


CURVE #2 DATA (TH 30)  
 PC STA. 14+19.879  
 $\Delta=40^{\circ}31'38.90''$  RT  
 $D=15^{\circ}29'07.24''$   
 $R=370.00'$   
 $T=136.601'$   
 $L=261.715'$   
 $E=24.411'$

STA. 16+50.00  
 END PROJECT

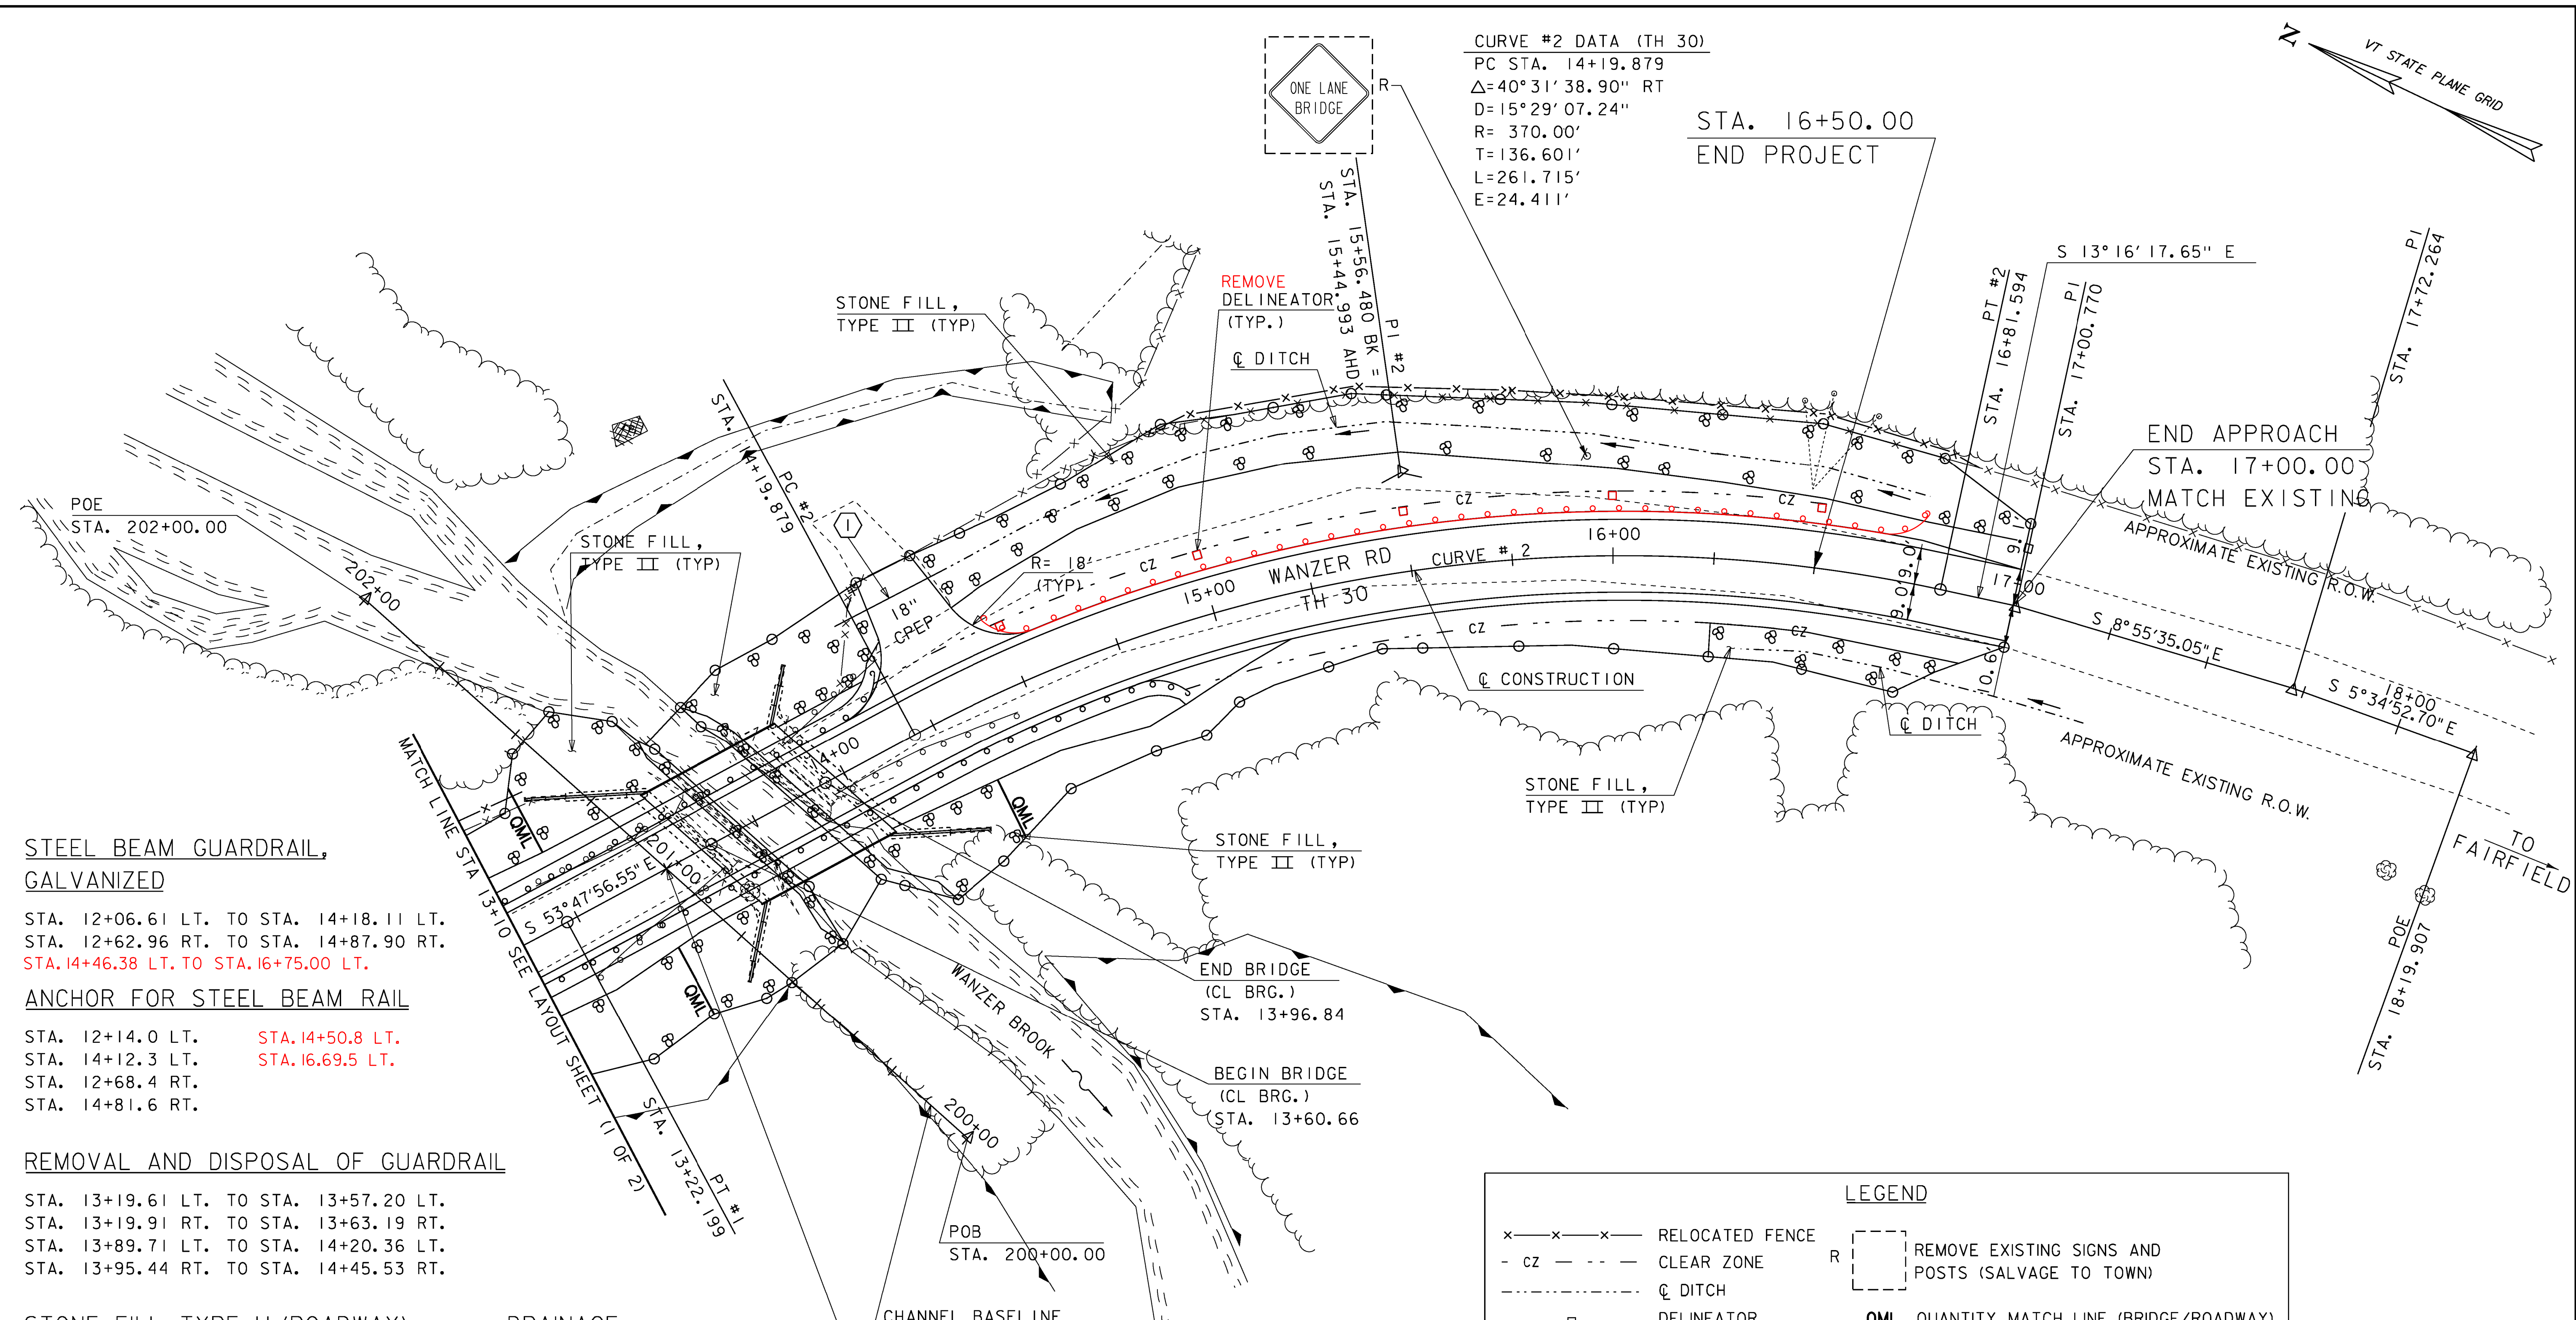

STEEL BEAM GUARDRAIL, GALVANIZED  
 STA. 12+06.61 LT. TO STA. 14+18.11 LT.  
 STA. 12+62.96 RT. TO STA. 14+87.90 RT.  
 STA. 14+46.38 LT. TO STA. 16+75.00 LT.

ANCHOR FOR STEEL BEAM RAIL  
 STA. 12+14.0 LT. STA. 14+50.8 LT.  
 STA. 14+12.3 LT. STA. 16.69.5 LT.  
 STA. 12+68.4 RT.  
 STA. 14+81.6 RT.

REMOVAL AND DISPOSAL OF GUARDRAIL  
 STA. 13+19.61 LT. TO STA. 13+57.20 LT.  
 STA. 13+19.91 RT. TO STA. 13+63.19 RT.  
 STA. 13+89.71 LT. TO STA. 14+20.36 LT.  
 STA. 13+95.44 RT. TO STA. 14+45.53 RT.

STONE FILL, TYPE II (ROADWAY)  
 STA. 11+00.00 LT. TO STA. 13+25.00 LT.  
 STA. 11+00.00 RT. TO STA. 13+43.00 RT.  
 STA. 14+36.99 LT. TO STA. 17+00.00 LT.  
 STA. 16+25.00 RT. TO STA. 16+90.00 RT.

STONE FILL, TYPE II (BRIDGE)  
 STA. 13+25.00 LT. TO STA. 14+25.00 LT.  
 STA. 13+43.00 RT. TO STA. 14+34.00 RT.

REMOVING AND RESETTING FENCE  
 STA. 14+19.69 LT. TO STA. 14+25.00 LT.  
 STA. 14+96.00 LT. TO STA. 14+34.00 LT.

DRAINAGE  
 I STA. 14+15.1, 33.0' LT. TO STA. 14+44.0, 33.4' LT.  
 CONSTRUCT 31 LF x 18" CPEP  
 INVERT IN = EL. 474.36  
 INVERT OUT = EL. 473.34

CONSTRUCT GRAVEL DRIVE  
 STA. 14+31 LT.

DELINEATOR WITH FLEXIBLE POST  
 STA. 14+50 LT. TO STA. 17+00 LT.  
 (SPACED AT 50 FEET)

CHANNEL BASELINE  
 STA. 13+50.00 WANZER RD  
 = STA. 201+00.00 CHANNEL BASELINE  
 $\Delta=20^{\circ}00'00''$  LT.

REMOVAL AND DISPOSAL OF DELINEATOR  
 STA. 14+50 LT. TO STA. 17+00 LT.

LEGEND	
x-x-x	RELOCATED FENCE
-cz-	CLEAR ZONE
- - -	☉ DITCH
□	DELINEATOR
R	REMOVE EXISTING SIGNS AND POSTS (SALVAGE TO TOWN)
OML	QUANTITY MATCH LINE (BRIDGE/ROADWAY) (STONE FILL, TYPE III)

EXISTING BRIDGE  
 SINGLE SPAN ROLLED BEAM WITH TIMBER DECK ON MASONRY/CONCRETE ABUTMENTS

LAYOUT SHEET 2  
 SCALE 1" = 20'-0"  
 20 0 20



PROJECT NAME: FAIRFIELD	PLOT DATE: 01-NOV-2013
PROJECT NUMBER: BRO 1448(38)	DRAWN BY: M. VALLETTA
FILE NAME: z11j072bdr_nu_01.dgn	DESIGNED BY: M. VALLETTA
	CHECKED BY: T. KENDRICK
	LAYOUT SHEET (2 OF 2)
	SHEET 11 OF 41