




10+75  
 \* MATCH EXISTING CROSS SLOPE (TYP)  
 BEGIN APPROACH  
 STA 10+75.00  
 MATCH EXISTING

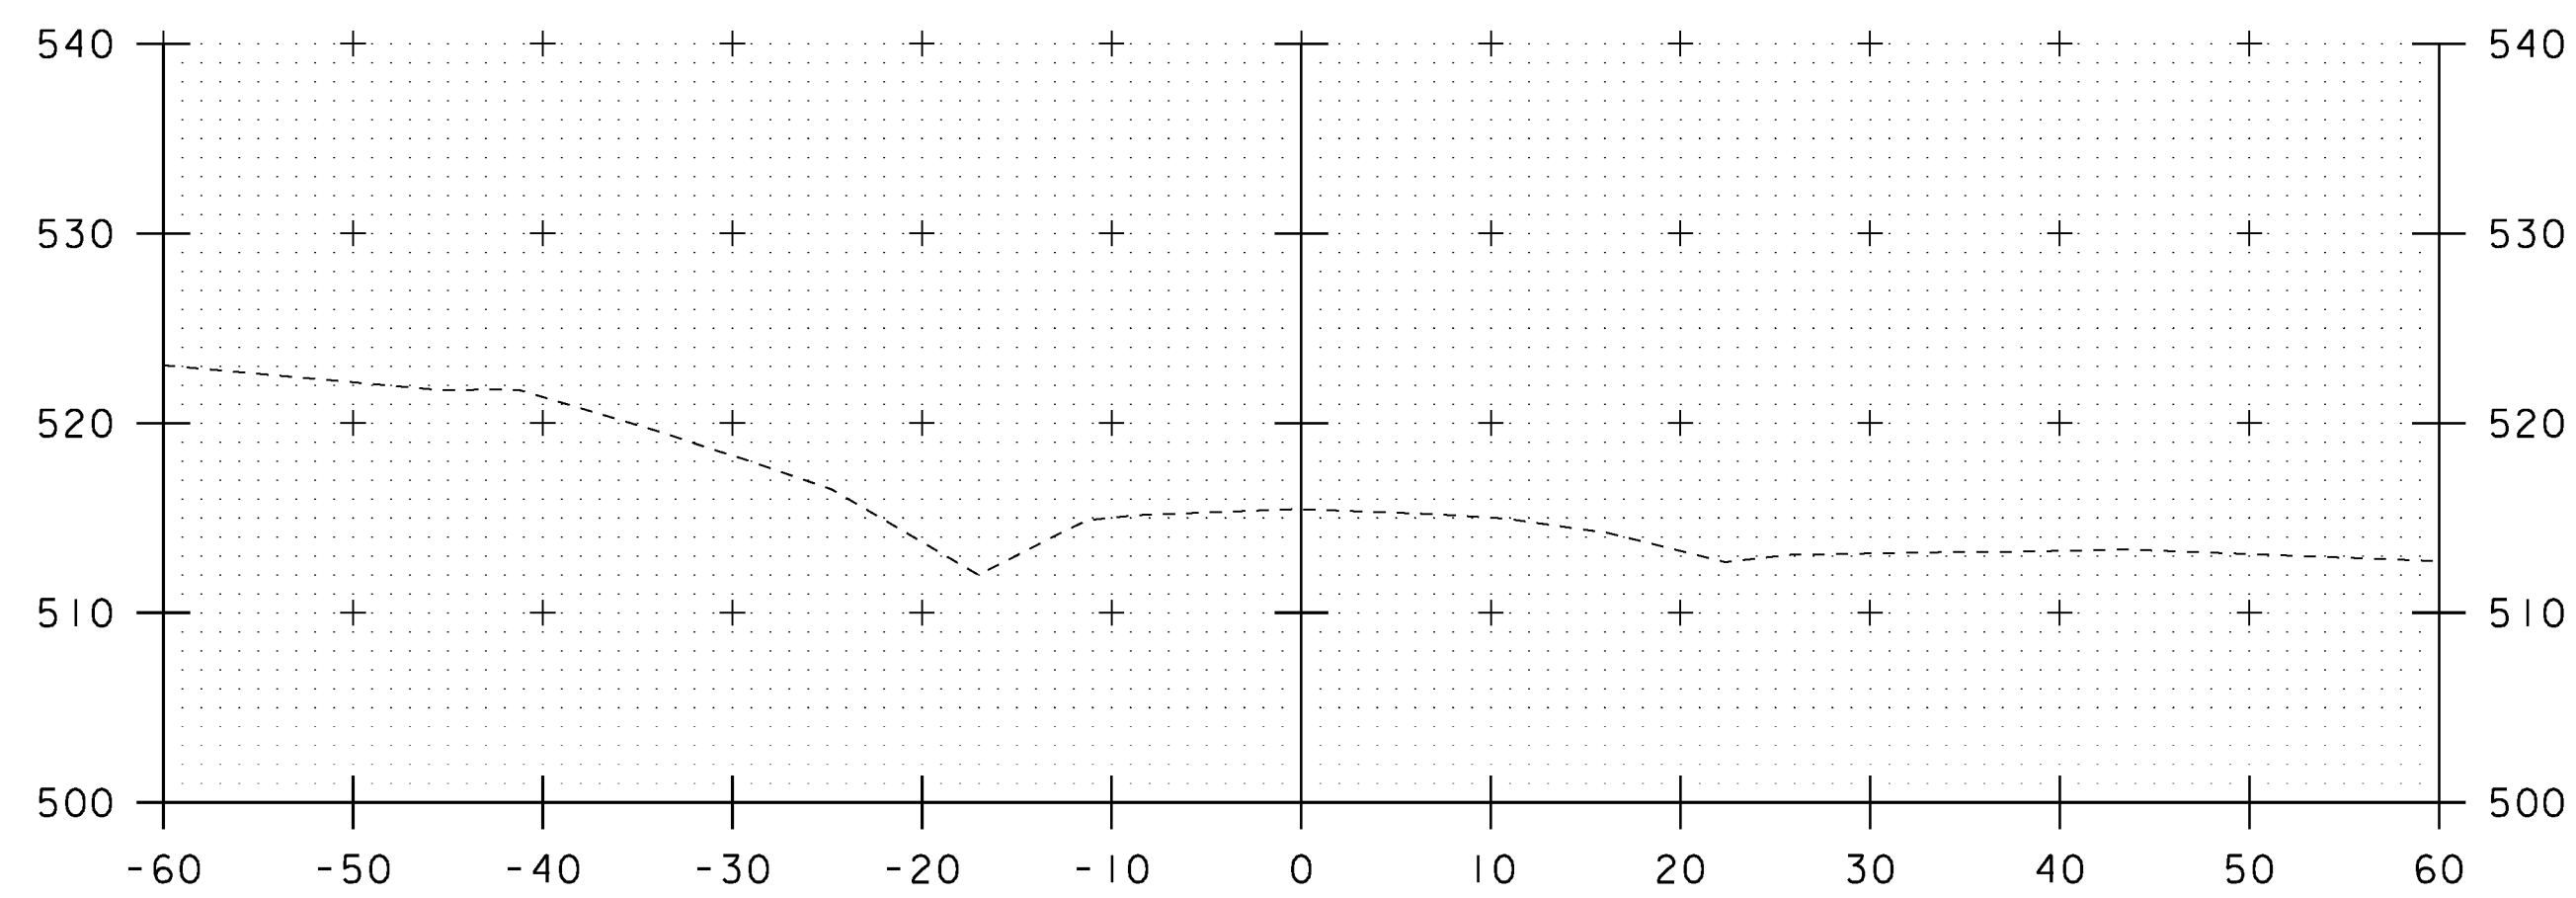


10+50

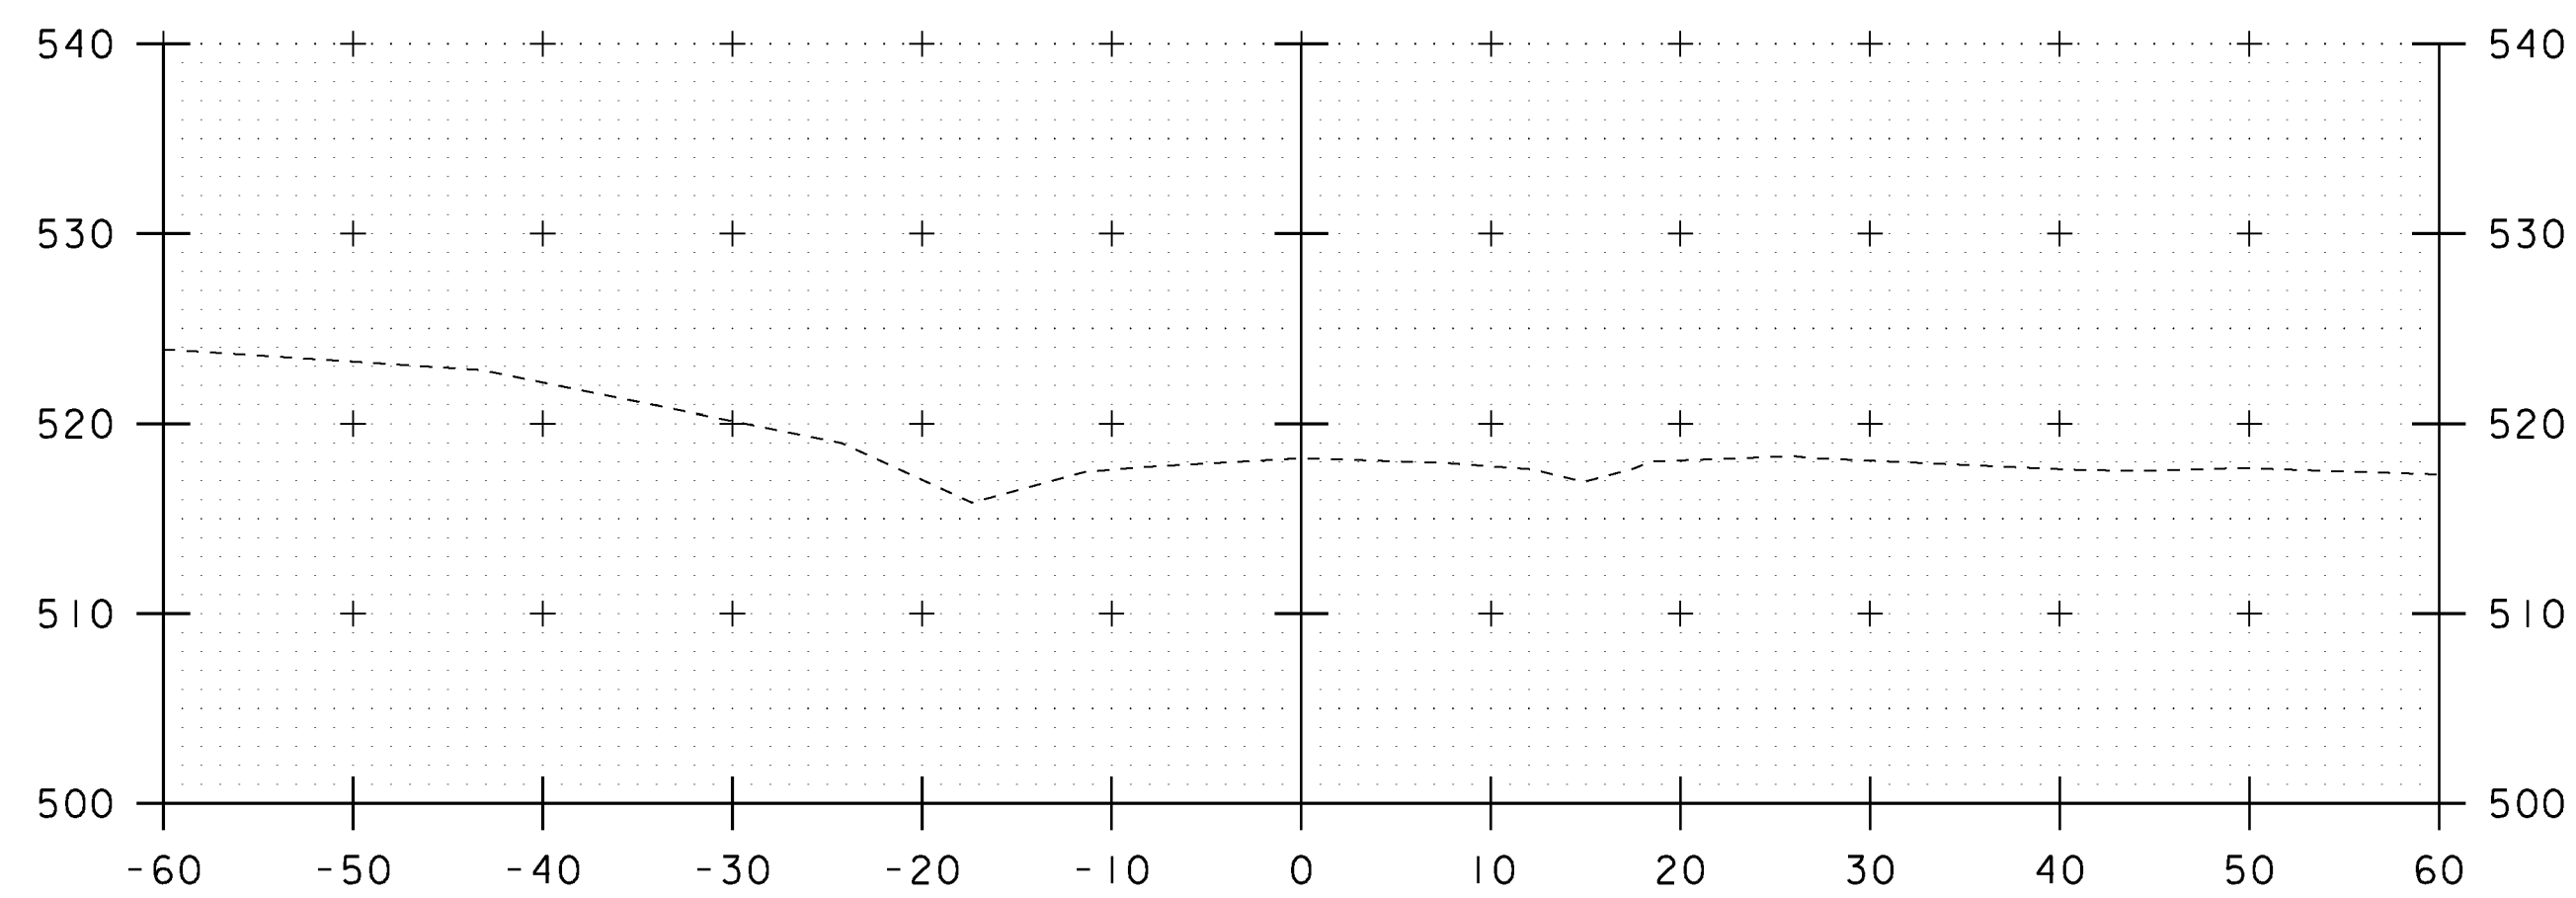

10+25

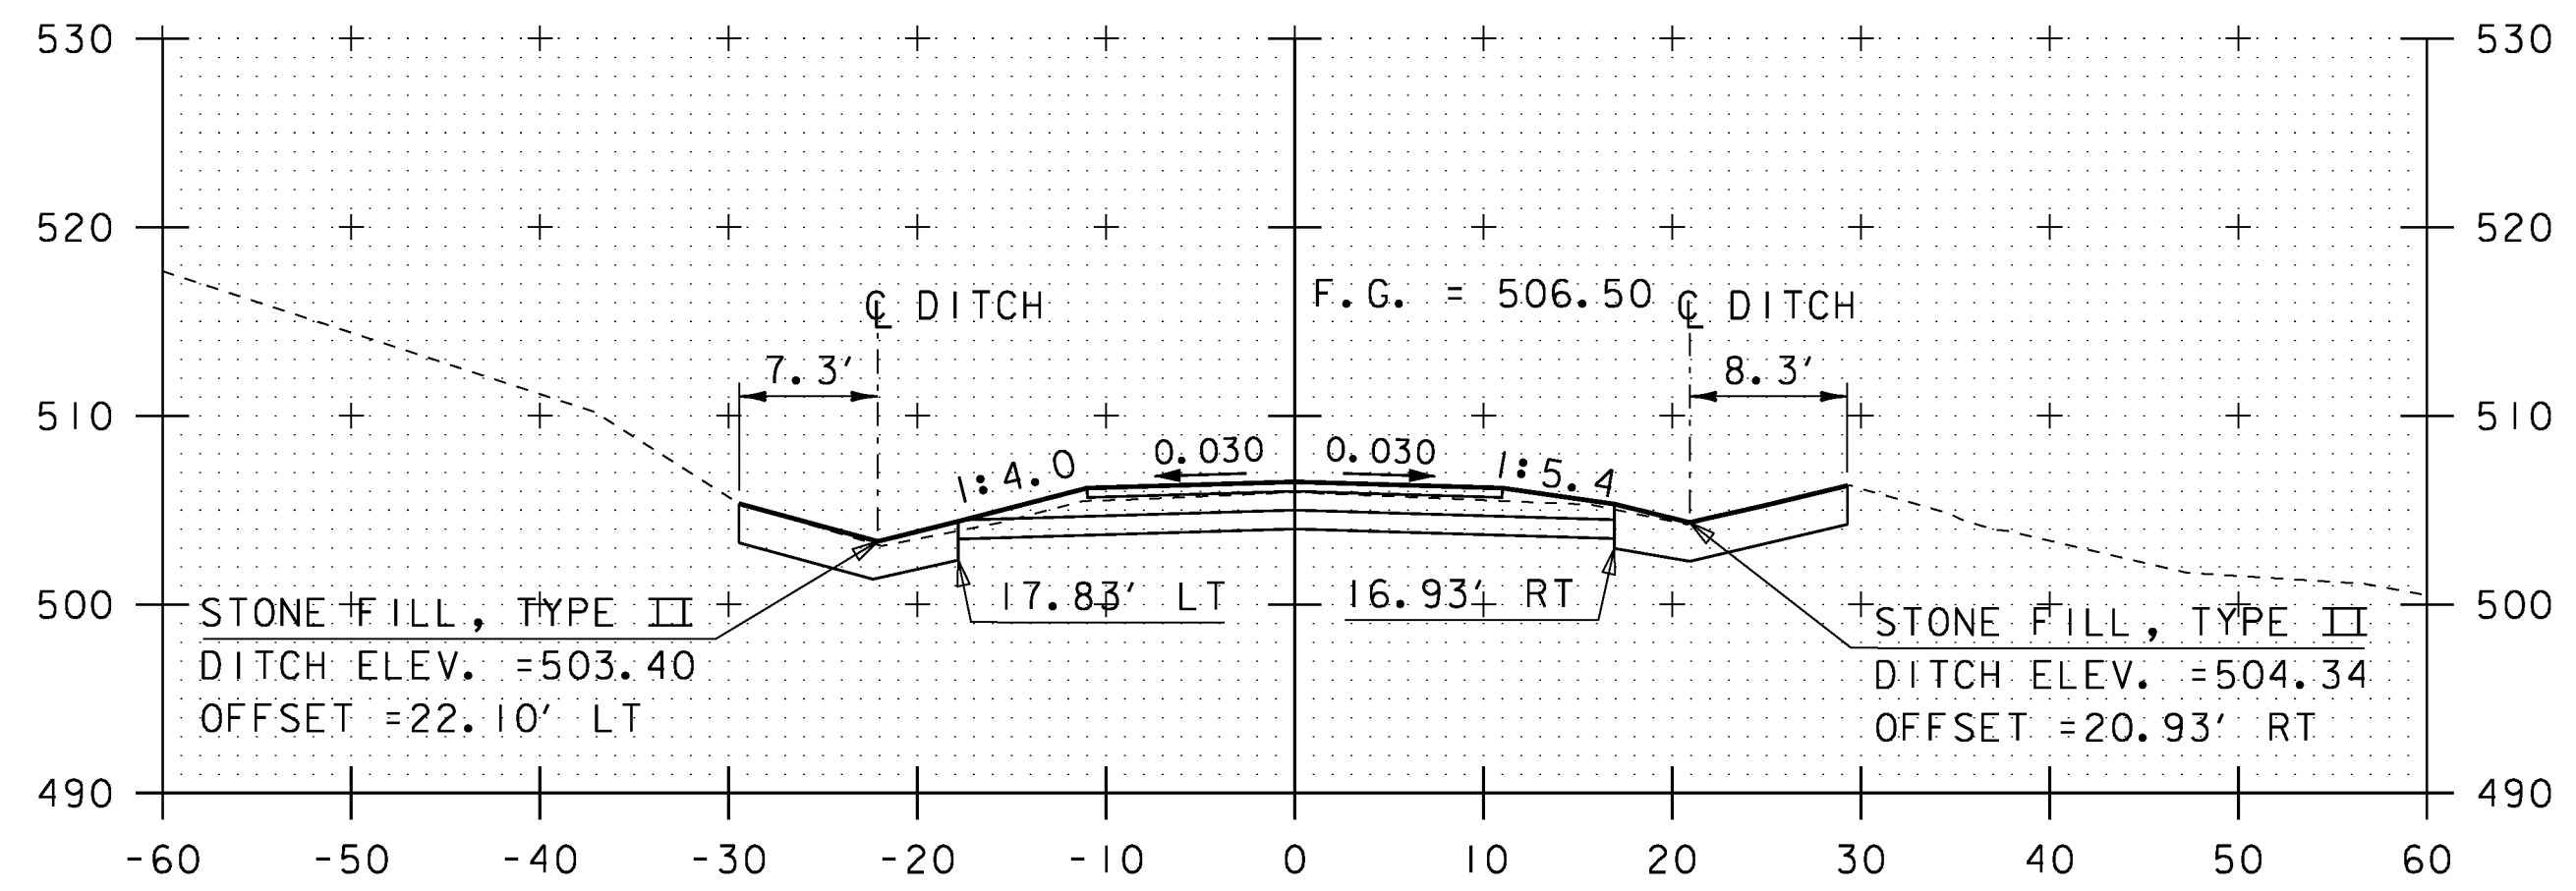

11+25  
 BEGIN PROJECT  
 STA 11+25.00

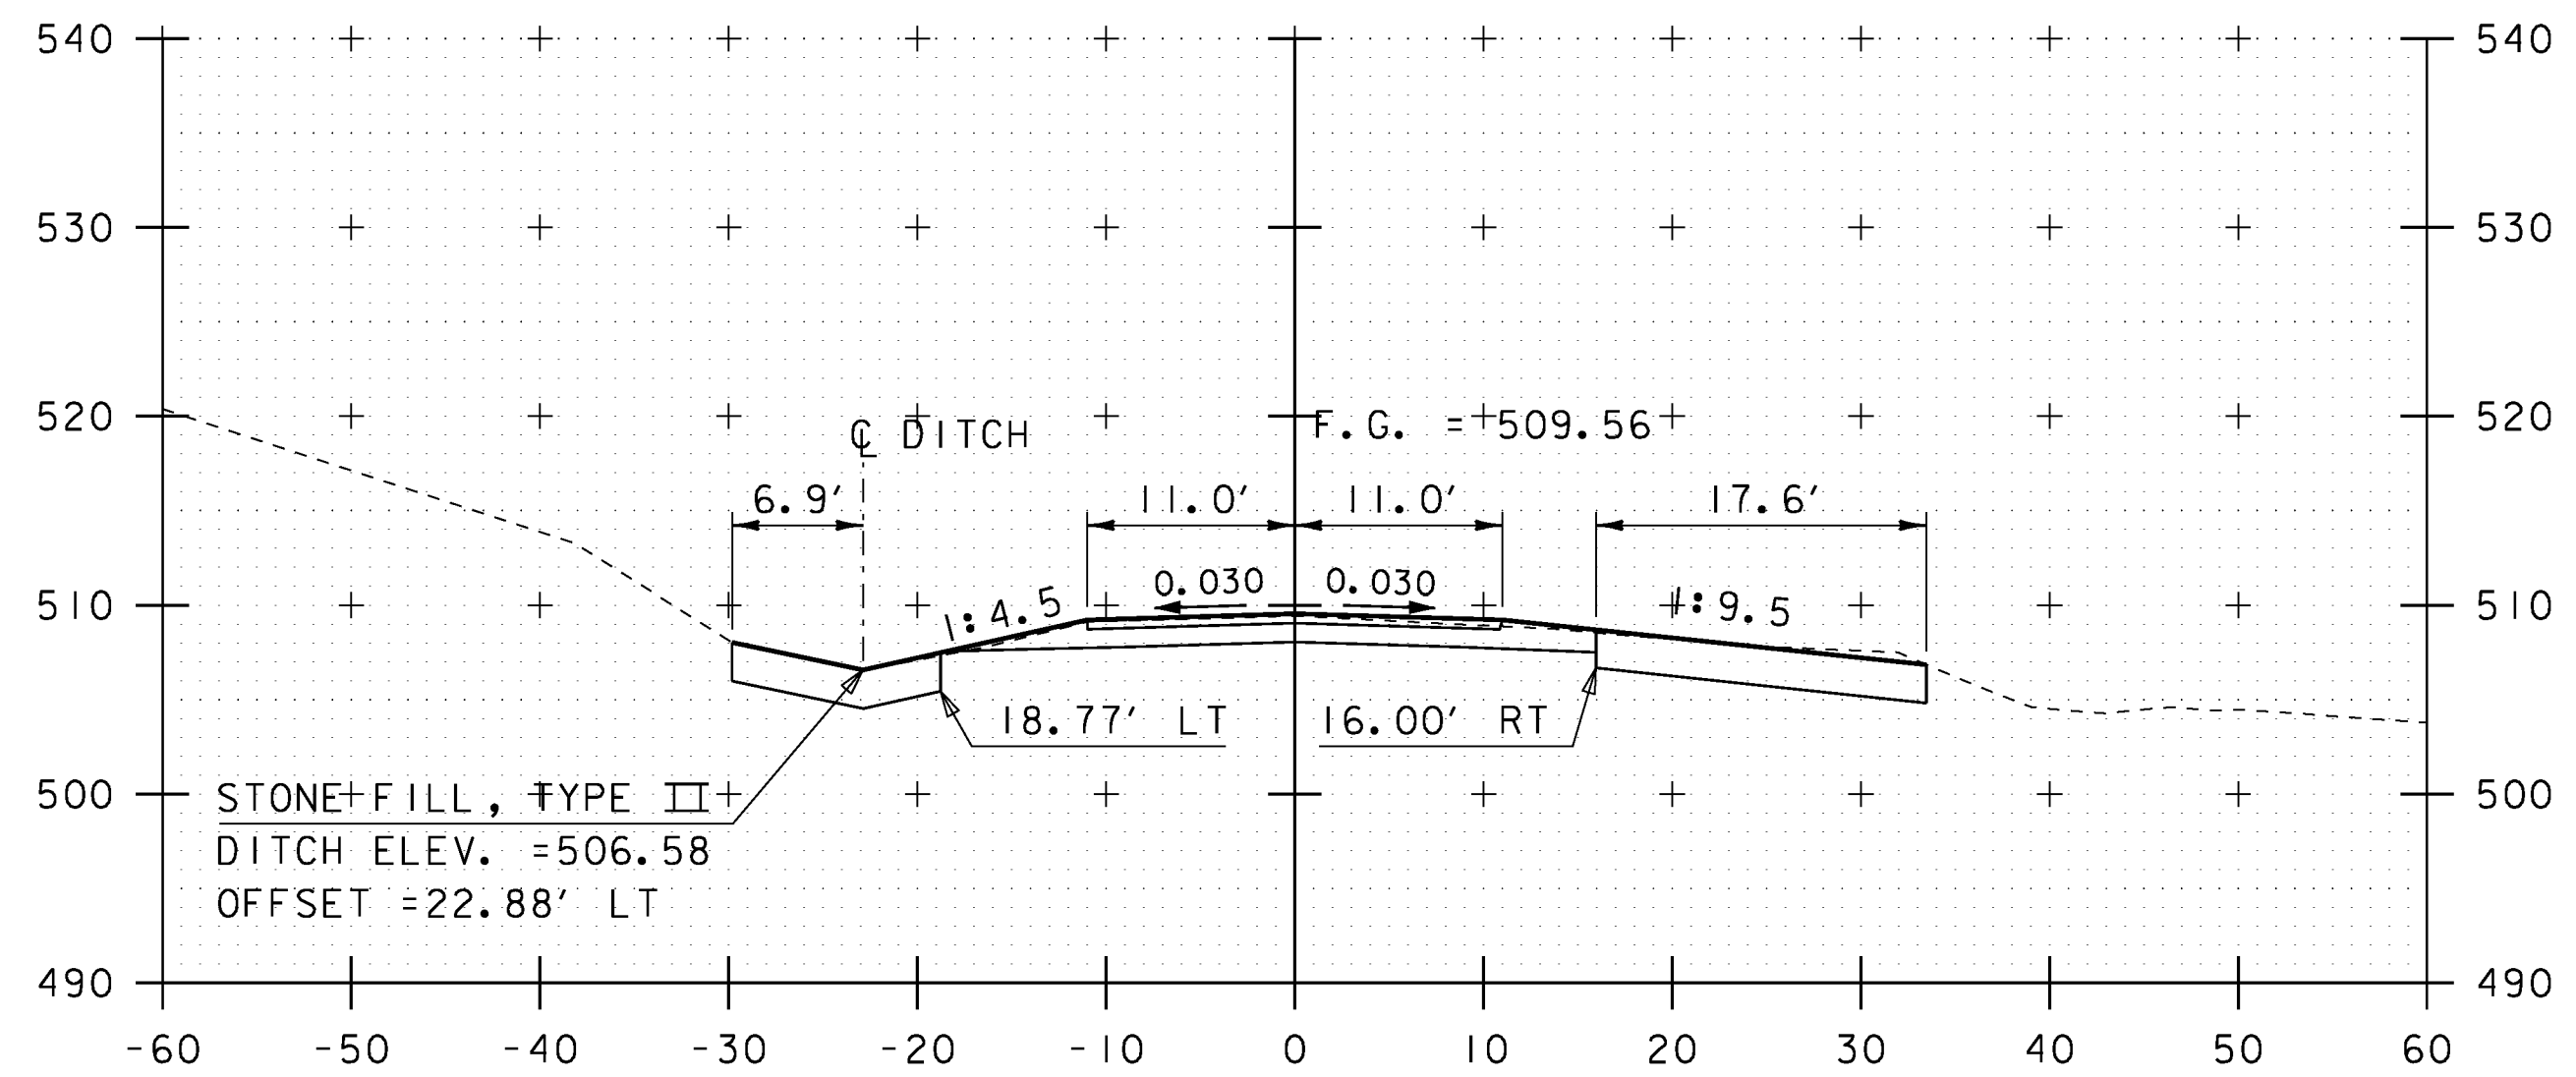

11+00

SCALE 1" = 10'-0"  
 10 0 10

STA. 10+25 TO STA. 11+25



PROJECT NAME: FAIRFIELD  
 PROJECT NUMBER: BRO 1448(38)

FILE NAME: z11j072\_xsl.dgn  
 PROJECT LEADER: D. LANDRY  
 DESIGNED BY: E. ALEXOPOULOS  
 ROADWAY CROSS SECTIONS (1 OF 6)

PLOT DATE: 01-NOV-2013  
 DRAWN BY: W. GAYNOR  
 CHECKED BY: T. KENDRICK  
 SHEET 34 OF 41