



17+25

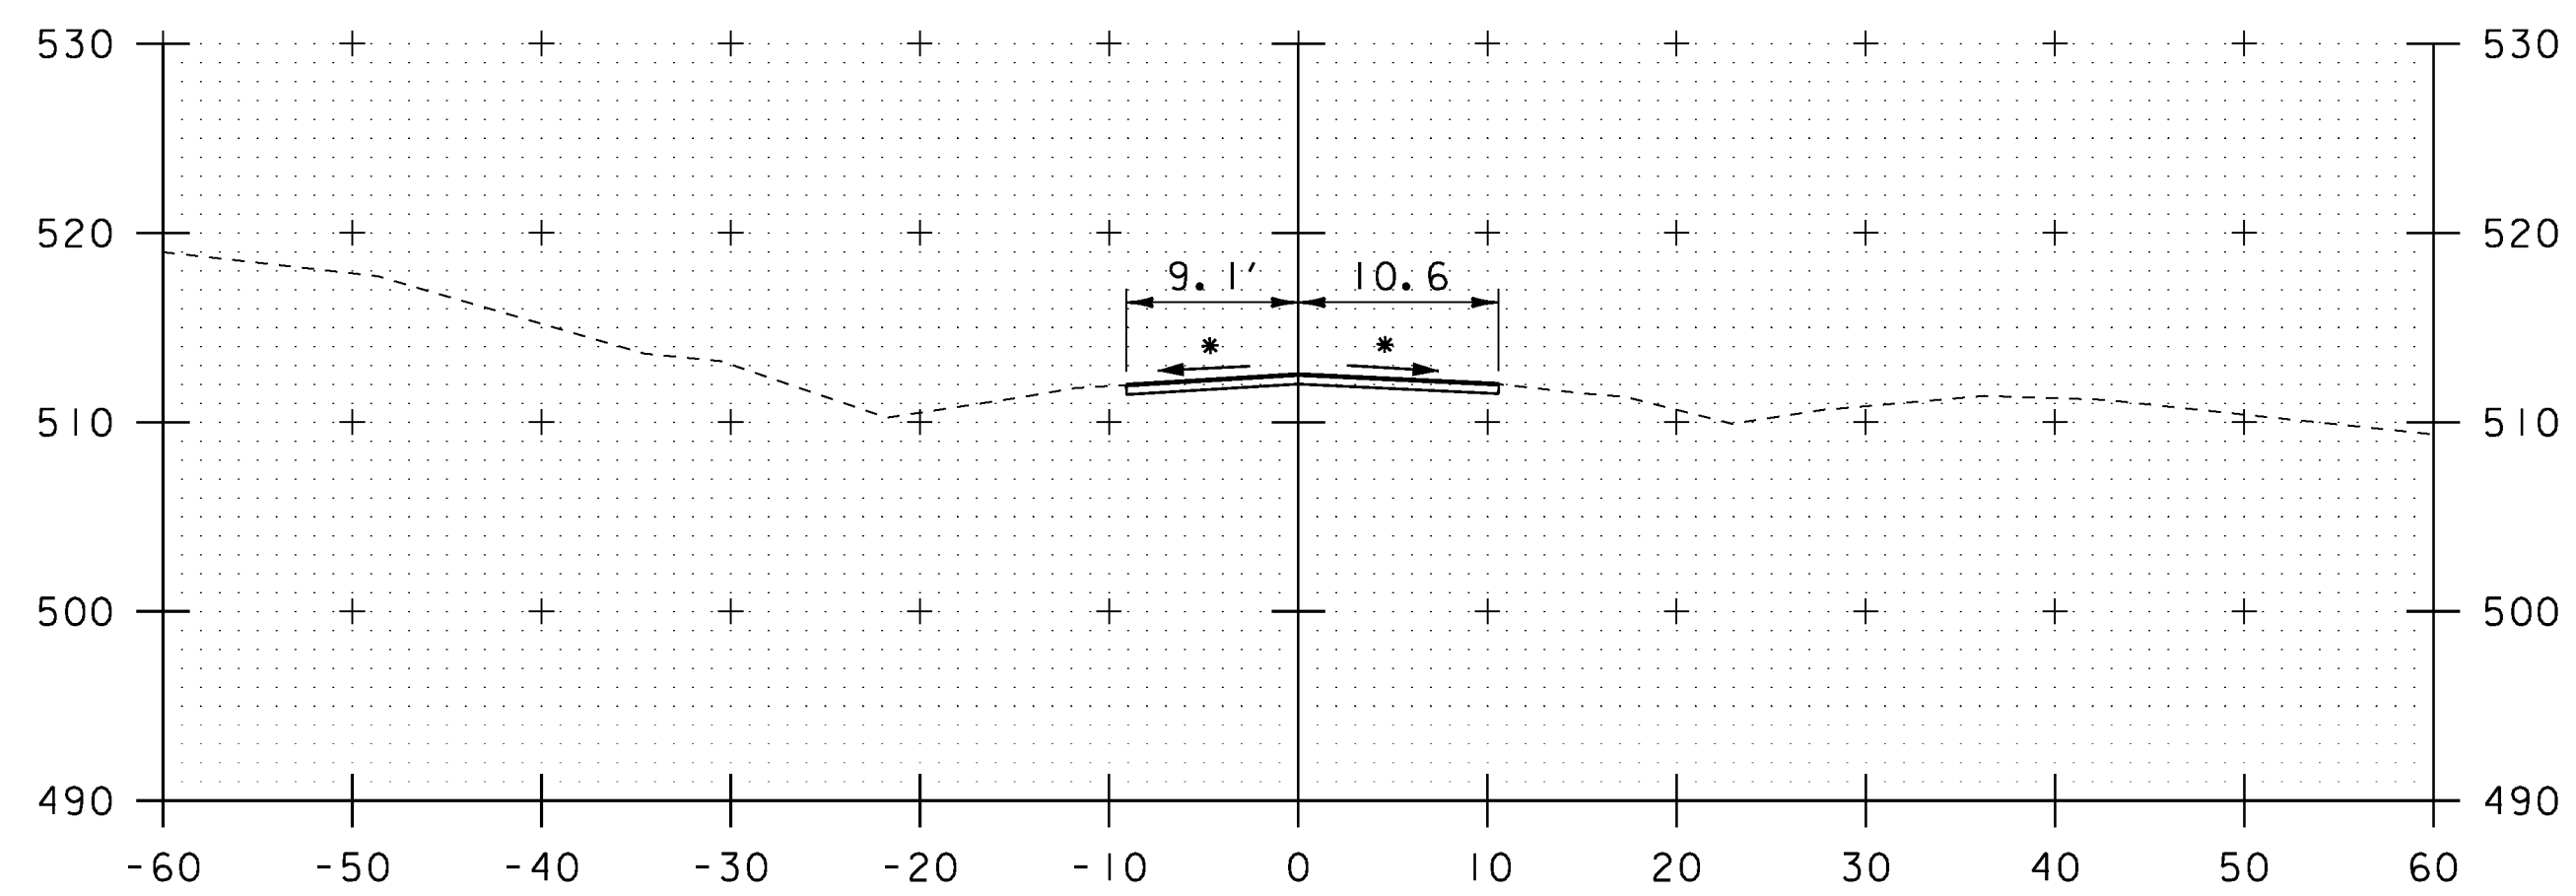


17+00

* MATCH EXISTING CROSS SLOPE (TYP)
 END APPROACH
 STA 17+00.00
 MATCH EXISTING

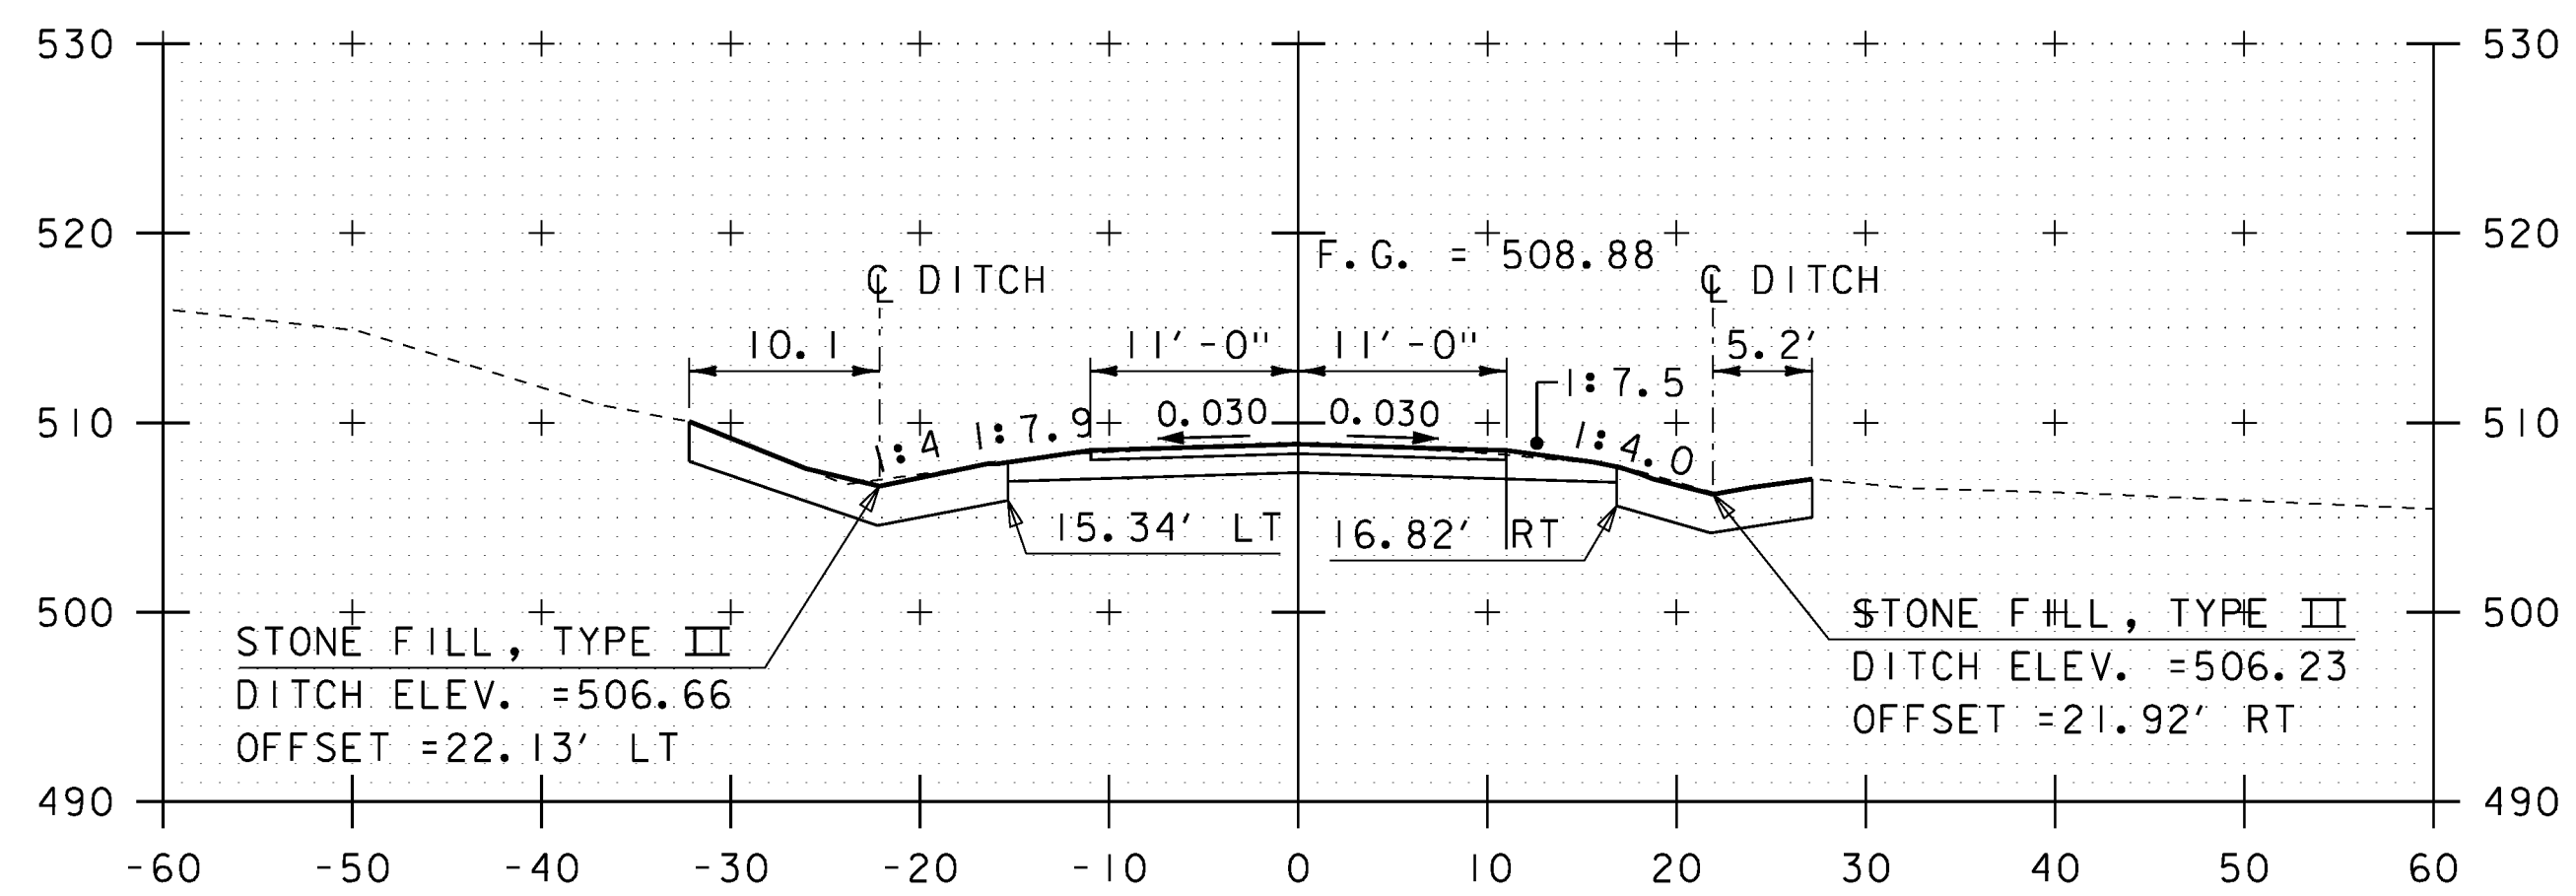

16+75

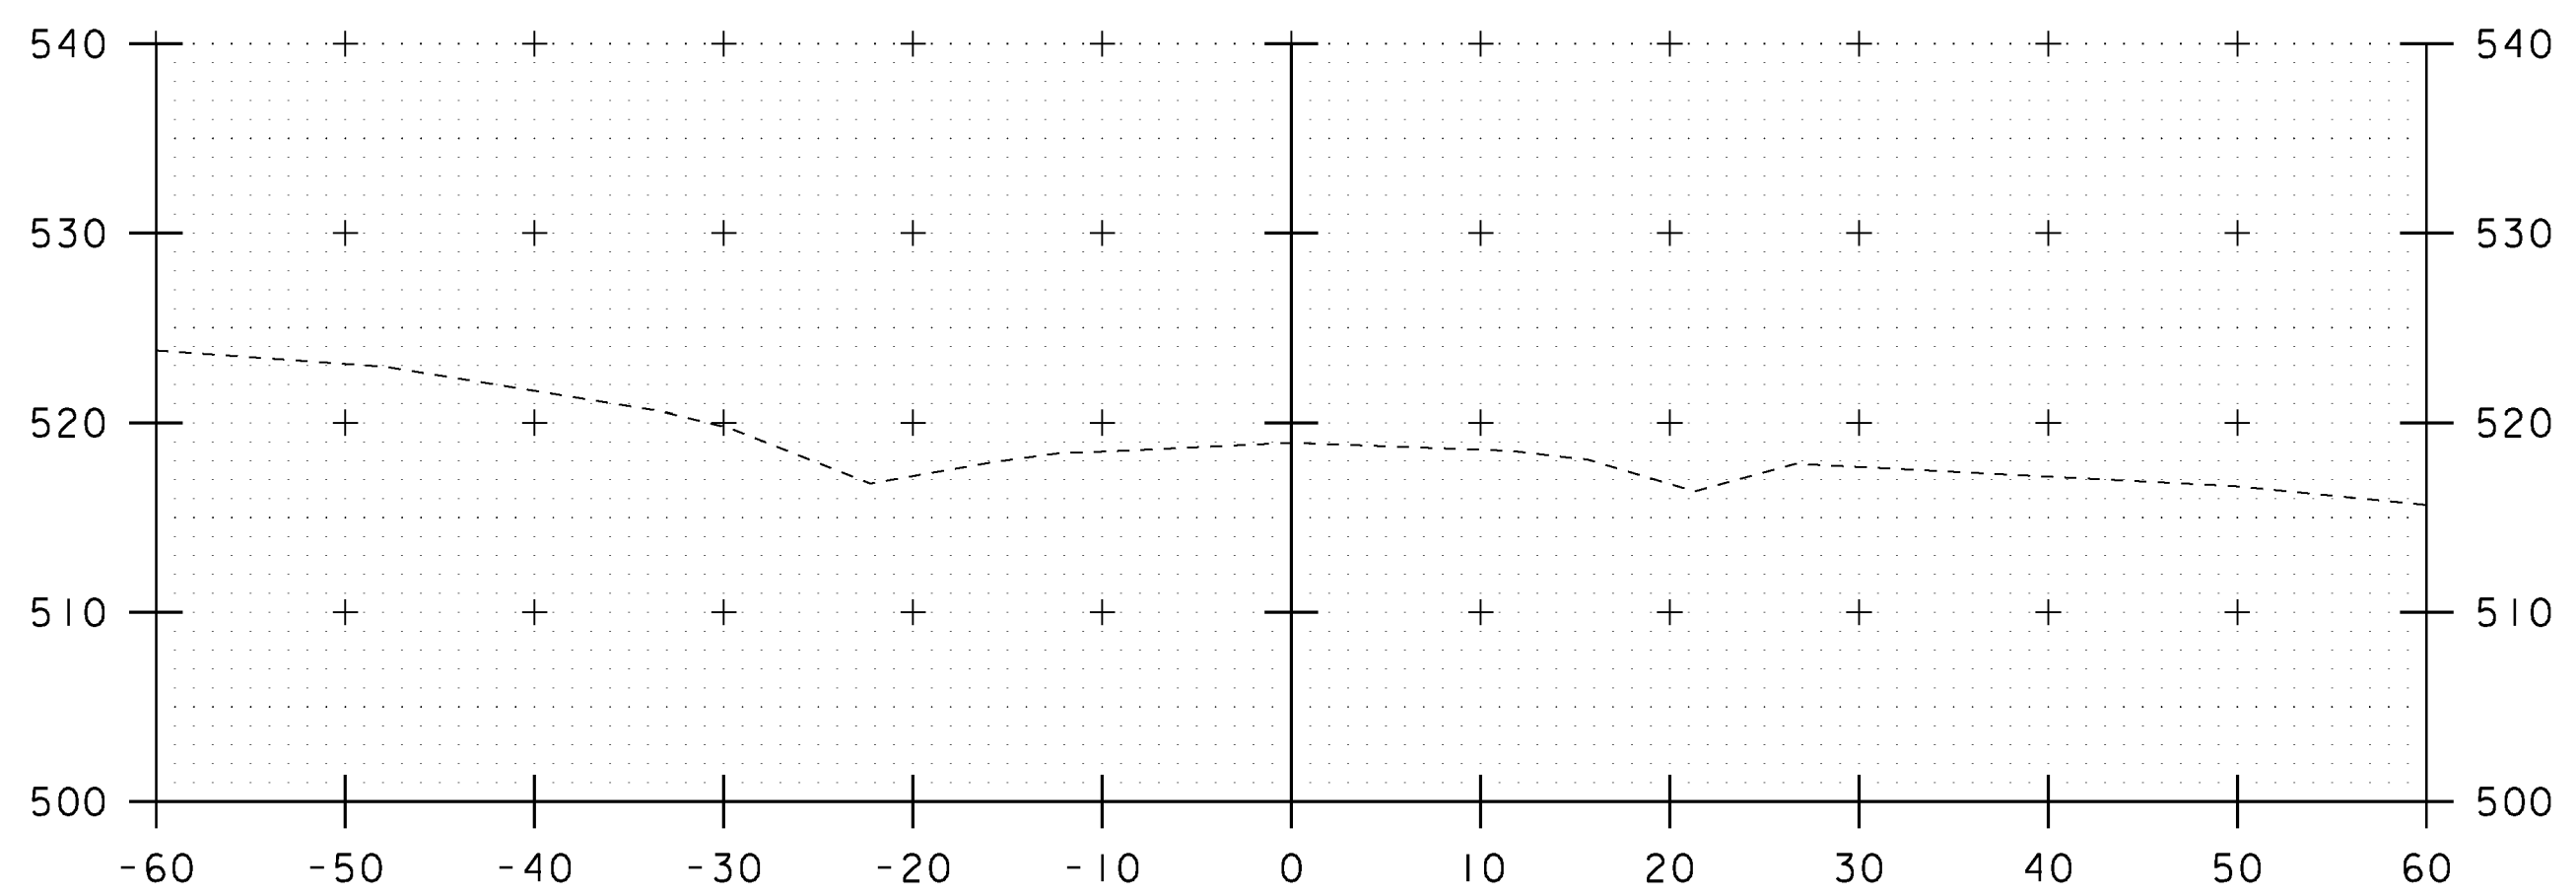

17+50

SCALE 1" = 10'-0"
 10 0 10

STA. 16+75 TO STA. 17+50



PROJECT NAME: FAIRFIELD	FILE NAME: z11j072_xsl.dgn	PLOT DATE: 01-NOV-2013
PROJECT NUMBER: BRO 1448(38)	PROJECT LEADER: D. LANDRY	DRAWN BY: W. GAYNOR
	DESIGNED BY: E. ALEXOPOULOS	CHECKED BY: T. KENDRICK
	ROADWAY CROSS SECTIONS (6 OF 6)	SHEET 39 OF 41