


STATE OF VERMONT AGENCY OF TRANSPORTATION

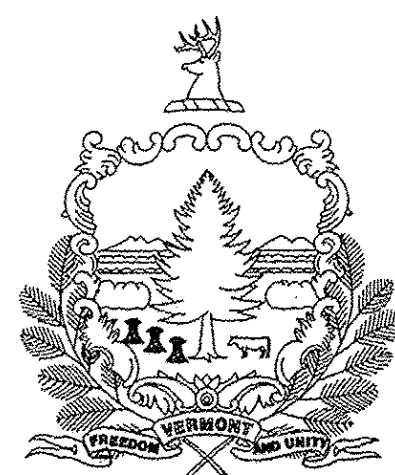

PROPOSED IMPROVEMENT BRIDGE PROJECT

TOWN OF FAIRFIELD COUNTY OF FRANKLIN



WANZER ROAD (TH 30, CLASS 3) - BRIDGE NO. 48

PROJECT LOCATION: BEGINNING AT A POINT ON TH 30, IN THE TOWN OF FAIRFIELD, LOCATED APPROXIMATELY 1.3 MILES FROM ITS INTERSECTION WITH TH 14 AND EXTENDING 0.10 MILES ON TH 30.

PROJECT DESCRIPTION: REPLACEMENT OF THE EXISTING STRUCTURE WITH A NEW RIGIFIED FRP TUBE ARCH (RFTA) STRUCTURE WITH RELATED CHANNEL AND ROADWAY WORK.

LENGTH OF STRUCTURE: 36.18 FEET = 0.01 MILES
 LENGTH OF ROADWAY: 488.82 FEET = 0.09 MILES
 LENGTH OF PROJECT: 525.00 FEET = 0.10 MILES

RECORD PLANS	
CONTRACTOR:	A.L. ST. ONGE CONTRACTOR, INC. - MONTGOMERY, VT.
RESIDENT ENGINEER:	JOSH HULETT
CONSTRUCTION BEGAN:	MAY 28, 2014
CONSTRUCTION COMPLETE:	SEPTEMBER 30, 2014
RECORD PLANS BY:	JOSH HULETT & AARON JAMES
I HEREBY CERTIFY THAT ALL THE CONSTRUCTION REQUIRED BY THIS SET OF DRAWINGS HAS BEEN ACCOMPLISHED AS INDICATED HEREIN.	
BY	<i>Josh Hulett</i> RESIDENT ENGINEER
DATE	August 23, 2016
NOTE: Any further information concerning final quantities, amounts or other details relative to this project may be found at Central Files in the electronic archives.	

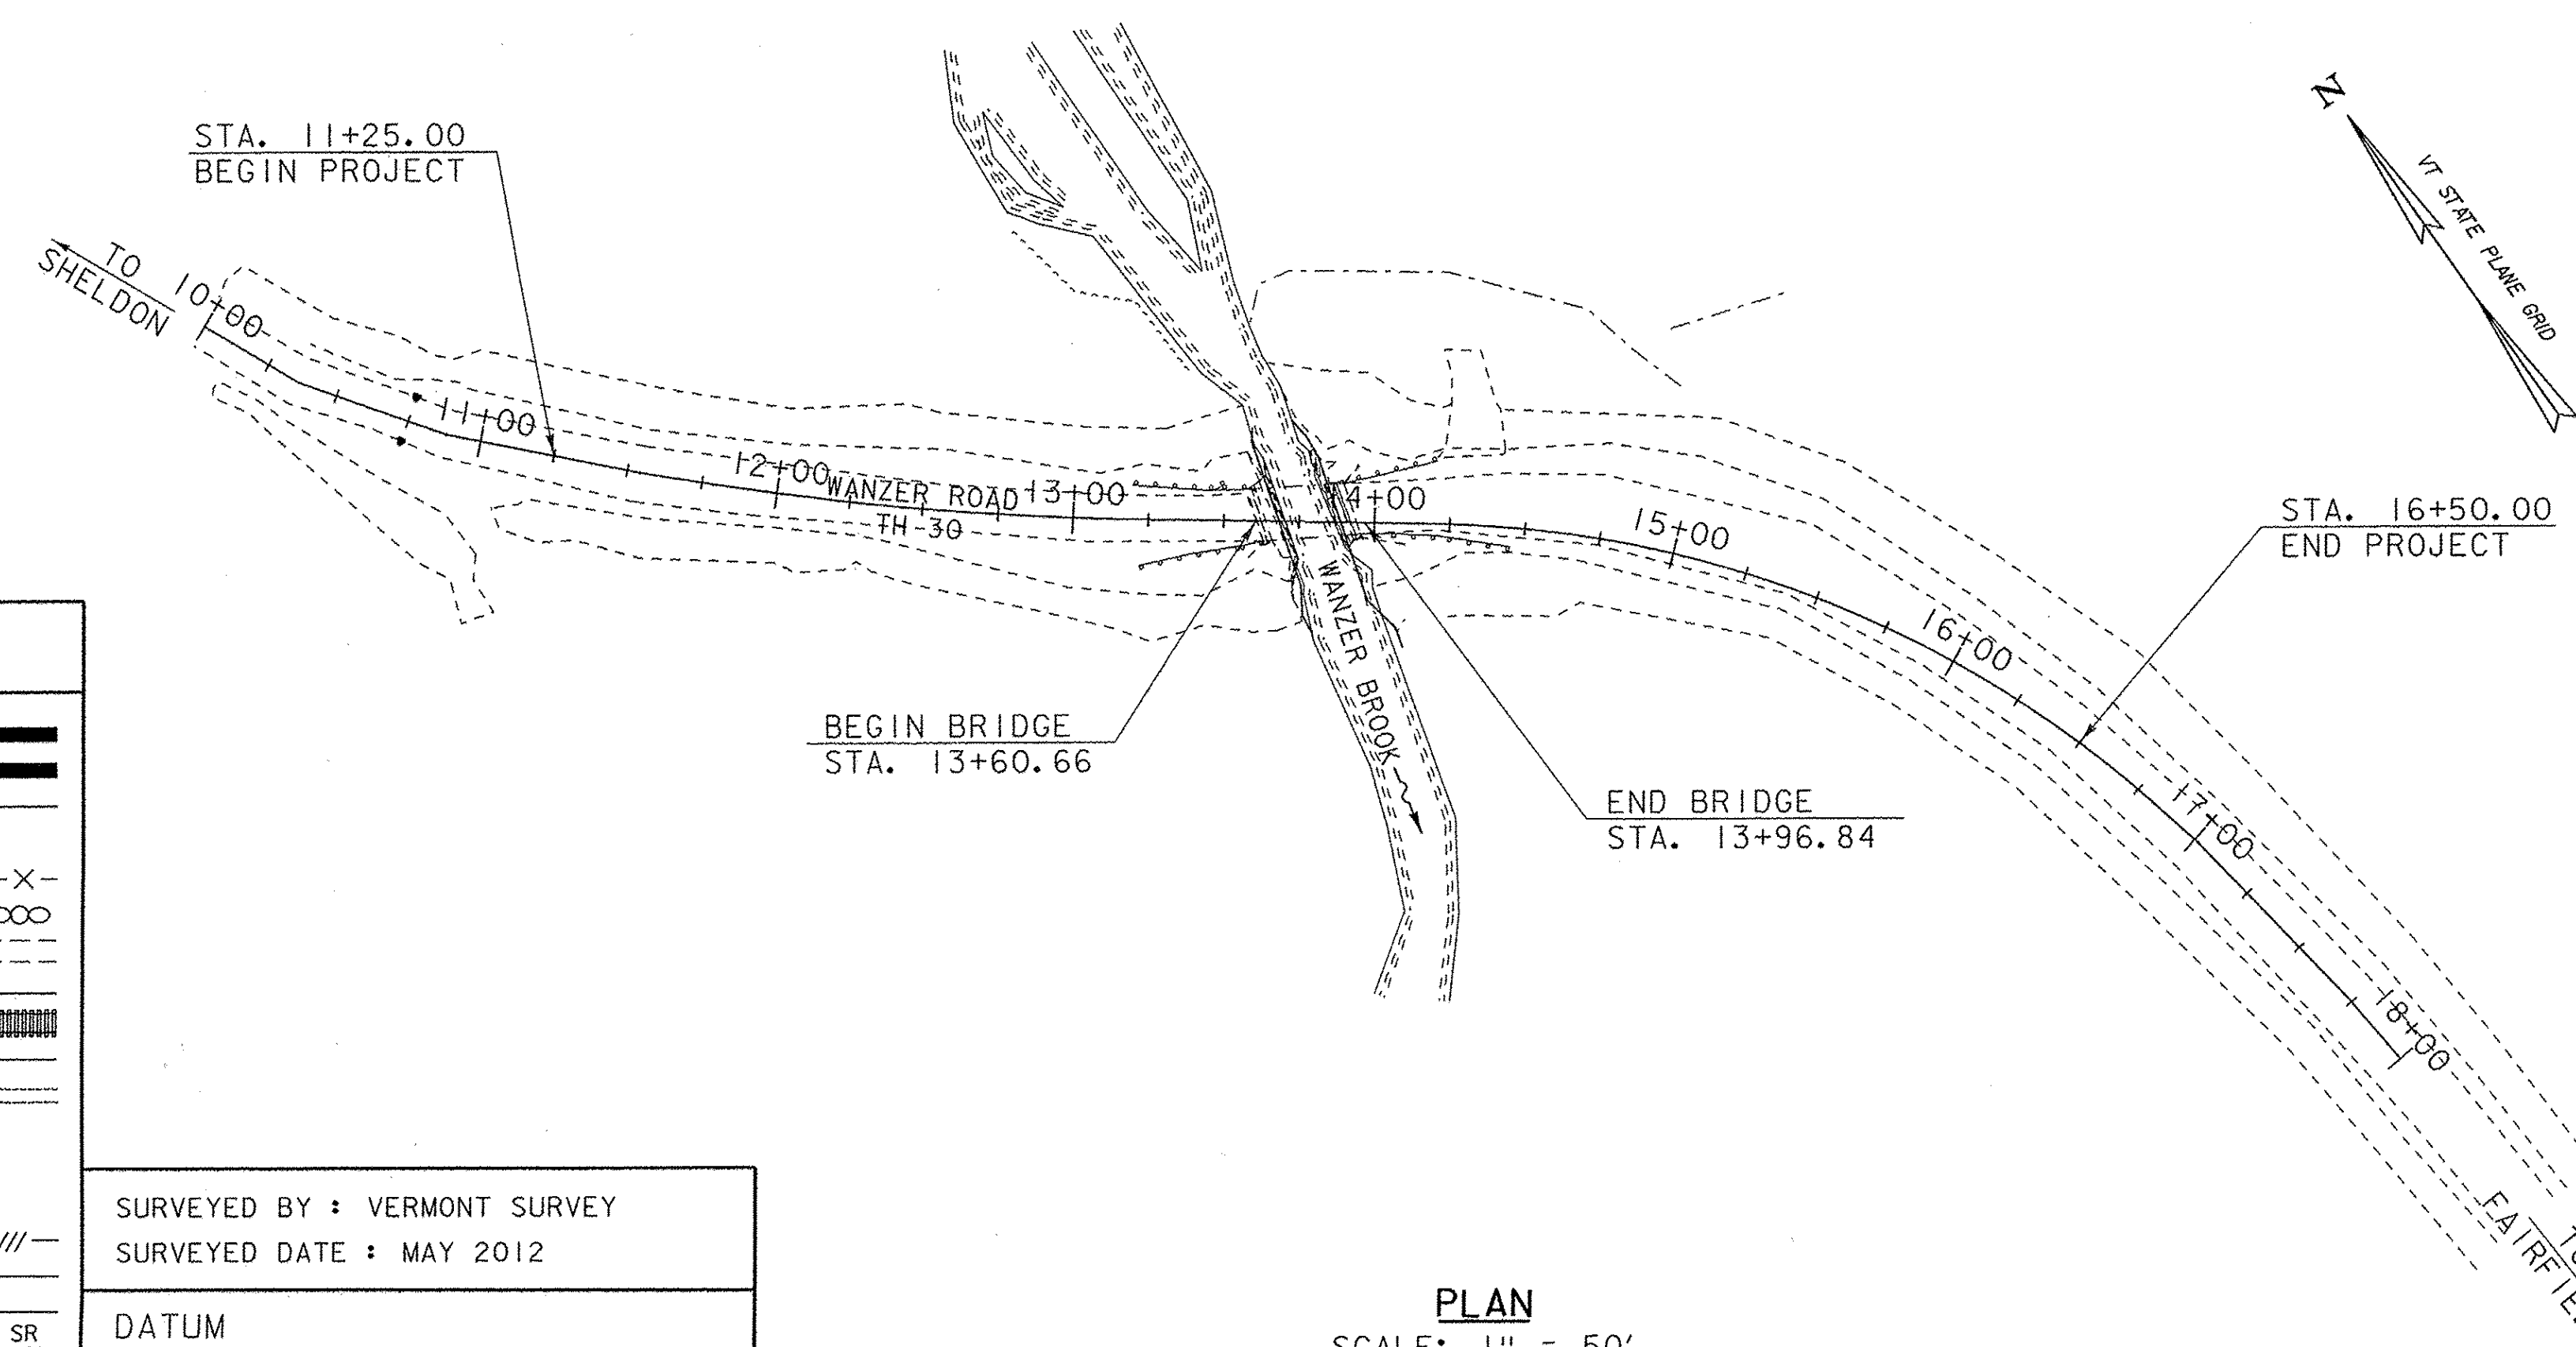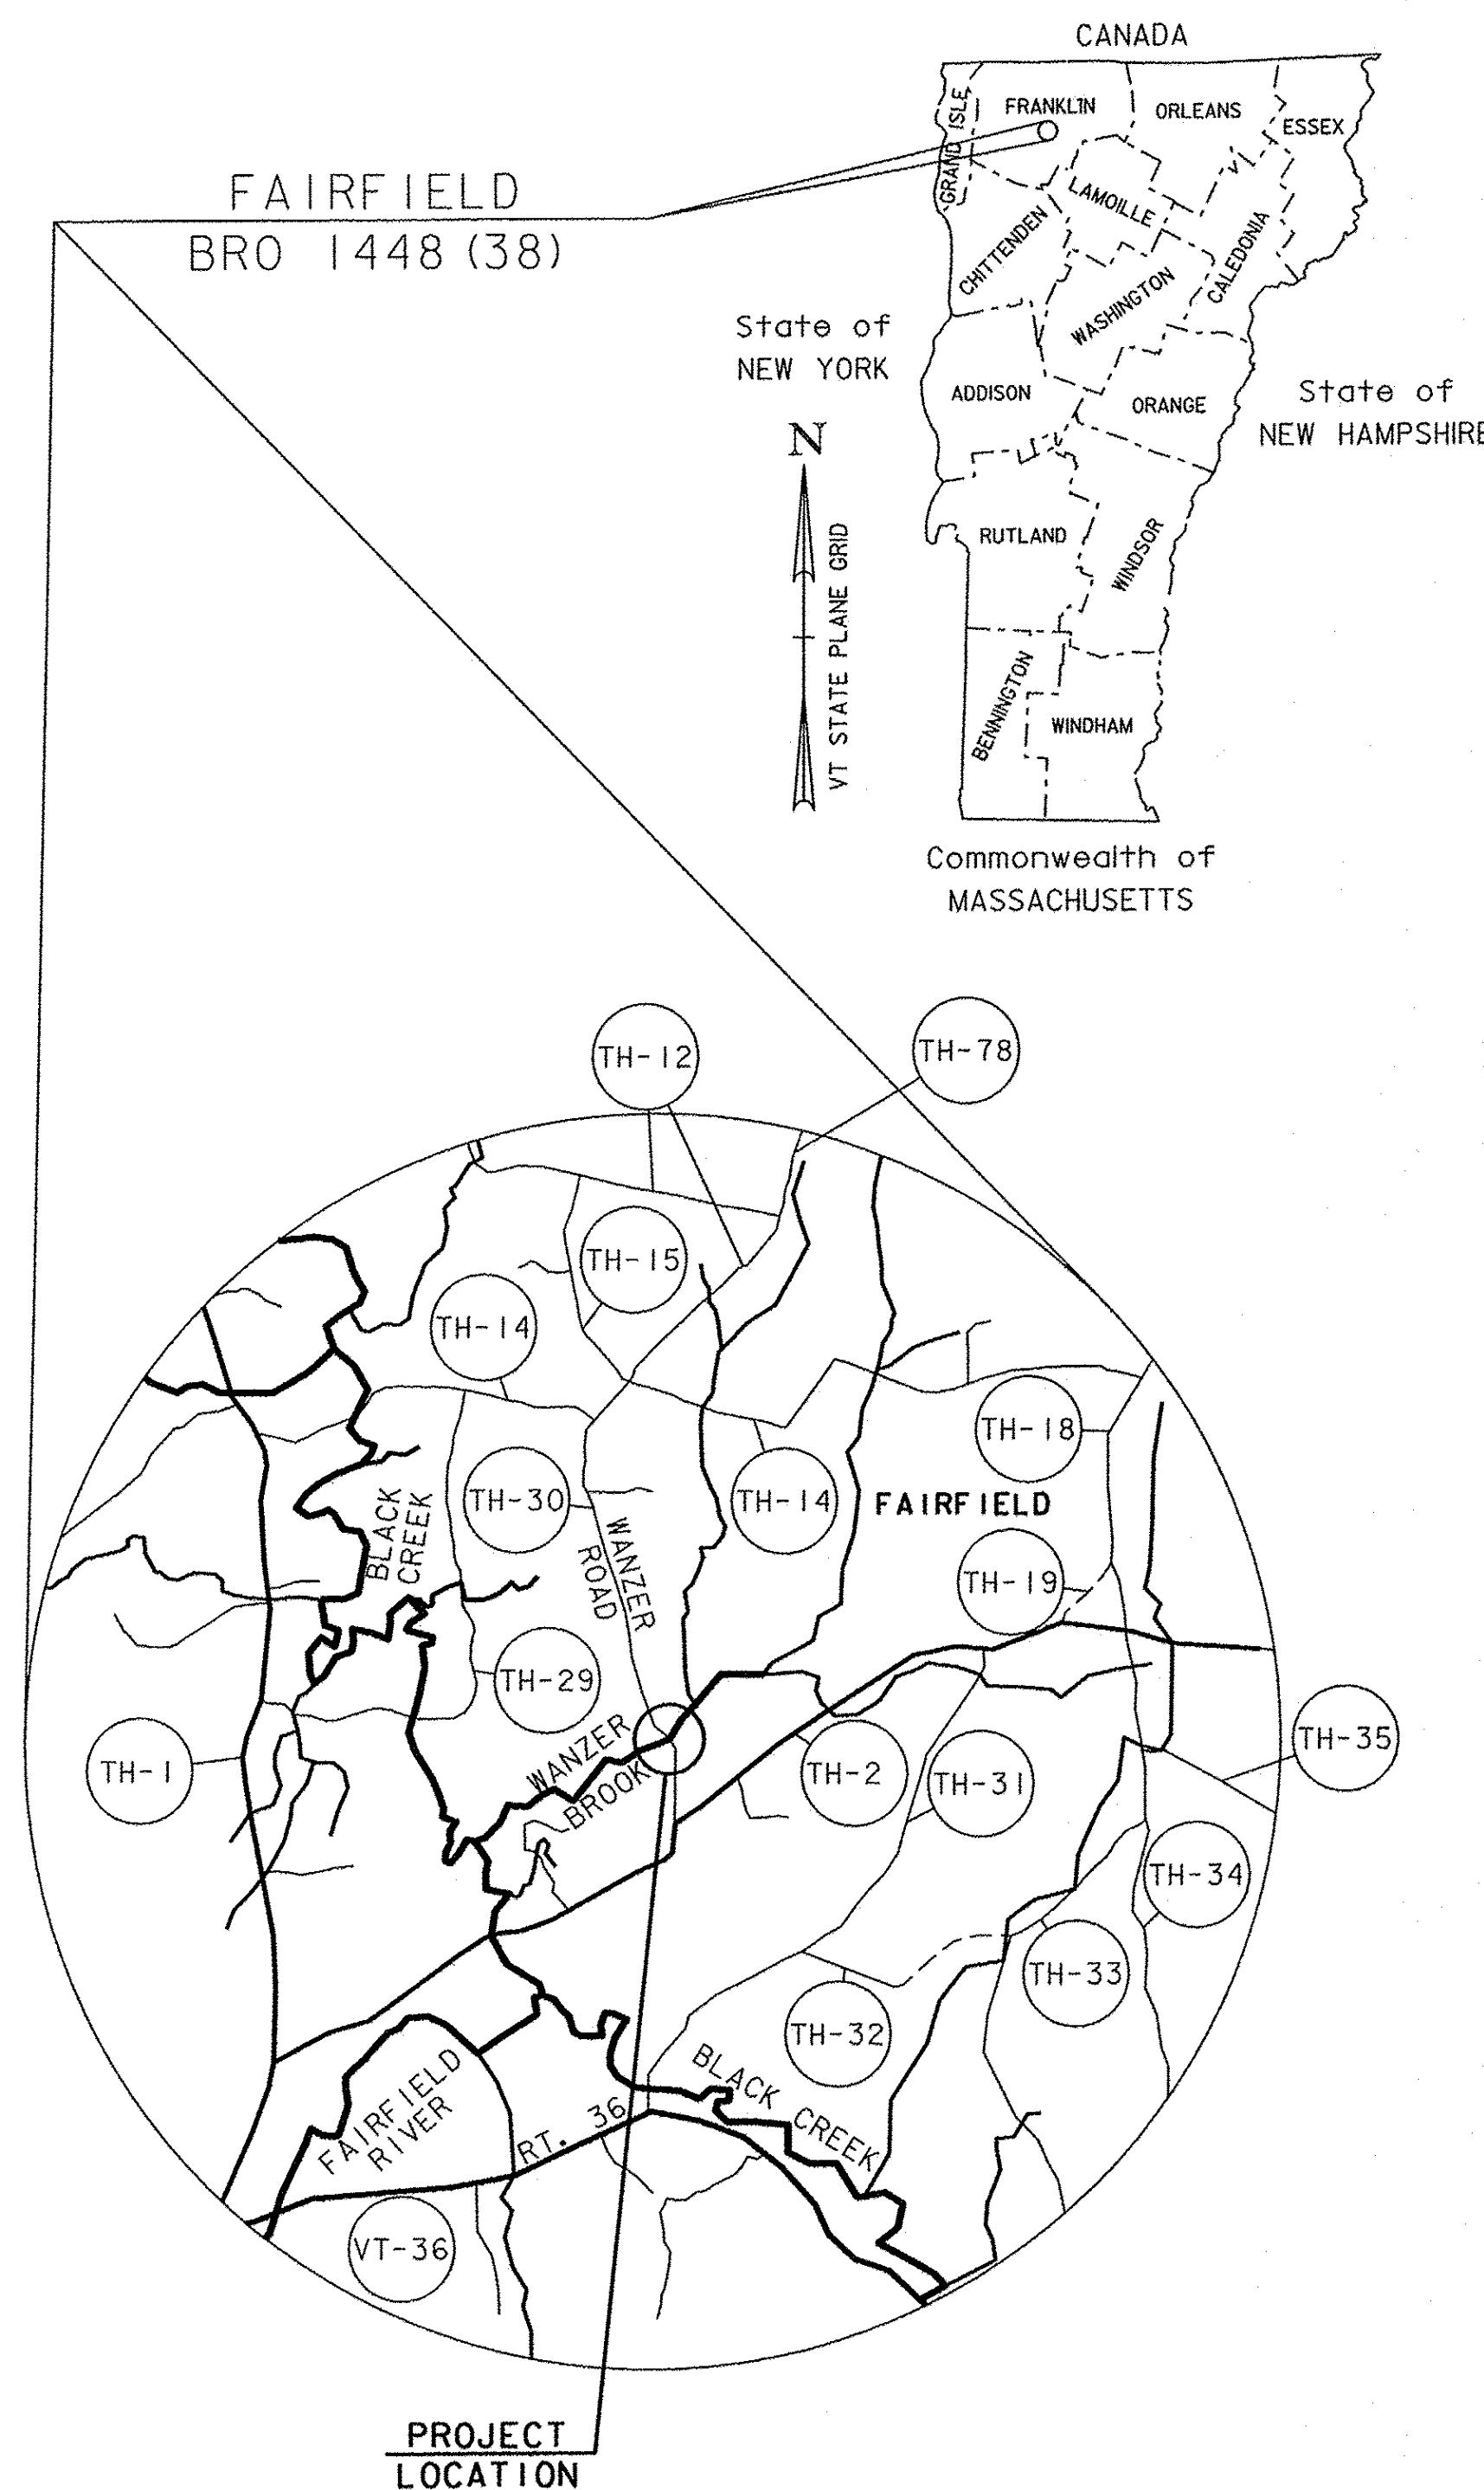


QUALITY ASSURANCE PROGRAM: LEVEL 2

CONVENTIONAL SYMBOLS	
COUNTY LINE	
TOWN LINE	
LIMITS OF ACCESS	
POINT OF ACCESS	
FENCE LINE	
STONE WALL	
TRAVELED WAY	
GUARD RAIL	
RAILROAD	
SURVEY LINE	
CULVERT	
POWER POLE	
TELEPHONE POLE	
TREES	
CONTROL OF ACCESS	
PROPERTY LINE	
R.O.W. TAKING LINE	
SLOPE RIGHTS	
TOP OF CUT	
TOE OF SLOPE	

SURVEYED BY : VERMONT SURVEY
 SURVEYED DATE : MAY 2012

DATUM
 VERTICAL NAVD 88 (GEO1D09) FT
 HORIZONTAL NAD 83 (CORS) sFT

PLAN
 SCALE: 1" = 50'
 0 50 100

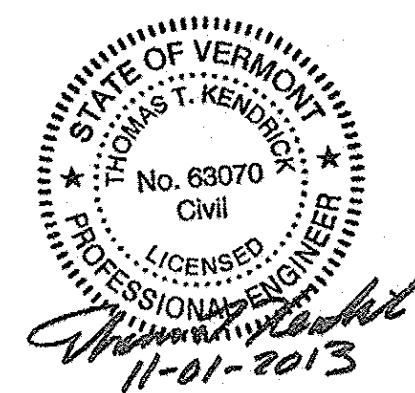

THESE PLANS ARE SUBJECT TO SUCH ENGINEERING CHANGES AS MAY BE REQUIRED BY THE FEDERAL HIGHWAY ADMINISTRATION OR THE DIRECTOR OF PROGRAM DEVELOPMENT.

CONSTRUCTION IS TO BE CARRIED ON IN ACCORDANCE WITH THESE PLANS AND THE STANDARD SPECIFICATIONS FOR CONSTRUCTION DATED 2011, AS APPROVED BY THE FEDERAL HIGHWAY ADMINISTRATION ON JULY 20, 2011 FOR USE ON THIS PROJECT, INCLUDING ALL SUBSEQUENT REVISIONS AND SUCH REVISED SPECIFICATIONS AND SPECIAL PROVISIONS AS ARE INCORPORATED IN THESE PLANS.

DIRECTOR OF PROGRAM DEVELOPMENT	
APPROVED <i>[Signature]</i>	DATE 11-5-13
PROJECT MANAGER : DANNY R. LANDRY, P.E.	
PROJECT NAME : FAIRFIELD	
PROJECT NUMBER : BRO 1448(38)	
SHEET 1 OF 41 SHEETS	

PRELIMINARY INFORMATION SHEET (BRIDGE)

LRFD

INDEX OF SHEETS

FINAL HYDRAULIC REPORT

PLAN SHEETS

1	TITLE SHEET
2	PRELIMINARY INFORMATION SHEET
3-4	TYPICAL SECTIONS 1-2
5	GENERAL NOTES
6-7	QUANTITY SHEETS 1-2
8	BRIDGE QUANTITY SHEET
9	TIE SHEET
10-11	LAYOUT SHEET 1-2
12	PROFILE SHEET
13	EPSC PLAN NARRATIVE
14	EPSC EXISTING CONDITIONS SITE PLAN
15	EPSC CONSTRUCTION SITE PLAN
16	EPSC FINAL CONDITIONS SITE PLAN
17-18	EPSC DETAILS 1-2
19	TRAFFIC CONTROL SHEET
20	BORING INFORMATION SHEET
21-24	BORING LOGS 1-4
25	PLAN AND ELEVATION
26-27	COMPOSITE ARCH SUPERSTRUCTURE 1-2
28	ABUTMENT FOOTING DETAILS
29	ABUTMENT NO. 1 DETAILS
30	ABUTMENT NO. 2 DETAILS
31	WINGWALL DETAILS
32	RETAINING WALL DETAILS
33	REINFORCING STEEL SCHEDULE
34-39	ROADWAY CROSS SECTIONS 1-6
40-41	CHANNEL CROSS SECTIONS 1-2

STANDARDS LIST

B-5	SLOPE GRADING, EMBANKMENTS, MUCK	06-01-1994
B-71	STANDARD FOR RESIDENTIAL AND COMMERCIAL DRIVES	07-08-2005
D-3	TREATED GUTTERS	06-01-1994
T-1	TRAFFIC CONTROL GENERAL NOTES	08-06-2012
T-10	CONVENTIONAL ROADS CONSTRUCTION APPROACH SIGNING	08-06-2012
T-17	TRAFFIC CONTROL MISCELLANEOUS DETAILS	08-06-2012
T-28	CONSTRUCTION SIGN DETAILS	08-06-2012
T-29	CONSTRUCTION SIGN DETAILS	08-06-2012
T-30	CONSTRUCTION SIGN DETAILS	08-06-2012
T-31	CONSTRUCTION SIGN DETAILS	08-06-2012
T-40	DELINEATORS AND MILEPOSTS	01-02-2013
G-1	STEEL BEAM GUARDRAIL DETAILS (POST, DELINEATOR, TYPICALS)	01-03-2000
G-1D	STEEL BEAM GUARDRAIL DETAILS (END TERMINAL, ANCHOR, MEDIAN)	01-03-2000

STRUCTURES DETAILS

SD-501.00	CONCRETE DETAILS AND NOTES	05-07-2000
-----------	----------------------------	------------

HYDROLOGIC DATA Date: JUNE 2012

DRAINAGE AREA : 6.82 sq. mi.
 CHARACTER OF TERRAIN : HILLY TO MOUNTAINOUS
 STREAM CHARACTERISTICS : STRAIGHT WITH LARGE RADIUS BENDS
 NATURE OF STREAMBED : RIVER COBBLES WITH BOULDERS

PEAK FLOW DATA

Q 2.33 =	250 cfs	Q 50 =	900
Q 10 =	560	Q 100 =	1,050
Q 25 =	750	Q 500 =	N/A

DATE OF FLOOD OF RECORD : UNKNOWN
 ESTIMATED DISCHARGE : UNKNOWN
 WATER SURFACE ELEV. : UNKNOWN
 NATURAL STREAM VELOCITY : @ Q25 = 5.5 fps NEAR BRIDGE LOCATION
 ICE CONDITIONS : MODERATE
 DEBRIS : MODERATE
 DOES THE STREAM REACH MAXIMUM HIGHWATER ELEV. RAPIDLY? YES
 IS ORDINARY RISE RAPID? YES
 IS STAGE AFFECTED BY UPSTREAM OR DOWNSTREAM CONDITIONS? NO
 IF YES, DESCRIBE :

WATERSHED STORAGE : < 0.25% HEADWATERS:
 UNIFORM : X
 IMMEDIATELY ABOVE SITE :

EXISTING STRUCTURE INFORMATION

STRUCTURE TYPE : SINGLE SPAN ROLLED BEAM WITH TIMBER DECK
 YEAR BUILT : 1919
 CLEAR SPAN(NORMAL TO STREAM): 17'
 VERTICAL CLEARANCE ABOVE STREAMBED: 12'
 WATERWAY OF FULL OPENING: 250 sq. ft.
 DISPOSITION OF STRUCTURE : STRUCTURE REPLACEMENT
 TYPE OF MATERIAL UNDER SUBSTRUCTURE : UNKNOWN

WATER SURFACE ELEVATIONS AT:

Q2.33 =	463.8'	VELOCITY =	7.8 fps
Q10 =	465.8'	"	10.0 fps
Q25 =	466.7'	"	10.4 fps
Q50 =	467.4'	"	11.0 fps
Q100 =	468.0'	"	11.6 fps

LONG TERM STREAMBED CHANGES : NONE NOTED

IS THE ROADWAY OVERTOPPED BELOW Q100: NO
 FREQUENCY: N/A
 RELIEF ELEVATION: 476.6'
 DISCHARGE OVER ROAD @Q100: 0

UPSTREAM STRUCTURE

TOWN: FAIRFIELD DISTANCE: 5,200' +/-
 HIGHWAY #: S0792 - TH 2 STRUCTURE #: ----
 CLEAR SPAN: UNKNOWN CLEAR HEIGHT: ----
 YEAR BUILT: UNKNOWN FULL WATERWAY: ----
 STRUCTURE TYPE: CULVERT

DOWNSTREAM STRUCTURE

TOWN: FAIRFIELD DISTANCE: 10,700' +/-
 HIGHWAY #: TH 29 STRUCTURE #: BR 49
 CLEAR SPAN: UNKNOWN CLEAR HEIGHT: UNKNOWN
 YEAR BUILT: UNKNOWN FULL WATERWAY: UNKNOWN
 STRUCTURE TYPE: UNKNOWN

LRFR LOAD RATING FACTORS

LOADING LEVELS	TRUCK						
	H-20	HL-93	3S2	6 AXLE	3A. STR	4A. STR	5A. SEMI
TONNAGE							
INVENTORY							
POSTING							
OPERATING							
COMMENTS:	LOAD RATING TO BE COMPLETED BY FABRICATOR						

AS BUILT "REBAR" DETAIL

LEVEL I	LEVEL II	LEVEL III
TYPE:	TYPE:	TYPE:
GRADE:	GRADE:	GRADE:

PROPOSED STRUCTURE

STRUCTURE TYPE: RIGIFIED FIBER REINFORCED POLYMER TUBULAR ARCH (RFTA)
 CLEAR SPAN(NORMAL TO STREAM): 31.3'
 VERTICAL CLEARANCE ABOVE STREAMBED: 15.5' AT CREST OF ARCH
 WATERWAY OF FULL OPENING: 398 sq. ft.

WATER SURFACE ELEVATIONS AT:

Q2.33 =	464.0'	VELOCITY=	3.2 fps
Q10 =	465.6'	"	4.8 fps
Q25 =	466.2'	"	5.5 fps
Q50 =	466.7'	"	6.1 fps
Q100 =	467.1'	"	6.6 fps

IS THE ROADWAY OVERTOPPED BELOW Q100: NO
 FREQUENCY: N/A
 RELIEF ELEVATION: 480.7'
 DISCHARGE OVER ROAD @Q100: 0

AVERAGE LOW ELEVATION OF SUPERSTRUCTURE: 474.0' AT CREST OF ARCH
 VERTICAL CLEARANCE: @ Q25 = 7.8' AT CREST OF ARCH

SCOUR: CONTRACTION SCOUR CALCULATED AS 0.0 FOR 100-YEAR STORM EVENT
 REQUIRED CHANNEL PROTECTION: STONE FILL, TYPE II

PERMIT INFORMATION

AVERAGE DAILY FLOW: 14 cfs DEPTH OR ELEVATION:
 ORDINARY LOW WATER: 7 cfs DEPTH = 0.5 FT
 ORDINARY HIGH WATER: 107 cfs DEPTH = 2.0 FT

TEMPORARY BRIDGE REQUIREMENTS

STRUCTURE TYPE: NOT REQUIRED
 CLEAR SPAN (NORMAL TO STREAM):
 VERTICAL CLEARANCE ABOVE STREAMBED:
 WATERWAY AREA OF FULL OPENING:

ADDITIONAL INFORMATION

SEE CHANNEL CROSS SECTIONS FOR ESTIMATED OHW

TRAFFIC MAINTENANCE NOTES

1. MAINTAIN TRAFFIC ON AN OFF SITE DETOUR.
2. TRAFFIC SIGNALS ARE NOT NECESSARY.
3. SIDEWALKS ARE NOT NECESSARY

DESIGN VALUES


1. DESIGN LIVE LOAD	HL-93
2. FUTURE PAVEMENT	dp: ---
3. DESIGN SPAN	L: 36.18 FT
4. MIN. MID-SPAN POS. CAMBER @ RELEASE (PRESTRESSED UNITS)	Δ: ---
5. PRESTRESSING STRAND	fy: ---
6. PRESTRESSED CONCRETE STRENGTH	f'c: ---
7. PRESTRESSED CONCRETE RELEASE STRENGTH	f'ci: ---
8. CONCRETE, HIGH PERFORMANCE CLASS AA	f'c: ---
9. CONCRETE, HIGH PERFORMANCE CLASS A	f'c: ---
10. CONCRETE, HIGH PERFORMANCE CLASS B	f'c: 3.5 KSI
11. CONCRETE, CLASS C	f'c: ---
12. REINFORCING STEEL	fy: 60 KSI
13. STRUCTURAL STEEL AASHTO M270	fy: ---
14. SOIL UNIT WEIGHT	γ: 0.125 KCF
15. NOMINAL BEARING RESISTANCE OF SOIL	qn: 22.2 KSF
16. SOIL BEARING RESISTANCE FACTOR (REFER TO AASHTO LRFD)	φ: 0.45
17. NOMINAL BEARING RESISTANCE OF ROCK	qn: ---
18. ROCK BEARING RESISTANCE FACTOR (REFER TO AASHTO LRFD)	φ: ---
19. NOMINAL AXIAL PILE RESISTANCE	qp: ---
20. PILE YIELD STRENGTH ASTM A572	fy: ---
21. PILE SIZE	Lp: ---
22. EST. PILE LENGTH	Lp: ---
23. PILE RESISTANCE FACTOR	φ: ---
24. LATERAL PILE DEFLECTION	Δ: ---
25. BASIC WIND SPEED	V3s: ---
26. MINIMUM GROUND SNOW LOAD	pg: ---
27. SEISMIC DATA	PGA: --- Ss: --- S1: ---

PROJECT NAME: FAIRFIELD
 PROJECT NUMBER: BRO 1448(38)


FILE NAME: z11j072pl_01.xls PLOT DATE: 10/30/2013
 PROJECT LEADER: D. LANDRY DRAWN BY: W. GAYNOR
 DESIGNED BY: E. ALEXOPOULOS CHECKED BY: T. KENDRICK
 PRELIMINARY INFORMATION SHEET SHEET 2 OF 41

TRAFFIC DATA


YEAR	ADT	DHV	% D	% T	ADTT	20 year ESAL for flexible pavement from 2015 to 2035 : 110000
2013	110	25	55	26	25	40 year ESAL for flexible pavement from 2015 to 2055 : 211000
2033	120	25	55	23	25	Design Speed : 35 mph

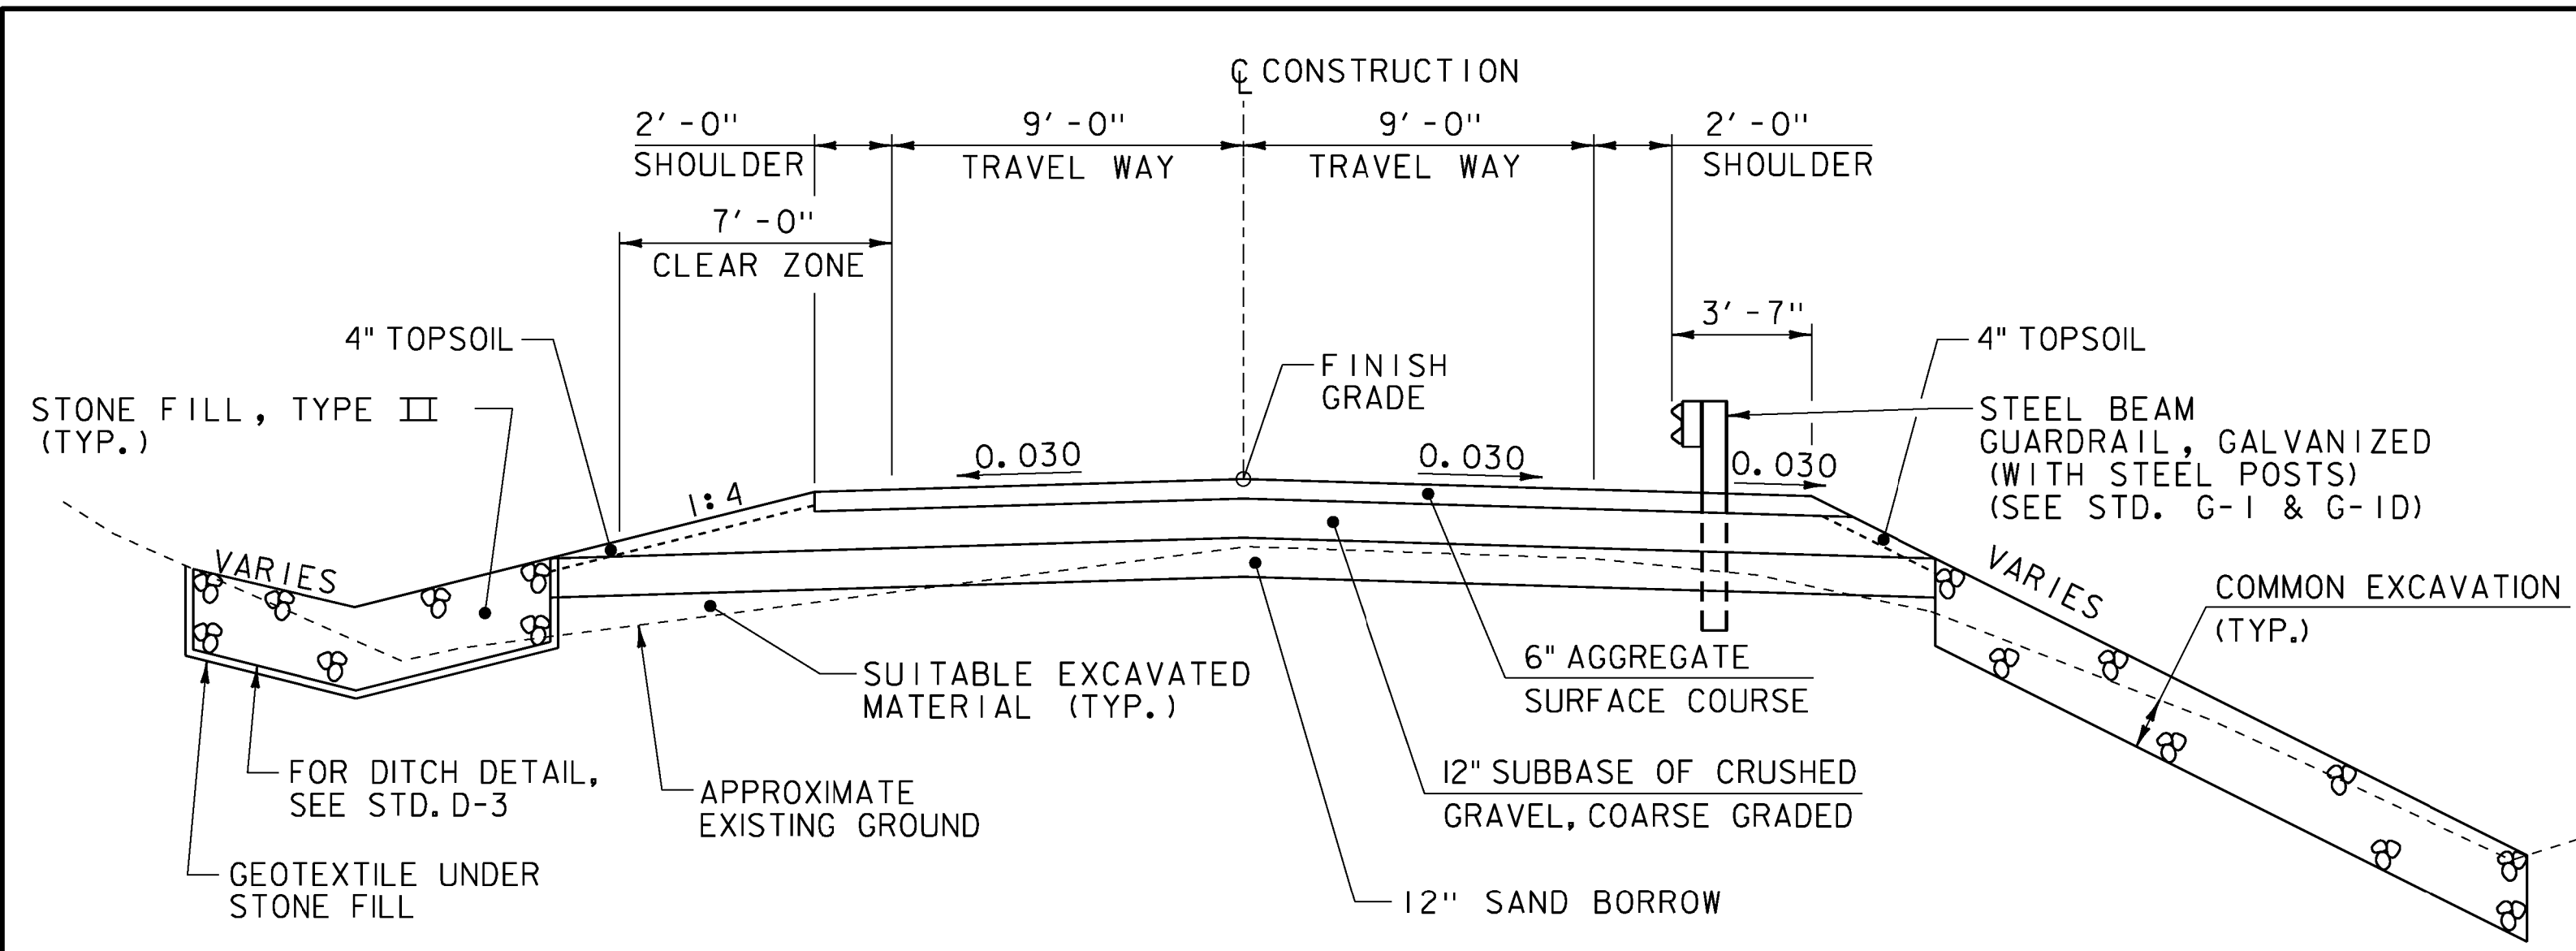

TYPICAL ROADWAY SECTION
SCALE 1/4" = 1'-0"

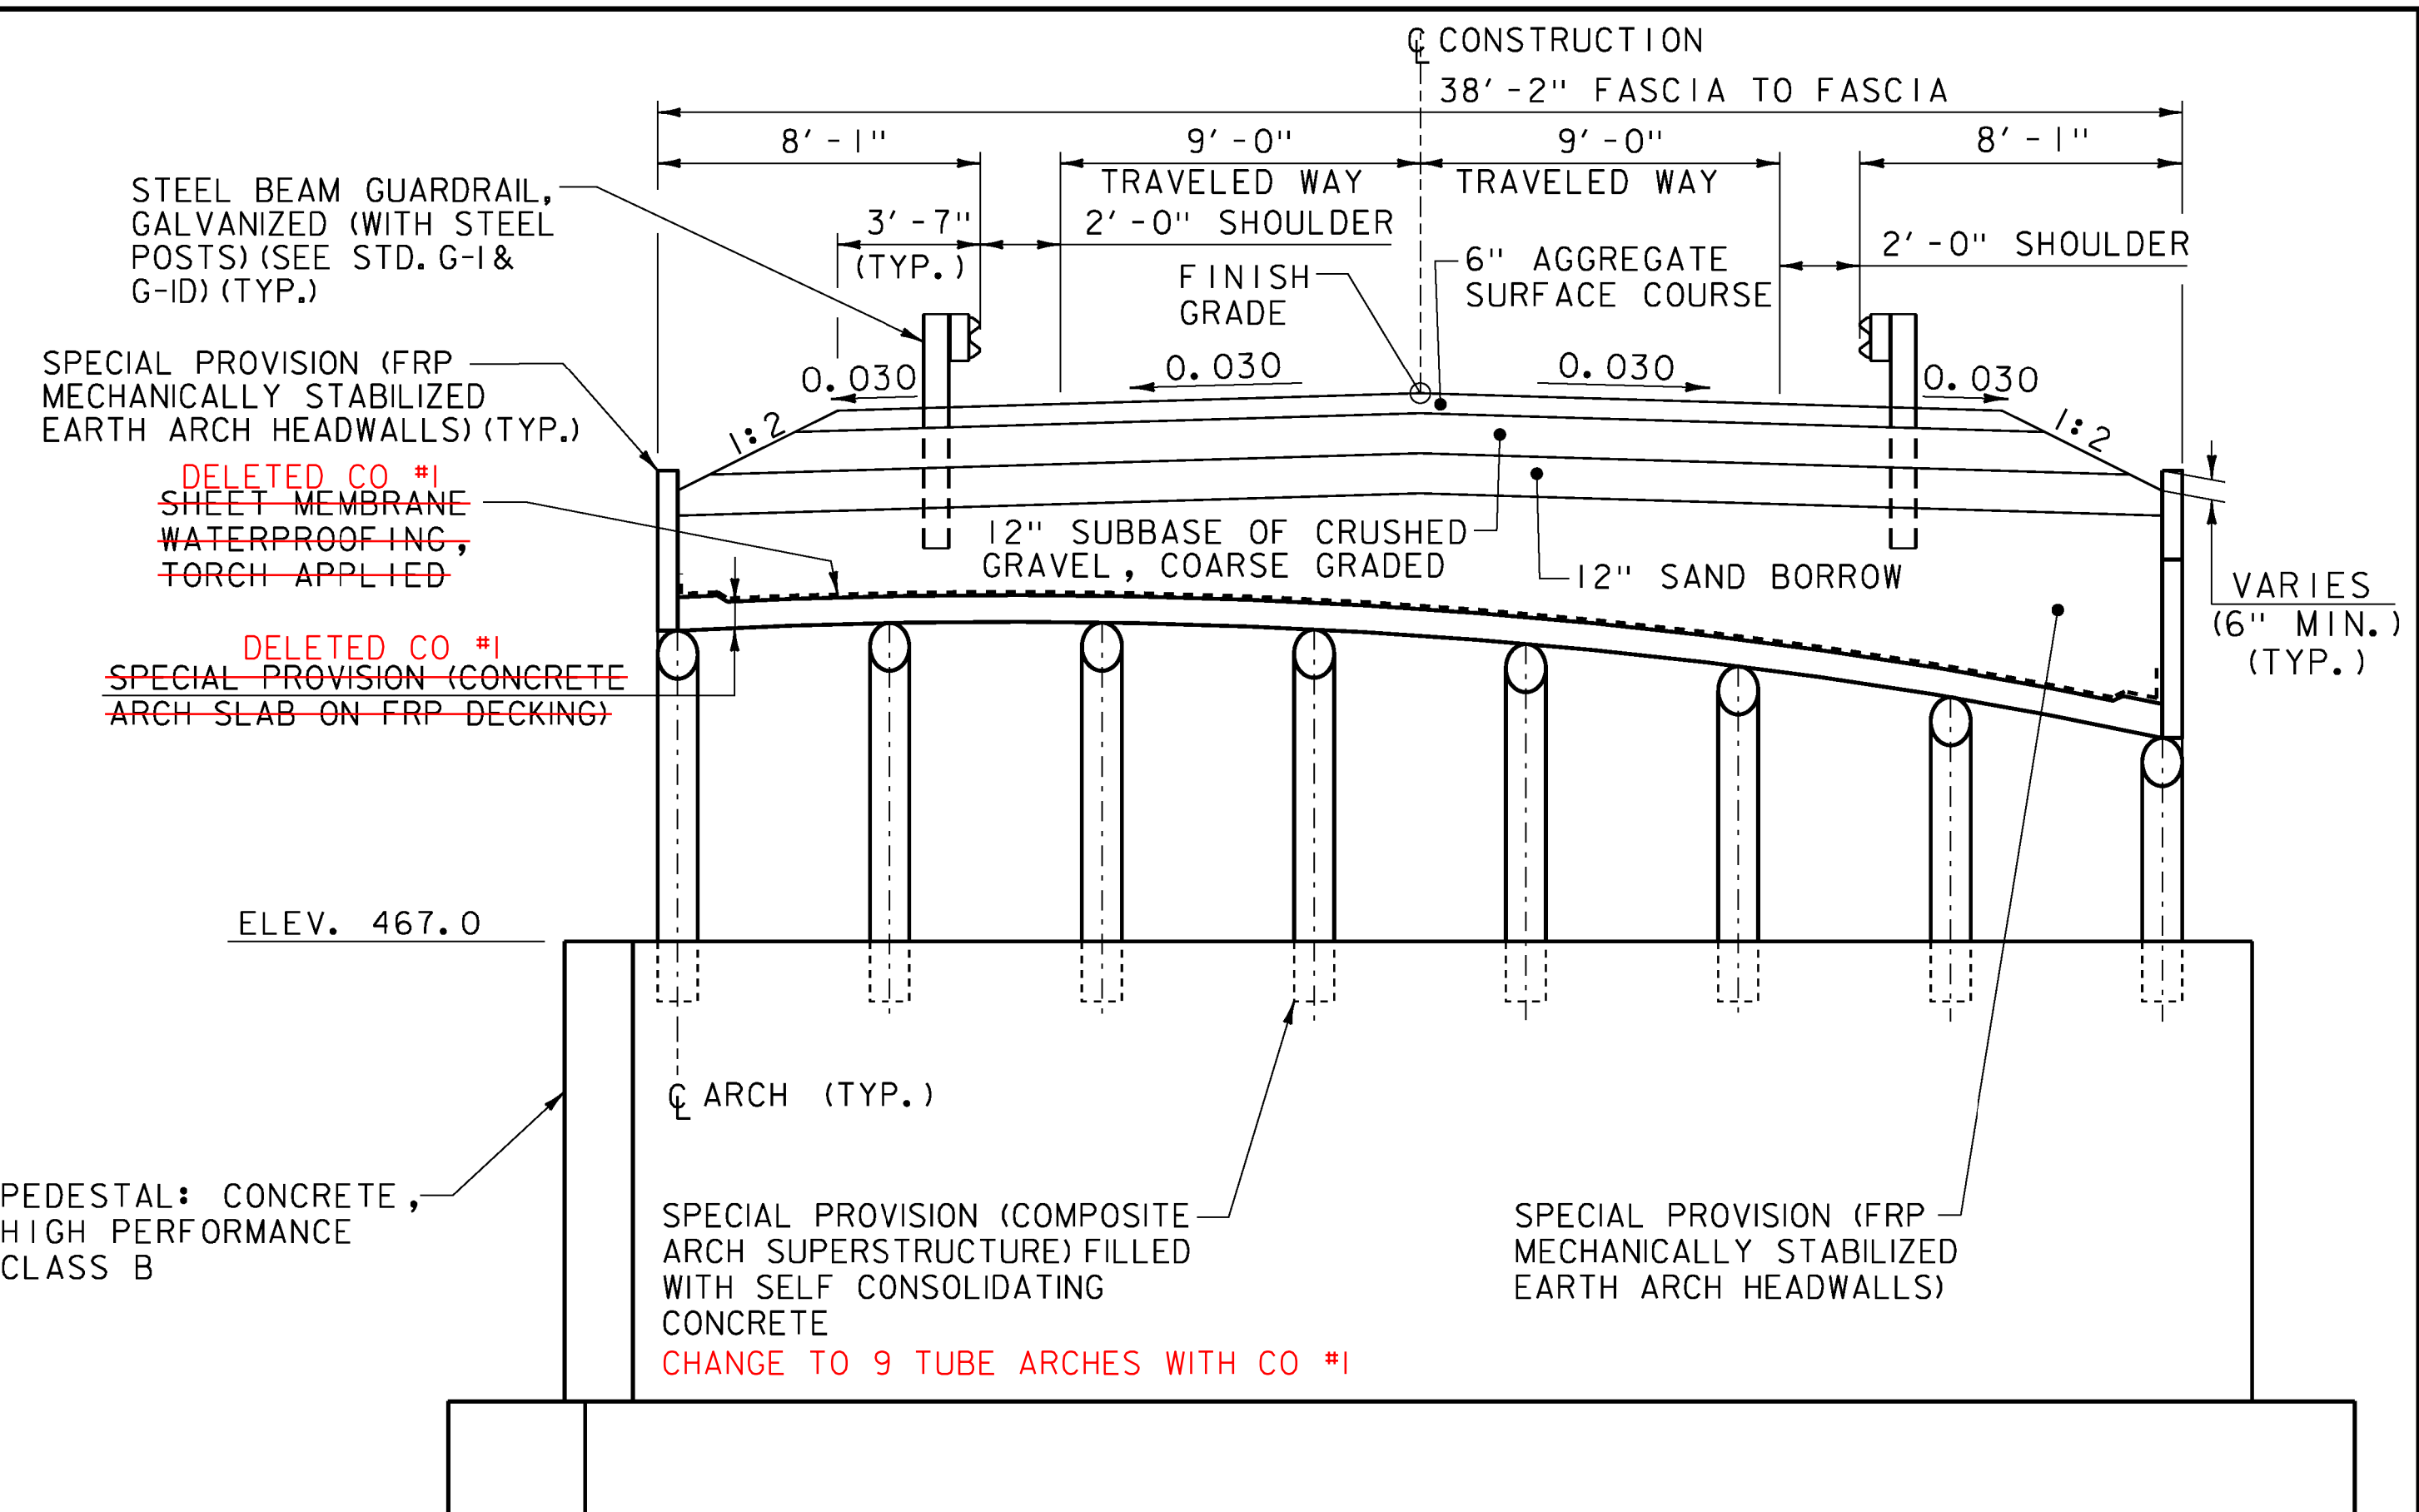

**TYPICAL BRIDGE SECTION
(NORMAL TO CONSTRUCTION)**
SCALE 1/4" = 1'-0"

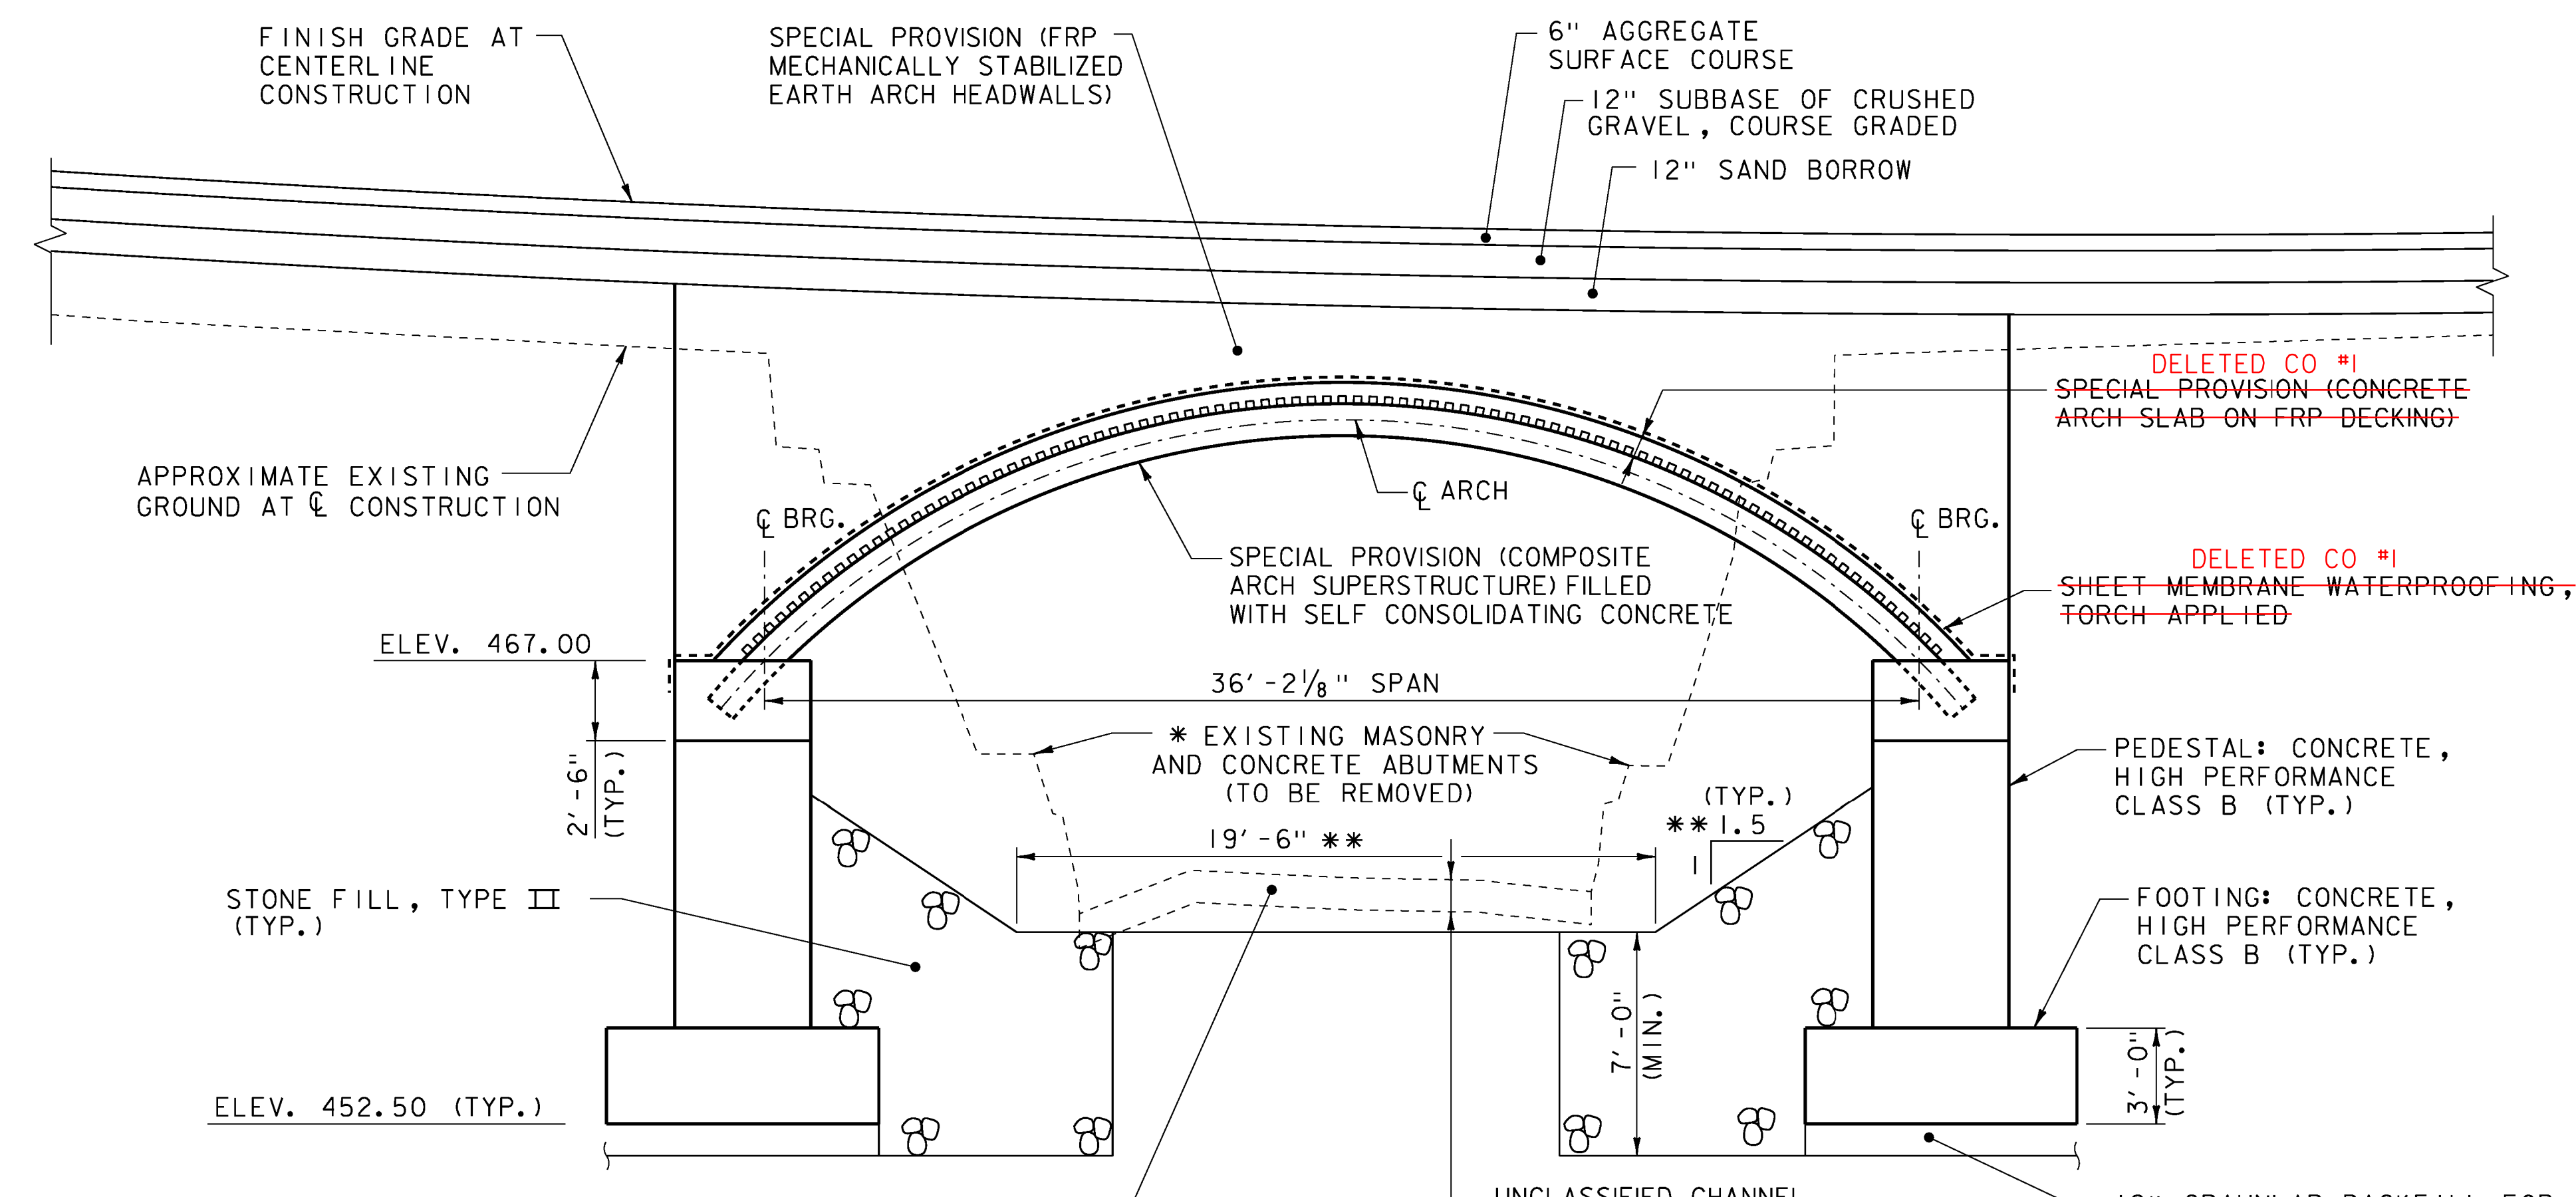


LONGITUDINAL SECTION
SCALE 1/4" = 1'-0"


* SIZE AND DEPTH OF EXISTING ABUTMENTS ARE UNKNOWN. REMOVAL COST INCLUDED IN COFFERDAM EXCAVATION, ROCK.
** DIMENSION AND SLOPE PERPENDICULAR TO CHANNEL BASELINE.

PROJECT NAME: FAIRFIELD	PLOT DATE: 01-NOV-2013
PROJECT NUMBER: BRO 1448(38)	DRAWN BY: W. GAYNOR
FILE NAME: z11j072+typ.dgn	DESIGNED BY: E. ALEXOPOULOS
	CHECKED BY: T. KENDRICK
TYPICAL SECTIONS (1 OF 2)	SHEET 3 OF 41



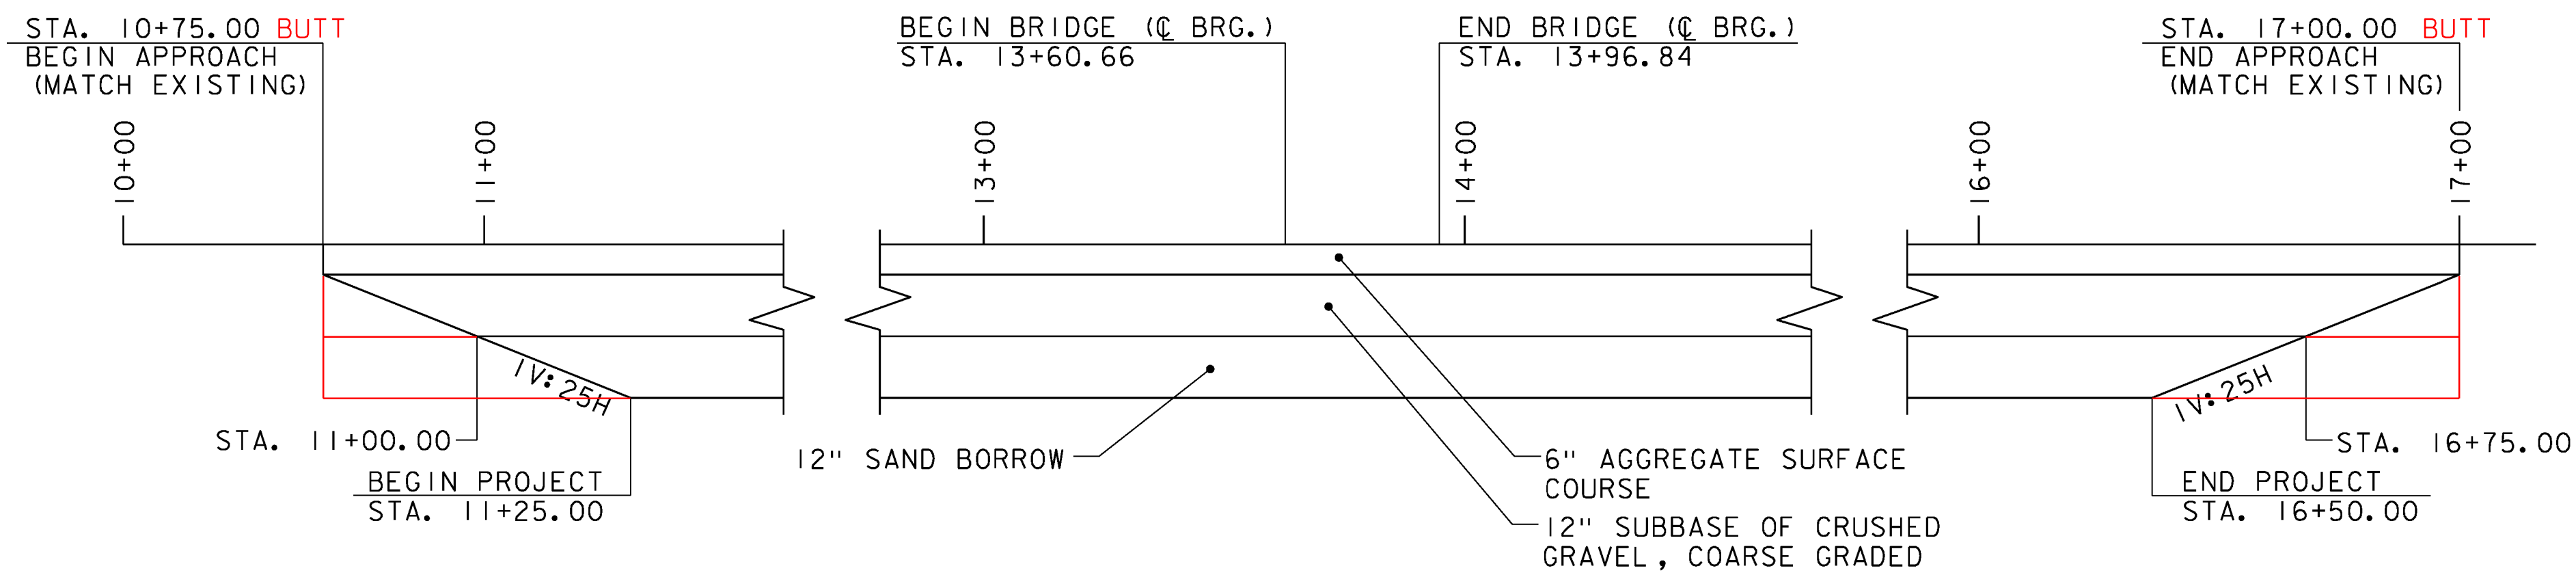


SUBBASE TRANSITION DETAIL
NOT TO SCALE

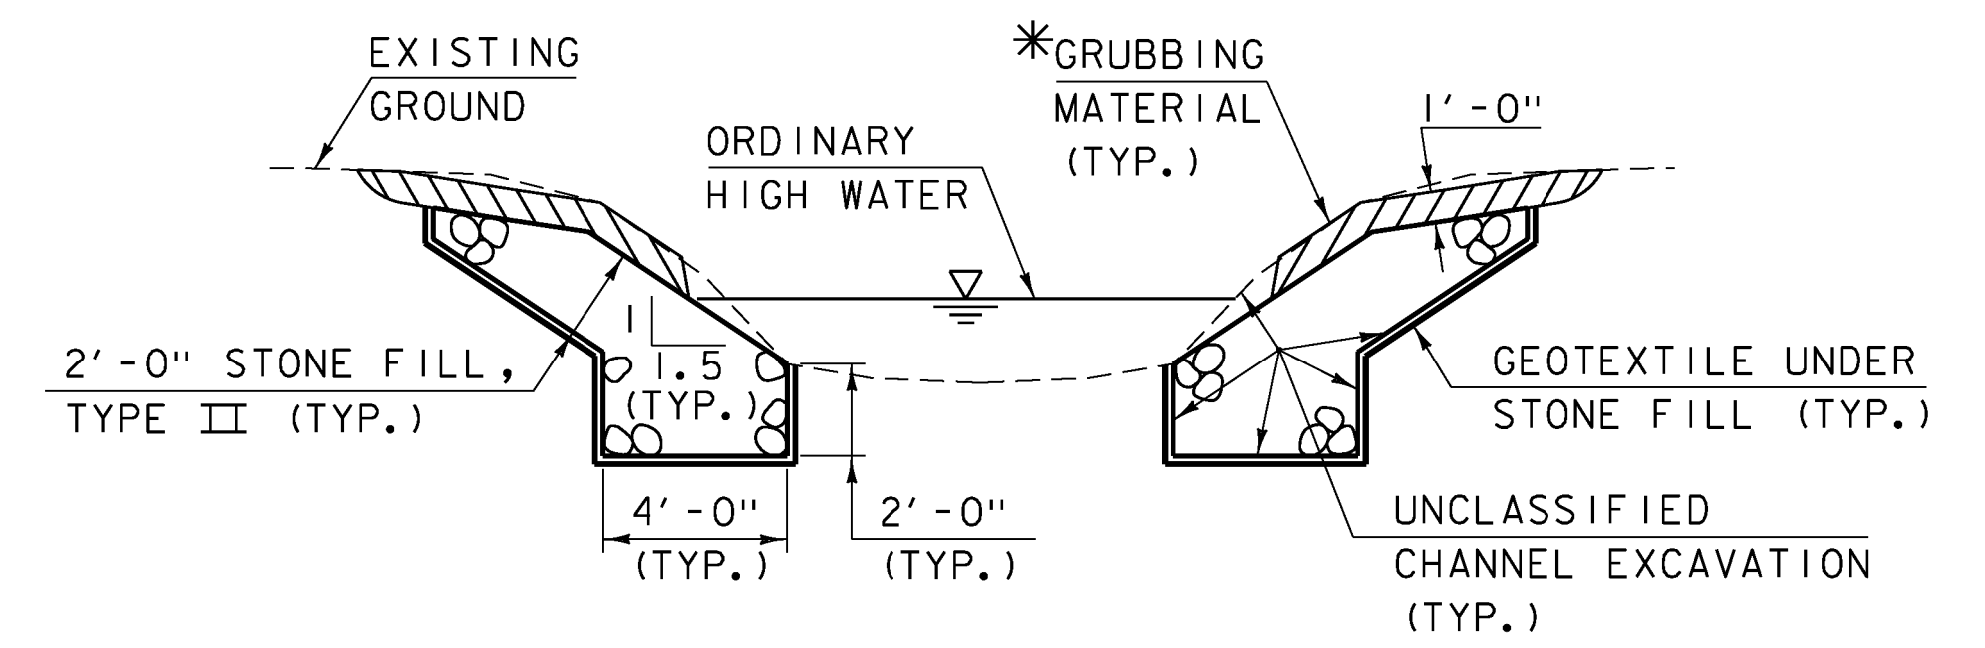

TYPICAL CHANNEL SECTION
NOT TO SCALE


*GRUBBING MATERIAL SHALL NOT BE PLACED ON THE STONE FILL IN THE AREA UNDER THE BRIDGE. WHENEVER CHANNEL SLOPE INTERSECTS ROADWAY SUBBASE, GRUBBING MATERIAL SHALL BEGIN AT THE BOTTOM OF SUBBASE.

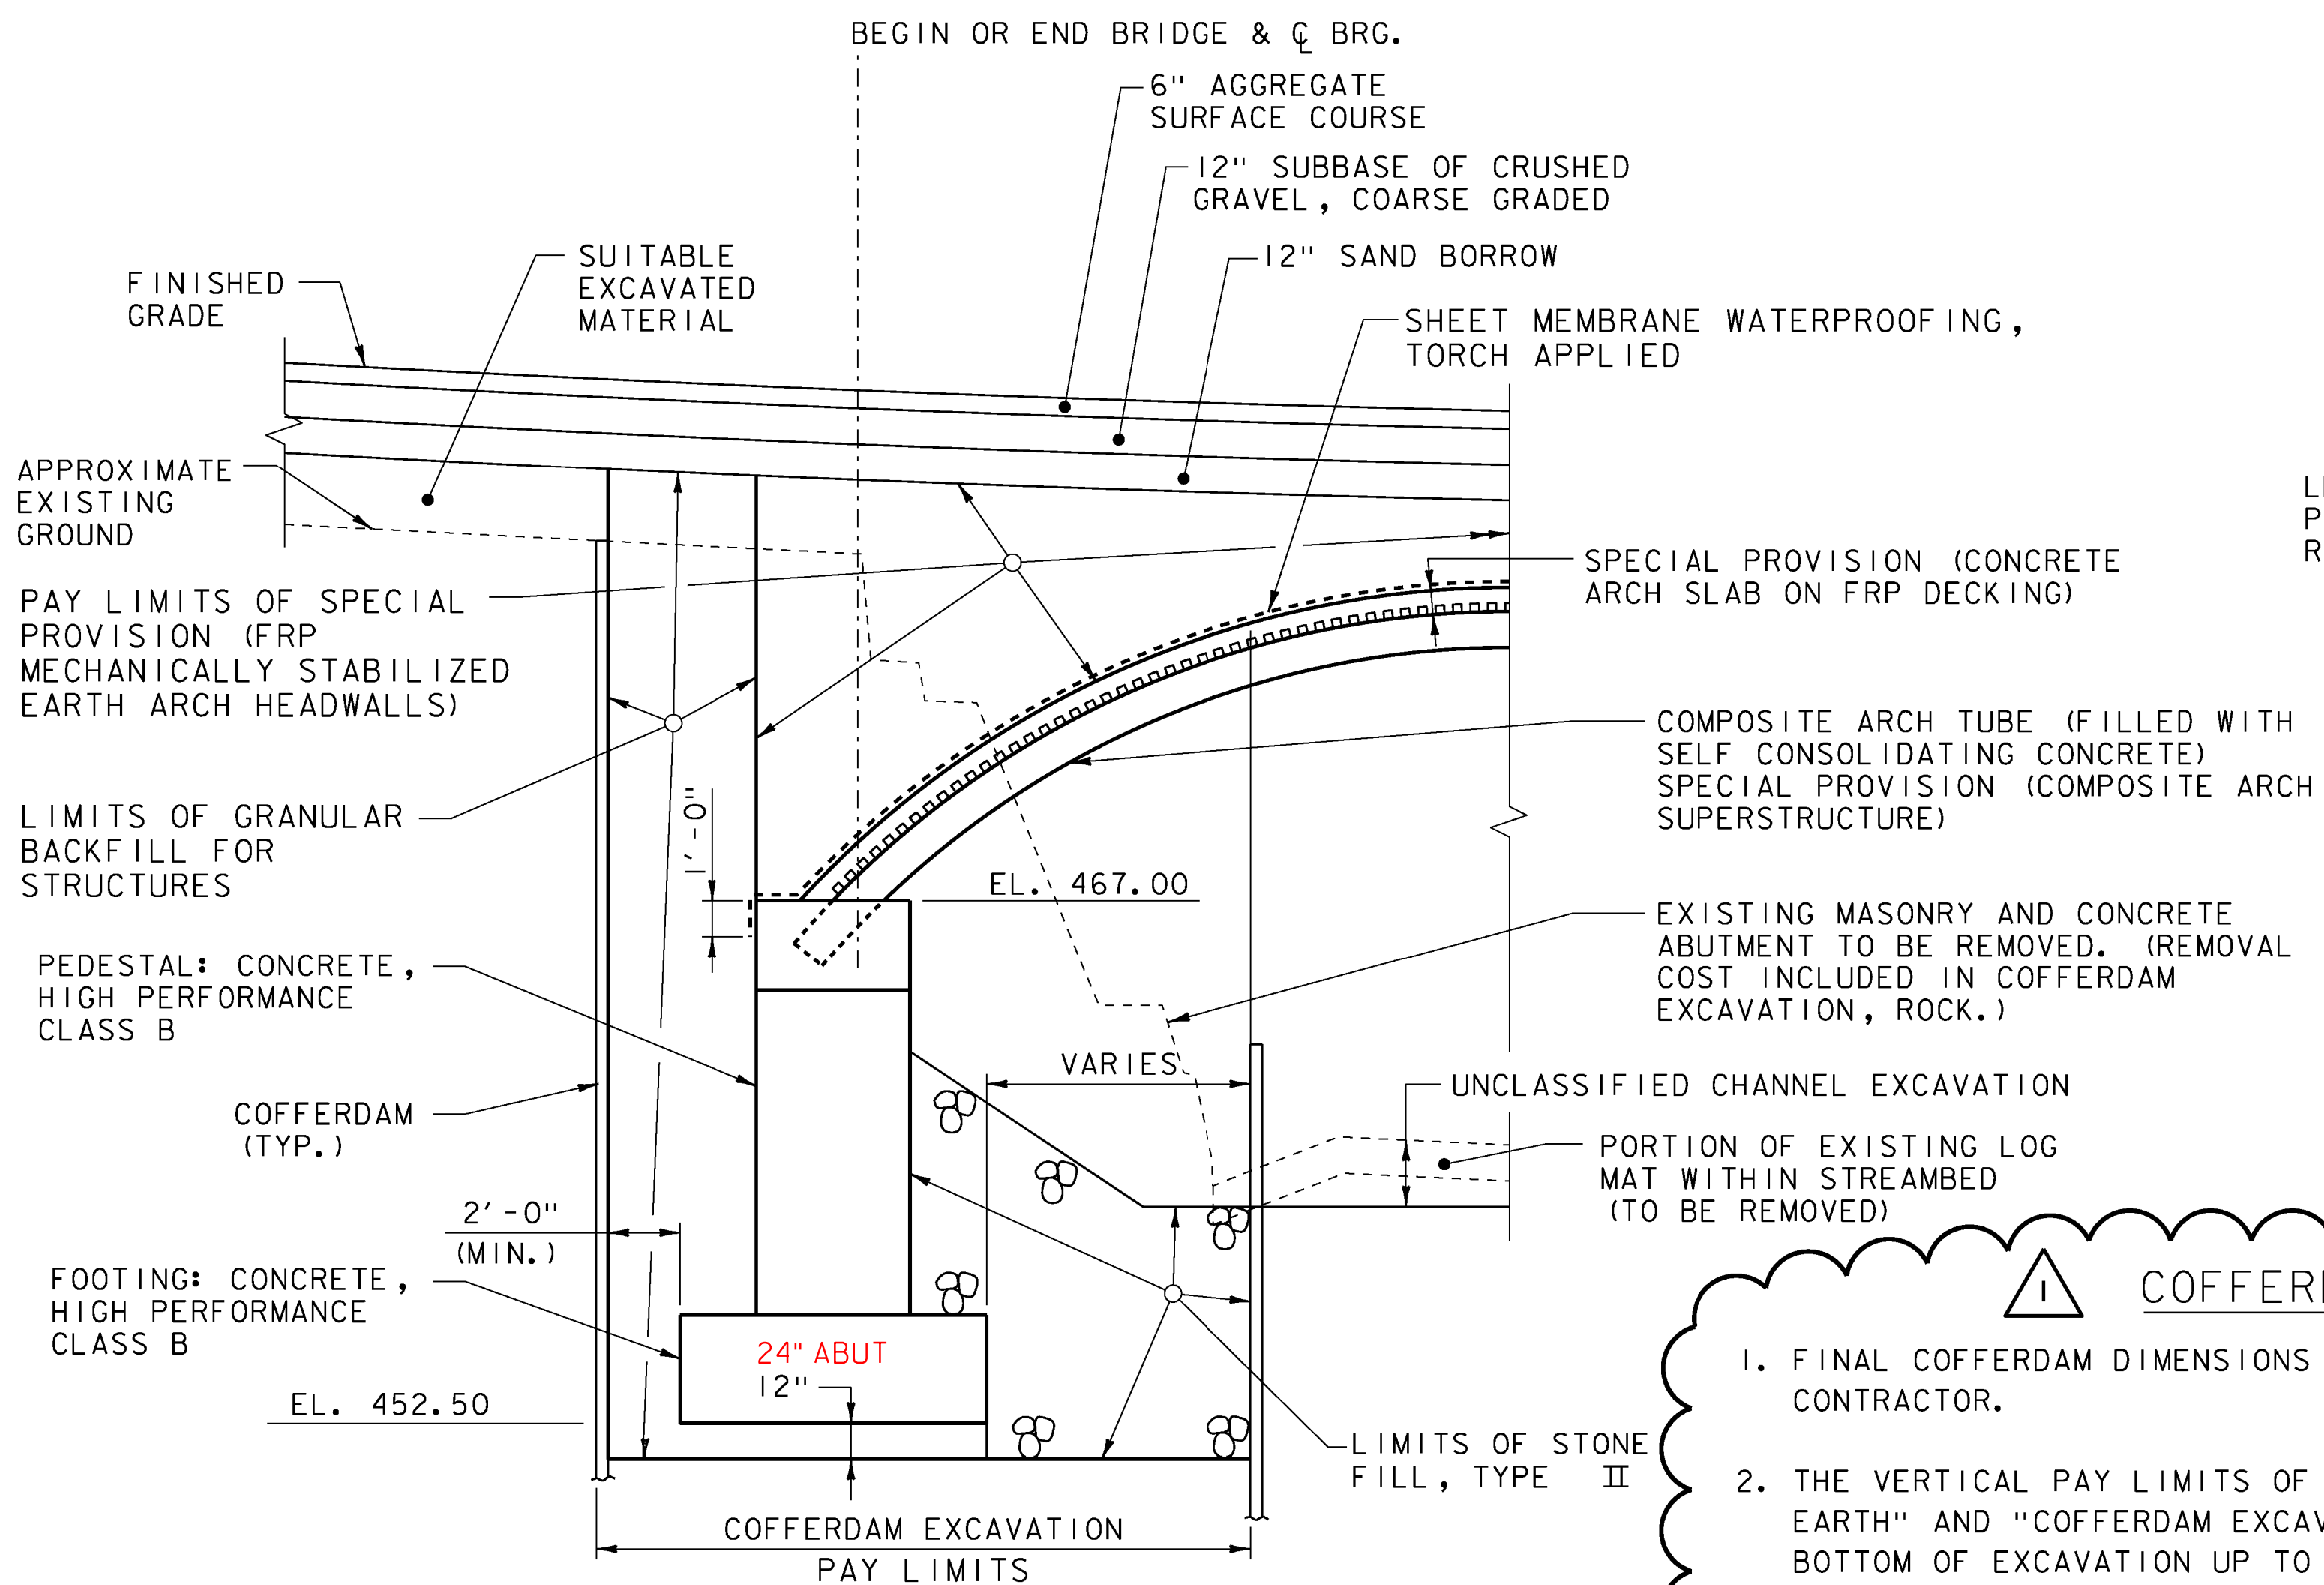

TYPICAL ABUTMENT EARTHWORK SECTION
SCALE 1/4" = 1'-0"

MATERIAL TOLERANCE TABLE

MATERIAL ITEM	TOLERANCE
AGGREGATE SURFACE COURSE	± 1/2"
SUBBASE	± 1"
SAND BORROW	± 1"

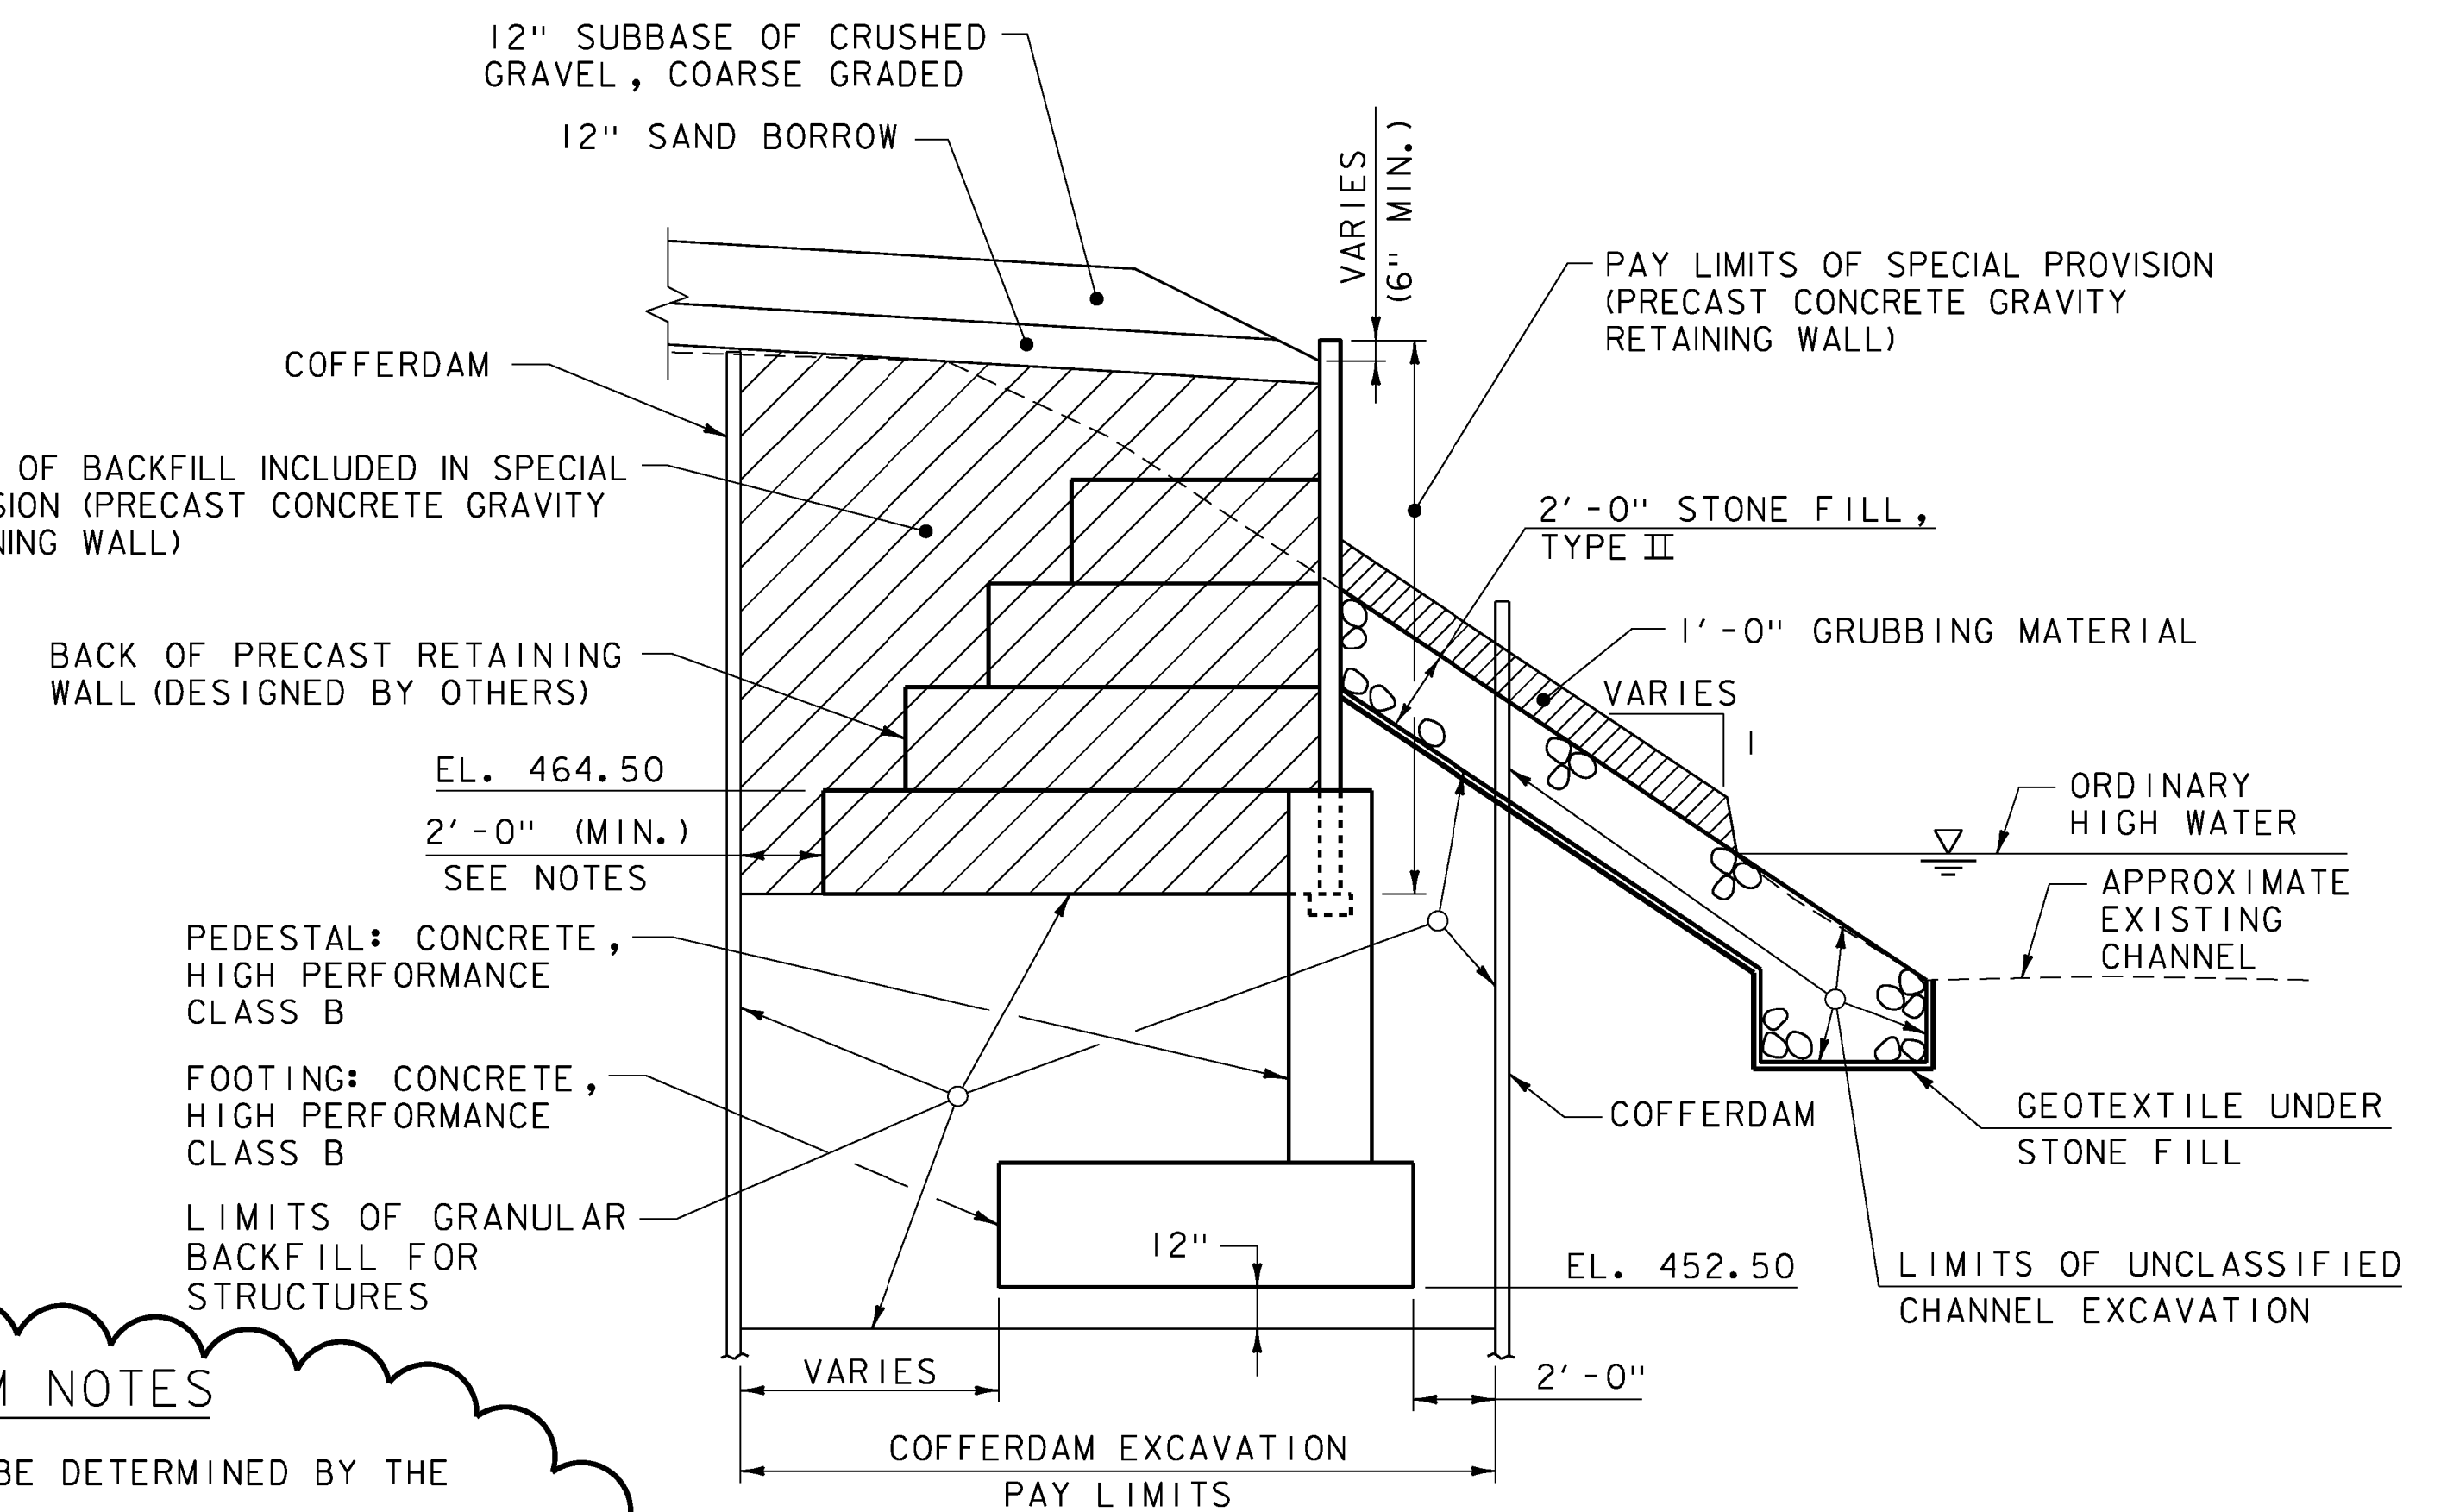

TYPICAL WINGWALL EARTHWORK SECTION
SCALE 1/4" = 1'-0"

COFFERDAM NOTES

1. FINAL COFFERDAM DIMENSIONS TO BE DETERMINED BY THE CONTRACTOR.
2. THE VERTICAL PAY LIMITS OF EITHER "COFFERDAM EXCAVATION, EARTH" AND "COFFERDAM EXCAVATION, ROCK" SHALL BE FROM BOTTOM OF EXCAVATION UP TO THE EXISTING GROUND OR BOTTOM OF SUBBASE, WHICHEVER IS LOWER.
3. IF A COFFERDAM IS CONSTRUCTED WHICH IS LARGER THAN THE INDICATED COFFERDAM EXCAVATION PAY LIMITS, PAYMENT FOR ALL UNCLASSIFIED CHANNEL EXCAVATION, INCLUDING THAT PORTION WHICH IS INSIDE THE COFFERDAM BUT OUTSIDE THE COFFERDAM PAY LIMITS, WILL BE MADE AT THE CONTRACT UNIT PRICE FOR UNCLASSIFIED CHANNEL EXCAVATION. NO MEASUREMENT AND PAYMENT WILL BE MADE FOR COFFERDAM EXCAVATION AND GRANULAR BACKFILL FOR STRUCTURES OUTSIDE THE PAY LIMITS DETAILED ON SHEET 15.
4. FOR PAY LIMITS OF COFFERDAMS, SEE SHEET 15 AND SUBSTRUCTURE NOTE 4 ON SHEET 5.

REVISIONS AFTER PROPOSAL

△ COFFERDAM NOTES REVISED 12/13

PROJECT NAME: FAIRFIELD
PROJECT NUMBER: BRO 1448(38)
FILE NAME: z1j072exc_01.dgn
PROJECT LEADER: D. LANDRY
DESIGNED BY: E. ALEXOPOULOS
TYPICAL SECTIONS (2 OF 2)
PLOT DATE: 05-DEC-2013
DRAWN BY: W. GAYNOR
CHECKED BY: T. KENDRICK
SHEET 4 OF 41

GENERAL NOTES

GENERAL NOTES

1. ALL MATERIALS AND CONSTRUCTION SHALL CONFORM TO STATE OF VERMONT, AGENCY OF TRANSPORTATION'S STANDARD SPECIFICATIONS FOR CONSTRUCTION, DATED 2011, AND ITS LATEST REVISIONS, AND THE AASHTO STANDARD SPECIFICATIONS FOR HIGHWAY BRIDGES, LRFD FIFTH EDITION, DATED 2010 AND ITS LATEST REVISIONS.
2. DESIGN IS FOR AN HL-93 LIVE LOADING.
3. ITEM 529.15 "REMOVAL OF STRUCTURE" SHALL BE USED FOR THE REMOVAL OF THE EXISTING STEEL GIRDER SUPERSTRUCTURE AND ANY PORTIONS OF THE SUBSTRUCTURE NOT REMOVED UNDER THE ITEM "COFFERDAM EXCAVATION, ROCK".
4. THE EXISTING STEEL GIRDERS TO BE REMOVED ARE PAINTED WITH A MATERIAL THAT MAY CONTAIN LEAD. ALL EXISTING STEEL REMOVED UNDER THIS PROJECT IS THE PROPERTY OF THE CONTRACTOR. THE CONTRACTOR MAY DISPOSE OF THE STEEL OR RETAIN IT FOR FUTURE REUSE. THE CONTRACTOR SHALL INFORM THE RESIDENT ENGINEER OF THE CONTRACTOR'S PLAN FOR THE STEEL PRIOR TO ITS REMOVAL.
5. RECORD PLANS FOR THE EXISTING BRIDGE ARE NOT AVAILABLE.
6. FOR TRAFFIC CONTROL NOTES, SEE SHEET 19.

REINFORCED CONCRETE NOTES

1. REINFORCING STEEL SHALL CONFORM TO THE REQUIREMENTS OF SECTION 507 FOR LEVEL 1 PLAIN REINFORCING AND SHALL BE DETAILED AND FABRICATED USING PROCEDURES AND TOLERANCES IN ACCORDANCE WITH APPLICABLE PUBLICATIONS OF THE "CONCRETE REINFORCING STEEL INSTITUTE" (CRSI).
2. THE MINIMUM CONCRETE COVER FOR REINFORCING STEEL SHALL BE TWO (2) INCHES ALONG WALL FACES AGAINST EARTH AND THREE (3) INCHES ELSEWHERE, UNLESS NOTED OTHERWISE.
3. REINFORCING PLACEMENT TOLERANCES SHALL BE:
SPACING: +/- ONE INCH
CLEARANCE: +/- ONE-QUARTER INCH
4. ALL ABUTMENT CONCRETE SHALL BE CONCRETE, HIGH PERFORMANCE CLASS B.
5. THE KEY IN CONCRETE CONSTRUCTION JOINTS SHALL BE MONOLITHIC AND CONTINUOUS FOR THE FULL LENGTH OF THE JOINT.
6. JOINTS AND SCORE MARKS IN THE CONCRETE SHALL BE CONSTRUCTED AS INDICATED ON THE PLANS OR AS DIRECTED BY THE ENGINEER.
7. ALL EXPOSED EDGES OF CONCRETE SHALL BE CHAMFERED 1 INCH BY 1 INCH UNLESS NOTED OTHERWISE.
8. "WATER REPELLANT, SILANE", SHALL BE APPLIED TO ALL EXPOSED NEW CONCRETE SURFACES.

SUPERSTRUCTURE NOTES

1. ITEM 900.645, SPECIAL PROVISION (COMPOSITE ARCH SUPERSTRUCTURE), SHALL INCLUDE, BUT IS NOT LIMITED TO:

RIGIFIED FIBER REINFORCED POLYMER TUBULAR ARCHES (RFTA)
EXPANSIVE SELF CONSOLIDATING CONCRETE (SCC) FILL INSIDE THE TUBES
2. ITEM 900.670, SPECIAL PROVISION (FRP MECHANICALLY STABILIZED EARTH ARCH HEADWALLS), SHALL INCLUDE, BUT IS NOT LIMITED TO:

VOIDED FRP MSE HEADWALL PANELS
FRP CURVED FASCIA PLATES
FRP GEOGRID REINFORCEMENT
SELECT BACKFILL MATERIAL
UNDERDRAIN AND DRAINAGE ELEMENTS
3. ITEM 900.645 SPECIAL PROVISION (CONCRETE ARCH SLAB ON FRP DECKING), SHALL INCLUDE, BUT IS NOT LIMITED TO:

CORRUGATED FRP DECKING
SLAB REINFORCEMENT
CONCRETE (ARCH) SLAB
4. THE MANUFACTURER SHALL DESIGN THE BRIDGE SUPERSTRUCTURE, INCLUDING (BUT NOT LIMITED TO) THE COMPOSITE ARCH TUBES, FIBER REINFORCED POLYMER FRP DECKING, REINFORCED CONCRETE SLAB, AND VOIDED FRP MSE HEADWALLS. THE MANUFACTURER SHALL PROVIDE STAMPED DESIGN CALCULATIONS PREPARED BY A PROFESSIONAL ENGINEER REGISTERED IN THE STATE OF VERMONT. THE MANUFACTURER SHALL CONSIDER STRENGTH, STIFFNESS, AND STABILITY OF THE PREFABRICATED ELEMENTS FOR LOADS GENERATED DURING FABRICATION, TRANSPORTATION, ERECTION, CONSTRUCTION OPERATIONS, AND ULTIMATE TRAFFIC CONDITIONS. THE MANUFACTURER SHALL OBTAIN WRITTEN APPROVAL OF THE FABRICATION DRAWINGS FROM THE STRUCTURES ENGINEER PRIOR TO FABRICATION.
5. THE MANUFACTURER SHALL SUPPLY LOAD RATINGS FOR THE SUPERSTRUCTURE BASED ON VERMONT'S SEVEN STANDARD TRUCKS. COMPLETED LOAD RATING TABLE AND CALCULATIONS SHALL BE INCLUDED WITH THE FABRICATION DRAWINGS AND SIGNED, STAMPED AND DATED BY A PROFESSIONAL ENGINEER REGISTERED IN THE STATE OF VERMONT.
6. THE CONTRACTOR SHALL FURNISH DETAILS, PROCEDURES, AND CALCULATIONS FOR PLACEMENT OF THE SELF CONSOLIDATING CONCRETE (SCC), INCLUDING (BUT NOT LIMITED TO) STANDPIPES AND SUPPORT FRAMING, FOR APPROVAL BY THE RESIDENT ENGINEER PRIOR TO PLACEMENT OF THE ABUTMENT CLOSURE POUR.
7. FABRICATION DRAWINGS SHALL BE SUBMITTED (5 WEEKS PRIOR TO FABRICATION OF THE SUPERSTRUCTURE) TO THE ENGINEER IN ACCORDANCE WITH STANDARD SPECIFICATION SUBSECTION 105.03(B).
8. THE CONTRACTOR SHALL FOLLOW THE MANUFACTURER'S REQUIREMENTS REGARDING BACKFILL AND COMPACTION LIMITS, PROPERTIES, AND PROCEDURES, INCLUDING RESTRICTIONS OF CONSTRUCTION MACHINERY AND OPERATIONS.
9. LIVE LOAD DEFLECTION SHALL BE LIMITED TO L/1000.

SUBSTRUCTURE NOTES

1. ITEM 900.670, SPECIAL PROVISION (PRECAST CONCRETE GRAVITY RETAINING WALL) (PCGRW) SHALL INCLUDE, BUT IS NOT LIMITED TO:

PRECAST MODULAR WALL UNITS
CONCRETE BEARING PADS
BACKFILL MATERIAL
2. BEARING RESISTANCE FOR PCGRW SHALL BE INVESTIGATED AT THE STRENGTH LIMIT STATE USING FACTORED LOADS AND A FACTORED BEARING RESISTANCE FO 10 KSF FOR WALL SYSTEM BASES FROM 8 TO 20 FEET WIDE. THE BEARING RESISTANCE FACTOR FOR SPREAD FOOTINGS ON SOIL IS 0.45. BASED ON PRESUMPTIVE BEARING RESISTANCE VALUES, A FACTORED BEARING RESISTANCE OF 3 KSF MAY BE USED TO CONTROL SETTLEMENT WHEN ANALYZING THE SERVICE LIMIT STATE ASSUMING A RESISTANCE FACTOR OF 1.0.
3. THE ABUTMENT WINGWALL PEDESTALS WERE DESIGNED TO ACT INDEPENDENTLY OF THE PRECAST CONCRETE GRAVITY RETAINING WALLS AS SHOWN ON THE PLANS. THE CONTRACTOR SHALL SUBMIT RETAINING WALL DETAILS AND DESIGN CALCULATIONS FOR THE PRECAST CONCRETE GRAVITY RETAINING WALLS, STAMPED BY A PROFESSIONAL ENGINEER LICENSED IN THE STATE OF VERMONT. CONSTRUCTION OF THE ABUTMENTS SHALL NOT BE PERMITTED UNTIL THE PRECAST CONCRETE GRAVITY RETAINING WALL STRUCTURAL DESIGN HAS BEEN APPROVED BY THE STRUCTURES ENGINEER.
4. THE COFFERDAM LAYOUT DEPICTED IN THE PLANS ON THE EPSC SHEETS INCLUDES ALL CHANNEL WORK, ABUTMENT REMOVAL, AS WELL AS ABUTMENT AND PRECAST CONCRETE GRAVITY RETAINING WALL CONSTRUCTION.
5. THE CONTRACTOR'S ATTENTION IS DIRECTED TO THE FACT THAT THE SPREAD FOOTING ABUTMENTS ARE FOUNDED ON SOILS THAT ARE HIGHLY SENSITIVE TO MOISTURE AND WILL REQUIRE LIMITING DISTURBANCE. COFFERDAMS SHALL BE INSTALLED DEEP ENOUGH BELOW THE BOTTOM OF EXCAVATION LEVEL TO CONTROL LATERAL SEEPAGE AND PIPING SO THAT FOUNDATION SUBGRADE IS STABLE, AS DETERMINED BY THE RESIDENT ENGINEER.

PROJECT NAME: FAIRFIELD
PROJECT NUMBER: BRO 1448(38)

FILE NAME: z11j072gen.dgn
PROJECT LEADER: D. LANDRY
DESIGNED BY: E. ALEXOPOULOS
GENERAL NOTES

PLOT DATE: 01-NOV-2013
DRAWN BY: W. GAYNOR
CHECKED BY: T. KENDRICK
SHEET 5 OF 41

QUANTITY SHEET 1

SUMMARY OF ESTIMATED QUANTITIES										TOTALS		DESCRIPTIONS				DETAILED SUMMARY OF QUANTITIES			
							EROSION CONTROL	ROADWAY	BRIDGE	FULL C.E. ITEMS	GRAND TOTAL	FINAL	UNIT	ITEMS	ITEM NUMBER	ROUND	QUANTITIES	UNIT	ITEMS
								1			1		LS	CLEARING AND GRUBBING, INCLUDING INDIVIDUAL TREES AND STUMPS	201.10				
								1600			1600		CY	COMMON EXCAVATION	203.15				
									180		180		CY	UNCLASSIFIED CHANNEL EXCAVATION	203.27				
								820			820		CY	SAND BORROW	203.31				
								21			21		CY	TRENCH EXCAVATION OF EARTH	204.20				
								1			1		CY	TRENCH EXCAVATION OF EARTH, EXPLORATORY (N.A.B.I.)	204.22				
									1040		1040		CY	GRANULAR BACKFILL FOR STRUCTURES	204.30				
									1785		1785		CY	COFFERDAM EXCAVATION, EARTH	208.30				
								450			450		CY	COFFERDAM EXCAVATION, ROCK	208.35				
								1			1		LS	COFFERDAM (ABUTMENT NO. 1)	208.40				
								1			1		LS	COFFERDAM (ABUTMENT NO. 2)	208.40				
								900			900		CY	SUBBASE OF CRUSHED GRAVEL, COARSE GRADED	301.25				
								300			300		CY	AGGREGATE SURFACE COURSE	401.10				
									314		314		CY	CONCRETE, HIGH PERFORMANCE CLASS B	501.34				
									29176		29176		LB	REINFORCING STEEL, LEVEL I	507.11				
								5			5		GAL	WATER REPELLENT, SILANE	514.10				
								225			225		SY	SHEET MEMBRANE WATERPROOFING, TORCH APPLIED DELETED CO #1	519.20				
								1			1		EACH	REMOVAL OF STRUCTURE (575 SF - EST.)	529.15				
								31			31		LF	18" CPEP	601.0915				
								1			1		HR	ALL PURPOSE EXCAVATOR RENTAL, TYPE I	608.25				
								800	440		1240		CY	STONE FILL, TYPE II	613.11				
								165			165		LF	REMOVING AND RESETTNG FENCE	620.50				
								444			444		LF	STEEL BEAM GUARDRAIL, GALVANIZED	621.20				
								4			4		EACH	ANCHOR FOR STEEL BEAM RAIL	621.60				
								166			166		LF	REMOVAL AND DISPOSAL OF GUARDRAIL	621.80				
								60			60		LF	TEMPORARY TRAFFIC BARRIER	621.90				
								32			32		HR	FLAGGERS	630.15				
										1	1		LS	FIELD OFFICE, ENGINEERS	631.10				
										1	1		LS	TESTING EQUIPMENT, CONCRETE	631.16				
										3000	3000		DL	FIELD OFFICE TELEPHONE (N.A.B.I.)	631.26				
								1			1		LS	MOBILIZATION/DEMobilIZATION	635.11				
								1			1		LS	TRAFFIC CONTROL	641.10				
								2050	750		2800		SY	GEOTEXTILE UNDER STONE FILL	649.31				
							100				100		SY	GEOTEXTILE FOR SILT FENCE	649.51				
							50				50		LB	SEED	651.15				
							110				110		LB	FERTILIZER	651.18				
							0.5				0.5		TON	AGRICULTURAL LIMESTONE	651.20				
							0.5				0.5		TON	HAY MULCH	651.25				
							10				10		CY	TOPSOIL	651.35				
									440		440		SY	GRUBBING MATERIAL	651.40				

PROJECT NAME: FAIRFIELD
 PROJECT NUMBER: BRO 1448(38)
 FILE NAME: z1j072qty.dgn
 PROJECT LEADER: D. LANDRY
 DESIGNED BY: T. TRAVER
 QUANTITY SHEET (1 OF 2)

PLOT DATE: 12-NOV-2013
 DRAWN BY: W. GAYNOR
 CHECKED BY: T. KENDRICK
 SHEET 6 OF 41



QUANTITY SHEET 2

SUMMARY OF ESTIMATED QUANTITIES										TOTALS		DESCRIPTIONS				DETAILED SUMMARY OF QUANTITIES			
							EROSION CONTROL	ROADWAY	BRIDGE	FULL C.E. ITEMS	GRAND TOTAL	FINAL	UNIT	ITEMS	ITEM NUMBER	ROUND	QUANTITIES	UNIT	ITEMS
							1				1		LS	EPSC PLAN	652.10				
							50				50		HR	MONITORING EPSC PLAN	652.20				
							1				1		LU	MAINTENANCE OF EPSC PLAN (N.A.B.I)	652.30				
							1055				1055		SY	TEMPORARY EROSION MATTING	653.20				
							80				80		CY	TEMPORARY STONE CHECK DAM, TYPE I	653.25				
							2				2		EACH	FILTER BAG	653.45				
							1225				1225		LF	PROJECT DEMARCATION FENCE	653.55				
								2			2		EACH	REMOVING SIGNS	675.50				
								6			6		EACH	DELINEATOR WITH FLEXIBLE POST	676.20				
									1		1		LS	SPECIAL PROVISION (COMPOSITE ARCH SUPERSTRUCTURE)	900.645				
									1		1		LS	SPECIAL PROVISION (CONCRETE ARCH SLAB ON FRP DECKING) DELETED CO #1	900.645				
									530		530		SF	SPECIAL PROVISION (FRP MECHANICALLY STABILIZED EARTH ARCH HEADWALLS)	900.670				
									1075		1075		SF	SPECIAL PROVISION (PRECAST CONCRETE GRAVITY RETAINING WALL)	900.670				

PROJECT NAME: FAIRFIELD
PROJECT NUMBER: BRO 1448(38)

FILE NAME: z11j072qty.dgn
PROJECT LEADER: D. LANDRY
DESIGNED BY: T. TRAVER
QUANTITY SHEET (2 OF 2)

PLOT DATE: 01-NOV-2013
DRAWN BY: W. GAYNOR
CHECKED BY: T. KENDRICK
SHEET 7 OF 41



BRIDGE QUANTITY SHEET 1

SUMMARY OF BRIDGE QUANTITIES										TOTALS		DESCRIPTIONS			DETAILED SUMMARY OF QUANTITIES		
								SUPER-STRUCTURE	ABUTMENT NO. 1	ABUTMENT NO. 2	BRIDGE TOTAL	UNIT	ITEMS	ITEM NUMBER	QUANTITIES	UNIT	ITEMS
									90	90	180	CY	UNCLASSIFIED CHANNEL EXCAVATION	203.27			
									560	480	1040	CY	GRANULAR BACKFILL FOR STRUCTURES	204.30			
									960	825	1785	CY	COFFERDAM EXCAVATION, EARTH	208.30			
									240	210	450	CY	COFFERDAM EXCAVATION, ROCK	208.35			
									1		1	LS	COFFERDAM (ABUTMENT NO. 1)	208.40			
										1	1	LS	COFFERDAM (ABUTMENT NO. 2)	208.40			
									166	148	314	CY	CONCRETE, HIGH PERFORMANCE CLASS B	501.34			
									15167	14009	29176	LB	REINFORCING STEEL, LEVEL I	507.11			
									3	2	5	GAL	WATER REPELLENT, SILANE	514.10			
								225			225	SY	SHEET MEMBRANE WATERPROOFING, TORCH APPLIED DELETED CO #1	519.20			
								1			1	EACH	REMOVAL OF STRUCTURE (575 SF - EST.)	529.15			
									220	220	440	CY	STONE FILL, TYPE II	613.11			
									350	400	750	SY	GEOTEXTILE UNDER STONE FILL	649.31			
									200	240	440	SY	GRUBBING MATERIAL	651.40			
								1			1	LS	SPECIAL PROVISION (COMPOSITE ARCH SUPERSTRUCTURE)	900.645			
								1			1	LS	SPECIAL PROVISION (CONCRETE ARCH SLAB ON FRP DECKING) DELETED CO #1	900.645			
								530			530	SF	SPECIAL PROVISION (FRP MECHANICALLY STABILIZED EARTH ARCH HEADWALLS)	900.670			
									603	472	1075	SF	SPECIAL PROVISION (PRECAST CONCRETE GRAVITY RETAINING WALL)	900.670			

PROJECT NAME: FAIRFIELD
PROJECT NUMBER: BRO 1448(38)

FILE NAME: z1j072qty.dgn
PROJECT LEADER: D. LANDRY
DESIGNED BY: T. TRAVER
BRIDGE QUANTITY SHEET

PLOT DATE: 01-NOV-2013
DRAWN BY: W. GAYNOR
CHECKED BY: T. KENDRICK
SHEET 8 OF 41



 
 
 


GPS/NGS CONTROL POINTS

ST ALBANS CORS ARP

PID DJ8959
 N = 842210.22
 E = 1489218.53
 ELLIP HEIGHT = 480.184

STATION IS A GPS CONTINUOUSLY OPERATING REFERENCE STATION. STATION IS THE ANTENNA REFERENCE POINT OF THE GPS ANTENNA. LOCATED AT THE BELLOWS FREE ACADEMY IN ST. ALBANS, THE MONUMENT IS ATTACHED TO A TWO STORY CONCRETE/BRICK BUILDING WITH A 10 FT CONCRETE FOUNDATION BUILT IN THE MID 1960'S. THE MAST IS A 1.75 INCH DIA. GALV. PIPE THAT IS 108 INCHES LONG. THE MAST IS ATTACHED TO A STEEL MOUNTING FRAME WITH THREE ATTACHMENTS CONSISTING OF 3/8 INCH SS THROUGH BOLTS. THE MOUNTING FRAME IS ATTACHED TO THE BUILDING USING 8 ATTACHMENT POINTS. THE TOP 4 ARE 1/2 INCH SS BOLTS SECURED TO THE BRICK OR CONC WITH LEAD ANCHORS. THE BOTTOM 4 ATTACHMENTS ARE TROUGH BOLTED AND CONSIST OF 1/2 INCH SS THREADED ROD AND NUTS.

TRAVERSE TIES

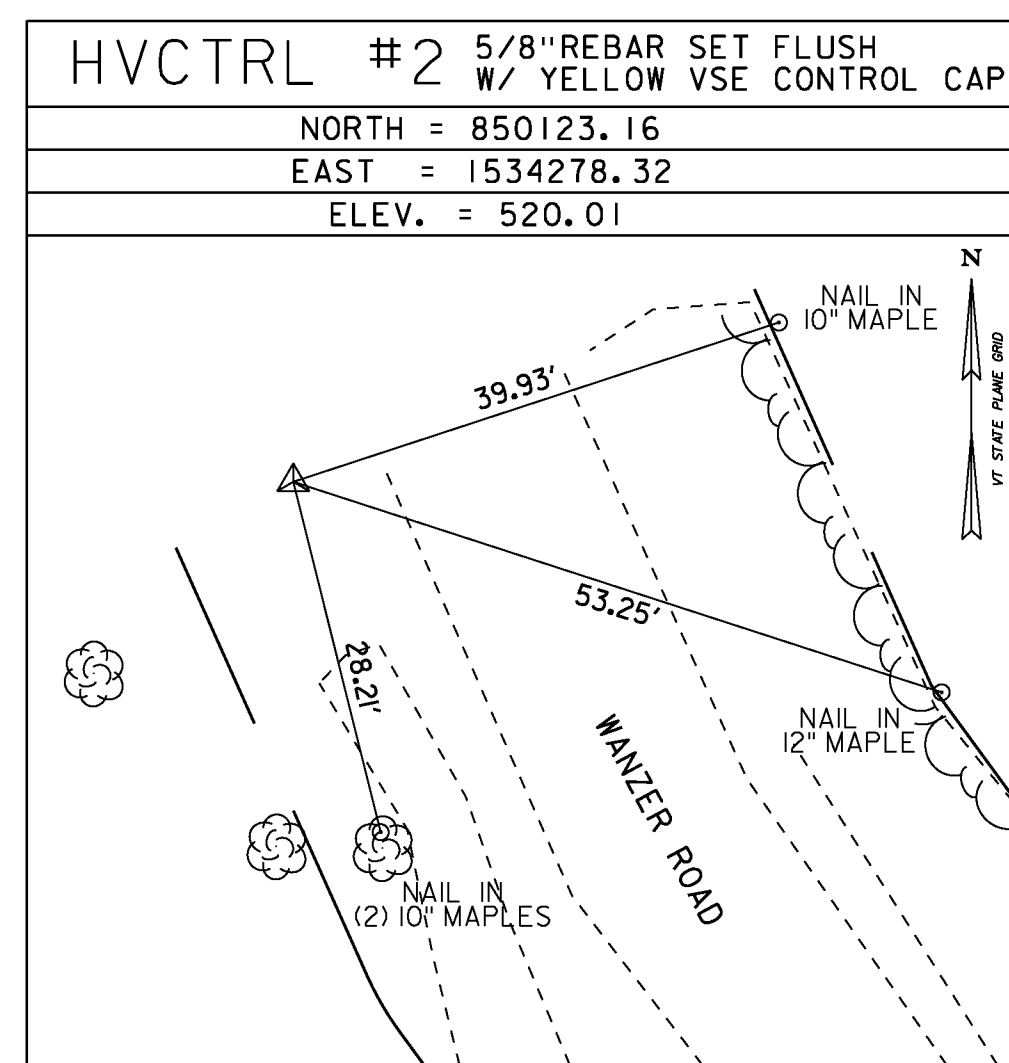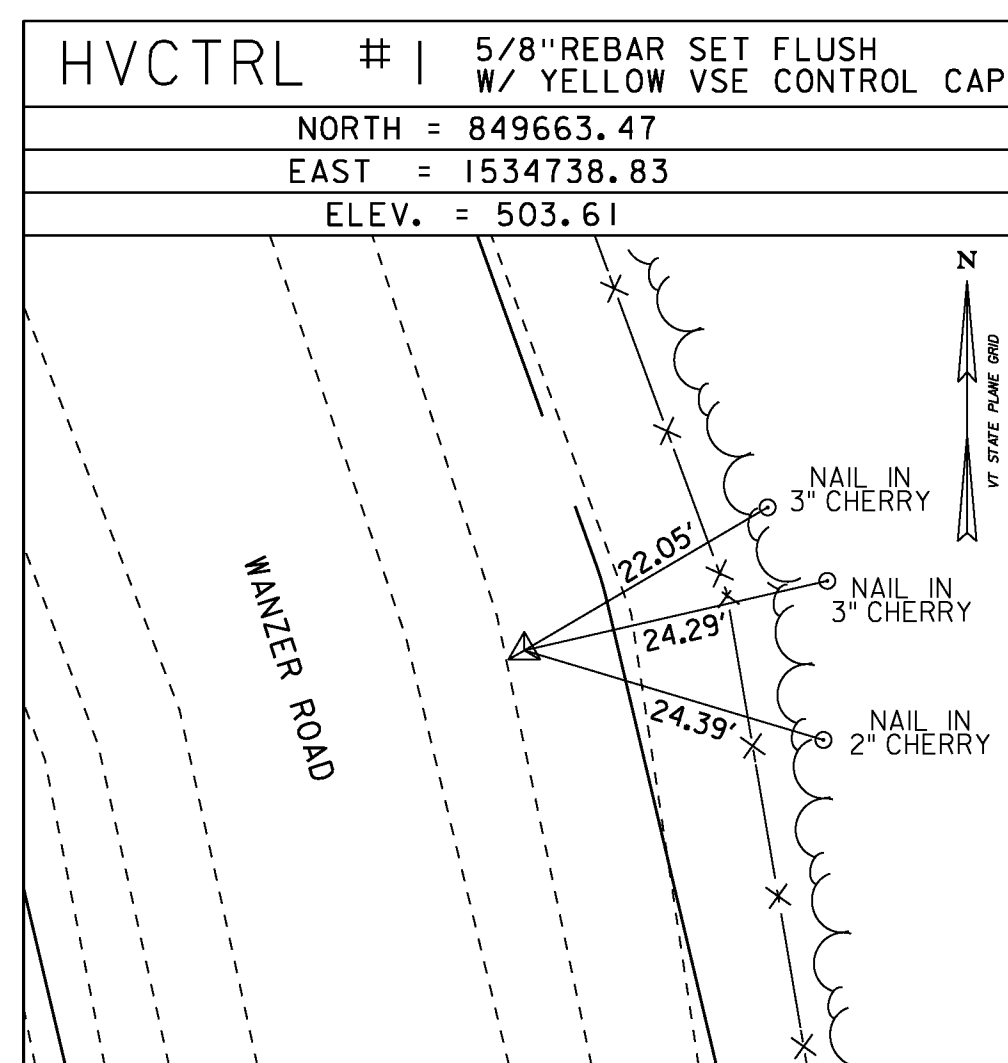

* MAIN TRAVERSE COMPLETED: MAY 2, 2012 BY VSE, T. CATTANEO-PC, T. COMSTOCK

ALIGNMENT COORD

ALIGNMENT COORDINATES							
WANZER ROAD TH 30				CHANNEL - WANZER BROOK			
	STATION	NORTHING	EASTING		STATION	NORTHING	EASTING
POB	10+00.00	850128.0944	1534291.7556	POB	200+00.00	849783.2935	1534503.8874
PI	10+36.60	850094.6860	1534306.6978	POE	202+00.00	849975.2278	1534560.1124
BEGIN APPROACH	10+75.00	850063.3121	1534328.8431				
PI	10+88.54	850052.2463	1534336.6538				
PI	11+54.29	850004.7730	1534382.1436				
PC	11+60.15	850000.6590	1534386.3094				
PT	13+22.20	849895.6804	1534509.5659				
PC	14+19.88	849837.9889	1534588.3887				
PT	16+81.59	849624.3569	1534729.9779				
END APPROACH	17+00.00	849606.4424	1534734.2034				
PI	17+00.17	849605.6933	1534734.3801				
PI	17+72.26	849535.0652	1534745.4735				
POE	18+19.91	849487.6476	1534750.1072				


DATUM
 VERTICAL NAVD 88(GEIOD09) FT
 HORIZONTAL NAD 83(CORS) SFT
 ADJUSTMENT LSO




PROJECT NAME: FAIRFIELD
 PROJECT NUMBER: BRO 1448(38)

FILE NAME: z11j0721e_01.dgn
 PROJECT LEADER: D. LANDRY
 DESIGNED BY: VSE
TIE SHEET

PLOT DATE: 01-NOV-2013
 DRAWN BY: VSE
 CHECKED BY: VSE
 SHEET 9 OF 41

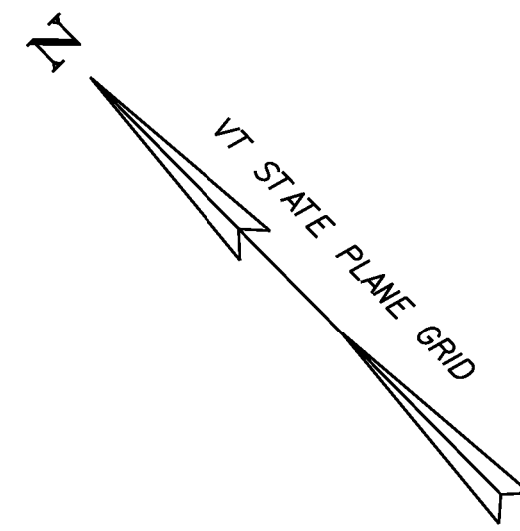

CURVE #1 DATA (TH 30)
 PC STA. 11+60.15
 $\Delta=8^{\circ}26'26.51''$ LT
 $D=5^{\circ}12'31.35''$
 $R=1100.00'$
 $T=81.17'$
 $L=162.050'$
 $E=2.991'$

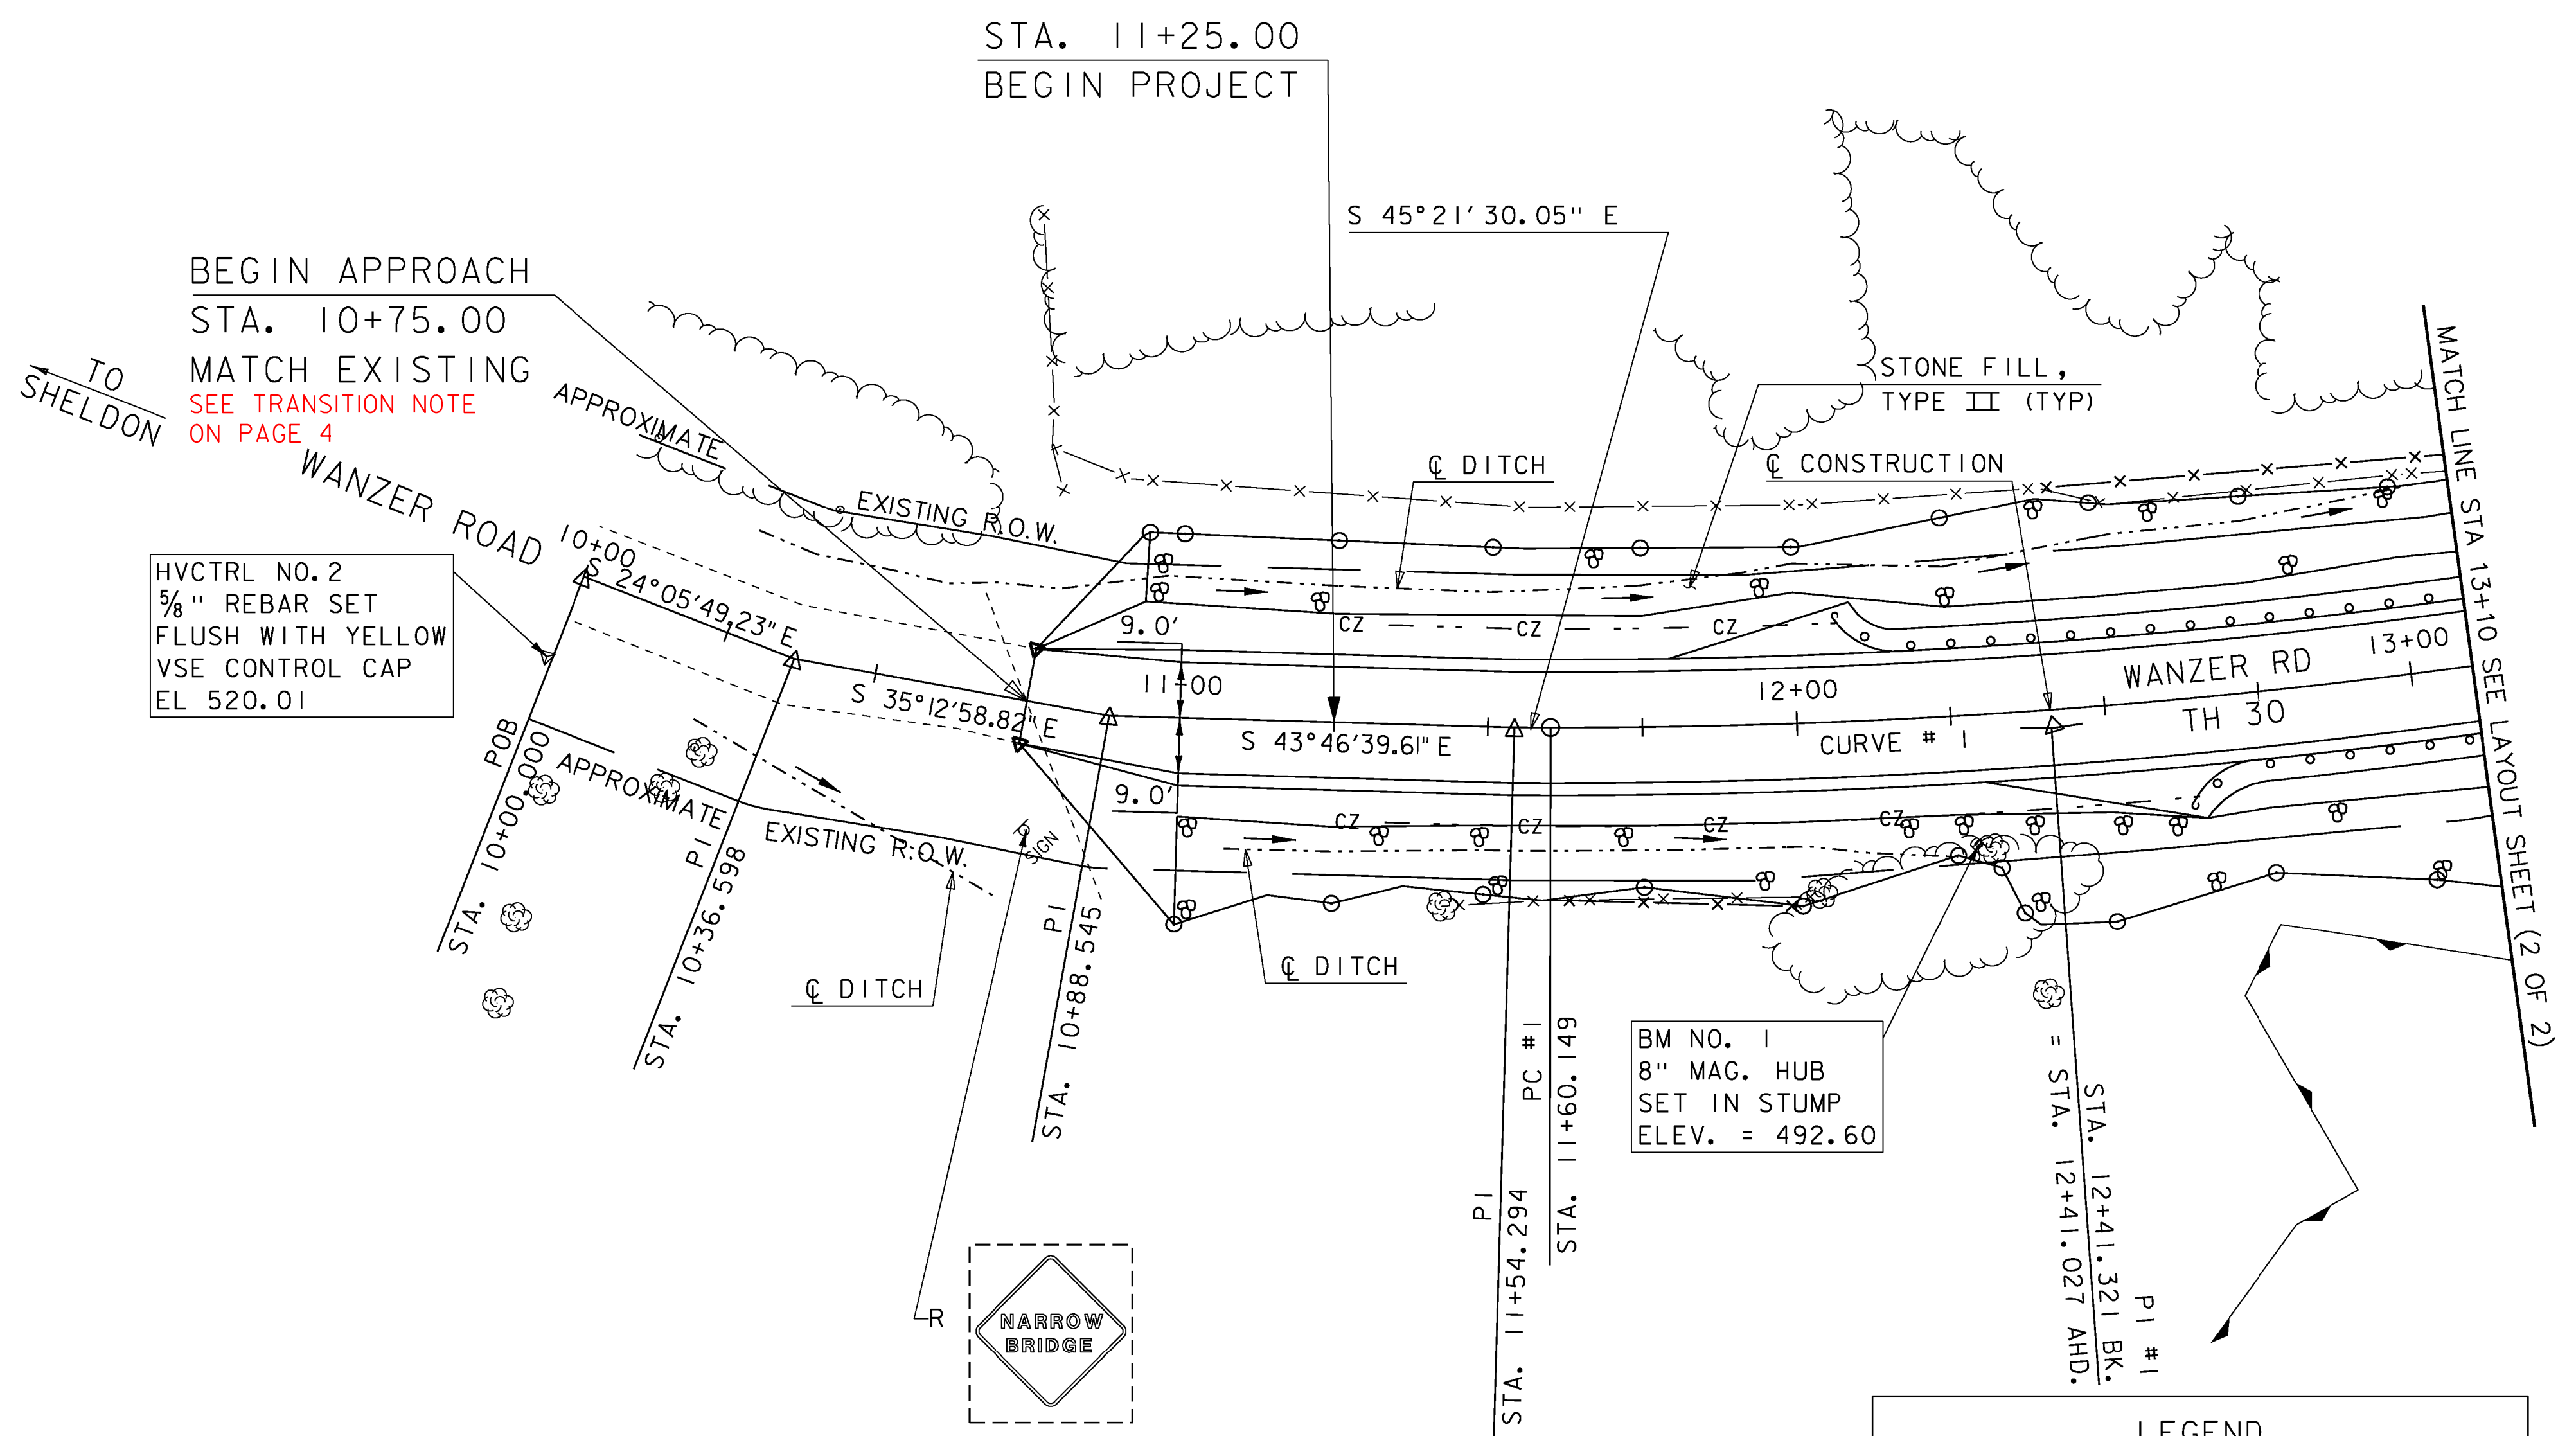

HVCTRL NO. 2
 5/8" REBAR SET
 FLUSH WITH YELLOW
 VSE CONTROL CAP
 EL 520.01

BM NO. 1
 8" MAG. HUB
 SET IN STUMP
 ELEV. = 492.60

LEGEND

- x-x-x-x RELOCATED FENCE
- cz - - - CLEAR ZONE
- - - - - C DITCH
- R [] REMOVE EXISTING SIGNS AND POSTS (SALVAGE TO TOWN)


REMOVING AND RESETTING FENCE
 STA. 12+41.00 LT. TO STA. 13+68.00 LT.
 STA. 11+61.00 RT. TO STA. 12+00.00 RT.

LAYOUT SHEET 1
 SCALE 1" = 20'-0"
 20 0 20





PROJECT NAME: FAIRFIELD
 PROJECT NUMBER: BRO 1448(38)
 FILE NAME: z11j072bdr_nu_01
 PROJECT LEADER: D. LANDRY
 DESIGNED BY: M. VALLETTA
 LAYOUT SHEET (1 OF 2)

PLOT DATE: 01-NOV-2013
 DRAWN BY: M. VALLETTA
 CHECKED BY: T. KENDRICK
 SHEET 10 OF 41

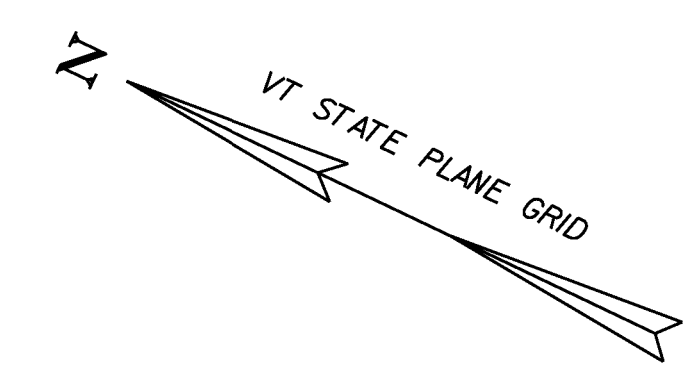

CURVE #2 DATA (TH 30)
 PC STA. 14+19.879
 $\Delta=40^{\circ}31'38.90''$ RT
 $D=15^{\circ}29'07.24''$
 $R=370.00'$
 $T=136.601'$
 $L=261.715'$
 $E=24.411'$

STA. 16+50.00
 END PROJECT

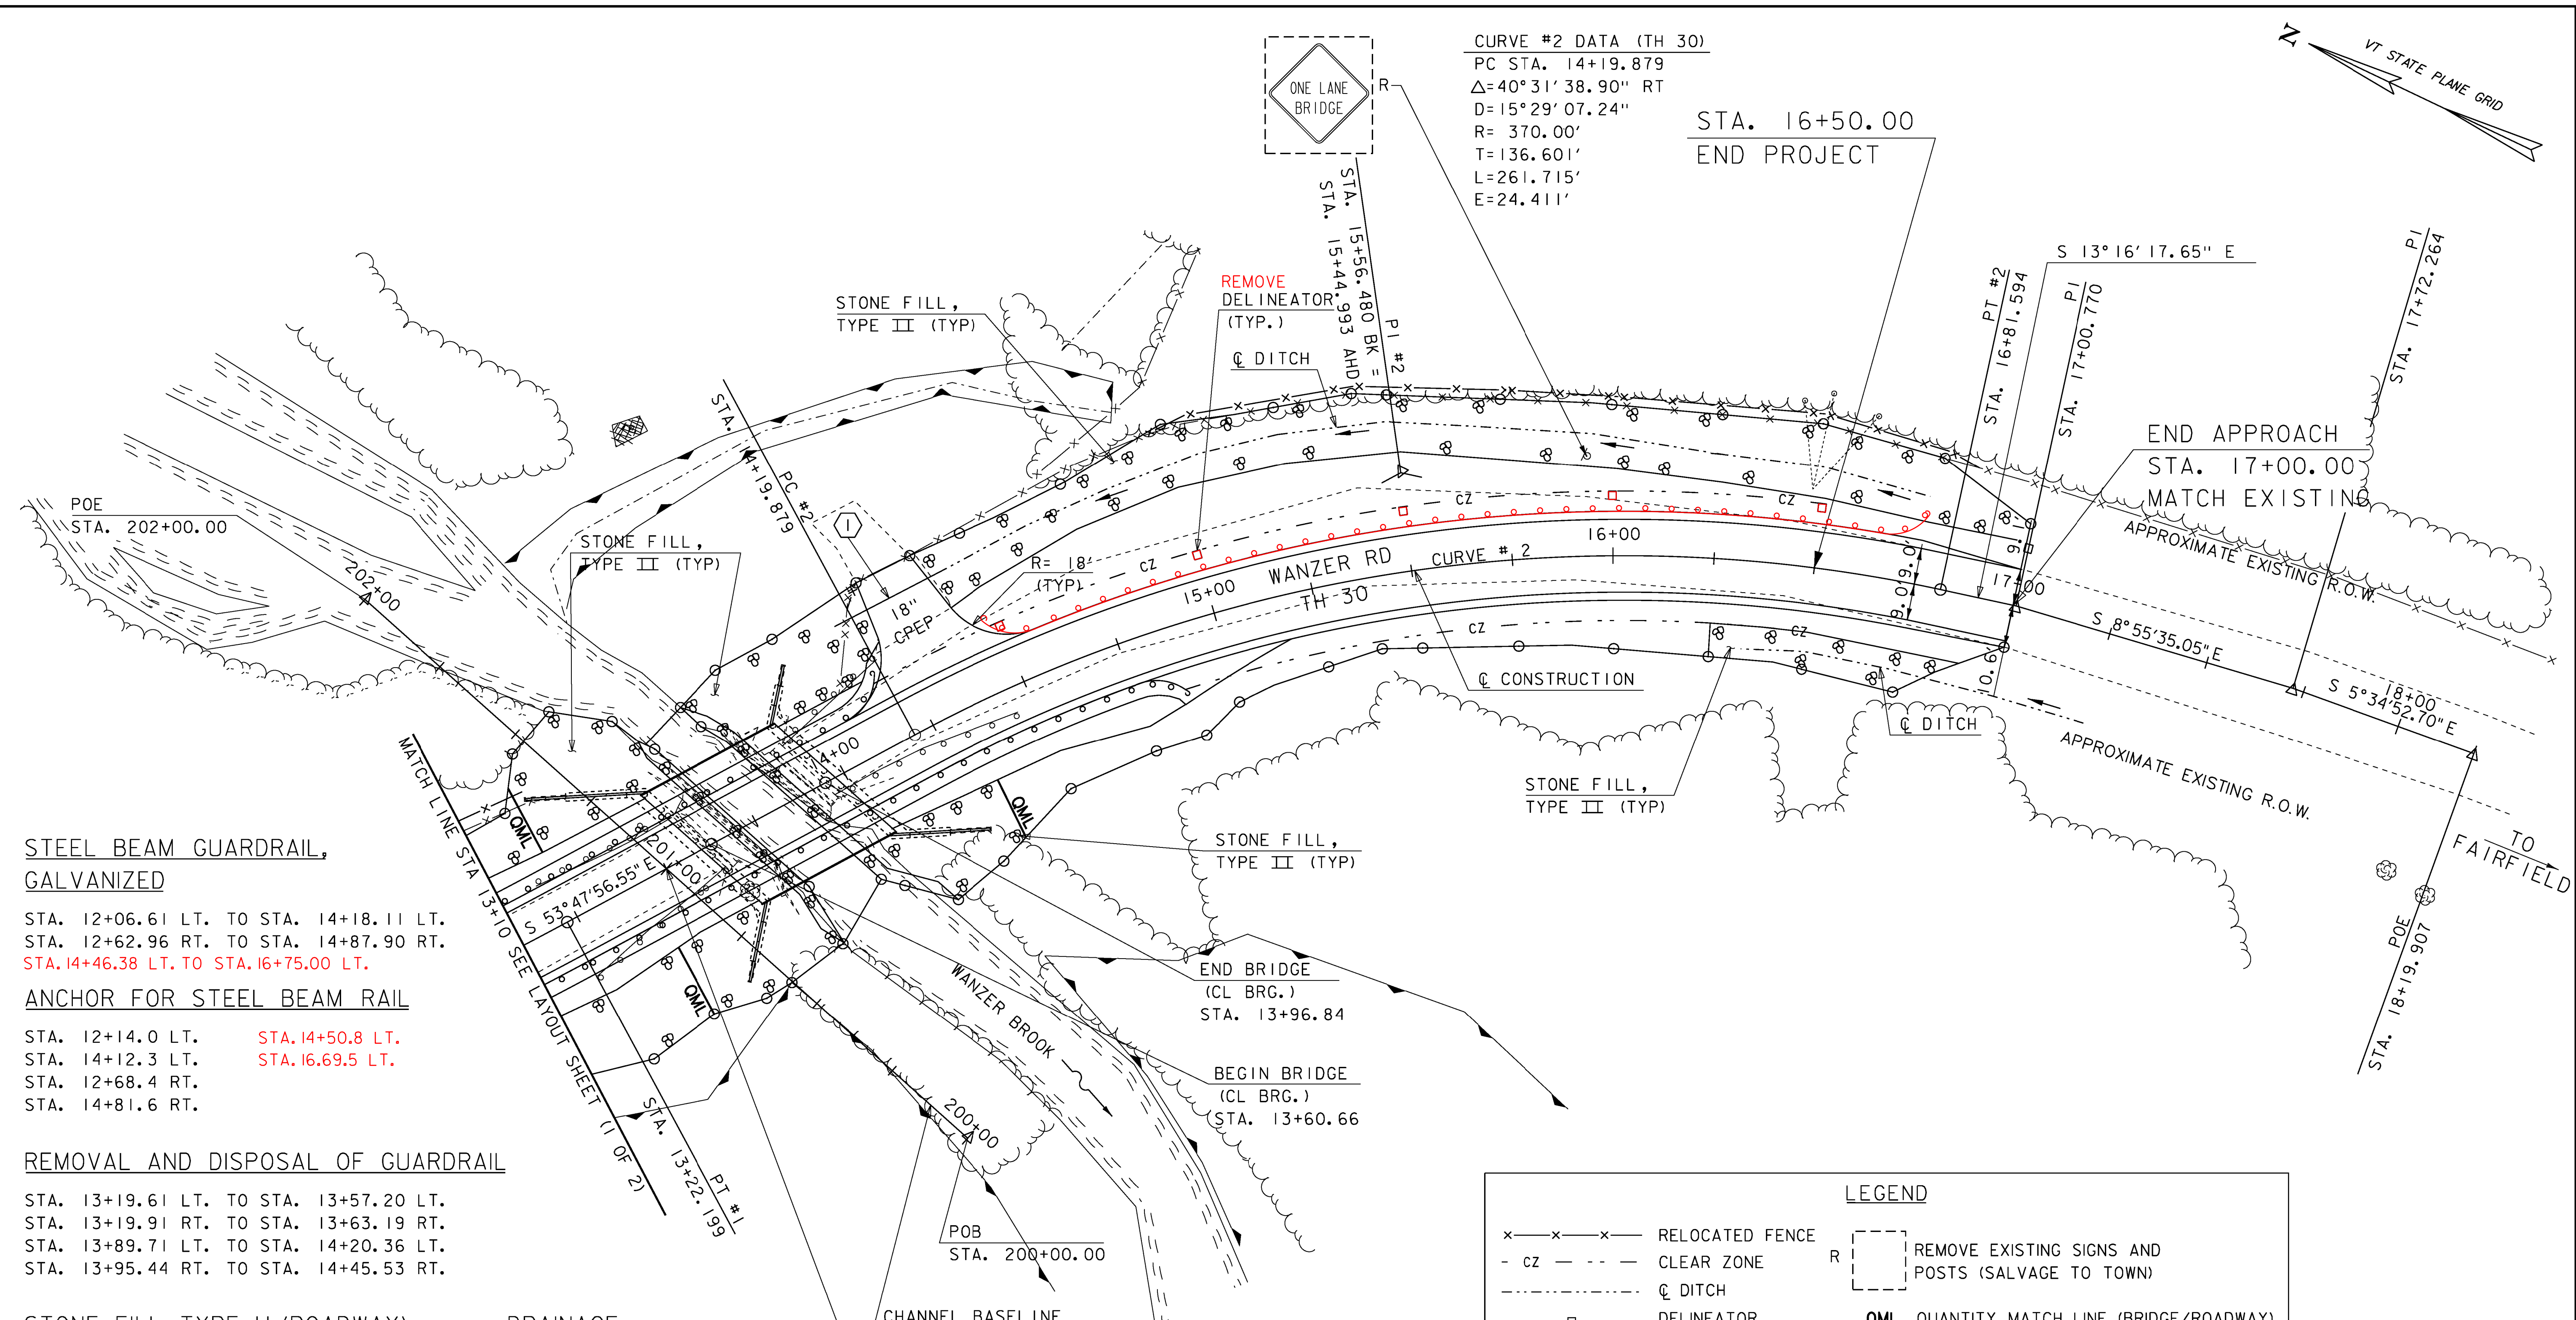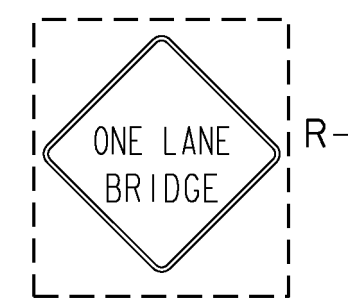

STEEL BEAM GUARDRAIL, GALVANIZED
 STA. 12+06.61 LT. TO STA. 14+18.11 LT.
 STA. 12+62.96 RT. TO STA. 14+87.90 RT.
 STA. 14+46.38 LT. TO STA. 16+75.00 LT.

ANCHOR FOR STEEL BEAM RAIL
 STA. 12+14.0 LT. STA. 14+50.8 LT.
 STA. 14+12.3 LT. STA. 16.69.5 LT.
 STA. 12+68.4 RT.
 STA. 14+81.6 RT.

REMOVAL AND DISPOSAL OF GUARDRAIL
 STA. 13+19.61 LT. TO STA. 13+57.20 LT.
 STA. 13+19.91 RT. TO STA. 13+63.19 RT.
 STA. 13+89.71 LT. TO STA. 14+20.36 LT.
 STA. 13+95.44 RT. TO STA. 14+45.53 RT.

STONE FILL, TYPE II (ROADWAY)
 STA. 11+00.00 LT. TO STA. 13+25.00 LT.
 STA. 11+00.00 RT. TO STA. 13+43.00 RT.
 STA. 14+36.99 LT. TO STA. 17+00.00 LT.
 STA. 16+25.00 RT. TO STA. 16+90.00 RT.

STONE FILL, TYPE II (BRIDGE)
 STA. 13+25.00 LT. TO STA. 14+25.00 LT.
 STA. 13+43.00 RT. TO STA. 14+34.00 RT.

REMOVING AND RESETTING FENCE
 STA. 14+19.69 LT. TO STA. 14+25.00 LT.
 STA. 14+96.00 LT. TO STA. 14+34.00 LT.

DRAINAGE
 I STA. 14+15.1, 33.0' LT. TO STA. 14+44.0, 33.4' LT.
 CONSTRUCT 31 LF x 18" CPEP
 INVERT IN = EL. 474.36
 INVERT OUT = EL. 473.34

CONSTRUCT GRAVEL DRIVE
 STA. 14+31 LT.

DELINEATOR WITH FLEXIBLE POST
 STA. 14+50 LT. TO STA. 17+00 LT.
 (SPACED AT 50 FEET)

CHANNEL BASELINE
 STA. 13+50.00 WANZER RD
 = STA. 201+00.00 CHANNEL BASELINE
 $\Delta=20^{\circ}00'00''$ LT.

REMOVAL AND DISPOSAL OF DELINEATOR
 STA. 14+50 LT. TO STA. 17+00 LT.

LEGEND	
x-x-x	RELOCATED FENCE
-cz-	CLEAR ZONE
- - -	☉ DITCH
□	DELINEATOR
R	REMOVE EXISTING SIGNS AND POSTS (SALVAGE TO TOWN)
OML	QUANTITY MATCH LINE (BRIDGE/ROADWAY) (STONE FILL, TYPE III)

EXISTING BRIDGE
 SINGLE SPAN ROLLED BEAM WITH TIMBER DECK ON MASONRY/CONCRETE ABUTMENTS

LAYOUT SHEET 2
 SCALE 1" = 20'-0"
 20 0 20



PROJECT NAME: FAIRFIELD	PLOT DATE: 01-NOV-2013
PROJECT NUMBER: BRO 1448(38)	DRAWN BY: M. VALLETTA
FILE NAME: z11j072bdr_nu_01.dgn	CHECKED BY: T. KENDRICK
PROJECT LEADER: D. LANDRY	SHEET 11 OF 41
DESIGNED BY: M. VALLETTA	LAYOUT SHEET (2 OF 2)



PROFILE - TH30

HORIZONTAL SCALE: 1" = 40'-0"
 VERTICAL SCALE: 1" = 20'-0"

NOTES:
 ELEVATIONS SHOWN TO THE NEAREST TENTH ARE EXISTING GROUND ALONG THE PROPOSED ALIGNMENT.
 ELEVATIONS SHOWN TO THE NEAREST HUNDREDTH ARE FINISH GRADE ELEVATIONS ALONG THE PROPOSED ALIGNMENT.

PROJECT NAME: FAIRFIELD	
PROJECT NUMBER: BRO 1448(38)	
FILE NAME: zlj072pro_01.dgn	PLOT DATE: 01-NOV-2013
PROJECT LEADER: D. LANDRY	DRAWN BY: W. GAYNOR
DESIGNED BY: E. ALEXOPOULOS	CHECKED BY: T. KENDRICK
PROFILE SHEET	SHEET 12 OF 41



EPSC PLAN NARRATIVE

1.1 PROJECT DESCRIPTION

THIS PROJECT INVOLVES THE REMOVAL OF THE EXISTING ROLLED STEEL BEAM BRIDGE, WHICH WILL BE REPLACED WITH A RIGIFIED FIBER REINFORCED POLYMER TUBULAR ARCH (RFTA) BRIDGE, WITH CONCRETE OVERLAY. THE ARCH SUPERSTRUCTURE WILL HAVE A 7.5 FOOT RISE (FROM ITS BASE), SPANNING APPROXIMATELY 32 FEET OVER WANZER BROOK, ON NEW FOOTINGS ALONG A NEW ALIGNMENT. THE BRIDGE IS LOCATED IN THE TOWN OF FAIRFIELD, ON WANZER ROAD (TH 30). VERTICAL ALIGNMENT OF THE ROADWAY WITHIN THE PROJECT LIMITS WILL BE RAISED TO IMPROVE SIGHT DISTANCE.

NOTE: AREA OF DISTURBANCE INCLUDES LIMITS OF EARTH DISTURBANCE WITHIN THE PROJECT AREA, AS WELL AS WASTE, BORROW AND STAGING AREAS, AND OTHER EARTH DISTURBING ACTIVITIES WITHIN OR DIRECTLY ADJACENT TO THE PROJECT LIMITS AS SHOWN ON THE ATTACHED EPSC PLAN.

TOTAL AREA OF DISTURBANCE AS SHOWN ON THE ATTACHED EPSC PLAN IS APPROXIMATELY 0.91 ACRES.

IT IS ANTICIPATED THAT THIS PROJECT WILL LAST ONE CONSTRUCTION SEASON.

1.2 SITE INVENTORY

1.2.1 TOPOGRAPHY

THE TOPOGRAPHY OF THE AREA IS HILLY TO MOUNTAINOUS, WITH MOSTLY WELL ESTABLISHED FOREST WITH OCCASIONAL OPEN AREAS. WANZER ROAD (TH 30) AND A GRAVEL DRIVEWAY IS WITHIN THE PROJECT SITE. THERE ARE NO RESIDENCES WITHIN THE PROJECT.

1.2.2 DRAINAGE, WATERWAYS, BODIES OF WATER, AND PROXIMITY TO NATURAL OR MAN-MADE WATER FEATURES

THE WANZER BROOK IS THE ONLY WATER SOURCE ON THE PROJECT SITE. THE BROOK IS CLASSIFIED AS STEEP, SINUOUS, NARROW, WITH A CONFINED CHANNEL AT THE SITE. THE STREAM BED CONSISTS OF GRAVEL, COBBLES AND BOULDERS. DUE TO THE NATURE OF THE SURROUNDING TERRAIN THE PROJECT SITE COULD RECEIVE RUNOFF WATER FROM A FEW NEARBY SLOPES.

1.2.3 VEGETATION

THE VEGETATION IN THE PROJECT AREA CONSISTS OF HARDWOOD TREES AND UNDERGROWTH. THE IMPACT TO VEGETATION WILL BE LIMITED TO THAT WHICH IS DIRECTLY AFFECTED BY REPLACEMENT OF THE EXISTING BRIDGE AND RECONSTRUCTION OF WANZER ROAD. UPON PROJECT COMPLETION, THE CHANNEL EMBANKMENTS WILL BE ARMORED WITH STONE FILL TYPE II AS SPECIFIED ON THE PLANS. DISTURBED VEGETATION WILL BE REESTABLISHED WITH STANDARD SEED AND MULCH PRACTICES.

1.2.4 SOILS

ALL SOIL DATA CAME FROM THE U.S. DEPARTMENT OF AGRICULTURE NATURAL RESOURCES CONSERVATION SERVICE FOR THE COUNTY OF FRANKLIN, VERMONT. SOILS ON THE PROJECT SITE ARE RUMNEY VARIANT SILT LOAM, 8% TO 15% SLOPES, "K FACTOR" = 0.37. THE SOIL IS CONSIDERED HIGHLY ERODIBLE.

NOTE: K-VALUES GENERALLY INDICATE THE FOLLOWING:

0.0-0.23 = LOW EROSION POTENTIAL
0.24-0.36 = MODERATE EROSION POTENTIAL
0.37 AND HIGHER = HIGH EROSION POTENTIAL

1.2.5 SENSITIVE RESOURCE AREAS

CRITICAL HABITATS: YES - FISH
HISTORICAL OR ARCHEOLOGICAL AREAS: NO
PRIME AGRICULTURAL LAND: YES
THREATENED OR ENDANGERED SPECIES: NO
WATER RESOURCE: WANZER BROOK
WETLANDS: YES

1.3 RISK EVALUATION

THIS PROJECT DOES NOT FALL UNDER THE JURISDICTION OF GENERAL PERMIT 3-9020 FOR STORMWATER RUNOFF FROM CONSTRUCTION SITES. SHOULD CHANGES PRIOR TO, OR DURING CONSTRUCTION, RESULT IN ONE OR MORE ACRES OF EARTH DISTURBANCE, OR

SHOULD THE PROJECT BECOME PART OF A LARGER PLAN OF DEVELOPMENT, THE CONTRACTOR WILL BE RESPONSIBLE FOR ANY ADDITIONAL PERMITTING.

1.4 EROSION PREVENTION AND SEDIMENT CONTROL

THE EROSION CONTROL PLANS ARE MEANT AS A GUIDELINE FOR PREVENTING EROSION AND CONTROLLING SEDIMENT TRANSPORT. THE PRINCIPLES OUTLINED IN THIS NARRATIVE CONSIST OF APPLYING MEASURES THROUGHOUT CONSTRUCTION OF THE PROJECT IN ORDER TO MINIMIZE SEDIMENT TRANSPORT TO THE RECEIVING WATERS. THE MEASURES INCLUDE STABILIZATION AND STRUCTURAL PRACTICES, STORM WATER CONTROLS AND OTHER POLLUTION PREVENTION PRACTICES. THEY HAVE BEEN PROPOSED BY THE DESIGNER AS A BASIS FOR PROTECTING RESOURCES AND WILL NEED TO BE BUILT UPON BASED ON THE SPECIFIC MEANS AND METHODS OF THE CONTRACTOR. REFER TO THE LOW RISK SITE HAND BOOK AND APPROPRIATE DETAIL SHEETS FOR SPECIFIC GUIDANCE AND CONSTRUCTION DETAILING.

ALL MEASURES SHALL BE REGULARLY MAINTAINED AND SHALL BE CHECKED FOR SEDIMENT BUILD-UP. SEDIMENT SHALL BE DISPOSED OF AT AN APPROVED SITE WHERE IT WILL NOT BE SUBJECT TO EROSION.

1.4.1 MARK SITE BOUNDARIES

SITE BOUNDARIES AND AREAS CONSTRUCTION EQUIPMENT CAN ACCESS SHALL BE DELINEATED.

PROJECT DEMARCATION FENCING (PDF) SHALL BE USED TO PHYSICALLY MARK SITE BOUNDARIES.

1.4.2 LIMIT DISTURBANCE AREA

PREVENTING INITIAL SOIL EROSION BY MINIMIZING THE EXPOSED AREA IS MUCH MORE EFFECTIVE THAN TREATING ERODED SEDIMENT. EARTH DISTURBANCE CAN BE MINIMIZED THROUGH CONSTRUCTION PHASING BY ONLY OPENING UP EARTH AS NECESSARY. THIS CAN LIMIT THE AREA THAT WILL BE DISTURBED AND EXPOSED TO EROSION. EMPLOY TEMPORARY CONSTRUCTION STABILIZATION PRACTICES IN INCREMENTAL STAGES AS PHASES CHANGE. FOR PROJECTS WHICH FALL UNDER THE CONSTRUCTION GENERAL PERMIT, ONLY THE ACREAGE LISTED ON THE PERMIT AUTHORIZATION MAY BE EXPOSED AT ANY GIVEN TIME.

MAINTAINING VEGETATED BUFFERS ALONG STREAM BANKS, WETLANDS OR OTHER SENSITIVE AREAS IS A CRUCIAL EROSION AND SEDIMENT CONTROL MEASURE THAT SHOULD BE ESTABLISHED WHEREVER POSSIBLE.

1.4.3 SITE ENTRANCE/EXIT STABILIZATION

TRACKING OF SEDIMENT ONTO PUBLIC HIGHWAYS SHALL BE MINIMIZED TO REDUCE THE POTENTIAL FOR RUNOFF ENTERING RECEIVING WATERS. INSTALLATION SHALL COINCIDE WITH THE CONTRACTOR'S PROGRESS SCHEDULE.

STABILIZED CONSTRUCTION ENTRANCES WILL NOT BE INSTALLED.

1.4.4 INSTALL SEDIMENT BARRIERS

SEDIMENT BARRIERS SHALL BE UTILIZED TO INTERCEPT RUNOFF AND ALLOW SUSPENDED SEDIMENT TO SETTLE OUT. THEY SHALL BE INSTALLED PRIOR TO ANY UP SLOPE WORK.

SILT FENCE WILL BE INSTALLED AS PROPOSED ON THE EPSC PLAN. INCORPORATE FILTER BAGS FOR COFFERDAM DEWATERING.

1.4.5 DIVERT UPLAND RUNOFF

DIVERSIONARY MEASURES SHALL BE USED TO INTERCEPT RUNOFF FROM ABOVE THE CONSTRUCTION AND DIRECT IT AROUND THE DISTURBED AREA SO THAT CLEAN WATER DOES NOT BECOME MUDDIED WHILE TRAVELING OVER EXPOSED SOILS ON THE CONSTRUCTION SITE.

1.4.6 SLOW DOWN CHANNELIZED RUNOFF

CHECK STRUCTURES SHALL BE UTILIZED TO REDUCE THE VELOCITY, AND THUS THE EROSION POTENTIAL, OF CONCENTRATED FLOW IN CHANNELS. STONE CHECK DAMS WILL BE INSTALLED AS PROPOSED ON THE EPSC PLAN, AT A MINIMUM.

1.4.7 CONSTRUCT PERMANENT CONTROLS

PERMANENT STORMWATER TREATMENT DEVICES SHALL BE INSTALLED AS SHOWN ON THE PLANS AND IN ACCORDANCE WITH PERMIT CONDITIONS.

MEASURES TO INCLUDE:

TYPE II STONE FOR SLOPE LINING, GUTTER AND CHANNEL PROTECTION.
SEED AND MULCH.

STREAM BANK VEGETATION WILL BE INTRODUCED IN THE GRUBBING MATERIAL THAT IS TO BE PLACED OVER THE STREAM BANK STONE FILL.

1.4.8 STABILIZE EXPOSED SOILS DURING CONSTRUCTION

ALL AREAS OF DISTURBANCE MUST HAVE TEMPORARY STABILIZATION IN PLACE WITHIN 48 HOURS OF DISTURBANCE OR IN ACCORDANCE WITH THE CONSTRUCTION GENERAL PERMIT 3-9020 AUTHORIZATION.

SURFACE ROUGHENING OF ALL EXPOSED SLOPES, COMBINED WITH TEMPORARY MULCHING, SHALL BE UTILIZED ON A REGULAR BASIS. BIODEGRADABLE EROSION CONTROL MATTING OR AN EQUIVALENT SHALL BE USED TO STABILIZE ALL SLOPES STEEPER THAN 1:3.

THE FORECAST OF RAINFALL EVENTS SHALL TRIGGER IMMEDIATE PROTECTION OF EXPOSED SOILS.

ANTICIPATED MEASURES INCLUDE SEED AND MULCH, AND EROSION MATTING.

1.4.9 WINTER STABILIZATION

VARIOUS MEASURES SPECIFIC TO WINTER MAY BE NECESSARY SHOULD THE PROJECT EXTEND INTO WINTER (OCTOBER 15 THROUGH APRIL 15). REFER TO THE LOW RISK SITE HANDBOOK FOR GUIDANCE.

1.4.10 STABILIZE SOIL AT FINAL GRADE

EXPOSED SOIL MUST BE STABILIZED WITHIN 48 HOURS OF REACHING FINAL GRADE.

SEED, MULCH, FERTILIZER AND LIME SHALL BE USED TO ESTABLISH PERMANENT VEGETATION. FOR SLOPES STEEPER THAN 1:3, BIODEGRADABLE EROSION CONTROL MATTING OR AN EQUIVALENT SHALL BE USED INSTEAD OF MULCH.

1.4.11 DE-WATERING ACTIVITIES

DISCHARGE FROM DEWATERING ACTIVITIES THAT FLOWS OFF OF THE CONSTRUCTION SITE MUST NOT CAUSE OR CONTRIBUTE TO A VIOLATION OF THE VERMONT WATER QUALITY STANDARDS.

TREATMENT OF DEWATERING COFFERDAM IS ANTICIPATED. A LOCATION FOR TREATMENT HAS BEEN PROPOSED AND IS SHOWN ON THE PLANS. HOWEVER THE SPECIFIC MEANS FOR TREATMENT OF DISCHARGE SHALL BE PROVIDED BY THE CONTRACTOR.

1.4.12 INSPECT YOUR SITE

INSPECT THE PROJECT SITE BASED ON SPECIAL PROVISION REQUIREMENTS OR CONSTRUCTION GENERAL PERMIT AUTHORIZATION STIPULATIONS.

1.5 SEQUENCE AND STAGING

THIS SECTION WILL BE DEVELOPED BY THE CONTRACTOR USING THE GUIDANCE OUTLINED IN THE VTRANS EPSC PLAN CONTRACTOR CHECKLIST.

1.5.1 CONSTRUCTION SEQUENCE

1.5.2 OFF-SITE ACTIVITIES


IN ADDITION TO THE CONTRACTOR CHECKLIST, ANY ACTIVITIES OUTSIDE THE CONSTRUCTION LIMITS SHALL FOLLOW SUBSECTIONS 105.25 - 105.29 OF THE STANDARD SPECIFICATIONS FOR CONSTRUCTION.



PROJECT NAME: FAIRFIELD
PROJECT NUMBER: BRO 1448(38)

FILE NAME: z1j072epsc_nar_01.dgn
PROJECT LEADER: D. LANDRY
DESIGNED BY: E. ALEXOPOULOS
EPSC PLAN NARRATIVE

PLOT DATE: 01-NOV-2013
DRAWN BY: W. GAYNOR
CHECKED BY: T. KENDRICK
SHEET 13 OF 41

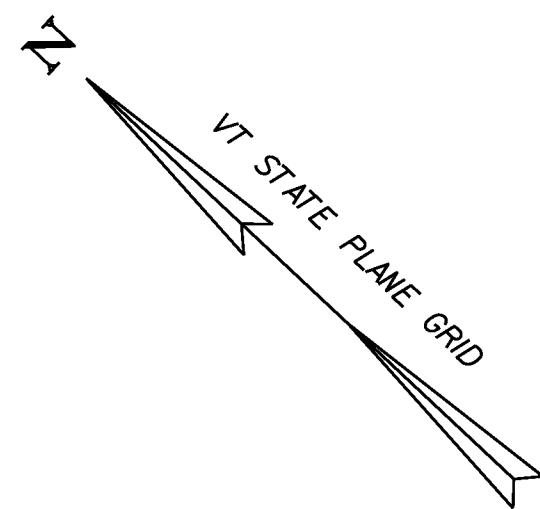

HVCTRL 3 - 5/8" REBAR
SET FLUSH WITH CAP MA
ELEV: 464.41

BM - CROSS CUT IN
LEDGE OUTCROP
ELEV: 471.10


END BRIDGE
C BRG. ABUTMENT NO. 2
STA. 13+96.84

BEGIN BRIDGE
C BRG. ABUTMENT NO. 1
STA. 13+60.66

FIELD DRIVE

EXISTING 18"
CPEP CULVERT

HVCTRL 1 - 5/8" REBAR
SET FLUSH WITH CAP MA
ELEV: 503.61

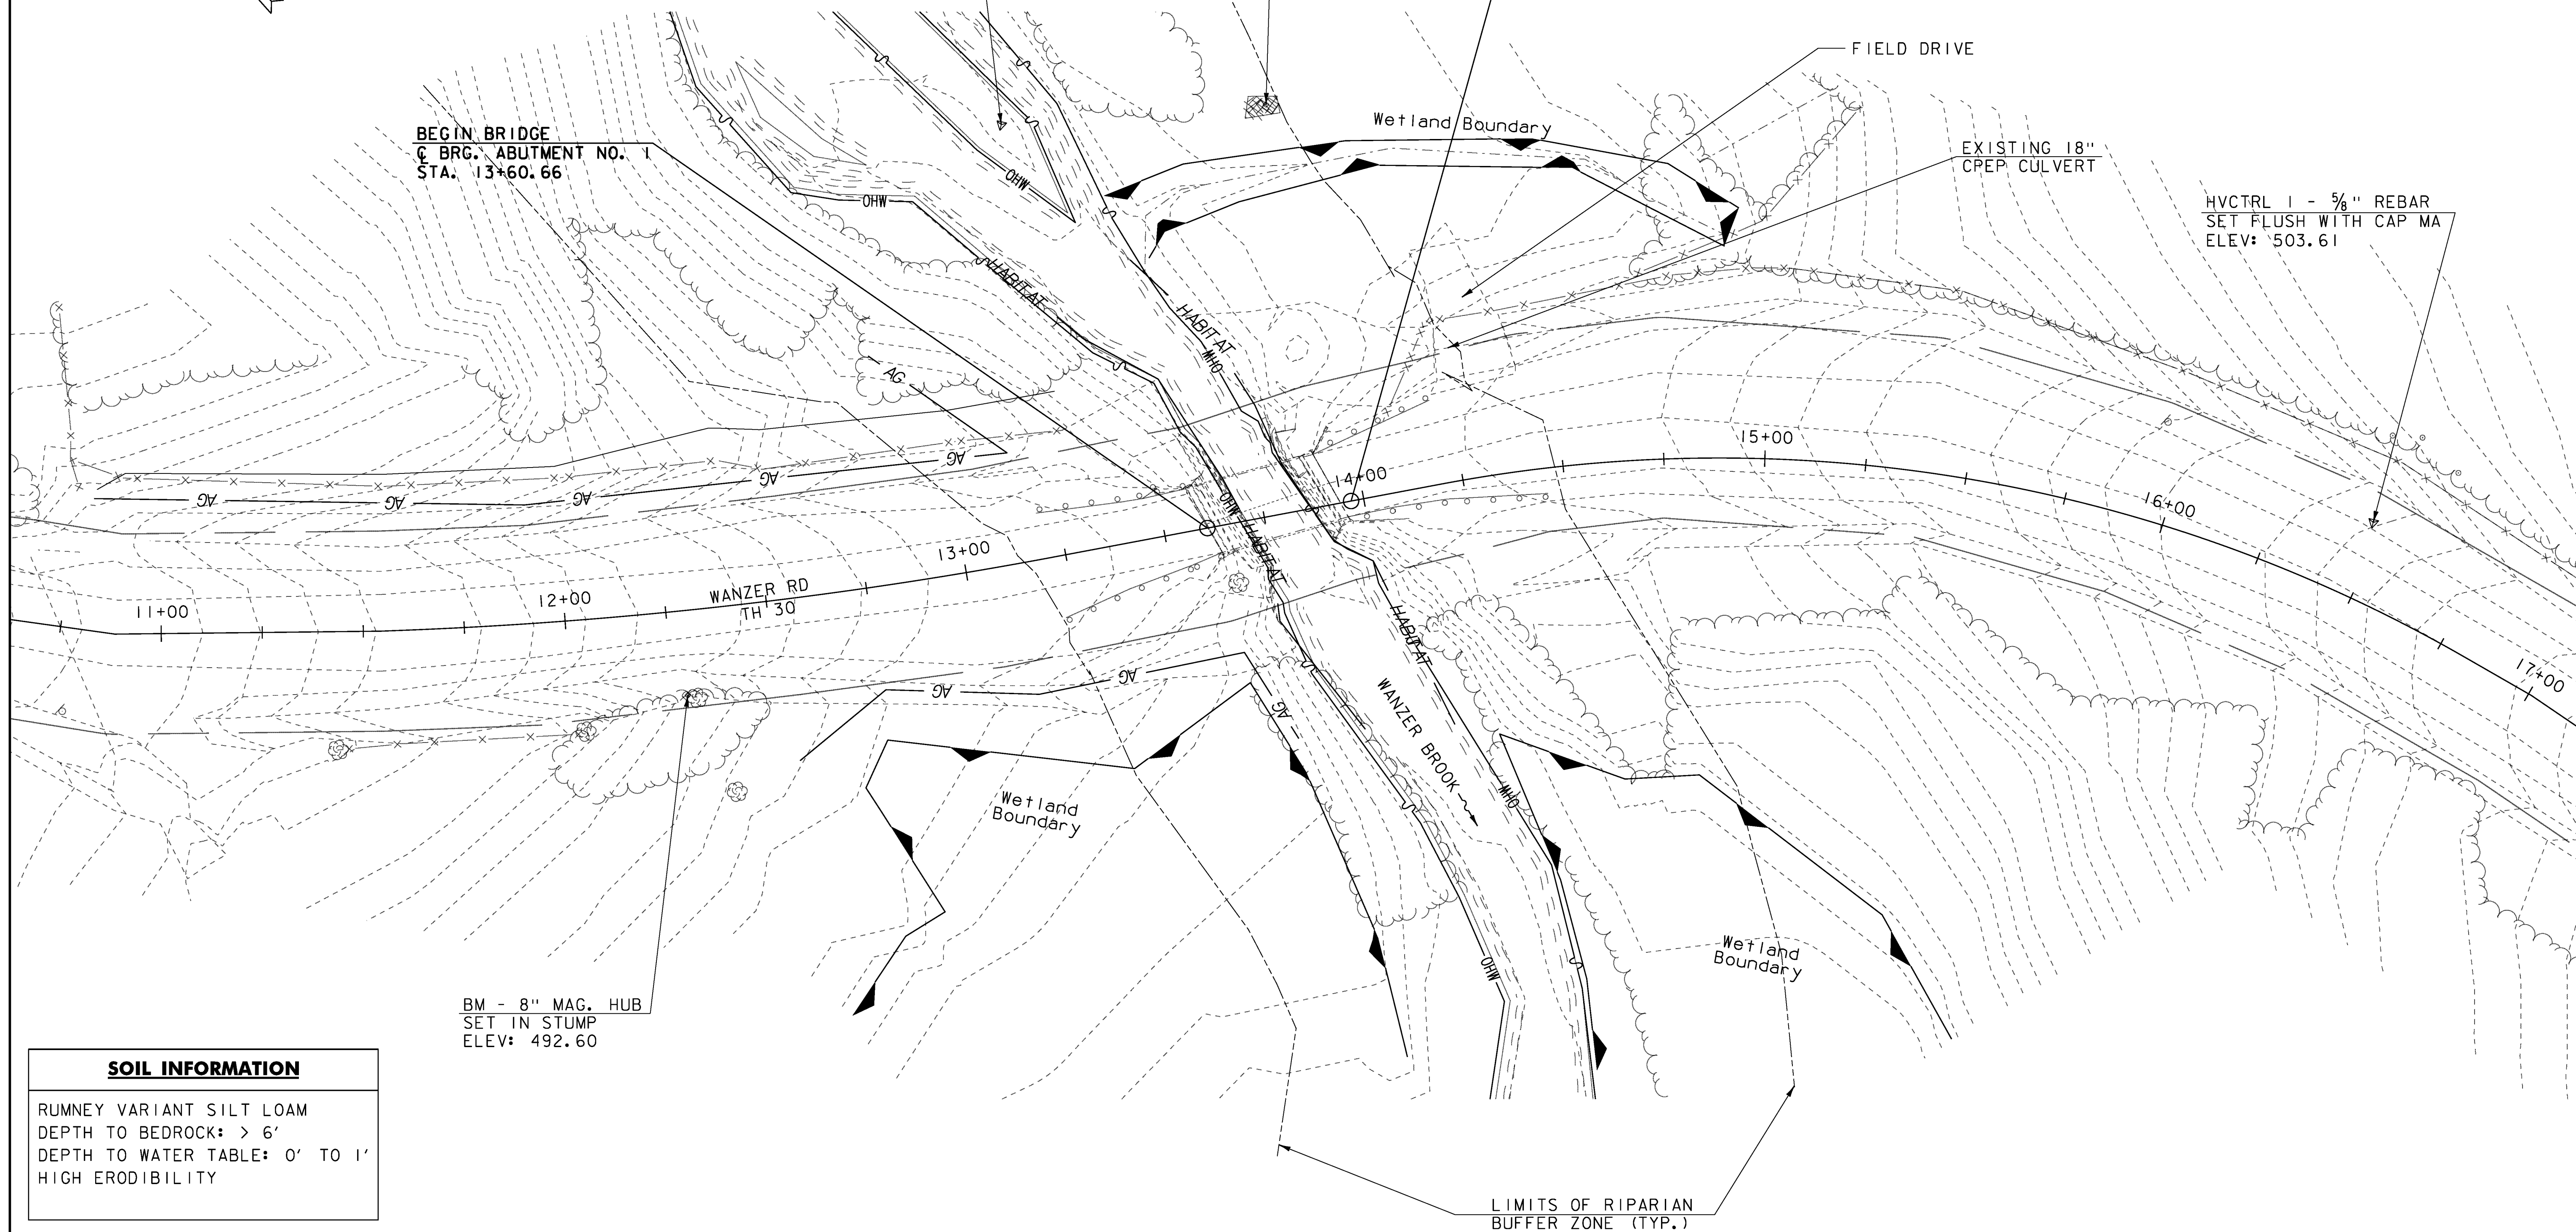

BM - 8" MAG. HUB
SET IN STUMP
ELEV: 492.60

SOIL INFORMATION

RUMNEY VARIANT SILT LOAM
DEPTH TO BEDROCK: > 6'
DEPTH TO WATER TABLE: 0' TO 1'
HIGH ERODIBILITY

LEGEND

- | | |
|--------------------------|-------------|
| RIPARIAN BUFFER ZONE | ----- |
| ORDINARY HIGH WATER | — OHW — |
| APPROX. WETLAND BOUNDARY | — HABITAT — |
| CRITICAL HABITAT | — AG — |
| AGRICULTURAL LAND | |


EXISTING CONDITIONS SITE PLAN

SCALE 1" = 20'-0"
20 0 20



PROJECT NAME: FAIRFIELD
PROJECT NUMBER: BRO 1448(38)

FILE NAME: z11j072bdr_ero.dgn	PLOT DATE: 01-NOV-2013
PROJECT LEADER: D. LANDRY	DRAWN BY: M. VALLETTA
DESIGNED BY: M. VALLETTA	CHECKED BY: T. KENDRICK
EPSC EXISTING CONDITIONS SITE PLAN	SHEET 14 OF 41

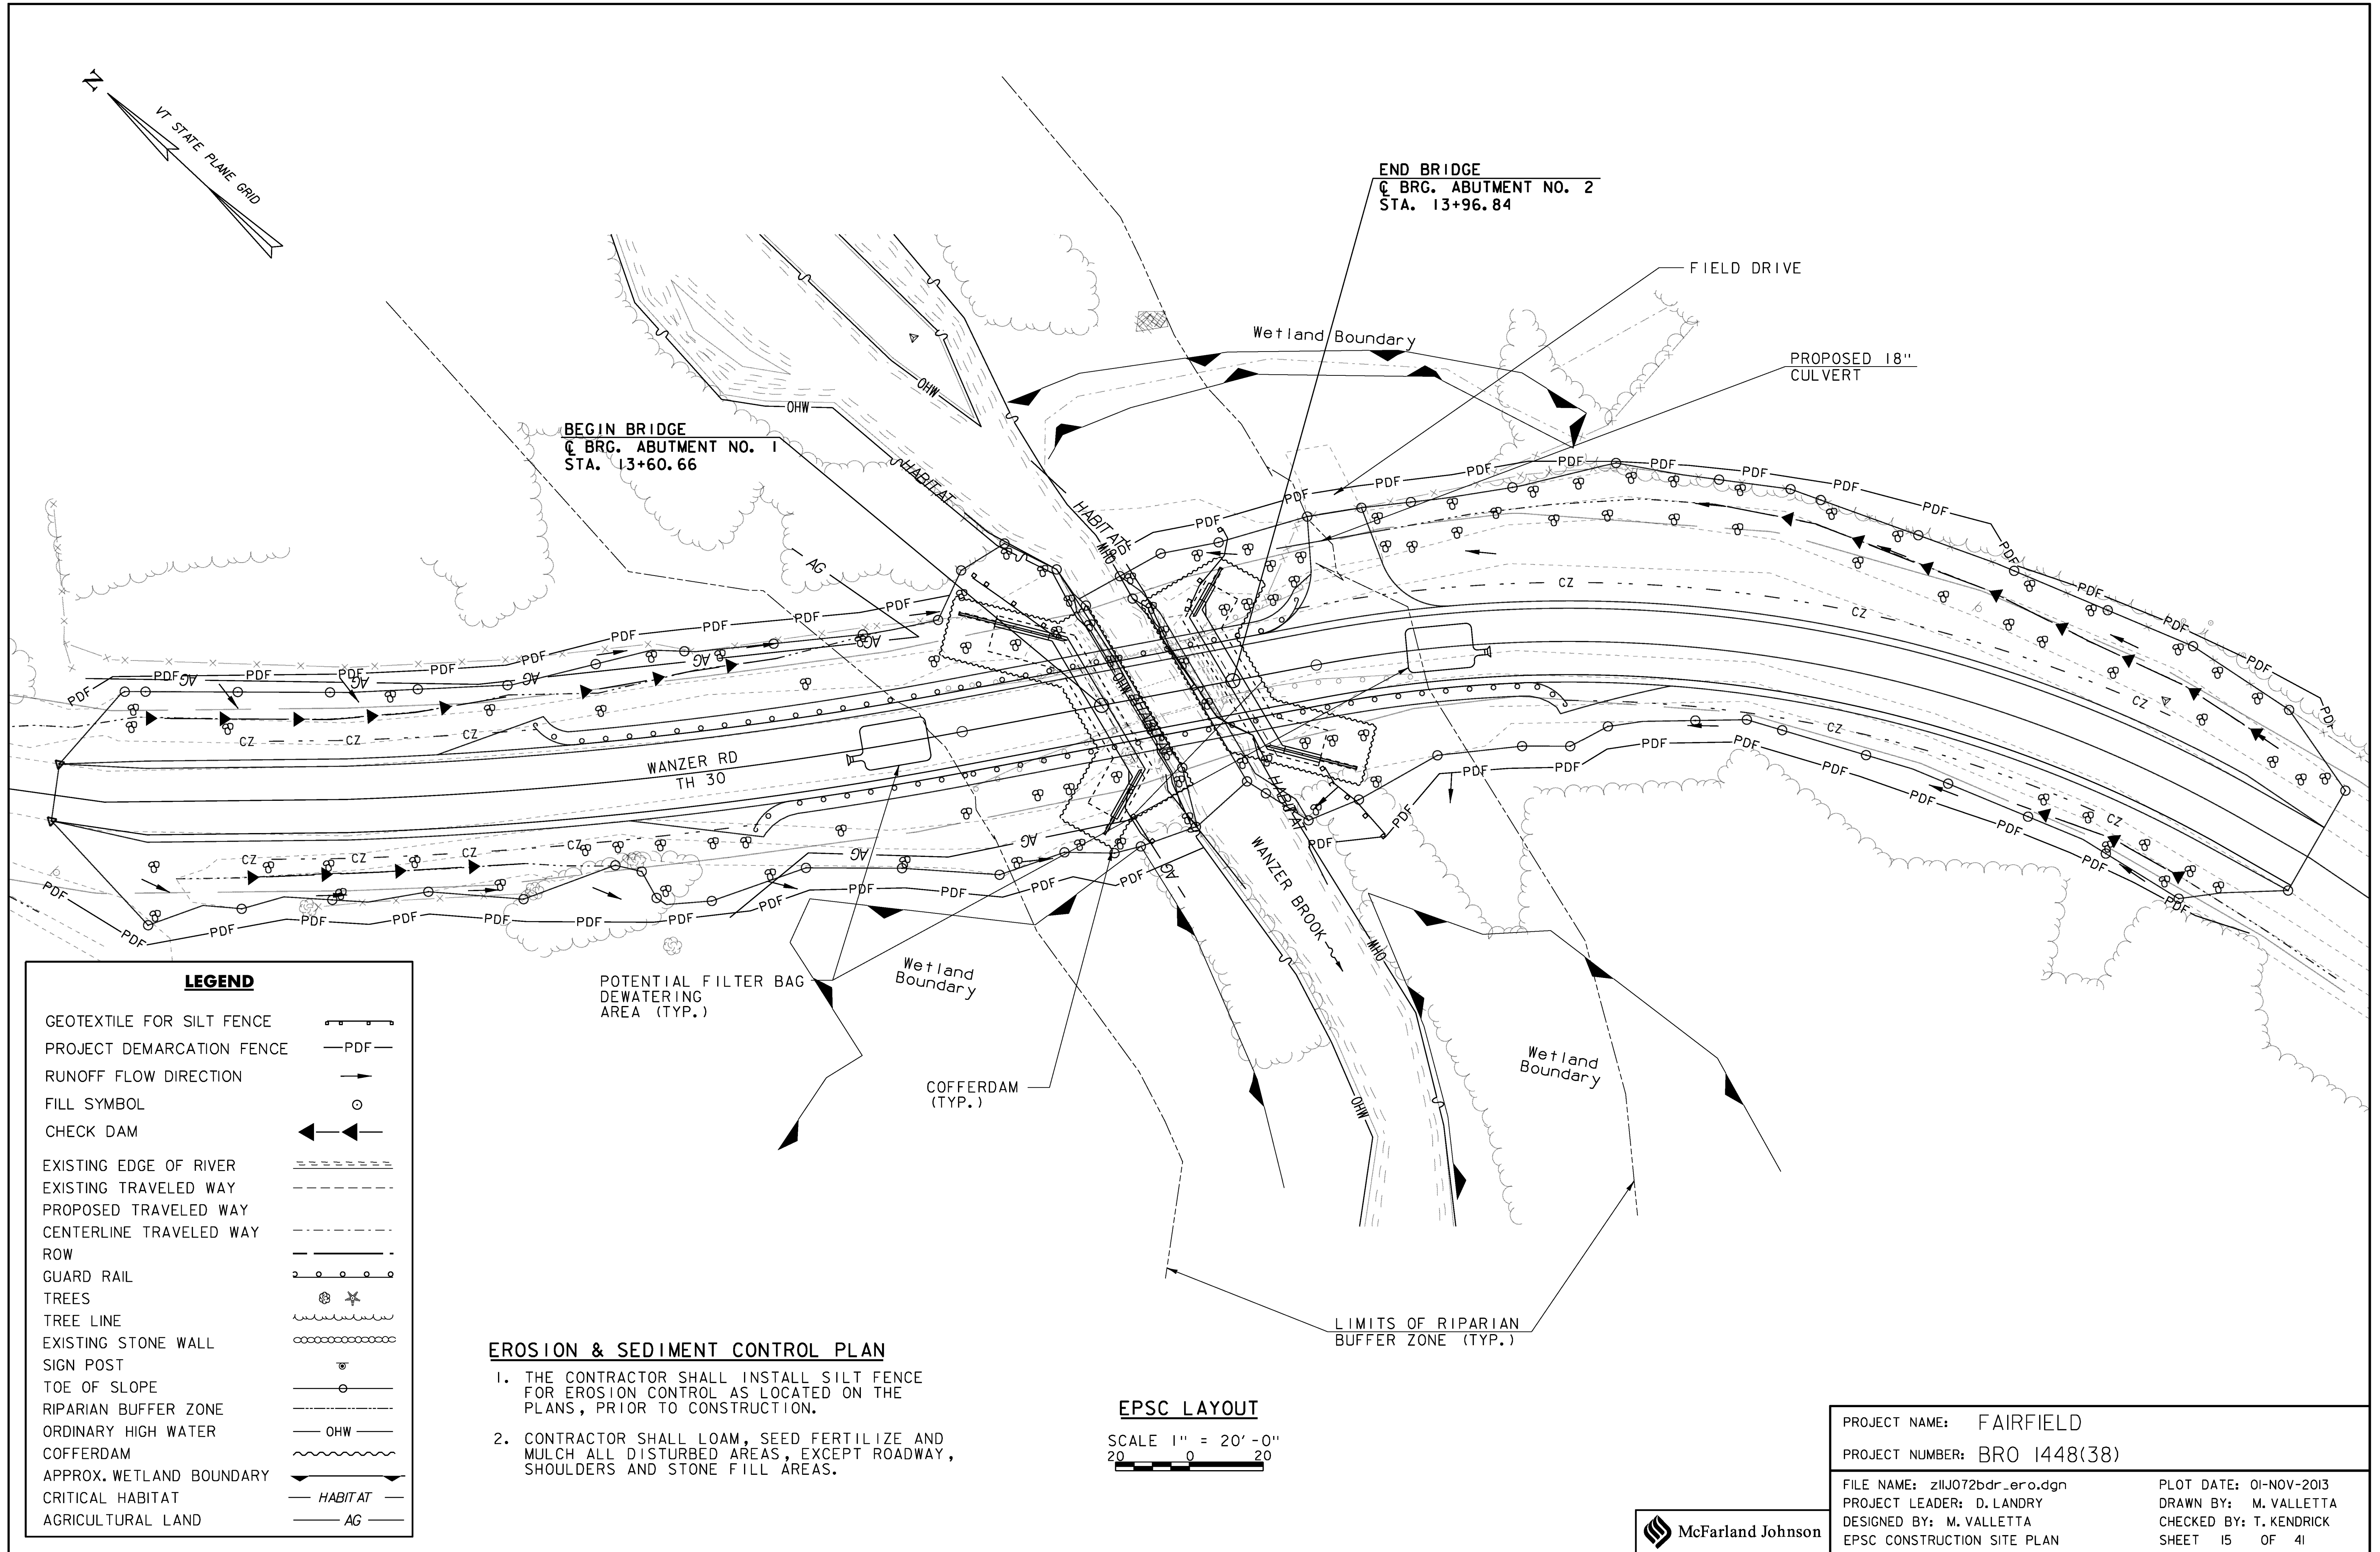

LEGEND

GEOTEXTILE FOR SILT FENCE	
PROJECT DEMARCATION FENCE	—PDF—
RUNOFF FLOW DIRECTION	
FILL SYMBOL	○
CHECK DAM	
EXISTING EDGE OF RIVER	
EXISTING TRAVELED WAY	
PROPOSED TRAVELED WAY	
CENTERLINE TRAVELED WAY	
ROW	
GUARD RAIL	
TREES	
TREE LINE	
EXISTING STONE WALL	
SIGN POST	
TOE OF SLOPE	
RIPARIAN BUFFER ZONE	
ORDINARY HIGH WATER	— OHW —
COFFERDAM	
APPROX. WETLAND BOUNDARY	
CRITICAL HABITAT	— HABITAT —
AGRICULTURAL LAND	— AG —

EROSION & SEDIMENT CONTROL PLAN



1. THE CONTRACTOR SHALL INSTALL SILT FENCE FOR EROSION CONTROL AS LOCATED ON THE PLANS, PRIOR TO CONSTRUCTION.
2. CONTRACTOR SHALL LOAM, SEED FERTILIZE AND MULCH ALL DISTURBED AREAS, EXCEPT ROADWAY, SHOULDERS AND STONE FILL AREAS.

EPSC LAYOUT

SCALE 1" = 20'-0"

PROJECT NAME:	FAIRFIELD
PROJECT NUMBER:	BRO 1448(38)
FILE NAME:	z11j072bdr_ero.dgn
PROJECT LEADER:	D. LANDRY
DESIGNED BY:	M. VALLETTA
EPSC CONSTRUCTION SITE PLAN	
PLOT DATE:	01-NOV-2013
DRAWN BY:	M. VALLETTA
CHECKED BY:	T. KENDRICK
SHEET	15 OF 41



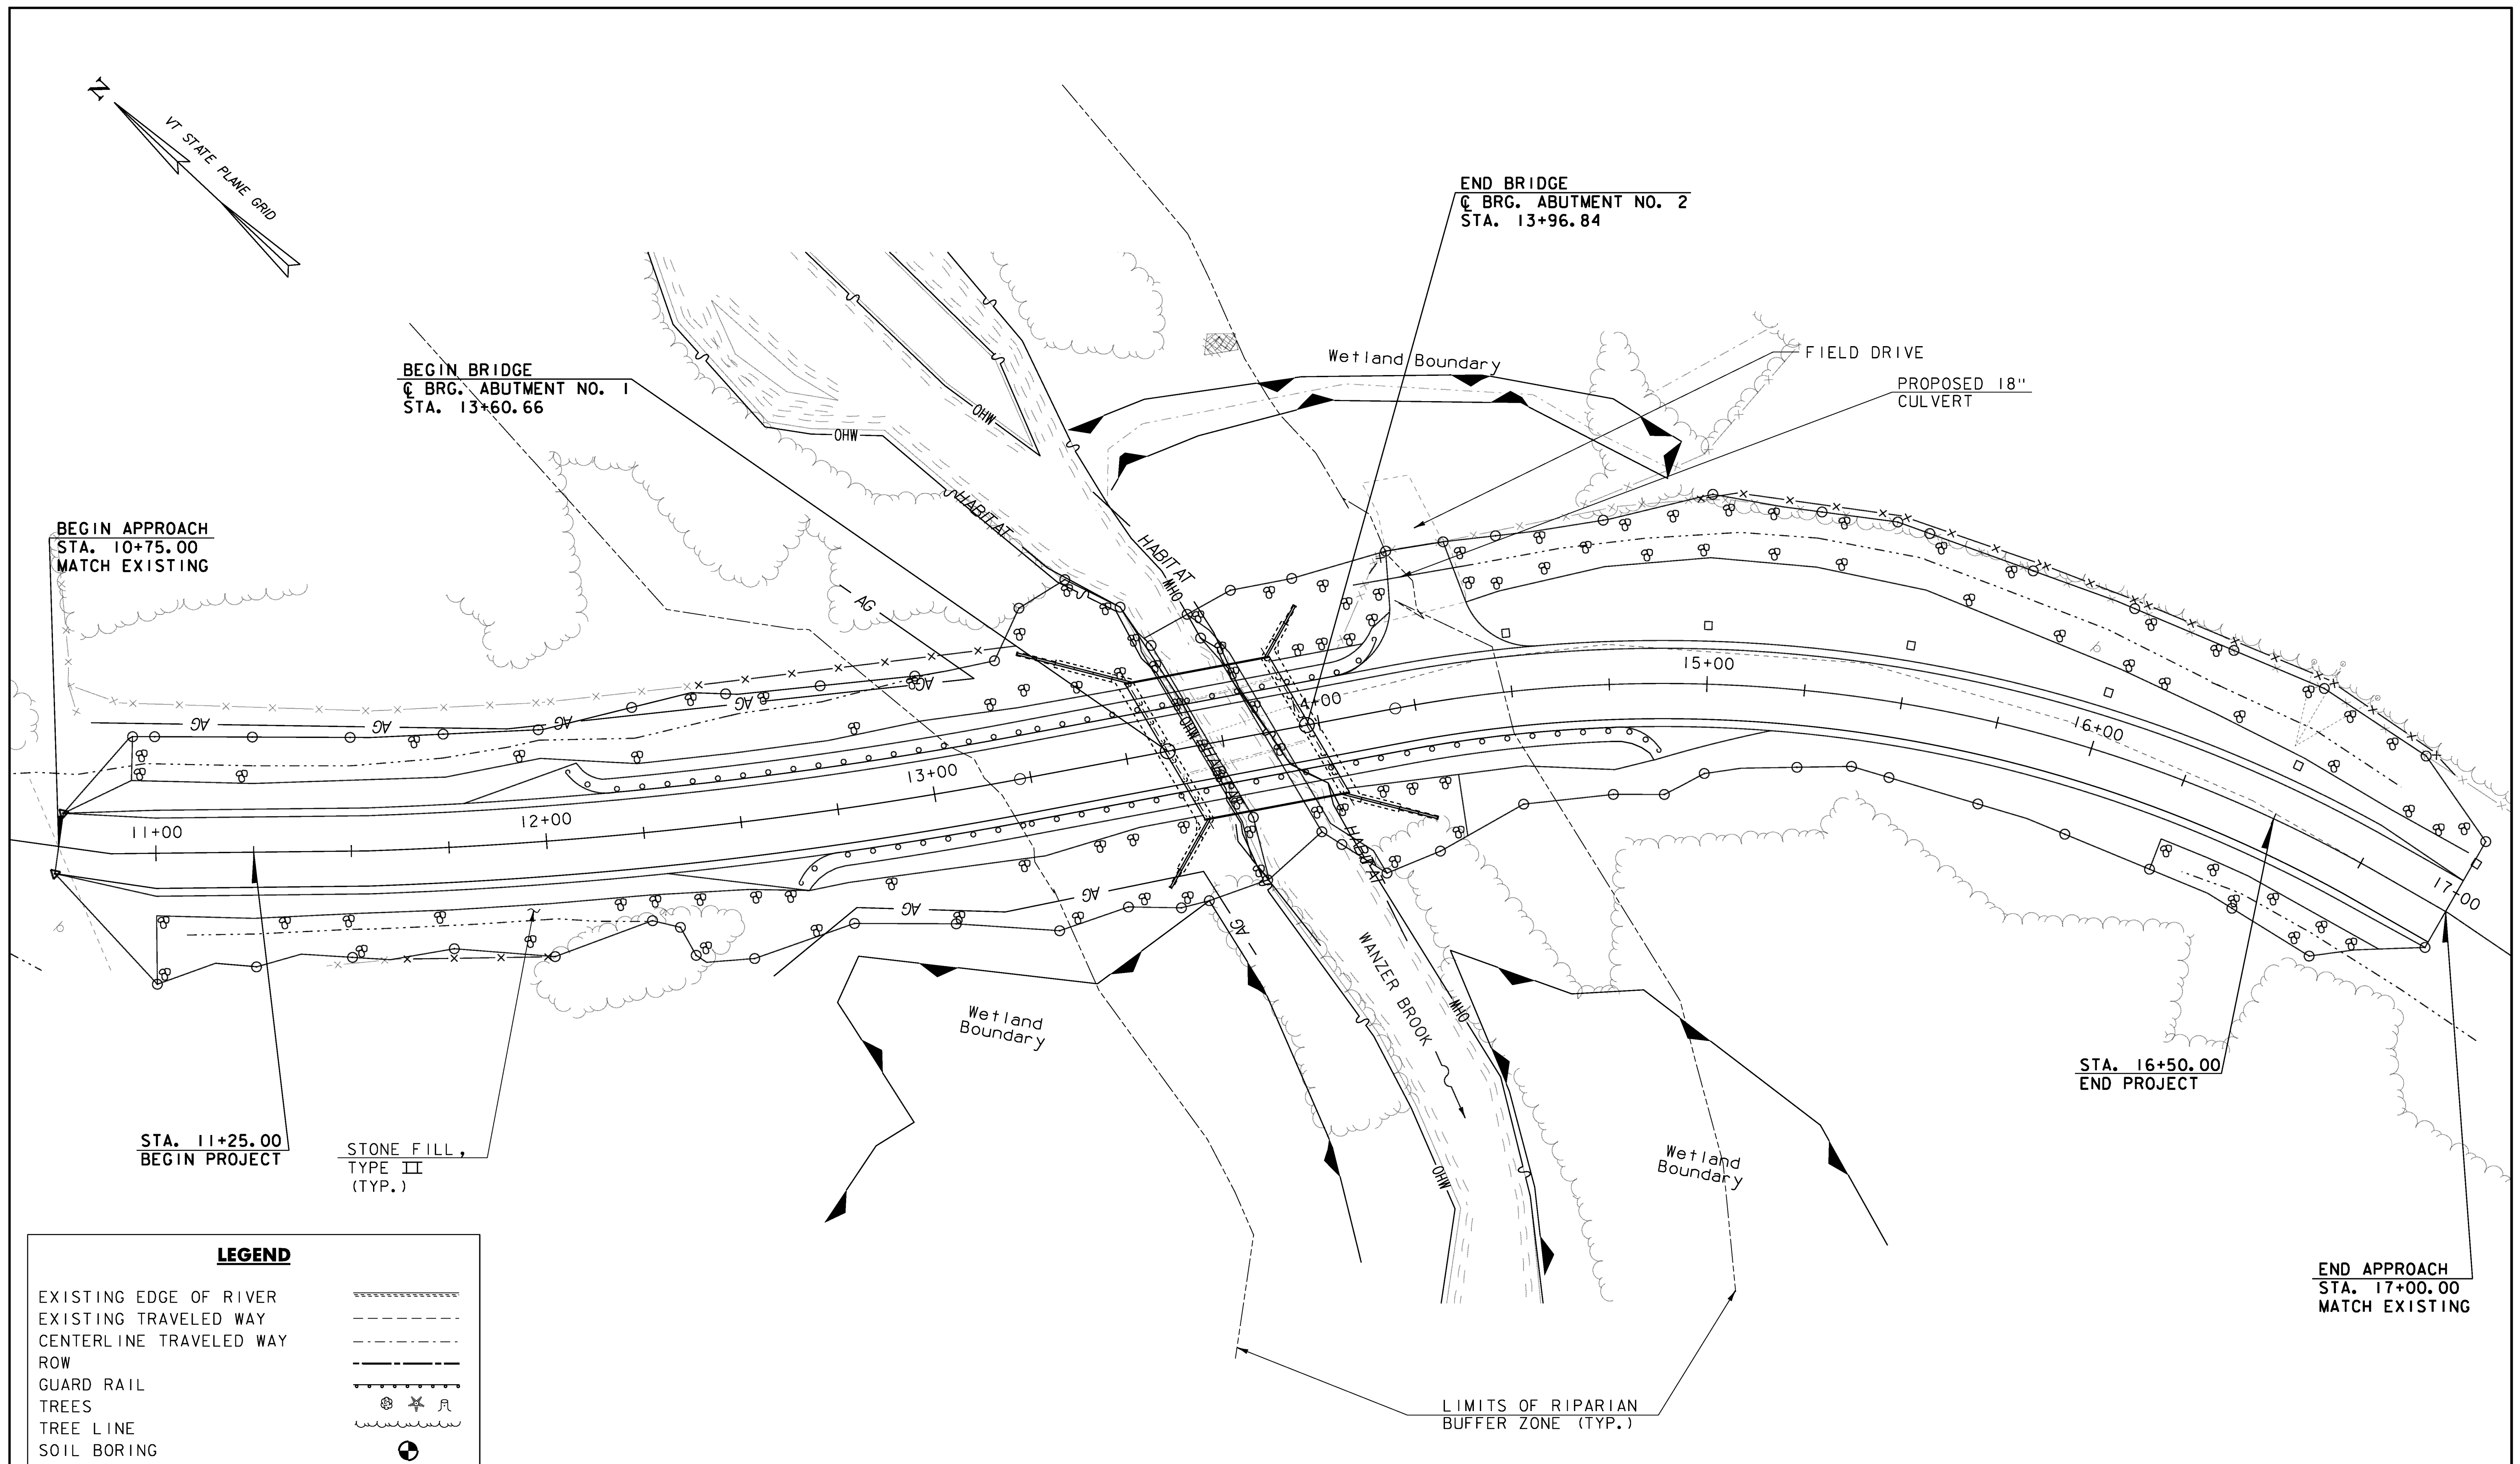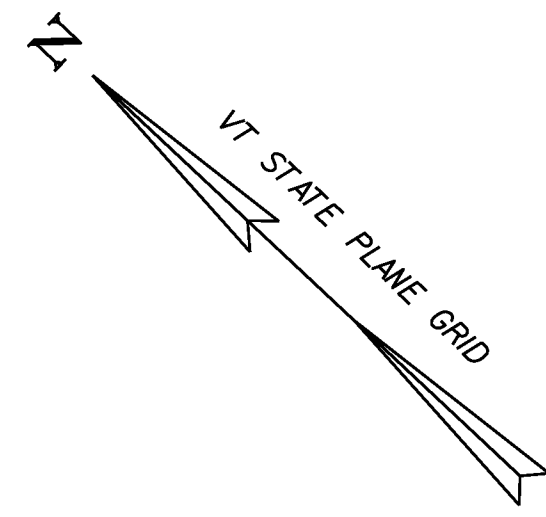

LEGEND


EXISTING EDGE OF RIVER	~~~~~
EXISTING TRAVELED WAY	-----
CENTERLINE TRAVELED WAY	- - - - -
ROW	-----
GUARD RAIL	-----
TREES	⊗ ⊛ ⊙
TREE LINE	~~~~~
SOIL BORING	⊕
EXISTING STONE WALL	-----
SIGN POST	⊕
RIPARIAN BUFFER ZONE	-----
ORDINARY HIGH WATER	— OHW —
APPROX. WETLAND BOUNDARY	— HABITAT —
CRITICAL HABITAT	— AG —
AGRICULTURAL LAND	— AG —

FINAL CONDITIONS SITE PLAN

SCALE 1" = 20'-0"
 20 0 20

PROJECT NAME: FAIRFIELD	
PROJECT NUMBER: BRO 1448(38)	
FILE NAME: z11j072bdr_ero.dgn	PLOT DATE: 01-NOV-2013
PROJECT LEADER: D. LANDRY	DRAWN BY: M. VALLETTA
DESIGNED BY: M. VALLETTA	CHECKED BY: T. KENDRICK
EPSC FINAL CONDITIONS SITE PLAN	SHEET 16 OF 41



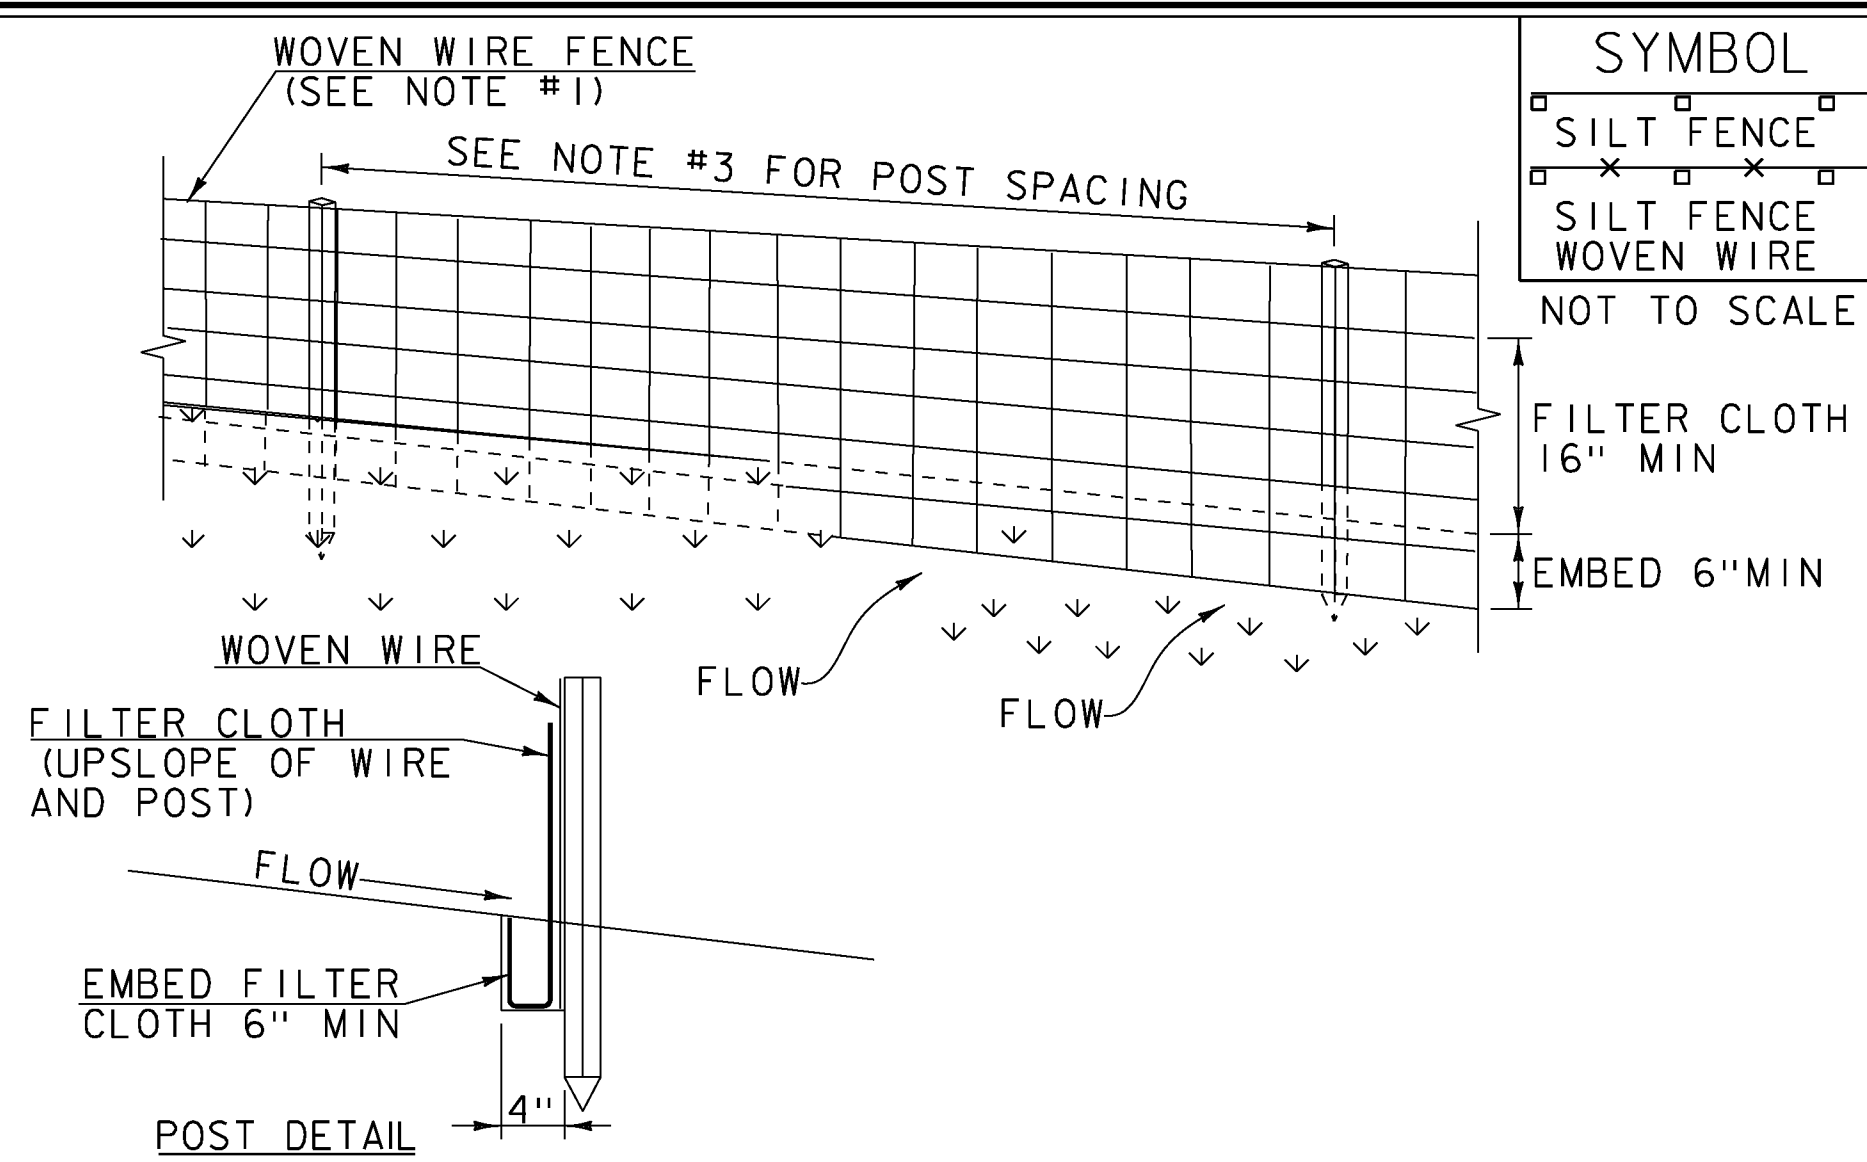

SYMBOL
 SILT FENCE
 SILT FENCE WOVEN WIRE
 NOT TO SCALE

CONSTRUCTION SPECIFICATIONS

1. WOVEN WIRE REINFORCED FENCE IS REQUIRED WITHIN 100' UPSLOPE OF RECEIVING WATERS WHEN THE PROJECT FALLS UNDER A CONSTRUCTION STORMWATER PERMIT. WOVEN WIRE SHALL BE A MIN. 14 GAUGE WITH A 6" MAX. MESH OPENING.
2. FILTER CLOTH SHALL BE EITHER FILTER X, MIRAF1100X, STABILINKA T140N OR APPROVED EQUIVALENT.
3. POST SPACING FOR WIRE-BACKED FENCE SHALL BE 10' MAXIMUM. FOR FILTER-CLOTH FENCE, WHEN ELONGATION IS >50%, POST SPACING SHALL NOT EXCEED 4' AND WHEN ELONGATION IS <50%, POST SPACING SHALL NOT EXCEED 6'.
4. WOVEN WIRE FENCE IS TO BE FASTENED SECURELY TO FENCE POSTS WITH WIRE TIES. FILTER CLOTH IS TO BE FASTENED SECURELY TO WOVEN WIRE FENCE WITH TIES SPACED EVERY 24" AT TOP AND MID SECTION.
5. WHEN TWO SECTIONS OF FILTER CLOTH ADJOIN EACH OTHER THEY SHALL BE OVER-LAPPED BY 6" AND FOLDED.
6. MAINTENANCE SHALL BE PERFORMED AS NEEDED AND MATERIAL REMOVED WHEN SEDIMENT REACHES HALF OF FABRIC HEIGHT.


ADAPTED FROM DETAILS PROVIDED BY: NEW YORK STATE DEC
 ORIGINALLY DEVELOPED BY USDA-NRCS
 VERMONT DEPARTMENT OF ENVIRONMENTAL CONSERVATION

SILT FENCE

NOTES:
 REFER TO "THE VERMONT STANDARDS & SPECIFICATIONS FOR EROSION PREVENTION & SEDIMENT CONTROL -2006-" FROM THE VT AGENCY OF NATURAL RESOURCES FOR ADDITIONAL GUIDANCE.

THIS WORK SHALL BE PERFORMED IN ACCORDANCE WITH SECTION 649 AND AS SHOWN IN THE PLANS FOR GEOTEXTILE FOR SILT FENCE (PAY ITEM 649.51) OR GEOTEXTILE FOR SILT FENCE, WOVEN WIRE REINFORCED (PAY ITEM 649.515).

REVISIONS	
MARCH 21, 2008	WHF
DECEMBER 11, 2008	WHF
JANUARY 13, 2009	WHF

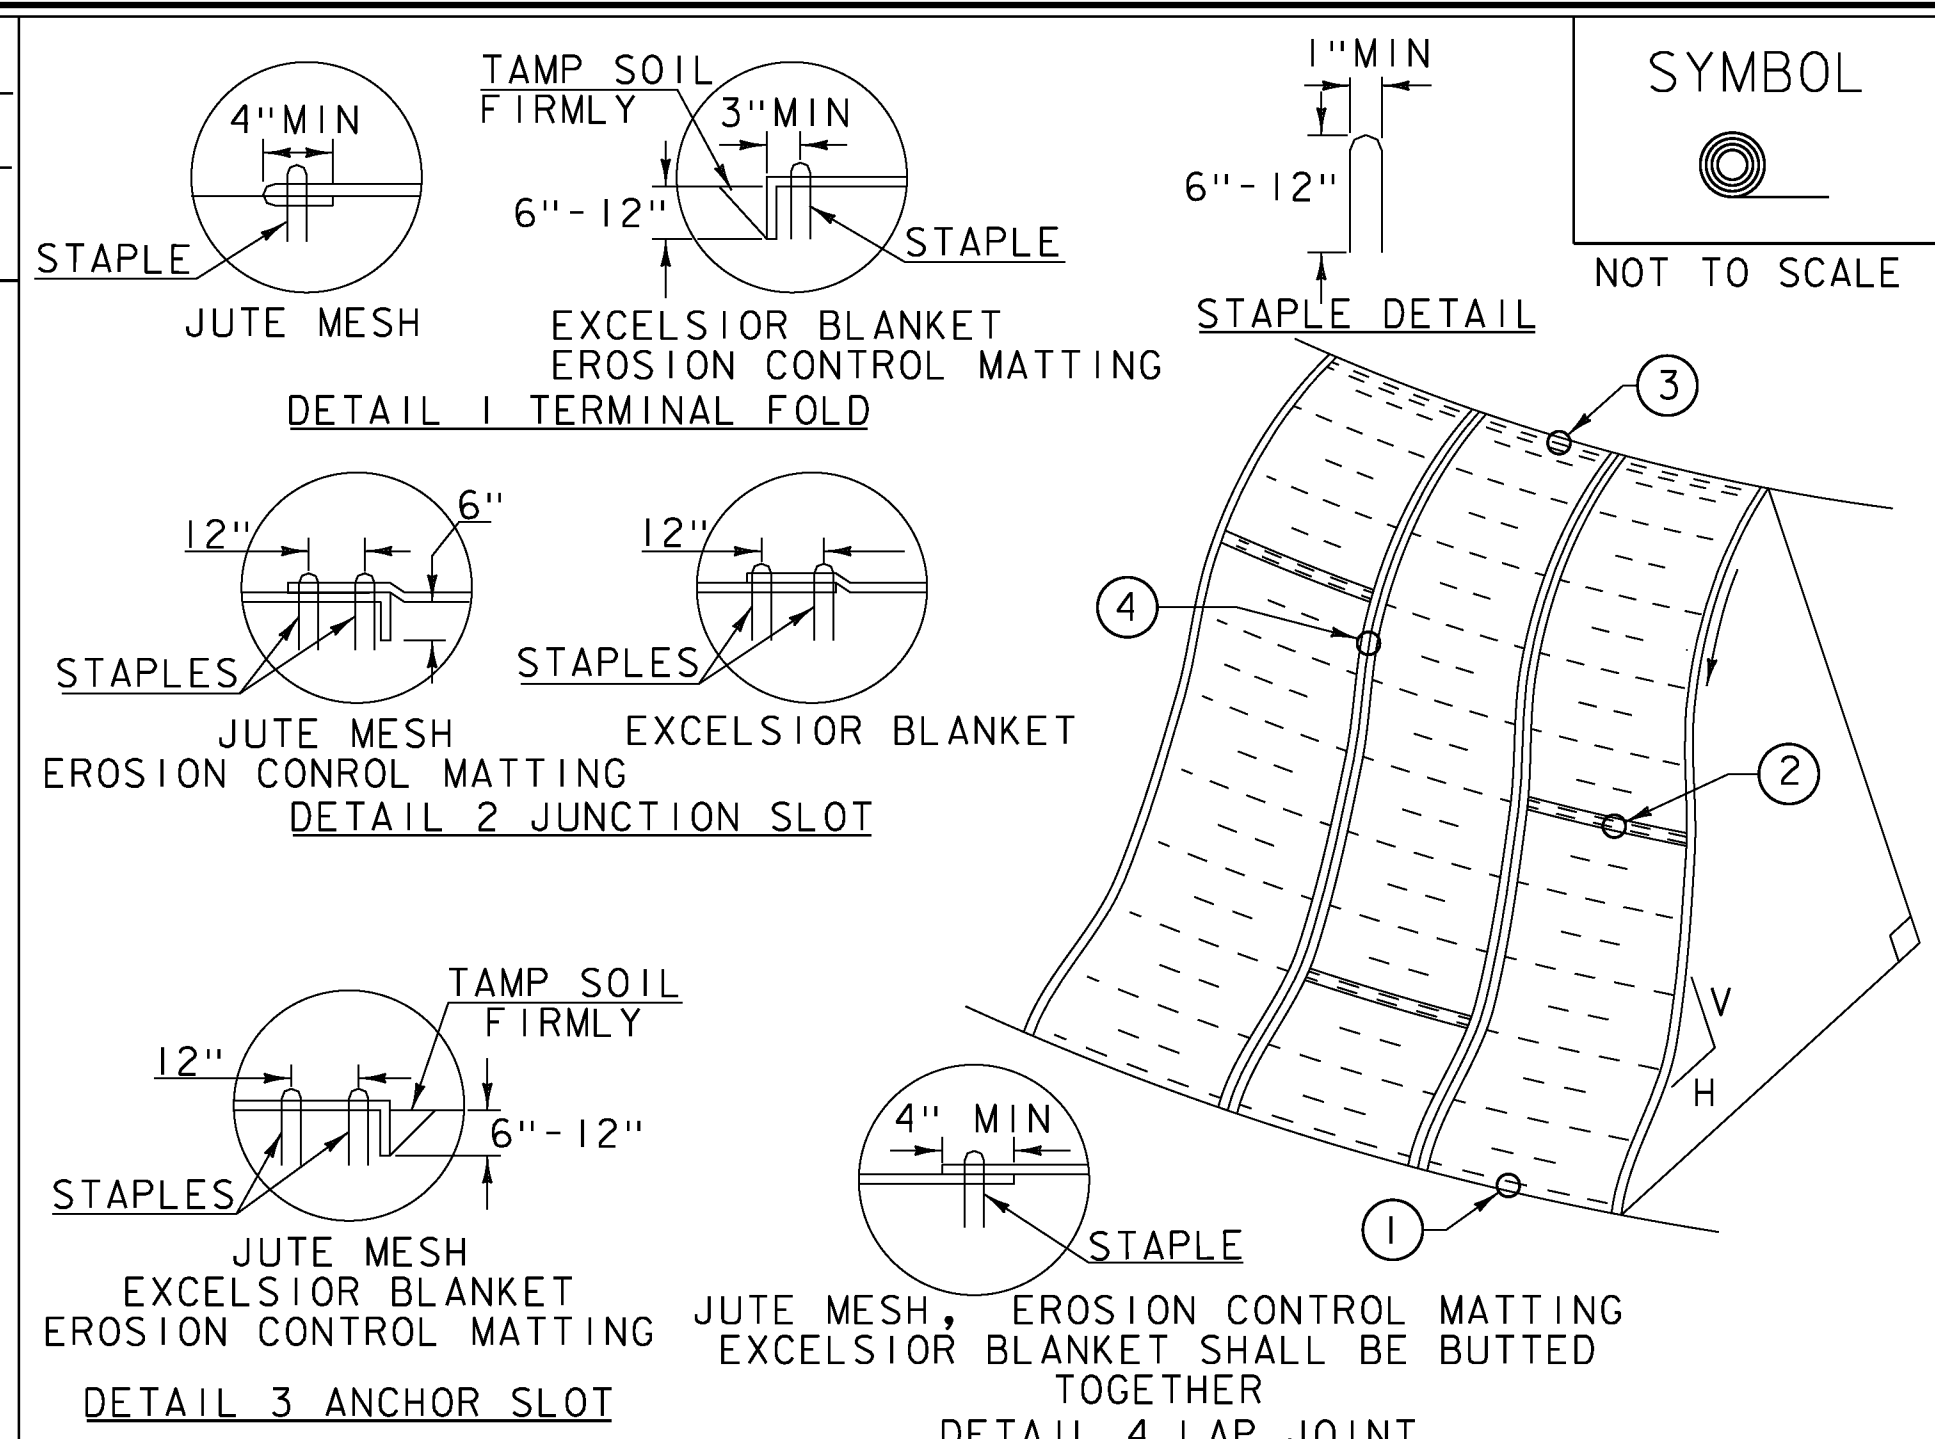

SYMBOL
 NOT TO SCALE

CONSTRUCTION SPECIFICATIONS


1. APPLY TO SLOPES GREATER THAN 3H:1V OR WHERE NECESSARY TO AID IN ESTABLISHING VEGETATION.
2. APPLY FERTILIZER, LIME SEED PRIOR TO PLACING MATTING.
3. STAPLES ARE TO BE PLACED ALTERNATELY, IN COLUMNS APPROXIMATELY 2' APART AND IN ROWS APPROXIMATELY 3' APART. APPROXIMATELY 175 STAPLES ARE REQUIRED PER 4' X 225' ROLL OF MATERIAL AND 125 STAPLES ARE REQUIRED PER 4' X 150' ROLL OF MATERIAL.
4. DISTURBED AREAS SHALL BE SMOOTHLY GRADED. EROSION CONTROL MATERIAL SHALL BE PLACED LOOSELY OVER GROUND SURFACE. DO NOT STRETCH.
5. ALL TERMINAL ENDS AND TRANSVERSE LAPS SHALL BE STAPLED AT APPROXIMATELY 12" INTERVALS.

ADAPTED FROM DETAILS PROVIDED BY: NEW YORK STATE DEC
 ORIGINALLY DEVELOPED BY USDA-NRCS
 VERMONT DEPARTMENT OF ENVIRONMENTAL CONSERVATION

ROLLED EROSION CONTROL PRODUCT (RECP) SIDE SLOPE

NOTES:
 REFER TO "THE VERMONT STANDARDS & SPECIFICATIONS FOR EROSION PREVENTION & SEDIMENT CONTROL -2006-" FROM THE VT AGENCY OF NATURAL RESOURCES FOR ADDITIONAL GUIDANCE.
 THIS WORK SHALL BE PERFORMED IN ACCORDANCE WITH SECTION 653 AND AS SHOWN IN THE PLANS FOR TEMPORARY EROSION MATTING (PAY ITEM 653.20) OR PERMANENT EROSION MATTING (PAY ITEM 653.21).

REVISIONS	
APRIL 16, 2007	JMF
JANUARY 13, 2009	WHF

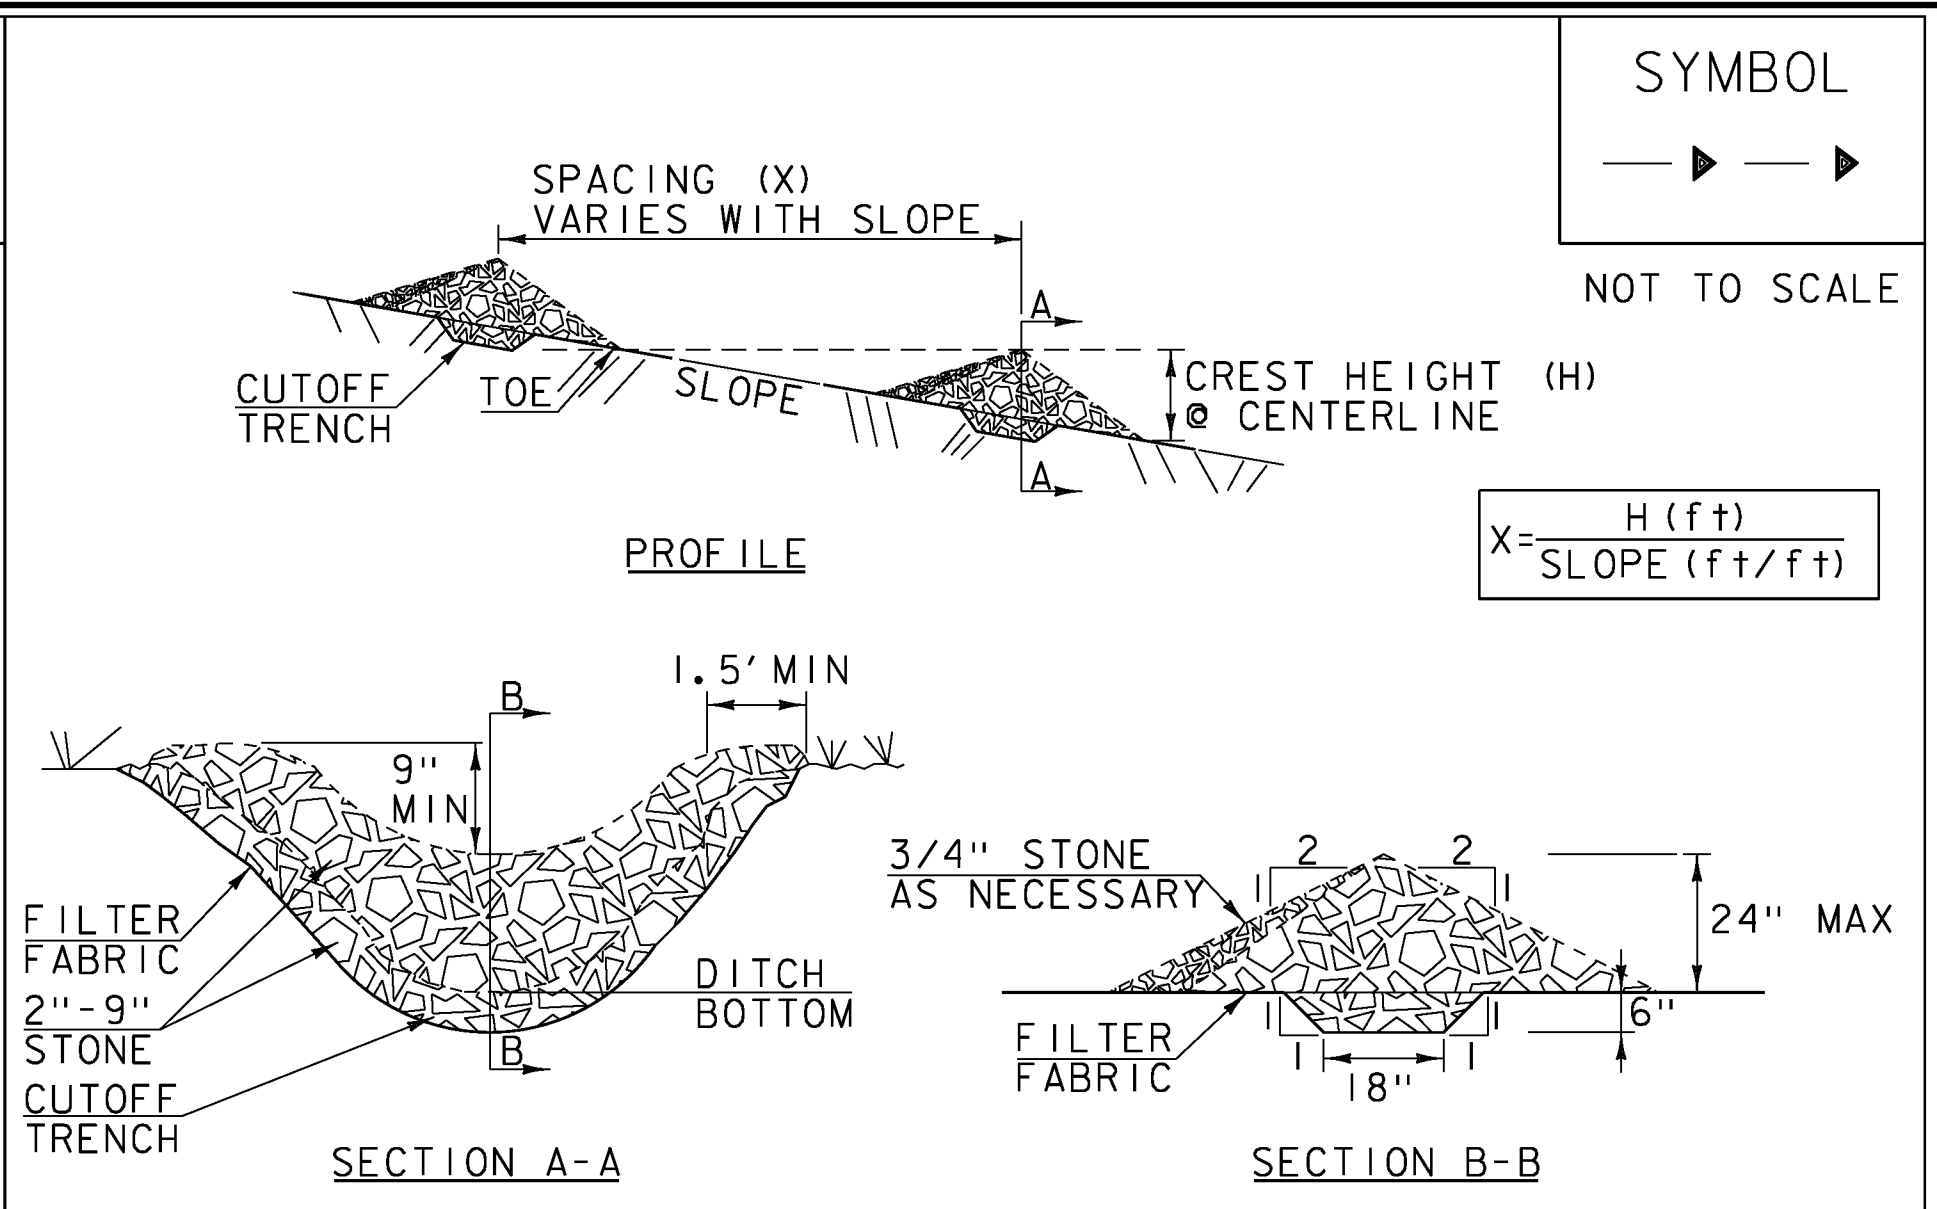

SYMBOL
 NOT TO SCALE

CONSTRUCTION SPECIFICATIONS

1. STONE WILL BE PLACED ON A FILTER FABRIC FOUNDATION.
2. CHECK DAMS SHALL BE SPACED SO THAT THE ELEVATION OF THE CREST OF THE DOWNSTREAM DAM IS AT THE SAME ELEVATION AS THE TOE OF THE UPSTREAM DAM.
3. 3/4" FILTERING STONE MAY BE ADDED TO THE FACE OF THE CHECK DAM AS NECESSARY.
4. EXTEND THE STONE A MINIMUM OF 1.5' BEYOND THE DITCH BANKS TO PREVENT CUTTING AROUND THE DAM.
5. PROTECT CHANNEL DOWNSTREAM OF THE LOWEST CHECK DAM FROM SCOUR AND EROSION WITH STONE OR LINER AS APPROPRIATE.
6. ENSURE THAT CHANNEL APPURTENANCES SUCH AS CULVERT ENTRANCES BELOW CHECK DAMS ARE NOT SUBJECT TO DAMAGE OR BLOCKAGE FROM DISPLACED STONE.
7. MAXIMUM DRAINAGE AREA 2 ACRES.


ADAPTED FROM DETAILS PROVIDED BY: NEW YORK STATE DEC
 ORIGINALLY DEVELOPED BY USDA-NRCS
 VERMONT DEPARTMENT OF ENVIRONMENTAL CONSERVATION

CHECK DAM

NOTES:
 REFER TO "THE VERMONT STANDARDS & SPECIFICATIONS FOR EROSION PREVENTION & SEDIMENT CONTROL -2006-" FROM THE VT AGENCY OF NATURAL RESOURCES FOR ADDITIONAL GUIDANCE.

THIS WORK SHALL BE PERFORMED IN ACCORDANCE WITH SECTION 653 FOR TEMPORARY STONE CHECK DAM, TYPE 1 (PAY ITEM 653.25)

REVISIONS	
MARCH 21, 2008	WHF
JANUARY 8, 2009	WHF

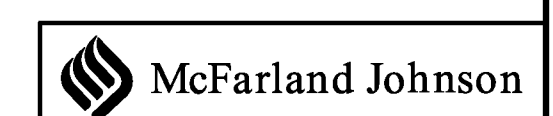

PROJECT NAME: FAIRFIELD
 PROJECT NUMBER: BRO 1448(38)

FILE NAME: z11j072epsc_det_01.dgn
 PROJECT LEADER: D. LANDRY
 DESIGNED BY: E. ALEXOPOULOS
 EPSC DETAILS (1 OF 2)

PLOT DATE: 01-NOV-2013
 DRAWN BY: W. GAYNOR
 CHECKED BY: T. KENDRICK
 SHEET 17 OF 41


VAOT RURAL AREA MIX					
% WEIGHT	LBS/AC		NAME	GERM %	PURITY %
	BROADCAST	HYDROSEED			
37.5%	22.5	45	CREeping RED FESCUE	85%	98%
37.5%	22.5	45	TALL FESCUE	90%	95%
5.0%	3	6	RED TOP	90%	95%
15.0%	9	18	BIRDSFOOT TREFOIL	85%	98%
5.0%	3	6	ANNUAL RYE GRASS	85%	95%
100%	60	120			

VAOT URBAN AREA MIX					
% WEIGHT	LBS/AC		NAME	GERM %	PURITY %
	BROADCAST	HYDROSEED			
42.5%	34	68	CREeping RED FESCUE	85%	98%
10.0%	8	16	PERENNIAL RYE GRASS	90%	95%
42.5%	34	68	KENTUCKY BLUE GRASS	85%	85%
5.0%	4	8	ANNUAL RYE GRASS	85%	95%
100%	80	160			

SOIL AMENDMENT GUIDANCE			
FERTILIZER		LIME	
BROADCAST	HYDROSEED	BROADCAST	HYDROSEED
10-20-10	FOLLOW	PELLETIZED	FOLLOW
500 LBS/AC	MANUFACTURER	2 TONS/AC	MANUFACTURER


CONSTRUCTION GUIDANCE

- RURAL SEED MIX: USE AS INDICATED IN THE PLANS AND/OR FOR ALL ESTABLISHED UPLAND (NON WETLAND) AREAS DISTURBED BY THE CONTRACTOR.
- URBAN SEED MIX: USE AS INDICATED IN THE PLANS AND/OR FOR ALL ESTABLISHED LAWN AREAS DISTURBED BY THE CONTRACTOR.
- ALL SEED MIXTURES: SHALL NOT HAVE A WEED CONTENT EXCEEDING 0.40% BY WEIGHT AND SHALL BE FREE OF ALL NOXIOUS SEED.
- FERTILIZER AND LIMESTONE: SHALL FOLLOW RATES SHOWN ON PLAN OR AS DIRECTED BY THE ENGINEER
- HAY MULCH: TO BE PLACED ON EARTH SLOPES AT THE RATE OF 2 TONS/ACRE, ACHIEVE 90% GROUND COVER OR AS DIRECTED BY THE ENGINEER.
- TOPSOIL: TO BE USED WITH SEED AS INDICATED ON THE PLANS, OR AS DIRECTED BY THE ENGINEER.
- HYDROSEEDING: ALTHOUGH GUIDANCE IS GIVEN ABOVE THE SITE CONDITIONS AND THE TYPE OF HYDROSEED WILL ULTIMATELY DICTATE THE AMOUNTS AND TYPES OF SOIL AMENDMENTS TO BE APPLIED
- TURF ESTABLISHMENT: PLACING SEED, FERTILIZER, LIME AND MULCH PRIOR TO SEPTEMBER 15 AND AFTER APRIL 15 CAN BETTER ENSURE A VIGOROUS GROWTH OF GRASS.

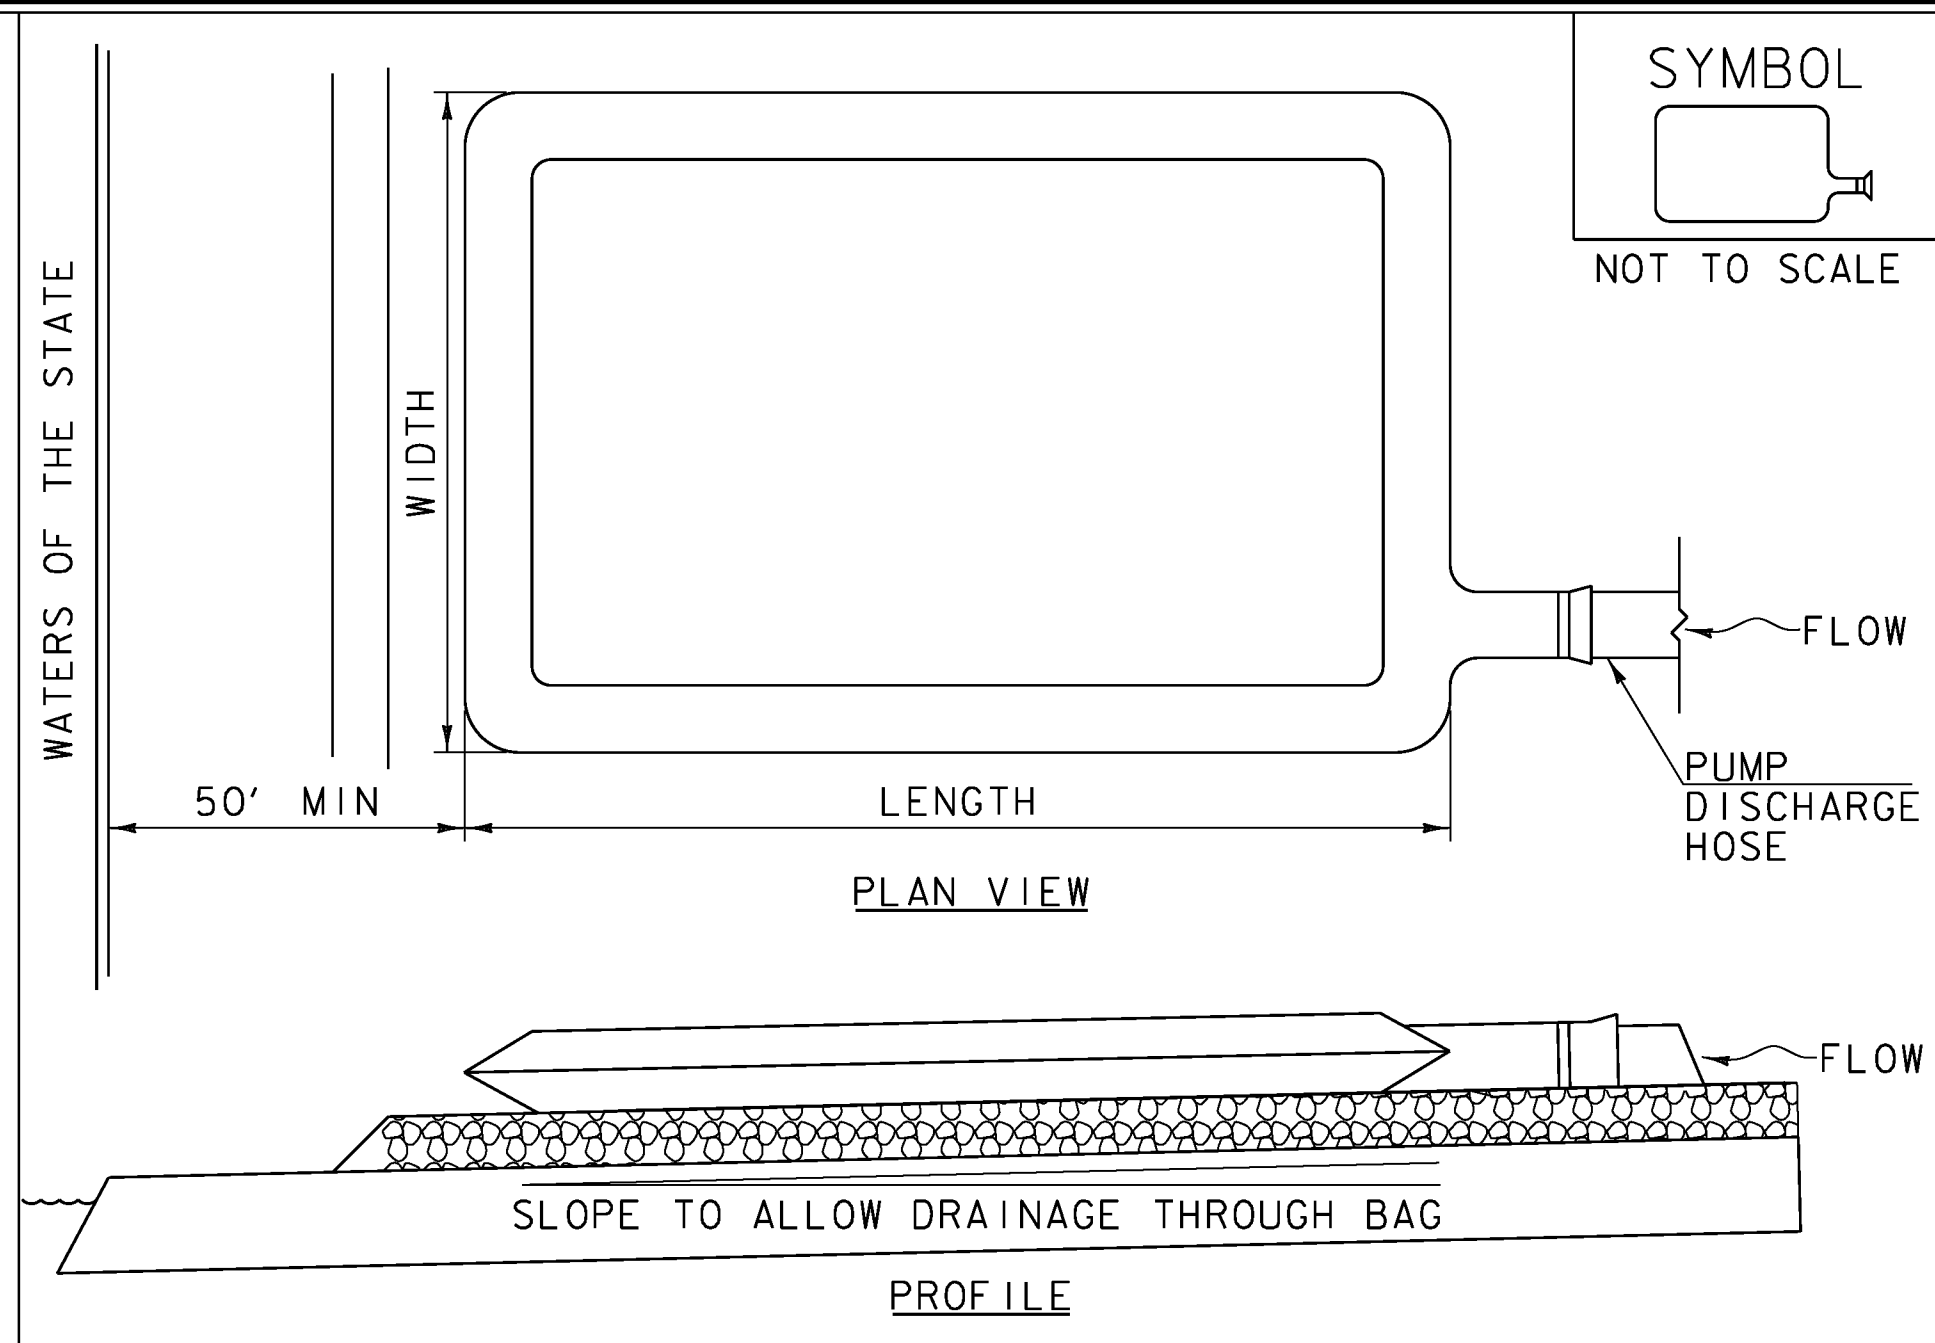

CONSTRUCTION SPECIFICATIONS

- THE PRIMARY PURPOSE OF FILTER BAG IS TO RETAIN SILT, SAND, AND FINES DURING DEWATERING OPERATIONS.
- FILTER BAGS SHALL BE INSTALLED ON A VEGETATED SLOPE GRADED TO ALLOW INCOMING WATER TO FLOW THROUGH THE BAG.
- FILTER BAGS MAY ALSO BE PLACED ON COARSE AGGREGATE, STONE, OR HAYBALES TO INCREASE FILTRATION EFFICIENCY.
- FILTER BAGS SHALL BE LOCATED A MINIMUM OF 50' FROM WATERS OF THE STATE UNLESS OTHERWISE APPROVED BY THE ENGINEER.
- THE NECK OF THE FILTER BAG SHALL BE STRAPPED TIGHTLY TO THE DISCHARGE HOSE.
- A FILTER BAG IS FULL WHEN IT NO LONGER CAN EFFICIENTLY FILTER SEDIMENT OR ALLOW WATER TO PASS AT A REASONABLE RATE.
- FILTER BAG SHALL BE DISPOSED OF AS APPROVED IN THE EPSC PLAN OR AS DIRECTED BY THE ENGINEER.

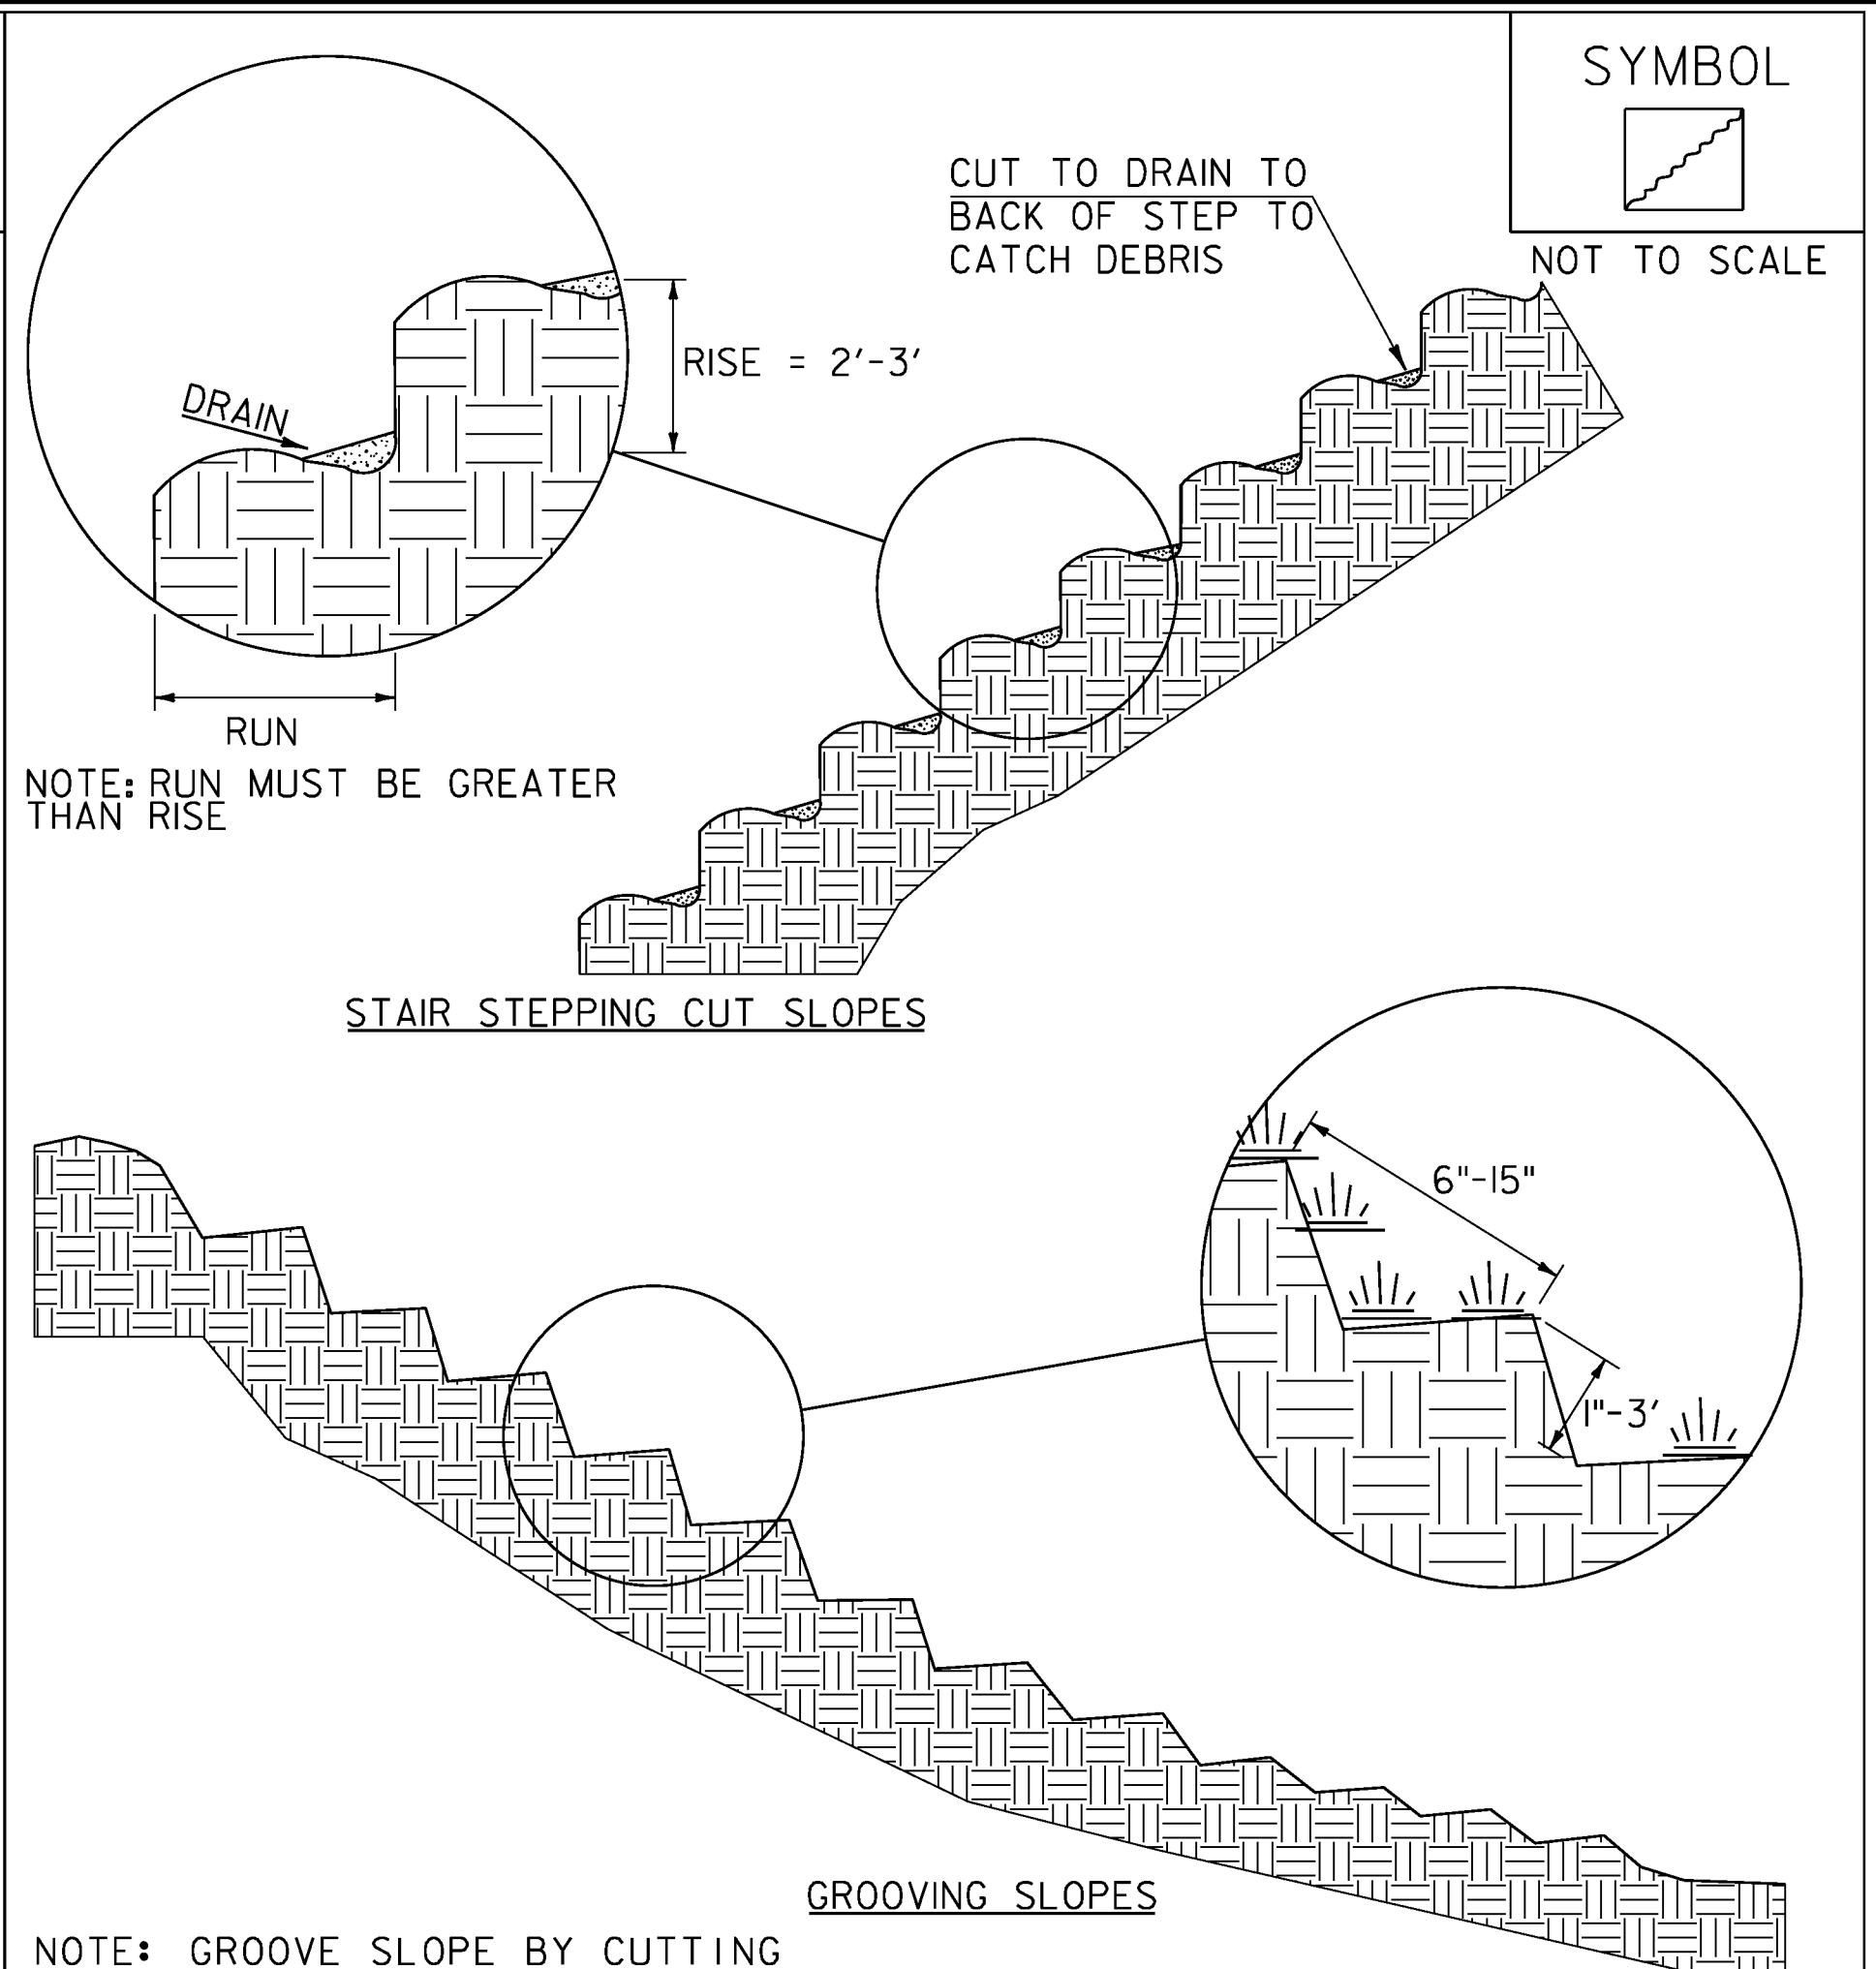

FILTER BAG

ADAPTED FROM DETAILS PROVIDED BY: NEW YORK STATE DEC
ORIGINALLY DEVELOPED BY USDA-NRCS
VERMONT DEPARTMENT OF ENVIRONMENTAL CONSERVATION

SURFACE ROUGHENING

NOTES:
REFER TO "THE VERMONT STANDARDS & SPECIFICATIONS FOR EROSION PREVENTION & SEDIMENT CONTROL -2006- "FROM THE VT AGENCY OF NATURAL RESOURCES FOR ADDITIONAL GUIDANCE.

THIS WORK SHALL BE CONSIDERED INCIDENTAL TO THE CONTRACT

NOTES:
REFER TO "THE VERMONT STANDARDS & SPECIFICATIONS FOR EROSION PREVENTION & SEDIMENT CONTROL -2006- "FROM THE VT AGENCY OF NATURAL RESOURCES FOR ADDITIONAL GUIDANCE.

THIS WORK SHALL BE PERFORMED IN ACCORDANCE WITH SECTION 653 FOR FILTER BAG (PAY ITEM 653.45) AND AS SPECIFIED IN THE CONTRACT.


ADAPTED FROM VTRANS TECHNICAL LANDSCAPE MANUAL FOR ROADWAYS AND TRANSPORTATION FACILITIES

TURF ESTABLISHMENT


REVISIONS		
JUNE 23, 2009	WHF	
JANUARY 15, 2010	WHF	
FEBRUARY 16, 2011	WHF	

REVISIONS		
MARCH 24, 2008	WHF	
JANUARY 13, 2009	WHF	

REVISIONS		
APRIL 1, 2008	WHF	
JANUARY 13, 2009	WHF	

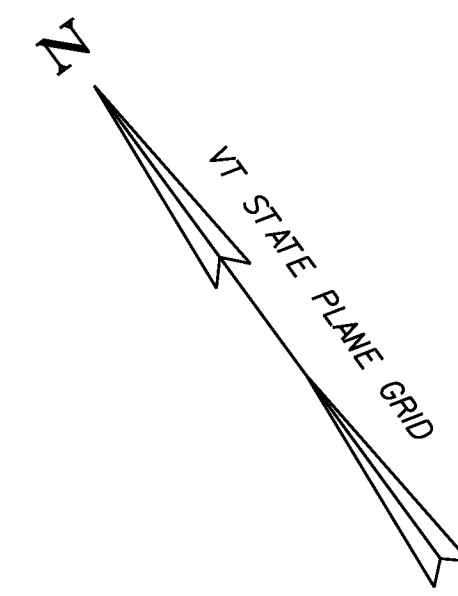


BEGIN APPROACH
STA. 10+75.00
MATCH EXISTING

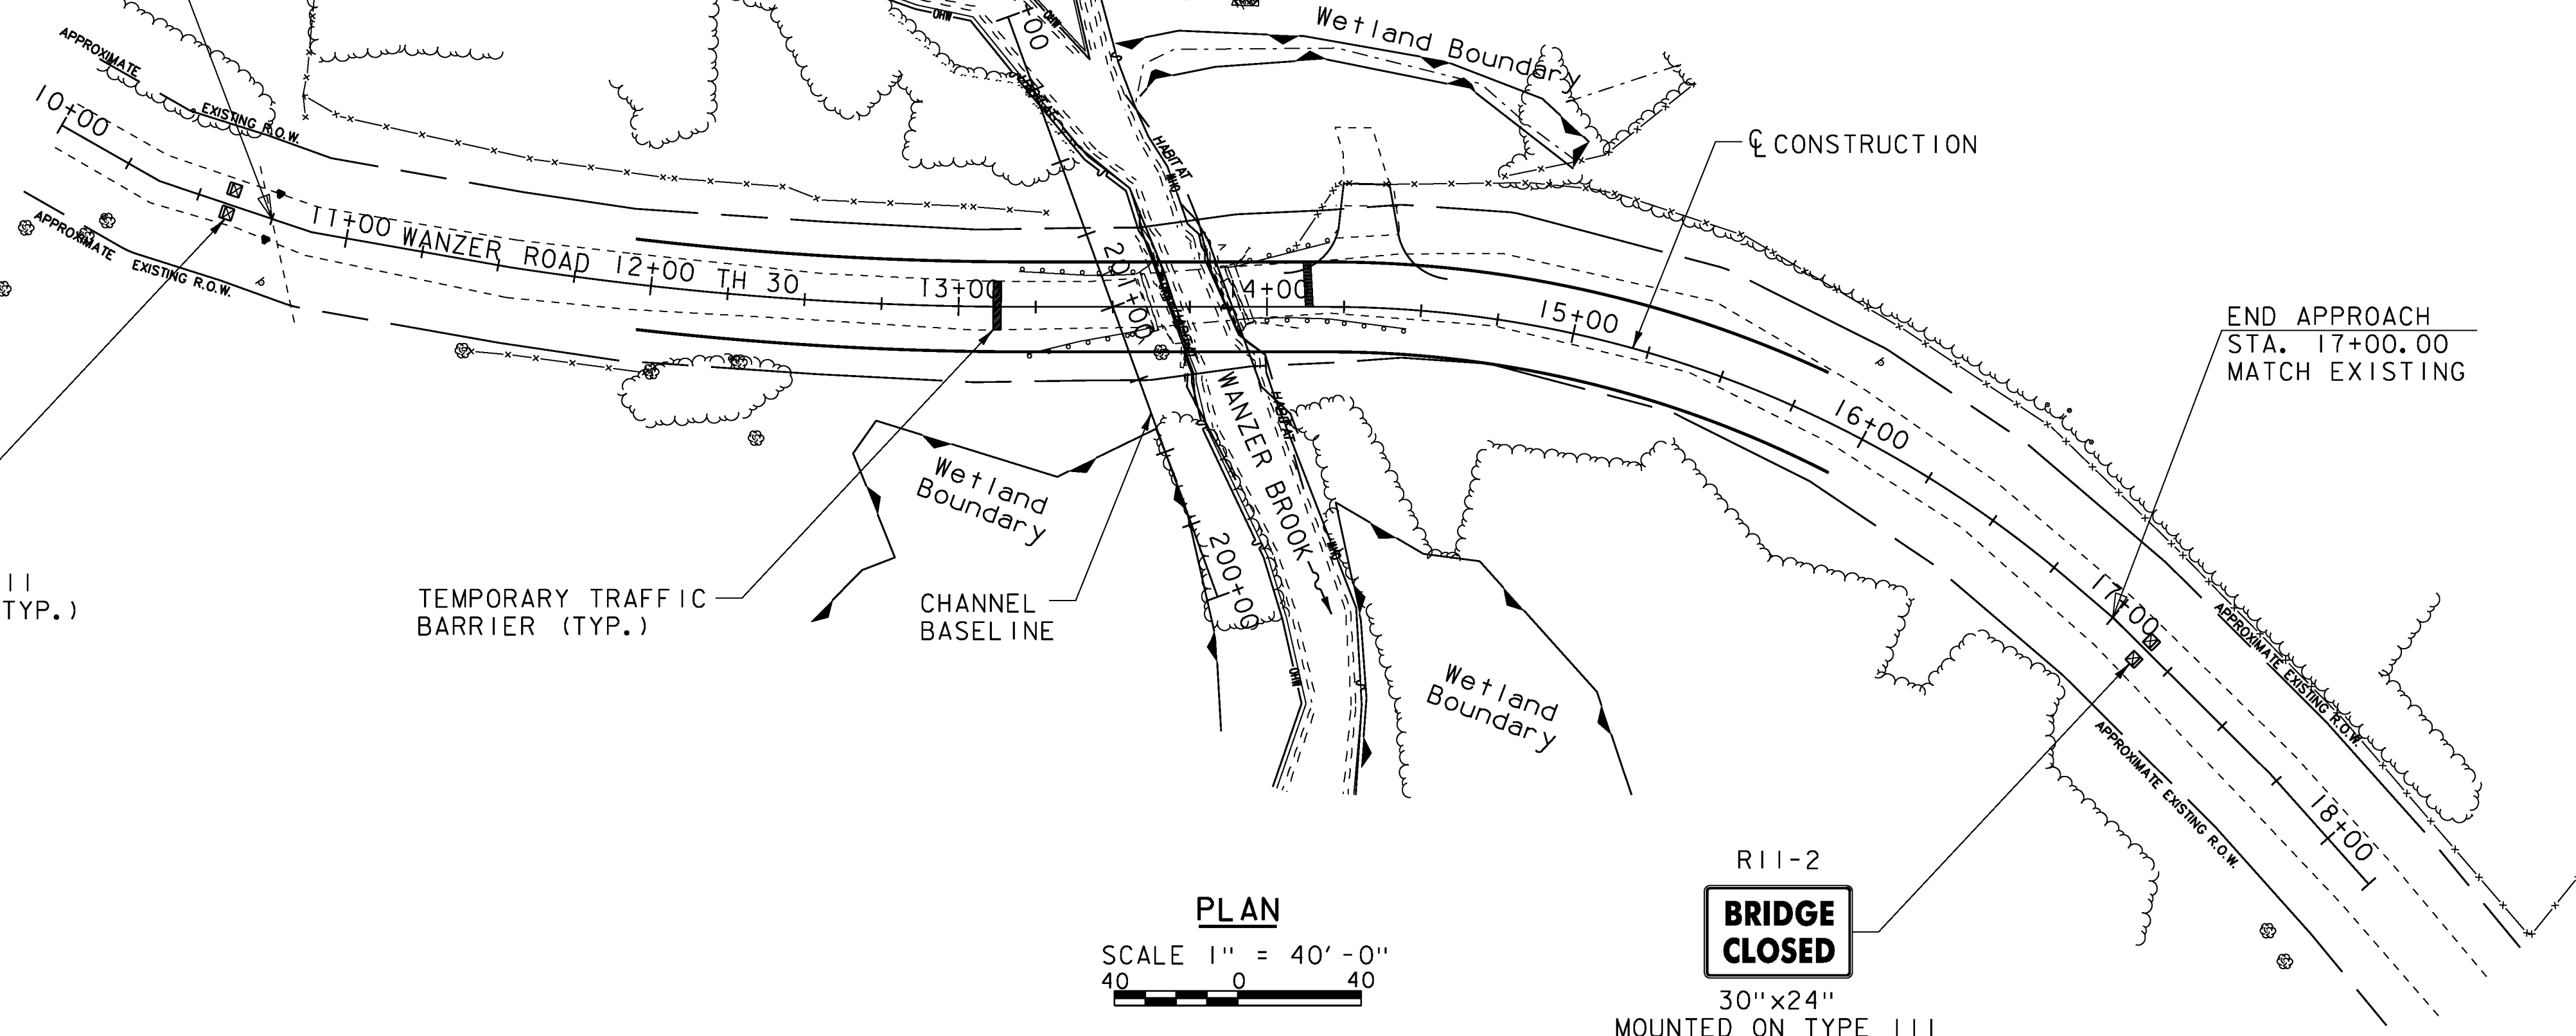

PLAN
SCALE 1" = 40'-0"
40 0 40

R11-3a
**BRIDGE CLOSED
AHEAD**
NO THRU TRAFFIC
24"x48"
MOUNTED ON TYPE 111
(MOD.) BARRICADES (TYP.)

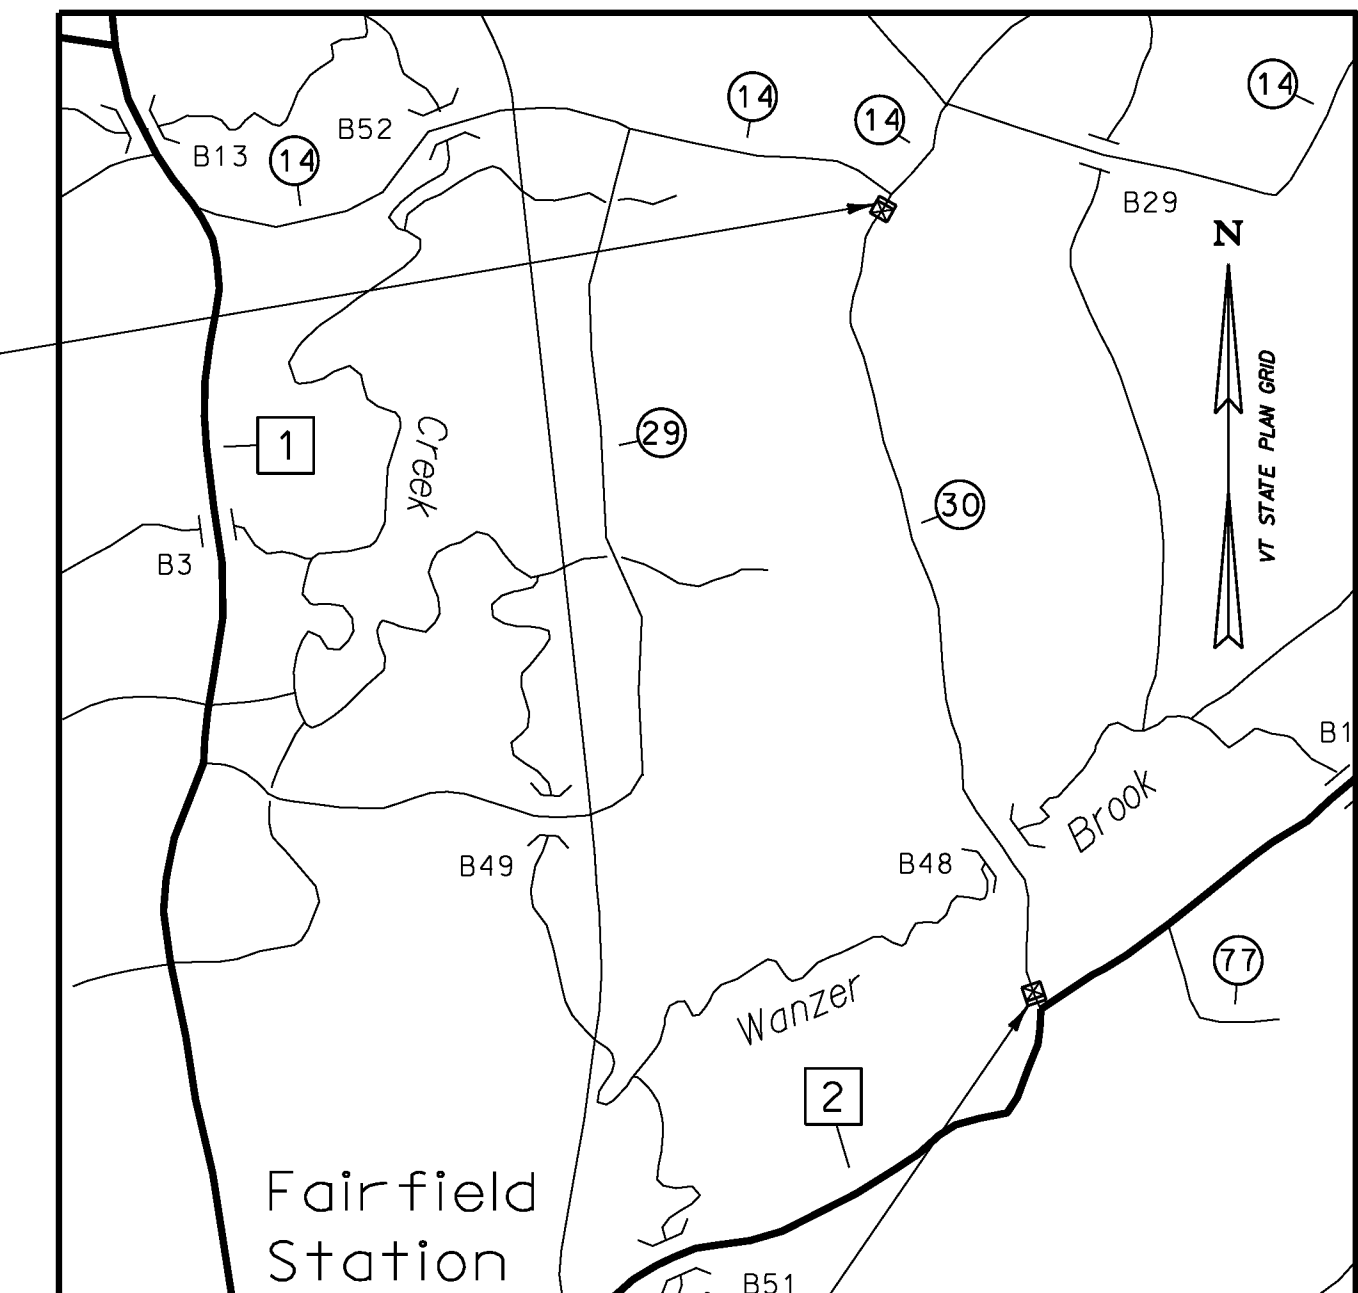

R11-3a
**BRIDGE CLOSED
AHEAD**
LOCAL TRAFFIC ONLY
24"x48"
MOUNTED ON TYPE 111
(MOD.) BARRICADES (TYP.)

LAYOUT
SCALE 1" = 2000'
2000 0 2000

R11-2
**BRIDGE
CLOSED**
30"x24"
MOUNTED ON TYPE 111
(MOD.) BARRICADES (TYP.)

TEMPORARY TRAFFIC
BARRIER (TYP.)

CHANNEL
BASELINE

R11-2
**BRIDGE
CLOSED**
30"x24"
MOUNTED ON TYPE 111
(MOD.) BARRICADES (TYP.)

TRAFFIC CONTROL NOTES

- BRIDGE NO. 48 WILL BE CLOSED TO ALL PEDESTRIAN AND VEHICULAR TRAFFIC. THE CONTRACTOR SHALL NOTIFY THE TOWN OF FAIRFIELD AT LEAST TWO (2) WEEKS PRIOR TO CLOSING THE BRIDGE AND COMMENCING CONSTRUCTION ACTIVITIES.
- TRAFFIC SHALL BE TEMPORARILY REROUTED AROUND THE PROJECT SITE DURING CONSTRUCTION. THE TOWN OF FAIRFIELD WILL PROVIDE AND MAINTAIN THE NECESSARY OFF-PROJECT TRAFFIC CONTROL DEVICES, INCLUDING TEMPORARY DETOUR SIGNS.
- THE CONTRACTOR SHALL BE RESPONSIBLE FOR DESIGNING, ERECTING AND MAINTAINING (AS WELL AS REMOVING AND RESETTING) ALL ON-PROJECT TEMPORARY TRAFFIC CONTROL ZONE DEVICES, INCLUDING BUT NOT LIMITED TO CONSTRUCTION SIGNS, BARRICADES, TEMPORARY TRAFFIC BARRIERS AND OTHER REQUIRED DEVICES USED TO REGULATE, WARN AND GUIDE TRAFFIC DURING CONSTRUCTION. TRAFFIC CONTROL DEVICES SHALL MEET THE REQUIREMENTS OF THE LATEST EDITION OF THE MANUAL ON UNIFORM TRAFFIC CONTROL DEVICES (MUTCD) AND PERTINENT T-SERIES STANDARDS, AND SHALL BE SUBMITTED TO THE RESIDENT ENGINEER FOR REVIEW AND APPROVAL. THE COST OF ALL ON-PROJECT TEMPORARY TRAFFIC CONTROL ZONE DEVICES (EXCEPT TEMPORARY TRAFFIC BARRIERS) SHALL BE PAID FOR UNDER ITEM 641.10, TRAFFIC CONTROL.
- ALL TRAFFIC CONTROL DEVICES SHALL BE KEPT IN THEIR PROPER POSITION AT ALL TIMES AND SHALL BE REPAIRED, REPLACED OR CLEANED AS NECESSARY TO PRESERVE THEIR APPEARANCE AND CONTINUITY.
- ALL SIGNS SHALL BE PLACED WITHIN EXISTING STATE AND TOWN RIGHTS-OF-WAY.
- TEMPORARY TRAFFIC BARRIERS SHALL BE PLACED ON WANZER ROAD TO LIMITS APPROVED BY THE ENGINEER TO PREVENT TRAFFIC FROM ENTERING THE BRIDGE WORK AREA. COST TO INCORPORATE THESE DURING NON-WORKING HOURS, AS WELL AS RELOCATING THESE DURING WORKING HOURS, SHALL BE INCLUDED IN THE UNIT BID PRICE FOR ITEM 621.90, TEMPORARY TRAFFIC BARRIER.
- NO CONSTRUCTION SIGNS SHALL BE INSTALLED AS TO INTERFERE OR OBSTRUCT THE VIEW OF THE EXISTING TRAFFIC CONTROL DEVICES, STOPPING SIGHT DISTANCE, AND CORNER SIGHT DISTANCE FROM DRIVES AND TOWN HIGHWAYS.



PROJECT NAME: FAIRFIELD	PLOT DATE: 01-NOV-2013
PROJECT NUMBER: BRO 1448(38)	DRAWN BY: W. GAYNOR
FILE NAME: z1j072+cpin_01.dgn	CHECKED BY: T. KENDRICK
PROJECT LEADER: D. LANDRY	SHEET 19 OF 41
DESIGNED BY: E. ALEXOPOULOS	
TRAFFIC CONTROL SHEET	

SOIL CLASSIFICATION

AASHTO

A1 Clayey Soil - Low Compressibility
A3 Gravel and Sand
A2 Clayey Soil - Highly Compressible
A4 Fine Sand
A5 Silty or Clayey Gravel and Sand
A6 Silty Soil - Low Compressibility
A7 Silty Soil - Highly Compressible

ROCK QUALITY DESIGNATION

R.O.D. (%)	ROCK DESCRIPTION
<25	Very Poor
25 to 50	Poor
51 to 75	Fair
76 to 90	Good
>90	Excellent

SHEAR STRENGTH

UNDRAINED SHEAR STRENGTH IN P.S.F.	CONSISTENCY
<250	Very Soft
250-500	Soft
500-1000	Med. Stiff
1000-2000	Stiff
2000-4000	Very Stiff
>4000	Hard

CORRELATION GUIDE OF "N" TO DENSITY/CONSISTENCY

DENSITY (GRANULAR SOILS)		CONSISTENCY (COHESIVE SOILS)	
N	DESCRIPTIVE TERM	N	DESCRIPTIVE TERM
<5	Very Loose	<2	Very Soft
5-10	Loose	2-4	Soft
11-24	Med. Dense	5-8	Med. Stiff
25-50	Dense	9-15	Stiff
>50	Very Dense	16-30	Very Stiff
		31-60	Hard
		>60	Very Hard

DEFINITIONS (AASHTO)

BEDROCK (LEDGE) - Rock in its native location of indefinite thickness.
BOULDER - A rock fragment with an average dimension > 12 inches.
COBBLE - Rock fragments with an average dimension between 3 and 12 inches.
GRAVEL - Rounded particles of rock < 3" and > 0.075" (#10 sieve).
SAND - Particles of rock < 0.075" (#10 sieve) and > 0.0029" (#200 sieve).
SILT - Soil < 0.0029" (#200 sieve), non or slightly plastic and exhibits no strength when air-dried.
CLAY - Fine grained soil, exhibits plasticity when moist and considerable strength when air-dried.
VARIED - Alternate layers of silt and clay.
HARDPAN - Extremely dense soil, cemented layer, not softened when wet.
MUCK - Soft organic soil containing > 10% organic material.
MOISTURE CONTENT - Weight of water divided by dry weight of soil.
FLOWING SAND - Granular soil so saturated (loose) that it flows into drill casing during extraction of wash rod.
STRIKE - Angle from magnetic north to line of intersection of bed with a horizontal plane.
DIP - Inclination of bed with a horizontal plane.

LOG KEY

GZA
Geo Environmental, Inc.
Engineers and Scientists

BURMISTER SOIL CLASSIFICATION (INORGANIC)

COMPONENT	NAME	PROPORTIONAL TERM	PERCENT BY WEIGHT	IDENTIFICATION OF FINES		
				Material	PI	Atterberg Thread Dia.
MAJOR	GRAVEL, SAND, FINES*		>50	SILT	0	Cannot Roll
Minor	Gravel, Sand, Fines*	and some little trace	35 - 50 20-35 10-20 0-10	Clayey SILT	1-5	1/4"
				SILT & CLAY	5-10	1/8"
				CLAY & SILT	10-20	1/16"
				Silty CLAY	20-40	1/32"
				CLAY	>40	1/64"

*See identification of fines table.

GRADATION DESIGNATION	PROPORTION OF COMPONENT	PLASTIC SOILS		GRAVEL & SAND	
		Consistency	Blows/Ft. SPT N-Value	Density	Blows/Ft. SPT N-Value
Fine to coarse	All fractions > 10%	Very Soft	< 2	Very Loose	< 4
Medium to coarse	<10% fine	Soft	2 - 4	Loose	4 - 10
Fine to medium	<10% coarse	Medium Stiff	4 - 8	Medium Dense	10 - 30
Coarse	<10% fine and medium	Stiff	8 - 15	Dense	30 - 50
Medium	<10% coarse and fine	Very Stiff	15 - 30	Very Dense	> 50
Fine	<10% coarse and medium	Hard	>30		

BURMISTER SOIL CLASSIFICATION (ORGANIC)

Fibrous PEAT (Pt) - Lightweight, spongy, mostly visible organic matter, water squeezes readily from sample. Typically near top of deposit.
Fine Grained PEAT (Pt) - Lightweight, spongy, little visible organic matter, water squeezes readily from sample. Typically below fibrous peat.
Organic Silt (OL) - Typically gray to dark gray, often has strong H2S odor. Typically contains shells or shell fragments. Lightweight. Usually found near coastal regions. May contain wide range of sand fractions.
Organic Clay (OH) - Typically gray to dark gray, high plasticity. Usually found near coastal regions. May contain wide range of sand fractions. Need organic content test for final identification.

UNIFIED SOIL CLASSIFICATION SYSTEM (USCS) (ASTM D 2487)

MAJOR DIVISIONS	Group Symbols		
Coarse Grained Soils More than 50% of material larger than No. 200 sieve	Gravel More than 50% larger than No. 4 sieve	Clean Gravels (Little or no fines)	GW GP
		Gravels with Fines (Appreciable amount of fines)	GM GC
	Sand More than 50% smaller than No. 4 sieve	Clean Sands (Little or no fines)	SW SP
		Sands with Fines (Appreciable amount of fines)	SM SC
		Silts and Clays Liquid Limit <50	ML CL
		Silts and Clays Liquid Limit >50	OL MH CH OH
		Highly Organic Soils	Pt


ABBREVIATIONS

MR = Mud Rotary
HSA = Hollow Stem Auger
SSA = Solid Stem Auger
SS = Split Spoon Sampler
U = Undisturbed Sample (Shelby Tube)
MC = Modified California Sampler
V = Vibracore
M = Macrocore
R = Refusal
USCS = Unified Soil Classification System (ASTM D2487)
NYCBC = New York City Building Code
WOR = Weight of Rods
WOH = Weight of Hammer
SPT = Standard Penetration Test (ASTM D1586)
N-Value = Cumulative number of uncorrected blows for the middle two 6-inch intervals (blows/foot).

Tv = Field Vane Shear Test (Torvane)
PP = Pocket Penetrometer
PI = Plasticity Index
MC = Moisture Content
CO = Consolidation
UC = Unconfined Compression Test
SI = Sieve Analysis
DS = Direct Shear
PID = Photoionization Detector
ppm = Parts Per Million
REC = Recovery
RQD = Rock Quality Designation
= Measured Water Level

COMMONLY USED SYMBOLS

▽ Water Elevation	M Double Tube Core Barrel Used	NR No Recovery
⊕ Standard Penetration Boring	LL Liquid Limit	Rec. Recovery
⊕ Auger Boring	PL Plastic Limit	%Rec. Percent Recovery
⊙ Rod Sounding	PI Plasticity Index	RQD Rock Quality Designation
S Sample	NP Non Plastic	CBR California Bearing Ratio
N Standard Penetration Test	w Moisture Content (Dry Wgt. Basis)	< Less Than
D Blow Count Per Foot For:	D Dry	> Greater Than
2" O.D. Sampler	M Moist	R Refusal (N > 100)
1 3/8" I.D. Sampler	MTW Moist To Wet	
Hammer Weight Of 140 Lbs.	W Wet	
Hammer Fall Of 30"	Sat Saturated	
	Bo Boulder	blk Black
VS Field Vane Shear Test	Gr Gravel	bl Blue
US Undisturbed Soil Sample	Sa Sand	brn Brown
B Blast	SI Silt	dk Dark
DC Diamond Core	Cl Clay	gry Gray
MD Mud Drill	HP Hardpan	gn Green
WA Wash Ahead	Le Ledge	lt Light
HSA Hollow Stem Auger	NLTD No Ledge To Depth	or Orange
AX Core Size 1 1/8"	CNPF Can Not Penetrate Further	
BX Core Size 1 5/8"	TLOB To Ledge Or Boulder	
NX Core Size 2 1/8"		

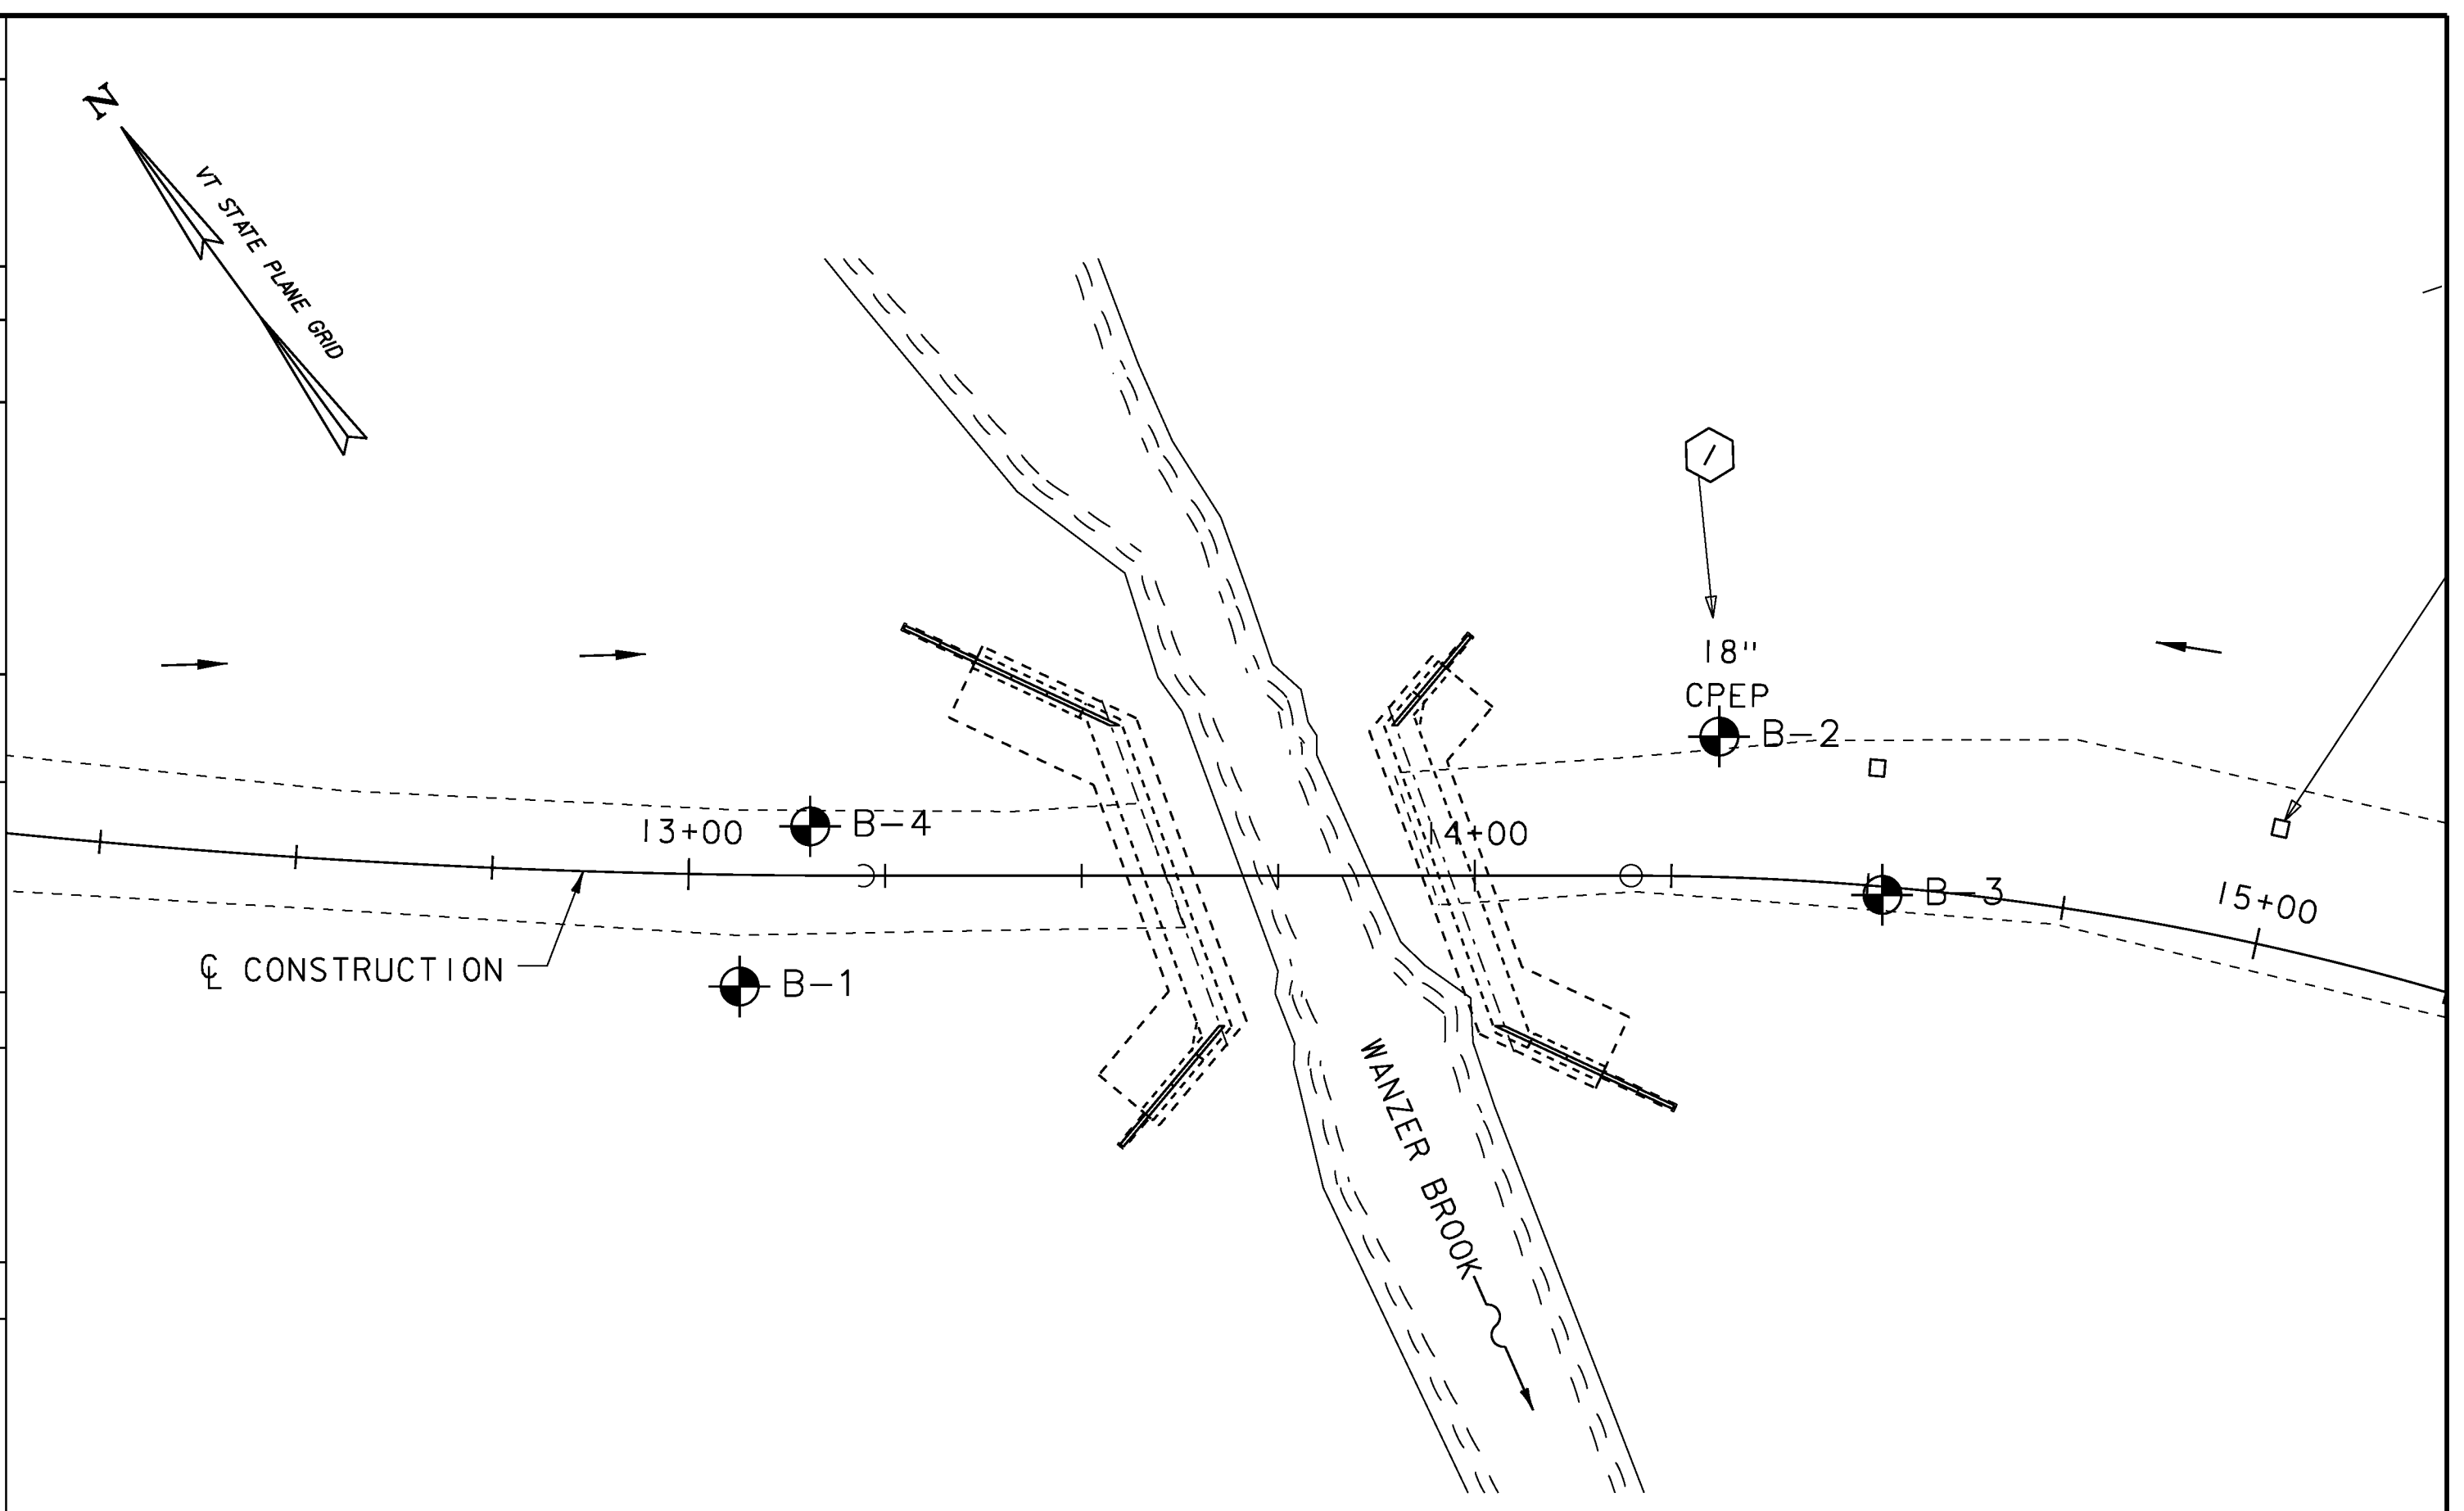

BORING LAYOUT


SCALE 1" = 20'-0"

BORING CHART

BORING	STATION	OFFSET (FT)	NORTHING	EASTING	GROUND ELEV.	TLOB ELEV.
B-1	13+06.7	14.2 RT	849893.57	1534488.55	480.0	434.0
B-2	14+30.6	17.9 LT	849845.62	1534607.88	478.0	436.0
B-3	14+52.0	1.1 RT	849817.12	1534612.74	479.0	441.0
B-4	13+15.4	6.3 LT	849904.71	1534507.83	479.0	441.5

GENERAL NOTES

- The subsurface explorations shown herein were made March 19 thru March 21, 2012 by GZA GeoEnvironmental, Inc. estimating purposes. Presentation of the information in the Contract is intended to provide the Contractor access to the same data available to the Owner. The subsurface information is presented in good faith and is not intended as a substitute for personal investigation, independent interpretation, independent analysis or judgement by the Contractor.
- Soiland rock classifications, properties and descriptions are based on engineering interpretation from available subsurface information and may not necessarily reflect actual variations in subsurface conditions that may be encountered between individual boring or sample locations.
- Observed water levels and/or conditions indicated are as recorded at the time of exploration and may vary according to the prevailing rainfall, methods of exploration and other factors.
- Engineering judgement was exercised in preparing the subsurface information presented herein. Analysis and interpretation of subsurface data was performed and interpreted for design and
- Pictorial structure details shown on the boring plan layout or soils profile are for illustrative purposes only and may not accurately portray final contract details.
- Terminology used on boring logs to describe the hardness, degree of weathering, and spacing of fractures, joints and other discontinuities in the bedrock is defined in the AASHTO Manual on Subsurface Investigations, 1988.

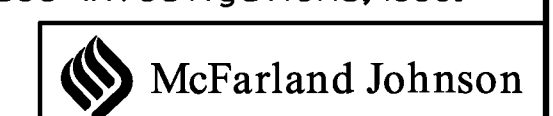

PROJECT NAME: FAIRFIELD
PROJECT NUMBER: BRO 1448(38)
FILE NAME: zlj072bor_01.dgn
DESIGNED BY: GZA
BORING INFORMATION SHEET

PLOT DATE: 01-NOV-2013
DRAWN BY: W. GAYNOR
CHECKED BY: T. KENDRICK
SHEET 20 OF 41

TEST BORING LOG																	
GZA GeoEnvironmental, Inc. Engineers and Scientists			Bridge #48 over Wanzer Brook Fairfield BRO 1448 (22) Fairfield, Vermont			EXPLORATION NO.: B-1 SHEET: 1 of 2 PROJECT NO: 04.0029571.00 REVIEWED BY: J. Baron			Logged By: J. Szmyt Drilling Co.: New Hampshire Boring, Inc. Foreman: Mark D'Ambrosio			Type of Rig: Acker Rig Model: Truck Drilling Method: Drive-and-Wash		Boring Location: See Plan Ground Surface Elev. (ft.): 480 Final Boring Depth (ft.): 58.5 Date Start - Finish: 3/19/2012 - 3/20/2012		H. Datum: NAD83 V. Datum: NAVD88	
Hammer Type: Safety Hammer Hammer Weight (lb.): 140 Hammer Fall (in.): 30 Auger or Casing O.D./I.D Dia (in.): 4.0			Sampler Type: SS Sampler O.D. (in.): 2.0 Sampler Length (in.): 24 Rock Core Size: 1.875			Groundwater Depth (ft.)											
Depth (ft)	Casing Blows/ Core Rate	Sample						SPT Value	Sample Description and Identification (Modified Burmister Procedure)	Remark	Field Test Data	Depth (ft.)	Stratum Description	Elev. (ft.)			
		No.	Depth (ft.)	Pen. (in)	Rec. (in)	Blows (per 6 in.)											
		S1	0-2	24	16	6 11 9 9	20	S1: Medium dense, brown, fine to coarse SAND, little Gravel, little Silt.			2	FILL	478.0				
5		S2	5-5.7	8	3	96 100/2"	R	S2: Very dense, brown, fine to coarse SAND and Silt, little Gravel.	1			SAND					
10		S3	10-12	24	14	65 63 54 40	>100	S3: Very dense, brown, GRAVEL, some Silt, little fine to medium Sand.			10	TILL	470.0				
15		S4	15-17	24	15	23 26 35 34	61	S4: Very dense, gray, SILT.			15		465.0				
20		S5	20-22	24	18	19 21 23 27	44	S5: Hard, gray, Clayey SILT.				CLAYEY SILT					
25		S6	25-27	24	20	21 21 29 27	50	S6: Hard, gray, Clayey SILT.									
30		1 - Rock in tip of split spoon.															
REMARKS										See Log Key for exploration of sample description and identification procedures. Stratification lines represent approximate boundaries between soil and bedrock types. Actual transitions may be gradual. Water level readings have been made at the times and under the conditions stated. Fluctuations of groundwater may occur due to other factors than those present at the times the measurements were made.							
										Exploration No.: B-1							

B.O.F. 452.50

TEST BORING LOG																	
GZA GeoEnvironmental, Inc. Engineers and Scientists			Bridge #48 over Wanzer Brook Fairfield BRO 1448 (22) Fairfield, Vermont			EXPLORATION NO.: B-1 SHEET: 2 of 2 PROJECT NO: 04.0029571.00 REVIEWED BY: J. Baron			Logged By: J. Szmyt Drilling Co.: New Hampshire Boring, Inc. Foreman: Mark D'Ambrosio			Type of Rig: Acker Rig Model: Truck Drilling Method: Drive-and-Wash		Boring Location: See Plan Ground Surface Elev. (ft.): 480 Final Boring Depth (ft.): 58.5 Date Start - Finish: 3/19/2012 - 3/20/2012		H. Datum: NAD83 V. Datum: NAVD88	
Hammer Type: Safety Hammer Hammer Weight (lb.): 140 Hammer Fall (in.): 30 Auger or Casing O.D./I.D Dia (in.): 4.0			Sampler Type: SS Sampler O.D. (in.): 2.0 Sampler Length (in.): 24 Rock Core Size: 1.875			Groundwater Depth (ft.)											
Depth (ft)	Casing Blows/ Core Rate	Sample						SPT Value	Sample Description and Identification (Modified Burmister Procedure)	Remark	Field Test Data	Depth (ft.)	Stratum Description	Elev. (ft.)			
		No.	Depth (ft.)	Pen. (in)	Rec. (in)	Blows (per 6 in.)											
		S7	30-32	24	11	18 22 23 26	45	S7: Hard, gray, Clayey SILT.									
35		S8	35-37	24	14	31 45 31 46	76	S8: Hard, gray, Clayey SILT.				CLAYEY SILT					
40		S9	40-40.9	11	10	20 100/5"	R	S9: Hard, gray, Clayey SILT.			41	TILL	439.0				
45		S10	45-45.1	1	1	100/1"	R	S10: Very dense, gray, fine SAND and Silt, little Gravel.			46		454.0				
50	4:31	C1	48.5-53.5	60	60			C1: Hard, slightly weathered, gray and white, fine grained SCHIST; joints moderately dipping, close, rough, planar, fresh, tight. RQD: 22"/37%				SCHIST					
55	4:49	C2	53.5-58.5	60	58			C2: Hard, slightly weathered, gray, fine grained SCHIST; joints moderately dipping, close, rough, planar, fresh, open. RQD: 21"/35%									
60	6:19	End of exploration at 58.5 feet.															
REMARKS										2 - Cobble at 41 feet below ground surface (approximately 1 foot thick). 3 - Rock pieces observed in wash water. 4 - Probable bedrock at approximately 46 feet. Advanced roller bit into probable bedrock from 46 to 48.5 feet below ground surface and began coring.							
										Exploration No.: B-1							

GZA TEMPLATE TEST BORING: 6/29/2012; 10:27:06 AM

GZA TEMPLATE TEST BORING: 6/29/2012; 10:27:06 AM

PROJECT NAME: FAIRFIELD
PROJECT NUMBER: BRO 1448(38)
FILE NAME: zlj072bor_02.dgn
PROJECT LEADER: D. LANDRY
DESIGNED BY: GZA
BORING LOGS (1 OF 4)

PLOT DATE: 01-NOV-2013
DRAWN BY: W. GAYNOR
CHECKED BY: T. KENDRICK
SHEET 21 OF 41



TEST BORING LOG																	
GZA GeoEnvironmental, Inc. Engineers and Scientists			Bridge #48 over Wanzer Brook Fairfield BRO 1448 (22) Fairfield, Vermont			EXPLORATION NO.: B-2 SHEET: 1 of 2 PROJECT NO: 04.0029571.00 REVIEWED BY: J. Baron			Logged By: J. Szmyt Drilling Co.: New Hampshire Boring, Inc. Foreman: Mark D'Ambrosio			Type of Rig: Acker Rig Model: Truck Drilling Method: Drive-and-Wash		Boring Location: See Plan Ground Surface Elev. (ft.): 478 Final Boring Depth (ft.): 47 Date Start - Finish: 3/20/2012 - 3/21/2012		H. Datum: NAD83 V. Datum: NAVD88	
Hammer Type: Safety Hammer Hammer Weight (lb.): 140 Hammer Fall (in.): 30 Auger or Casing O.D./I.D Dia (in.): 4.0			Sampler Type: SS Sampler O.D. (in.): 2.0 Sampler Length (in.): 24 Rock Core Size: 1.875			Groundwater Depth (ft.)											
Depth (ft)	Casing Blows/ Core Rate	Sample						SPT Value	Sample Description and Identification (Modified Burmister Procedure)	Remark	Field Test Data	Depth (ft.)	Stratum Description	Elev. (ft.)			
		No.	Depth (ft.)	Pen. (in)	Rec. (in)	Blows (per 6 in.)											
		S1	0-2	24	14	12 23 33 29	56	S1: Very dense, brown, fine to medium SAND, trace Gravel, trace Silt.			2	FILL	476.0				
5		S2	5-7	24	18	27 21 15 13	36	S2: Dense, brown, fine to medium SAND, little Gravel, little Silt.				SAND					
10		S3	10-11.3	16	0	19 79 100/4"	R	S3: No Recovery.	1		10		466.0				
15		S4	15-16.8	21	11	45 19 35 100/3"	54	S4: Very dense, brown, fine to coarse SAND and Gravel, little Silt.	2			TILL					
20		S5	20-20.4	5	4	100/5"	R	S5: Very dense, gray, fine to coarse SAND and Gravel, little Silt.			21		457.0				
25		S6	26-28	24	16	26 36 40 49	76	S6: Hard, gray, varved SILT & CLAY with fine Sand partings.				SILT AND CLAY	B.O.F. 452.50				
30																	
REMARKS 1 - Cobbles and boulders at approximately 11 feet to 14 feet below ground surface. 2 - Boulder at 16.8 feet (2.5 feet thick).																	
See Log Key for exploration of sample description and identification procedures. Stratification lines represent approximate boundaries between soil and bedrock types. Actual transitions may be gradual. Water level readings have been made at the times and under the conditions stated. Fluctuations of groundwater may occur due to other factors than those present at the times the measurements were made.										Exploration No.: B-2							

TEST BORING LOG																	
GZA GeoEnvironmental, Inc. Engineers and Scientists			Bridge #48 over Wanzer Brook Fairfield BRO 1448 (22) Fairfield, Vermont			EXPLORATION NO.: B-2 SHEET: 2 of 2 PROJECT NO: 04.0029571.00 REVIEWED BY: J. Baron			Logged By: J. Szmyt Drilling Co.: New Hampshire Boring, Inc. Foreman: Mark D'Ambrosio			Type of Rig: Acker Rig Model: Truck Drilling Method: Drive-and-Wash		Boring Location: See Plan Ground Surface Elev. (ft.): 478 Final Boring Depth (ft.): 47 Date Start - Finish: 3/20/2012 - 3/21/2012		H. Datum: NAD83 V. Datum: NAVD88	
Hammer Type: Safety Hammer Hammer Weight (lb.): 140 Hammer Fall (in.): 30 Auger or Casing O.D./I.D Dia (in.): 4.0			Sampler Type: SS Sampler O.D. (in.): 2.0 Sampler Length (in.): 24 Rock Core Size: 1.875			Groundwater Depth (ft.)											
Depth (ft)	Casing Blows/ Core Rate	Sample						SPT Value	Sample Description and Identification (Modified Burmister Procedure)	Remark	Field Test Data	Depth (ft.)	Stratum Description	Elev. (ft.)			
		No.	Depth (ft.)	Pen. (in)	Rec. (in)	Blows (per 6 in.)											
		S7	30-32	24	12	11 10 16 26	26	S7: Very stiff, gray, varved SILT & CLAY with fine Sand partings.									
35		S8	35-37	24	13	22 43 60 76	>100	S8: Hard, gray, varved SILT & CLAY with fine Sand partings.				SILT AND CLAY					
40		S9	40-42	24	19	16 29 33 36	62	S9: Hard, gray, varved SILT & CLAY with fine Sand partings.	3				436.0				
45												PROBABLE BEDROCK					
50								End of exploration at 47 feet.					431.0				
55																	
60																	
REMARKS 3 - Advanced roller bit into probable bedrock from approximately 42 feet to 47 feet below ground surface.																	
See Log Key for exploration of sample description and identification procedures. Stratification lines represent approximate boundaries between soil and bedrock types. Actual transitions may be gradual. Water level readings have been made at the times and under the conditions stated. Fluctuations of groundwater may occur due to other factors than those present at the times the measurements were made.										Exploration No.: B-2							

GZA TEMPLATE TEST BORING; 6/29/2012; 10:27:06 AM

GZA TEMPLATE TEST BORING; 6/29/2012; 10:27:06 AM



PROJECT NAME: FAIRFIELD
 PROJECT NUMBER: BRO 1448(38)
 FILE NAME: zlj072bor_02.dgn
 PROJECT LEADER: D. LANDRY
 DESIGNED BY: GZA
 BORING LOGS (2 OF 4)
 PLOT DATE: 01-NOV-2013
 DRAWN BY: W. GAYNOR
 CHECKED BY: T. KENDRICK
 SHEET 22 OF 41

TEST BORING LOG																	
GZA GeoEnvironmental, Inc. Engineers and Scientists			Bridge #48 over Wanzer Brook Fairfield BRO 1448 (22) Fairfield, Vermont			EXPLORATION NO.: B-3 SHEET: 1 of 2 PROJECT NO: 04.0029571.00 REVIEWED BY: J. Baron			Logged By: J. Szmyt Drilling Co.: New Hampshire Boring, Inc. Foreman: Mark D'Ambrosio			Type of Rig: Acker Rig Model: Truck Drilling Method: Drive-and-Wash		Boring Location: See Plan Ground Surface Elev. (ft.): 479 Final Boring Depth (ft.): 50 Date Start - Finish: 3/21/2012 - 3/21/2012		H. Datum: NAD83 V. Datum: NAVD88	
Hammer Type: Safety Hammer Hammer Weight (lb.): 140 Hammer Fall (in.): 30 Auger or Casing O.D./I.D Dia (in.): 4.0			Sampler Type: SS Sampler O.D. (in.): 2.0 Sampler Length (in.): 24 Rock Core Size: 1.875			Groundwater Depth (ft.)											
Depth (ft)	Casing Blows/ Core Rate	Sample					SPT Value	Sample Description and Identification (Modified Burmister Procedure)	Remark	Field Test Data	Depth (ft.)	Stratum Description	Elev. (ft.)	Groundwater Depth (ft.)			
		No.	Depth (ft.)	Pen. (in)	Rec. (in)	Blows (per 6 in.)								Date	Time	Water Depth	Stab. Time
		S1	0-2	24	17	19 21 22 19	43	S1: Dense, light brown, fine to medium SAND, trace Gravel, trace Silt.			2	FILL	477.0				
5		S2	5-7	24	19	1 3 5 6	8	S2: Loose, brown, SILT, some fine to medium Sand, little Gravel.									
10		S3	10-12	24	11	3 5 3 3	8	S3: Loose, brown, SILT, some fine to medium Sand, little Gravel.									
15		S4	15-17	24	0	7 7 4 7	11	S4: No Recovery.	1	15			464.0				
20		S5	20-22	24	14	14 17 16 19	33	S5: Hard, gray, Clayey SILT.	2								
25		S6	25-27	24	20	20 23 27 33	50	S6: Hard, gray, varved SILT & CLAY with fine Sand partings.									
30																	
REMARKS 1 - Rock in tip of split spoon. 2 - Cobble or boulder encountered from approximately 17 feet to 19.5 feet below ground surface.																	
See Log Key for exploration of sample description and identification procedures. Stratification lines represent approximate boundaries between soil and bedrock types. Actual transitions may be gradual. Water level readings have been made at the times and under the conditions stated. Fluctuations of groundwater may occur due to other factors than those present at the times the measurements were made.										Exploration No.: B-3							

B.O.F. 452.50

TEST BORING LOG																	
GZA GeoEnvironmental, Inc. Engineers and Scientists			Bridge #48 over Wanzer Brook Fairfield BRO 1448 (22) Fairfield, Vermont			EXPLORATION NO.: B-3 SHEET: 2 of 2 PROJECT NO: 04.0029571.00 REVIEWED BY: J. Baron			Logged By: J. Szmyt Drilling Co.: New Hampshire Boring, Inc. Foreman: Mark D'Ambrosio			Type of Rig: Acker Rig Model: Truck Drilling Method: Drive-and-Wash		Boring Location: See Plan Ground Surface Elev. (ft.): 479 Final Boring Depth (ft.): 50 Date Start - Finish: 3/21/2012 - 3/21/2012		H. Datum: NAD83 V. Datum: NAVD88	
Hammer Type: Safety Hammer Hammer Weight (lb.): 140 Hammer Fall (in.): 30 Auger or Casing O.D./I.D Dia (in.): 4.0			Sampler Type: SS Sampler O.D. (in.): 2.0 Sampler Length (in.): 24 Rock Core Size: 1.875			Groundwater Depth (ft.)											
Depth (ft)	Casing Blows/ Core Rate	Sample					SPT Value	Sample Description and Identification (Modified Burmister Procedure)	Remark	Field Test Data	Depth (ft.)	Stratum Description	Elev. (ft.)	Groundwater Depth (ft.)			
		No.	Depth (ft.)	Pen. (in)	Rec. (in)	Blows (per 6 in.)								Date	Time	Water Depth	Stab. Time
		S7	30-32	24	18	14 16 20 24	36	S7: Hard, gray, varved SILT & CLAY with fine Sand partings.									
35		S8	35-35.3	4	4	100/4"	R	S8: Very dense, gray/green, fine SAND, little Silt, little Gravel.	3				444.0				
40	4:37 4:23 3:13 3:33 3:49	C1	40-45	60	58			C1: Hard, slightly weathered, gray, fine grained SCHIST; joints moderately dipping, moderately rough, planar, fresh, open. RQD: 22"/37%									
45	3:04 3:08 3:20 3:10 3:14	C2	45-50	60	58			C2: Hard, fresh, gray, fine grained SCHIST; joints high angle, wide, rough, stepped, fresh, tight. RQD: 50"/83%									
50								End of exploration at 50 feet.								429.0	
55																	
60																	
REMARKS 3 - Advanced roller bit into probable bedrock from approximately 38 to 40 feet below ground surface and began coring.																	
See Log Key for exploration of sample description and identification procedures. Stratification lines represent approximate boundaries between soil and bedrock types. Actual transitions may be gradual. Water level readings have been made at the times and under the conditions stated. Fluctuations of groundwater may occur due to other factors than those present at the times the measurements were made.										Exploration No.: B-3							

GZA TEMPLATE TEST BORING; 6/29/2012; 10:27:07 AM

GZA TEMPLATE TEST BORING; 6/29/2012; 10:27:07 AM

PROJECT NAME: FAIRFIELD
PROJECT NUMBER: BRO 1448(38)
FILE NAME: zlj072bor_02.dgn
PROJECT LEADER: D. LANDRY
DESIGNED BY: GZA
BORING LOGS (3 OF 4)

PLOT DATE: 01-NOV-2013
DRAWN BY: W. GAYNOR
CHECKED BY: T. KENDRICK
SHEET 23 OF 41



TEST BORING LOG																	
GZA GeoEnvironmental, Inc. Engineers and Scientists			Bridge #48 over Wanzer Brook Fairfield BRO 1448 (22) Fairfield, Vermont			EXPLORATION NO.: B-4 SHEET: 1 of 2 PROJECT NO: 04.0029571.00 REVIEWED BY: J. Baron			Logged By: J. Szmyt Drilling Co.: New Hampshire Boring, Inc. Foreman: Mark D'Ambrosio			Type of Rig: Acker Rig Model: Truck Drilling Method: Drive-and-Wash		Boring Location: See Plan Ground Surface Elev. (ft.): 479 Final Boring Depth (ft.): 48.5 Date Start - Finish: 3/21/2012 - 3/21/2012		H. Datum: NAD83 V. Datum: NAVD88	
Hammer Type: Safety Hammer Hammer Weight (lb.): 140 Hammer Fall (in.): 30 Auger or Casing O.D./I.D Dia (in.): 4.0			Sampler Type: SS Sampler O.D. (in.): 2.0 Sampler Length (in.): 24 Rock Core Size: 1.875			Groundwater Depth (ft.)											
Depth (ft)	Casing Blows/ Core Rate	Sample					SPT Value	Sample Description and Identification (Modified Burmister Procedure)	Remark	Field Test Data	Depth (ft.)	Stratum Description	Elev. (ft.)				
		No.	Depth (ft.)	Pen. (in)	Rec. (in)	Blows (per 6 in.)											
		S1	0-2	24	17	18 24 23 18	47	S1: Dense, brown, fine to coarse SAND, little Gravel, trace Silt.				FILL	477.0				
5		S2	5-7	24	16	19 9 6 7	15	S2: Top 12": Medium dense, brown, Clayey SILT, trace Gravel, trace fine Sand. Bottom 4": Stiff, gray, CLAY & SILT.	1								
10		S3	11-13	24	15	14 15 22 26	37	S3: Hard, gray, varved CLAY & SILT with fine Sand partings.									
15		S4	15-17	24	16	22 36 33 37	69	S4: Hard, gray, varved CLAY & SILT with fine Sand partings.				CLAY AND SILT					
20		S5	20-22	24	19	29 32 35 41	67	S5: Hard, gray, varved CLAY & SILT with fine Sand partings.									
25		S6	25-27	24	15	25 26 27 34	53	S6: Hard, gray, varved CLAY & SILT with fine Sand partings.									
30																	
REMARKS													1 - Boulder from approximately 8 feet to 11 feet below ground surface.				
See Log Key for exploration of sample description and identification procedures. Stratification lines represent approximate boundaries between soil and bedrock types. Actual transitions may be gradual. Water level readings have been made at the times and under the conditions stated. Fluctuations of groundwater may occur due to other factors than those present at the times the measurements were made.													Exploration No.: B-4				

B.O.F. 452.50



TEST BORING LOG																	
GZA GeoEnvironmental, Inc. Engineers and Scientists			Bridge #48 over Wanzer Brook Fairfield BRO 1448 (22) Fairfield, Vermont			EXPLORATION NO.: B-4 SHEET: 2 of 2 PROJECT NO: 04.0029571.00 REVIEWED BY: J. Baron			Logged By: J. Szmyt Drilling Co.: New Hampshire Boring, Inc. Foreman: Mark D'Ambrosio			Type of Rig: Acker Rig Model: Truck Drilling Method: Drive-and-Wash		Boring Location: See Plan Ground Surface Elev. (ft.): 479 Final Boring Depth (ft.): 48.5 Date Start - Finish: 3/21/2012 - 3/21/2012		H. Datum: NAD83 V. Datum: NAVD88	
Hammer Type: Safety Hammer Hammer Weight (lb.): 140 Hammer Fall (in.): 30 Auger or Casing O.D./I.D Dia (in.): 4.0			Sampler Type: SS Sampler O.D. (in.): 2.0 Sampler Length (in.): 24 Rock Core Size: 1.875			Groundwater Depth (ft.)											
Depth (ft)	Casing Blows/ Core Rate	Sample					SPT Value	Sample Description and Identification (Modified Burmister Procedure)	Remark	Field Test Data	Depth (ft.)	Stratum Description	Elev. (ft.)				
		No.	Depth (ft.)	Pen. (in)	Rec. (in)	Blows (per 6 in.)											
		S7	30-32	24	18	29 25 27 36	52	S7: Hard, gray, varved CLAY & SILT with fine Sand partings.									
35		S8	35-37	24	19	18 31 41 45	72	S8: Top 10": Hard, gray, varved CLAY & SILT with fine Sand partings. Bottom 9": Very dense, gray, SILT and fine Sand, trace Gravel.	2			CLAY AND SILT					
40	4:13	C1	38.5-	60	36			C1: Hard, slightly weathered, gray, fine grained SCHIST; primary joints low angle, moderately rough, planar, fresh and tight; secondary joints low angle, wide, decomposed and open. RQD: 14"/23%									
45	2:03	C2	43.5-	60	36			C2: Hard, slightly weathered, gray, fine grained, SCHIST; joints low angle, wide, rough, stepped, decomposed, open. RQD: 7"/12%									
50	2:22																
55	3:10																
60	5:51																
	3:27																
	5:38																
	7:16																
	9:16																
	13:05																
								End of exploration at 48.5 feet.									
REMARKS													2 - Advanced roller bit into probable bedrock from approximately 37.5 to 38.5 feet below ground surface and began coring.				
See Log Key for exploration of sample description and identification procedures. Stratification lines represent approximate boundaries between soil and bedrock types. Actual transitions may be gradual. Water level readings have been made at the times and under the conditions stated. Fluctuations of groundwater may occur due to other factors than those present at the times the measurements were made.													Exploration No.: B-4				

GZA TEMPLATE TEST BORING; 6/29/2012; 10:27:07 AM


GZA TEMPLATE TEST BORING; 6/29/2012; 10:27:07 AM

PROJECT NAME: FAIRFIELD
PROJECT NUMBER: BRO 1448(38)
FILE NAME: z1j072bor_02.dgn
PLOT DATE: 01-NOV-2013
PROJECT LEADER: D. LANDRY
DRAWN BY: W. GAYNOR
DESIGNED BY: GZA
CHECKED BY: T. KENDRICK
BORING LOGS (4 OF 4)
SHEET 24 OF 41



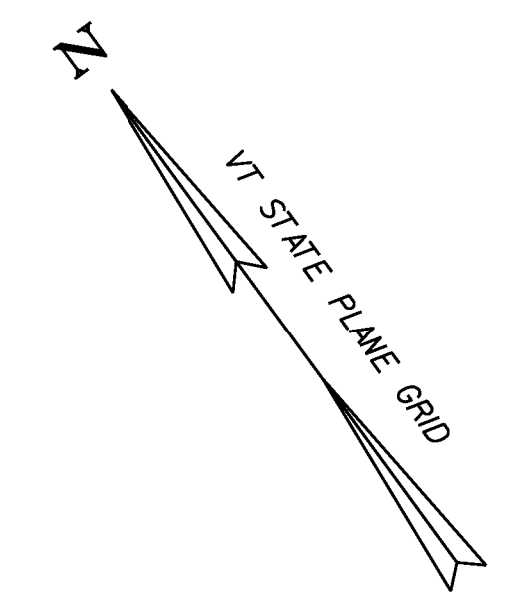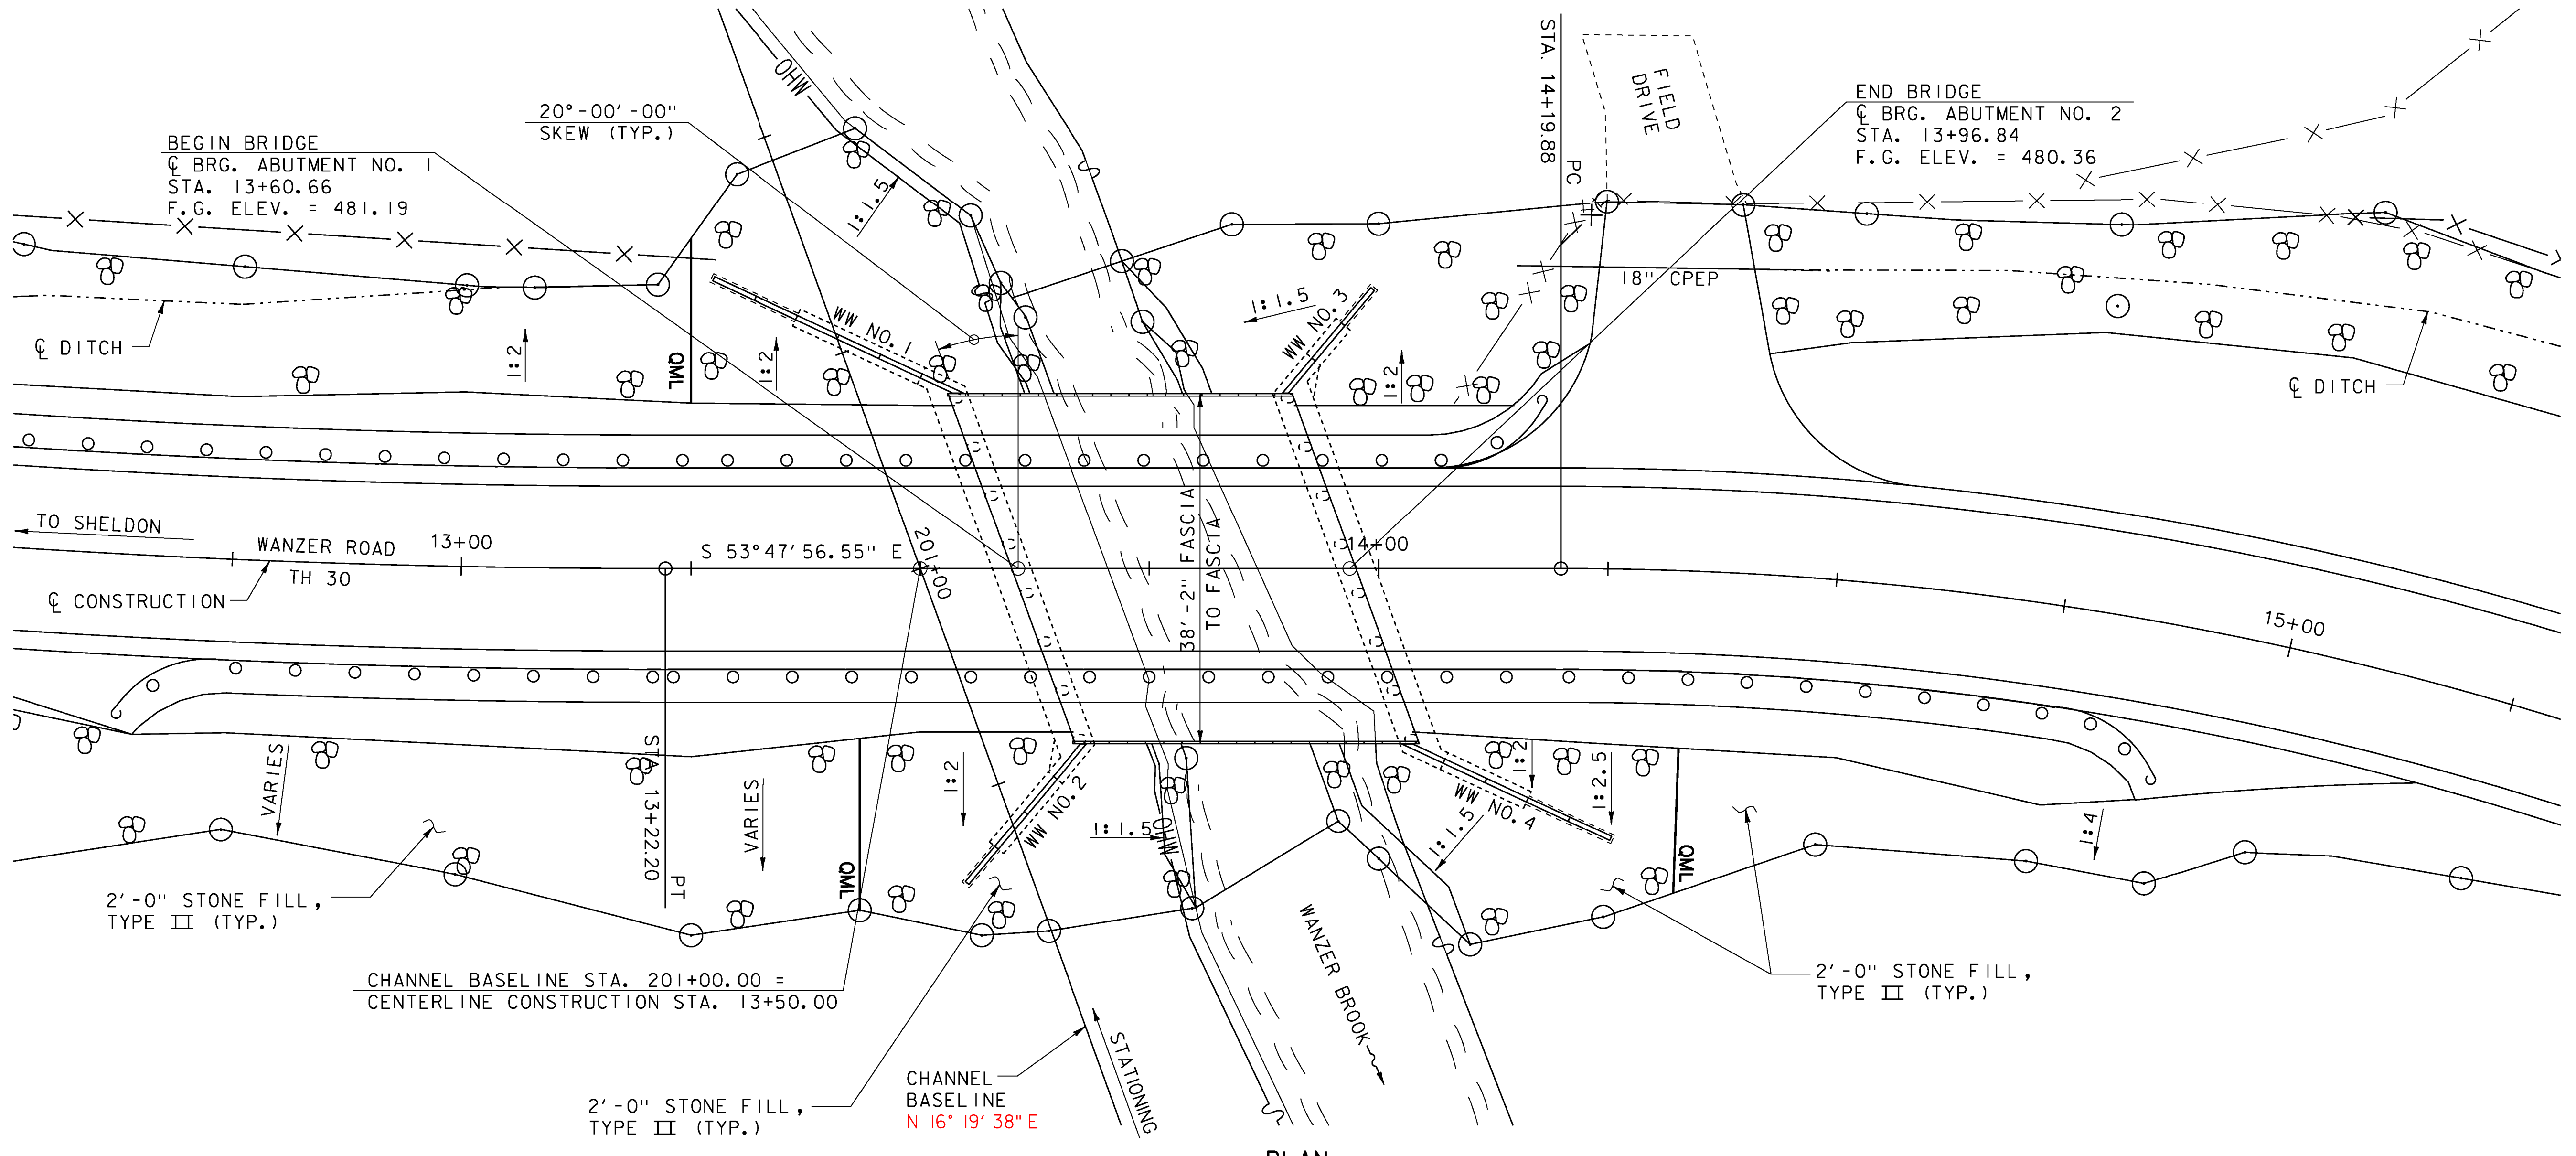


PLAN
SCALE 1" = 10'-0"
10 0 10

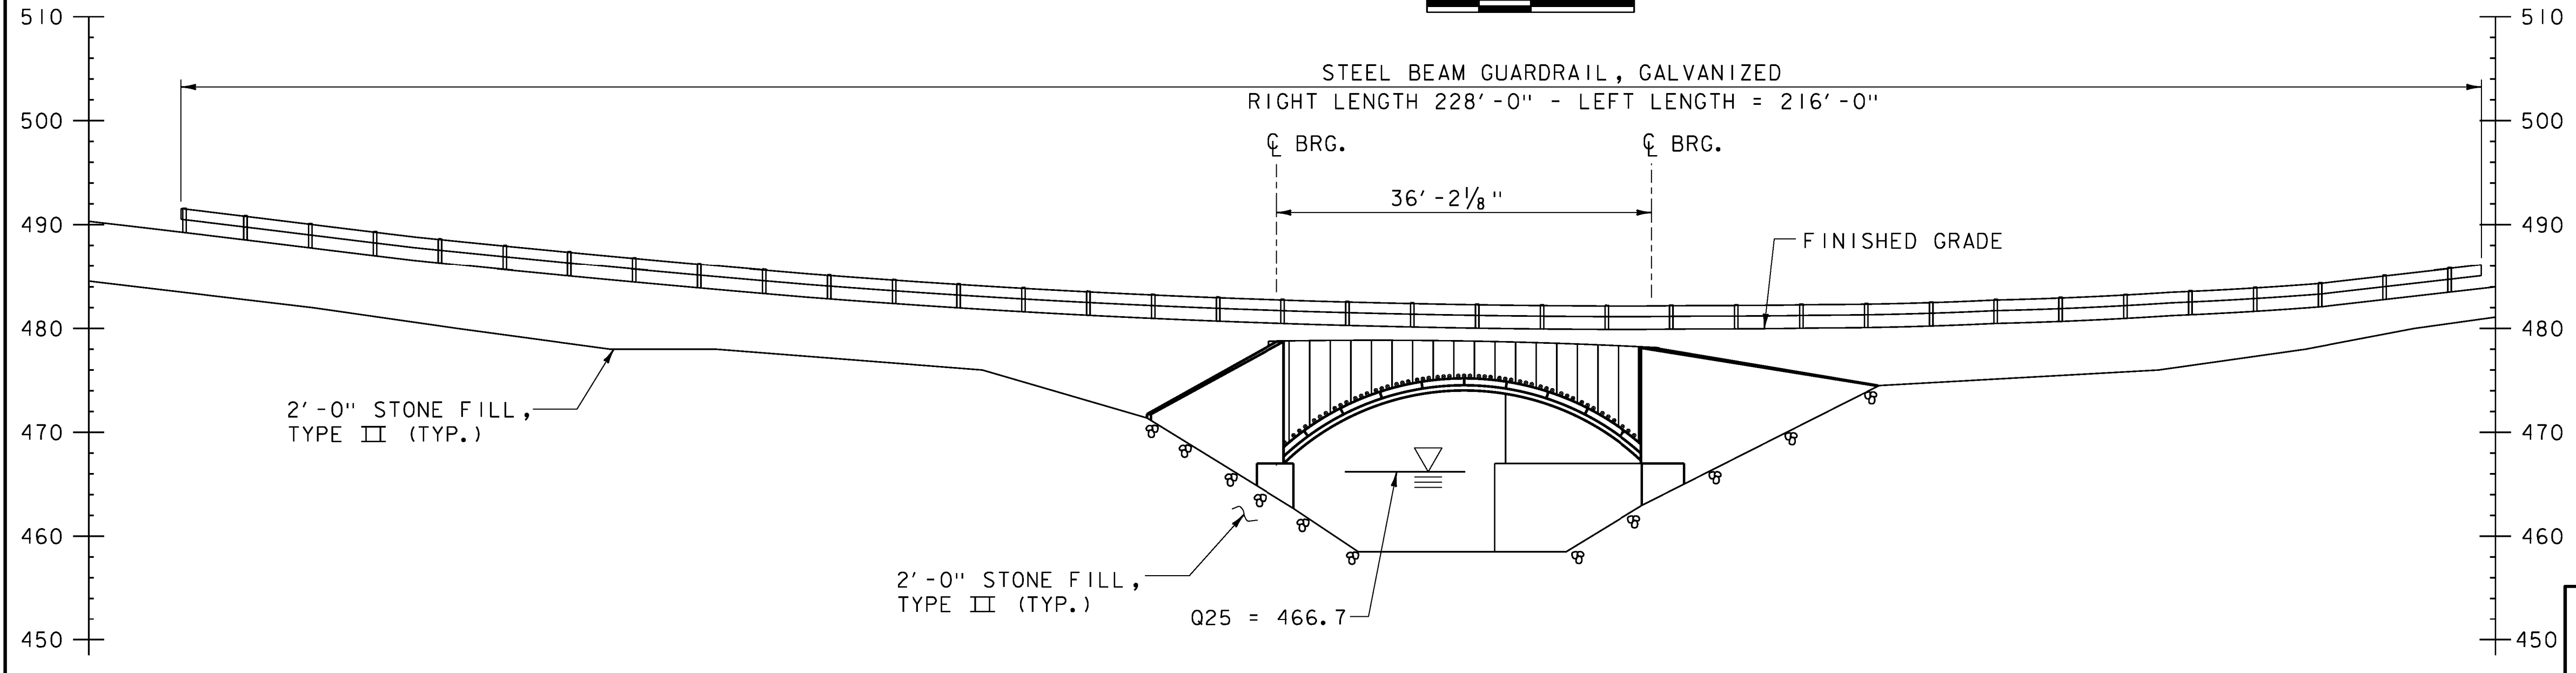

ELEVATION
SCALE 1" = 10'-0"
10 0 10


PROJECT NAME: FAIRFIELD	PLOT DATE: 01-NOV-2013
PROJECT NUMBER: BRO 1448(38)	DRAWN BY: W. GAYNOR
FILE NAME: z1j072pe_01.dgn	CHECKED BY: T. KENDRICK
DESIGNED BY: E. ALEXOPOULOS	PLAN AND ELEVATION
	SHEET 25 OF 41



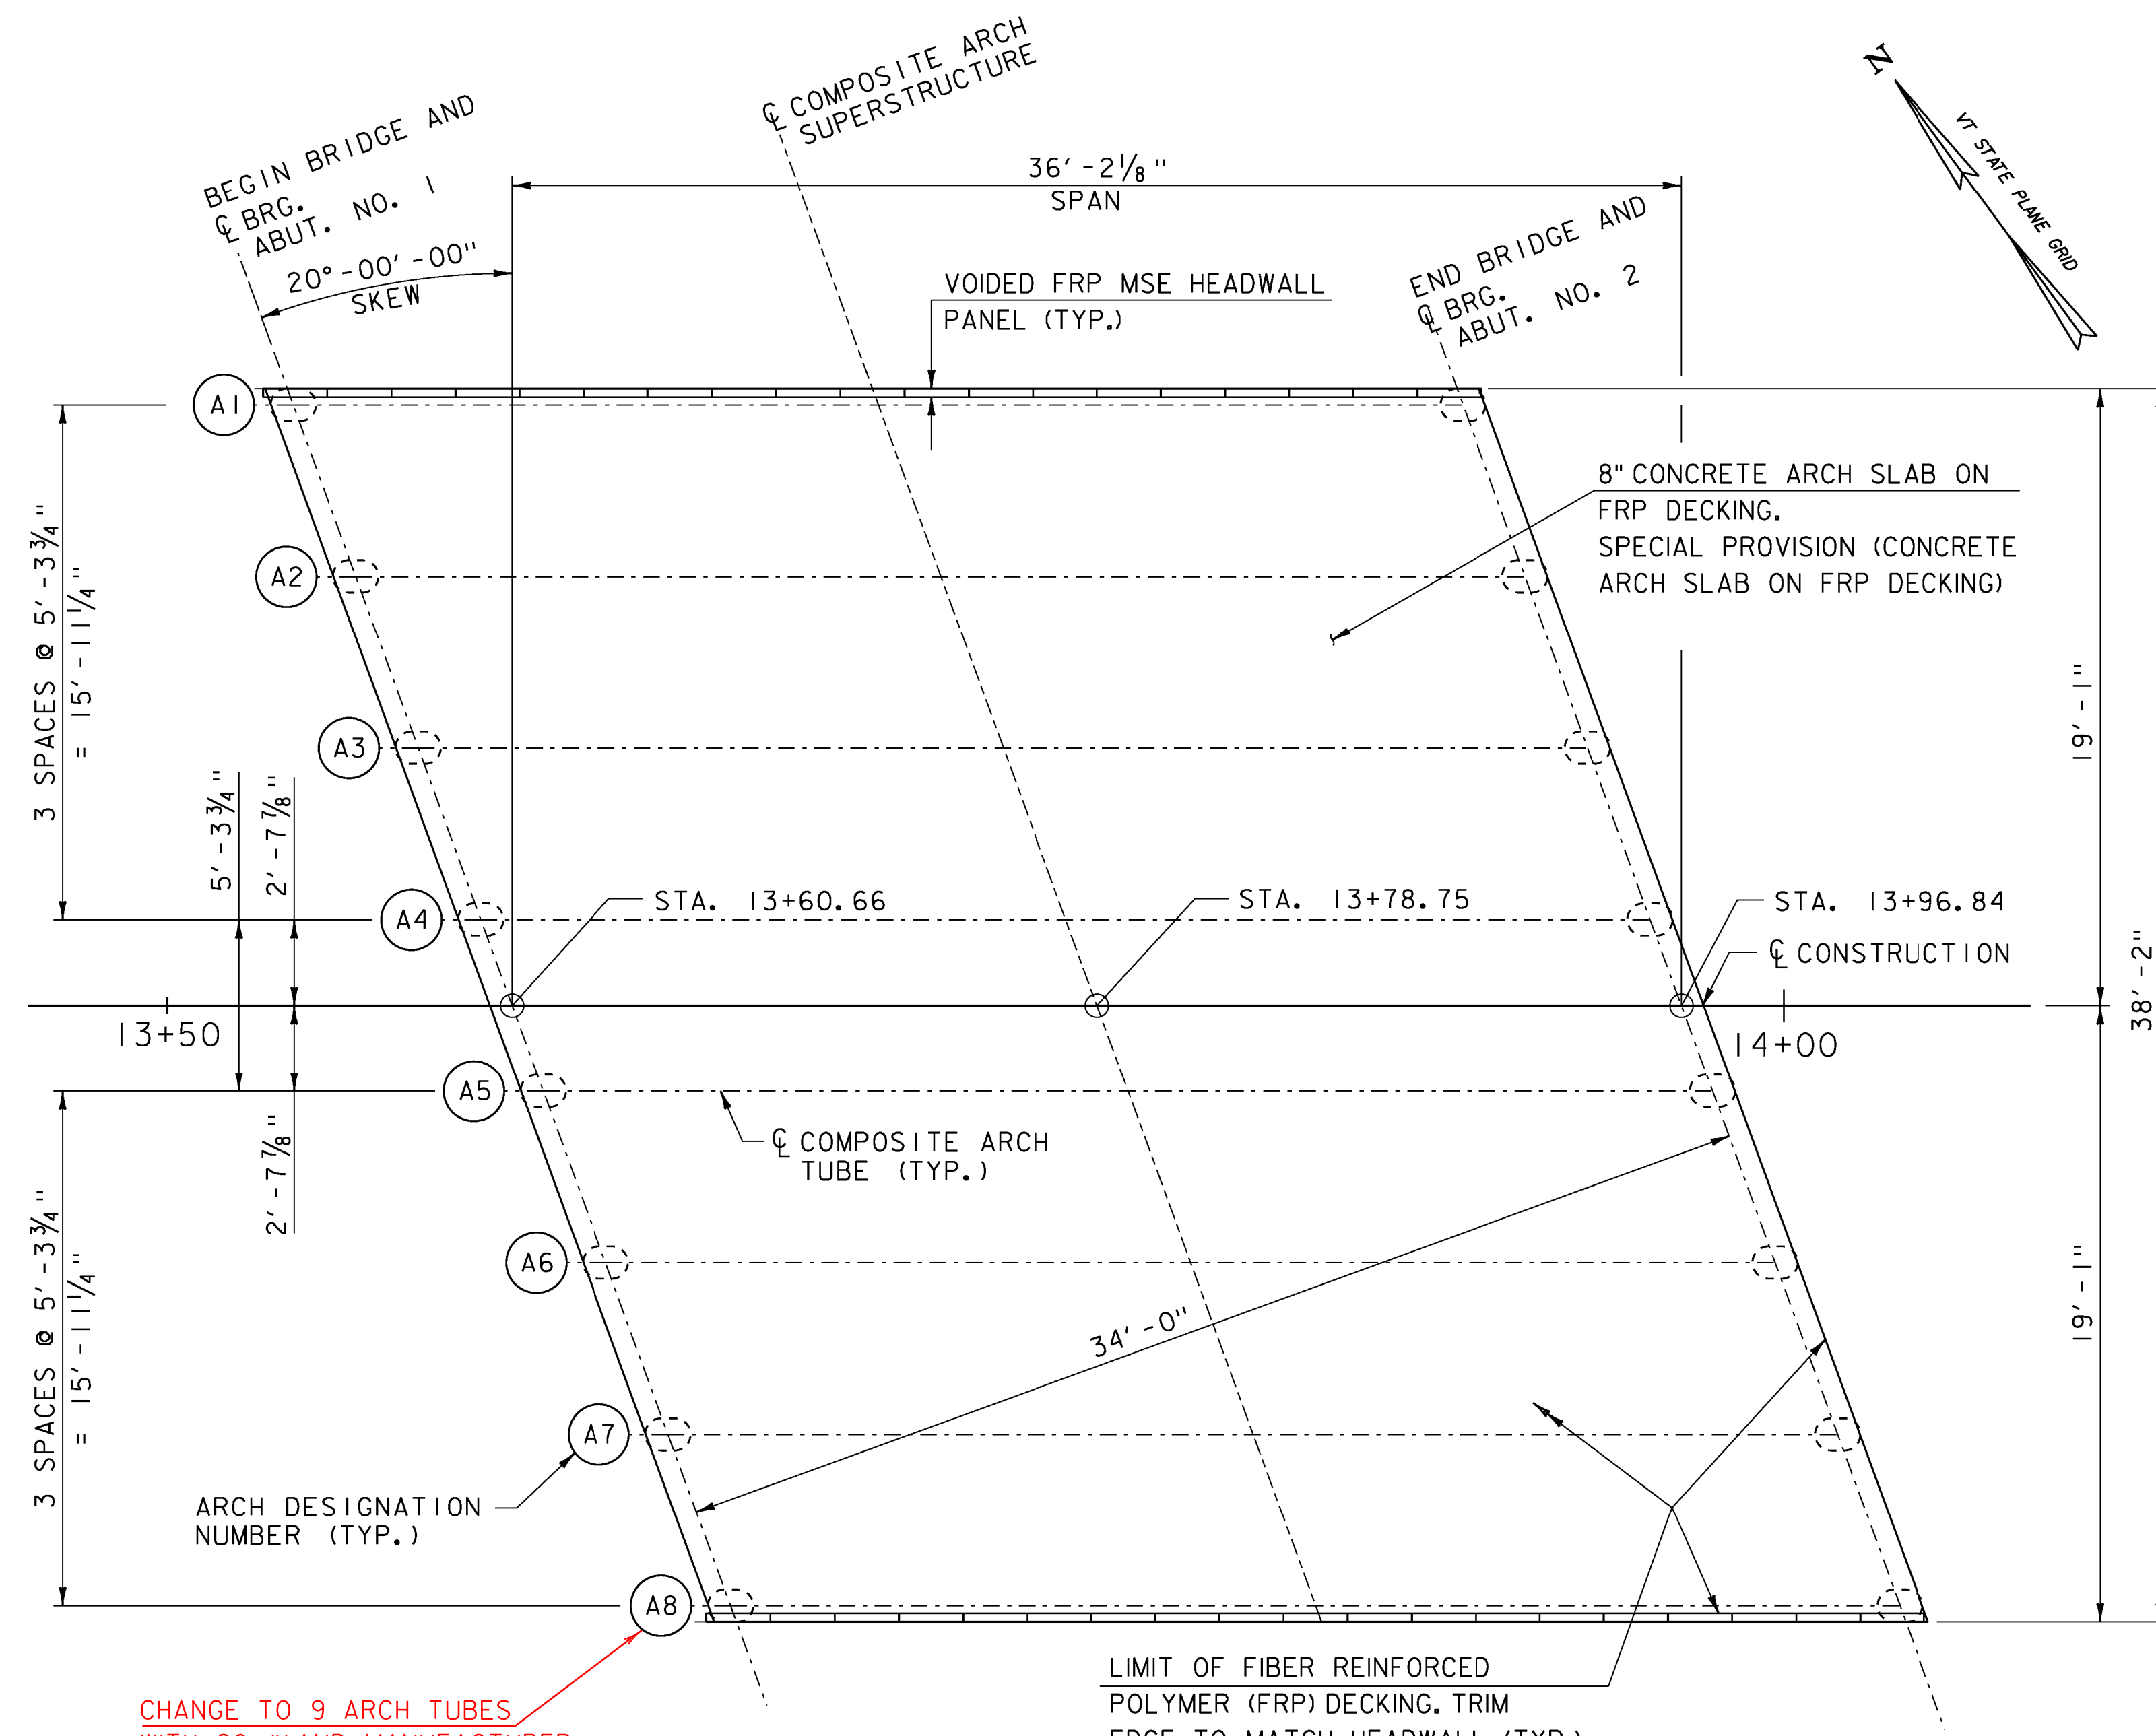


ARCH SUPERSTRUCTURE PLAN
SCALE 1/4" = 1'-0"

CHANGE TO 9 ARCH TUBES WITH CO #1 AND MANUFACTURER DESIGN SUBMITTAL. SEE SHOP DRAWINGS INCLUDED.

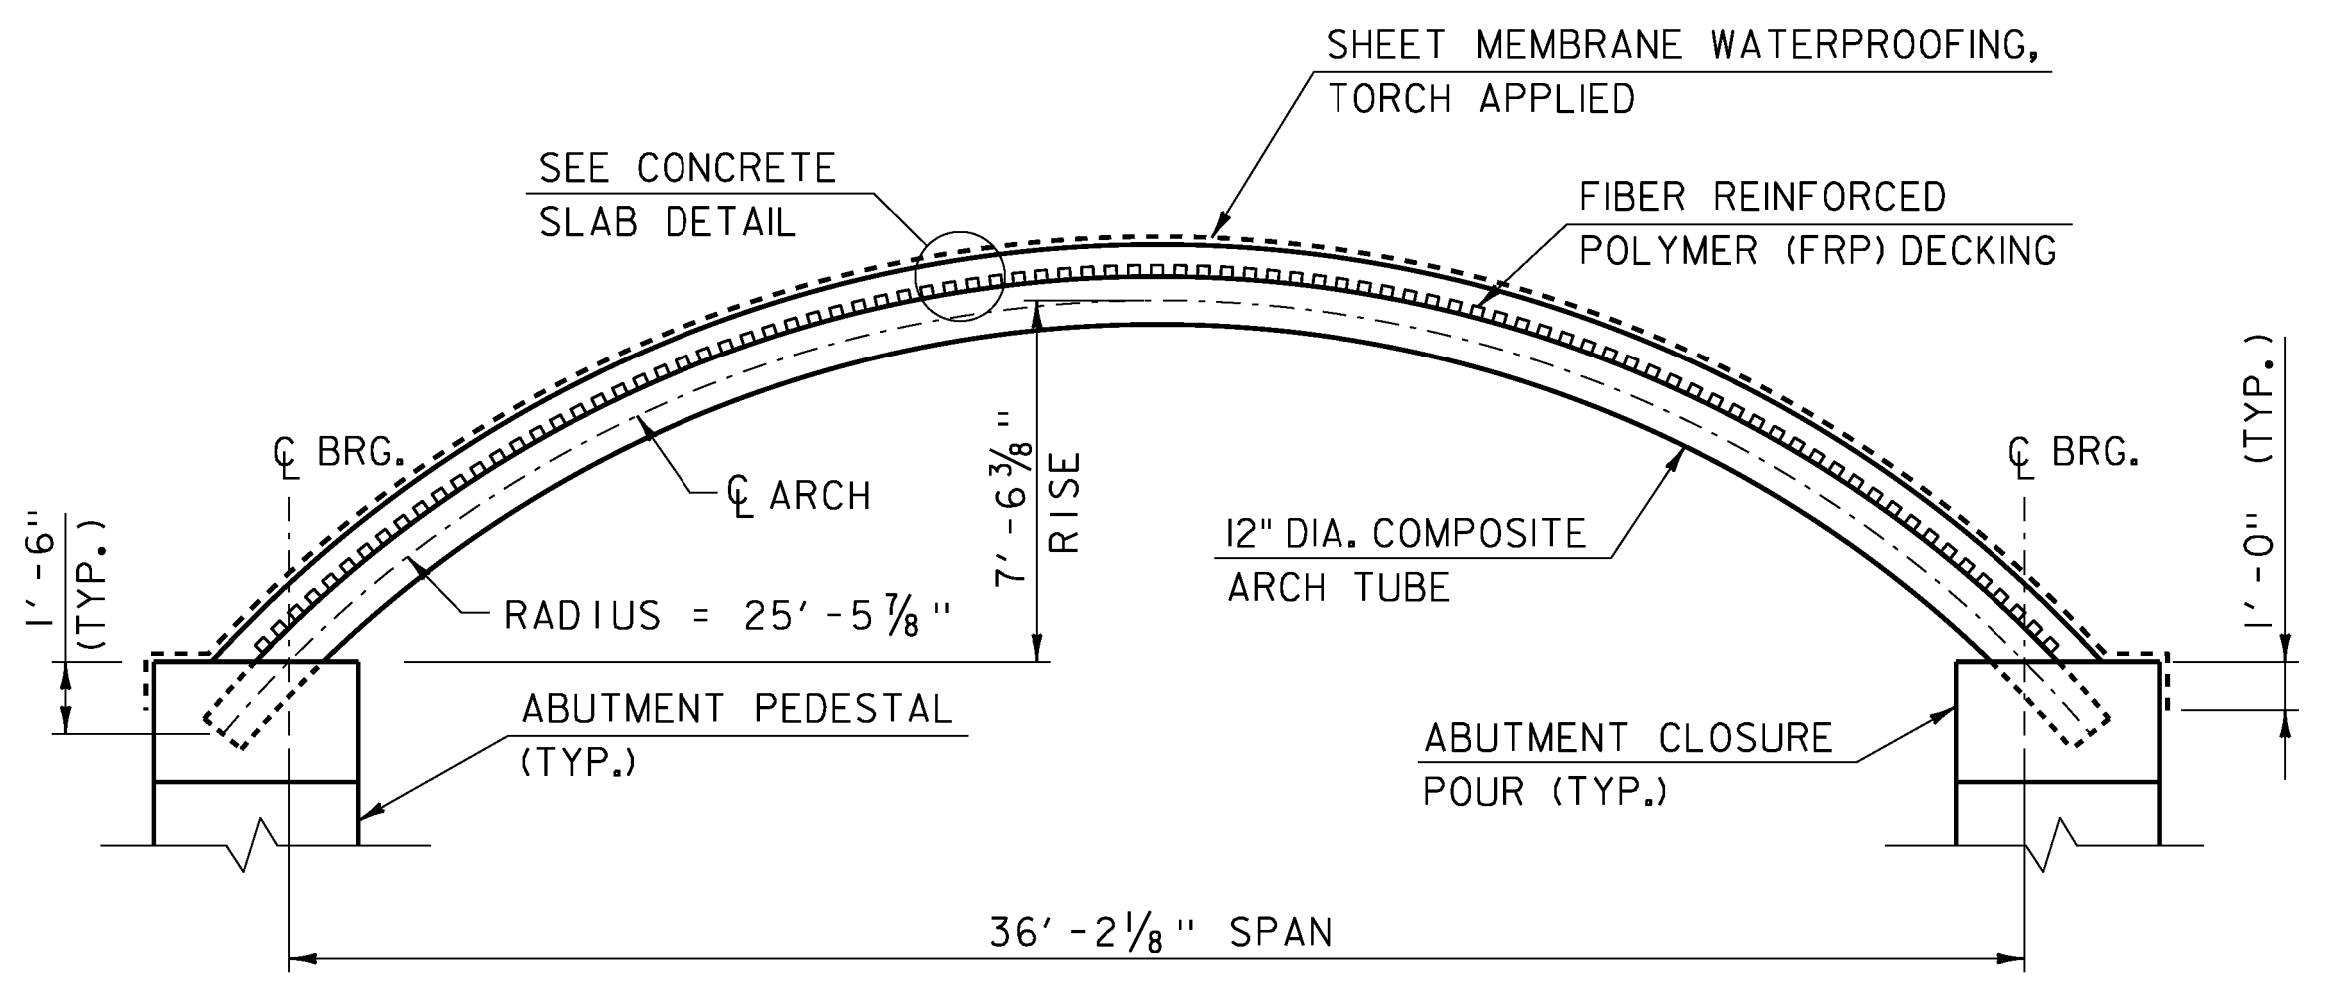


ARCH ELEVATION
SCALE 1/4" = 1'-0"

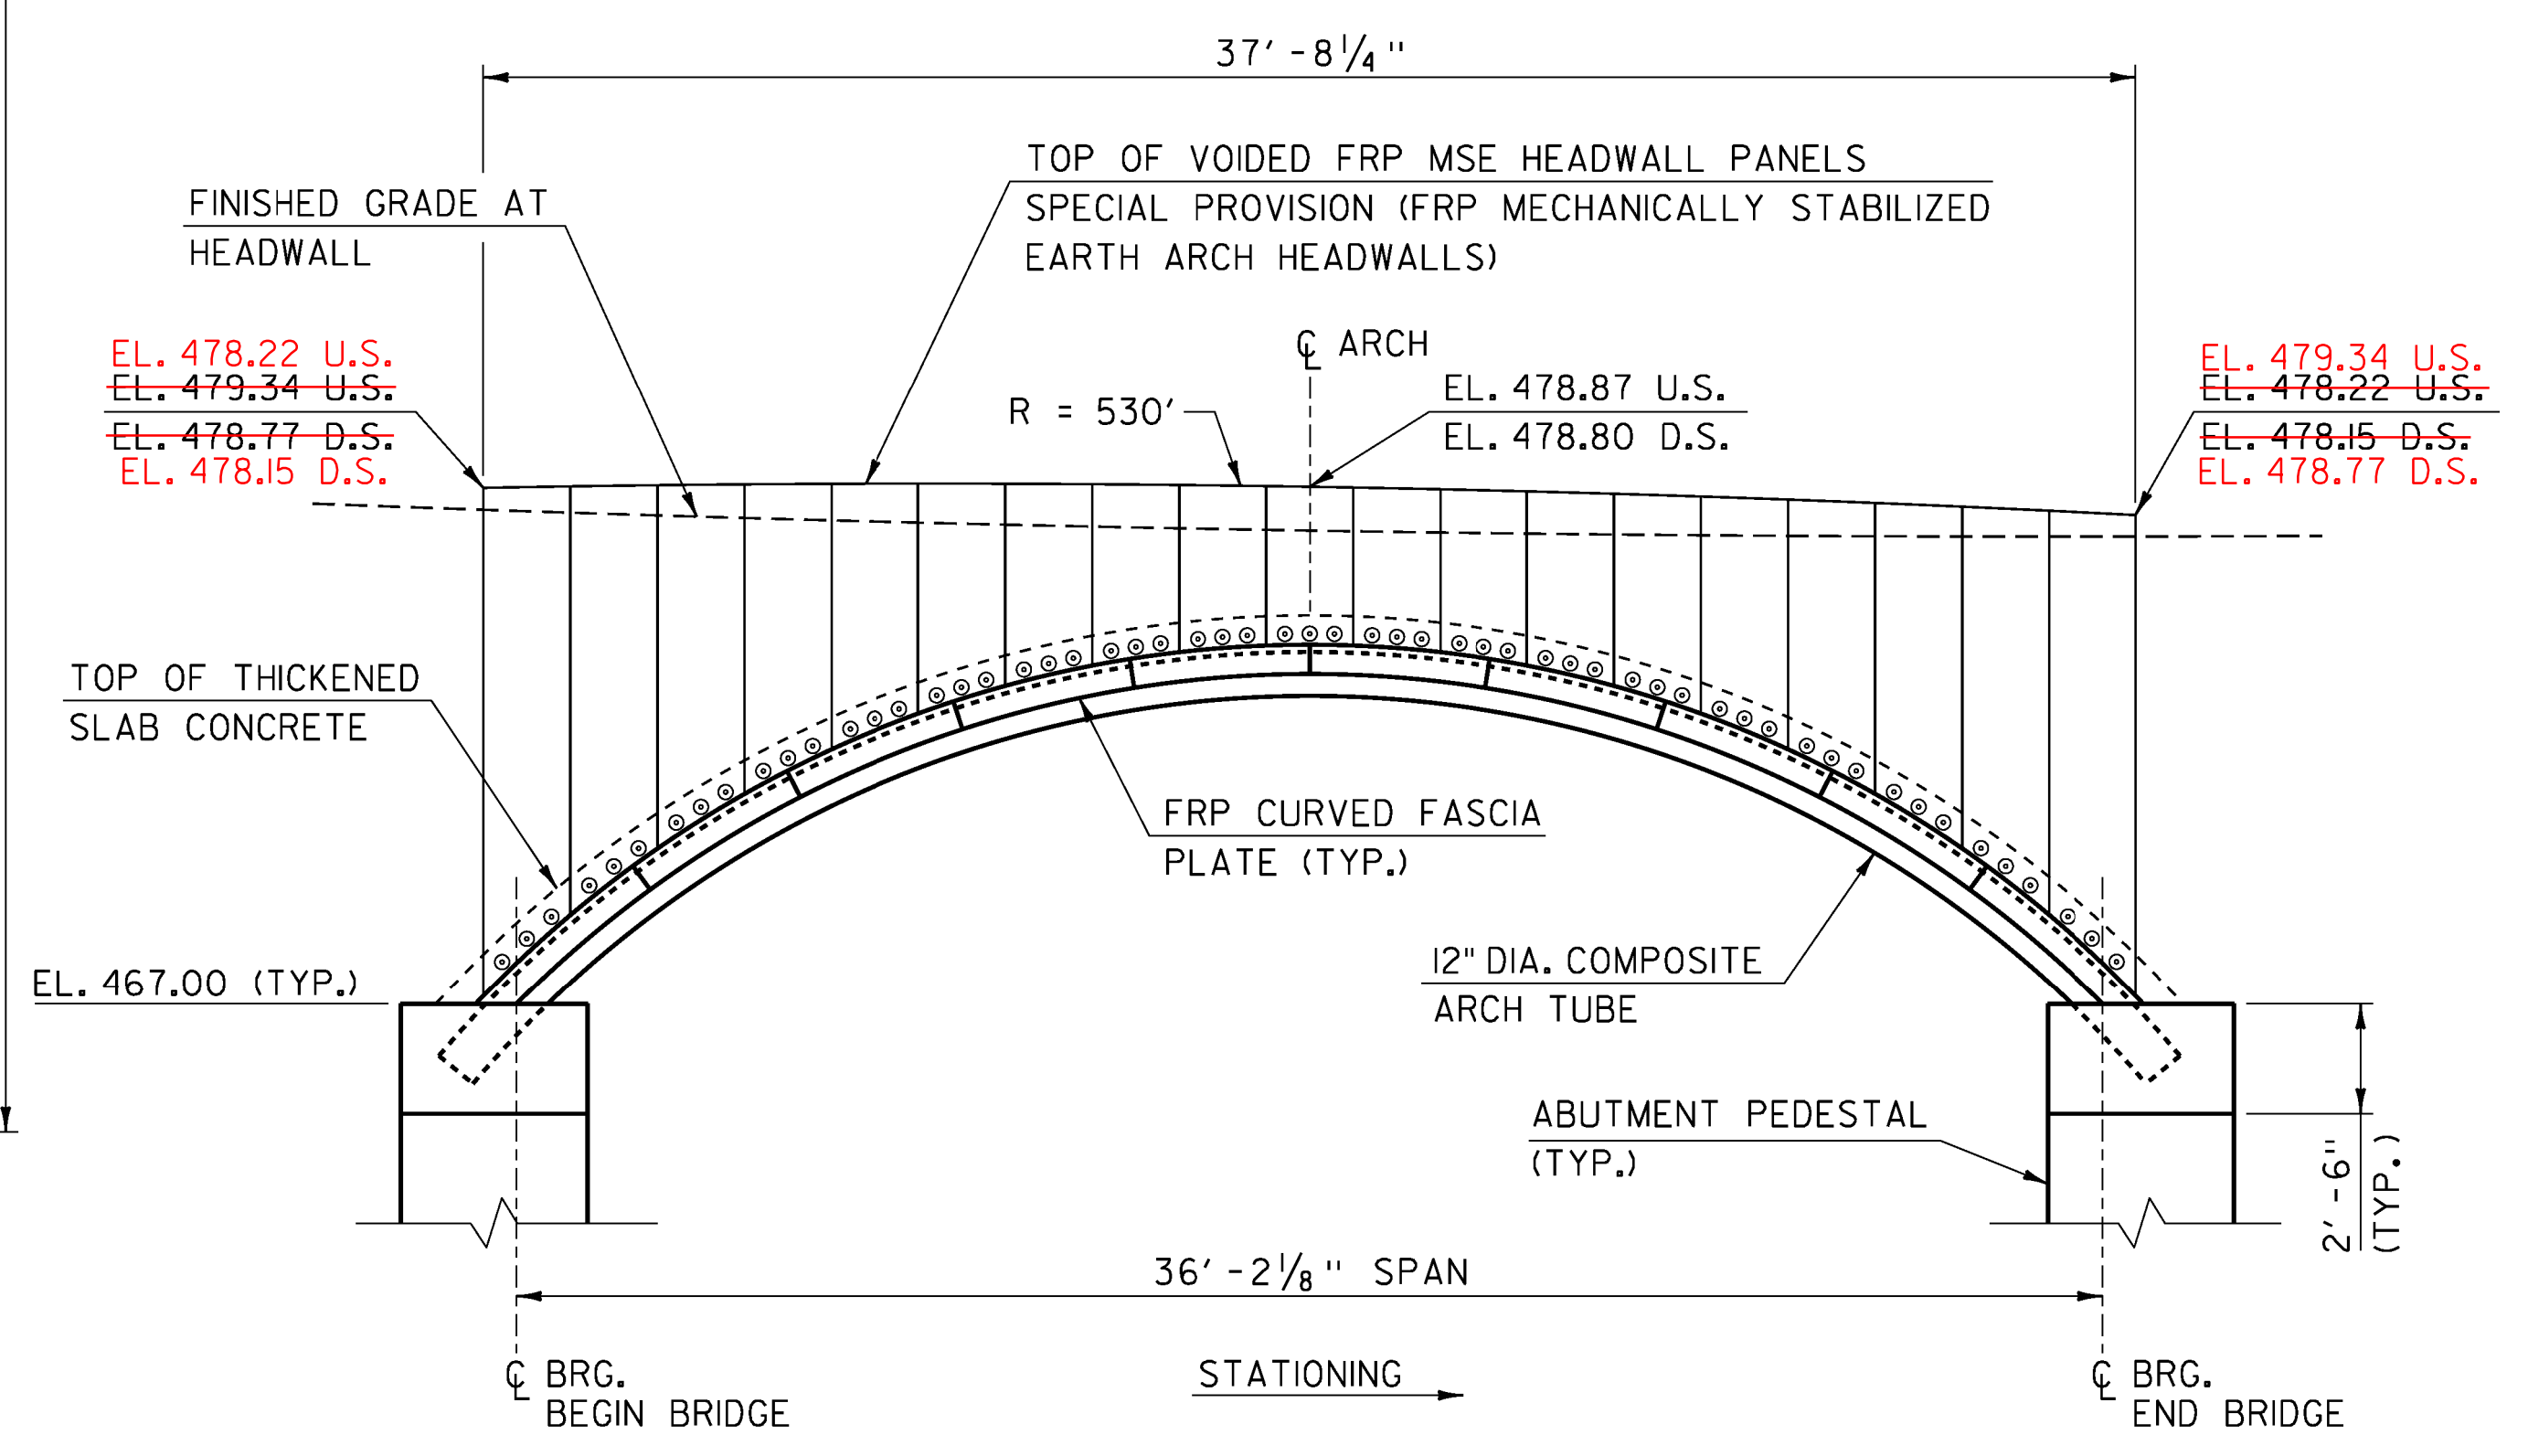


HEADWALL ELEVATION
SCALE 1/4" = 1'-0"

NOTE:
U.S. = UPSTREAM
D.S. = DOWNSTREAM

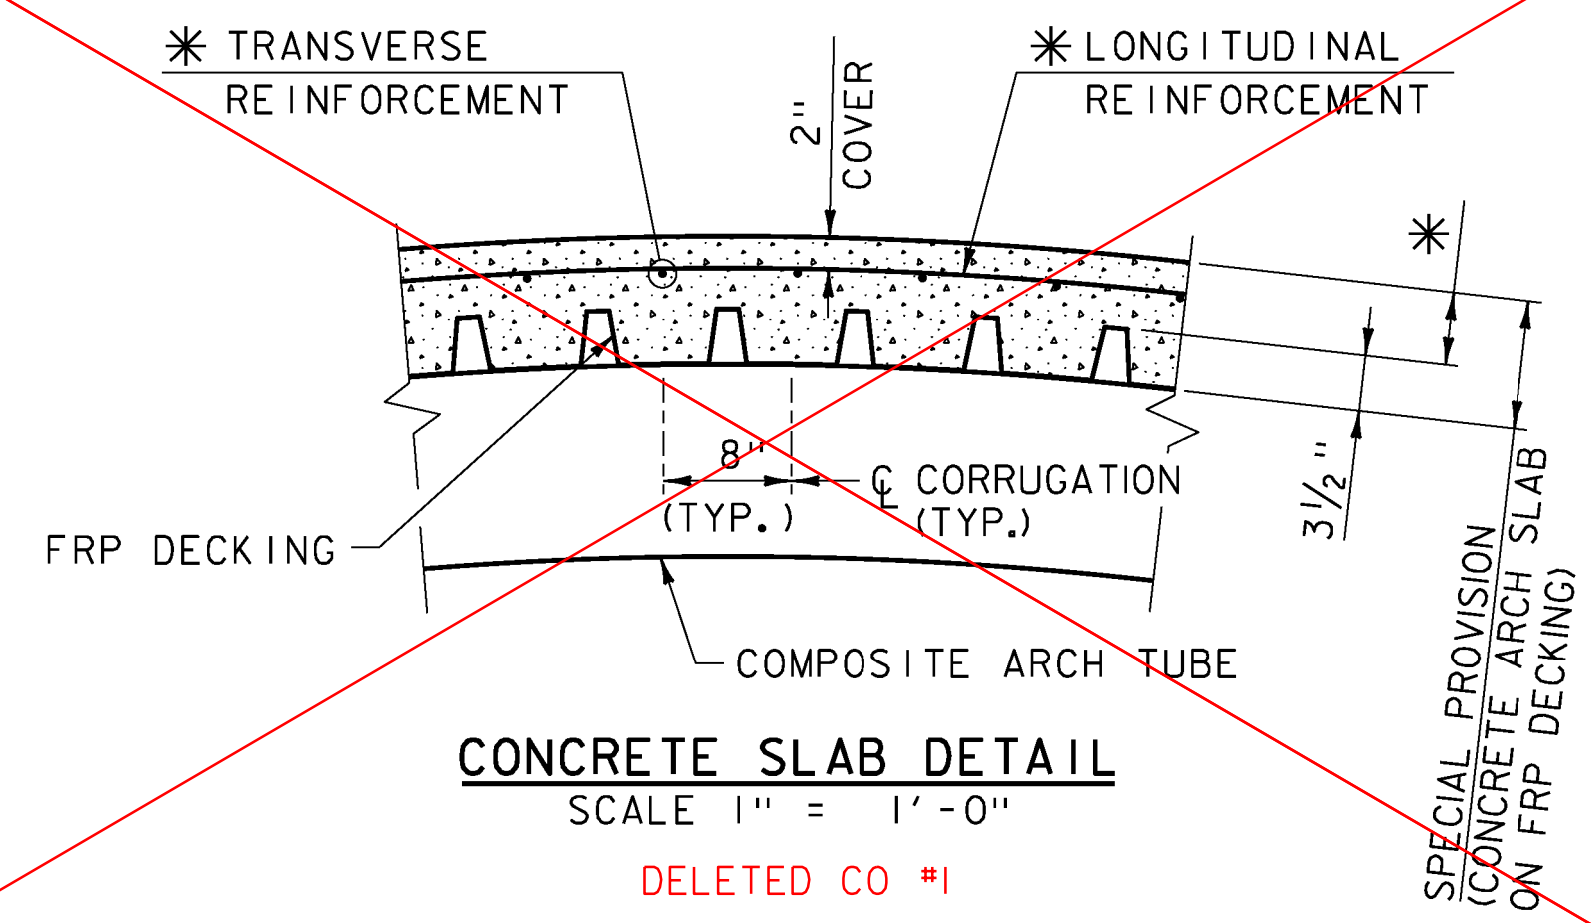

CONCRETE SLAB DETAIL
SCALE 1" = 1'-0"

DELETED CO #1

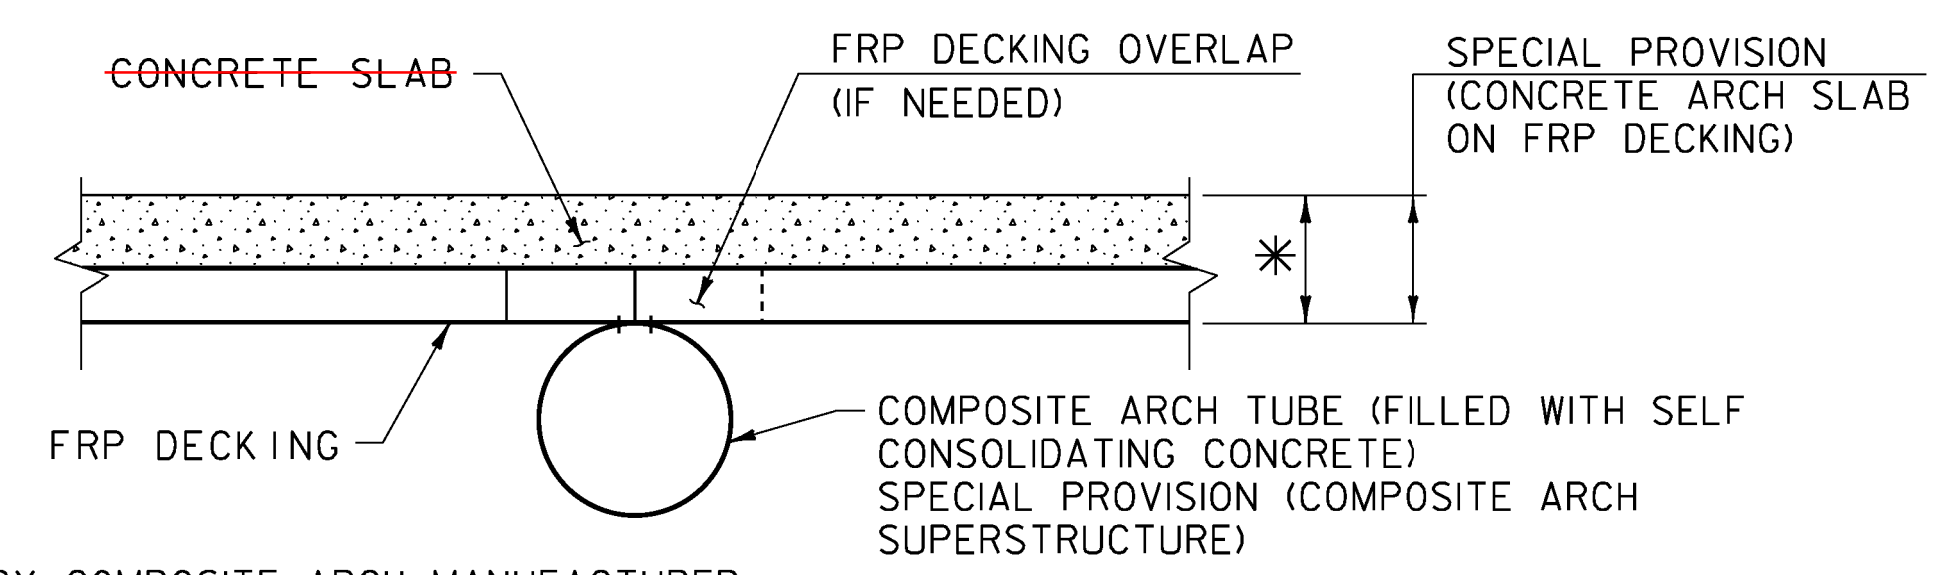


DECKING SPLICE DETAIL
SCALE 1" = 1'-0"

* AS REQUIRED BY COMPOSITE ARCH MANUFACTURER




PROJECT NAME: FAIRFIELD	PLOT DATE: 01-NOV-2013
PROJECT NUMBER: BRO 1448(38)	DRAWN BY: W. GAYNOR
FILE NAME: z11j072frm_01.dgn	DESIGNED BY: E. ALEXOPOULOS
PROJECT LEADER: D. LANDRY	CHECKED BY: T. KENDRICK
COMPOSITE ARCH SUPERSTRUCTURE (1 OF 2)	SHEET 26 OF 41

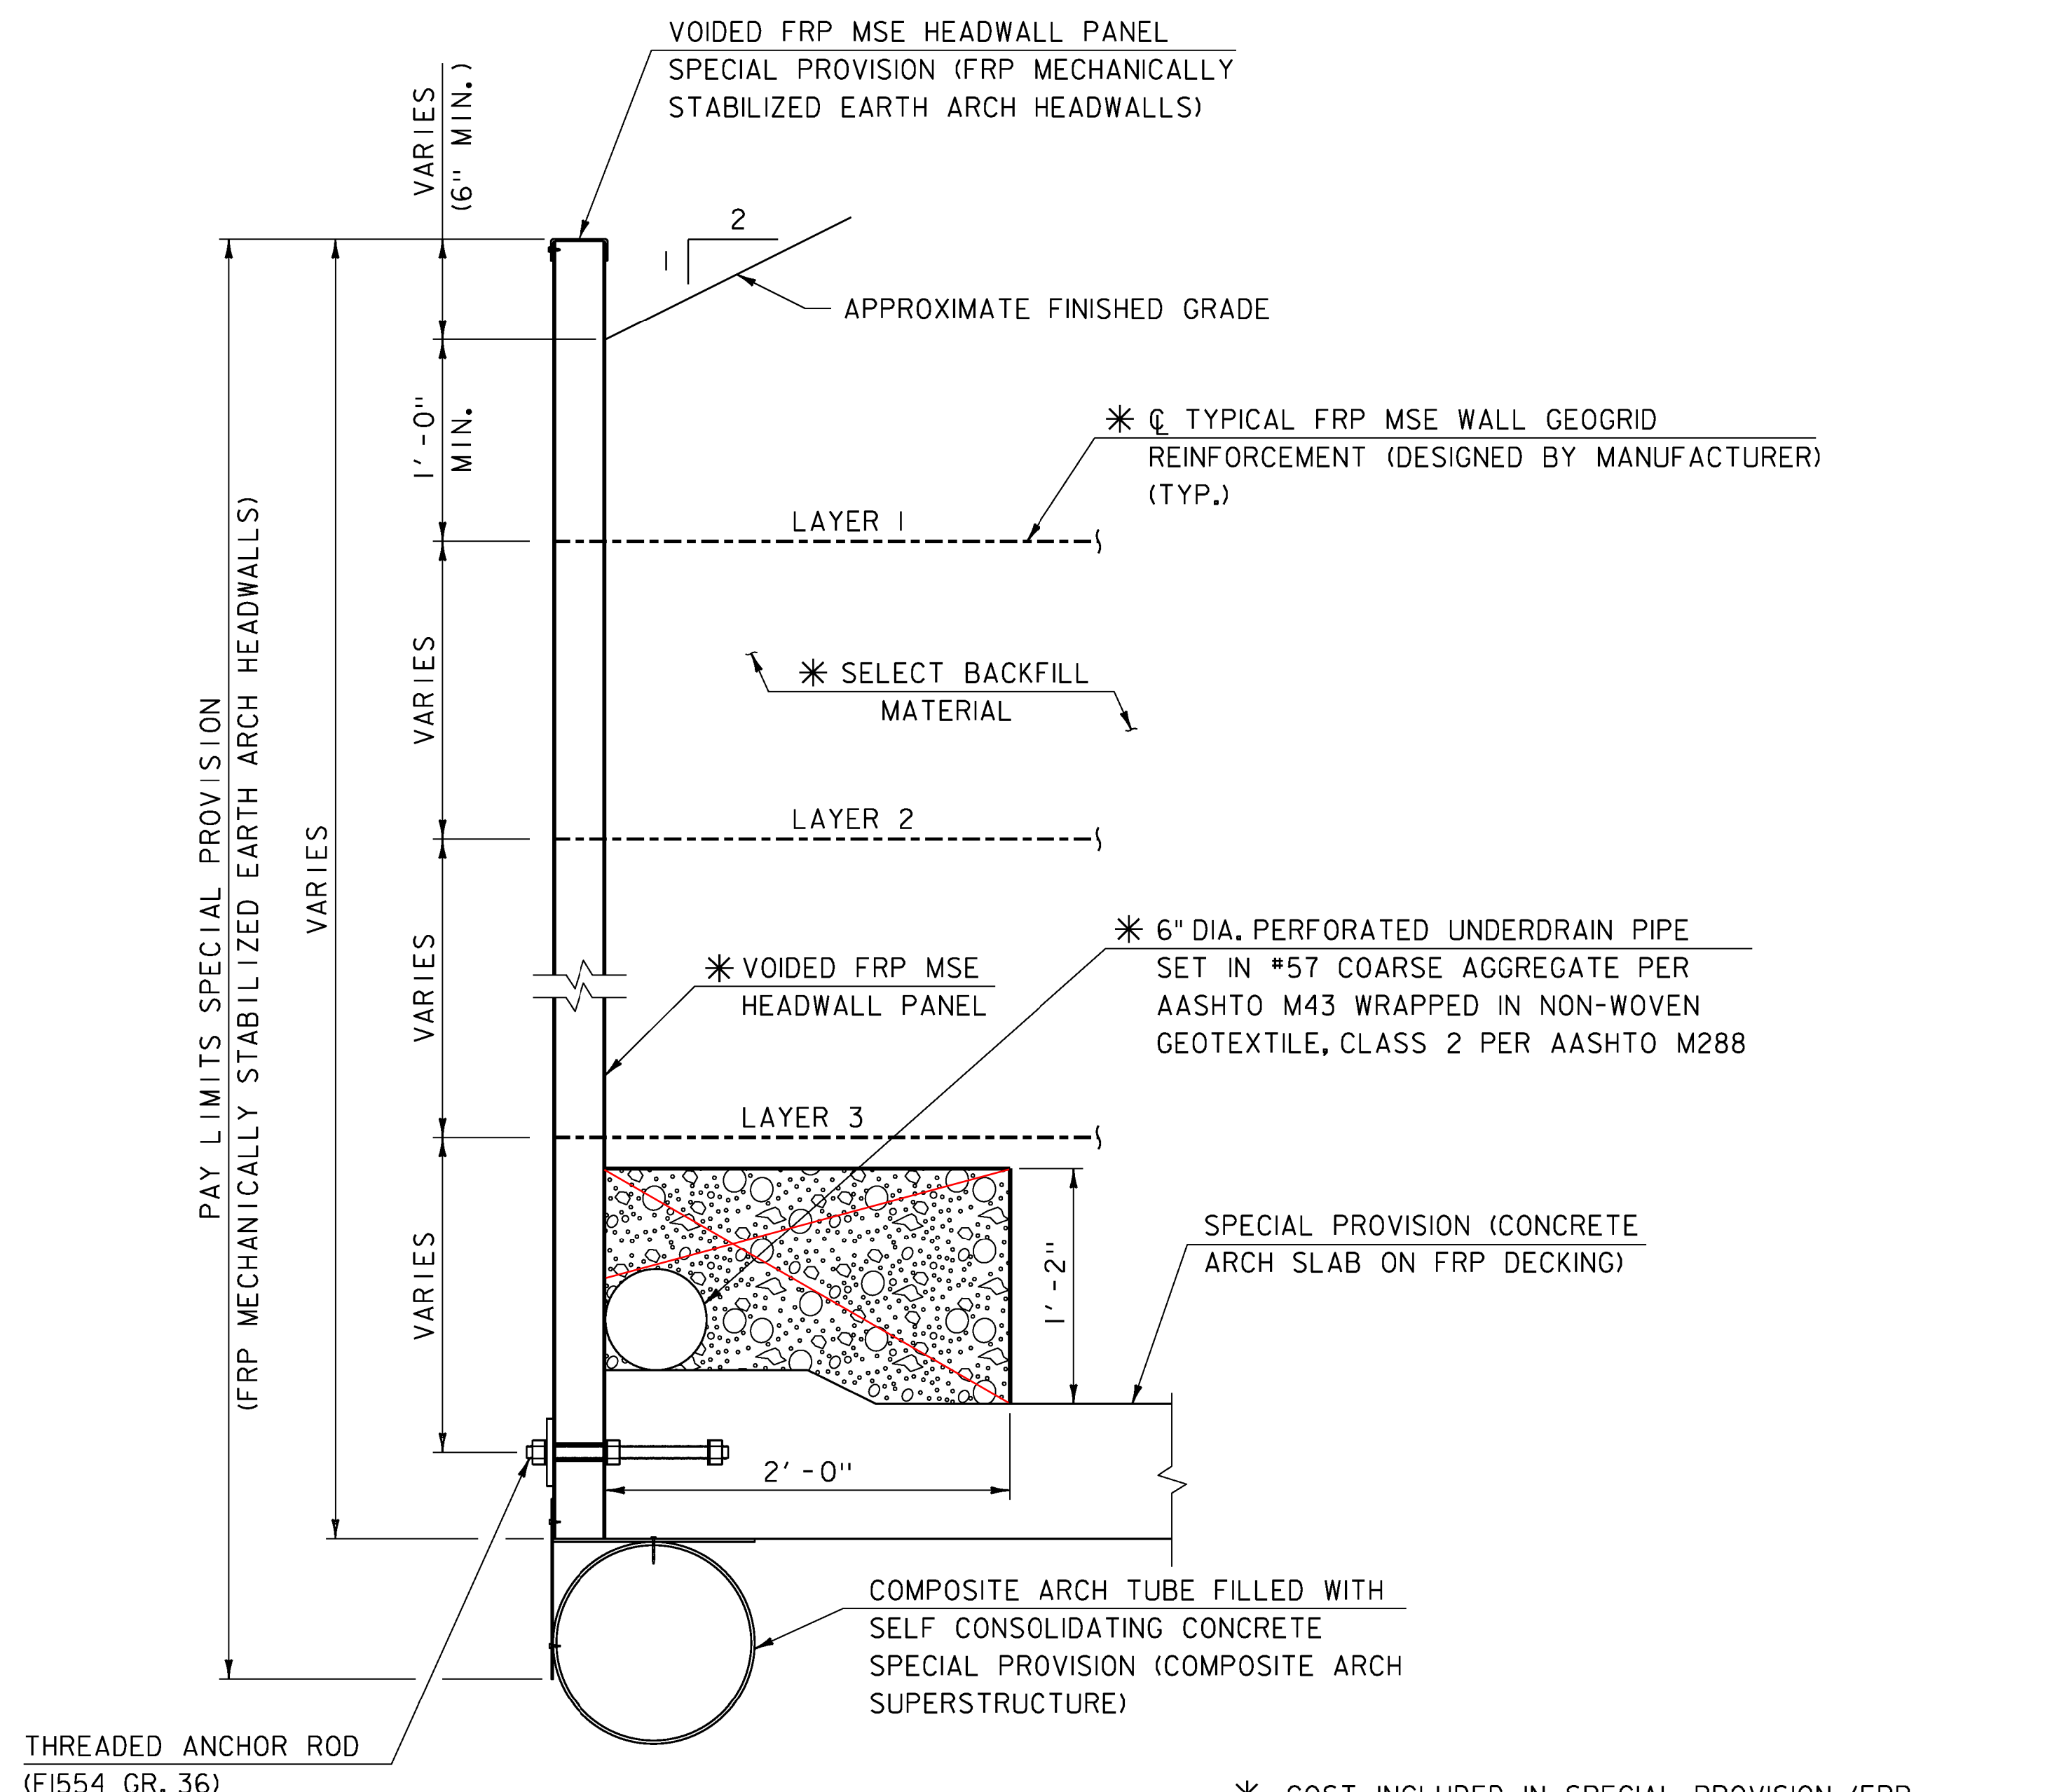


TYPICAL FRP MSE HEADWALL SECTION
SCALE 1 1/2" = 1'-0"

* COST INCLUDED IN SPECIAL PROVISION (FRP MECHANICALLY STABILIZED EARTH ARCH HEADWALLS)

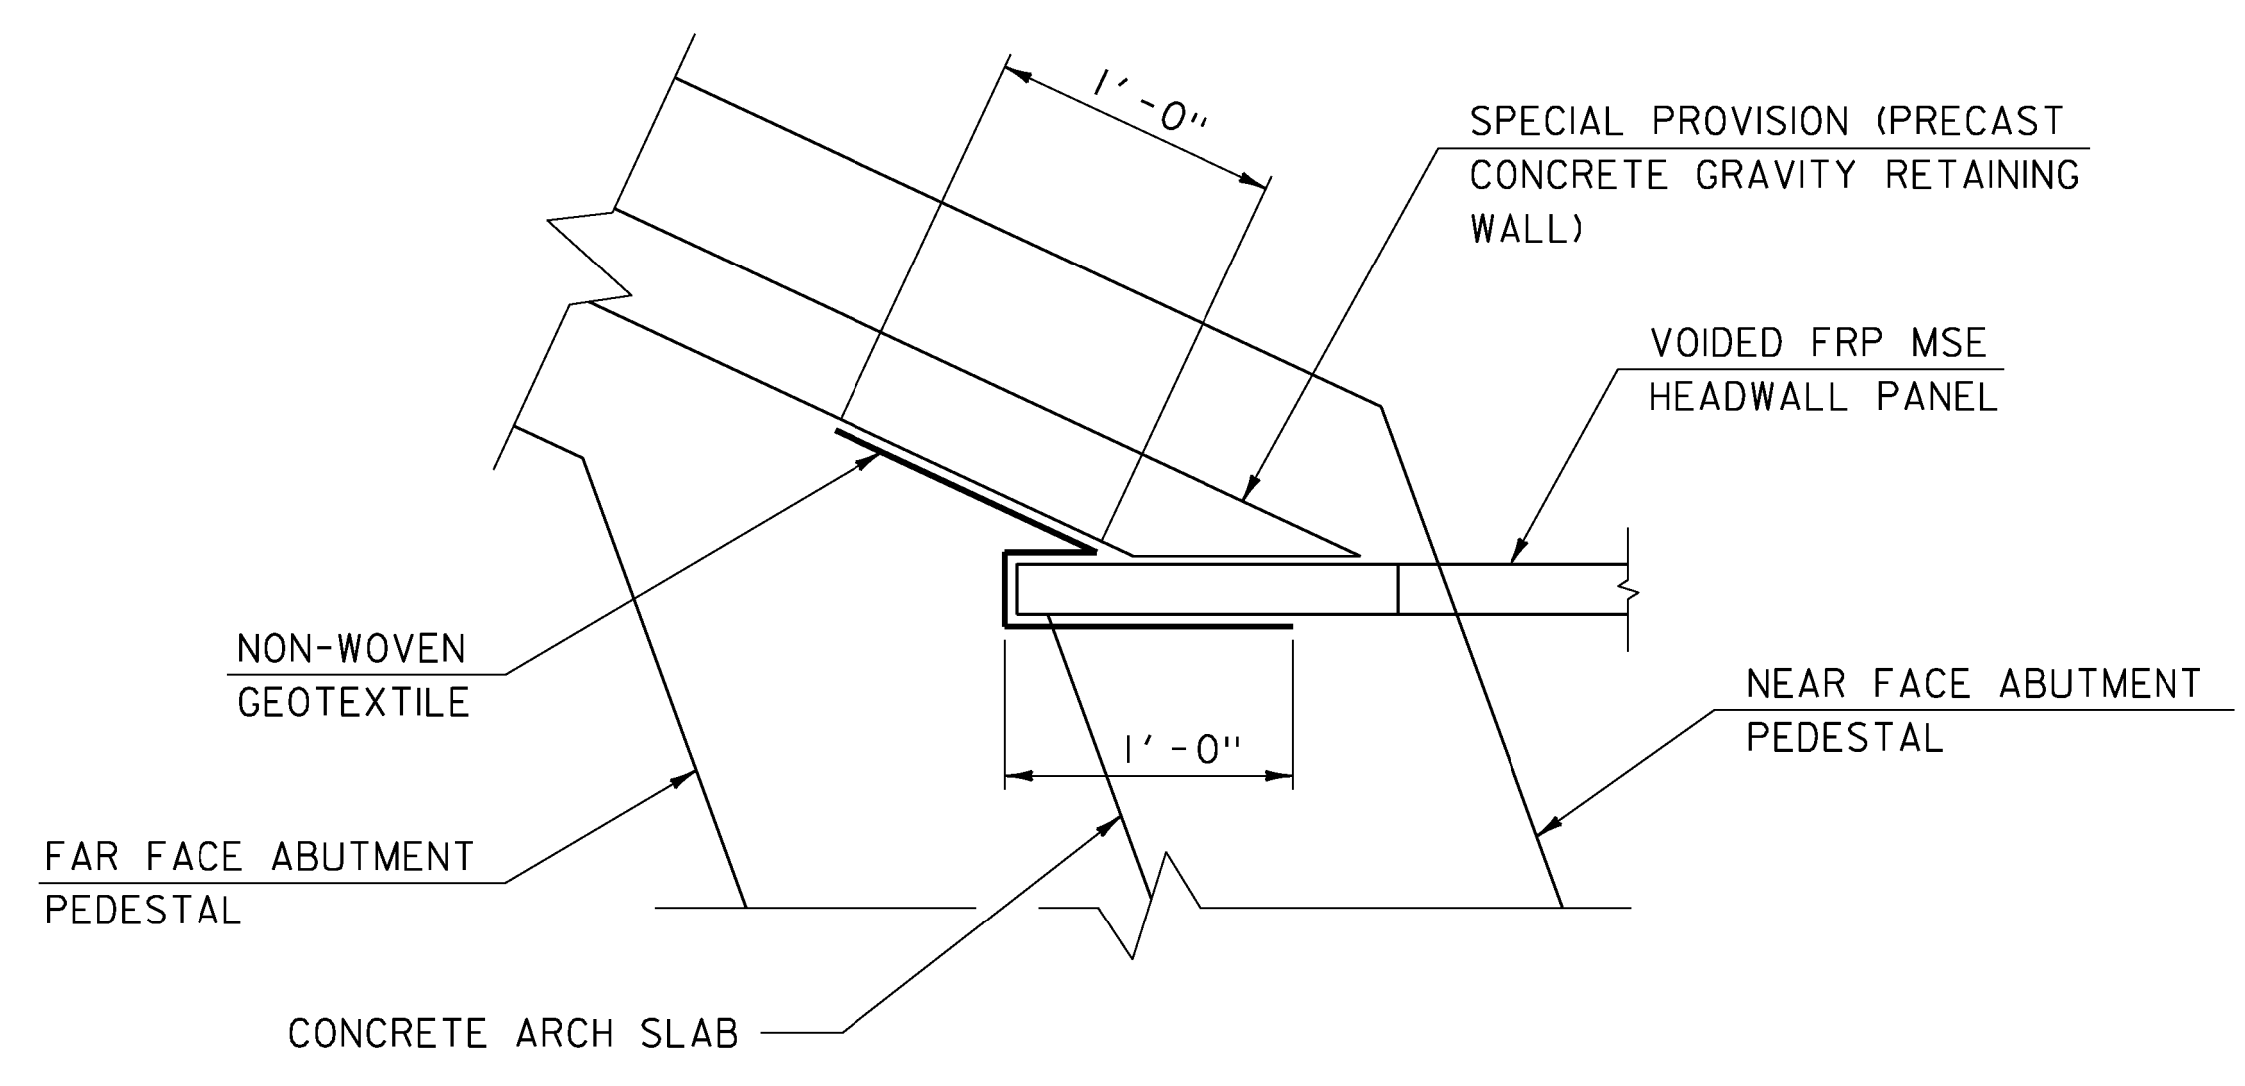

FILTER FABRIC CORNER DETAIL
NOT TO SCALE

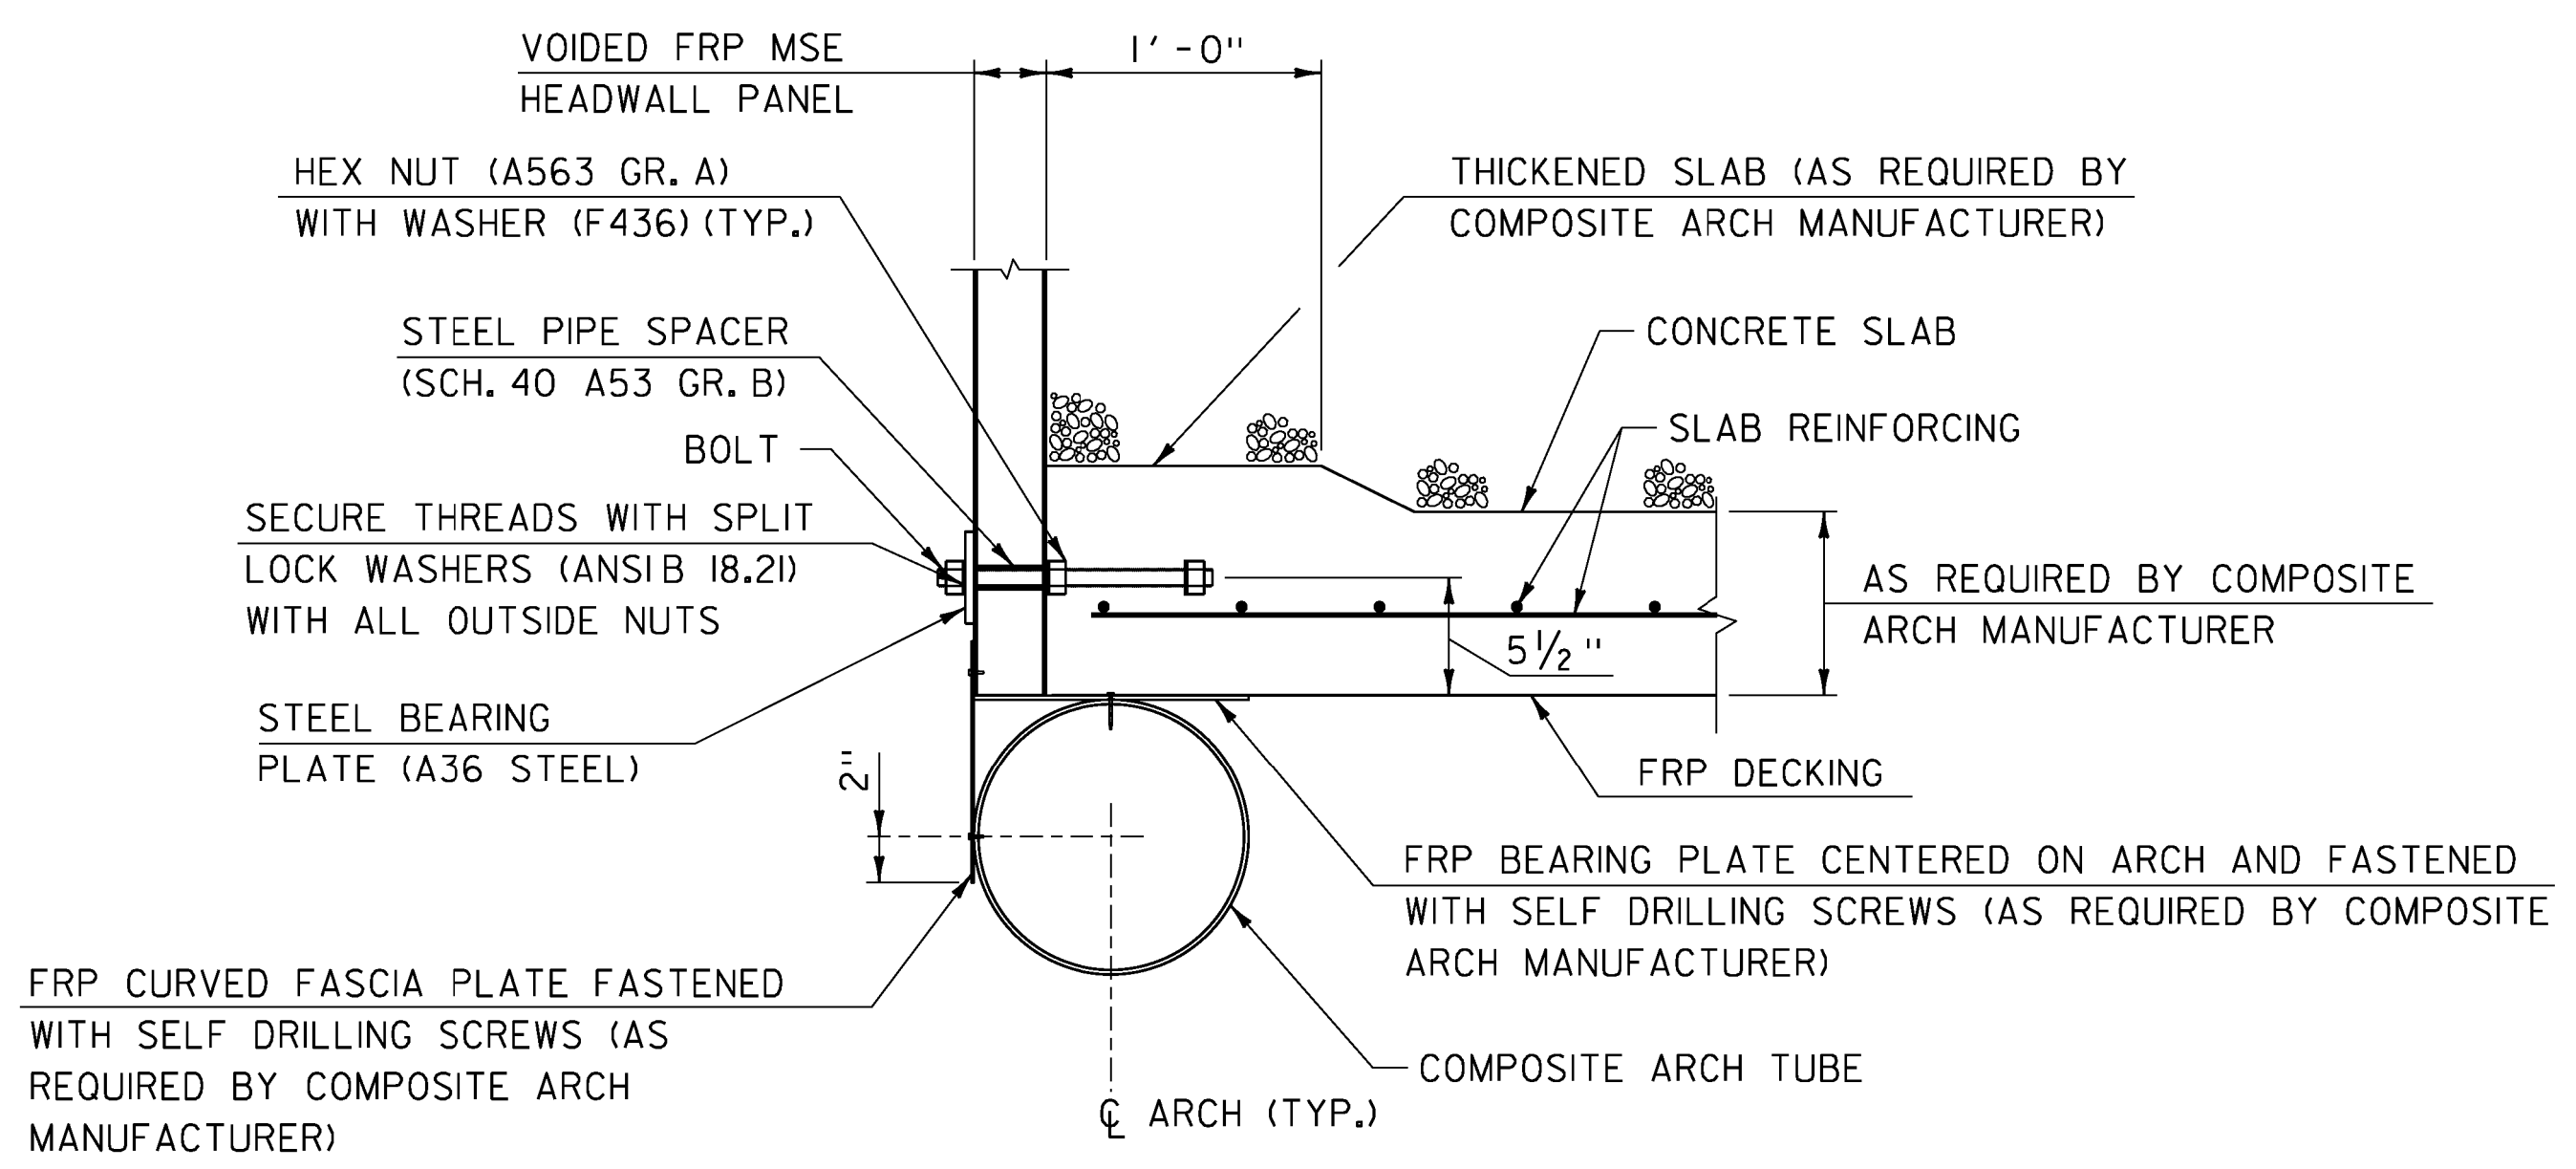



NOTE: UNDERDRAIN ITEMS NOT SHOWN FOR CLARITY

TYPICAL FASCIA DETAIL
SCALE 1 1/2" = 1'-0"

NOTES


1. DETAILS SHOWN ON THIS SHEET ARE CONCEPTUAL. FINAL DETAILS TO BE PROVIDED BY THE MANUFACTURER FOR VTRANS APPROVAL.

PROJECT NAME:	FAIRFIELD
PROJECT NUMBER:	BRO 1448(38)
FILE NAME:	z11j072supl.dgn
PROJECT LEADER:	D. LANDRY
DESIGNED BY:	E. ALEXOPOULOS
COMPOSITE ARCH SUPERSTRUCTURE (2 OF 2)	SHEET 27 OF 41
PLOT DATE:	01-NOV-2013
DRAWN BY:	W. GAYNOR
CHECKED BY:	T. KENDRICK

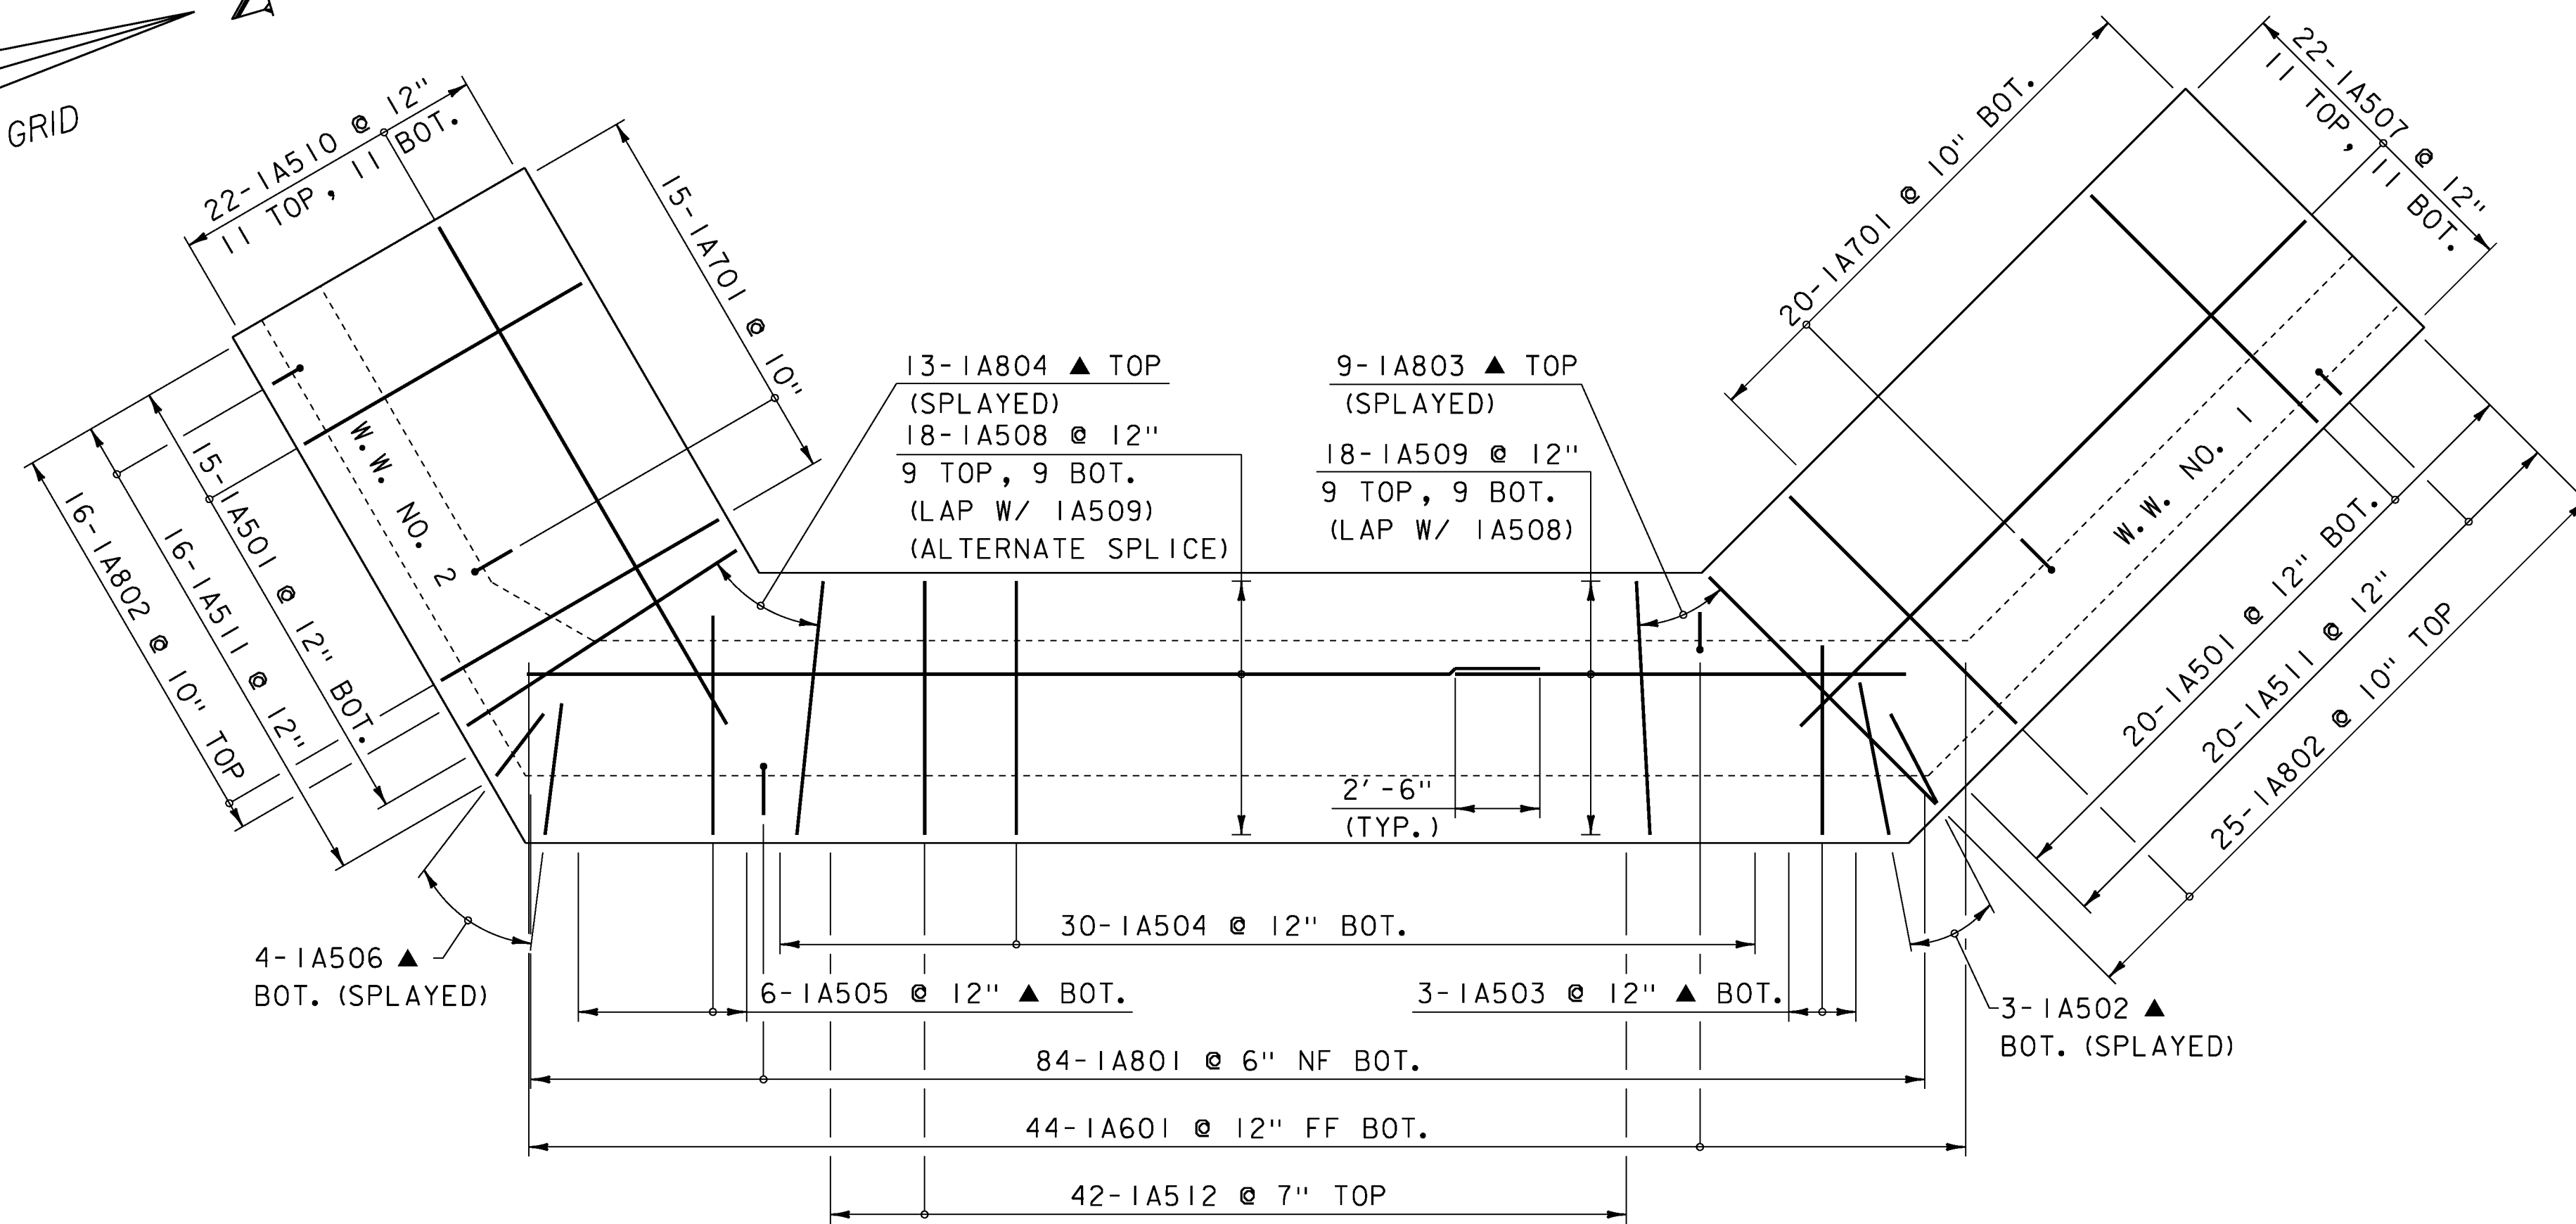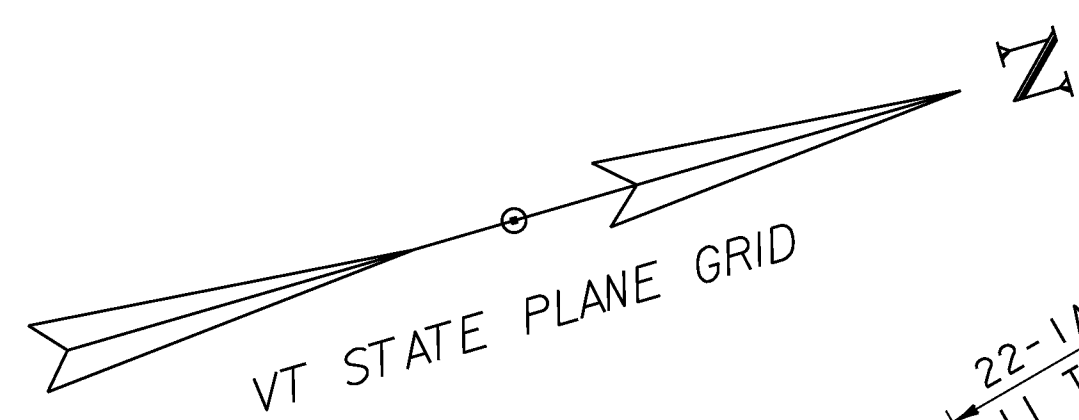

ABUTMENT NO. 1 FOOTING REINFORCEMENT PLAN

SCALE: 1/4" = 1'-0"

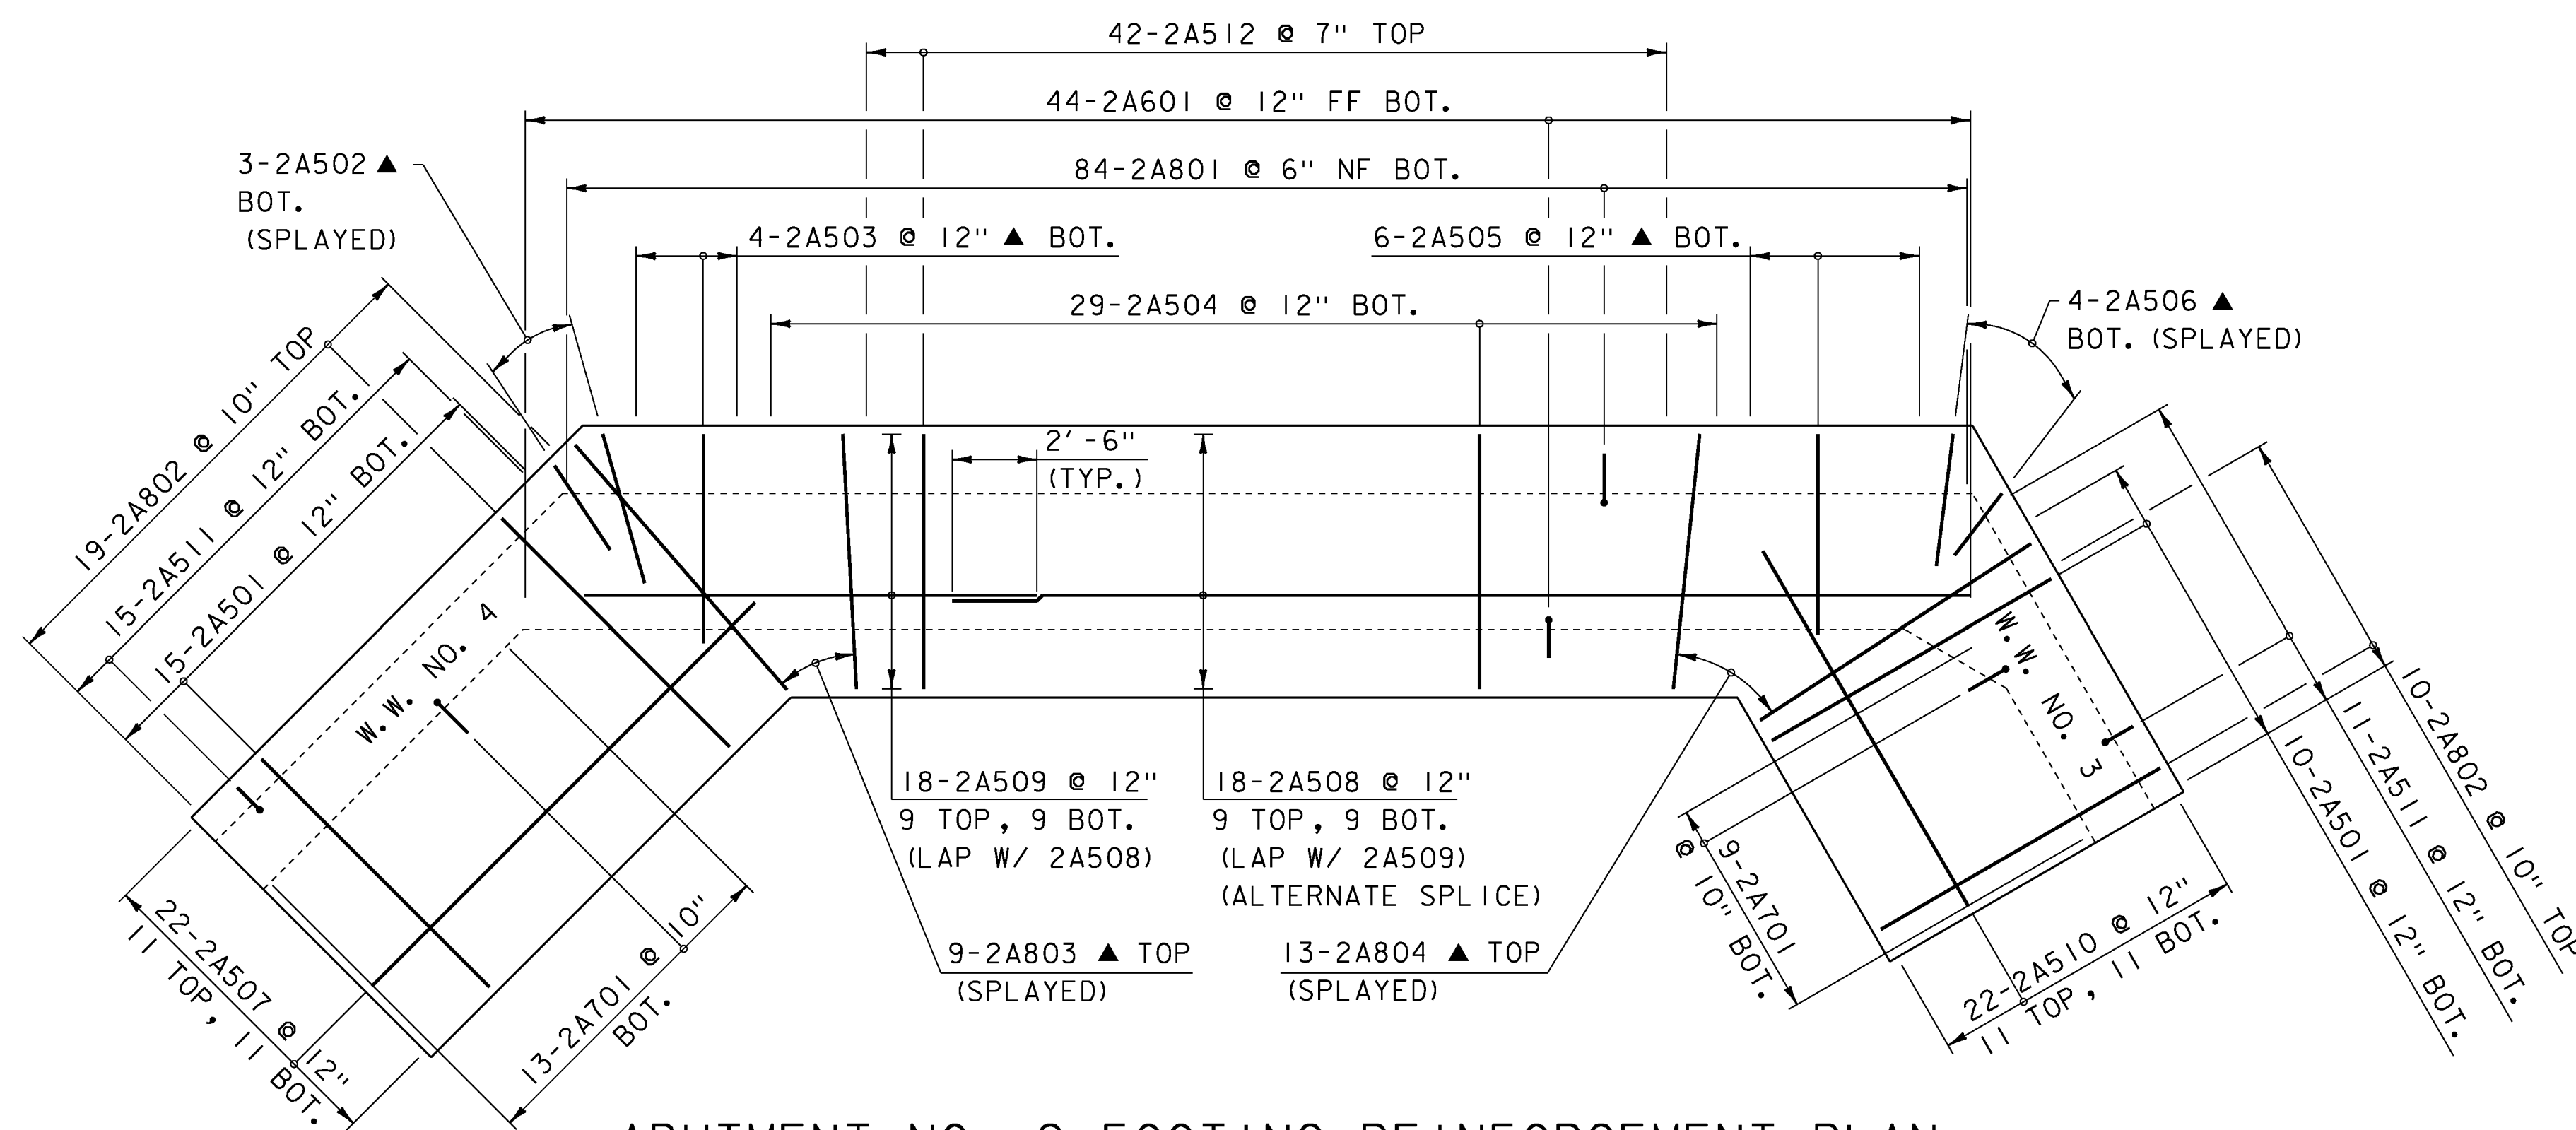

ABUTMENT NO. 2 FOOTING REINFORCEMENT PLAN

SCALE: 1/4" = 1'-0"

NOTE:



- NF = NEAR FACE
- FF = FAR FACE
- EF = EACH FACE
- ▲ = CUT TO FIT IN FIELD
- 3" CLEAR, UNLESS OTHERWISE SPECIFIED ON THE PLANS.
- 2'-2" BAR LAP UNLESS OTHERWISE SPECIFIED ON THE PLANS.

PROJECT NAME: FAIRFIELD
PROJECT NUMBER: BRO 1448(38)

FILE NAME: z11j072sub1.dgn
PROJECT LEADER: D. LANDRY
DESIGNED BY: T. TRAYER
ABUTMENT FOOTING DETAILS


PLOT DATE: 01-NOV-2013
DRAWN BY: P. DUSTIN
CHECKED BY: T. KENDRICK
SHEET 28 OF 41



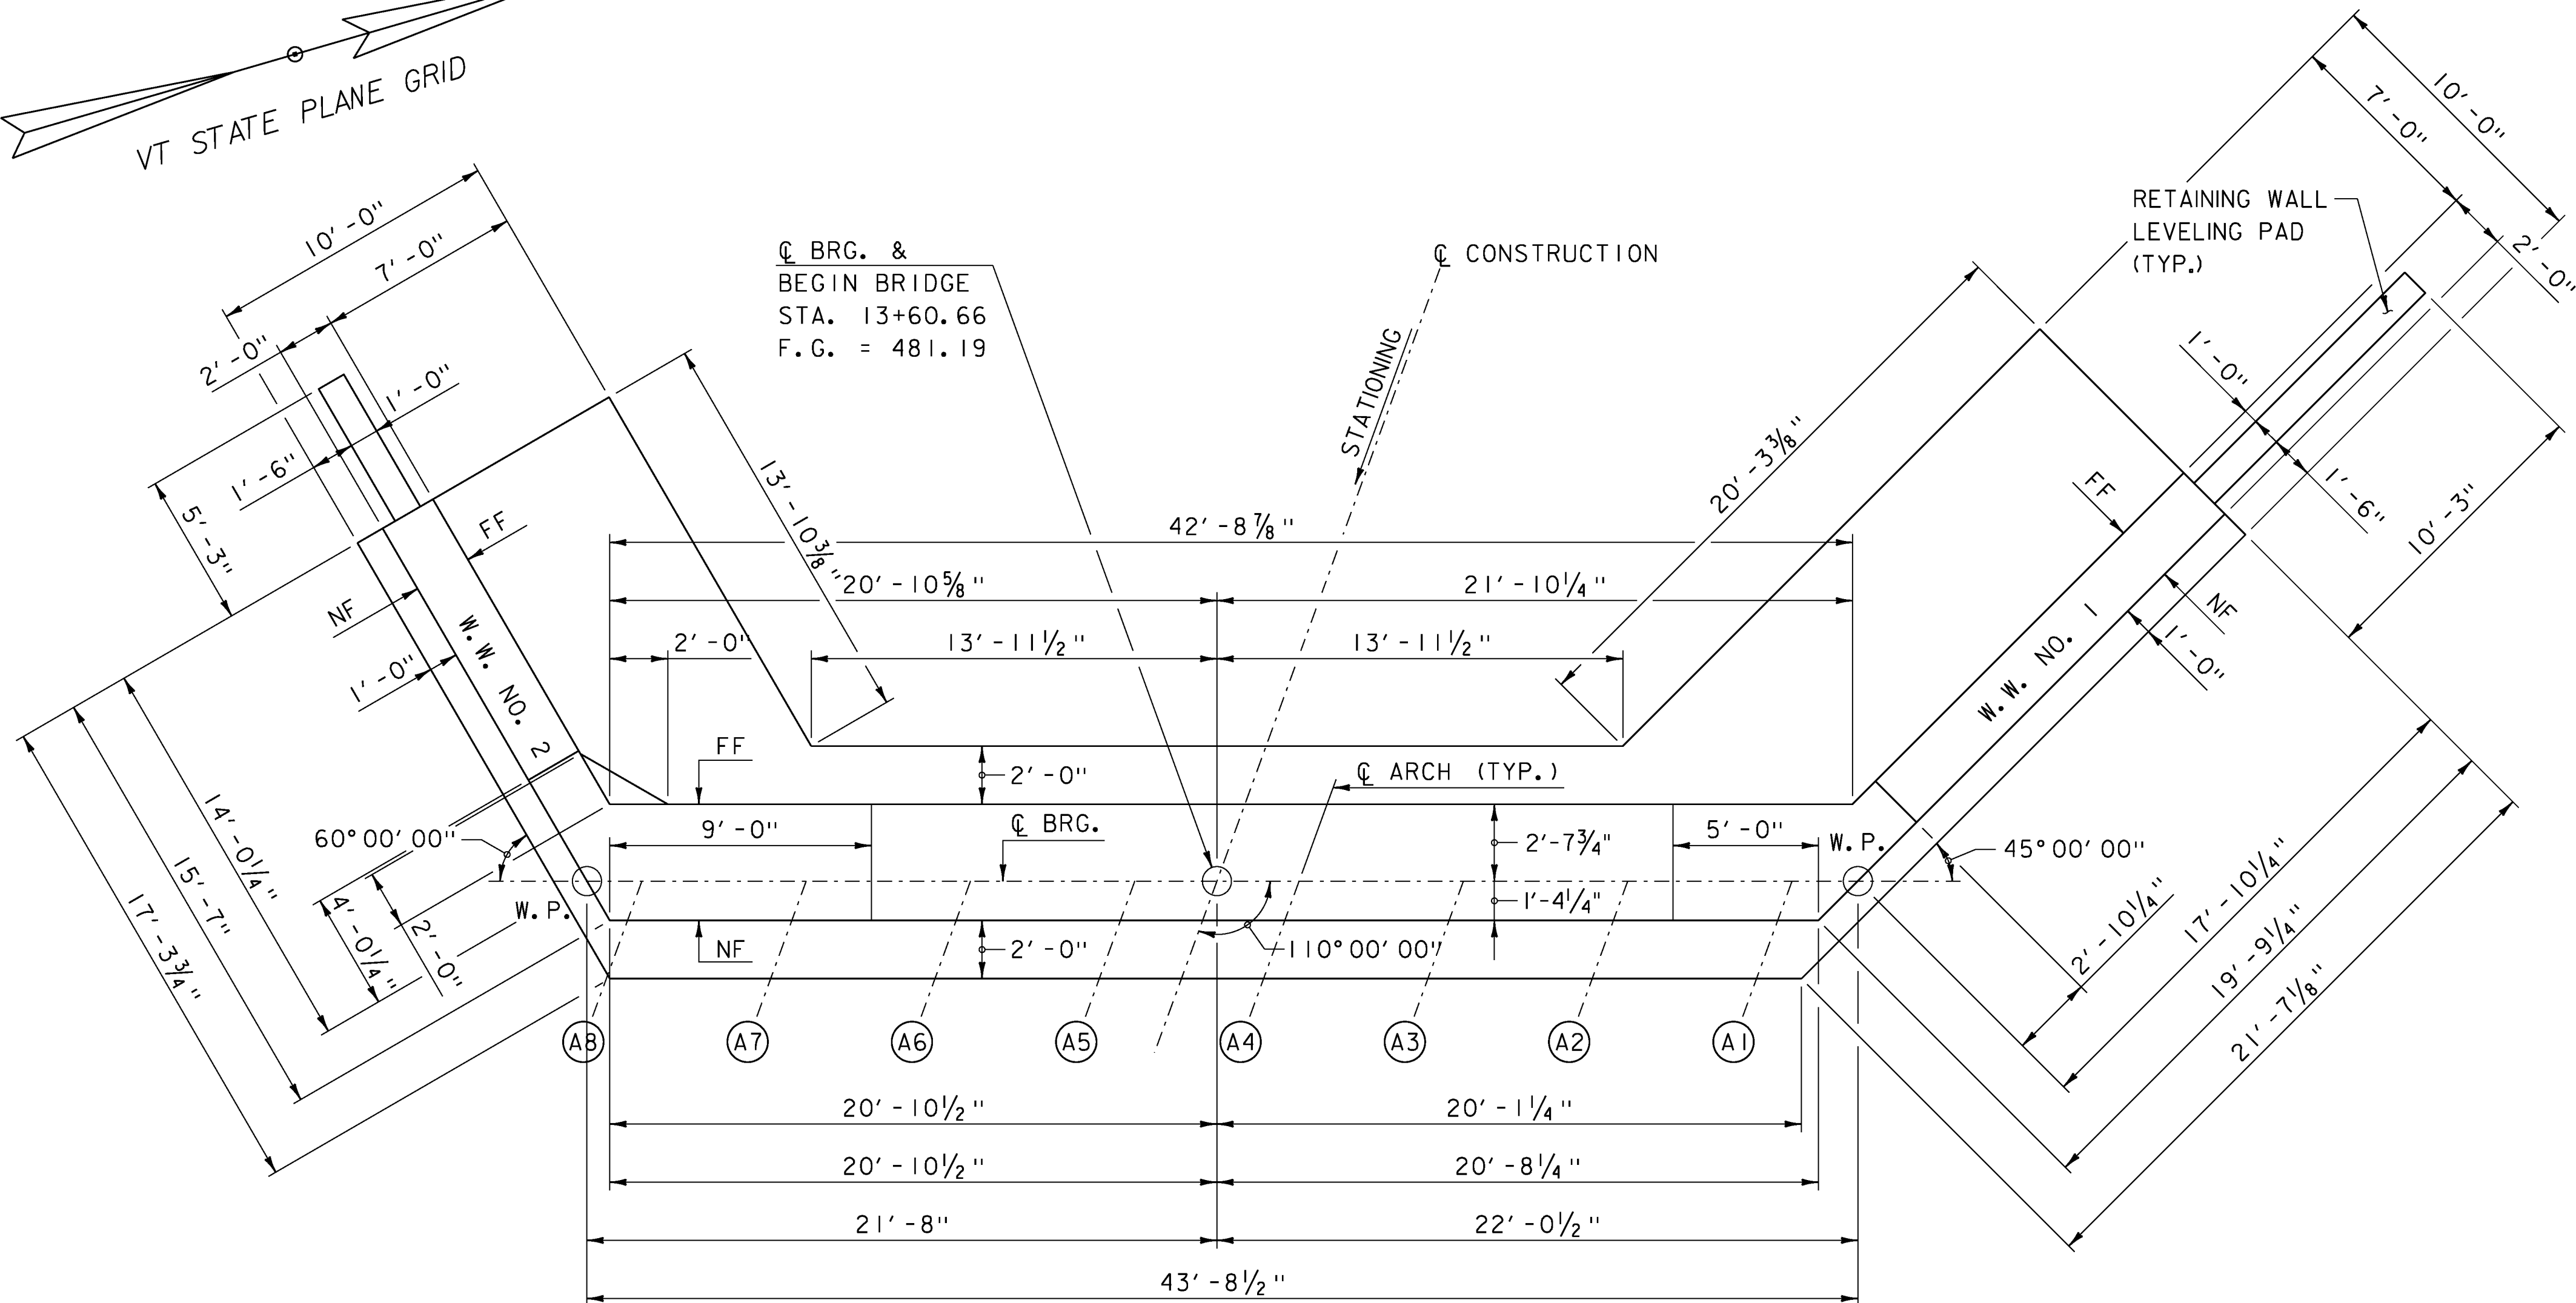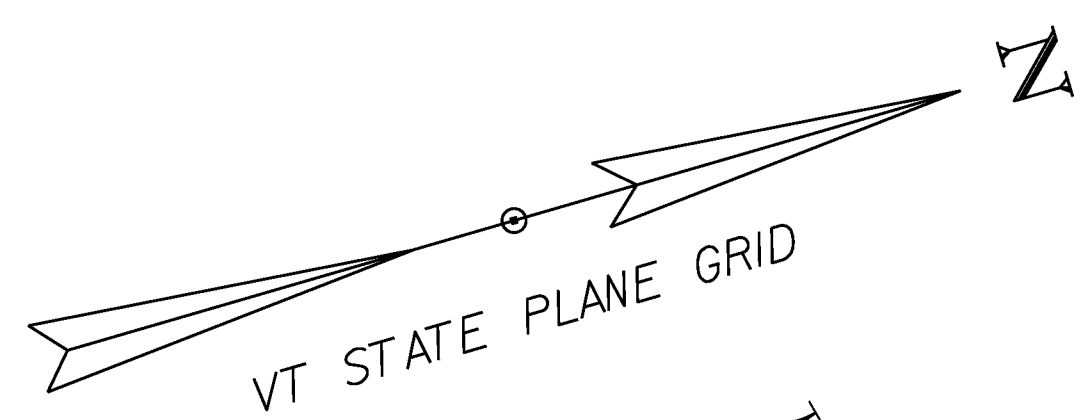


ABUTMENT NO. 1 PLAN

SCALE: 1/4" = 1'-0"

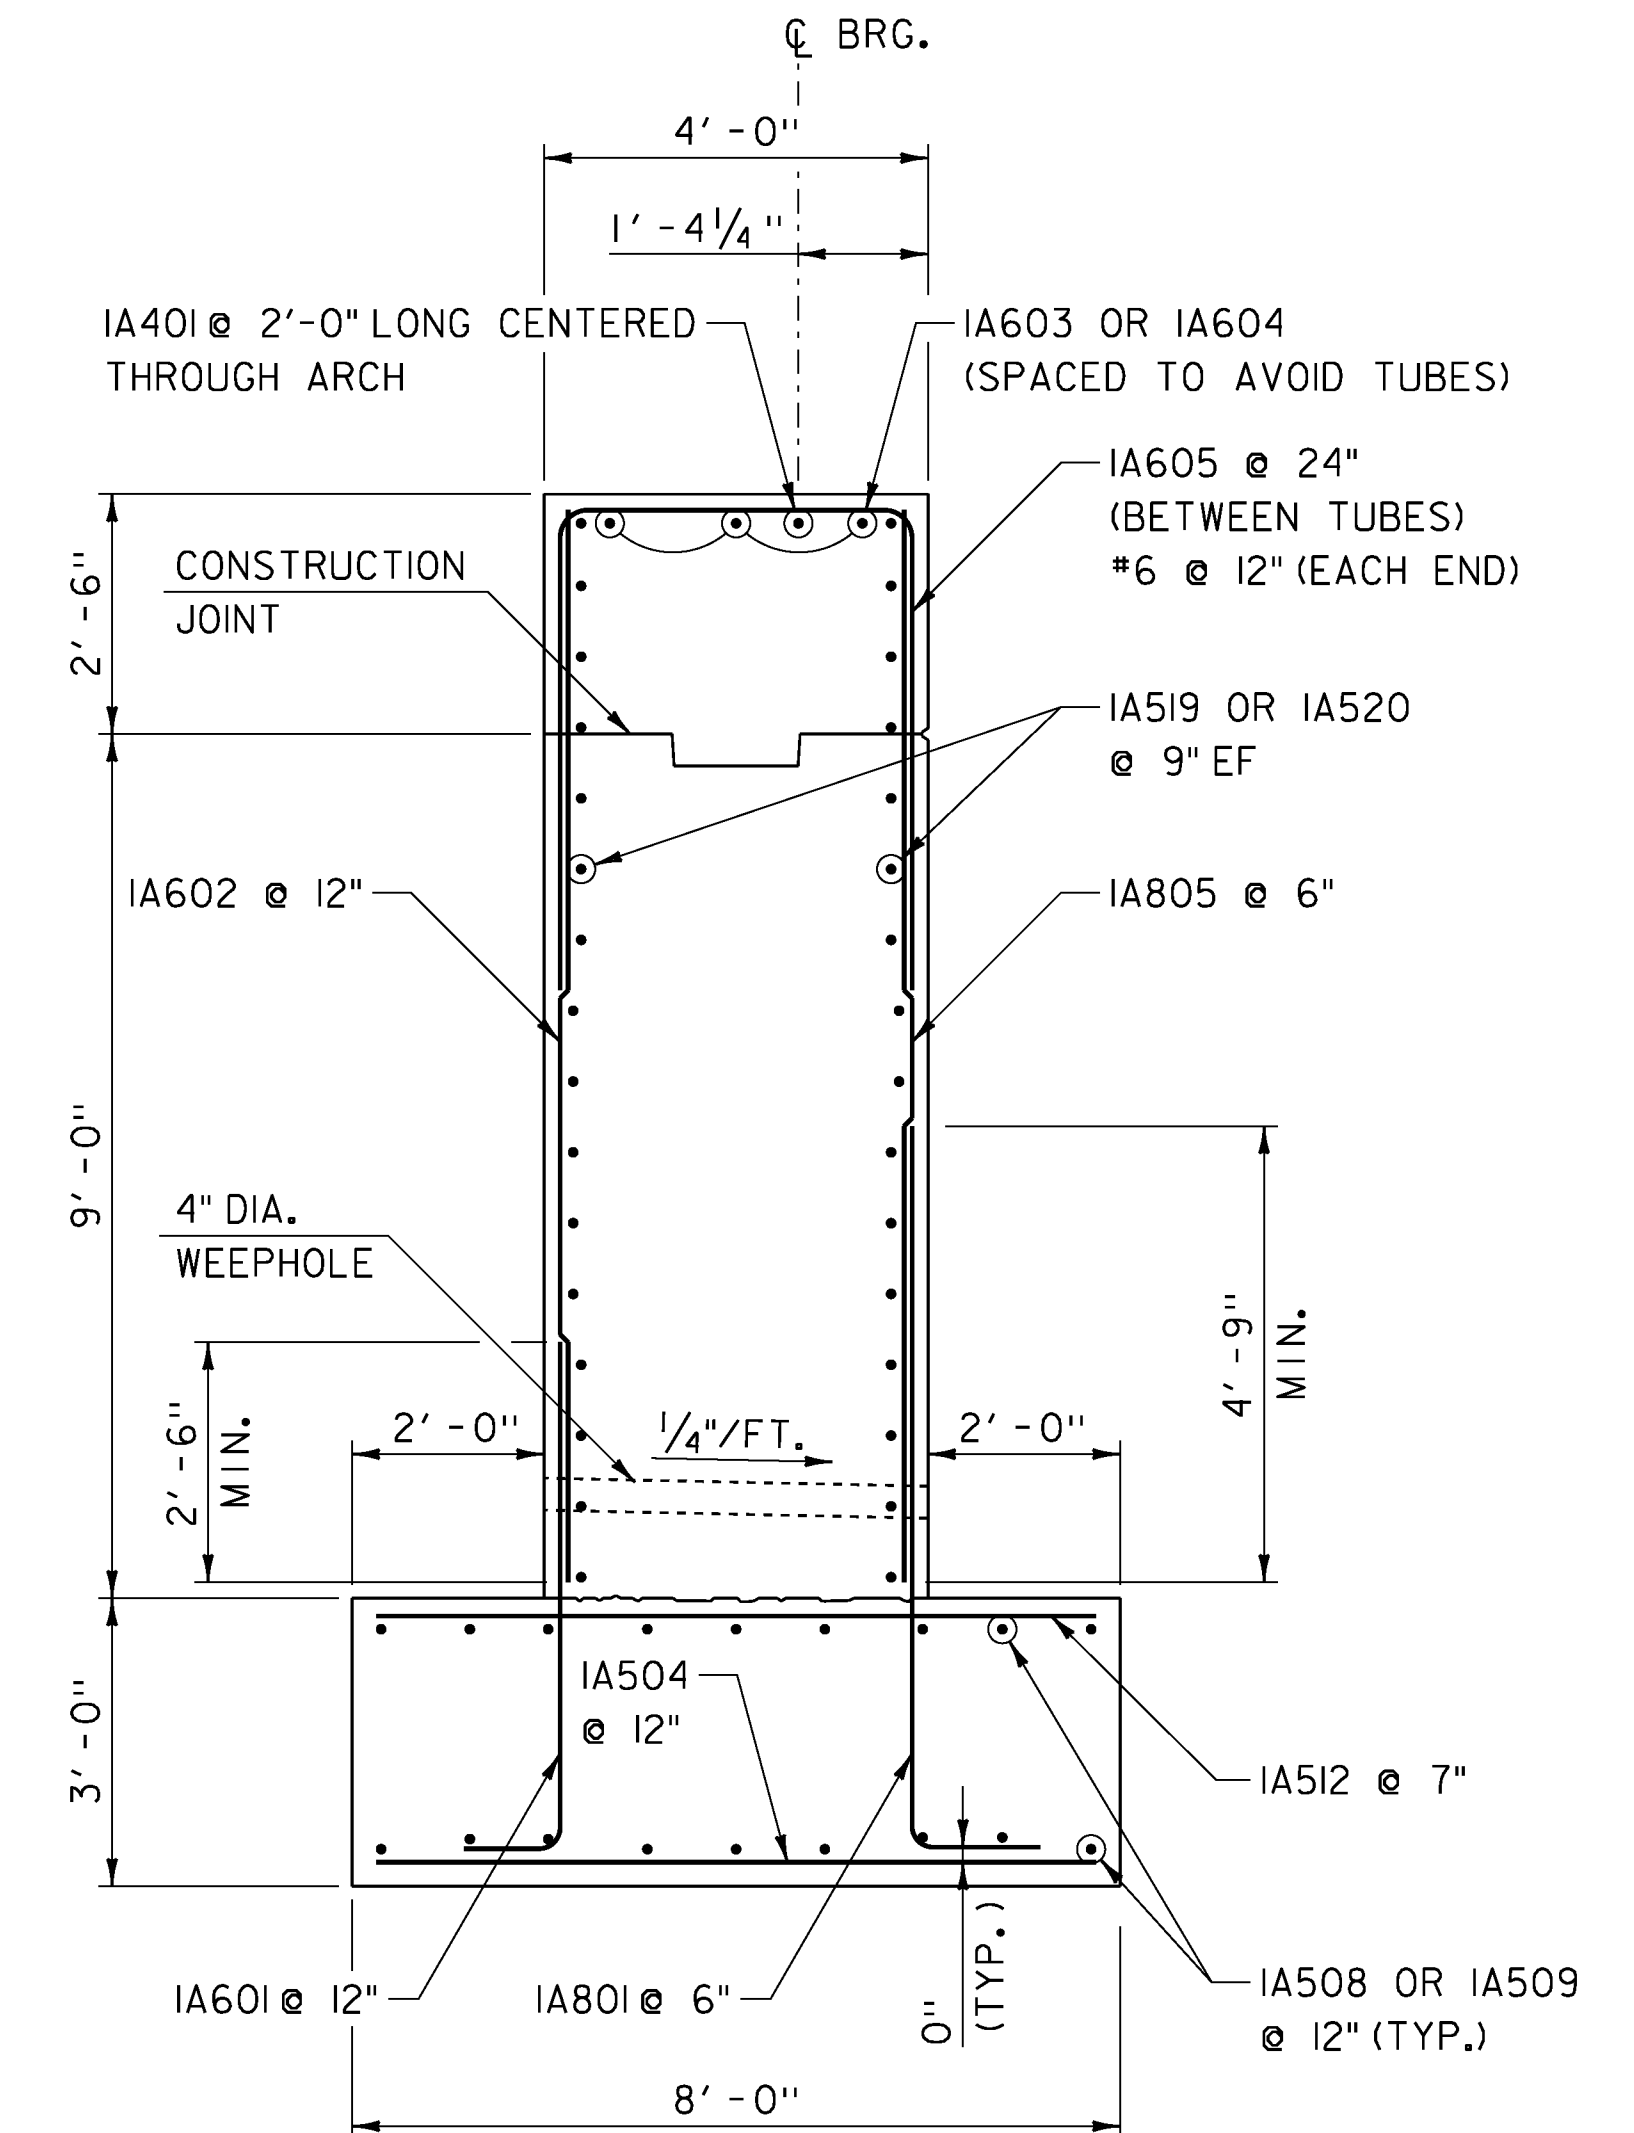

ABUTMENT NO. 1 TYPICAL SECTION

ABUTMENT NO. 2 SIMILAR
SCALE: 1/2" = 1'-0"

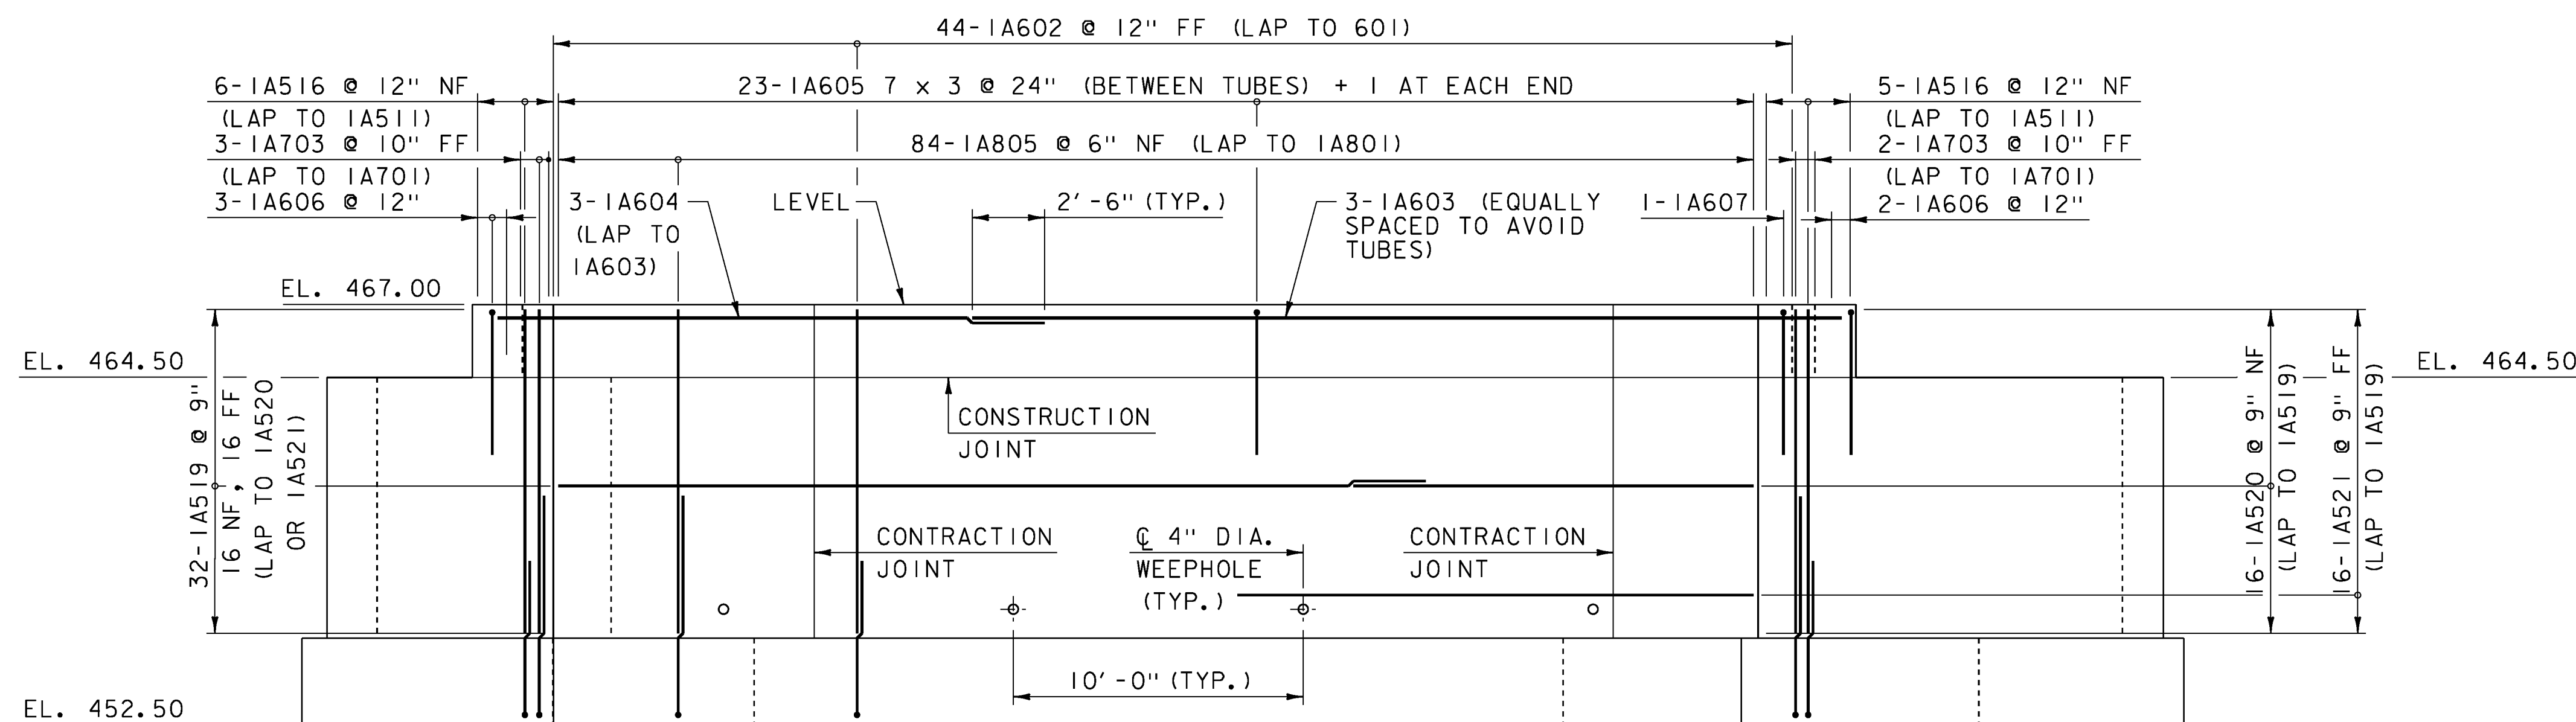

ABUTMENT NO. 1 ELEVATION

SCALE: 1/4" = 1'-0"

NOTE:

- NF = NEAR FACE
- FF = FAR FACE
- EF = EACH FACE
- ▲ = CUT TO FIT IN FIELD
- 3" CLEAR, UNLESS OTHERWISE SPECIFIED ON THE PLANS.
- 2'-2" BAR LAP UNLESS OTHERWISE SPECIFIED ON THE PLANS.

NOTES


1. FOR TYPICAL WINGWALL SECTION, SEE SHEET 30.

PROJECT NAME: FAIRFIELD
PROJECT NUMBER: BRO 1448(38)


FILE NAME: z11j072sub1.dgn
PROJECT LEADER: D. LANDRY
DESIGNED BY: T. TRAVER
ABUTMENT NO. 1 DETAILS

PLOT DATE: 01-NOV-2013
DRAWN BY: P. DUSTIN
CHECKED BY: T. KENDRICK
SHEET 29 OF 41




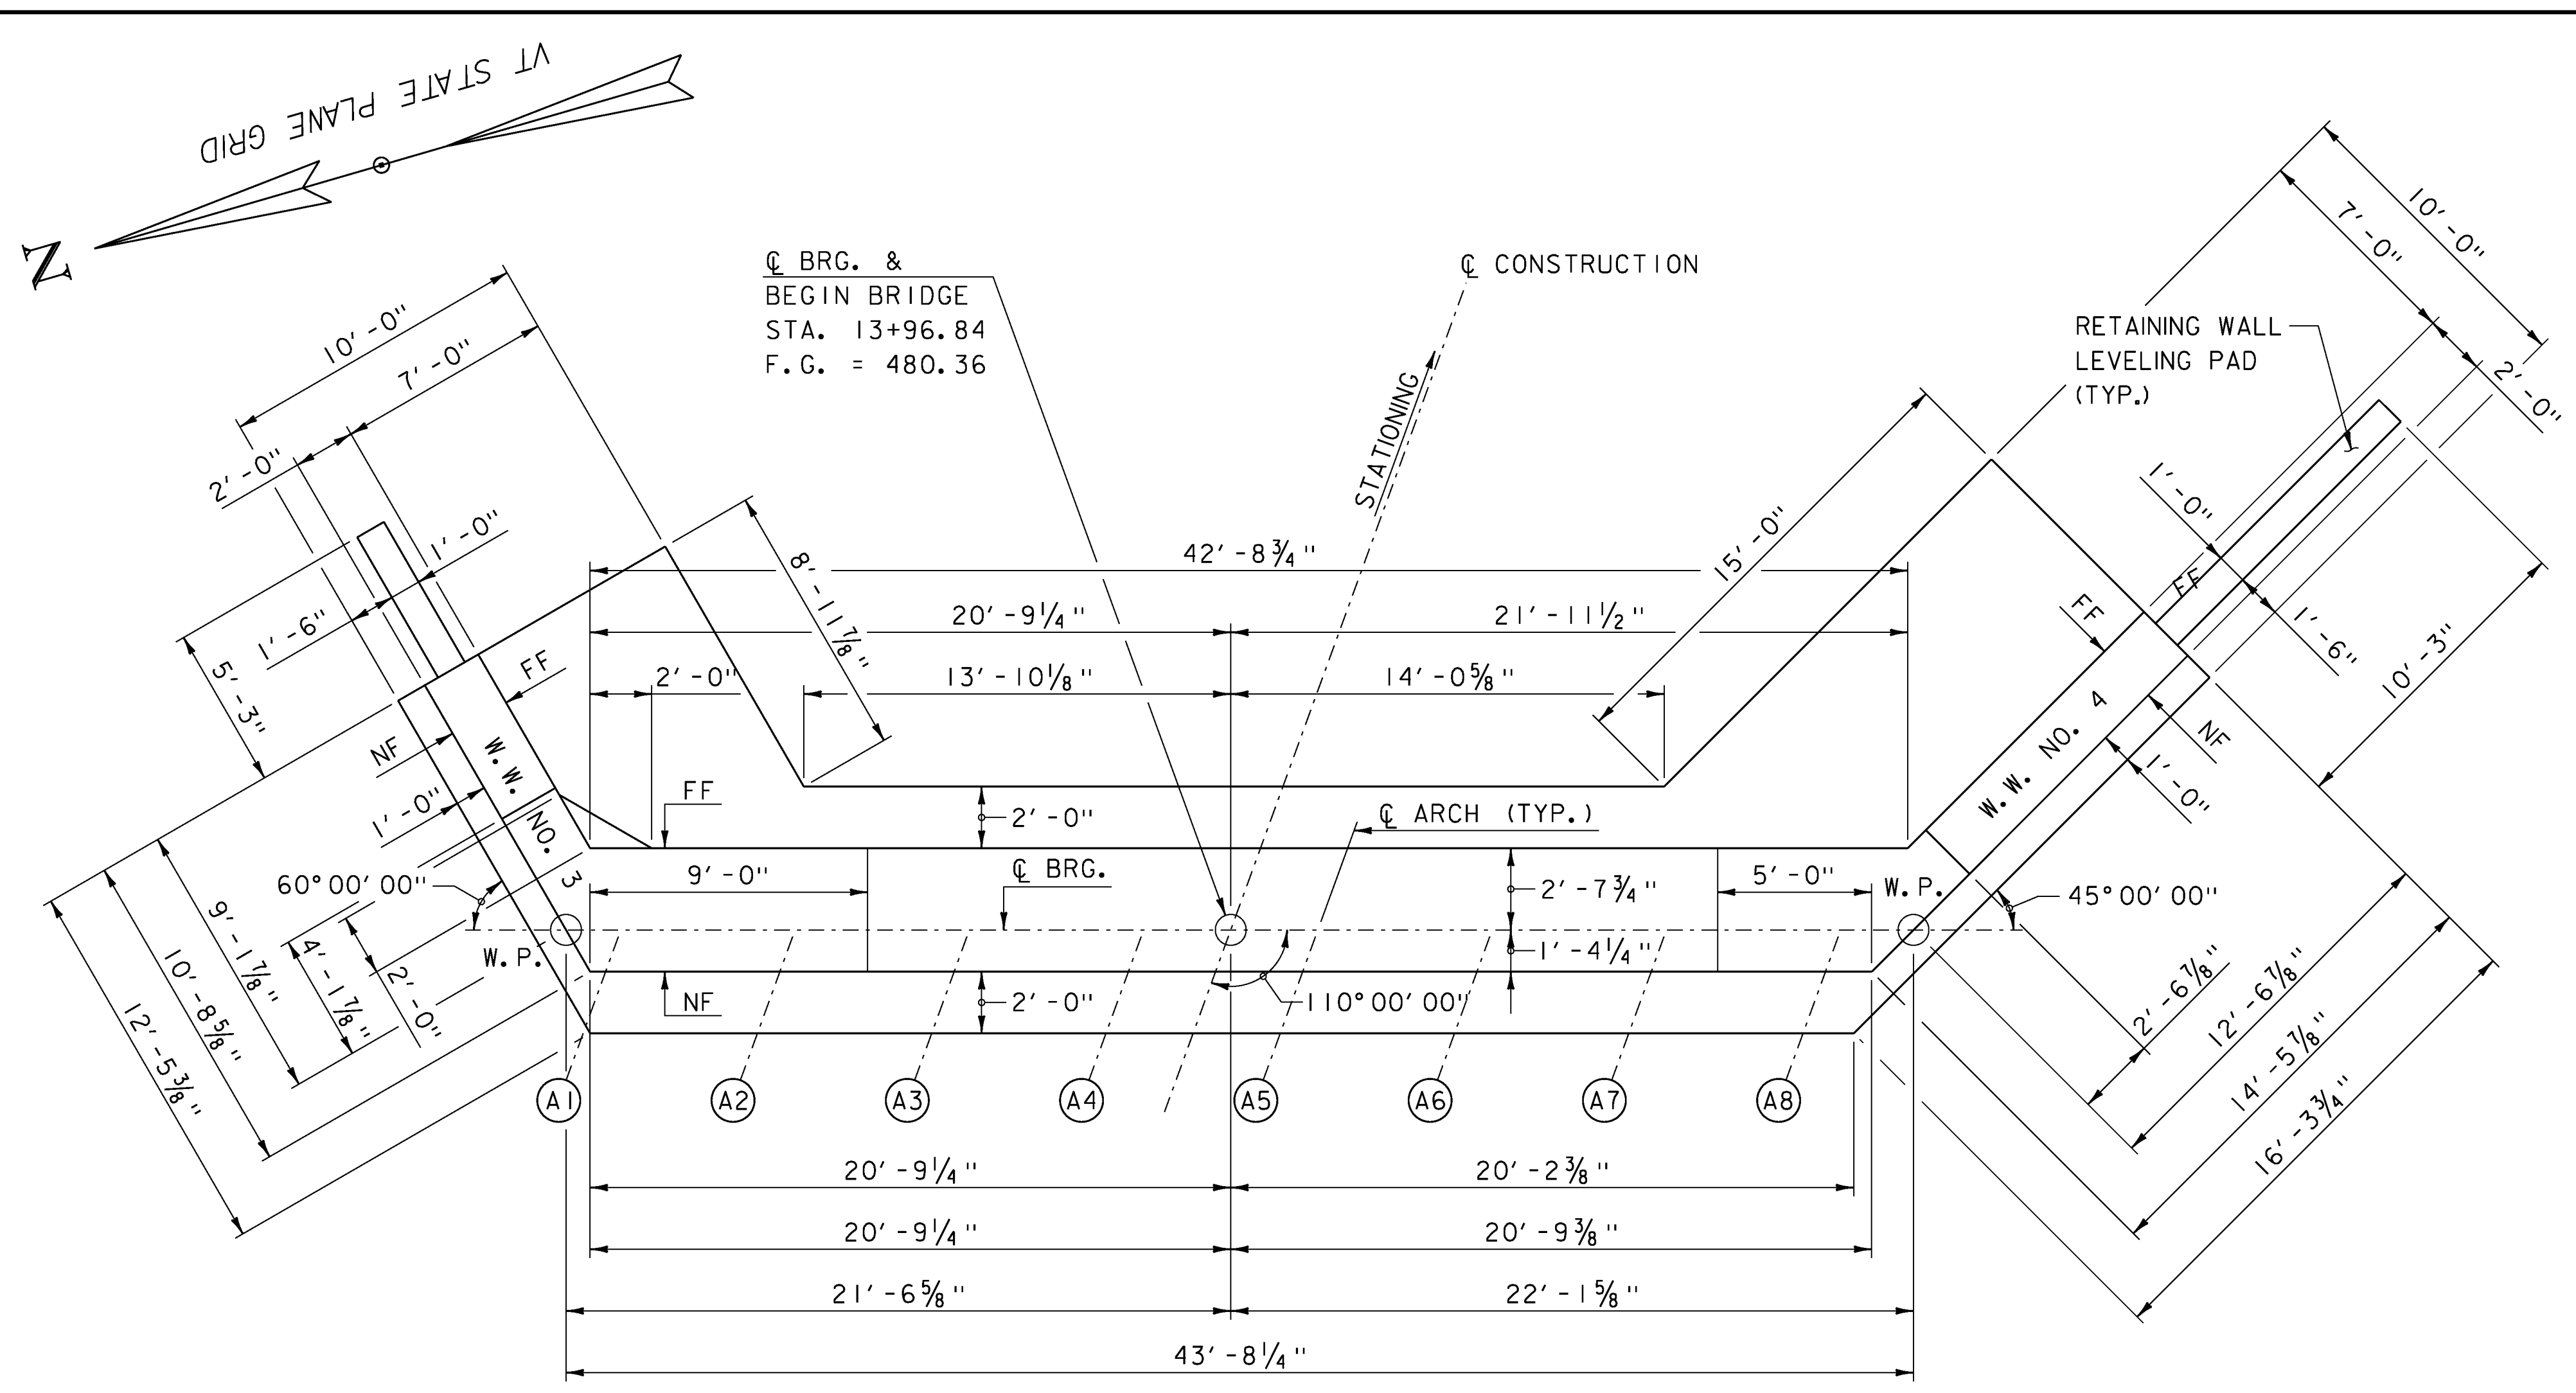

ABUTMENT NO. 2 PLAN
SCALE: 1/4" = 1'-0"

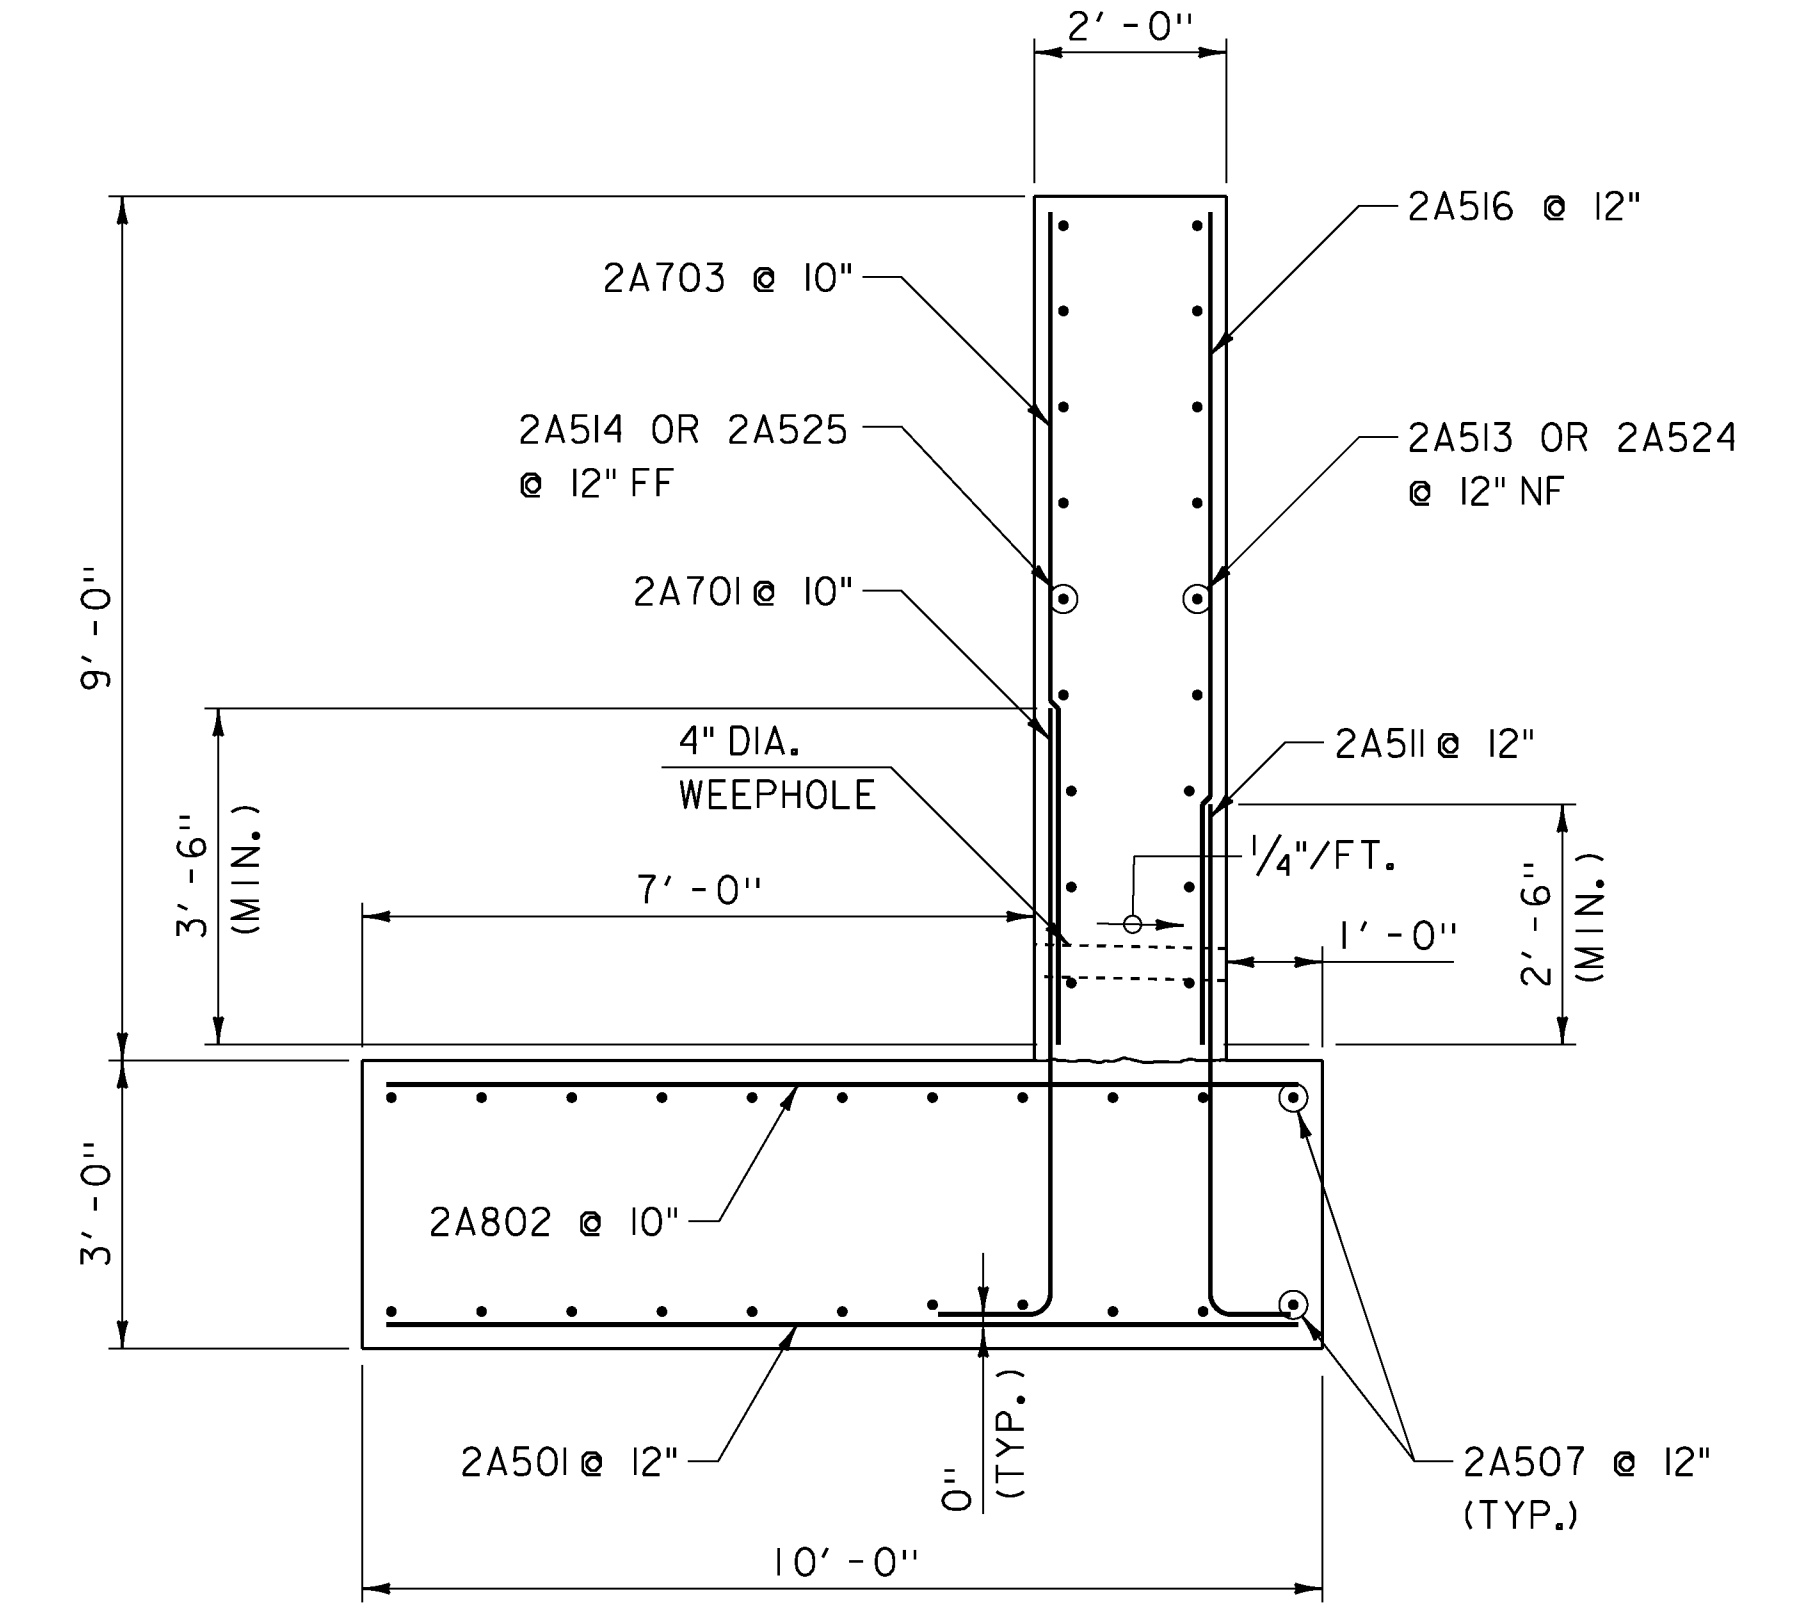

ABUTMENT NO. 2 WINGWALL TYPICAL SECTION
ABUTMENT NO. 1 WINGWALL TYPICAL SECTION SIMILAR

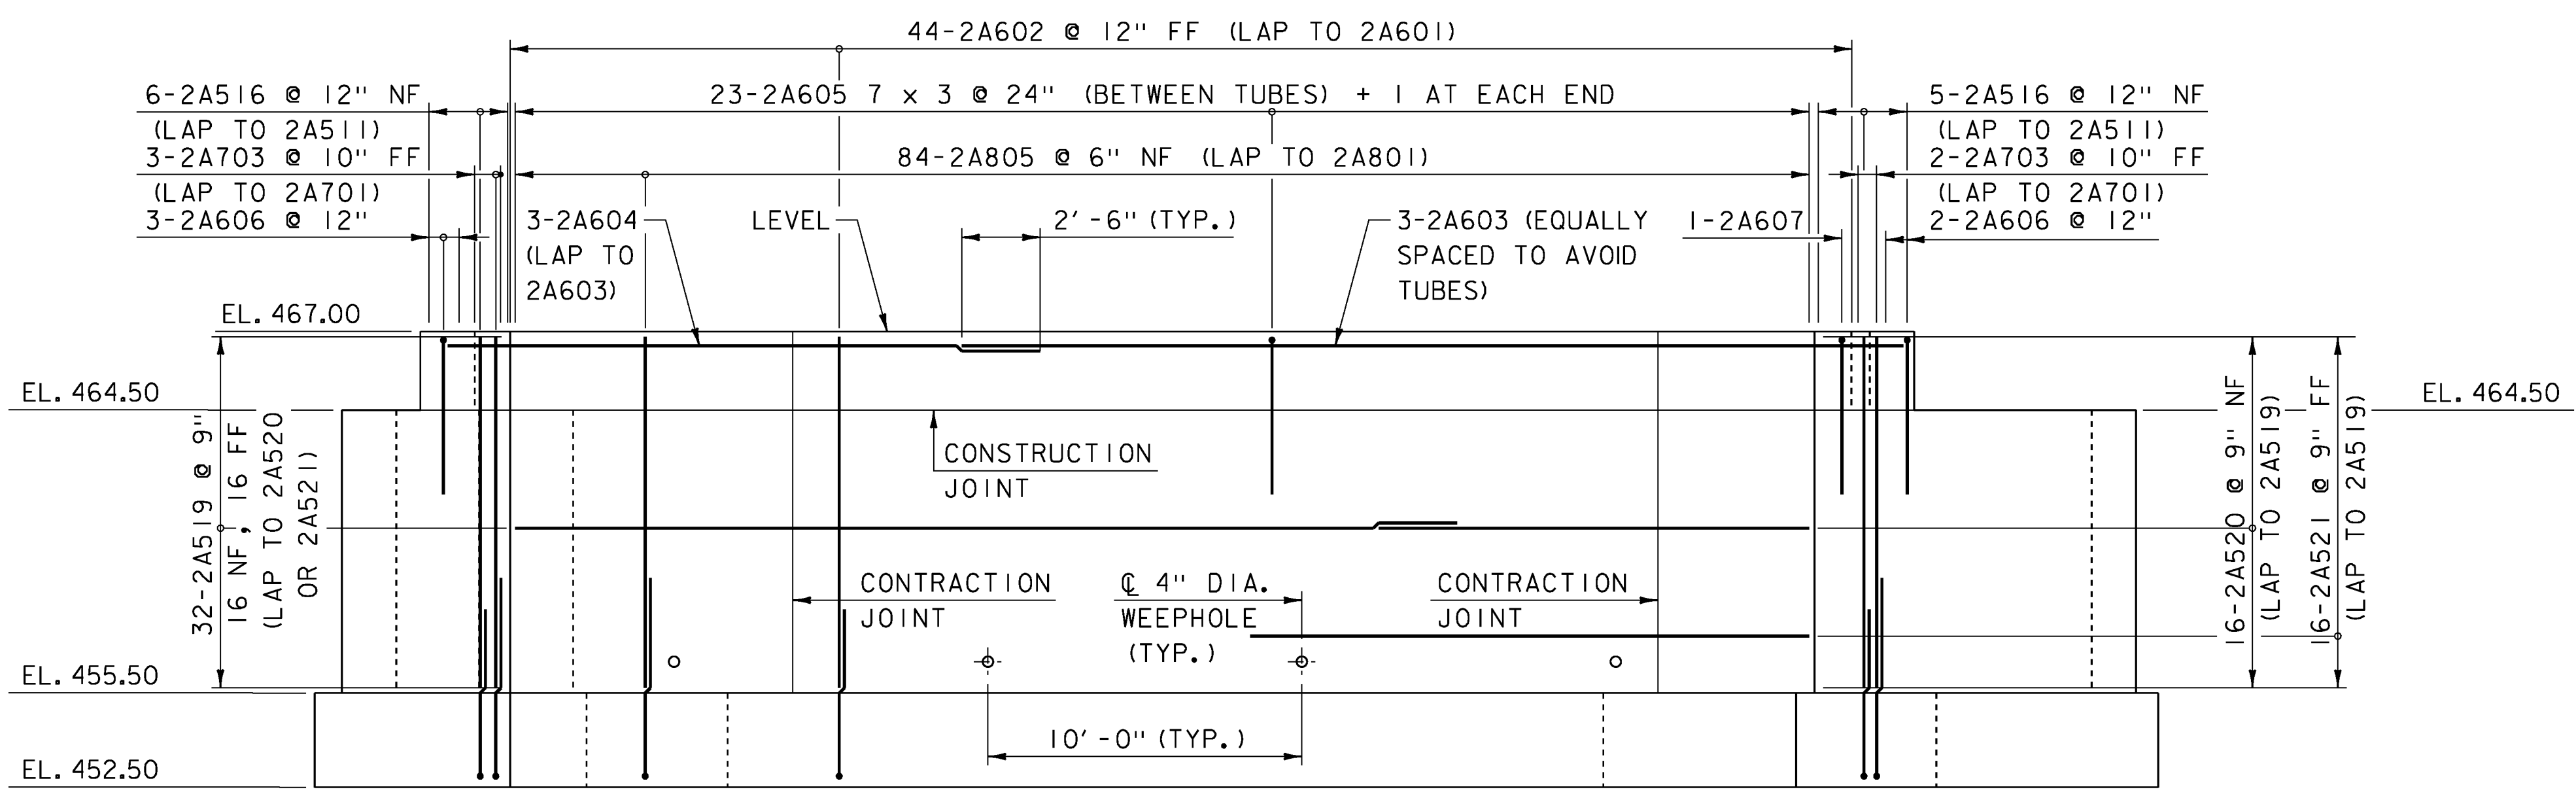


ABUTMENT NO. 2 ELEVATION
SCALE: 1/4" = 1'-0"

NOTE:
 NF = NEAR FACE
 FF = FAR FACE
 EF = EACH FACE
 ▲ = CUT TO FIT IN FIELD
 3" CLEAR, UNLESS OTHERWISE SPECIFIED ON THE PLANS.
 2'-2" BAR LAP UNLESS OTHERWISE SPECIFIED ON THE PLANS.


NOTES
 1. FOR TYPICAL ABUTMENT SECTION, SEE SHEET 29.

PROJECT NAME: FAIRFIELD	PLOT DATE: 01-NOV-2013
PROJECT NUMBER: BRO 1448(38)	DRAWN BY: P. DUSTIN
FILE NAME: z1j072sub2.dgn	CHECKED BY: T. KENDRICK
PROJECT LEADER: D. LANDRY	SHEET 30 OF 41
DESIGNED BY: T. TRAVER	
ABUTMENT NO. 2 DETAILS	




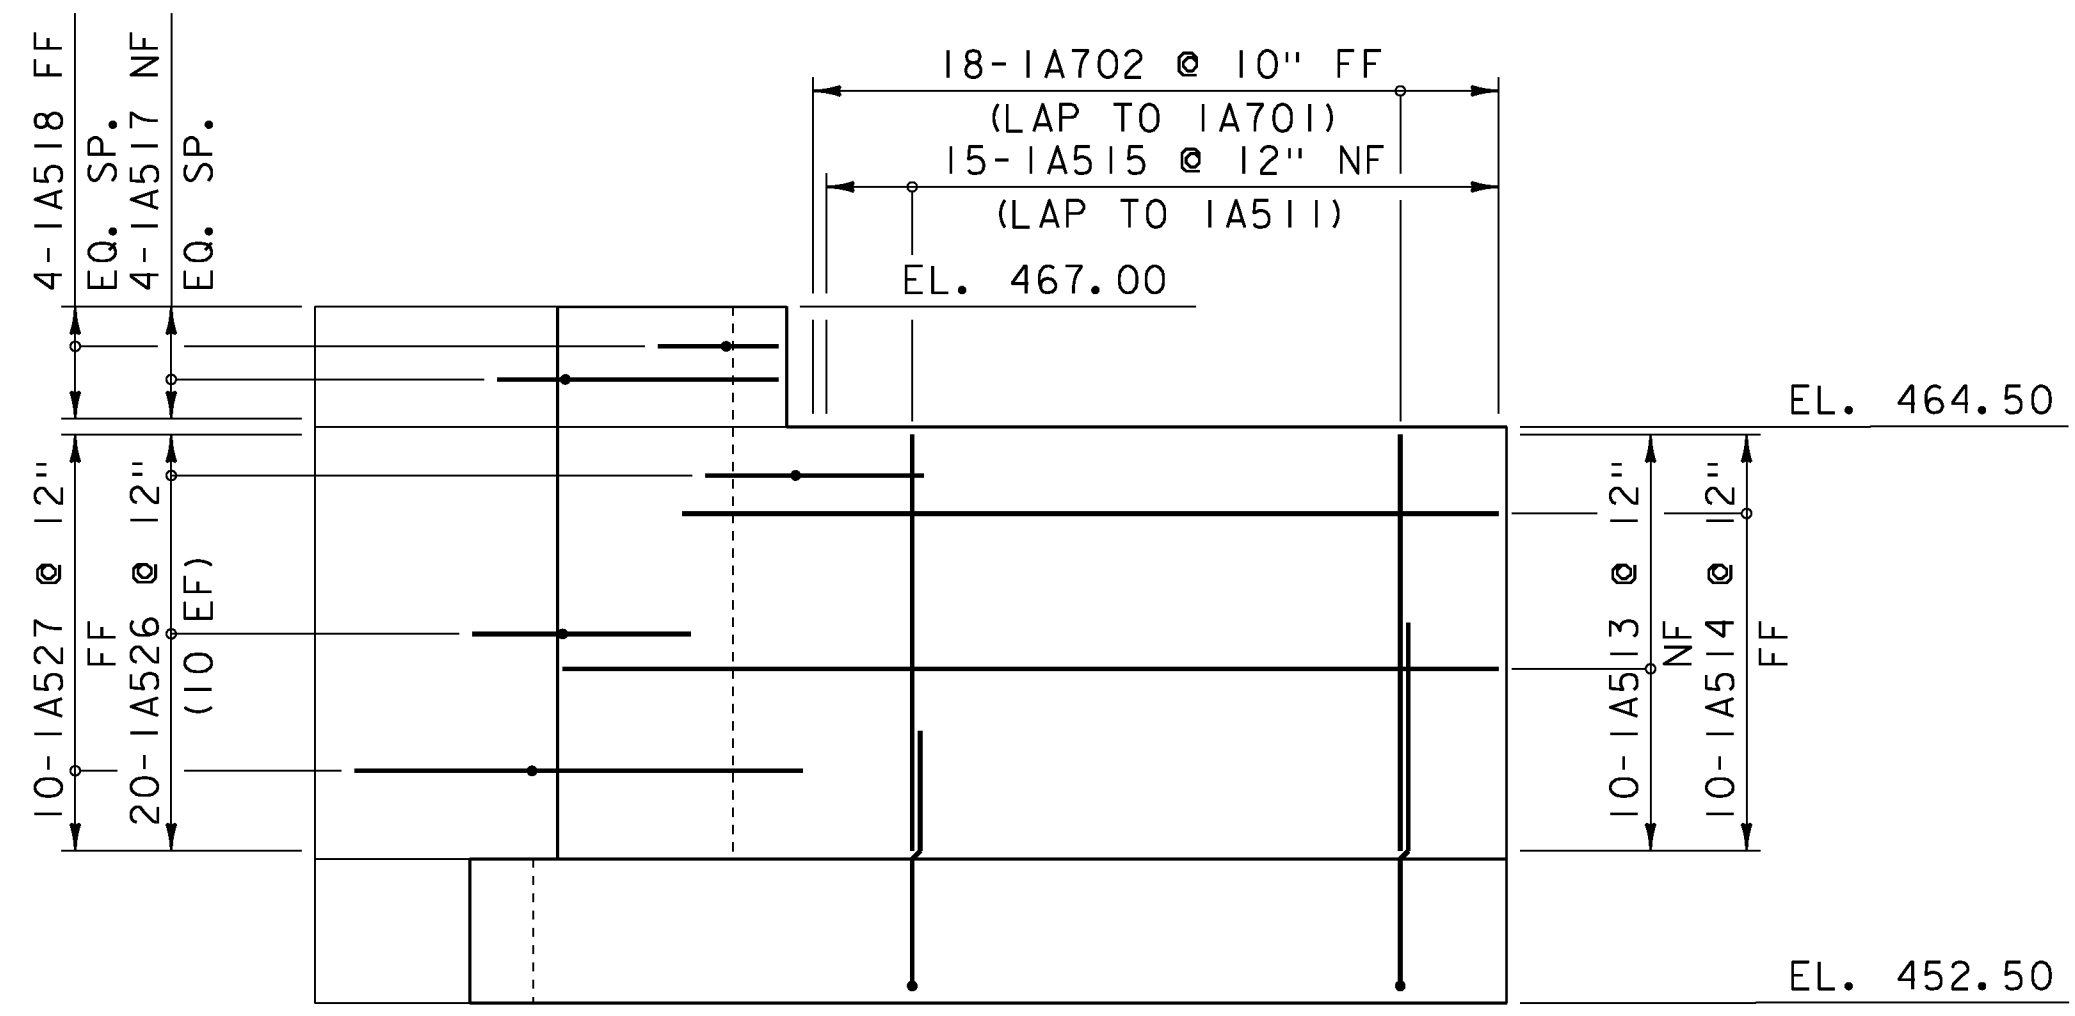


WINGWALL NO. 1 ELEVATION
SCALE: 1/4" = 1'-0"

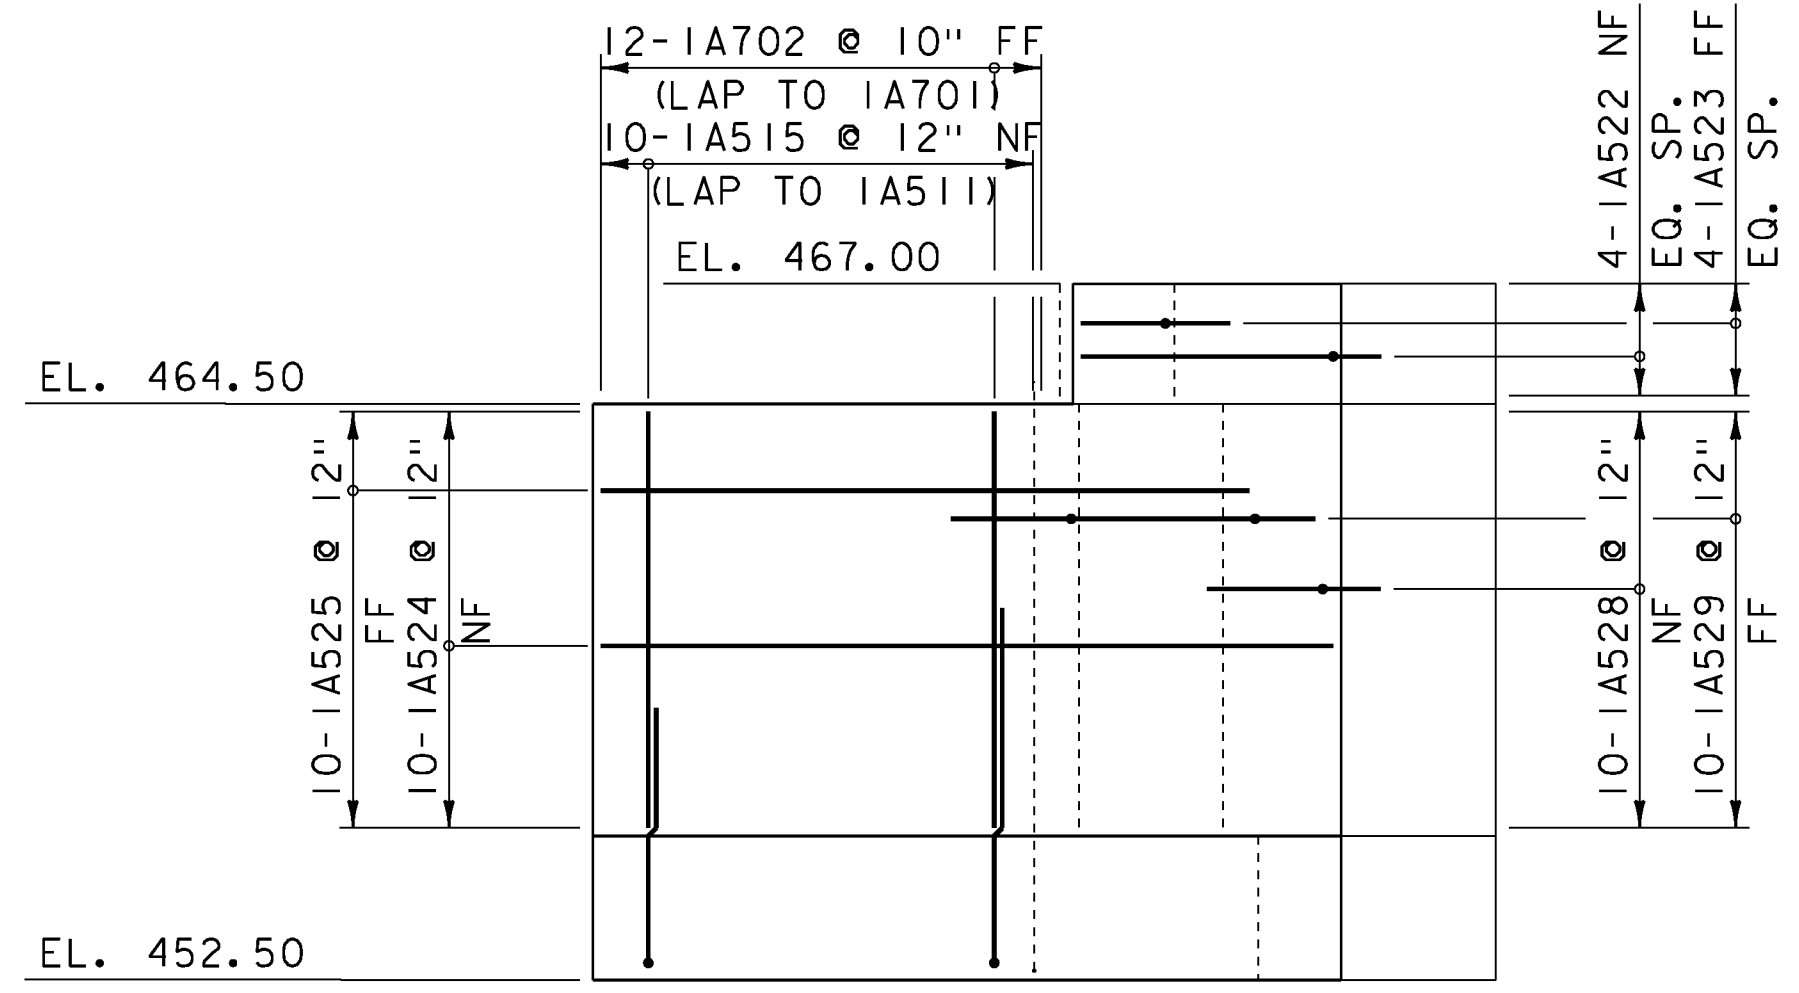


WINGWALL NO. 2 ELEVATION
SCALE: 1/4" = 1'-0"

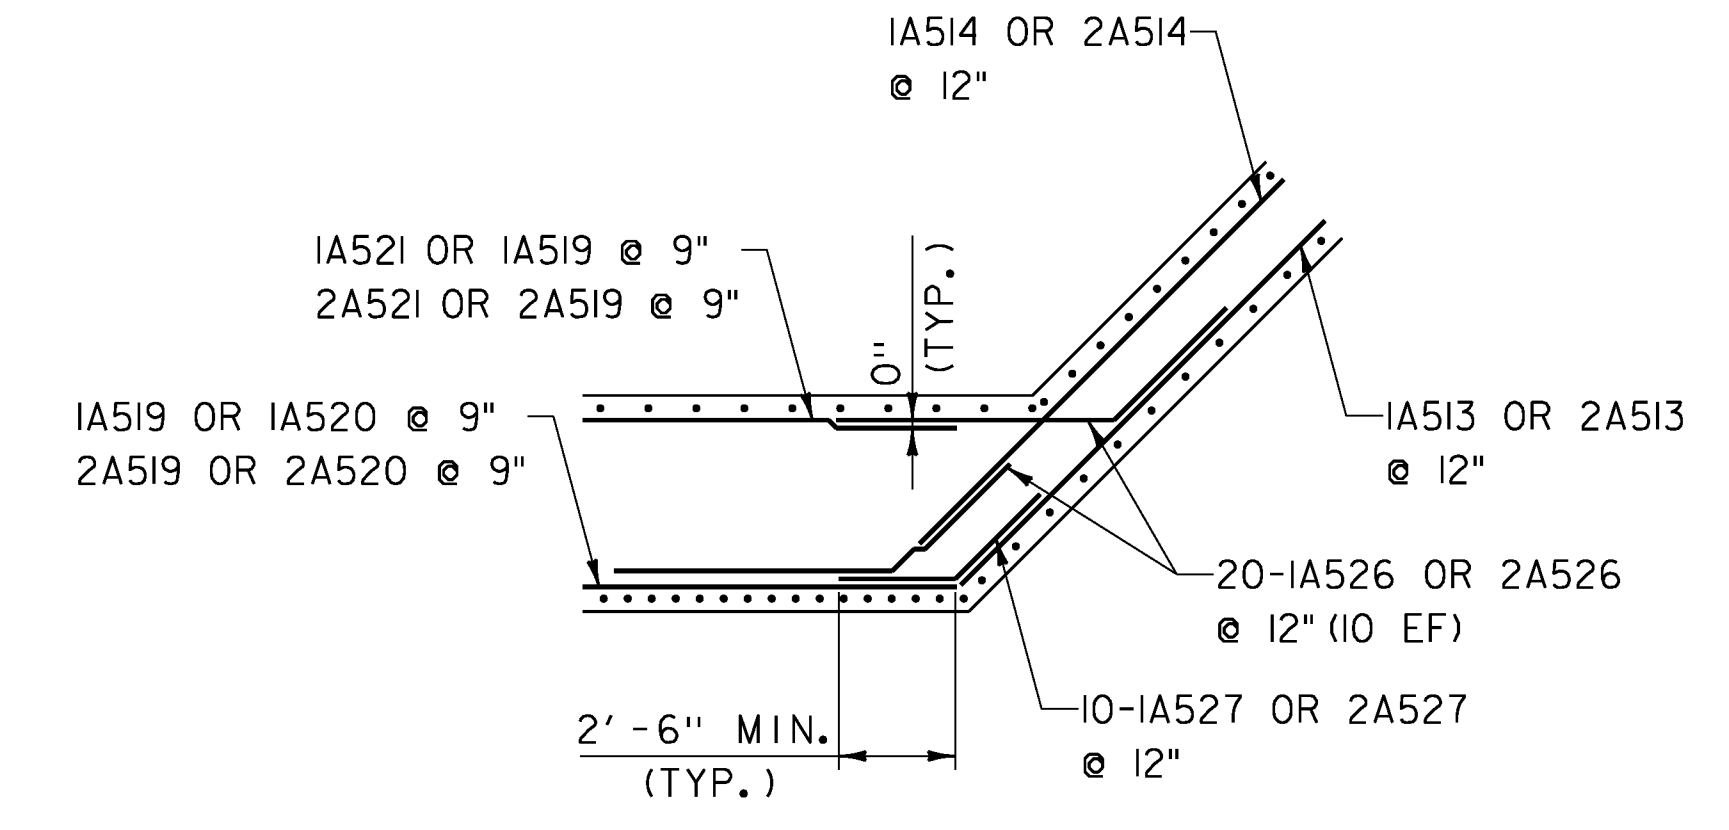


**WINGWALLS NO. 1 & NO. 4
CORNER DETAIL**
SCALE: 1/4" = 1'-0"

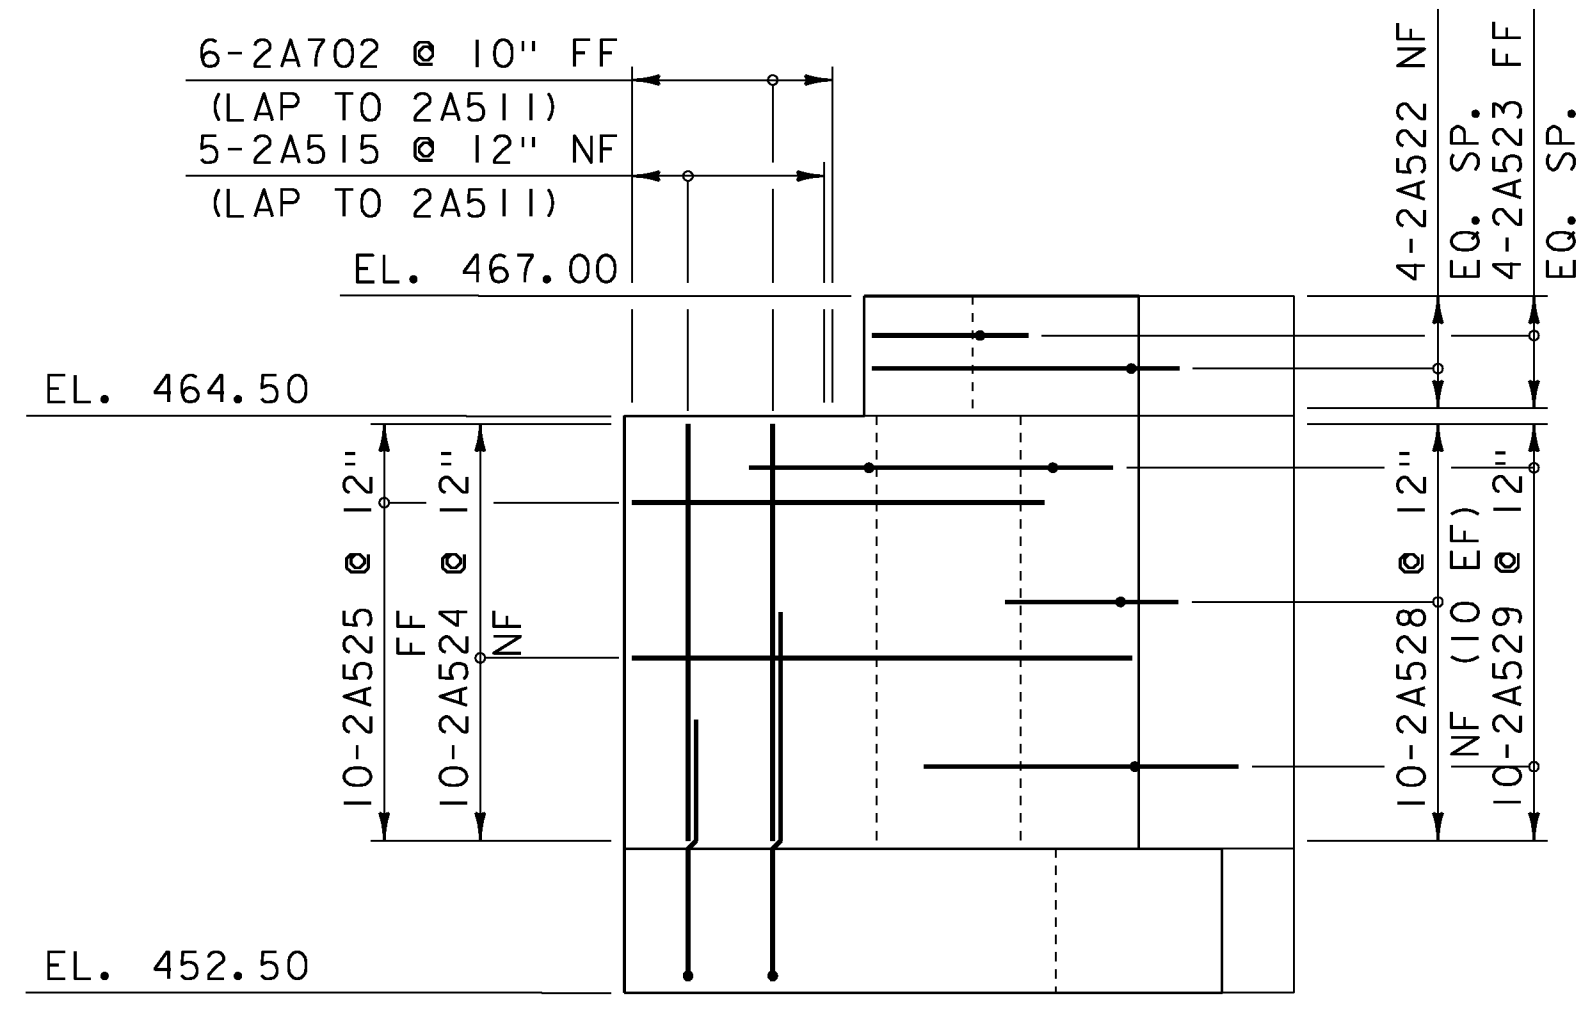

WINGWALL NO. 3 ELEVATION
SCALE: 1/4" = 1'-0"

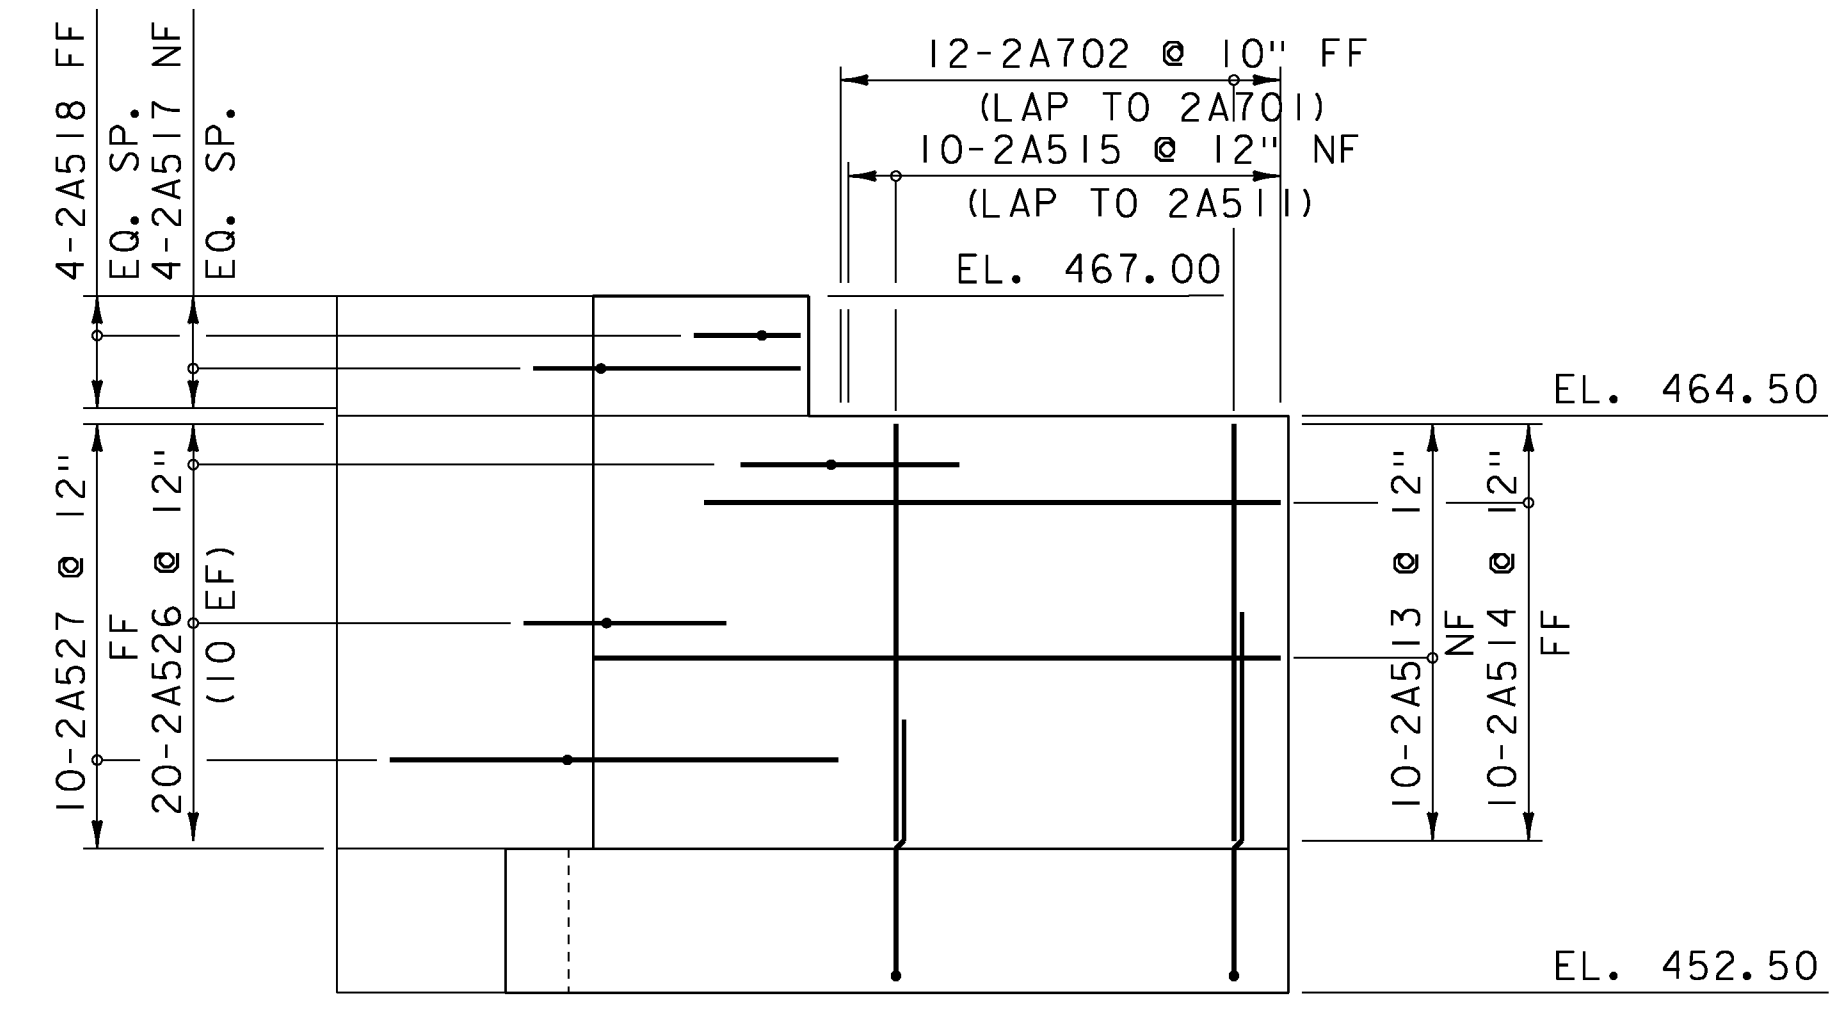

WINGWALL NO. 4 ELEVATION
SCALE: 1/4" = 1'-0"

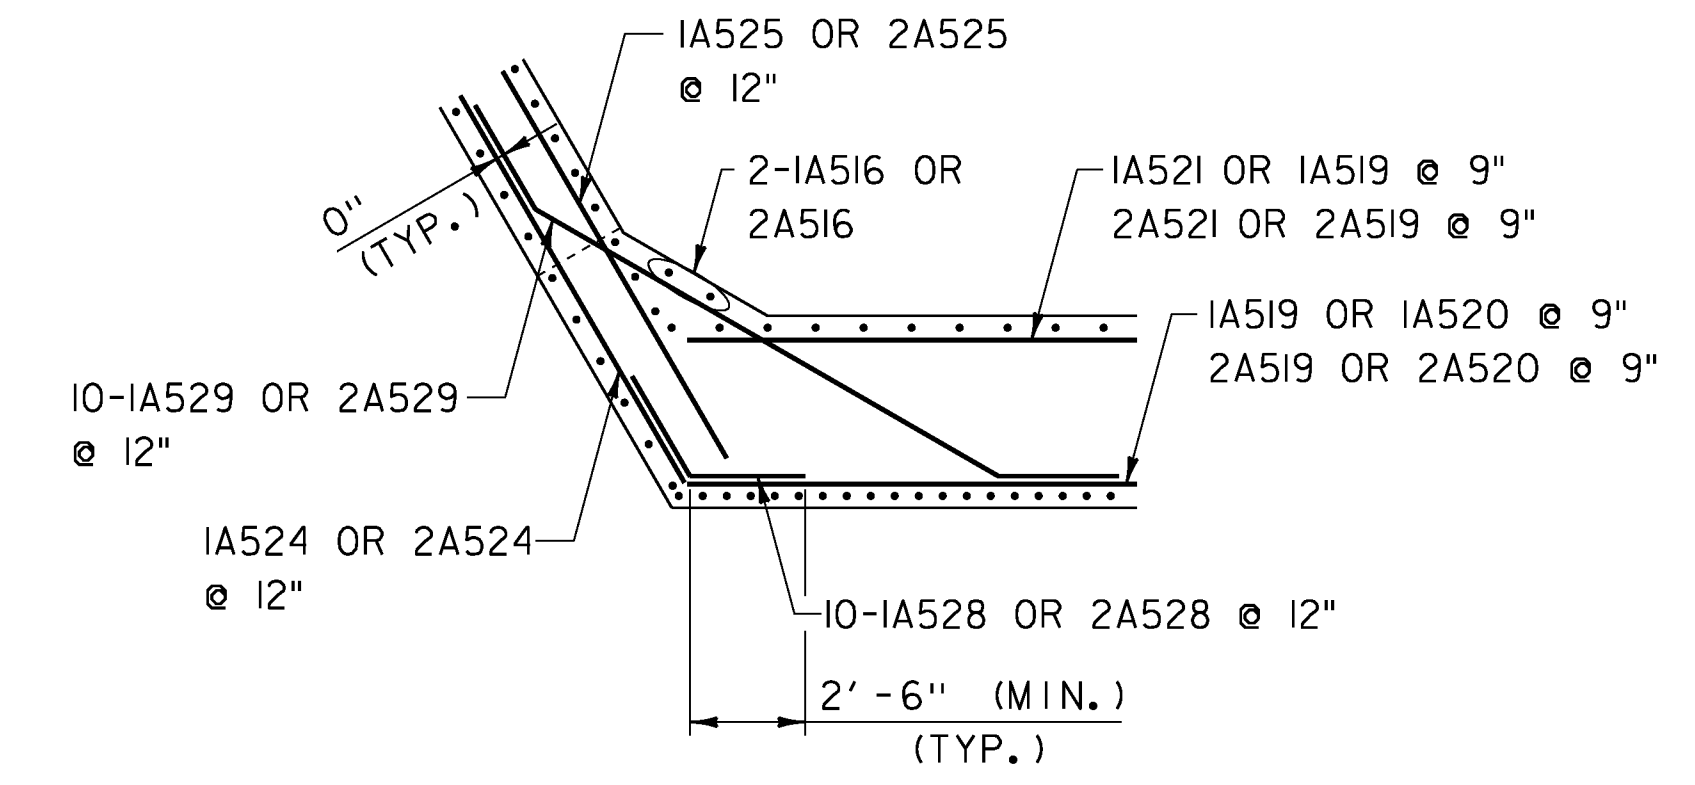


**WINGWALLS NO. 2 & NO. 3
CORNER DETAIL**
SCALE: 1/4" = 1'-0"

NOTE:
NF = NEAR FACE
FF = FAR FACE
EF = EACH FACE
▲ = CUT TO FIT IN FIELD
3" CLEAR, UNLESS OTHERWISE SPECIFIED ON THE PLANS.
2'-2" BAR LAP UNLESS OTHERWISE SPECIFIED ON THE PLANS.


PROJECT NAME:	FAIRFIELD
PROJECT NUMBER:	BRO 1448(38)
FILE NAME:	z11j072sub1.dgn
PROJECT LEADER:	D. LANDRY
DESIGNED BY:	T. TRAVER
WINGWALL DETAILS	
PLOT DATE:	01-NOV-2013
DRAWN BY:	P. DUSTIN
CHECKED BY:	T. KENDRICK
SHEET	31 OF 41



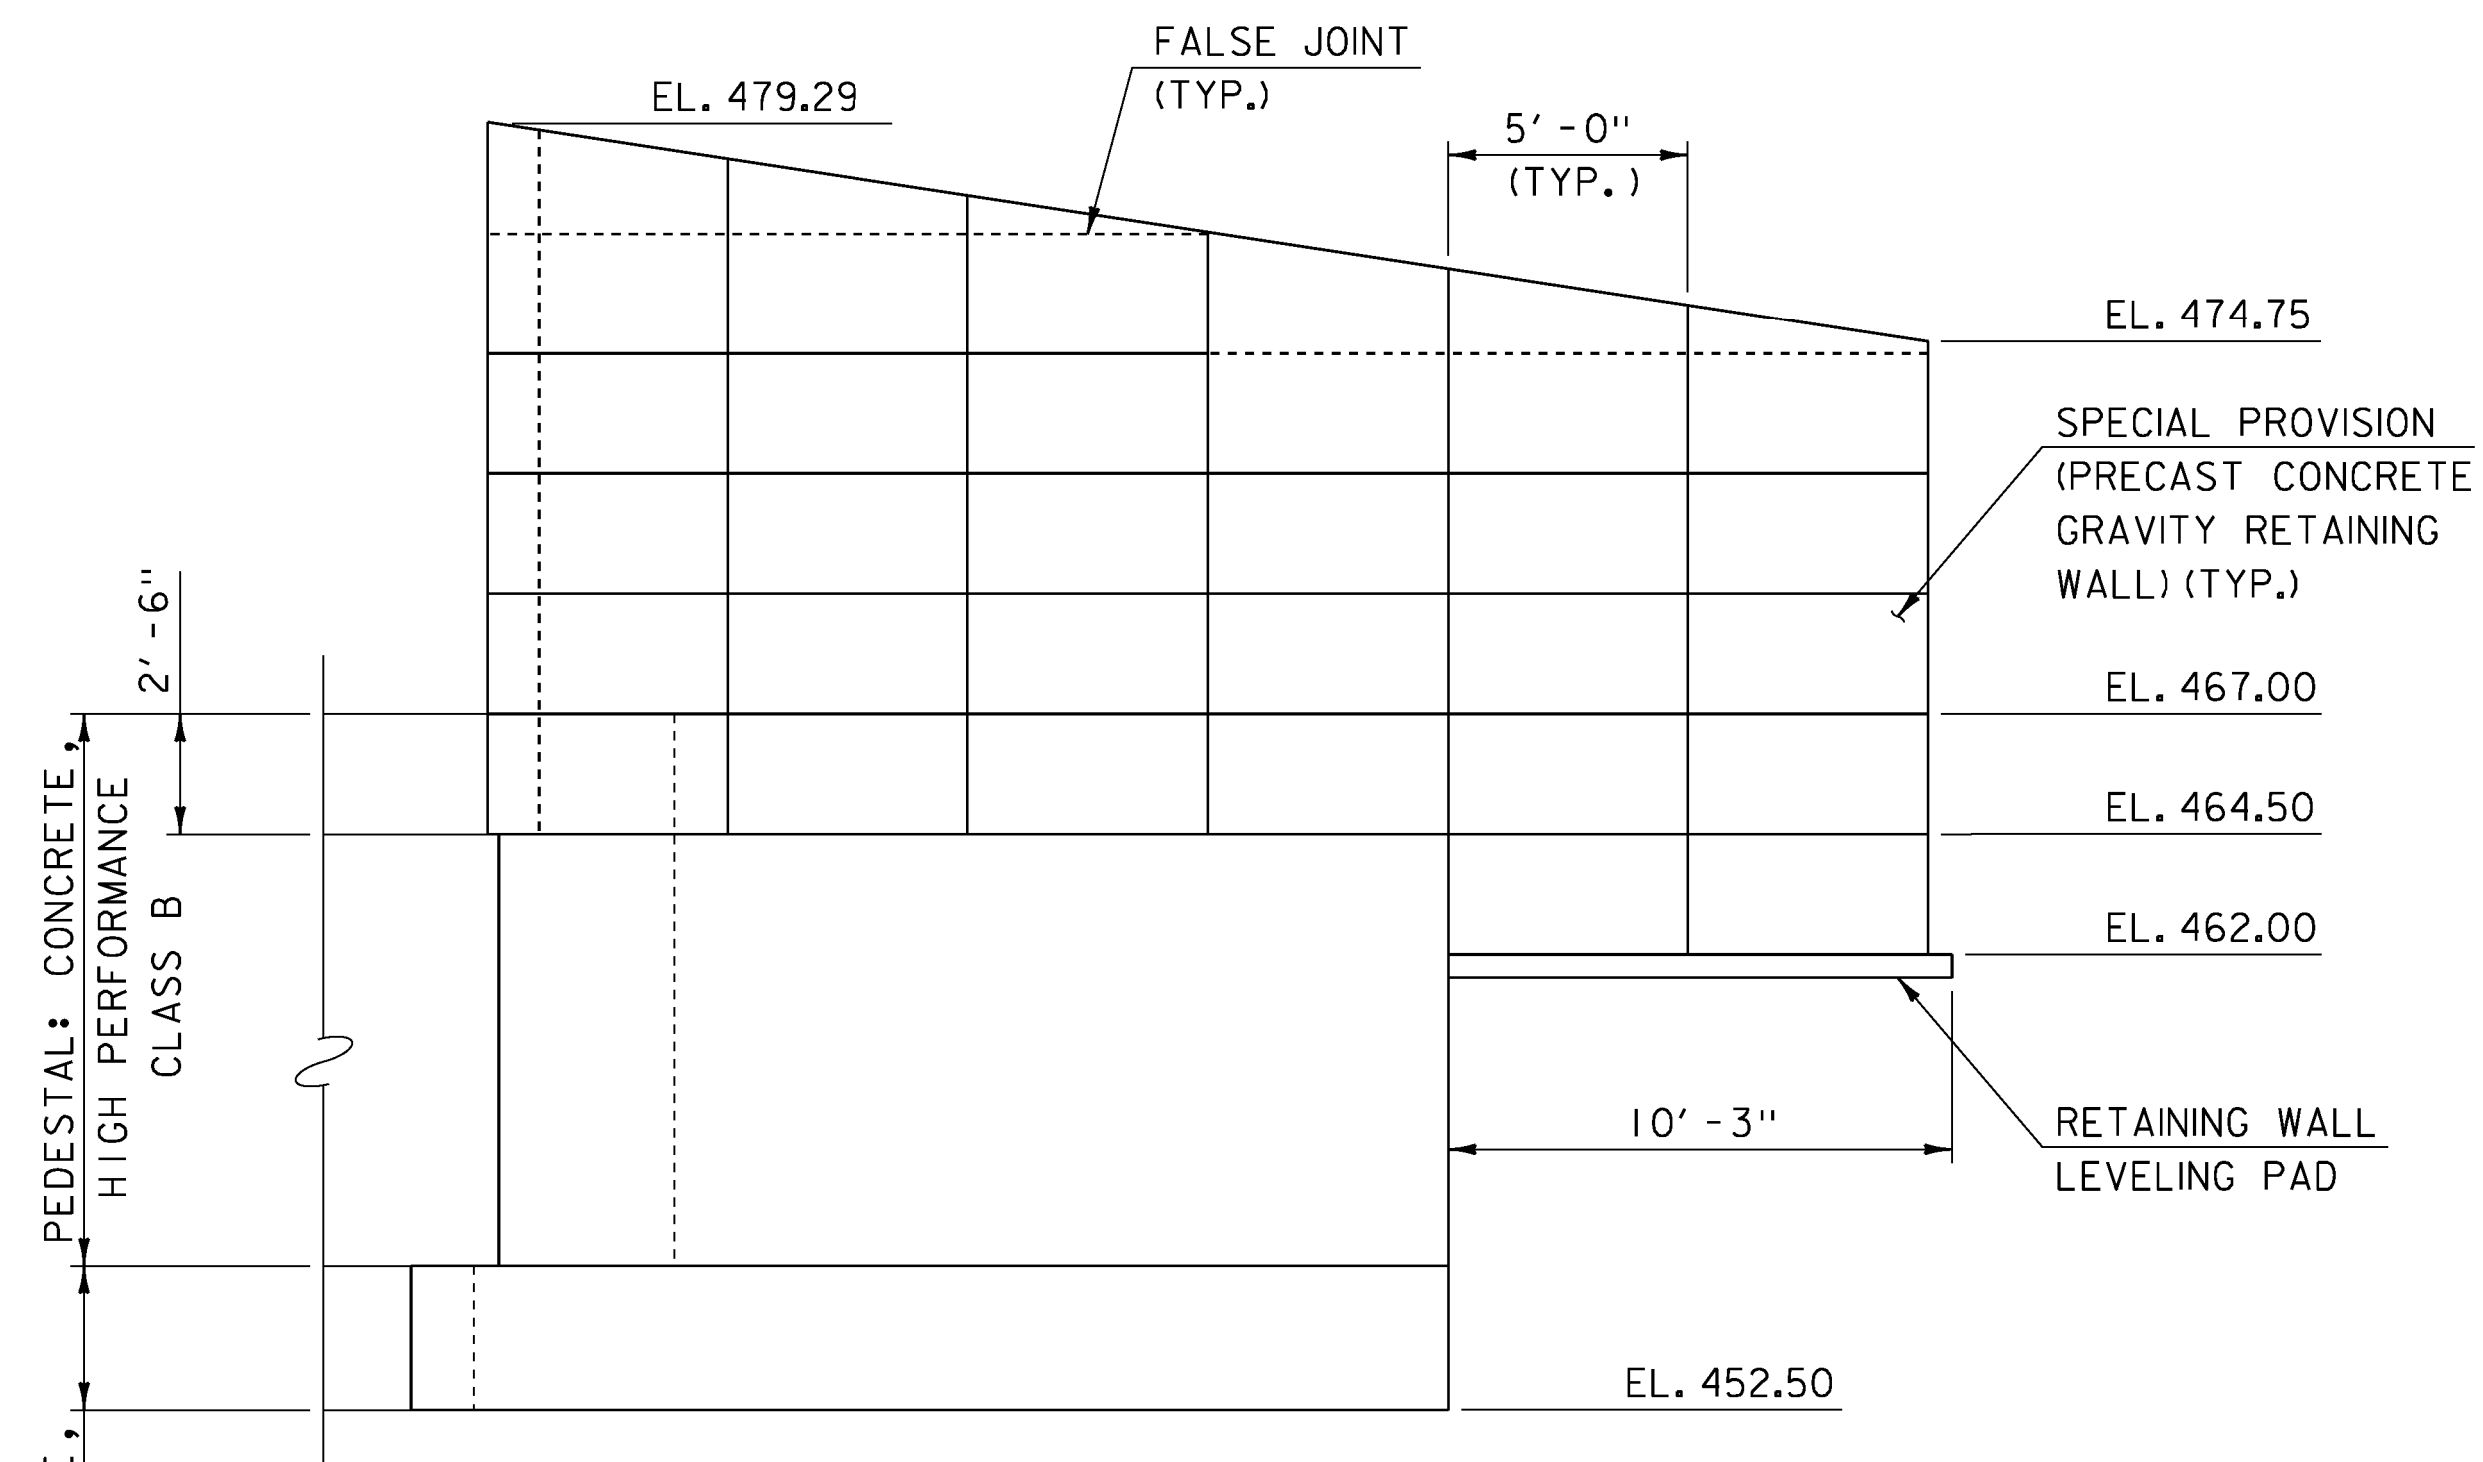


WINGWALL NO. 1 ELEVATION

SCALE: 1/4" = 1'-0"

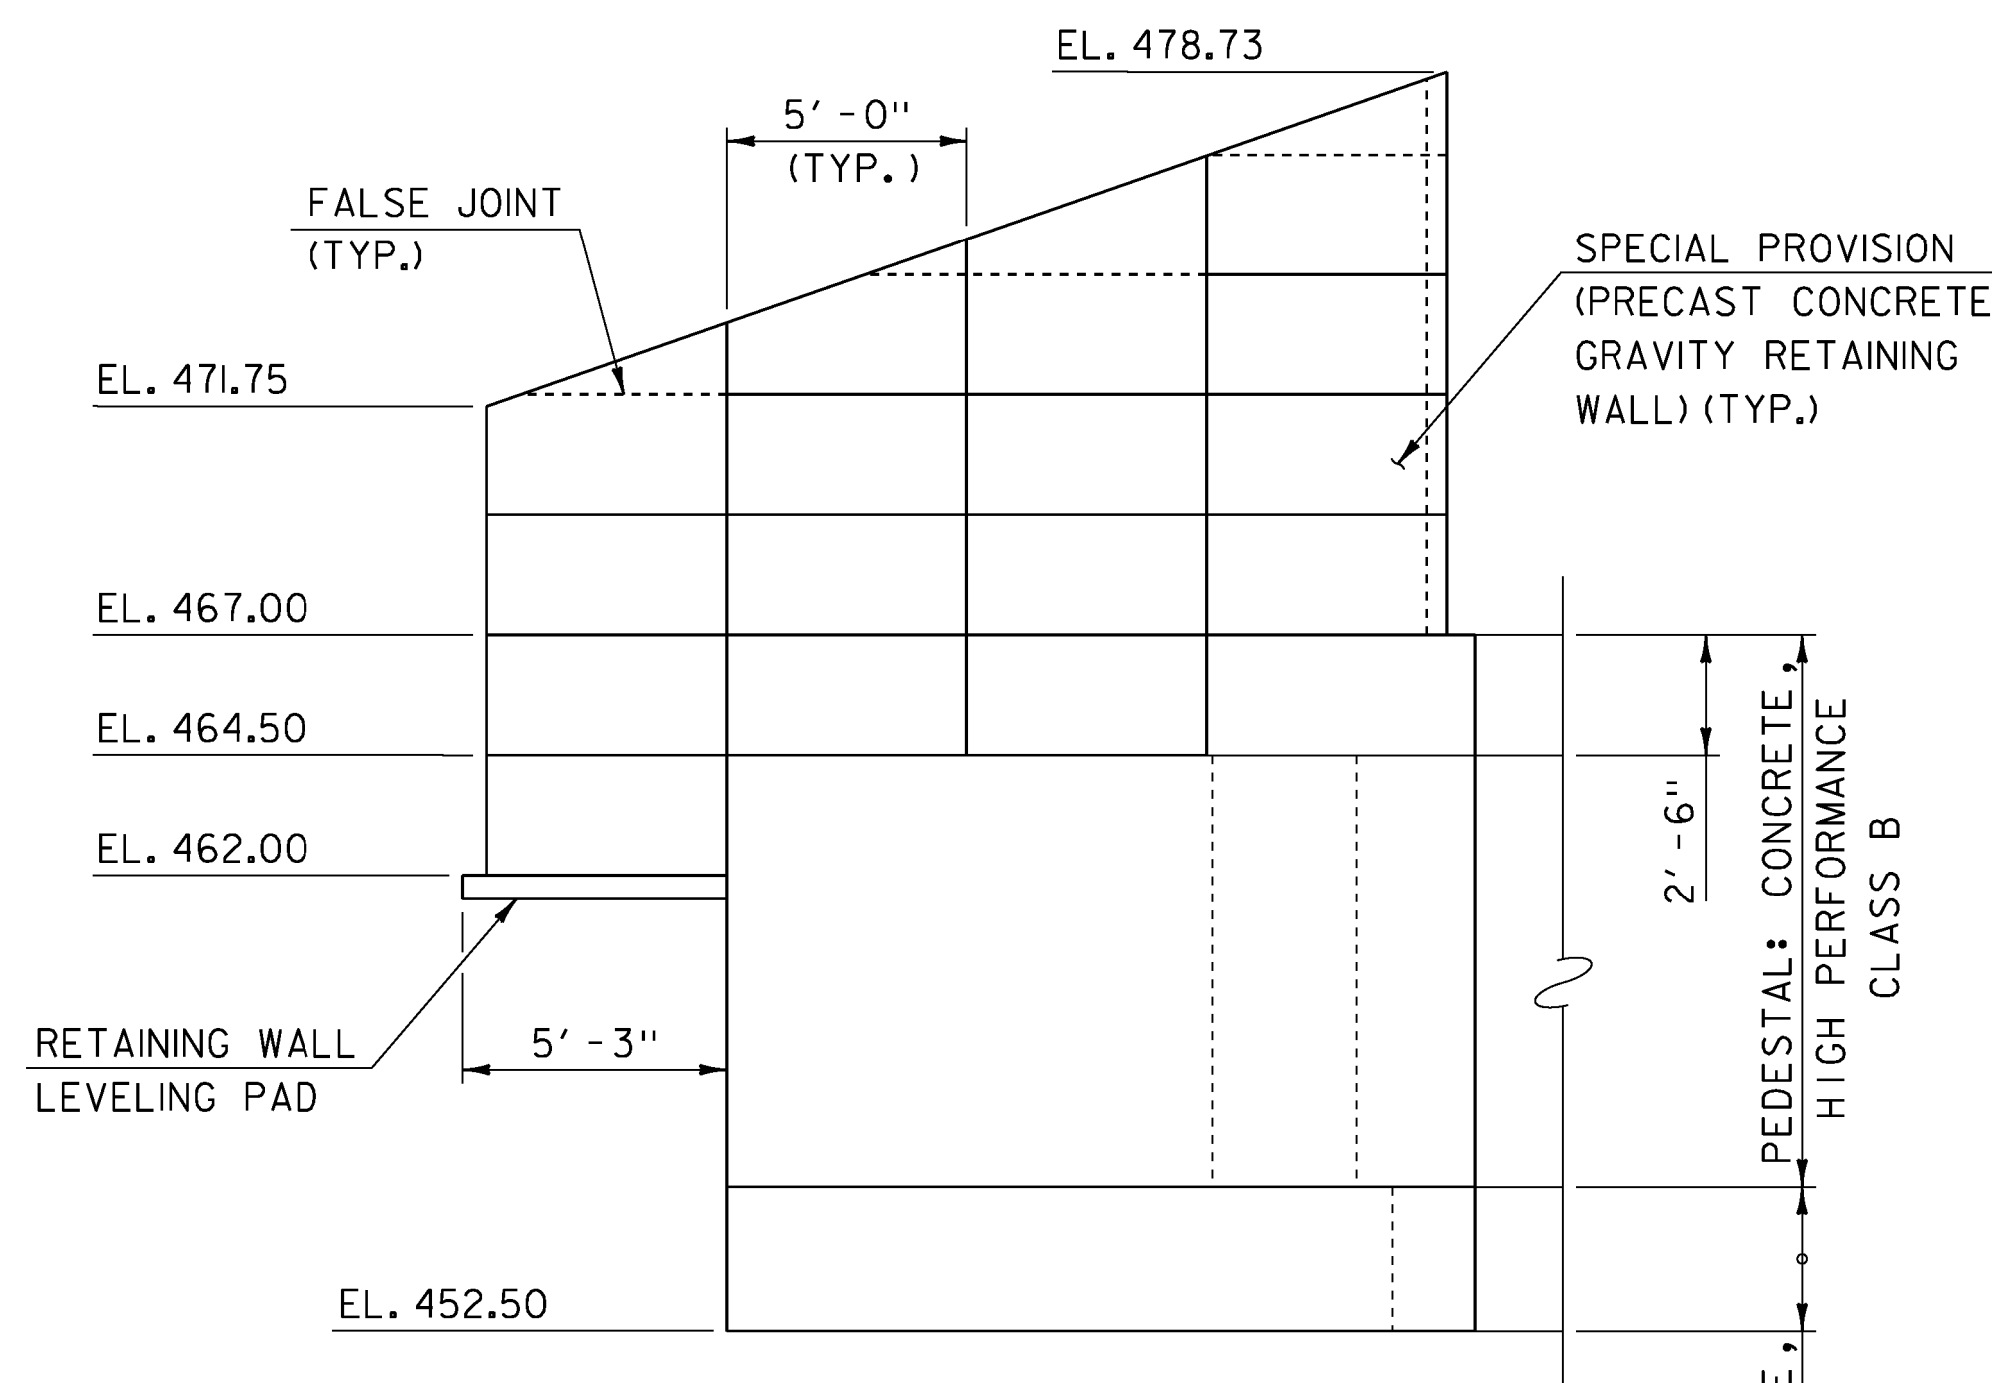


WINGWALL NO. 2 ELEVATION

SCALE: 1/4" = 1'-0"

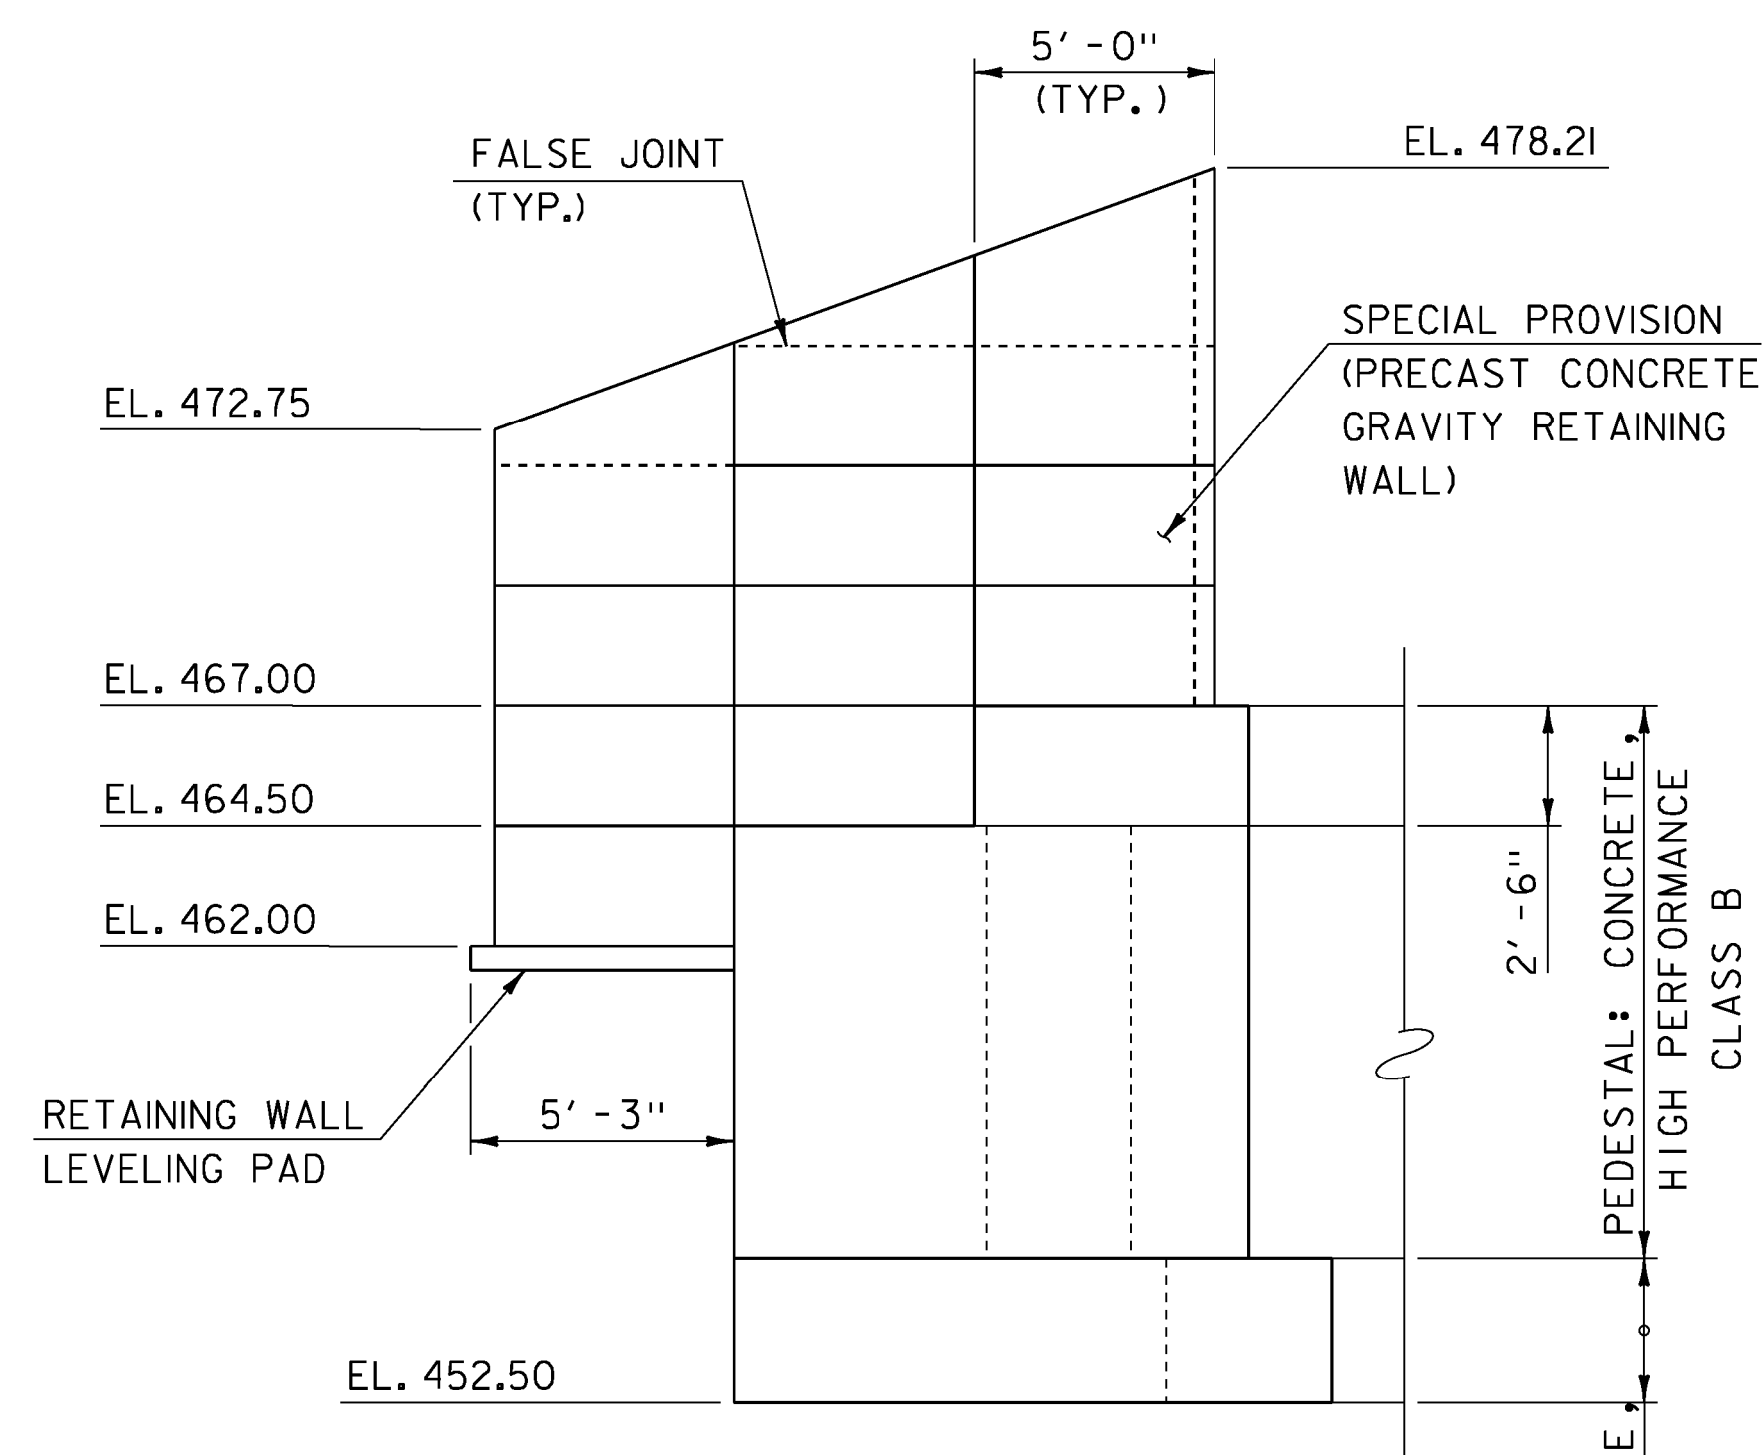

WINGWALL NO. 3 ELEVATION

SCALE: 1/4" = 1'-0"

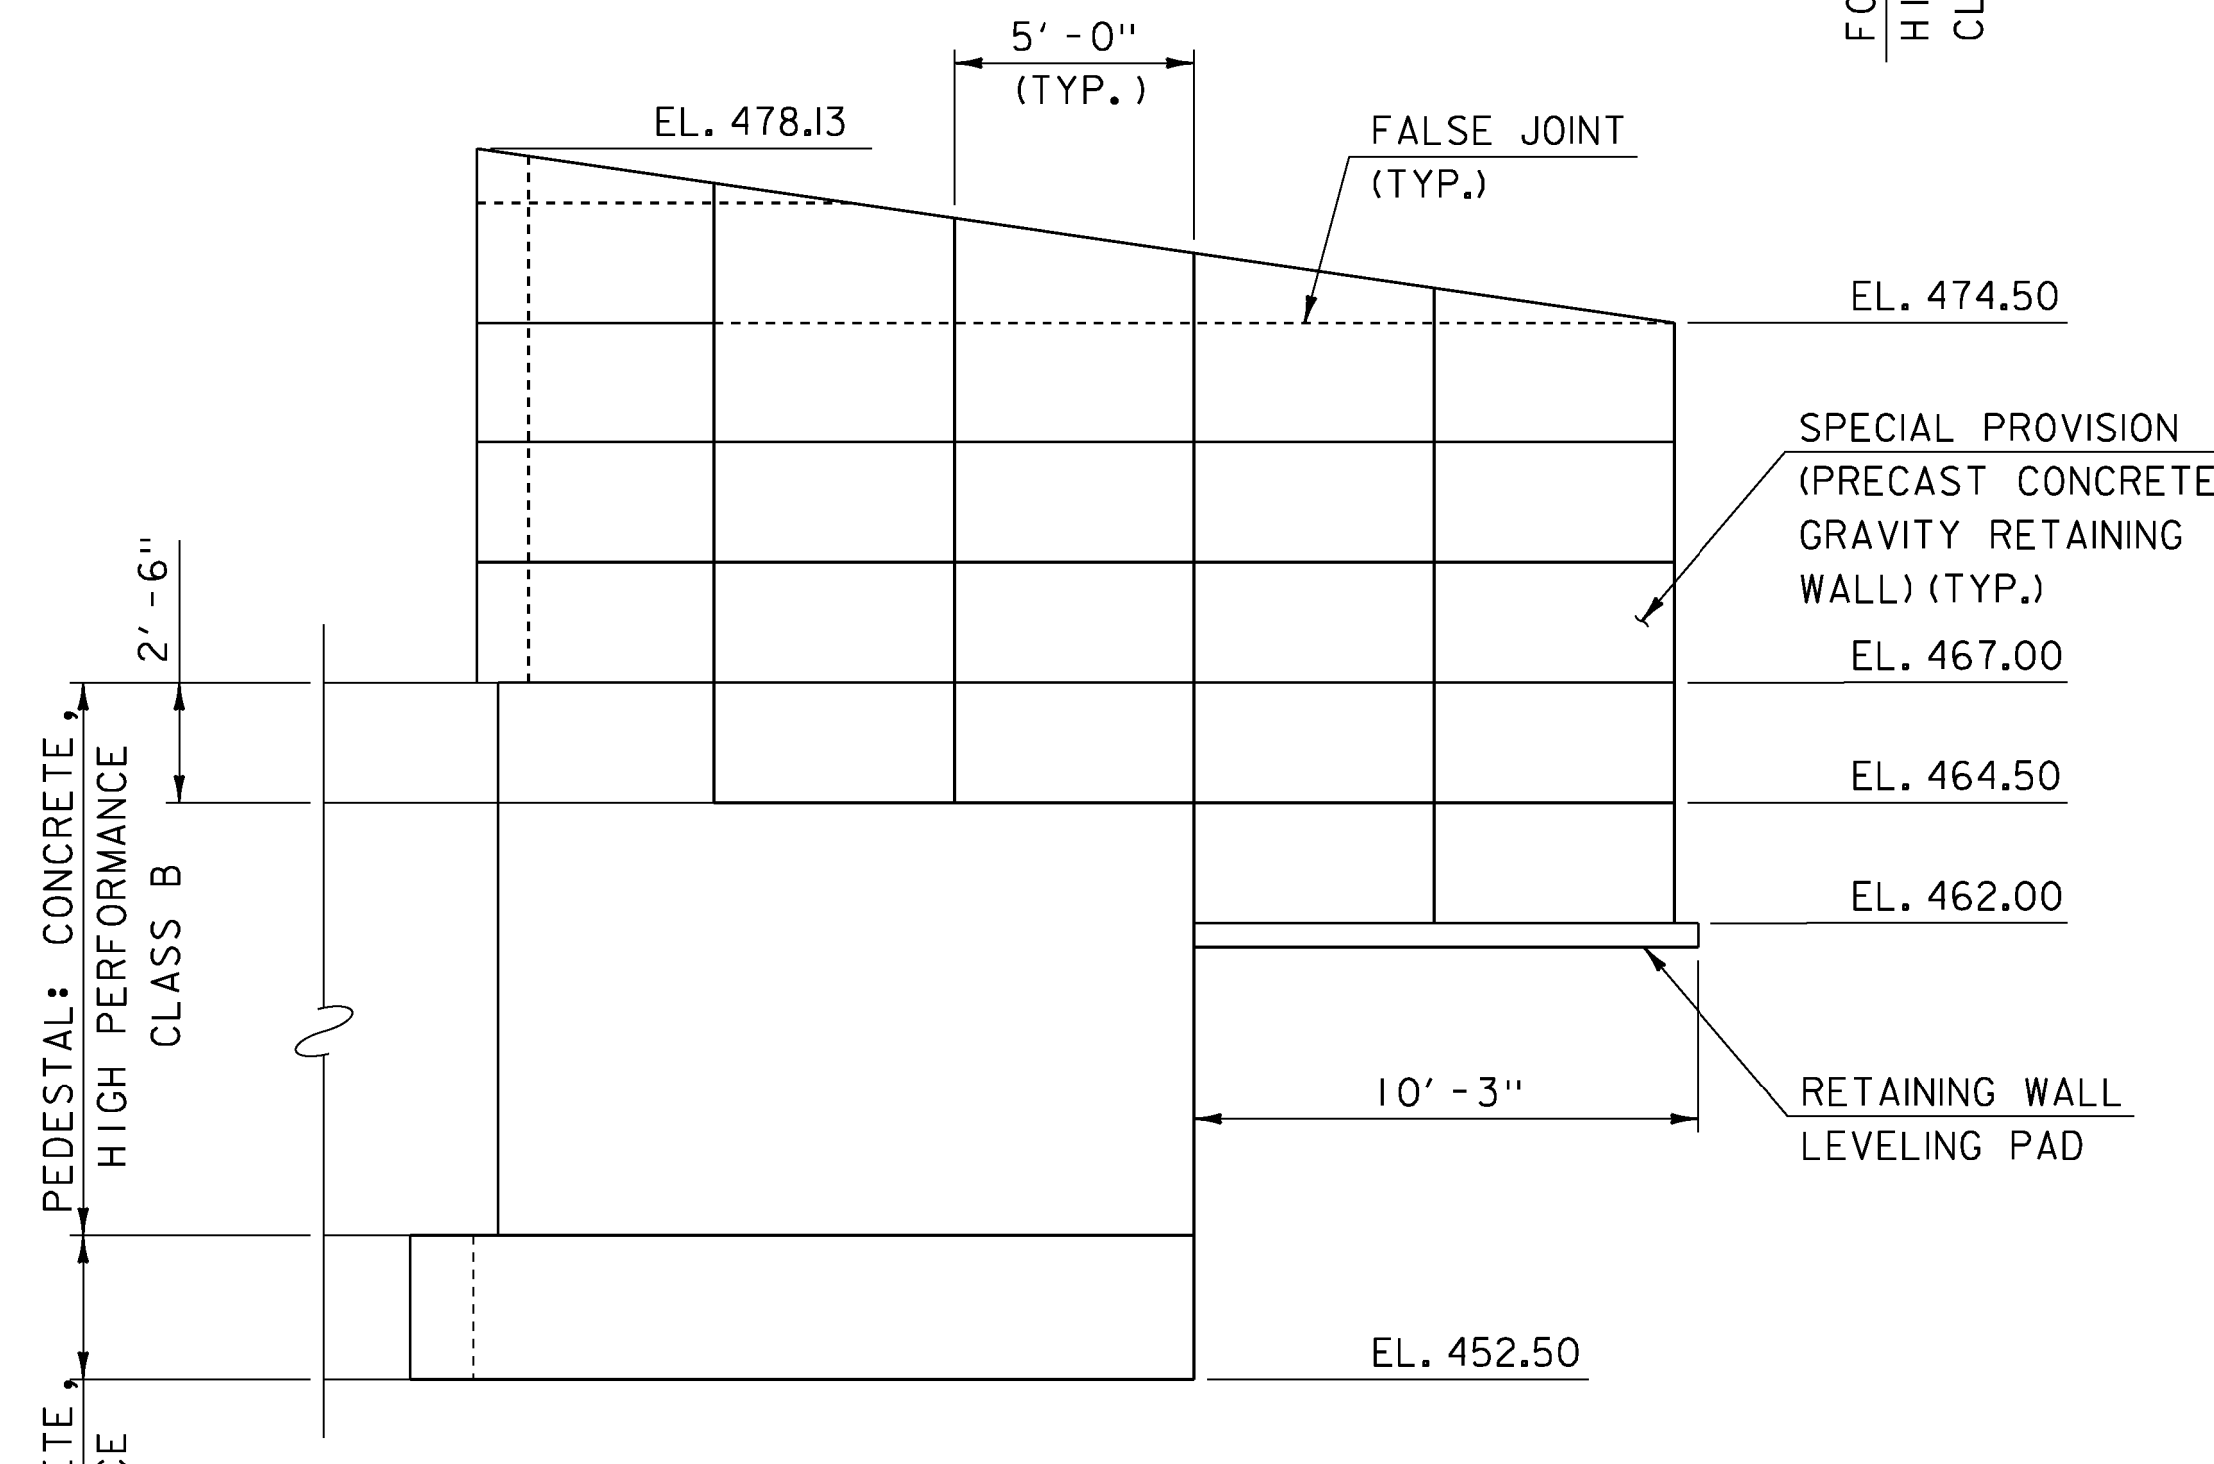

WINGWALL NO. 4 ELEVATION

SCALE: 1/4" = 1'-0"

SEE CONTRACTOR SUBMITTAL PLAN INCLUDED.

PROJECT NAME: FAIRFIELD
PROJECT NUMBER: BRO 1448(38)

FILE NAME: z11j072sub2.dgn
PROJECT LEADER: D. LANDRY
DESIGNED BY: T. TRAVER
RETAINING WALL DETAILS

PLOT DATE: 01-NOV-2013
DRAWN BY: P. DUSTIN
CHECKED BY: T. KENDRICK
SHEET 32 OF 41




REINFORCING STEEL SCHEDULE

ITEM	EACH	SIZE	LENGTH	MARK	TYPE	A	B	C	D	E	F	G	H	J	K	R	O	ITEM	EACH	SIZE	LENGTH	MARK	TYPE	A	B	C	D	E	F	G	H	J	K	R	O
ABUTMENT NO. 1																		ABUTMENT NO. 2																	
16	4	2'- 0"	1A401	STR														16	4	2'- 0"	2A401	STR													
35	5	9'- 6"	1A501	STR														25	5	9'- 6"	2A501	STR													
▲ 3	5	4'- 7"	1A502	STR														▲ 3	5	4'- 7"	2A502	STR													
* 3	5	6'- 8"	1A503	STR														* 5	5	7'- 1"	2A503	STR													
▲ 30	5	7'- 6"	1A504	STR														▲ 29	5	7'- 6"	2A504	STR													
▲ 6	5	7'- 1"	1A505	STR														▲ 6	5	7'- 1"	2A505	STR													
▲ 4	5	3'- 11"	1A506	STR														▲ 4	5	3'- 11"	2A506	STR													
22	5	21'- 2"	1A507	STR														22	5	15'- 11"	2A507	STR													
18	5	30'- 0"	1A508	STR														18	5	30'- 0"	2A508	STR													
18	5	13'- 5"	1A509	STR														18	5	13'- 5"	2A509	STR													
22	5	17'- 0"	1A510	STR														22	5	12'- 1"	2A510	STR													
36	5	5'- 10"	1A511	2	0'- 10"	5'- 0"						0'- 0"						26	5	5'- 10"	2A511	2	0'- 10"	5'- 0"					0'- 0"						
42	5	7'- 6"	1A512	STR														42	5	7'- 6"	2A512	STR													
10	5	19'- 6"	1A513	STR														10	5	14'- 4"	2A513	STR													
10	5	19'- 6"	1A514	STR														10	5	14'- 4"	2A514	STR													
25	5	8'- 8"	1A515	STR														15	5	8'- 8"	2A515	STR													
11	5	11'- 4"	1A516	STR														13	5	11'- 4"	2A516	STR													
4	5	6'- 6"	1A517	19		2'- 0"	4'- 6"						1'- 5"		1'- 5"			4	5	6'- 6"	2A517	19		2'- 0"	4'- 4"					1'- 5"		1'- 5"		5'- 8"	
4	5	3'- 1"	1A518	19		1'- 1"	2'- 0"						0'- 9"		0'- 9"			4	5	3'- 0"	2A518	19		0'- 9"	2'- 0"					0'- 6"		0'- 6"		2'- 6"	
32	5	30'- 0"	1A519	STR														32	5	30'- 0"	2A519	STR													
16	5	13'- 6"	1A520	STR														16	5	13'- 6"	2A520	STR													
16	5	17'- 6"	1A521	STR														16	5	17'- 6"	2A521	STR													
4	5	7'- 4"	1A522	19		2'- 0"	5'- 4"						1'- 9"		1'- 0"		6'- 4"	4	5	7'- 5"	2A522	19		2'- 0"	5'- 5"				1'- 9"		1'- 0"		6'- 5"		
4	5	4'- 2"	1A523	19		2'- 2"	2'- 0"						1'- 11"		1'- 1"		3'- 1"	4	5	4'- 4"	2A523	19		2'- 4"	2'- 0"				1'- 9"		1'- 0"		3'- 0"		
10	5	15'- 3"	1A524	STR														10	5	10'- 5"	2A524	STR													
10	5	13'- 6"	1A525	STR														10	5	8'- 7"	2A525	STR													
20	5	5'- 0"	1A526	19		2'- 6"	2'- 6"						1'- 9"		1'- 9"		4'- 3"	20	5	5'- 0"	2A526	19		2'- 6"	2'- 6"				1'- 9"		1'- 9"		4'- 3"		
10	5	5'- 0"	1A527	19		2'- 6"	2'- 6"						1'- 9"		1'- 9"		4'- 3"	10	5	5'- 0"	2A527	19		2'- 6"	2'- 6"				1'- 9"		1'- 9"		4'- 3"		
20	5	5'- 0"	1A528	19		2'- 6"	2'- 6"						1'- 9"		1'- 9"		4'- 3"	20	5	5'- 0"	2A528	19		2'- 6"	2'- 6"				1'- 9"		1'- 9"		4'- 3"		
10	5	18'- 11"	1A529	22		2'- 6"	13'- 11"	2'- 6"					1'- 3"	1'- 3"	2'- 2"	2'- 2"		10	5	18'- 11"	2A529	22		2'- 6"	13'- 11"	2'- 6"			1'- 3"	1'- 3"	2'- 2"	2'- 2"			
44	6	6'- 5"	1A601	2	0'- 12"	5'- 5"							0'- 0"					44	6	6'- 5"	2A601	2	0'- 12"	5'- 5"					0'- 0"						
* 45	6	11'- 2"	1A602	STR														* 44	6	11'- 4"	2A602	STR													
3	6	30'- 0"	1A603	STR														3	6	30'- 0"	2A603	STR													
3	6	18'- 4"	1A604	STR														3	6	18'- 4"	2A604	STR													
23	6	13'- 8"	1A605	17		5'- 0"	3'- 8"	5'- 0"										23	6	13'- 8"	2A605	17		5'- 0"	3'- 8"	5'- 0"									
5	6	11'- 8"	1A606	17		5'- 0"	1'- 8"	5'- 0"										5	6	11'- 8"	2A606	17		5'- 0"	1'- 8"	5'- 0"									
1	6	12'- 8"	1A607	17		5'- 0"	2'- 8"	5'- 0"										1	6	12'- 8"	2A607	17		5'- 0"	2'- 8"	5'- 0"									
36	7	7'- 7"	1A701	2	1'- 2"	6'- 5"							0'- 0"					22	7	7'- 7"	2A701	2	1'- 2"	6'- 5"					0'- 0"						
* 31	7	8'- 8"	1A702	STR														* 19	7	8'- 8"	2A702	STR													
5	7	11'- 4"	1A703	STR														5	7	11'- 4"	2A703	STR													
85	8	7'- 9"	1A801	2	1'- 4"	6'- 5"							0'- 0"					* 84	8	8'- 9"	2A801	2	1'- 4"	7'- 5"					0'- 0"						
* 42	8	9'- 6"	1A802	STR														* 30	8	9'- 6"	2A802	STR													
▲ 9	8	9'- 6"	1A803	STR														▲ 9	8	9'- 6"	2A803	STR													
▲ 13	8	10'- 0"	1A804	STR														▲ 13	8	10'- 1"	2A804	STR													
84	8	11'- 2"	1A805	STR														84	8	11'- 4"	2A805	STR													

~ NOTES ~


- UNLESS OTHERWISE DESIGNATED, ALL BAR REINFORCEMENT FOR CONCRETE IN SIZES UP TO AND INCLUDING NO. 18 SHALL CONFORM TO THE REQUIREMENTS OF THE "SPECIFICATIONS FOR DEFORMED BILLET-STEEL BARS FOR CONCRETE REINFORCEMENT", AASHTO M 31 (ASTM A615-S1). ALL BARS SHALL BE GRADE 60, UNLESS OTHERWISE DESIGNATED.
- FOR TYPICAL BENDING DETAILS, RECOMMENDED PIN DIAMETER "D" OF BENDS AND HOOKS, AND OTHER STANDARD PRACTICE, SEE CURRENT CONCRETE REINFORCING STEEL INSTITUTE "MANUAL OF STANDARD PRACTICE".
- BARS WHICH REQUIRE MORE ACCURATE BENDING THAN STANDARD PRACTICES SHOULD HAVE LIMITS INDICATED.
- ALL DIMENSIONS ARE OUT TO OUT OF BAR EXCEPT "A" AND "G" ON STANDARD 180 DEGREE AND 135 DEGREE HOOKS.
- "J" DIMENSION ON 180 DEGREE HOOKS TO BE SHOWN ONLY WHERE NECESSARY TO RESTRICT HOOK SIZE. OTHERWISE, STANDARD HOOKS ARE TO BE USED.
- "H" DIMENSION ON STIRRUPS TO BE SHOWN ONLY WHEN NECESSARY TO MAINTAIN CLEARANCES.
- WHERE SLOPE DIFFERS FROM 45 DEGREES, DIMENSIONS "H" AND "K" MUST BE SHOWN.
- ▲ DENOTES BARS TO BE CUT IN FIELD.
- * DENOTES ONE EXTRA BAR ADDED FOR TESTING PURPOSES.
- △ DENOTES TWO EXTRA BARS ADDED FOR TESTING PURPOSES.
- E IN BAR MARK PREFIX DENOTES EPOXY COATED REINFORCING STEEL.

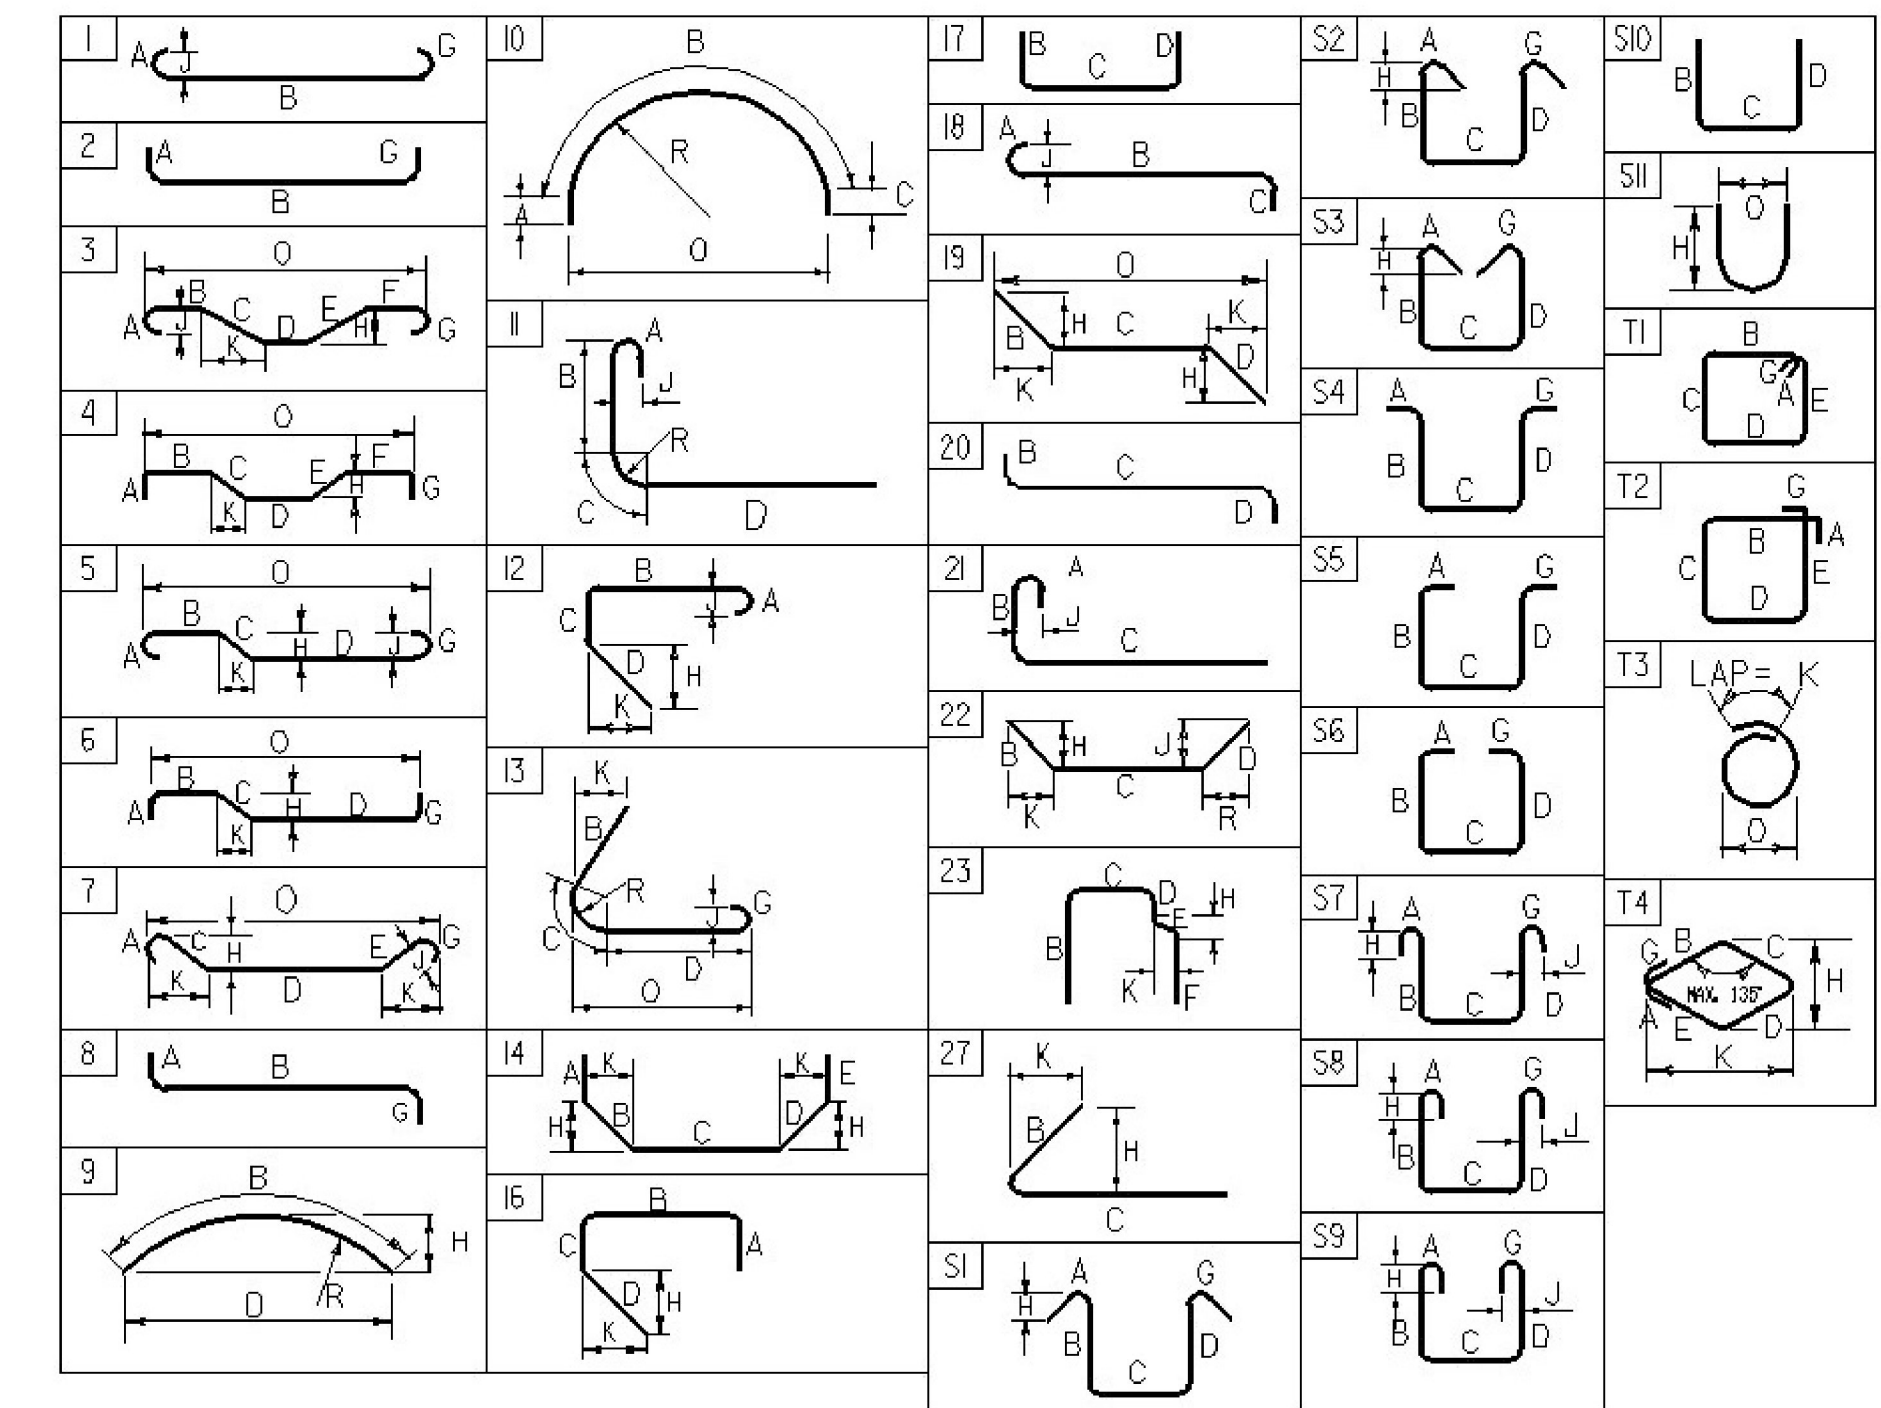


ASTM STANDARD
REINFORCING BARS

BAR SIZE DESIGNATION	WEIGHT POUNDS PER FOOT	NOMINAL DIMENSIONS ROUND SECTION		
		DIAMETER INCHES	AREA INCHES ²	PERIMETER INCHES
#3	0.376	0.375	0.11	1.178
#4	0.668	0.500	0.20	1.571
#5	1.043	0.625	0.31	1.963
#6	1.502	0.750	0.44	2.356
#7	2.044	0.875	0.60	2.749
#8	2.670	1.000	0.79	3.142
#9	3.400	1.128	1.00	3.544
#10	4.303	1.270	1.27	3.990
#11	5.313	1.410	1.56	4.430
#14	7.65	1.693	2.25	5.32
#18	13.60	2.257	4.00	7.09


PROJECT NAME: **FAIRFIELD**
PROJECT NUMBER: **BRO 1448(38)**
FILE NAME: **z11j072reinf.xls** PLOT DATE: **11/01/2013**
PROJECT MANAGER: **D. LANDRY** DRAWN BY: **P. DUSTIN**
DESIGNED BY: **T. TRAVER** CHECKED BY: **T. KENDRICK**
REINFORCING STEEL SCHEDULE SHEET **33** OF **41**

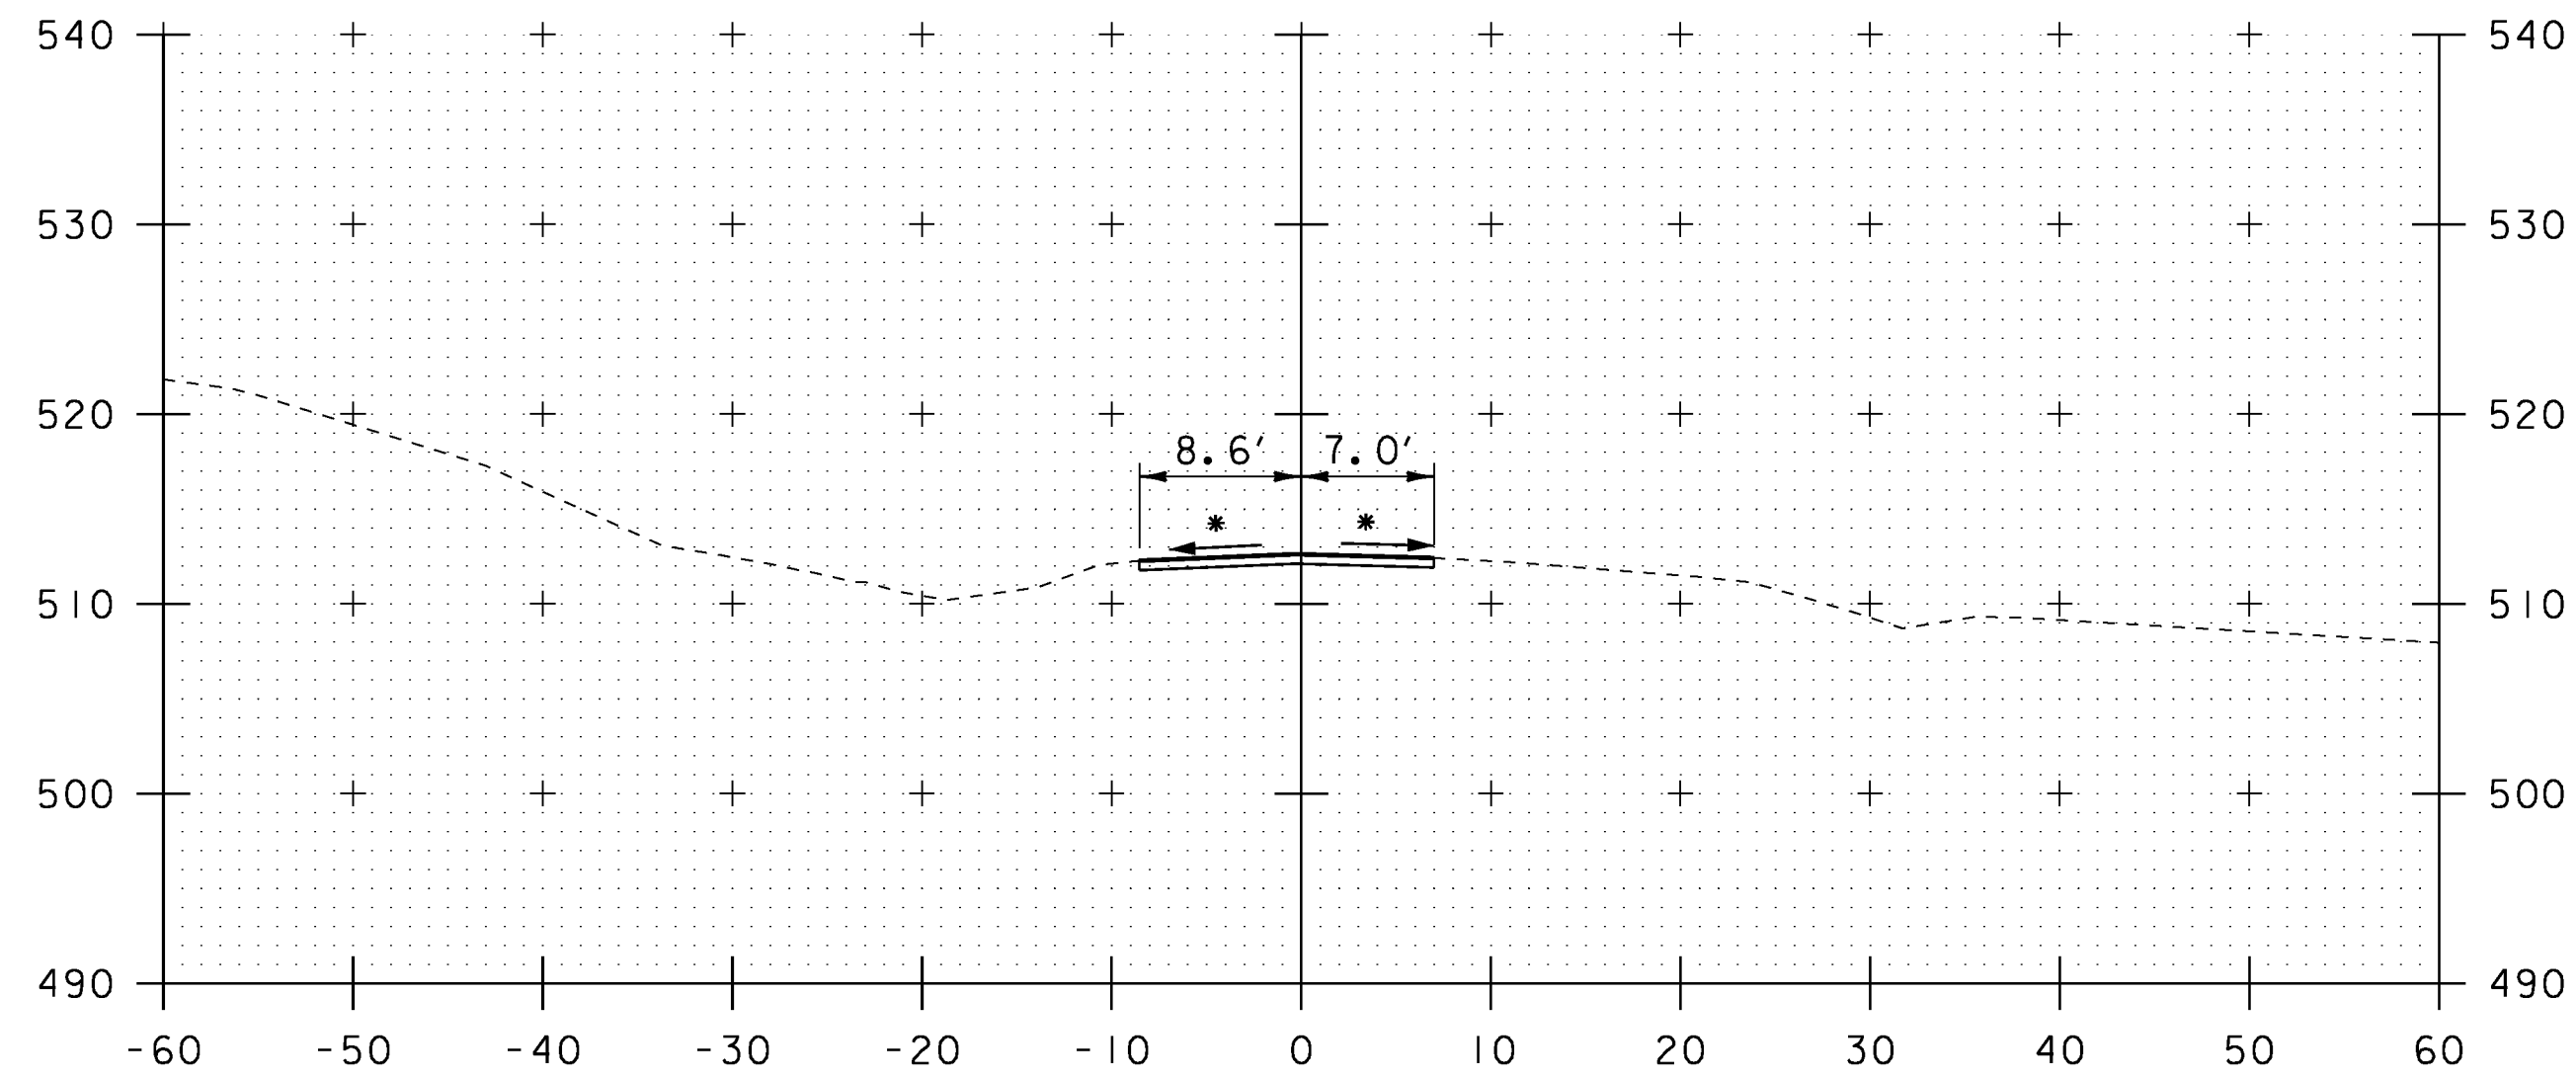


10+75
 * MATCH EXISTING CROSS SLOPE (TYP)
 BEGIN APPROACH STA 10+75.00
 MATCH EXISTING

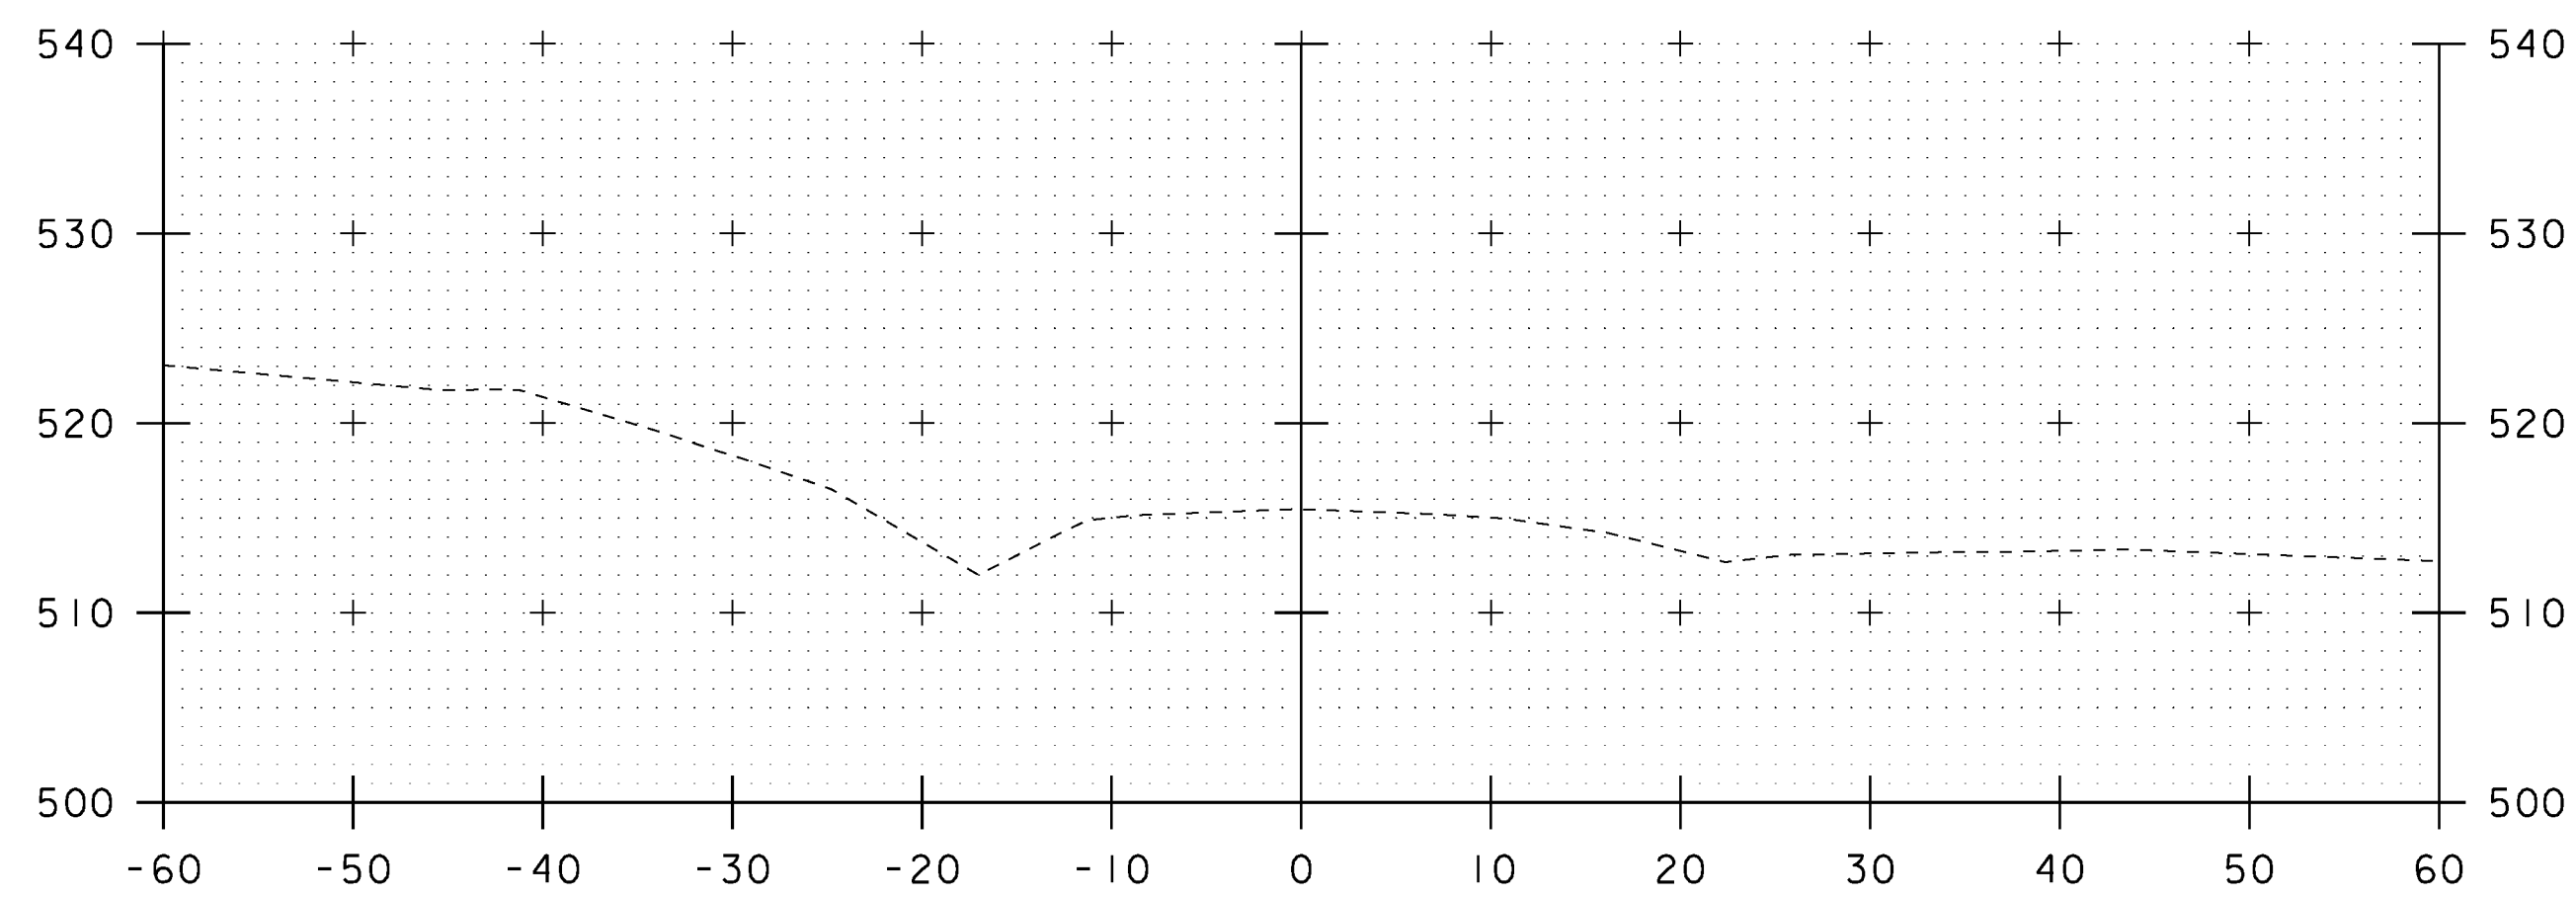


10+50

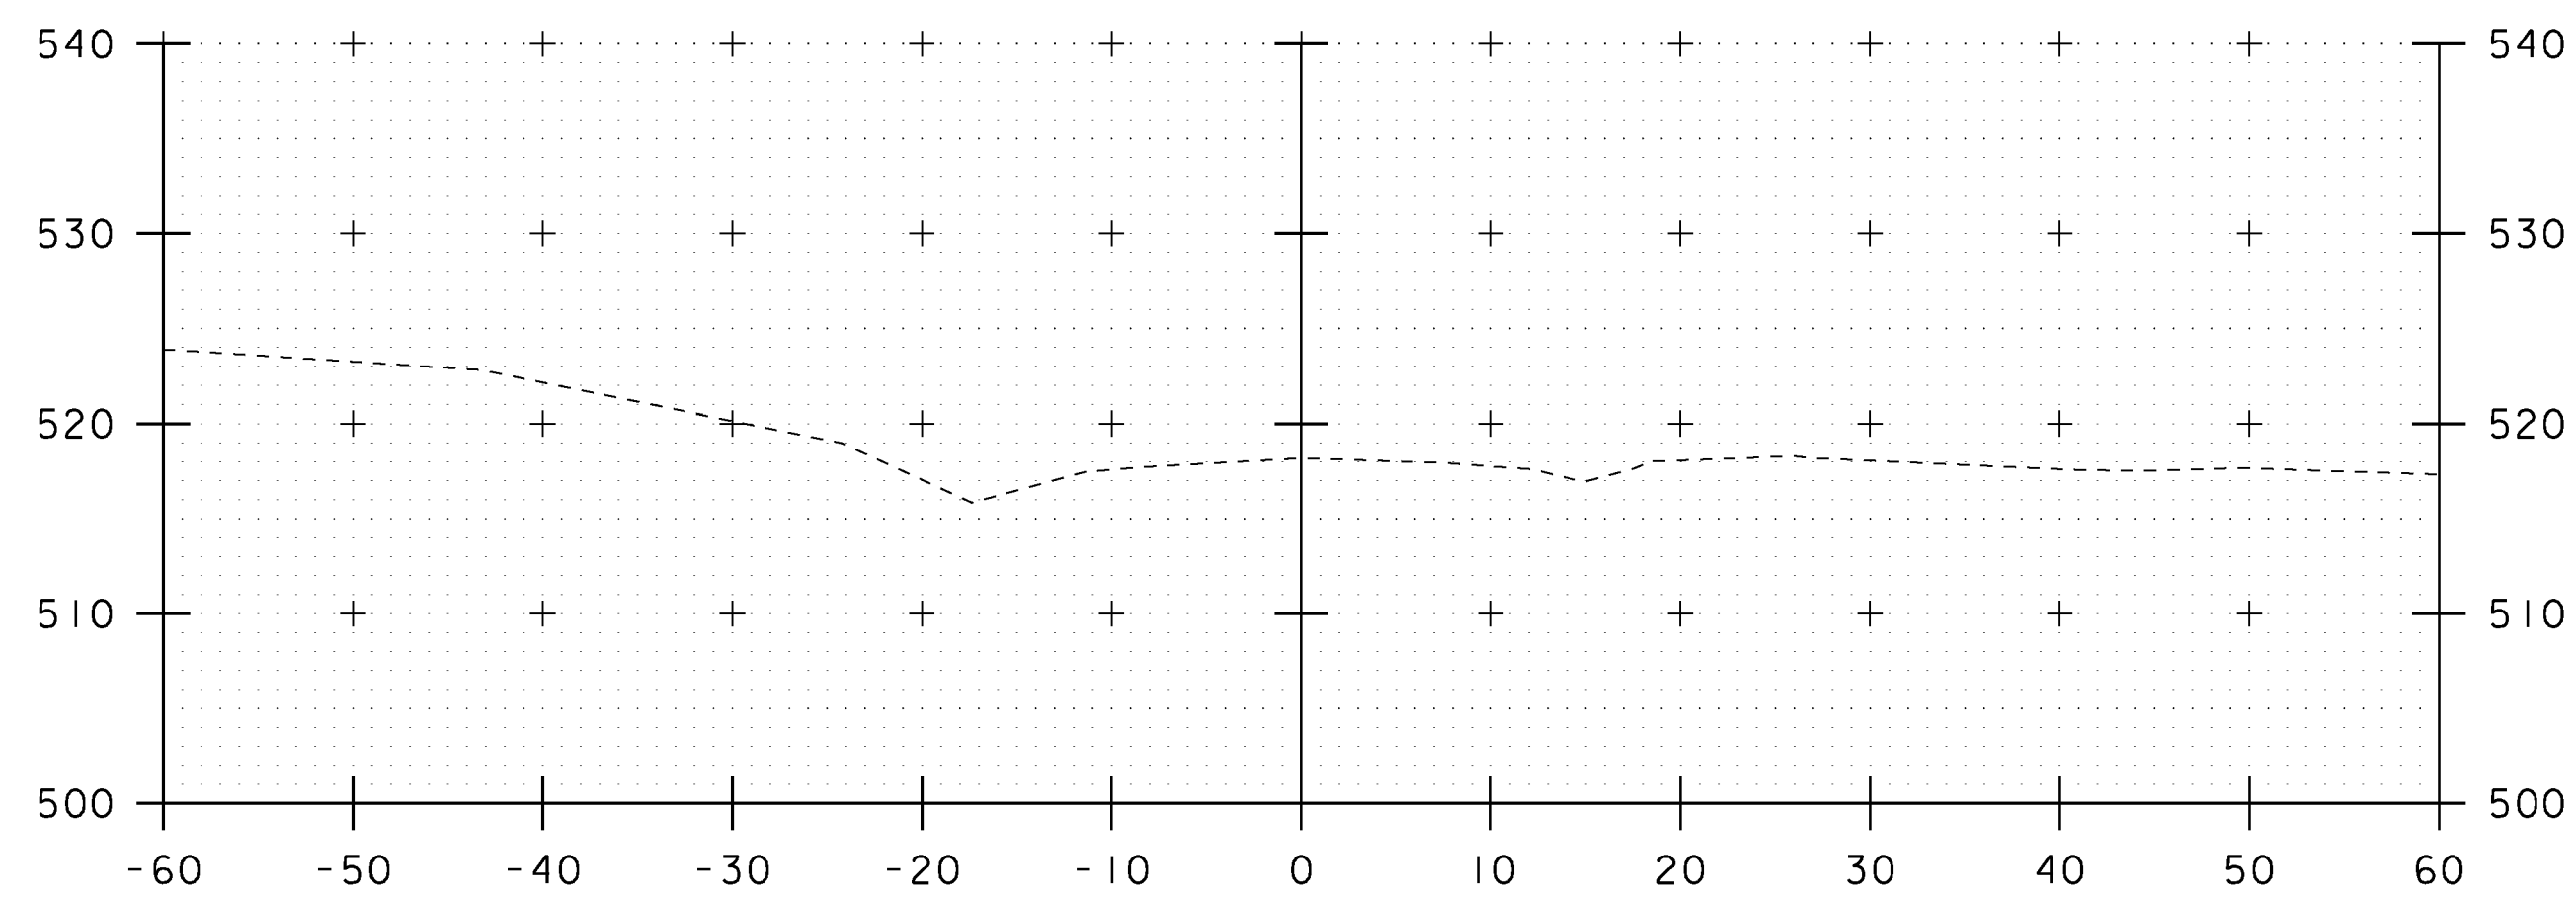

10+25

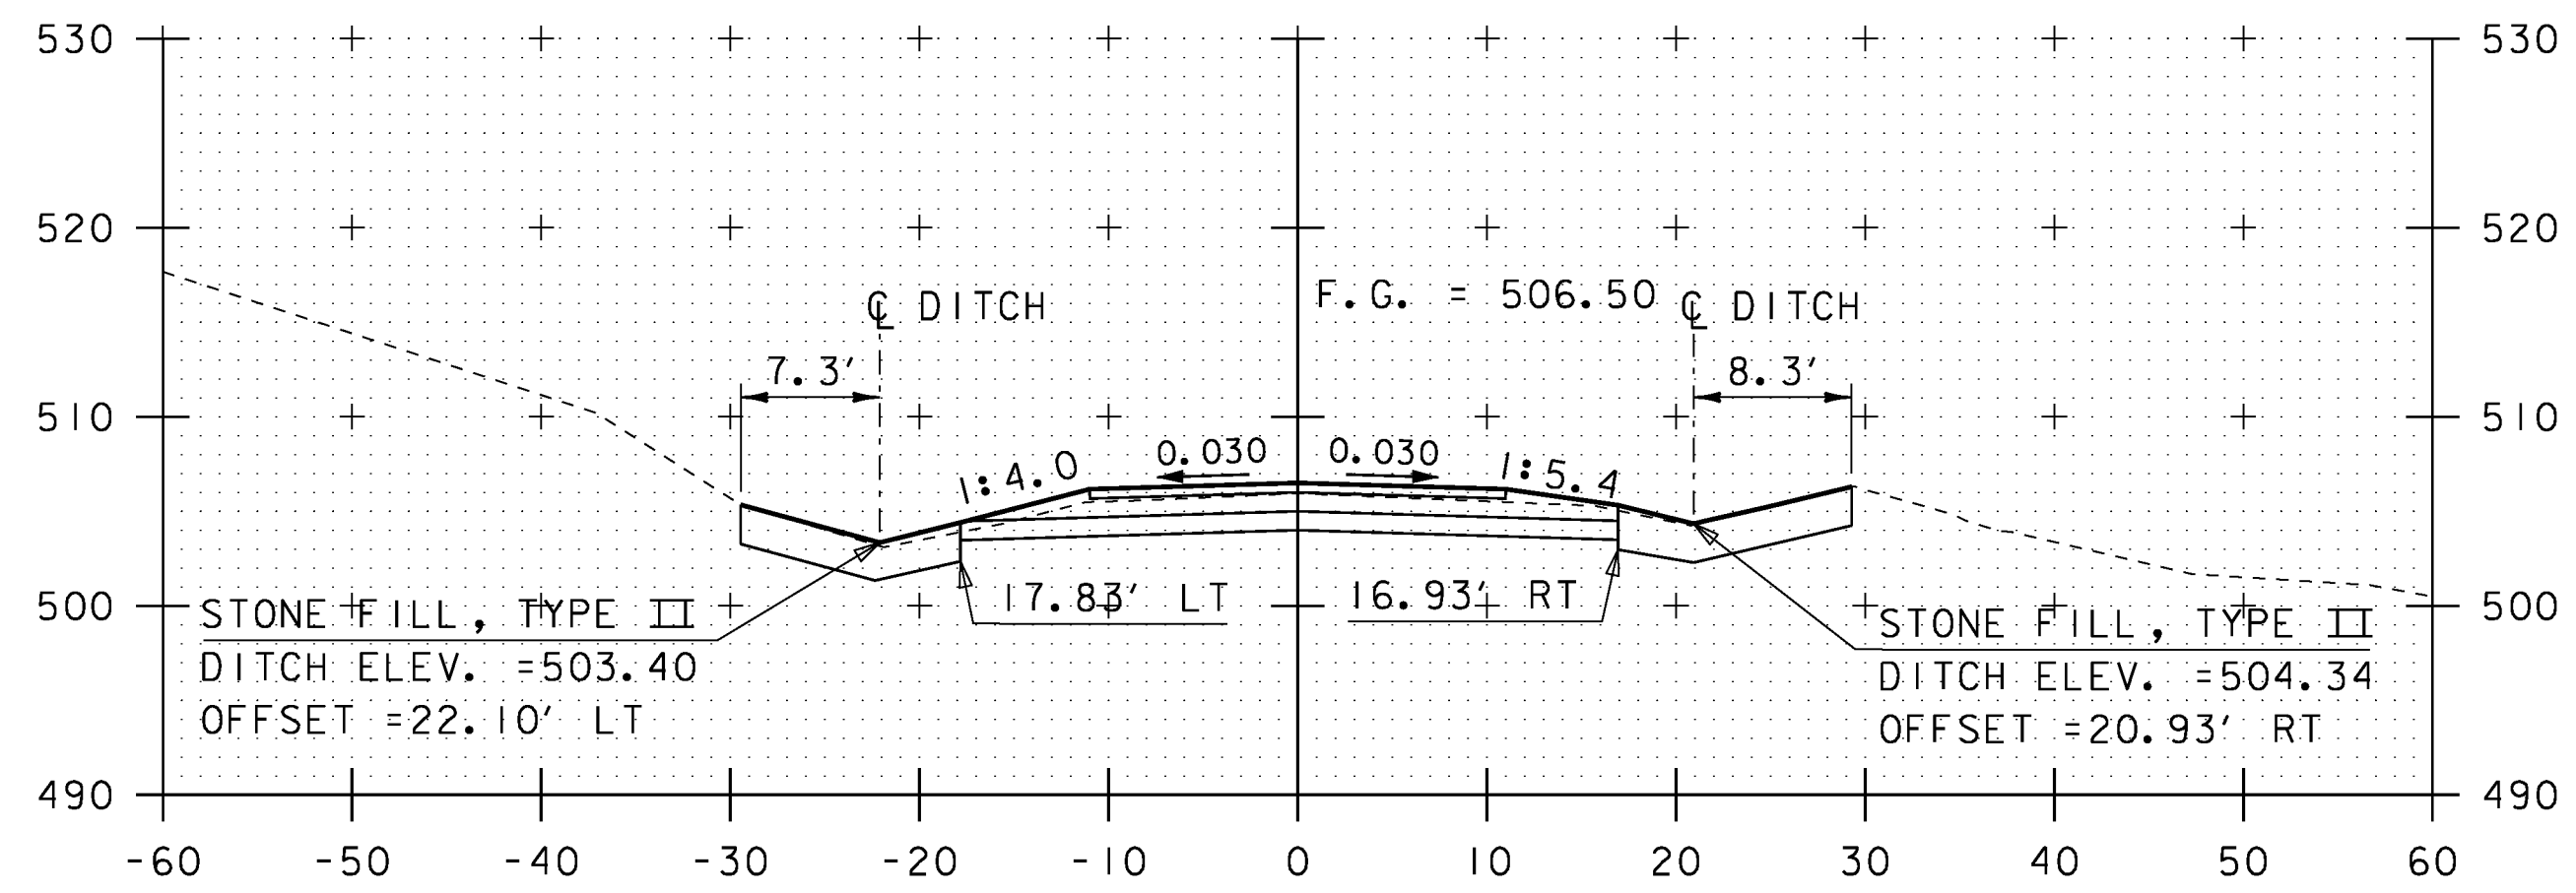

11+25
 BEGIN PROJECT STA 11+25.00

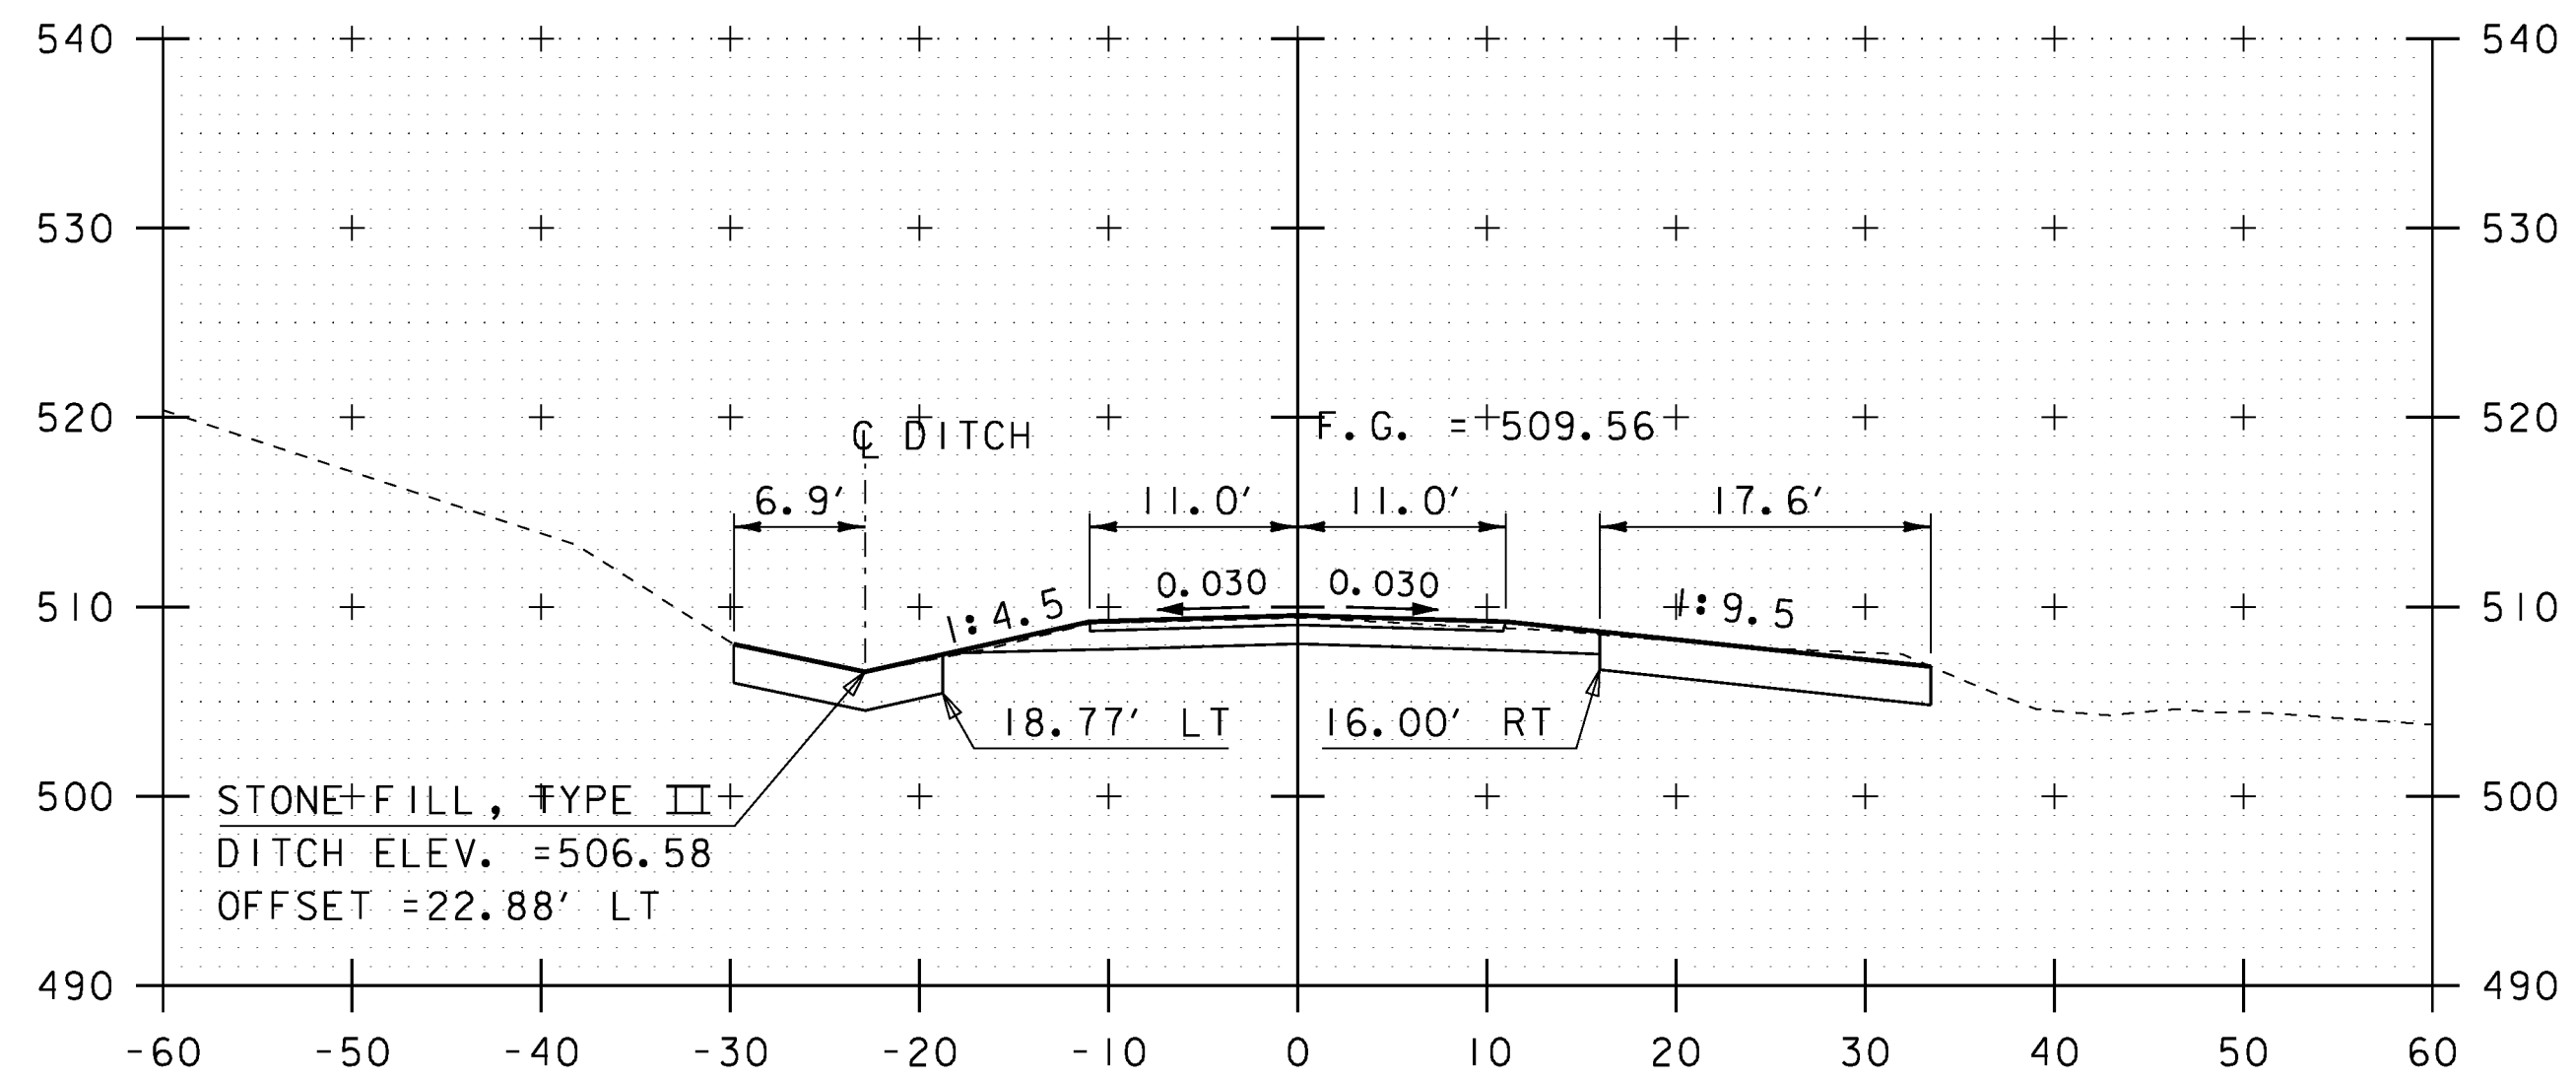

11+00


SCALE 1" = 10'-0"
 10 0 10

STA. 10+25 TO STA. 11+25




PROJECT NAME: FAIRFIELD
 PROJECT NUMBER: BRO 1448(38)
 FILE NAME: z11j072_xsl.dgn
 PROJECT LEADER: D. LANDRY
 DESIGNED BY: E. ALEXOPOULOS
 ROADWAY CROSS SECTIONS (1 OF 6)


PLOT DATE: 01-NOV-2013
 DRAWN BY: W. GAYNOR
 CHECKED BY: T. KENDRICK
 SHEET 34 OF 41

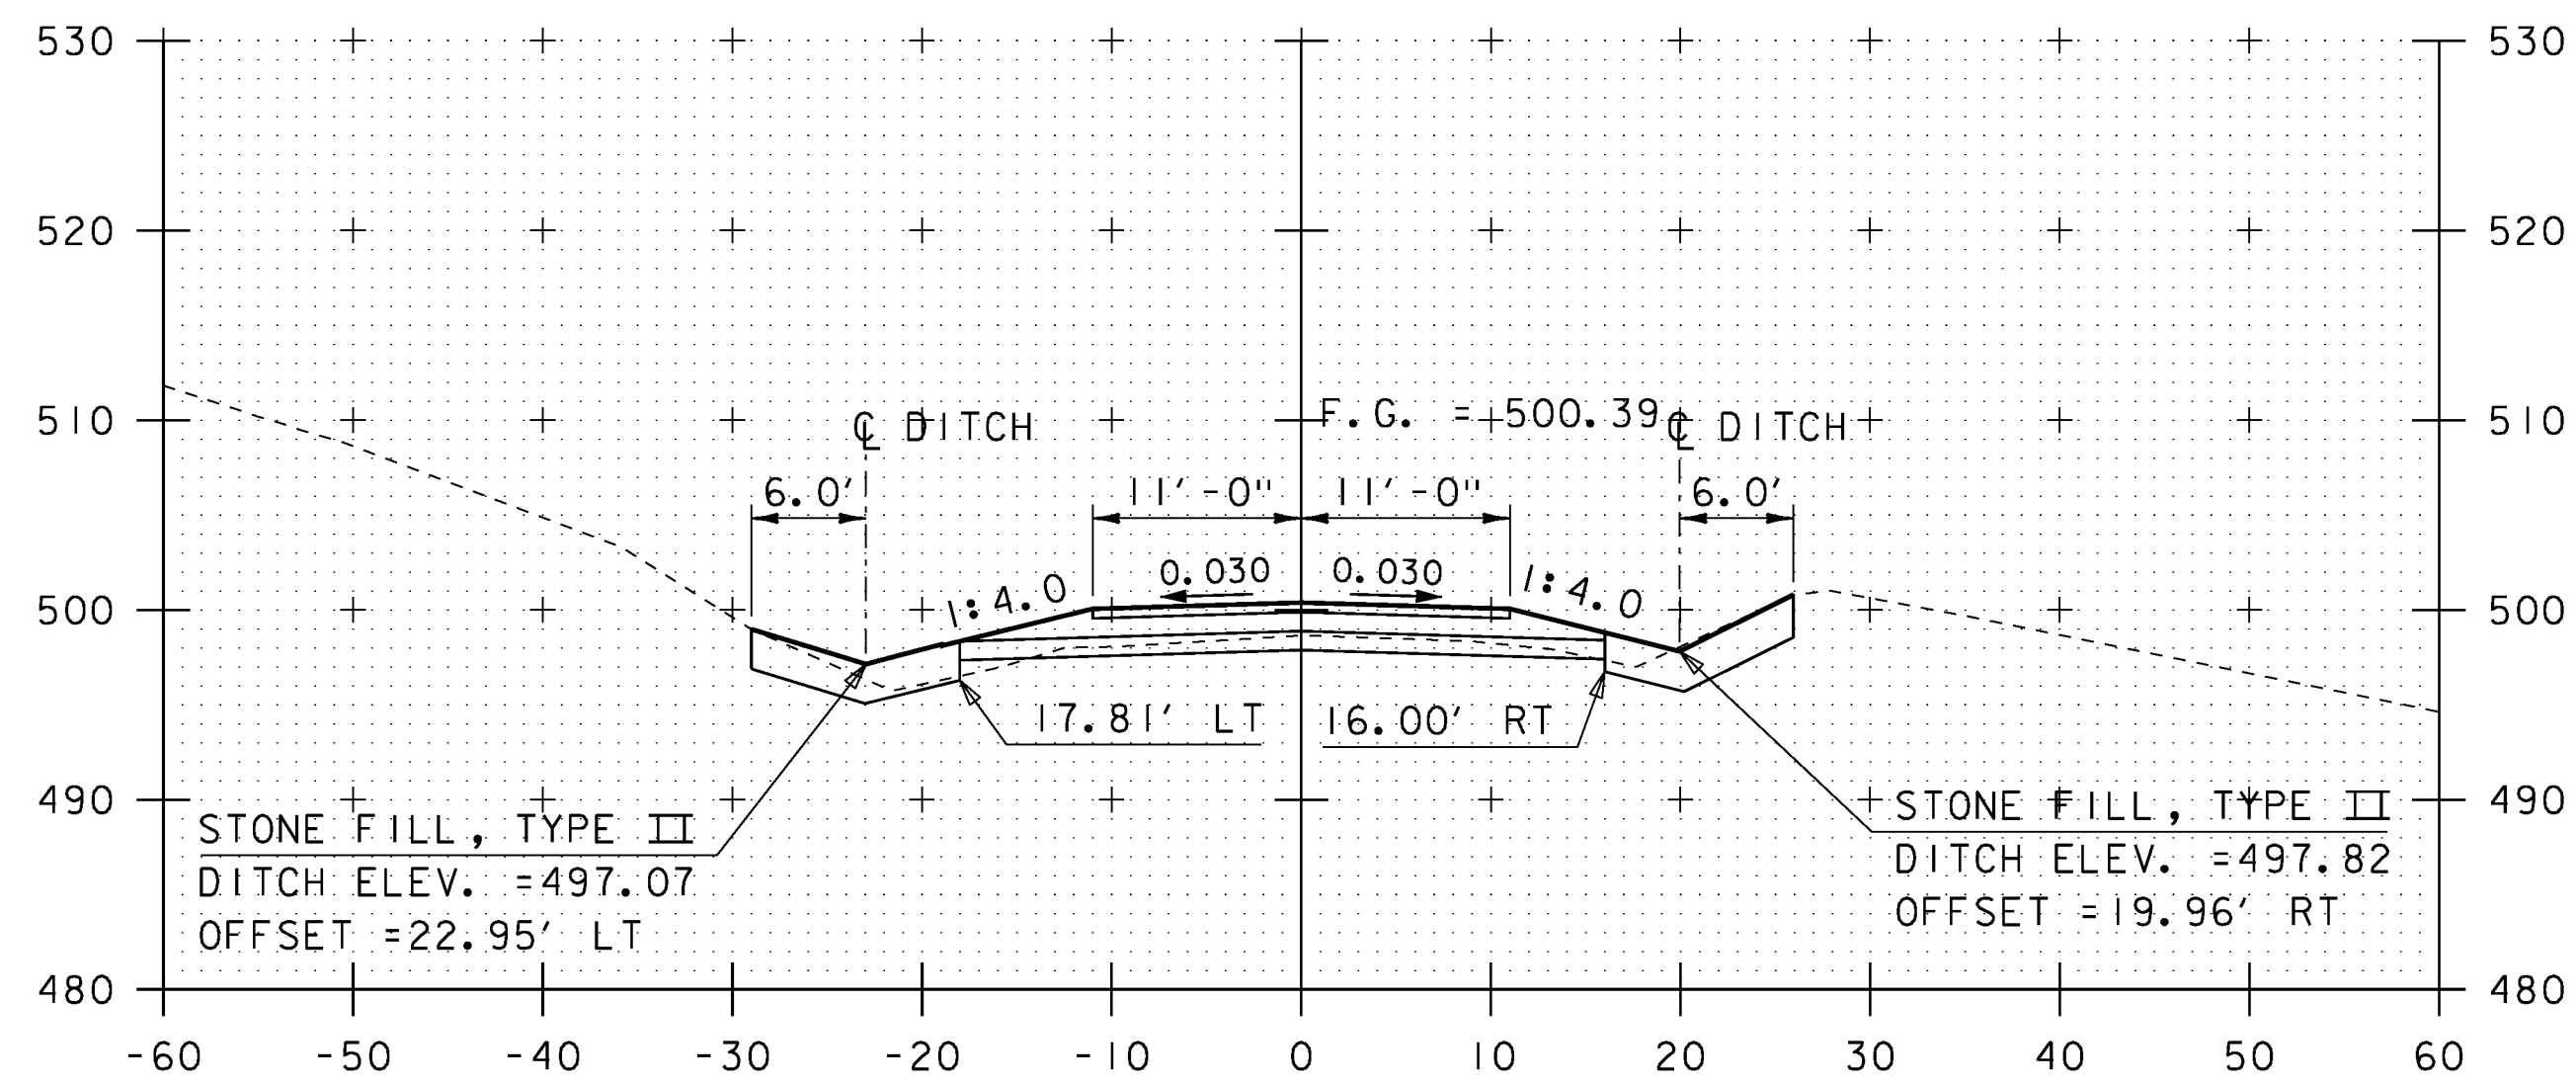


11+75

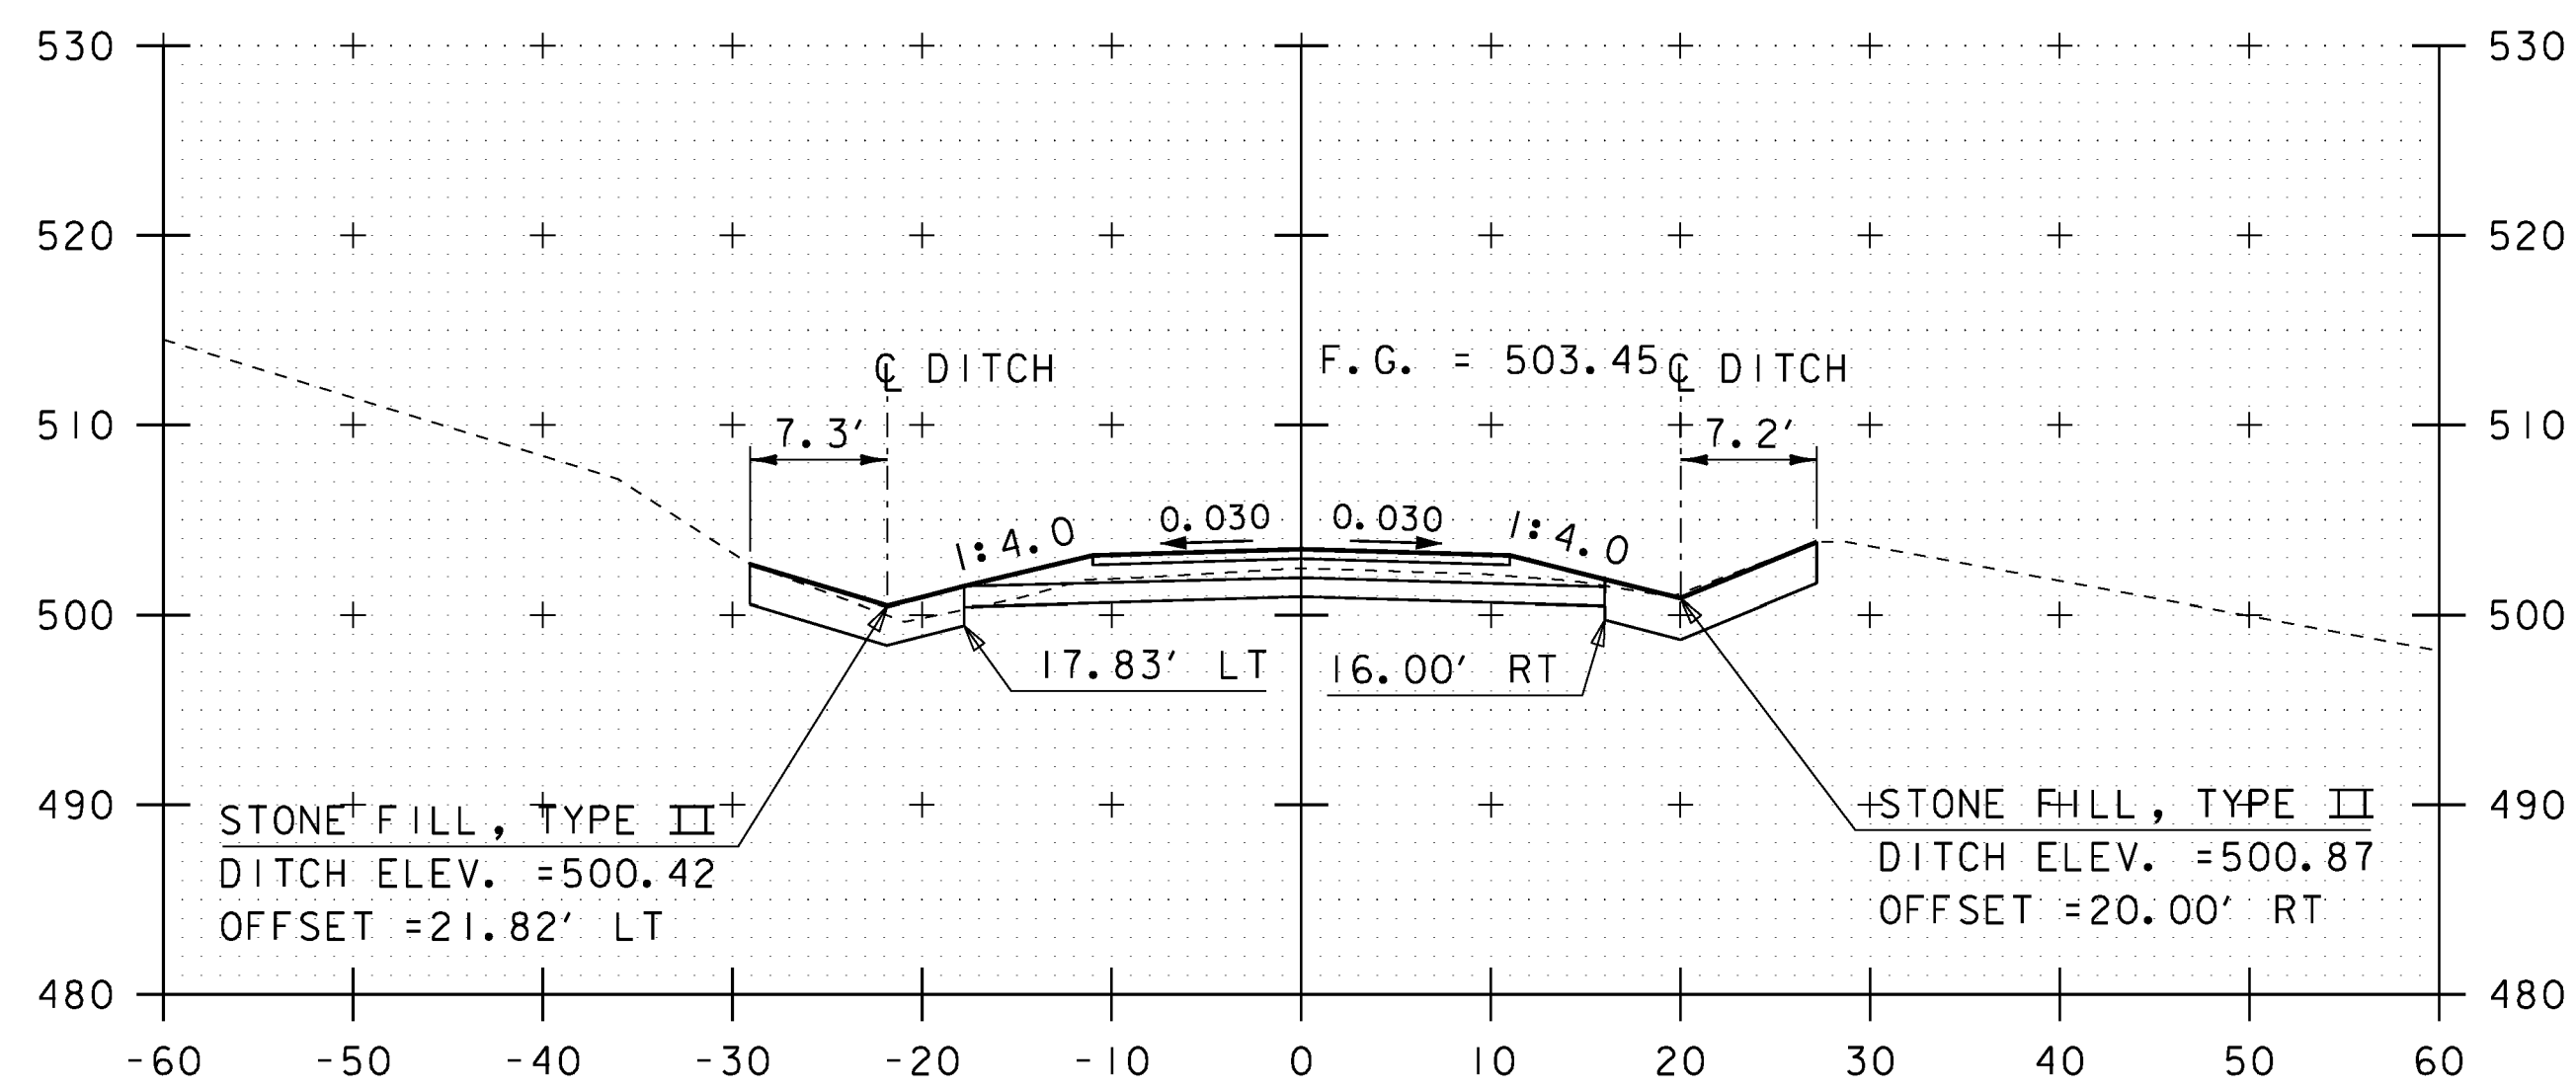


11+50

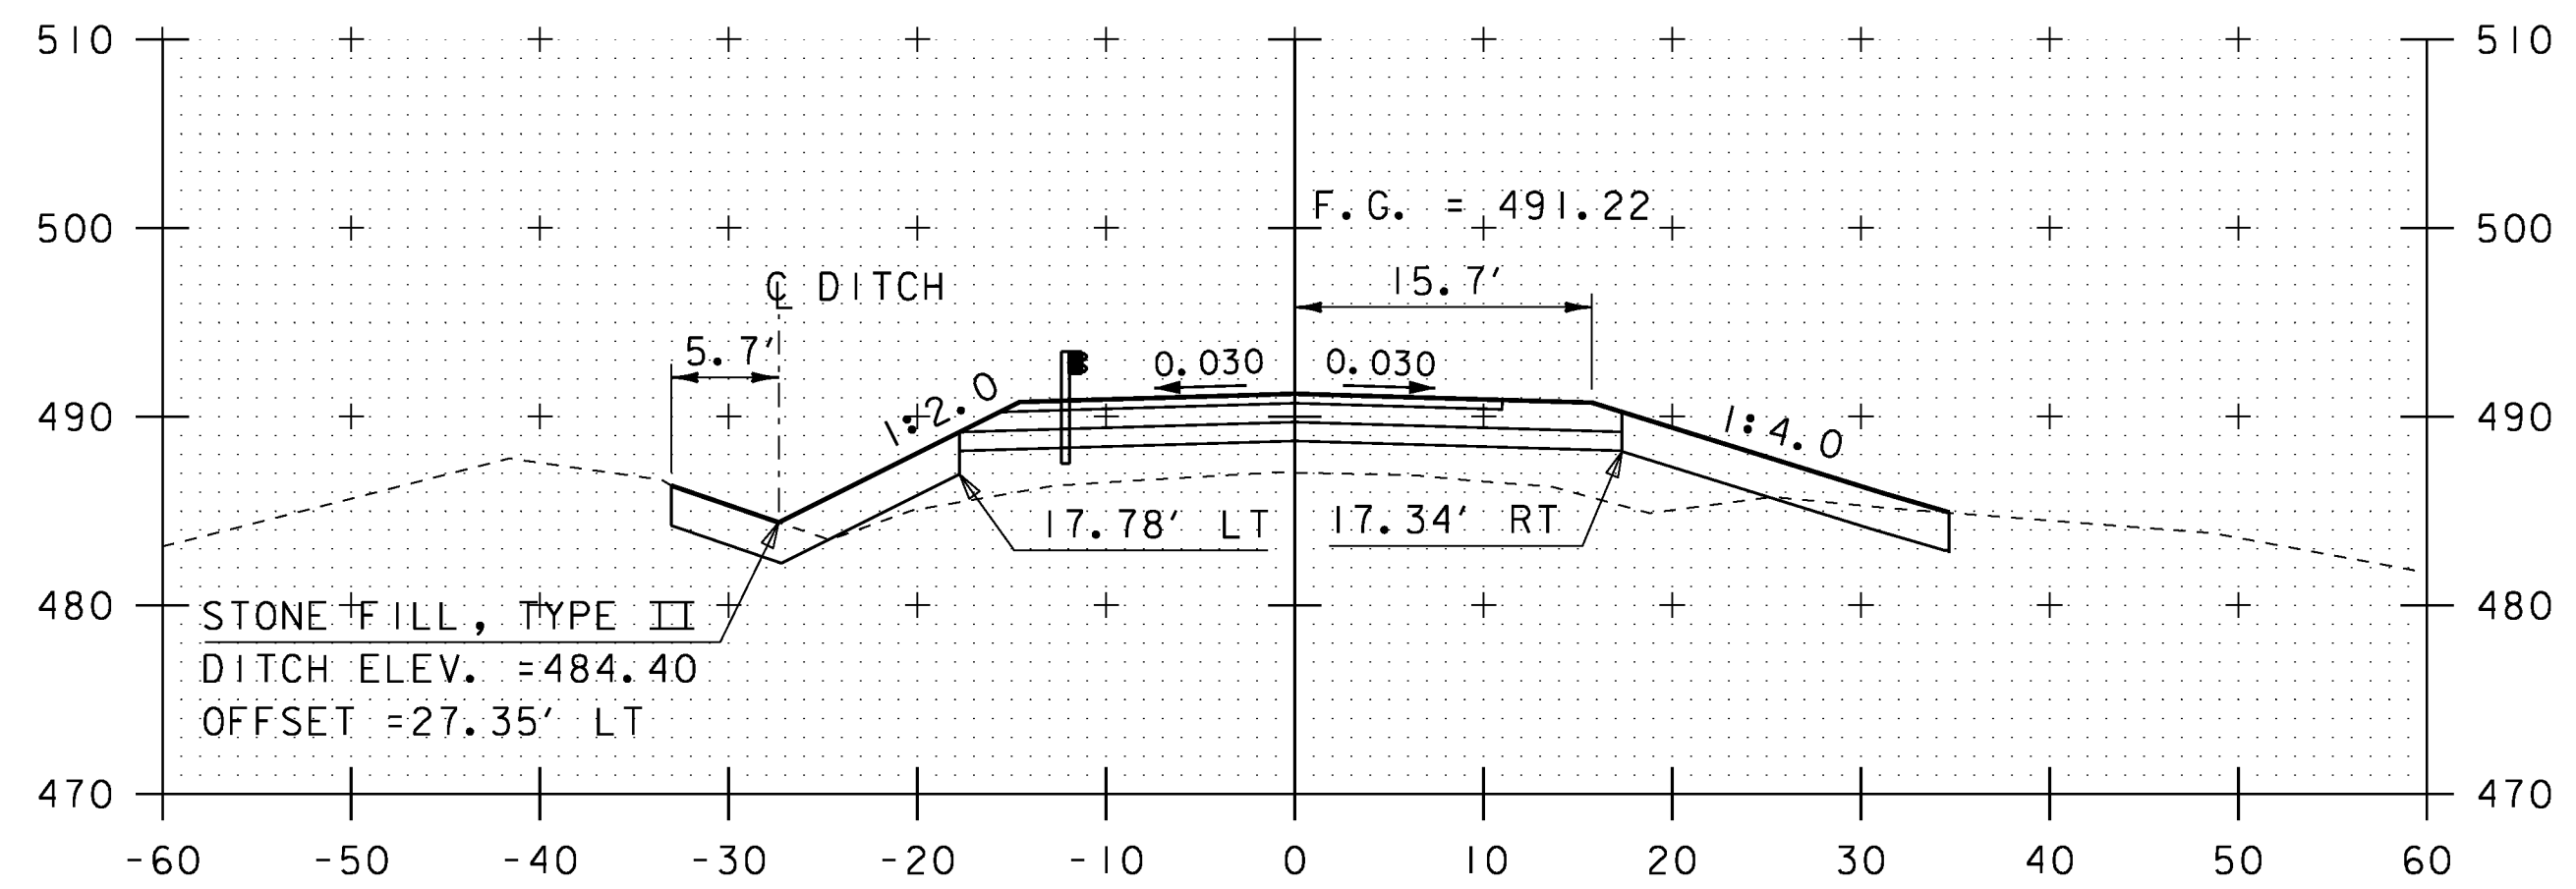

12+50

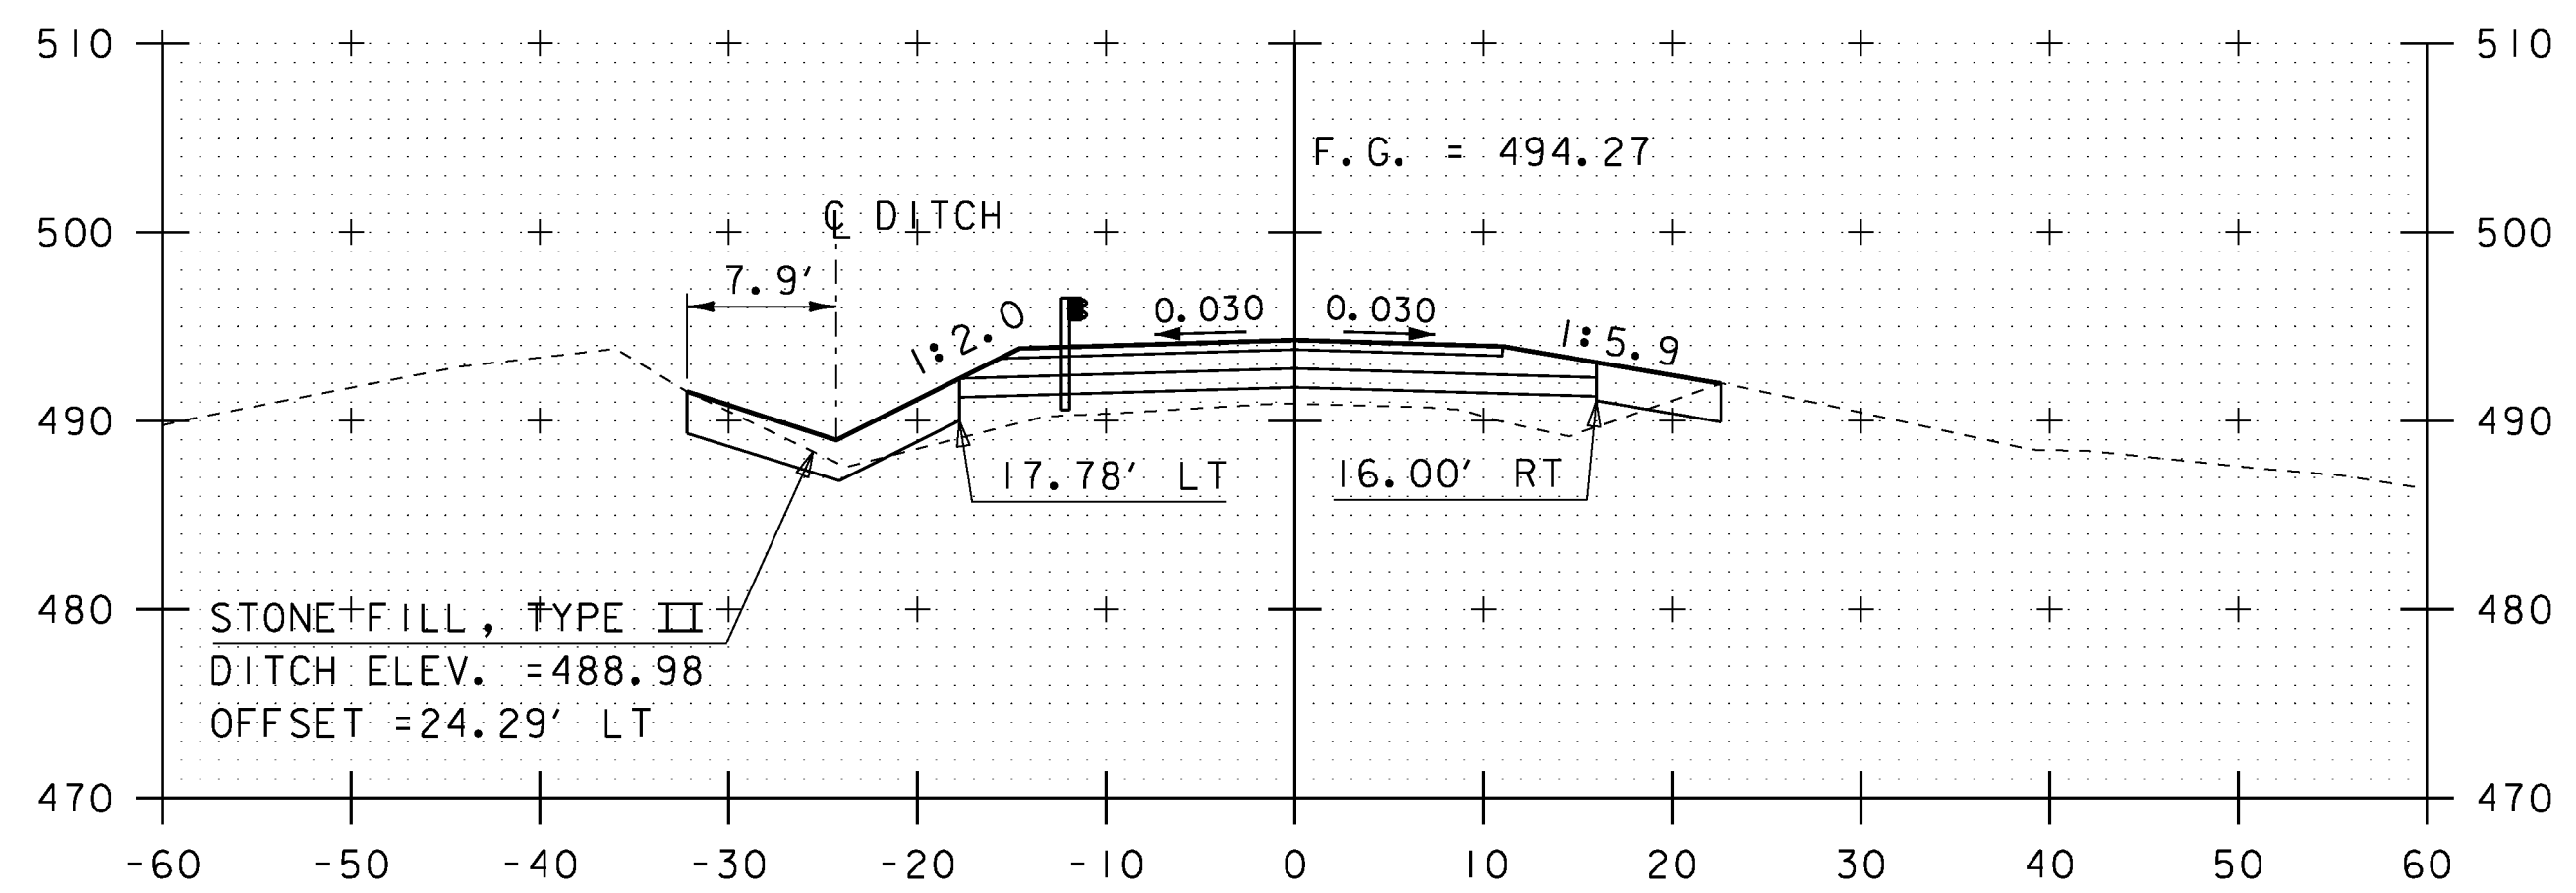

12+25

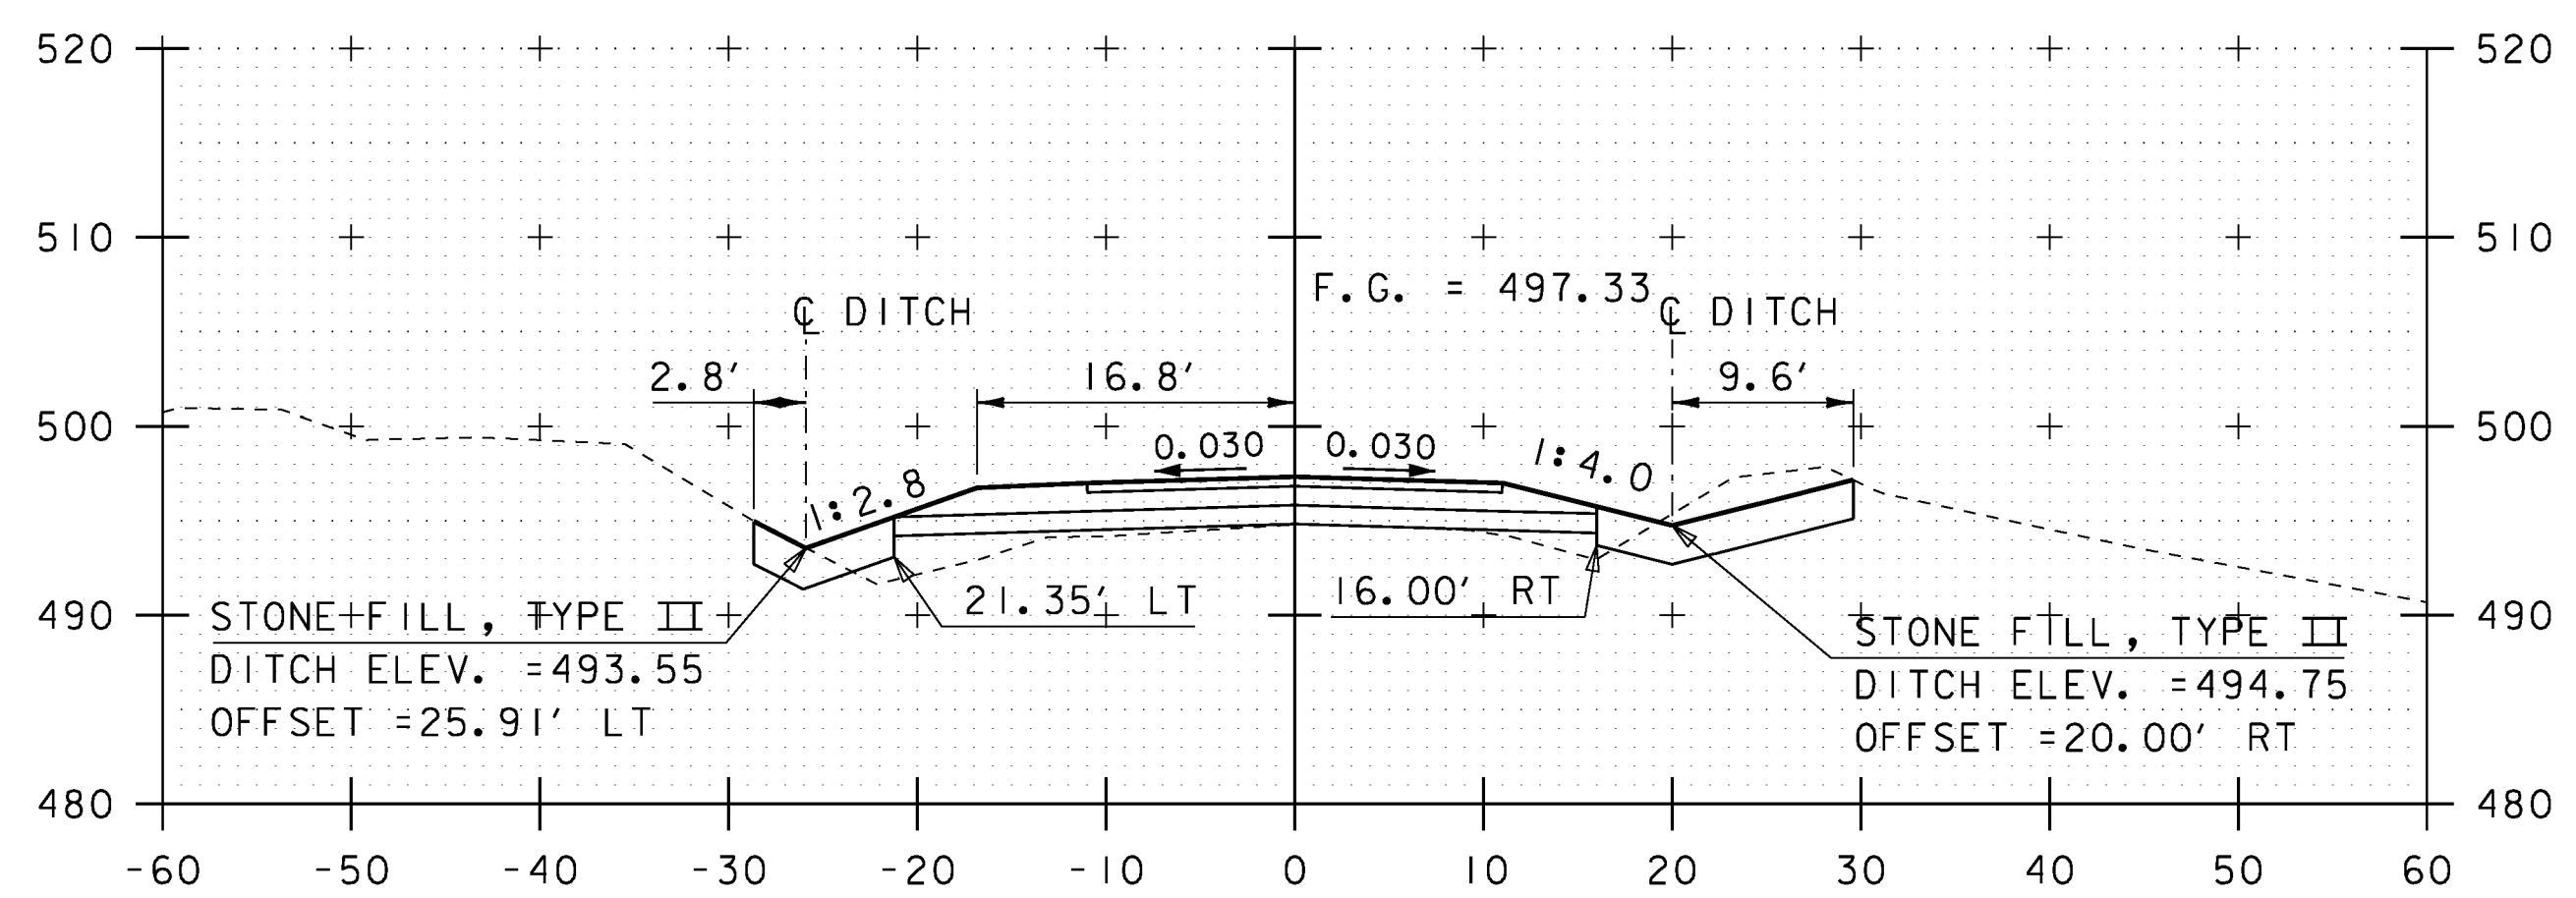

12+00

SCALE 1" = 10'-0"


STA. 11+50 TO STA. 12+50




PROJECT NAME: FAIRFIELD
PROJECT NUMBER: BRO 1448(38)

FILE NAME: z11j072_xsl.dgn
PROJECT LEADER: D. LANDRY
DESIGNED BY: E. ALEXOPOULOS
ROADWAY CROSS SECTIONS (2 OF 6)


PLOT DATE: 01-NOV-2013
DRAWN BY: W. GAYNOR
CHECKED BY: T. KENDRICK
SHEET 35 OF 41

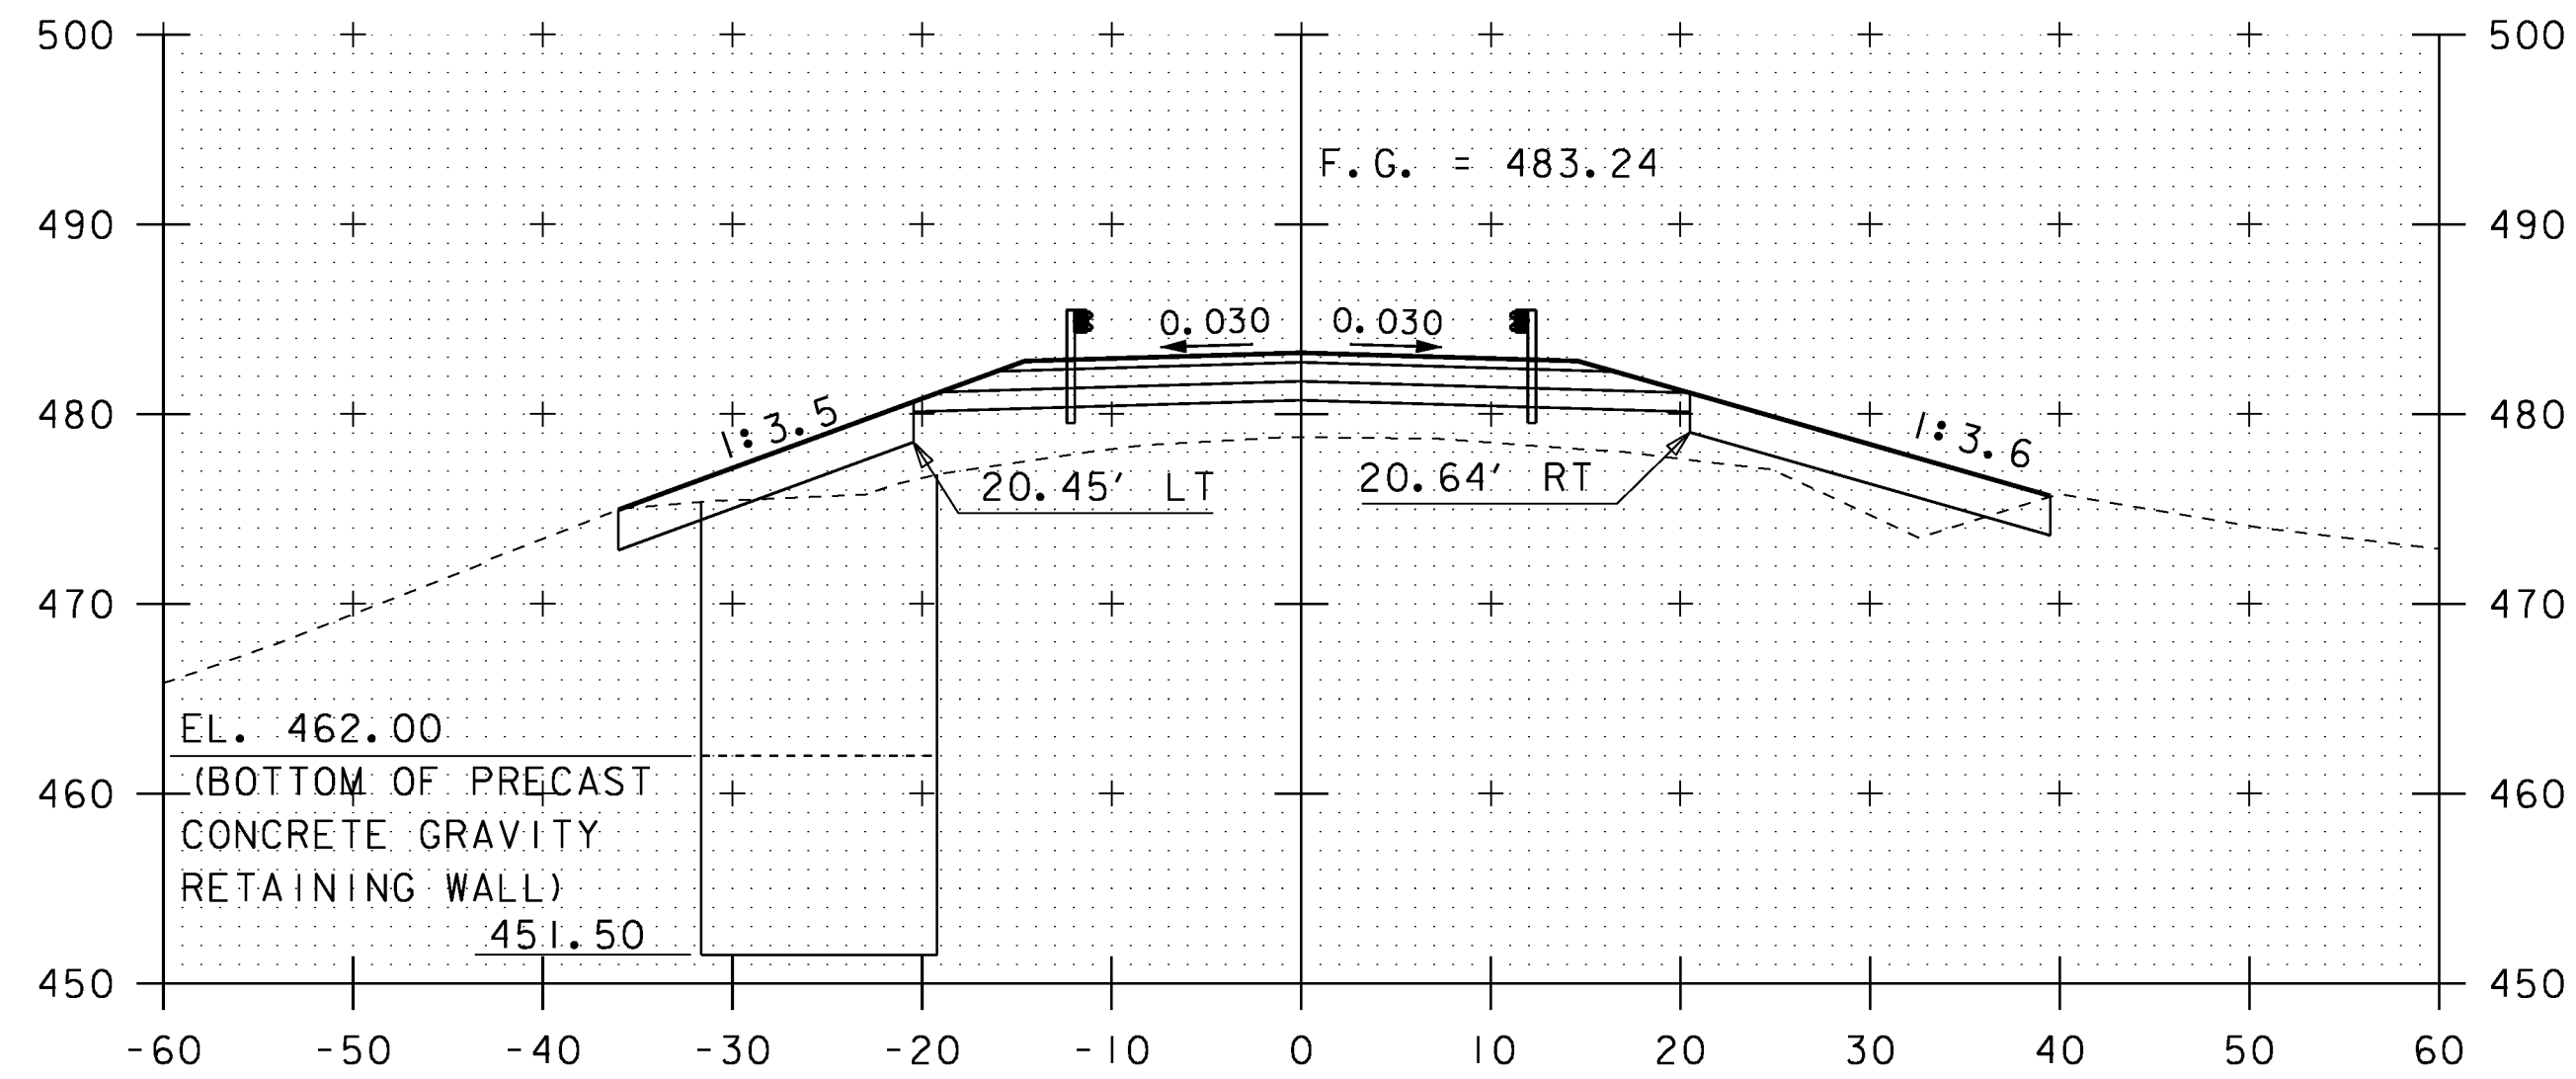


13+25

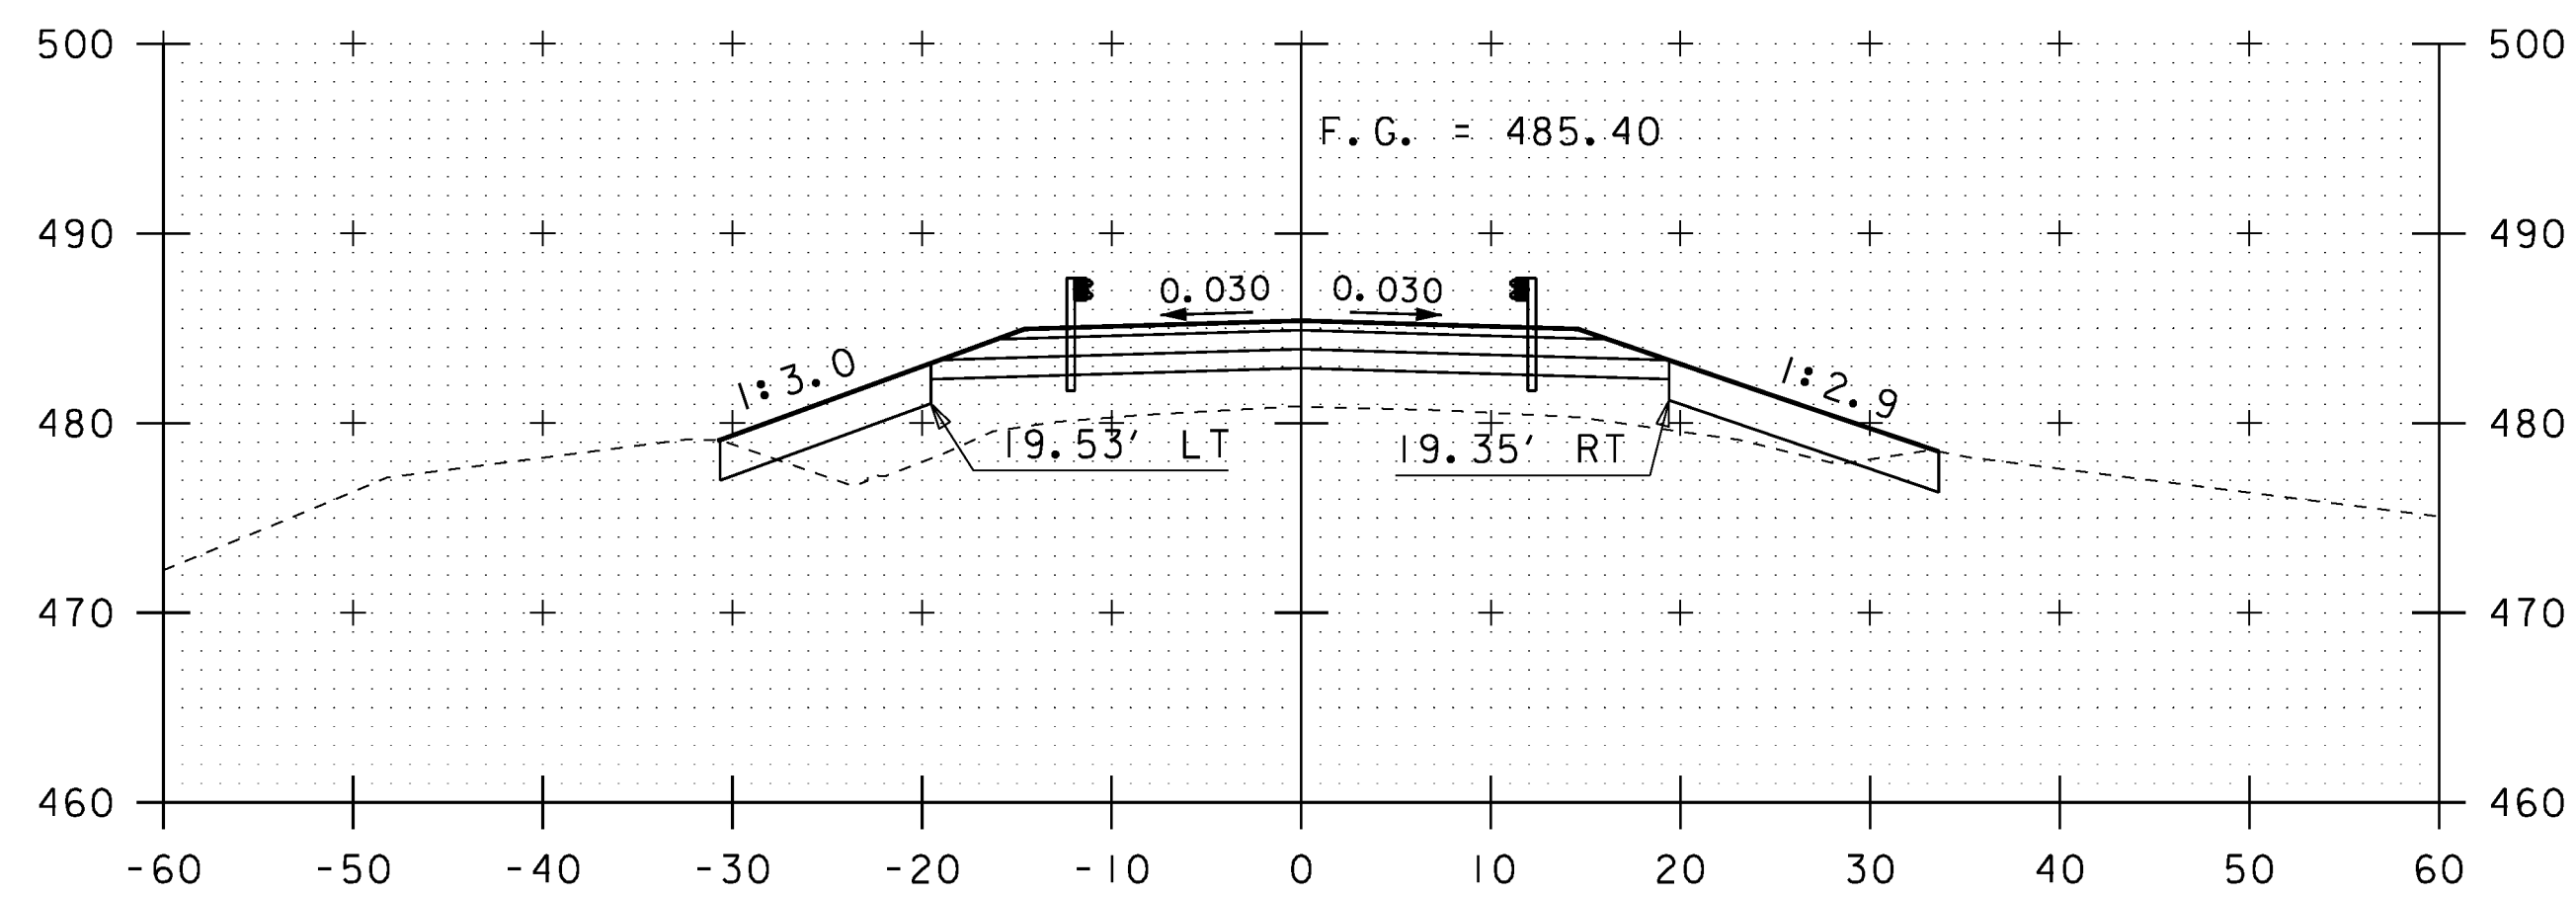


13+00

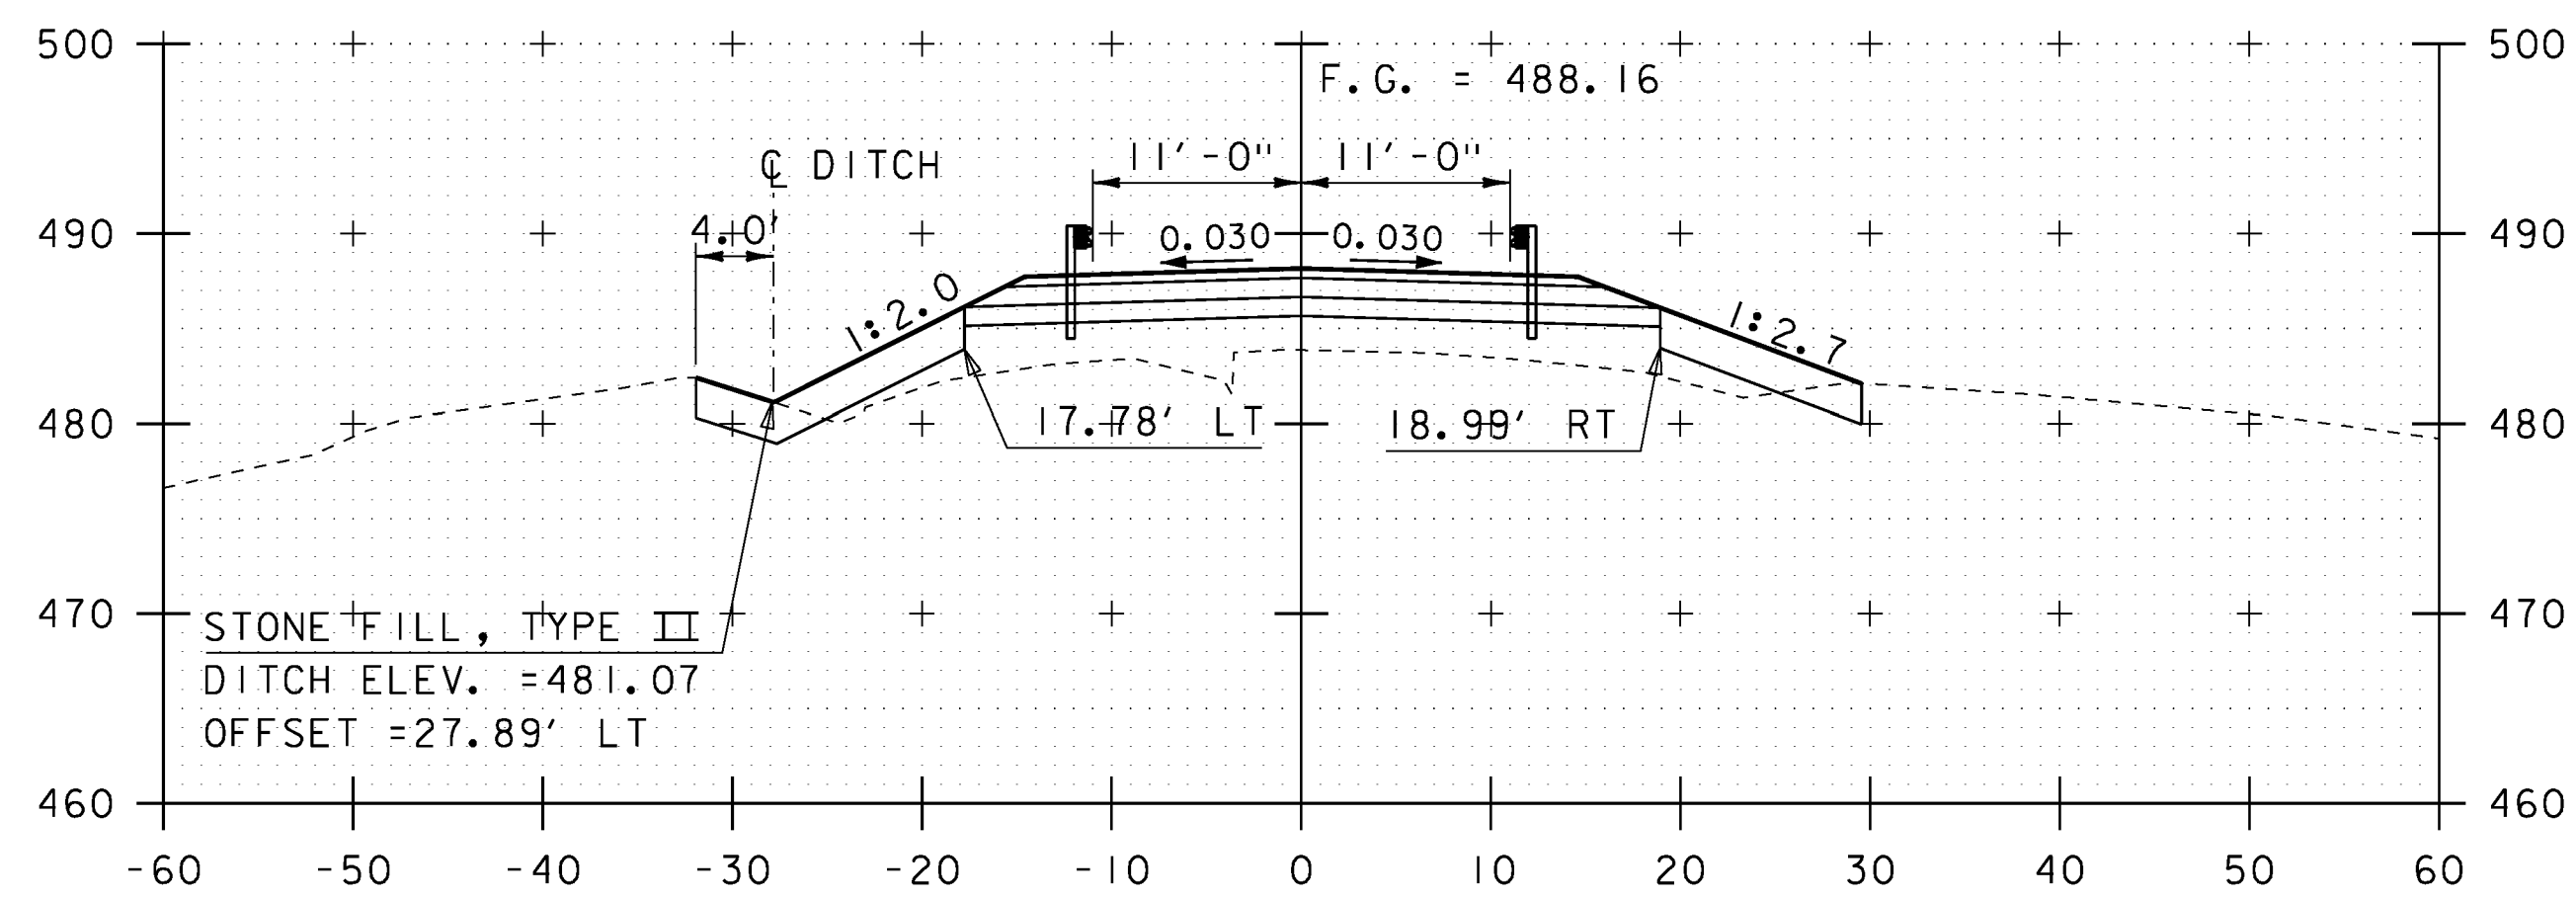

12+75

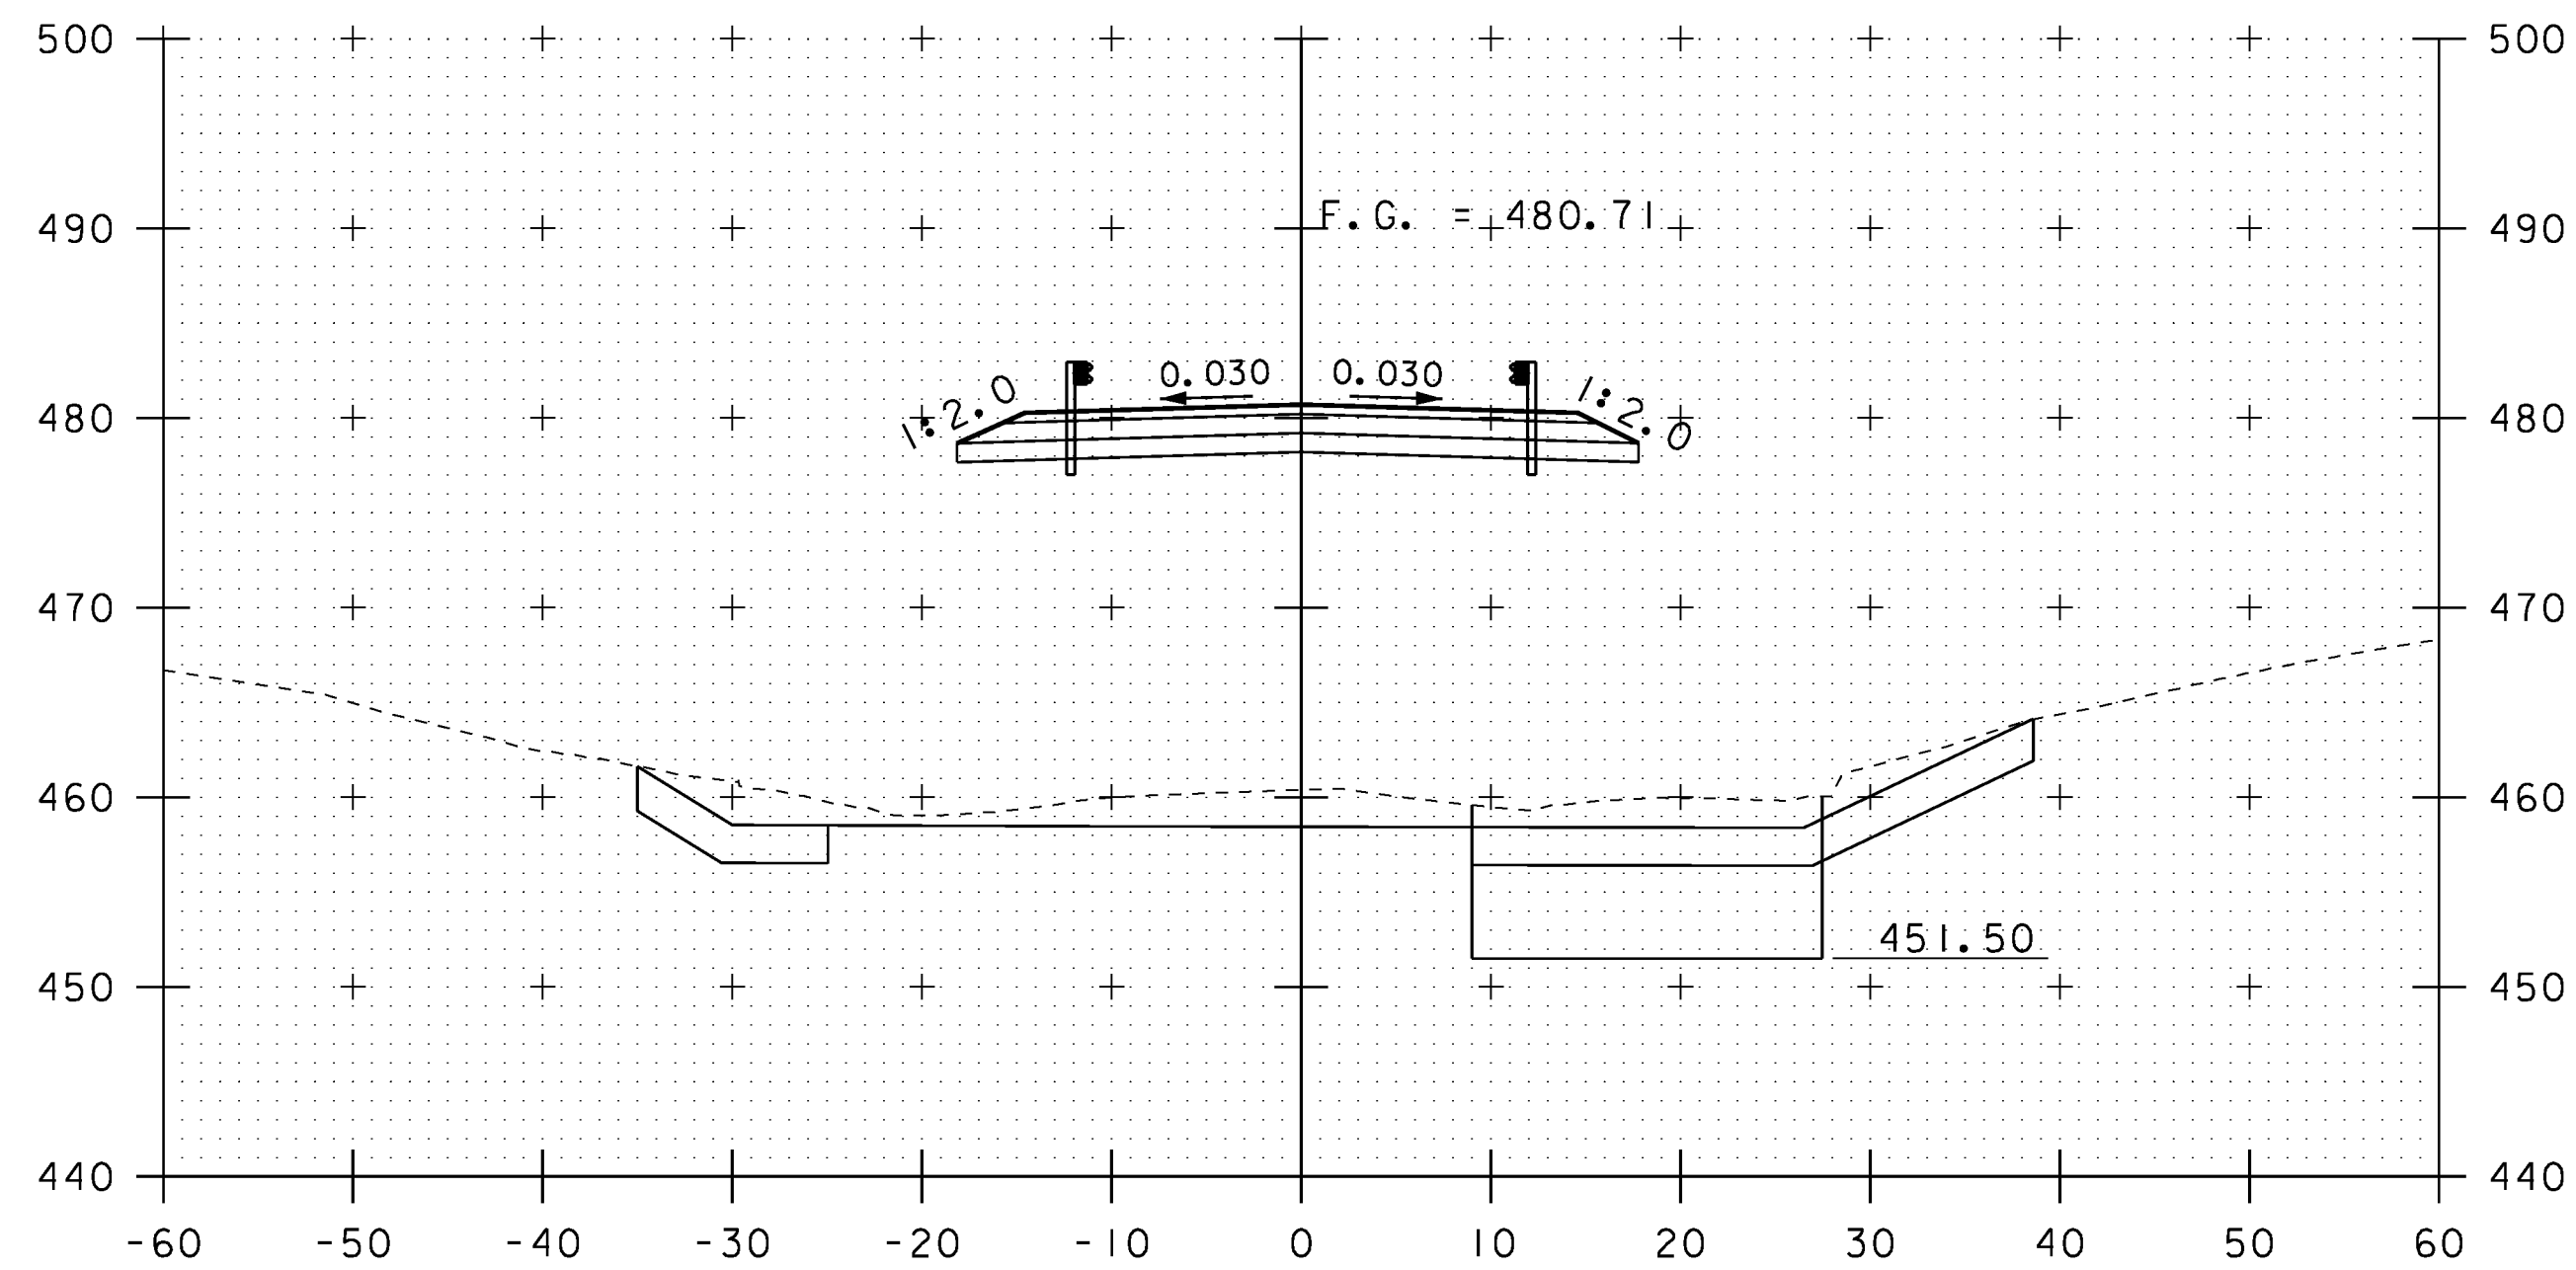

13+75
BEGIN BRIDGE
STA 13+60.66

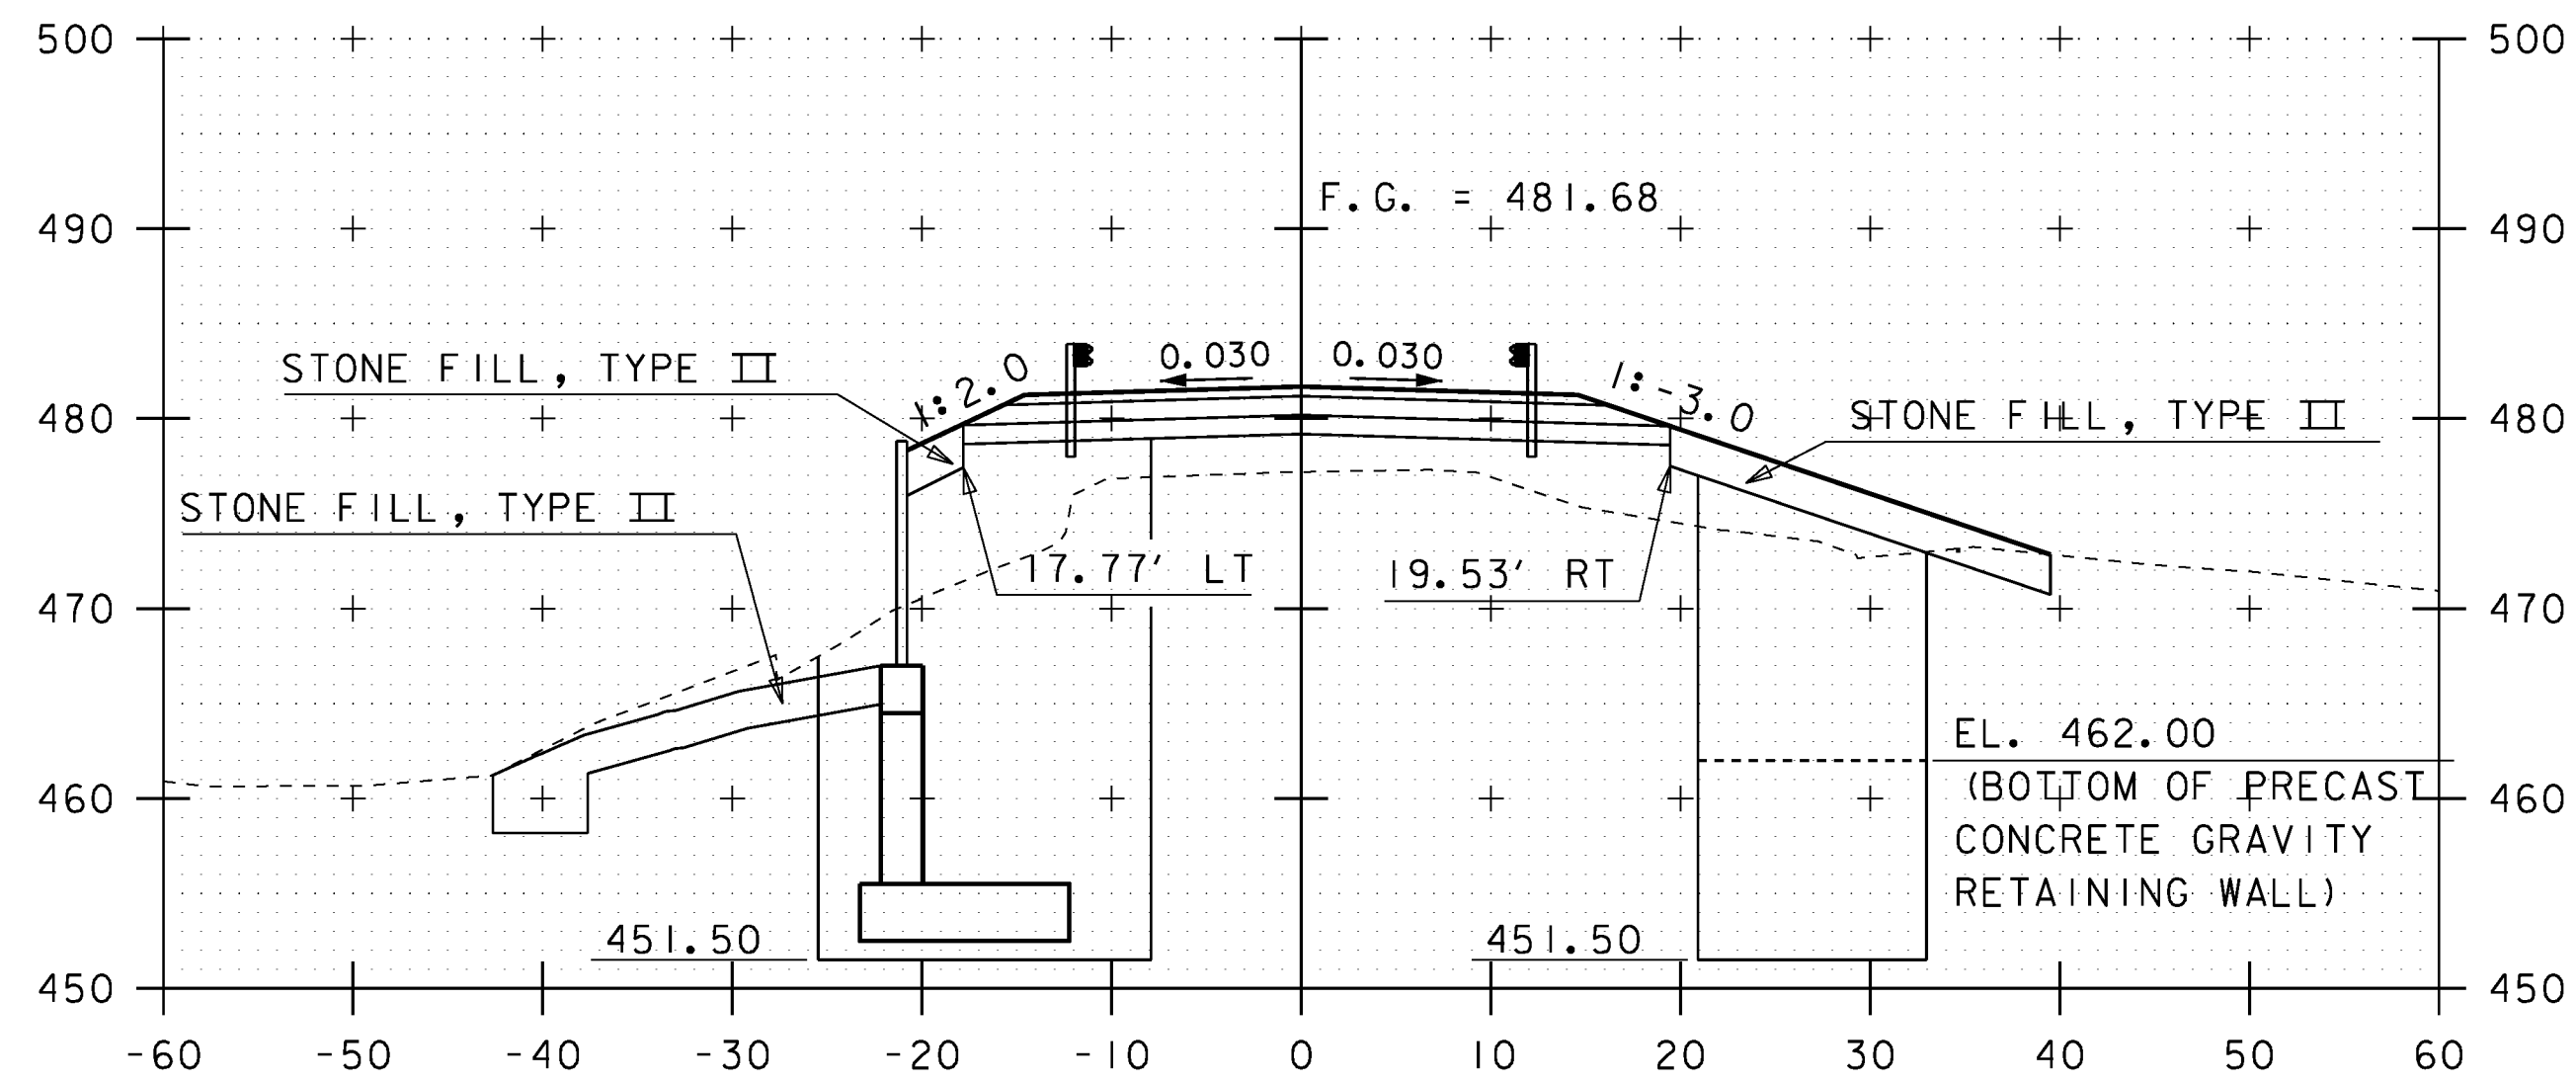

13+50

SCALE 1" = 10'-0"
10 0 10


STA. 12+75 TO STA. 13+75




PROJECT NAME: FAIRFIELD
PROJECT NUMBER: BRO 1448(38)

FILE NAME: z11j072_xsl.dgn
PROJECT LEADER: D. LANDRY
DESIGNED BY: E. ALEXOPOULOS
ROADWAY CROSS SECTIONS (3 OF 6)

PLOT DATE: 01-NOV-2013
DRAWN BY: W. GAYNOR
CHECKED BY: T. KENDRICK
SHEET 36 OF 41

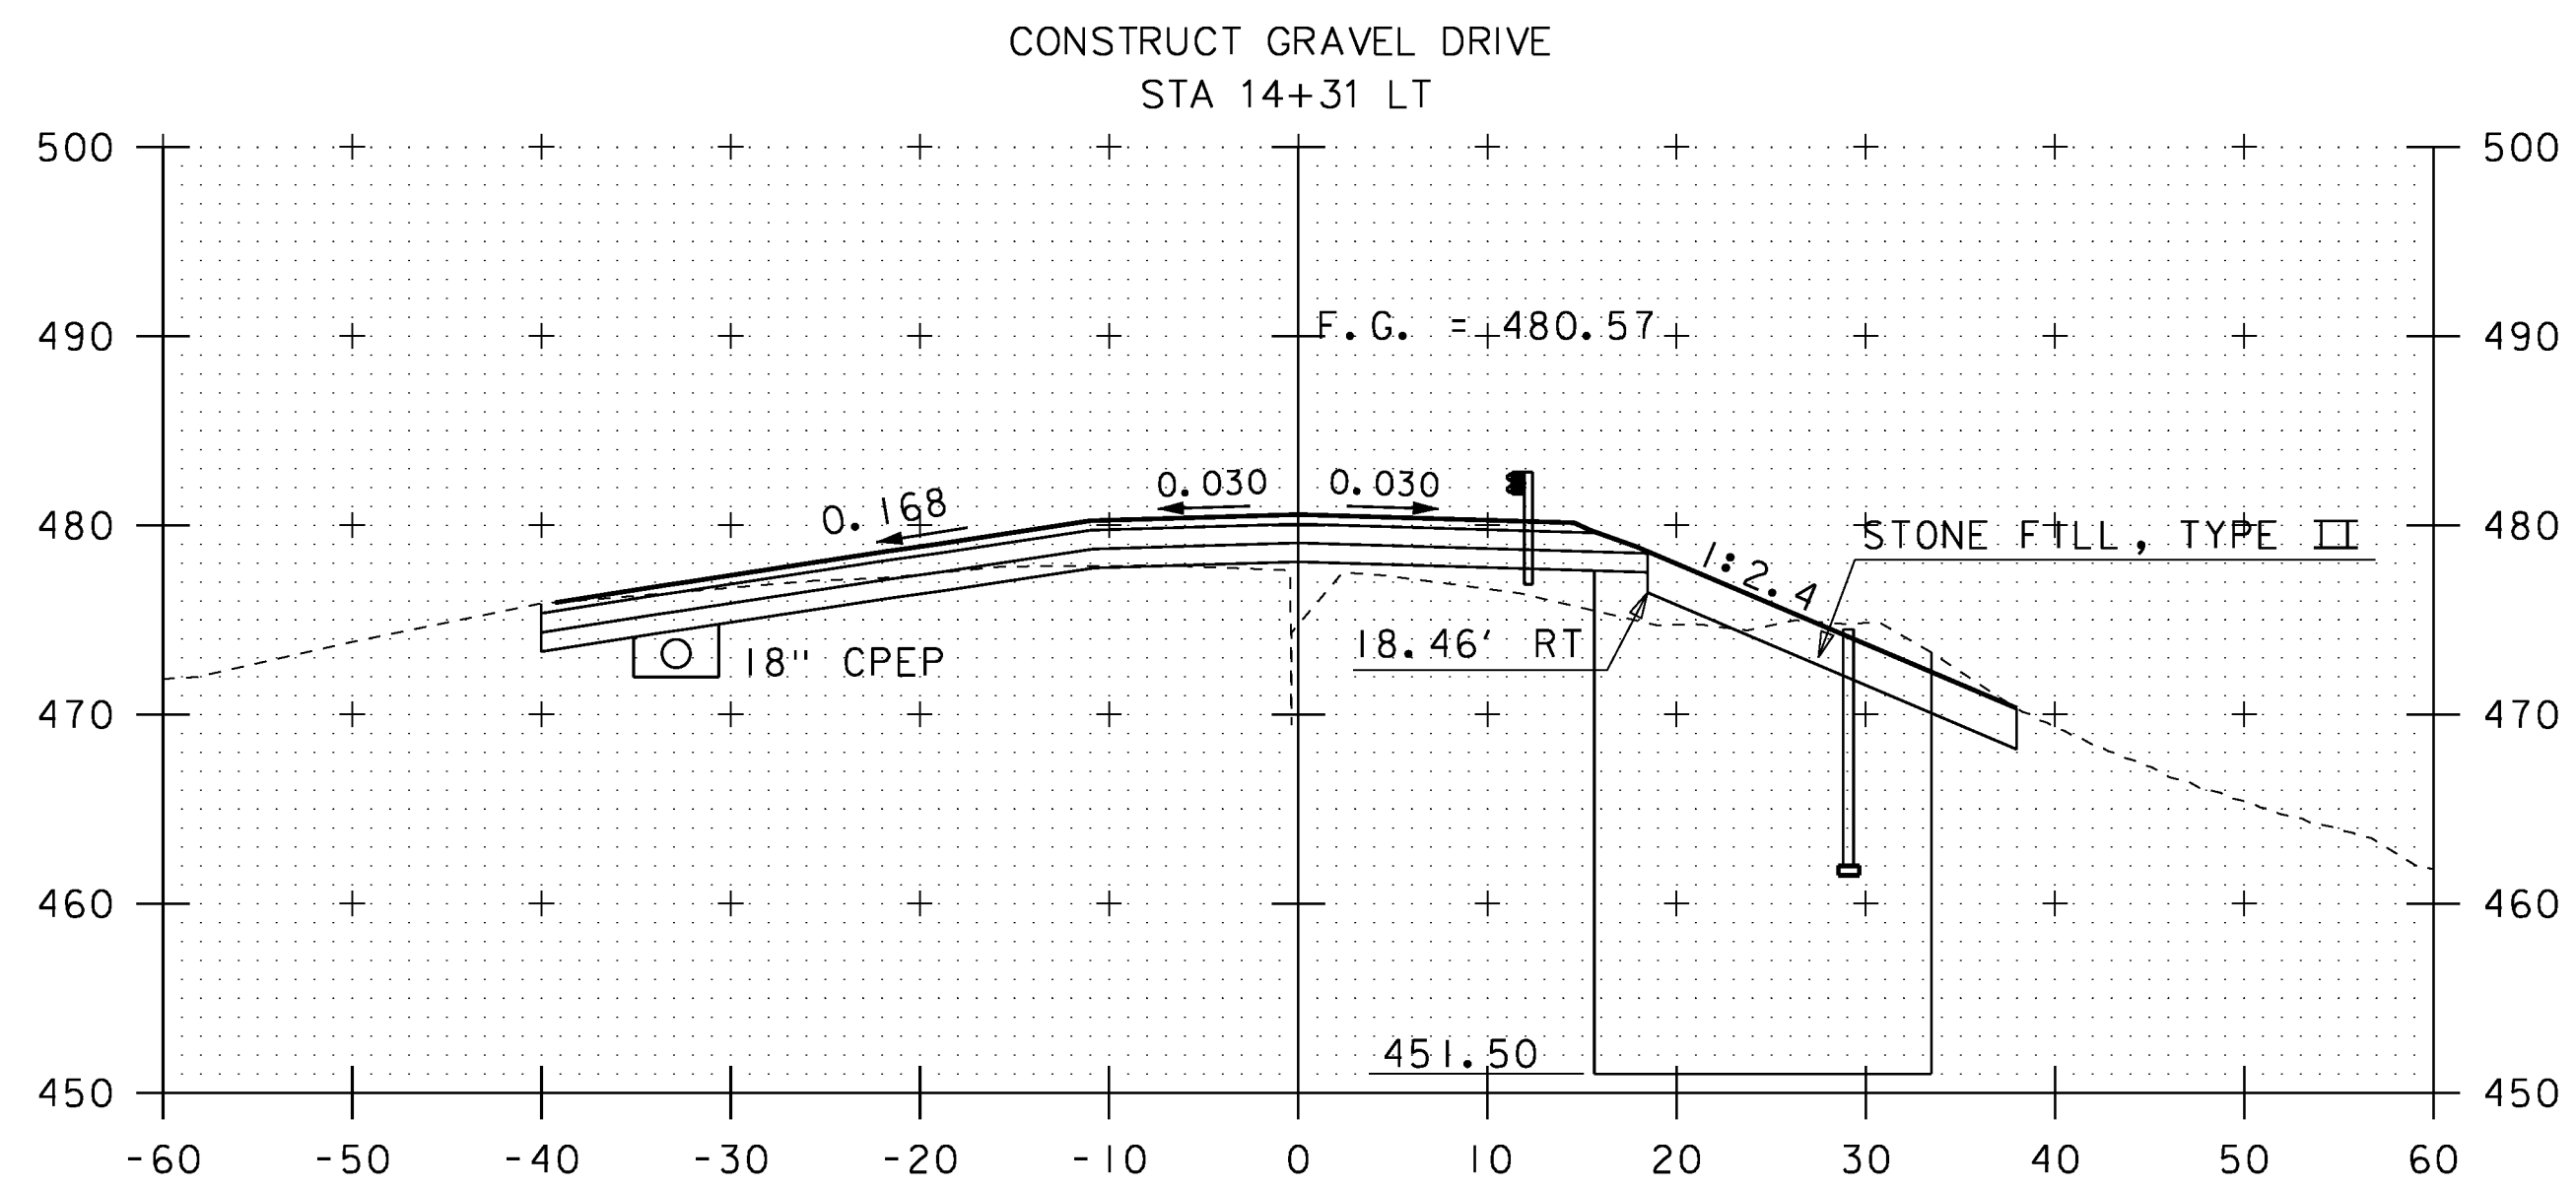


14+25

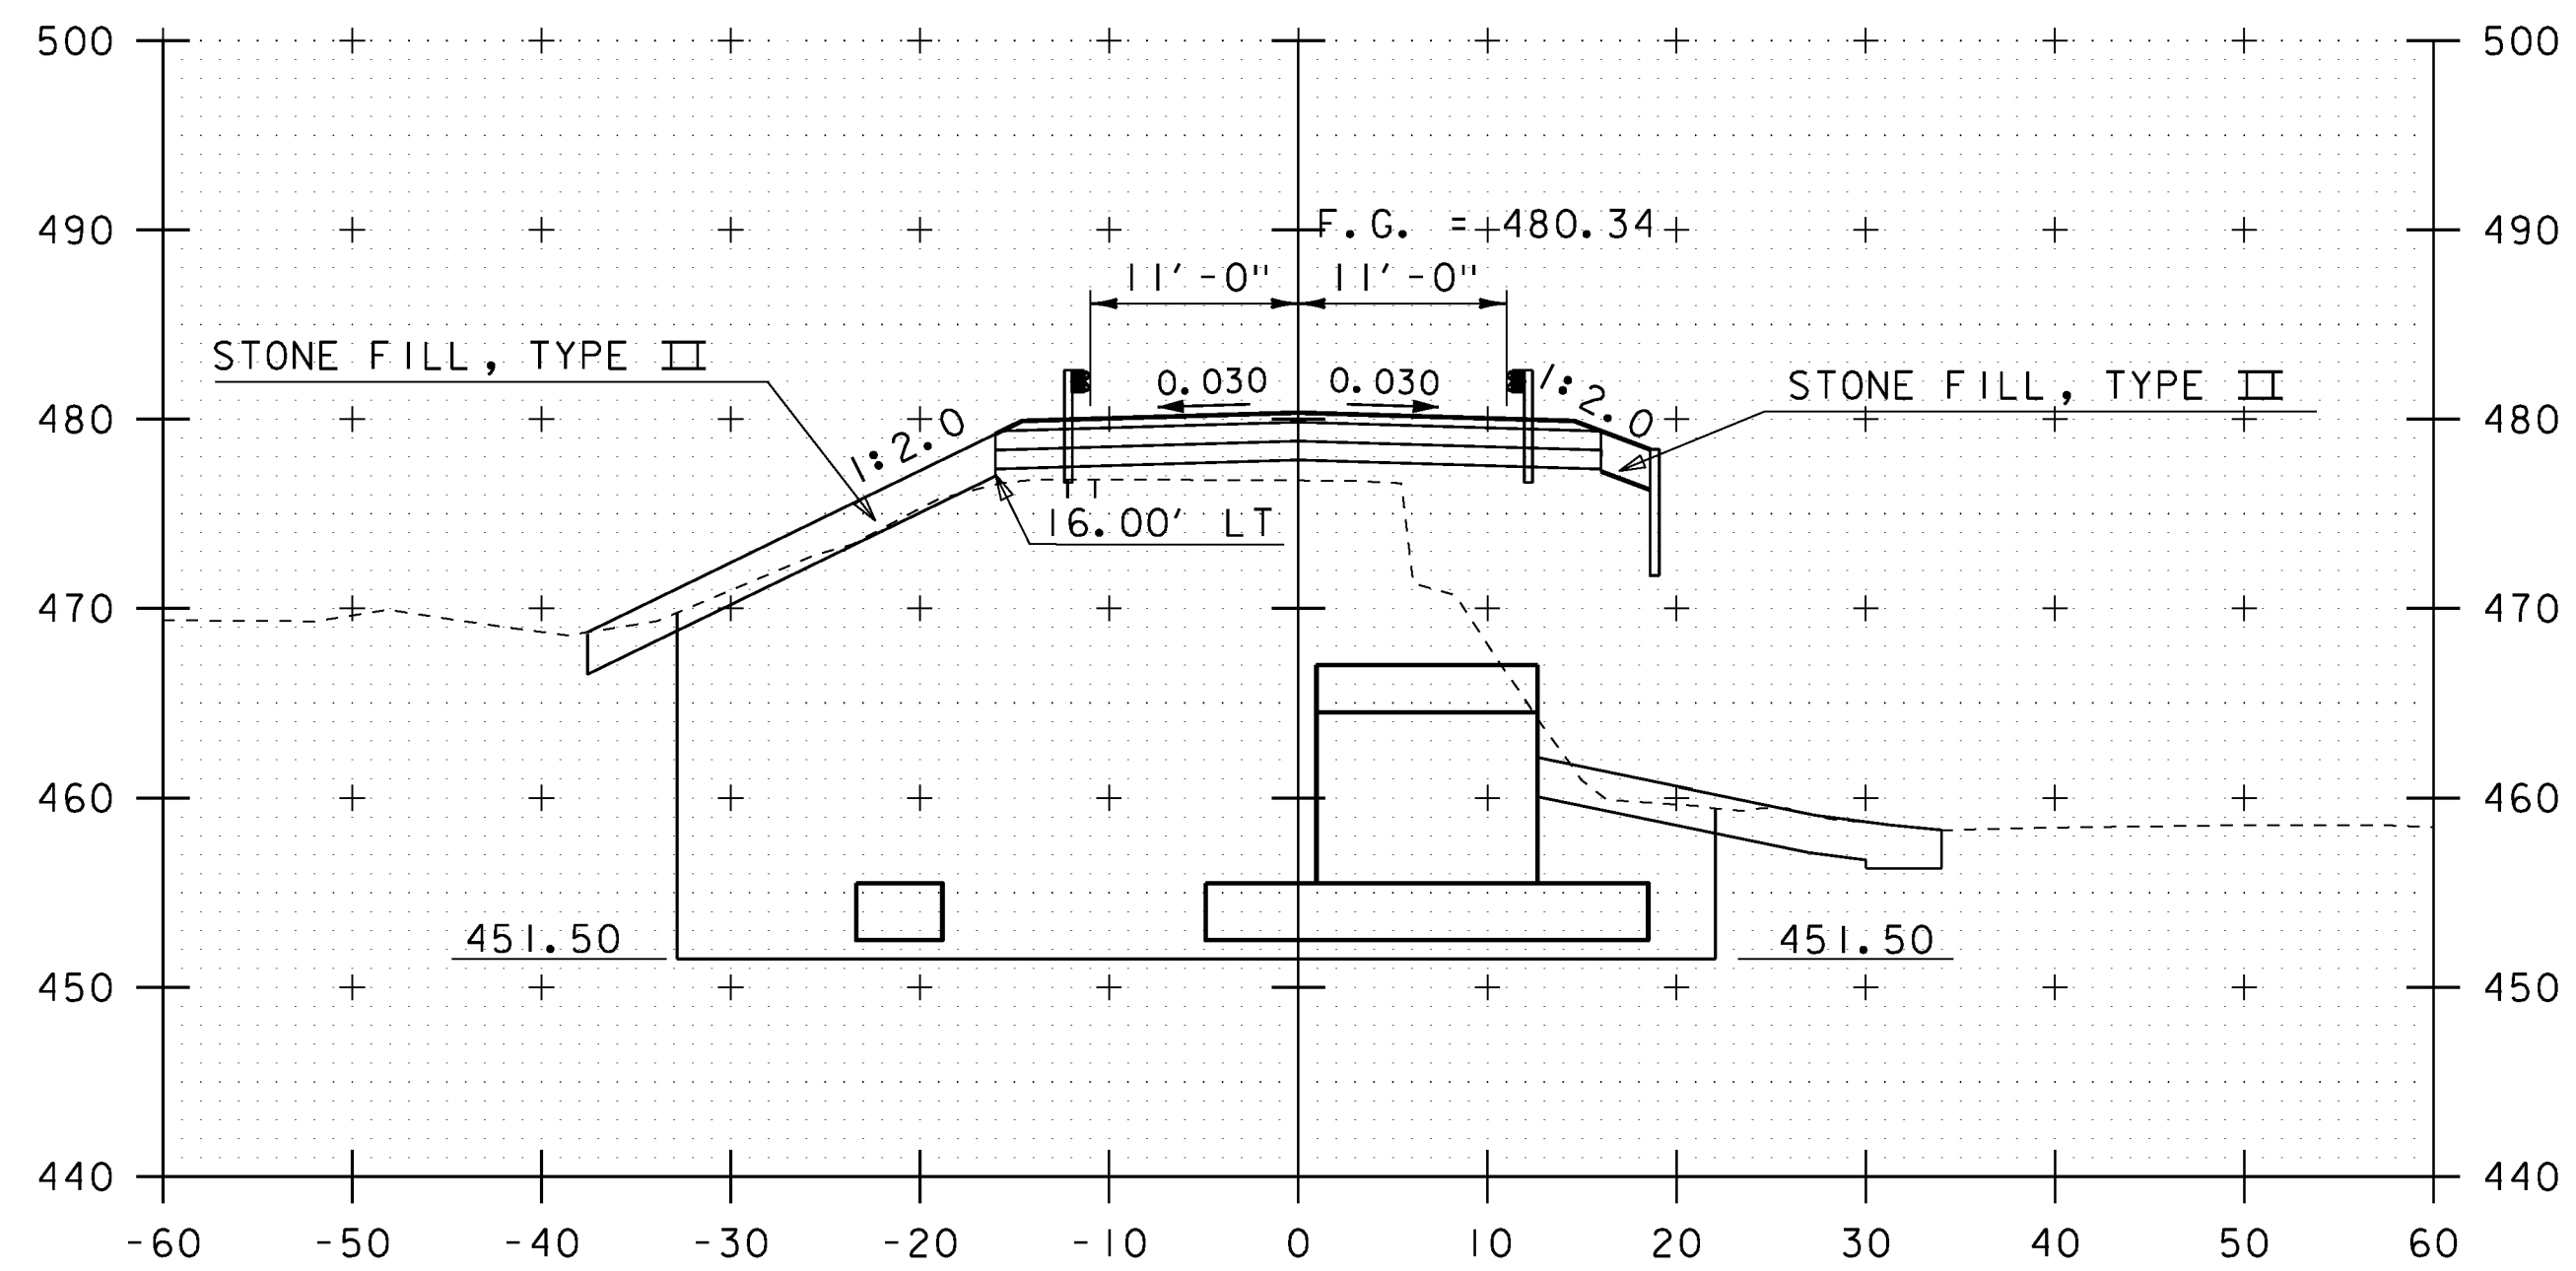


14+00


END BRIDGE
STA 13+96.84

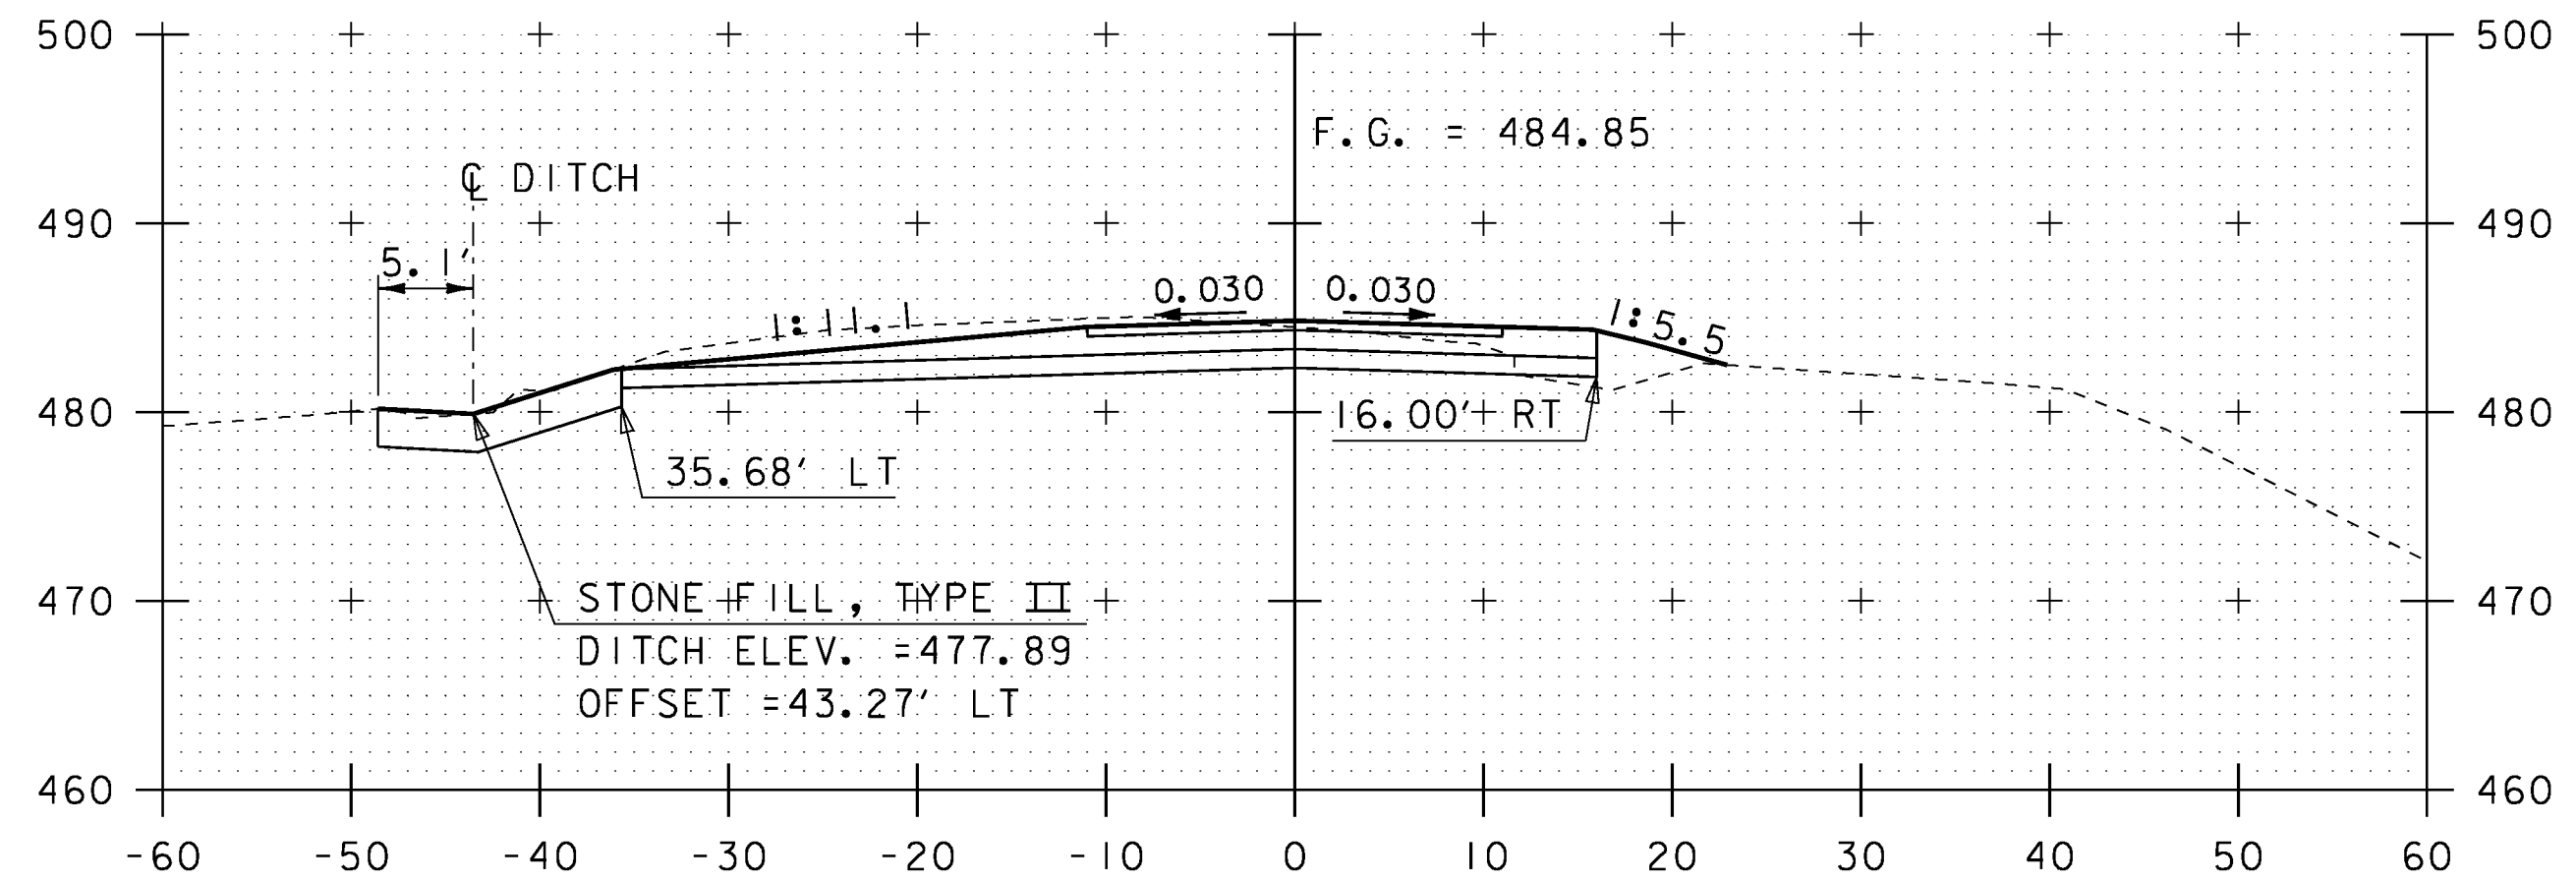

15+00

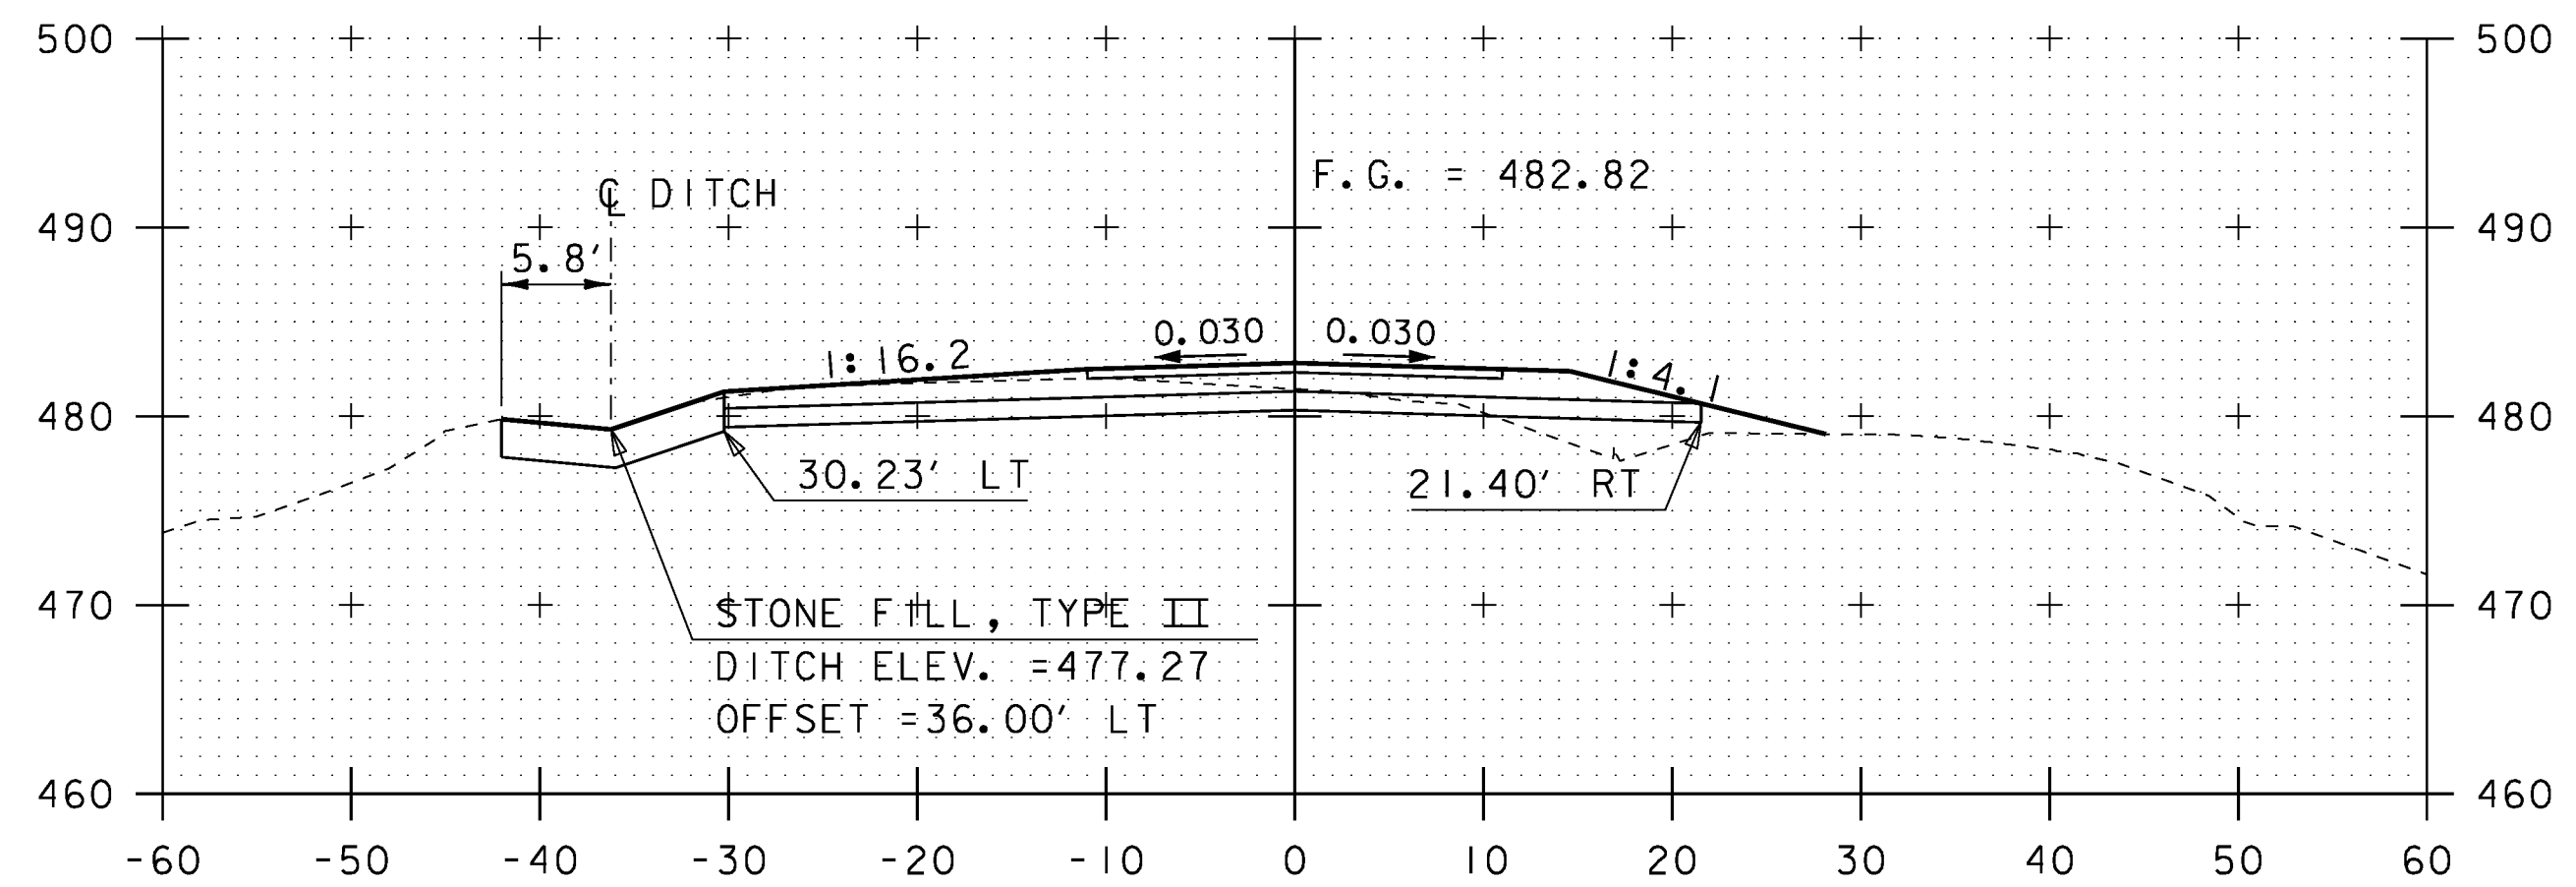

14+75

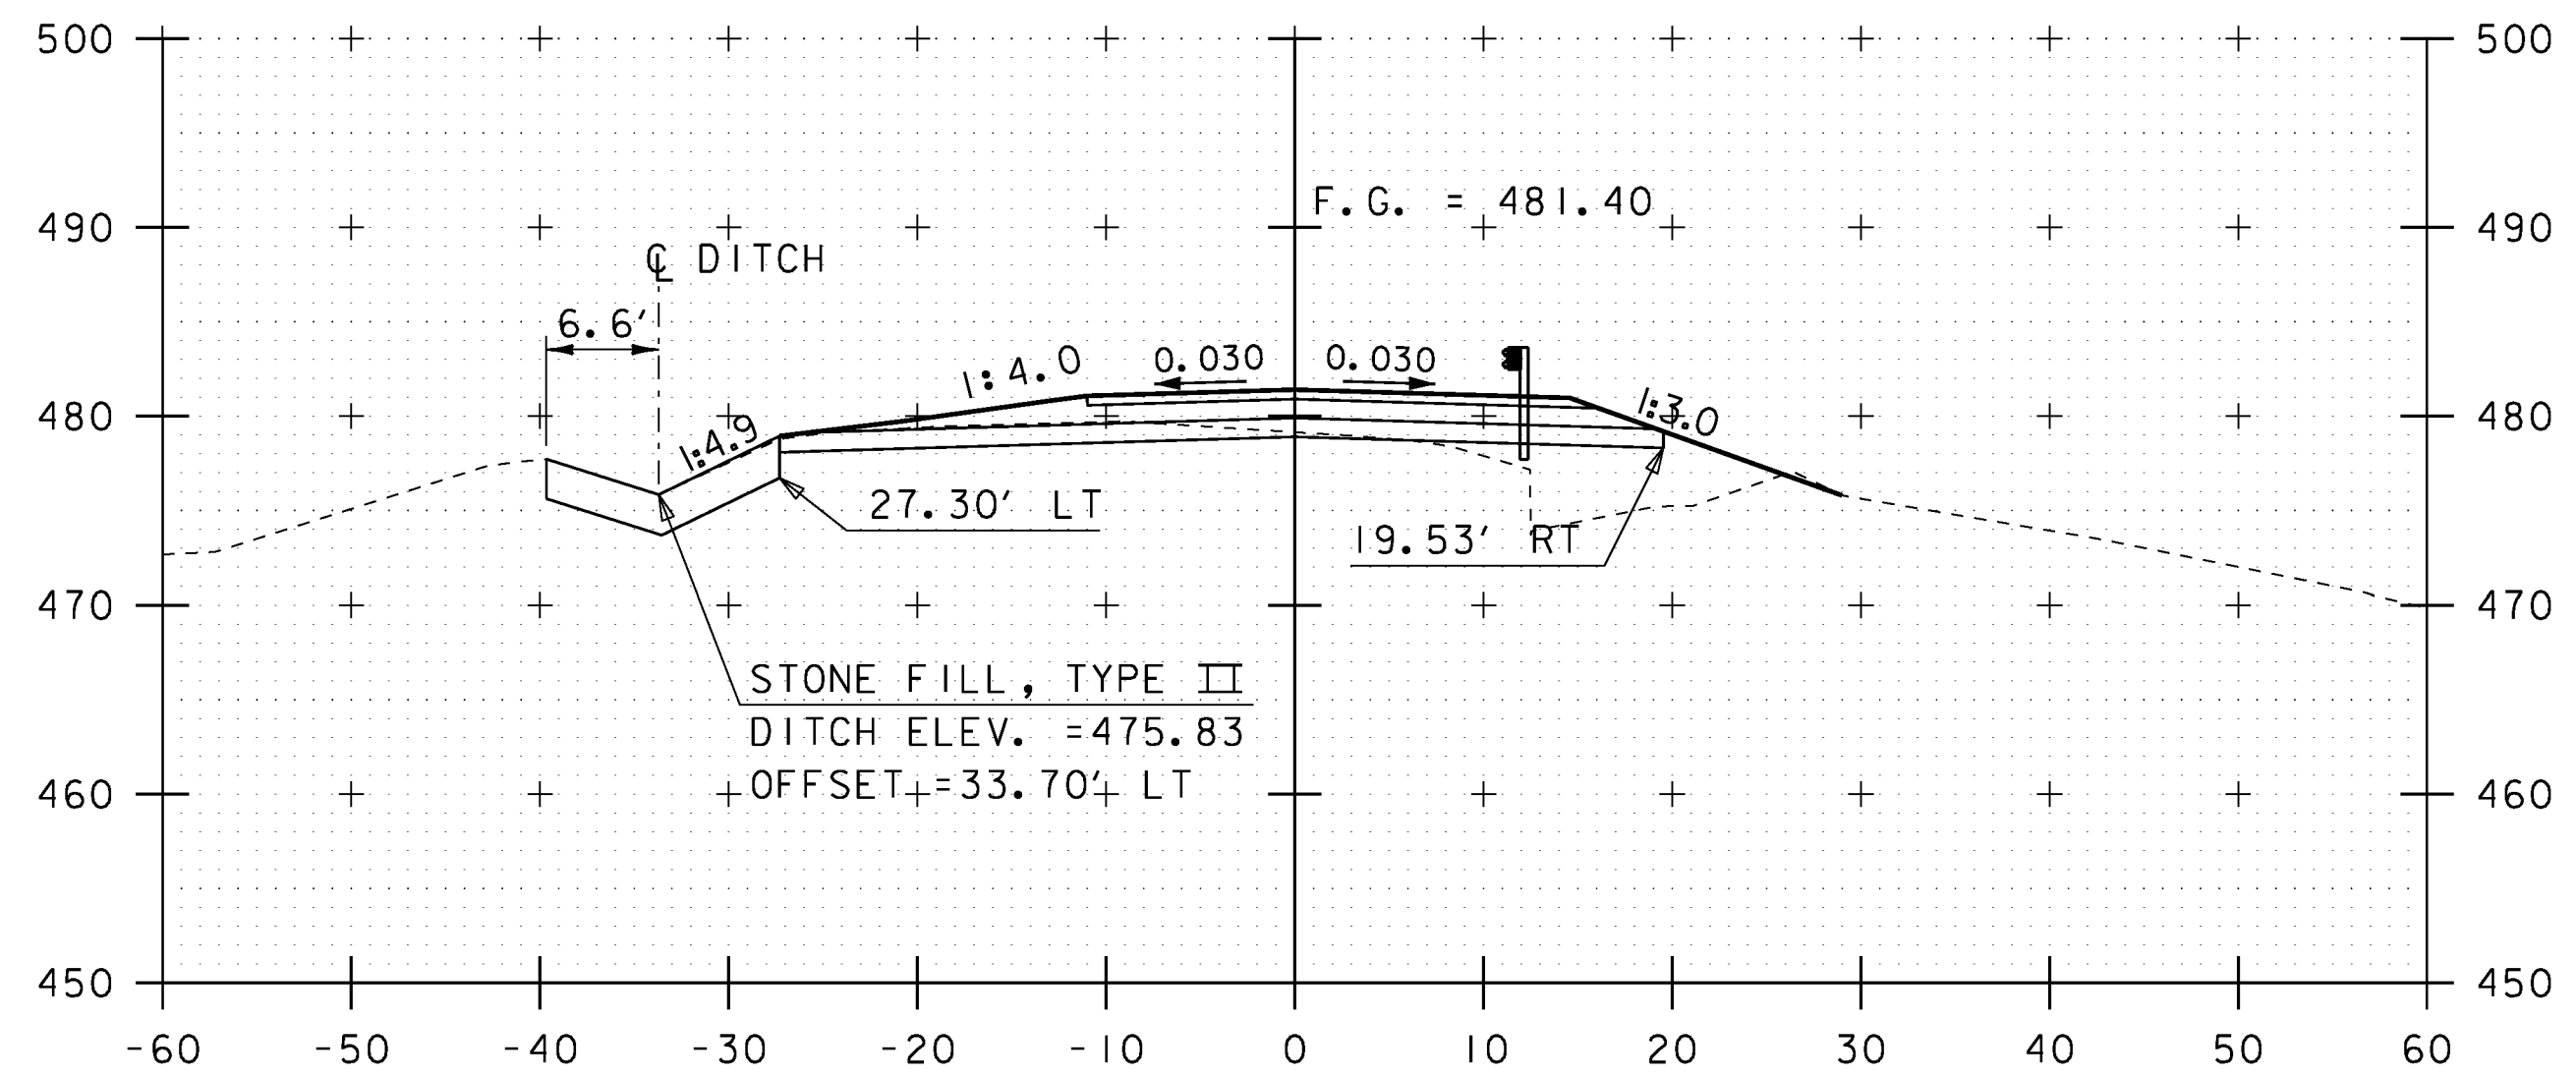

14+50


SCALE 1" = 10'-0"
10 0 10

STA. 14+00 TO STA. 15+00




PROJECT NAME: FAIRFIELD
PROJECT NUMBER: BRO 1448(38)
FILE NAME: z1j072_xsl.dgn
PROJECT LEADER: D. LANDRY
DESIGNED BY: E. ALEXOPOULOS
ROADWAY CROSS SECTIONS (4 OF 6)

PLOT DATE: 01-NOV-2013
DRAWN BY: W. GAYNOR
CHECKED BY: T. KENDRICK
SHEET 37 OF 41

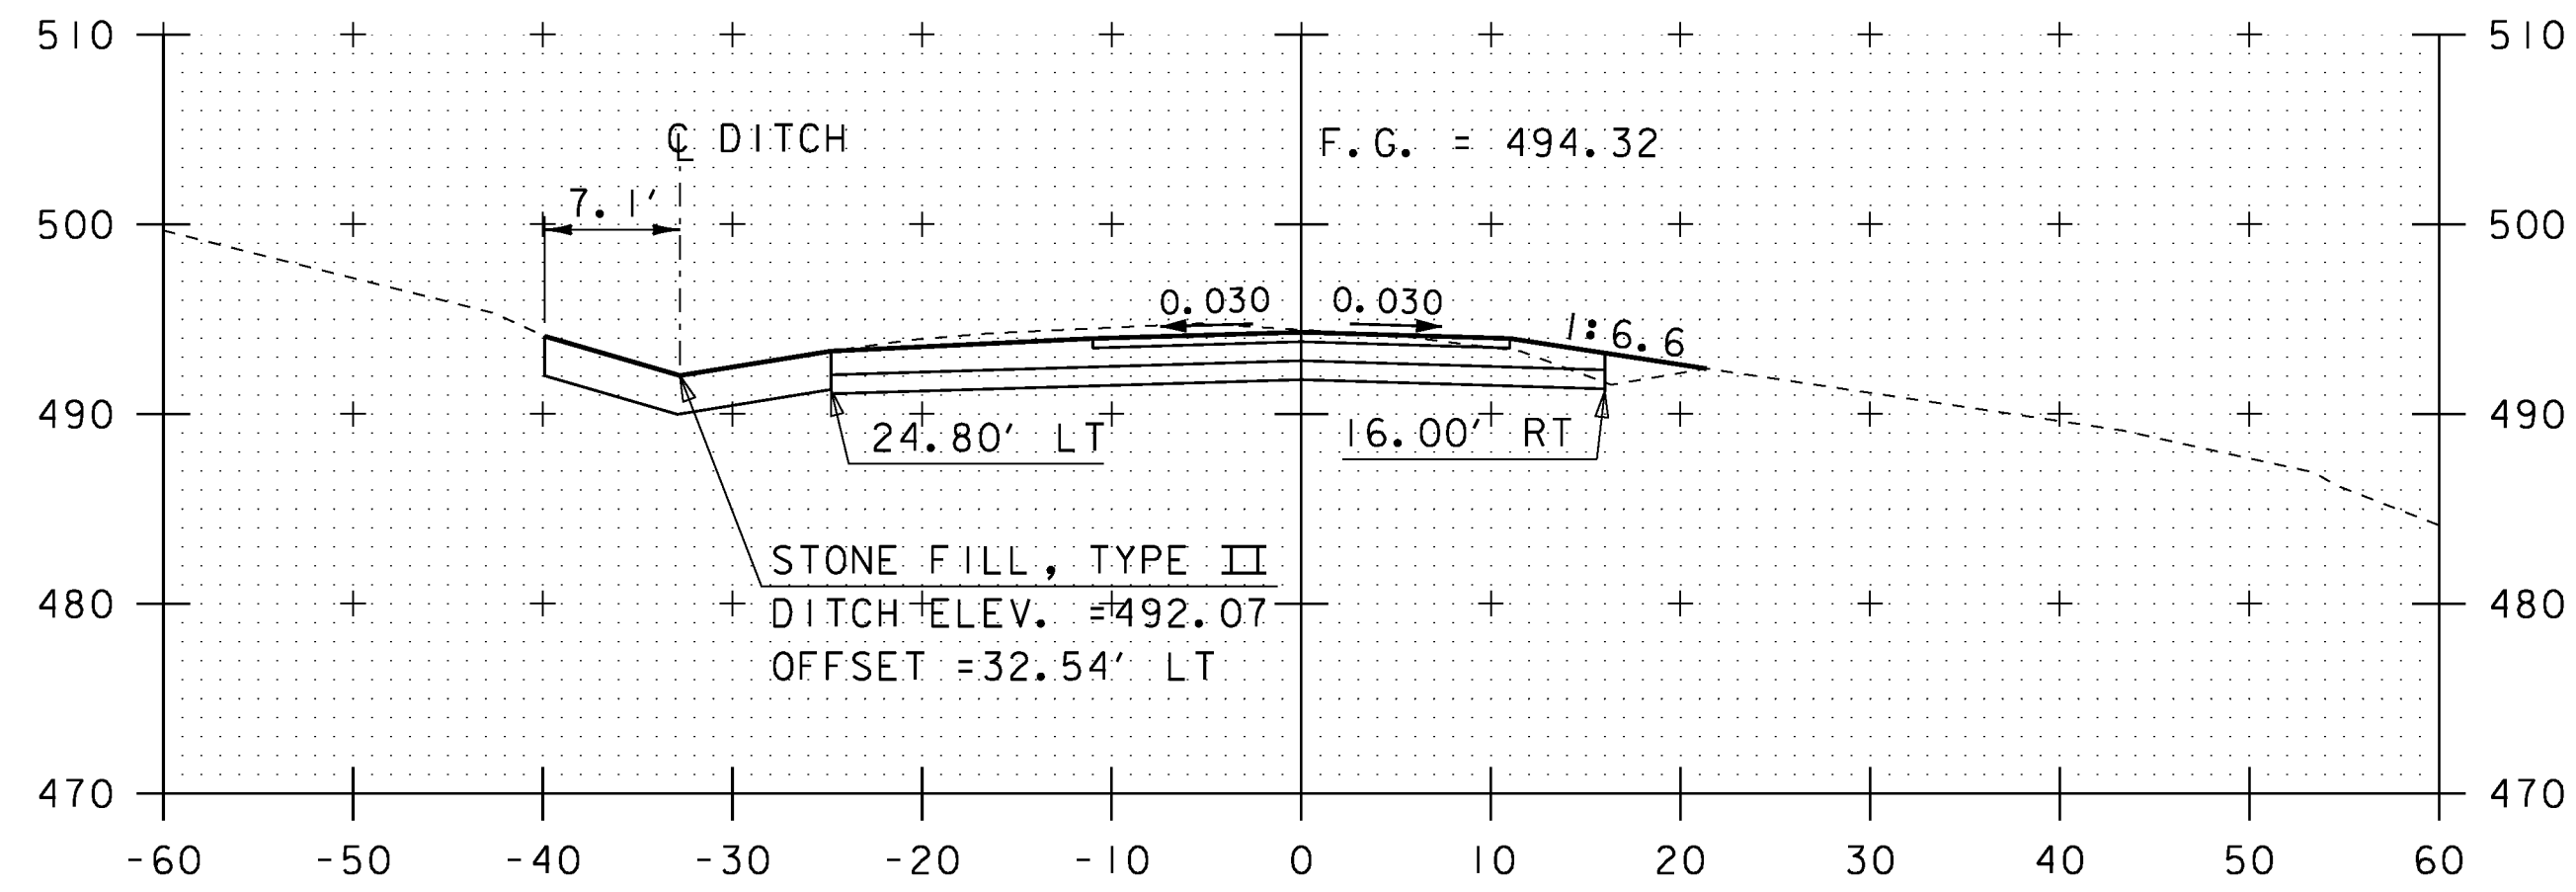


15+75

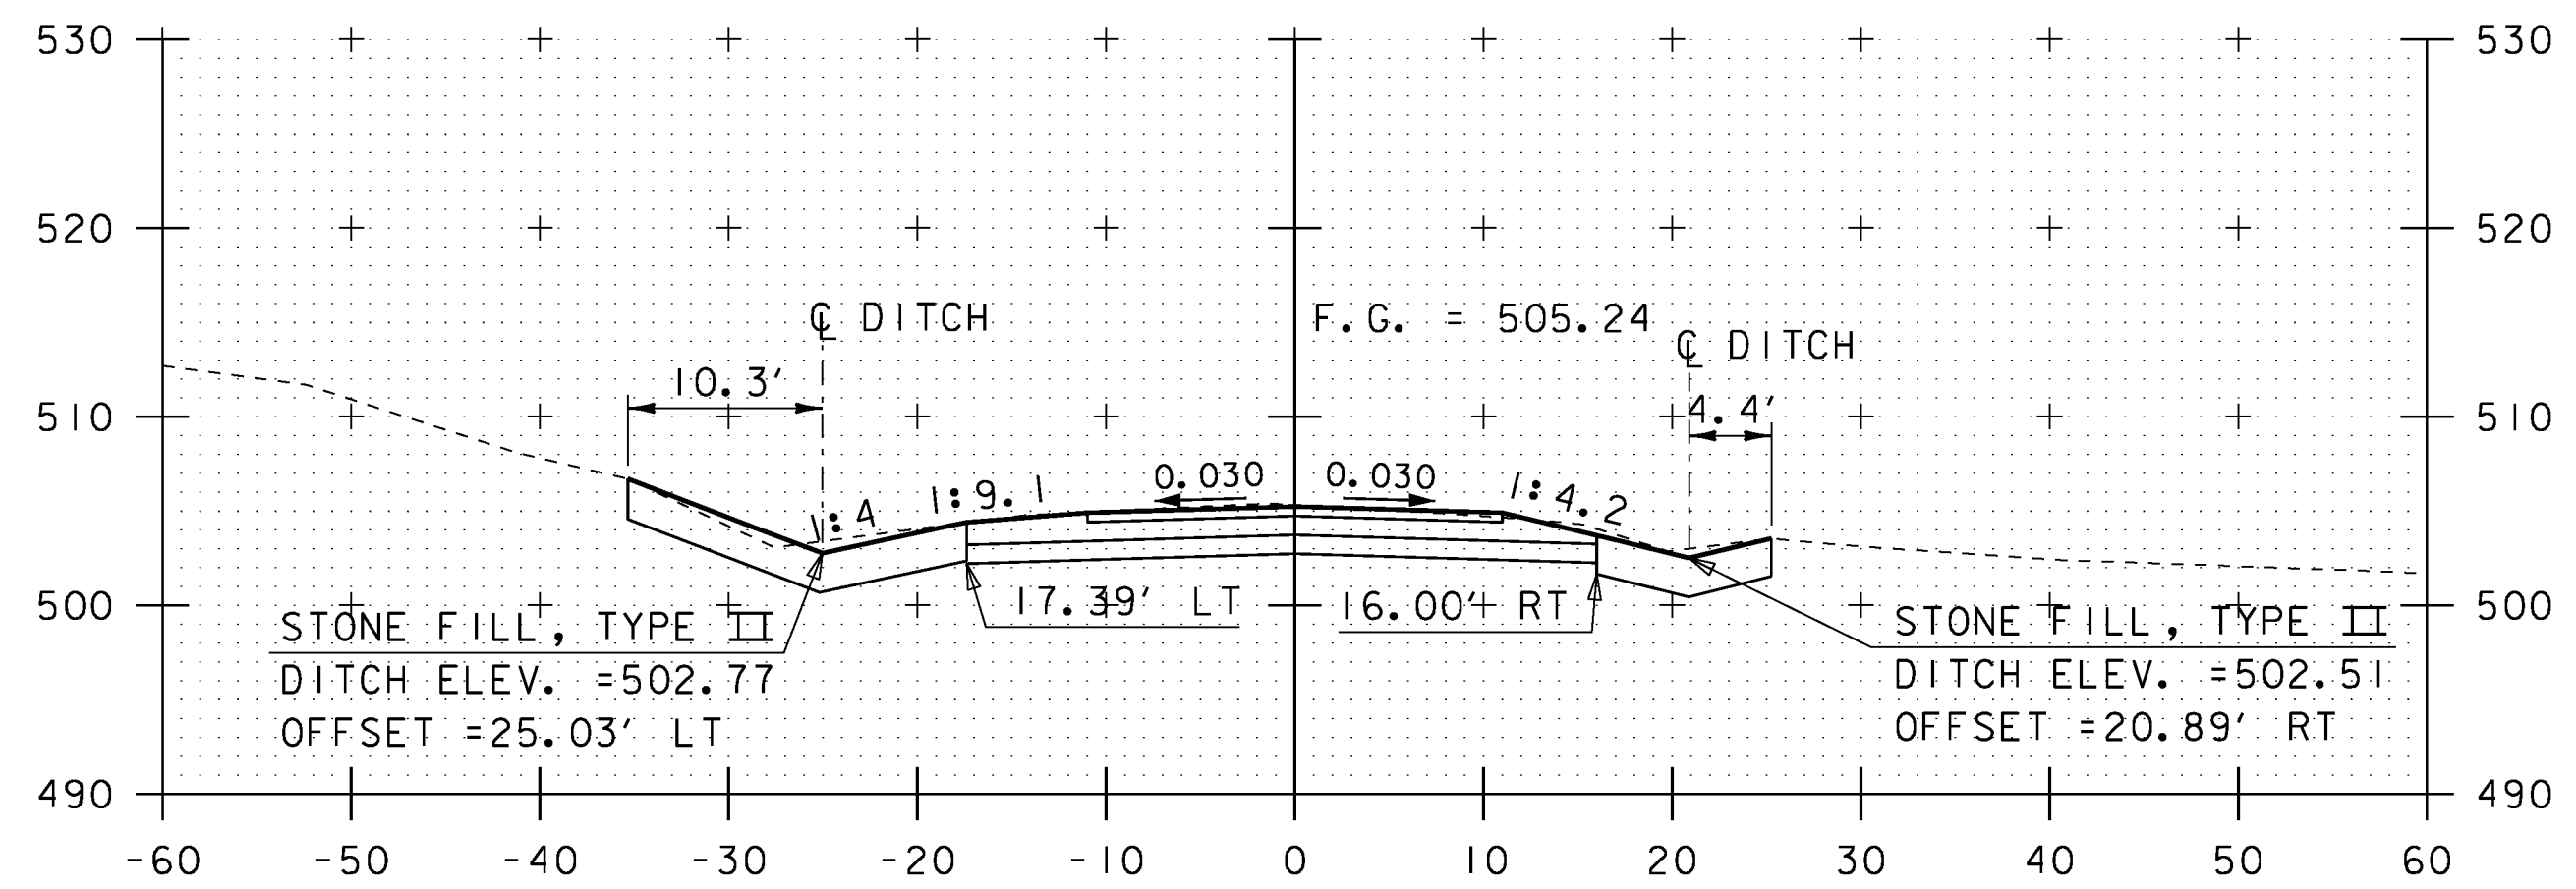


16+50


END PROJECT
STA 16+50.00

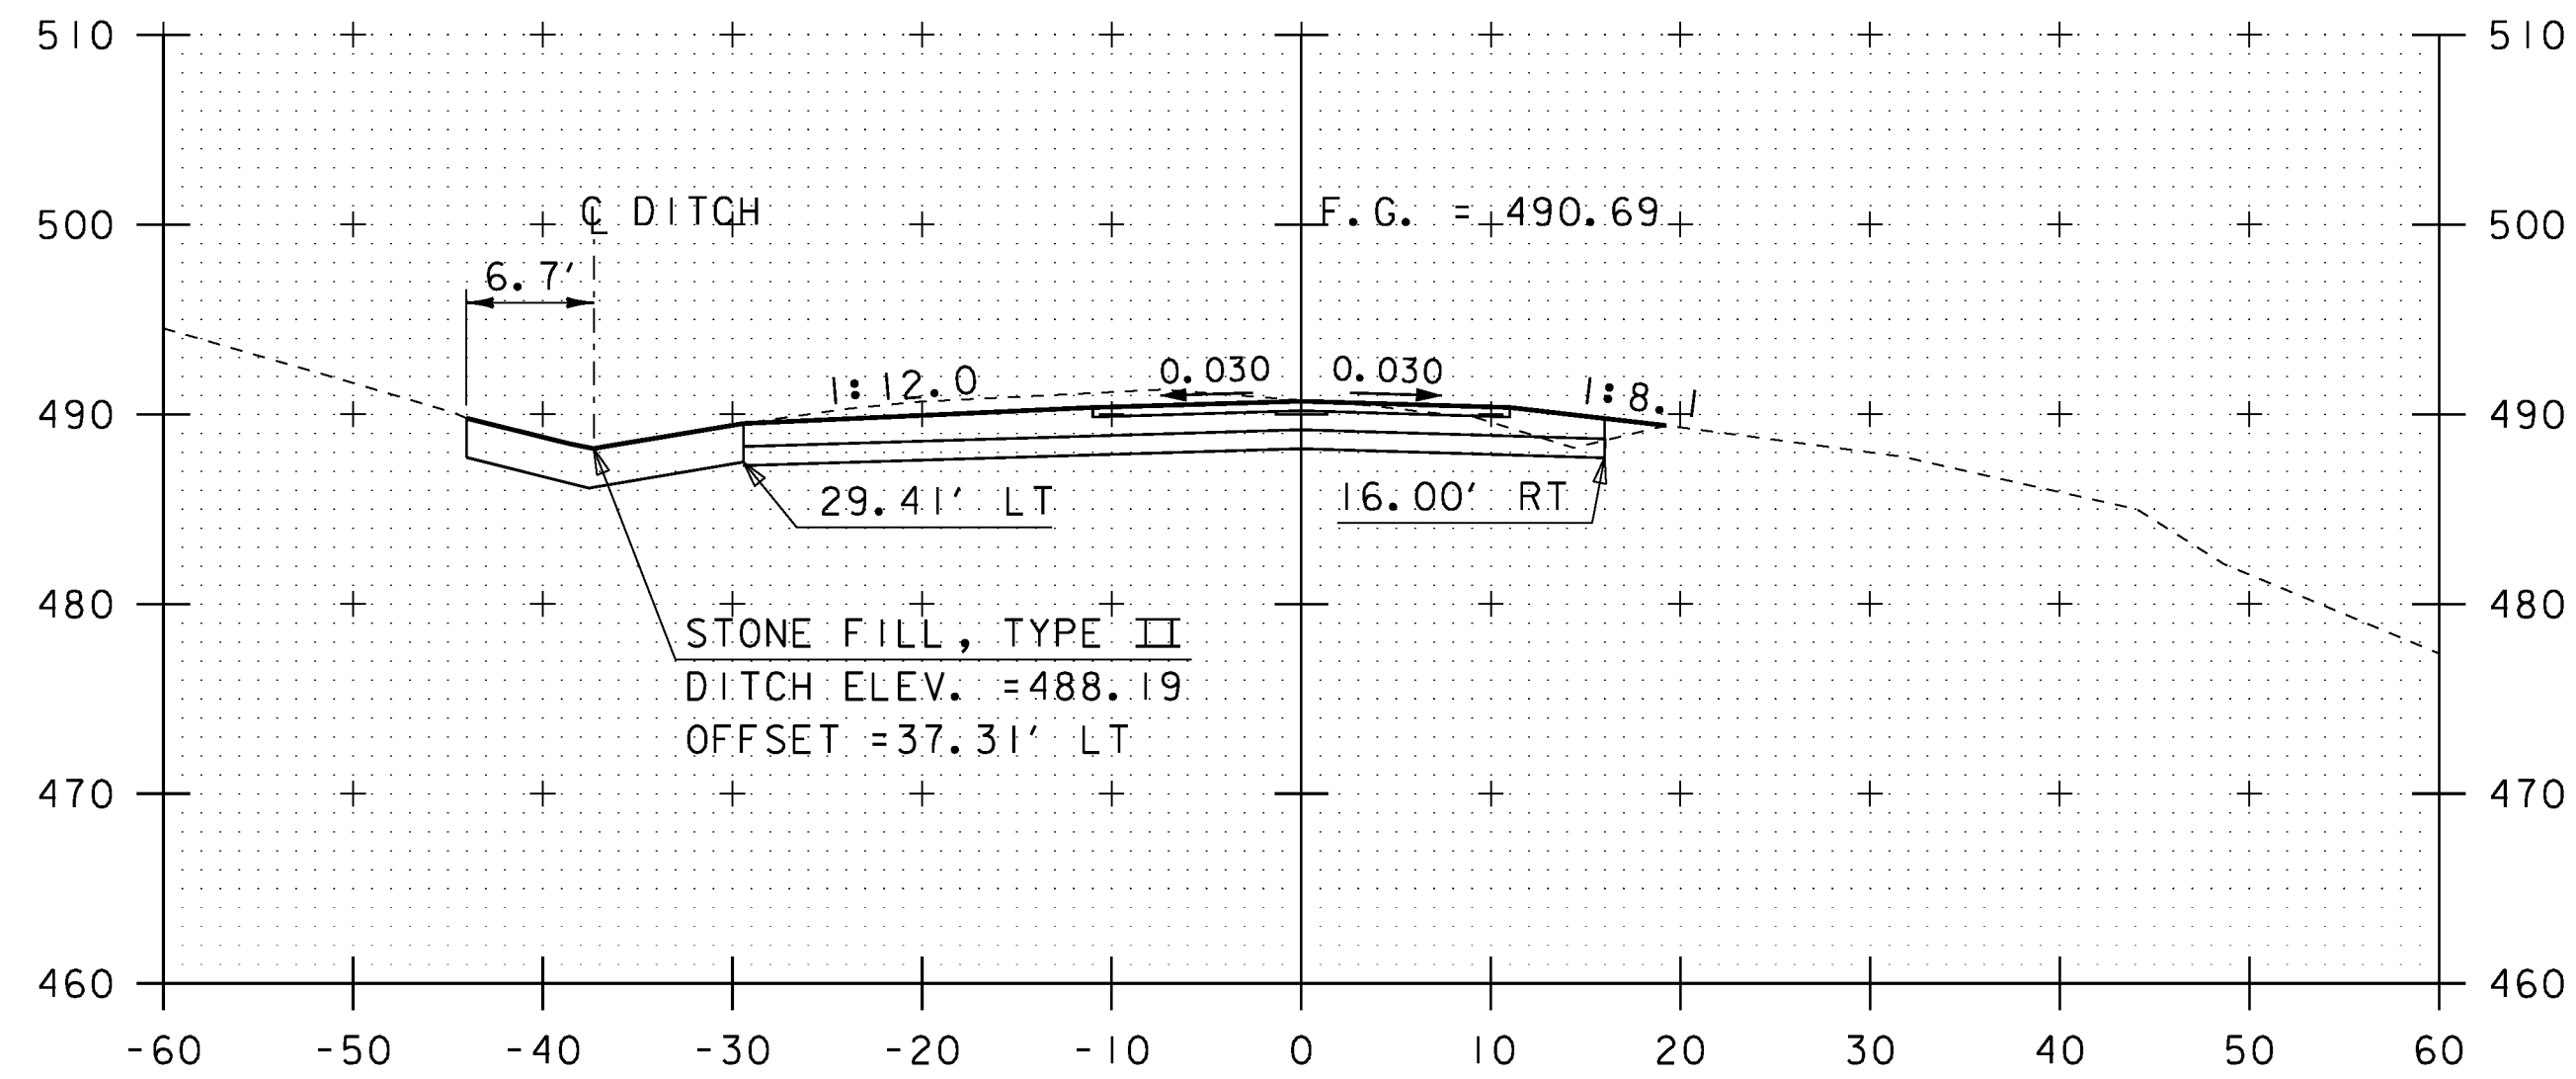


15+50

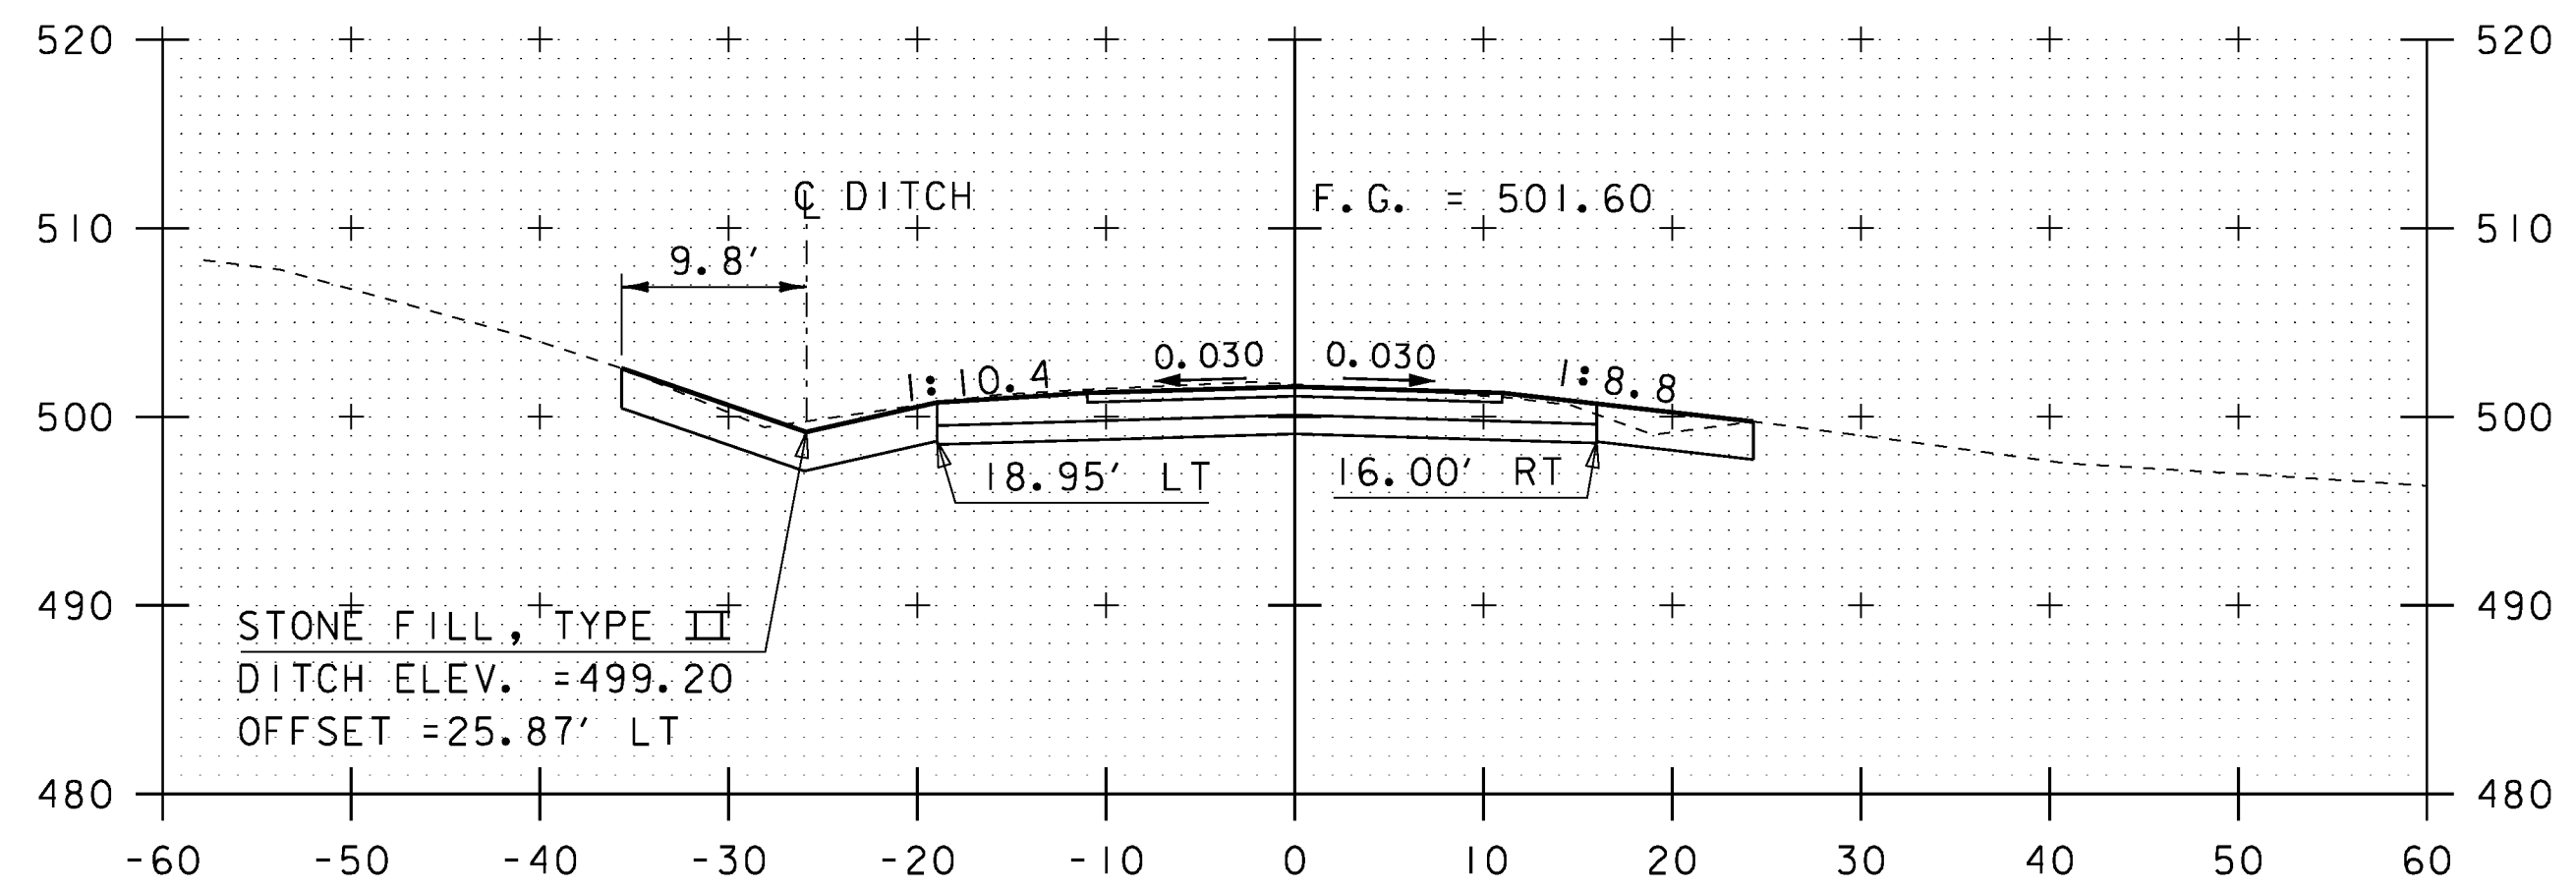

16+25

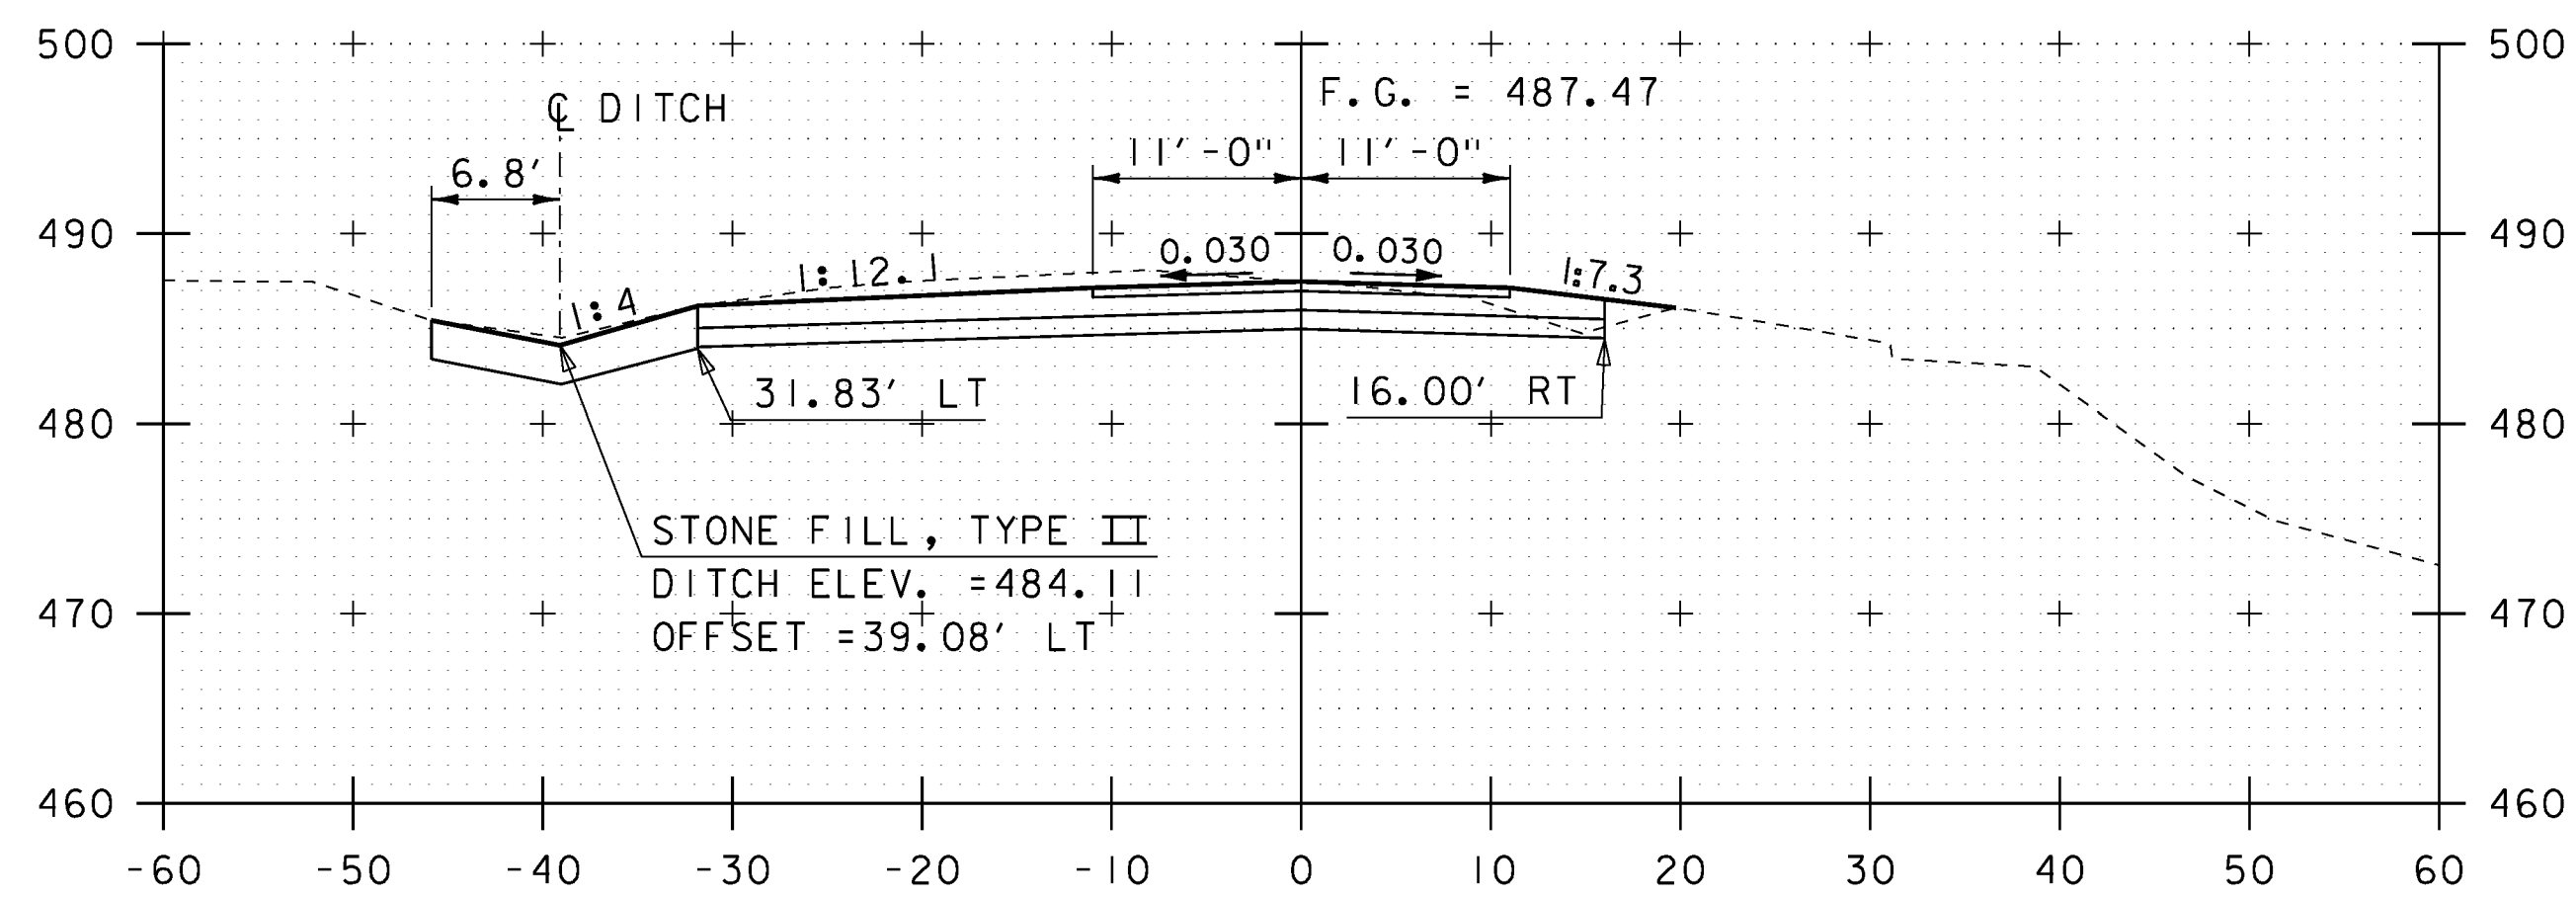

15+25

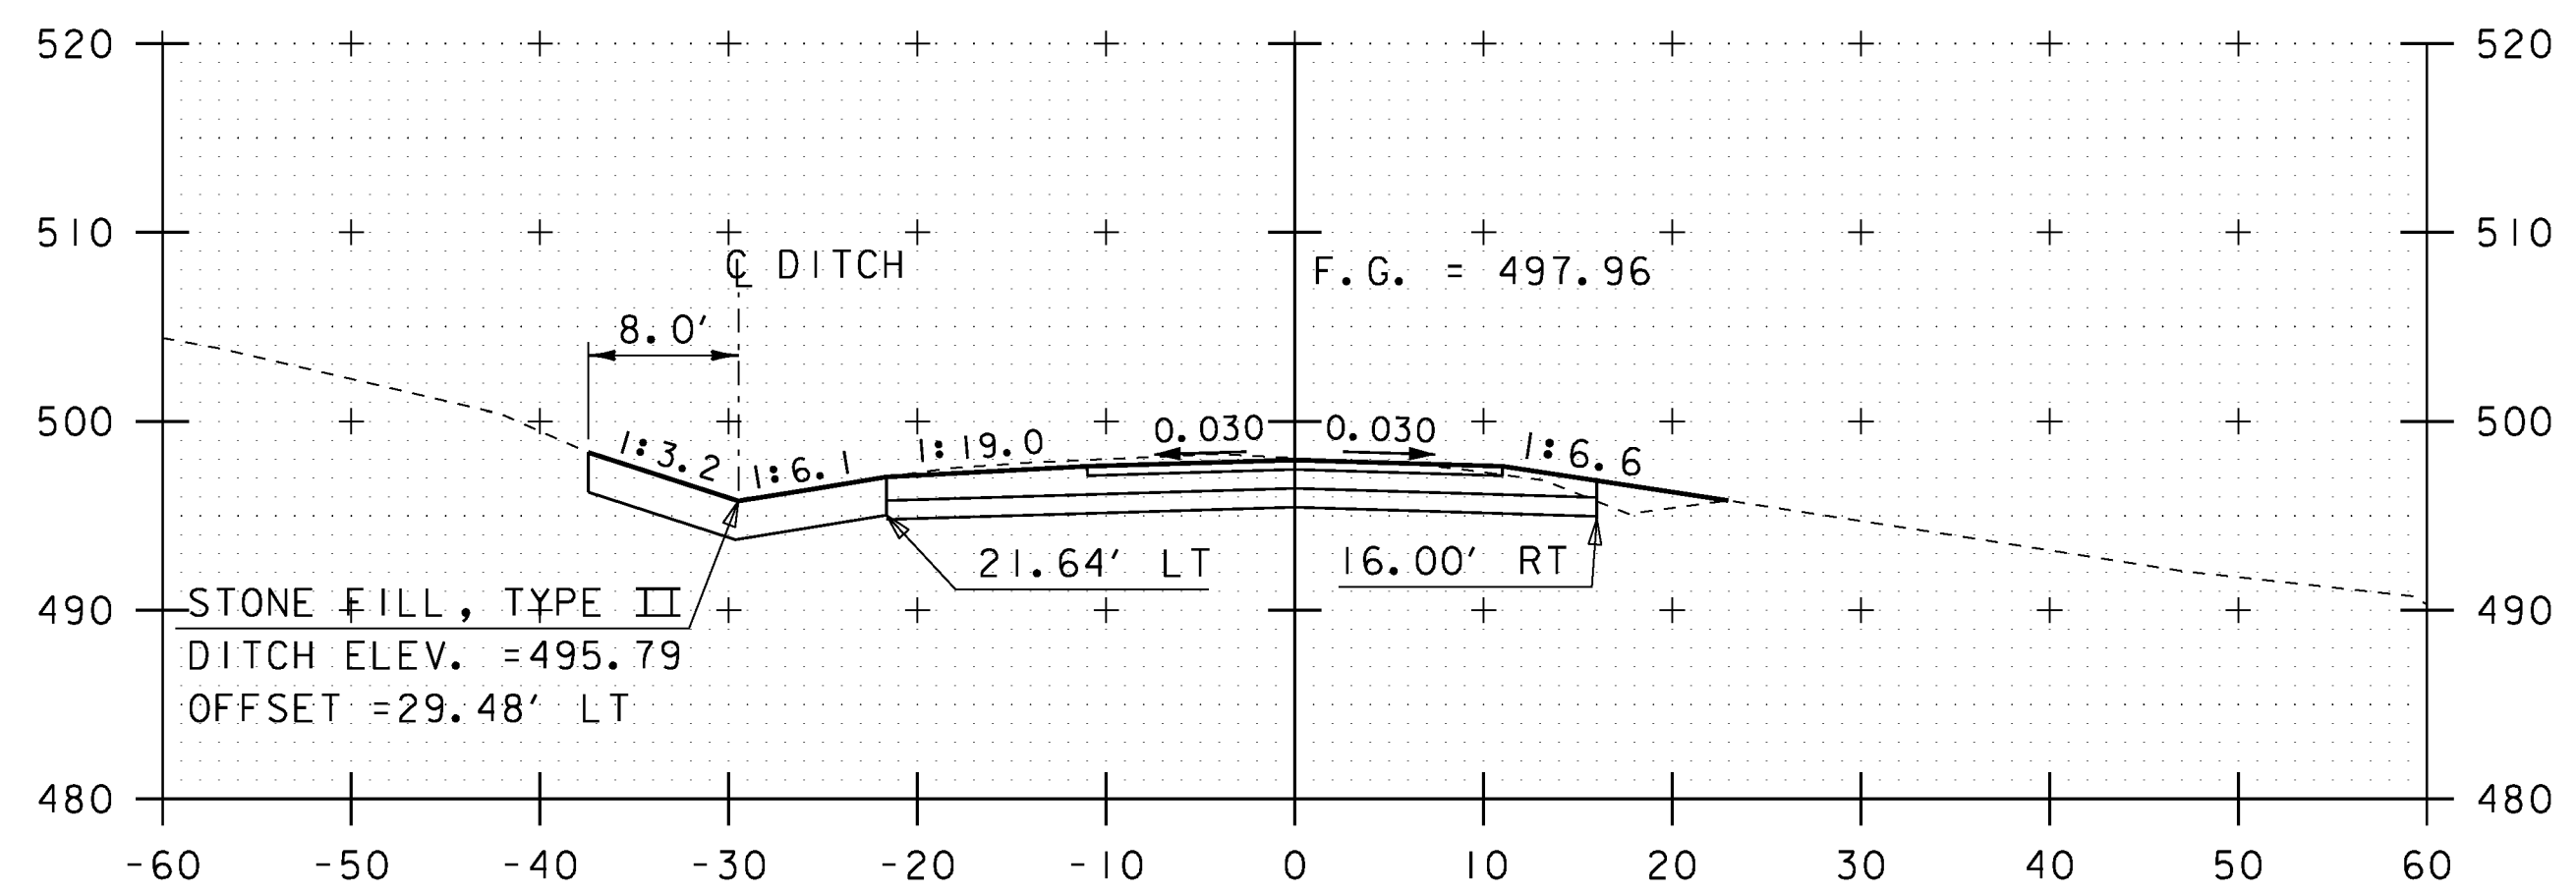

16+00

SCALE 1" = 10'-0"
10 0 10


STA. 15+25 TO STA. 16+50




PROJECT NAME: FAIRFIELD
PROJECT NUMBER: BRO 1448(38)

FILE NAME: z11j072_xsl.dgn
PROJECT LEADER: D. LANDRY
DESIGNED BY: E. ALEXOPOULOS
ROADWAY CROSS SECTIONS (5 OF 6)

PLOT DATE: 01-NOV-2013
DRAWN BY: W. GAYNOR
CHECKED BY: T. KENDRICK
SHEET 38 OF 41

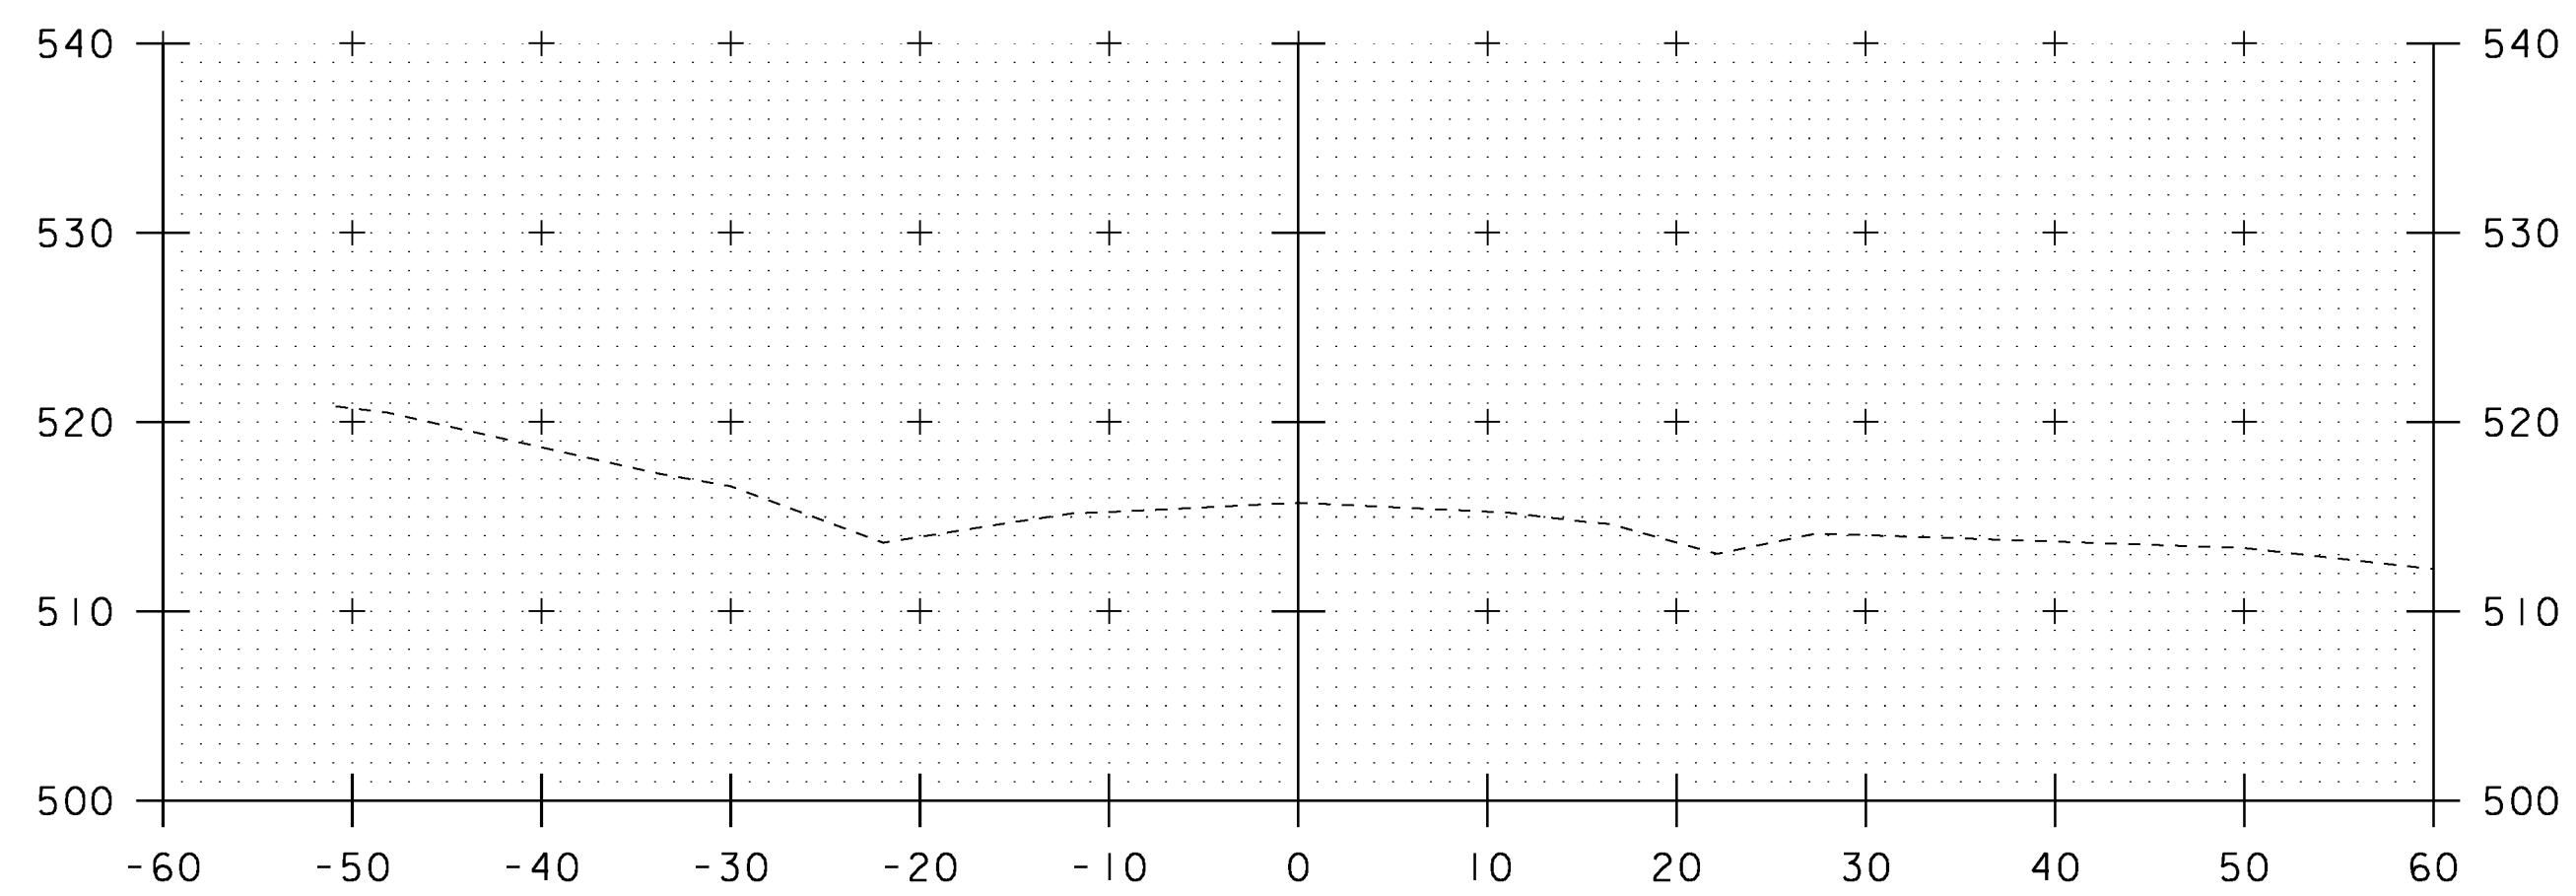


17+25

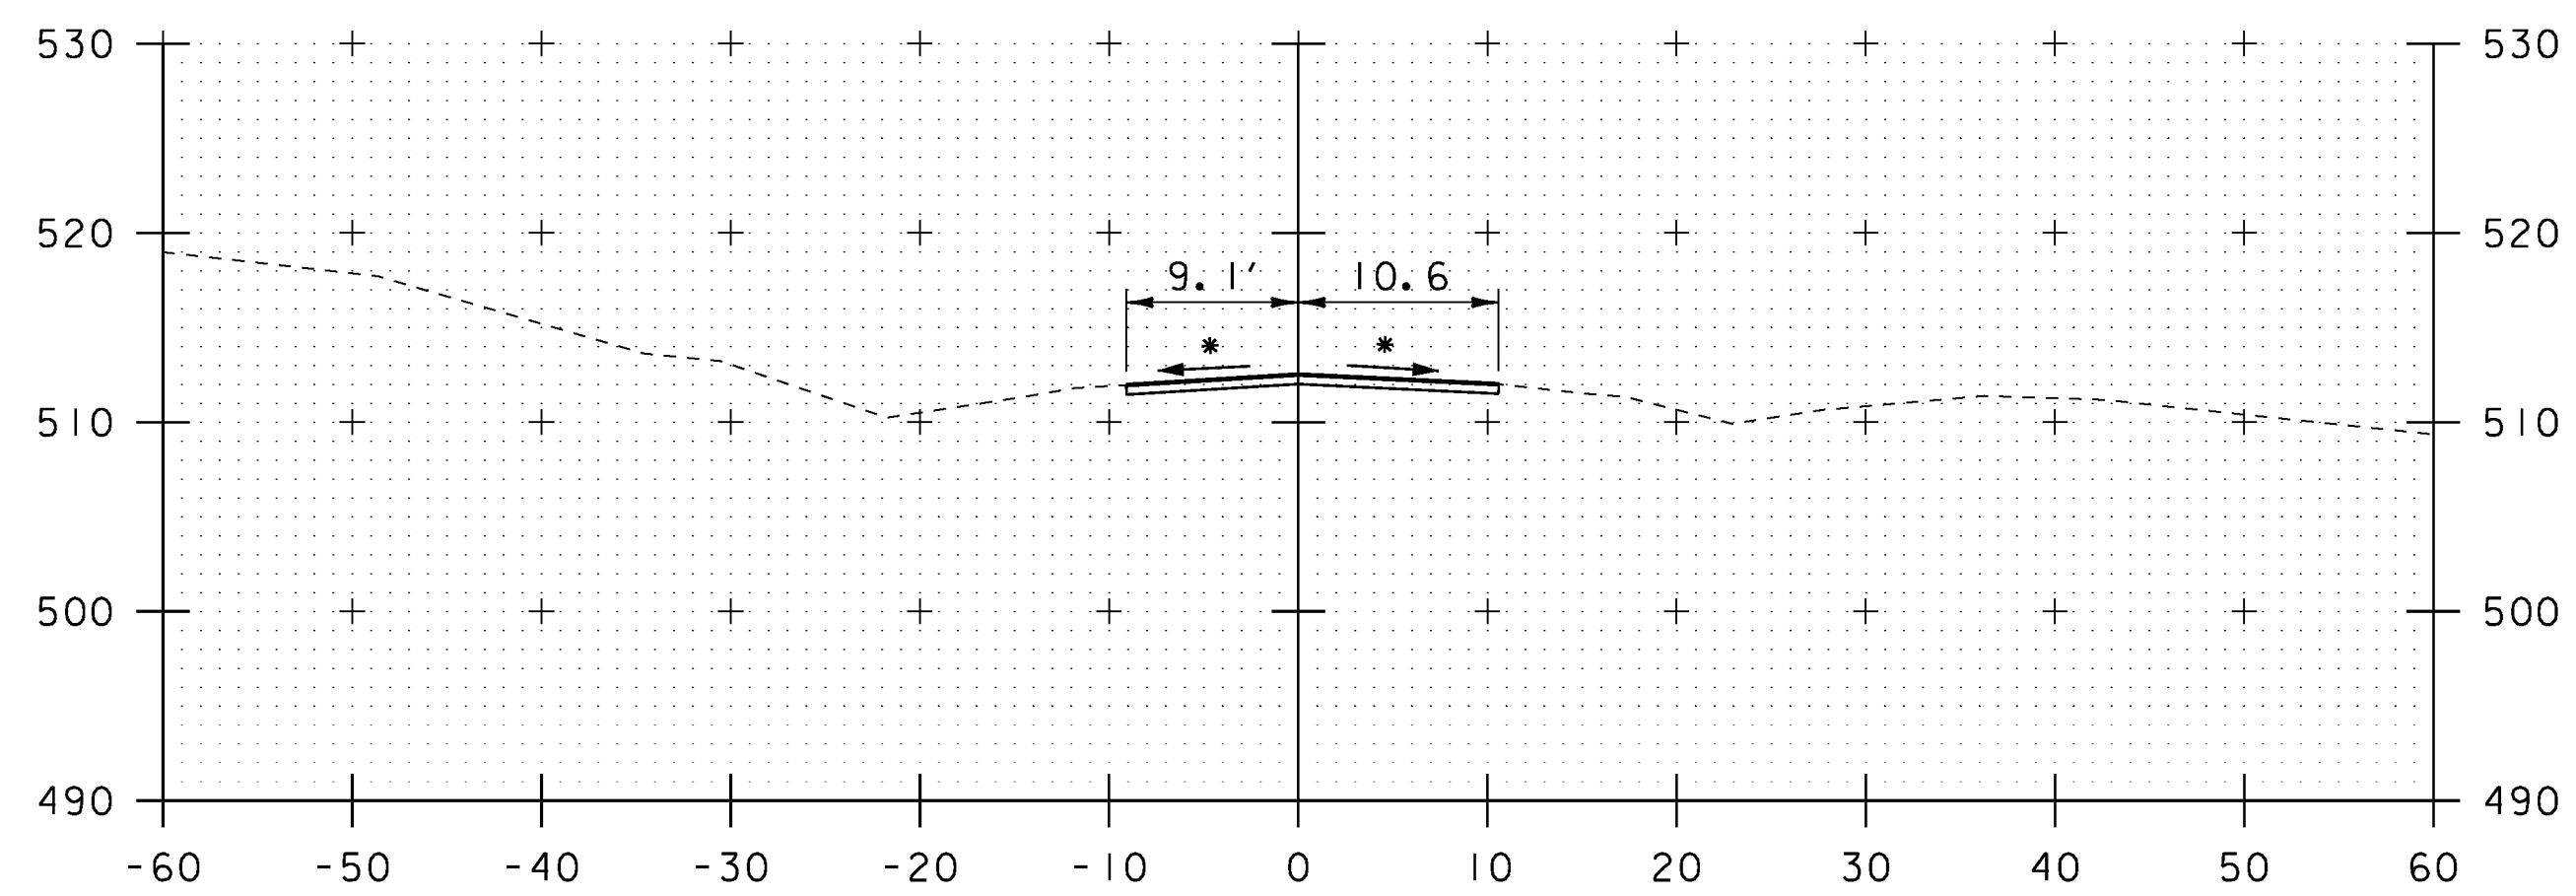


17+00

* MATCH EXISTING CROSS SLOPE (TYP)
 END APPROACH STA 17+00.00
 MATCH EXISTING

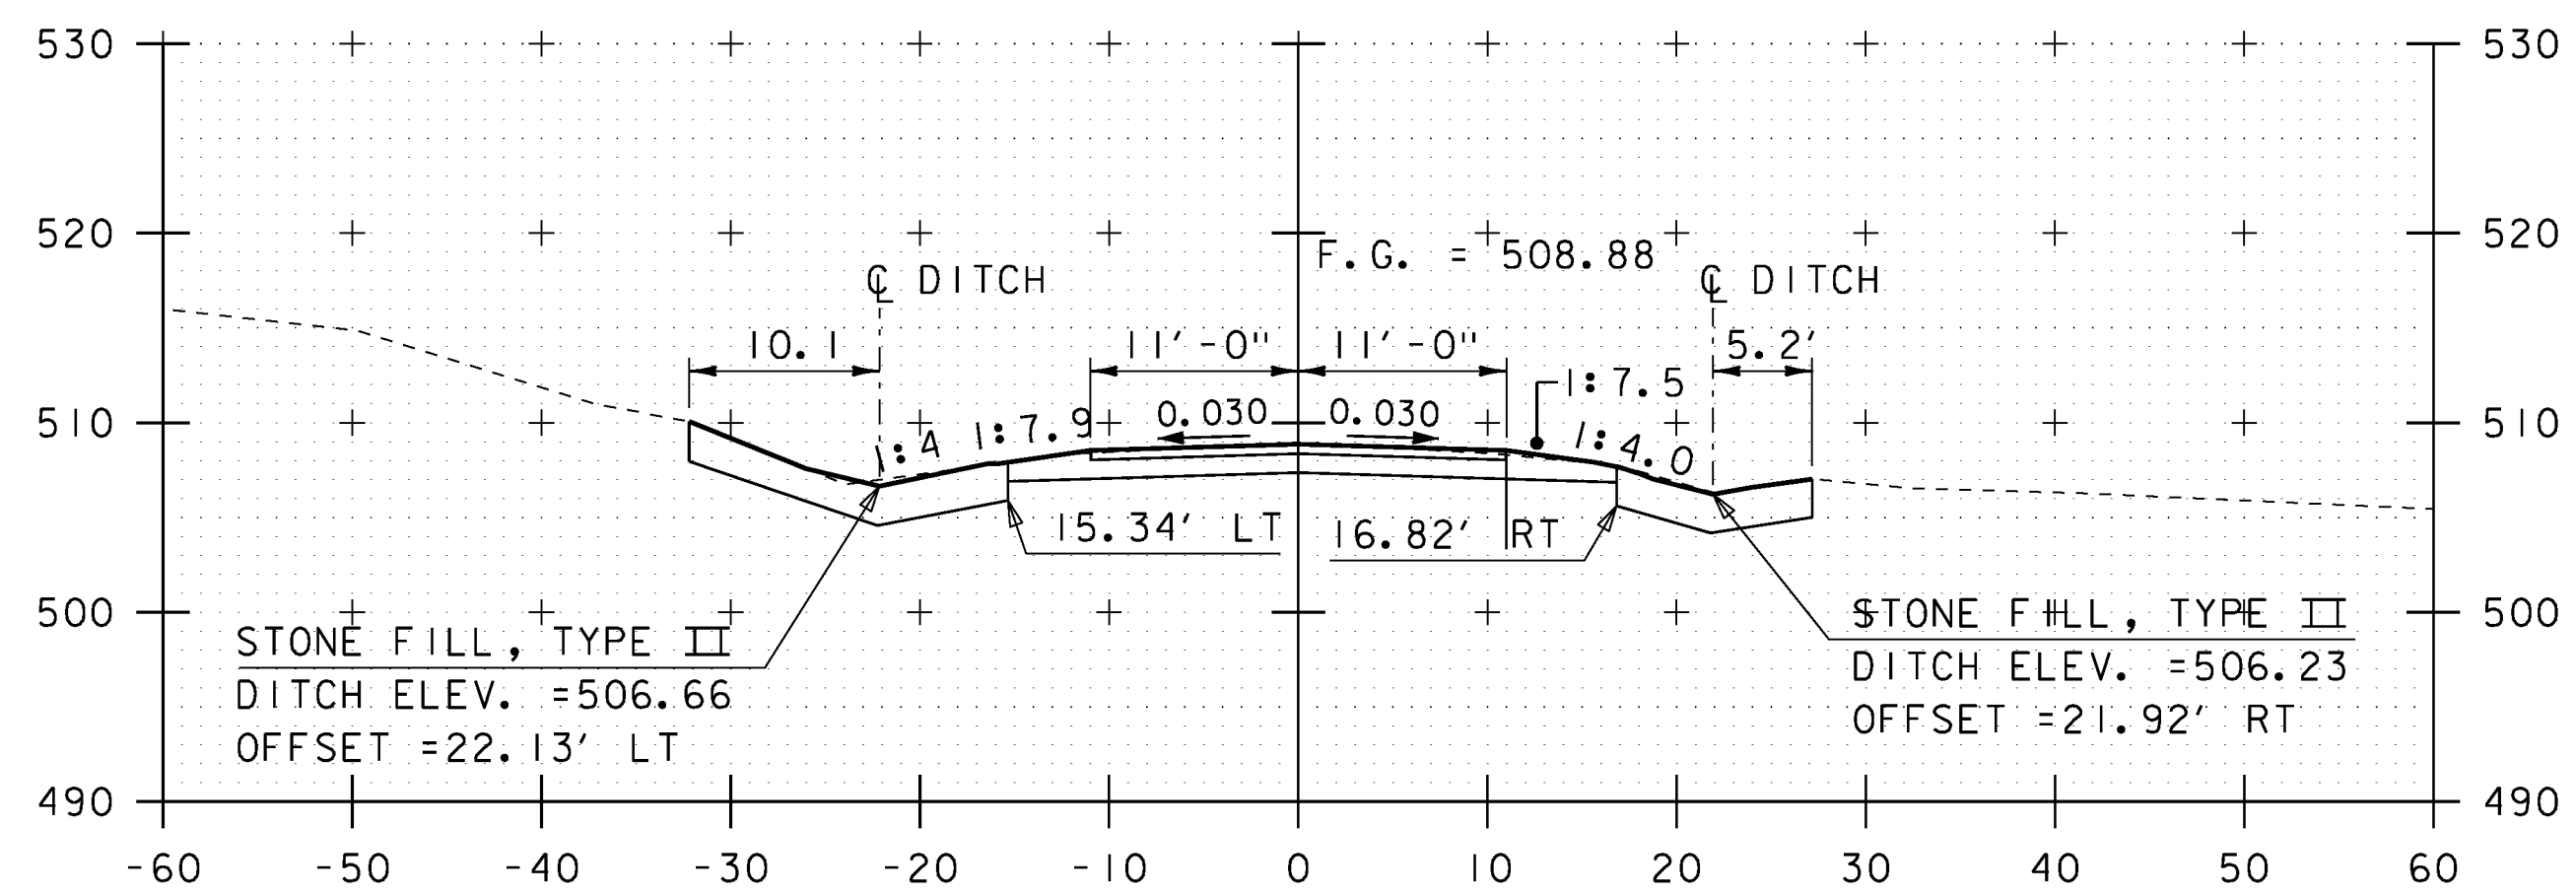

16+75

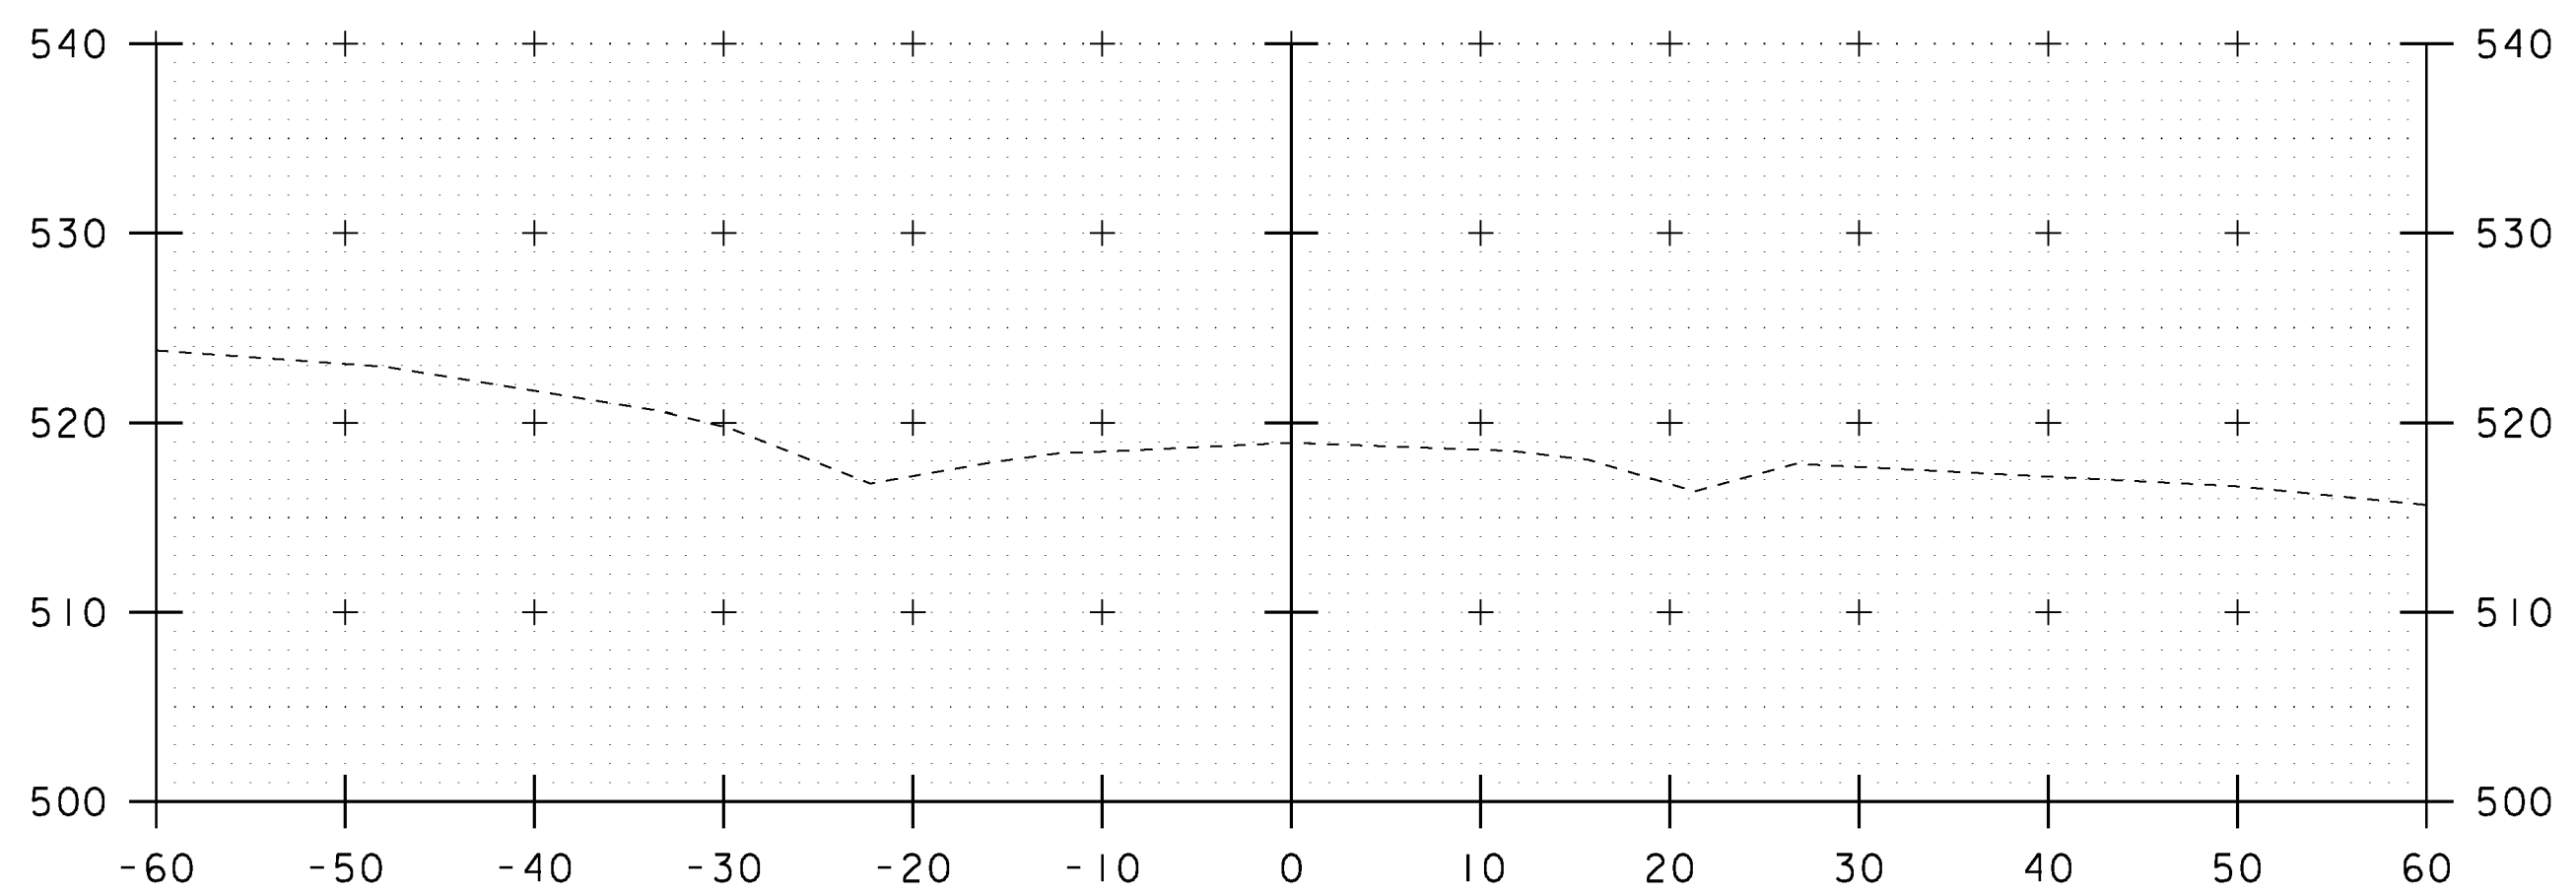


17+50

SCALE 1" = 10'-0"
 10 0 10

STA. 16+75 TO STA. 17+50




PROJECT NAME: FAIRFIELD	FILE NAME: z11j072_xsl.dgn	PLOT DATE: 01-NOV-2013
PROJECT NUMBER: BRO 1448(38)	PROJECT LEADER: D. LANDRY	DRAWN BY: W. GAYNOR
	DESIGNED BY: E. ALEXOPOULOS	CHECKED BY: T. KENDRICK
	ROADWAY CROSS SECTIONS (6 OF 6)	SHEET 39 OF 41

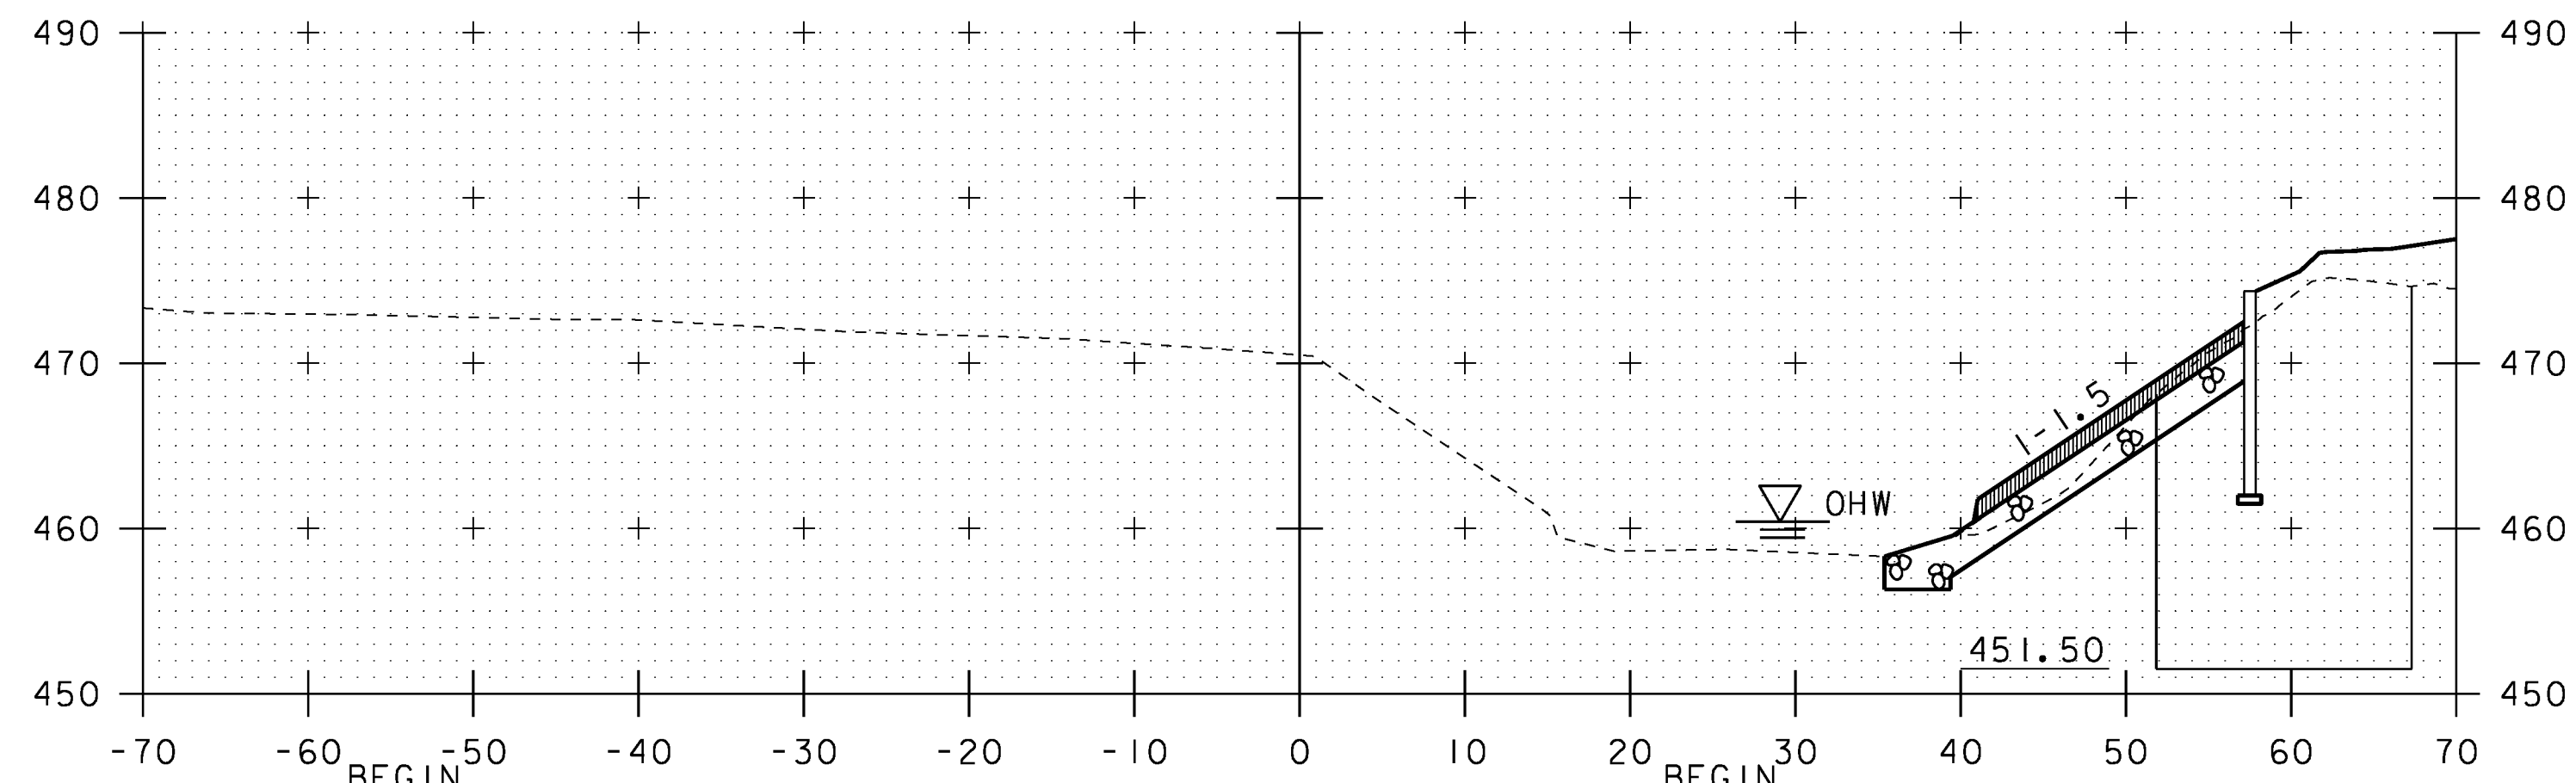


BEGIN
UNCLASSIFIED CHANNEL EXCAVATION
GEOTEXTILE UNDER STONE FILL
STONE FILL, TYPE II
GRUBBING MATERIAL
STA 200+55 LT

200+50


BEGIN
UNCLASSIFIED CHANNEL EXCAVATION
GEOTEXTILE UNDER STONE FILL
STONE FILL, TYPE II
GRUBBING MATERIAL
STA 200+41 RT

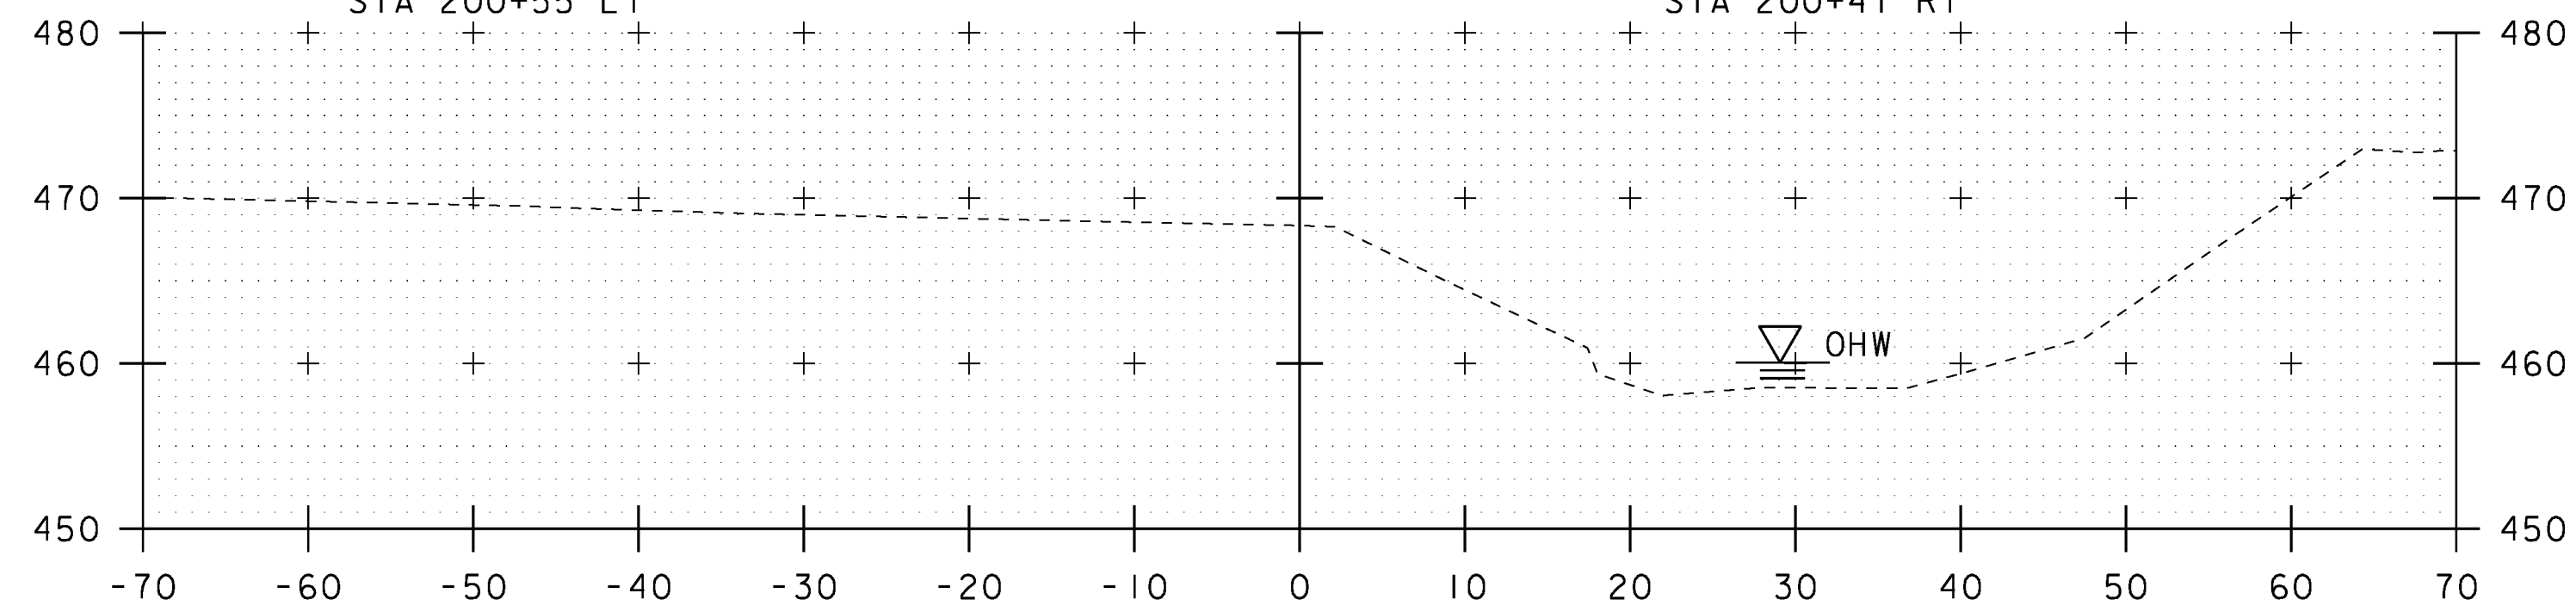


200+25

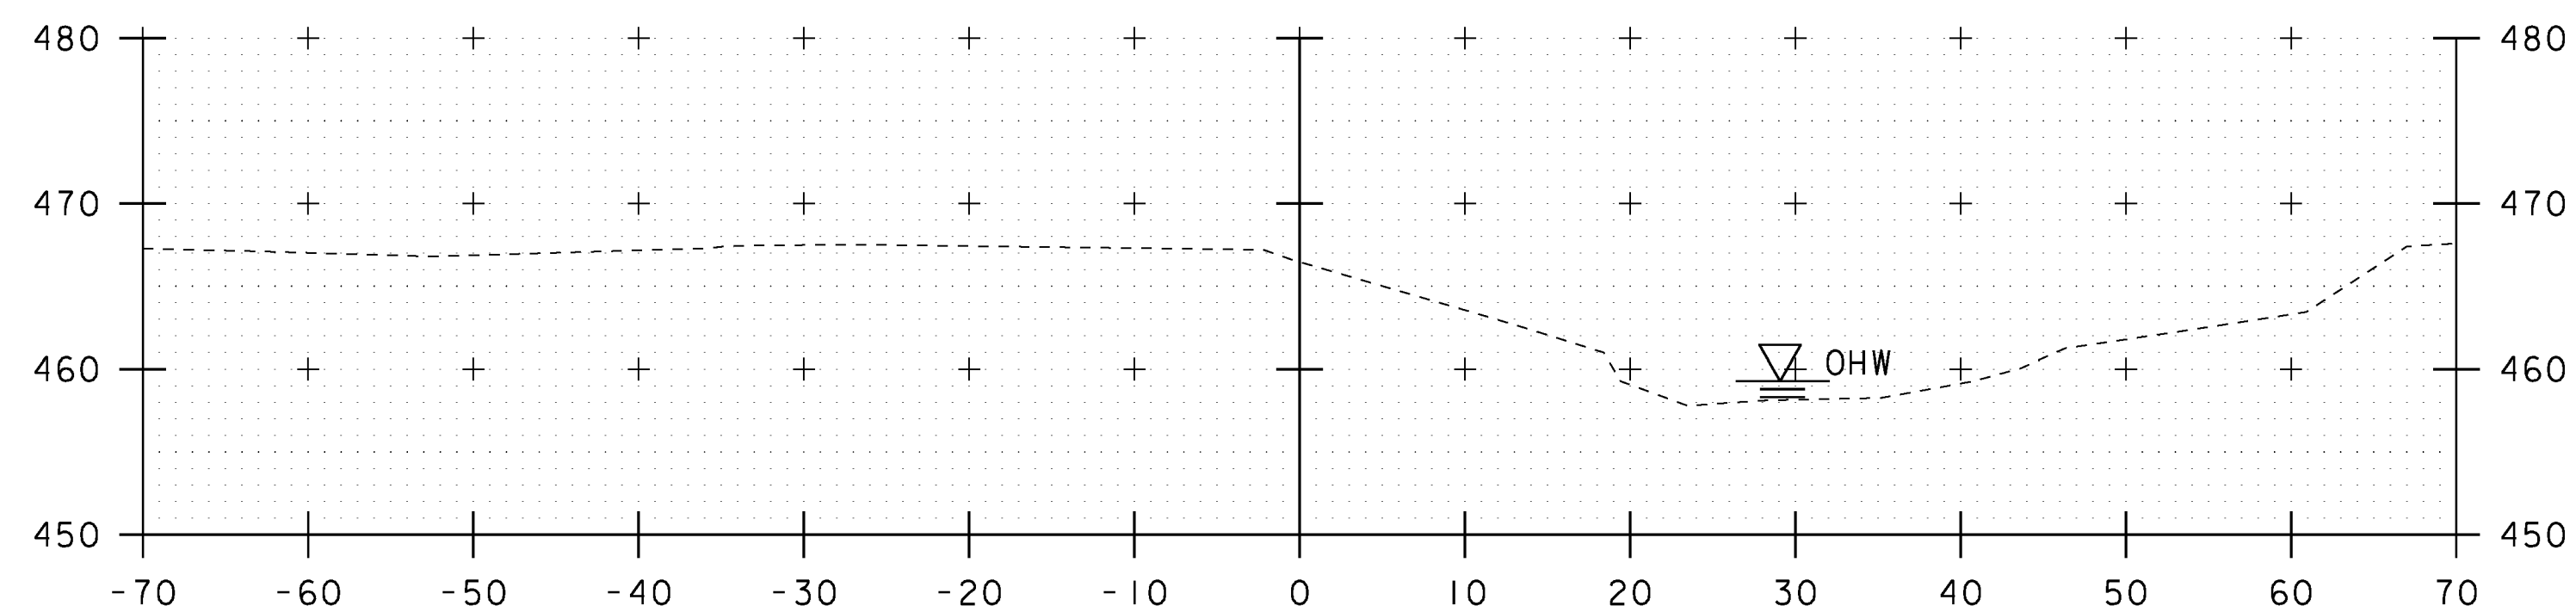

200+00

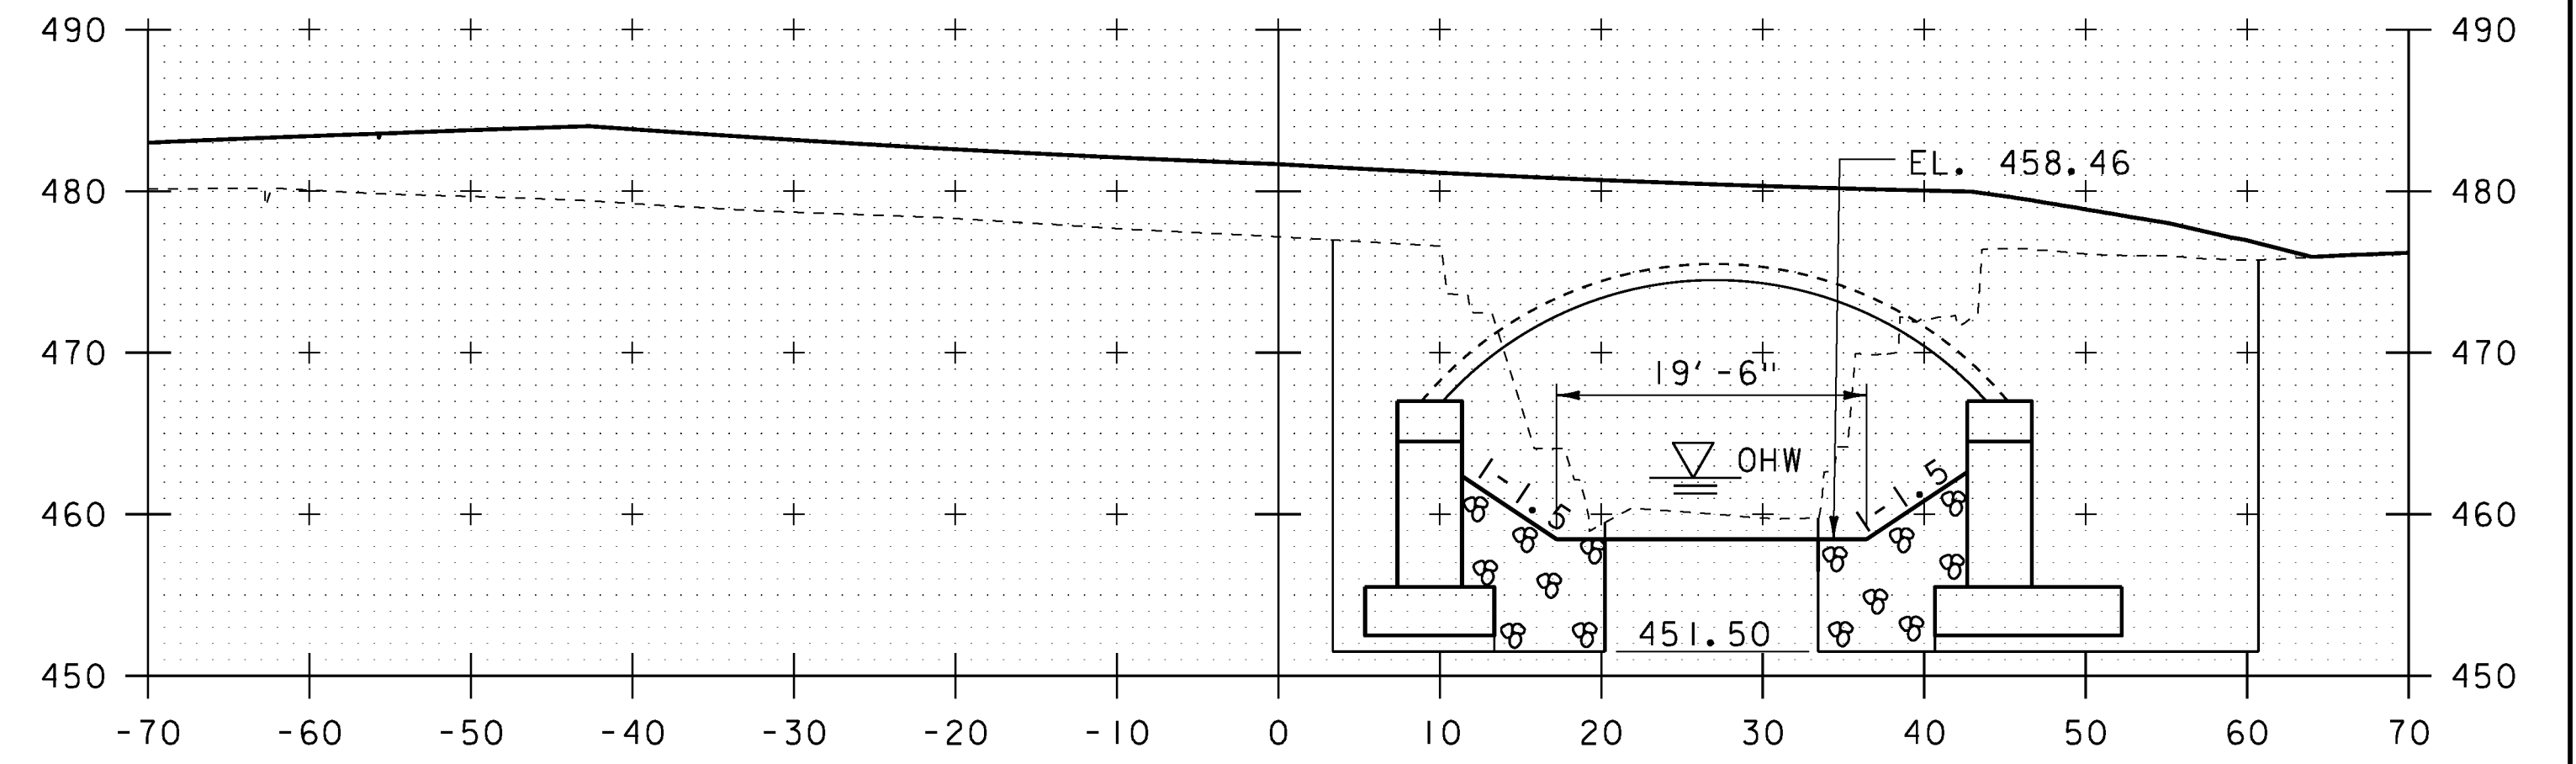

201+00

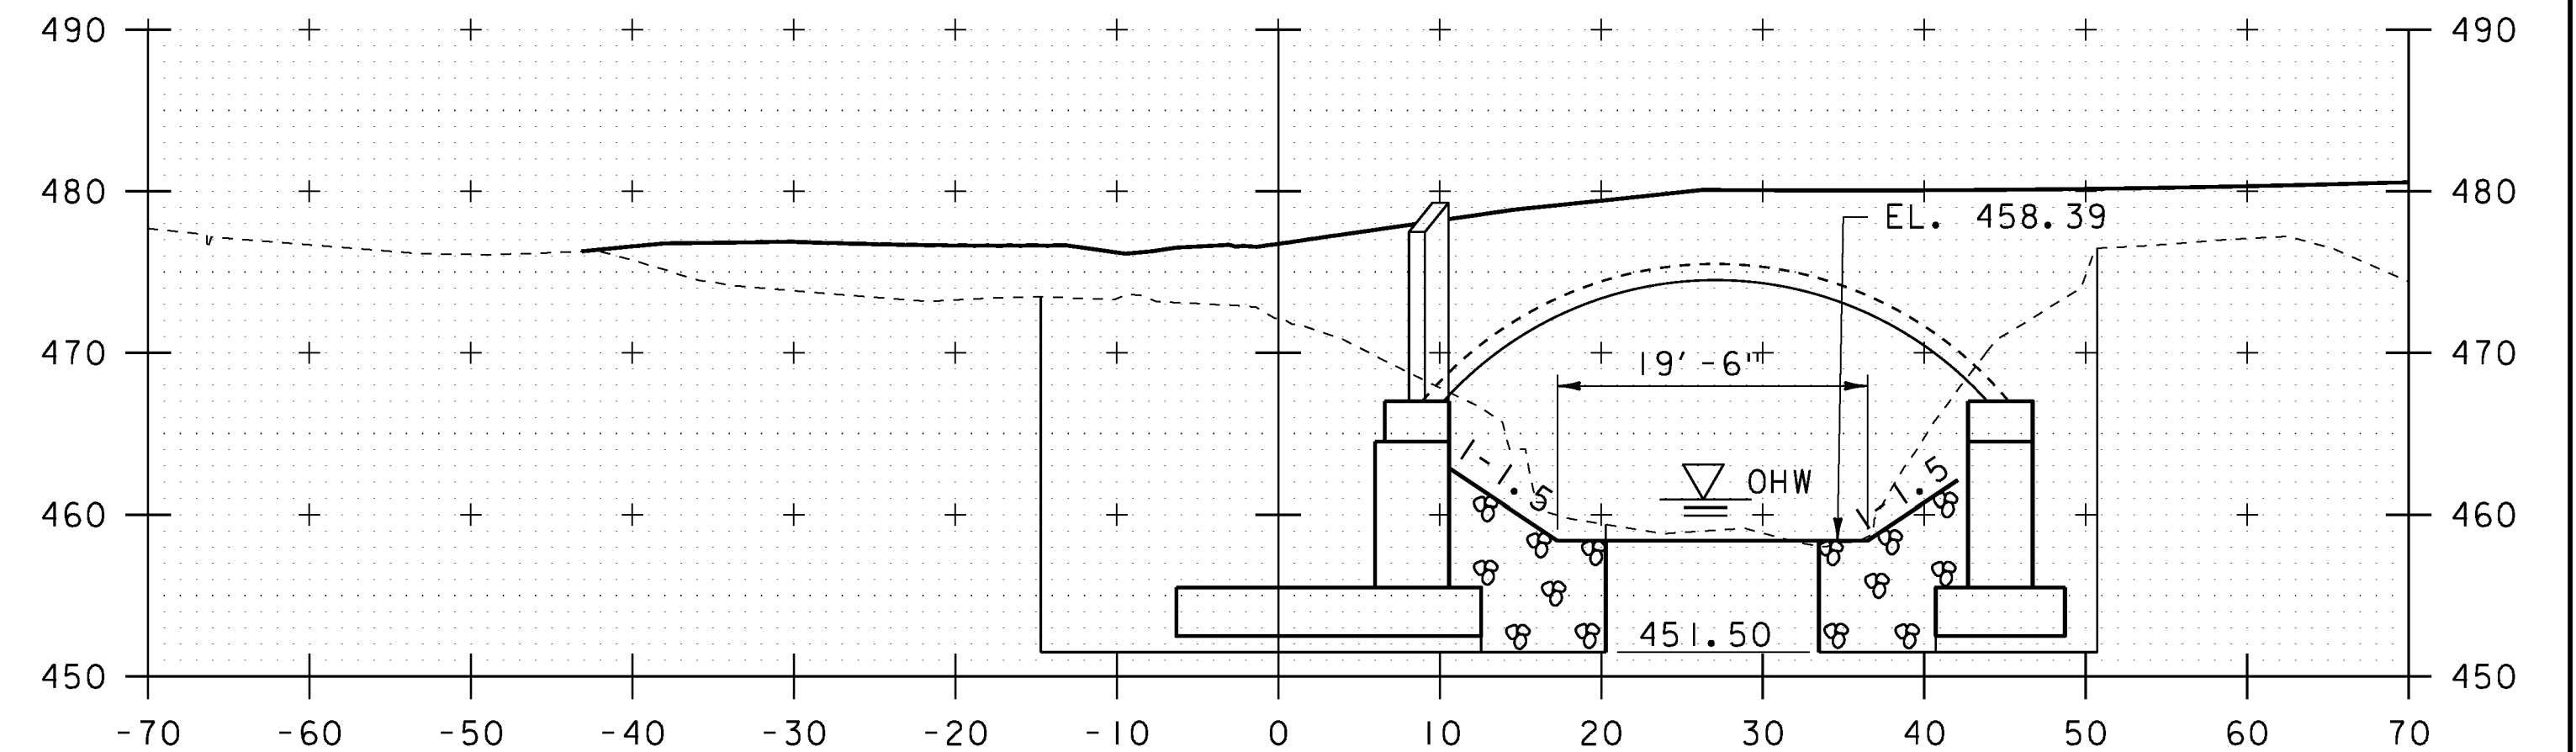


200+75

END
GRUBBING MATERIAL
STA 200+72 LT


END
GRUBBING MATERIAL
STA 200+41 RT

STA. 200+00 TO STA. 201+00

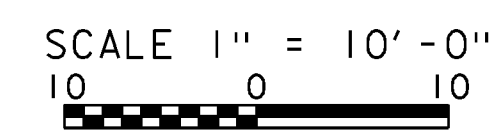

McFarland Johnson


PROJECT NAME:	FAIRFIELD	FILE NAME:	zlj072_xsl.dgn	PLOT DATE:	01-NOV-2013
PROJECT NUMBER:	BRO 1448(38)	PROJECT LEADER:	D. LANDRY	DRAWN BY:	W. GAYNOR
		DESIGNED BY:	E. ALEXOPOULOS	CHECKED BY:	T. KENDRICK
		CHANNEL CROSS SECTIONS (1 OF 2)		SHEET	40 OF 41

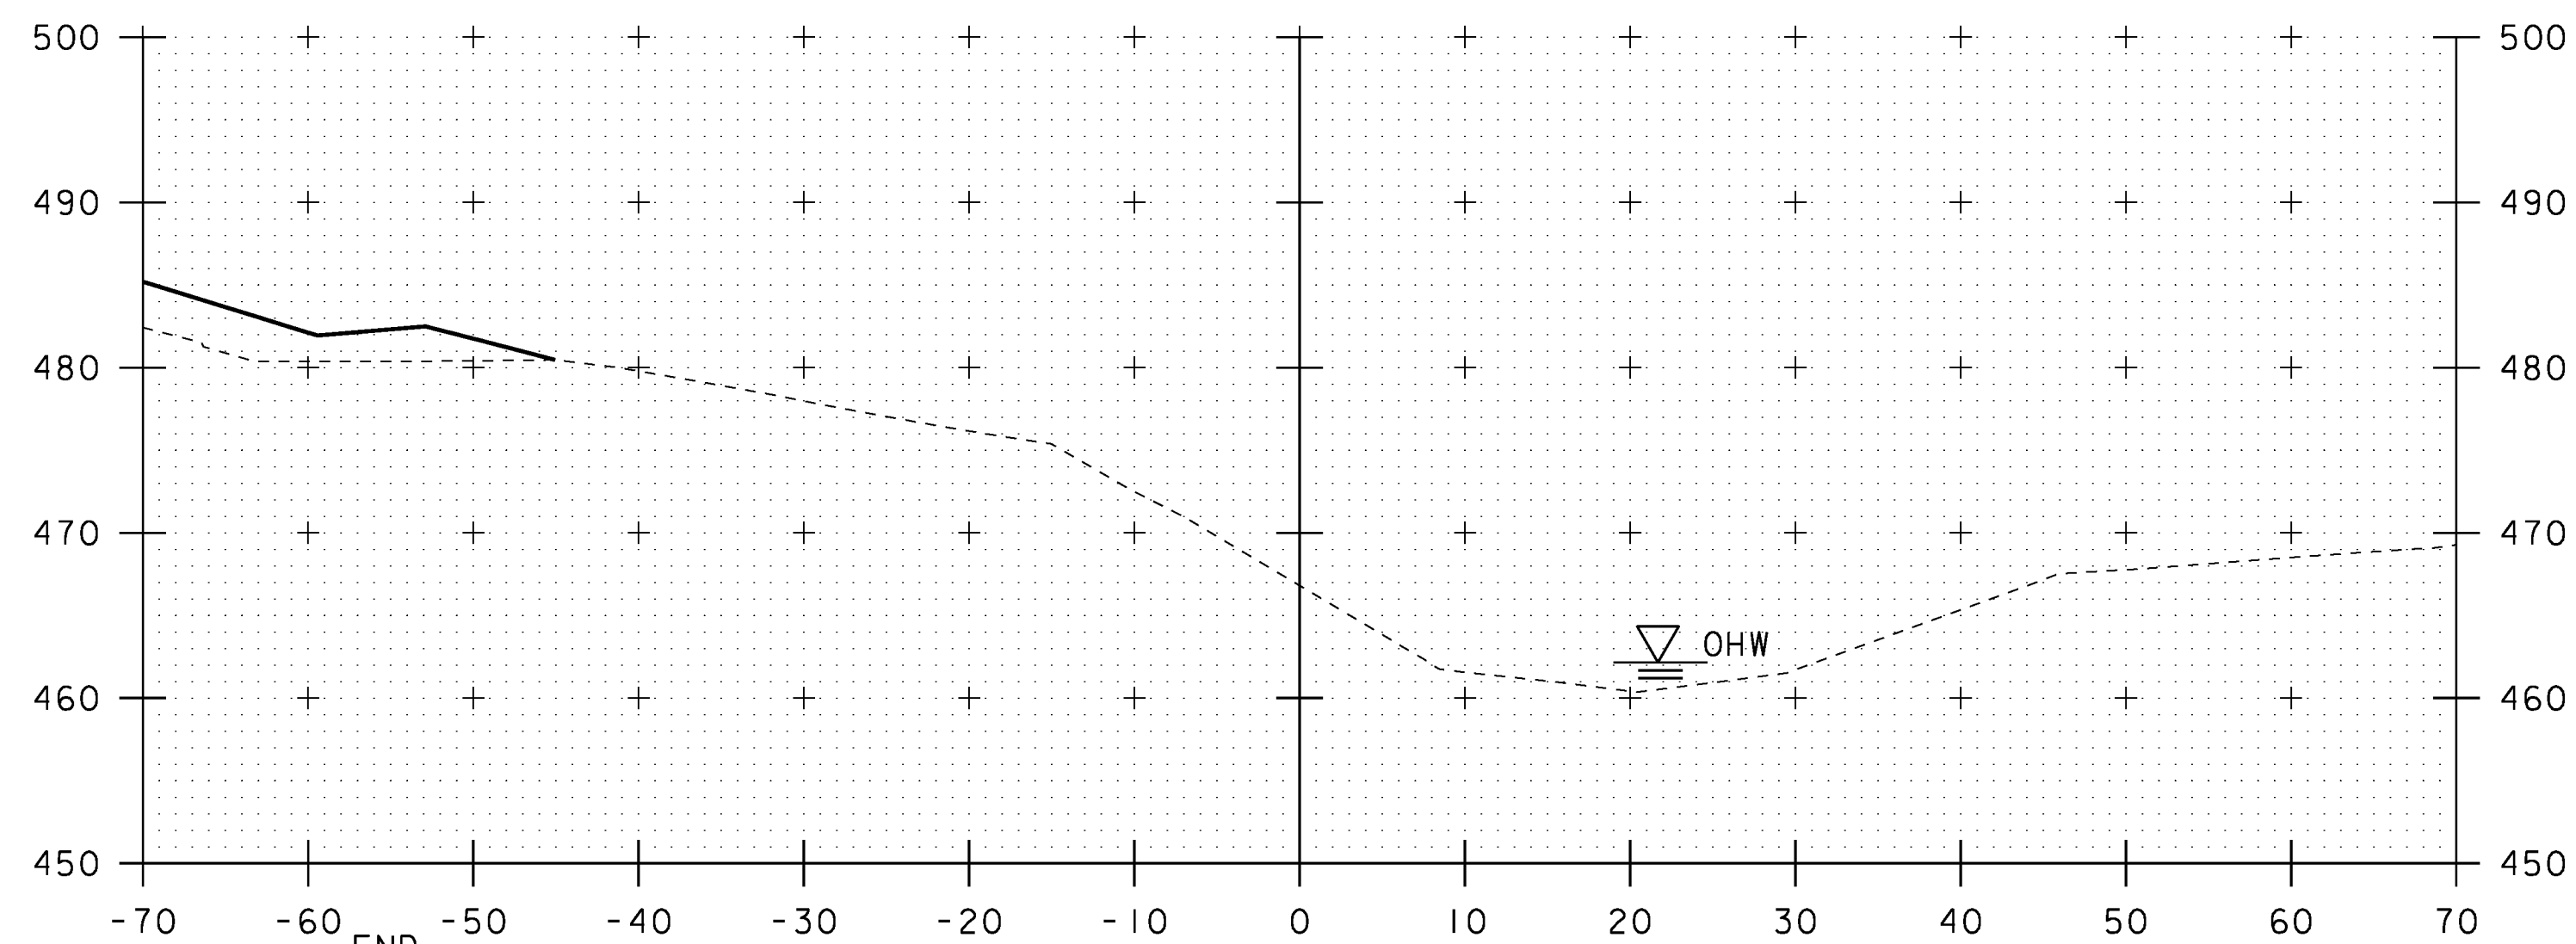


END
UNCLASSIFIED CHANNEL EXCAVATION
GEOTEXTILE UNDER STONE FILL
STONE FILL, TYPE II
GRUBBING MATERIAL
STA 201+48 LT

201+50

=

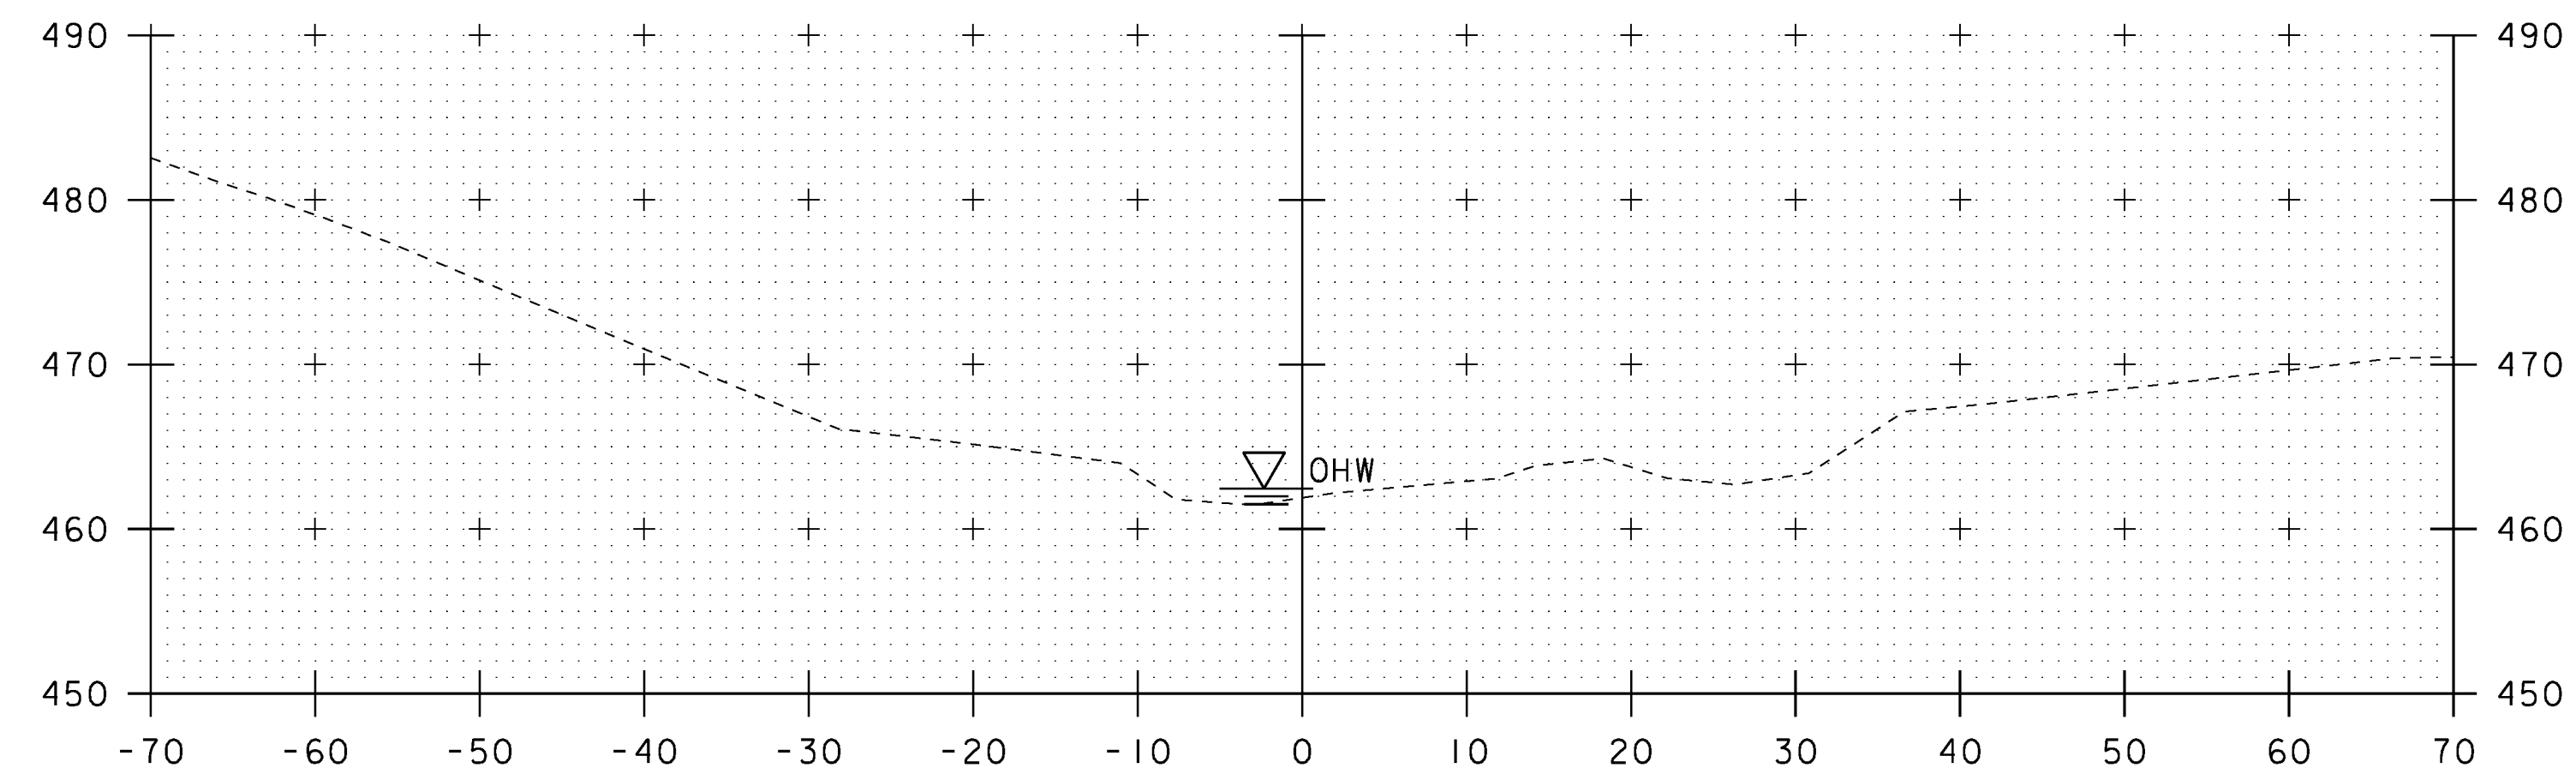

202+00

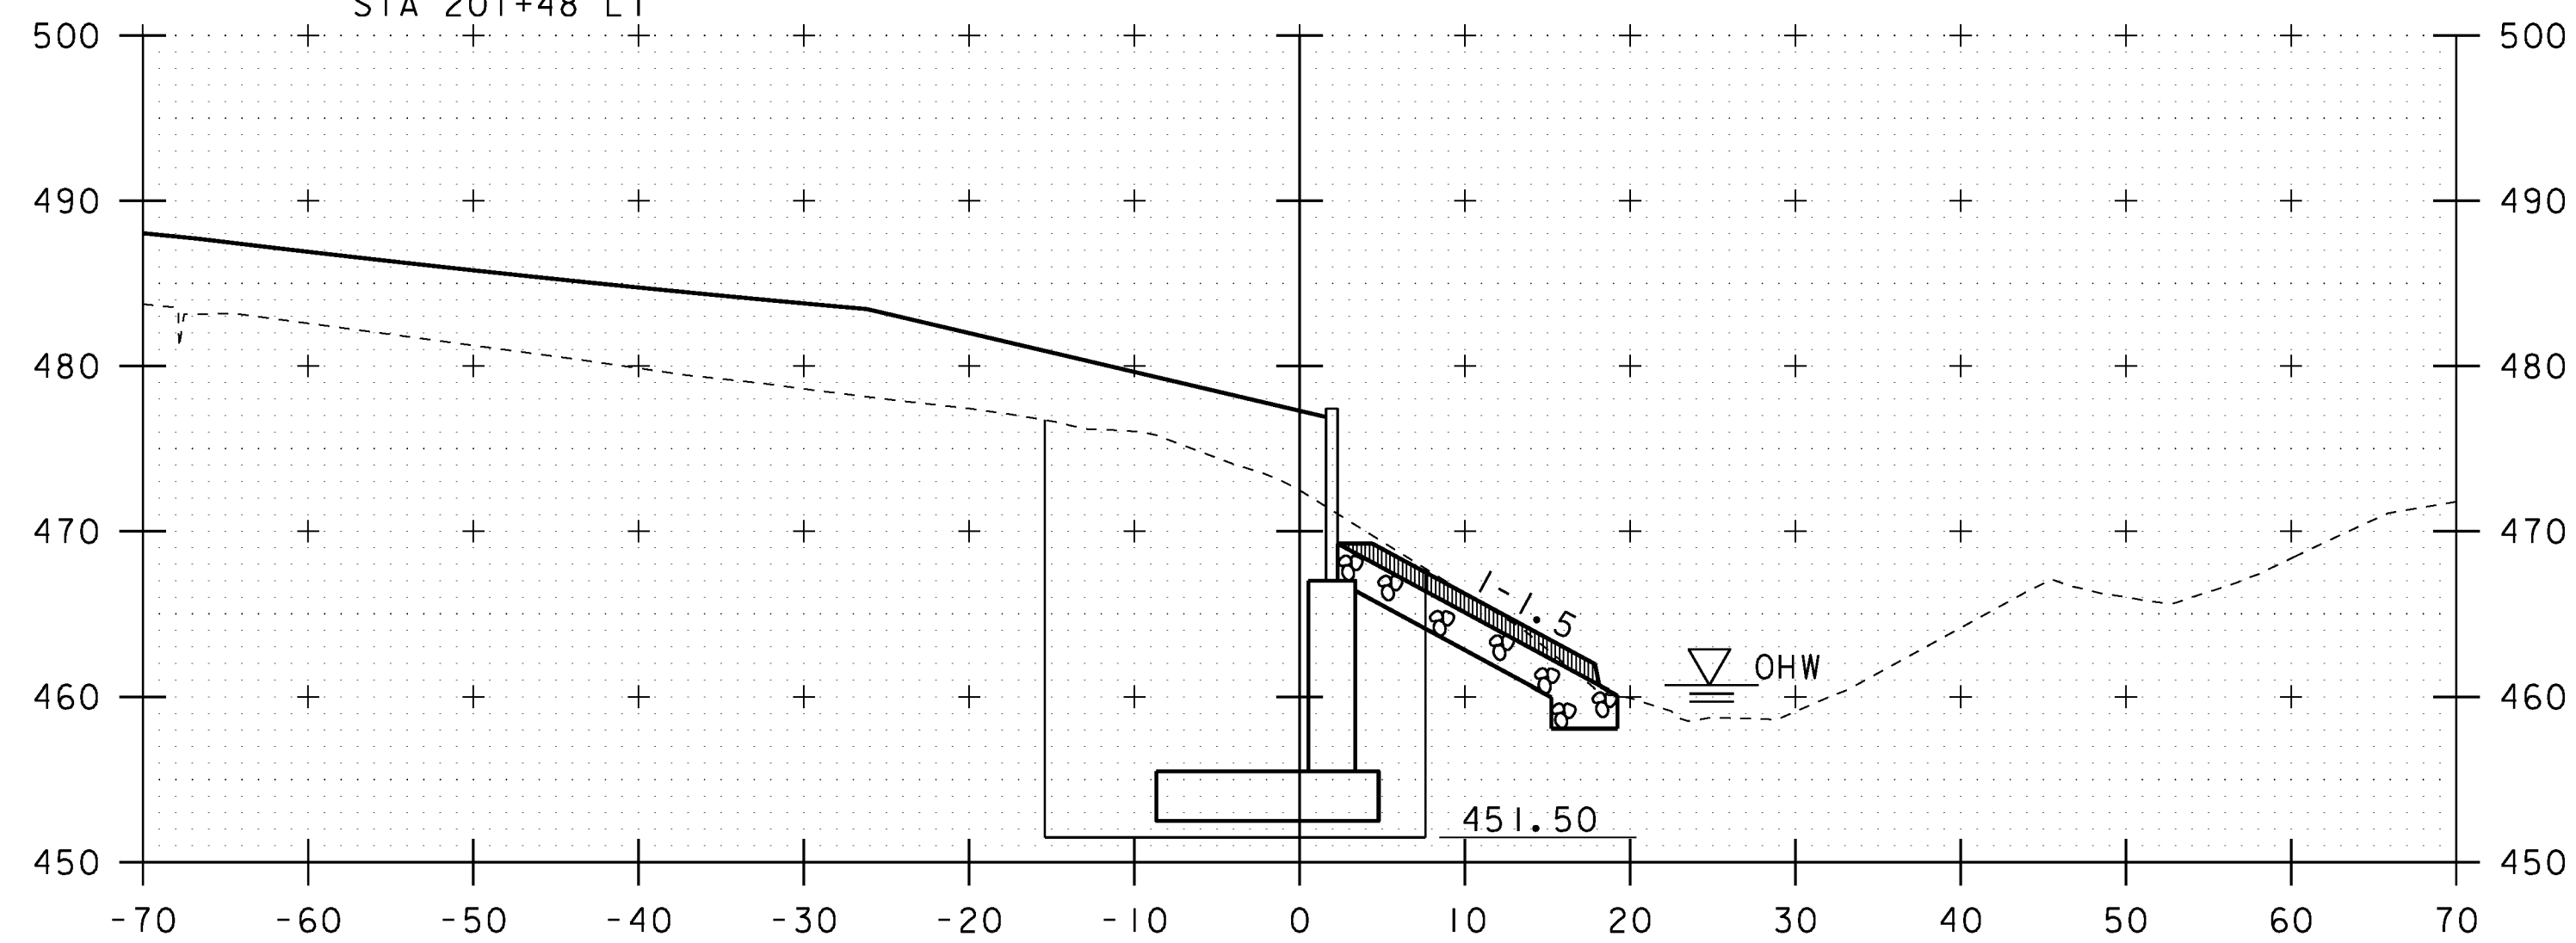


BEGIN
GRUBBING MATERIAL
STA 200+12 LT

201+25

END
UNCLASSIFIED CHANNEL EXCAVATION
GEOTEXTILE UNDER STONE FILL
STONE FILL, TYPE II
GRUBBING MATERIAL
STA 201+24 RT

BEGIN
GRUBBING MATERIAL
STA 201+08 RT

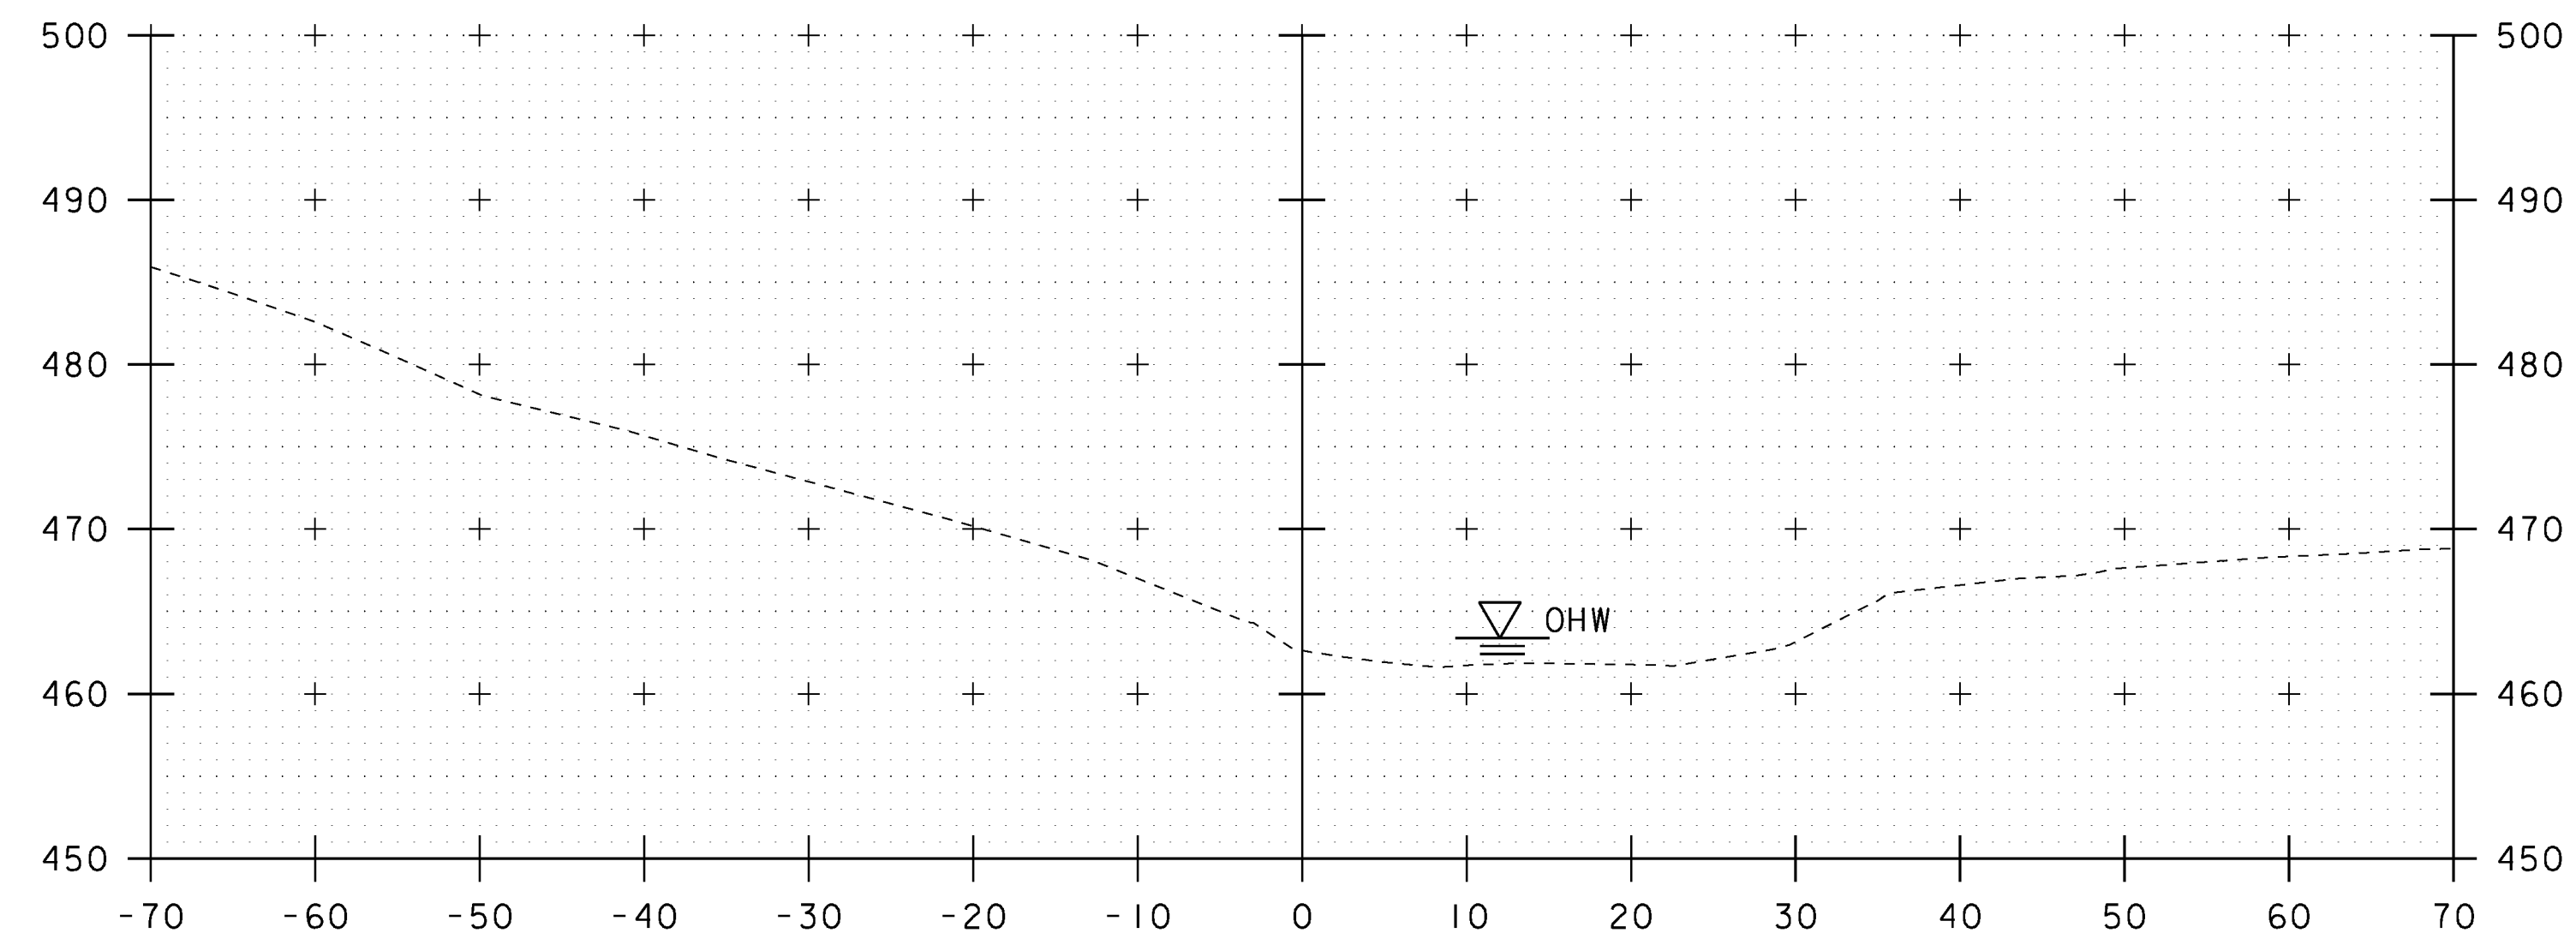

201+75

STA. 201+25 TO STA. 202+00

SCALE 1" = 10' - 0"
10 0 10




PROJECT NAME: FAIRFIELD
PROJECT NUMBER: BRO 1448(38)
FILE NAME: z11j072_xsl.dgn
PROJECT LEADER: D. LANDRY
DESIGNED BY: E. ALEXOPOULOS
CHANNEL CROSS SECTIONS (2 OF 2)

PLOT DATE: 01-NOV-2013
DRAWN BY: W. GAYNOR
CHECKED BY: T. KENDRICK
SHEET 41 OF 41


CONCRETE GENERAL NOTES

- ALL EXPOSED EDGES OF CONCRETE SHALL BE CHAMFERED 1" x 1"

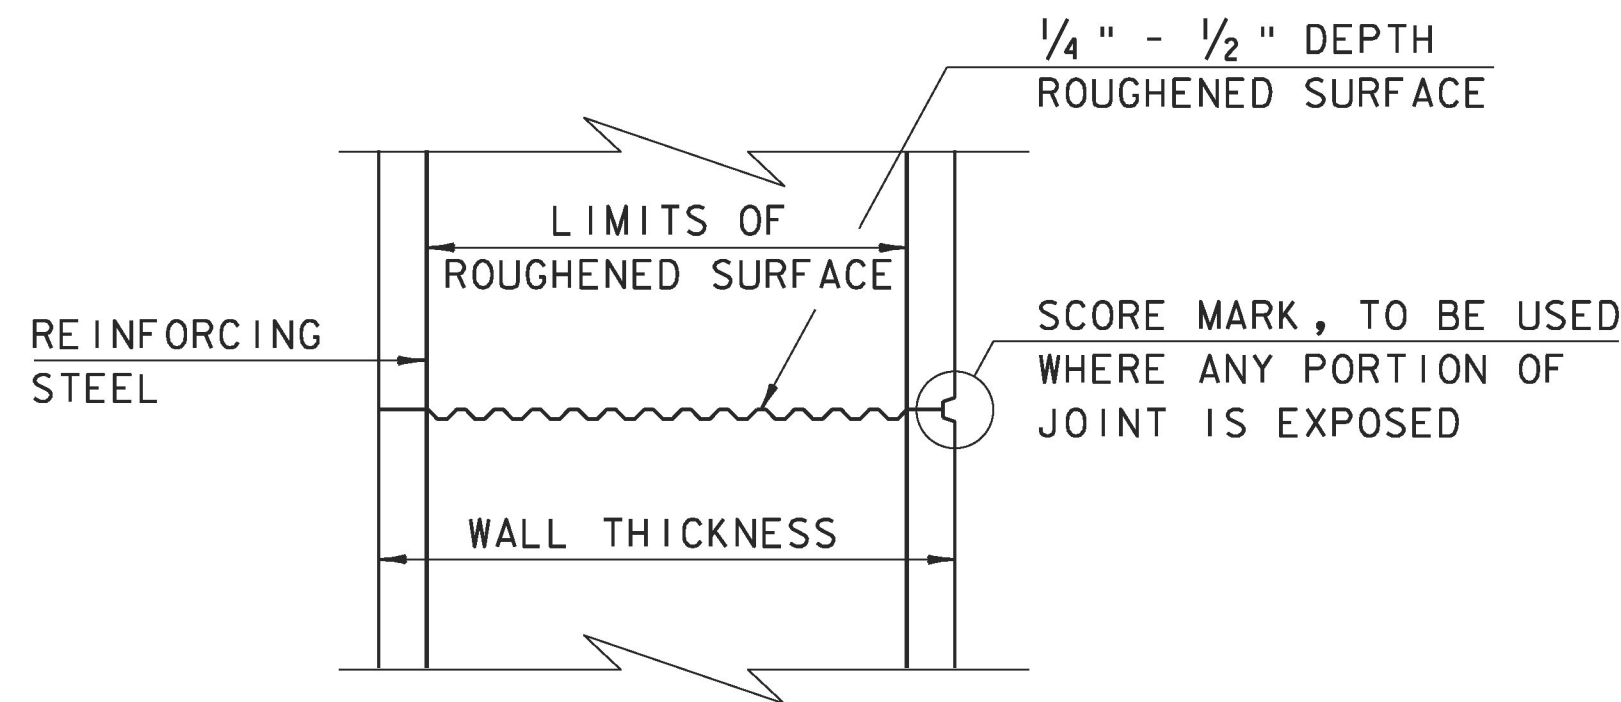


TYPICAL HORIZONTAL CONSTRUCTION JOINT
(NOT TO SCALE)


- THE SURFACE OF THE CONCRETE CONSTRUCTION JOINTS SHALL BE CLEANED AND FREE OF LAITANCE.
- IMMEDIATELY BEFORE NEW CONCRETE IS PLACED, ALL CONSTRUCTION JOINTS SHALL BE WETTED AND STANDING WATER REMOVED.

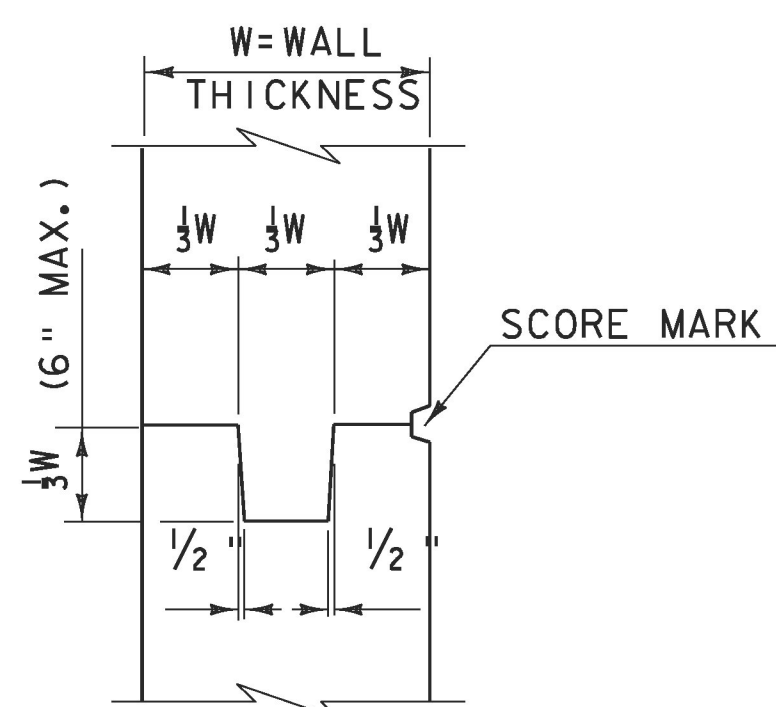


TYPICAL CONCRETE CONSTRUCTION JOINT
(NOT TO SCALE)

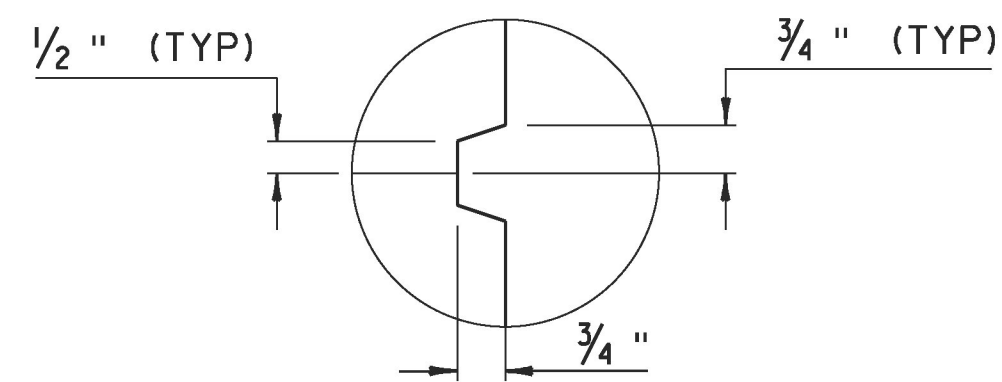


SCORE MARK DETAIL
(NOT TO SCALE)

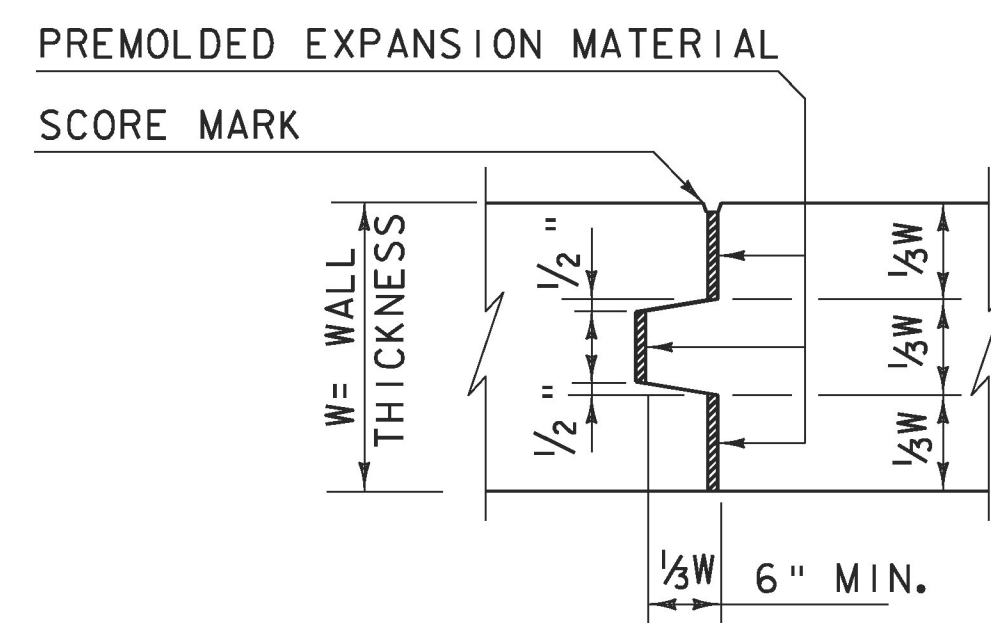

TYPICAL CONCRETE EXPANSION JOINT
(NOT TO SCALE)

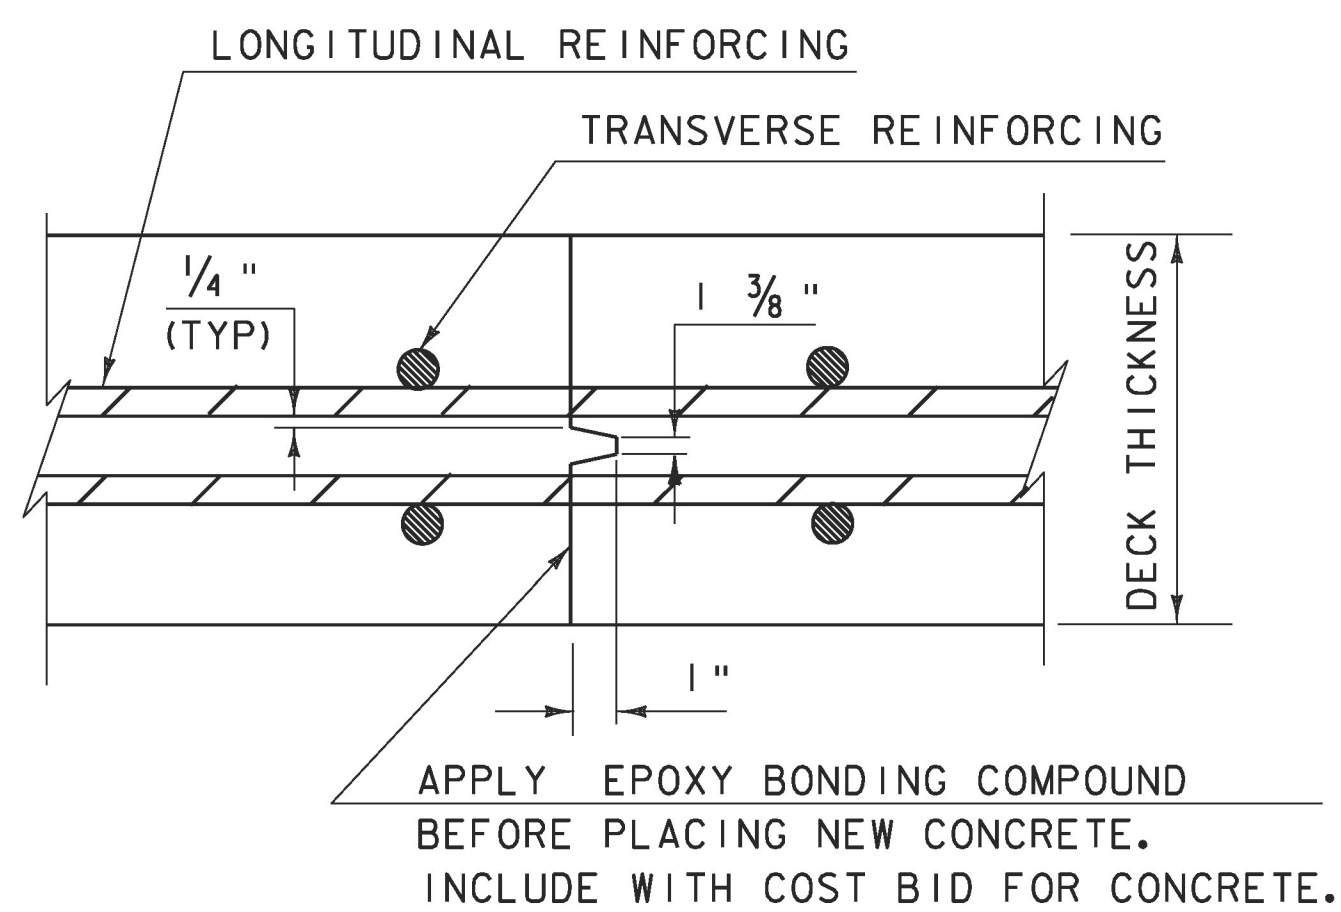


TRANSVERSE BRIDGE SLAB CONSTRUCTION JOINT DETAILS
(NOT TO SCALE)

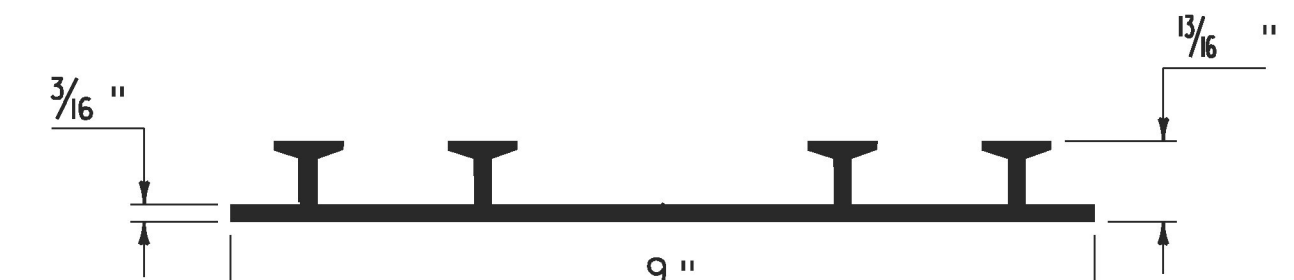

P.V.C. WATERSTOP FOR CONSTRUCTION JOINTS
(NOT TO SCALE)

PAYMENT FOR THE P.V.C. WATERSTOP SHALL BE INCIDENTAL TO THE UNIT BID PRICE FOR THE ADJACENT CONCRETE.


OTHER CONFIGURATIONS OF WATERSTOP MAY BE USED UPON APPROVAL OF THE ENGINEER.

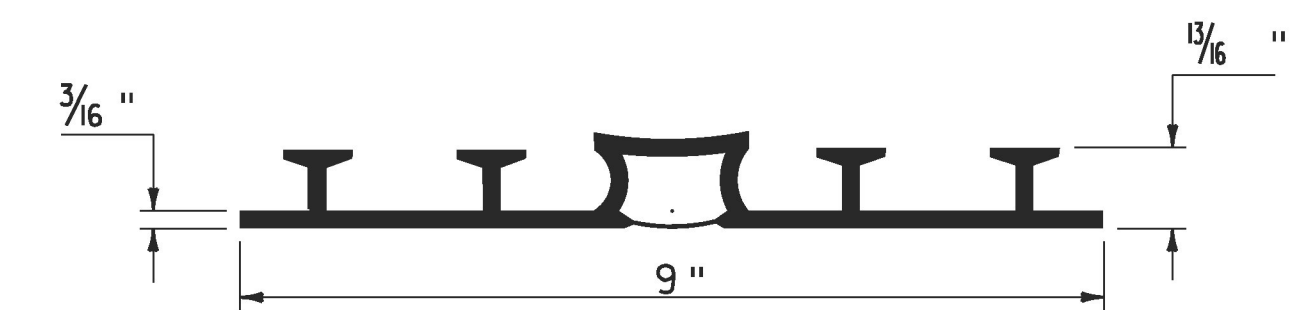

P.V.C. WATERSTOP FOR EXPANSION JOINTS
(NOT TO SCALE)

PAYMENT FOR THE P.V.C. WATERSTOP SHALL BE INCIDENTAL TO THE UNIT BID PRICE FOR THE ADJACENT CONCRETE.


OTHER CONFIGURATIONS OF WATERSTOP MAY BE USED UPON APPROVAL OF THE ENGINEER.

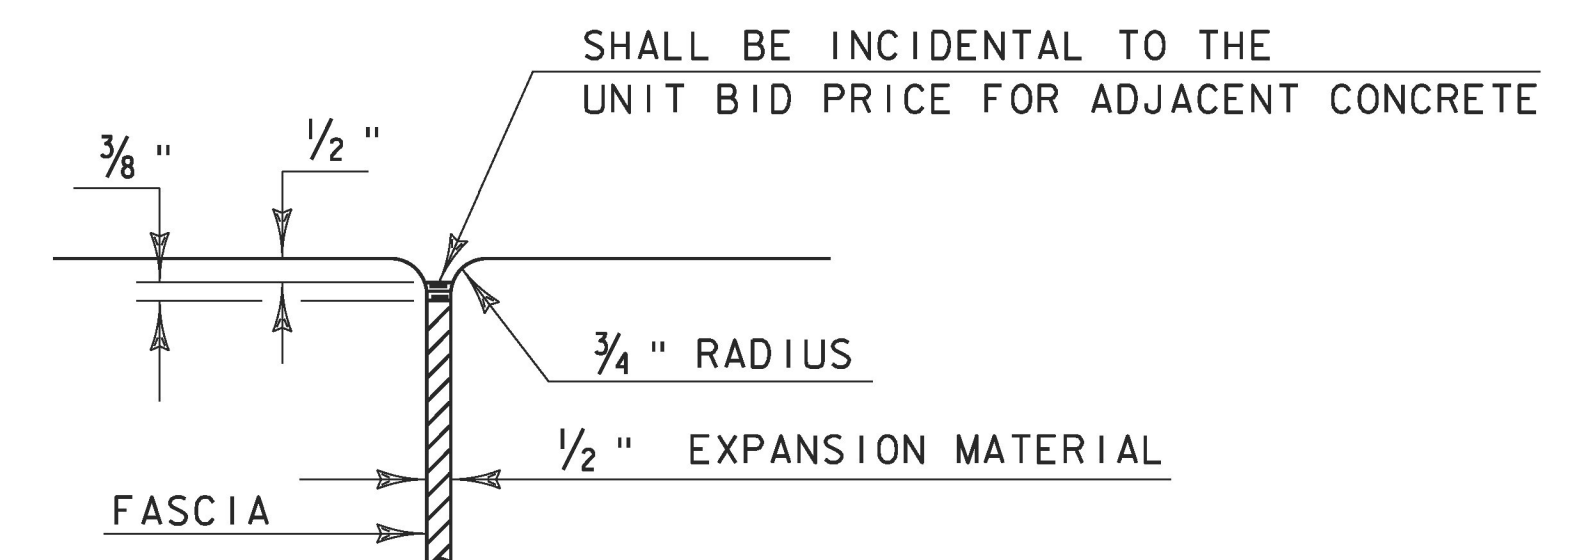

JOINT BETWEEN FASCIA AND WINGWALL
(NOT TO SCALE)

REVISIONS	
MAY 7, 2010	APPROVED FOR USE BY VAOT STRUCTURES SECTION

**CONCRETE
DETAILS AND NOTES**

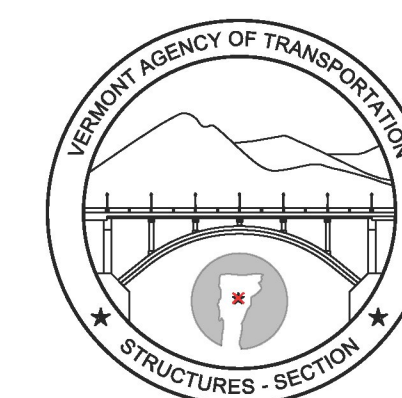


**STRUCTURES
DETAIL
SD-5 01.00**

WANZER ROAD OVER WANZER BROOK: BRO 1448(38)
(BRIDGE NO. 48)
FAIRFIELD
FRANKLIN COUNTY
VERMONT

INDEX

SHEET NO.	DESCRIPTION
1	TITLE SHEET AND INDEX
2	CONSTRUCTION NOTES
3	PLAN VIEW
4	SOUTH ELEVATION
5	NORTH ELEVATION
6	ARCH DETAILS
7	DECK DETAILS
8	HEADWALL LAYOUT
9	HEADWALL DETAILS
10	FASCIA PLATE LAYOUT AND DETAILS

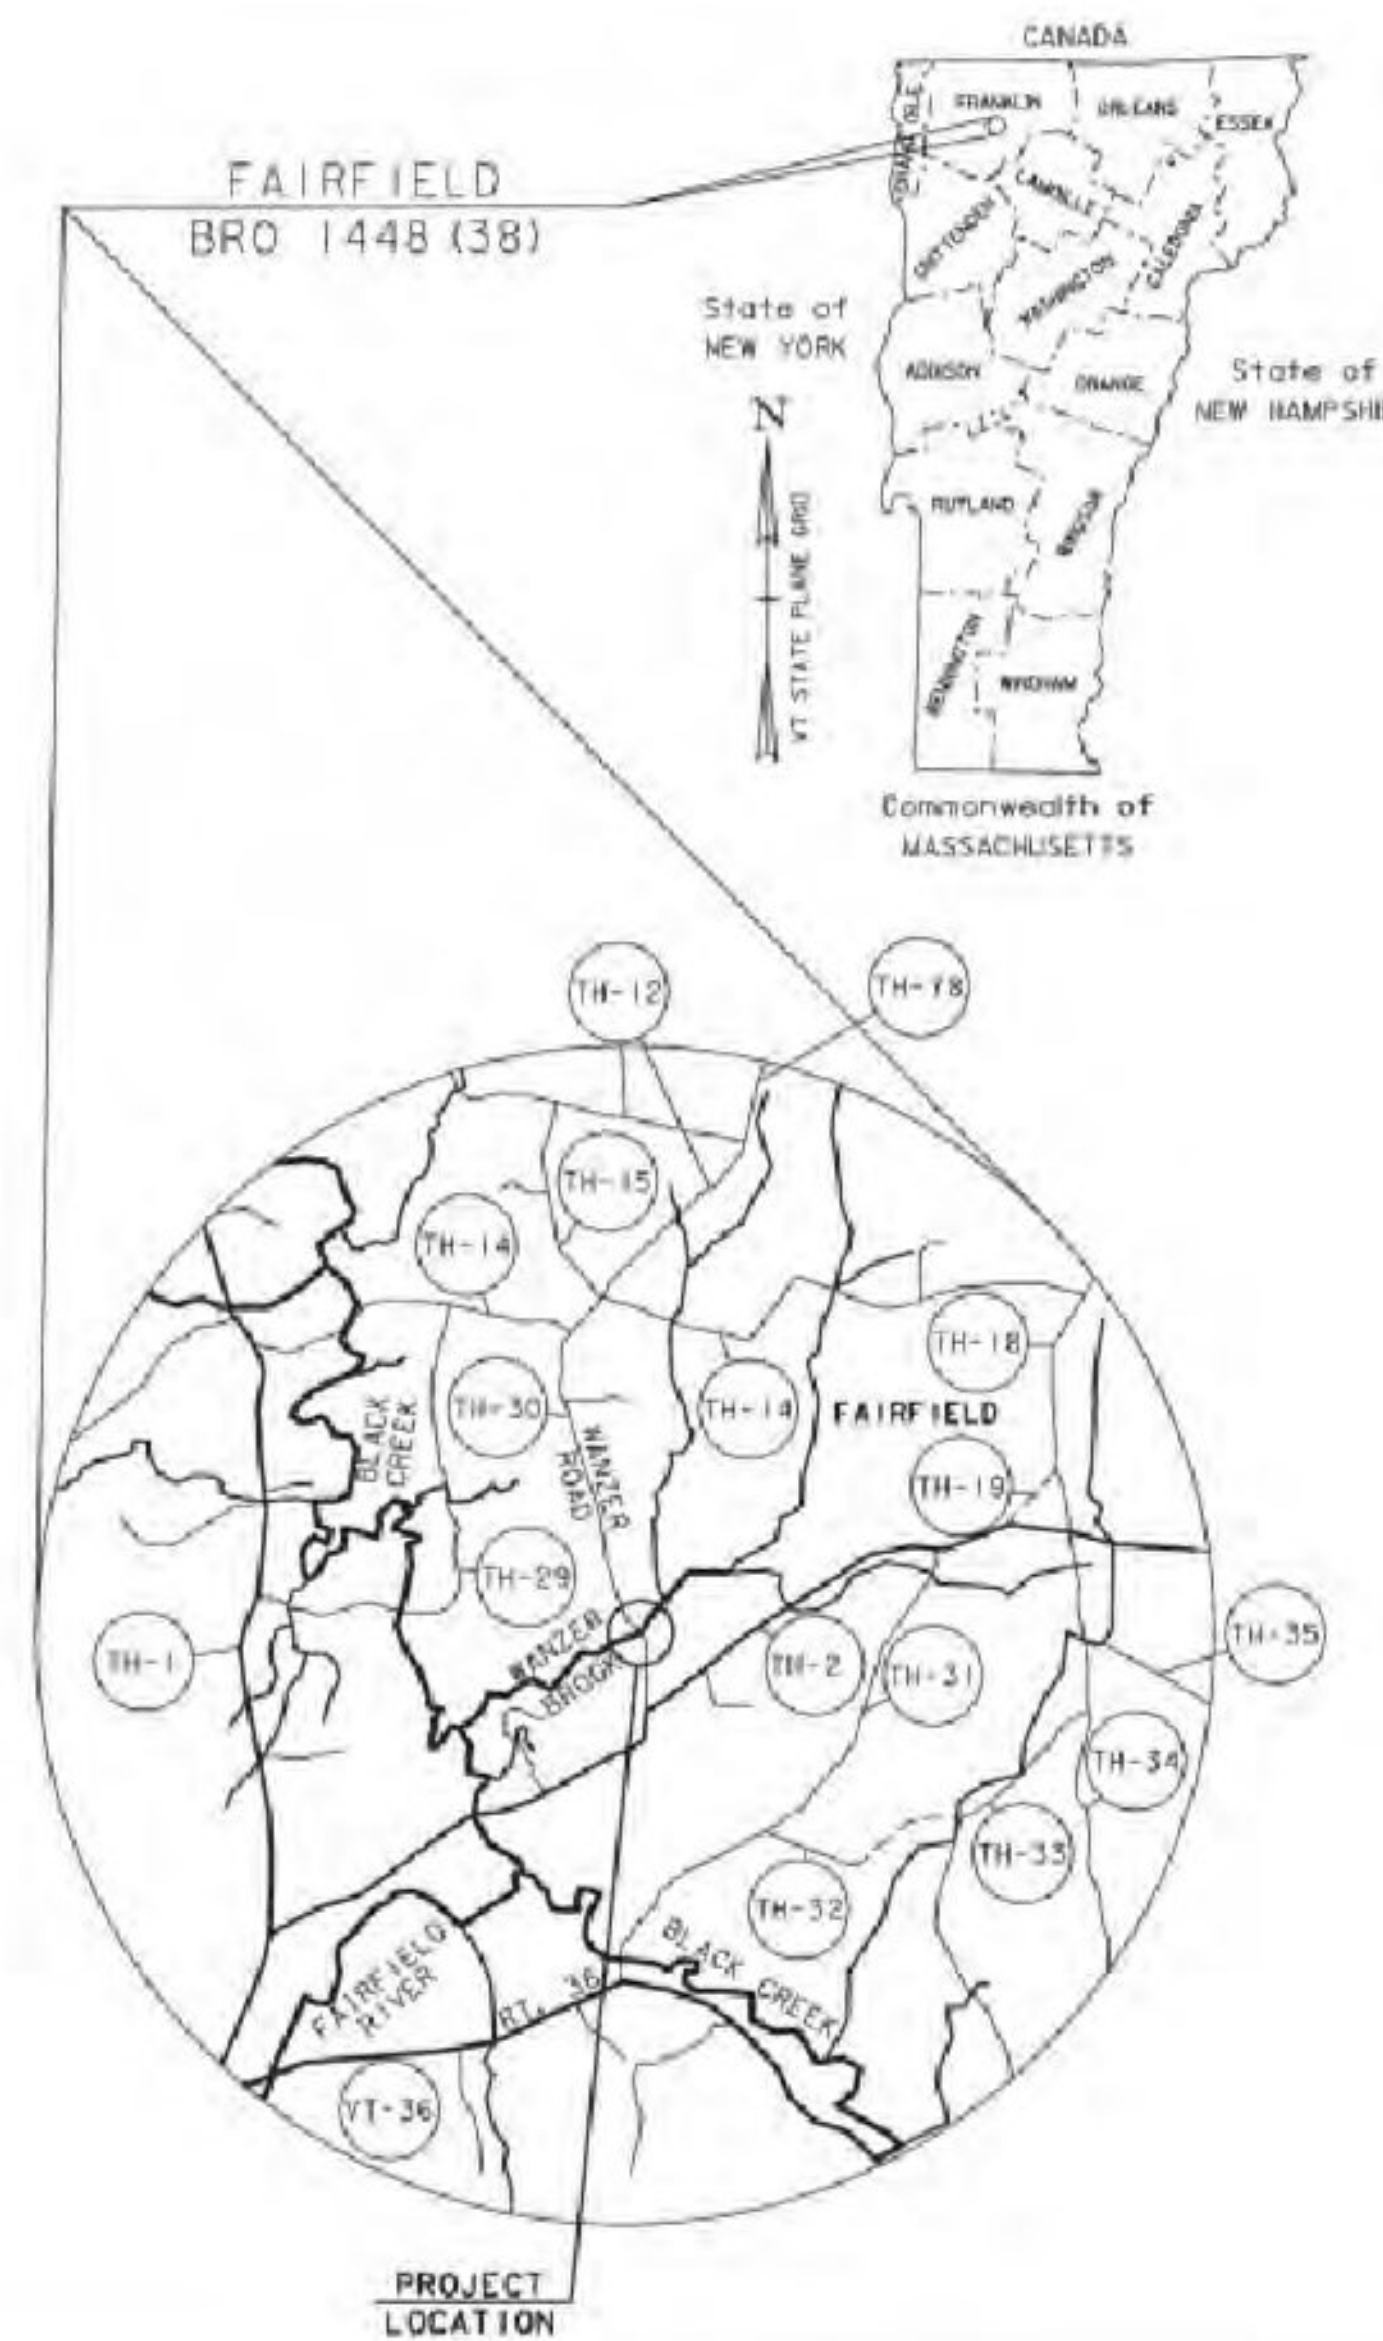

Approved **Approved As Noted**
 Rejected

This review is only for general conformance with the design concept and the information given in the Construction Documents. Corrections or comments made on the shop drawings during the review do not relieve the Contractor from compliance with the requirements of the Plans and Specifications. Review of a specific item shall not include review of an assembly of which an item is a component. The Contractor is responsible for dimensions to be confirmed and corrected at the job site; information that pertains solely to the fabrication process or to the means, methods, techniques, sequences and procedures of construction; coordination of the Work with that of other trades and performing all Work in a safe and satisfactory manner.

Date 6/6/2014
 By T. Traver

McFarland Johnson

THIS DRAWING IS THE PROPERTY OF "ADVANCED INFRASTRUCTURE TECHNOLOGIES, LLC" (AIT). IT IS MADE FOR THE EXCLUSIVE USE OF "AIT". NEITHER THE DRAWING OR REPRODUCTION OF IN NOR INFORMATION DERIVED FROM IT IS TO BE GIVEN TO OTHERS WITHOUT THE EXPRESSED CONSENT OF "AIT". NO USE IS TO BE MADE OF IT WHICH IS OR MAY BE IN ANY WAY INJURIOUS TO AND/OR CONTRARY TO THE INTERESTS OF "AIT". "AIT" MAKES NO REPRESENTATION OR WARRANTIES AS TO ANY USE OF THIS DRAWING OTHER THAN THAT OF WHICH "AIT" ORIGINALLY INTENDED. THIS COMPOSITE ARCH BRIDGE SYSTEM IS COVERED UNDER U.S. PATENT NUMBERS 7,811,495, 8,522,486, AND 8,591,788

"I HEREBY CERTIFY THAT ALL DESIGN ASSUMPTIONS HAVE BEEN VALIDATED EITHER THROUGH CONSTRUCTION DETAILS OR NOTES ON THESE DRAWINGS OR THROUGH THE CONTRACT PLANS AND PROVISIONS."

STATE OF VERMONT
 ZEVI BURHAN UZMAN
 No. 73284
 Structural
 LICENSED
 PROFESSIONAL ENGINEER

PREPARED BY:
 AIT BRIDGES
 20 GODFREY DRIVE
 ORONO, ME 04473

ENGINEER
 DATE

ADVANCED
INFRASTRUCTURE

TECHNOLOGIES

20 Godfrey Drive
 Orono, Maine 04473
 Tel 207.866.6526
 Fax 207.866.6501
 www.aitbridges.com

PROJECT: Wanzer Road Bridge No. 48	TITLE: TITLE SHEET AND INDEX		SHEET NUMBER:											
LOCATION: Fairfield, VT JN: 12018			1											
DRAWING STATUS: Approved for Construction			OF 10											
Correct scale on size B paper (11x17 Ledger)			REV: 05-20-2014											
	<table border="1" style="width: 100%; border-collapse: collapse;"> <thead> <tr> <th style="width: 30%;"></th> <th style="width: 20%;">INITIALS</th> <th style="width: 20%;">DATE</th> </tr> </thead> <tbody> <tr> <td>DRAWN BY:</td> <td style="text-align: center;">JEK</td> <td style="text-align: center;">4-9-2014</td> </tr> <tr> <td>DESIGNED BY:</td> <td style="text-align: center;">JEK</td> <td style="text-align: center;">4-9-2014</td> </tr> <tr> <td>CHECKED BY:</td> <td style="text-align: center;">ZU</td> <td style="text-align: center;">5-20-2014</td> </tr> </tbody> </table>		INITIALS	DATE	DRAWN BY:	JEK	4-9-2014	DESIGNED BY:	JEK	4-9-2014	CHECKED BY:	ZU	5-20-2014	
	INITIALS	DATE												
DRAWN BY:	JEK	4-9-2014												
DESIGNED BY:	JEK	4-9-2014												
CHECKED BY:	ZU	5-20-2014												

SUGGESTED CONSTRUCTION SEQUENCE:

1. FORM ABUTMENTS AND PLACE REBAR
2. ATTACH BEARING PLATE TO SPINE OF TWO OUTSIDE ARCHES (SEE SHEET 9 DETAIL A)
3. INSERT END REINFORCEMENT CAGES INTO ARCH ENDS AND INSTALL ARCHES IN ABUTMENTS
4. PLACE DECKING - CUT TO FIT SKEW - SCREW TO ARCHES - DRILL SHEAR BOLT HOLES AND INSTALL SHEAR BOLTS - INSTALL HEADWALL CLIPS ON OUTER ARCHES
5. CAST ARCHES IN ABUTMENTS
6. DRILL 3" HOLE AT APEX OF ARCH AND FILL ARCHES WITH SELF-CONSOLIDATING CONCRETE - INSTALL CLOSURE STRIP OF DECKING AT APEX OF ARCH TO COVER FILL HOLES
7. INSTALL HEADWALL HARDWARE - ERECT AND TEMPORARILY BRACE HEADWALLS
8. BACKFILL STRUCTURE ATTACHING PRIMARY GEOTEXTILE AT 32" LIFTS TO HEADWALL AND PLACING SECONDARY GEOTEXTILE HALF WAY BETWEEN PRIMARY GEOTEXTILE LIFTS (SEE SHEET 8 FOR DETAILS)
9. INSTALL HEADWALL CAP AND FASCIA PLATES

ARCH FILLING NOTES:

1. SELF-CONSOLIDATING CONCRETE MAY BE PLACED BY PUMP OR WITH A CONCRETE BUCKET AND FUNNEL
2. EACH ARCH WILL TAKE AN ESTIMATED 1.3 CUBIC YARDS OF CONCRETE
3. NO CONCRETE SHALL BE PLACED IN THE ARCH IF IT DOES NOT MEET THE SLUMP FLOW REQUIREMENTS OF 24" - 30" SPREAD
4. DRILL THE 3" FILL HOLE IN THE ARCH AT THE APEX BETWEEN THE GAP IN THE DECKING. LEAVE THE SHEAR BOLTS OUT OF THE ADJACENT CORRUGATIONS TO ALLOW AIR VENTING DURING FILLING. INSERT SHEAR BOLTS AND PLACE CLOSURE STRIP AFTER FILLING IS COMPLETE.
5. ARCHES CAN BE INSPECTED FOR VOIDS AFTER FILLING BY TAPPING THE ARCH AND LISTENING FOR A HOLLOW SOUND. REPAIR IN ACCORDANCE WITH THE SPECIFICATIONS.

HEADWALL CONSTRUCTION NOTES:

1. THE CENTER PANEL SHOULD BE CENTERED OVER THE APEX OF THE ARCH
2. PANELS MUST BE JOINED BY INSERTING THE BUTTERFLY TOGGLE IN THE KEY WAY. THE TOGGLE MAY BE CUT AND INSERTED WITH THE AID OF A PALM HAMMER
3. HEADWALL BACK BATTER OF 1:32 IS TYPICAL TO RESULT IN A VERTICAL INSTALLATION AFTER BACKFILL. ADJUST IN FIELD AS NECESSARY
4. USE ONLY WALK BEHIND COMPACTORS WITHIN 3 FEET OF HEADWALL WITH A MINIMUM OF THREE PASSES
5. BACKFILL ARCH IN MAXIMUM 8" LOOSE LIFTS, ALTERNATING LIFTS ON EACH SIDE OF THE ARCH TO MAINTAIN BALANCED LOADING. THE MAXIMUM DEVIATION FROM EQUAL BACKFILLING WILL BE 24 INCHES.

MATERIAL NOTES:

1. SELECT BACKFILL SHALL CONTAIN NOT MORE THAN 5% FINES (US NO. 200 SIEVE)
2. ALL STRUCTURAL FASTENERS SHALL CONFORM TO AASHTO M232 HOT DIP GALV.
3. ALL SCREWS SHALL BE 410 STAINLESS STEEL
4. STRUCTURAL ADHESIVE SHALL BE PLOGRIP 7770 OR APPROVED EQUAL

SUPPLIED PARTS LIST:

- | | | |
|-----|------------|--|
| 1. | 9 UNITS | COMPOSITE ARCHES |
| 2. | 25 UNITS | ATLAS DECK PANELS, 42' x 20.9' x 3.7' - FIELD FITTING REQUIRED |
| 3. | 1 UNIT | DECK CLOSURE STRIP, 42' LONG 1/4"x8" FRP PLATE |
| 4. | 1 LUMP SUM | STRUCTURAL ADHESIVE FOR DECK TO DECK CONNECTION, PLOGRIP 7770 |
| 5. | 1 LUMP SUM | DECKING SCREWS, 1/4"x2" ZINC PLATED |
| 6. | 1 LUMP SUM | DECK-TO-ARCH SHEAR BOLTS, 1/2"x8" |
| 7. | 1 LUMP SUM | HEADWALL TO DECK BASE ANGLES, (A36 GALV.) 2" WIDE L7"x4"x 3/8" |
| 8. | 38 UNITS | HEADWALL PANELS - PRE-CUT AND PRE-DRILLED |
| 9. | 1 LUMP SUM | HEADWALL BUTTERFLY TOGGLE CONNECTION, 20' SECTIONS |
| 10. | 1 LUMP SUM | HEADWALL WALER, 23-1/2" SECTIONS |
| 11. | 1 LUMP SUM | HEADWALL CHANNEL CAP, 20' SECTIONS |
| 12. | 1 LUMP SUM | HEADED BOLTS FOR HEADWALL ATTACHMENT (A307 GR. A), 1/2"x10" |
| 13. | 1 LUMP SUM | 1/2" x3-3/16" SCH.40 SPACER PIPE (A53 GR. B) |
| 14. | 1 LUMP SUM | 1/2" HEAVY HEX NUT (A564DH GR. A) |
| 15. | 1 LUMP SUM | 1/2" GALVANIZED ROUND WASHER |
| 16. | 1 LUMP SUM | 3/8"x4-1/4" OD x 9/16" ID GALVANIZED PLATE WASHER |
| 17. | 1 LUMP SUM | PRIMARY GEOGRID REINFORCEMENT, 6'x150' ROLLS |
| 18. | 1 LUMP SUM | SECONDARY GEOGRID REINFORCEMENT, 6' x150' ROLLS |
| 19. | 1 LUMP SUM | BEARING PLATES FOR OUTSIDE ARCHES, 3/8"x8" |
| 20. | 1 LUMP SUM | #6 1" SCREWS FOR BEARING PLATE-TO-ARCH CONNECTION AND HEADWALL CAP |
| 21. | 22 UNITS | FASCIA PLATES, 1/10"x8"x48" |

Approved **Approved As Noted**
 Rejected

This review is only for general conformance with the design concept and the information given in the Construction Documents. Corrections or comments made on the shop drawings during the review do not relieve the Contractor from compliance with the requirements of the Plans and Specifications. Review of a specific item shall not include review of an assembly of which an item is a component. The Contractor is responsible for dimensions to be confirmed and corrected at the job site; information that pertains solely to the fabrication process or to the means, methods, techniques, sequences and procedures of construction; coordination of the Work with that of other trades and performing all Work in a safe and satisfactory manner.




McFarland Johnson

Date 6/6/2014

By T. Traver



<p>ADVANCED INFRASTRUCTURE TECHNOLOGIES</p> <p>20 Godfrey Drive Orono, Maine 04473 Tel 207.866.6526 Fax 207.866.6501 www.aitbridges.com</p>	PROJECT: Wanzer Road Bridge No. 48	TITLE: CONSTRUCTION NOTES			SHEET NUMBER: 2 OF 10
	LOCATION: Fairfield, VT JN: 12018	INITIALS DATE			
	DRAWING STATUS: Approved for Construction	DRAWN BY:	JEK	4-9-2014	REV: 05-20-2014
	Correct scale on size B paper (11x17 Ledger)	DESIGNED BY:	JEK	4-9-2014	
	CHECKED BY:	ZU	5-20-2014		

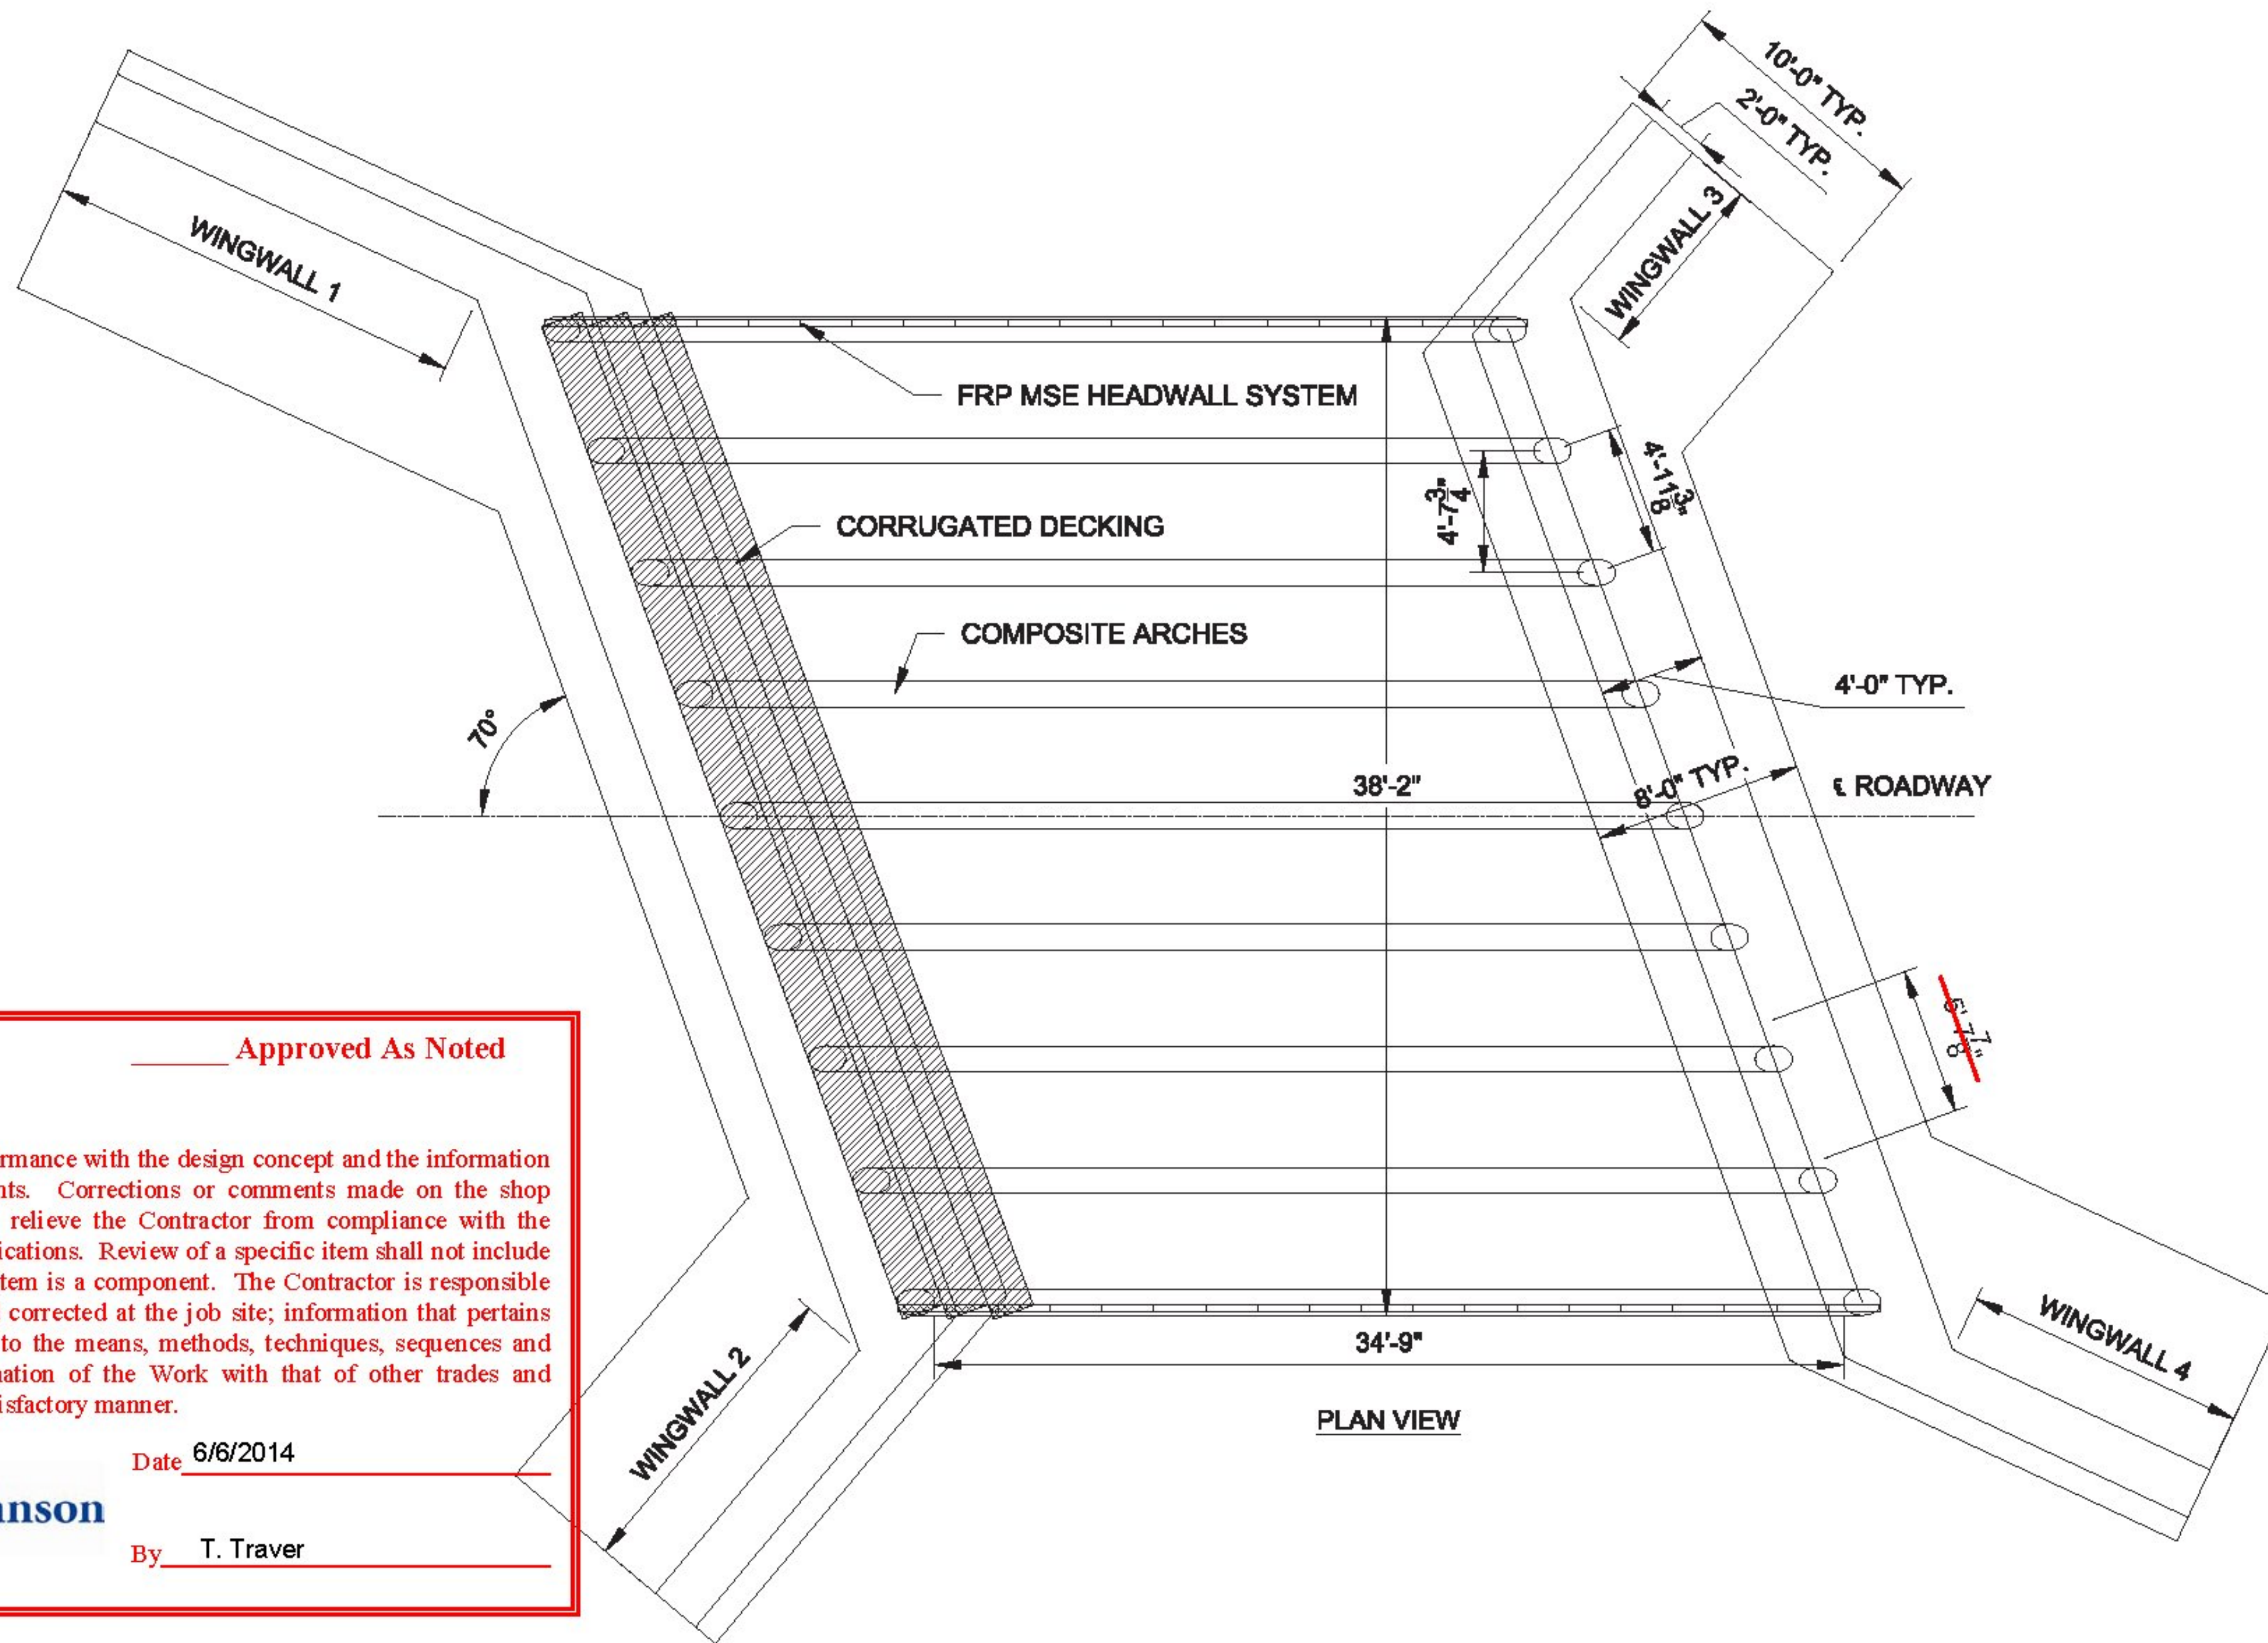

Approved
 Rejected

Approved As Noted

This review is only for general conformance with the design concept and the information given in the Construction Documents. Corrections or comments made on the shop drawings during the review do not relieve the Contractor from compliance with the requirements of the Plans and Specifications. Review of a specific item shall not include review of an assembly of which an item is a component. The Contractor is responsible for dimensions to be confirmed and corrected at the job site; information that pertains solely to the fabrication process or to the means, methods, techniques, sequences and procedures of construction; coordination of the Work with that of other trades and performing all Work in a safe and satisfactory manner.


Date 6/6/2014
 By T. Traver



ADVANCED INFRASTRUCTURE TECHNOLOGIES

20 Godfrey Drive
Orono, Maine 04473
Tel 207.866.6526
Fax 207.866.6501
www.aitbridges.com

PROJECT: Wanzer Road Bridge No. 48		TITLE: PLAN		SHEET NUMBER:		
LOCATION: Fairfield, VT		JN: 12018		<div style="font-size: 2em; font-weight: bold;">3</div> OF 10		
DRAWING STATUS: Approved for Construction		DRAWN BY:	JEK			4-9-2014
Correct scale on size B paper (11x17 Ledger)		DESIGNED BY:	JEK			4-9-2014
		CHECKED BY:	ZU	5-20-2014	REV: 05-20-2014	

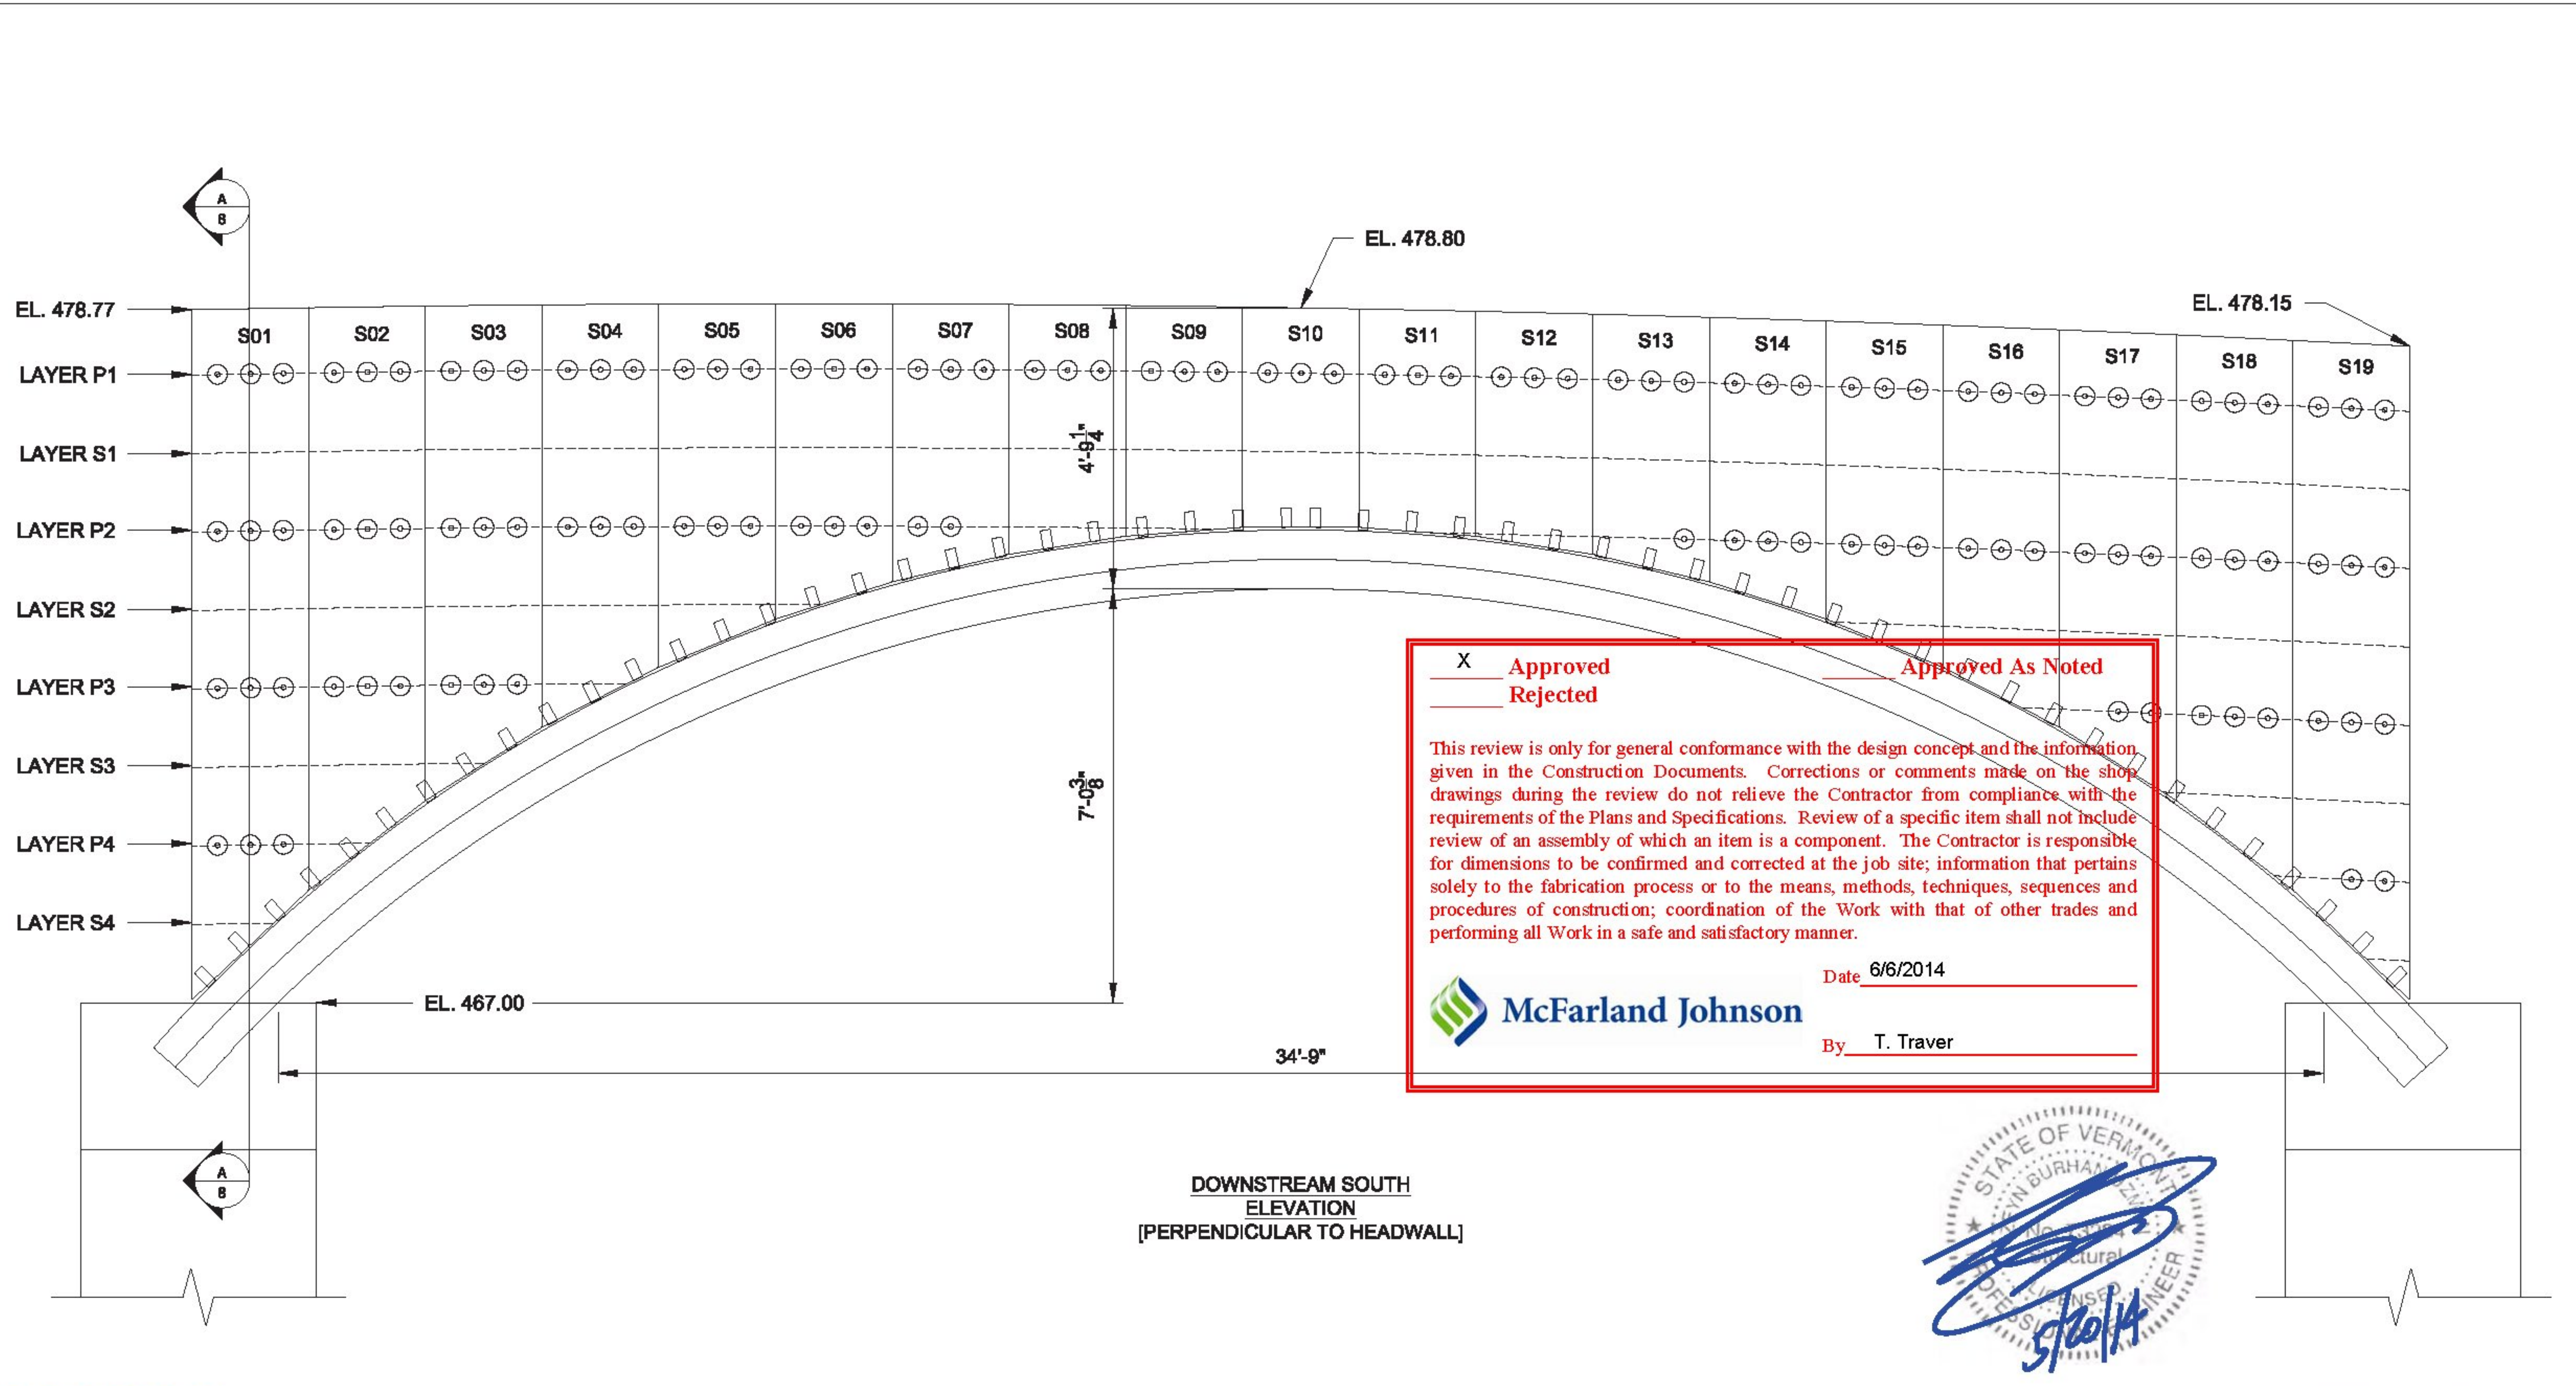

DOWNSTREAM SOUTH
ELEVATION
[PERPENDICULAR TO HEADWALL]

**ADVANCED
INFRASTRUCTURE
TECHNOLOGIES**


20 Godfrey Drive
Orono, Maine 04473
Tel 207.866.6526
Fax 207.866.6501
www.aitbridges.com

PROJECT: Wanzer Road Bridge No. 48
 LOCATION: Fairfield, VT JN: 12018
 DRAWING STATUS: Approved for Construction
 Correct scale on size B paper (11x17 Ledger)

TITLE: SOUTH ELEVATION

	INITIALS	DATE
DRAWN BY:	JEK	4-9-2014
DESIGNED BY:	JEK	4-9-2014
CHECKED BY:	ZU	5-20-2014

SHEET NUMBER:
4 OF 10
REV: 05-20-2014

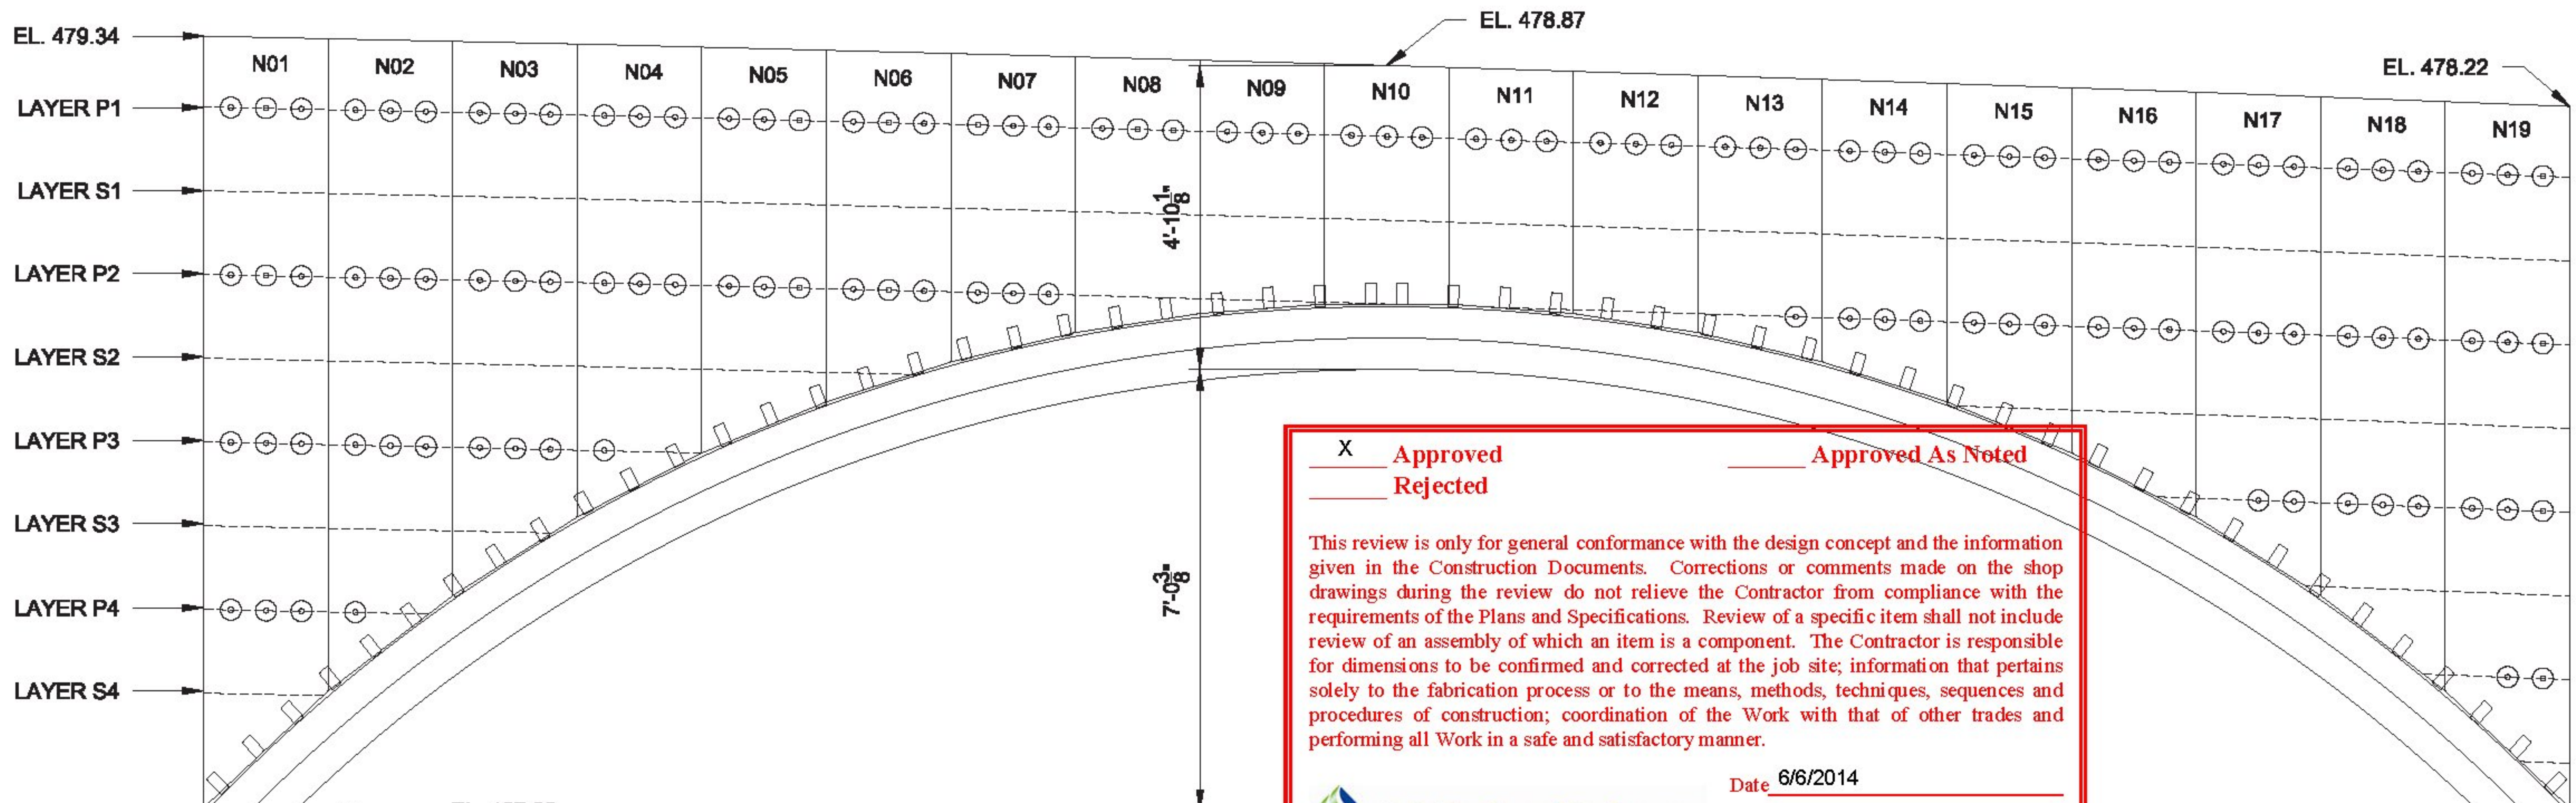

Approved
 Rejected
 Approved As Noted

This review is only for general conformance with the design concept and the information given in the Construction Documents. Corrections or comments made on the shop drawings during the review do not relieve the Contractor from compliance with the requirements of the Plans and Specifications. Review of a specific item shall not include review of an assembly of which an item is a component. The Contractor is responsible for dimensions to be confirmed and corrected at the job site; information that pertains solely to the fabrication process or to the means, methods, techniques, sequences and procedures of construction; coordination of the Work with that of other trades and performing all Work in a safe and satisfactory manner.

Date 6/6/2014
 By T. Traver

UPSTREAM NORTH ELEVATION
[PERPENDICULAR TO HEADWALL]




20 Godfrey Drive
 Orono, Maine 04473
 Tel 207.866.6526
 Fax 207.866.6501
 www.aitbridges.com


PROJECT: Wanzer Road Bridge No. 48	TITLE: NORTH ELEVATION		SHEET NUMBER:
LOCATION: Fairfield, VT	JN: 12018	INITIALS	DATE
DRAWING STATUS: Approved for Construction	DRAWN BY: JEK	4-9-2014	5 OF 10
Correct scale on size B paper (11x17 Ledger)	DESIGNED BY: JEK	4-9-2014	
	CHECKED BY: ZU	5-20-2014	
			REV: 05-20-2014

FINISHING NOTES:

1. ARCH MATERIALS SHALL CONFORM TO SECTION 3 OF "AASHTO LRFD GUIDE SPECIFICATIONS FOR DESIGN OF CONCRETE-FILLED FRP TUBES FOR FLEXURAL AND AXIAL MEMBERS"
2. PROJECT SHALL INCLUDE NINE (9) COMPOSITE ARCHES. ONE (1) LAYER OF AIT12GNP, THREE (3) LAYERS OF AIT12GS, AND DEREKANE 610C VINYL ESTER RESIN.
3. PROJECT SHALL INCLUDE EIGHTEEN (18) END REINFORCEMENT CAGES - SUPPLIED BY ERECTION CONTRACTOR
4. ARCH FINISH COAT SHALL BE SHERWIN-WILLIAMS FLUOROKEM FLUOROPOLYMER URETHANE MCSO SW4028 GYPSUM COLORED PAINT
5. ARCHES SHALL BE MANUFACTURED FOLLOWING AIT QUALITY ASSURANCE PLAN REV. 3.0
6. 3"Ø FILL HOLE AND SHEAR BOLT HOLES SHALL BE DRILLED IN THE FIELD BY ERECTION CONTRACTOR

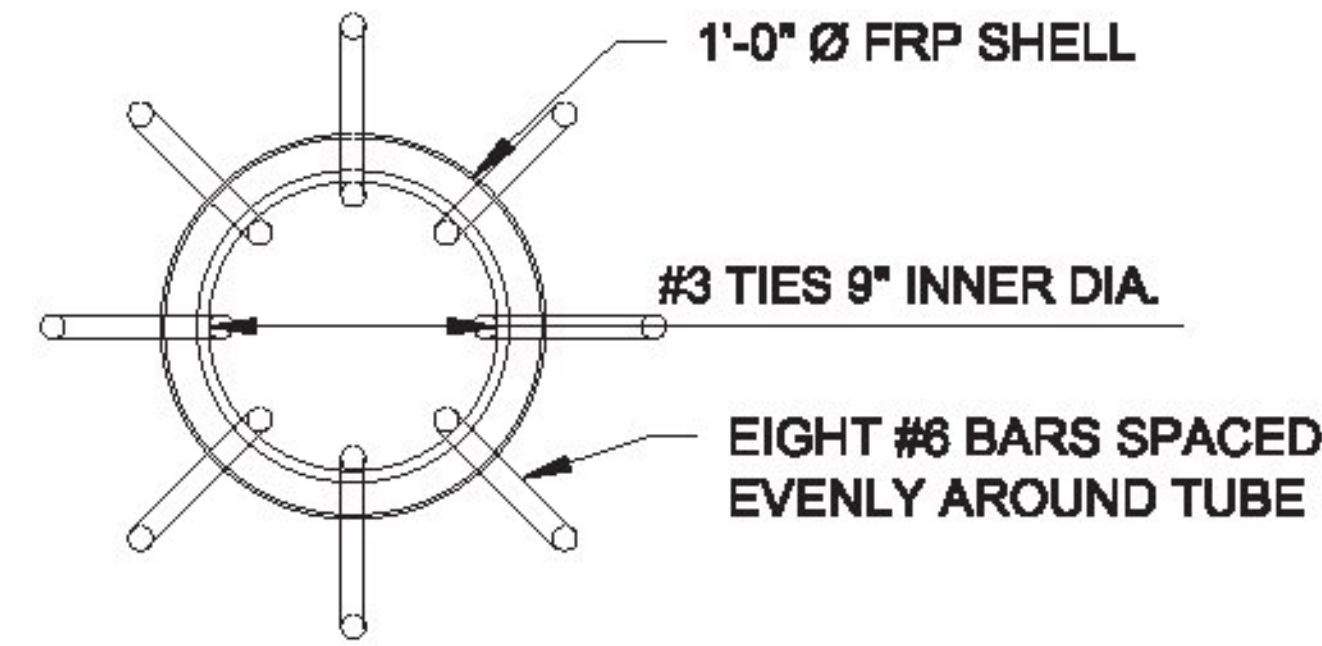

**END REINFORCEMENT CAGE
END VIEW SECTION A-A**

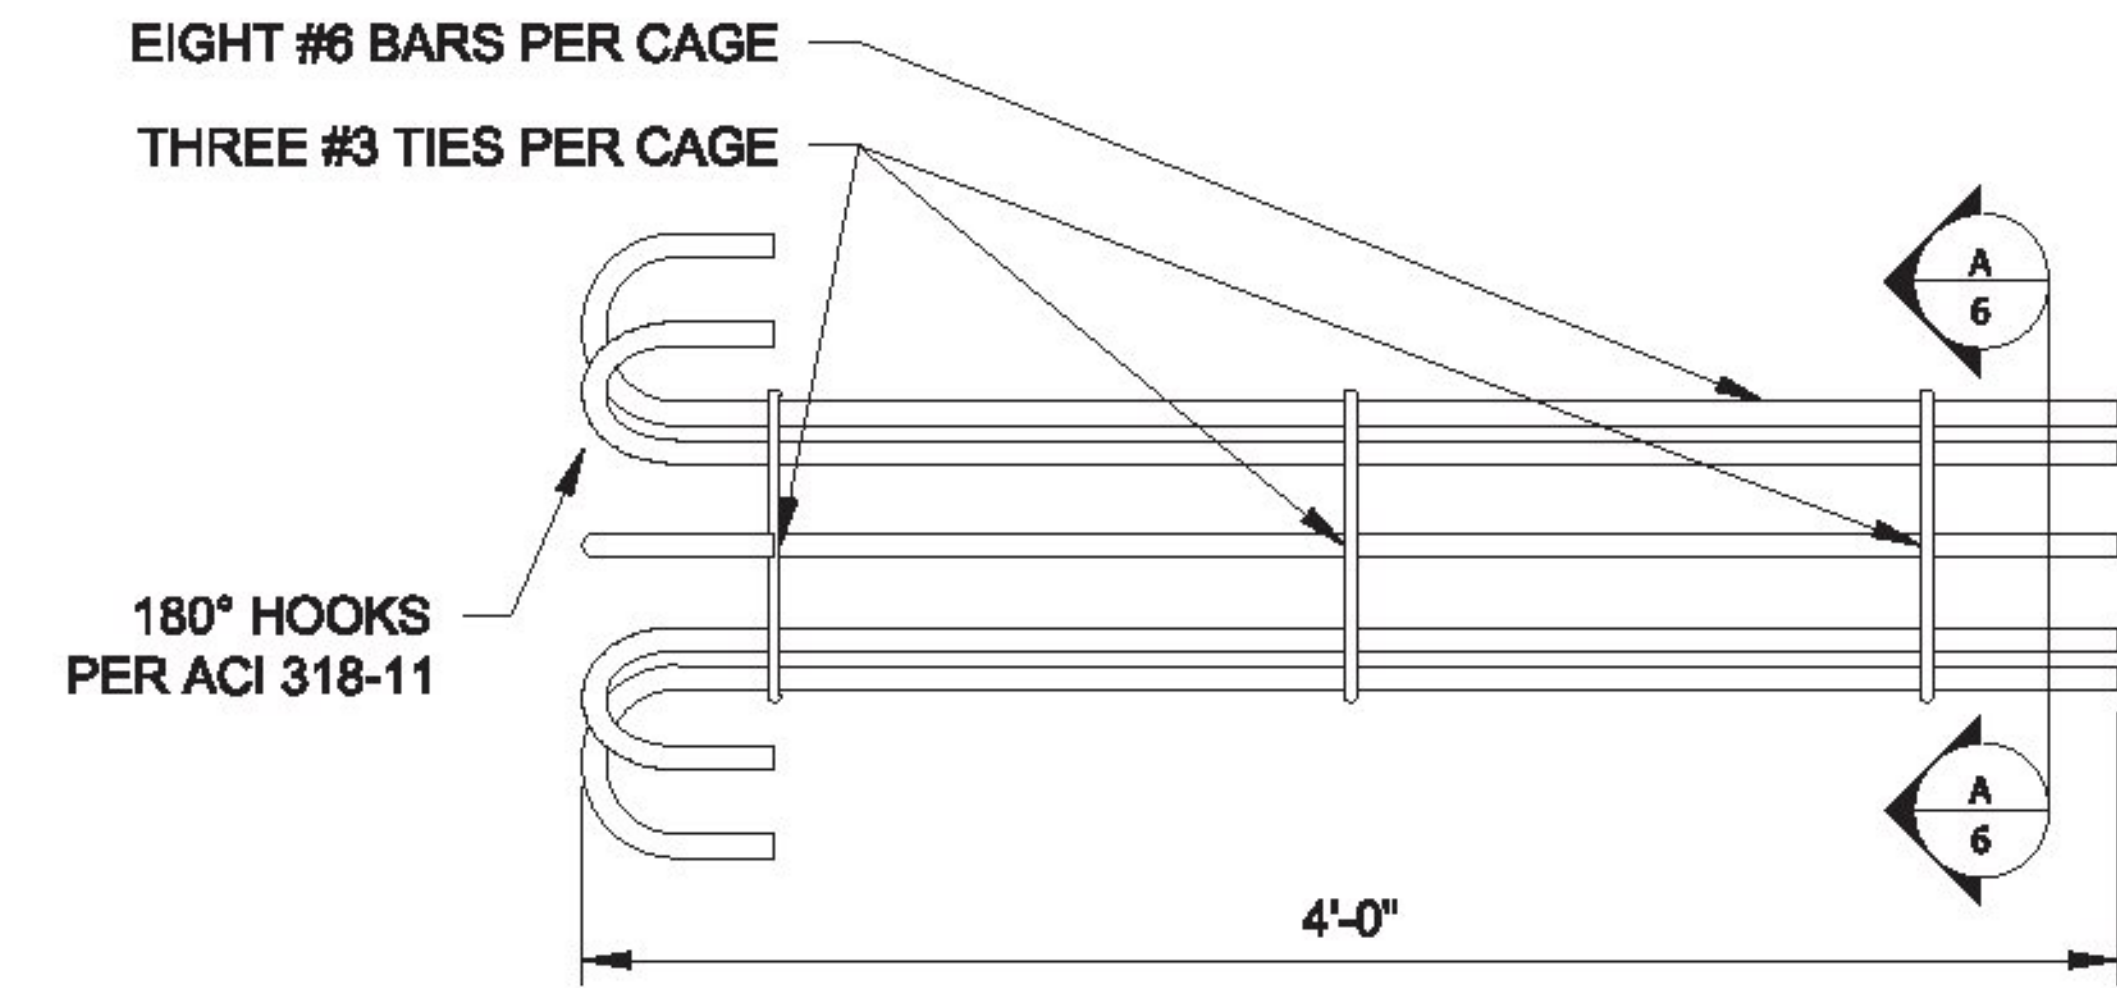


**END REINFORCEMENT CAGE
ELEVATION VIEW**


Approved
 Approved As Noted
 Rejected

This review is only for general conformance with the design concept and the information given in the Construction Documents. Corrections or comments made on the shop drawings during the review do not relieve the Contractor from compliance with the requirements of the Plans and Specifications. Review of a specific item shall not include review of an assembly of which an item is a component. The Contractor is responsible for dimensions to be confirmed and corrected at the job site; information that pertains solely to the fabrication process or to the means, methods, techniques, sequences and procedures of construction; coordination of the Work with that of other trades and performing all Work in a safe and satisfactory manner.

Date 6/6/2014
 By T. Traver

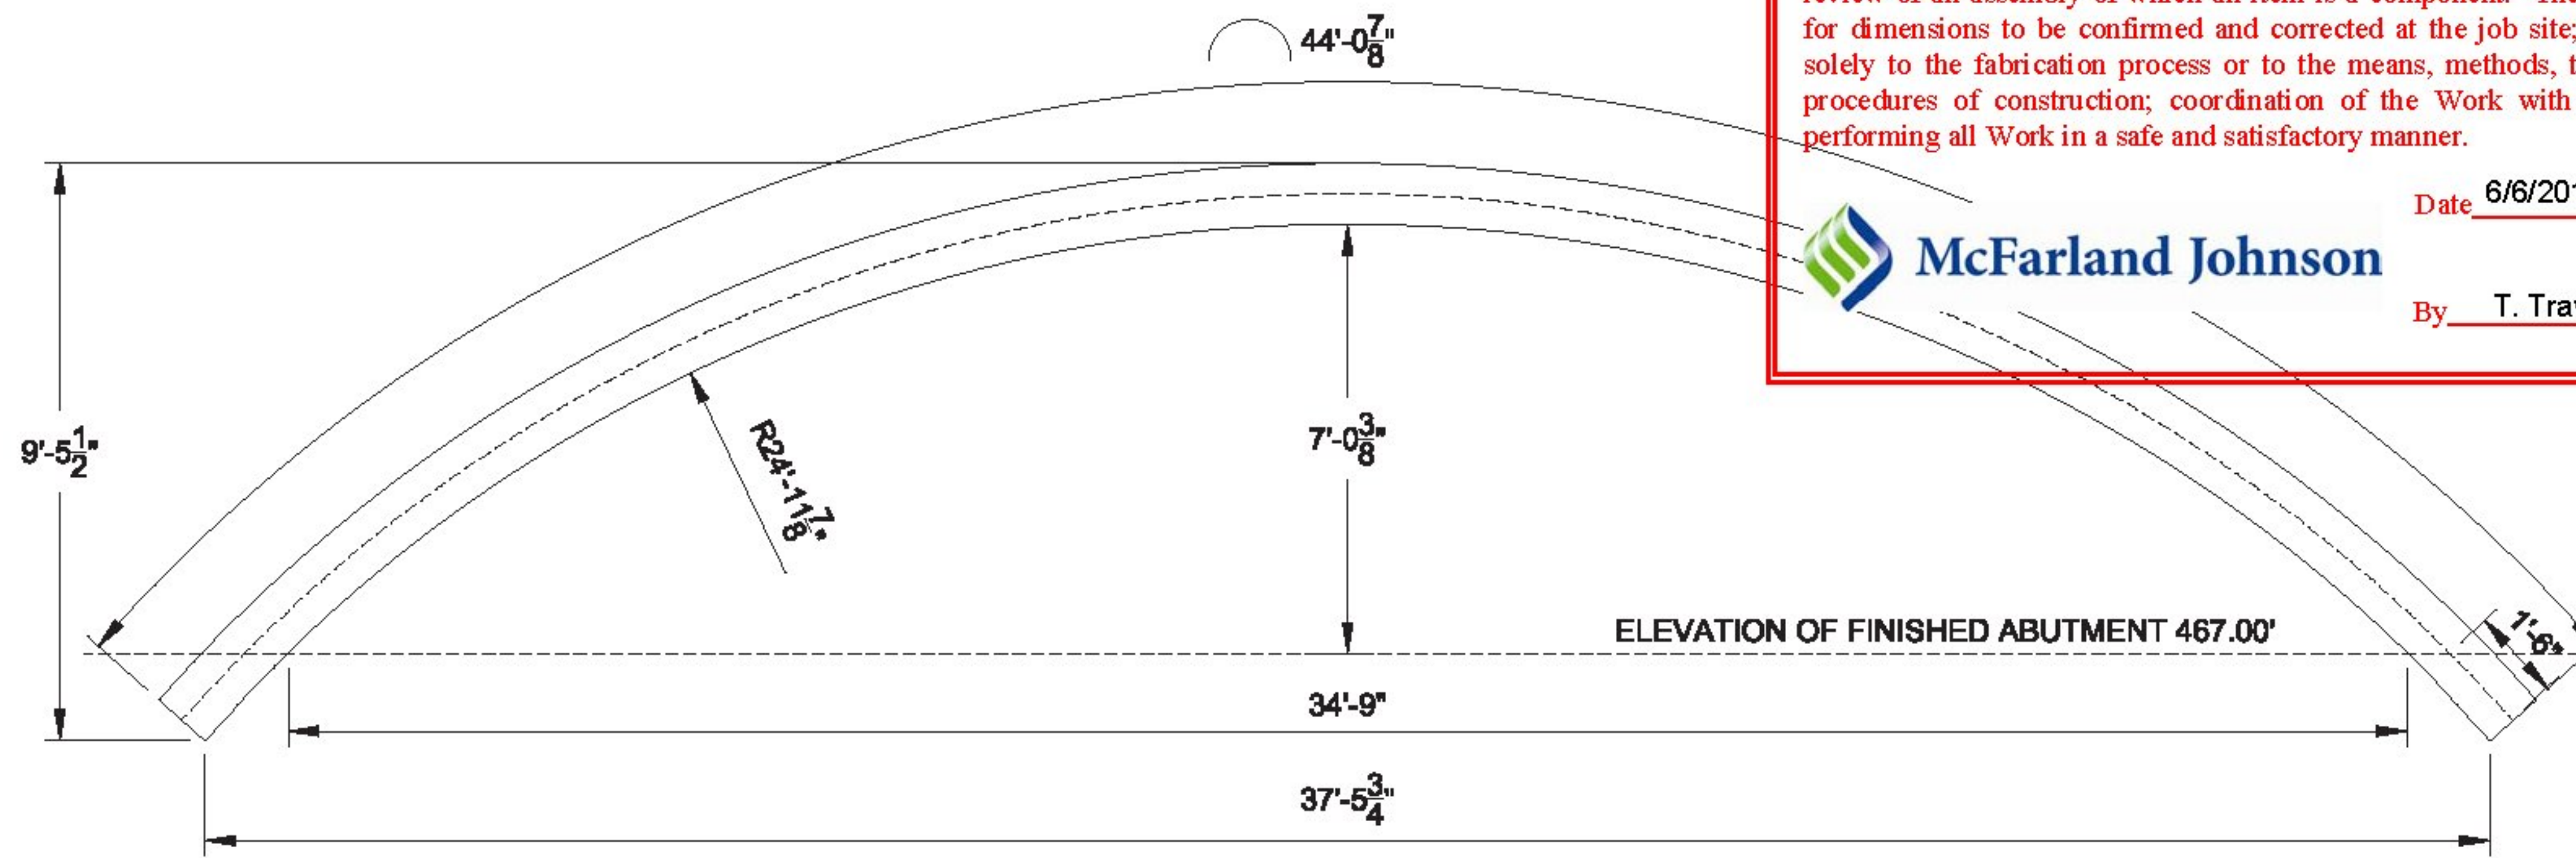

ARCH FINISH DIMENSIONS

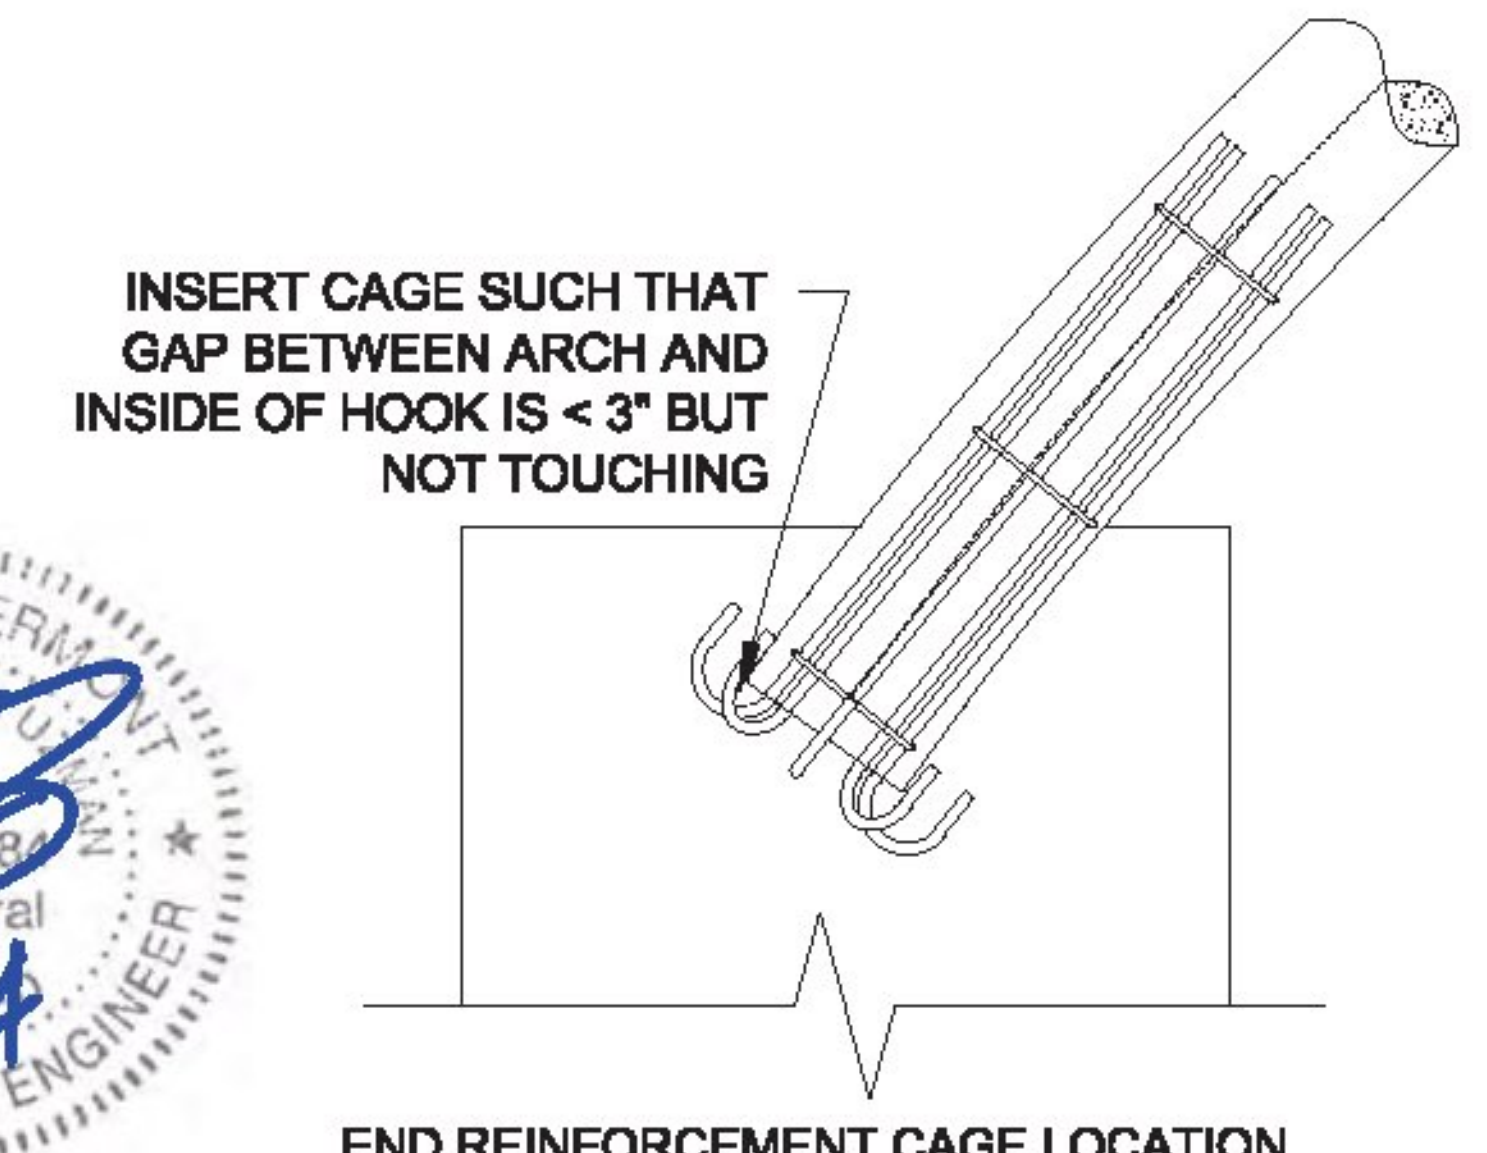

END REINFORCEMENT CAGE LOCATION





**ADVANCED
INFRASTRUCTURE
TECHNOLOGIES**

20 Godfrey Drive
 Orono, Maine 04473
 Tel 207.866.6526
 Fax 207.866.6501
 www.aitbridges.com

PROJECT: Wanzer Road Bridge No. 48		TITLE: ARCH DETAILS		SHEET NUMBER:	
LOCATION: Fairfield, VT		JN: 12018		<div style="font-size: 2em; font-weight: bold; margin: 0;">6</div> OF 10	
DRAWING STATUS: Approved for Construction		INITIALS	DATE		
Correct scale on size B paper (11x17 Ledger)		DRAWN BY: JEK	4-9-2014		
		DESIGNED BY: JEK	4-9-2014		
		CHECKED BY: ZU	5-20-2014	REV: 05-20-2014	

DECK NOTES:

1. PROJECT TO INCLUDE TWENTY-FIVE (25) ATLAS FRP DECK PANELS 42' LONG x 20.9" WIDE (19.5" COVERAGE WIDTH) x 3.7" DEEP
2. BRIDGE WIDTH TO BE SPANNED BY ONE PANEL - NO SPLICING
3. FIELD CUT PANELS TO PROPER LENGTH BY PLACING ON ARCHES, MARKING CUT LOCATION, SLIDING TO ONE SIDE AND CUTTING. IMPORTANT NOTE: EACH PANEL IS CUT AT A DIFFERENT ANGLE. DO NOT CUT BEFORE PLACING ON ARCHES.
4. ATTACH PANELS EACH SIDE OF ABUTMENT AND WORK TOWARD CROWN LEAVING GAP AT TOP FOR FILL HOLE
5. DRILL 3" DIAMETER ARCH CONCRETE FILLING HOLE ON SPINE AT CROWN WITHIN GAP. USE 3" HOLE SAW - SUPPLIED BY OTHER
6. FIELD CUT CLOSURE STRIP TO FILL GAP BETWEEN DECK PANELS AT CROWN - ATTACH WITH STRUCTURAL ADHESIVE AND SCREWS


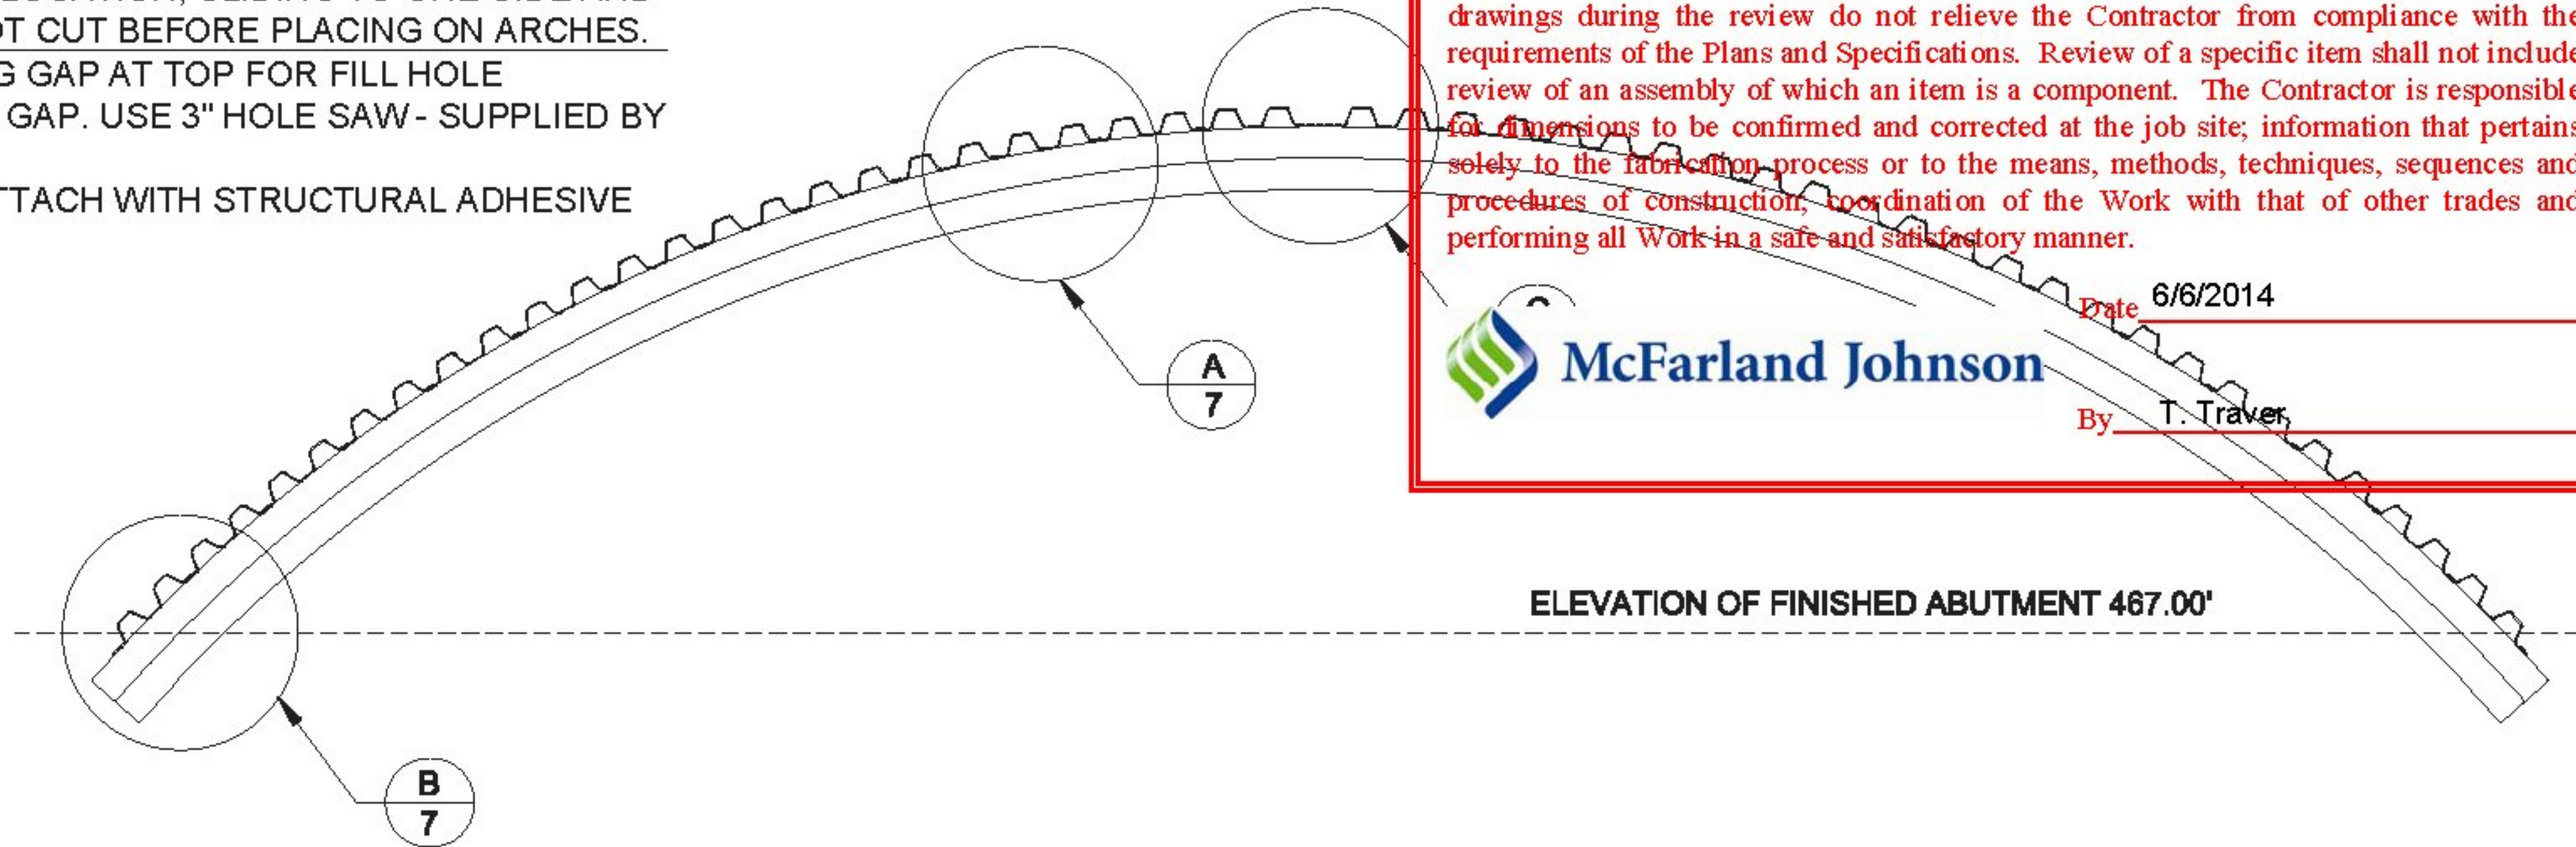
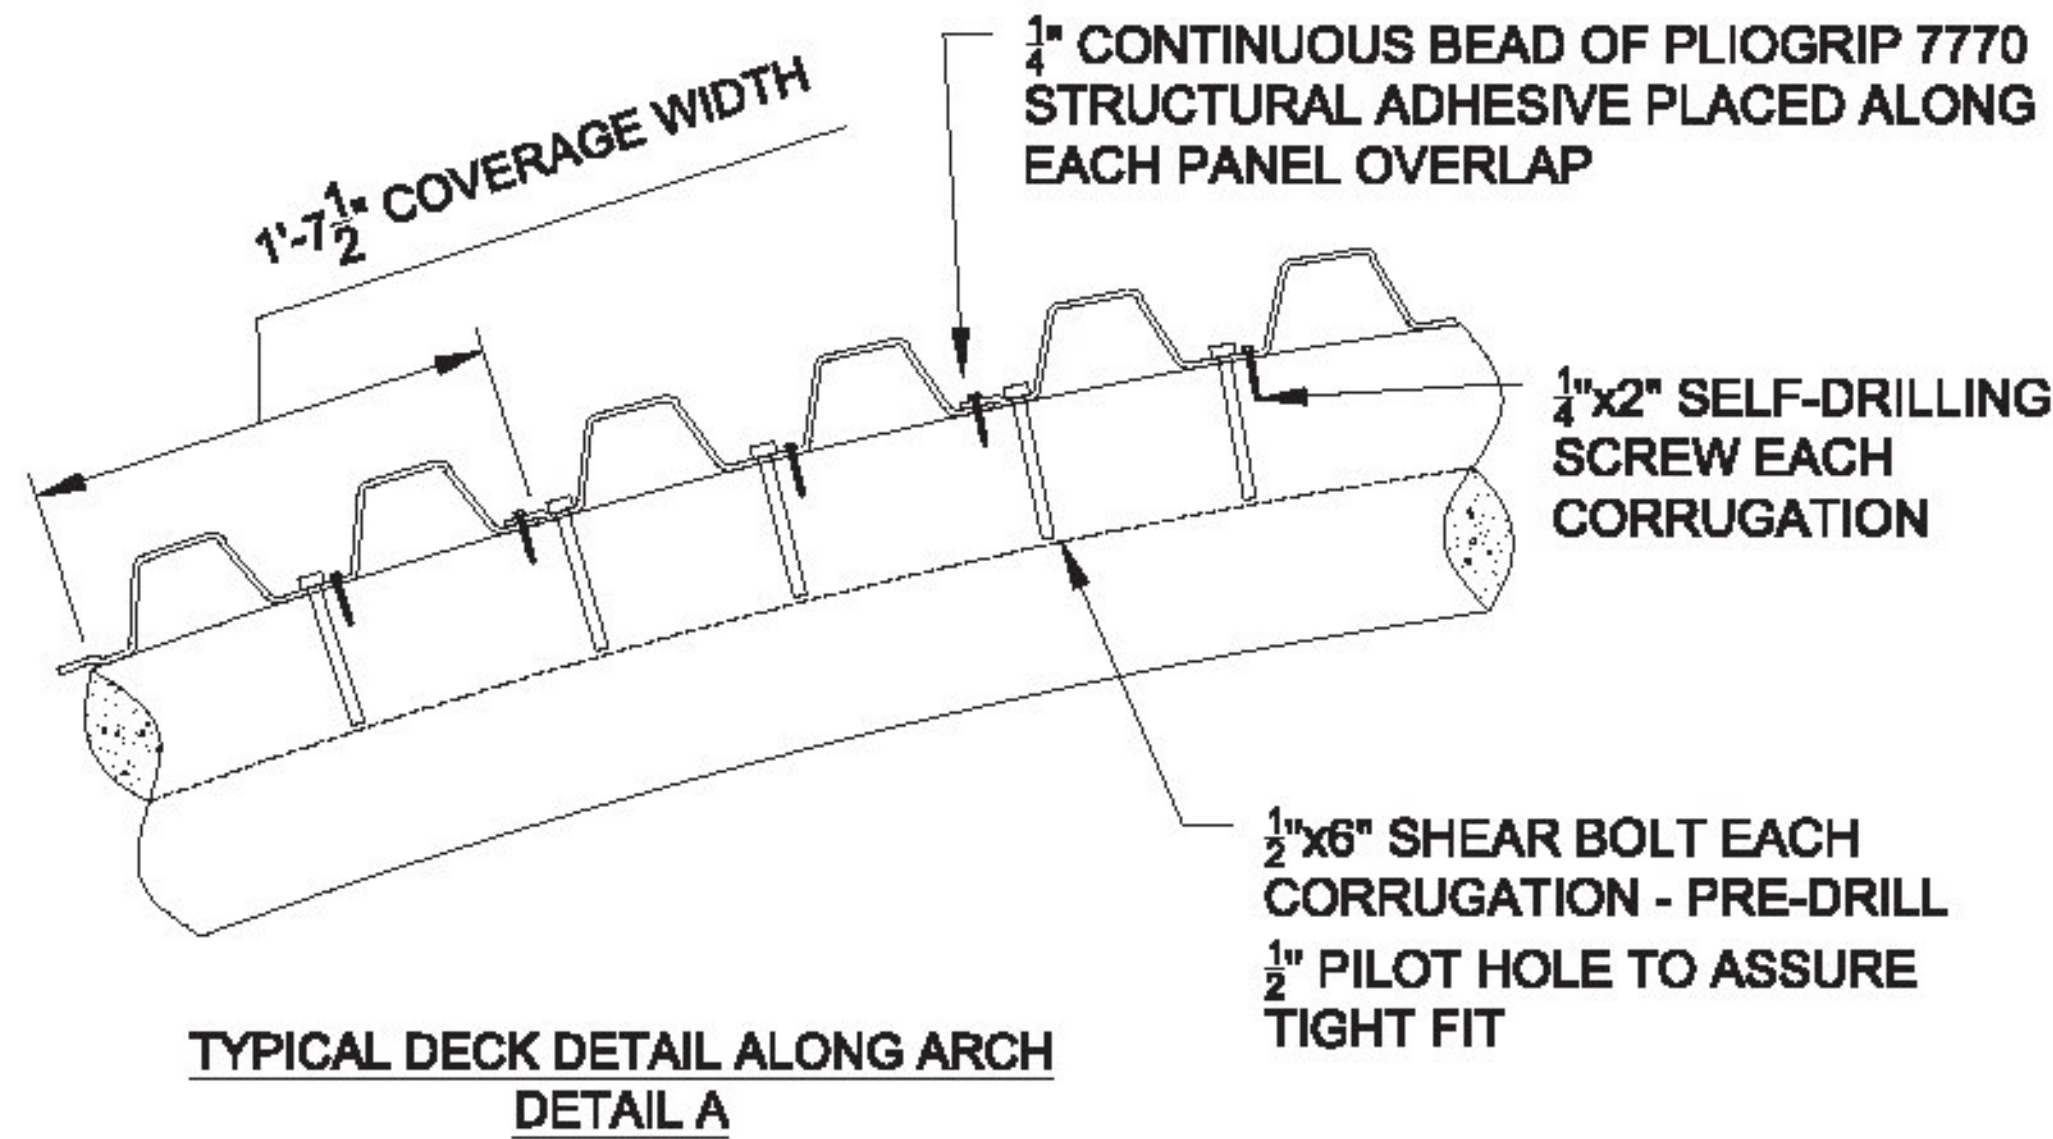


<input checked="" type="checkbox"/> Approved	<input type="checkbox"/> Approved As Noted
<input type="checkbox"/> Rejected	

This review is only for general conformance with the design concept and the information given in the Construction Documents. Corrections or comments made on the shop drawings during the review do not relieve the Contractor from compliance with the requirements of the Plans and Specifications. Review of a specific item shall not include review of an assembly of which an item is a component. The Contractor is responsible for dimensions to be confirmed and corrected at the job site; information that pertains solely to the fabrication process or to the means, methods, techniques, sequences and procedures of construction, coordination of the Work with that of other trades and performing all Work in a safe and satisfactory manner.

Date: 6/6/2014
By: T. Traver

McFarland Johnson

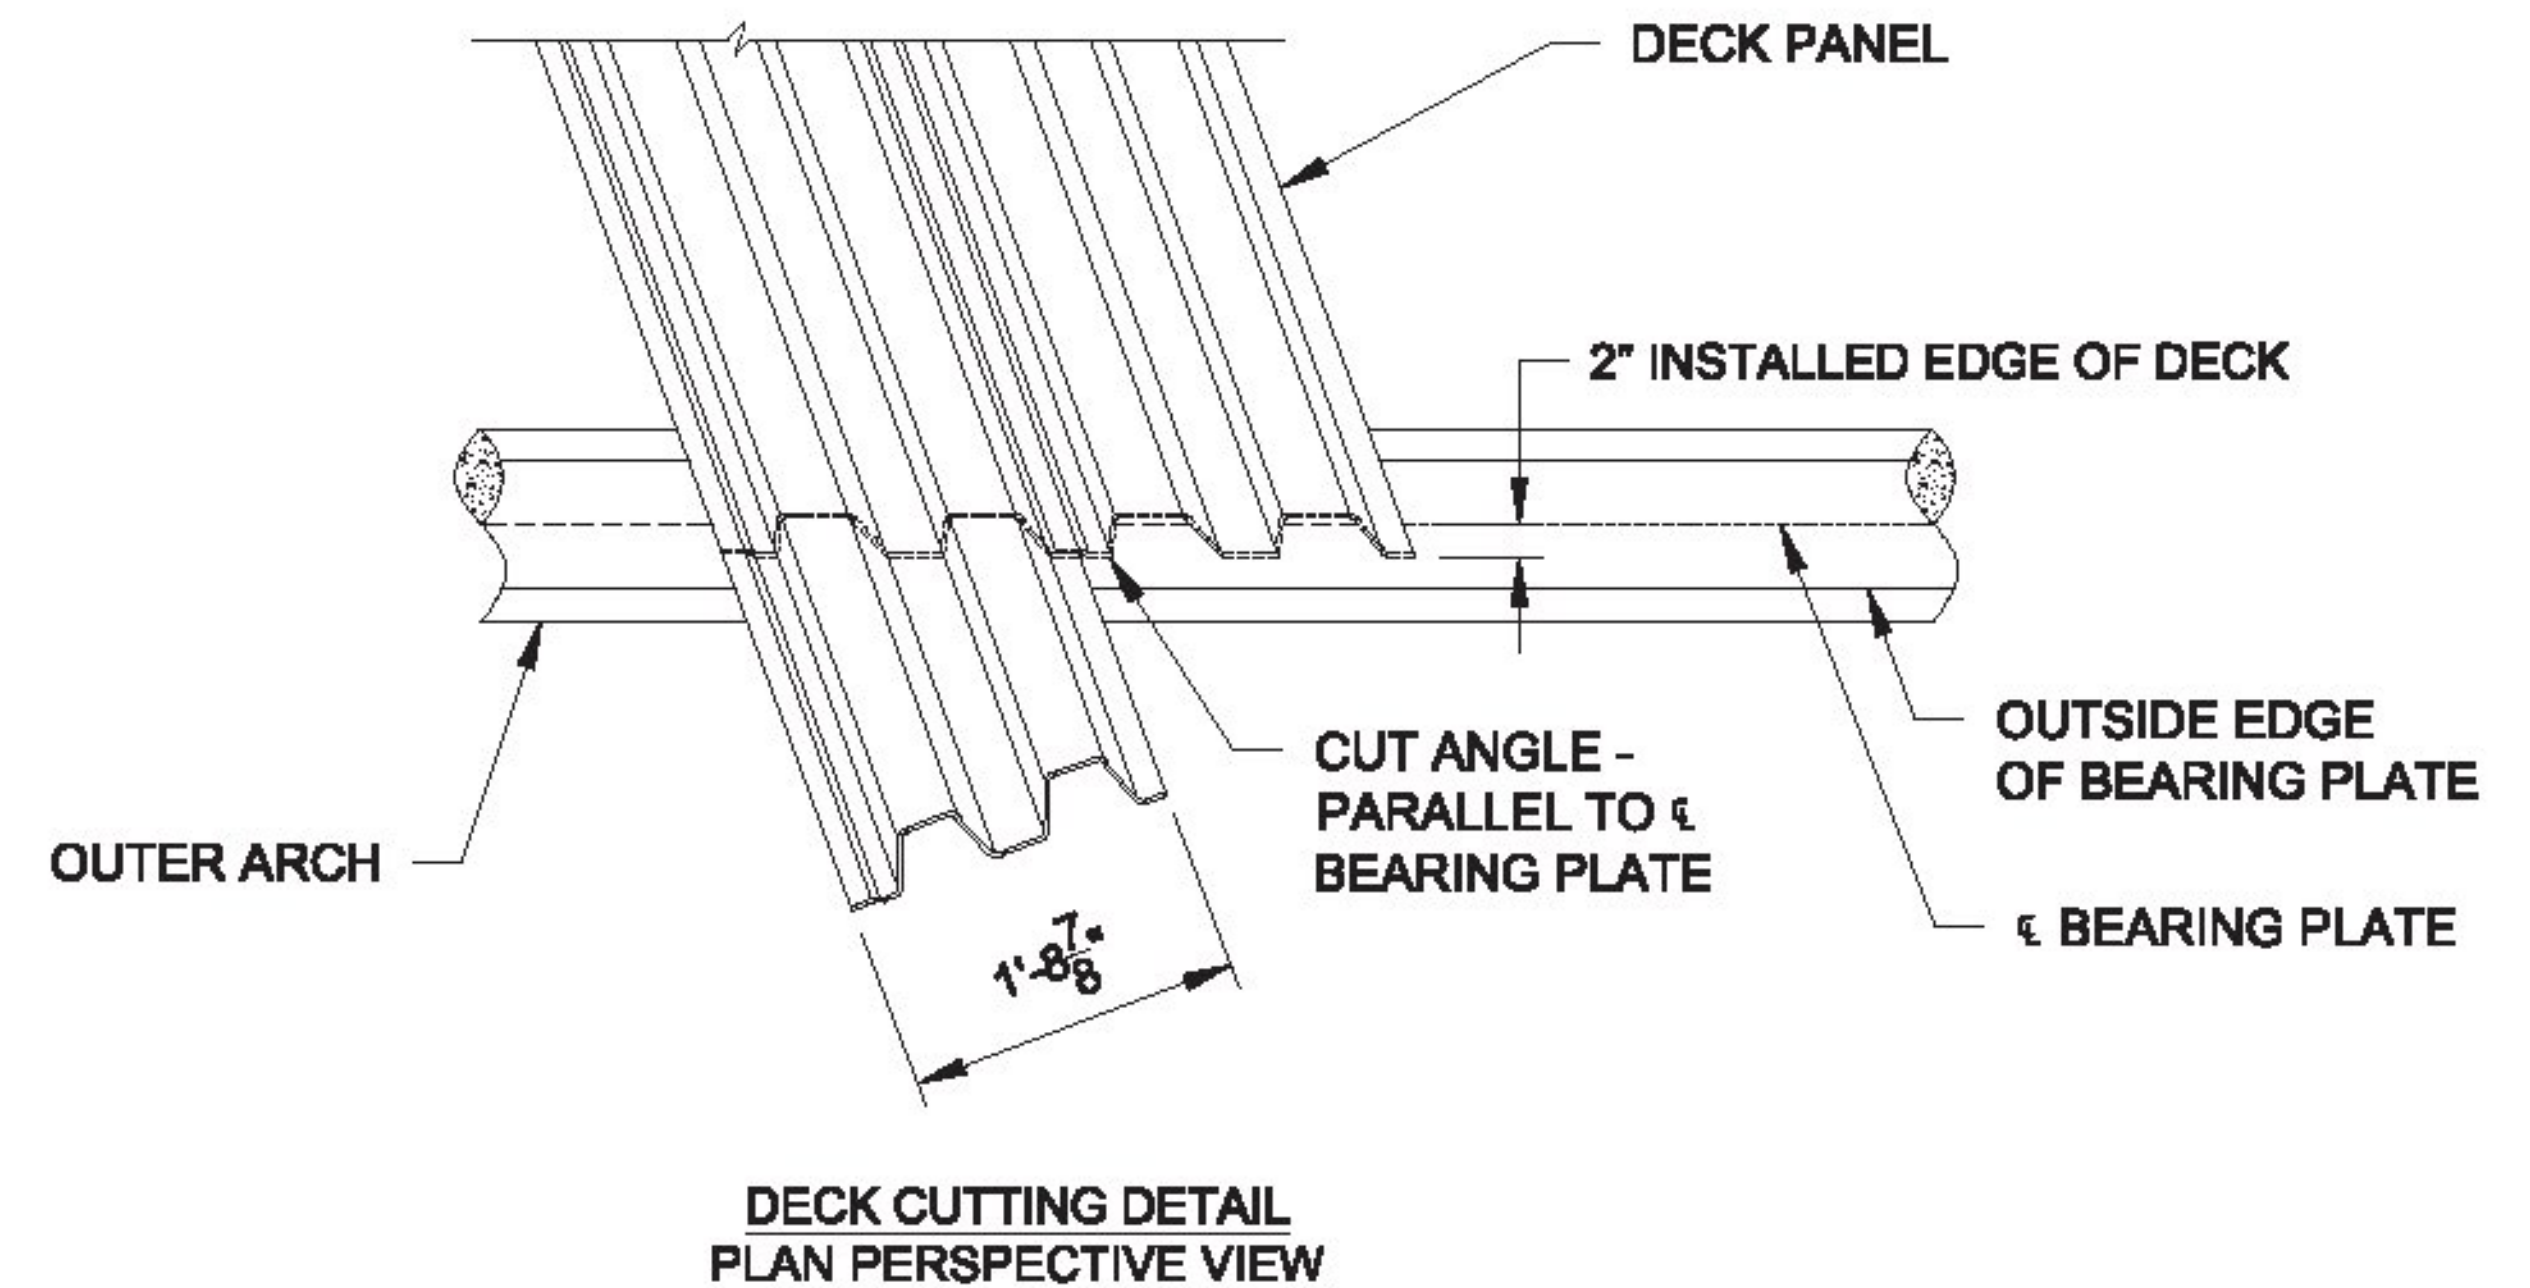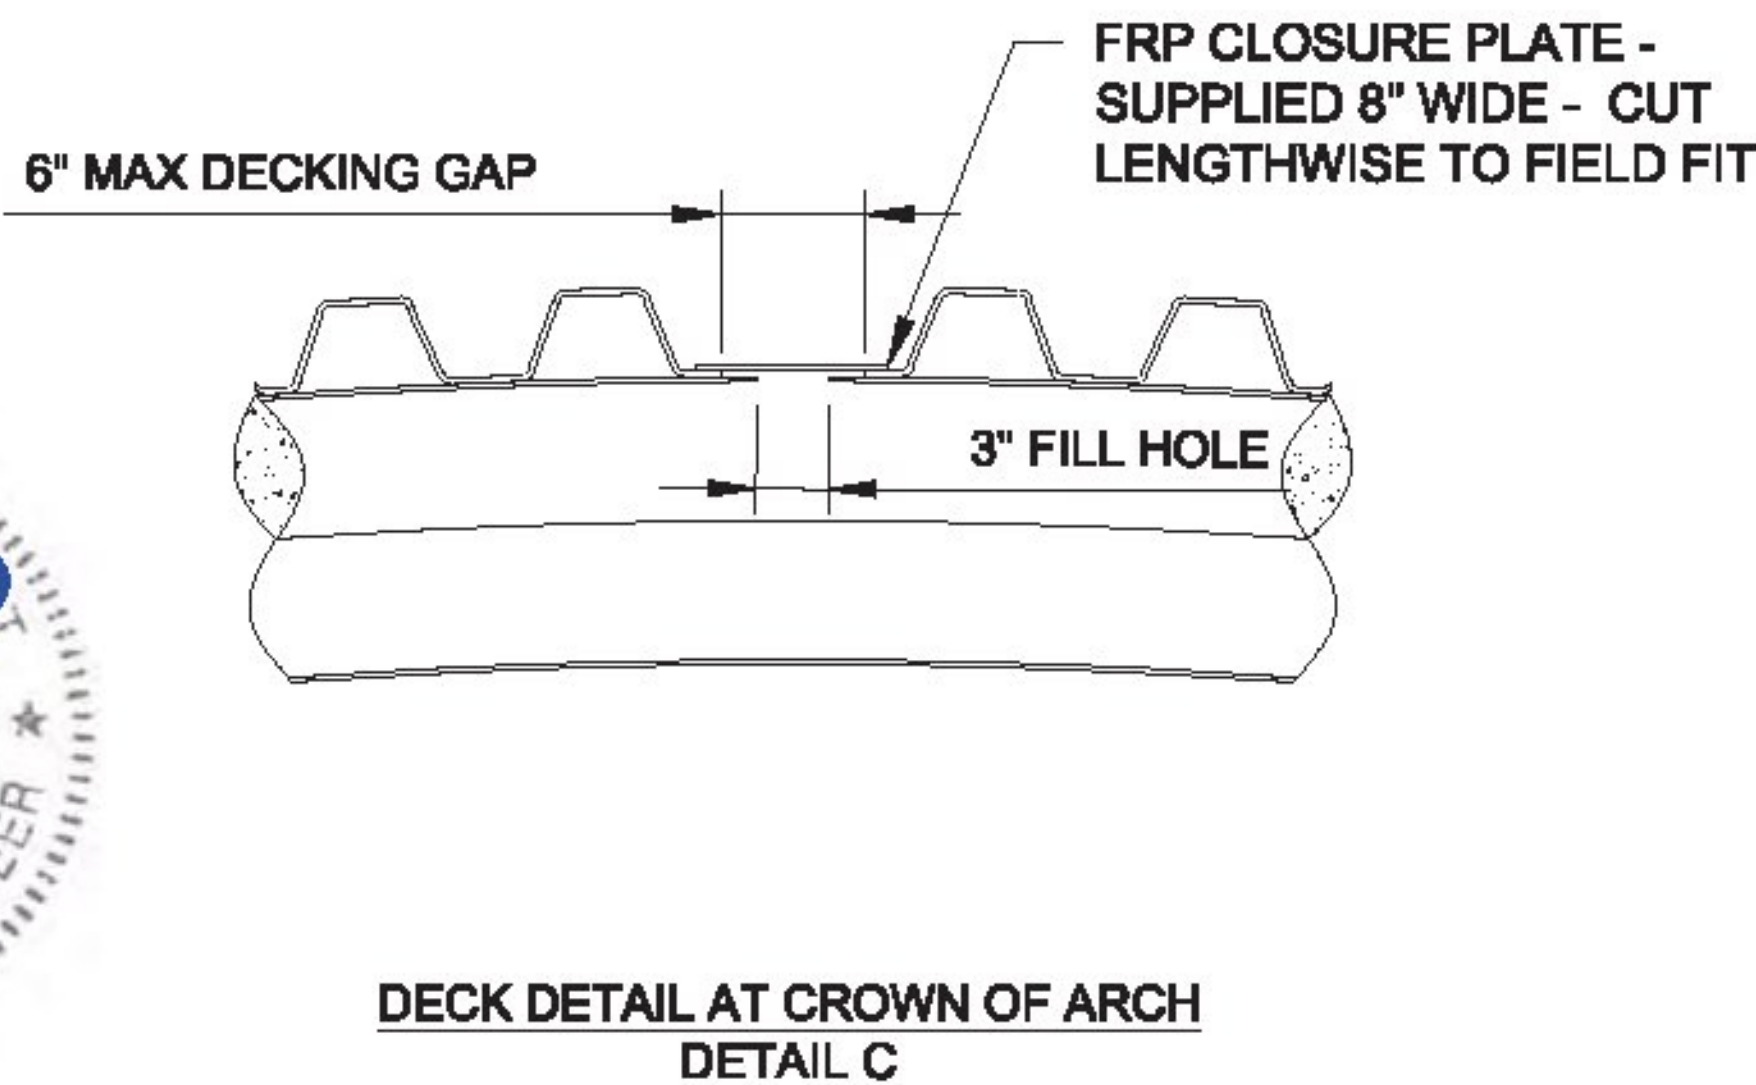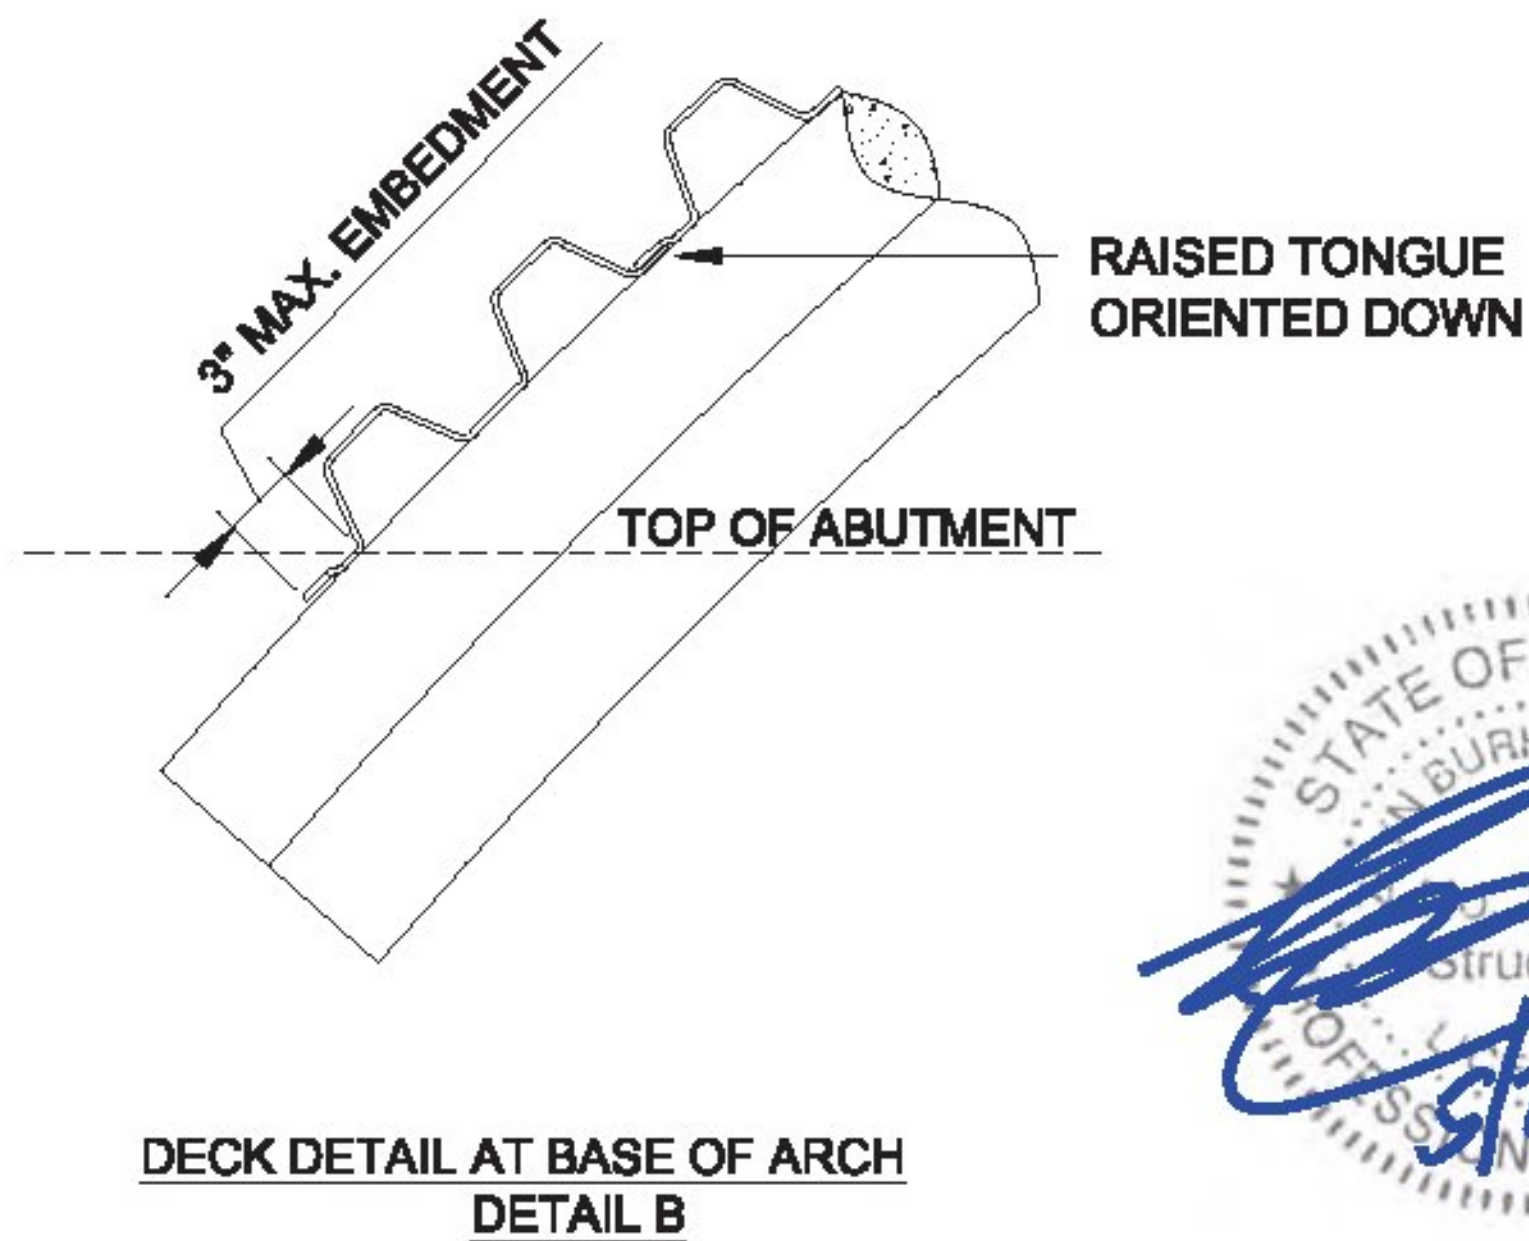

ADVANCED INFRASTRUCTURE TECHNOLOGIES

20 Godfrey Drive
Orono, Maine 04473
Tel 207.866.6526
Fax 207.866.6501
www.aitbridges.com

PROJECT: Wanzer Road Bridge No. 48	TITLE: DECK DETAILS	SHEET NUMBER:
LOCATION: Fairfield, VT	JN: 12018	7 OF 10
DRAWING STATUS: Approved for Construction	INITIALS DATE	
Correct scale on size B paper (11x17 Ledger)	DRAWN BY: JEK 4-9-2014	
	DESIGNED BY: JEK 4-9-2014	
	CHECKED BY: ZU 5-20-2014	REV: 05-20-2014

GEOGRID NOTES:

PRIMARY REINFORCEMENT

- LAYERS WITH "P" INDICATE PRIMARY REINFORCEMENT WITH TWO TAILS
- PRIMARY REINFORCEMENT IS ATTACHED TO HEADWALL BY WRAPPING CONTINUOUS EQUAL LENGTH TAILS AROUND FRP WALER

SECONDARY REINFORCEMENT

- LAYERS WITH "S" INDICATE SECONDARY REINFORCEMENT WITH ONE TAIL
- SECONDARY REINFORCEMENT EXTENDS TO THE HEADWALL, BUT IS NOT ATTACHED

INSTALLATION

- FOLLOW ALL WRITTEN SPECIFICATION WHEN INSTALLING GEOGRID
- INSTALL ALL LAYERS TO THE EXTENTS INDICATED BY DASHED LINES IN ELEVATION DRAWINGS
- ADJACENT LAYERS MUST BE BUTTED TO ONE ANOTHER TO ACHIEVE 100% COVERAGE
- MACHINE DIRECTION OF GEOGRID MUST BE ORIENTED PERPENDICULAR TO WALL
- GEOGRID ROLLS ARE 6' WIDE - EXTRA WIDTH CAN BE BURIED IN BACKFILL OR CUT TO FIT
- GEOGRID IS CUT TO LENGTH - NO SPLICING IN THE MACHINE DIRECTION
- SUGGESTED HEADWALL BATTER IS 1:32 BACK FROM VERTICAL (BETWEEN
- BACKFILL PLACEMENT SHOULD BE PLACED TO PREVENT DAMAGE AND WRINKLES

Approved **Approved As Noted**
 Rejected




This review is only for general conformance with the design concept and the information given in the Construction Documents. Corrections or comments made on the shop drawings during the review do not relieve the Contractor from compliance with the requirements of the Plans and Specifications. Review of a specific item shall not include review of an assembly of which an item is a component. The Contractor is responsible for dimensions to be confirmed and corrected at the job site; information that pertains solely to the fabrication process or to the means, methods, techniques, sequences and procedures of construction; coordination of the Work with that of other trades and performing all Work in a safe and satisfactory manner.

Date 6/6/2014

By T. Traver


McFarland Johnson
 PROFESSIONAL ENGINEER


AIT SUPPLIED HEADWALL CAP SECURED WITH #6 1" SCREWS

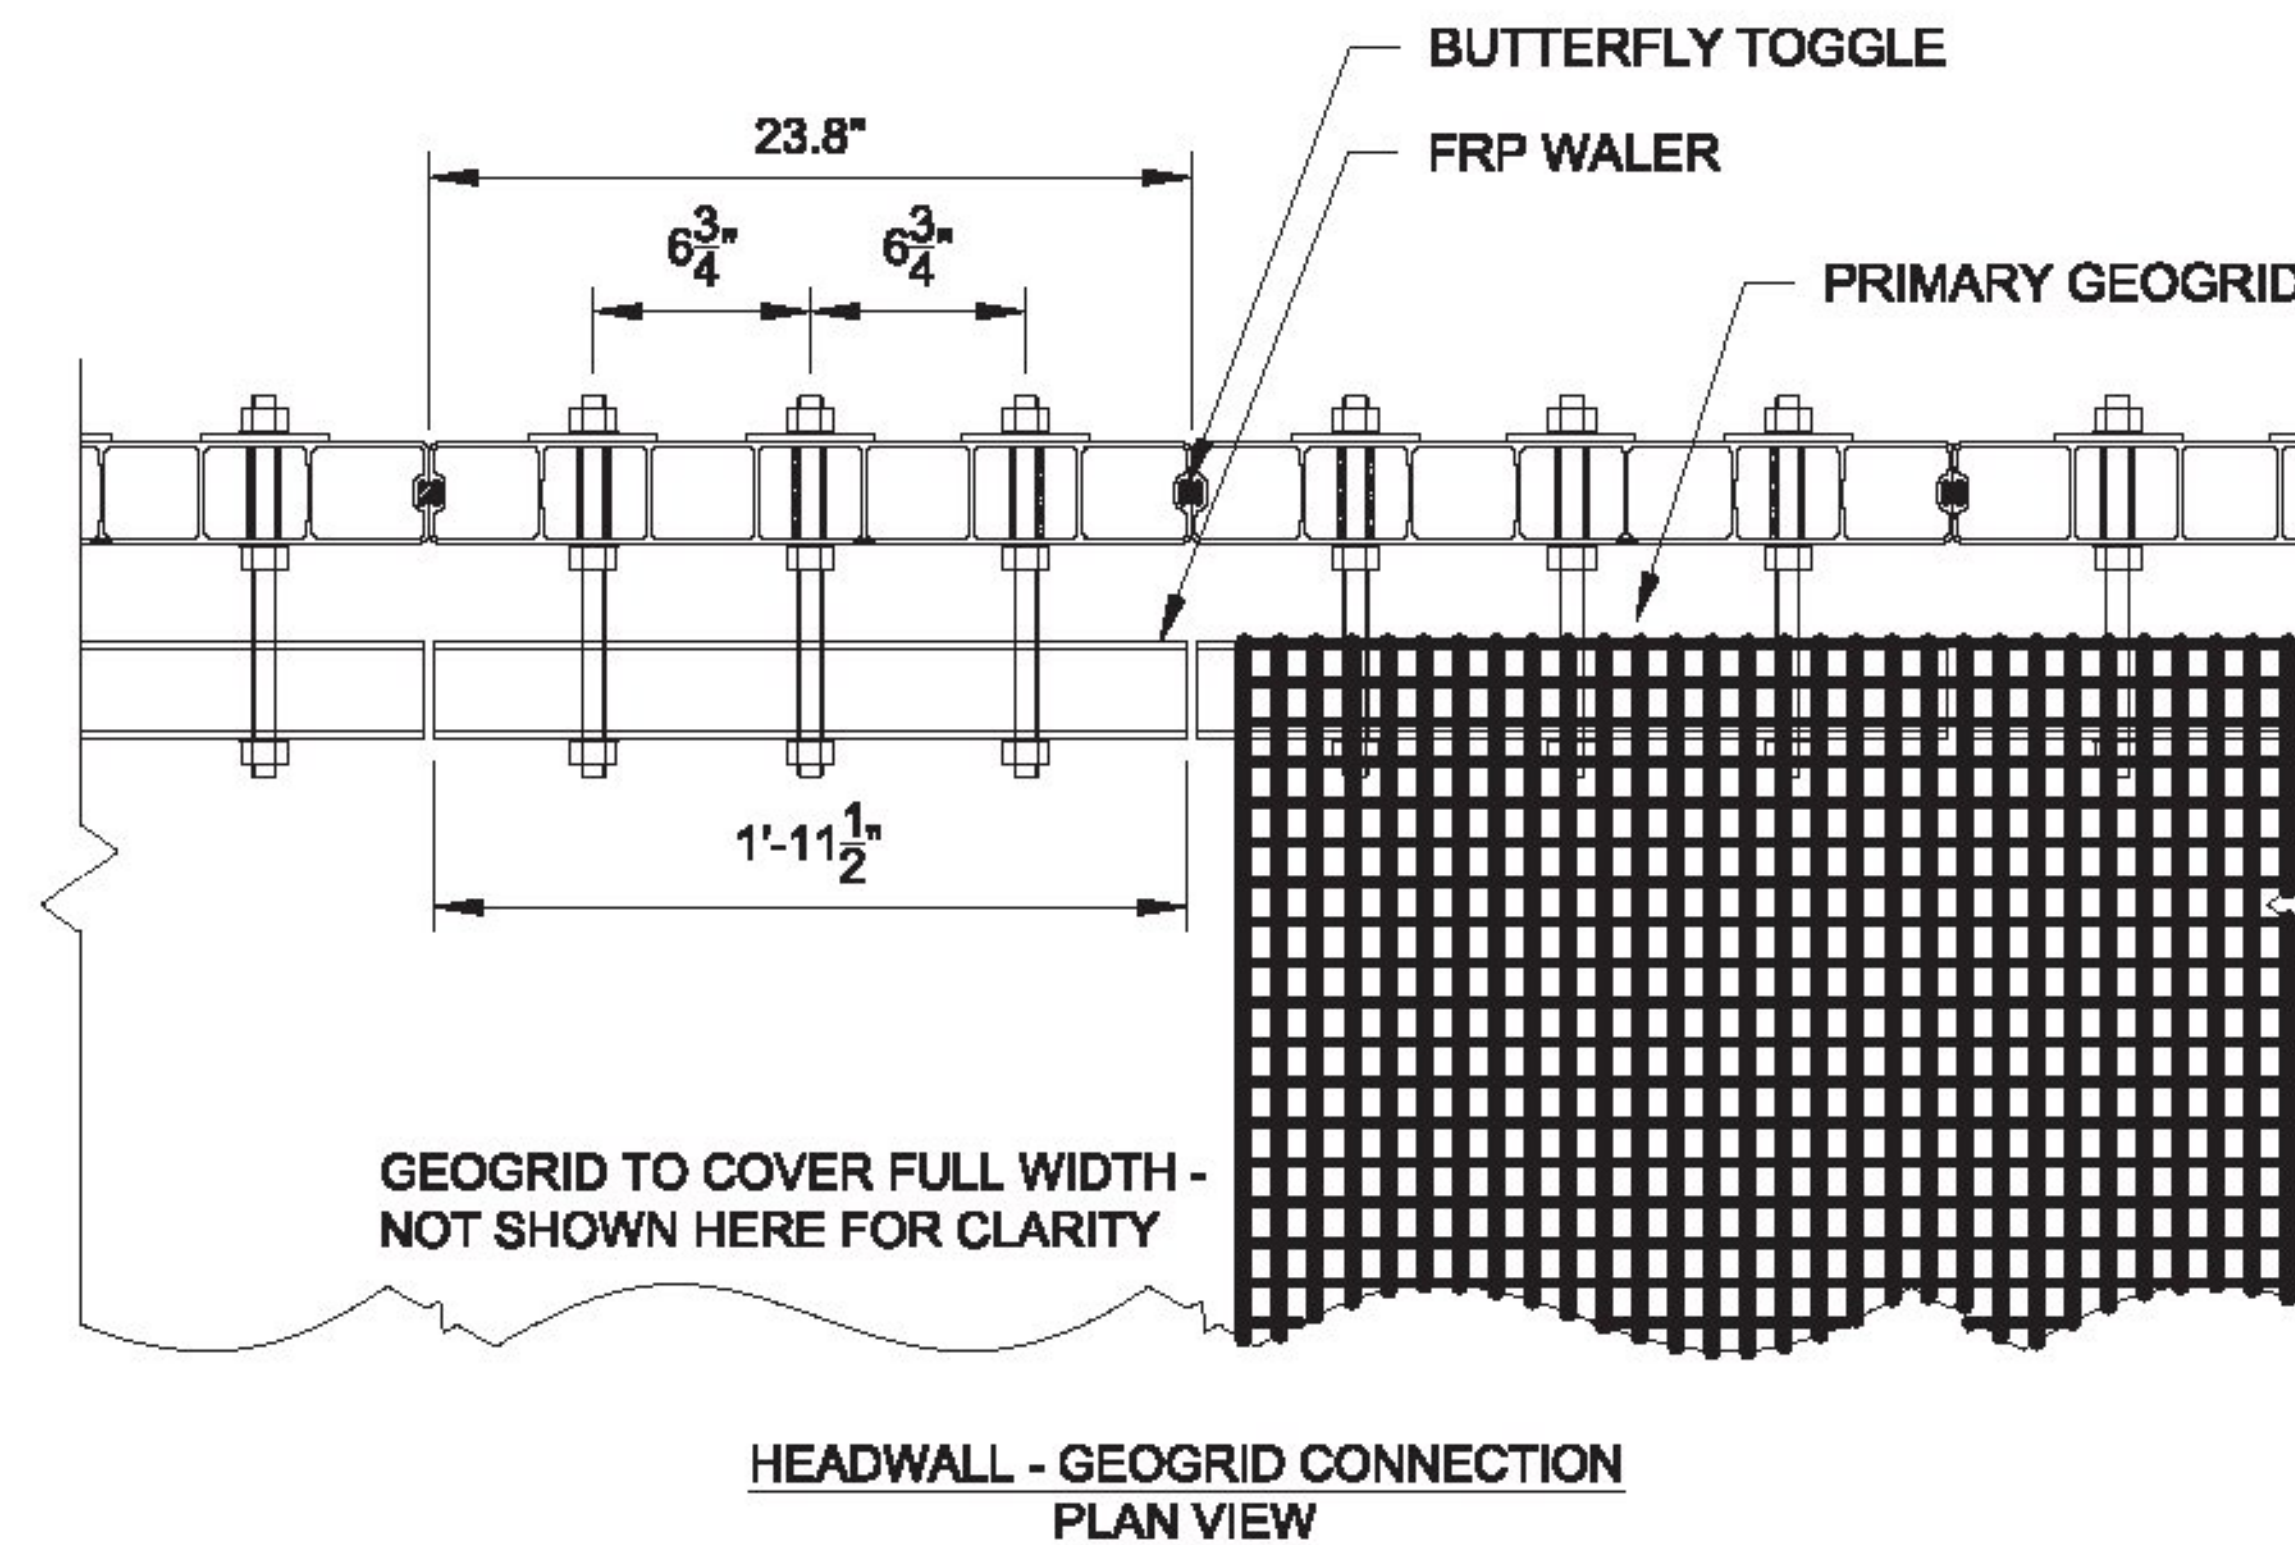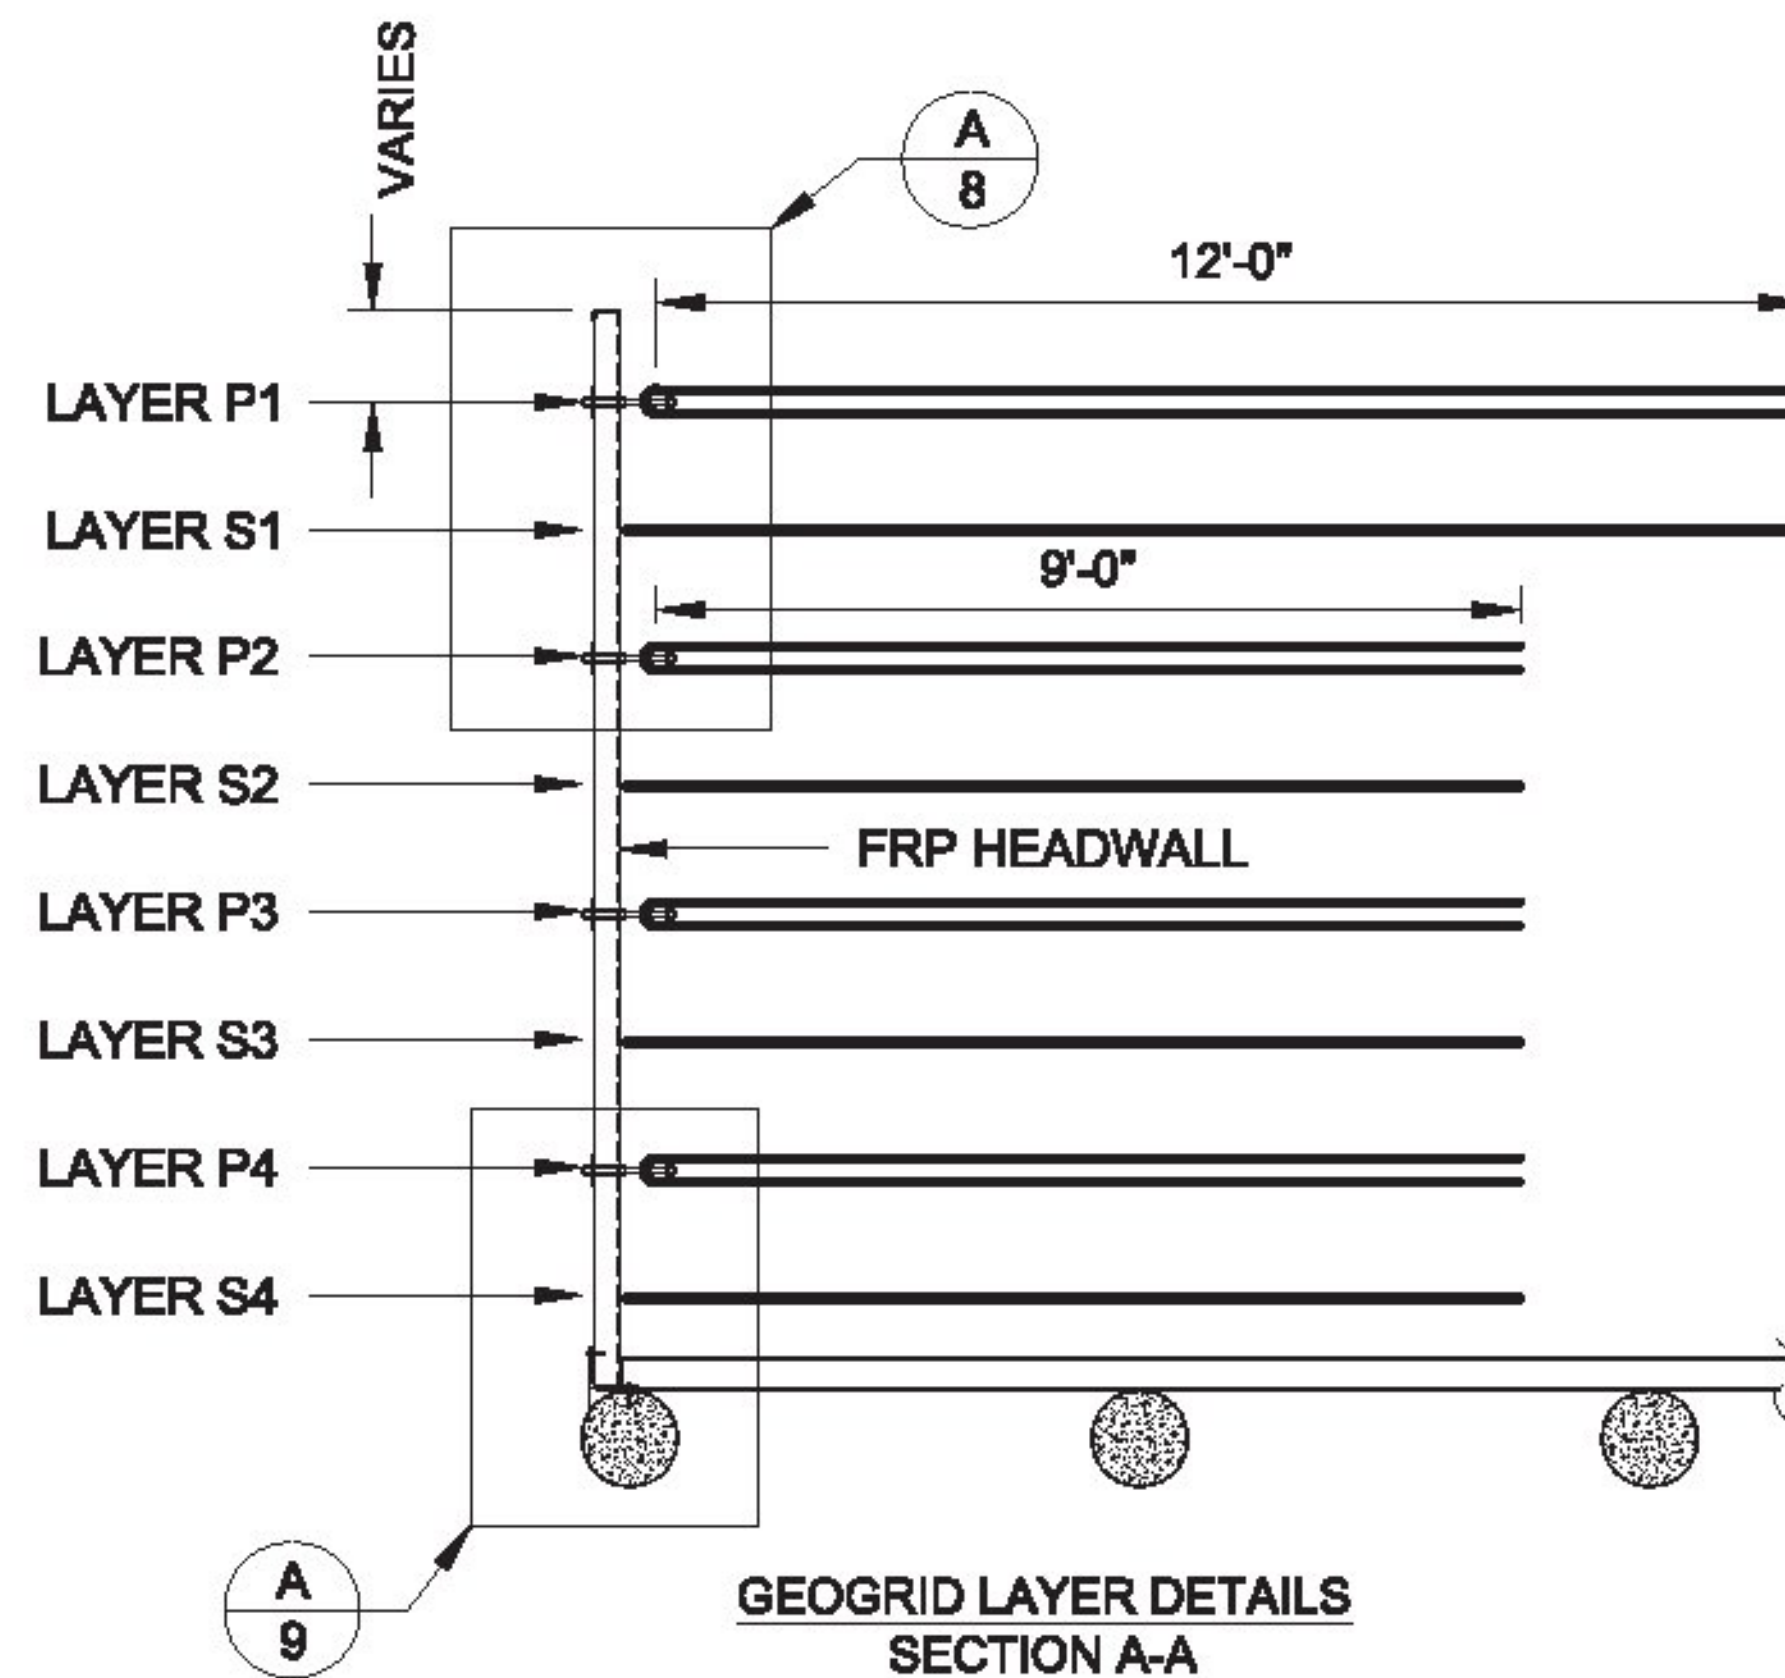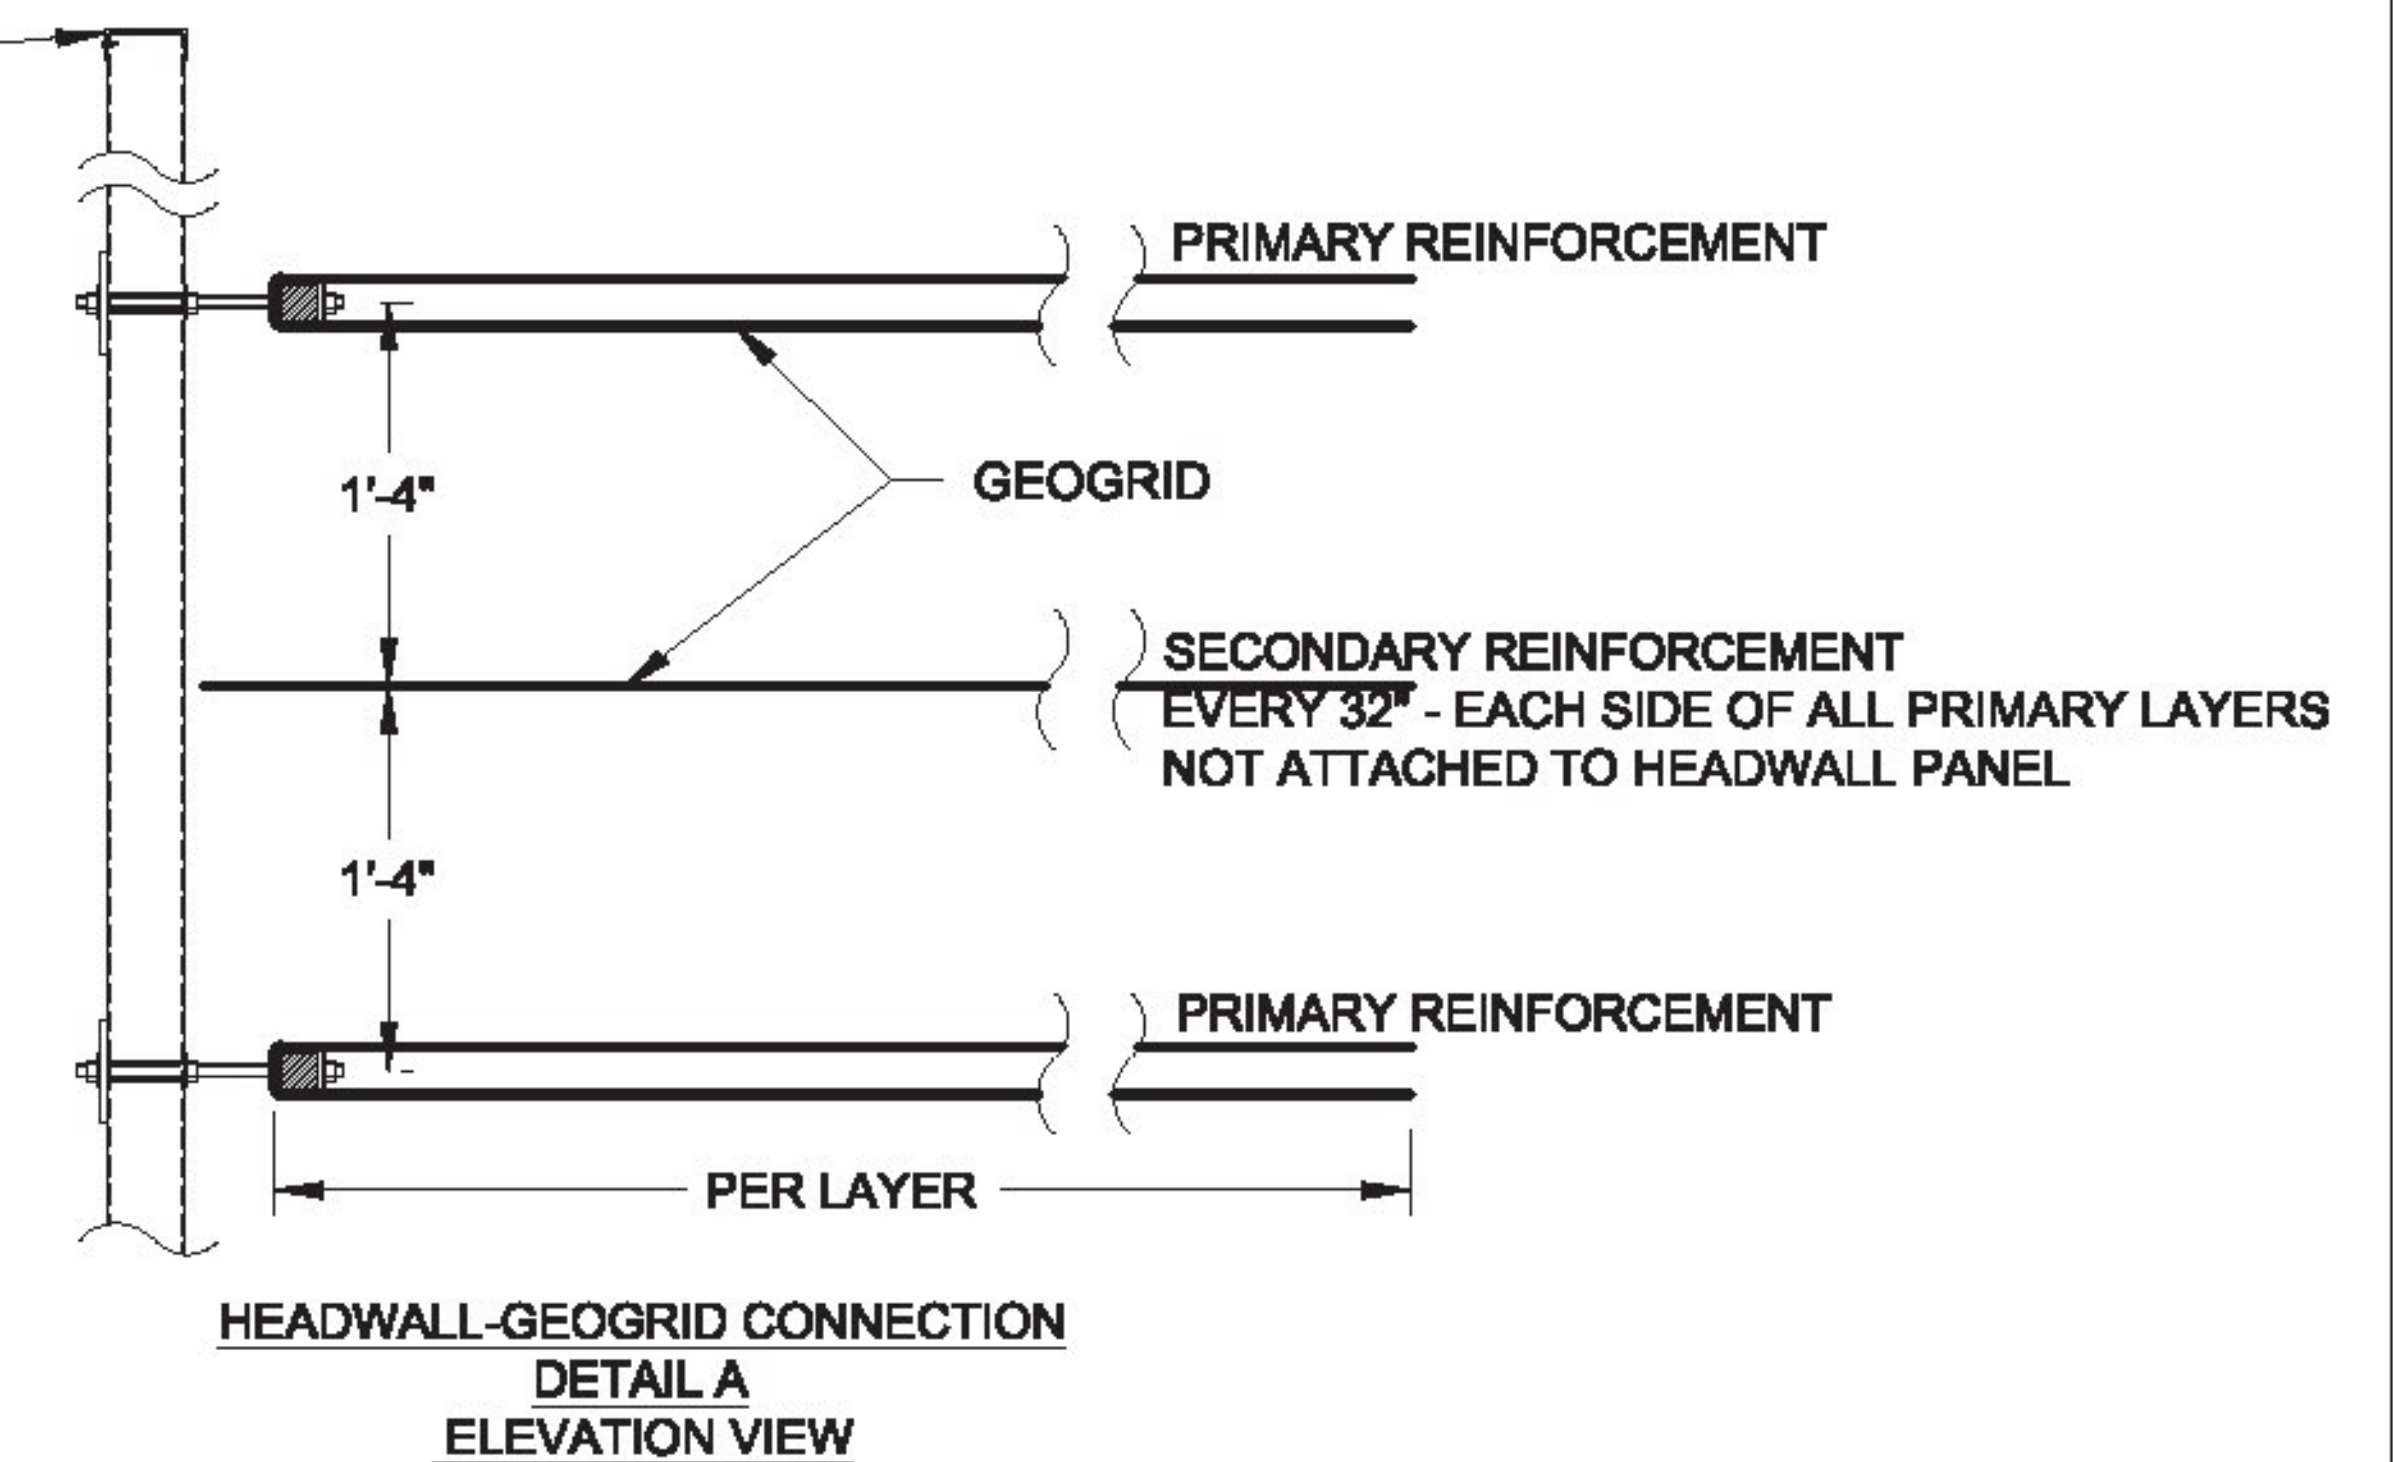


**ADVANCED
INFRASTRUCTURE
TECHNOLOGIES**

20 Godfrey Drive
Orono, Maine 04473
Tel 207.866.6526
Fax 207.866.6501
www.aitbridges.com



PROJECT: Wanzer Road Bridge No. 48	TITLE: HEADWALL LAYOUT		SHEET NUMBER:
LOCATION: Fairfield, VT	JN: 12018	INITIALS	DATE
DRAWING STATUS: Approved for Construction	DRAWN BY: JEK	4-9-2014	8 OF 10
Correct scale on size B paper (11x17 Ledger)	DESIGNED BY: JEK	4-9-2014	
	CHECKED BY: ZU	5-20-2014	
			REV: 05-20-2014

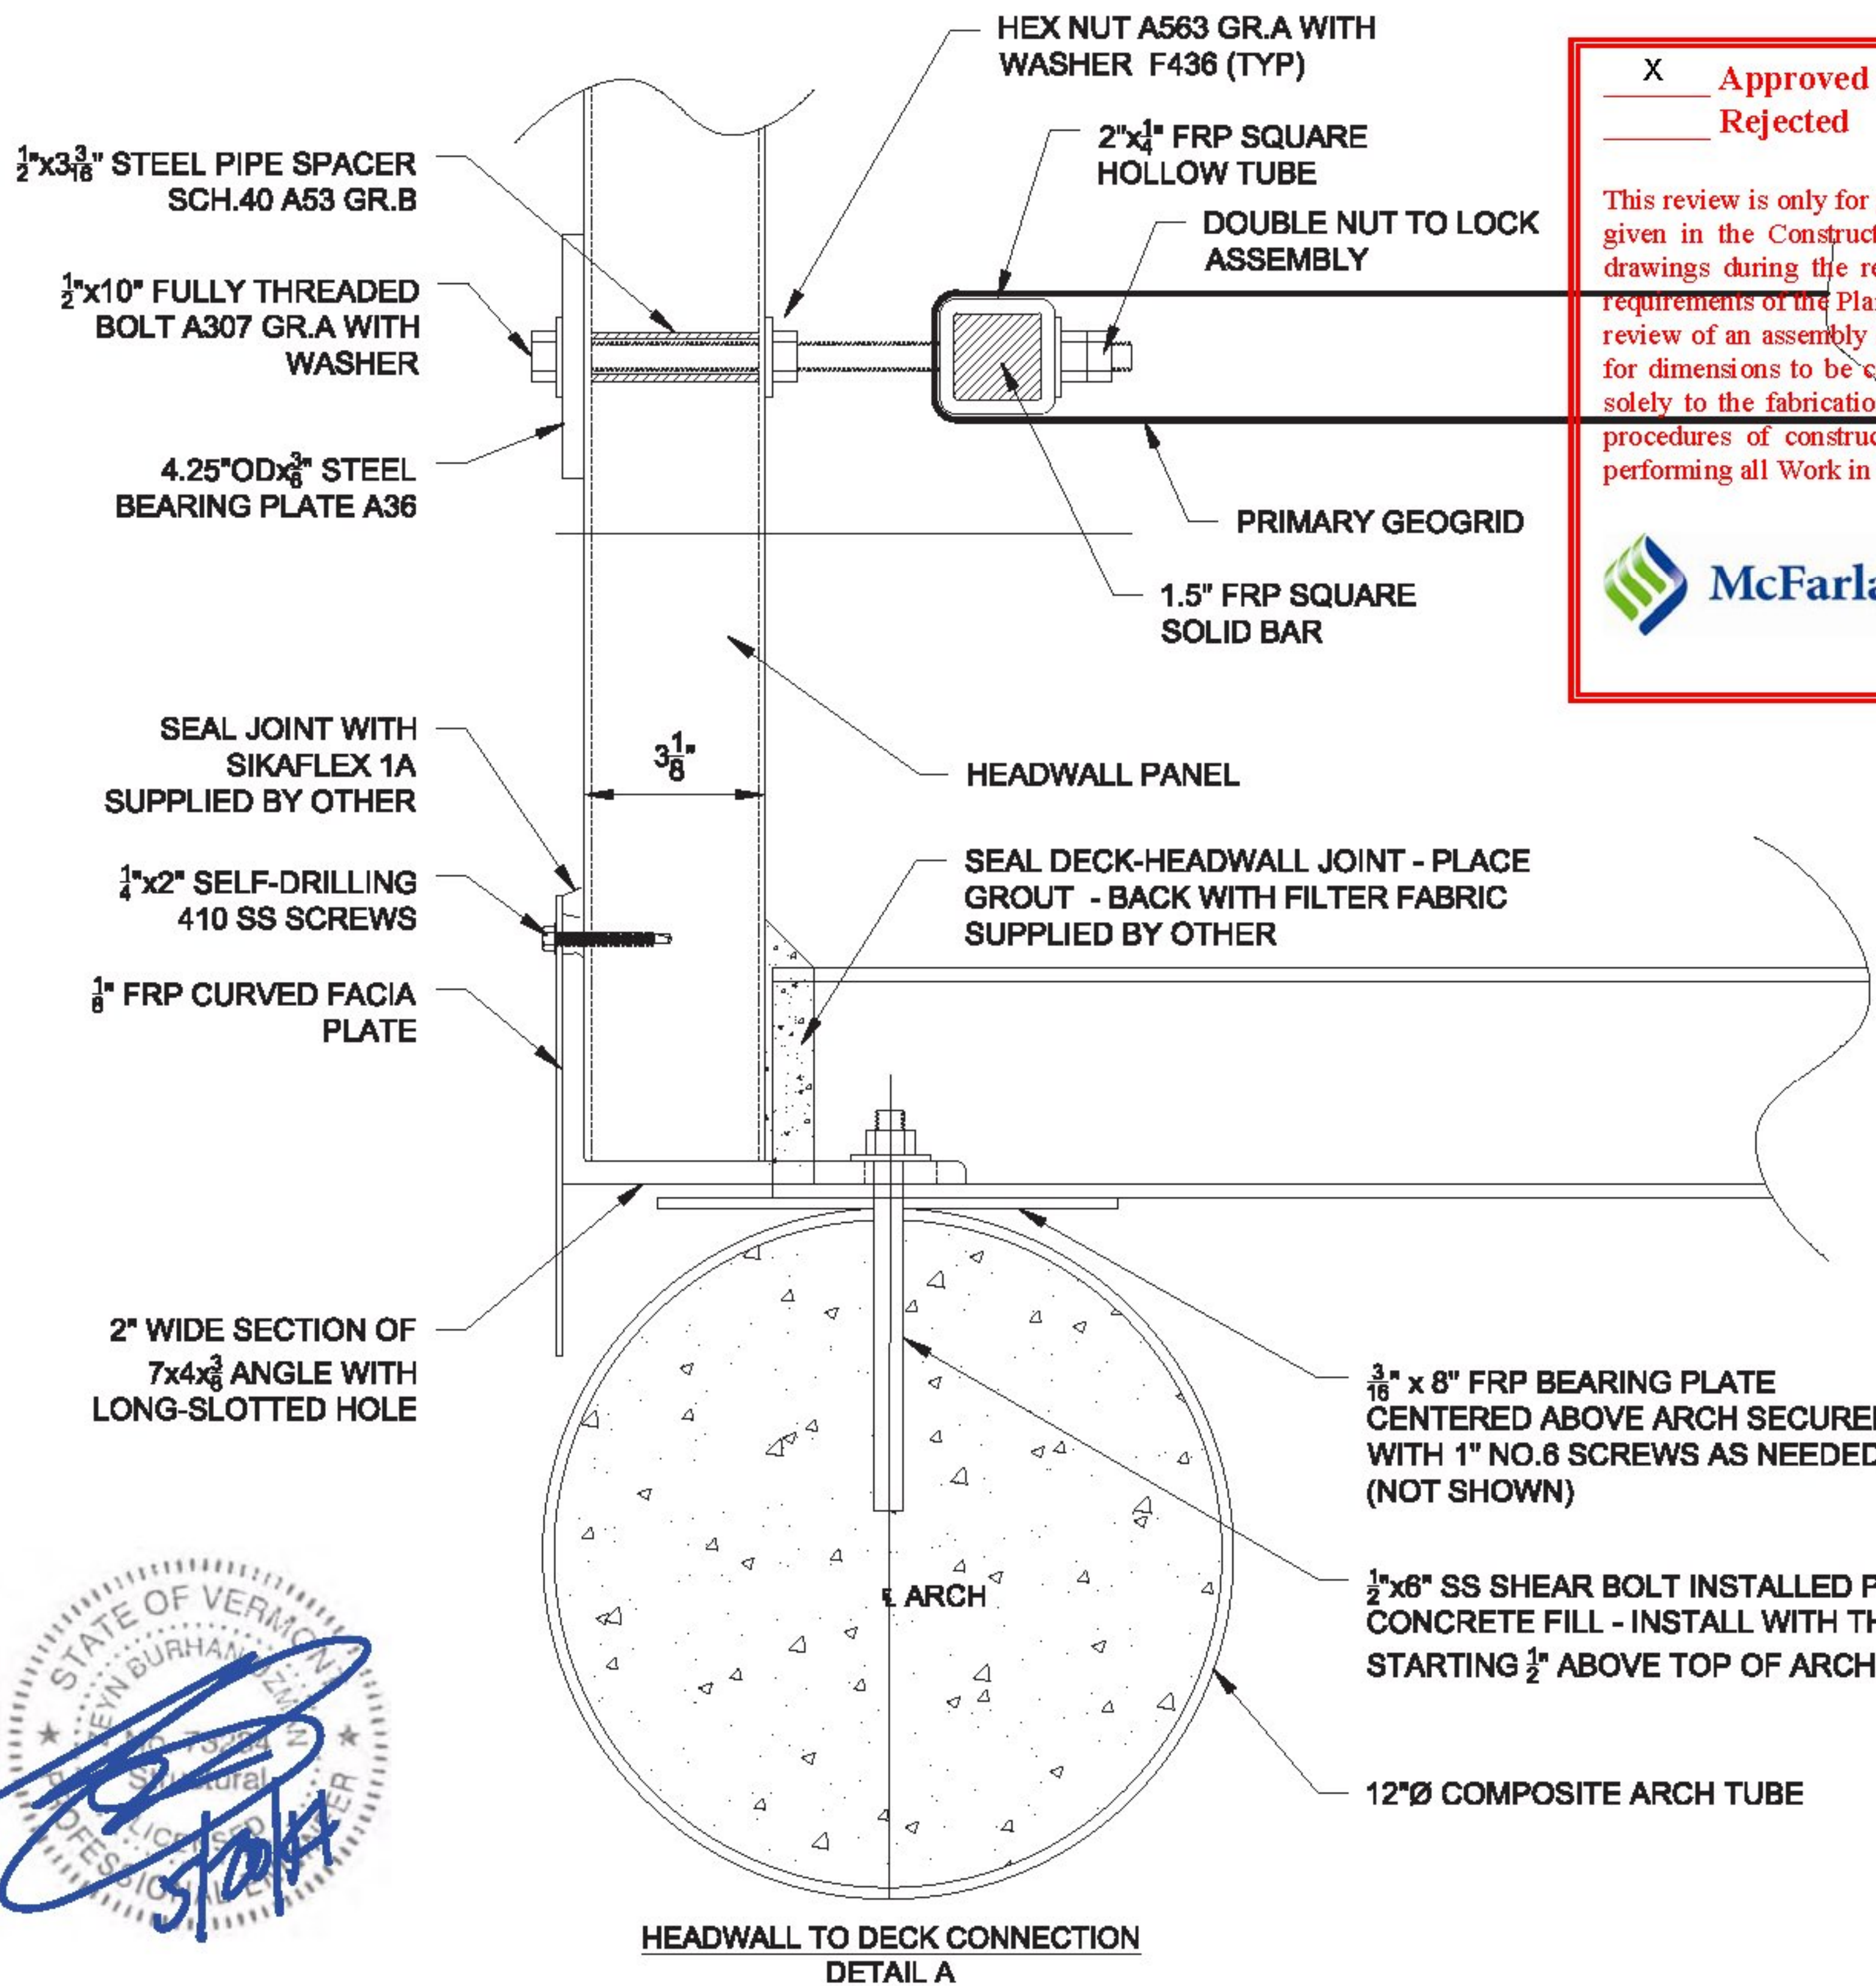

Approved
 Rejected
 Approved As Noted

This review is only for general conformance with the design concept and the information given in the Construction Documents. Corrections or comments made on the shop drawings during the review do not relieve the Contractor from compliance with the requirements of the Plans and Specifications. Review of a specific item shall not include review of an assembly of which an item is a component. The Contractor is responsible for dimensions to be confirmed and corrected at the job site; information that pertains solely to the fabrication process or to the means, methods, techniques, sequences and procedures of construction; coordination of the Work with that of other trades and performing all Work in a safe and satisfactory manner.

Date 6/6/2014
 By T. Traver

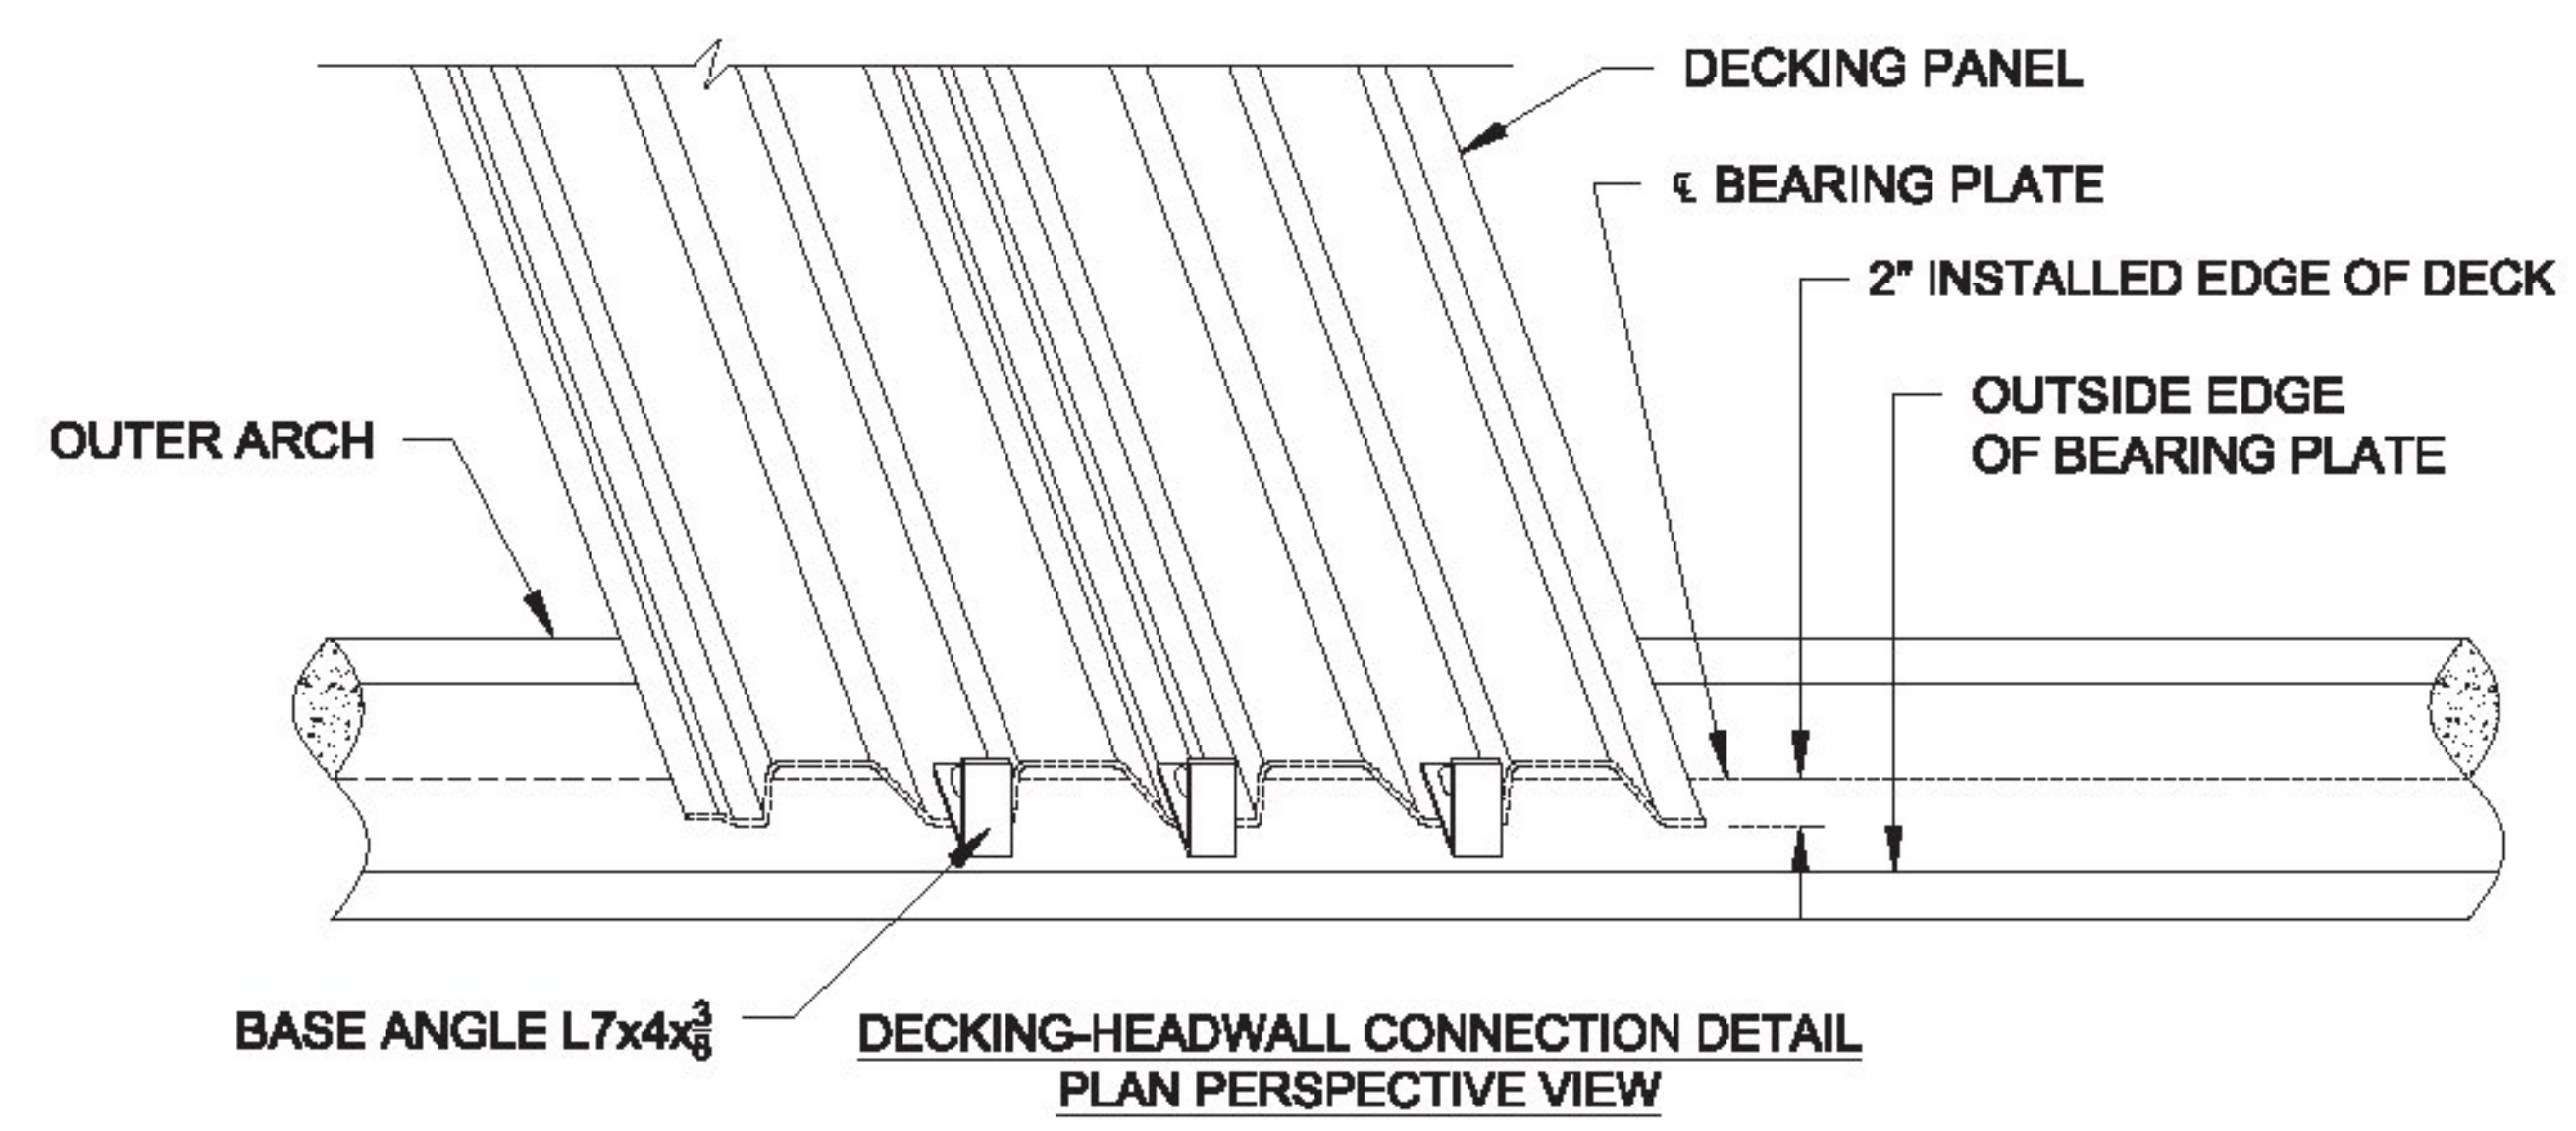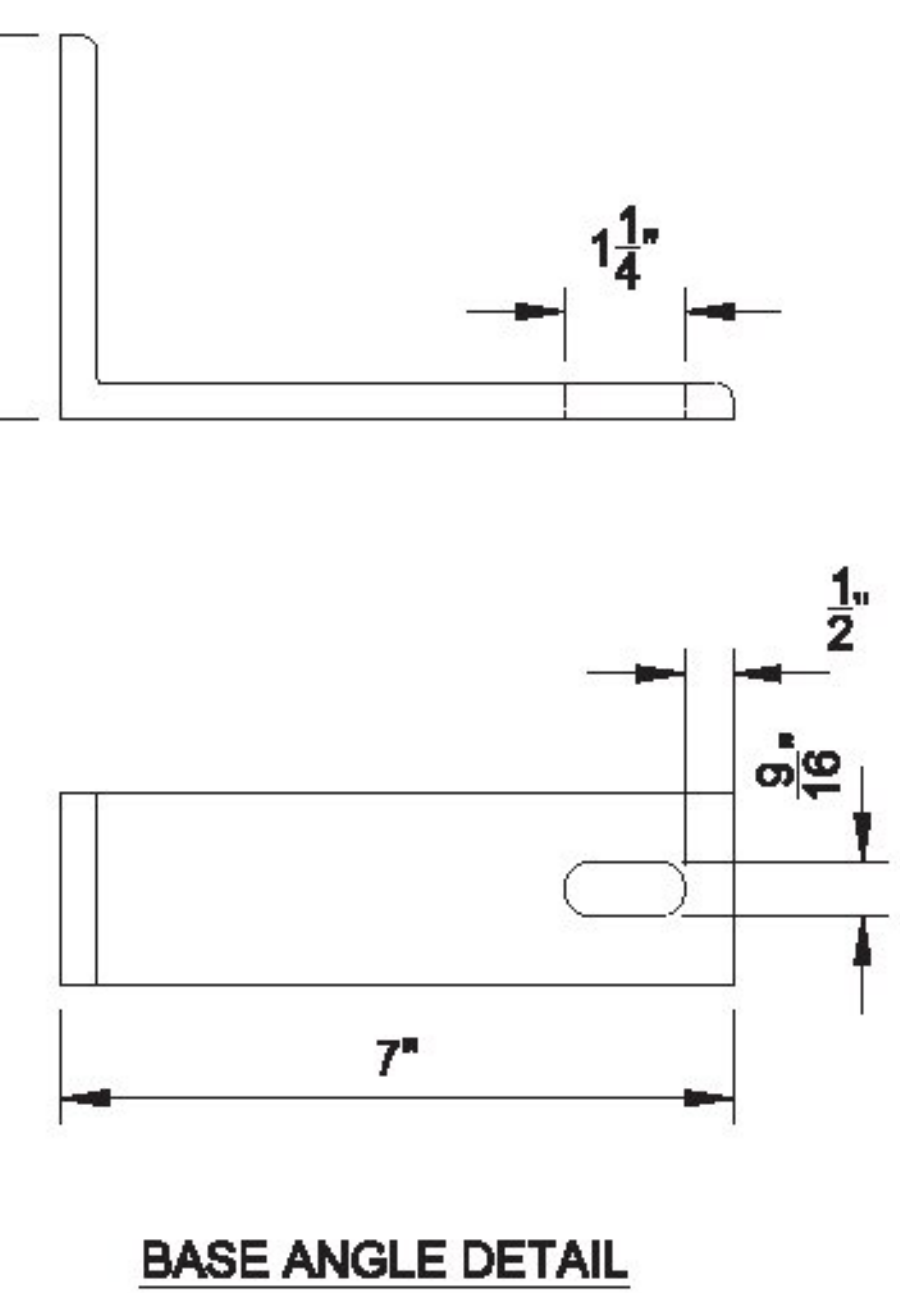

ADVANCED INFRASTRUCTURE TECHNOLOGIES

20 Godfrey Drive
 Orono, Maine 04473
 Tel 207.866.6526
 Fax 207.866.6501
 www.aitbridges.com

PROJECT: Wanzer Road Bridge No. 48	TITLE: HEADWALL DETAILS		SHEET NUMBER:
LOCATION: Fairfield, VT	JN: 12018	INITIALS	DATE
DRAWING STATUS: Approved for Construction	DRAWN BY: JEK	4-9-2014	9 OF 10 REV: 05-20-2014
Correct scale on size B paper (11x17 Ledger)	DESIGNED BY: JEK	4-9-2014	
	CHECKED BY: ZU	5-20-2014	

FASCIA PLATE NOTES:

- PROJECT SHALL INCLUDE TWENTY-TWO (22) TOTAL $\frac{1}{16}$ " BI-DIRECTIONAL E-GLASS CURVED FASCIA PLATES
- FASCIA PLATES SHALL BE PROVIDED CUT TO DIMENSIONS SHOWN ON PLANS
- FASCIA PLATES WILL NOT BE PRE-DRILLED OR MARKED AT SCREW LOCATIONS
- FASCIA PLATES SHALL BE FINISHED WITH SHERWIN-WILLIAMS FLUOROKEM FLUOROPOLYMER URETHANE MCSO SW4028 GYPSUM COLORED PAINT



X Approved _____ Approved As Noted
 _____ Rejected

This review is only for general conformance with the design concept and the information given in the Construction Documents. Corrections or comments made on the shop drawings during the review do not relieve the Contractor from compliance with the requirements of the Plans and Specifications. Review of a specific item shall not include review of an assembly of which an item is a component. The Contractor is responsible for dimensions to be confirmed and corrected at the job site; information that pertains solely to the fabrication process or to the means, methods, techniques, sequences and procedures of construction; coordination of the Work with that of other trades and performing all Work in a safe and satisfactory manner.

Date 6/6/2014



By T. Traver

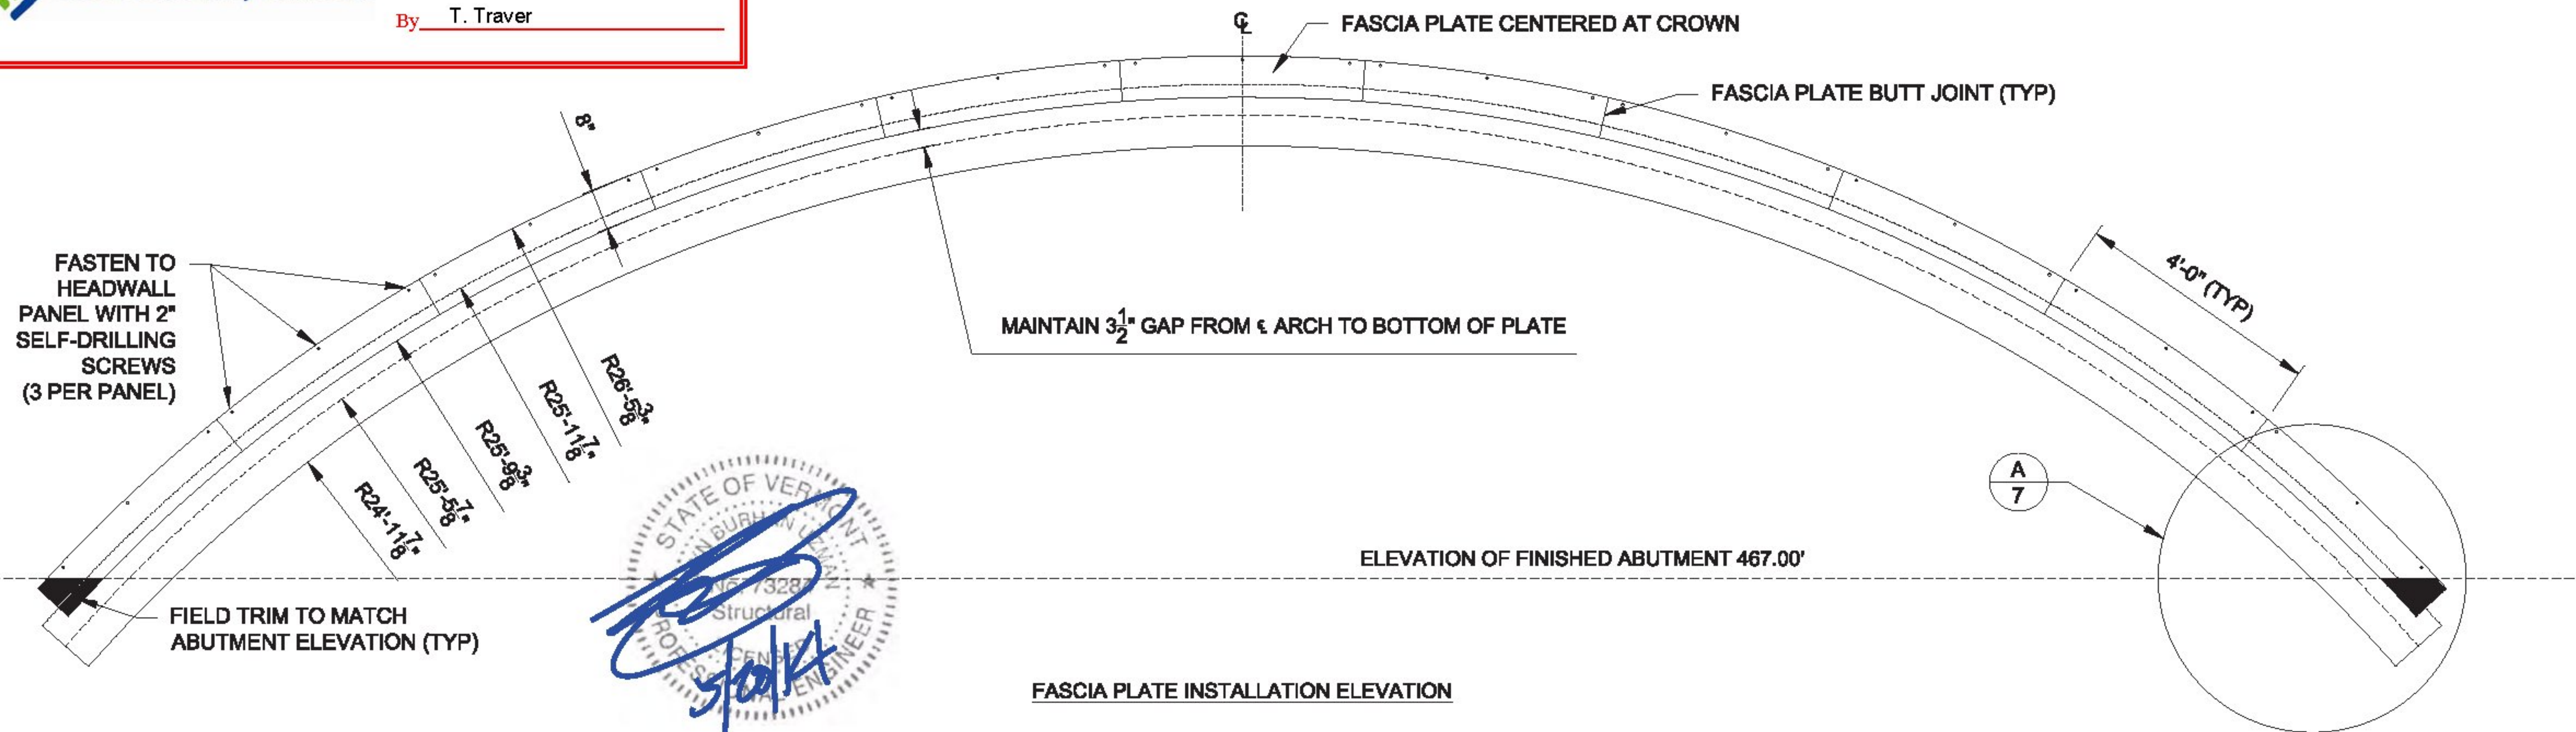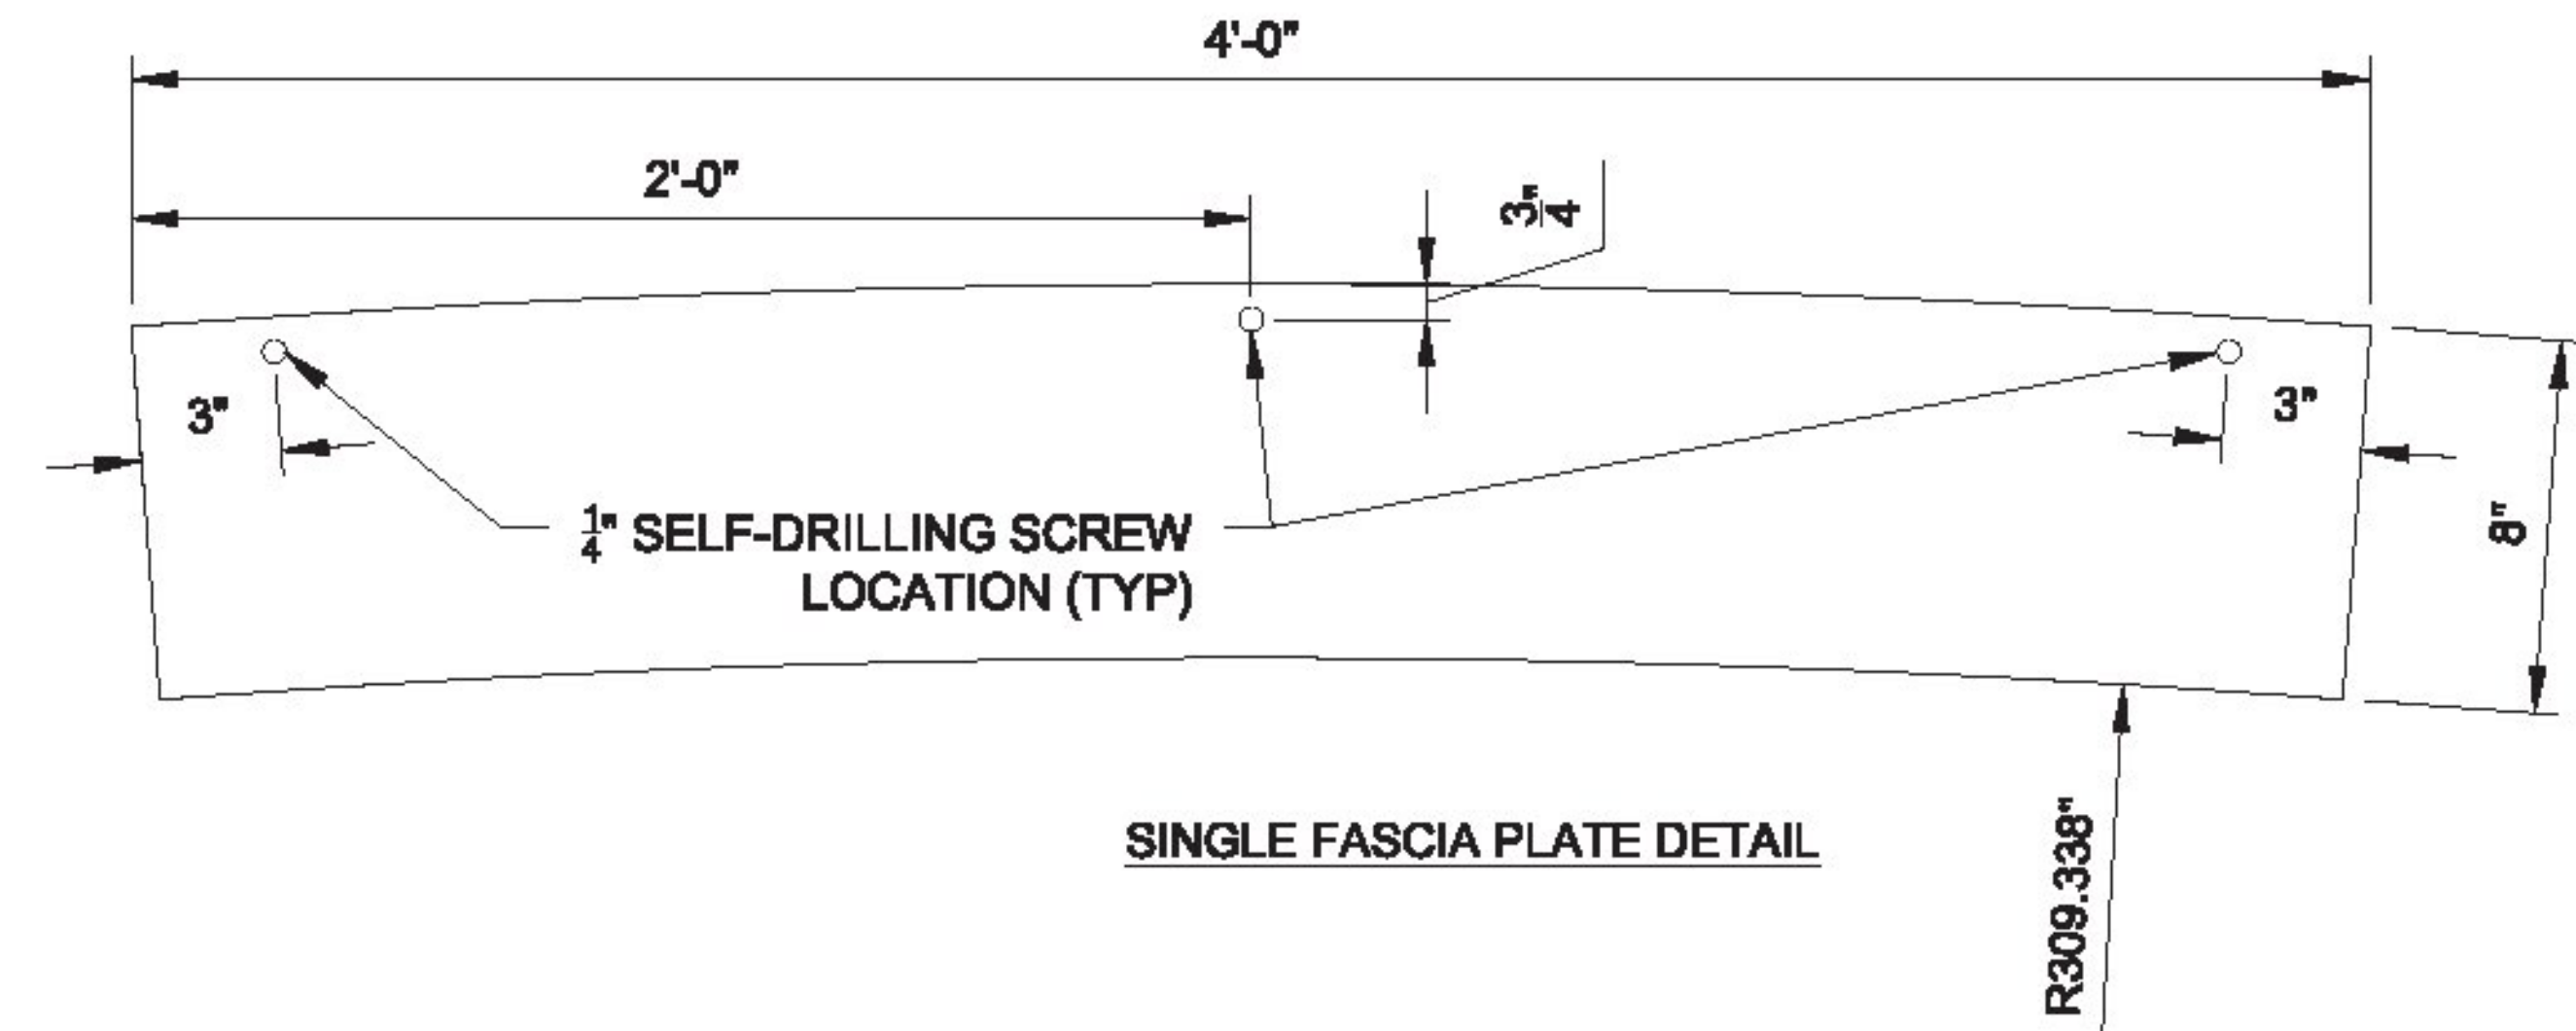

20 Godfrey Drive
 Orono, Maine 04473
 Tel 207.866.6526
 Fax 207.866.6501
 www.aitbridges.com

PROJECT: Wanzer Road Bridge No. 48	TITLE: FASCIA PLATE LAYOUT AND DETAILS		SHEET NUMBER:
LOCATION: Fairfield, VT	JN: 12018	INITIALS	DATE
DRAWING STATUS: Approved for Construction	DRAWN BY: JEK	4-9-2014	10 OF 10
Correct scale on size B paper (11x17 Ledger)	DESIGNED BY: JEK	4-9-2014	
	CHECKED BY: ZU	5-20-2014	
			REV: 05-20-2014

RIGIDIFIED TUBE FRP ARCH (RTFA) PROJECT

FAIRFIELD, VT

T-WALL® RETAINING WALL SYSTEM

DESIGNER



THE NEEL COMPANY

8328-D TRAFORD LANE
SPRINGFIELD, VIRGINIA 22152
PH: (703) 913-7858
FX: (703) 913-7859
WEB: WWW.NEELCO.COM

PRECASTER




Concrete Systems Inc.
9 Commercial St., Hudson, NH, 03051
Phone 603-889-4163
Fax 603-889-2417
Web www.csigroup.biz

INDEX OF DRAWINGS

SHEET	TITLE	REV #	DATE
1	COVER SHEET	1	8/6/14
2	TYPICAL T-WALL® NOMENCLATURE	0	4/21/14
3	NOTES	0	4/21/14
4	PLAN VIEW	0	4/21/14
5	ELEVATIONS	1	8/6/14
6	SECTION, DETAILS & QUANTITIES	1	8/6/14
7	REBAR - STANDARD UNITS	0	4/21/14
8	REBAR - SLOPED TOP UNITS	1	8/6/14
9	REBAR - NARROW SLOPED TOP LEFT BEVELED UNITS	1	8/6/14
10	REBAR - NARROW SLOPED TOP RIGHT BEVELED UNITS	1	8/6/14
11	REBAR - NARROW LEFT BEVELED UNITS	1	8/6/14
12	REBAR - NARROW RIGHT BEVELED UNITS	0	4/21/14

LEGEND

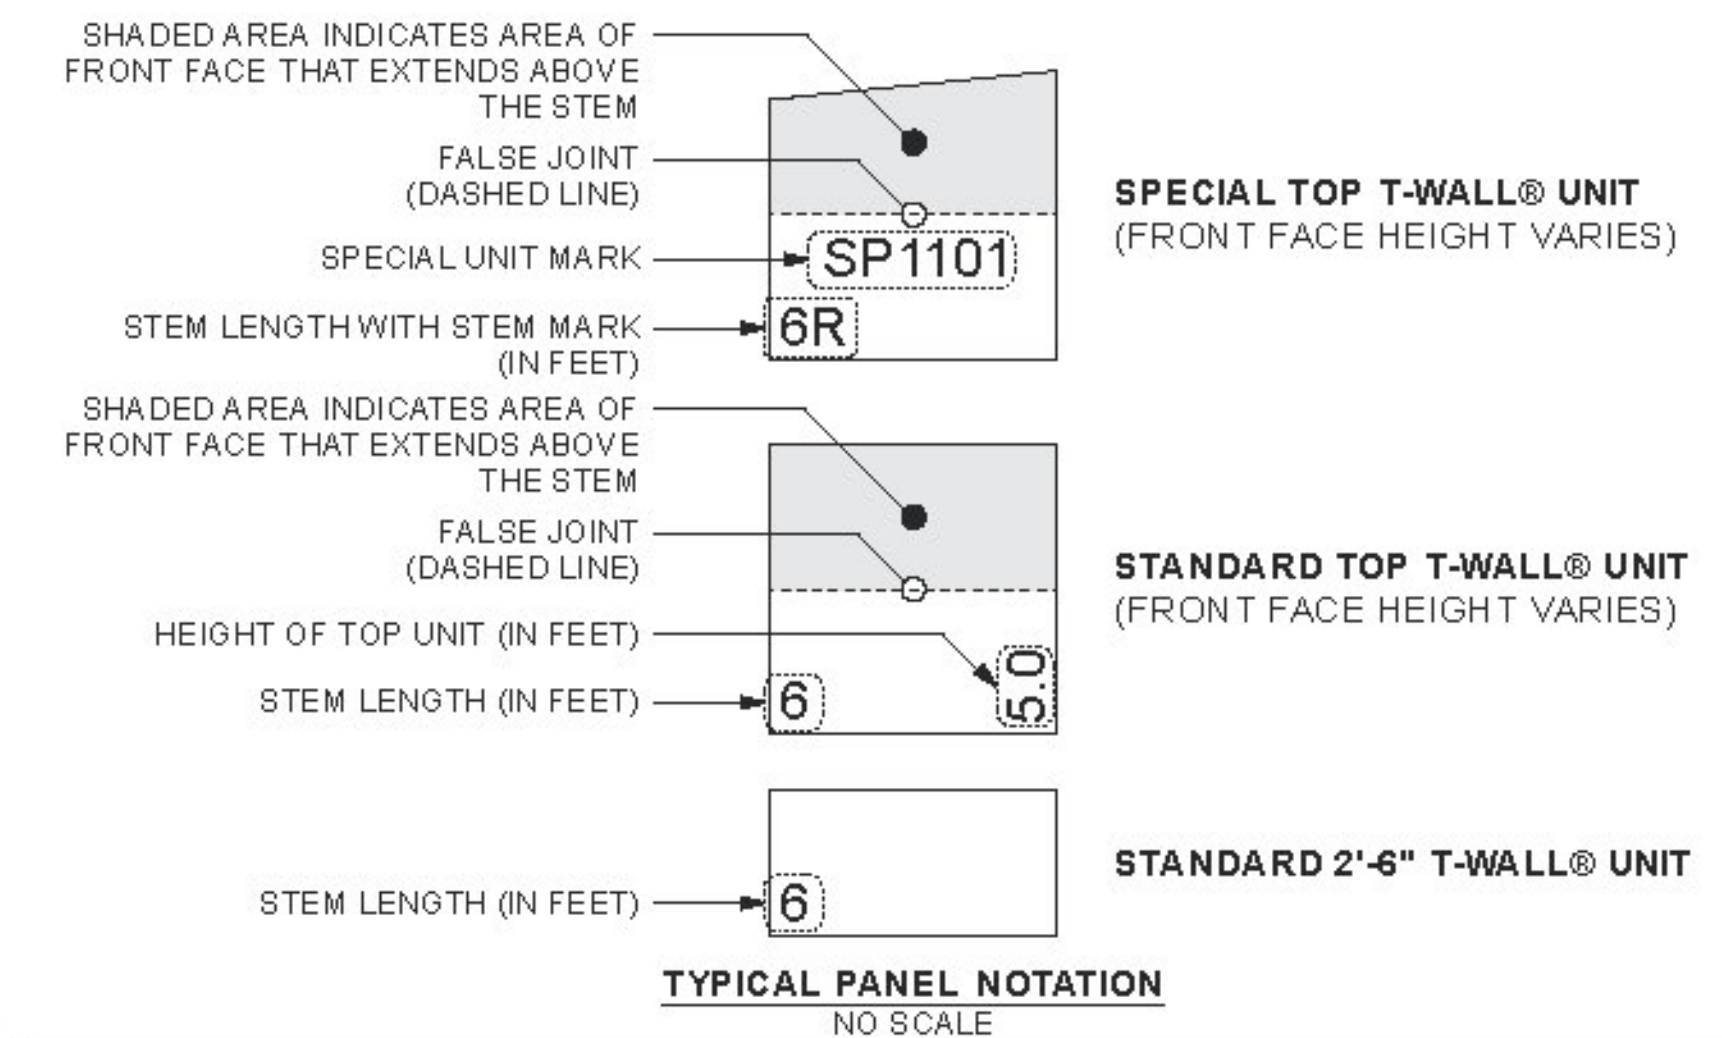




Approved **Approved As Noted**
 Rejected

This review is only for general conformance with the design concept and the information given in the Construction Documents. Corrections or comments made on the shop drawings during the review do not relieve the Contractor from compliance with the requirements of the Plans and Specifications. Review of a specific item shall not include review of an assembly of which an item is a component. The Contractor is responsible for dimensions to be confirmed and corrected at the job site; information that pertains solely to the fabrication process or to the means, methods, techniques, sequences and procedures of construction; coordination of the Work with that of other trades and performing all Work in a safe and satisfactory manner.



Date 8/8/2014

By T. Traver

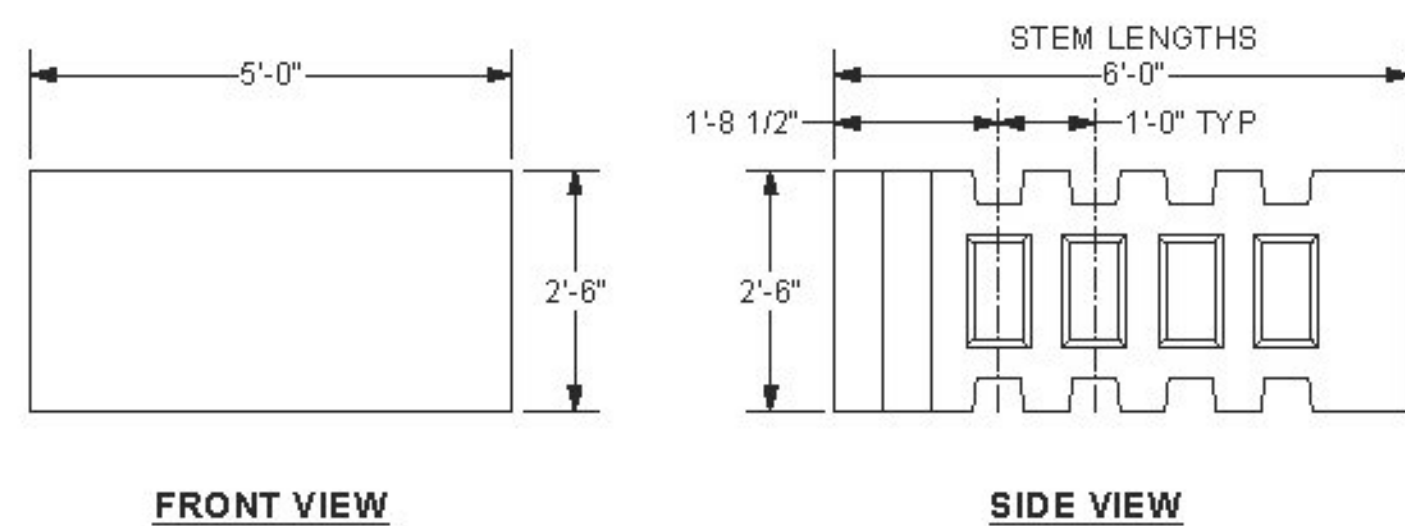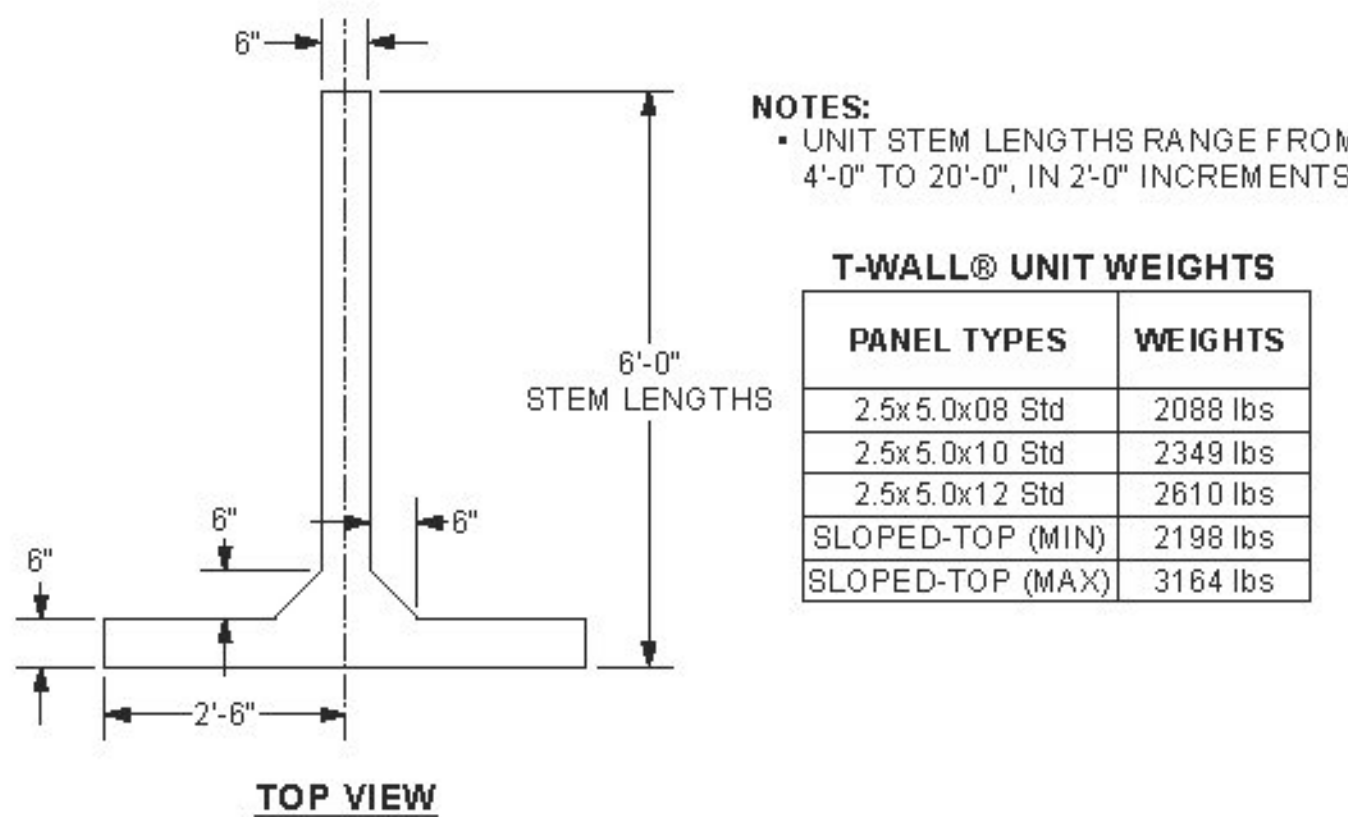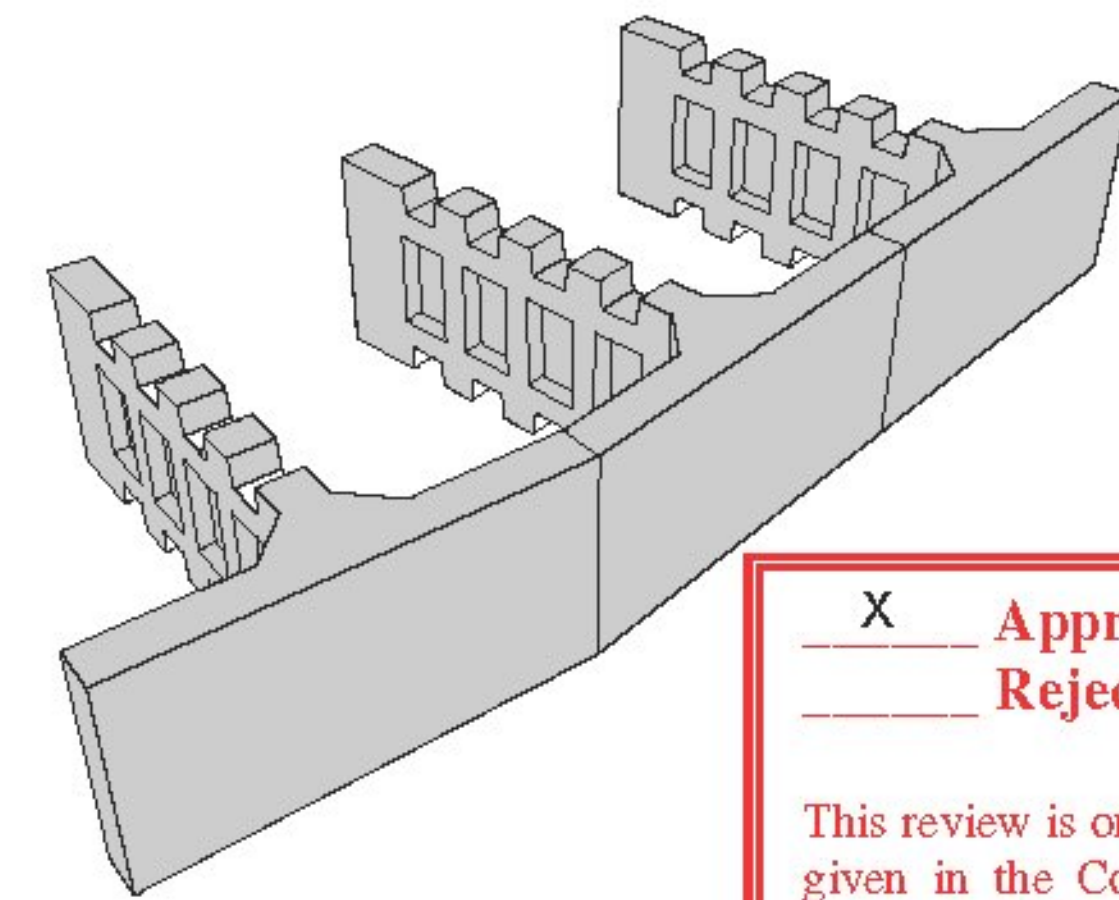

TYPICAL 2'-6" x 5'-0" x 6'-0" STEM T-WALL® UNIT



The design contained on these drawings is based upon information provided by the owner. On the basis of this information, The Neel Company has designed, and is responsible for, the internal stability of the structure only. External stability, including foundation and slope stability, is the responsibility of the owner.

This drawing contains information proprietary to The Neel Company. T-WALL® is a registered trademark owned by The Neel Company. ©2014 The Neel Company

PRECASTER: CONCRETE SYSTEMS, INC. CSI

PROJECT #: T21882

CONTRACTOR: AL. ST. ONGE CONTRACTORS

PROJECT #:

DESIGNER



THE NEEL COMPANY
8328-D TRAFORD LANE
SPRINGFIELD, VIRGINIA 22152
PH: (703) 913-7858
FX: (703) 913-7859
WEB: WWW.NEELCO.COM

PROJECT # TW4301

CERTIFIED WITH RESPECT TO INTERNAL STABILITY OF T-WALL® STRUCTURES ONLY



REVISIONS

NO.	REVISION	DATE
1	REVIEWER COMMENTS	ABC 8-6-14

RIGIDIFIED TUBE FRP ARCH (RTFA) PROJECT

FAIRFIELD, VT

SHOP DRAWINGS
COVER SHEET

T-WALL® RETAINING WALL SYSTEM

SCALE: NO SCALE


DATE: 4/21/14

DESIGNED BY: KD


DRAWN BY: ABC

CHECKED BY: CCG


SHEET: 1

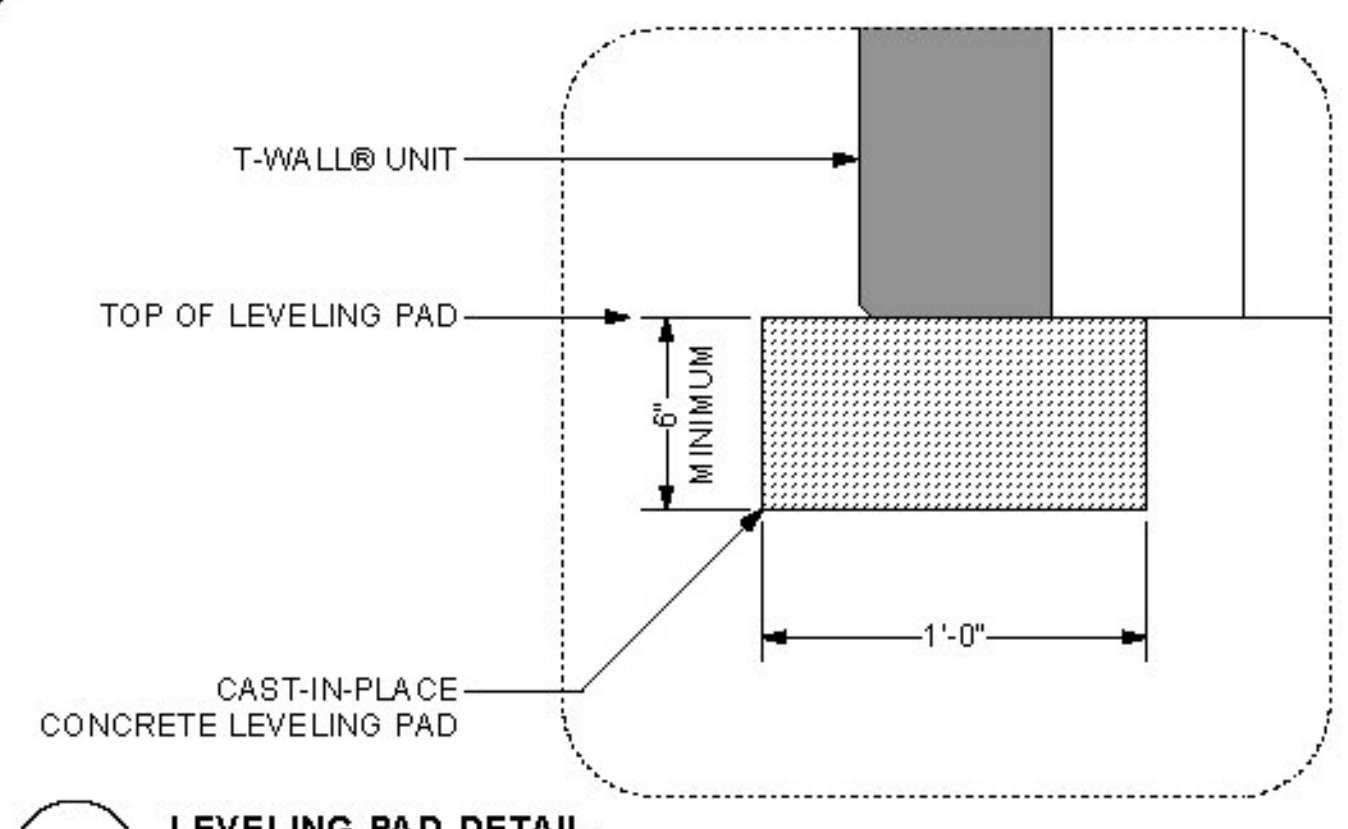

4 LEVELING PAD DETAIL
Scale: 2" = 1'-0"

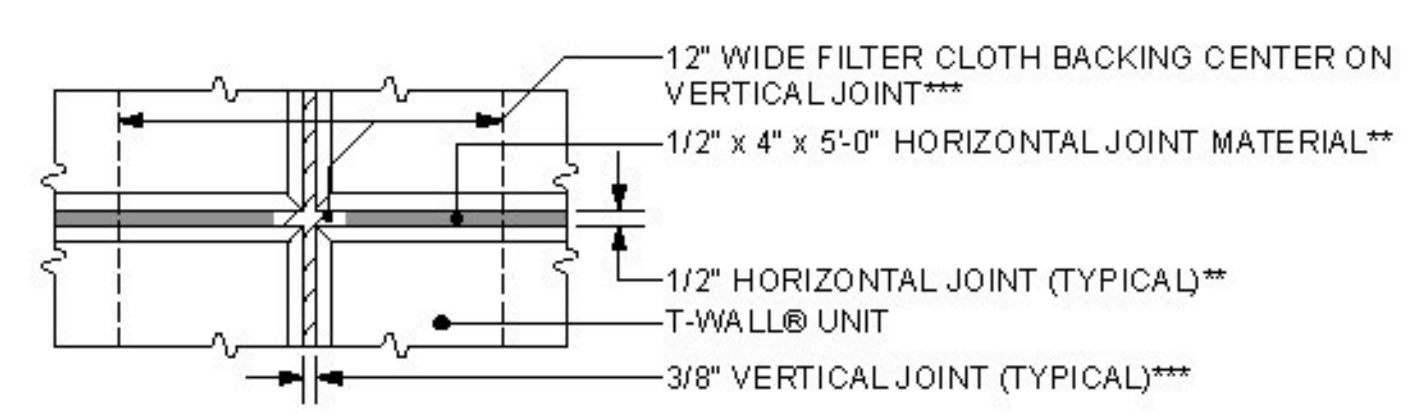

3 HORIZONTAL AND VERTICAL JOINT DETAIL
Scale: 2" = 1'-0"
** SEE GENERAL NOTE 4 ON SHEET 3 FOR ADDITIONAL DETAILS
*** SEE GENERAL NOTE 5 ON SHEET 3 FOR ADDITIONAL DETAILS

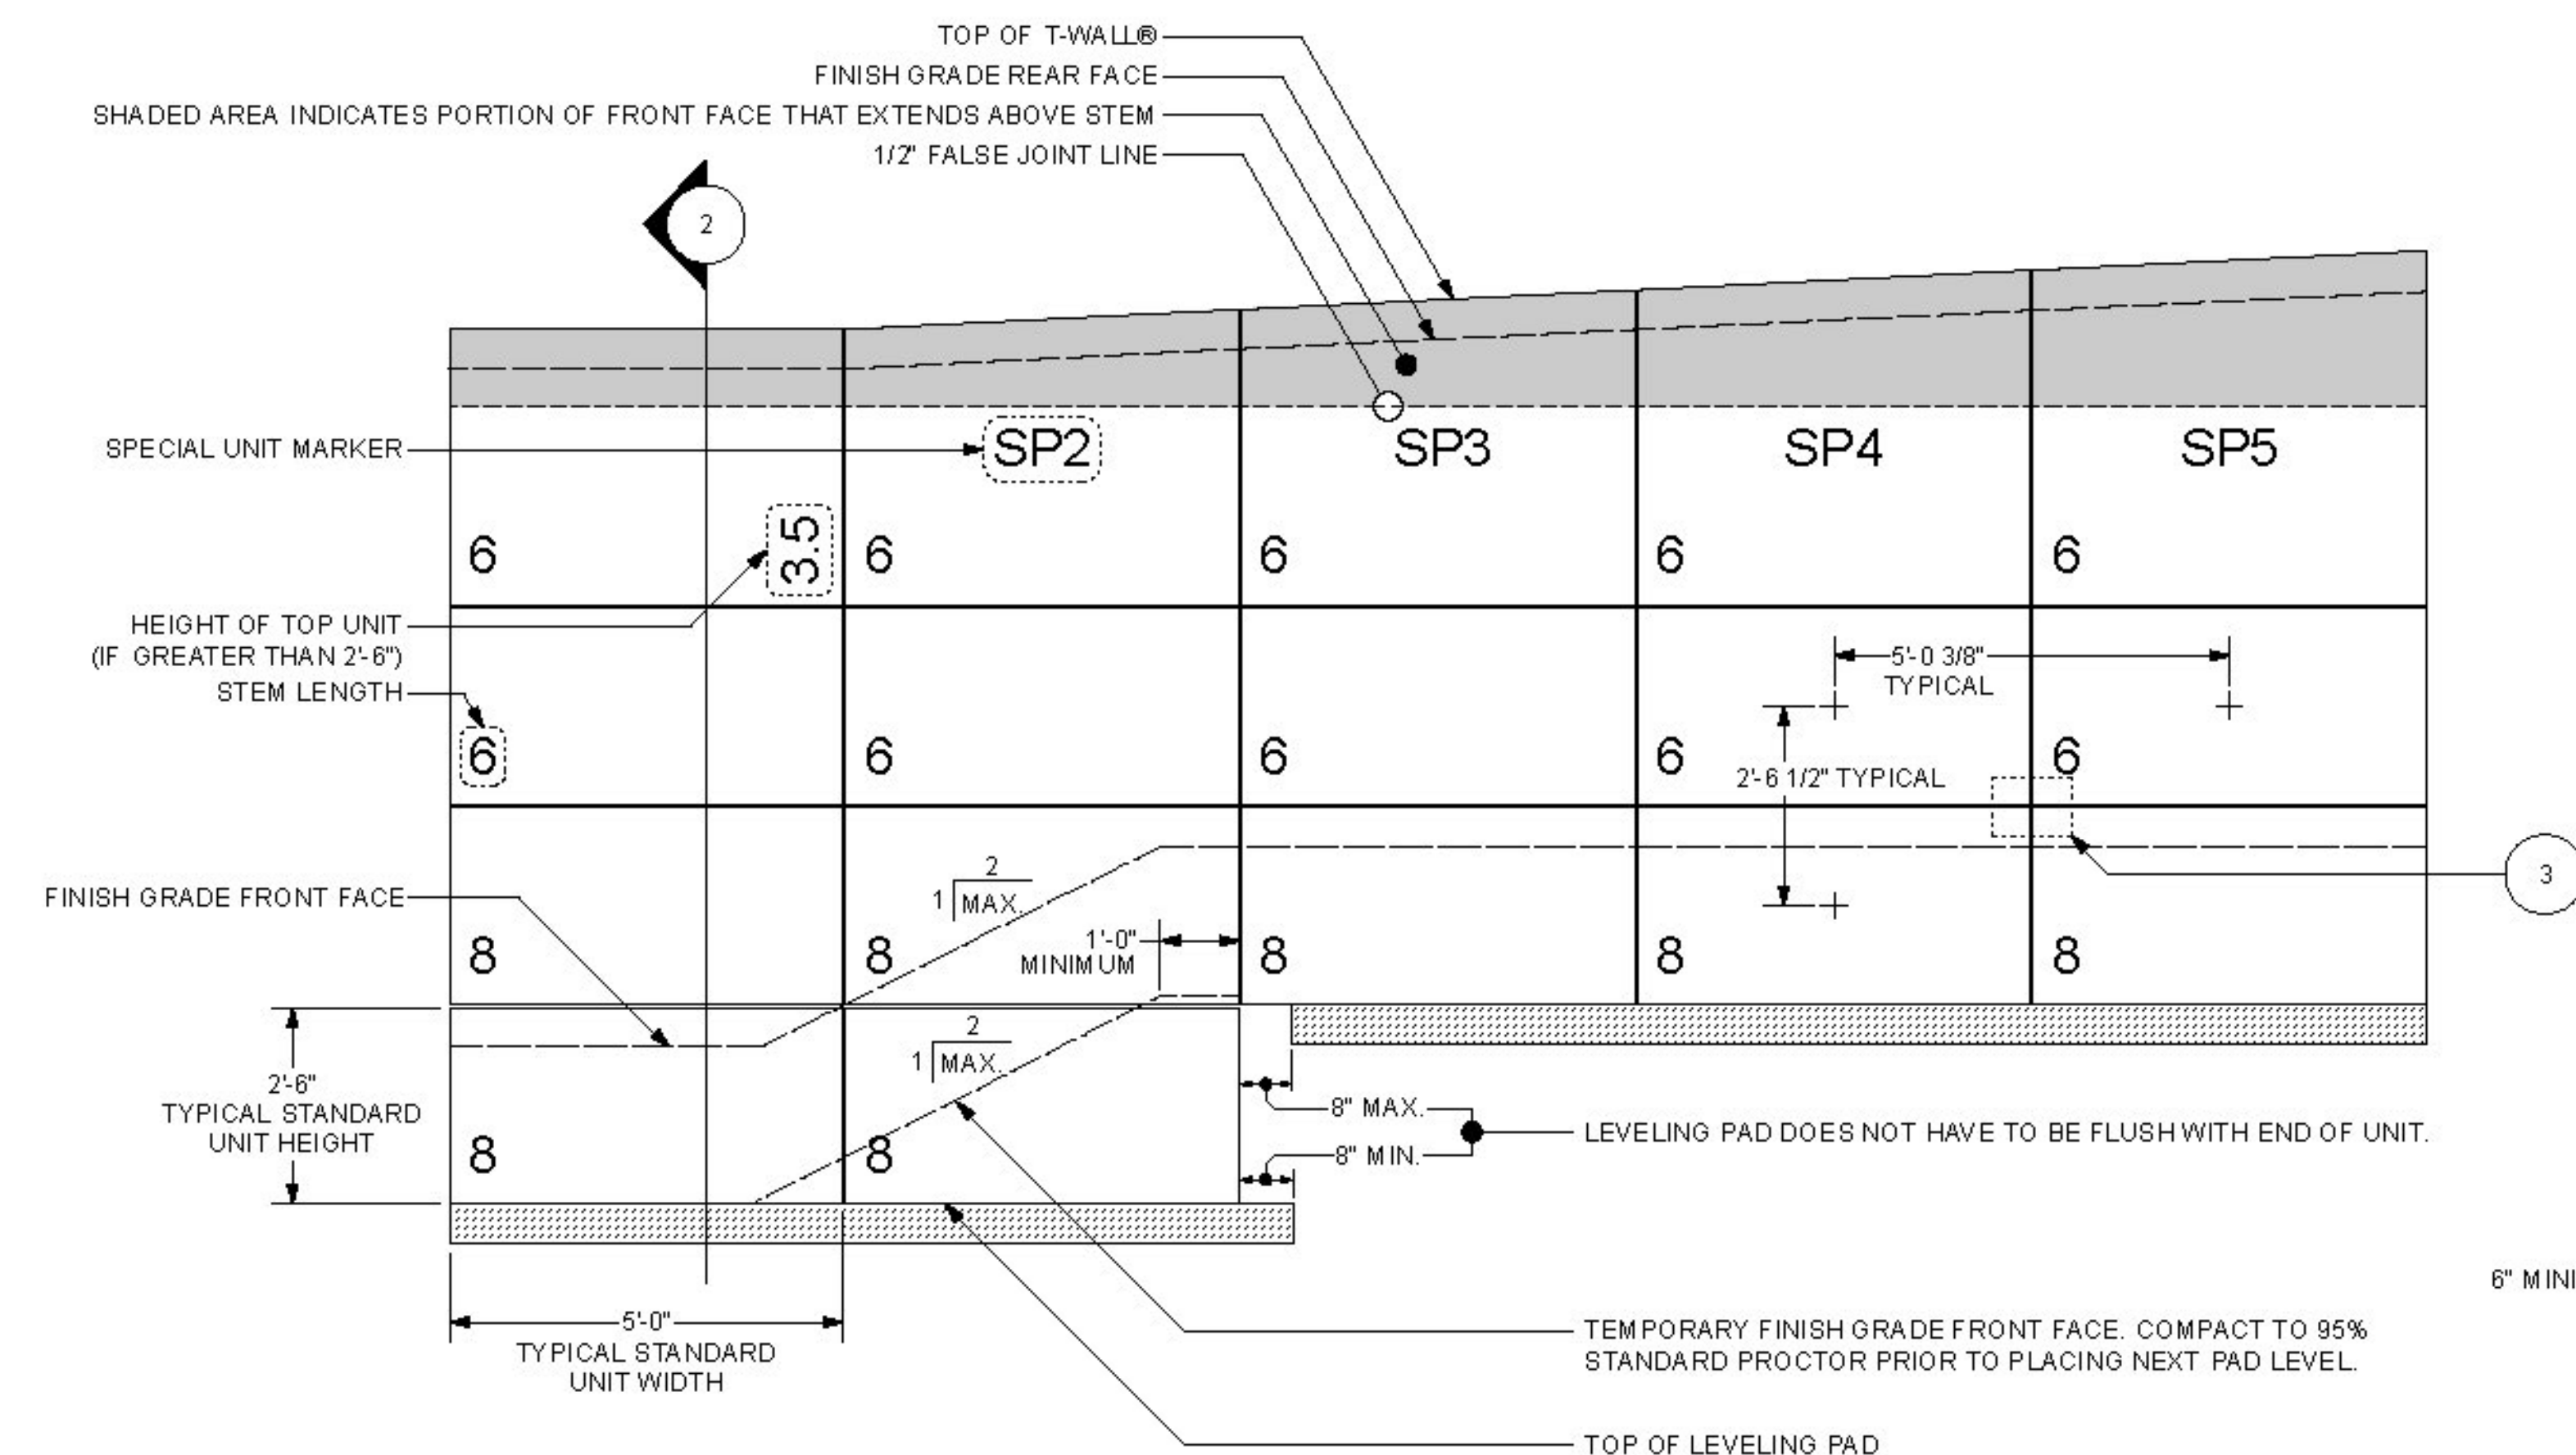

1 PARTIAL ELEVATION SHOWN - TYPICAL DETAILS
Scale: 1/2" = 1'-0"
NOT ALL DETAILS APPLY. SEE SPECIFIC WALL ELEVATIONS

NOMENCLATURE NOTE:

THIS SHEET IS PROVIDED FOR GENERAL INFORMATION PURPOSES ONLY, REFERENCING STANDARD DETAILS APPLICABLE TO ANY T-WALL STRUCTURE. THIS SHEET IS NOT INTENDED TO PROVIDE DETAILS SPECIFIC TO THE WALL STRUCTURES CONTAINED IN THIS DRAWING PACKAGE. FOR INFORMATION SPECIFIC TO THESE WALLS, SEE THE APPLICABLE DRAWING SHEETS.


SHEAR KEY NOTES:

1. WALL IS DESIGNED FOR SPECIFIC NUMBER OF SHEAR KEYS AS SHOWN IN "TYPICAL SECTION AT MAXIMUM HEIGHT" ON SHEET 4. LOCATION OF SHEAR KEYS CAN BE ADJUSTED IF NECESSARY AT A SPECIFIC LEVEL.


Approved **Approved As Noted**
 Rejected

This review is only for general conformance with the design concept and the information given in the Construction Documents. Corrections or comments made on the shop drawings during the review do not relieve the Contractor from compliance with the requirements of the Plans and Specifications. Review of a specific item shall not include review of an assembly of which an item is a component. The Contractor is responsible for dimensions to be confirmed and corrected at the job site; information that pertains solely to the fabrication process or to the means, methods, techniques, sequences and procedures of construction; coordination of the Work with that of other trades and performing all Work in a safe and satisfactory manner.

Date: 8/8/2014
By: T. Traver

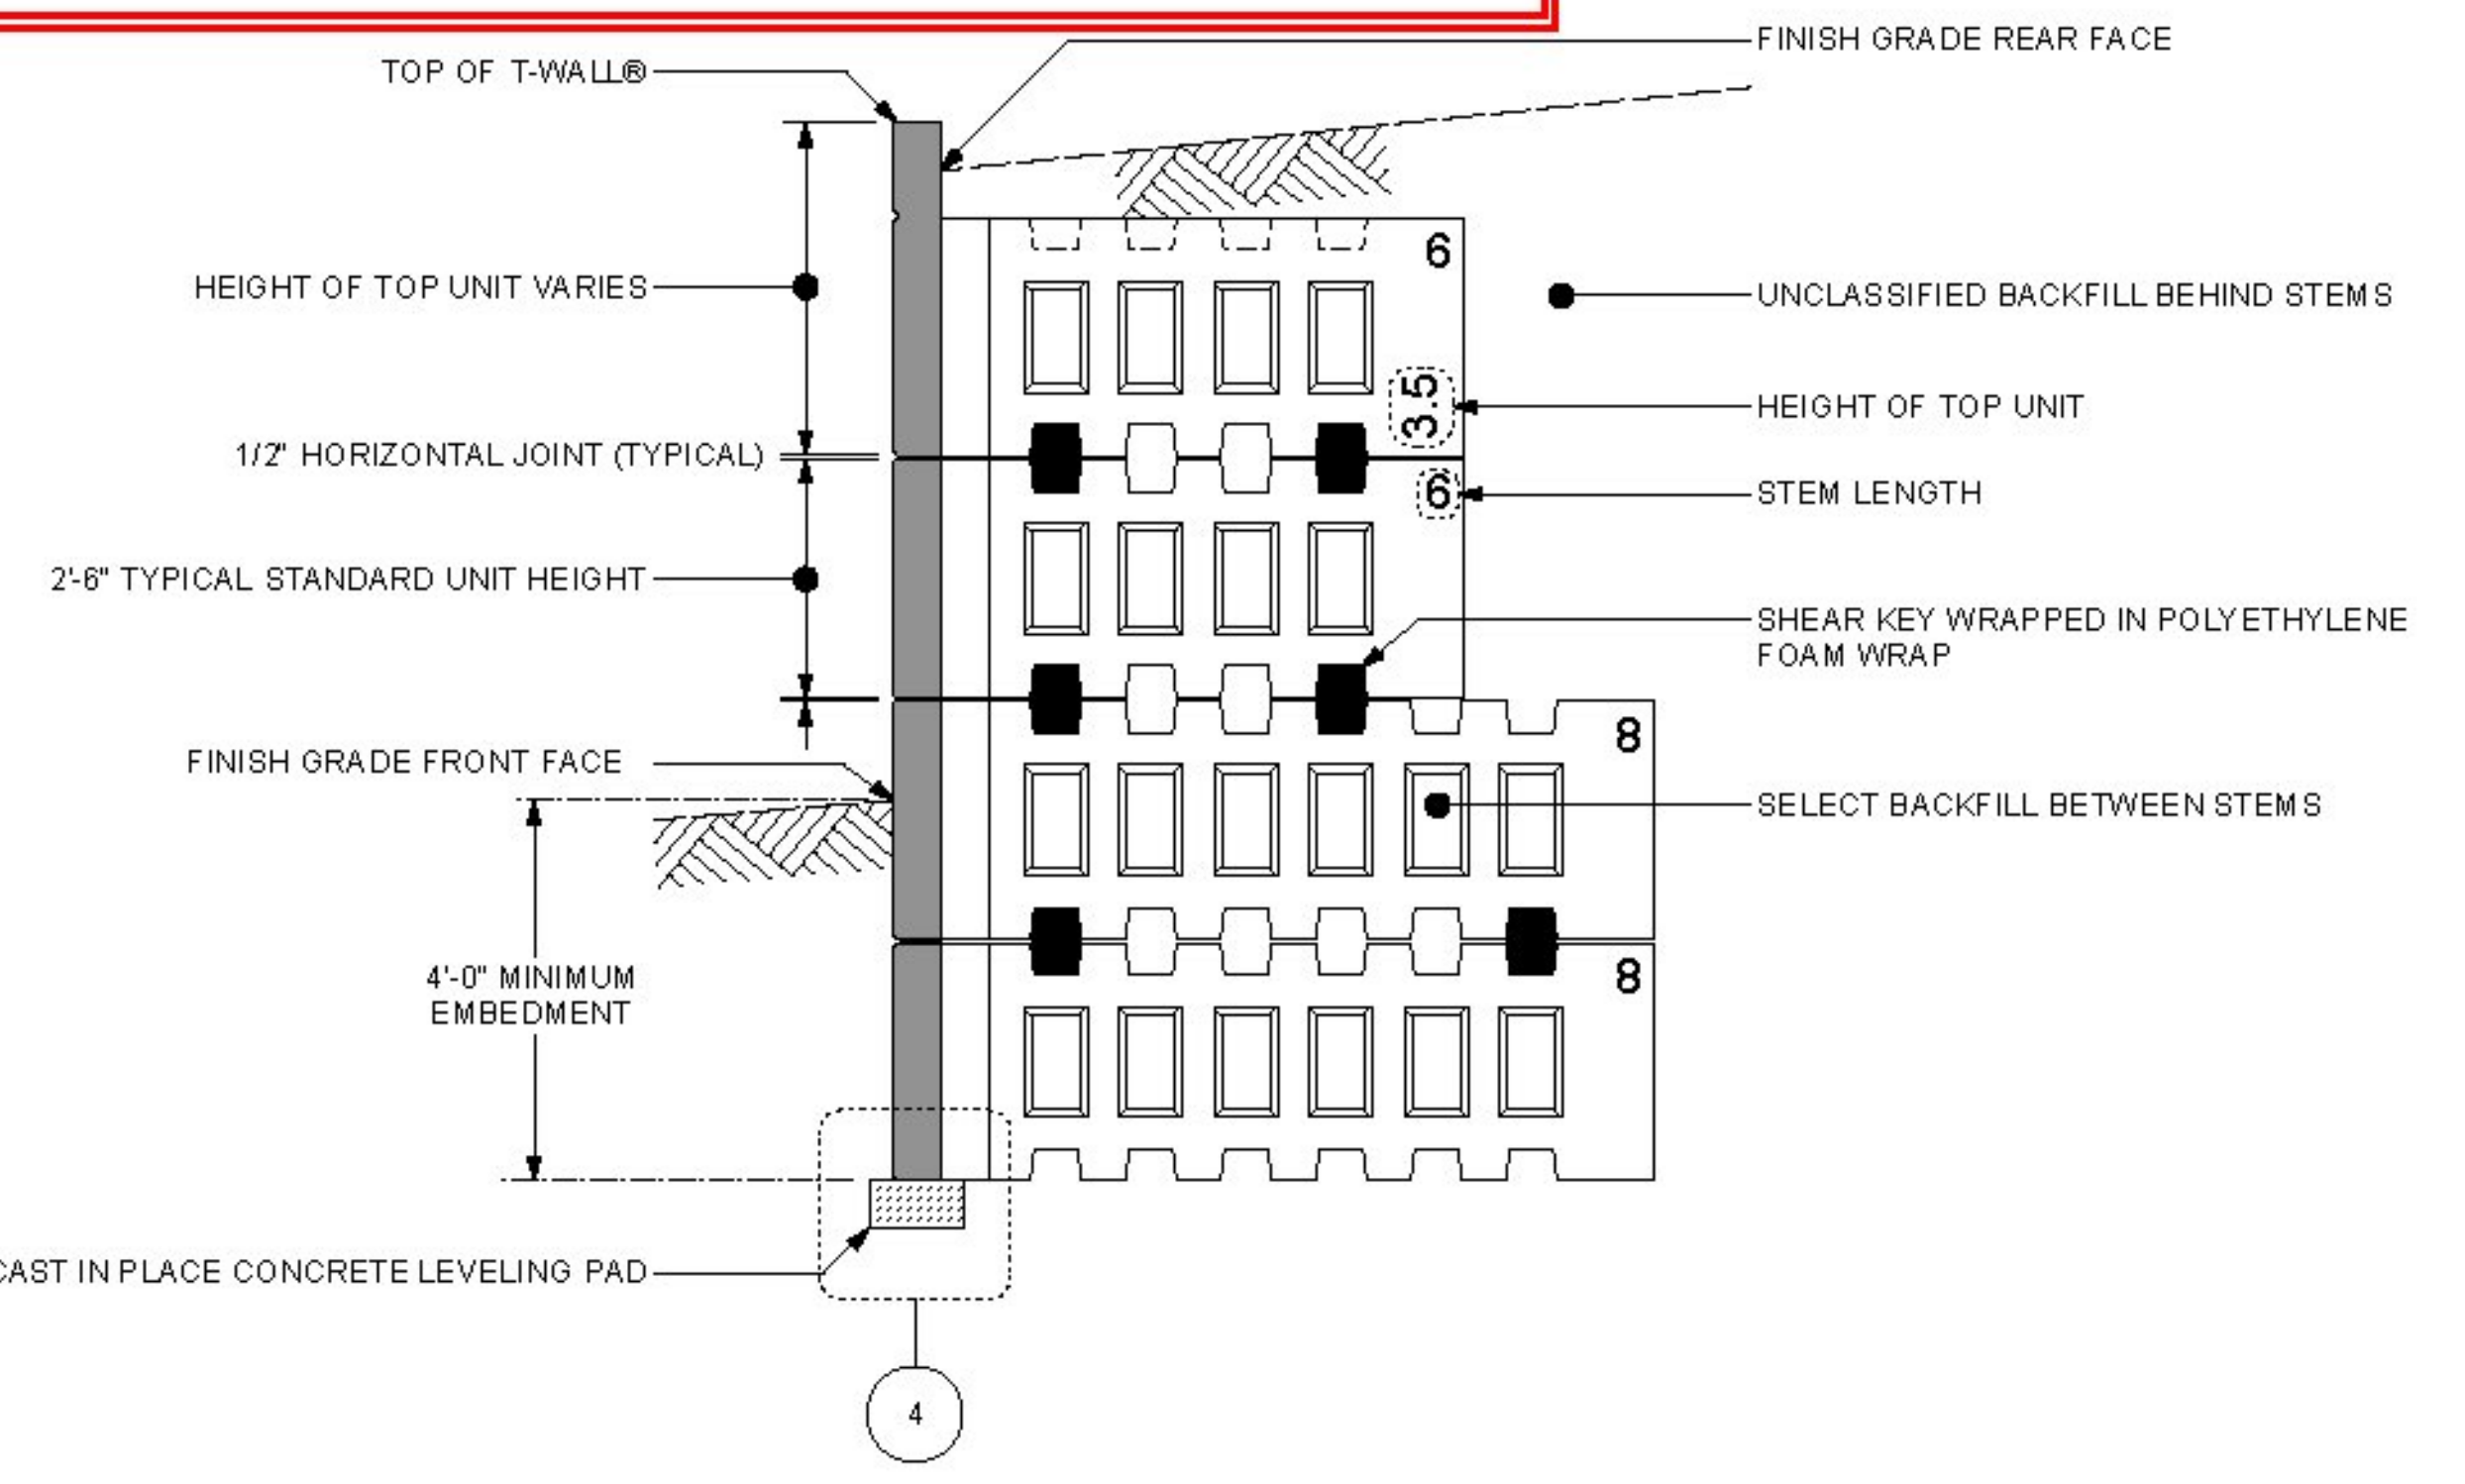

2 PARTIAL ELEVATION SHOWN - TYPICAL DETAILS
Scale: 1/2" = 1'-0"
NOT ALL DETAILS APPLY. SEE SPECIFIC WALL ELEVATIONS

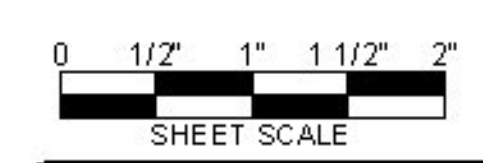

The design contained on these drawings is based upon information provided by the owner. On the basis of this information, The Neel Company has designed, and is responsible for, the internal stability of the structure only. External stability, including foundation and slope stability, is the responsibility of the owner.

This drawing contains information proprietary to The Neel Company. T-WALL is a registered trademark owned by The Neel Company. ©2014 The Neel Company


PRECASTER: CONCRETE SYSTEMS, INC. CSI
PROJECT #: T21882

CONTRACTOR: AL. ST. ONGE CONTRACTORS
PROJECT #:

DESIGNER

THE NEEL COMPANY
8328-D TRAFORD LANE
SPRINGFIELD, VIRGINIA 22152
PH: (703) 913-7888
FX: (703) 913-7889
WEB: WWW.NEELCO.COM

PROJECT #: TW4301

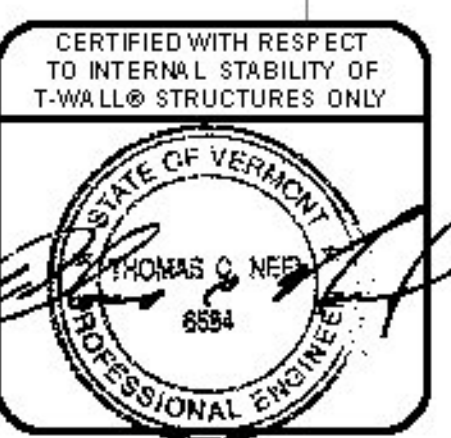

REVISIONS	

RIGIDIFIED TUBE FRP ARCH (RTFA) PROJECT

FAIRFIELD, VT

SHOP DRAWINGS
TYPICAL T-WALL NOMENCLATURE
T-WALL RETAINING WALL SYSTEM

SCALE:	AS NOTED
DATE:	4/21/14
DESIGNED BY:	KD
DRAWN BY:	ABC
CHECKED BY:	CCG
SHEET:	2

X Approved _____ Approved As Noted
_____ Rejected

This review is only for general conformance with the design concept and the information given in the Construction Documents. Corrections or comments made on the shop drawings during the review do not relieve the Contractor from compliance with the requirements of the Plans and Specifications. Review of a specific item shall not include review of an assembly of which an item is a component. The Contractor is responsible for dimensions to be confirmed and corrected at the job site; information that pertains solely to the fabrication process or to the means, methods, techniques, sequences and procedures of construction; coordination of the Work with that of other trades and performing all Work in a safe and satisfactory manner.



Date 8/8/2014

By T. Traver

SPECIAL NOTES:

- 1. THESE DRAWINGS WERE PREPARED BASED ON INFORMATION GIVEN IN THE FOLLOWING:
- CONTRACT DRAWINGS:
- STATE OF VERMONT AGENCY OF TRANSPORTATION CONTRACT PLANS DATED 10/30/2013. PREPARED BY MCFARLAND JOHNSON.
2. REPORT DISCREPANCIES BETWEEN CONTRACT INFORMATION AND ACTUAL CONDITIONS AS SITE WORK PROGRESSES TO THE NEEL COMPANY FOR REDESIGN. NO LIABILITY IS ACCEPTED FOR INACCURATE INFORMATION SUPPLIED BY OTHERS.
3. THE FOLLOWING ASSUMPTIONS WERE MADE:
- FOUNDATION IS ABLE TO SUPPORT BEARING PRESSURE SHOWN IN SPECIAL NOTES 4 WITH AN ACCEPTABLE FACTOR OF SAFETY.
4. APPLIED BEARING PRESSURE AT MAXIMUM HEIGHT:
- WINGWALL MAXIMUM PRESSURE: 4,475 psf STR 1 MAX
- DESIGN IS BASED ON AASHTO LRFD METHOD.
5. THE DESIGN CONTAINED ON THESE DRAWINGS IS BASED UPON INFORMATION PROVIDED BY THE OWNER. ON THE BASIS OF THIS INFORMATION, THE NEEL COMPANY HAS DESIGNED, AND IS RESPONSIBLE FOR, THE INTERNAL STABILITY OF THE STRUCTURE ONLY. EXTERNAL STABILITY, INCLUDING FOUNDATION AND SLOPE STABILITY, IS THE RESPONSIBILITY OF THE OWNER.
6. THE NEEL COMPANY HAS NOT PERFORMED GLOBAL STABILITY SETTLEMENT AND BEARING CAPACITY ANALYSIS FOR THE WALL FOUNDATION. THESE ANALYSES WILL BE THE RESPONSIBILITY OF OTHERS.
7. DRAINAGE:
- THE NEEL COMPANY HAS NOT PERFORMED A DRAINAGE ANALYSIS FOR THIS WALL SITE. IT IS THE OWNER'S RESPONSIBILITY TO ASSURE THAT SURFACE RUN-OFF IS DIVERTED AWAY FROM THE WALL.
8. SELECT BACKFILL GRADATION AND COMPACTION:
- BACKFILL GRADATION AND COMPACTION BETWEEN STEMS AND AROUND PIPES ARE IMPORTANT TO THE WALL STABILITY. THE OWNER'S GEOTECHNICAL ENGINEER SHOULD PROVIDE SUFFICIENT TESTING TO INSURE COMPLIANCE WITH THE SELECT BACKFILL GRADATION AND COMPACTION SPECIFICATIONS NOTED ON THIS SHEET. PLACEMENT OF LOOSE LIFT OF BACKFILL SHALL NOT EXCEED 12 INCHES.
9. T-WALL@ FACE FORM FINISH:
- PLAIN STEEL FORM FINISH

GENERAL NOTES:

- 1. PRIMARY REFERENCE:
- AASHTO LRFD BRIDGE DESIGN SPECIFICATIONS 5TH EDITION 2010 AND INTERIMS.
2. SELECT BACKFILL BETWEEN STEMS:
- ANGLE OF INTERNAL FRICTION - 34°
- DENSITY - 120 pcf
- 10% MAXIMUM PASSING #200 SIEVE
- 100% PASSING 3" SIEVE
- 95% STANDARD COMPACTION (ASTM D-698)
3. UNCLASSIFIED BACKFILL BEHIND STEMS:
- ANGLE OF INTERNAL FRICTION - 30°
- DENSITY - 120 pcf
- 95% STANDARD COMPACTION (ASTM D-698)
4. HORIZONTAL JOINT:
- 1/2 INCH ASPHALT JOINT MATERIAL PER ASTM D-994 AS SHOWN ON DEVELOPED ELEVATIONS.
5. VERTICAL JOINT:
- 3/8 INCH SPACE
- 12 INCHES WIDE FILTER CLOTH BACKING CENTERED AT JOINT, UNLESS OTHERWISE NOTED.
- FILTER CLOTH BACKING: MIRAFI 160N OR EQUAL
6. OVERALL DIMENSIONAL TOLERANCES FOR FINISHED WALL:
- VERTICAL ALIGNMENT (PLUMPNES) - 3/4 INCH IN 10 FEET
- HORIZONTAL ALIGNMENT (LINE) - 3/4 INCH IN 10 FEET
7. FOUNDATION:
- PROOF-ROLL THE FOUNDATION SUBGRADE ALONG THE ENTIRE WALL LENGTH PRIOR TO CONSTRUCTION OF THE T-WALL@. A GEOTECHNICAL ENGINEER MUST INSPECT THE EXCAVATED FOUNDATION SUBGRADE AND PROOF-ROLLING ACTIVITIES. ANY SOFT OR UNSUITABLE MATERIALS IDENTIFIED BY INSPECTION SHALL BE REMOVED AND REPLACED WITH COMPACTED STRUCTURAL BACKFILL AS DIRECTED BY THE ENGINEER. CONTRACTOR TO PROVIDE SUFFICIENT DEWATERING SO THAT THE EXCAVATIONS ARE DRY ENOUGH FOR INSPECTION, TESTING AND CONSTRUCTION.
8. CAST-IN-PLACE CONCRETE LEVELING PAD:
- 6 INCHES MINIMUM x 12 INCHES
- CONCRETE STRENGTH: 2500 psi (MINIMUM) @ 28 DAYS
- NO REBAR
- GRADE TOLERANCE - 1/4 INCH IN 10 FEET
9. T-WALL@ UNIT REBAR:
- ASTM A615/ASTM A185
- Fy = 60 ksi (GRADE 60)
- BLACK
- WELDING IS NOT PERMITTED
10. T-WALL@ UNIT CONCRETE:
- 5000 psi (MINIMUM) @ 28 DAYS
11. SHEAR KEYS:
- NO REBAR
- CONCRETE STRENGTH: 4000 psi (MINIMUM) @ 28 DAYS
- WALL IS DESIGNED FOR SPECIFIC NUMBER OF SHEAR KEYS AS SHOWN IN TYPICAL SECTION ON SHEET 4. LOCATION OF SHEAR KEYS CAN BE ADJUSTED IF NECESSARY AT A SPECIFIC LEVEL.
- SHEAR KEY WRAP:
- 1/4 INCH POLYETHYLENE FOAM WRAP TWO TIMES AROUND THE SHEAR KEY.
- SHEAR KEY WRAP: AF250 POLYETHYLENE FOAM
12. CONSTRUCTION:
- TO BE IN ACCORDANCE WITH T-WALL@ CONSTRUCTION MANUAL (v07.04) AND TYPICAL T-WALL@ NOMENCLATURE ON SHEET 2.
- T-WALL@ CONSTRUCTION MANUAL (v07.04) CAN BE DOWNLOADED FROM OUR WEB SITE AT www.neelco.com, UNDER "Downloads".
- CONTRACTOR IS RESPONSIBLE FOR THE STABILITY OF ALL EXCAVATED SLOPES. DESIGN AND CONSTRUCTION OF ANY REQUIRED TEMPORARY SUPPORT OF EXCAVATION SHALL ALSO BE THE RESPONSIBILITY OF THE CONTRACTOR.
- ALL SURFACE RUNOFF IS TO BE DIVERTED AWAY FROM EXCAVATIONS TO AVOID THE DETERIORATION OF THE SUBGRADE SOILS DUE TO EXPOSURE TO MOISTURE.



The design contained on these drawings is based upon information provided by the owner. On the basis of this information, The Neel Company has designed, and is responsible for, the internal stability of the structure only. External stability, including foundation and slope stability, is the responsibility of the owner.

This drawing contains information proprietary to The Neel Company. T-WALL@ is a registered trademark owned by The Neel Company. ©2014 The Neel Company

PRECASTER: CONCRETE SYSTEMS, INC. CSI

PROJECT #: T21882

CONTRACTOR: AL. ST. ONGE CONTRACTORS


PROJECT #:

DESIGNER

THE NEEL COMPANY
8328-D TRAFORD LANE
SPRINGFIELD, VIRGINIA 22152
PH: (703) 913-7888
FAX: (703) 913-7889
WEB: WWW.NEELCO.COM

PROJECT # TW4301

CERTIFIED WITH RESPECT TO INTERNAL STABILITY OF T-WALL@ STRUCTURES ONLY

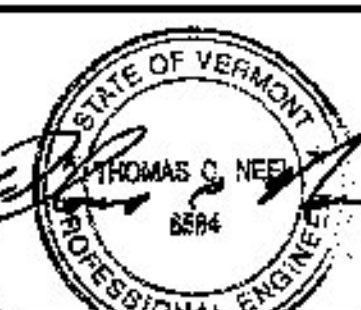

REVISIONS

Table with 3 columns: Description, Date, and Initials. It is currently empty.

RIGIDIFIED TUBE FRP ARCH (RTFA) PROJECT

FAIRFIELD, VT

SHOP DRAWINGS NOTES

T-WALL@ RETAINING WALL SYSTEM

SCALE: NO SCALE


DATE: 4/21/14

DESIGNED BY: KD

DRAWN BY: ABC

CHECKED BY: CCG

SHEET: 3

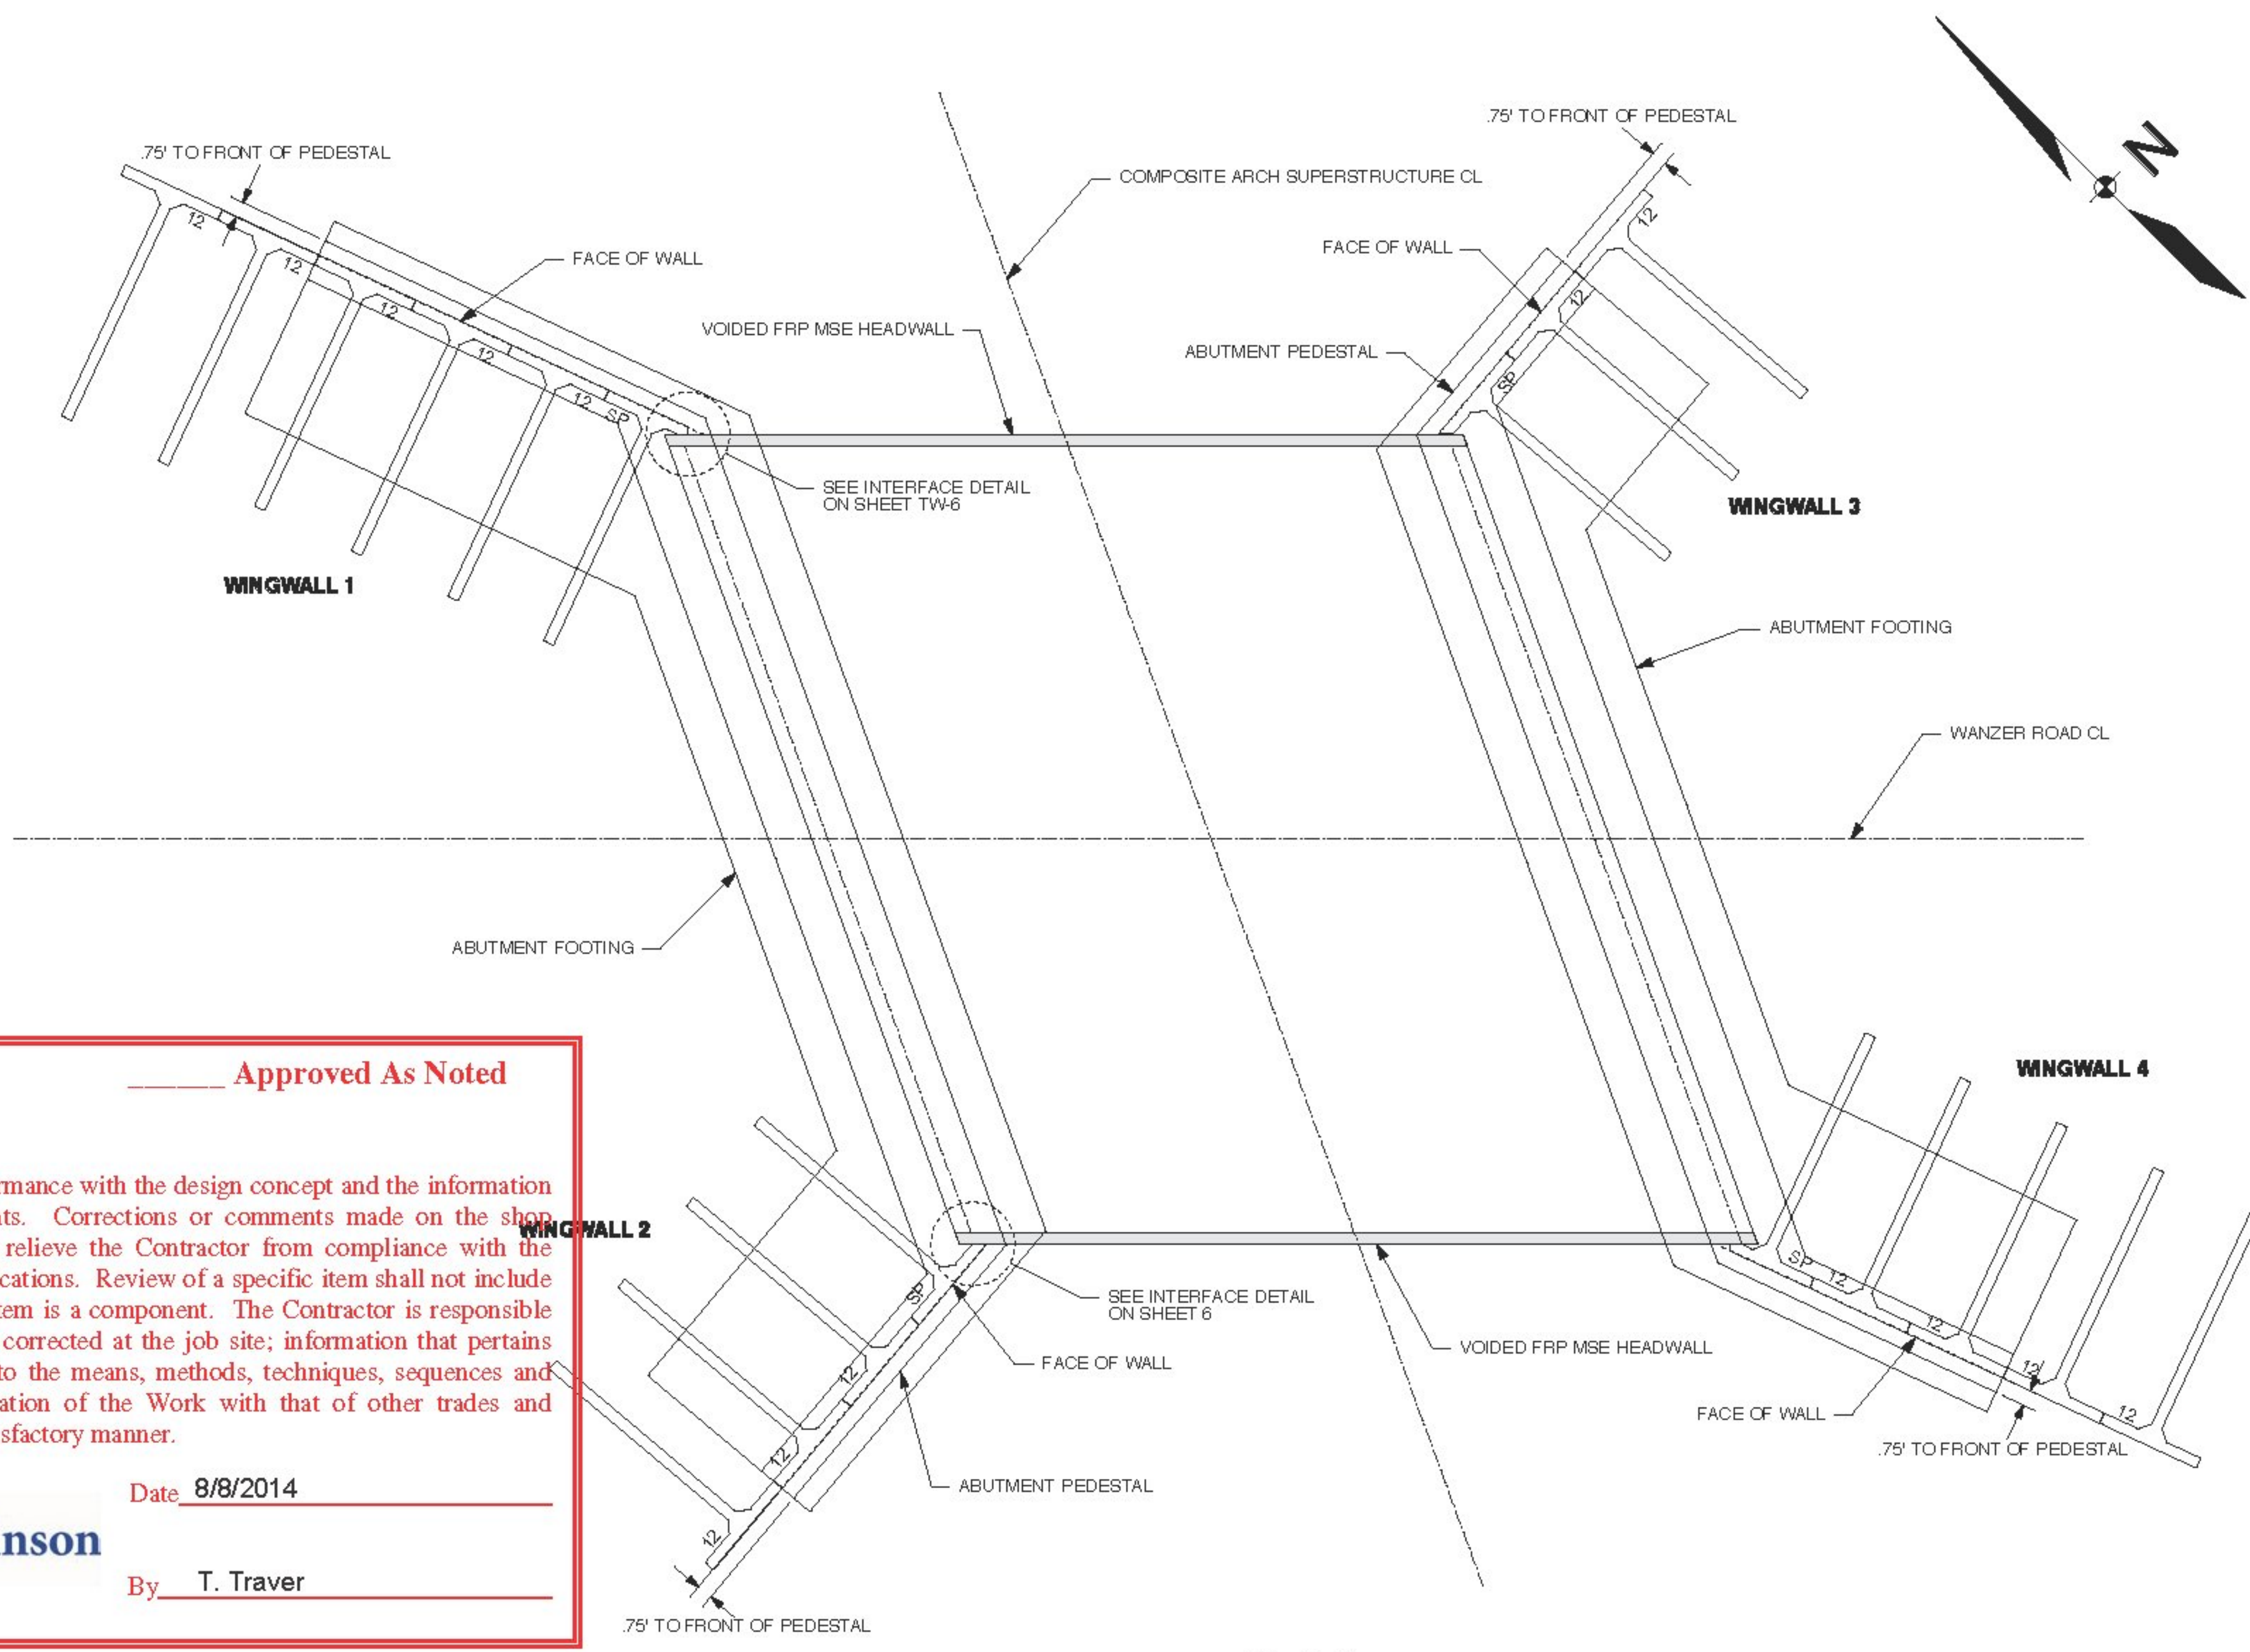

Approved
 Rejected

Approved As Noted

This review is only for general conformance with the design concept and the information given in the Construction Documents. Corrections or comments made on the shop drawings during the review do not relieve the Contractor from compliance with the requirements of the Plans and Specifications. Review of a specific item shall not include review of an assembly of which an item is a component. The Contractor is responsible for dimensions to be confirmed and corrected at the job site; information that pertains solely to the fabrication process or to the means, methods, techniques, sequences and procedures of construction; coordination of the Work with that of other trades and performing all Work in a safe and satisfactory manner.

Date 8/8/2014

By T. Traver



1 PLAN
1" = 5 ft



The design contained on these drawings is based upon information provided by the owner. On the basis of this information, The Neel Company has designed, and is responsible for, the internal stability of the structure only. External stability, including foundation and slope stability, is the responsibility of the owner.

This drawing contains information proprietary to The Neel Company. T-WALL® is a registered trademark owned by The Neel Company. ©2014 The Neel Company


PRECASTER: CONCRETE SYSTEMS, INC. CSI
PROJECT #: T21882

CONTRACTOR: AL. ST. ONGE CONTRACTORS
PROJECT #:

DESIGNER

THE NEEL COMPANY
 8328-D TRAFORD LANE
 SPRINGFIELD, VIRGINIA 22152
 PH: (703) 913-7858
 FX: (703) 913-7859
 WEB: WWW.NEELCO.COM

PROJECT #: TW4301

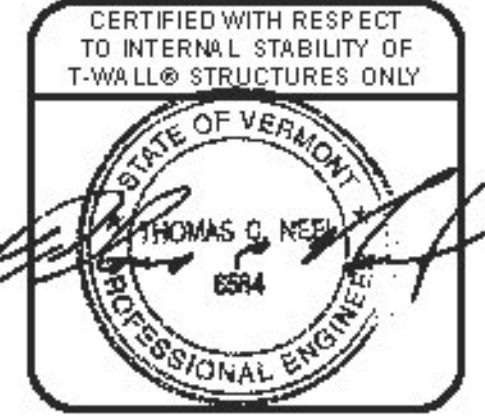

REVISIONS	

RIGIDIFIED TUBE FRP ARCH (RTFA) PROJECT


FAIRFIELD, VT

SHOP DRAWINGS
 WALL DRAWINGS
 PLAN VIEW

T-WALL® RETAINING WALL SYSTEM


SCALE:	AS NOTED
DATE:	4/21/14
DESIGNED BY:	KD
DRAWN BY:	ABC
CHECKED BY:	CCG
SHEET:	4

BORDER-TWC T-WALL HWY V4.1

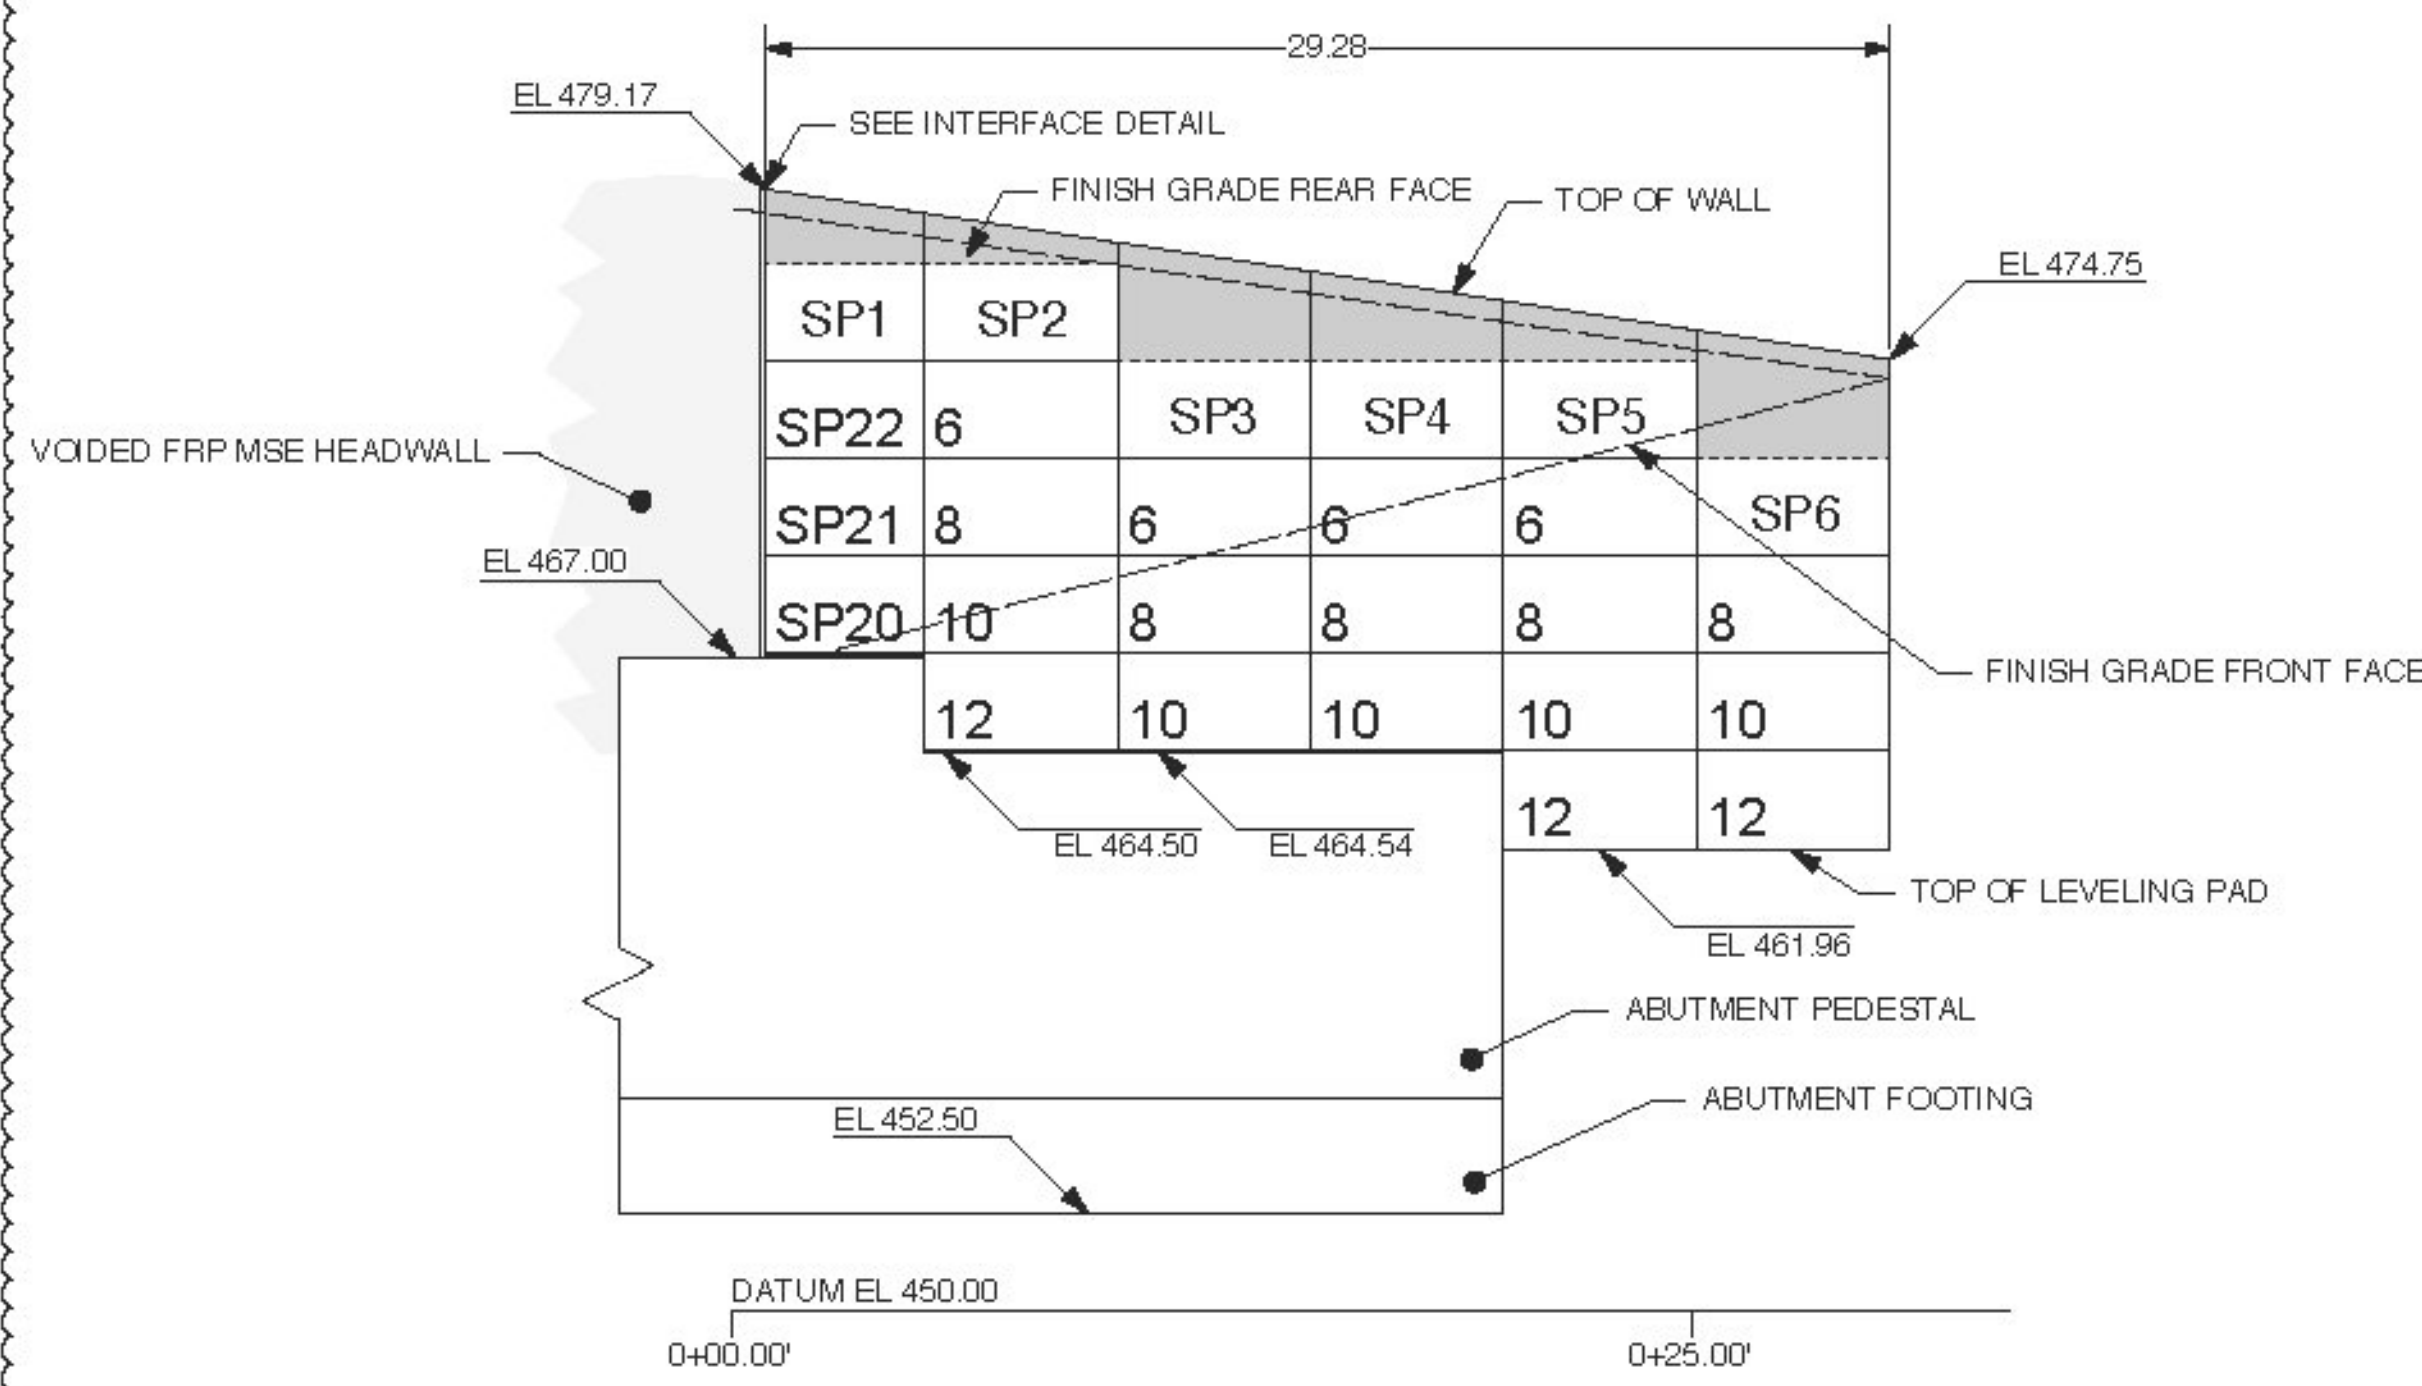


1 WINGWALL 1 DEVELOPED ELEVATION (FRONT FACE)
1" = 5 ft

NOTE: SEE ELEVATION DETAIL ON NEXT SHEET

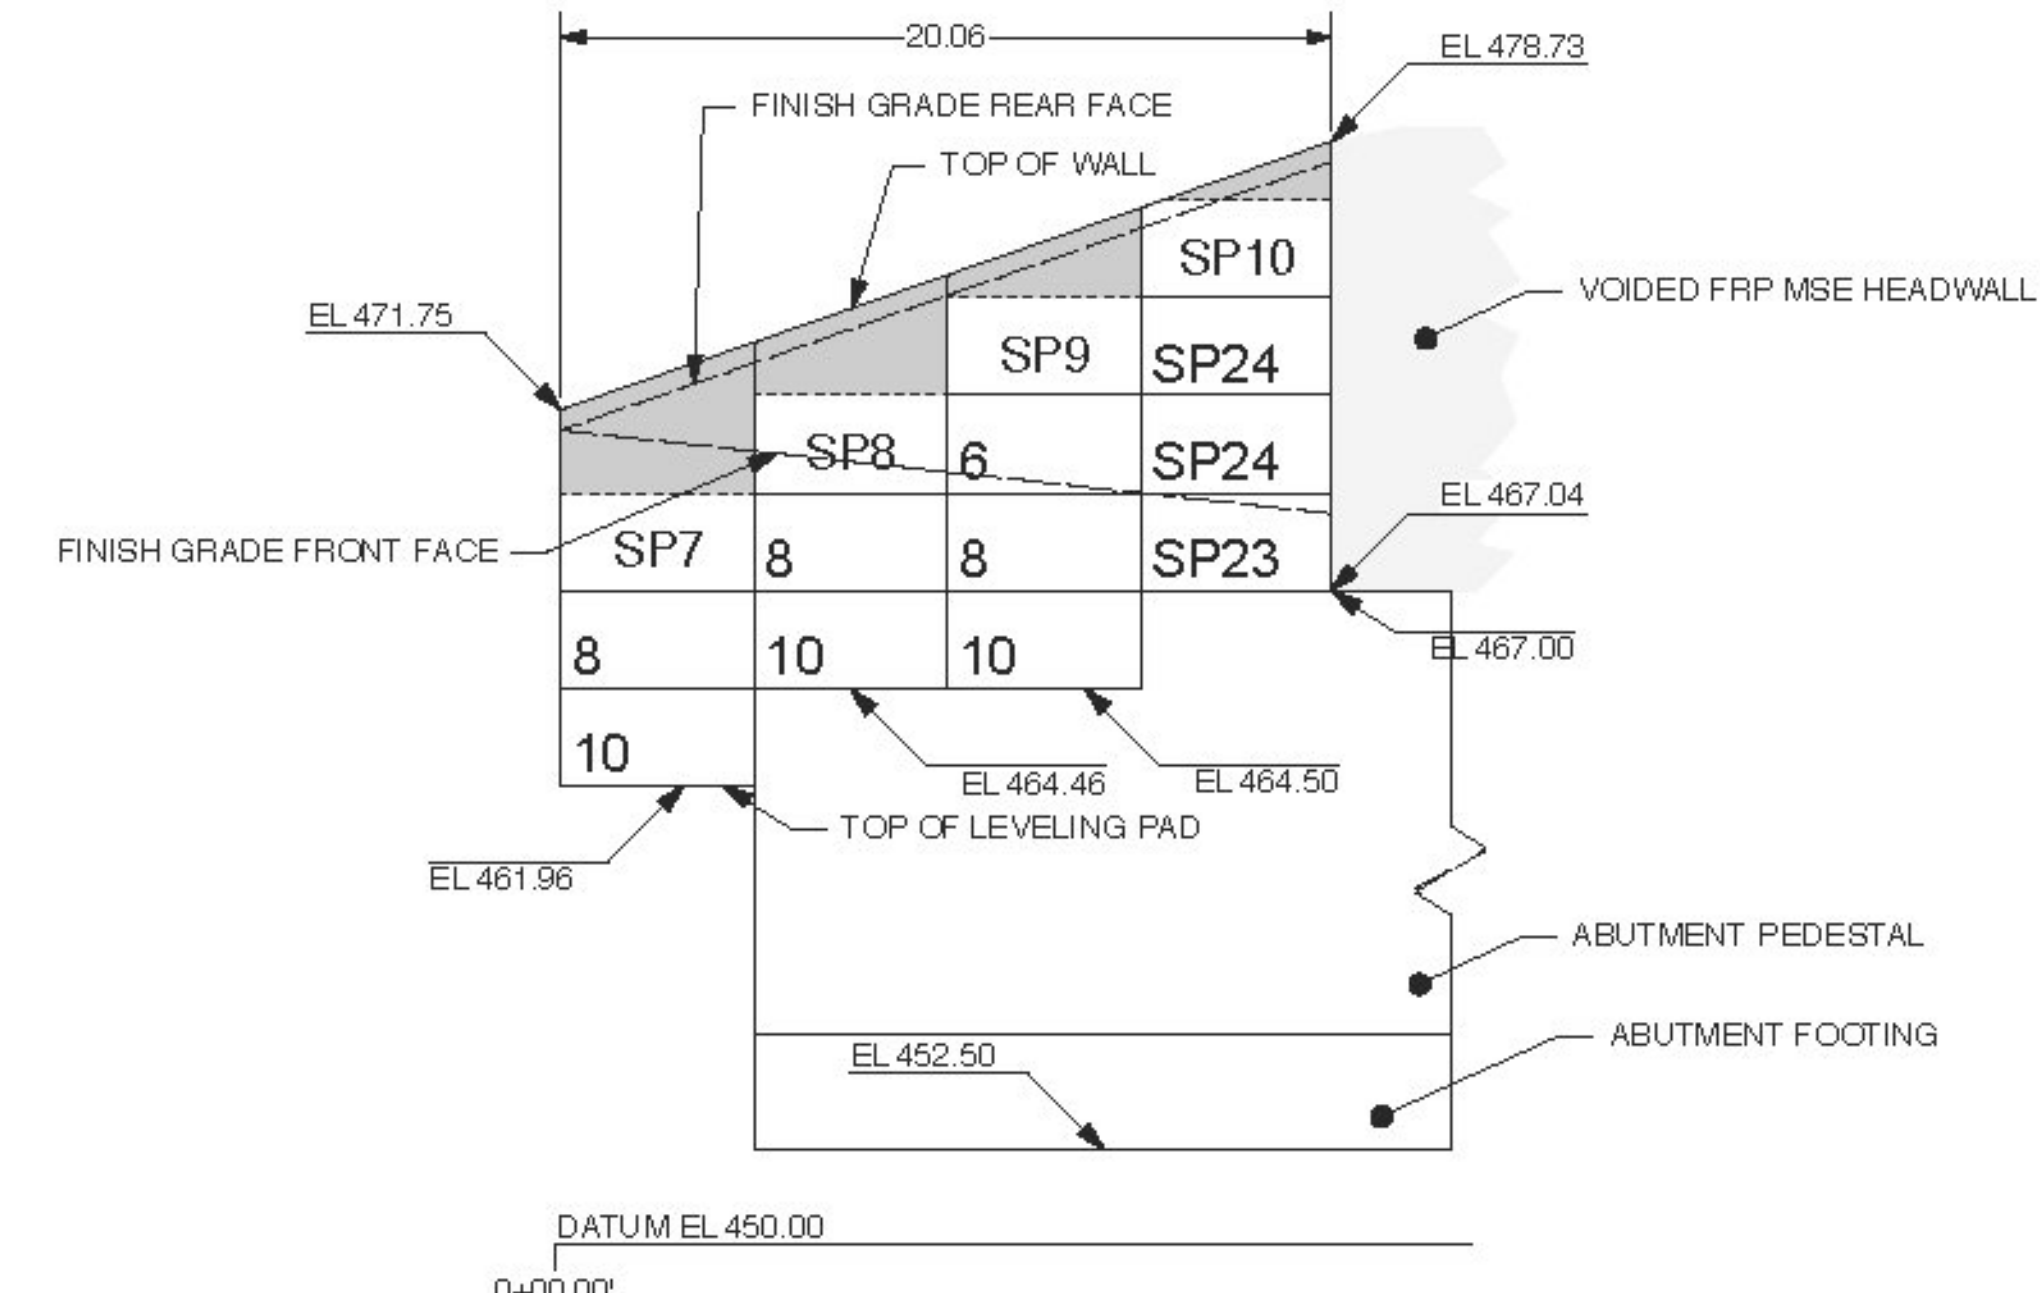


2 WINGWALL 2 DEVELOPED ELEVATION (FRONT FACE)
1" = 5 ft

NOTE: SEE ELEVATION DETAIL ON NEXT SHEET

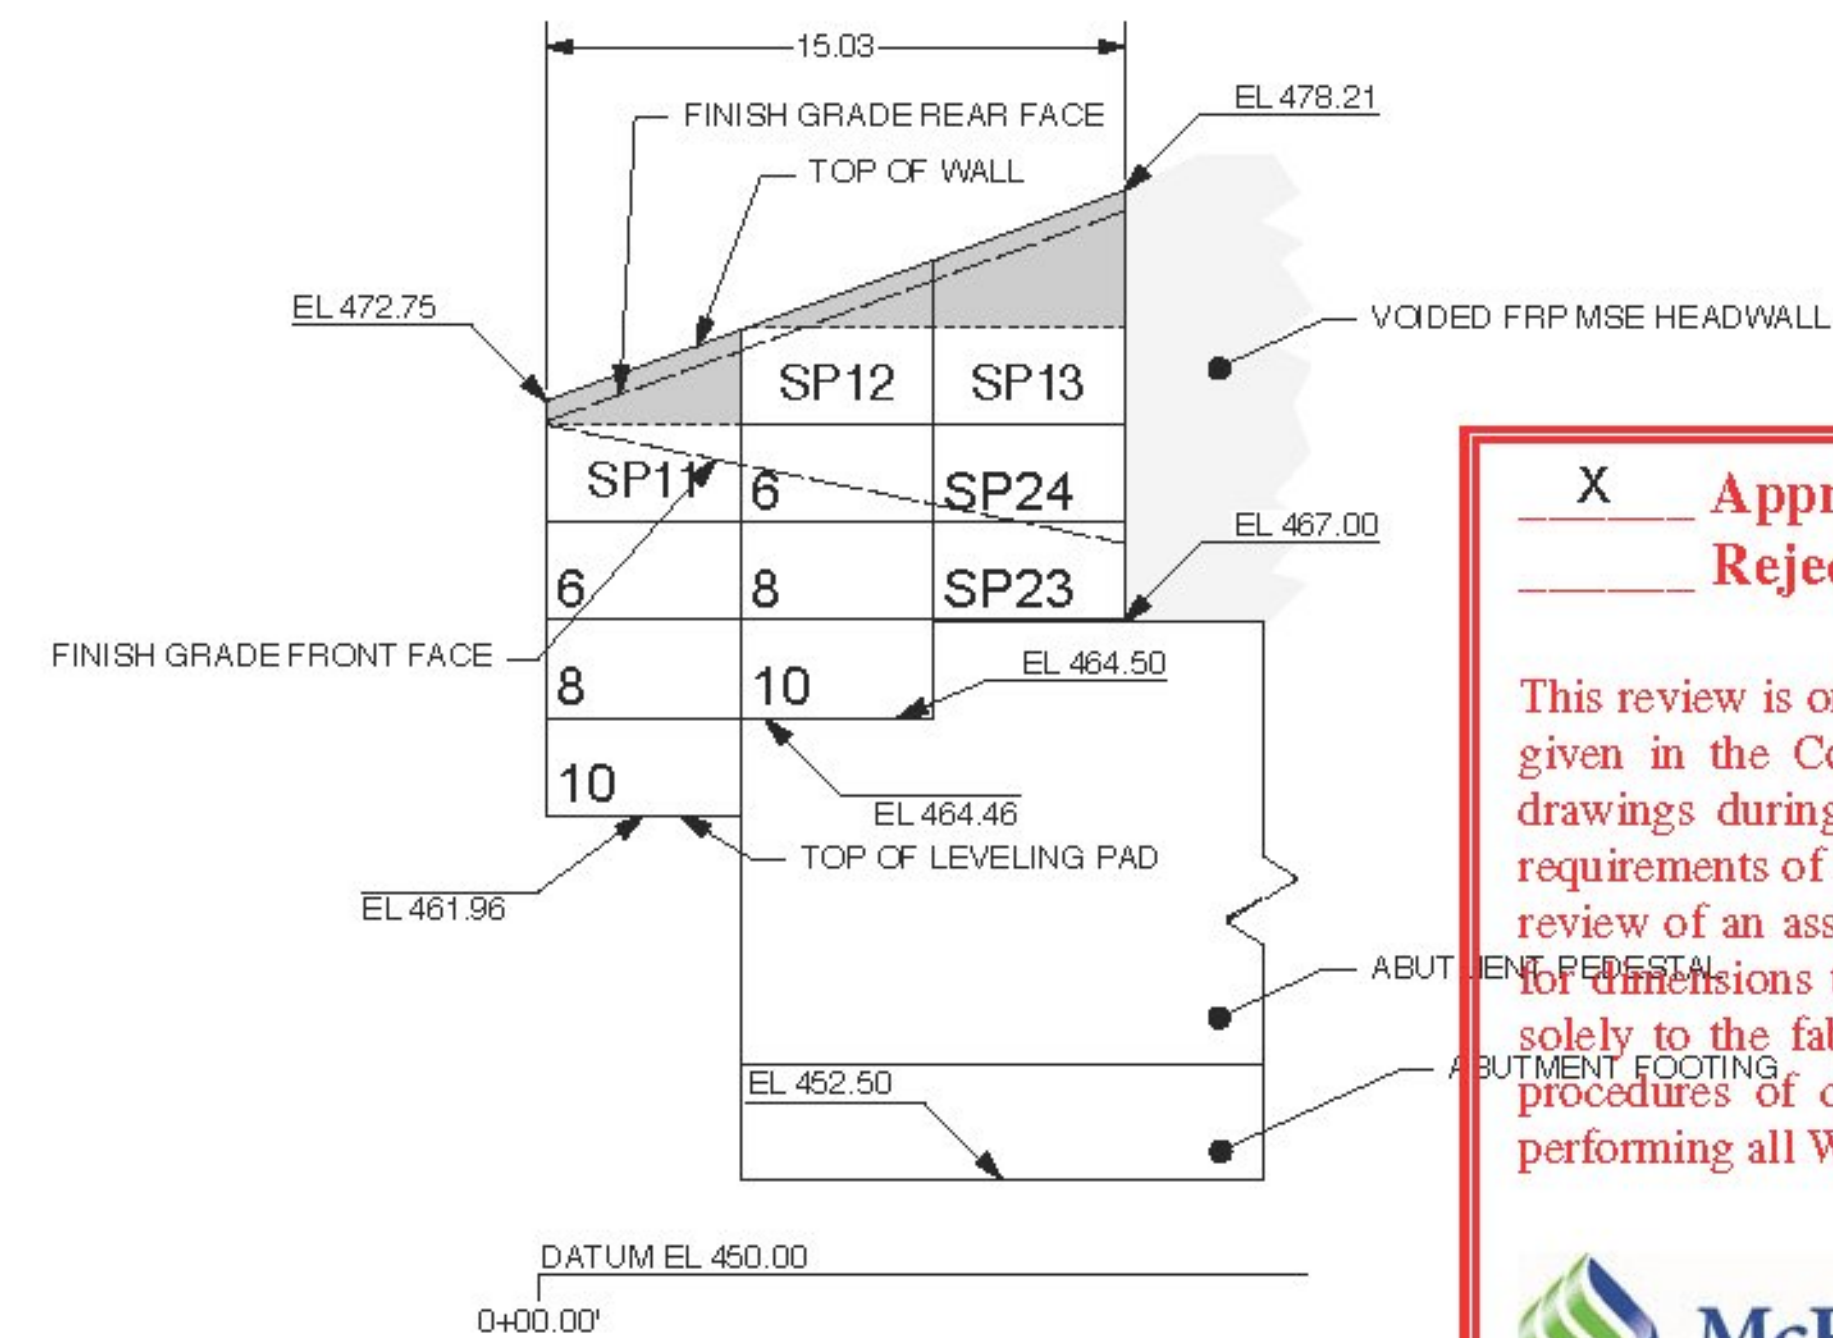

3 WINGWALL 3 DEVELOPED ELEVATION (FRONT FACE)
1" = 5 ft

NOTE: SEE ELEVATION DETAIL ON NEXT SHEET

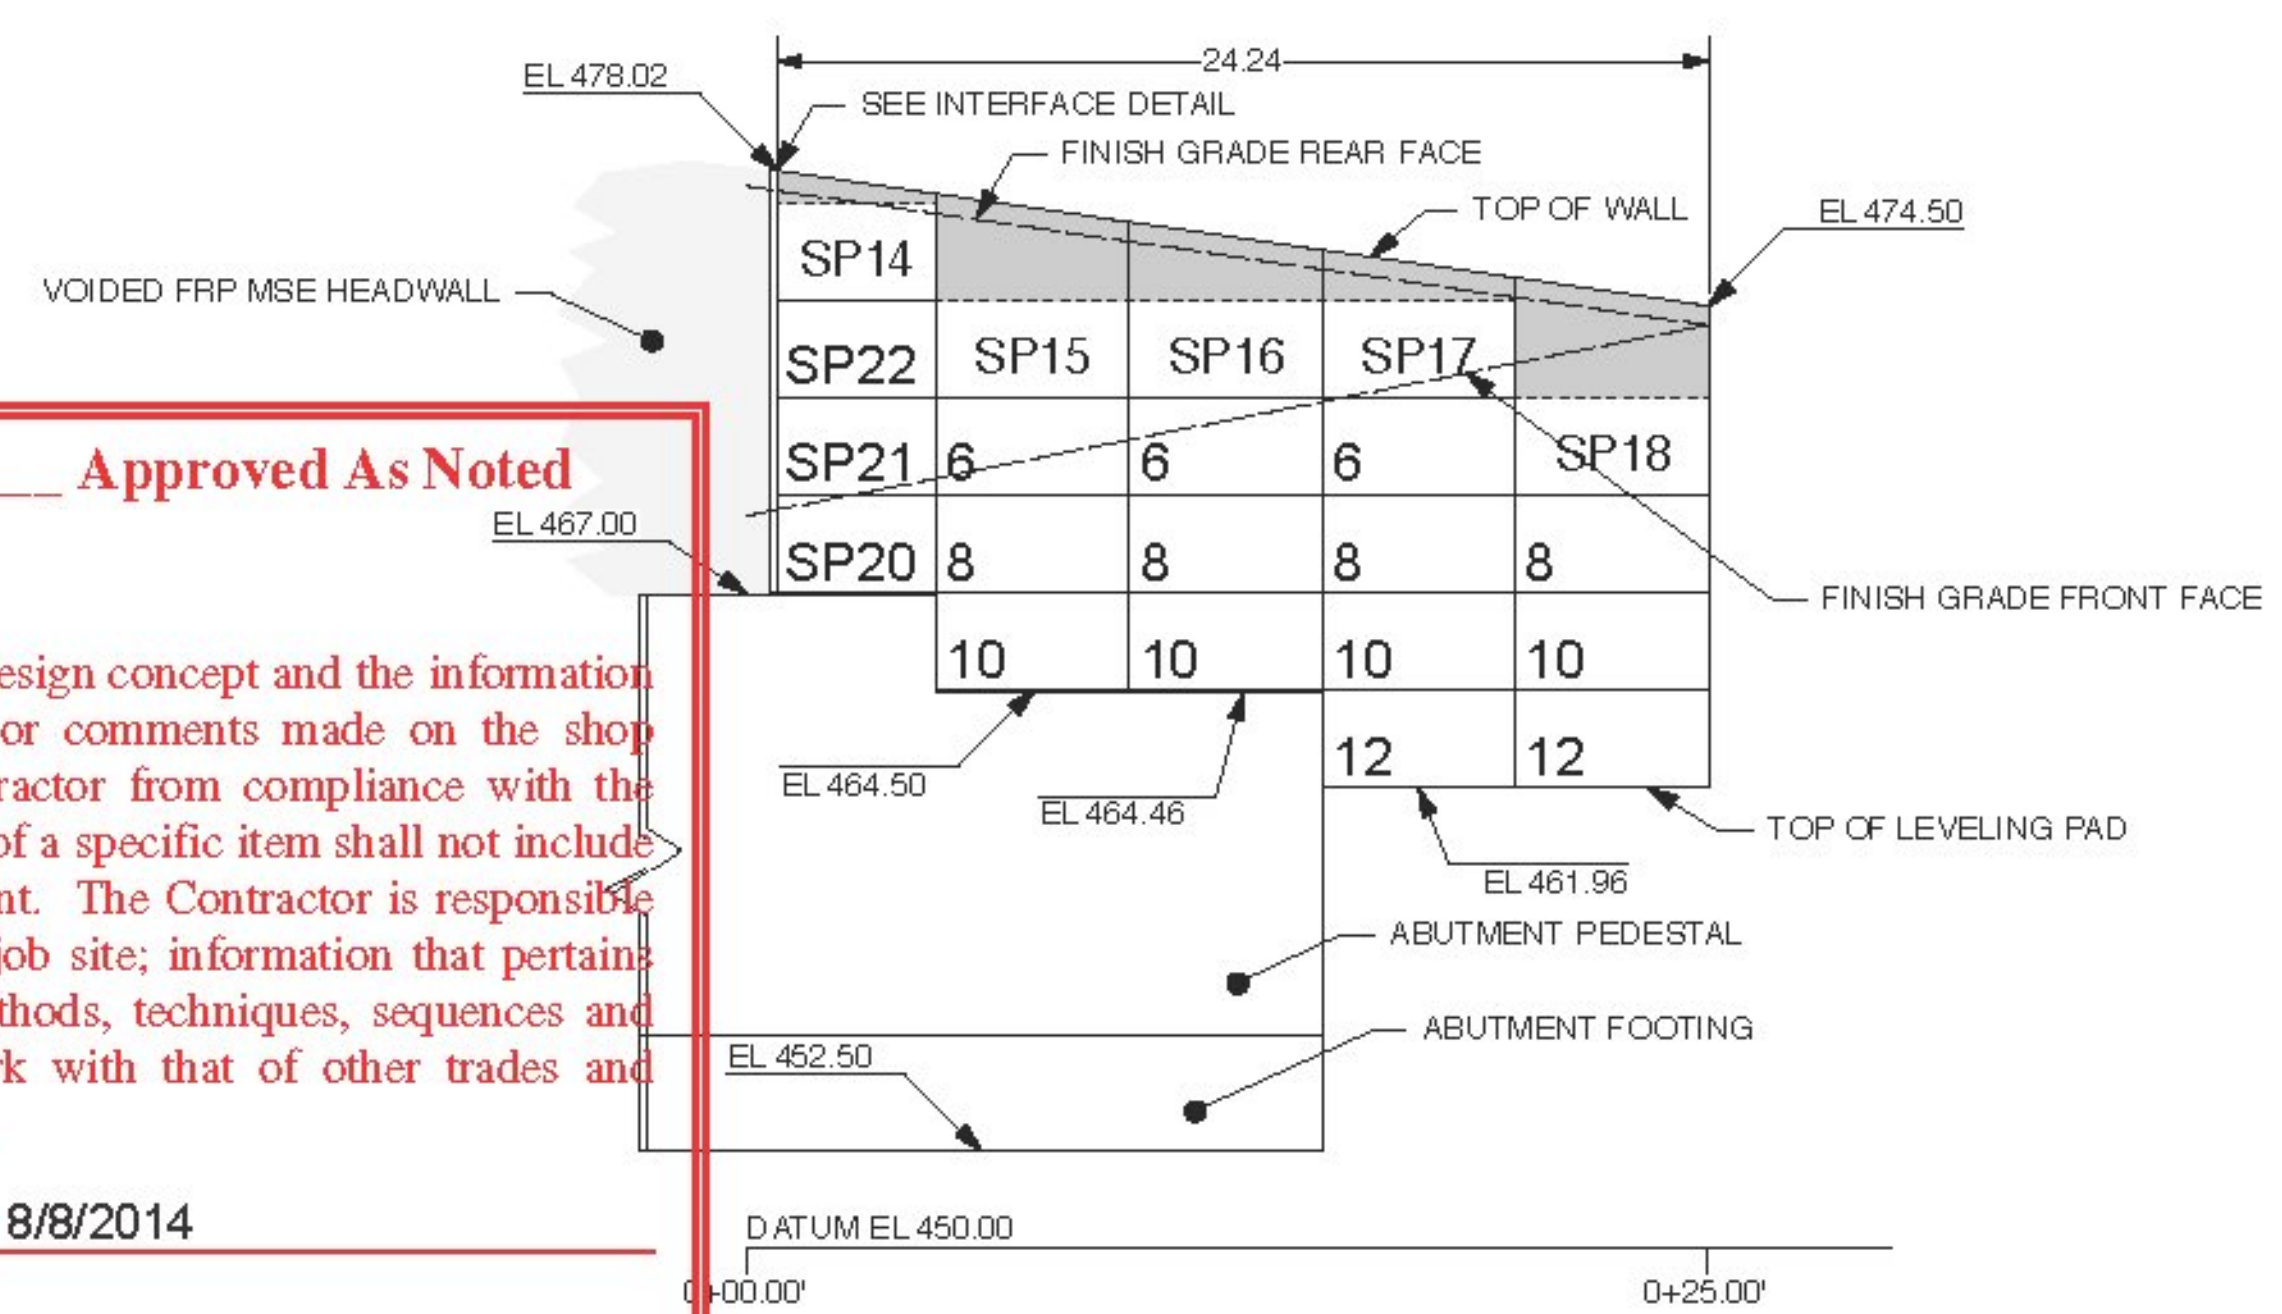

4 WINGWALL 4 DEVELOPED ELEVATION (FRONT FACE)
1" = 5 ft

NOTE: SEE ELEVATION DETAIL ON NEXT SHEET

Approved
 Rejected
 Approved As Noted

This review is only for general conformance with the design concept and the information given in the Construction Documents. Corrections or comments made on the shop drawings during the review do not relieve the Contractor from compliance with the requirements of the Plans and Specifications. Review of a specific item shall not include review of an assembly of which an item is a component. The Contractor is responsible for dimensions to be confirmed and corrected at the job site; information that pertains solely to the fabrication process or to the means, methods, techniques, sequences and procedures of construction; coordination of the Work with that of other trades and performing all Work in a safe and satisfactory manner.

Date 8/8/2014
 By T. Traver

McFarland Johnson



USER NAME: N/A
VECTORWORKS 2011
PLOT DATE & TIME: Wednesday, August 6, 2014 11:24:57 AM
CAD FILE NAME: 04 Walls.VWX
VW SHEET NAME: Sheets

The design contained on these drawings is based upon information provided by the owner. On the basis of this information, The Neel Company has designed, and is responsible for, the internal stability of the structure only. External stability, including foundation and slope stability, is the responsibility of the owner.


This drawing contains information proprietary to The Neel Company. T-WALL® is a registered trademark owned by The Neel Company. ©2014 The Neel Company

PRECASTER: CONCRETE SYSTEMS, INC. CSI
 PROJECT #: T21882

CONTRACTOR: AL. ST. ONGE CONTRACTORS
 PROJECT #:

DESIGNER
THE NEEL COMPANY
 8328-D TRAFORD LANE
 SPRINGFIELD, VIRGINIA 22152
 PH: (703) 913-7858
 FX: (703) 913-7859
 WEB: WWW.NEELCO.COM

PROJECT # TW4301

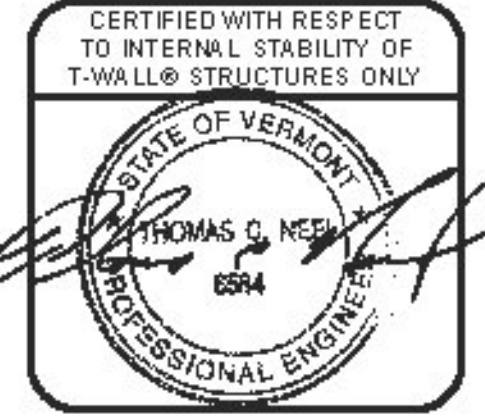


REVISIONS		
1	REVIEWER COMMENTS	
		ABC 8-6-14

RIGIDIFIED TUBE FRP ARCH (RTFA) PROJECT

FAIRFIELD, VT

SHOP DRAWINGS
 WALL DRAWINGS
 DEVELOPED ELEVATIONS
 T-WALL® RETAINING WALL SYSTEM

SCALE:	AS NOTED
DATE:	4/21/14
DESIGNED BY:	KD
DRAWN BY:	ABC
CHECKED BY:	CCG
SHEET:	5

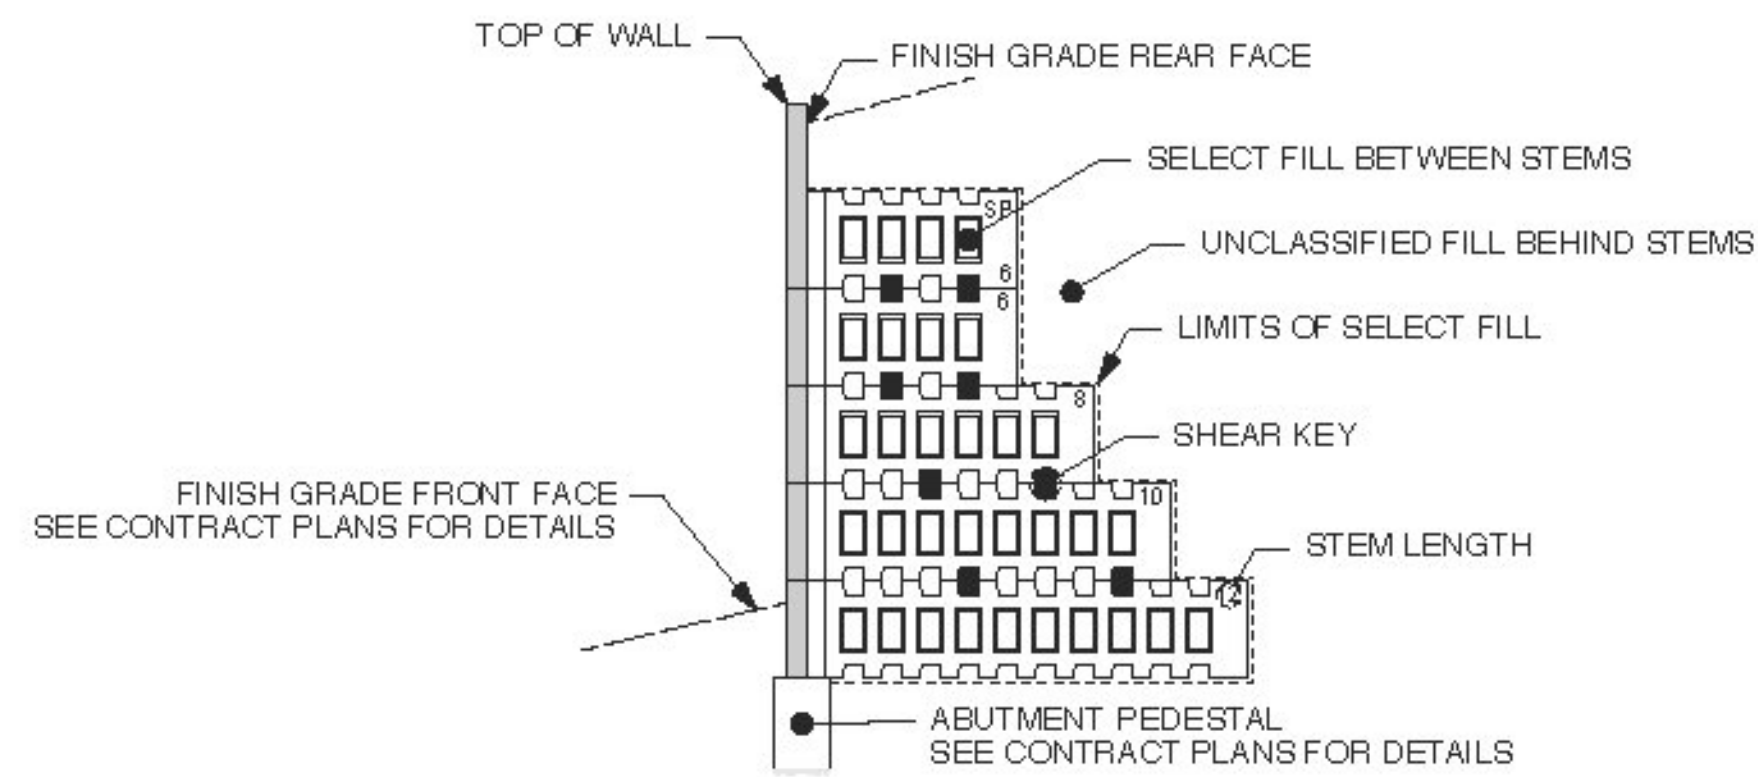

1 TYPICAL SECTION AT MAXIMUM HEIGHT
1" = 5 ft

T-WALL Unit Count for Wingwall 1 8/8/14 10:55:48 AM

PANEL TYPE	QNTY (ea)	AREA (sqD)	SELECT FILL (cy)
2.5 x 5.0 x 06 Std	4	50.00	9
2.5 x 5.0 x 08 Std	5	62.50	16
2.5 x 5.0 x 10 Std	5	62.50	20
2.5 x 5.0 x 12 Std	3	37.50	15
Special Units	9	160.70	21
TOTALS:	26 ea	373.20 sqD	82 cy

NOTE: Select backfill quantities are between stems only.

T-WALL Unit Count for Wingwall 3 8/8/14 10:58:28 AM

PANEL TYPE	QNTY (ea)	AREA (sqD)	SELECT FILL (cy)
2.5 x 5.0 x 06 Std	2	25.00	5
2.5 x 5.0 x 08 Std	2	25.00	6
2.5 x 5.0 x 10 Std	2	25.00	8
Special Units	5	87.49	12
TOTALS:	11 ea	162.49 sqD	31 cy

NOTE: Select backfill quantities are between stems only.

T-WALL Unit Count for Wingwall 2 8/8/14 10:56:14 AM

PANEL TYPE	QNTY (ea)	AREA (sqD)	SELECT FILL (cy)
2.5 x 5.0 x 06 Std	1	12.50	2
2.5 x 5.0 x 08 Std	3	37.50	10
2.5 x 5.0 x 10 Std	3	37.50	12
Special Units	7	124.78	17
TOTALS:	14 ea	212.28 sqD	41 cy

NOTE: Select backfill quantities are between stems only.


T-WALL Unit Count for Wingwall 4 8/8/14 11:17:17 AM

PANEL TYPE	QNTY (ea)	AREA (sqD)	SELECT FILL (cy)
2.5 x 5.0 x 06 Std	3	37.50	7
2.5 x 5.0 x 08 Std	4	50.00	13
2.5 x 5.0 x 10 Std	4	50.00	16
2.5 x 5.0 x 12 Std	2	25.00	10
Special Units	8	133.45	19
TOTALS:	21 ea	295.95 sqD	66 cy

NOTE: Select backfill quantities are between stems only.


SHOP LOOSE LIST FOR WINGWALLS

ITEM	QNTY
T-Wall Lifting Device	1 ea
Shear Keys	108 ea
M/trafil 160N Filter Fabric (12" wide)	287 lf
1/2" x 4" x 5' Horizontal Joint Material	295 lf

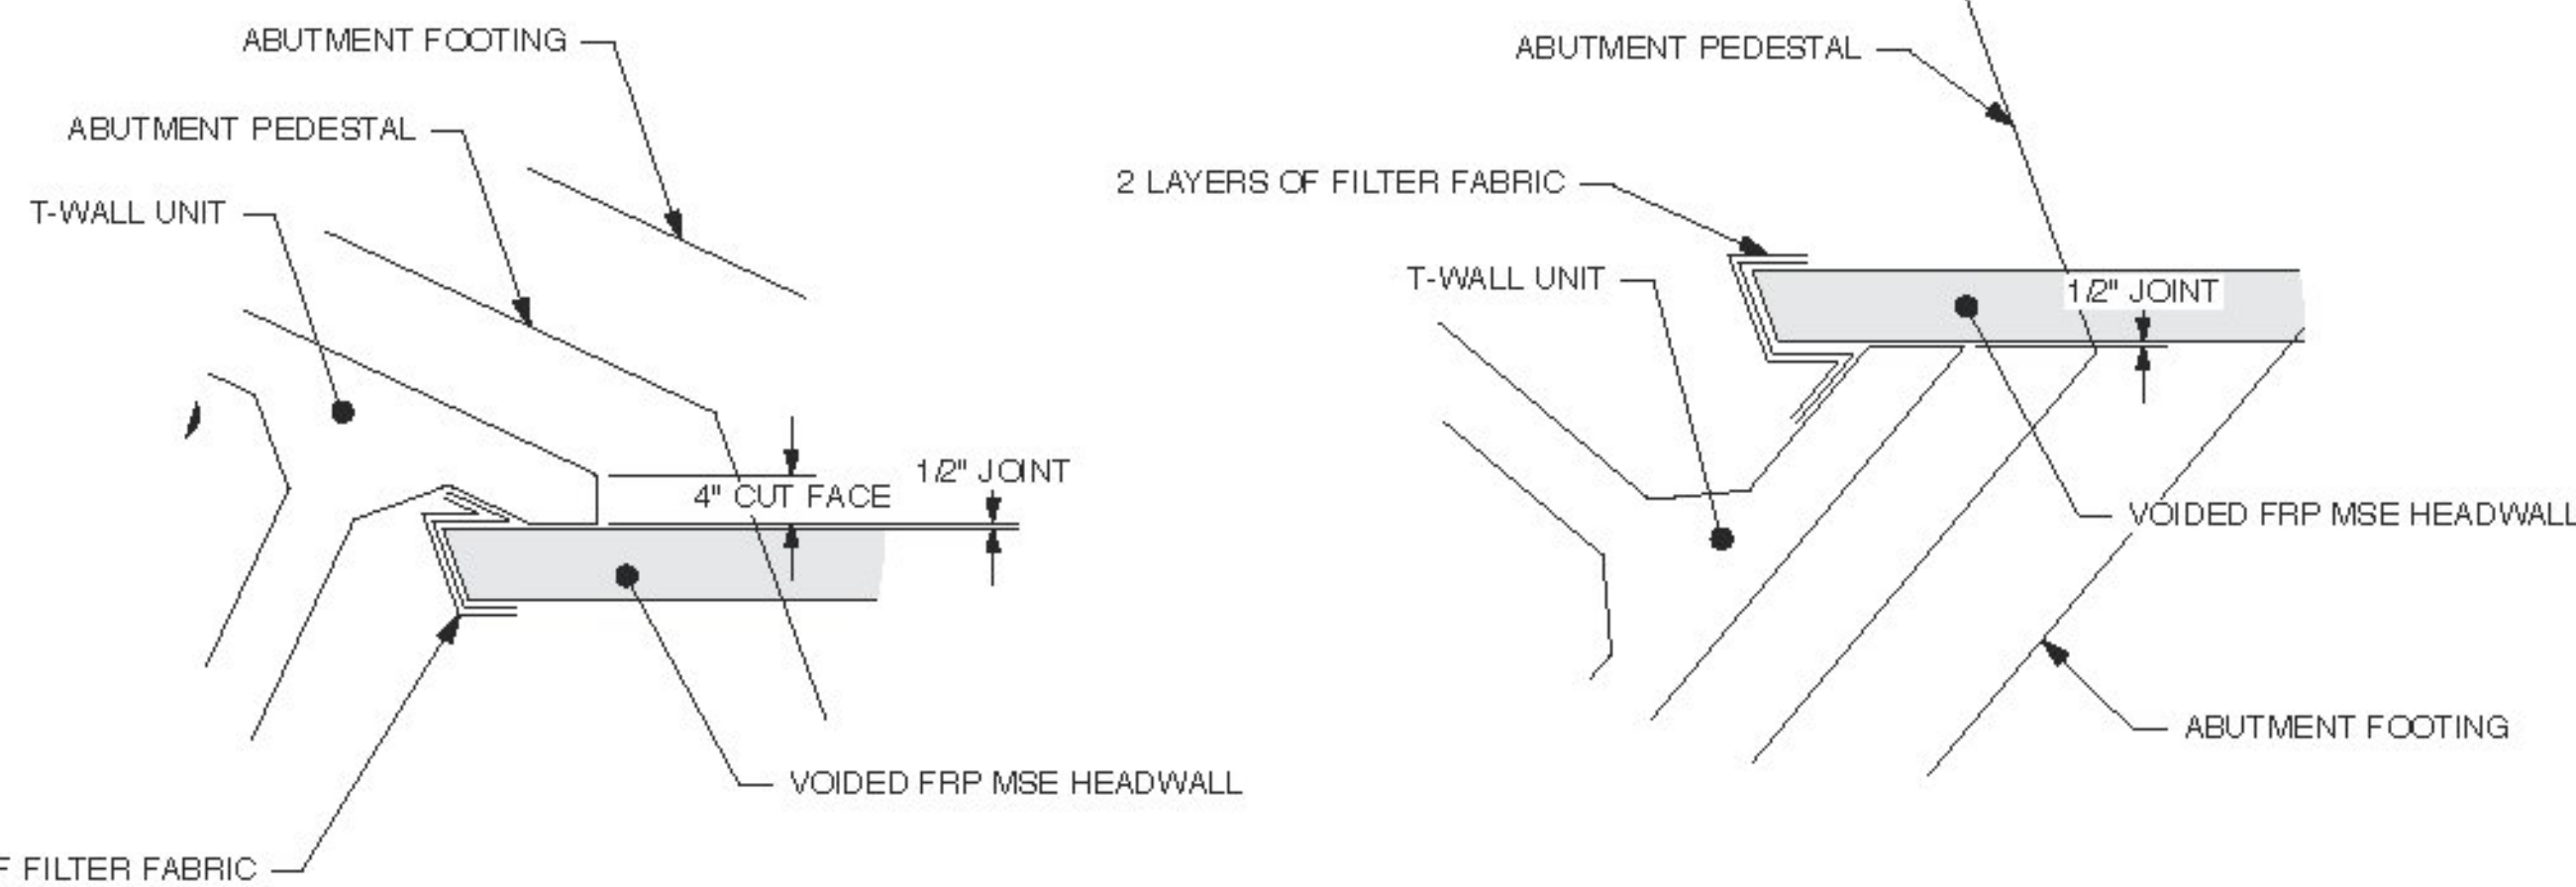

2 WINGWALLS 1 & 4 INTERFACE DETAIL
Scale: 3/4" = 1'-0"

3 WINGWALLS 2 & 3 INTERFACE DETAIL
Scale: 3/4" = 1'-0"

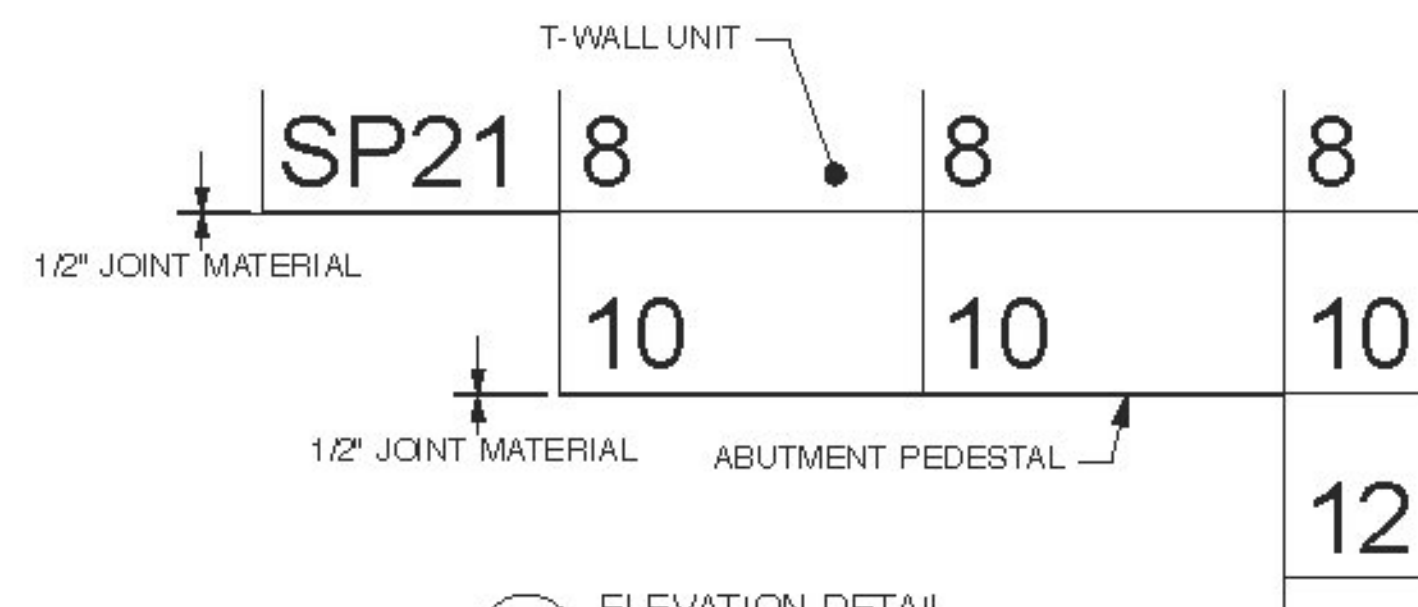

4 ELEVATION DETAIL
Scale: 3/8" = 1'-0"

NOTE: CONTRACTOR TO CONFIRM REVISED PEDESTAL ELEVATIONS FOR 2" 1/2" SPACING.



USER NAME: N/A
 VECTORWORKS 2011
 PLOT DATE & TIME: Wednesday, August 6, 2014 11:24:57 AM
 CAD FILE NAME: 04 Walls.VMX
 VV SHEET NAME: Sheets

The design contained on these drawings is based upon information provided by the owner. On the basis of this information, The Neel Company has designed, and is responsible for, the internal stability of the structure only. External stability, including foundation and slope stability, is the responsibility of the owner.

This drawing contains information proprietary to The Neel Company. T-WALL® is a registered trademark owned by The Neel Company. ©2014 The Neel Company


PRECASTER: CONCRETE SYSTEMS, INC. CSI
PROJECT #: T21882

CONTRACTOR: AL. ST. ONGE CONTRACTORS
PROJECT #:

DESIGNER

THE NEEL COMPANY
 8328-D TRAFORD LANE
 SPRINGFIELD, VIRGINIA 22152
 PH: (703) 913-7858
 FX: (703) 913-7859
 WEB: WWW.NEELCO.COM

PROJECT #: TW4301

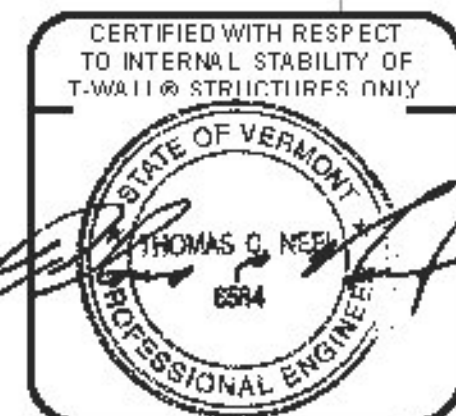

REVISIONS

NO.	REVIEWER COMMENTS	DATE
1	REVIEWER COMMENTS	ABC 8-6-14

RIGIDIFIED TUBE FRP ARCH (RTFA) PROJECT

FAIRFIELD, VT

SHOP DRAWINGS
 WALL DRAWINGS
 SECTION, DETAILS & QUANTITIES
 T-WALL® RETAINING WALL SYSTEM

SCALE:	AS NOTED
DATE:	4/21/14
DESIGNED BY:	KD
DRAWN BY:	ABC
CHECKED BY:	CCG
SHEET:	6

Approved
 Rejected

Approved As Noted

This review is only for general conformance with the design concept and the information given in the Construction Documents. Corrections or comments made on the shop drawings during the review do not relieve the Contractor from compliance with the requirements of the Plans and Specifications. Review of a specific item shall not include review of an assembly of which an item is a component. The Contractor is responsible for dimensions to be confirmed and corrected at the job site; information that pertains solely to the fabrication process or to the means, methods, techniques, sequences and procedures of construction; coordination of the Work with that of other trades and performing all Work in a safe and satisfactory manner.

Date: 8/8/2014
 By: T. Traver

Mcfarland Johnson

T-WALL UNIT PROPERTIES

UNIT TYPE	H	W	S	Tf*	Ts	SH	VOLUME*	WEIGHT*
2.5x5.0x06 Std	2'6"	5'0"	6'4 1/2"	6"	6"	2'6"	0.45 cy	1,827 lbs
2.5x5.0x08 Std	2'6"	5'0"	8'4 1/2"	6"	6"	2'6"	0.52 cy	2,088 lbs
2.5x5.0x10 Std	2'6"	5'0"	10'4 1/2"	6"	6"	2'6"	0.58 cy	2,349 lbs
2.5x5.0x12 Std	2'6"	5'0"	12'4 1/2"	6"	6"	2'6"	0.64 cy	2,610 lbs

*VOLUMES AND WEIGHTS ON THIS TABLE ARE BASED ON 6" FACE THICKNESS (Tf)


REBAR SCHEDULES

Unit Dims	Bar Mark	Qty	Size	Length	Dim "A"	Bar Weight	Bend Dia	Remarks	
H=2'6"	H-1	3 ea	#4	4'8"		9.35 lbs			
W=5'0"	V-1	12 ea	#4	2'2"		17.37 lbs			
S=6'4 1/2"	V-2	6 ea	#4	2'2"		8.68 lbs			
SH=2'6"	S-1	4 ea	#4	3'4 1/2"		9.02 lbs	D= 3"		
	TB-1	4 ea	#4	8'2"	5'11"	21.81 lbs	D= 3"		
						66.23 lbs			


Unit Dims	Bar Mark	Qty	Size	Length	Dim "A"	Bar Weight	Bend Dia	Remarks	
H=2'6"	H-1	3 ea	#4	4'8"		9.35 lbs			
W=5'0"	V-1	16 ea	#4	2'2"		23.16 lbs			
S=8'4 1/2"	V-2	6 ea	#4	2'2"		8.68 lbs			
SH=2'6"	S-1	4 ea	#4	3'4 1/2"		9.02 lbs	D= 3"		
	TB-1	4 ea	#4	10'2"	7'11"	27.16 lbs	D= 3"		
						77.37 lbs			

Unit Dims	Bar Mark	Qty	Size	Length	Dim "A"	Bar Weight	Bend Dia	Remarks	
H=2'6"	H-1	3 ea	#4	4'8"		9.35 lbs			
W=5'0"	V-1	20 ea	#4	2'2"		16.29 lbs			
S=10'4 1/2"	V-2	6 ea	#4	2'2"		4.89 lbs			
SH=2'6"	S-1	4 ea	#4	3'4 1/2"		5.08 lbs	D= 2 1/4"		
	TB-1	4 ea	#4	12'2"	9'11"	32.50 lbs	D= 3"		
						68.11 lbs			


Unit Dims	Bar Mark	Qty	Size	Length	Dim "A"	Bar Weight	Bend Dia	Remarks	
H=2'6"	H-1	3 ea	#4	4'8"		9.35 lbs			
W=5'0"	V-1	20 ea	#4	2'2"		16.29 lbs			
S=12'4 1/2"	V-2	6 ea	#4	2'2"		4.89 lbs			
SH=2'6"	S-1	4 ea	#4	3'4 1/2"		5.08 lbs	D= 2 1/4"		
	TB-1	4 ea	#4	12'2"	9'11"	32.50 lbs	D= 3"		
						68.11 lbs			

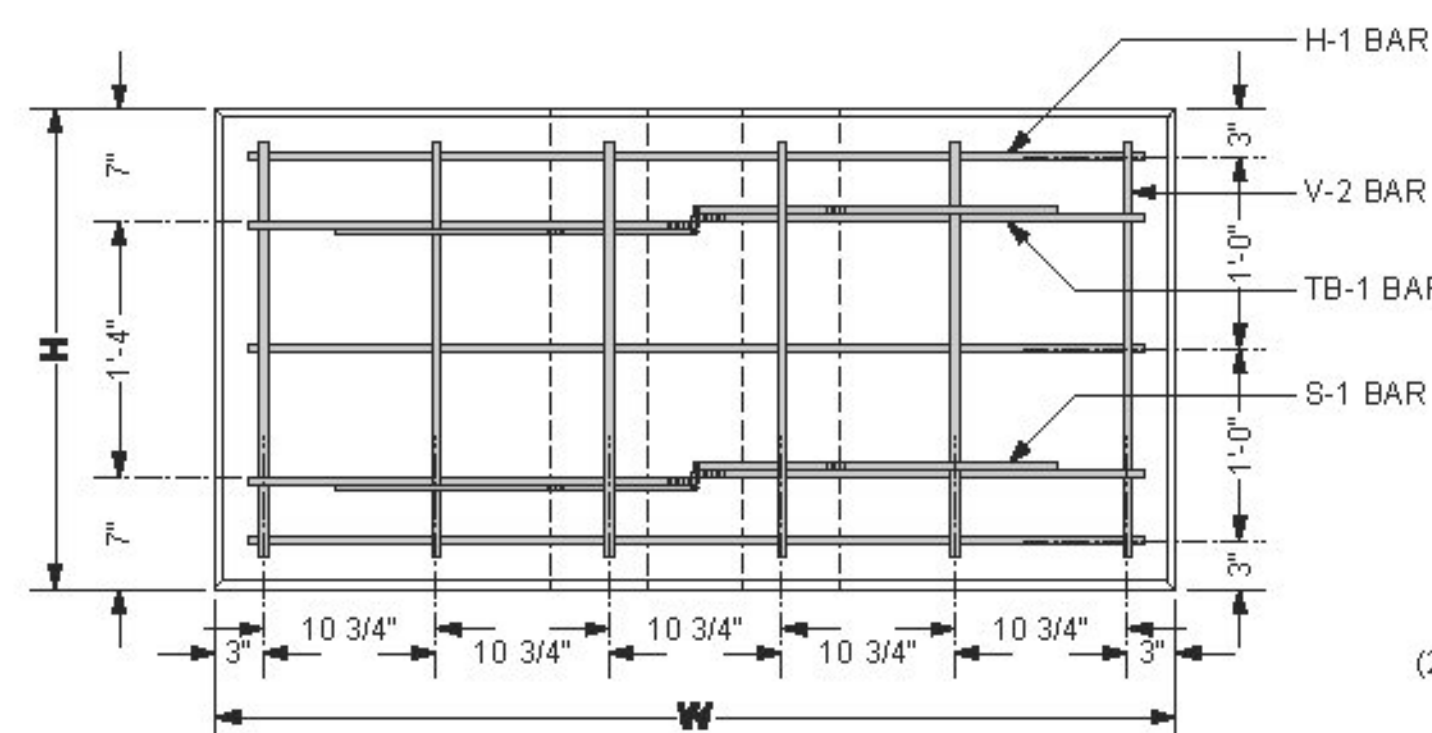

3 FRONT VIEW - 2.5 x 5.0 x 06 Std SHOWN
Scale: 1" = 1'-0"

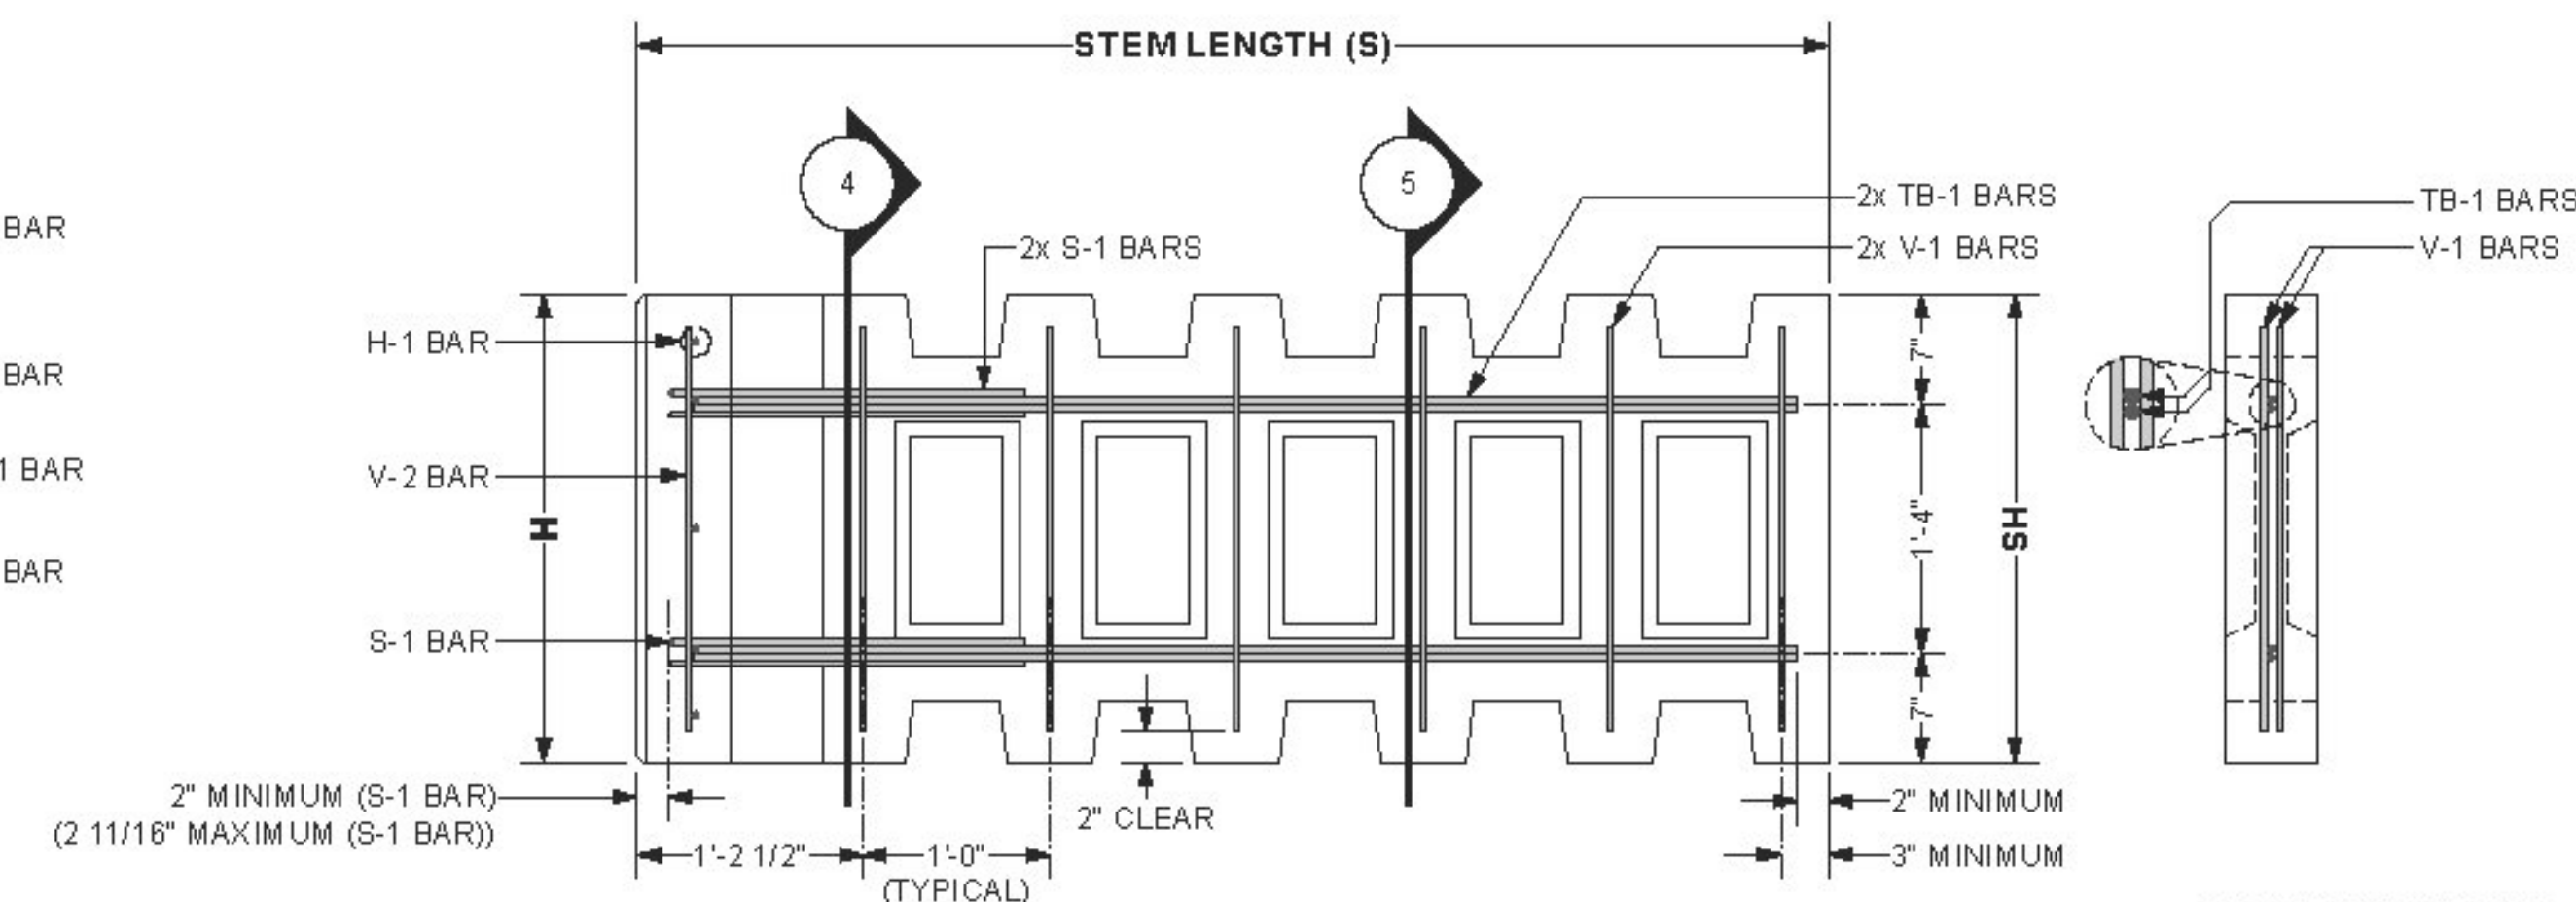

2 SIDE VIEW - 2.5 x 5.0 x 06 Std SHOWN
Scale: 1" = 1'-0"

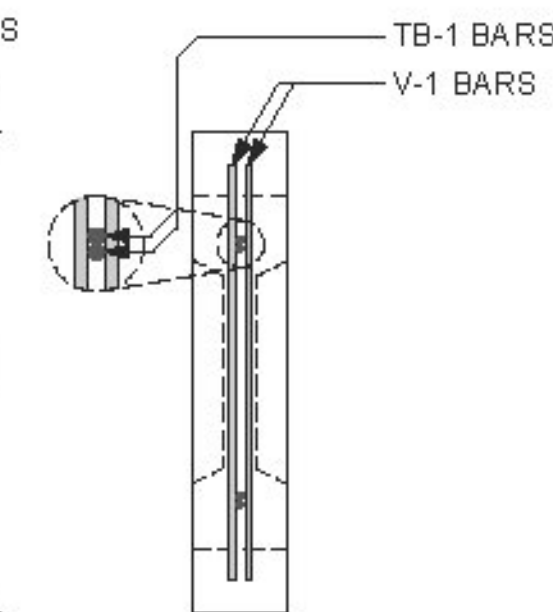


5 SECTION THROUGH STEM
Scale: 1" = 1'-0"

SPECIAL NOTES:

- FRONT FACE OF T-WALL@ UNITS FINISH TREATMENT:
 - PLAIN STEEL FORM FINISH

GENERAL NOTES:

- PRIMARY REFERENCE:
 - AASHTO, LRFD BRIDGE DESIGN SPECIFICATION, 5TH EDITION 2010 (WITH INTERIMS)
- T-WALL@ CONCRETE:
 - F'c = 5000 psi (MINIMUM) @ 28 DAYS
 - MINIMUM STRIPPING STRENGTH: 2500 psi
- T-WALL@ REINFORCING STEEL:
 - BLACK
 - Fy = 60 ksi (GRADE 60)
 - WELDING IS NOT PERMITTED
- MARKING OF PRECAST UNITS:
 - CLEARLY MARK EACH PRECAST UNIT ON THE BUTT END OF THE STEM WITH THE UNIT TYPE (i.e. 2.5x5.0x06 STD), THE DATE OF MANUFACTURE, THE LOT NUMBER (IF APPLICABLE), AND THE TRADEMARK "T-WALL@".
- REINFORCING FABRICATION AND PLACEMENT TOLERANCES:
 - THE STRUCTURAL DESIGN OF PRECAST UNITS ASSUMES 2 INCHES OF CONCRETE COVER OVER ALL REINFORCING BARS.
 - UNLESS OTHERWISE NOTED IN CONTRACT DOCUMENTS OR REFERENCED SPECIFICATIONS, TOLERANCES ON CONCRETE COVER SHALL BE ± 3/8 INCHES.
 - UNLESS OTHERWISE NOTED IN CONTRACT DOCUMENTS OR REFERENCED SPECIFICATIONS, TOLERANCES ON BAR PLACEMENT SHALL BE:
 - VERTICAL LOCATION OF TB-1 BARS: ± 3/8 INCHES
 - LOCATION / SPACING OF H-1, V-1 & V-2 BARS: ± 1 INCH
 - REGARDLESS OF THE SPECIFIED PLACEMENT TOLERANCES, CONCRETE COVER SHALL BE MAINTAINED WITHIN ± 3/8 INCHES AS PREVIOUSLY NOTED.
 - ALL REINFORCING BARS SHALL BE CUT AND BENT FOLLOWING REQUIREMENTS OF THE CRSI MANUAL OF STANDARD PRACTICE.
 - UNLESS NOTED OTHERWISE, TOLERANCES FOR BAR FABRICATION SHALL MEET REQUIREMENTS OF STANDARD ACI 318 AND THE CRSI MANUAL OF STANDARD PRACTICE.

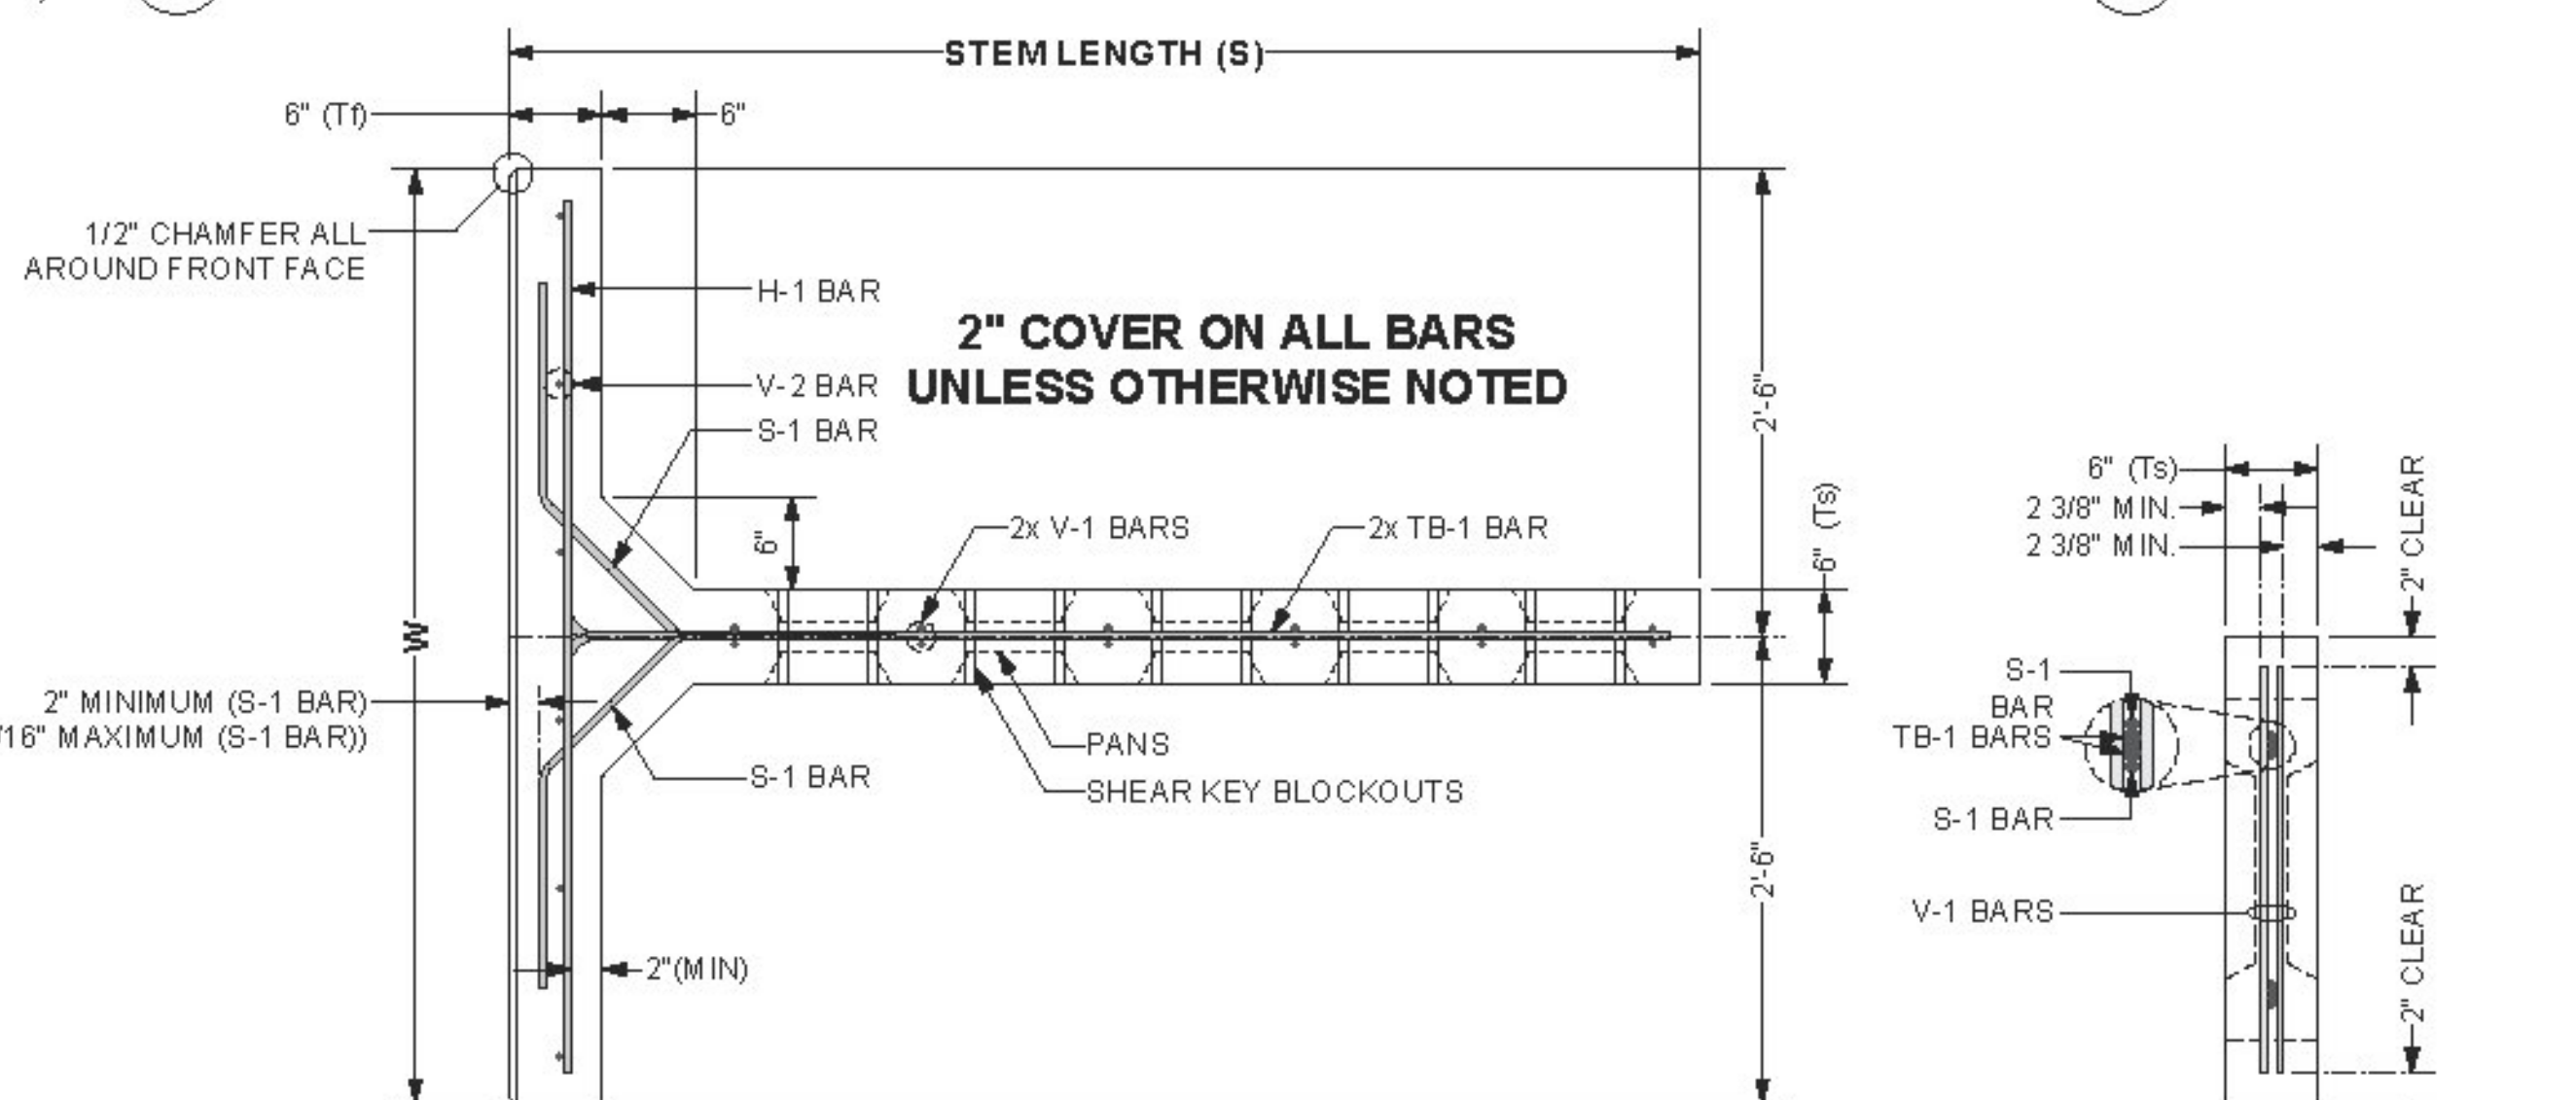

1 PLAN VIEW - 2.5 x 5.0 x 06 Std SHOWN
Scale: 1" = 1'-0"

4 SECTION THROUGH STEM
Scale: 1" = 1'-0"

X Approved
Approved As Noted
Rejected

This review is only for general conformance with the design concept and the information given in the Construction Documents. Corrections or comments made on the shop drawings during the review do not relieve the Contractor from compliance with the requirements of the Plans and Specifications. Review of a specific item shall not include review of an assembly of which an item is a component. The Contractor is responsible for dimensions to be confirmed and corrected at the job site; information that pertains solely to the fabrication process or to the means, methods, techniques, sequences and procedures of construction; coordination of the Work with that of other trades and for maintaining all Work in a safe and satisfactory manner.

The design contained on these drawings is based upon information provided by the owner. On the basis of this information, The Neel Company has the structure, stability, etc.

This drawing contains information proprietary to The Neel Company. T-WALL@ is a registered trademark owned by The Neel Company. ©2014 The Neel Company

PRECASTER: CONCRETE SYSTEMS, INC. CSI
Date: 8/8/2014
PROJECT #: 121552

CONTRACTOR: AL TRAVEL CONTRACTORS

PROJECT #: TW4301

DESIGNER

THE NEEL COMPANY
8328-D TRAFORD LANE
SPRINGFIELD, VIRGINIA 22152
PH: (703) 913-7858
FX: (703) 913-7859
WEB: WWW.NEELCO.COM

CERTIFIED WITH RESPECT TO INTERNAL STABILITY OF T-WALL@ STRUCTURES ONLY

NO.	REVISIONS


RIGIDIFIED TUBE FRP ARCH (RTFA) PROJECT

FAIRFIELD, VT


SHOP DRAWINGS
STANDARD UNITS
REBAR AND DIMENSIONS

T-WALL@ RETAINING WALL SYSTEM

SCALE:	AS NOTED
DATE:	4/21/14
DESIGNED BY:	KD
DRAWN BY:	ABC
CHECKED BY:	CCG
SHEET:	7

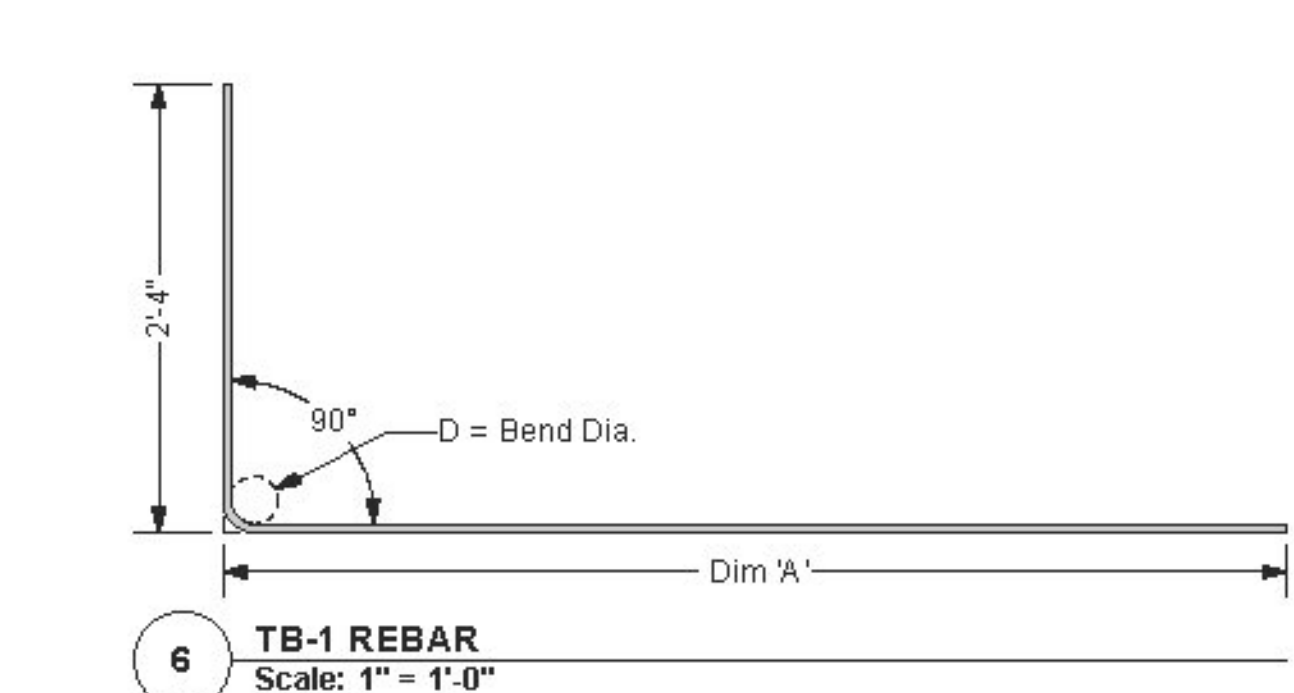


6 TB-1 REBAR
Scale: 1" = 1'-0"

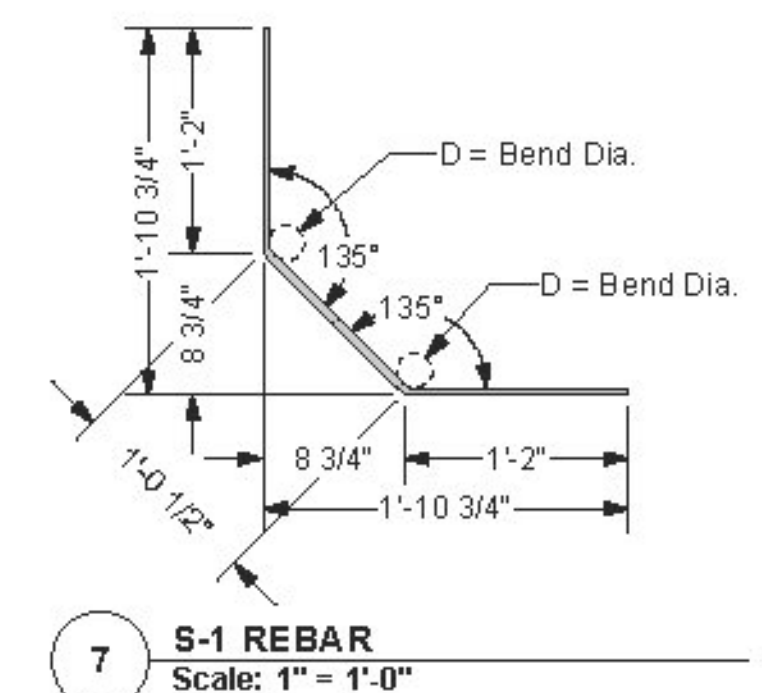


7 S-1 REBAR
Scale: 1" = 1'-0"


- GENERAL NOTES:**
- PRIMARY REFERENCE:
 - AASHTO, LRFD BRIDGE DESIGN SPECIFICATION, 5TH EDITION 2010 (WITH INTERIMS)
 - T-WALL@ CONCRETE:
 - F_c = 5000 psi (MINIMUM) @ 28 DAYS
 - MINIMUM STRIPPING STRENGTH: 2500 psi
 - T-WALL@ REINFORCING STEEL:
 - BLACK
 - F_y = 60 ksi (GRADE 60)
 - WELDING IS NOT PERMITTED**
 - MARKING OF PRECAST UNITS:
 - CLEARLY MARK EACH PRECAST UNIT ON THE BUTT END OF THE STEM WITH THE UNIT TYPE (i.e. 2.5x5.0x06 STD), THE DATE OF MANUFACTURE, THE LOT NUMBER (IF APPLICABLE), AND THE TRADEMARK "T-WALL@".
 - REINFORCING FABRICATION AND PLACEMENT TOLERANCES:
 - THE STRUCTURAL DESIGN OF PRECAST UNITS ASSUMES 2 INCHES OF CONCRETE COVER OVER ALL REINFORCING BARS.
 - UNLESS OTHERWISE NOTED IN CONTRACT DOCUMENTS OR REFERENCED SPECIFICATIONS, TOLERANCES ON CONCRETE COVER SHALL BE ± 3/8 INCHES.
 - UNLESS OTHERWISE NOTED IN CONTRACT DOCUMENTS OR REFERENCED SPECIFICATIONS, TOLERANCES ON BAR PLACEMENT SHALL BE:
 - VERTICAL LOCATION OF TB-1 BARS: ± 3/8 INCHES
 - LOCATION / SPACING OF H-1, V-1 & V-2 BARS: ± 1 INCH
 - REGARDLESS OF THE SPECIFIED PLACEMENT TOLERANCES, CONCRETE COVER SHALL BE MAINTAINED WITHIN ± 3/8 INCHES AS PREVIOUSLY NOTED.
 - ALL REINFORCING BARS SHALL BE CUT AND BENT FOLLOWING REQUIREMENTS OF THE CRSI MANUAL OF STANDARD PRACTICE.
 - UNLESS NOTED OTHERWISE, TOLERANCES FOR BAR FABRICATION SHALL MEET REQUIREMENTS OF STANDARD A CI 318 AND THE CRSI MANUAL OF STANDARD PRACTICE.

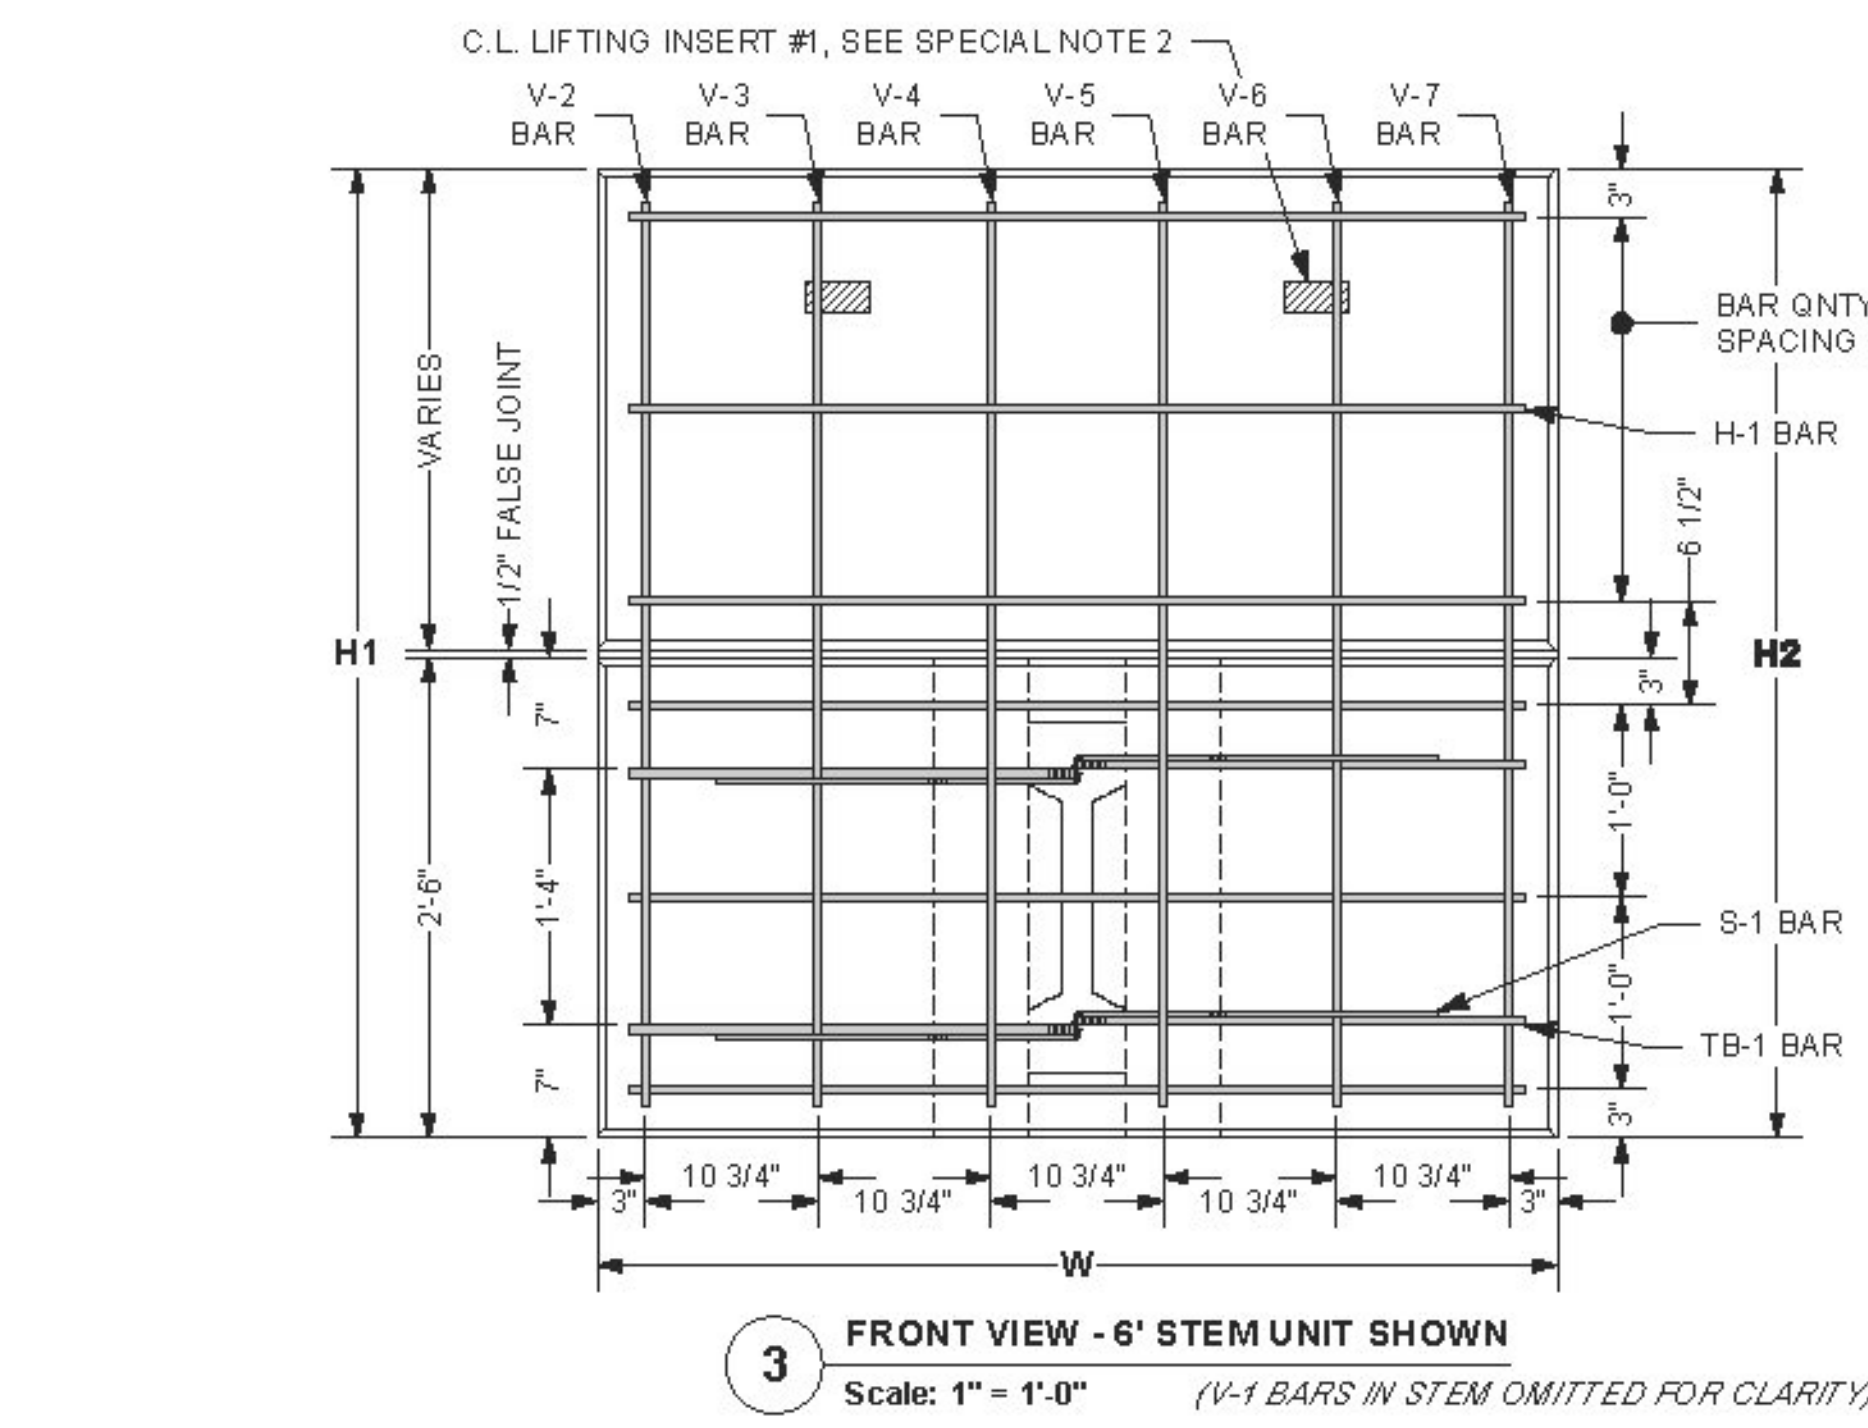


3 FRONT VIEW - 6' STEM UNIT SHOWN
Scale: 1" = 1'-0" (V-1 BARS IN STEM OMITTED FOR CLARITY)

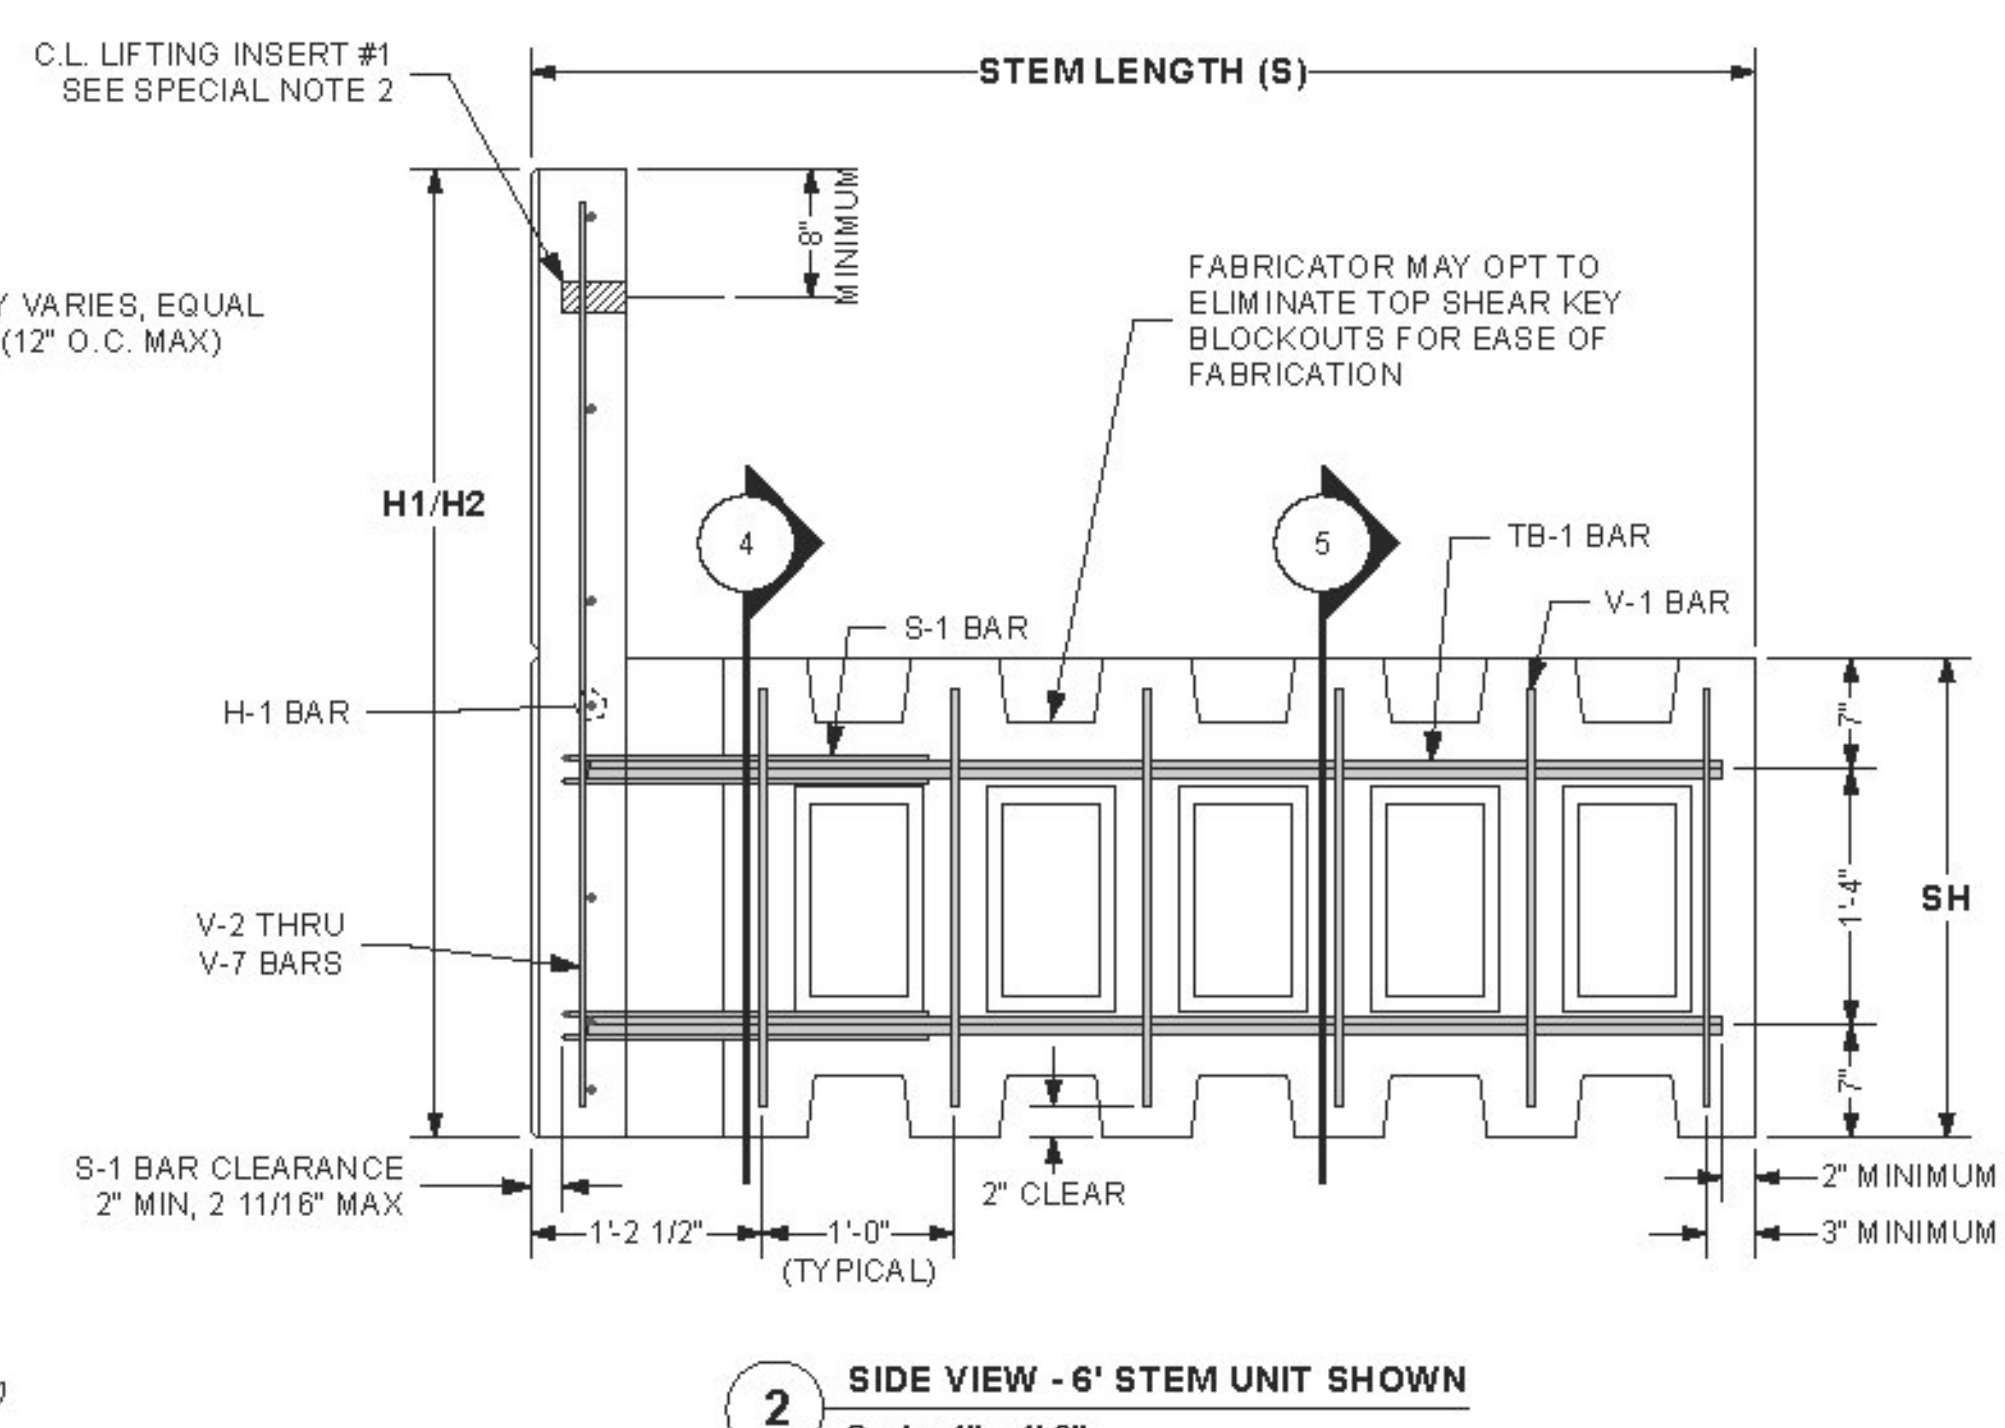

2 SIDE VIEW - 6' STEM UNIT SHOWN
Scale: 1" = 1'-0"

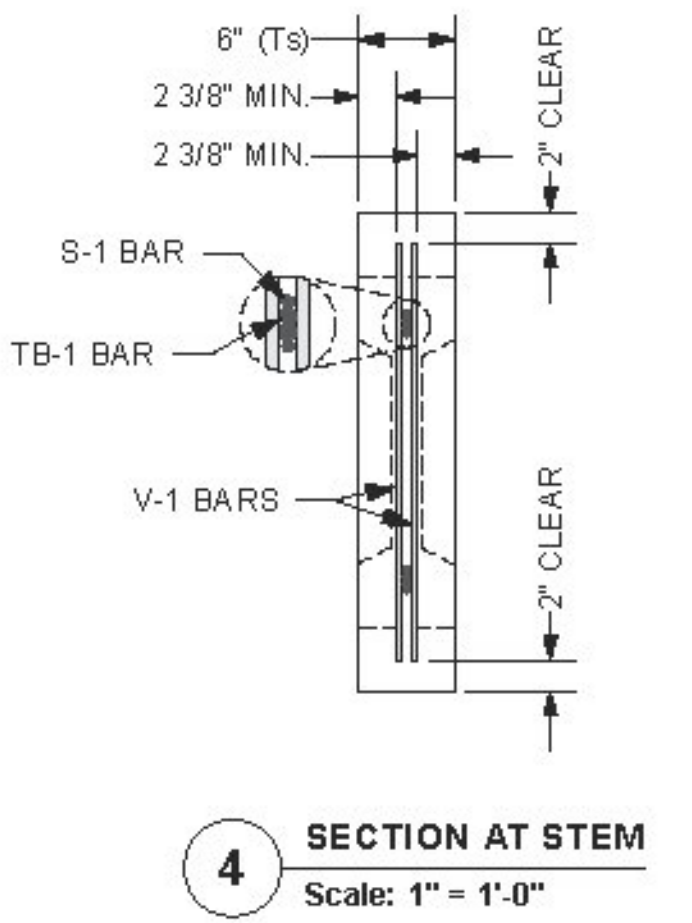


4 SECTION AT STEM
Scale: 1" = 1'-0"

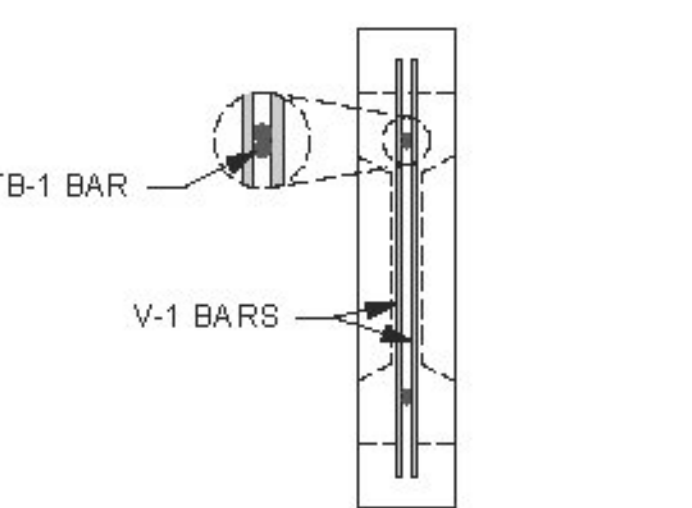


5 SECTION AT STEM
Scale: 1" = 1'-0"


- SPECIAL NOTES:**
- FRONT FACE OF T-WALL@ UNITS FINISH TREATMENT:
 - PLAIN STEEL FORM FINISH
 - LIFTING INSERTS CAPACITY:
 - TWO QUICKLIFT 'QL050G' LIFTING INSERTS OR EQUAL, SPACED AT LEAST 30" APART.
 - 2000 LBS (1 TON) MINIMUM RATED WORKING LOAD CAPACITY.
 - MINIMUM CONCRETE STRENGTH SHALL BE 3,500 psi PRIOR TO STRIPPING AND LIFTING OPERATIONS.
 - 1/2" FALSE JOINT LOCATION:
 - IF H-1 IS GREATER THEN 2'-6", THEN FIRST FALSE JOINT WILL BE 2'-6" FROM THE BOTTOM OF THE UNIT.
 - IF H-1 IS GREATER THEN 5'-0", THEN SECOND FALSE JOINT WILL BE 2'-6" ABOVE THE FIRST FALSE JOINT.
 - THE FALSE JOINT WILL 1/2" HIGH AND 1/2" DEEP.

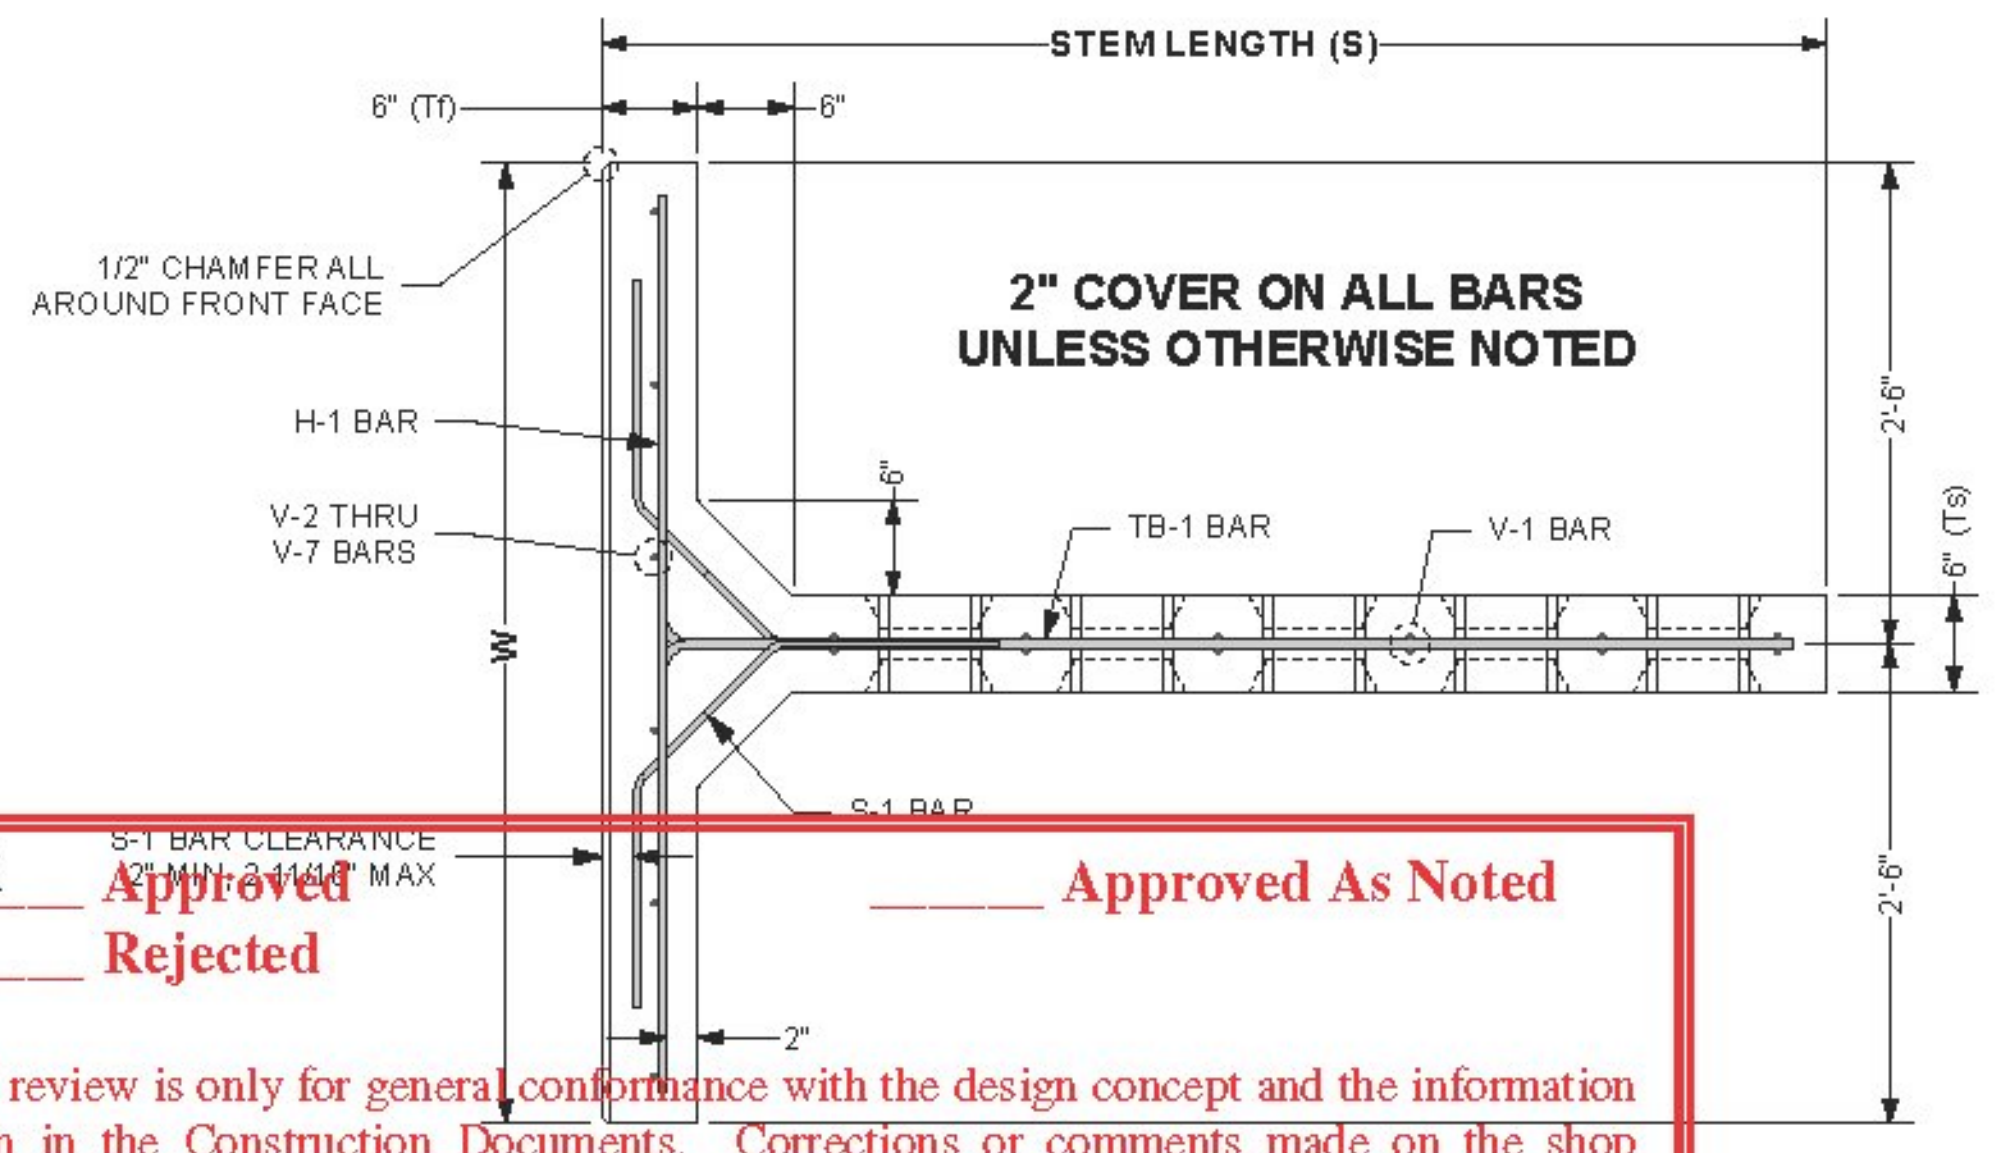

1 PLAN VIEW - 6' STEM UNIT SHOWN
Scale: 1" = 1'-0"

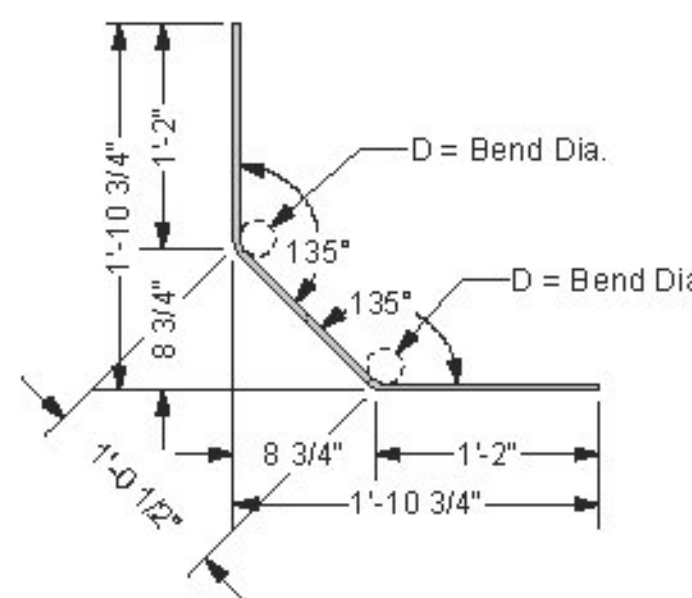

6 S-1 REBAR
Scale: 1" = 1'-0"

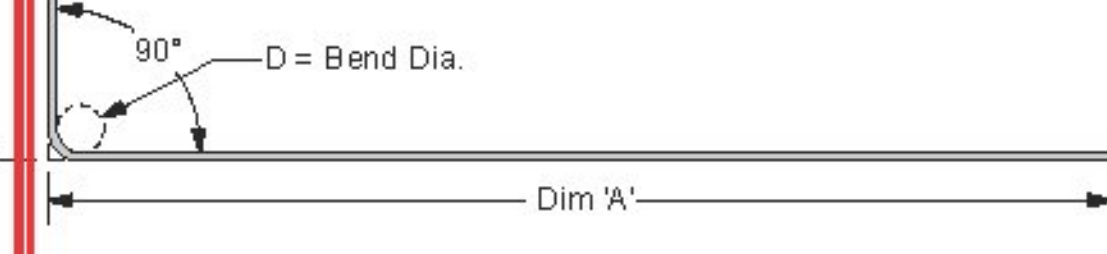

7 TB-1 REBAR
Scale: 1" = 1'-0"

Approved As Noted

This review is only for general conformance with the design concept and the information given in the Construction Documents. Corrections or comments made on the shop drawings during the review do not relieve the Contractor from compliance with the requirements of the Plans and Specifications. Review of a specific item shall not include review of an assembly of which an item is a component. The Contractor is responsible for dimensions to be confirmed and corrected at the job site; information that pertains solely to the fabrication process or to the means, methods, techniques, sequences and procedures of construction; coordination of the Work with that of other trades and performing all Work in a safe and satisfactory manner.

Date 8/8/2014

By T. Traver

McFarland Johnson

REBAR SCHEDULES

Unit Dims	Bar Mark	Qty	Size	Length	Dim "A"	Bar Weight	Bend Dia	Remarks
H=VARIES	H-1	VARIES	#4	4'8"				SEE SLOPED TOP UNIT SCHEDULE
W=5'0"	V-1	12 ea	#4	2'2"		17.37 lbs		
S=6'4 1/2"	V-2 THRU V-7	1 ea	#5	VARIES				SEE SLOPED TOP UNIT SCHEDULE
SH=2'6"	S-1	4 ea	#4	3'4 1/2"		9.02 lbs	D=3"	
	TB-1	4 ea	#4	8'3"	5'11"	22.04 lbs	D=3"	

SLOPED TOP UNIT SCHEDULE:

MARK No.	QNTY	STEM	WIDTH	H1	H2	H-1 BAR	V-2 BAR	V-3 BAR	V-4 BAR	V-5 BAR	V-6 BAR	V-7 BAR	VOL	WEIGHT	AREA
SP2	1 ea	6'4 1/2"	5'0"	3'10 1/8"	3'11"	5 ea	3'5 5/8"	3'3 3/4"	3'2"	3'1 1/8"	2'9 1/2"	2'9 1/2"	0.56 cy	2,266 lbs	17.30 sf
SP3	1 ea	6'4 1/2"	5'0"	5'7 1/2"	4'10 3/8"	7 ea	5'3"	5'1 1/8"	4'11 3/8"	4'10 3/8"	4'8 5/8"	4'6 7/8"	0.72 cy	2,934 lbs	26.20 sf
SP4	1 ea	6'4 1/2"	5'0"	4'10 3/8"	4'1 1/4"	6 ea	4'5 7/8"	4'4"	4'2 1/4"	4'1 1/4"	3'11 1/2"	3'9 3/4"	0.65 cy	2,649 lbs	22.40 sf
SP5	1 ea	6'4 1/2"	5'0"	4'1 1/4"	3'4 1/8"	5 ea	3'8 3/4"	3'6 7/8"	3'5 1/8"	3'4 1/8"	3'2 3/8"	3'0 5/8"	0.58 cy	2,364 lbs	18.60 sf
SP6	1 ea	6'4 1/2"	5'0"	5'10 5/8"	5'1 1/2"	7 ea	5'6 1/8"	5'4 1/4"	5'2 1/2"	5'1 1/2"	4'11 3/4"	4'10"	0.75 cy	3,032 lbs	27.50 sf
SP7	1 ea	6'4 1/2"	5'0"	4'8 1/2"	6'5 1/2"	7 ea	4'5 5/8"	4'9 7/8"	5'2"	5'4 1/8"	5'8 1/4"	6'0 3/8"	0.76 cy	3,063 lbs	27.93 sf
SP8	1 ea	6'4 1/2"	5'0"	3'11"	5'6"	7 ea	3'8 1/8"	4'0 3/8"	4'4 1/2"	4'6 5/8"	4'10 3/4"	5'2 7/8"	0.68 cy	2,767 lbs	23.93 sf
SP9	1 ea	6'4 1/2"	5'0"	3'1 1/2"	4'10 1/2"	6 ea	2'10 3/4"	3'2 7/8"	3'7"	3'9 1/8"	4'1 1/4"	4'5 3/8"	0.61 cy	2,471 lbs	20.02 sf
SP11	1 ea	6'4 1/2"	5'0"	3'1 7/8"	4'11 7/8"	6 ea	2'11 1/8"	3'3 1/2"	3'7 3/4"	3'10"	4'2 3/8"	4'6 3/4"	0.62 cy	2,497 lbs	20.38 sf
SP12	1 ea	6'4 1/2"	5'0"	2'5 3/8"	4'3 3/8"	5 ea	2'2 5/8"	2'7"	2'11 1/4"	3'1 1/2"	3'5 7/8"	3'10 1/8"	0.55 cy	2,231 lbs	16.82 sf
SP15	1 ea	6'4 1/2"	5'0"	5'3 1/2"	4'6 3/4"	6 ea	4'11"	4'9 1/4"	4'7 1/2"	4'6 5/8"	4'4 7/8"	4'3 1/4"	0.70 cy	2,816 lbs	24.62 sf
SP16	1 ea	6'4 1/2"	5'0"	4'6 3/4"	3'10"	6 ea	4'2 1/4"	4'0 1/2"	3'10 3/4"	3'9 7/8"	3'6 1/2"	3'6 1/2"	0.63 cy	2,542 lbs	20.97 sf
SP17	1 ea	6'4 1/2"	5'0"	3'10"	3'1 1/4"	5 ea	3'5 1/2"	3'3 3/4"	3'2"	3'1 1/8"	2'11 3/8"	2'9 5/8"	0.56 cy	2,268 lbs	17.32 sf
SP18	1 ea	6'4 1/2"	5'0"	5'7 3/4"	4'11"	7 ea	5'3 3/8"	5'1 5/8"	4'11 7/8"	4'11"	4'9 1/4"	4'7 1/2"	0.73 cy	2,951 lbs	26.43 sf



The design contained on these drawings is based upon information provided by the owner. On the basis of this information, The Neel Company has designed, and is responsible for, the internal stability of the structure only. External stability, including foundation and slope stability, is the responsibility of the owner.


This drawing contains information proprietary to The Neel Company. T-WALL@ is a registered trademark owned by The Neel Company. ©2014 The Neel Company

PRECASTER: CONCRETE SYSTEMS, INC. CSI
PROJECT #: T21882

CONTRACTOR: AL. ST. ONGE CONTRACTORS
PROJECT #:

DESIGNER
THE NEEL COMPANY
8328-D TRAFORD LANE
SPRINGFIELD, VIRGINIA 22152
PH: (703) 913-7858
FX: (703) 913-7859
WEB: WWW.NEELCO.COM

PROJECT # TW4301

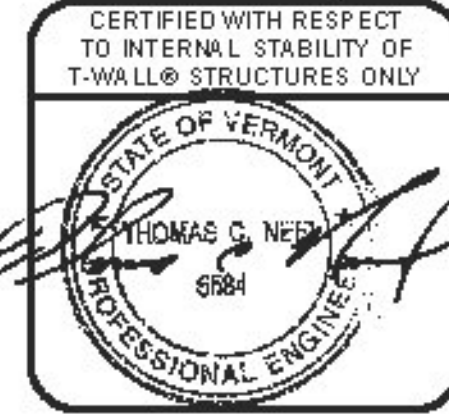

REVISIONS

NO.	REVIEWER COMMENTS	ABC	8-6-14
1			

RIGIDIFIED TUBE FRP ARCH (RTFA) PROJECT

FAIRFIELD, VT

SHOP DRAWINGS
SLOPED TOP UNITS
REBAR AND DIMENSIONS

T-WALL@ RETAINING WALL SYSTEM

SCALE: AS NOTED

DATE: 4/21/14

DESIGNED BY: KD

DRAWN BY: ABC

CHECKED BY: CCG

SHEET: 8

BORDER-TWC T-WALL HWY v4.1

- GENERAL NOTES:**
- PRIMARY REFERENCE:
 - AASHTO, LRFD BRIDGE DESIGN SPECIFICATION, 5TH EDITION 2010 (WITH INTERIMS)
 - T-WALL@ CONCRETE:
 - F_c = 5000 psi (MINIMUM) @ 28 DAYS
 - MINIMUM STRIPPING STRENGTH: 2500 psi
 - T-WALL@ REINFORCING STEEL:
 - BLACK
 - F_y = 60 ksi (GRADE 60)
 - WELDING IS NOT PERMITTED**
 - MARKING OF PRECAST UNITS:
 - CLEARLY MARK EACH PRECAST UNIT ON THE BUTT END OF THE STEM WITH THE UNIT TYPE (i.e. 2.5x5.0x06 STD), THE DATE OF MANUFACTURE, THE LOT NUMBER (IF APPLICABLE), AND THE TRADEMARK "T-WALL@".
 - REINFORCING FABRICATION AND PLACEMENT TOLERANCES:
 - THE STRUCTURAL DESIGN OF PRECAST UNITS ASSUMES 2 INCHES OF CONCRETE COVER OVER ALL REINFORCING BARS.
 - UNLESS OTHERWISE NOTED IN CONTRACT DOCUMENTS OR REFERENCED SPECIFICATIONS, TOLERANCES ON CONCRETE COVER SHALL BE ± 3/8 INCHES.
 - UNLESS OTHERWISE NOTED IN CONTRACT DOCUMENTS OR REFERENCED SPECIFICATIONS, TOLERANCES ON BAR PLACEMENT SHALL BE:
 - VERTICAL LOCATION OF TB-1 BARS: ± 3/8 INCHES
 - LOCATION / SPACING OF H-1, V-1 & V-2 BARS: ± 1 INCH
 - REGARDLESS OF THE SPECIFIED PLACEMENT TOLERANCES, CONCRETE COVER SHALL BE MAINTAINED WITHIN ± 3/8 INCHES AS PREVIOUSLY NOTED.
 - ALL REINFORCING BARS SHALL BE CUT AND BENT FOLLOWING REQUIREMENTS OF THE CRSI MANUAL OF STANDARD PRACTICE.
 - UNLESS NOTED OTHERWISE, TOLERANCES FOR BAR FABRICATION SHALL MEET REQUIREMENTS OF STANDARD ACI 318 AND THE CRSI MANUAL OF STANDARD PRACTICE.










- SPECIAL NOTES:**
- FRONT FACE OF T-WALL@ UNITS FINISH TREATMENT:
 - PLAIN STEEL FORM FINISH
 - LIFTING INSERTS CAPACITY:
 - TWO QUICKLIFT "QLO50G" LIFTING INSERTS OR EQUAL, SPACED AT LEAST 30" APART.
 - 2000 LBS (1 TON) MINIMUM RATED WORKING LOAD CAPACITY.
 - MINIMUM CONCRETE STRENGTH SHALL BE 3,500 psi PRIOR TO STRIPPING AND LIFTING OPERATIONS.
 - 1/2" FALSE JOINT LOCATION:
 - IF H-1 IS GREATER THEN 2'-6", THEN FIRST FALSE JOINT WILL BE 2'-6" FROM THE BOTTOM OF THE UNIT.
 - IF H-1 IS GREATER THEN 5'-0", THEN SECOND FALSE JOINT WILL BE 2'-6" ABOVE THE FIRST FALSE JOINT.
 - THE FALSE JOINT WILL 1/2" HIGH AND 1/2" DEEP.

REBAR SCHEDULES

Unit Dims	Bar Mark	Qty	Size	Length	Dim "A"	Bar Weight	Bend Dia	Remarks
H=VARIES	H-1	VARIES	#4	4'1 1/4"				SEE SLOPED TOP UNIT SCHEDULE
W=4'-1 1/4"	V-1	12 ea	#4	2'-2"		17.37 lbs		
S=6'-4 1/2"	V-2 THRU V-6	1 ea	#4	VARIES				SEE SLOPED TOP UNIT SCHEDULE
SH=2'-6"	S-1	2 ea	#4	3'-4 1/2"		4.51 lbs	D=3"	
	S-2	2 ea	#4	3'-0 1/2"		4.06 lbs	D=3"	
	TB-1	2 ea	#4	4'-4"	2'-0 1/2"	5.79 lbs	D=3"	
	TB-2	2 ea	#4	3'-5 1/4"	2'-0 1/2"	4.59 lbs	D=3"	

SLOPED TOP UNIT SCHEDULE:

MARK No.	QNTY	STEM	WIDTH	H1	H2	H-1 BAR	V-2 BAR	V-3 BAR	V-4 BAR	V-5 BAR	V-6 BAR	VOL	WEIGHT	AREA
SP1	1 ea	6'-4 1/2"	4'-1 1/4"	4'-5 1/2"	3'-10 1/8"	5 ea	4'-0 7/8"	4'-0"	3'-9 3/4"	3'-8 1/8"	3'-6 3/8"	0.55 cy	2,247 lbs	17.04 sf
SP14	1 ea	6'-4 1/2"	4'-1 1/4"	3'-4 1/4"	2'-9"	4 ea	2'-11 5/8"	2'-10 5/8"	2'-8 1/2"	2'-6 7/8"	2'-5 3/8"	0.47 cy	1,908 lbs	12.52 sf

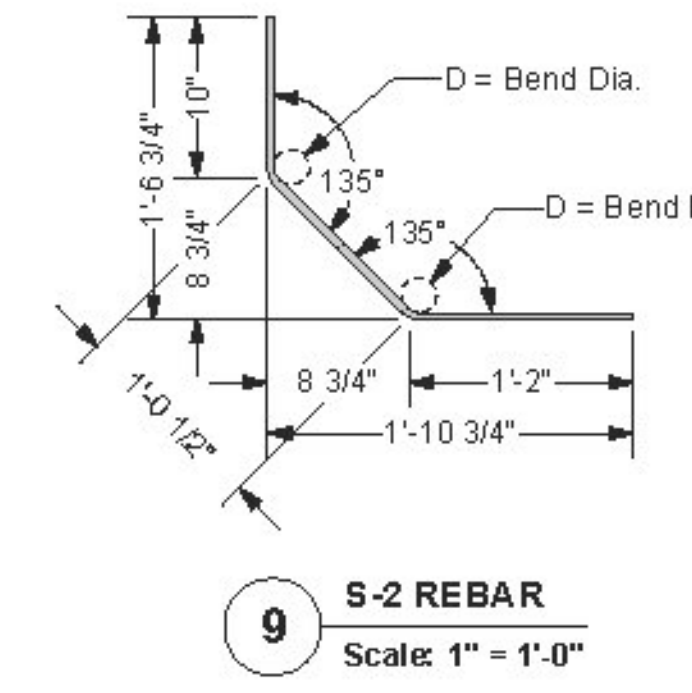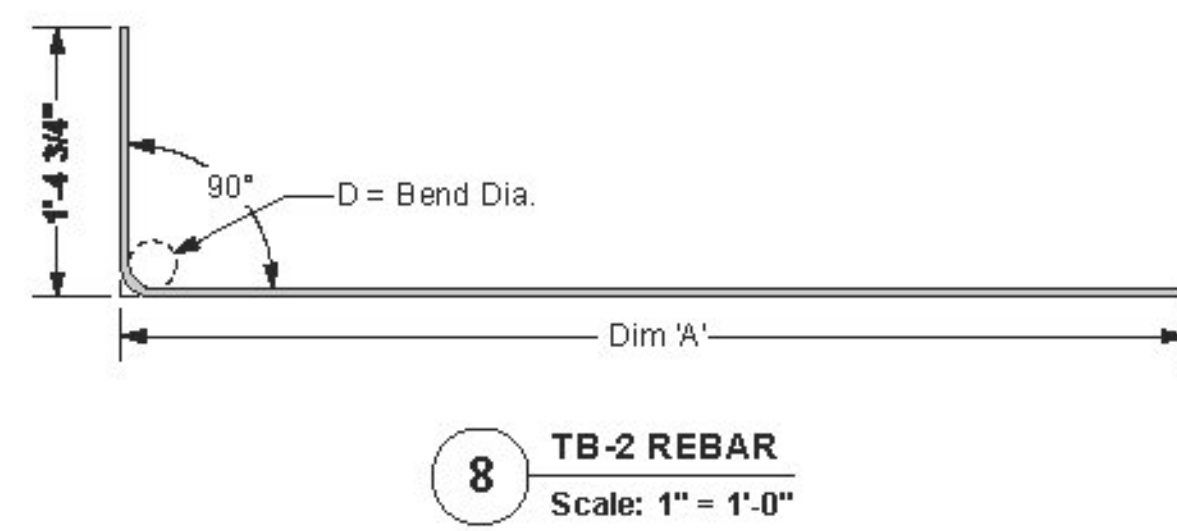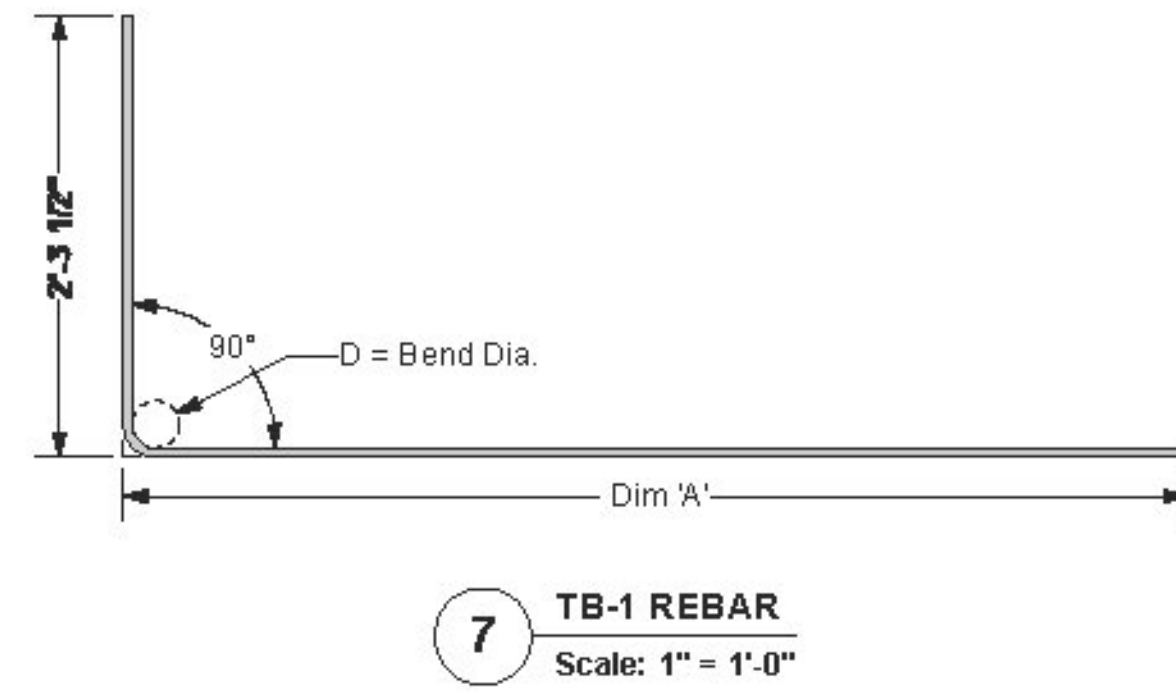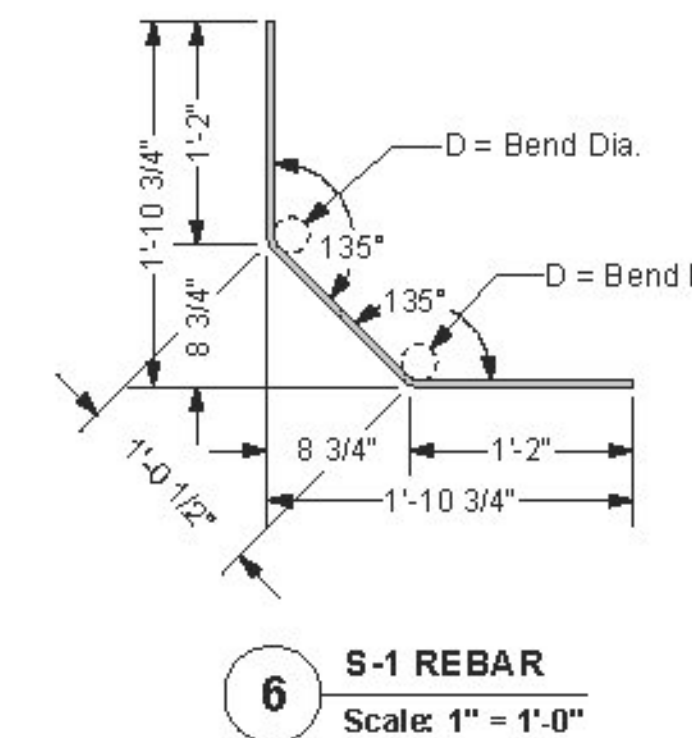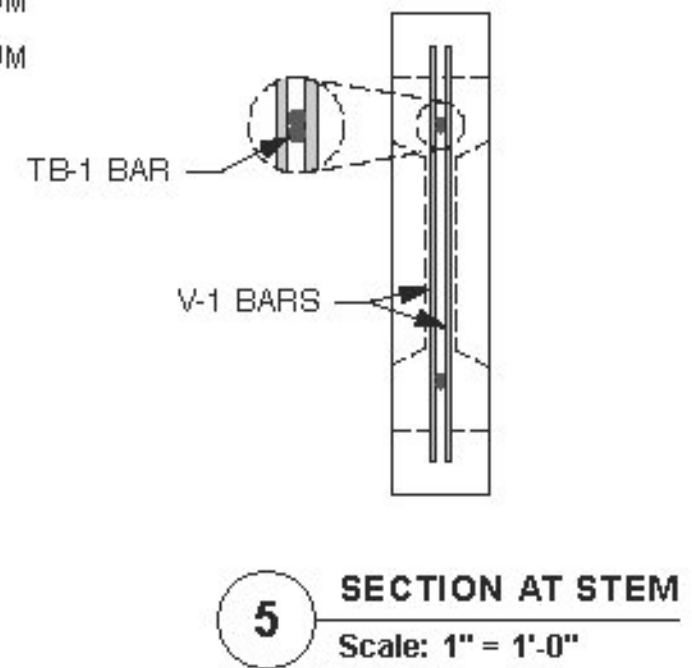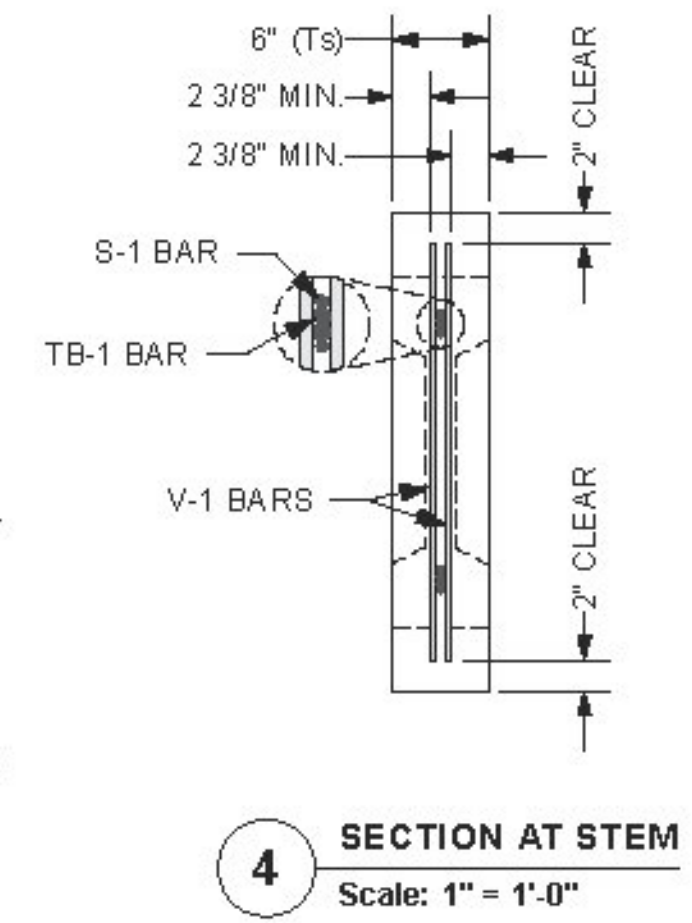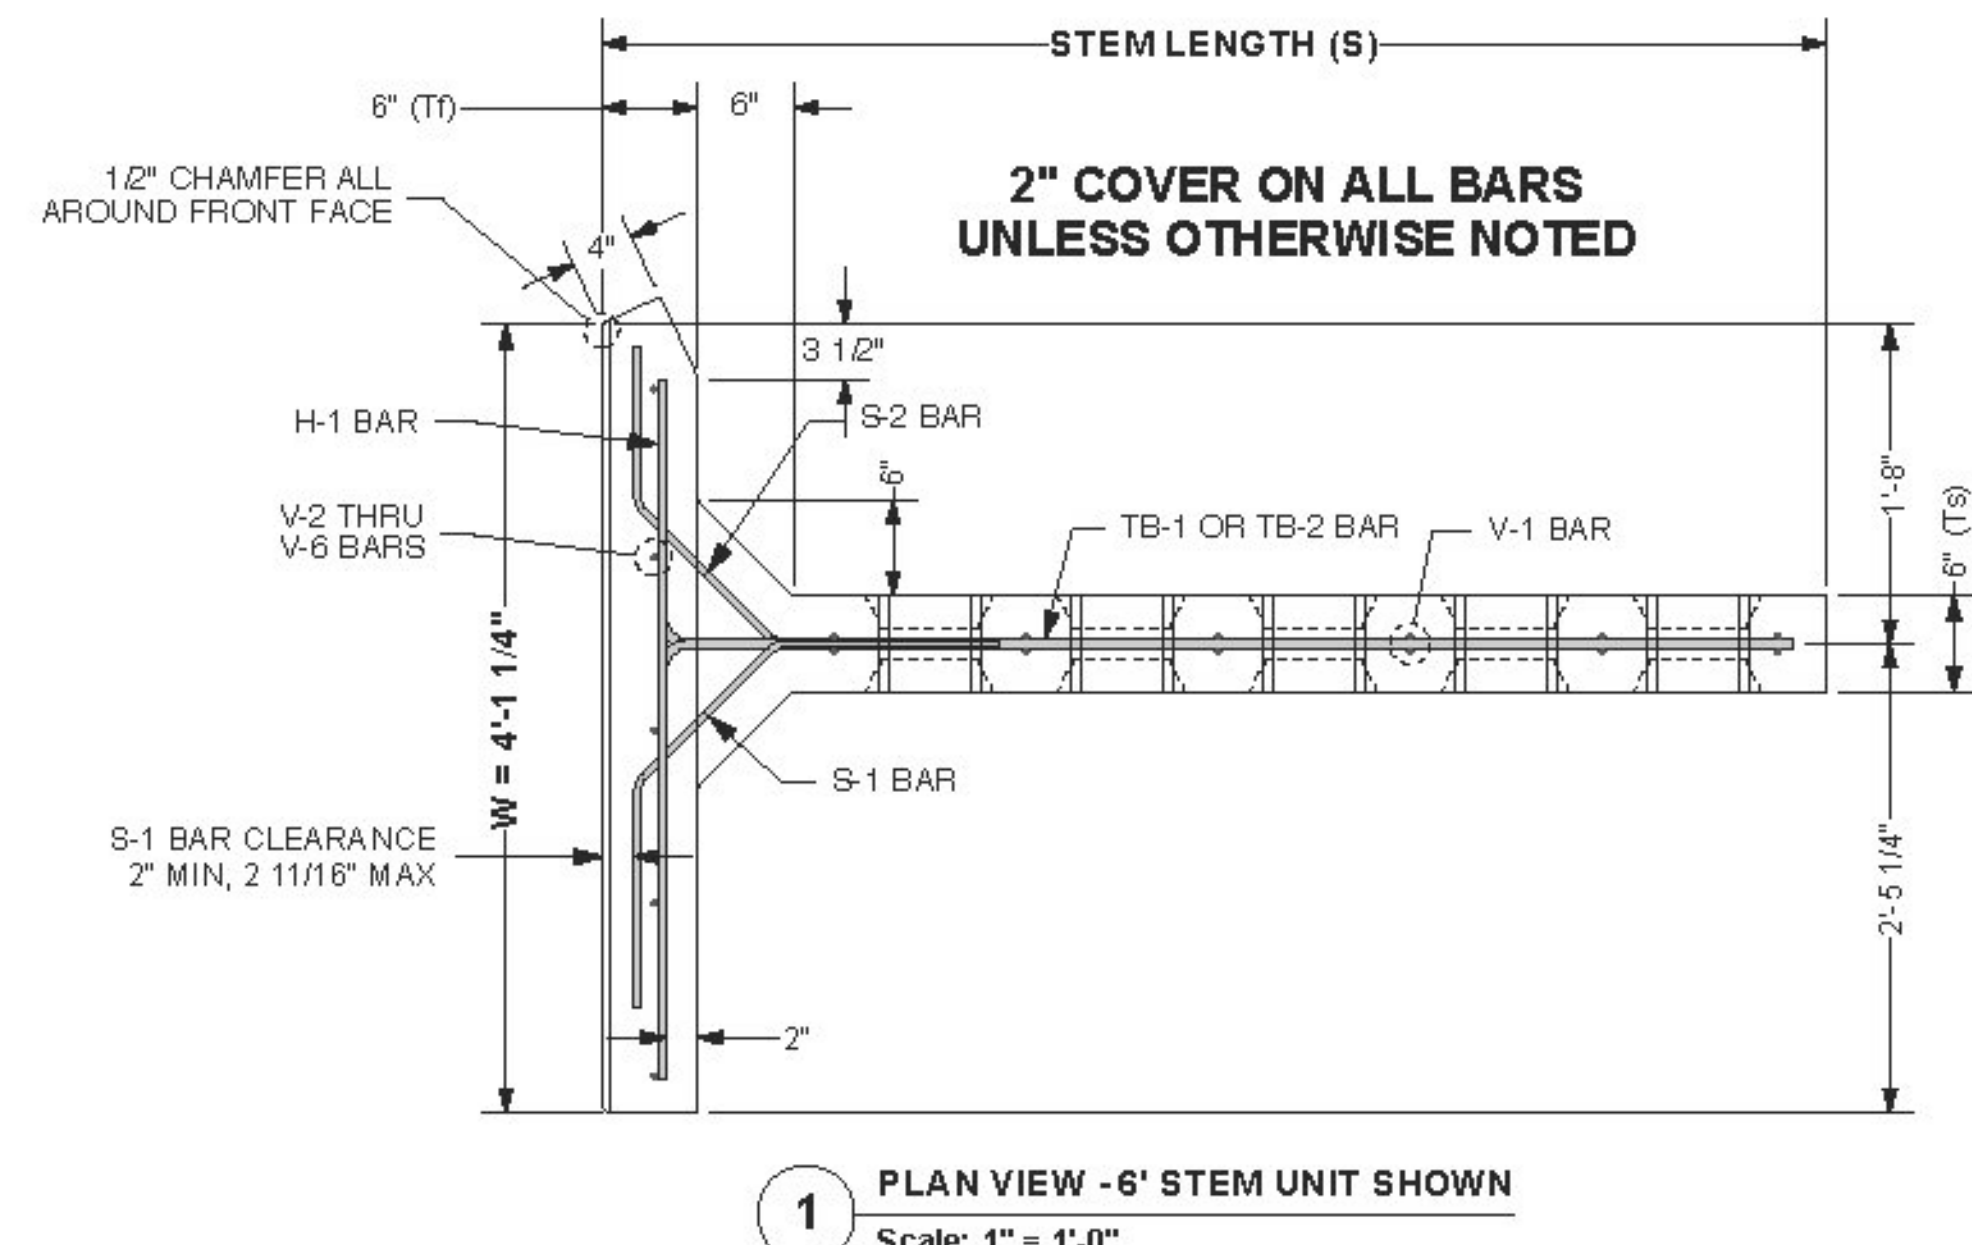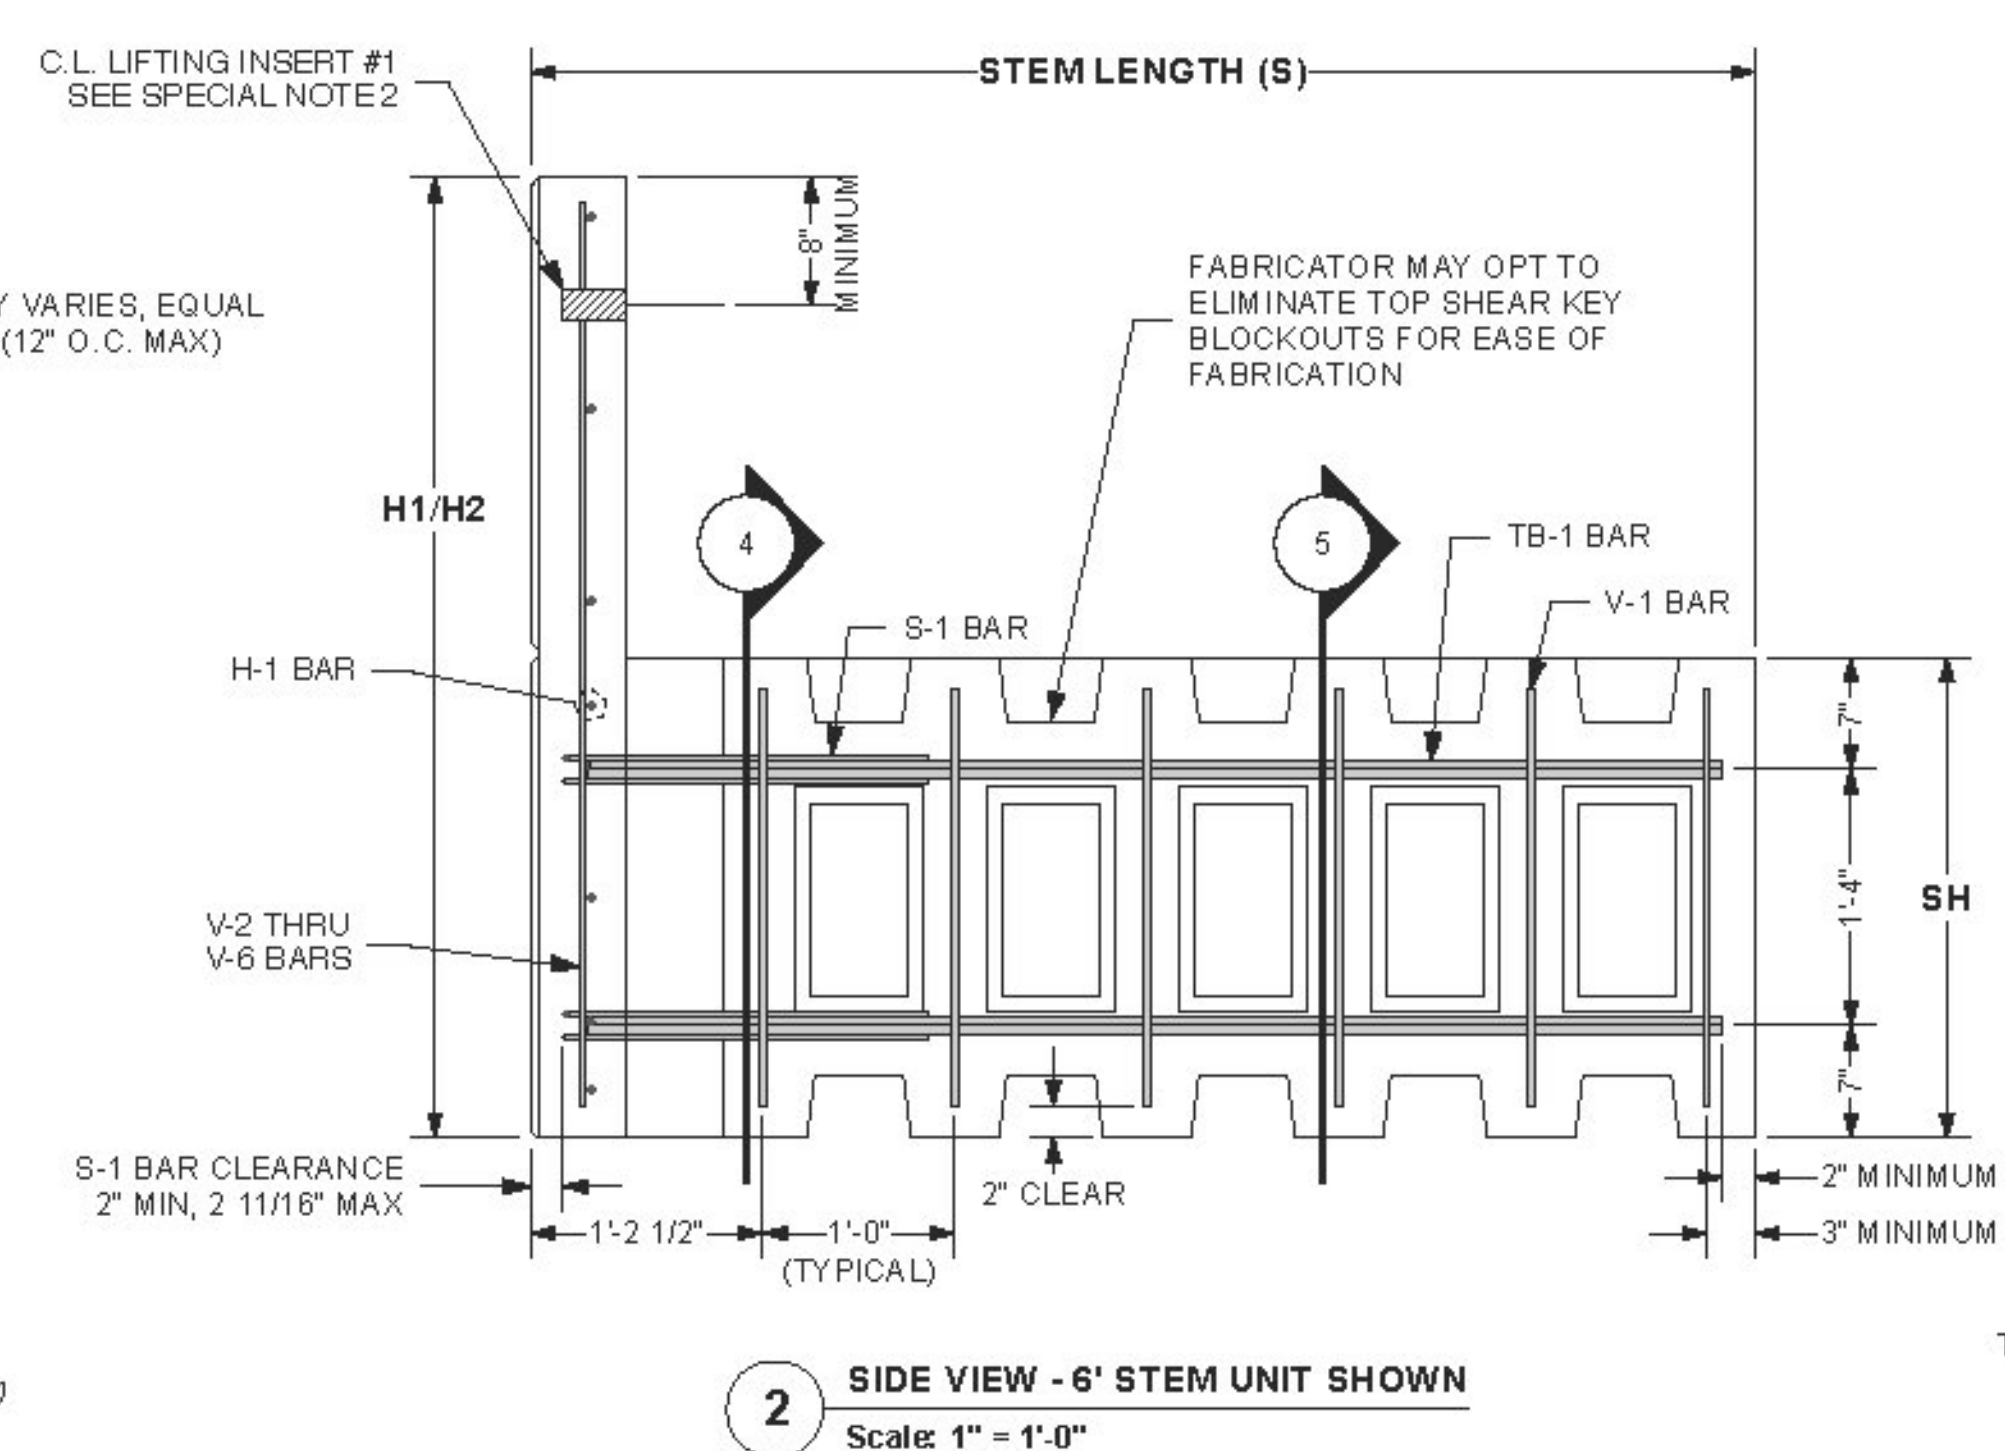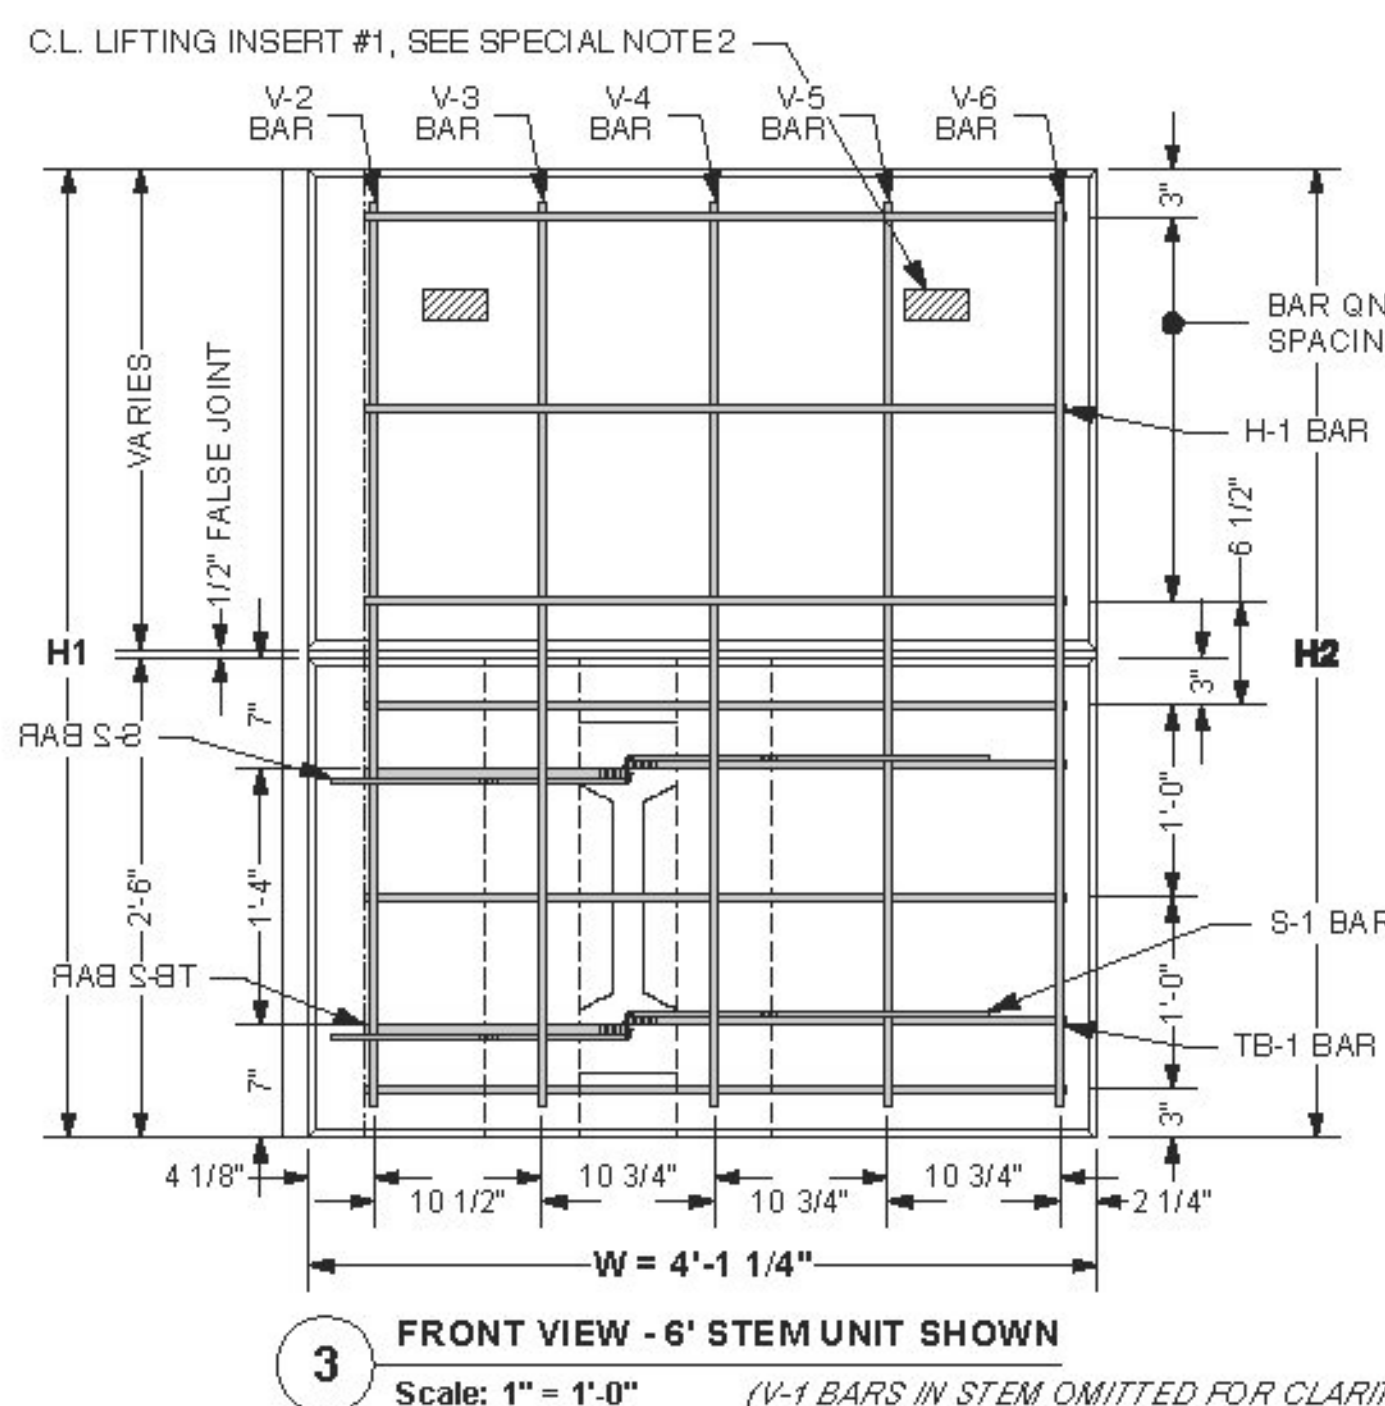

X Approved **Approved As Noted**
Rejected

This review is only for general conformance with the design concept and the information given in the Construction Documents. Corrections or comments made on the shop drawings during the review do not relieve the Contractor from compliance with the requirements of the Plans and Specifications. Review of a specific item shall not include review of an assembly of which an item is a component. The Contractor is responsible for dimensions to be confirmed and corrected at the job site; information that pertains solely to the fabrication process or to the means, methods, techniques, sequences and procedures of construction; coordination of the Work with that of other trades and performing all Work in a safe and satisfactory manner.

The design contained on these drawings is based upon information provided by the Precaster. The Precaster has design responsibility for the structure only. The Engineer's responsibility is for the stability, is the responsibility of the Precaster.

McFarland Johnson


This drawing contains information proprietary to The Neel Company. T-WALL@ is a registered trademark of The Neel Company. ©2014 The Neel Company

PRECASTER: CONCRETE PRODUCTS, INC. CSI
Date: 8/8/2014
#: T21882

CONTRACTOR: RYAN TRAYER
BY: J. Trayer
PROJECT #:

DESIGNER
THE NEEL COMPANY
8328-D TRAFORD LANE
SPRINGFIELD, VIRGINIA 22152
PH: (703) 913-7858
FAX: (703) 913-7859
WEB: WWW.NEELCO.COM

PROJECT # TW4301

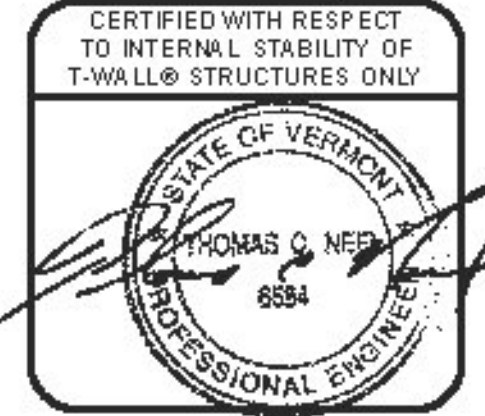

REVISIONS

NO.	REVIEWER COMMENTS	ABC	8-6-14
1			

RIGIDIFIED TUBE FRP ARCH (RTFA) PROJECT

FAIRFIELD, VT

SHOP DRAWINGS
NARROW SLOPED TOP LEFT BEVELED UNITS
REBAR AND DIMENSIONS
T-WALL@ RETAINING WALL SYSTEM

SCALE: AS NOTED

DATE: 4/21/14

DESIGNED BY: KD

DRAWN BY: ABC

CHECKED BY: CCG

SHEET: 9

PLOT DATE & TIME: Wednesday, August 6, 2014 11:27:28 AM
USER NAME: N/A
CAD FILE NAME: 09 Rebar - Narrow Sloped Top Left Beveled Units.vwk
VECTORWORKS 2011
VW SHEET NAME: TW-08

- GENERAL NOTES:**
- PRIMARY REFERENCE:
 - AASHTO, LRFD BRIDGE DESIGN SPECIFICATION, 5TH EDITION 2010 (WITH INTERIMS)
 - T-WALL@ CONCRETE:
 - F'c = 5000 psi (MINIMUM) @ 28 DAYS
 - MINIMUM STRIPPING STRENGTH: 2500 psi
 - T-WALL@ REINFORCING STEEL:
 - BLACK
 - Fy = 60 ksi (GRADE 60)
 - WELDING IS NOT PERMITTED**
 - MARKING OF PRECAST UNITS:
 - CLEARLY MARK EACH PRECAST UNIT ON THE BUTT END OF THE STEM WITH THE UNIT TYPE (i.e. 2.5x5.0x06 STD), THE DATE OF MANUFACTURE, THE LOT NUMBER (IF APPLICABLE), AND THE TRADEMARK 'T-WALL@'.
 - REINFORCING FABRICATION AND PLACEMENT TOLERANCES:
 - THE STRUCTURAL DESIGN OF PRECAST UNITS ASSUMES 2 INCHES OF CONCRETE COVER OVER ALL REINFORCING BARS.
 - UNLESS OTHERWISE NOTED IN CONTRACT DOCUMENTS OR REFERENCED SPECIFICATIONS, TOLERANCES ON CONCRETE COVER SHALL BE ± 3/8 INCHES.
 - UNLESS OTHERWISE NOTED IN CONTRACT DOCUMENTS OR REFERENCED SPECIFICATIONS, TOLERANCES ON BAR PLACEMENT SHALL BE:
 - VERTICAL LOCATION OF TB-1 BARS: ± 3/8 INCHES
 - LOCATION / SPACING OF H-1, V-1 & V-2 BARS: ± 1 INCH
 - REGARDLESS OF THE SPECIFIED PLACEMENT TOLERANCES, CONCRETE COVER SHALL BE MAINTAINED WITHIN ± 3/8 INCHES AS PREVIOUSLY NOTED.
 - ALL REINFORCING BARS SHALL BE CUT AND BENT FOLLOWING REQUIREMENTS OF THE CRSI MANUAL OF STANDARD PRACTICE.
 - UNLESS NOTED OTHERWISE, TOLERANCES FOR BAR FABRICATION SHALL MEET REQUIREMENTS OF STANDARD A CI 318 AND THE CRSI MANUAL OF STANDARD PRACTICE.

- SPECIAL NOTES:**
- FRONT FACE OF T-WALL@ UNITS FINISH TREATMENT:
 - PLAIN STEEL FORM FINISH
 - LIFTING INSERTS CAPACITY:
 - TWO QUICKLIFT 'QL050G' LIFTING INSERTS OR EQUAL, SPACED AT LEAST 30" APART.
 - 2000 LBS (1 TON) MINIMUM RATED WORKING LOAD CAPACITY.
 - MINIMUM CONCRETE STRENGTH SHALL BE 3,500 psi PRIOR TO STRIPPING AND LIFTING OPERATIONS.
 - 1/2" FALSE JOINT LOCATION:
 - IF H-1 IS GREATER THEN 2'-6", THEN FIRST FALSE JOINT WILL BE 2'-6" FROM THE BOTTOM OF THE UNIT.
 - IF H-1 IS GREATER THEN 5'-0", THEN SECOND FALSE JOINT WILL BE 2'-6" ABOVE THE FIRST FALSE JOINT.
 - THE FALSE JOINT WILL 1/2" HIGH AND 1/2" DEEP.


REBAR SCHEDULES

6' STEM SPECIAL UNITS


Unit Dims	Bar Mark	Qty	Size	Length	Dim "A"	Bar Weight	Bend Dia	Remarks
H=VARIES	H-1	VARIES	#4	4'3 3/8"				SEE SLOPED TOP UNIT SCHEDULE
W=4'11 1/4"	V-1	12 ea	#4	2'2"		17.37 lbs		
S=6'4 1/2"	V-2 THRU V-7	1 ea	#5	VARIES				SEE SLOPED TOP UNIT SCHEDULE
SH=2'6"	S-1	4 ea	#4	3'4 1/2"		9.02 lbs	D=3"	
	TB-1	2 ea	#4	8'2 7/8"	5'11"	11.01 lbs	D=3"	
	TB-2	2 ea	#4	7'11"	5'11"	10.58 lbs	D=3"	

SLOPED TOP UNIT SCHEDULE:


MARK No.	QNTY	STEM	WIDTH	H1	H2	H-1 BAR	V-2 BAR	V-3 BAR	V-4 BAR	V-5 BAR	V-6 BAR	V-7 BAR	VOL	WEIGHT	AREA
SP10	1 ea	6'4 1/2"	4'11 1/4"	2'4"	4'0 3/4"	5 ea	2'1 1/4"	2'5 3/8"	2'9 1/2"	2'11 5/8"	3'3 3/4"	3'6 3/8"	0.53 cy	2,155 lbs	15.81 sf
SP13	1 ea	6'4 1/2"	4'11 1/4"	4'3 3/8"	6'1"	7 ea	4'0 1/2"	4'4 7/8"	4'9 1/4"	4'11 3/8"	5'3 3/4"	5'6 3/8"	0.71 cy	2,887 lbs	25.58 sf

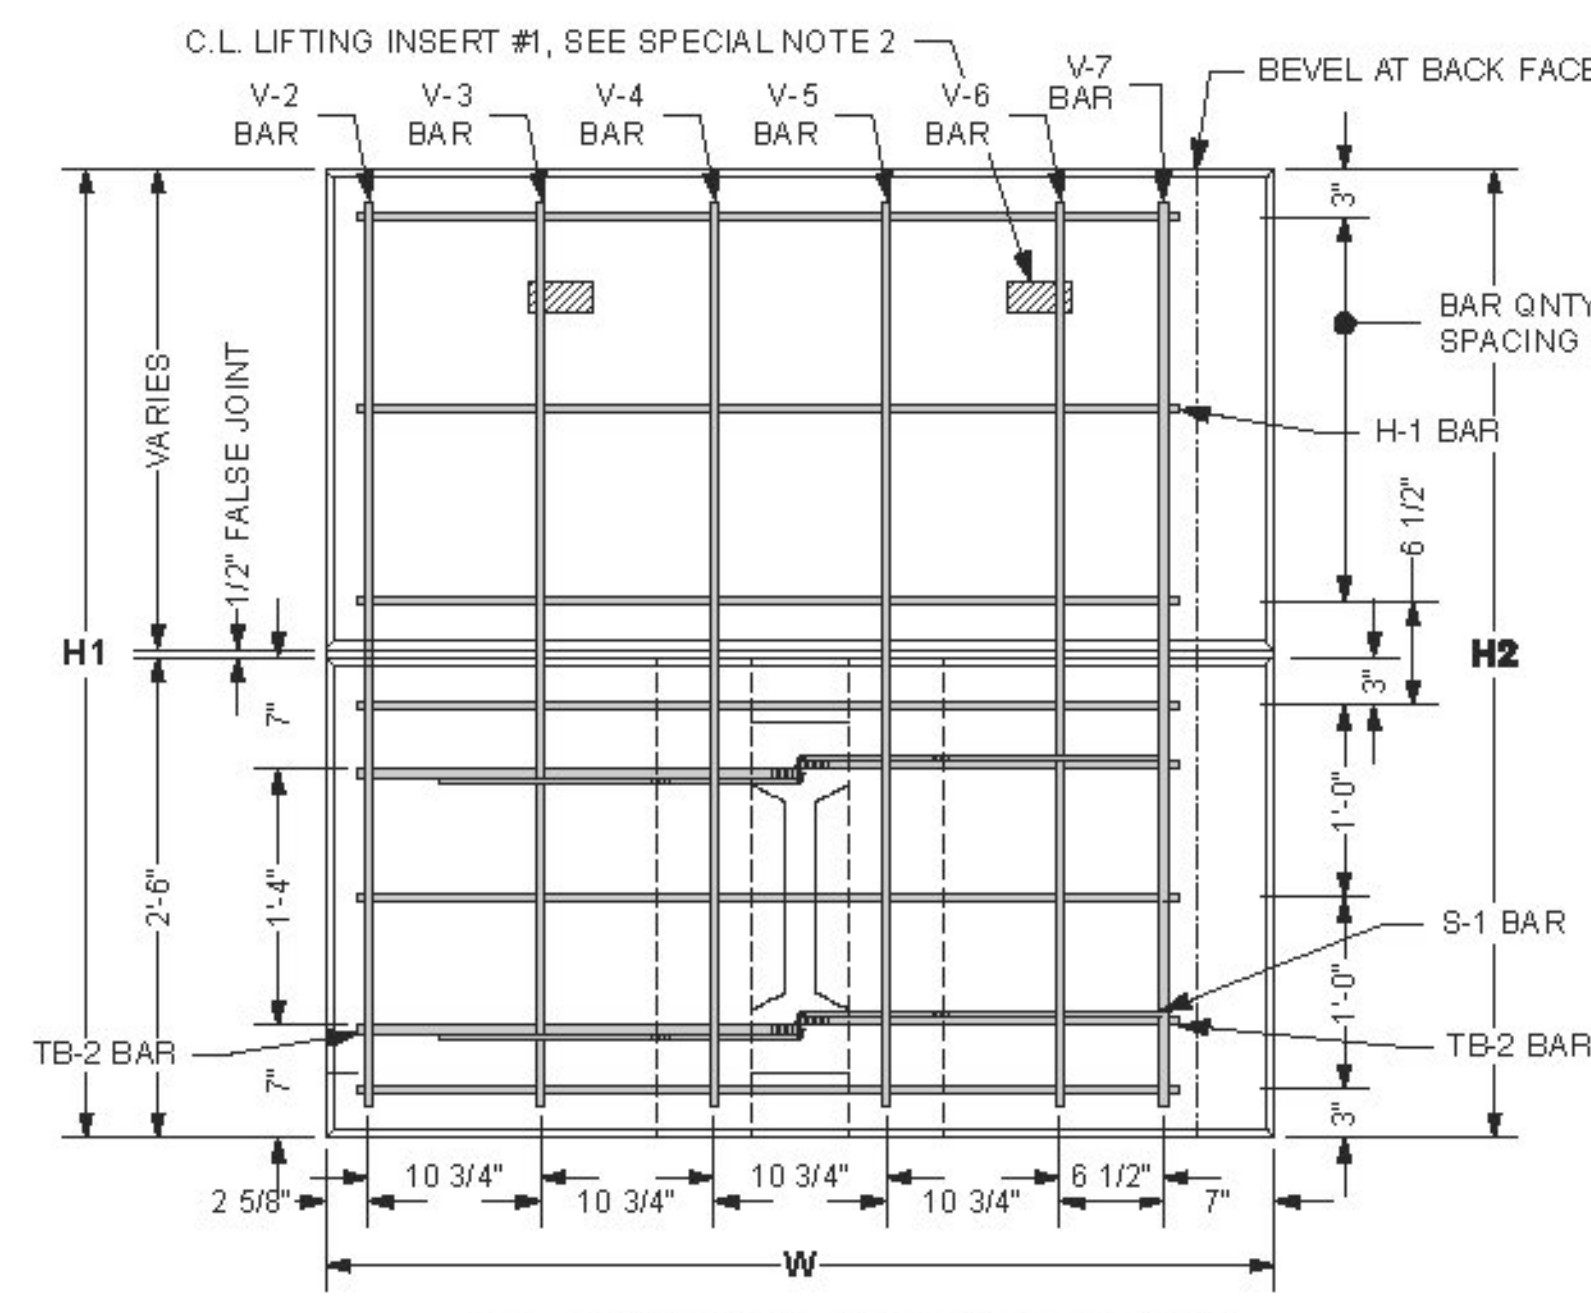


3 FRONT VIEW - 6' STEM UNIT SHOWN
Scale: 1" = 1'-0" (V-1 BARS IN STEM OMITTED FOR CLARITY)

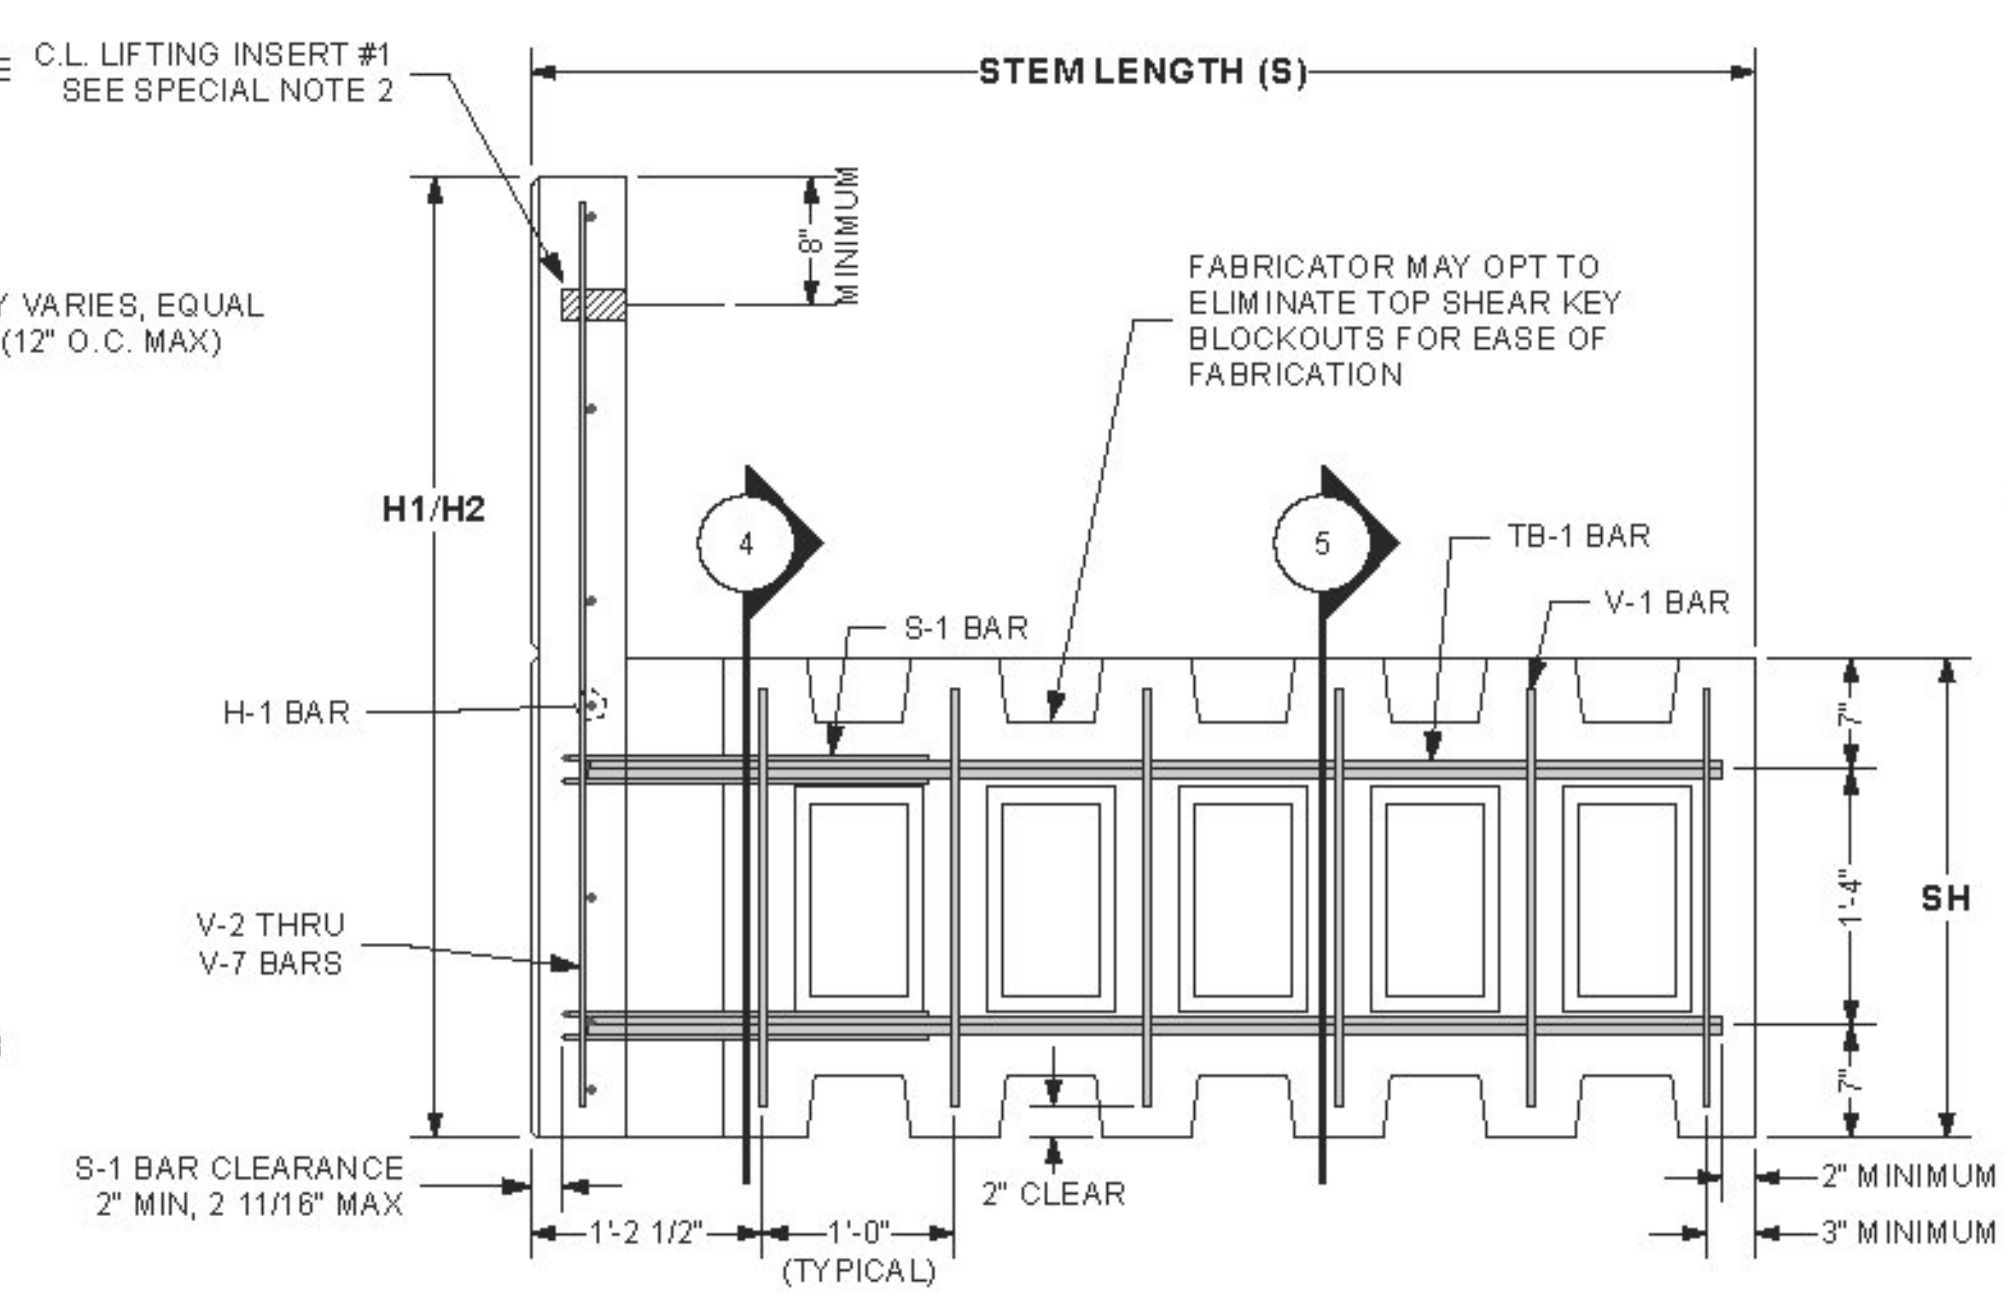


2 SIDE VIEW - 6' STEM UNIT SHOWN
Scale: 1" = 1'-0"

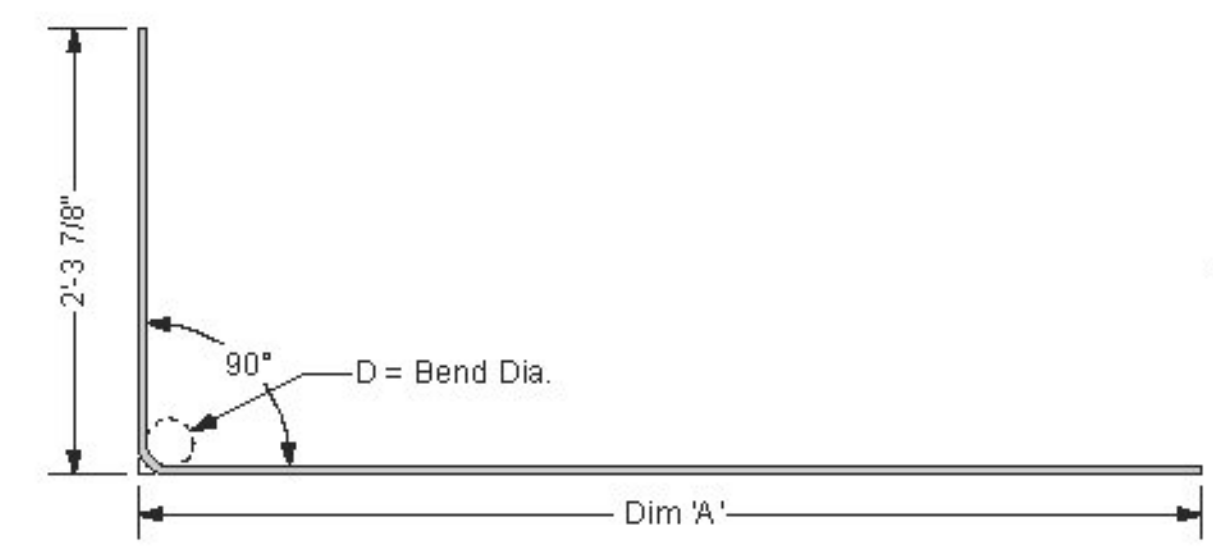


7 TB-1 REBAR
Scale: 1" = 1'-0"

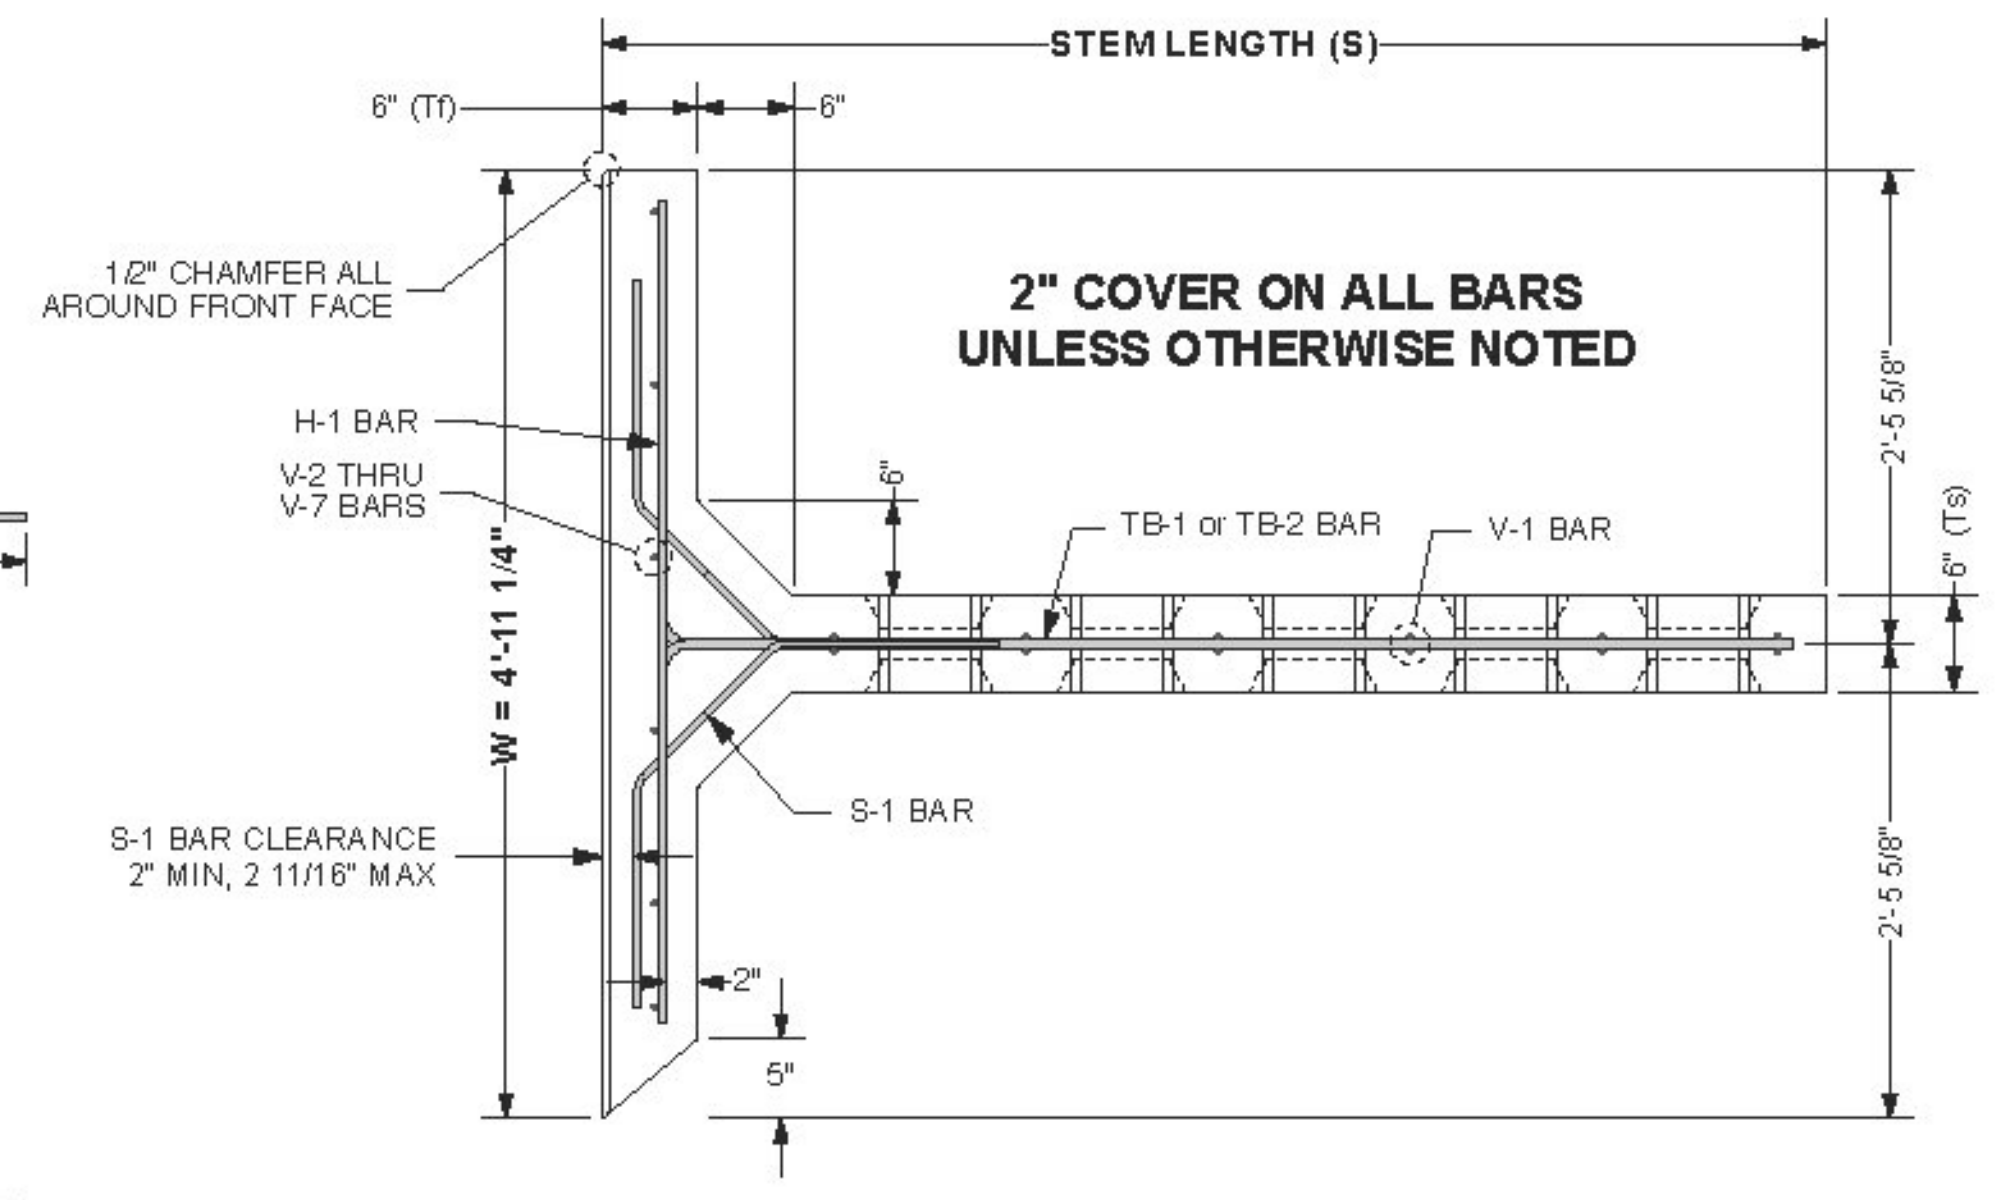


1 PLAN VIEW - 6' STEM UNIT SHOWN
Scale: 1" = 1'-0"

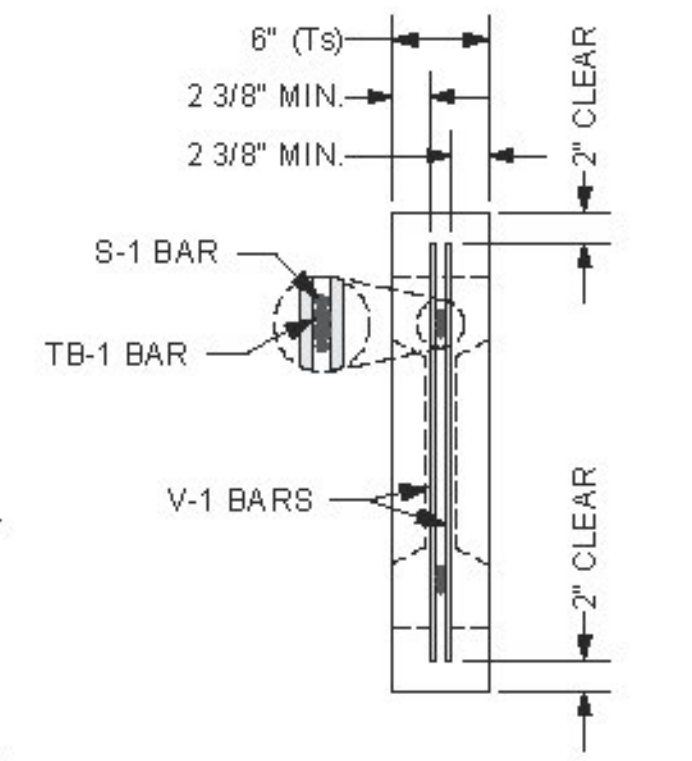

4 SECTION AT STEM
Scale: 1" = 1'-0"

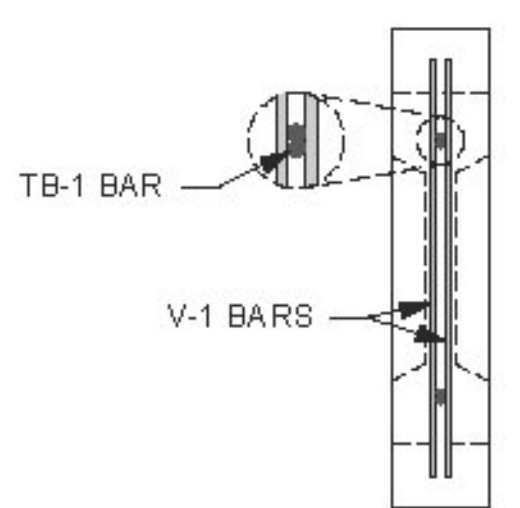

5 SECTION AT STEM
Scale: 1" = 1'-0"

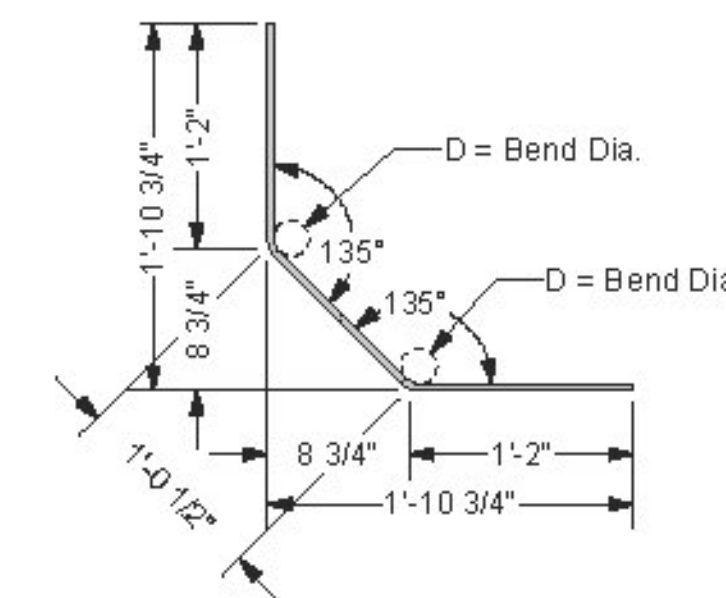

6 S-1 REBAR
Scale: 1" = 1'-0"



The design contained on these drawings is based upon information provided by the owner. On the basis of this information, The Neel Company has designed, and is responsible for, the internal stability of the structure only. External stability, including foundation and slope stability, is the responsibility of the owner.


This drawing contains information proprietary to The Neel Company. T-WALL@ is a registered trademark owned by The Neel Company. ©2014 The Neel Company

PRECASTER: CONCRETE SYSTEMS, INC. CSI
PROJECT #: T21882

CONTRACTOR: AL. ST. ONGE CONTRACTORS
PROJECT #:

DESIGNER
THE NEEL COMPANY
8328-D TRAFORD LANE
SPRINGFIELD, VIRGINIA 22152
PH: (703) 913-7858
FX: (703) 913-7859
WEB: WWW.NEELCO.COM

PROJECT #: TW4301

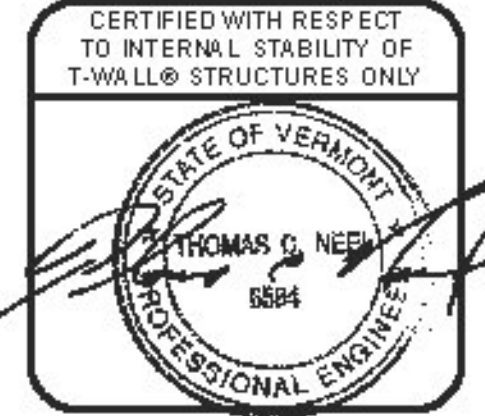

REVISIONS

NO.	REVISION COMMENTS	DATE
1	REVIEWER COMMENTS	8/8/14

McFarland Johnson

RIGIDIFIED TUBE FRP ARCH (RTFA) PROJECT
FAIRFIELD, VT

By: T. Traver
Date: 8/8/2014

SHOP DRAWINGS
NARROW SLOPED TOP RIGHT BEVELED UNITS
REBAR AND DIMENSIONS
T-WALL@ RETAINING WALL SYSTEM

SCALE: AS NOTED
DATE: 4/21/14
DESIGNED BY: KD
DRAWN BY: ABC
CHECKED BY: CCG
SHEET: 10

X Approved
Rejected

Approved As Noted

This review is only for general conformance with the design concept and the information given in the Construction Documents. Corrections or comments made on the shop drawings during the review do not relieve the Contractor from compliance with the requirements of the Plans and Specifications. Review of a specific item shall not include review of an assembly of which an item is a component. The Contractor is responsible for dimensions to be confirmed and corrected at the job site; information that pertains solely to the fabrication process or to the means, methods, techniques, sequences and procedures of construction; coordination of the Work with that of other trades and performing all Work in a safe and satisfactory manner.

REBAR SCHEDULES

Table with 8 columns: Unit Dims, Bar Mark, Qty, Size, Length, Dim "A", Bar Weight, Bend Dia, Remarks. Includes sub-tables for SP22 and SP21.


T-WALL UNIT PROPERTIES

Table with 10 columns: UNIT TYPE, H, W, S, Tf, Ts, SH, VOLUME, WEIGHT. Lists properties for SP22, SP21, and SP20.


*VOLUMES AND WEIGHTS ON THIS TABLE ARE BASED ON 6" FACE THICKNESS (Tf)

Table with 8 columns: Unit Dims, Bar Mark, Qty, Size, Length, Dim "A", Bar Weight, Bend Dia, Remarks. Includes sub-tables for SP21 and SP20.


Table with 8 columns: Unit Dims, Bar Mark, Qty, Size, Length, Dim "A", Bar Weight, Bend Dia, Remarks. Includes sub-tables for SP20 and SP21.

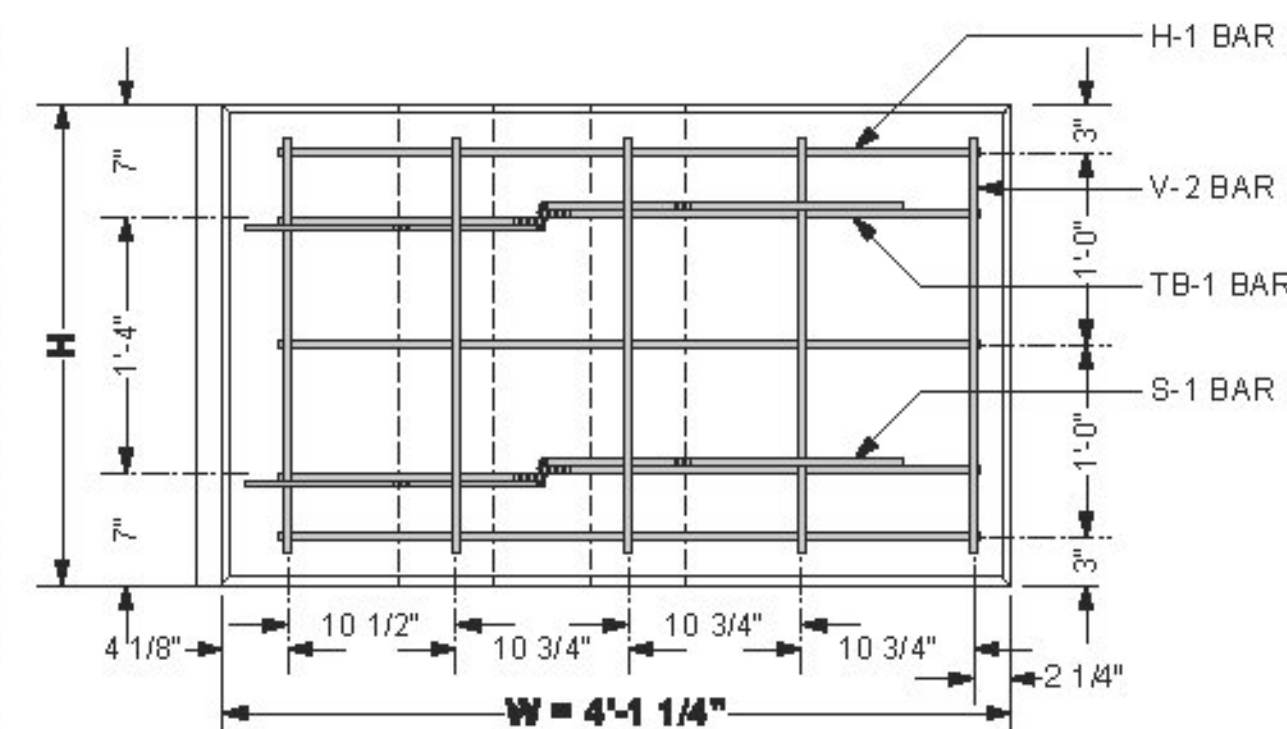


3 FRONT VIEW - 2.5 x 5.0 x 06 Std SHOWN Scale: 1" = 1'-0" (V-1 BARS IN STEM OMITTED FOR CLARITY)

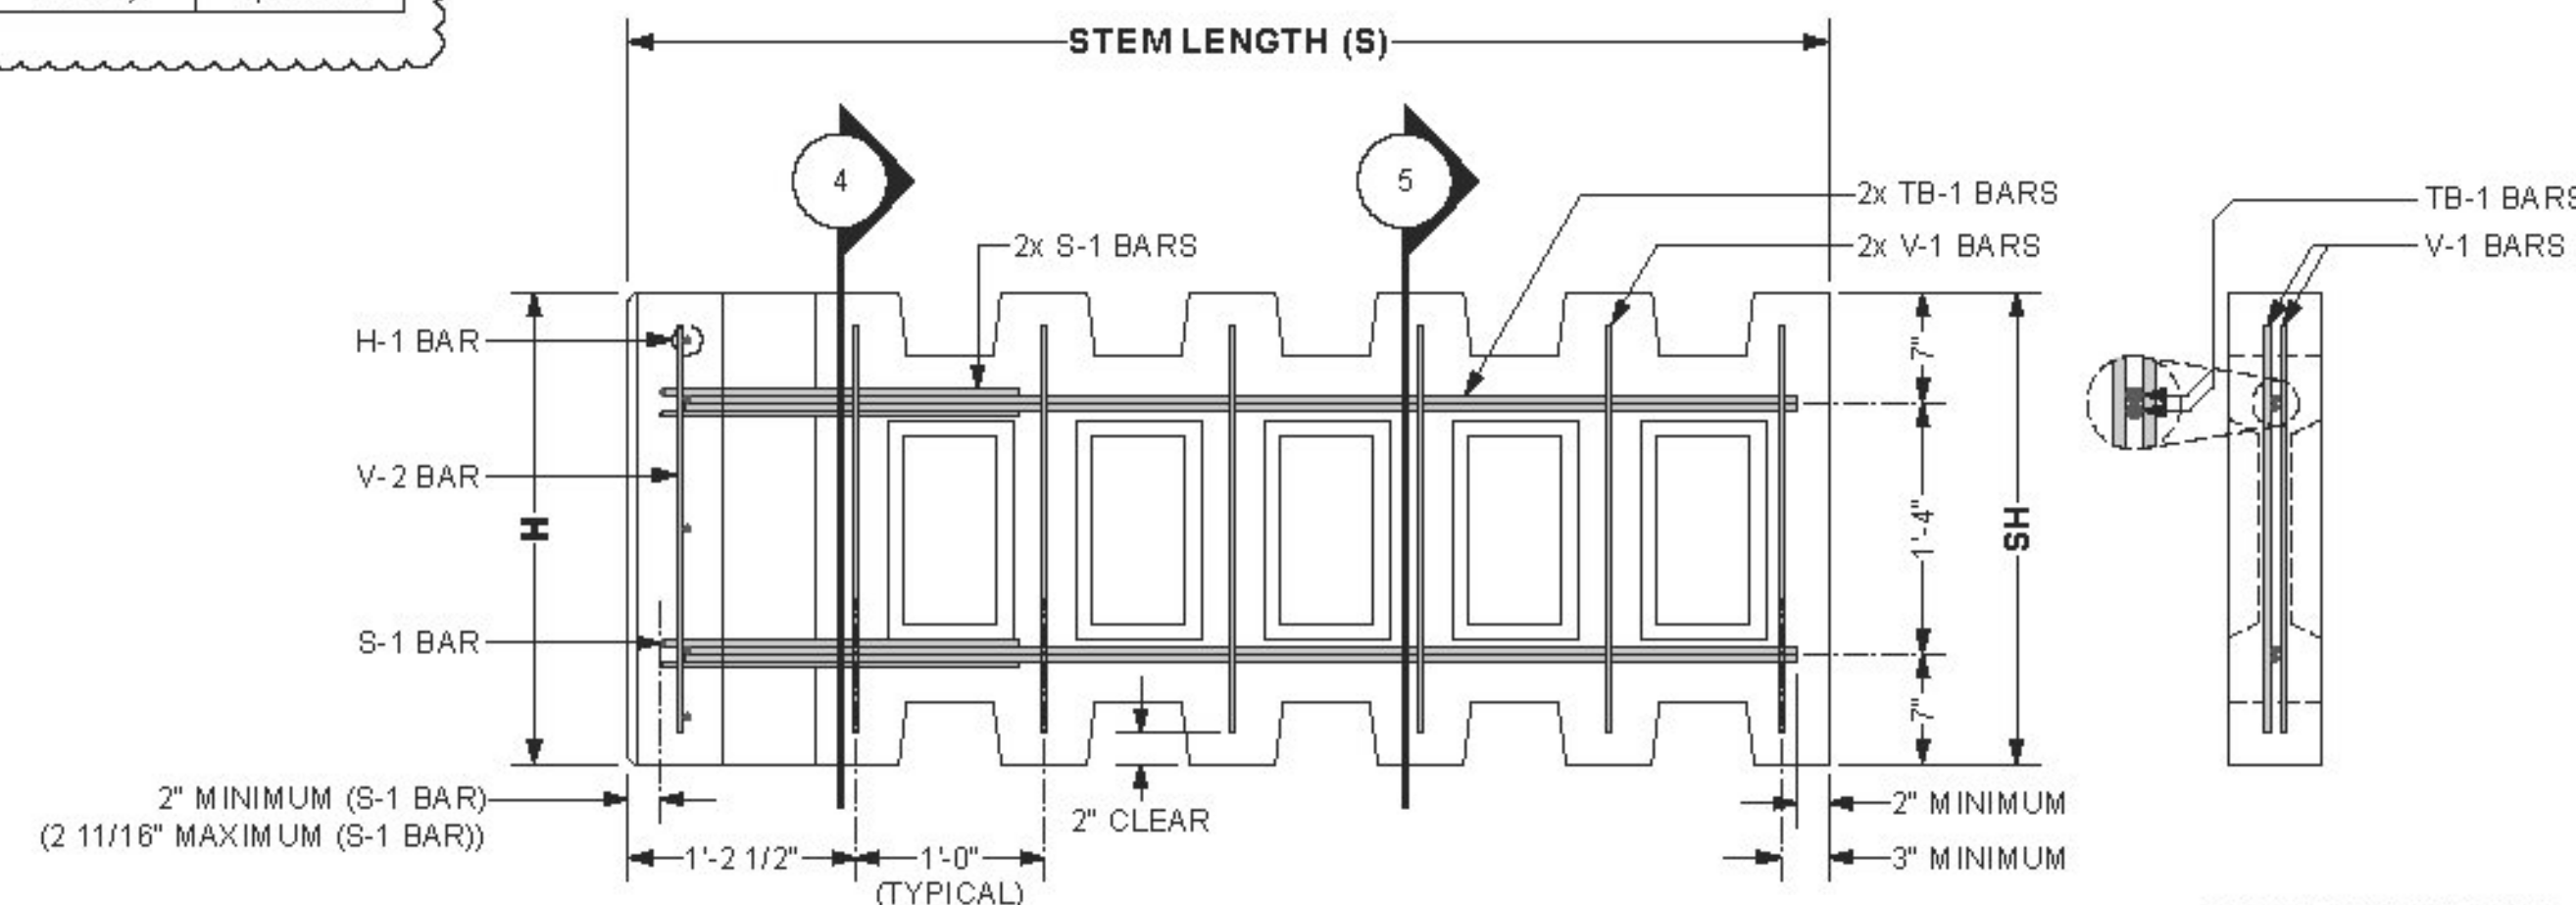


2 SIDE VIEW - 2.5 x 5.0 x 06 Std SHOWN Scale: 1" = 1'-0"

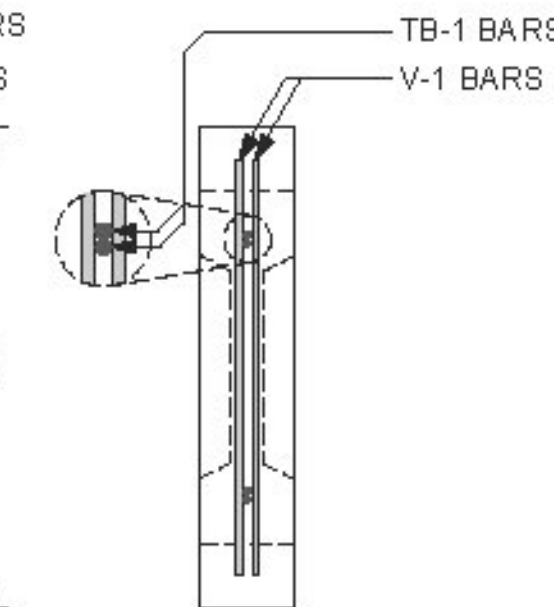

5 SECTION THROUGH STEM Scale: 1" = 1'-0"

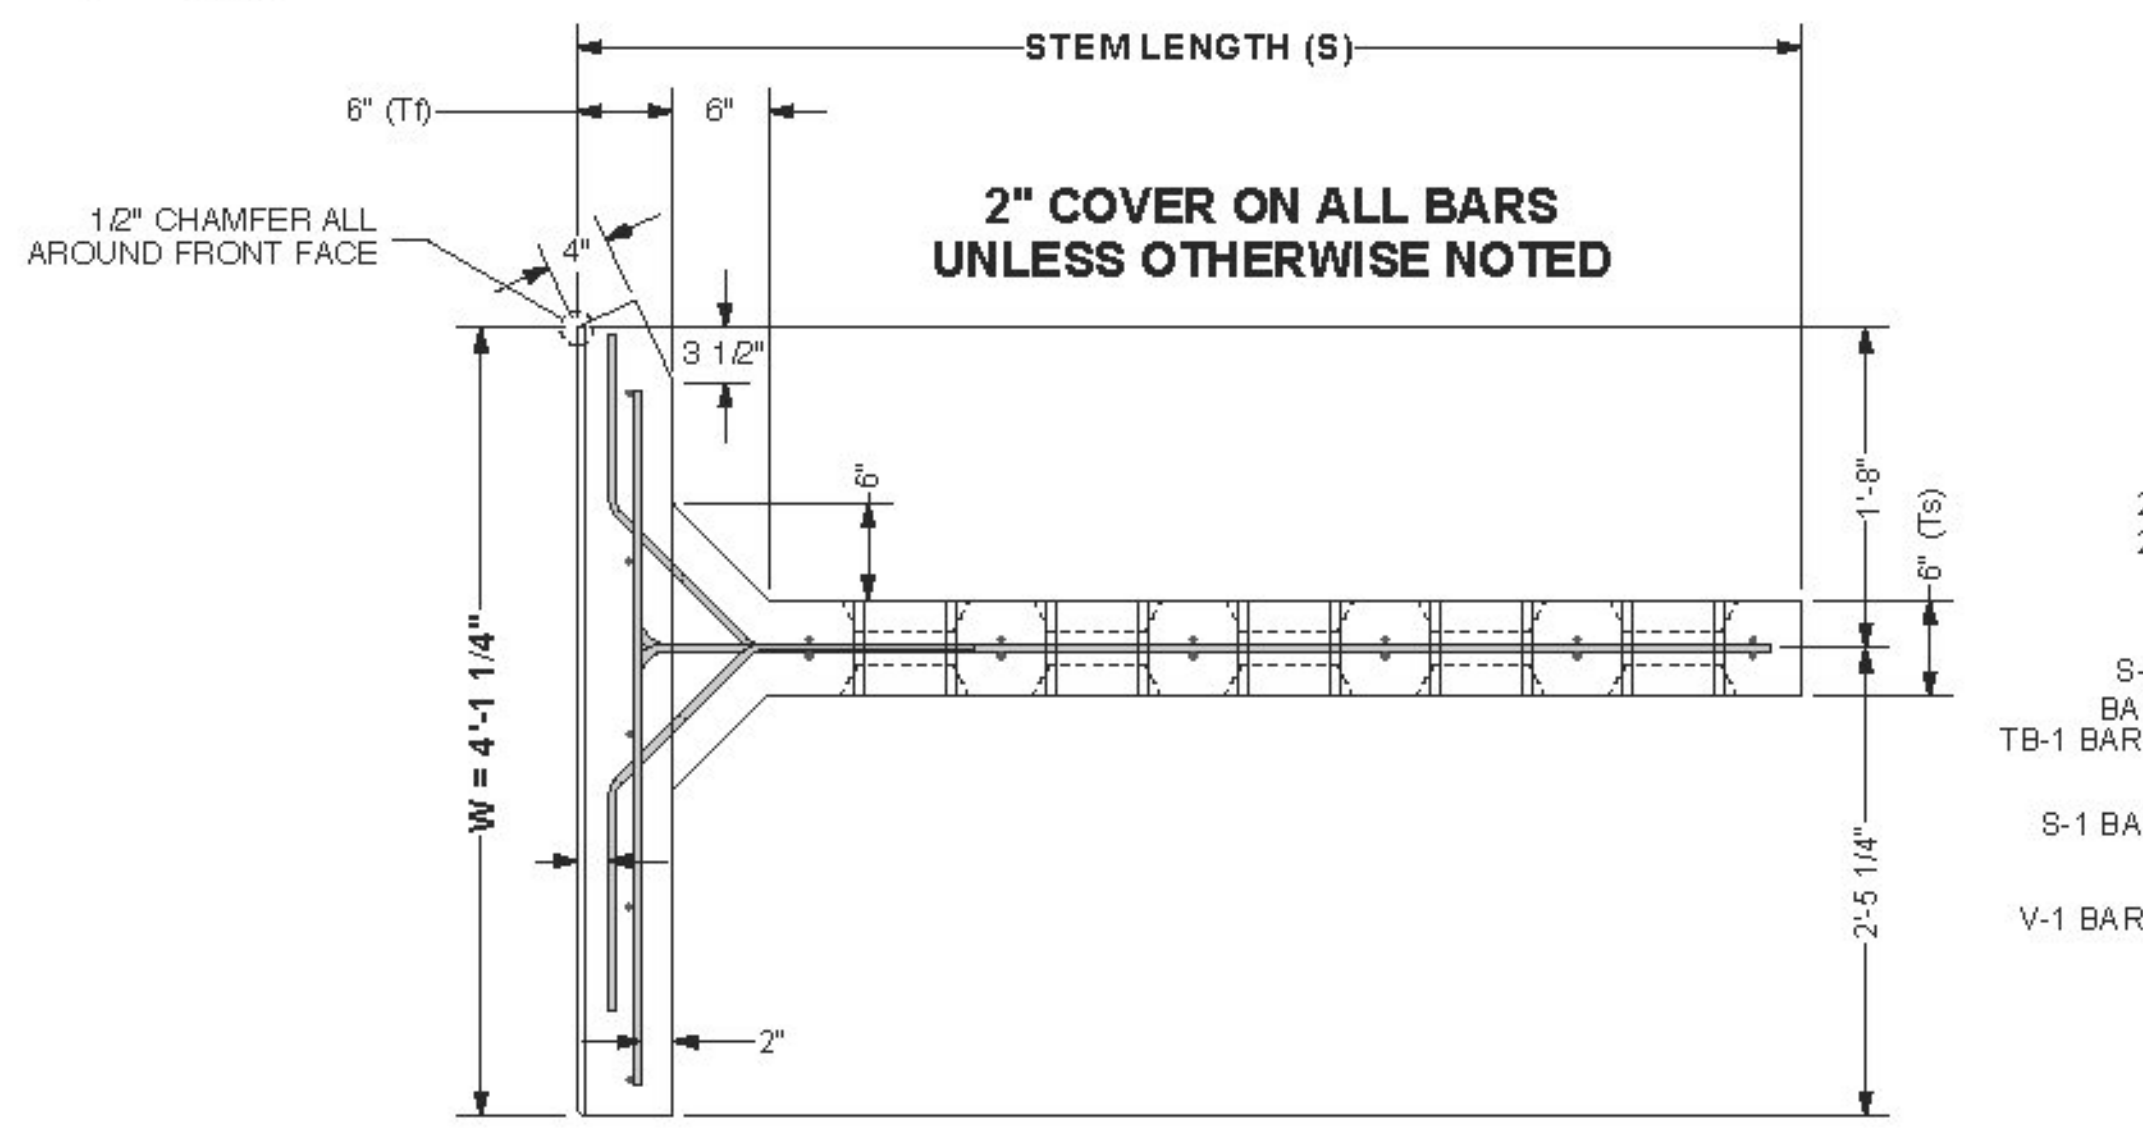

1 PLAN VIEW - 2.5 x 5.0 x 06 Std SHOWN Scale: 1" = 1'-0"

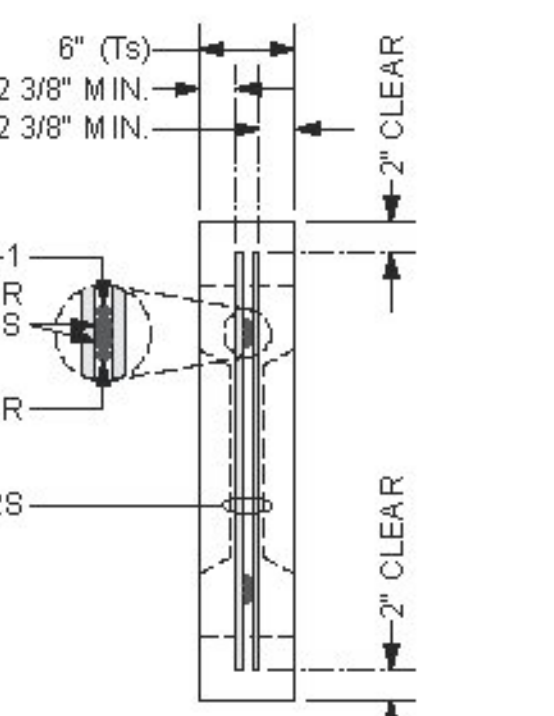

4 SECTION THROUGH STEM Scale: 1" = 1'-0"


Approval box with 'X Approved Rejected' and 'Approved As Noted' options. Includes a signature line for T. Traver dated 8/8/2014 and the McFarland Johnson logo.

SPECIAL NOTES:


- 1. FRONT FACE OF T-WALL@ UNITS FINISH TREATMENT: PLAIN STEEL FORM FINISH

GENERAL NOTES:


- 1. PRIMARY REFERENCE: AASHTO, LRFD BRIDGE DESIGN SPECIFICATION, 5TH EDITION 2010 (WITH INTERIMS)
2. T-WALL@ CONCRETE: F'c = 5000 psi (MINIMUM) @ 28 DAYS; MINIMUM STRIPPING STRENGTH
3. T-WALL@ REINFORCING STEEL: BLACK; Fy = 60 ksi (GRADE 60); WELDING IS NOT PERMITTED
4. MARKING OF PRECAST UNITS: CLEARLY MARK EACH PRECAST UNIT ON THE SHIRT END OF THE STEM WITH THE UNIT TYPE (i.e. 2.5x5.0x06 STD), THE DATE OF MANUFACTURE, THE LOT NUMBER (IF APPLICABLE), AND THE TRADEMARK "T-WALL@".
5. REINFORCING FABRICATION AND PLACEMENT TOLERANCES: THE STRUCTURAL DESIGN OF PRECAST UNITS ASSUMES 2 INCHES OF CONCRETE COVER OVER ALL REINFORCING BARS. UNLESS OTHERWISE NOTED IN CONTRACT DOCUMENTS OR REFERENCED SPECIFICATIONS, TOLERANCES ON CONCRETE COVER SHALL BE ± 3/8 INCHES. UNLESS OTHERWISE NOTED IN CONTRACT DOCUMENTS OR REFERENCED SPECIFICATIONS, TOLERANCES ON BAR PLACEMENT SHALL BE: VERTICAL LOCATION OF TB-1 BARS: ± 3/8 INCHES; LOCATION / SPACING OF H-1, V-1 & V-2 BARS: ± 1 INCH. REGARDLESS OF THE SPECIFIED PLACEMENT TOLERANCES, CONCRETE COVER SHALL BE MAINTAINED WITHIN ± 3/8 INCHES AS PREVIOUSLY NOTED. ALL REINFORCING BARS SHALL BE CUT AND BENT FOLLOWING REQUIREMENTS OF THE CRSI MANUAL OF STANDARD PRACTICE. UNLESS NOTED OTHERWISE, TOLERANCES FOR BAR FABRICATION SHALL MEET REQUIREMENTS OF STANDARD ACI 318 AND THE CRSI MANUAL OF STANDARD PRACTICE.

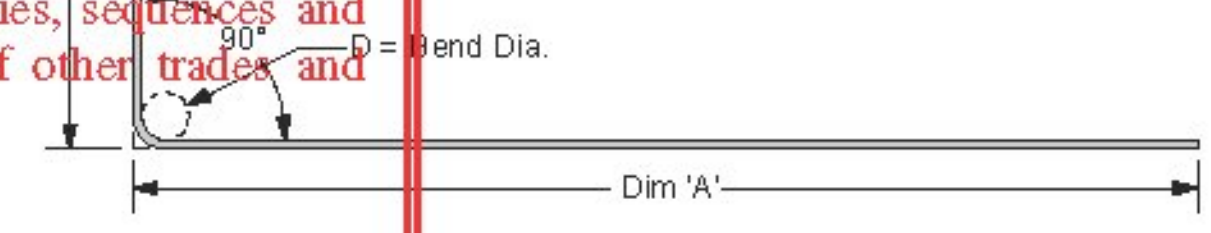


7 TB-1 REBAR Scale: 1" = 1'-0"

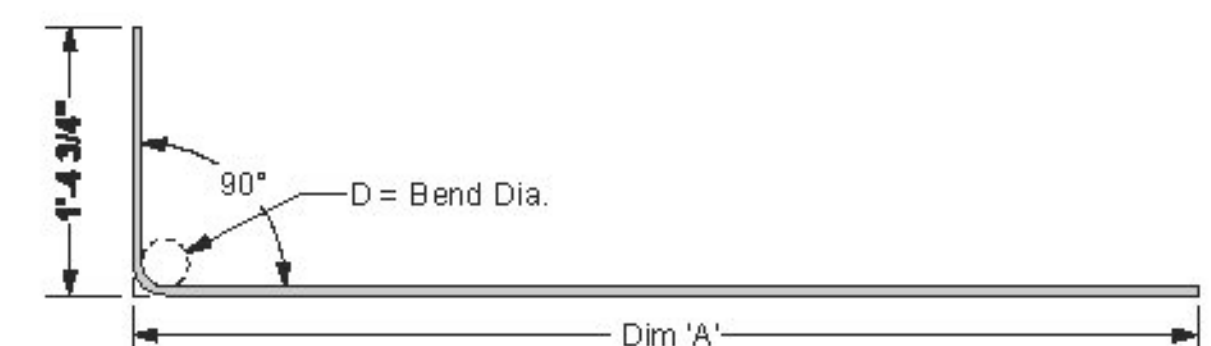

8 TB-2 REBAR Scale: 1" = 1'-0"

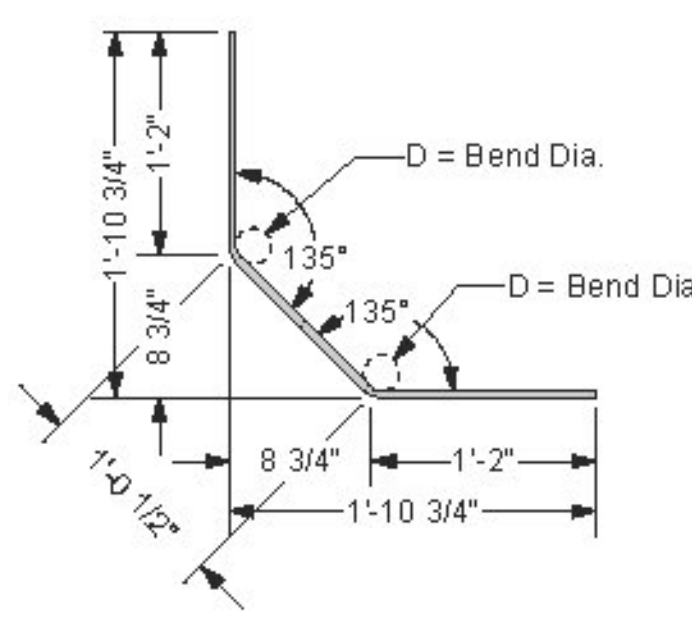

6 S-1 REBAR Scale: 1" = 1'-0"

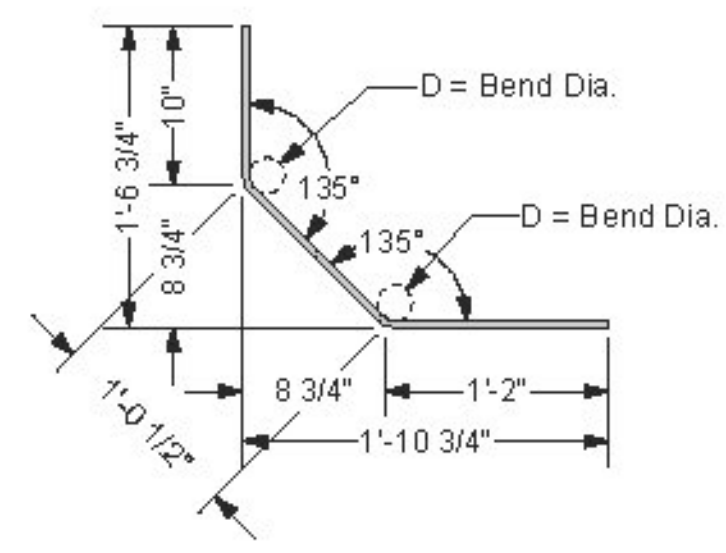


9 S-2 REBAR Scale: 1" = 1'-0"



The design contained on these drawings is based upon information provided by the owner. On the basis of this information, The Neel Company has designed, and is responsible for, the internal stability of the structure only. External stability, including foundation and slope stability, is the responsibility of the owner.

PRECASTER: CONCRETE SYSTEMS, INC. CSI
PROJECT #: T21882
CONTRACTOR: AL ST. ONGE CONTRACTORS
PROJECT #:

DESIGNER: THE NEEL COMPANY
8328-D TRAFORD LANE
SPRINGFIELD, VIRGINIA 22152
PH: (703) 913-7858
FX: (703) 913-7859
WEB: WWW.NEELCO.COM
PROJECT # TW4301

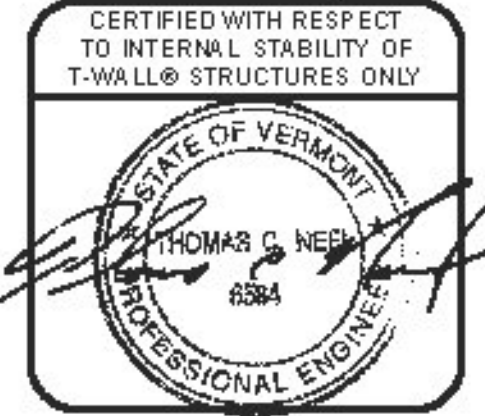

REVISIONS table with columns for REVIEWER COMMENTS, ABC, and 8-6-14.

RIGIDIFIED TUBE FRP ARCH (RTFA) PROJECT
FAIRFIELD, VT
SHOP DRAWINGS
NARROW LEFT BEVELED UNITS
REBAR AND DIMENSIONS
T-WALL@ RETAINING WALL SYSTEM

Table with columns for SCALE, DATE, DESIGNED BY, DRAWN BY, CHECKED BY, SHEET.

T-WALL UNIT PROPERTIES

UNIT TYPE	H	W	S	Tf*	Ts	SH	VOLUME*	WEIGHT*
SP24	2'6"	4'11 1/4"	6'4 1/2"	6"	6"	2'6"	0.45 cy	1,815 lbs
SP23	2'6"	4'11 1/4"	8'4 1/2"	6"	6"	2'6"	0.51 cy	2,076 lbs

*VOLUMES AND WEIGHTS ON THIS TABLE ARE BASED ON 6" FACE THICKNESS (Tf)

REBAR SCHEDULES

SP24								HIGHWAY REBAR	
Unit Dims	Bar Mark	Qty	Size	Length	Dim "A"	Bar Weight	Bend Dia	Remarks	
H=2'6"	H-1	3 ea	#4	4'3 3/8"		8.57 lbs			
W=4'11 1/4"	V-1	12 ea	#4	2'2"		17.37 lbs			
S=6'4 1/2"	V-2	3 ea	#4	2'2"		4.34 lbs			
SH=2'6"	S-1	4 ea	#4	3'4 1/2"		9.02 lbs	D= 3"		
	TB-1	2 ea	#4	8'2 7/8"	5'11"	11.01 lbs	D= 3"		
	TB-2	2 ea	#4	7'11"	5'11"	10.58 lbs	D= 3"		
						52.31 lbs			


SP23								HIGHWAY REBAR	
Unit Dims	Bar Mark	Qty	Size	Length	Dim "A"	Bar Weight	Bend Dia	Remarks	
H=2'6"	H-1	3 ea	#4	4'3 3/8"		8.57 lbs			
W=4'11 1/4"	V-1	16 ea	#4	2'2"		23.16 lbs			
S=8'4 1/2"	V-2	3 ea	#4	2'2"		4.34 lbs			
SH=2'6"	S-1	4 ea	#4	3'4 1/2"		9.02 lbs	D= 3"		
	TB-1	2 ea	#4	10'2 7/8"	7'11"	13.68 lbs	D= 3"		
	TB-2	2 ea	#4	9'11"	7'11"	13.25 lbs	D= 3"		
						63.45 lbs			

SPECIAL NOTES:

- FRONT FACE OF T-WALL@ UNITS FINISH TREATMENT:
 - PLAIN STEEL FORM FINISH

GENERAL NOTES:


- PRIMARY REFERENCE:
 - AASHTO, LRFD BRIDGE DESIGN SPECIFICATION, 5TH EDITION 2010 (WITH INTERIMS)
- T-WALL@ CONCRETE:
 - F'c = 5000 psi (MINIMUM) @ 28 DAYS
 - MINIMUM STRIPPING STRENGTH: 2500 psi
- T-WALL@ REINFORCING STEEL:
 - BLACK
 - Fy = 60 ksi (GRADE 60)
 - WELDING IS NOT PERMITTED**
- MARKING OF PRECAST UNITS:
 - CLEARLY MARK EACH PRECAST UNIT ON THE BUTT END OF THE STEM WITH THE UNIT TYPE (i.e. 2.5x5.0x06 STD), THE DATE OF MANUFACTURE, THE LOT NUMBER (IF APPLICABLE), AND THE TRADEMARK "T-WALL@".
- REINFORCING FABRICATION AND PLACEMENT TOLERANCES:
 - THE STRUCTURAL DESIGN OF PRECAST UNITS ASSUMES 2 INCHES OF CONCRETE COVER OVER ALL REINFORCING BARS.
 - UNLESS OTHERWISE NOTED IN CONTRACT DOCUMENTS OR REFERENCED SPECIFICATIONS, TOLERANCES ON CONCRETE COVER SHALL BE ± 3/8 INCHES.
 - UNLESS OTHERWISE NOTED IN CONTRACT DOCUMENTS OR REFERENCED SPECIFICATIONS, TOLERANCES ON BAR PLACEMENT SHALL BE:
 - VERTICAL LOCATION OF TB-1 BARS: ± 3/8 INCHES
 - LOCATION / SPACING OF H-1, V-1 & V-2 BARS: ± 1 INCH
 - REGARDLESS OF THE SPECIFIED PLACEMENT TOLERANCES, CONCRETE COVER SHALL BE MAINTAINED WITHIN ± 3/8 INCHES AS PREVIOUSLY NOTED.
 - ALL REINFORCING BARS SHALL BE CUT AND BENT FOLLOWING REQUIREMENTS OF THE CRSI MANUAL OF STANDARD PRACTICE.
 - UNLESS NOTED OTHERWISE, TOLERANCES FOR BAR FABRICATION SHALL MEET REQUIREMENTS OF STANDARD ACI 318 AND THE CRSI MANUAL OF STANDARD PRACTICE.

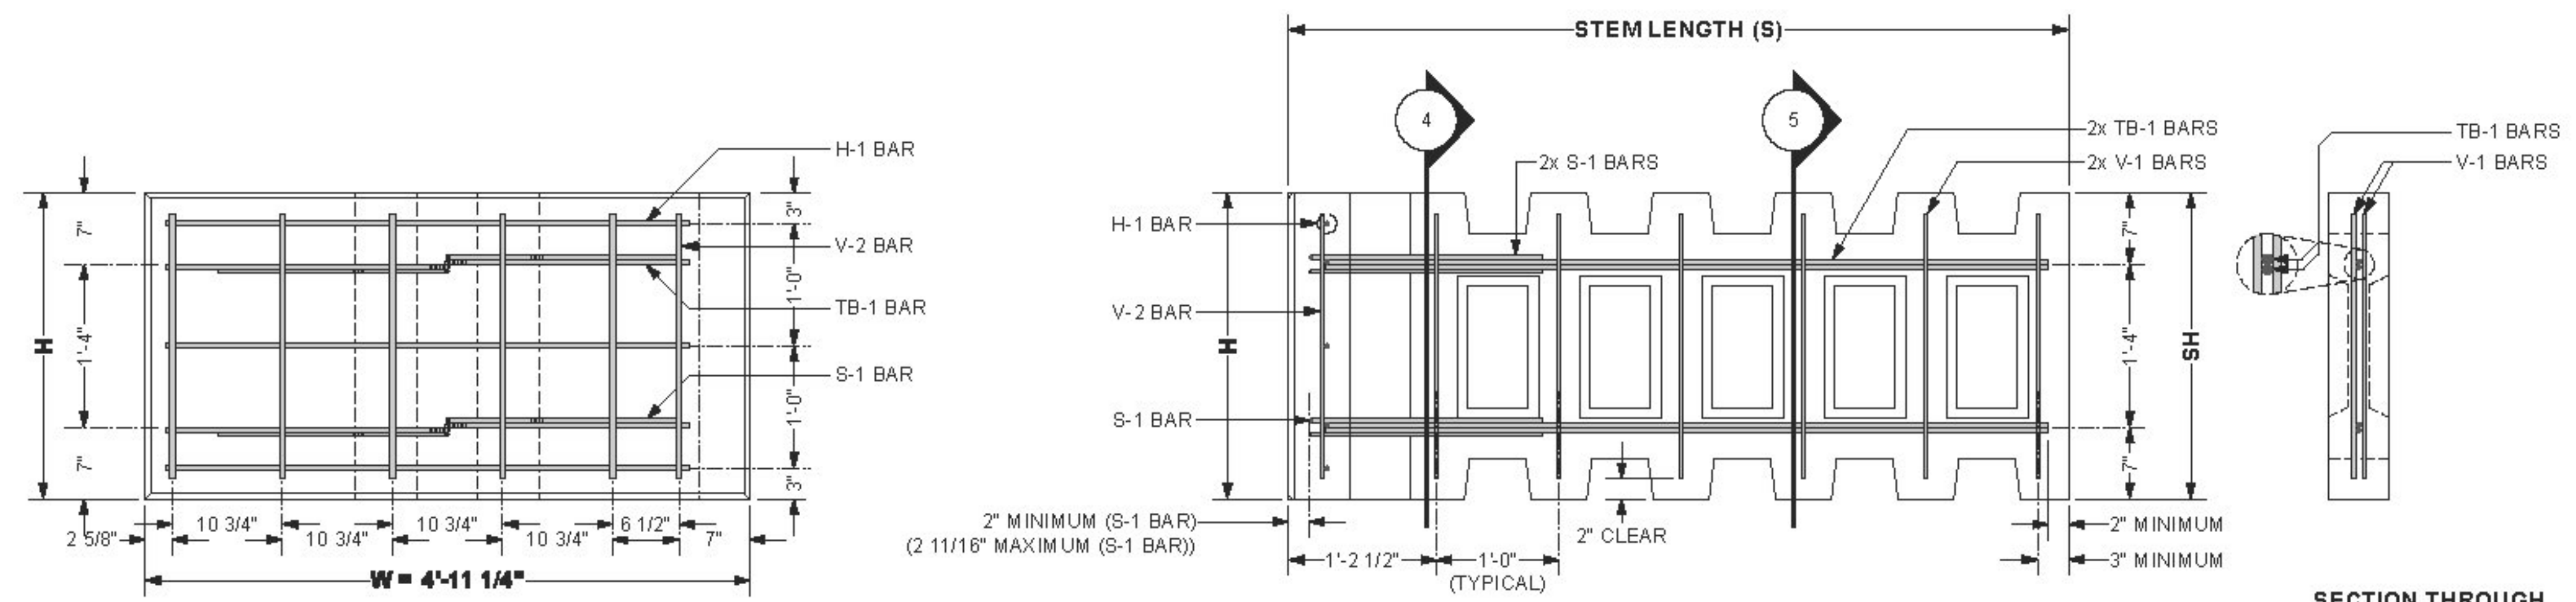


3 FRONT VIEW - 2.5 x 5.0 x 06 Std SHOWN
Scale: 1" = 1'-0"
(V-1 BARS IN STEM OMITTED FOR CLARITY)

2 SIDE VIEW - 2.5 x 5.0 x 06 Std SHOWN
Scale: 1" = 1'-0"


5 SECTION THROUGH STEM
Scale: 1" = 1'-0"

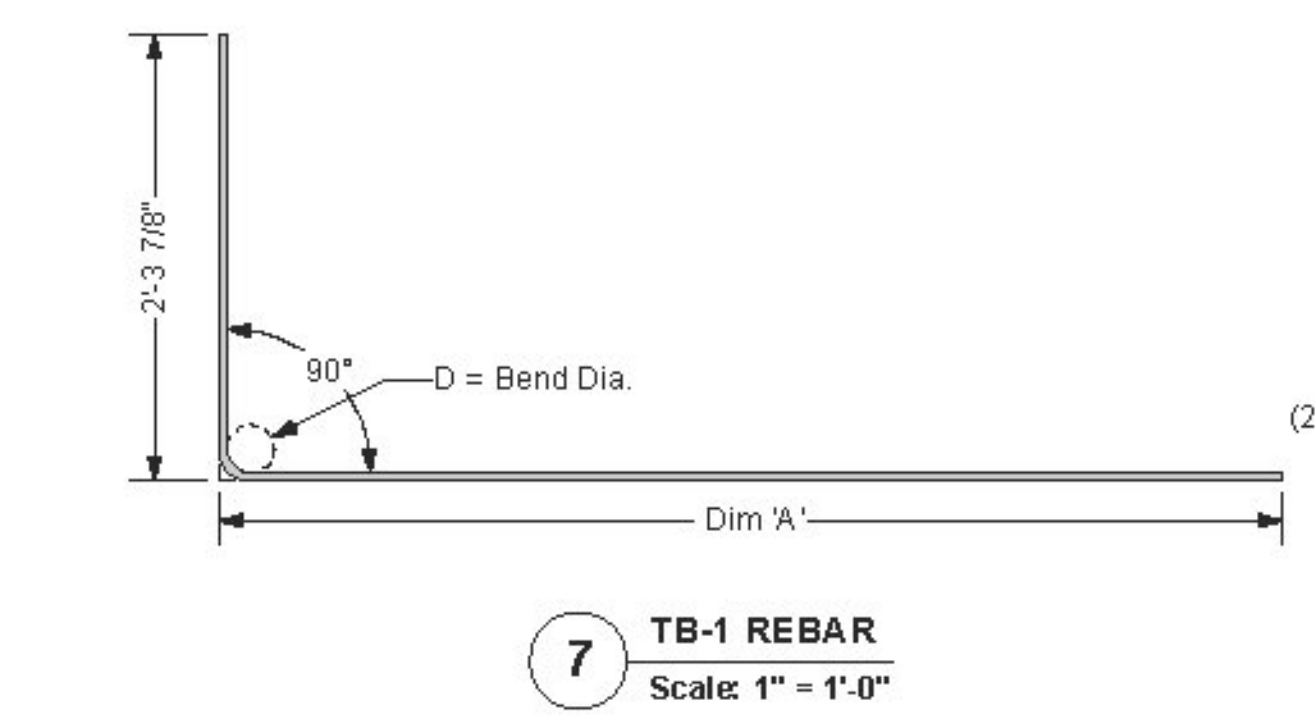

7 TB-1 REBAR
Scale: 1" = 1'-0"

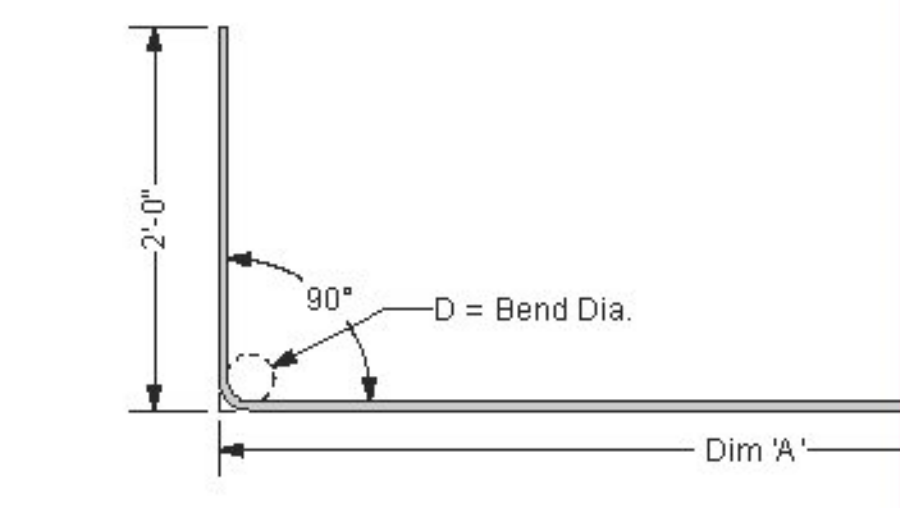


8 TB-2 REBAR
Scale: 1" = 1'-0"

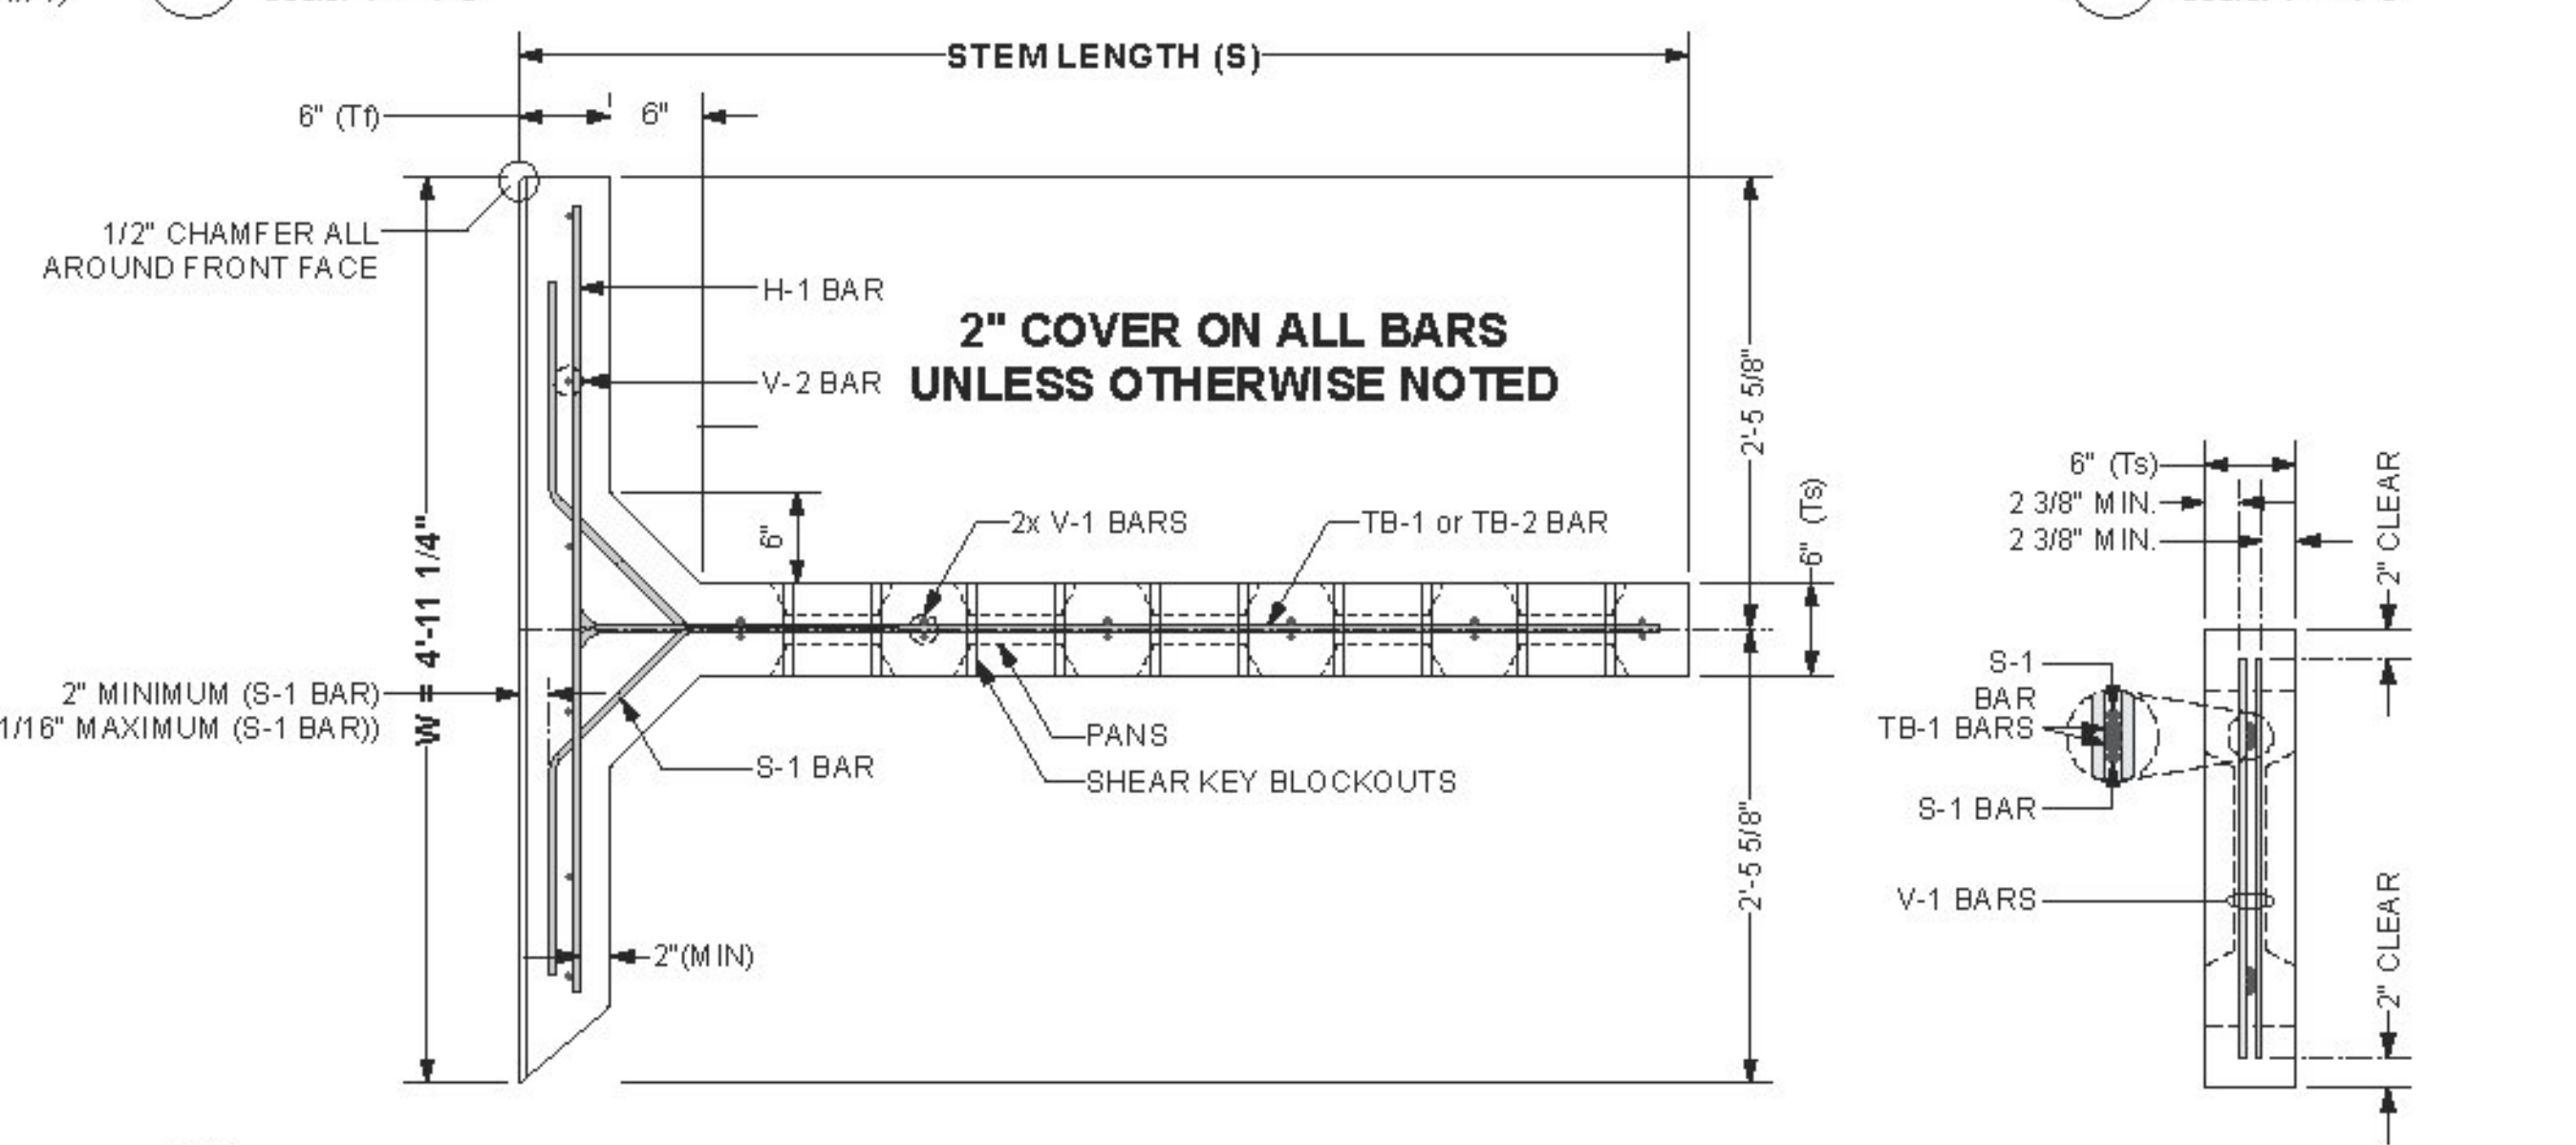

1 PLAN VIEW - 2.5 x 5.0 x 06 Std SHOWN
Scale: 1" = 1'-0"

4 SECTION THROUGH STEM
Scale: 1" = 1'-0"

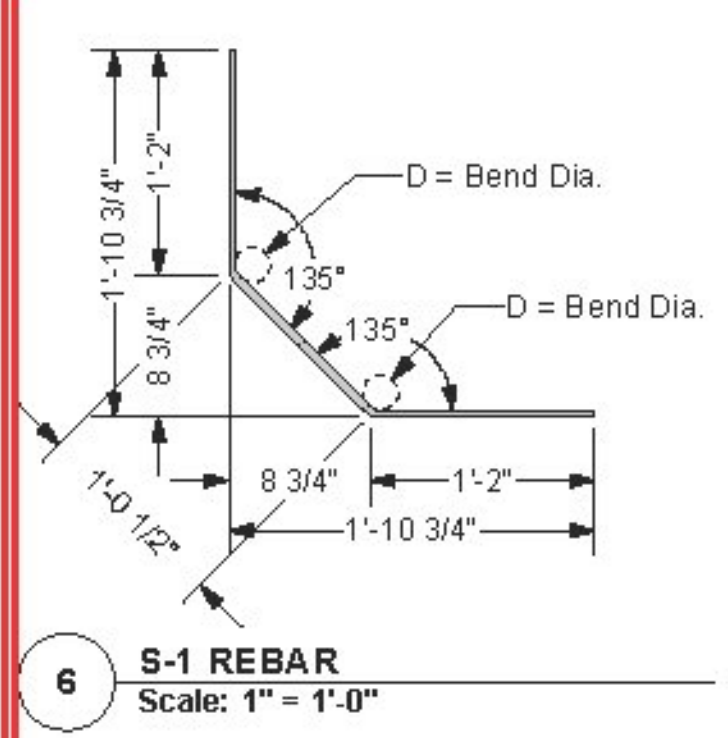

6 S-1 REBAR
Scale: 1" = 1'-0"

X Approved
Rejected

Approved As Noted

This review is only for general conformance with the design concept and the information given in the Construction Documents. Corrections or comments made on the shop drawings during the review do not relieve the Contractor from compliance with the requirements of the Plans and Specifications. Review of a specific item shall not include review of an assembly of which an item is a component. The Contractor is responsible for dimensions to be confirmed and corrected at the job site; information that pertains solely to the fabrication process or to the means, methods, techniques, sequences and procedures of construction; coordination of the Work with that of other trades and performing all Work in a safe and satisfactory manner.


Date 8/8/2014

By T. Traver

McFarland Johnson

CERTIFIED WITH R TO INTERNAL STATE T-WALL@ STRU

PROFESSIONAL ENGINEER

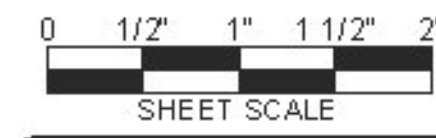

The design contained on these drawings is based upon information provided by the owner. On the basis of this information, The Neel Company has designed, and is responsible for, the internal stability of the structure only. External stability, including foundation and slope stability, is the responsibility of the owner.

This drawing contains information proprietary to The Neel Company. T-WALL@ is a registered trademark owned by The Neel Company. ©2014 The Neel Company

PRECASTER: CONCRETE SYSTEMS, INC. CSI
PROJECT #: T21882

CONTRACTOR: AL. ST. ONGE CONTRACTORS
PROJECT #:

DESIGNER
THE NEEL COMPANY
8328-D TRAFORD LANE
SPRINGFIELD, VIRGINIA 22152
PH: (703) 913-7858
FX: (703) 913-7859
WEB: WWW.NEELCO.COM

PROJECT # TW4301

McFarland Johnson

By T. Traver

RIGIDIFIED TUBE FRP ARCH (RTFA) PROJECT

FAIRFIELD, VT


SHOP DRAWINGS
NARROW RIGHT BEVELED UNITS
REBAR AND DIMENSIONS
T-WALL@ RETAINING WALL SYSTEM

SCALE: AS NOTED
DATE: 4/21/14
DESIGNED BY: KD
DRAWN BY: ABC
CHECKED BY: CCG
SHEET: 12

RIGIDIFIED TUBE FRP ARCH (RTFA) PROJECT

FAIRFIELD, VT

FABRICATION DRAWINGS **T-WALL®** RETAINING WALL SYSTEM

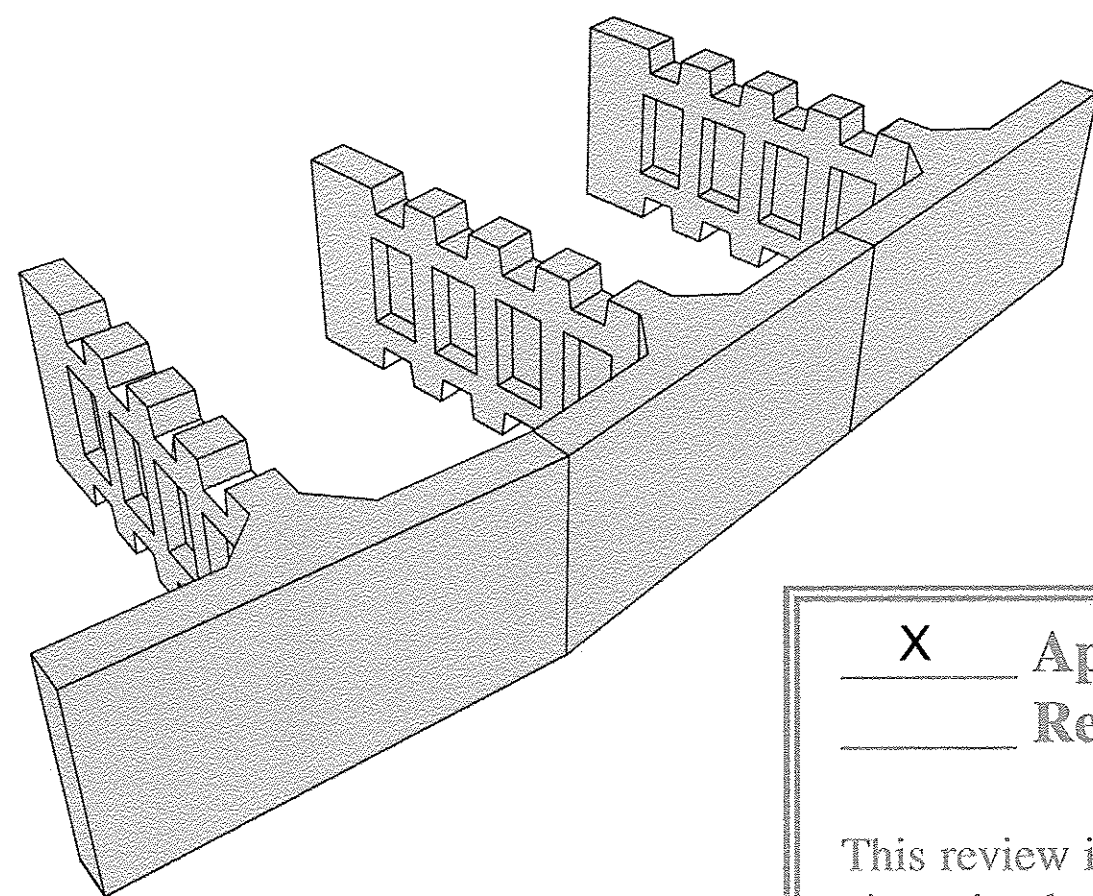

Approved
 Rejected

_____ Approved As Noted


This review is only for general conformance with the design concept and the information given in the Construction Documents. Corrections or comments made on the shop drawings during the review do not relieve the Contractor from compliance with the requirements of the Plans and Specifications. Review of a specific item shall not include review of an assembly of which an item is a component. The Contractor is responsible for dimensions to be confirmed and corrected at the job site; information that pertains solely to the fabrication process or to the means, methods, techniques, sequences and procedures of construction; coordination of the Work with that of other trades and performing all Work in a safe and satisfactory manner.

Date 8/8/2014

McFarland Johnson

By T. Traver

DESIGNER

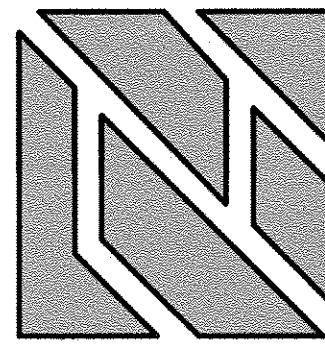

THE NEEL COMPANY
8328-D TRAFORD LANE
SPRINGFIELD, VIRGINIA 22152
PH: (703) 913-7858
FX: (703) 913-7859
WEB: WWW.NEELCO.COM

PRECASTER



Concrete Systems Inc.
9 Commercial St., Hudson, NH, 03051
Phone 603-889-4163
Fax 603-889-2417
Web www.csigroup.biz

INDEX OF DRAWINGS

SHEET	TITLE	REV	DATE
TW-FB1	COVER SHEET		8-6-14
TW-FB2	SPECIAL UNIT SP1		8-6-14
TW-FB3	SPECIAL UNIT SP2		8-6-14
TW-FB4	SPECIAL UNIT SP3		8-6-14
TW-FB5	SPECIAL UNIT SP4		8-6-14
TW-FB6	SPECIAL UNIT SP5		8-6-14
TW-FB7	SPECIAL UNIT SP6		8-6-14
TW-FB8	SPECIAL UNIT SP7		8-6-14
TW-FB9	SPECIAL UNIT SP8		8-6-14
TW-FB10	SPECIAL UNIT SP9		8-6-14
TW-FB11	SPECIAL UNIT SP10		8-6-14
TW-FB12	SPECIAL UNIT SP11		8-6-14
TW-FB13	SPECIAL UNIT SP12		8-6-14
TW-FB14	SPECIAL UNIT SP13		8-6-14
TW-FB15	SPECIAL UNIT SP14		8-6-14
TW-FB16	SPECIAL UNIT SP15		8-6-14
TW-FB17	SPECIAL UNIT SP16		8-6-14
TW-FB18	SPECIAL UNIT SP17		8-6-14
TW-FB19	SPECIAL UNIT SP18		8-6-14
TW-FB20	SPECIAL UNIT SP20		8-6-14
TW-FB21	SPECIAL UNIT SP21		8-6-14
TW-FB22	SPECIAL UNIT SP22		8-6-14
TW-FB23	SPECIAL UNIT SP23		8-6-14
TW-FB24	SPECIAL UNIT SP24		8-6-14

LEGEND

SHADED AREA INDICATES AREA OF FRONT FACE THAT EXTENDS ABOVE THE STEM

FALSE JOINT (DASHED LINE)

SPECIAL UNIT MARK

STEM LENGTH WITH STEM MARK (IN FEET)

SHADED AREA INDICATES AREA OF FRONT FACE THAT EXTENDS ABOVE THE STEM

FALSE JOINT (DASHED LINE)

HEIGHT OF TOP UNIT (IN FEET)

STEM LENGTH (IN FEET)



STEM LENGTH (IN FEET)

SPECIAL TOP T-WALL® UNIT
(FRONT FACE HEIGHT VARIES)

STANDARD TOP T-WALL® UNIT
(FRONT FACE HEIGHT VARIES)

STANDARD 2'-6" T-WALL® UNIT

TYPICAL PANEL NOTATION
NO SCALE

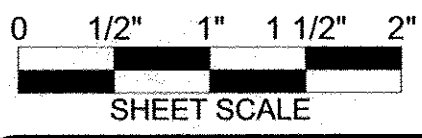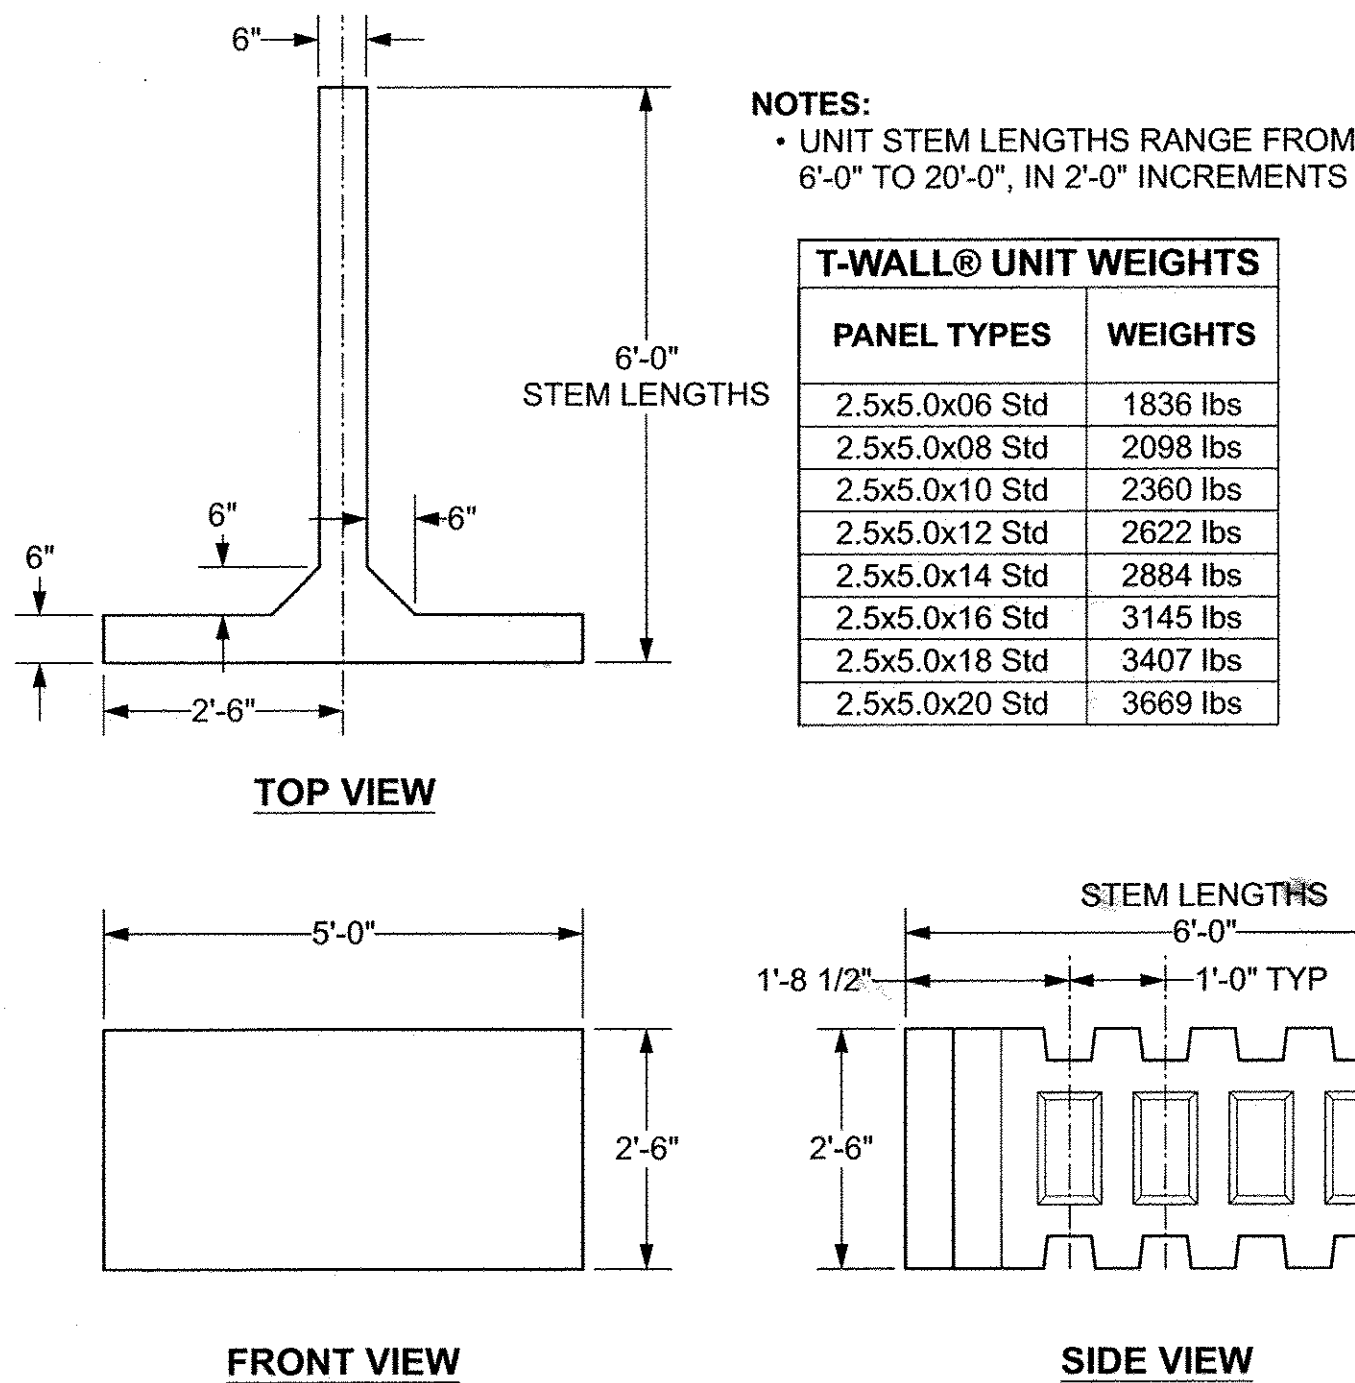

The design contained on these drawings is based upon information provided by the owner. On the basis of this information, The Neel Company has designed, and is responsible for, the internal stability of the structure only. External stability, including foundation and slope stability, is the responsibility of the owner.


This drawing contains information proprietary to The Neel Company. T-WALL® is a registered trademark owned by The Neel Company. ©2012 The Neel Company

PRECASTER: CONCRETE SYSTEMS, INC.
HUDSON, NH
PROJECT #: T21882

CONTRACTOR:

PROJECT #:

DESIGNER

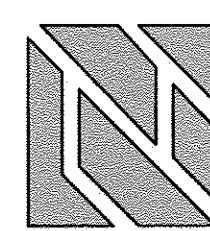

THE NEEL COMPANY
8328-D TRAFORD LANE
SPRINGFIELD, VIRGINIA 22152
PH: (703) 913-7858
FX: (703) 913-7859
WEB: WWW.NEELCO.COM

PROJECT #: TW4301

CERTIFIED WITH RESPECT TO INTERNAL STABILITY OF T-WALL® STRUCTURES ONLY

REVISIONS

NO.	DESCRIPTION	DATE

FABRICATION DRAWING 8-6-14


RIGIDIFIED TUBE FRP ARCH (RTFA) PROJECT

FAIRFIELD, VT


FABRICATION DRAWING
COVER SHEET

T-WALL® RETAINING WALL SYSTEM


SCALE:	NO SCALE
DATE:	8-6-14
DESIGNED BY:	KD
DRAWN BY:	ABC
CHECKED BY:	KD
SHEET:	TW-FB1

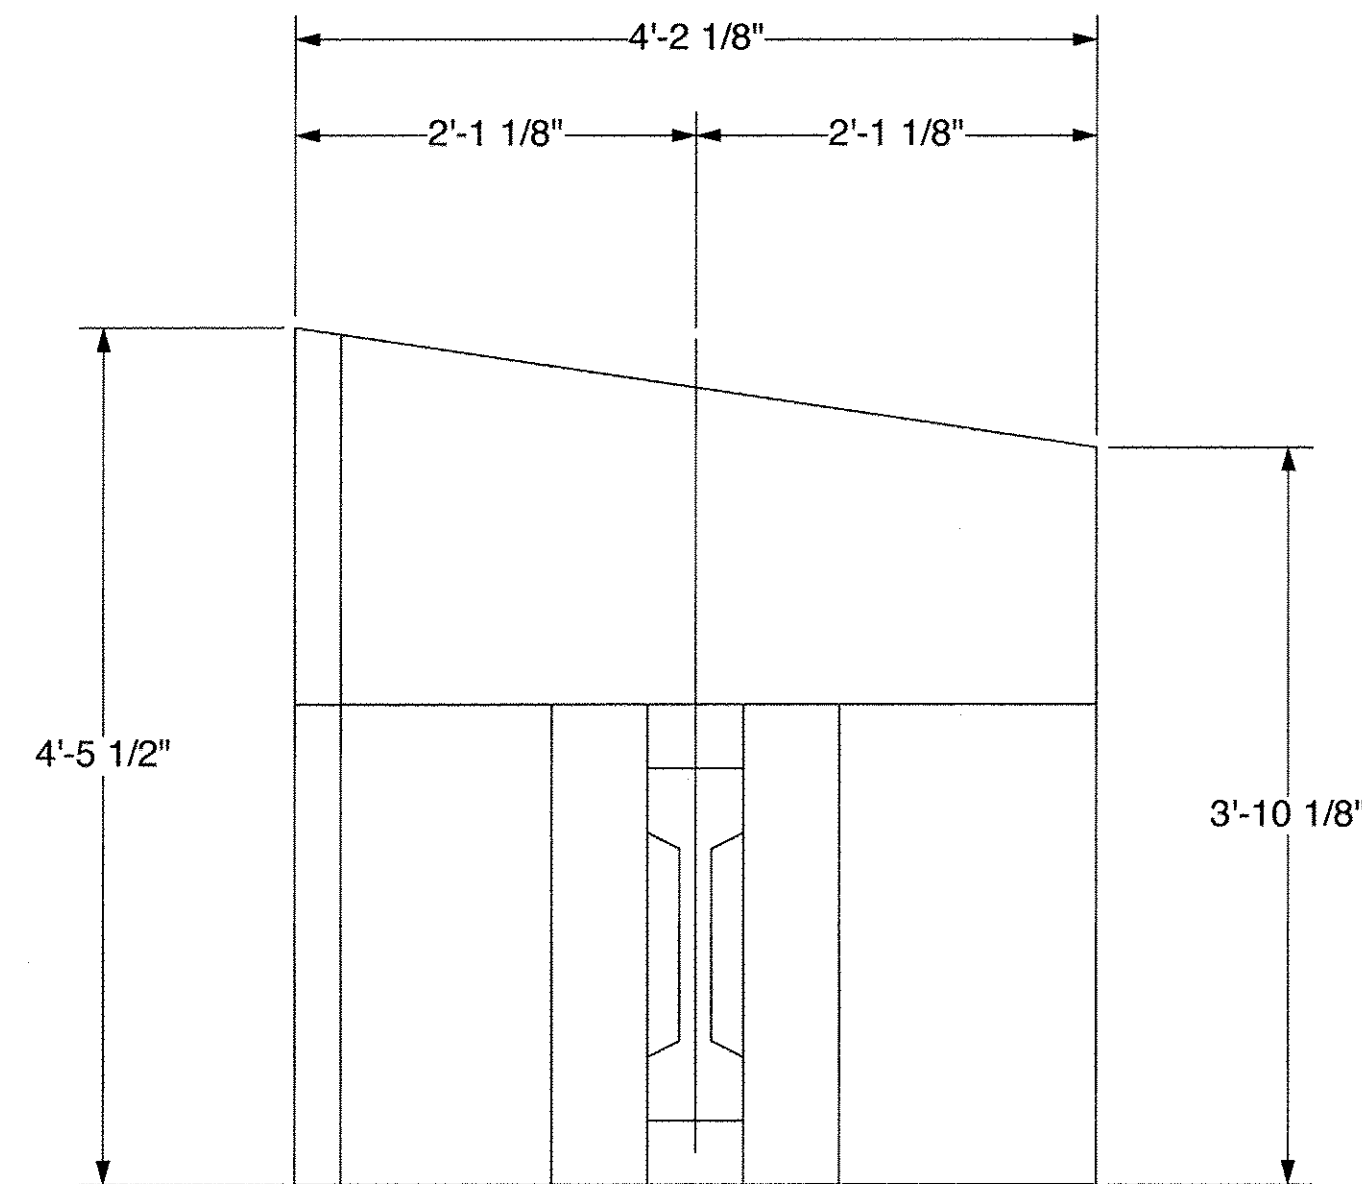

SP1 - FRONT VIEW

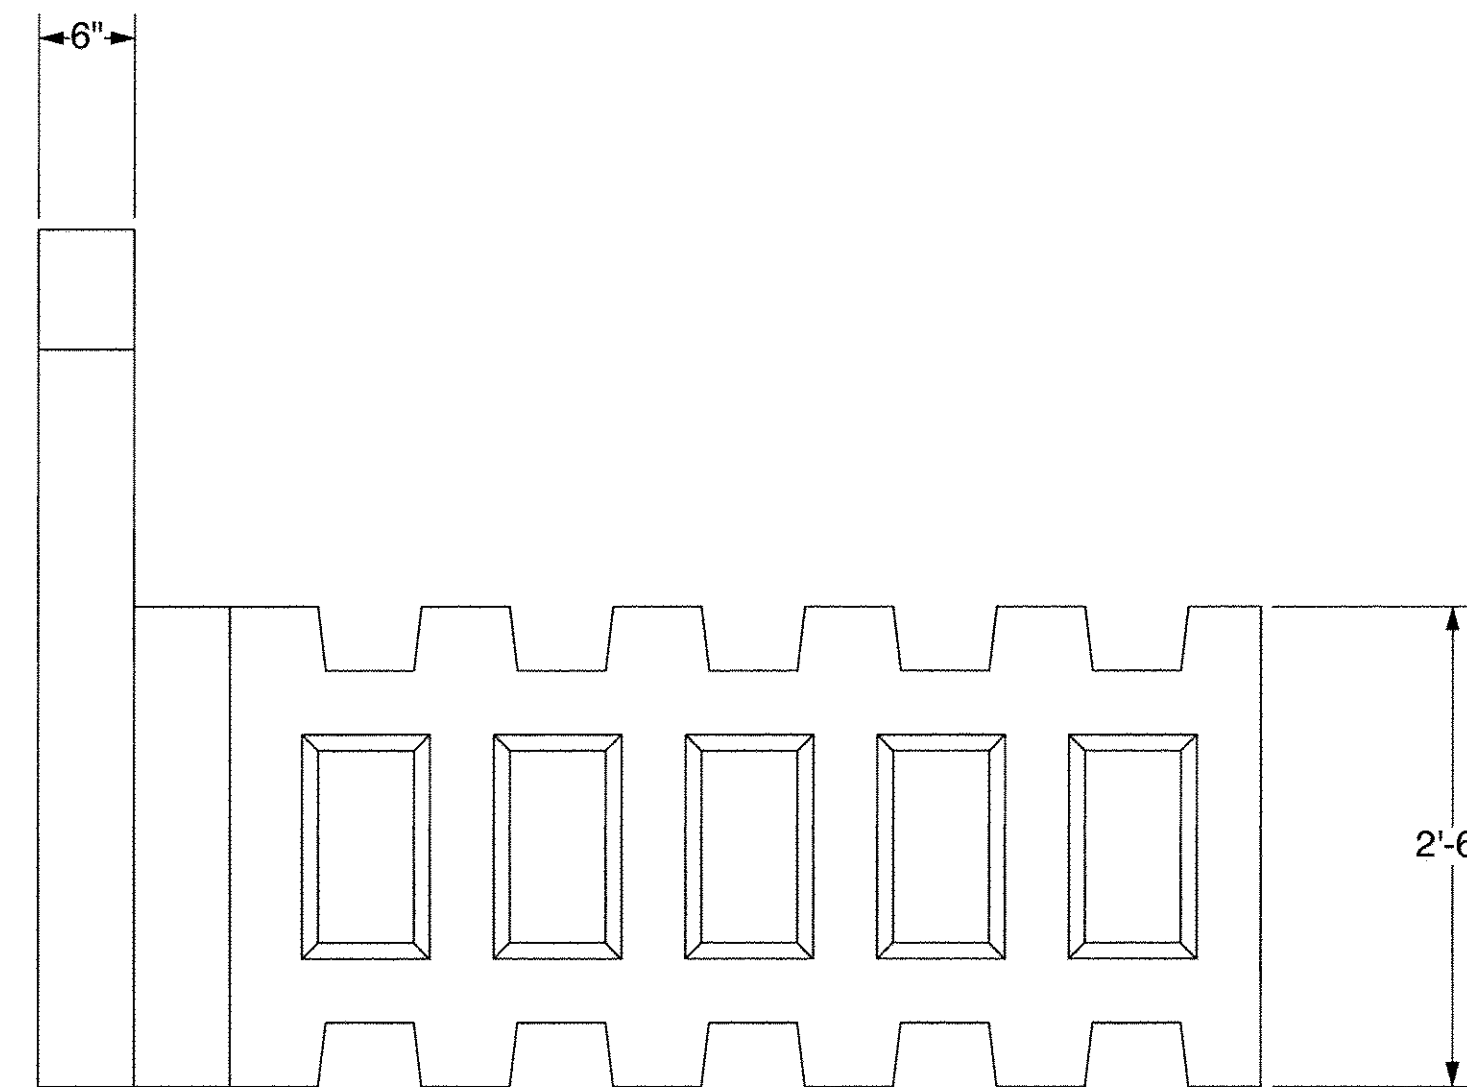

SP1 - SIDE VIEW

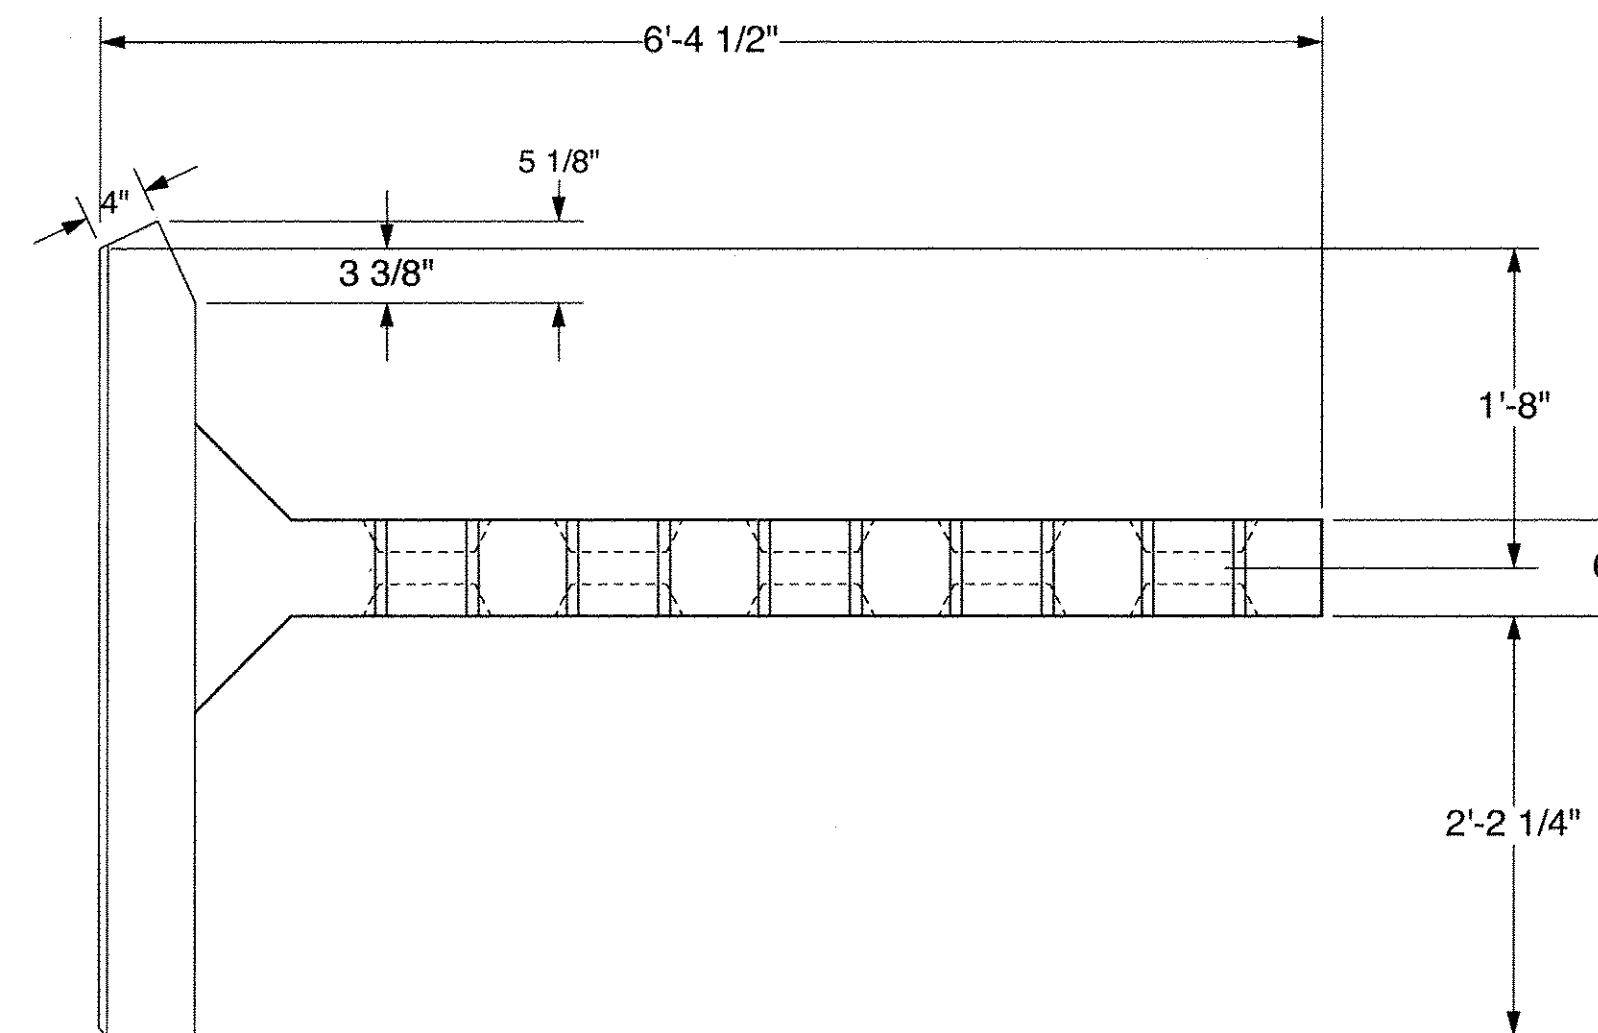

SP1 - PLAN VIEW


Approved Approved As Noted
 Rejected

This review is only for general conformance with the design concept and the information given in the Construction Documents. Corrections or comments made on the shop drawings during the review do not relieve the Contractor from compliance with the requirements of the Plans and Specifications. Review of a specific item shall not include review of an assembly of which an item is a component. The Contractor is responsible for dimensions to be confirmed and corrected at the job site; information that pertains solely to the fabrication process or to the means, methods, techniques, sequences and procedures of construction; coordination of the Work with that of other trades and performing all Work in a safe and satisfactory manner.



Date 8/8/2014

By T. Traver

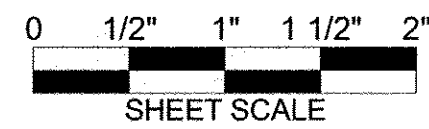

The design contained on these drawings is based upon information provided by the owner. On the basis of this information, The Neel Company has designed, and is responsible for, the internal stability of the structure only. External stability, including foundation and slope stability, is the responsibility of the owner.

This drawing contains information proprietary to The Neel Company. T-WALL® is a registered trademark owned by The Neel Company. ©2012 The Neel Company

PRECASTER: CONCRETE SYSTEMS, INC.
 HUDSON, NH
 PROJECT #: T21882

CONTRACTOR:
 PROJECT #:

DESIGNER

THE NEEL COMPANY
 8328-D TRAFORD LANE
 SPRINGFIELD, VIRGINIA 22152
 PH: (703) 913-7858
 FX: (703) 913-7859
 WEB: WWW.NEELCO.COM

PROJECT #: TW4301

CERTIFIED WITH RESPECT
 TO INTERNAL STABILITY OF
 T-WALL® STRUCTURES ONLY

REVISIONS


--	--	--

FABRICATION DRAWING
8-6-14


RIGIDIFIED TUBE FRP ARCH (RTFA) PROJECT

FAIRFIELD, VT
 FABRICATION DRAWING
 SPECIAL UNIT SP1
 T-WALL® RETAINING WALL SYSTEM


SCALE:	1" = 1'-0"
DATE:	8-6-14
DESIGNED BY:	KD
DRAWN BY:	ABC
CHECKED BY:	KD
SHEET:	TW-FB2

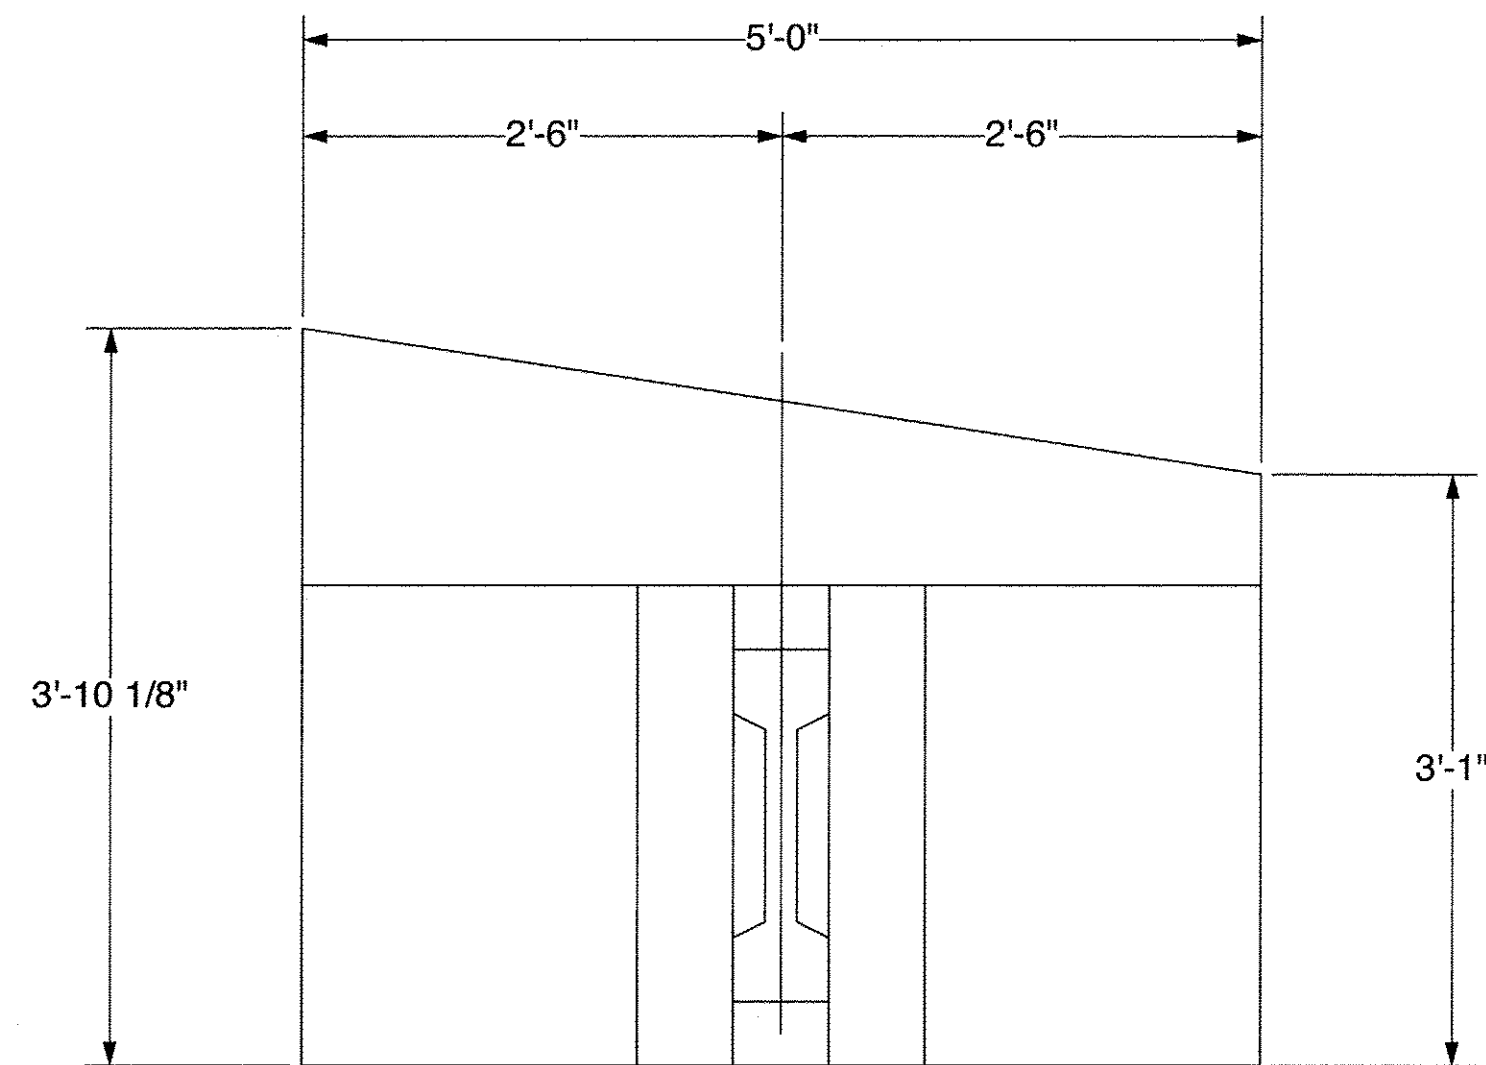

SP2 - FRONT VIEW

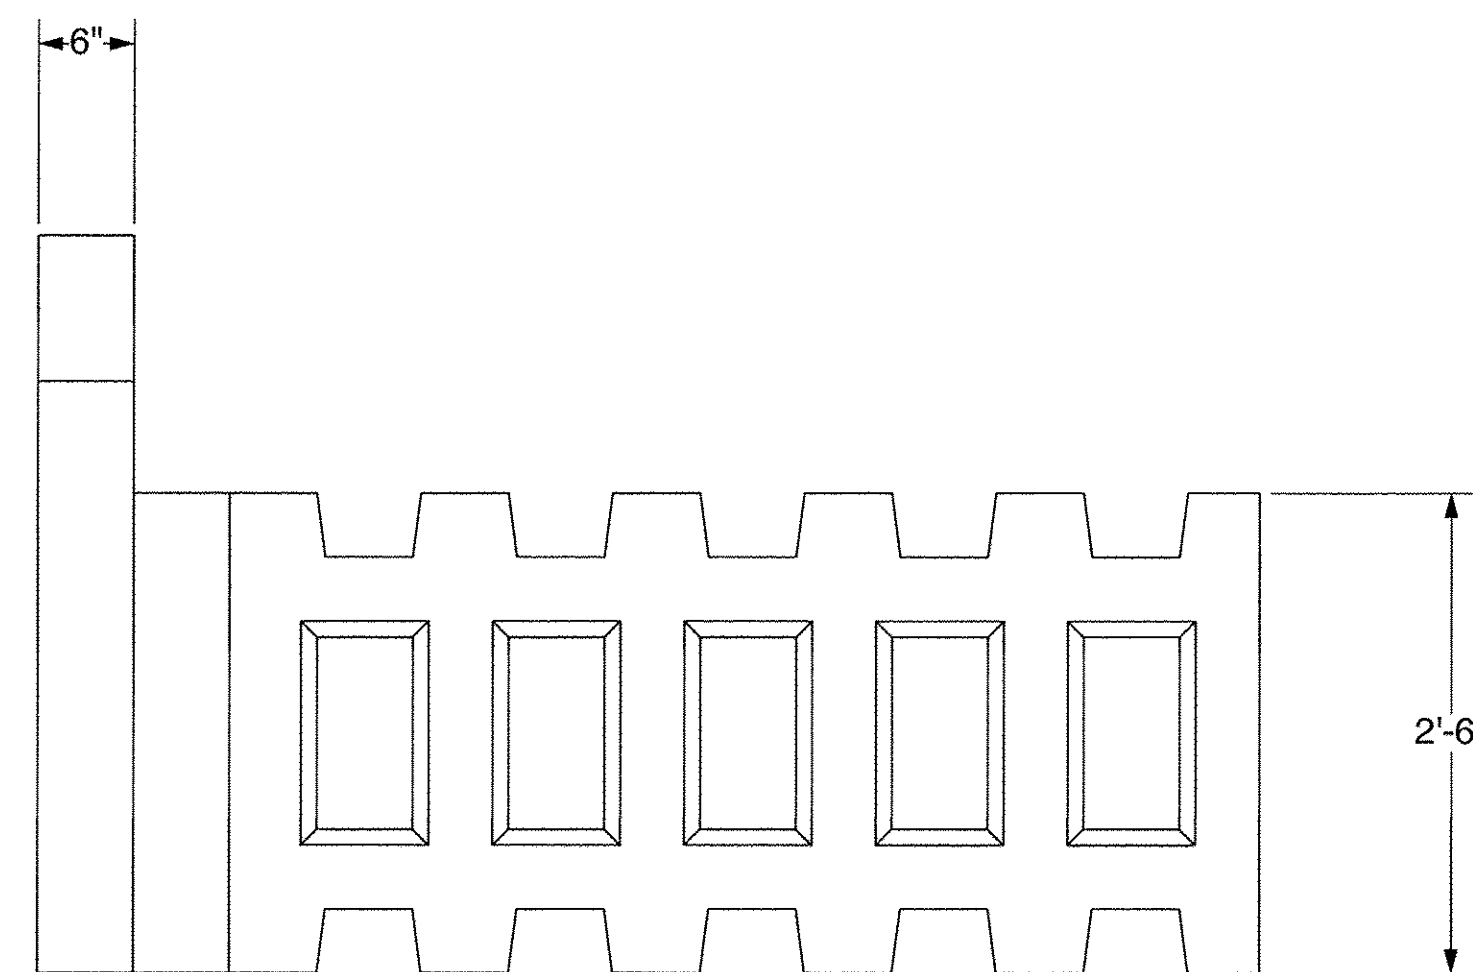

SP2 - SIDE VIEW

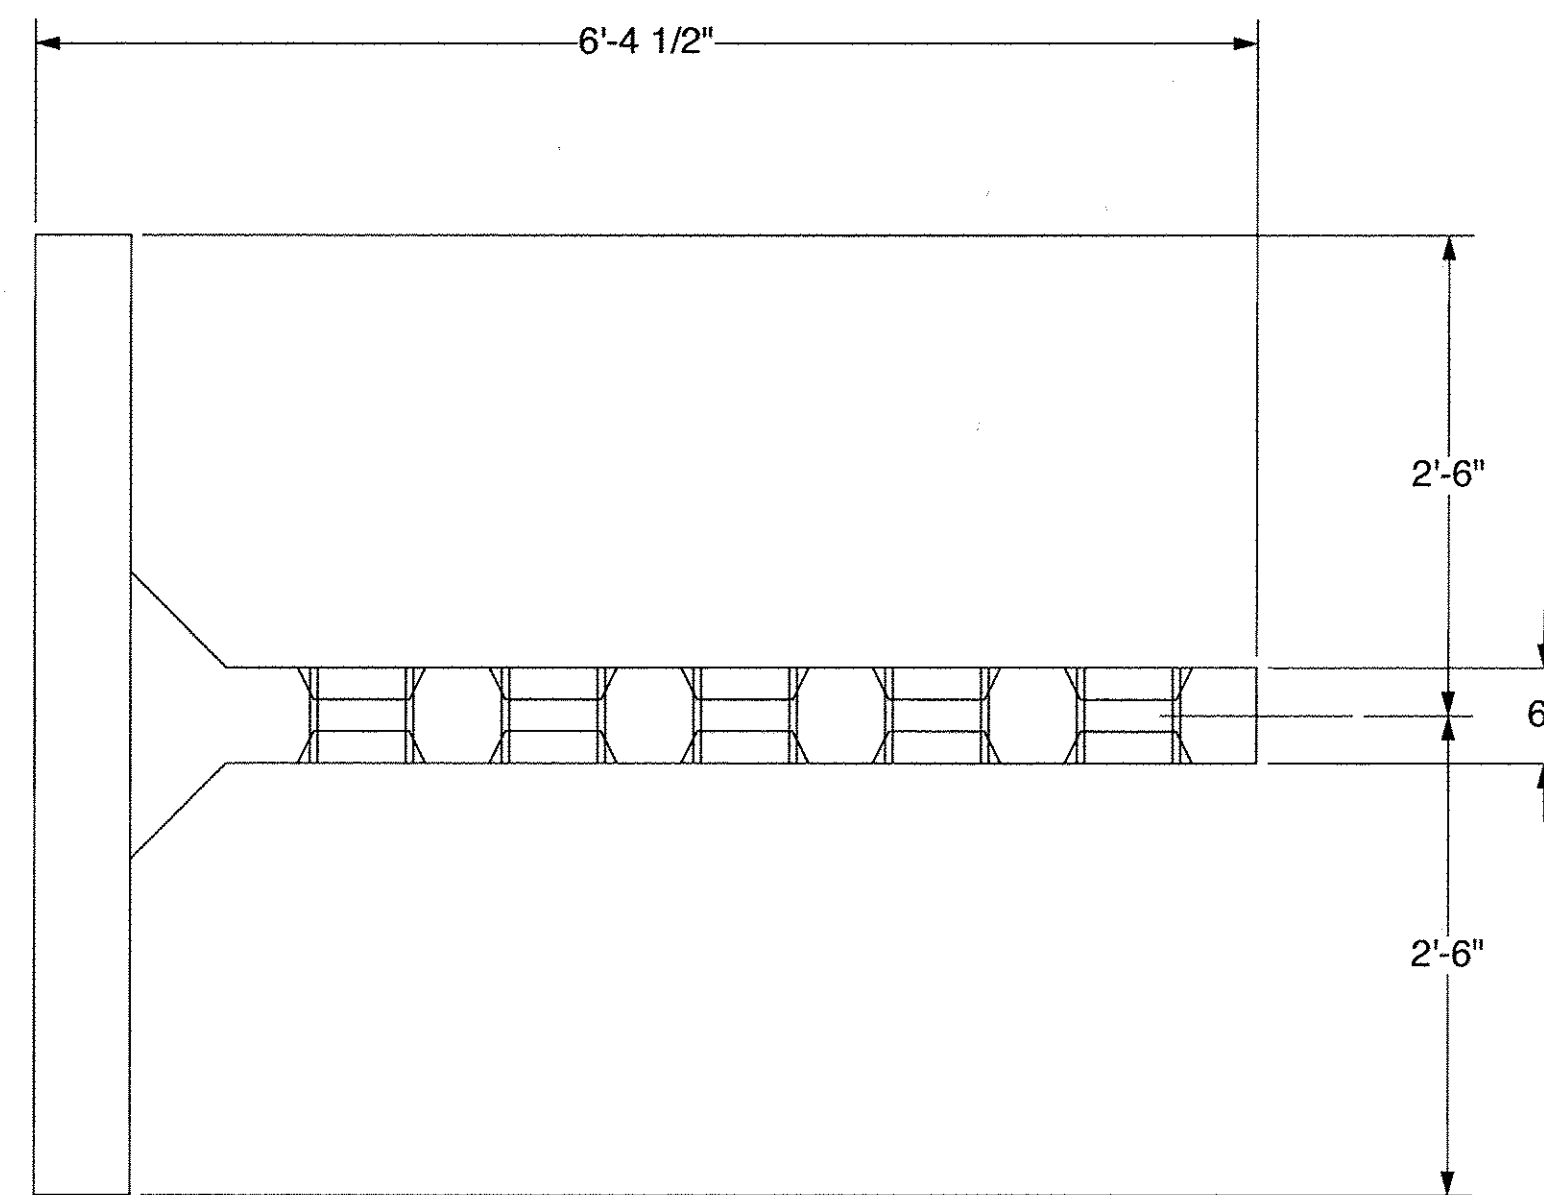

SP2 - PLAN VIEW


Approved Approved As Noted
 Rejected

This review is only for general conformance with the design concept and the information given in the Construction Documents. Corrections or comments made on the shop drawings during the review do not relieve the Contractor from compliance with the requirements of the Plans and Specifications. Review of a specific item shall not include review of an assembly of which an item is a component. The Contractor is responsible for dimensions to be confirmed and corrected at the job site; information that pertains solely to the fabrication process or to the means, methods, techniques, sequences and procedures of construction; coordination of the Work with that of other trades and performing all Work in a safe and satisfactory manner.

Date 8/8/2014



By T. Traver

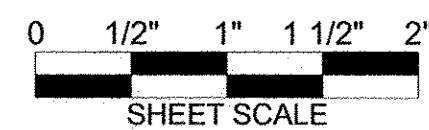


The design contained on these drawings is based upon information provided by the owner. On the basis of this information, The Neel Company has designed, and is responsible for, the internal stability of the structure only. External stability, including foundation and slope stability, is the responsibility of the owner.

This drawing contains information proprietary to The Neel Company. T-WALL® is a registered trademark owned by The Neel Company. ©2012 The Neel Company

PRECASTER: CONCRETE SYSTEMS, INC.
 HUDSON, NH
 PROJECT #: T21882

CONTRACTOR:
 PROJECT #:

DESIGNER

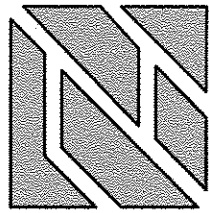

THE NEEL COMPANY
 8328-D TRAFORD LANE
 SPRINGFIELD, VIRGINIA 22152
 PH: (703) 913-7858
 FX: (703) 913-7859
 WEB: WWW.NEELCO.COM

PROJECT #: TW4301

CERTIFIED WITH RESPECT
 TO INTERNAL STABILITY OF
 T-WALL® STRUCTURES ONLY


REVISIONS

**FABRICATION DRAWING
 8-6-14**


RIGIDIFIED TUBE FRP ARCH (RTFA) PROJECT

FAIRFIELD, VT
 FABRICATION DRAWING
 SPECIAL UNIT SP2
 T-WALL® RETAINING WALL SYSTEM


SCALE:	1" = 1'-0"
DATE:	8-6-14
DESIGNED BY:	KD
DRAWN BY:	ABC
CHECKED BY:	KD
SHEET:	TW-FB3

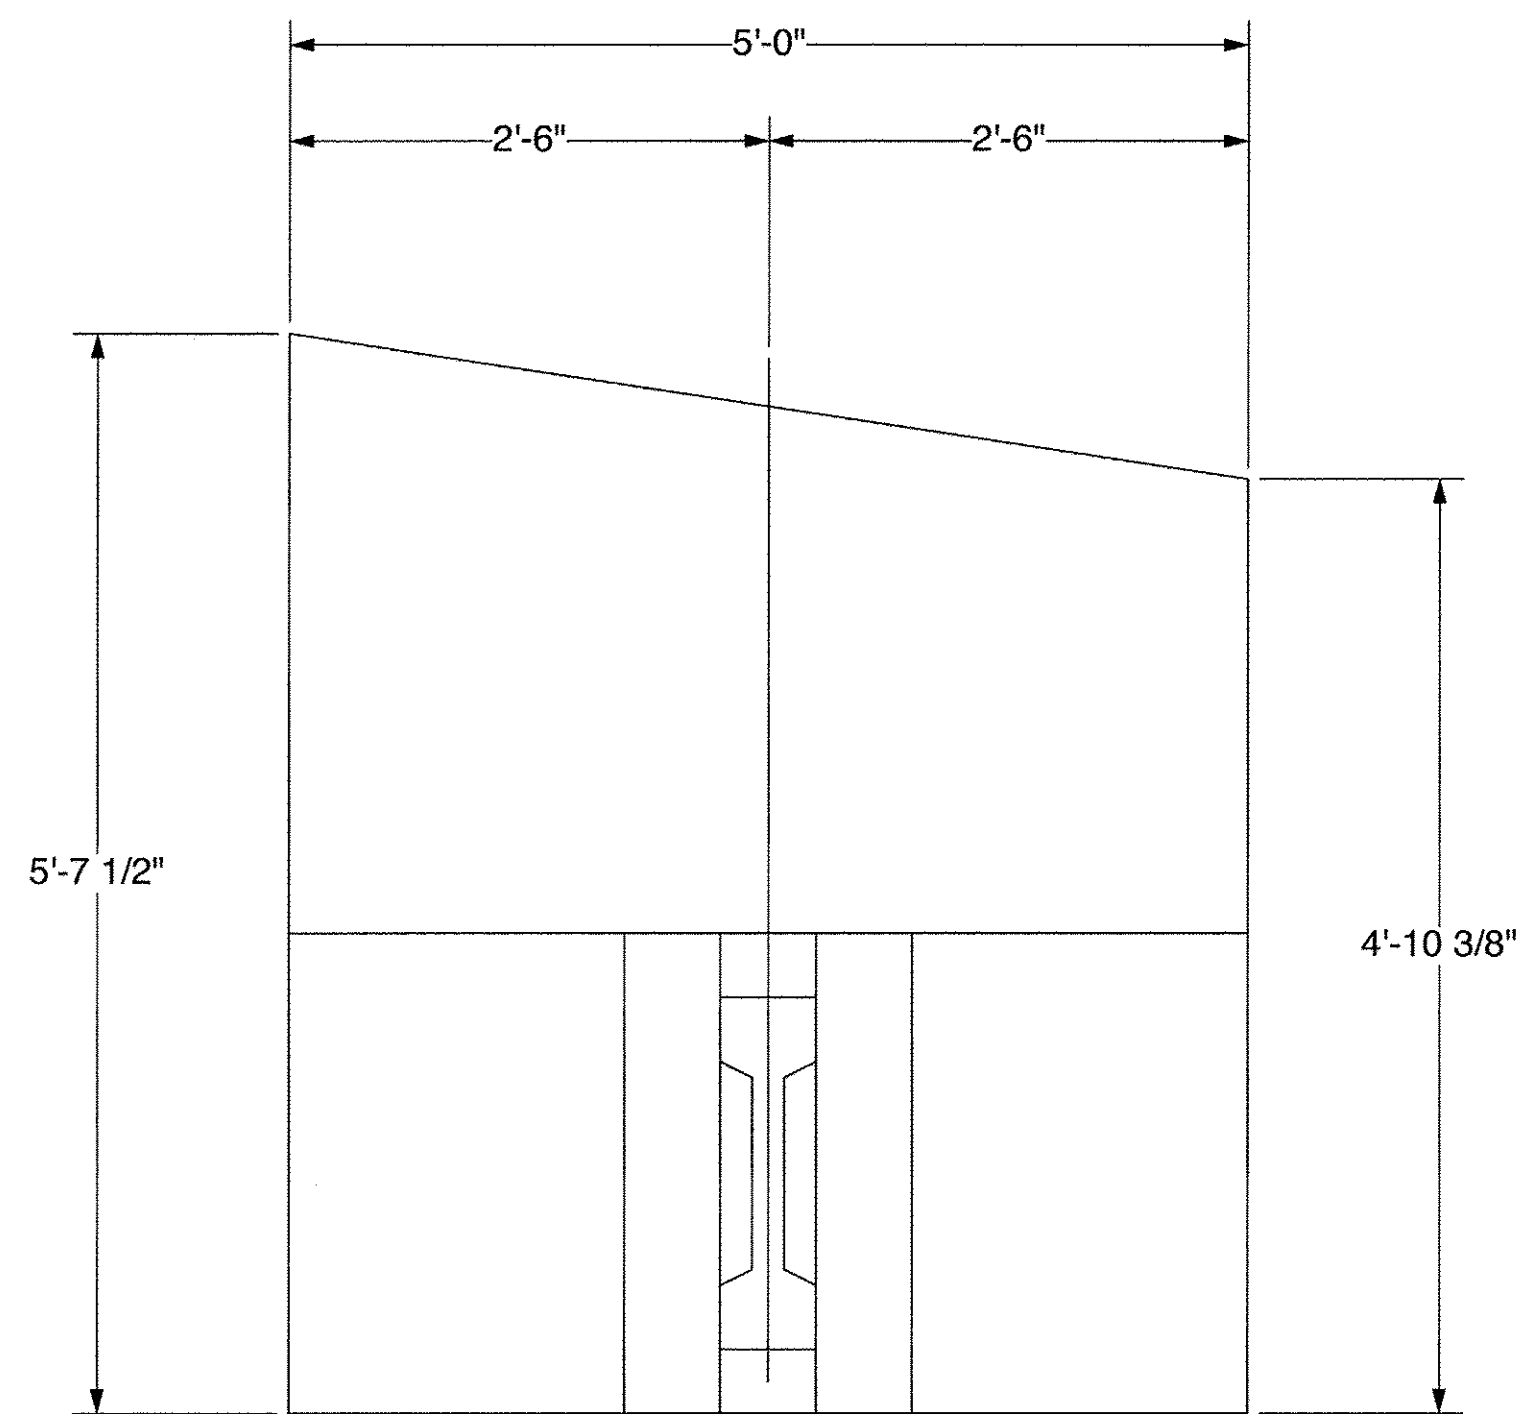

SP3 - FRONT VIEW

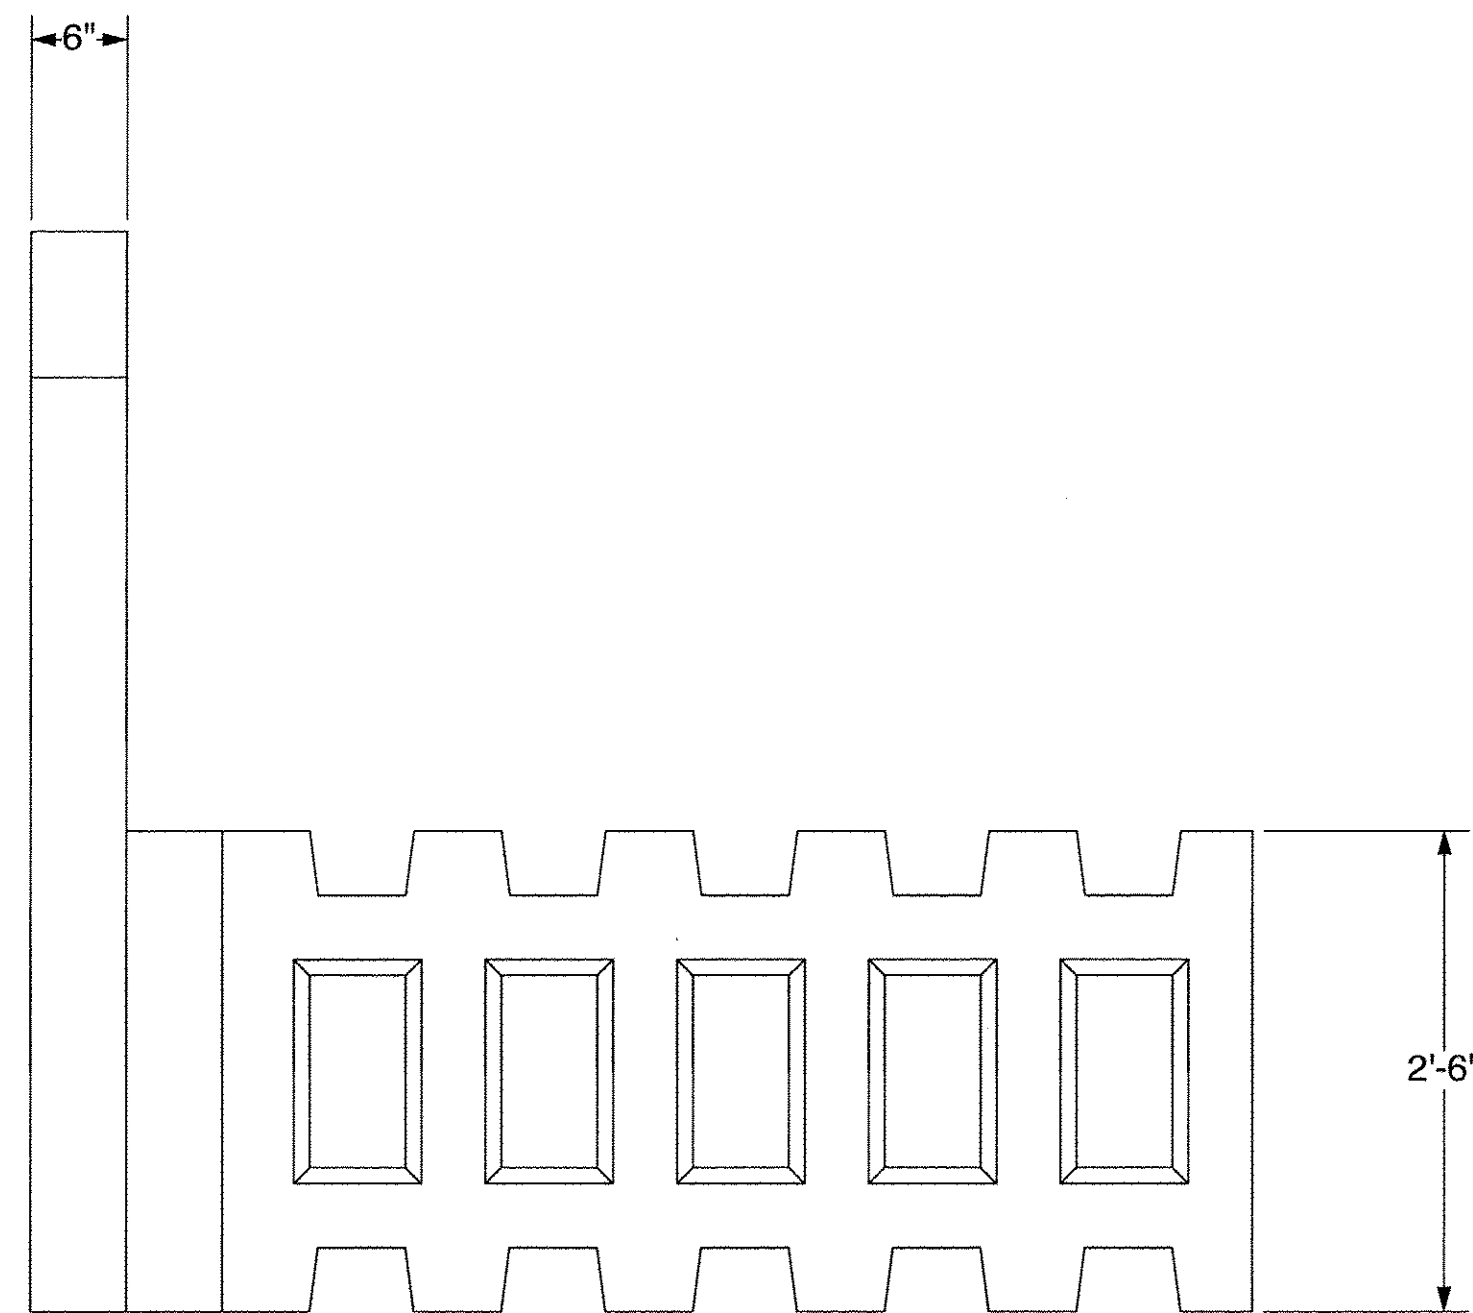

SP3 - SIDE VIEW

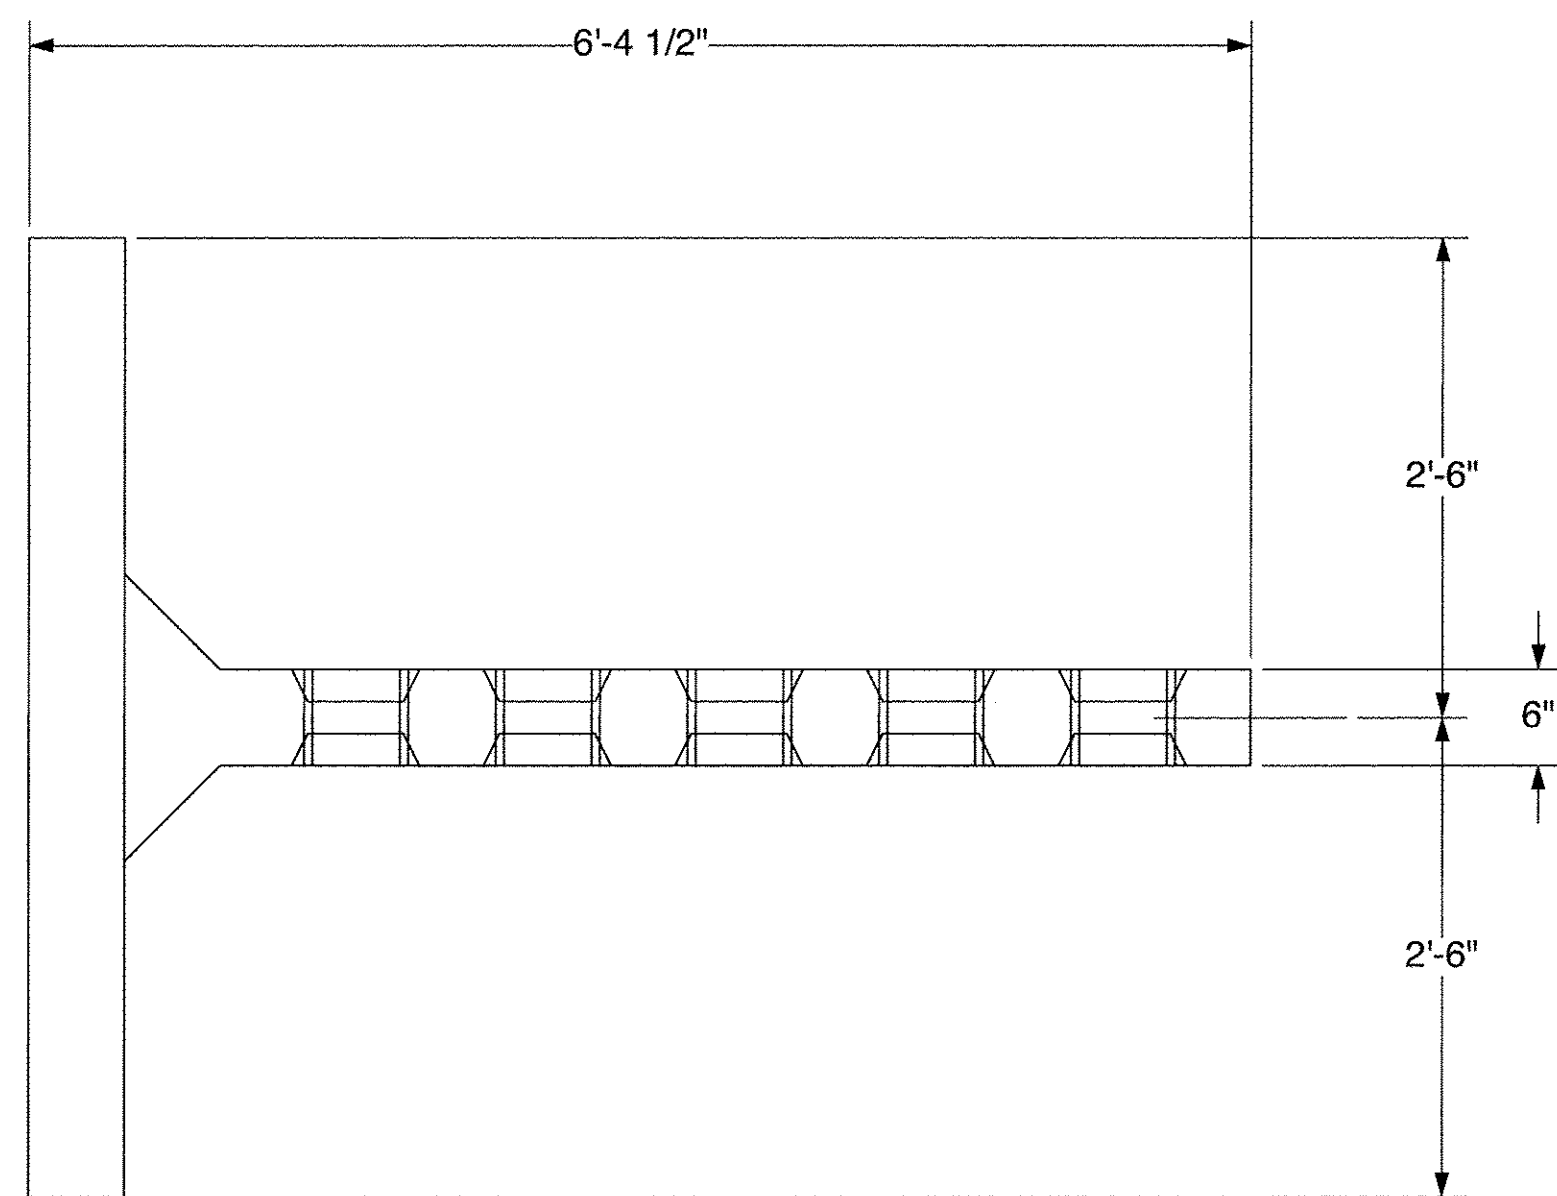

SP3 - PLAN VIEW

**FABRICATION DRAWING
8-6-14**

RIGIDIFIED TUBE FRP ARCH (RTFA) PROJECT

FAIRFIELD, VT
FABRICATION DRAWING
SPECIAL UNIT SP3
T-WALL® RETAINING WALL SYSTEM


SCALE:	1" = 1'-0"
DATE:	8-6-14
DESIGNED BY:	KD
DRAWN BY:	ABC
CHECKED BY:	KD
SHEET:	TW-FB4

Approved
 Approved As Noted
 Rejected

This review is only for general conformance with the design concept and the information given in the Construction Documents. Corrections or comments made on the shop drawings during the review do not relieve the Contractor from compliance with the requirements of the Plans and Specifications. Review of a specific item shall not include review of an assembly of which an item is a component. The Contractor is responsible for dimensions to be confirmed and corrected at the job site; information that pertains solely to the fabrication process or to the means, methods, techniques, sequences and procedures of construction; coordination of the Work with that of other trades and performing all Work in a safe and satisfactory manner.

Date 8/8/2014

By T. Traver

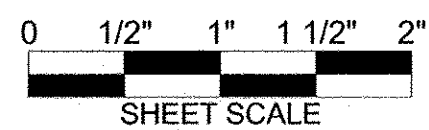
The design contained on these drawings is based upon information provided by the owner. On the basis of this information, The Neel Company has designed, and is responsible for, the internal stability of the structure only. External stability, including foundation and slope stability, is the responsibility of the owner.

This drawing contains information proprietary to The Neel Company. T-WALL® is a registered trademark owned by The Neel Company. ©2012 The Neel Company

PRECASTER: CONCRETE SYSTEMS, INC.
HUDSON, NH
PROJECT #: T21882

CONTRACTOR:
PROJECT #:

DESIGNER

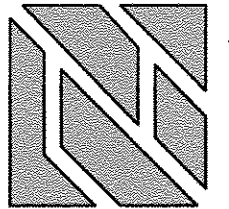


THE NEEL COMPANY
8328-D TRAFORD LANE
SPRINGFIELD, VIRGINIA 22152
PH: (703) 913-7858
FX: (703) 913-7859
WEB: WWW.NEELCO.COM

PROJECT #: TW4301


CERTIFIED WITH RESPECT
TO INTERNAL STABILITY OF
T-WALL® STRUCTURES ONLY

REVISIONS

--	--	--

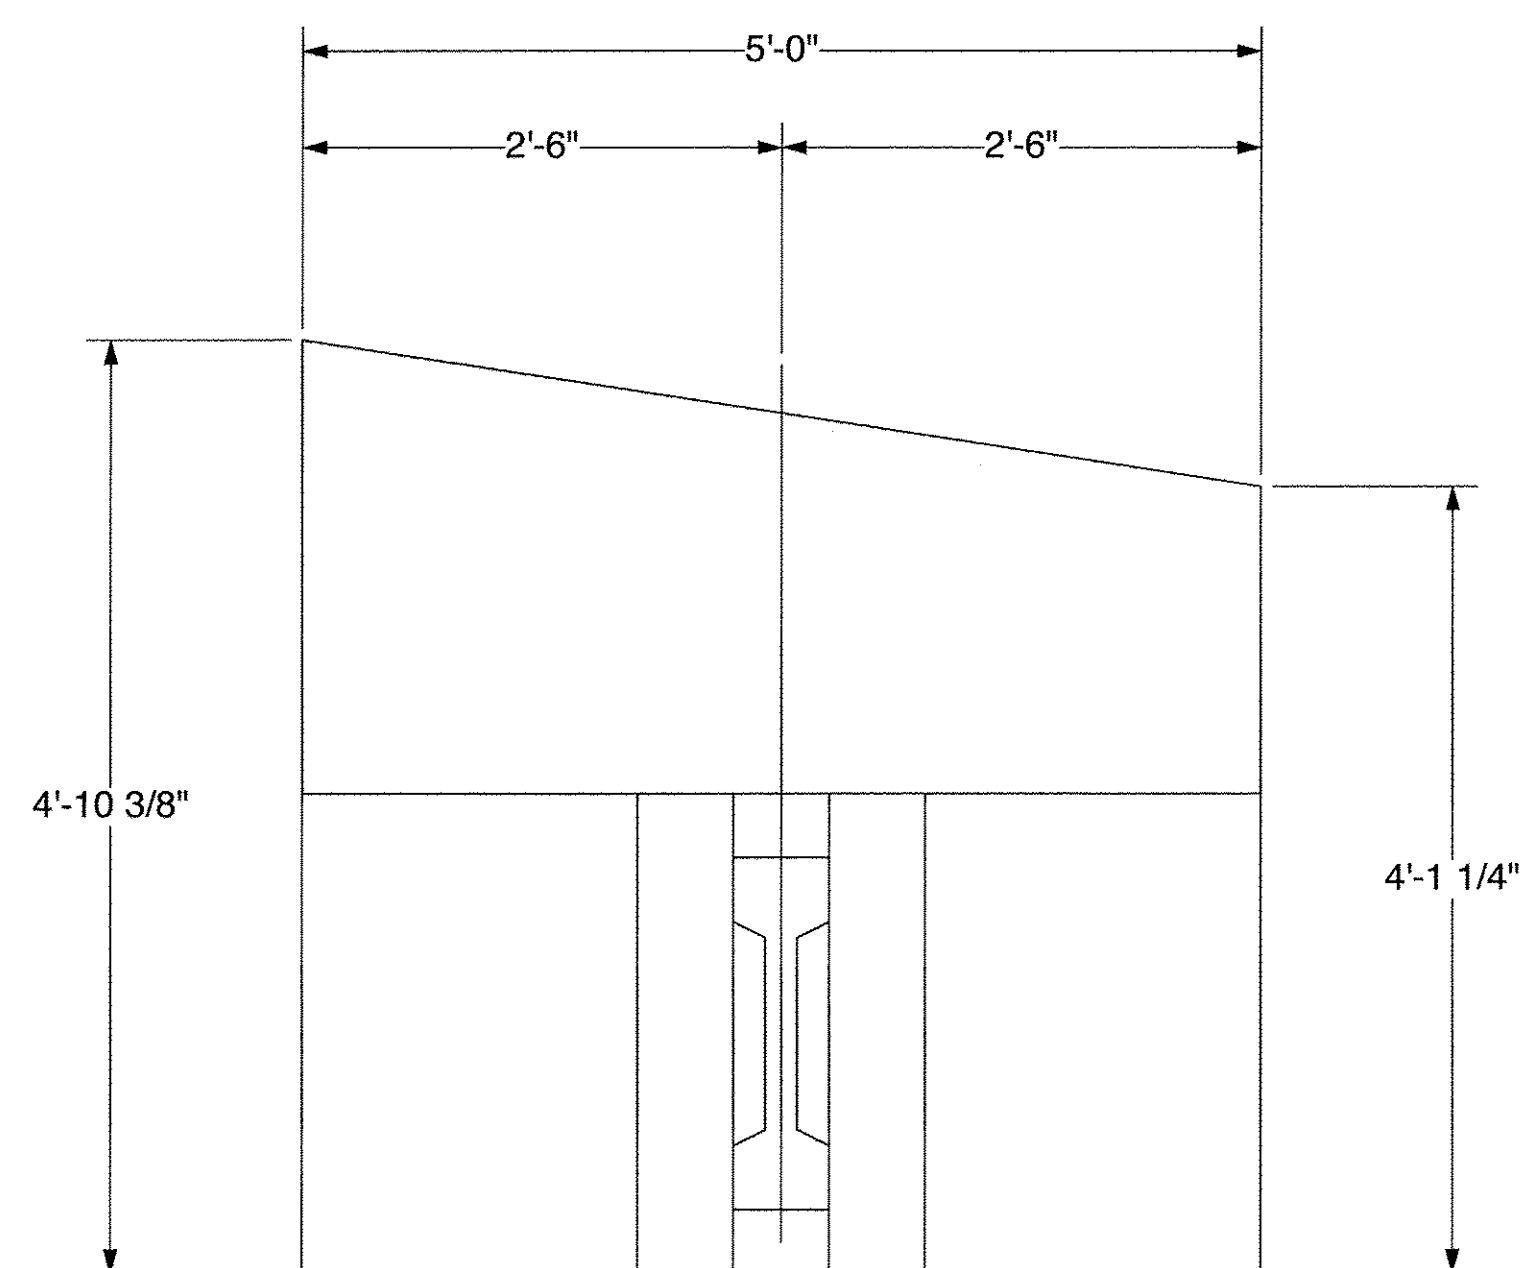

SP4 - FRONT VIEW

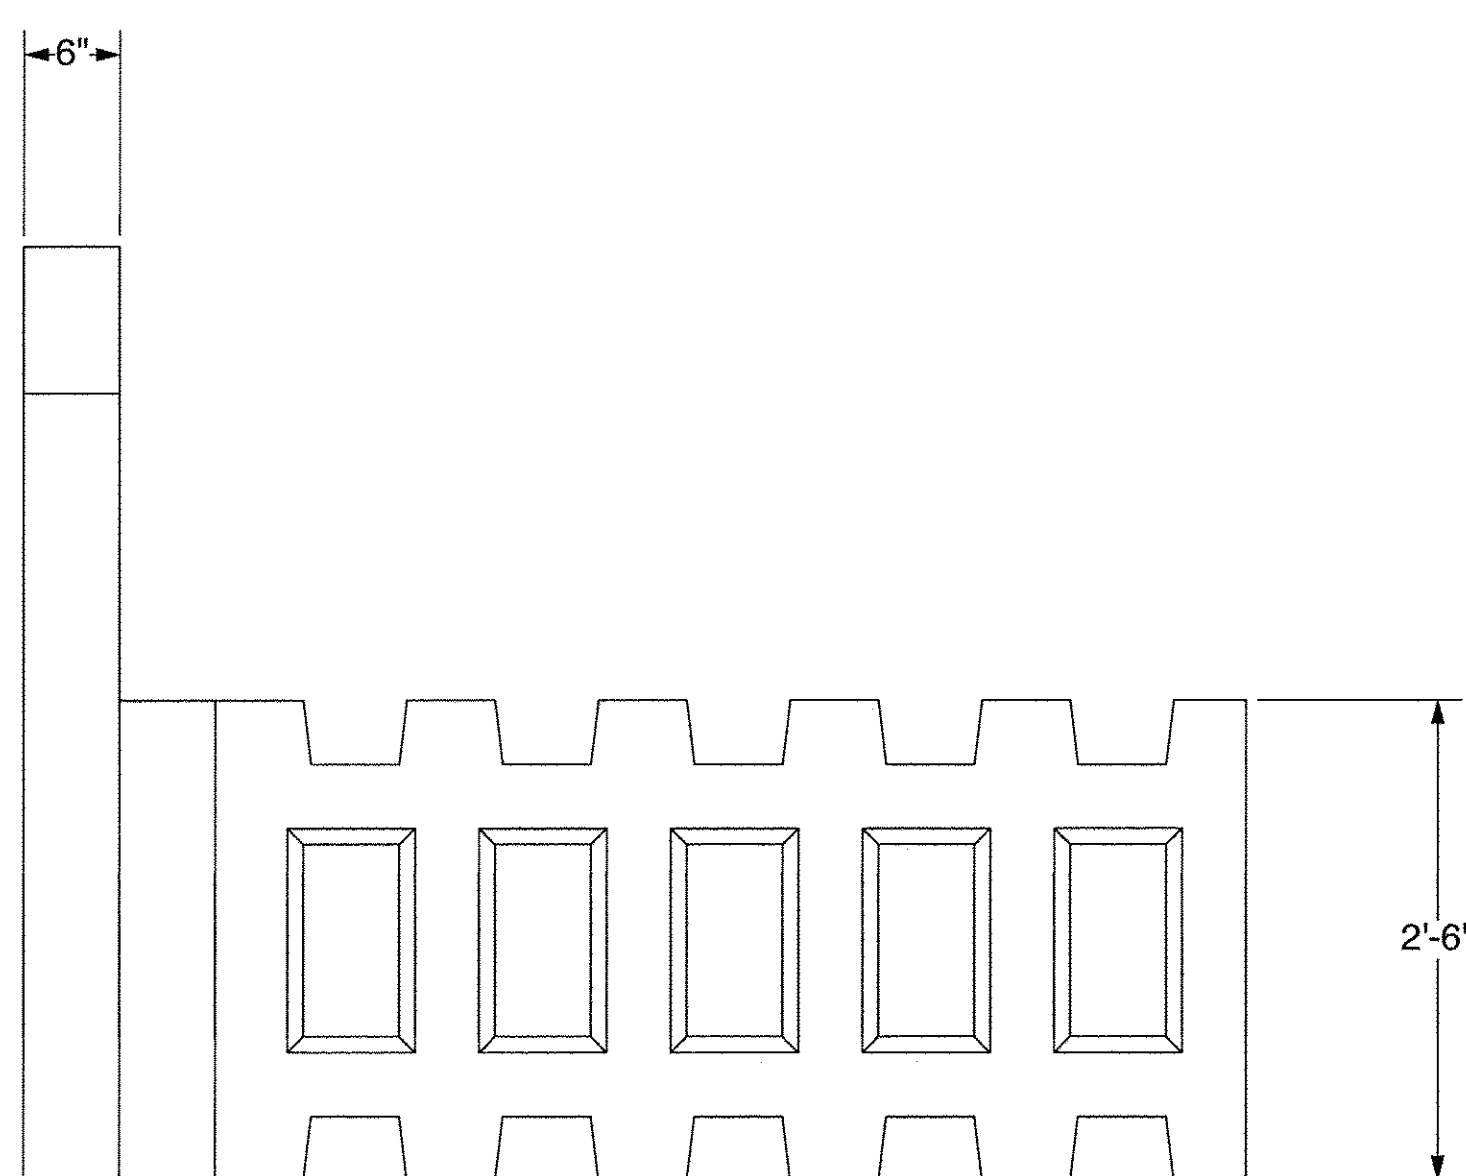

SP4 - SIDE VIEW


Approved
 Rejected

Approved As Noted

This review is only for general conformance with the design concept and the information given in the Construction Documents. Corrections or comments made on the shop drawings during the review do not relieve the Contractor from compliance with the requirements of the Plans and Specifications. Review of a specific item shall not include review of an assembly of which an item is a component. The Contractor is responsible for dimensions to be confirmed and corrected at the job site; information that pertains solely to the fabrication process or to the means, methods, techniques, sequences and procedures of construction; coordination of the Work with that of other trades and performing all Work in a safe and satisfactory manner.

Date 8/8/2014
 By T. Traver

McFarland Johnson

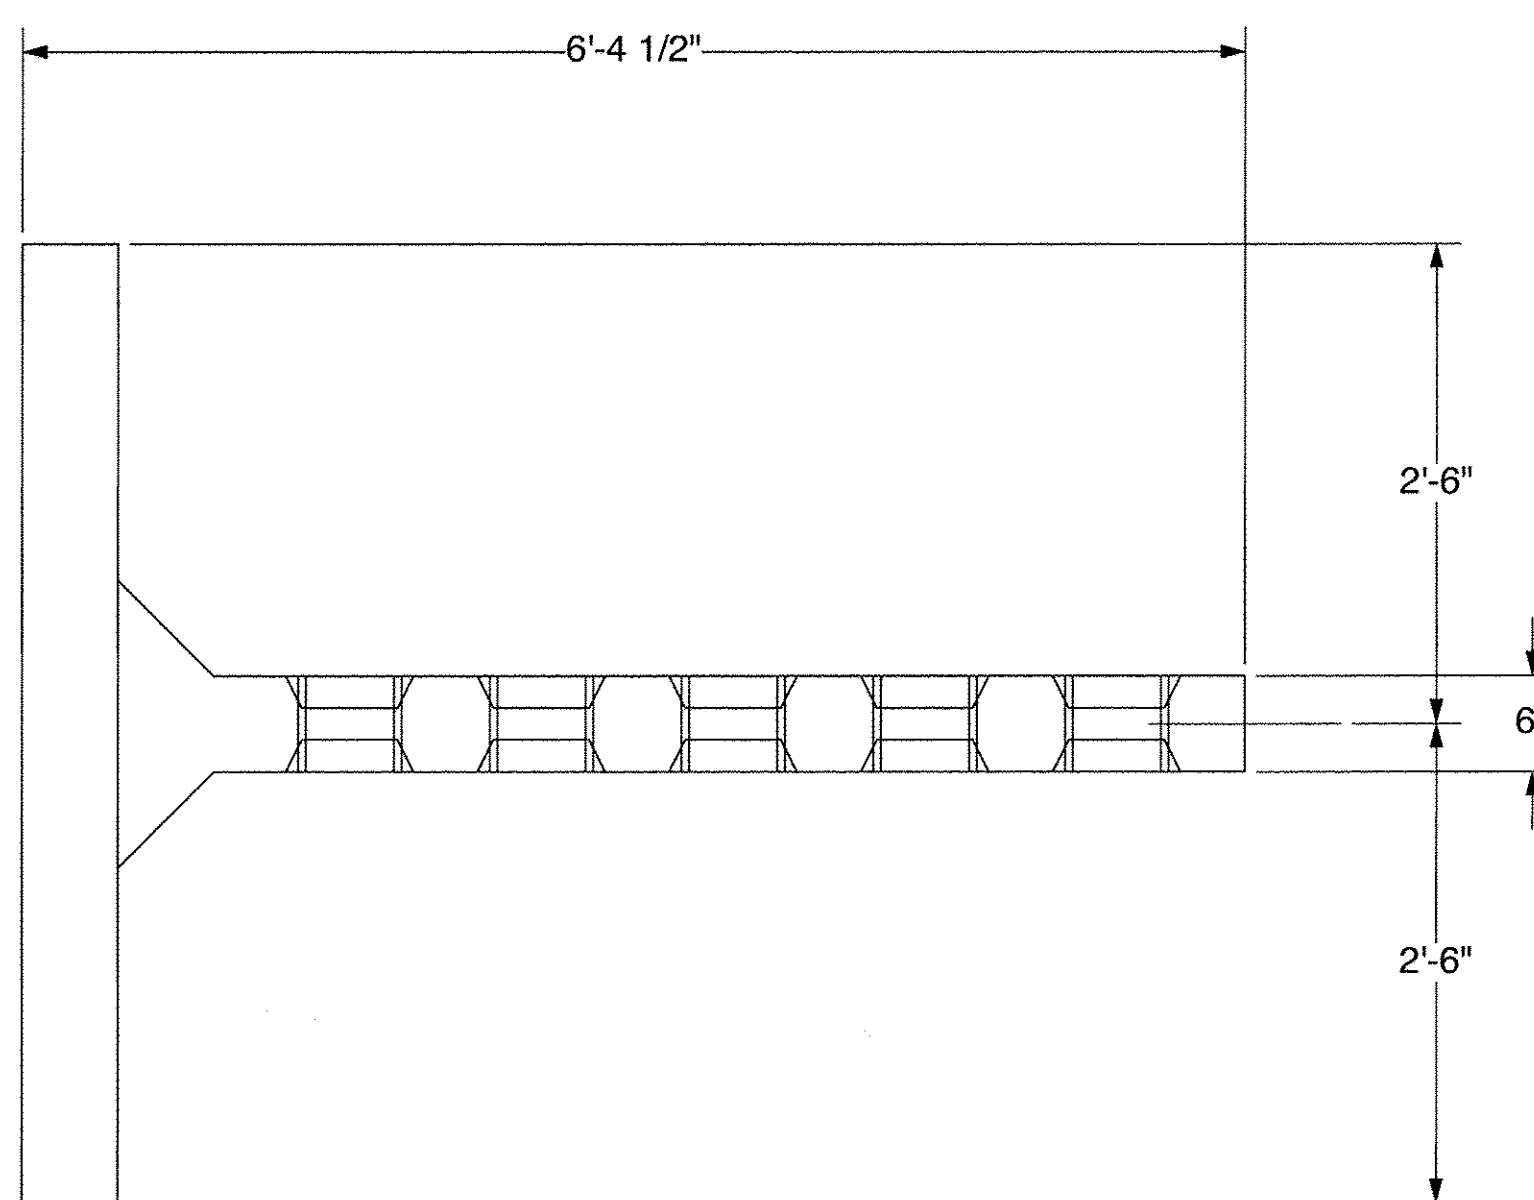


SP4 - PLAN VIEW

**FABRICATION DRAWING
8-6-14**

RIGIDIFIED TUBE FRP ARCH (RTFA) PROJECT
 FAIRFIELD, VT
 FABRICATION DRAWING
 SPECIAL UNIT SP4
 T-WALL® RETAINING WALL SYSTEM

SCALE:	1" = 1'-0"
DATE:	8-6-14
DESIGNED BY:	KD
DRAWN BY:	ABC
CHECKED BY:	KD
SHEET:	TW-FB5

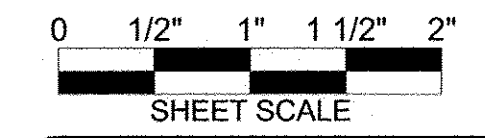

The design contained on these drawings is based upon information provided by the owner. On the basis of this information, The Neel Company has designed, and is responsible for, the internal stability of the structure only. External stability, including foundation and slope stability, is the responsibility of the owner.

This drawing contains information proprietary to The Neel Company. T-WALL® is a registered trademark owned by The Neel Company. ©2012 The Neel Company

PRECASTER: CONCRETE SYSTEMS, INC.
 HUDSON, NH
PROJECT #: T21882


CONTRACTOR:
PROJECT #:

DESIGNER
THE NEEL COMPANY
 8328-D TRAFORD LANE
 SPRINGFIELD, VIRGINIA 22152
 PH: (703) 913-7858
 FX: (703) 913-7859
 WEB: WWW.NEELCO.COM


PROJECT #: TW4301

CERTIFIED WITH RESPECT
 TO INTERNAL STABILITY OF
 T-WALL® STRUCTURES ONLY


REVISIONS	

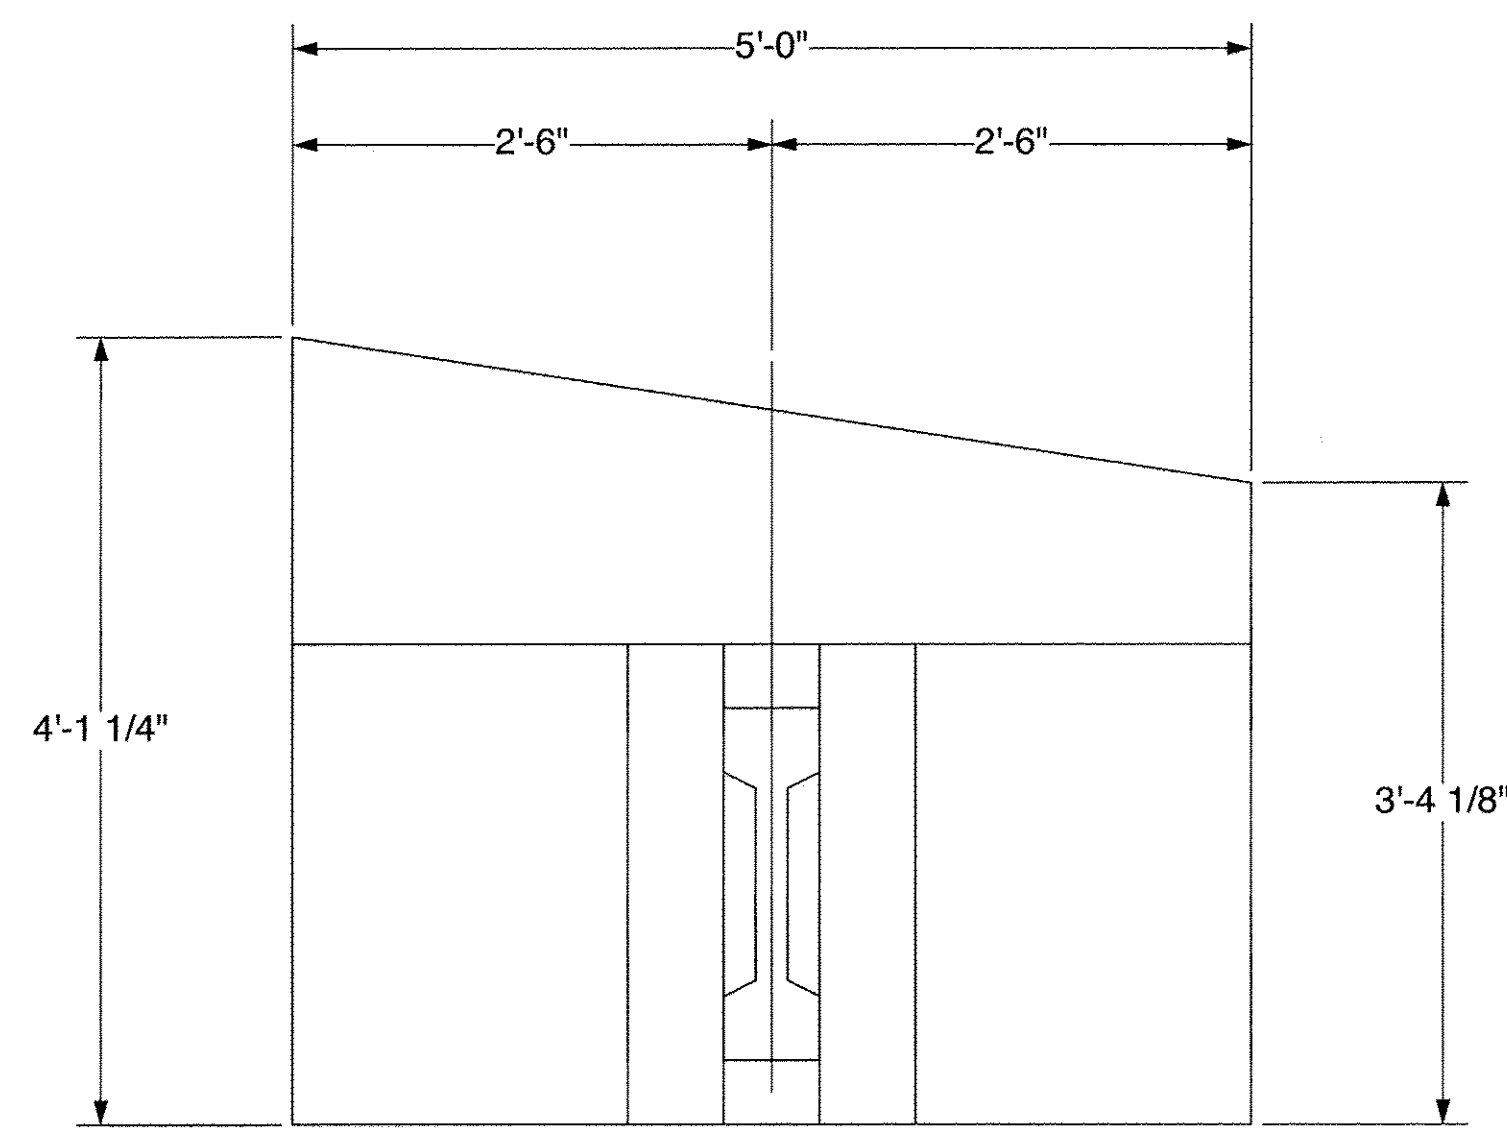

SP5 - FRONT VIEW

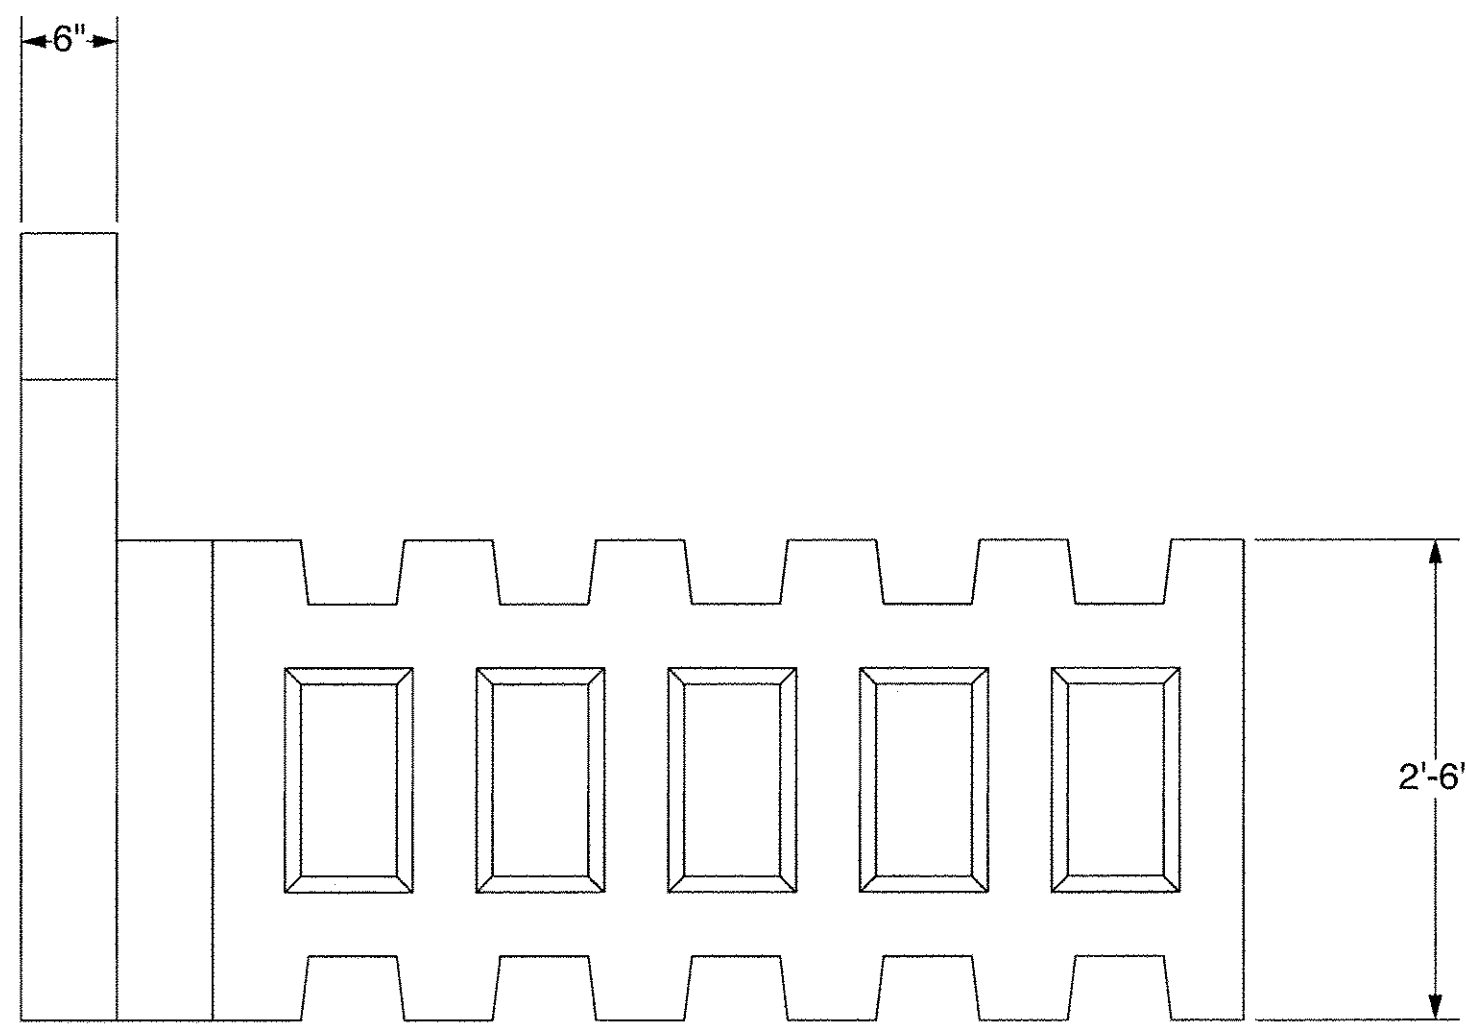

SP5 - SIDE VIEW

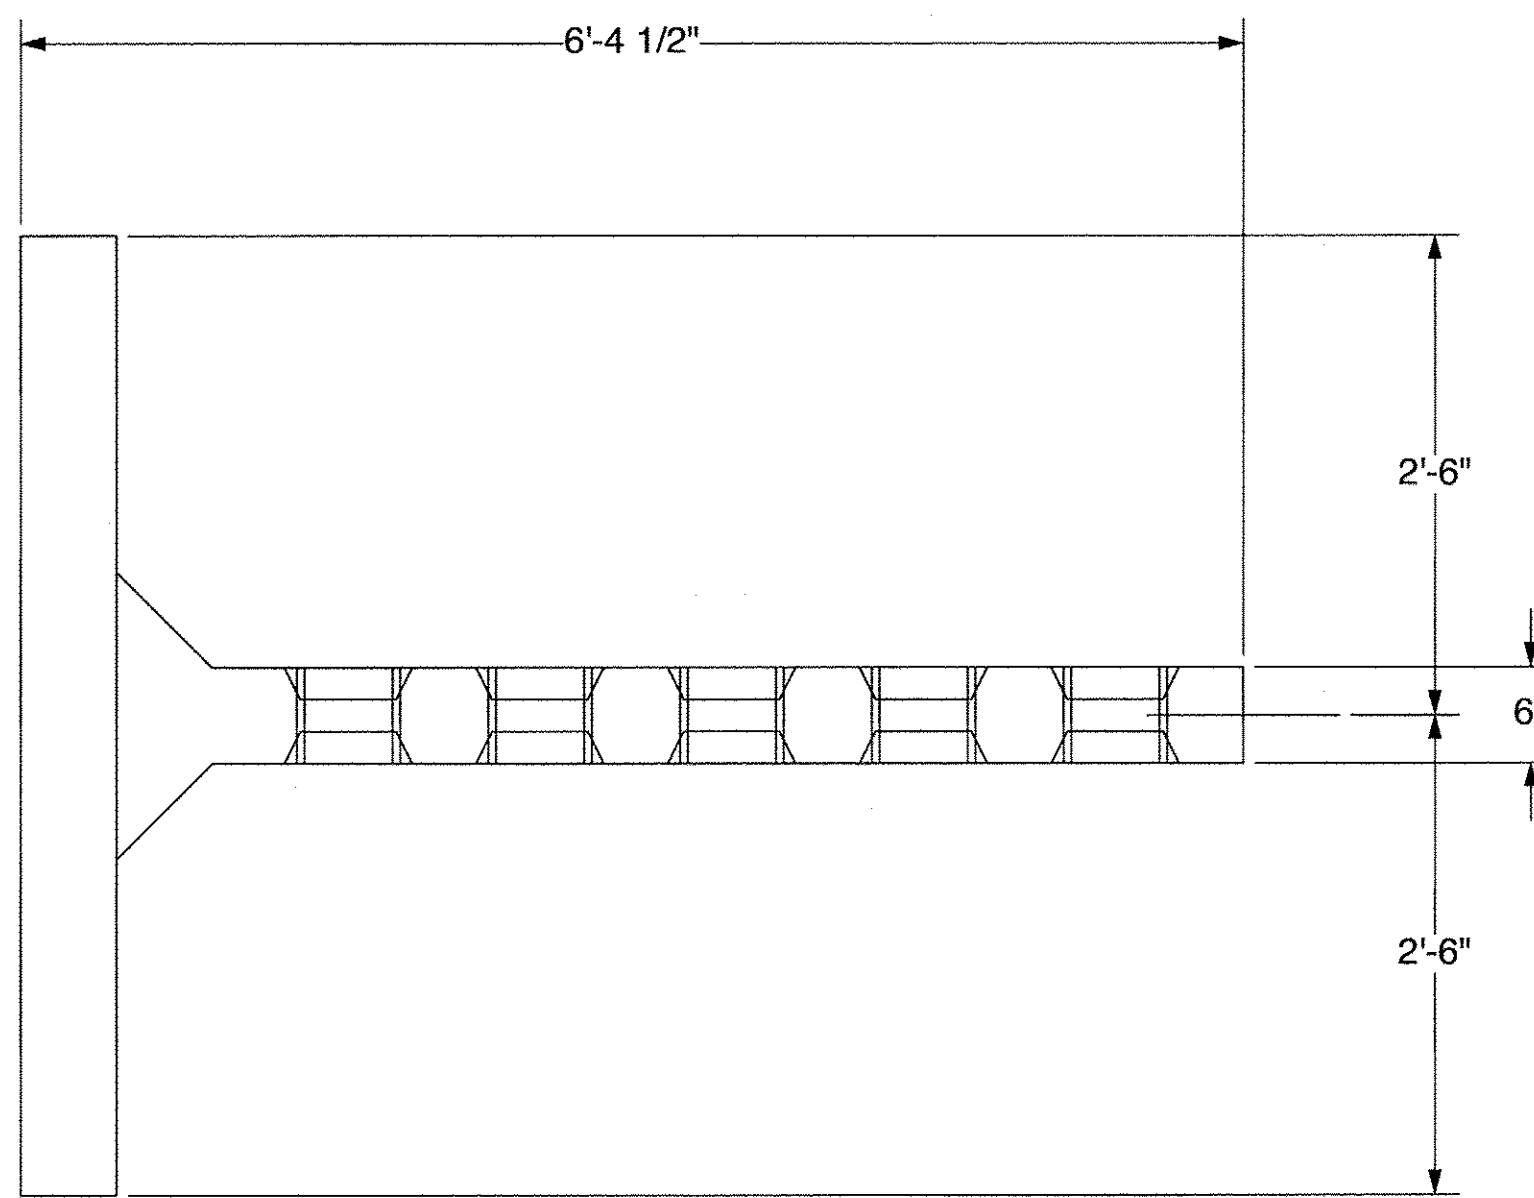

SP5 - PLAN VIEW


Approved
 Rejected

Approved As Noted

This review is only for general conformance with the design concept and the information given in the Construction Documents. Corrections or comments made on the shop drawings during the review do not relieve the Contractor from compliance with the requirements of the Plans and Specifications. Review of a specific item shall not include review of an assembly of which an item is a component. The Contractor is responsible for dimensions to be confirmed and corrected at the job site; information that pertains solely to the fabrication process or to the means, methods, techniques, sequences and procedures of construction; coordination of the Work with that of other trades and performing all Work in a safe and satisfactory manner.

Date 8/8/2014

By T. Traver

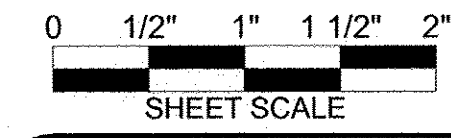

The design contained on these drawings is based upon information provided by the owner. On the basis of this information, The Neel Company has designed, and is responsible for, the internal stability of the structure only. External stability, including foundation and slope stability, is the responsibility of the owner.

This drawing contains information proprietary to The Neel Company. T-WALL® is a registered trademark owned by The Neel Company. ©2012 The Neel Company

PRECASTER: CONCRETE SYSTEMS, INC.
HUDSON, NH
PROJECT #: T21882

CONTRACTOR:

PROJECT #:

DESIGNER

THE NEEL COMPANY
8328-D TRAFORD LANE
SPRINGFIELD, VIRGINIA 22152
PH: (703) 913-7858
FX: (703) 913-7859
WEB: WWW.NEELCO.COM

PROJECT #: TW4301

CERTIFIED WITH RESPECT
TO INTERNAL STABILITY OF
T-WALL® STRUCTURES ONLY

REVISIONS	

FABRICATION DRAWING
8-6-14


RIGIDIFIED TUBE FRP ARCH (RTFA) PROJECT

FAIRFIELD, VT


FABRICATION DRAWING
SPECIAL UNIT SP5

T-WALL® RETAINING WALL SYSTEM


SCALE:	1" = 1'-0"
DATE:	8-6-14
DESIGNED BY:	KD
DRAWN BY:	ABC
CHECKED BY:	KD
SHEET:	TW-FB6

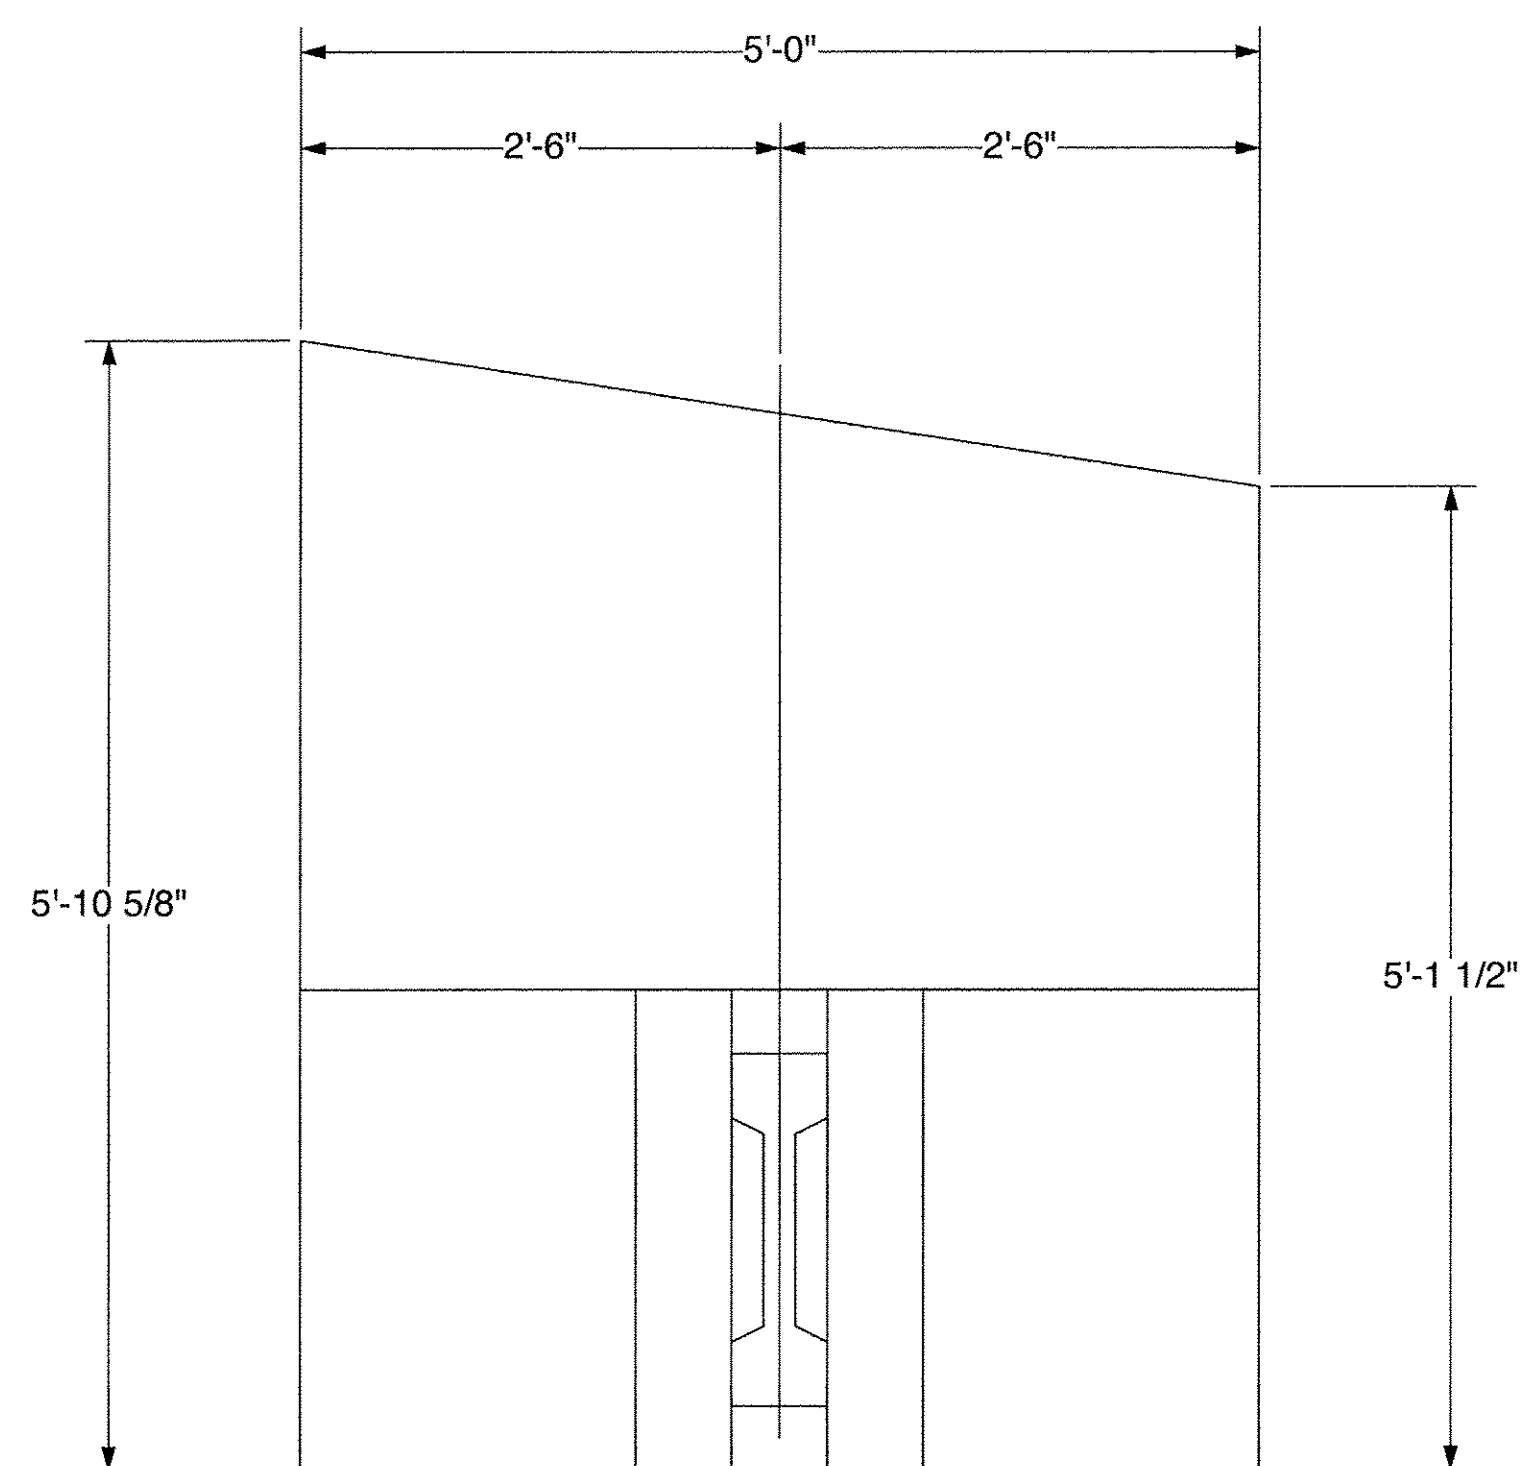

SP6 - FRONT VIEW

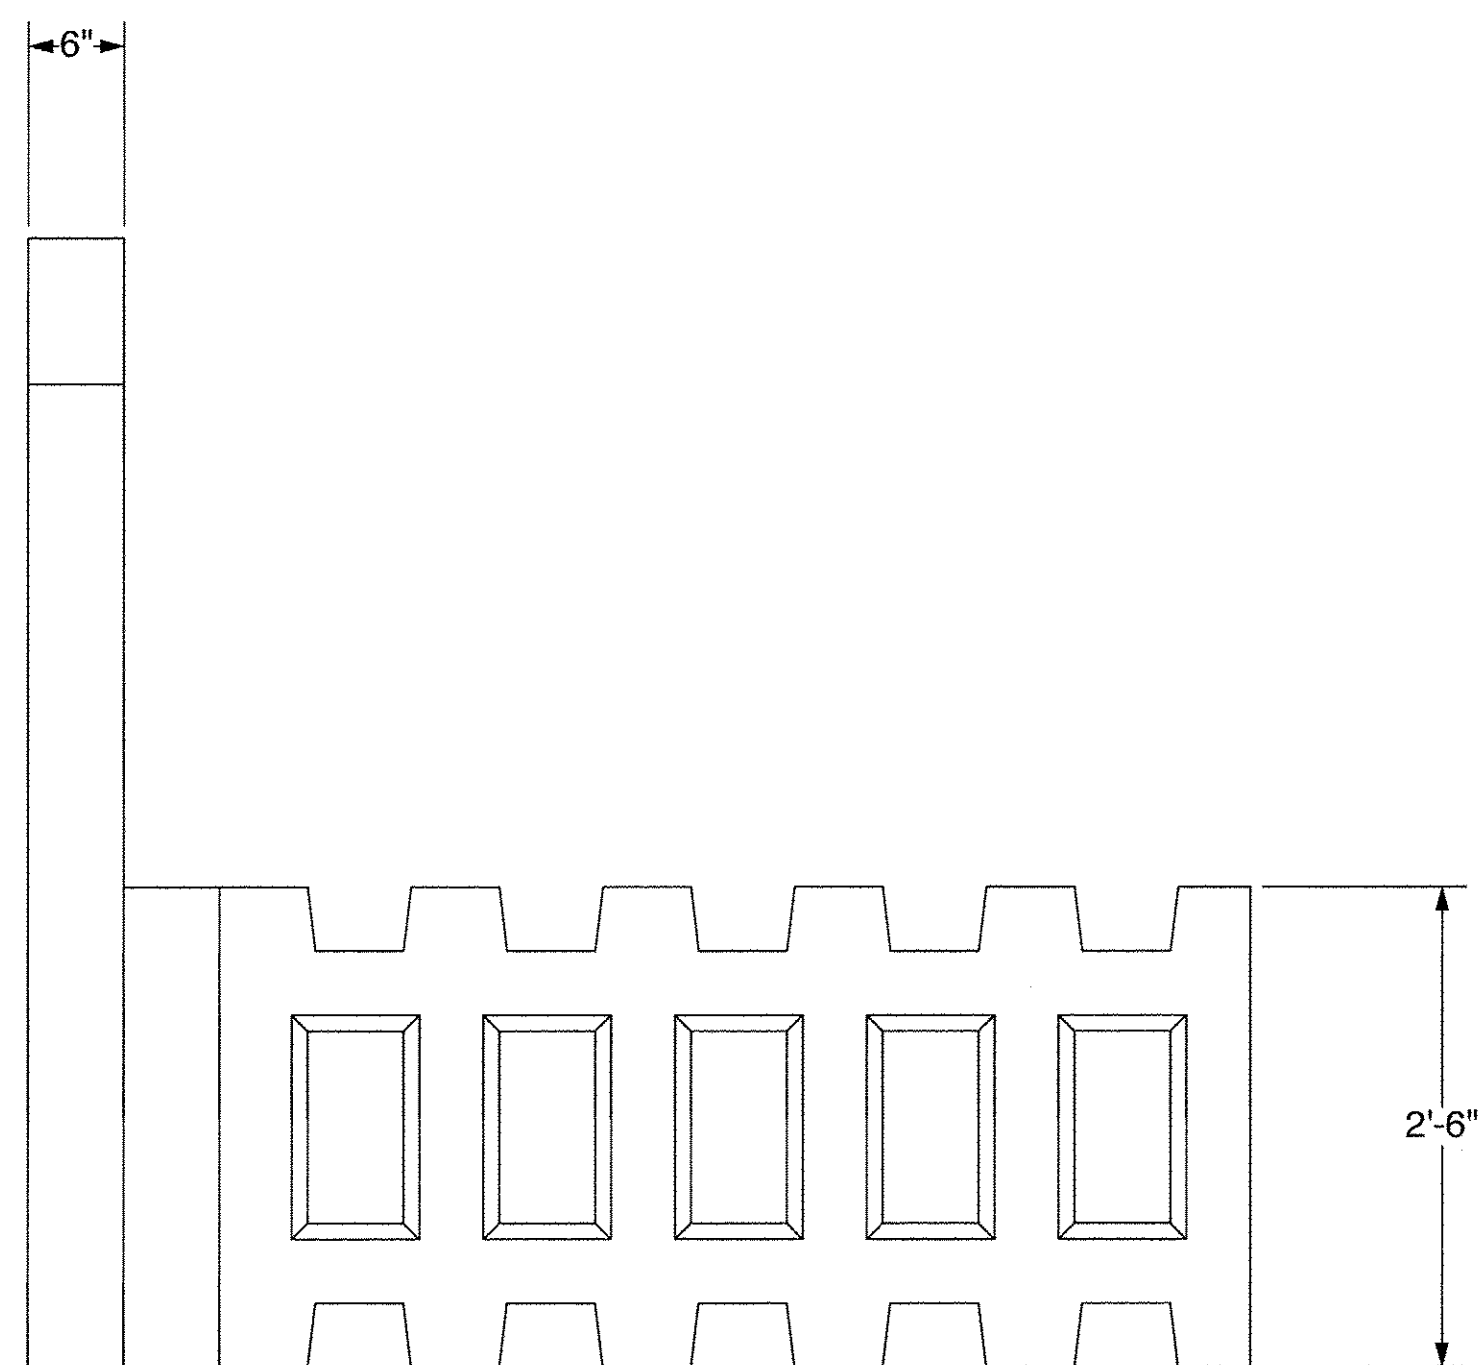

SP6 - SIDE VIEW

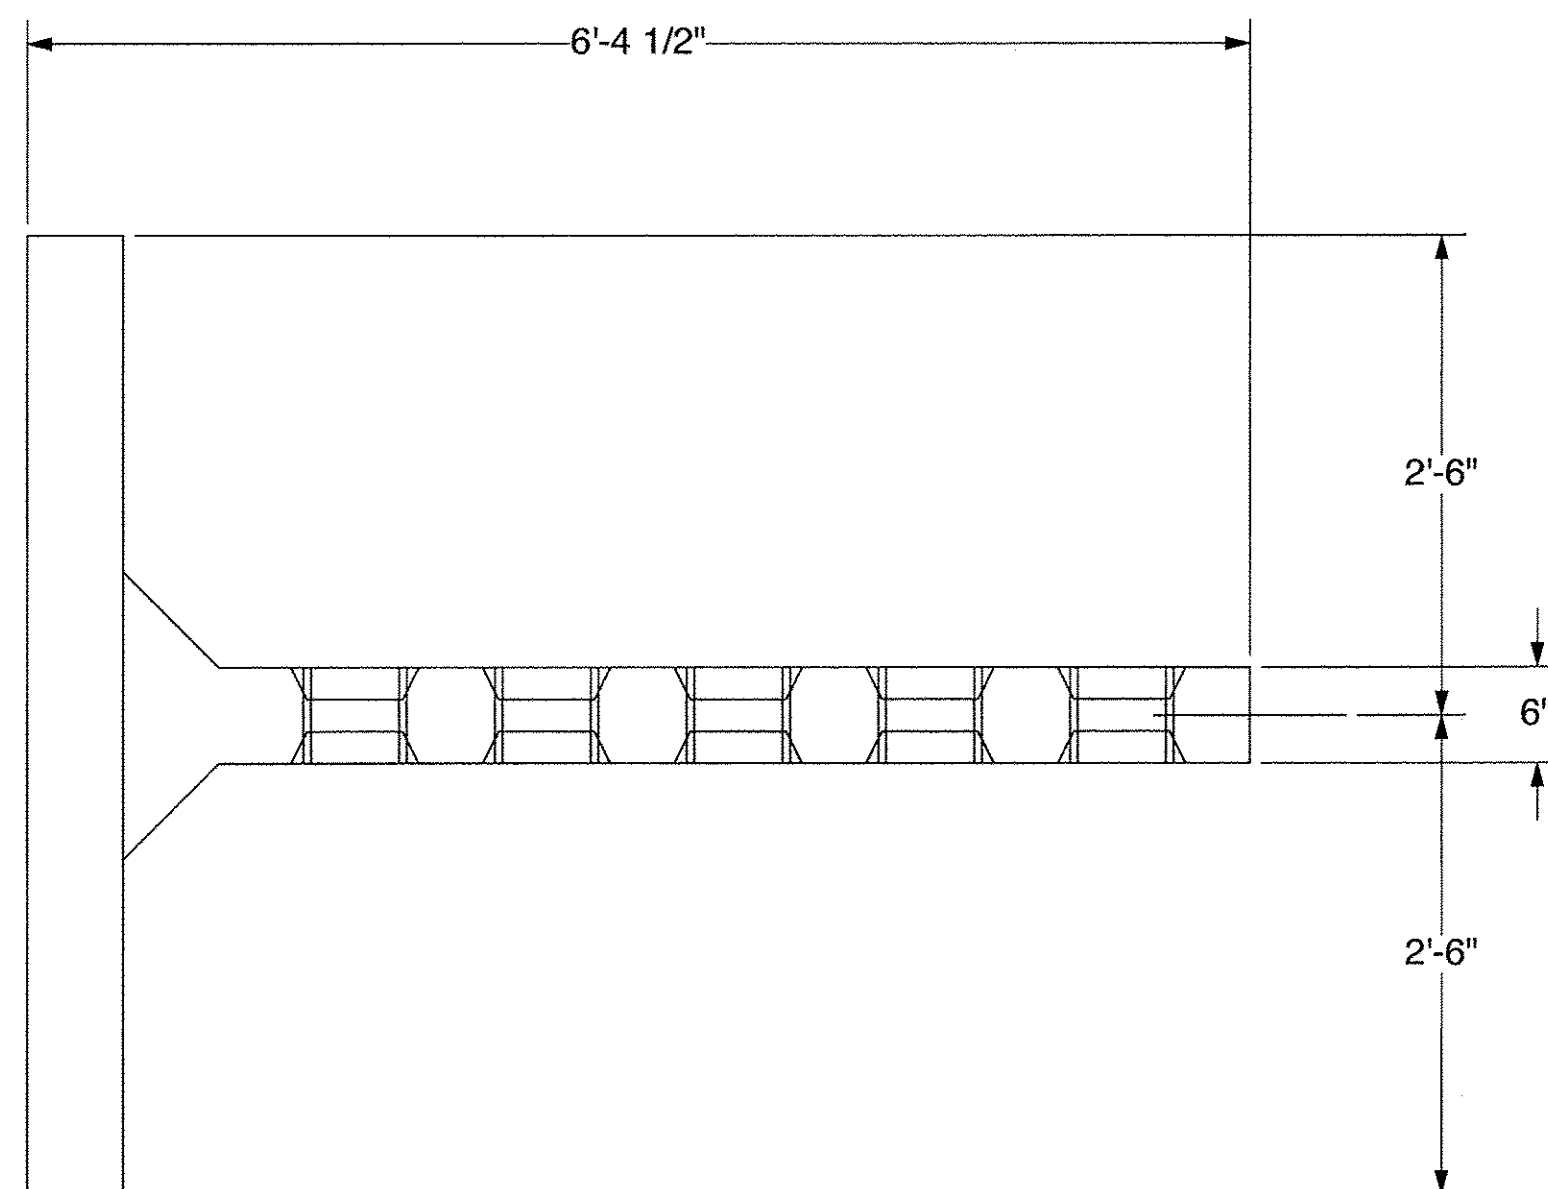

SP6 - PLAN VIEW

**FABRICATION DRAWING
8-6-14**

RIGIDIFIED TUBE FRP ARCH (RTFA) PROJECT

FAIRFIELD, VT
FABRICATION DRAWING
SPECIAL UNIT SP6
T-WALL® RETAINING WALL SYSTEM


SCALE:	1" = 1'-0"
DATE:	8-6-14
DESIGNED BY:	KD
DRAWN BY:	ABC
CHECKED BY:	KD
SHEET:	TW-FB7

Approved **Approved As Noted**
 Rejected

This review is only for general conformance with the design concept and the information given in the Construction Documents. Corrections or comments made on the shop drawings during the review do not relieve the Contractor from compliance with the requirements of the Plans and Specifications. Review of a specific item shall not include review of an assembly of which an item is a component. The Contractor is responsible for dimensions to be confirmed and corrected at the job site; information that pertains solely to the fabrication process or to the means, methods, techniques, sequences and procedures of construction; coordination of the Work with that of other trades and performing all Work in a safe and satisfactory manner.

Date 8/8/2014

By T. Traver

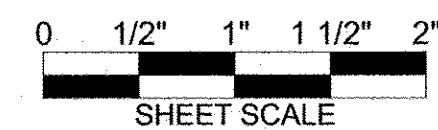

The design contained on these drawings is based upon information provided by the owner. On the basis of this information, The Neel Company has designed, and is responsible for, the internal stability of the structure only. External stability, including foundation and slope stability, is the responsibility of the owner.

This drawing contains information proprietary to The Neel Company. T-WALL® is a registered trademark owned by The Neel Company. ©2012 The Neel Company

PRECASTER: CONCRETE SYSTEMS, INC.
HUDSON, NH
PROJECT #: T21882

CONTRACTOR:
PROJECT #:

DESIGNER


THE NEEL COMPANY
8328-D TRAFORD LANE
SPRINGFIELD, VIRGINIA 22152
PH: (703) 913-7858
FX: (703) 913-7859
WEB: WWW.NEELCO.COM

PROJECT #: TW4301


CERTIFIED WITH RESPECT
TO INTERNAL STABILITY OF
T-WALL® STRUCTURES ONLY

REVISIONS

BORDER-TNC T-WALL HWY v4.1

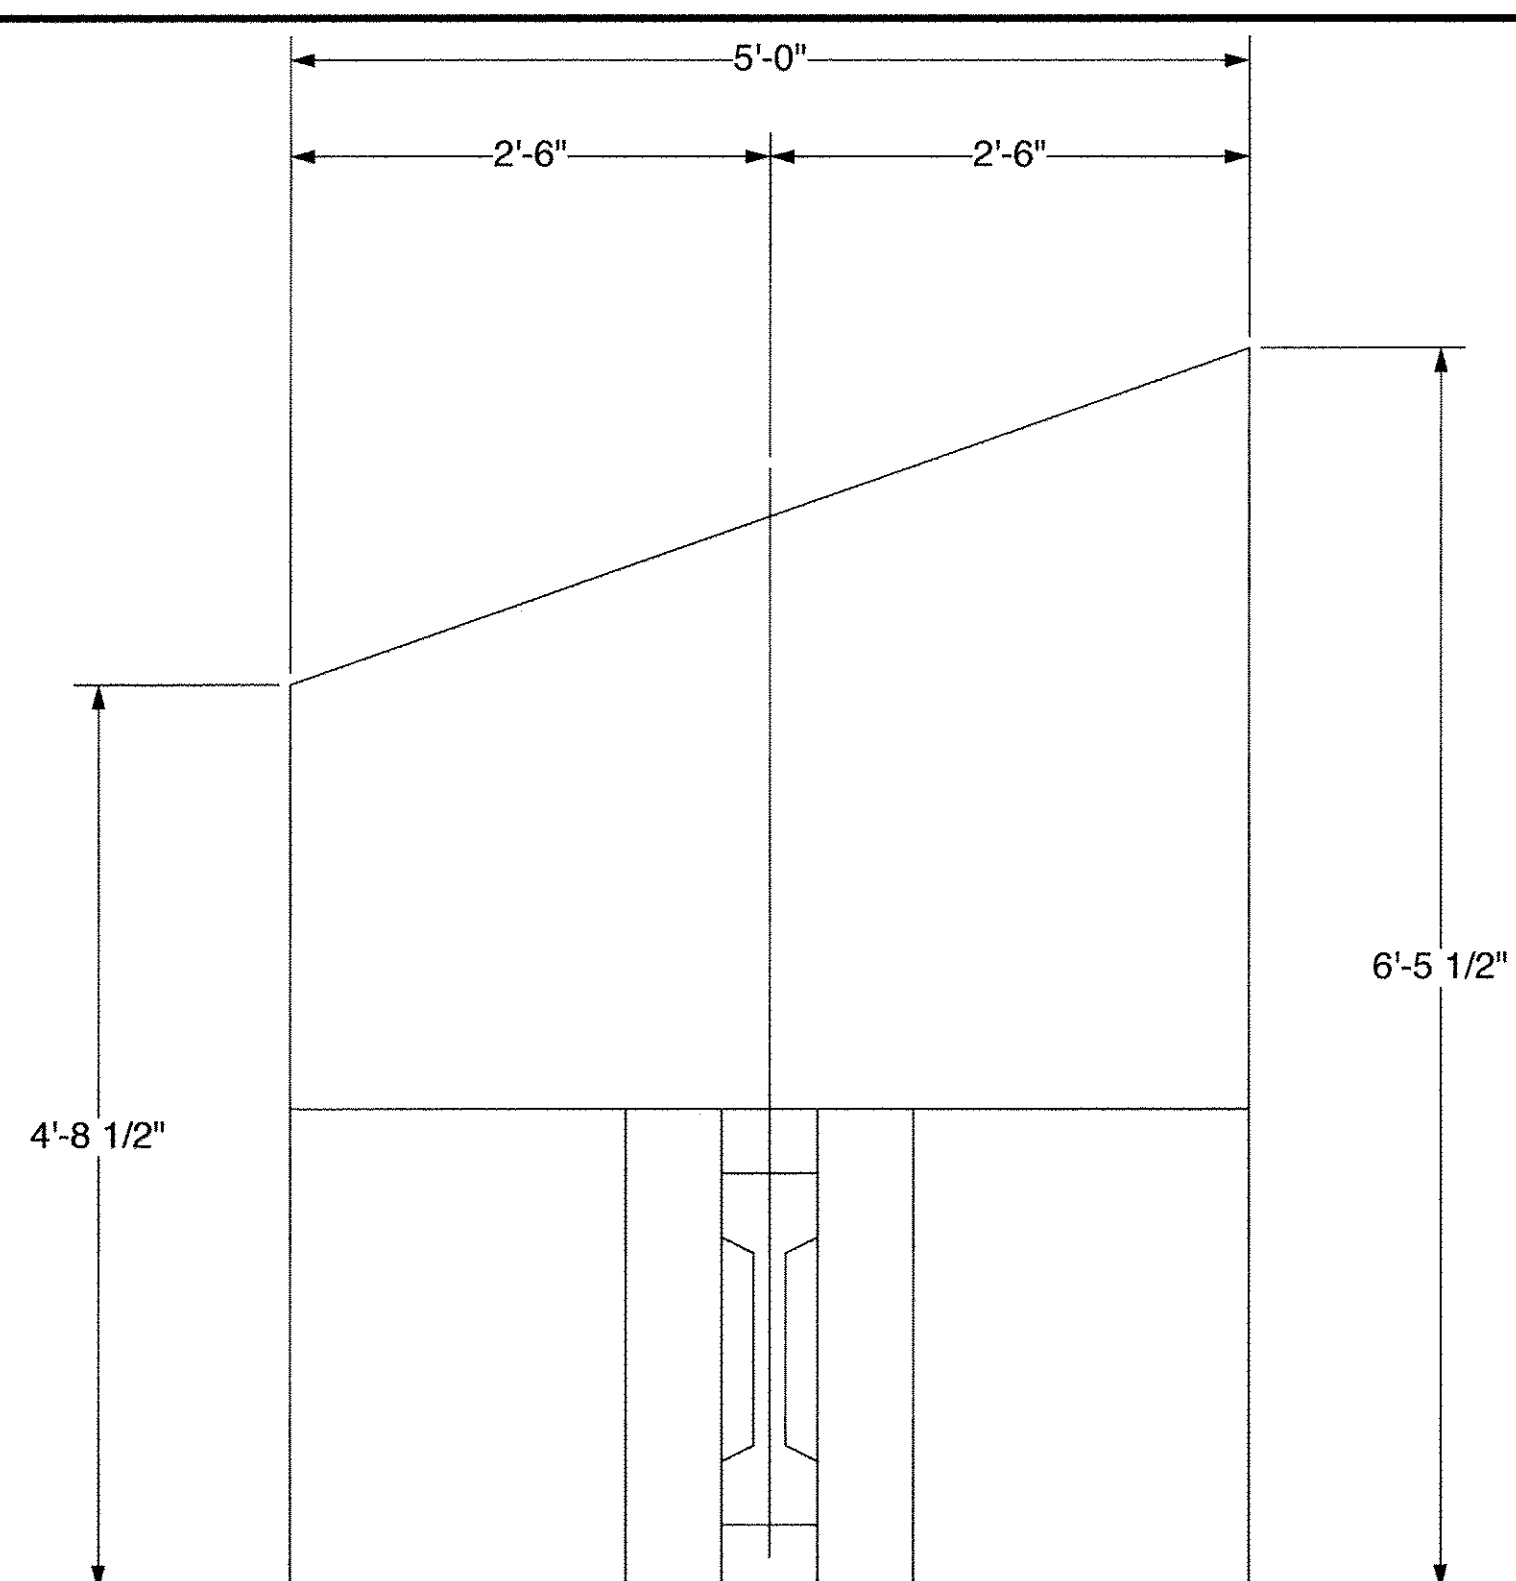

SP7 - FRONT VIEW

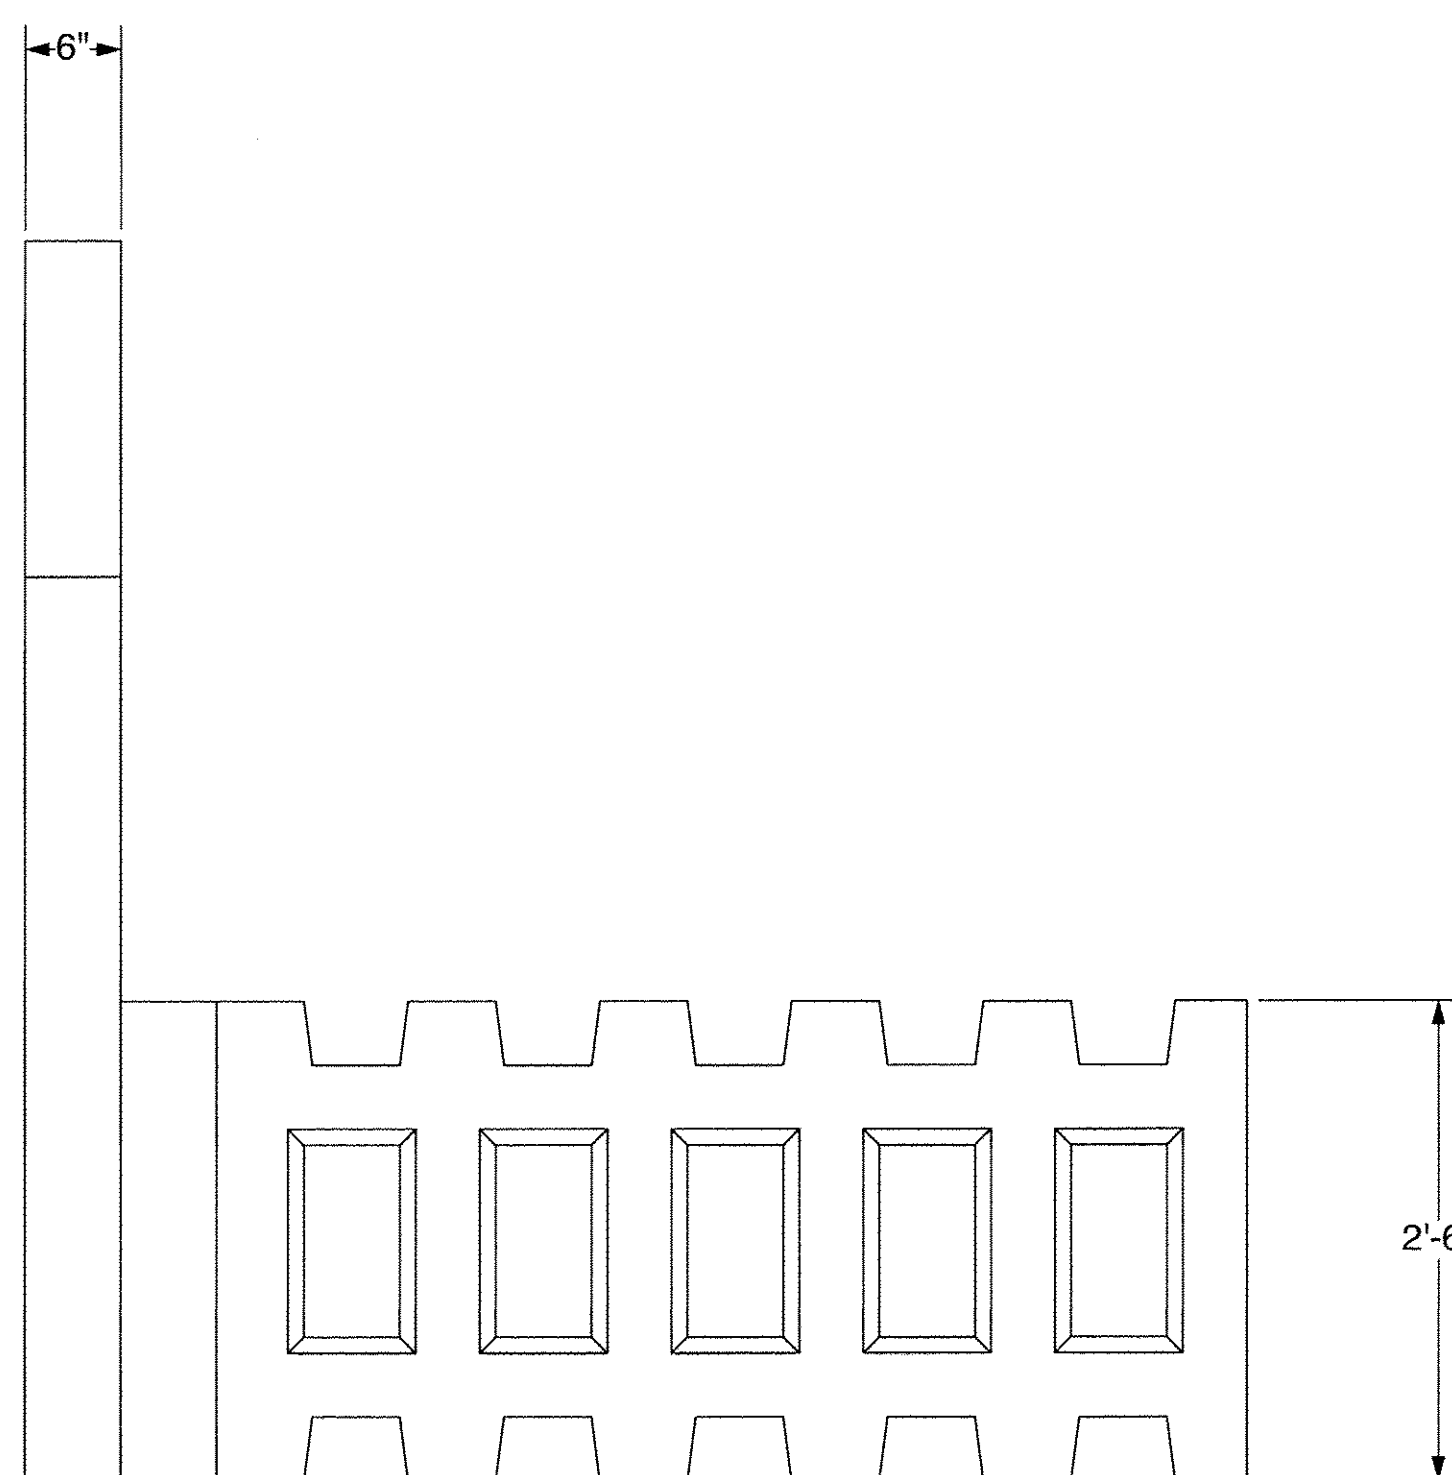

SP7 - SIDE VIEW

Approved
 Rejected


Approved As Noted

This review is only for general conformance with the design concept and the information given in the Construction Documents. Corrections or comments made on the shop drawings during the review do not relieve the Contractor from compliance with the requirements of the Plans and Specifications. Review of a specific item shall not include review of an assembly of which an item is a component. The Contractor is responsible for dimensions to be confirmed and corrected at the job site; information that pertains solely to the fabrication process or to the means, methods, techniques, sequences and procedures of construction; coordination of the Work with that of other trades and performing all Work in a safe and satisfactory manner.

Date 8/8/2014


By T. Traver

 **McFarland Johnson**

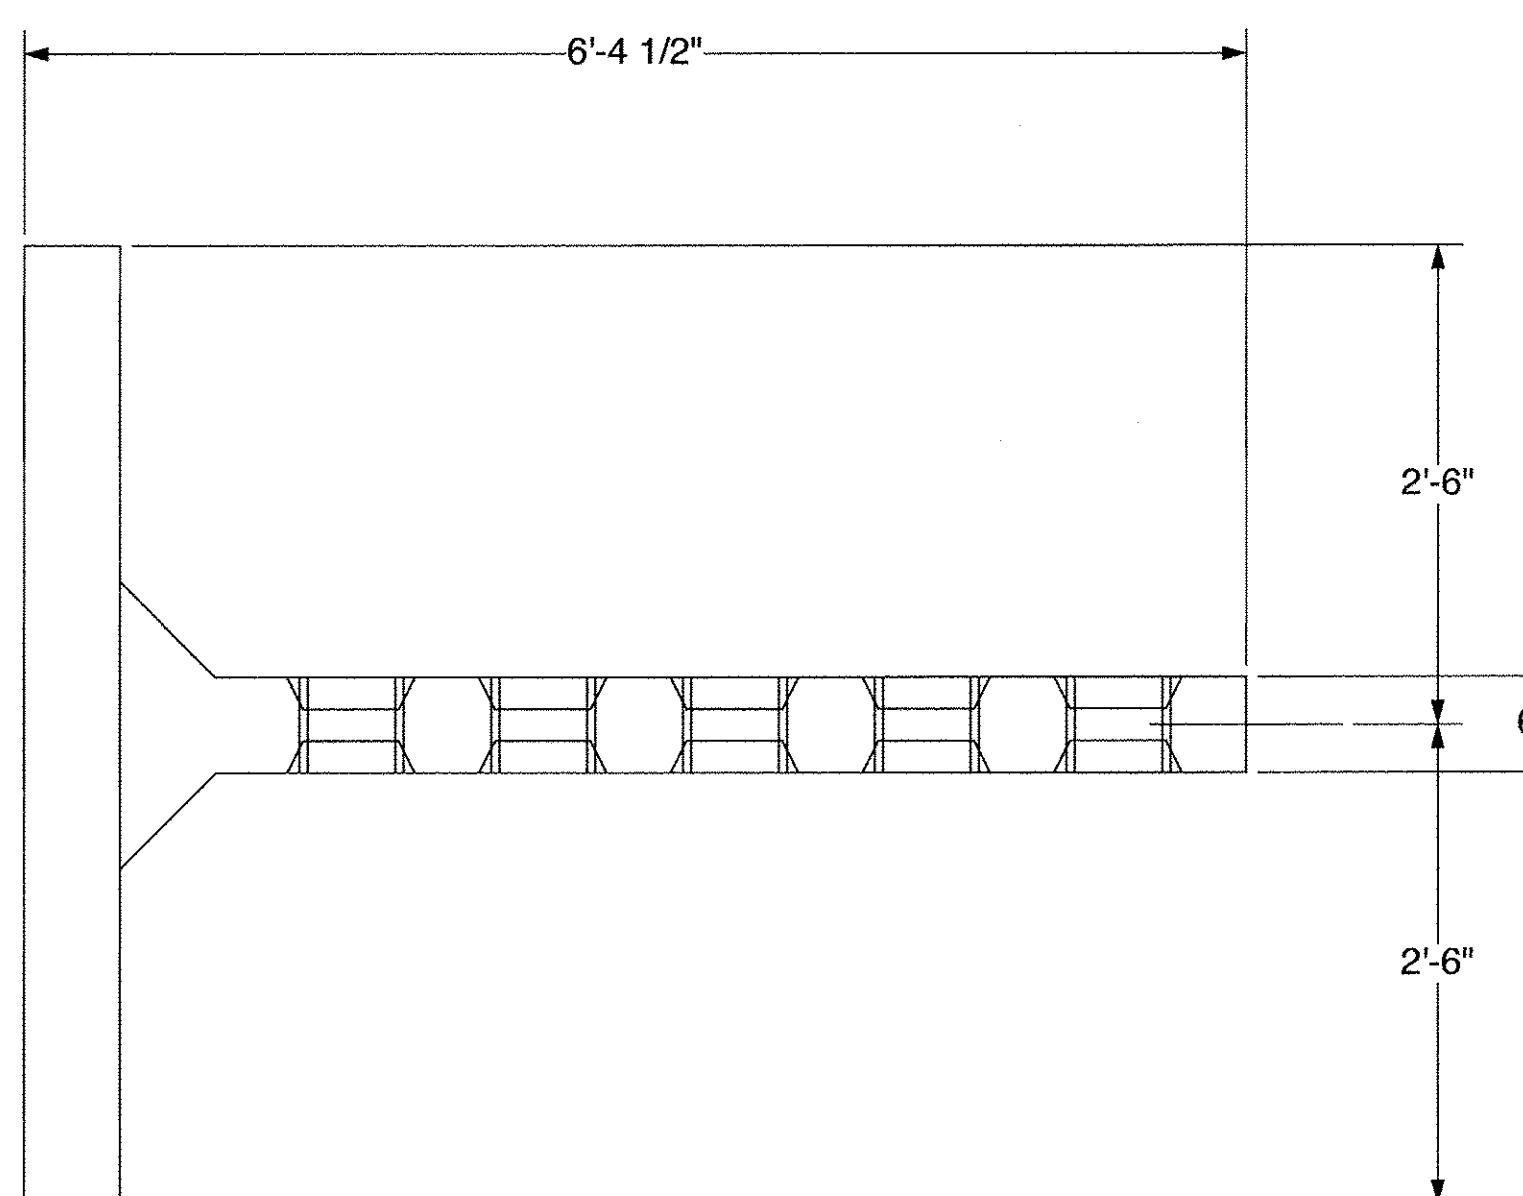

SP7 - PLAN VIEW

**FABRICATION DRAWING
8-6-14**

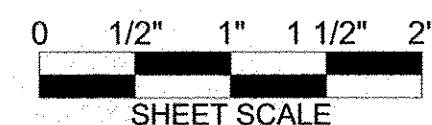

The design contained on these drawings is based upon information provided by the owner. On the basis of this information, The Neel Company has designed, and is responsible for, the internal stability of the structure only. External stability, including foundation and slope stability, is the responsibility of the owner.

This drawing contains information proprietary to The Neel Company. T-WALL® is a registered trademark owned by The Neel Company. ©2012 The Neel Company

PRECASTER: CONCRETE SYSTEMS, INC.
HUDSON, NH
PROJECT #: T21882

CONTRACTOR:

PROJECT #:

DESIGNER

 **THE NEEL COMPANY**
8328-D TRAFORD LANE
SPRINGFIELD, VIRGINIA 22152
PH: (703) 913-7858
FX: (703) 913-7859
WEB: WWW.NEELCO.COM

PROJECT #: TW4301

CERTIFIED WITH RESPECT
TO INTERNAL STABILITY OF
T-WALL® STRUCTURES ONLY

REVISIONS	

RIGIDIFIED TUBE FRP ARCH (RTFA) PROJECT

FAIRFIELD, VT


FABRICATION DRAWING
SPECIAL UNIT SP7

T-WALL® RETAINING WALL SYSTEM


SCALE:	1" = 1'-0"
DATE:	8-6-14
DESIGNED BY:	KD
DRAWN BY:	ABC
CHECKED BY:	KD
SHEET:	TW-FB8

USER NAME: N/A
VECTORWORKS 2011

PLOT DATE & TIME: Wednesday, August 6, 2014 1:41:43 PM
CAD FILE NAME: C:\TW4301\Fab-SP Unit.rvt
VW SHEET NAME: TW-FB02

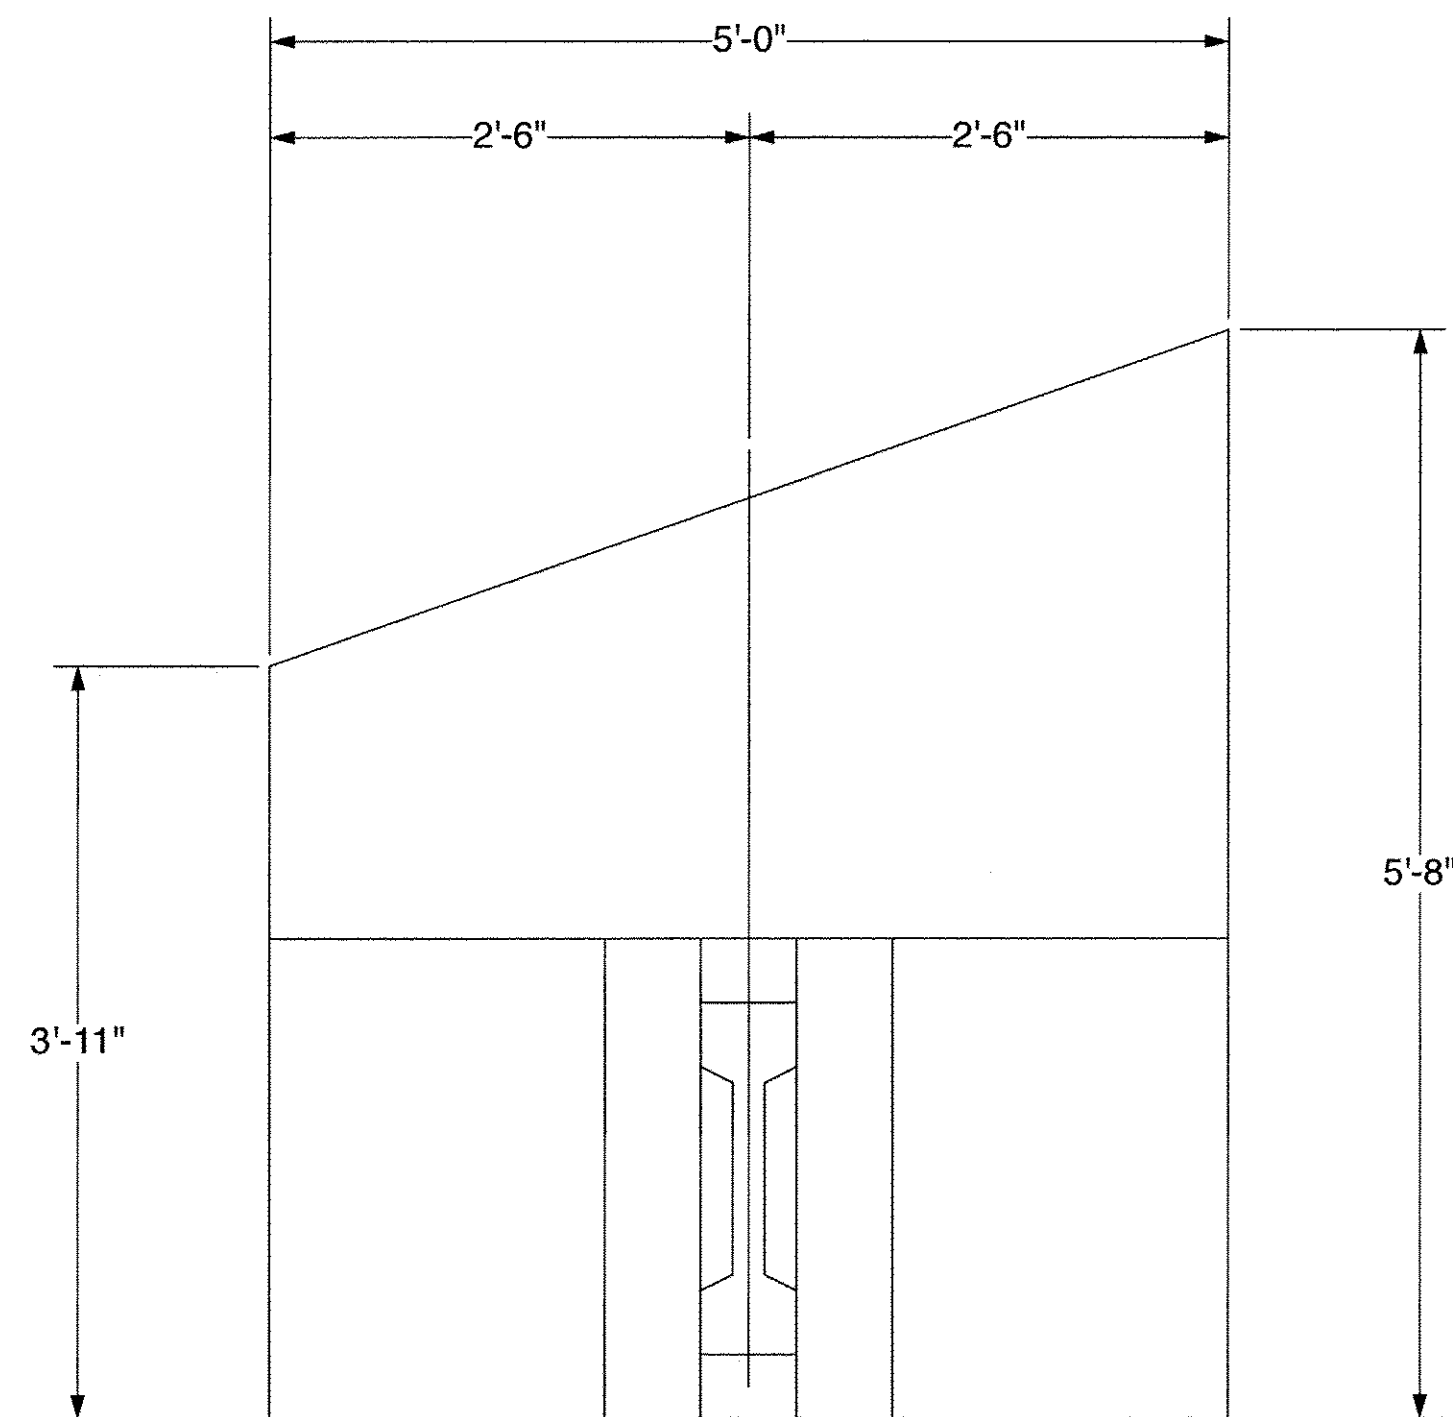

SP8 - FRONT VIEW

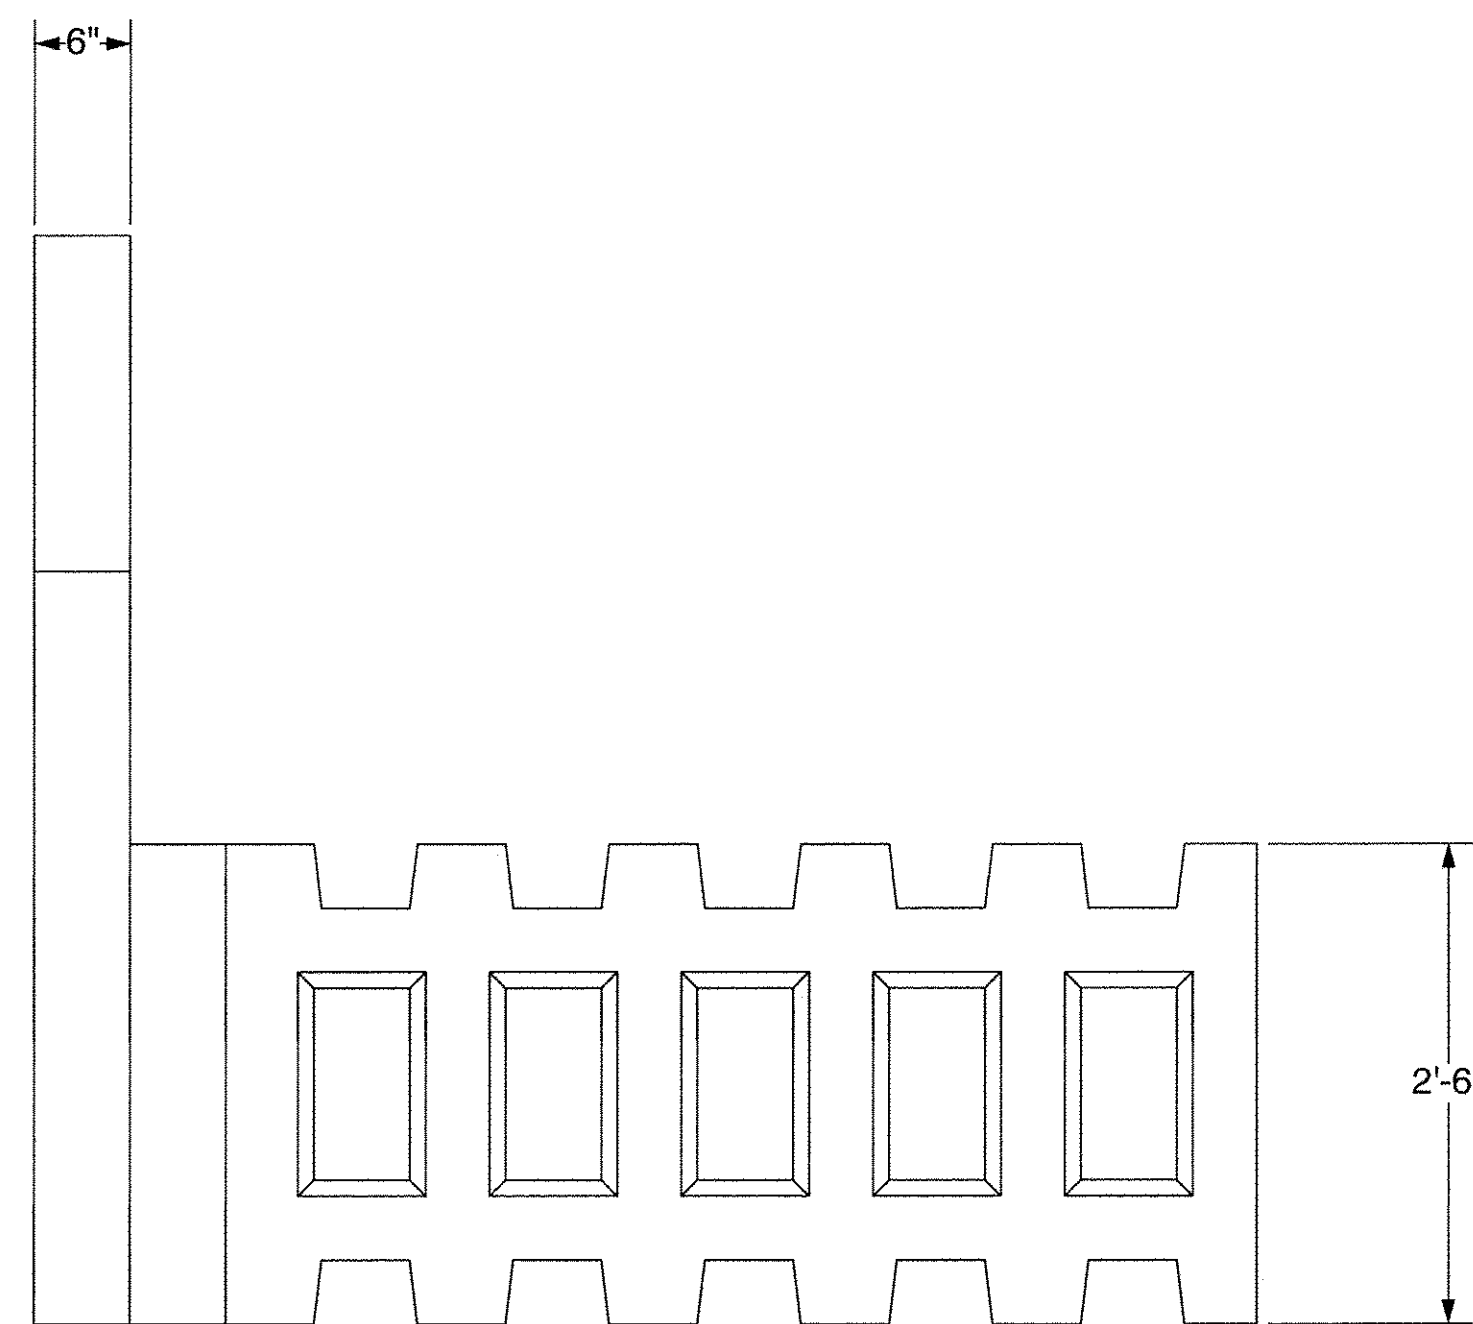


SP8 - SIDE VIEW

Approved **Approved As Noted**
 Rejected


This review is only for general conformance with the design concept and the information given in the Construction Documents. Corrections or comments made on the shop drawings during the review do not relieve the Contractor from compliance with the requirements of the Plans and Specifications. Review of a specific item shall not include review of an assembly of which an item is a component. The Contractor is responsible for dimensions to be confirmed and corrected at the job site; information that pertains solely to the fabrication process or to the means, methods, techniques, sequences and procedures of construction; coordination of the Work with that of other trades and performing all Work in a safe and satisfactory manner.

Date 8/8/2014

By T. Traver

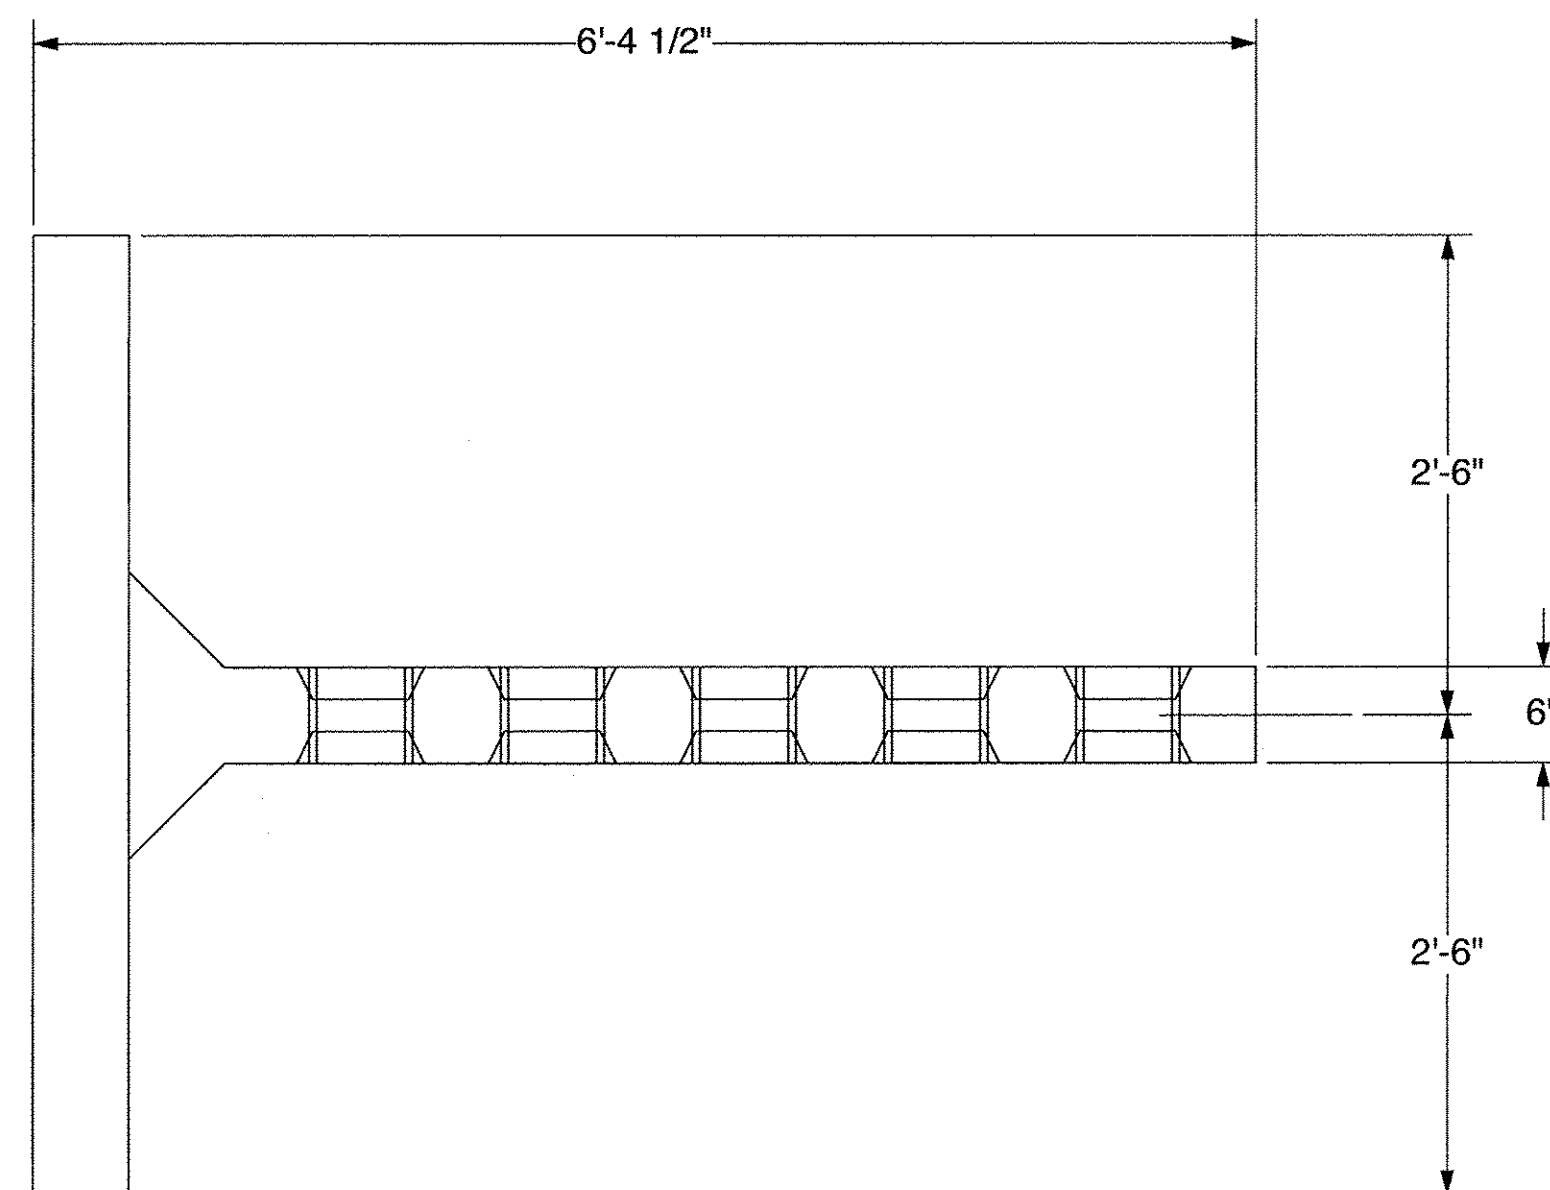

SP8 - PLAN VIEW

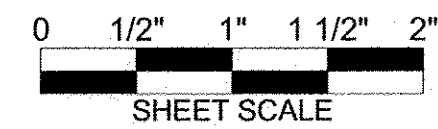

The design contained on these drawings is based upon information provided by the owner. On the basis of this information, The Neel Company has designed, and is responsible for, the internal stability of the structure only. External stability, including foundation and slope stability, is the responsibility of the owner.

This drawing contains information proprietary to The Neel Company. T-WALL® is a registered trademark owned by The Neel Company. ©2012 The Neel Company

PRECASTER: CONCRETE SYSTEMS, INC. HUDSON, NH PROJECT #: T21882
CONTRACTOR:
PROJECT #:

DESIGNER

THE NEEL COMPANY
8328-D TRAFORD LANE
SPRINGFIELD, VIRGINIA 22152
PH: (703) 913-7858
FX: (703) 913-7859
WEB: WWW.NEELCO.COM

PROJECT #: TW4301

CERTIFIED WITH RESPECT TO INTERNAL STABILITY OF T-WALL® STRUCTURES ONLY

REVISIONS	

FABRICATION DRAWING
8-6-14

RIGIDIFIED TUBE FRP ARCH (RTFA) PROJECT


FAIRFIELD, VT

FABRICATION DRAWING
SPECIAL UNIT SP8


T-WALL® RETAINING WALL SYSTEM

SCALE:	1" = 1'-0"
DATE:	8-6-14
DESIGNED BY:	KD
DRAWN BY:	ABC
CHECKED BY:	KD
SHEET:	TW-FB9

FABRICATION DRAWING
8-6-14

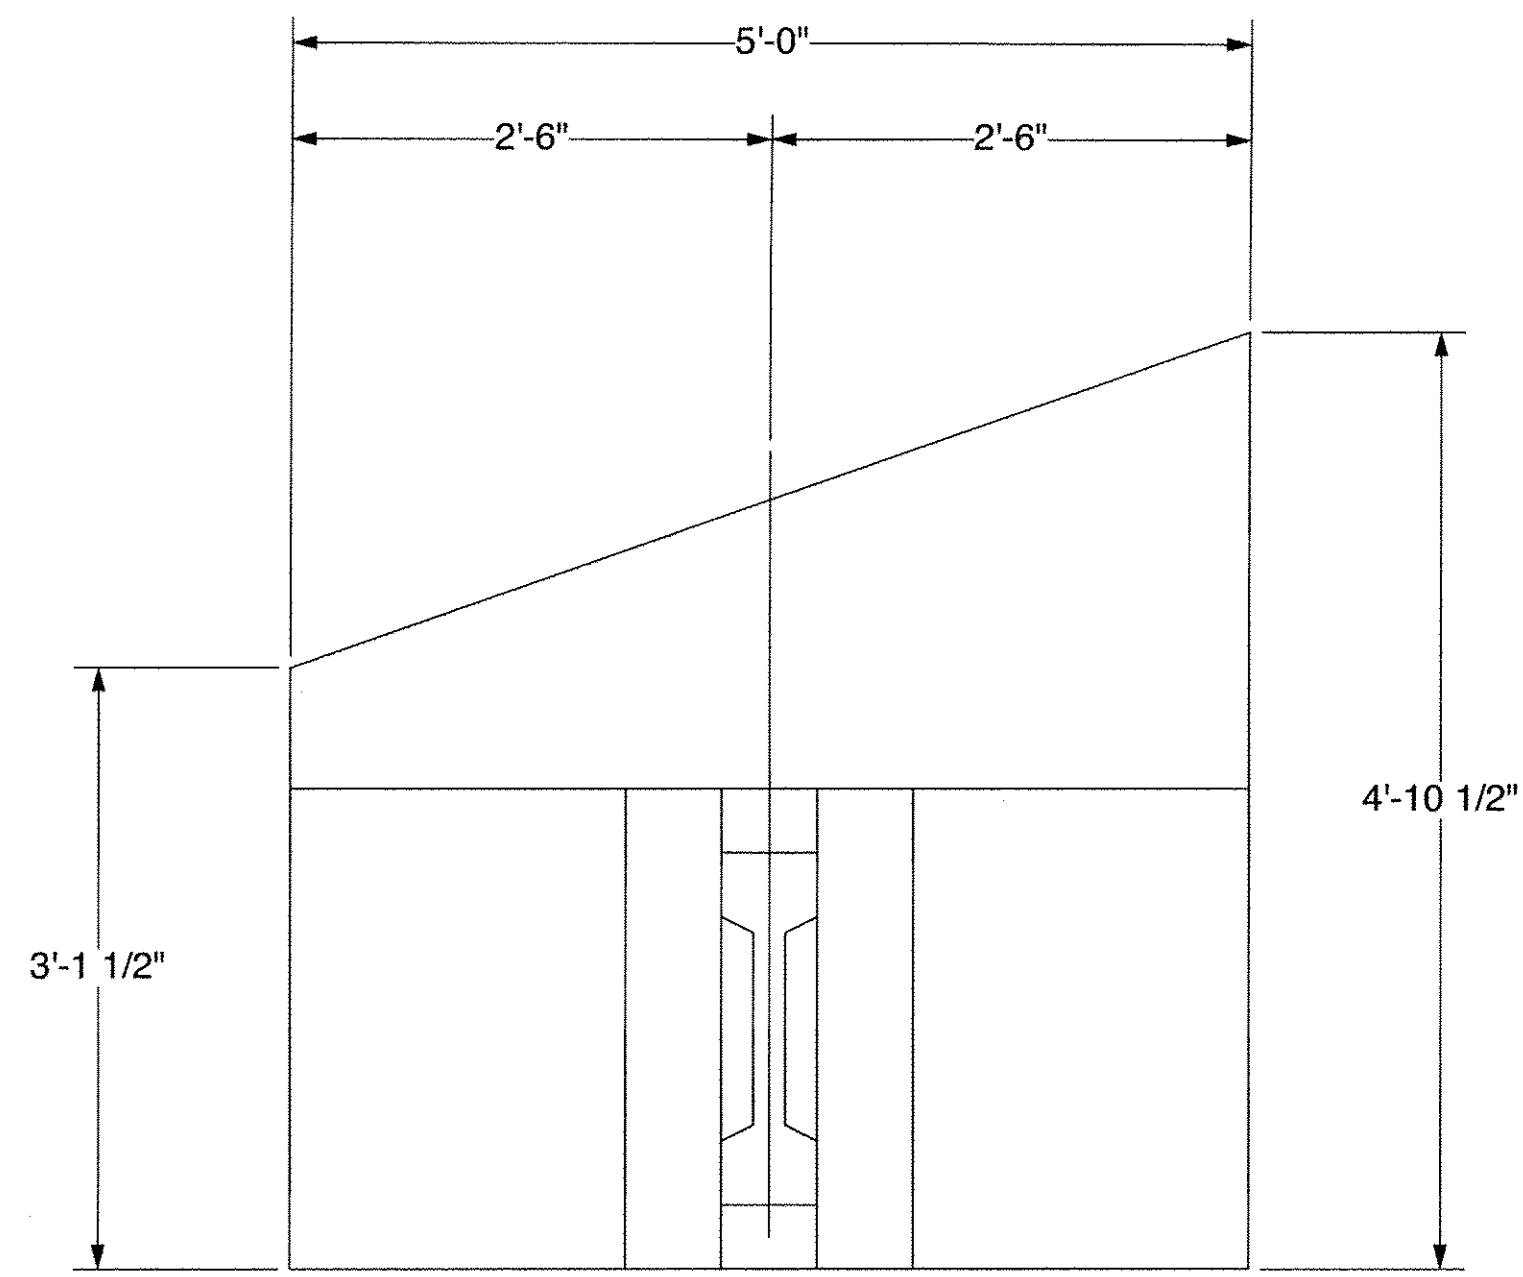


SP9 - FRONT VIEW

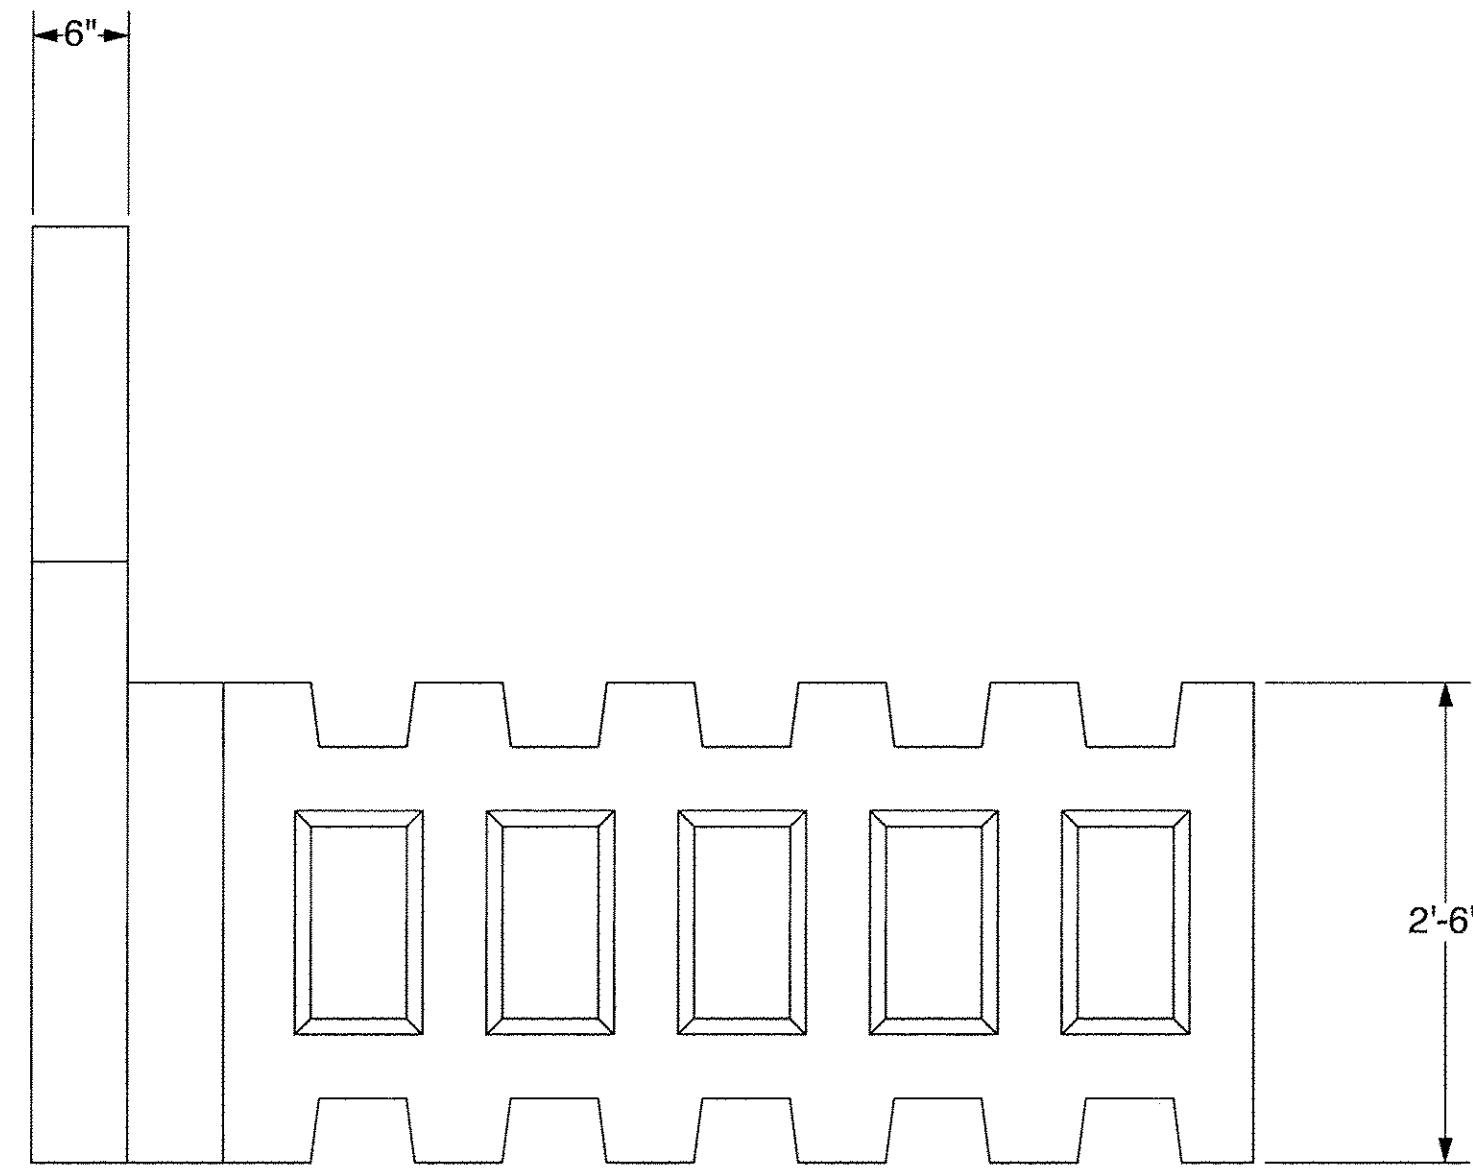


SP9 - SIDE VIEW

<input checked="" type="checkbox"/> Approved <input type="checkbox"/> Rejected	<input type="checkbox"/> Approved As Noted	
<p>This review is only for general conformance with the design concept and the information given in the Construction Documents. Corrections or comments made on the shop drawings during the review do not relieve the Contractor from compliance with the requirements of the Plans and Specifications. Review of a specific item shall not include review of an assembly of which an item is a component. The Contractor is responsible for dimensions to be confirmed and corrected at the job site; information that pertains solely to the fabrication process or to the means, methods, techniques, sequences and procedures of construction; coordination of the Work with that of other trades and performing all Work in a safe and satisfactory manner.</p>		
McFarland Johnson		
Date <u>8/8/2014</u> By <u>T. Traver</u>		

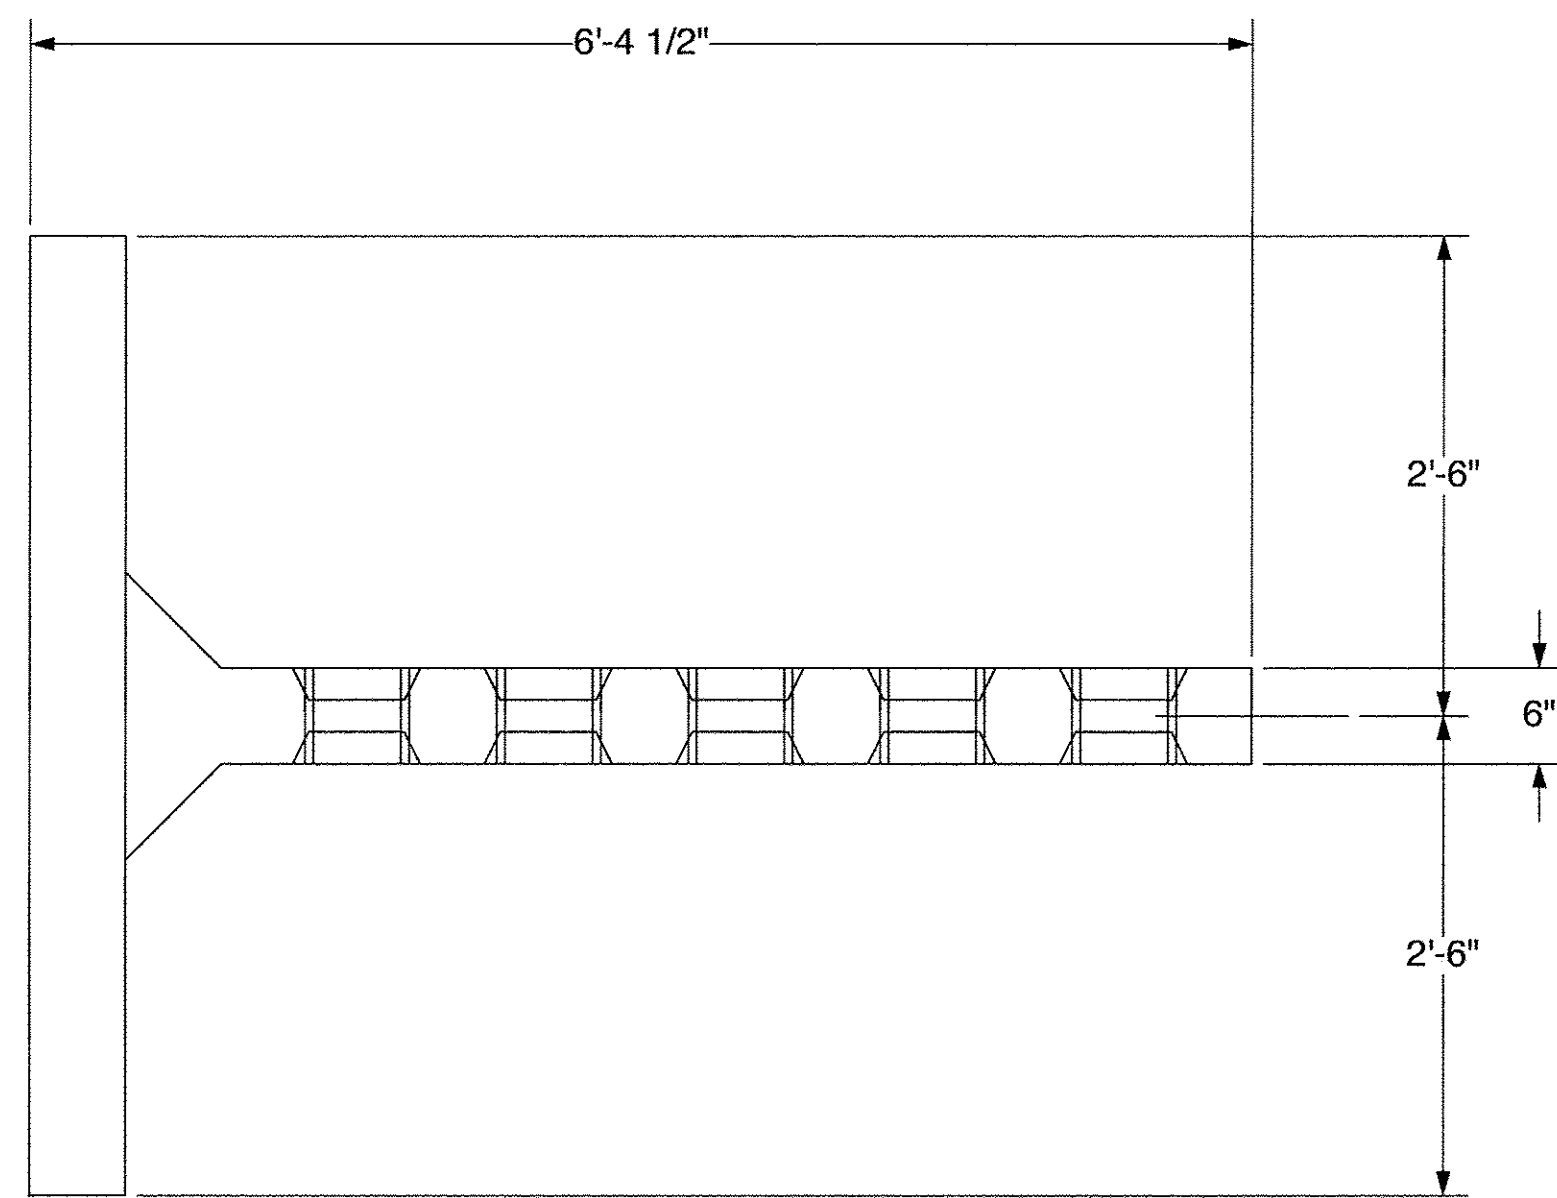

SP9 - PLAN VIEW

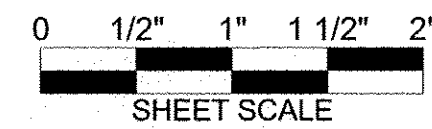

The design contained on these drawings is based upon information provided by the owner. On the basis of this information, The Neel Company has designed, and is responsible for, the internal stability of the structure only. External stability, including foundation and slope stability, is the responsibility of the owner.

This drawing contains information proprietary to The Neel Company. T-WALL® is a registered trademark owned by The Neel Company. ©2012 The Neel Company

PRECASTER: CONCRETE SYSTEMS, INC.
HUDSON, NH
PROJECT #: T21882

CONTRACTOR:
PROJECT #:

DESIGNER

THE NEEL COMPANY
8328-D TRAFORD LANE
SPRINGFIELD, VIRGINIA 22152
PH: (703) 913-7858
FX: (703) 913-7859
WEB: WWW.NEELCO.COM

PROJECT #: TW4301

CERTIFIED WITH RESPECT
TO INTERNAL STABILITY OF
T-WALL® STRUCTURES ONLY

REVISIONS	

FABRICATION DRAWING
8-6-14


RIGIDIFIED TUBE FRP ARCH (RTFA) PROJECT

FAIRFIELD, VT


FABRICATION DRAWING
SPECIAL UNIT SP9

T-WALL® RETAINING WALL SYSTEM

SCALE:	1" = 1'-0"
DATE:	8-6-14
DESIGNED BY:	KD
DRAWN BY:	ABC
CHECKED BY:	KD
SHEET:	TW-FB10

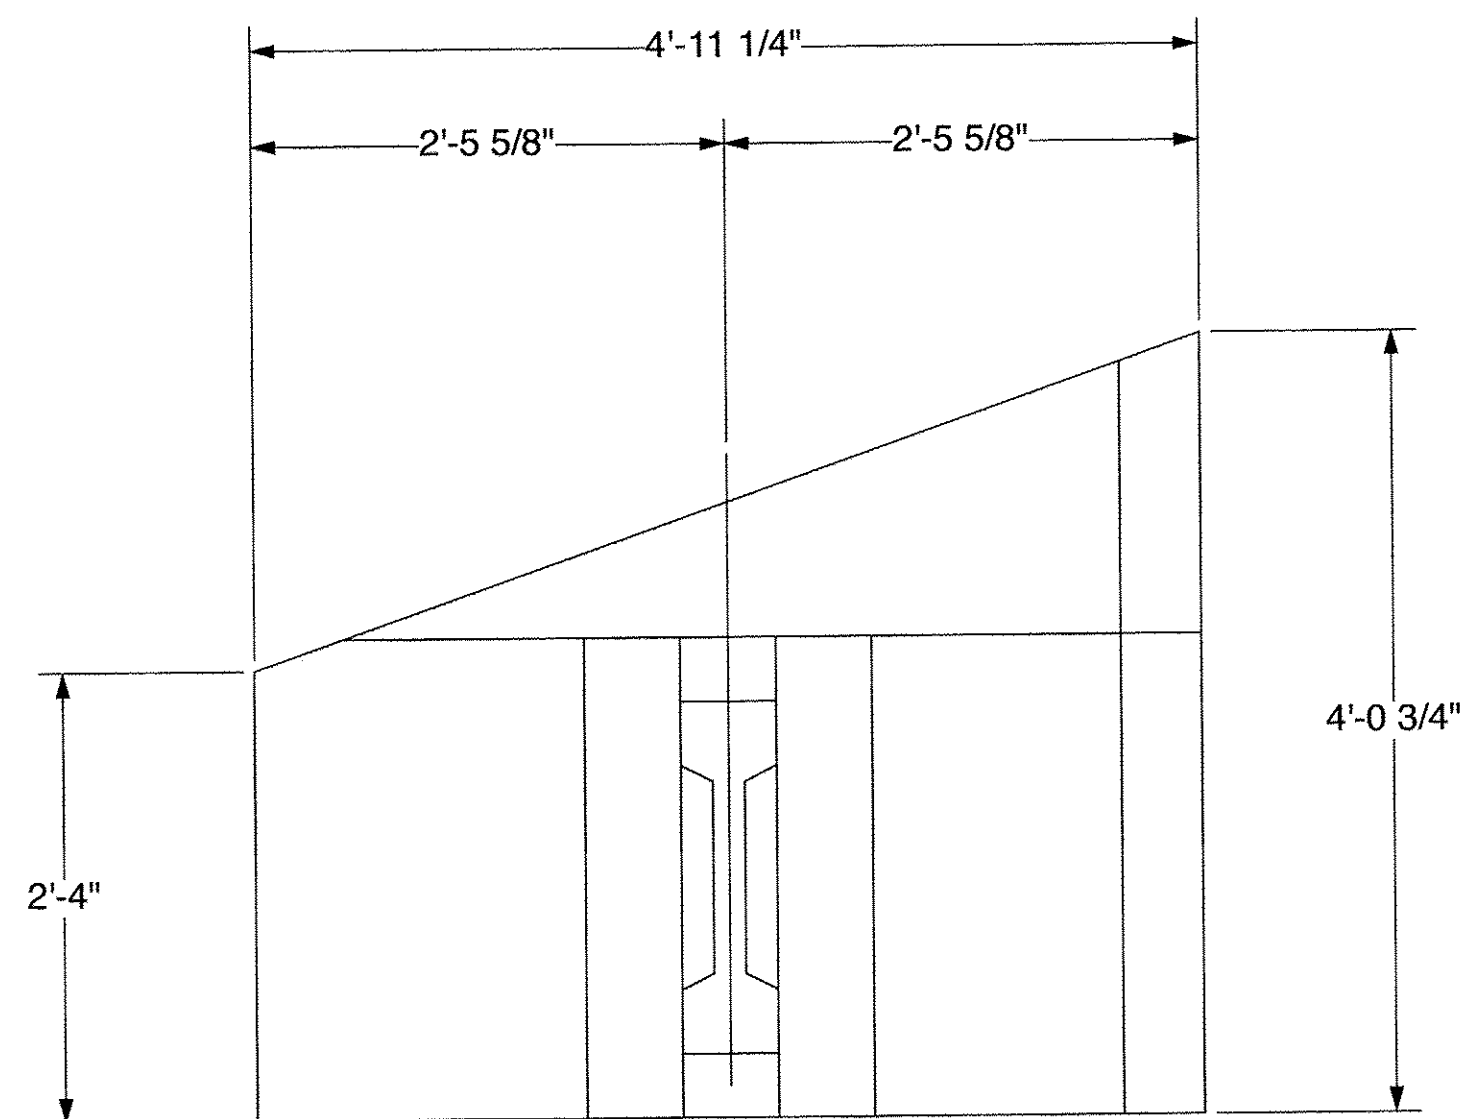


SP10 - FRONT VIEW

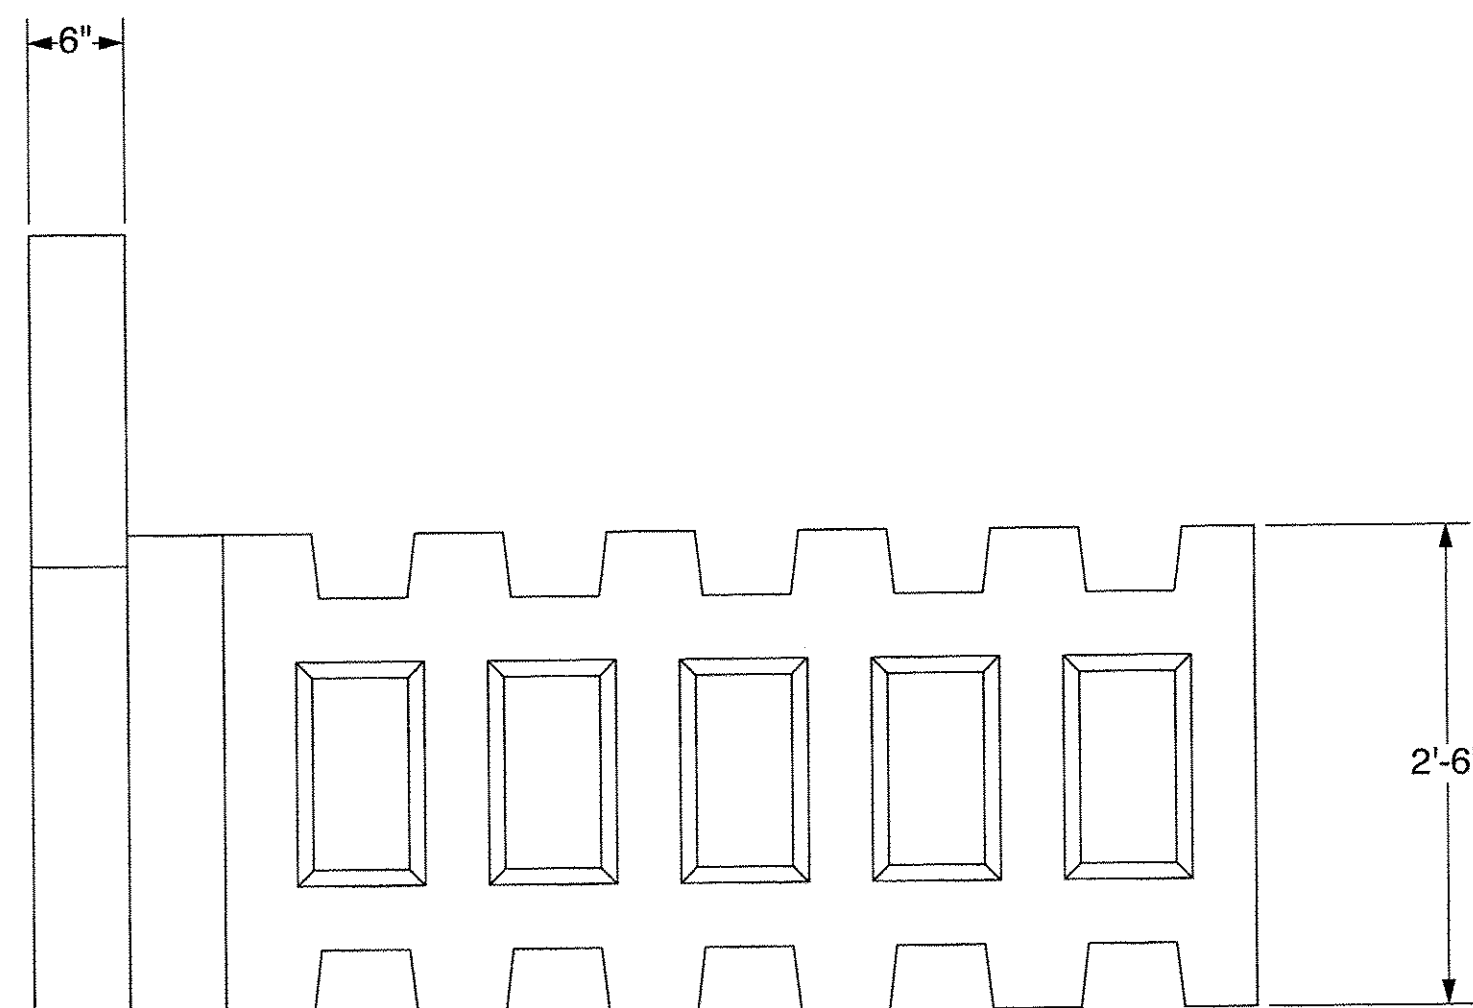

SP10 - SIDE VIEW

<input checked="" type="checkbox"/> Approved <input type="checkbox"/> Rejected	<input type="checkbox"/> Approved As Noted
<p>This review is only for general conformance with the design concept and the information given in the Construction Documents. Corrections or comments made on the shop drawings during the review do not relieve the Contractor from compliance with the requirements of the Plans and Specifications. Review of a specific item shall not include review of an assembly of which an item is a component. The Contractor is responsible for dimensions to be confirmed and corrected at the job site; information that pertains solely to the fabrication process or to the means, methods, techniques, sequences and procedures of construction; coordination of the Work with that of other trades and performing all Work in a safe and satisfactory manner.</p>	
<p>Date <u>8/8/2014</u></p>	
<p>By <u>T. Traver</u></p>	
McFarland Johnson	

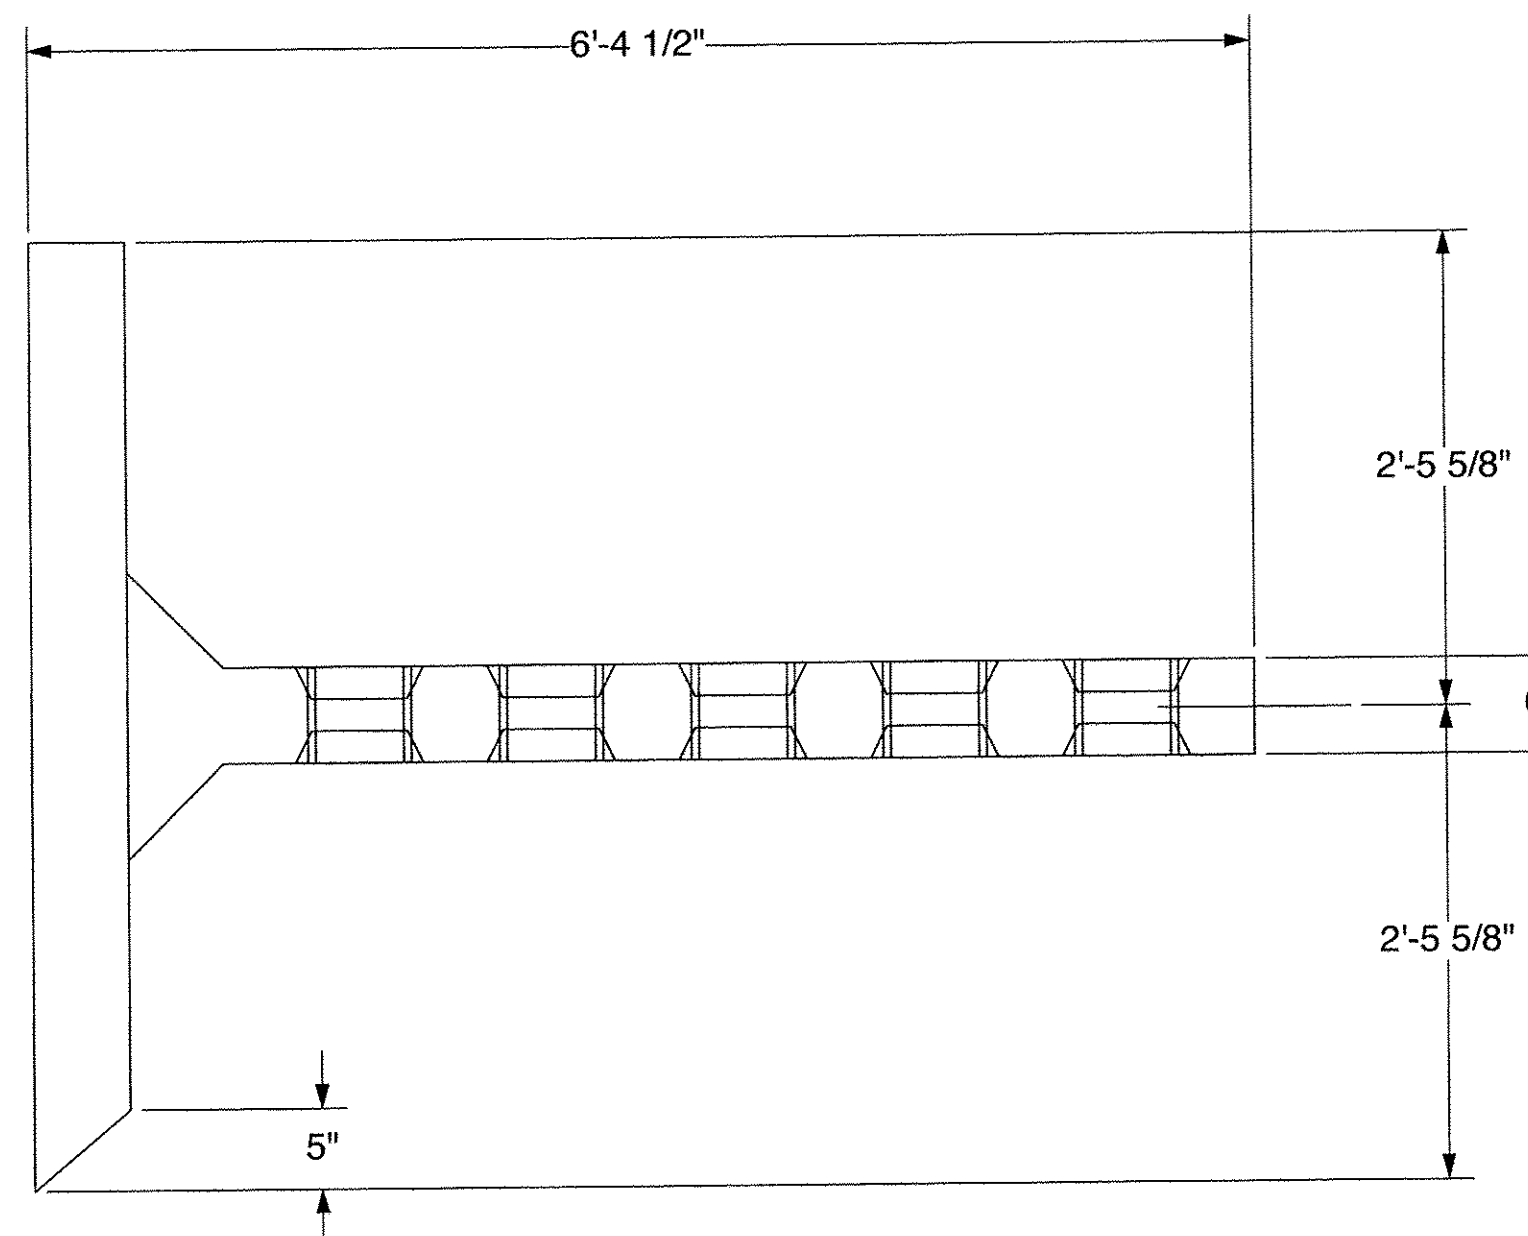

SP10 - PLAN VIEW

**FABRICATION DRAWING
8-6-14**


RIGIDIFIED TUBE FRP ARCH (RTFA) PROJECT

FAIRFIELD, VT

FABRICATION DRAWING
SPECIAL UNIT SP10

T-WALL® RETAINING WALL SYSTEM

SCALE:	1" = 1'-0"
DATE:	8-6-14
DESIGNED BY:	KD
DRAWN BY:	ABC
CHECKED BY:	KD
SHEET:	TW-FB11

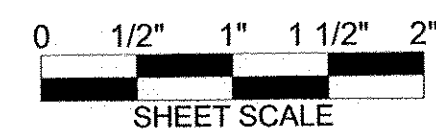

The design contained on these drawings is based upon information provided by the owner. On the basis of this information, The Neel Company has designed, and is responsible for, the internal stability of the structure only. External stability, including foundation and slope stability, is the responsibility of the owner.

This drawing contains information proprietary to The Neel Company. T-WALL® is a registered trademark owned by The Neel Company. ©2012 The Neel Company

PRECASTER: CONCRETE SYSTEMS, INC.
HUDSON, NH
PROJECT #: T21882

CONTRACTOR:
PROJECT #:

DESIGNER


THE NEEL COMPANY
8328-D TRAFORD LANE
SPRINGFIELD, VIRGINIA 22152
PH: (703) 913-7858
FX: (703) 913-7859
WEB: WWW.NEELCO.COM

PROJECT #: TW4301


CERTIFIED WITH RESPECT
TO INTERNAL STABILITY OF
T-WALL® STRUCTURES ONLY

REVISIONS


--	--

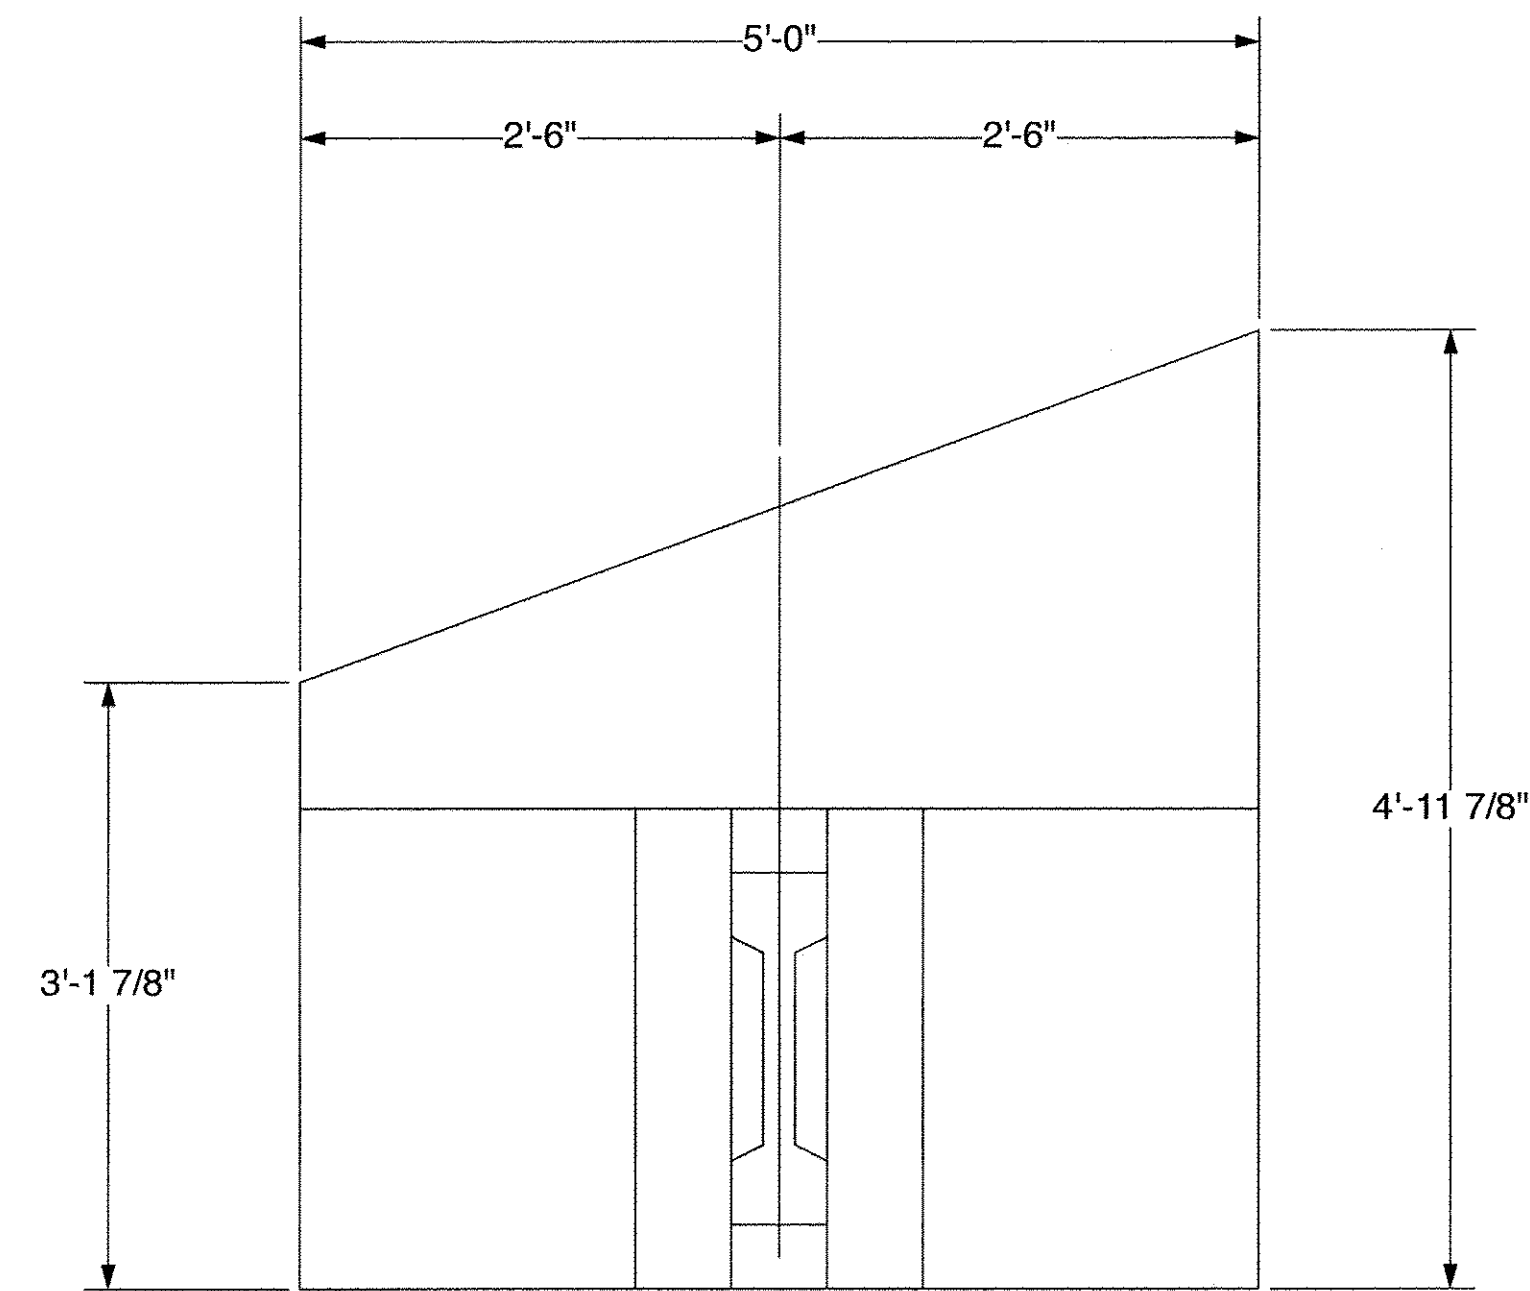

SP11 - FRONT VIEW

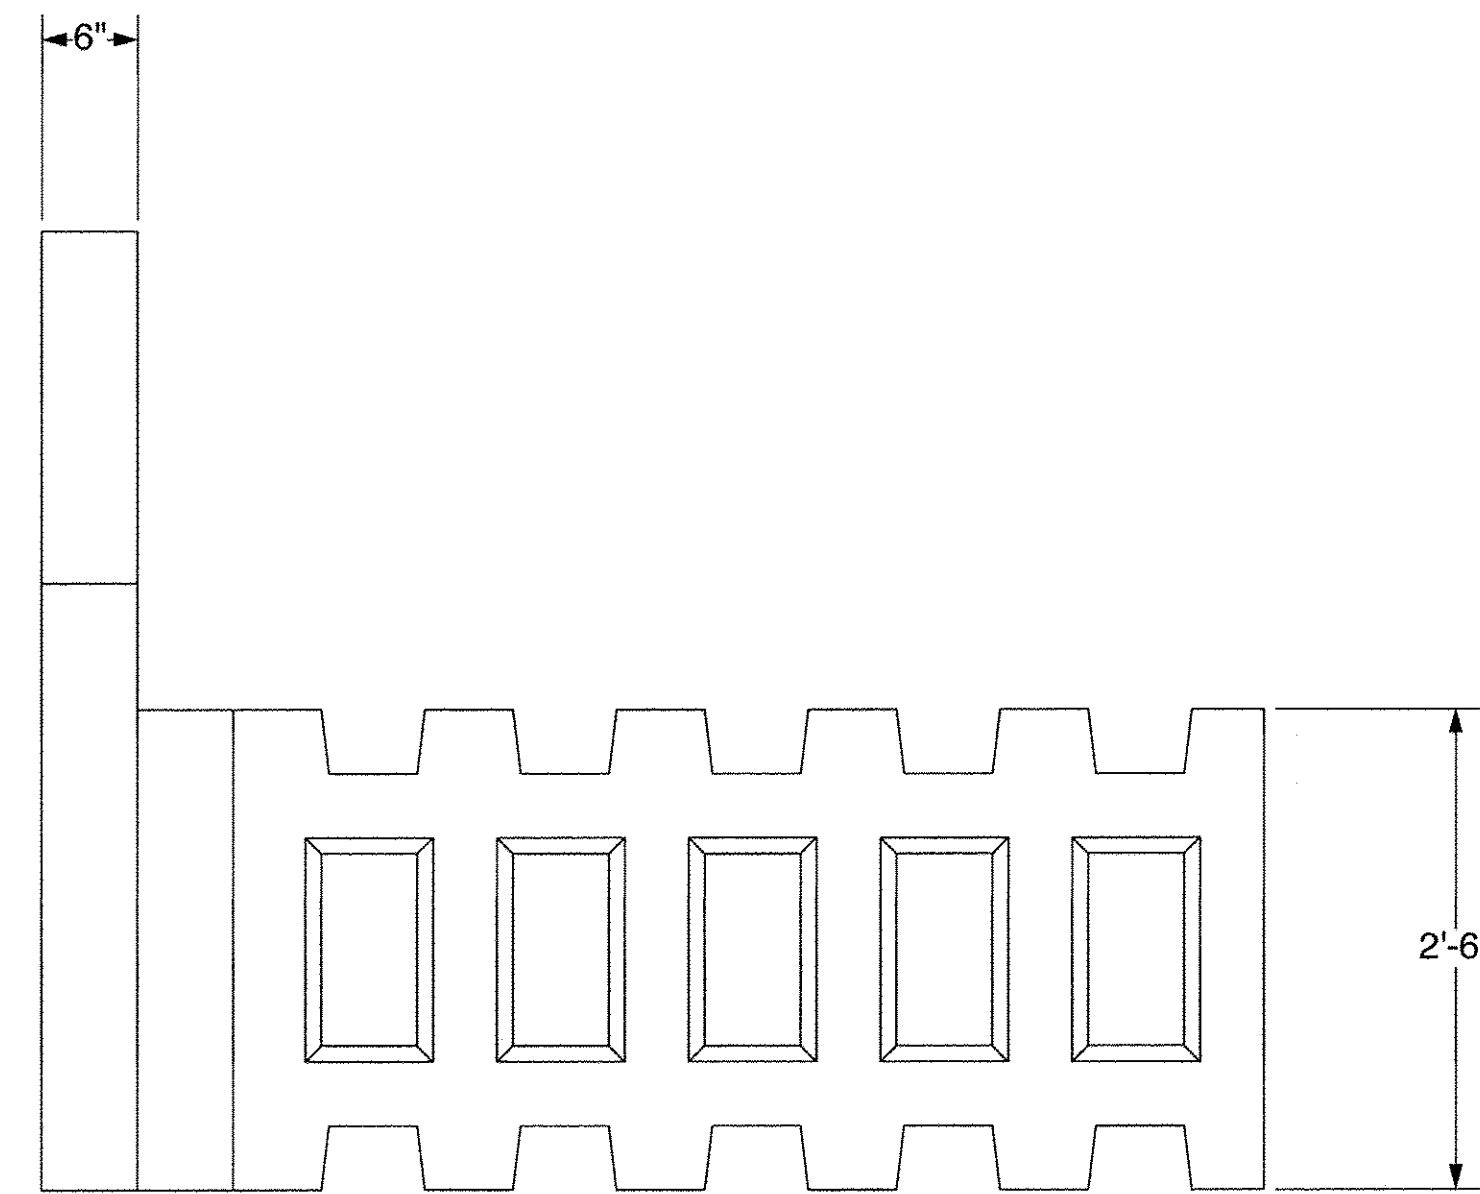

SP11 - SIDE VIEW

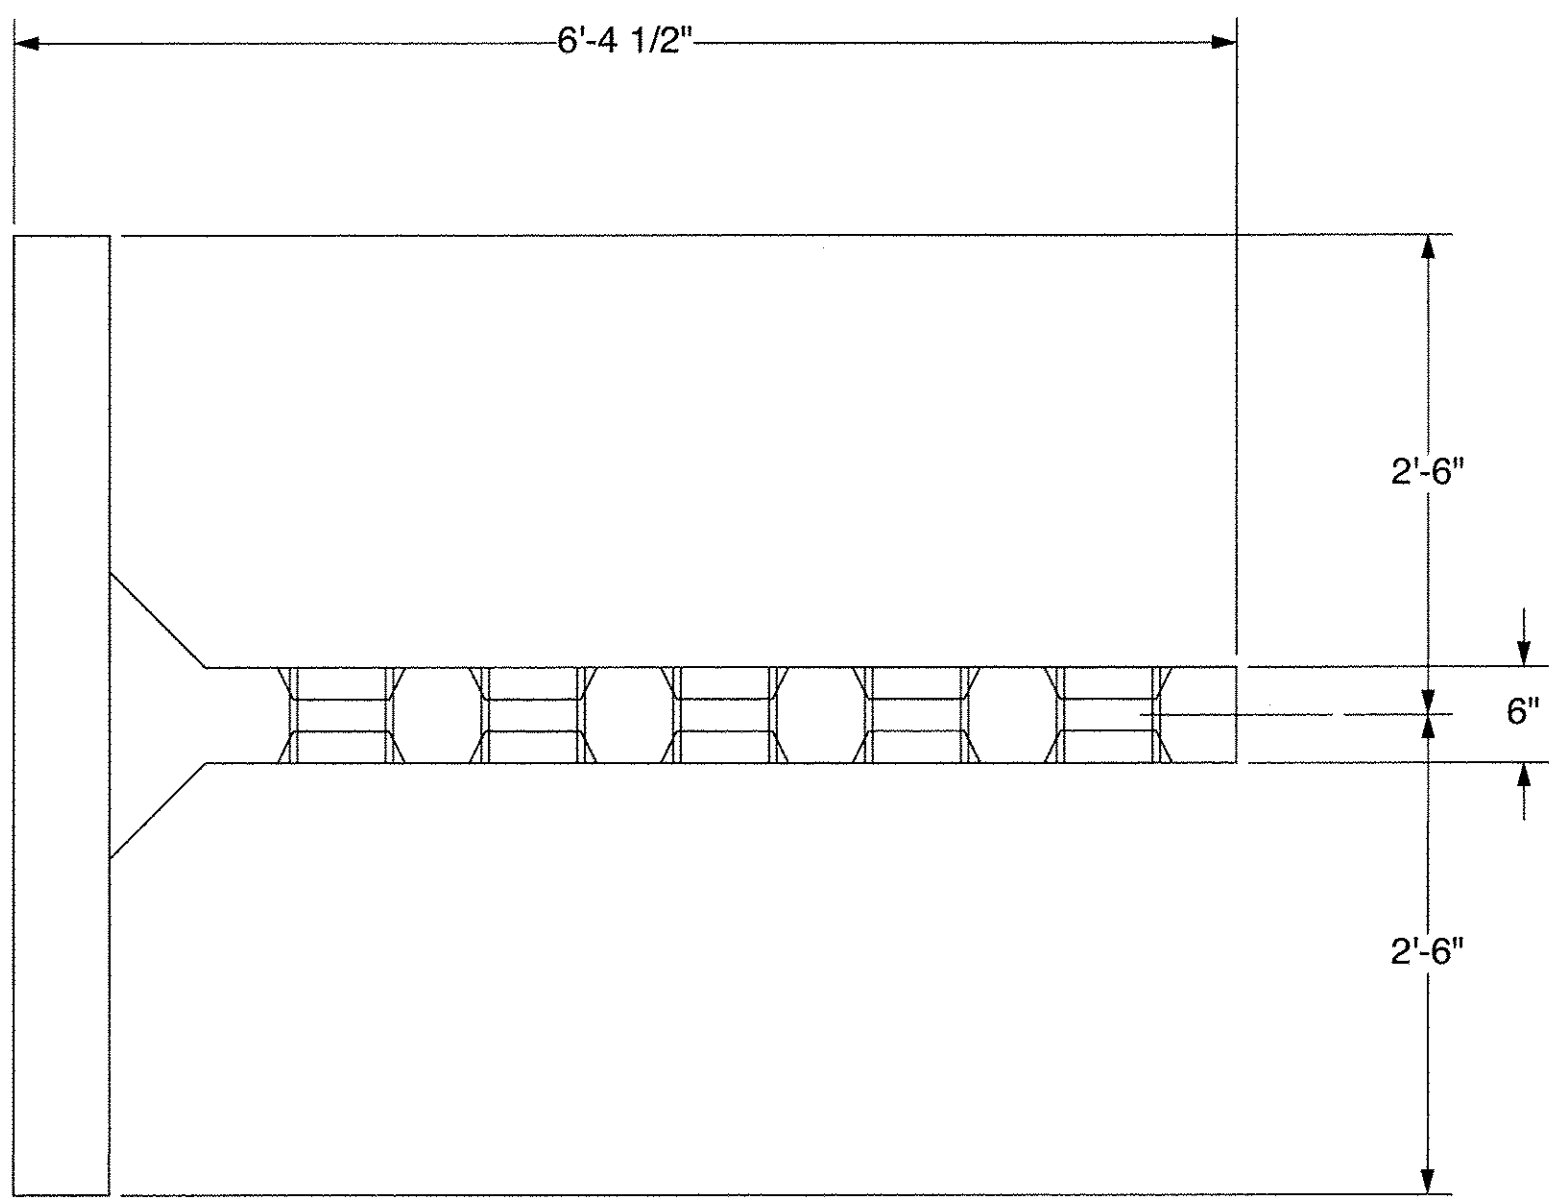


SP11 - PLAN VIEW

Approved **Approved As Noted**
 Rejected

This review is only for general conformance with the design concept and the information provided in the Construction Documents. Corrections or comments made on the shop drawings during the review do not relieve the Contractor from compliance with the requirements of the Plans and Specifications. Review of a specific item shall not include review of an assembly of which an item is a component. The Contractor is responsible for dimensions to be confirmed and corrected at the job site; information that pertains solely to the fabrication process or to the means, methods, techniques, sequences and procedures of construction; coordination of the Work with that of other trades and performing all Work in a safe and satisfactory manner.

Date 8/8/2014
 By T. Traver

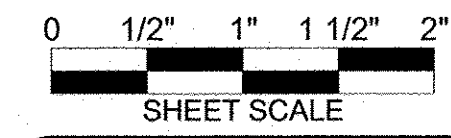

The design contained on these drawings is based upon information provided by the owner. On the basis of this information, The Neel Company has designed, and is responsible for, the internal stability of the structure only. External stability, including foundation and slope stability, is the responsibility of the owner.

This drawing contains information proprietary to The Neel Company. T-WALL® is a registered trademark owned by The Neel Company. ©2012 The Neel Company

PRECASTER: CONCRETE SYSTEMS, INC.
 HUDSON, NH
PROJECT #: T21882

CONTRACTOR:
PROJECT #:

DESIGNER

THE NEEL COMPANY
 8328-D TRAFORD LANE
 SPRINGFIELD, VIRGINIA 22152
 PH: (703) 913-7858
 FX: (703) 913-7859
 WEB: WWW.NEELCO.COM

PROJECT #: TW4301

CERTIFIED WITH RESPECT
 TO INTERNAL STABILITY OF
 T-WALL® STRUCTURES ONLY

REVISIONS	

FABRICATION DRAWING
8-6-14


RIGIDIFIED TUBE FRP ARCH (RTFA) PROJECT

FAIRFIELD, VT


FABRICATION DRAWING
 SPECIAL UNIT SP11

T-WALL® RETAINING WALL SYSTEM

SCALE:	1" = 1'-0"
DATE:	8-6-14
DESIGNED BY:	KD
DRAWN BY:	ABC
CHECKED BY:	KD
SHEET:	TW-FB12

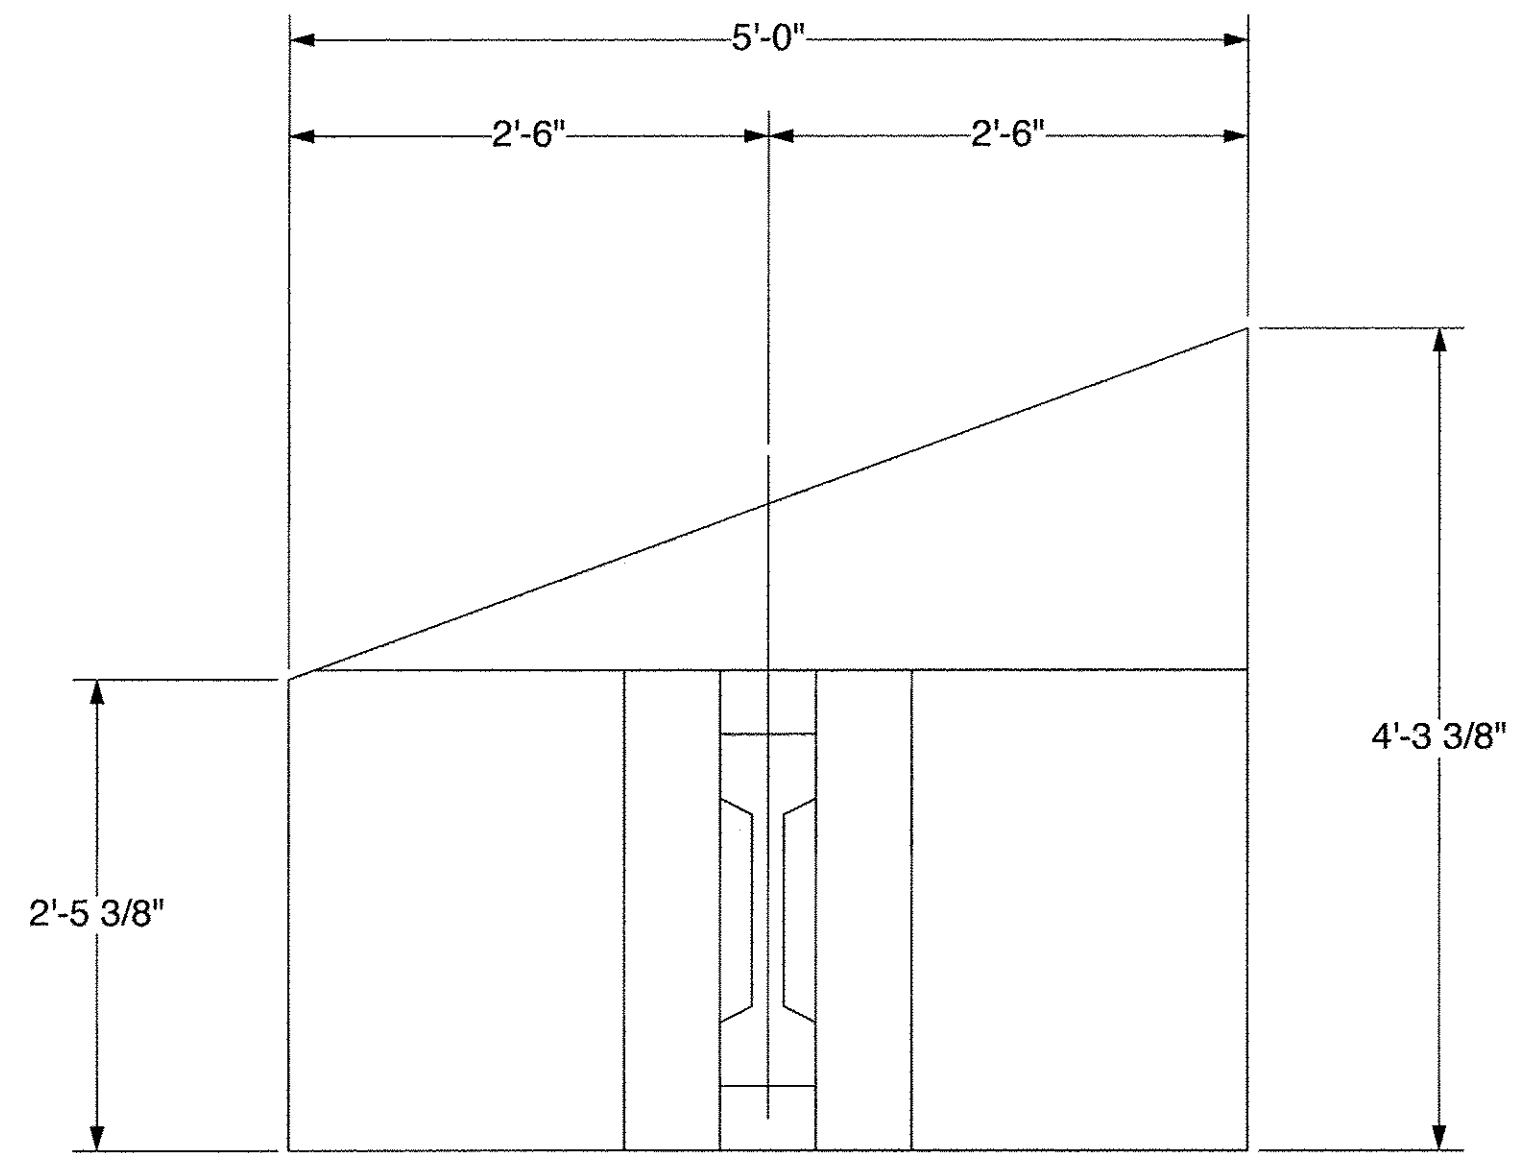

SP12 - FRONT VIEW

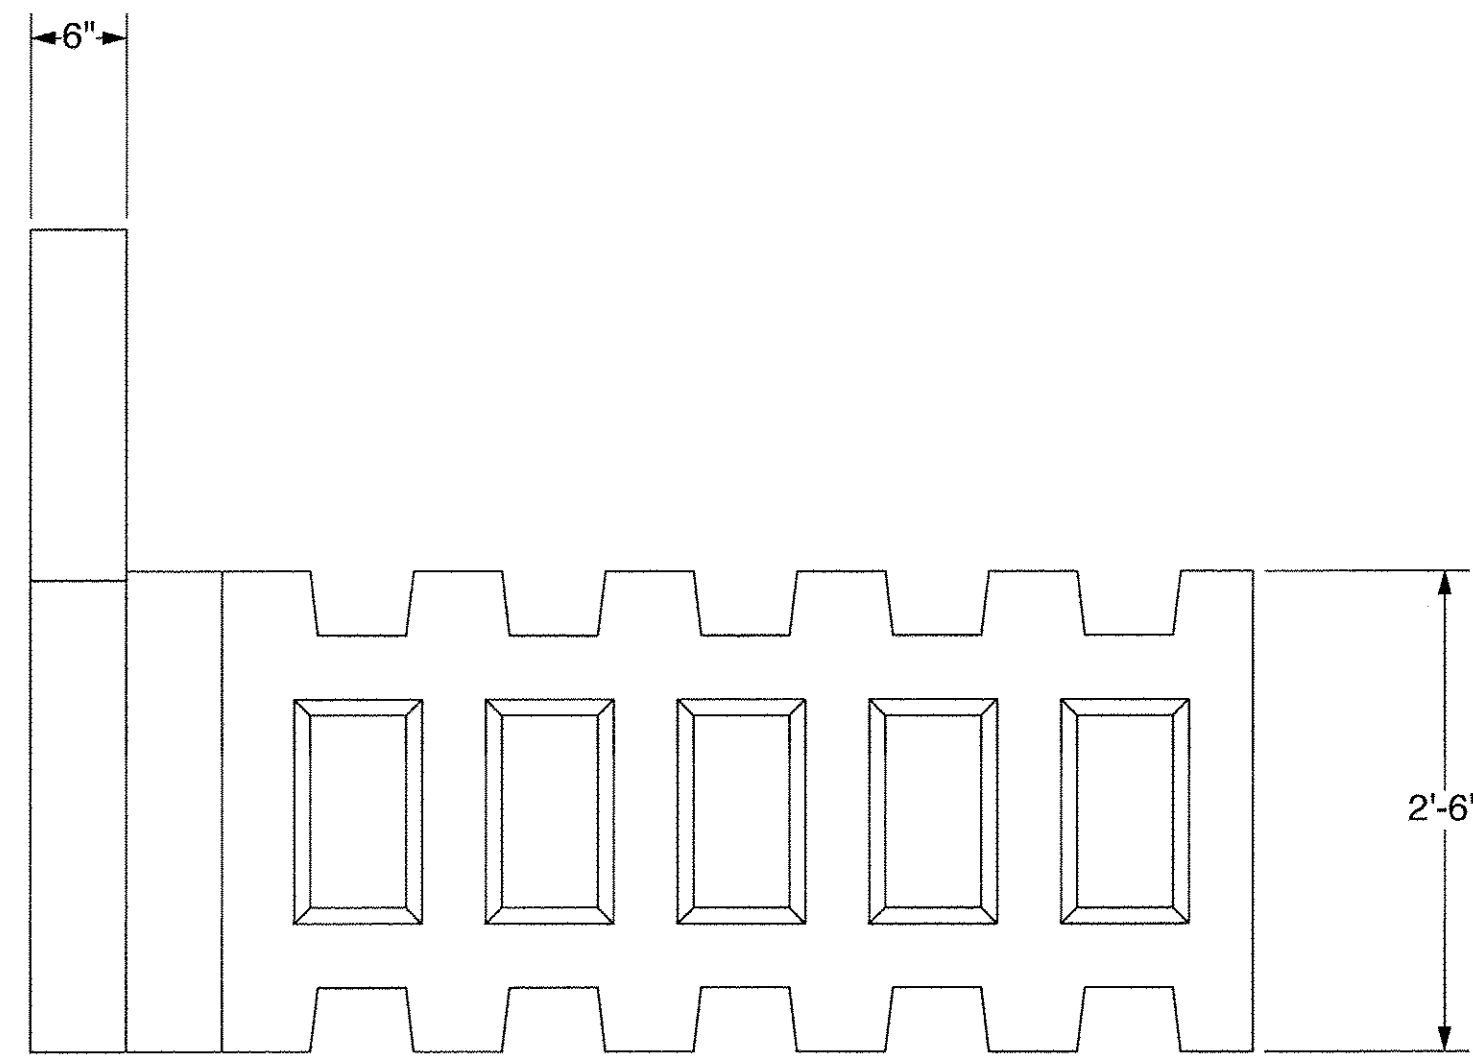


SP12 - SIDE VIEW

Approved
 Approved As Noted
 Rejected


This review is only for general conformance with the design concept and the information given in the Construction Documents. Corrections or comments made on the shop drawings during the review do not relieve the Contractor from compliance with the requirements of the Plans and Specifications. Review of a specific item shall not include review of an assembly of which an item is a component. The Contractor is responsible for dimensions to be confirmed and corrected at the job site; information that pertains solely to the fabrication process or to the means, methods, techniques, sequences and procedures of construction; coordination of the Work with that of other trades and performing all Work in a safe and satisfactory manner.

Date 8/8/2014
 By T. Traver

McFarland Johnson

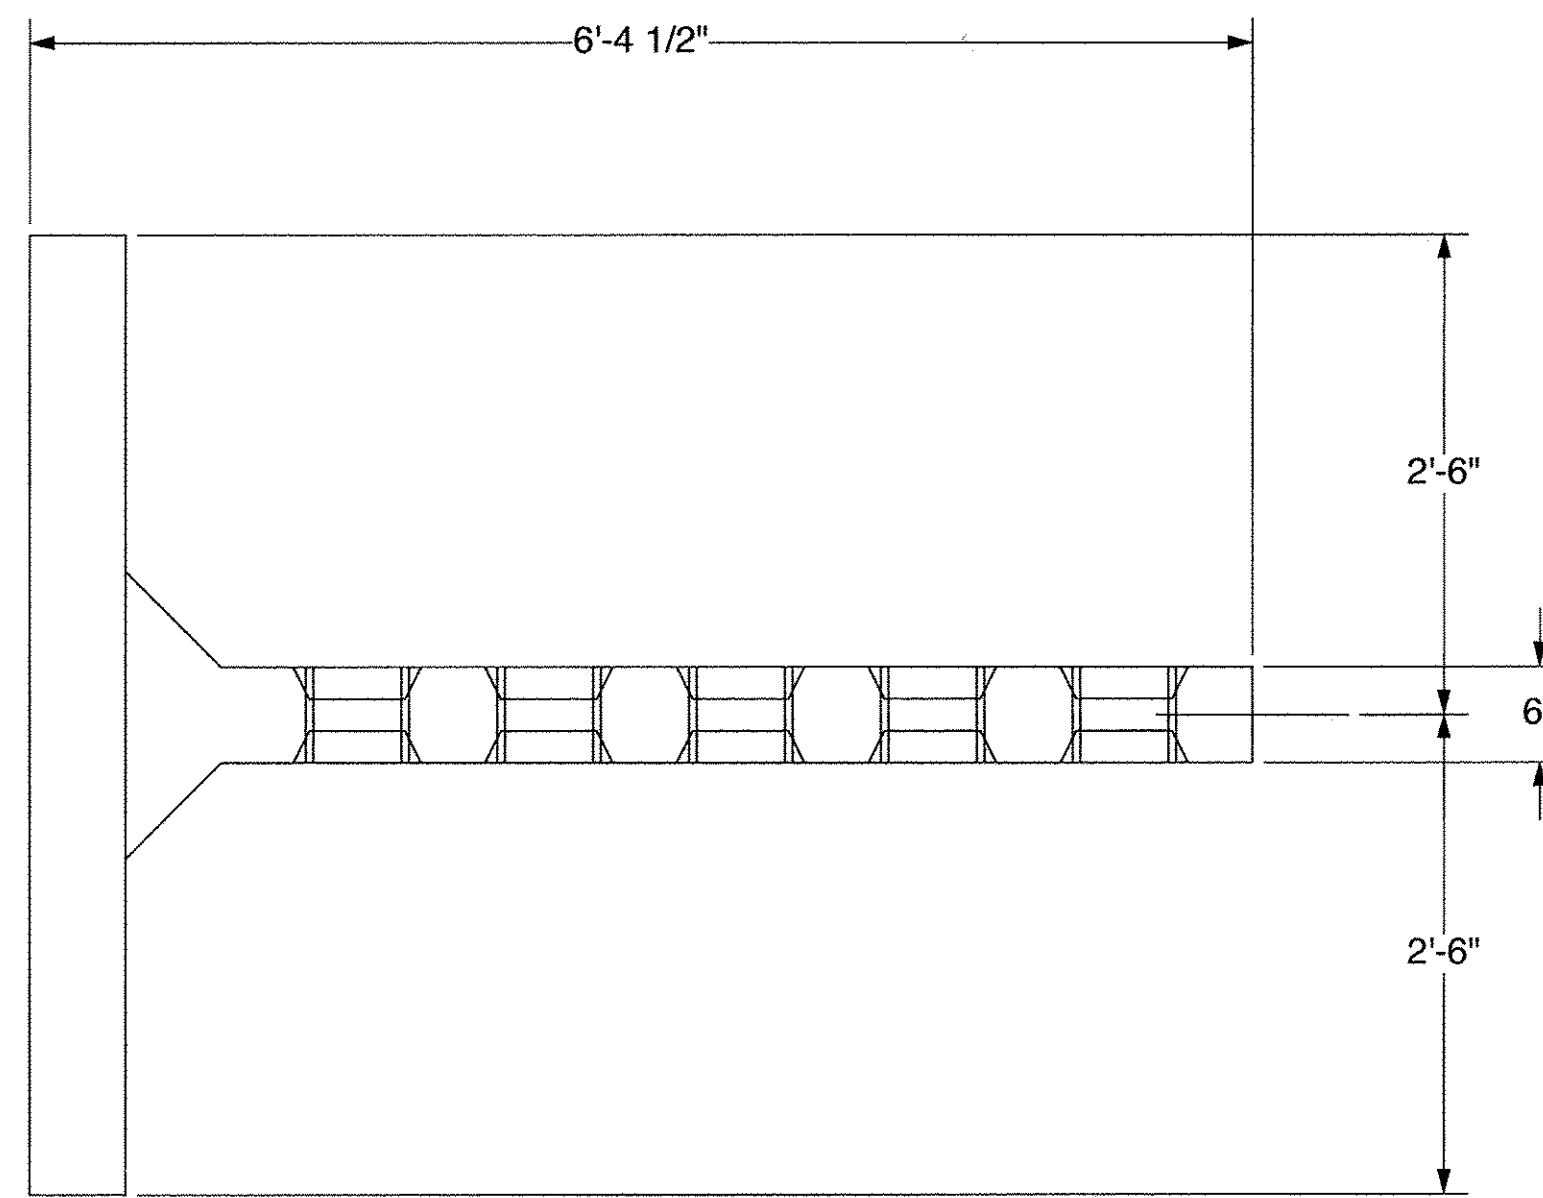

SP12 - PLAN VIEW

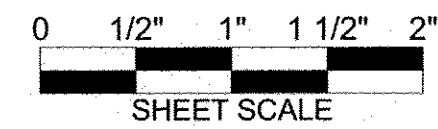

The design contained on these drawings is based upon information provided by the owner. On the basis of this information, The Neel Company has designed, and is responsible for, the internal stability of the structure only. External stability, including foundation and slope stability, is the responsibility of the owner.

This drawing contains information proprietary to The Neel Company. T-WALL® is a registered trademark owned by The Neel Company. ©2012 The Neel Company

PRECASTER: CONCRETE SYSTEMS, INC. HUDSON, NH PROJECT #: T21882
CONTRACTOR: PROJECT #:


DESIGNER
THE NEEL COMPANY
 8328-D TRAFORD LANE
 SPRINGFIELD, VIRGINIA 22152
 PH: (703) 913-7858
 FX: (703) 913-7859
 WEB: WWW.NEELCO.COM
PROJECT #: TW4301

CERTIFIED WITH RESPECT TO INTERNAL STABILITY OF T-WALL® STRUCTURES ONLY


REVISIONS	

FABRICATION DRAWING
8-6-14
RIGIDIFIED TUBE FRP ARCH (RTFA) PROJECT
 FAIRFIELD, VT
 FABRICATION DRAWING
 SPECIAL UNIT SP12
 T-WALL® RETAINING WALL SYSTEM


SCALE:	1" = 1'-0"
DATE:	8-6-14
DESIGNED BY:	KD
DRAWN BY:	ABC
CHECKED BY:	KD
SHEET:	TW-FB13

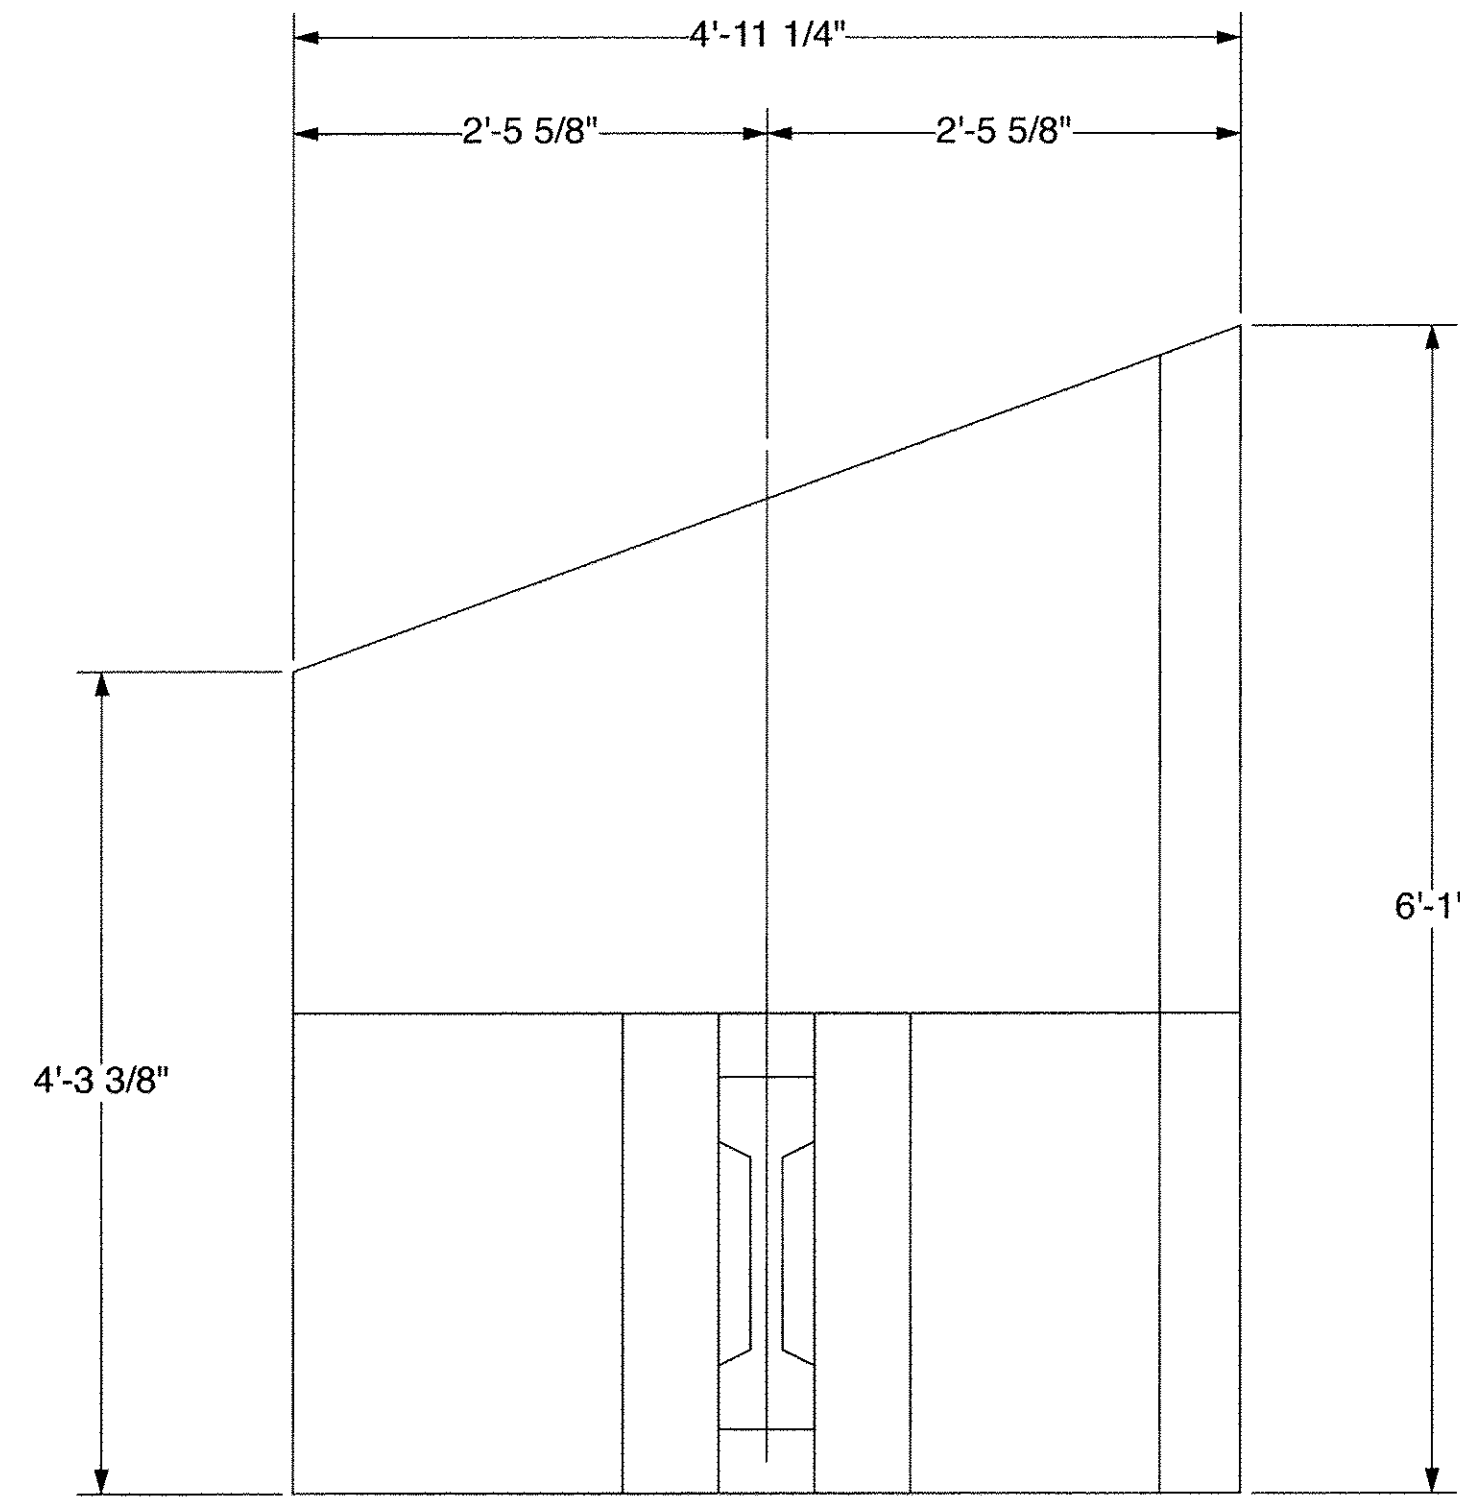

SP13 - FRONT VIEW

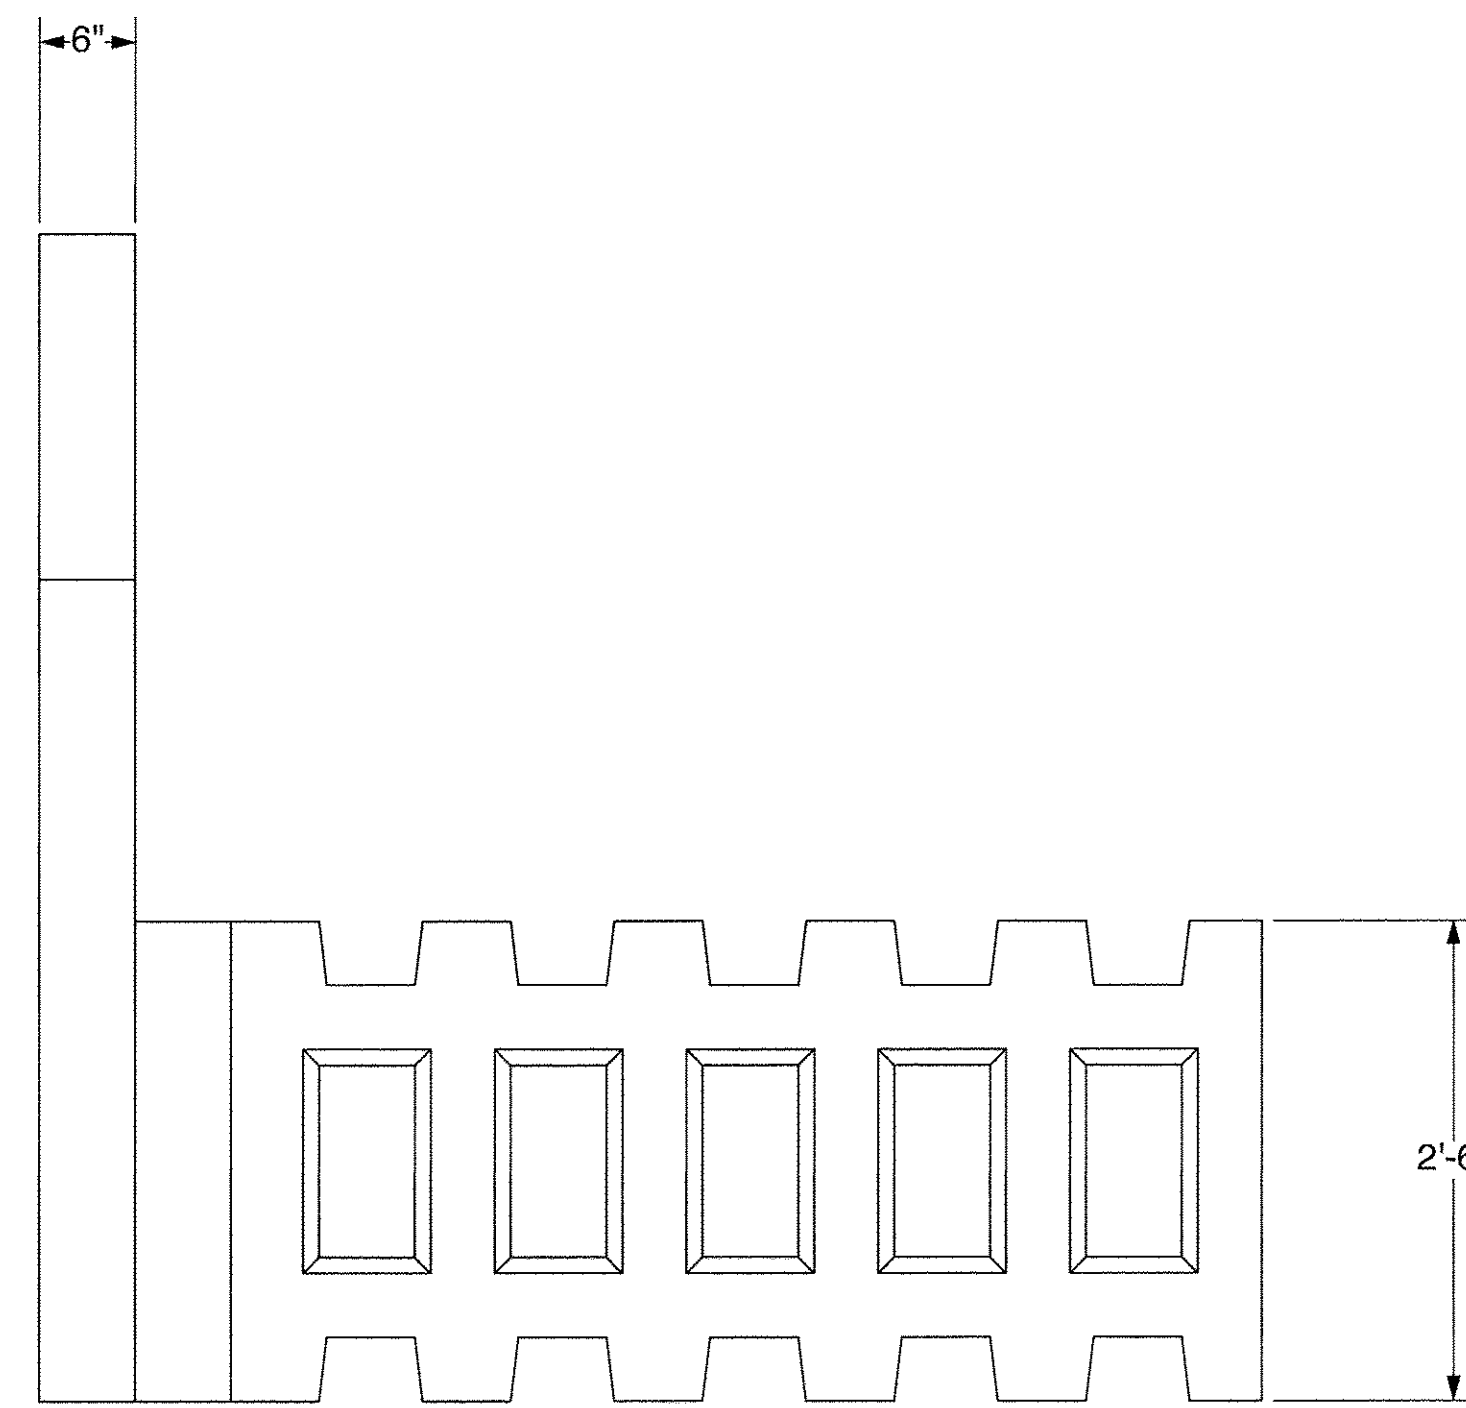

SP13 - SIDE VIEW

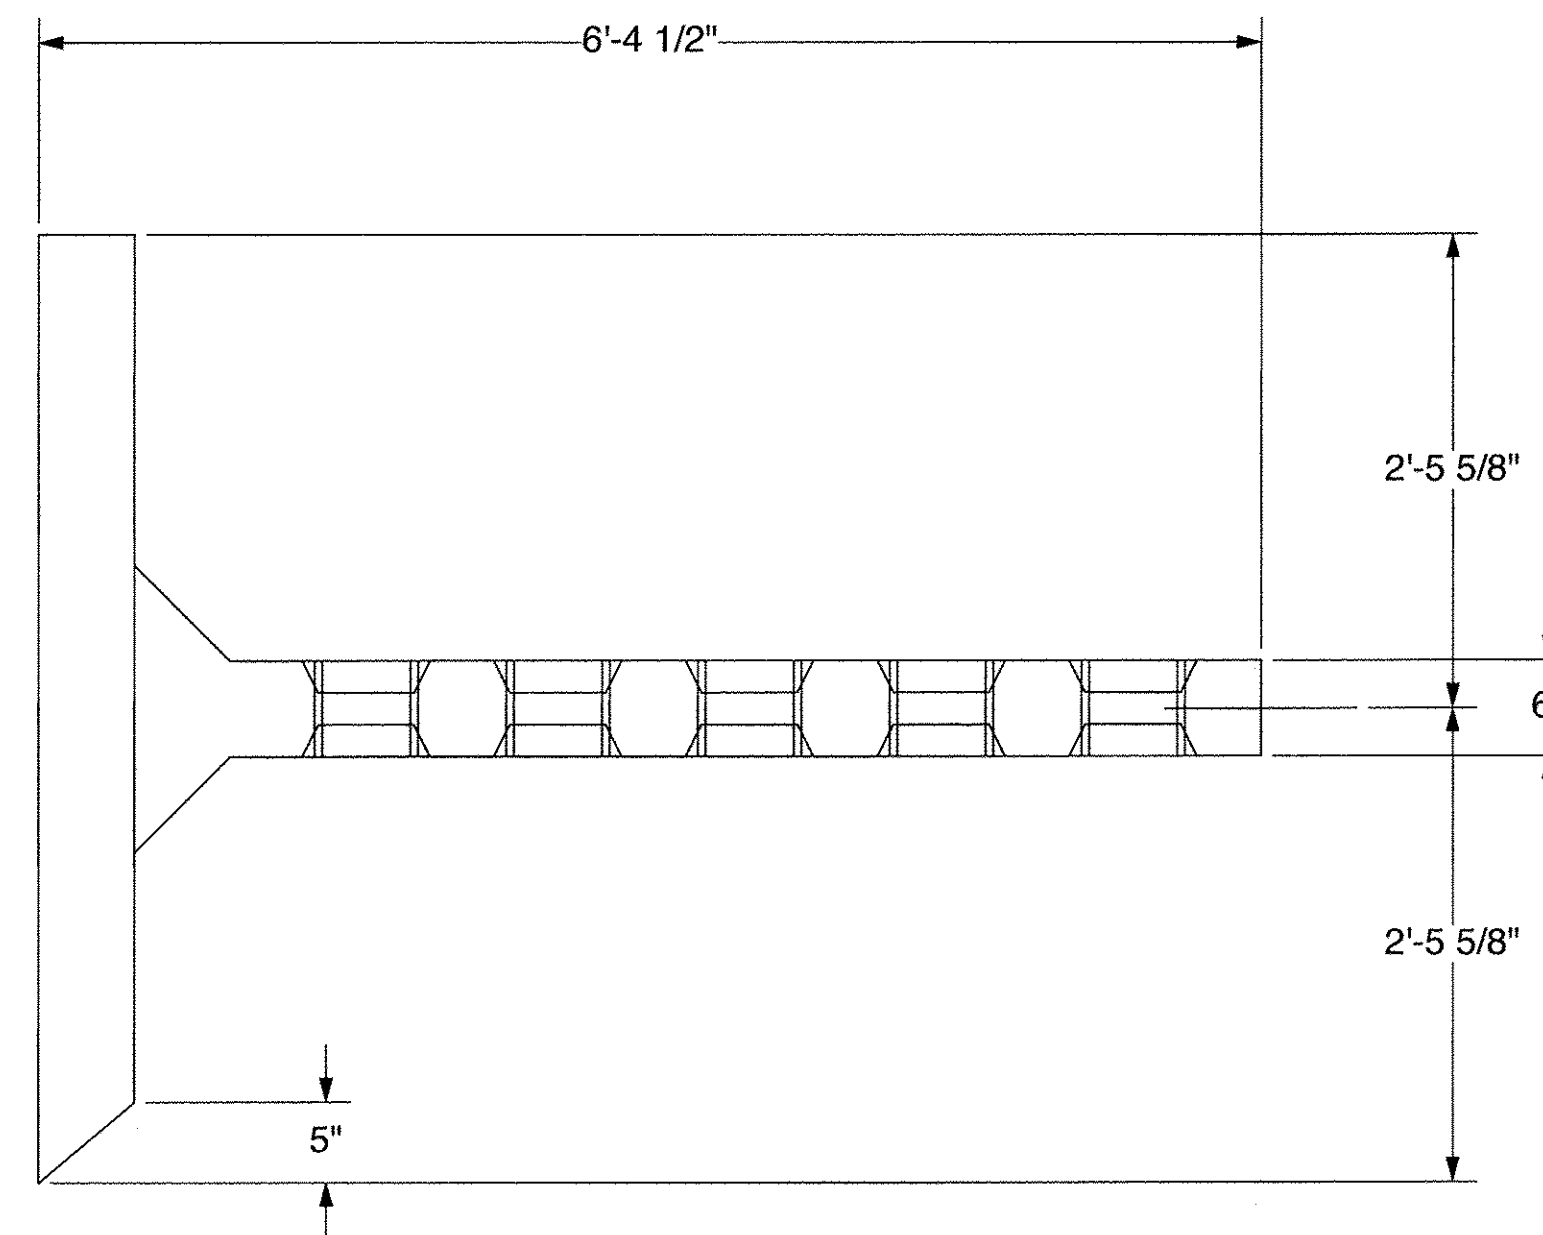

SP13 - PLAN VIEW


Approved
 Rejected

Approved As Noted

This review is only for general conformance with the design concept and the information given in the Construction Documents. Corrections or comments made on the shop drawings during the review do not relieve the Contractor from compliance with the requirements of the Plans and Specifications. Review of a specific item shall not include review of an assembly of which an item is a component. The Contractor is responsible for dimensions to be confirmed and corrected at the job site; information that pertains solely to the fabrication process or to the means, methods, techniques, sequences and procedures of construction; coordination of the Work with that of other trades and performing all Work in a safe and satisfactory manner.

Date 8/8/2014

By T. Traver

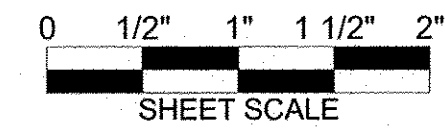

The design contained on these drawings is based upon information provided by the owner. On the basis of this information, The Neel Company has designed, and is responsible for, the internal stability of the structure only. External stability, including foundation and slope stability, is the responsibility of the owner.

This drawing contains information proprietary to The Neel Company. T-WALL® is a registered trademark owned by The Neel Company. ©2012 The Neel Company

PRECASTER:	CONCRETE SYSTEMS, INC. HUDSON, NH
PROJECT #:	T21882
CONTRACTOR:	
PROJECT #:	

DESIGNER

THE NEEL COMPANY
8328-D TRAFORD LANE
SPRINGFIELD, VIRGINIA 22152
PH: (703) 913-7858
FX: (703) 913-7859
WEB: WWW.NEELCO.COM

PROJECT #: TW4301

CERTIFIED WITH RESPECT
TO INTERNAL STABILITY OF
T-WALL® STRUCTURES ONLY

REVISIONS	

FABRICATION DRAWING
8-6-14


RIGIDIFIED TUBE FRP ARCH (RTFA) PROJECT

FAIRFIELD, VT


FABRICATION DRAWING
SPECIAL UNIT SP13

T-WALL® RETAINING WALL SYSTEM


SCALE:	1" = 1'-0"
DATE:	8-6-14
DESIGNED BY:	KD
DRAWN BY:	ABC
CHECKED BY:	KD
SHEET:	TW-FB14

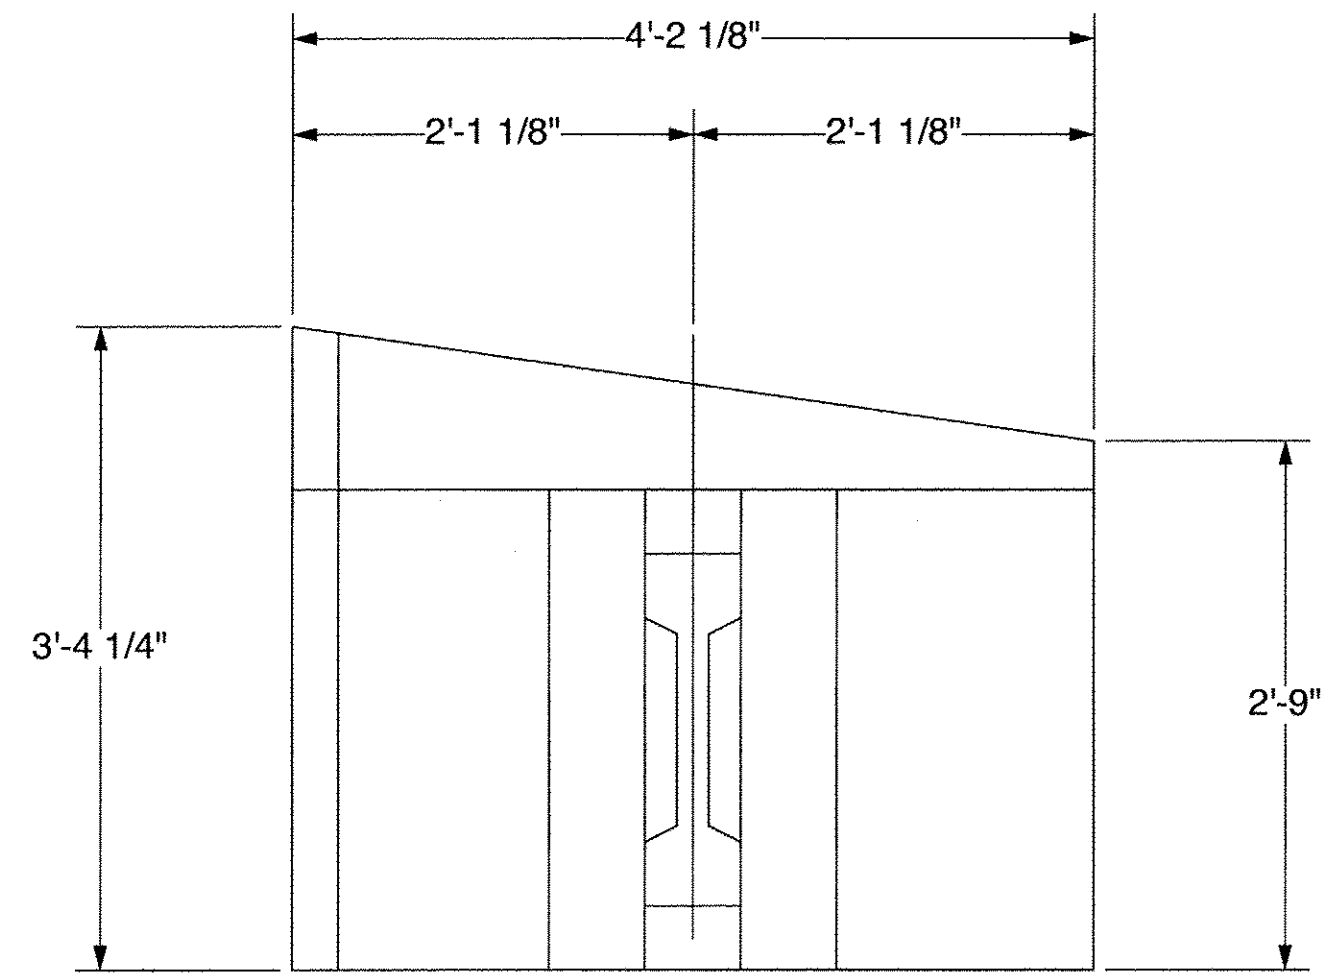

SP14 - FRONT VIEW

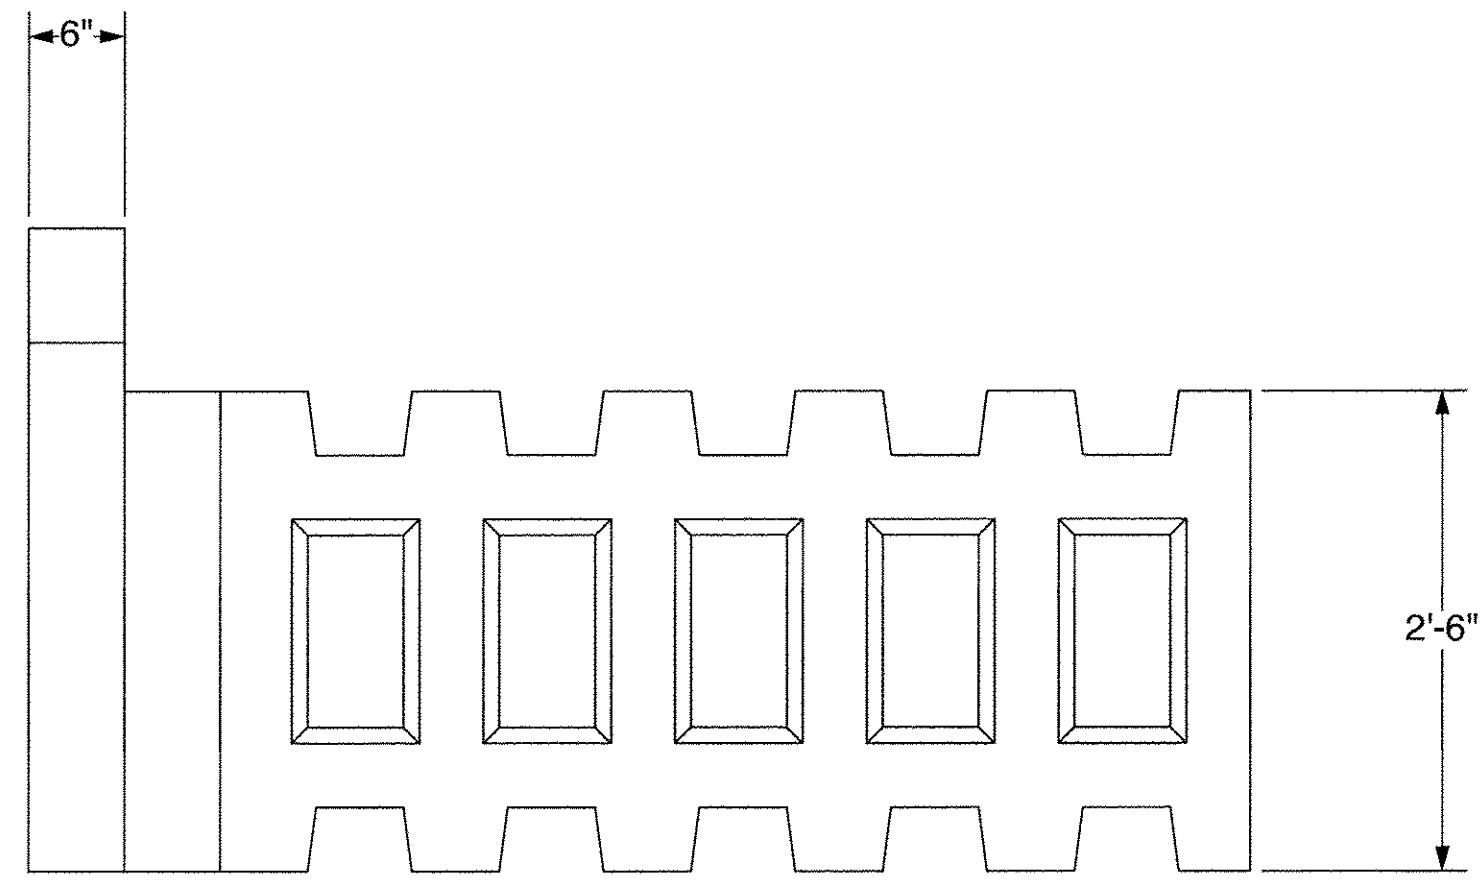


SP14 - SIDE VIEW

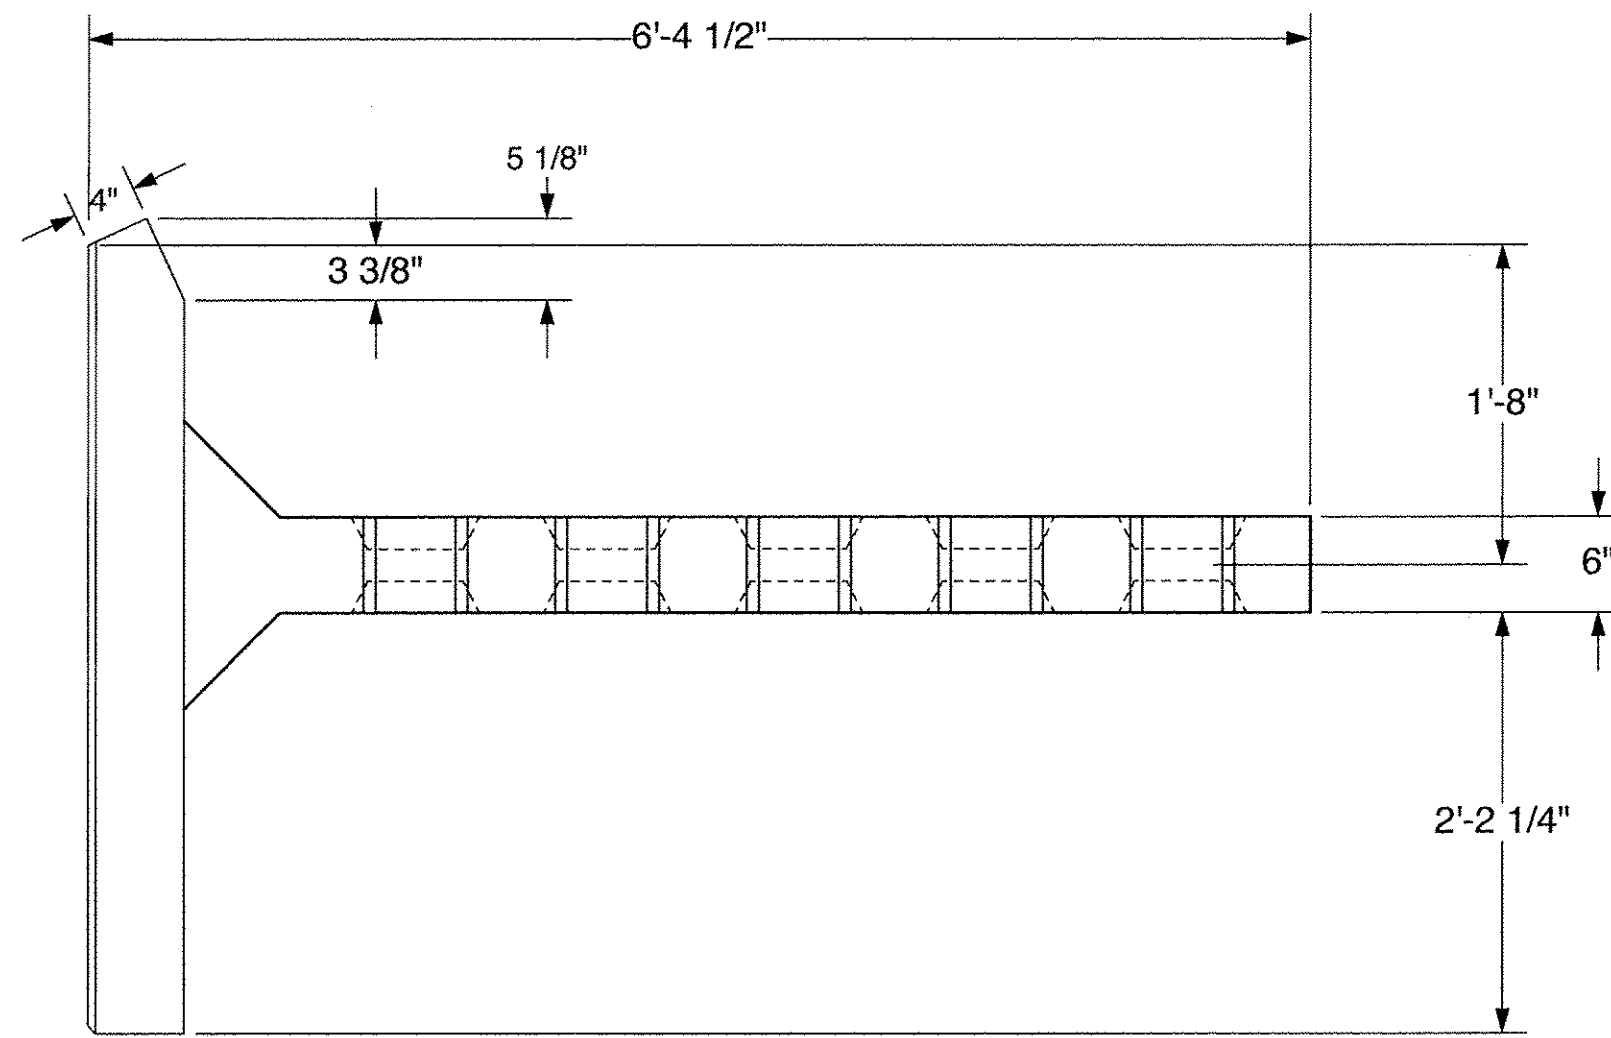

SP14 - PLAN VIEW

X Approved _____ Rejected	_____ Approved As Noted	
This review is only for general conformance with the design concept and the information given in the Construction Documents. Corrections or comments made on the shop drawings during the review do not relieve the Contractor from compliance with the requirements of the Plans and Specifications. Review of a specific item shall not include review of an assembly of which an item is a component. The Contractor is responsible for dimensions to be confirmed and corrected at the job site; information that pertains solely to the fabrication process or to the means, methods, techniques, sequences and procedures of construction; coordination of the Work with that of other trades and performing all Work in a safe and satisfactory manner.		
McFarland Johnson		Date <u>8/8/2014</u>
		By <u>T. Traver</u>

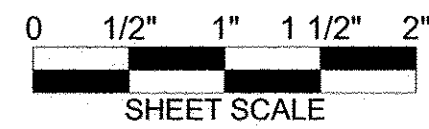

The design contained on these drawings is based upon information provided by the owner. On the basis of this information, The Neel Company has designed, and is responsible for, the internal stability of the structure only. External stability, including foundation and slope stability, is the responsibility of the owner.

This drawing contains information proprietary to The Neel Company. T-WALL® is a registered trademark owned by The Neel Company. ©2012 The Neel Company

PRECASTER: CONCRETE SYSTEMS, INC.
HUDSON, NH
PROJECT #: T21882

CONTRACTOR:
PROJECT #:

DESIGNER

THE NEEL COMPANY
8328-D TRAFORD LANE
SPRINGFIELD, VIRGINIA 22152
PH: (703) 913-7858
FX: (703) 913-7859
WEB: WWW.NEELCO.COM

PROJECT #: TW4301

CERTIFIED WITH RESPECT
TO INTERNAL STABILITY OF
T-WALL® STRUCTURES ONLY

REVISIONS	

**FABRICATION DRAWING
8-6-14**


RIGIDIFIED TUBE FRP ARCH (RTFA) PROJECT

FAIRFIELD, VT


FABRICATION DRAWING
SPECIAL UNIT SP14

T-WALL® RETAINING WALL SYSTEM

SCALE:	1" = 1'-0"
DATE:	8-6-14
DESIGNED BY:	KD
DRAWN BY:	ABC
CHECKED BY:	KD
SHEET:	TW-FB15

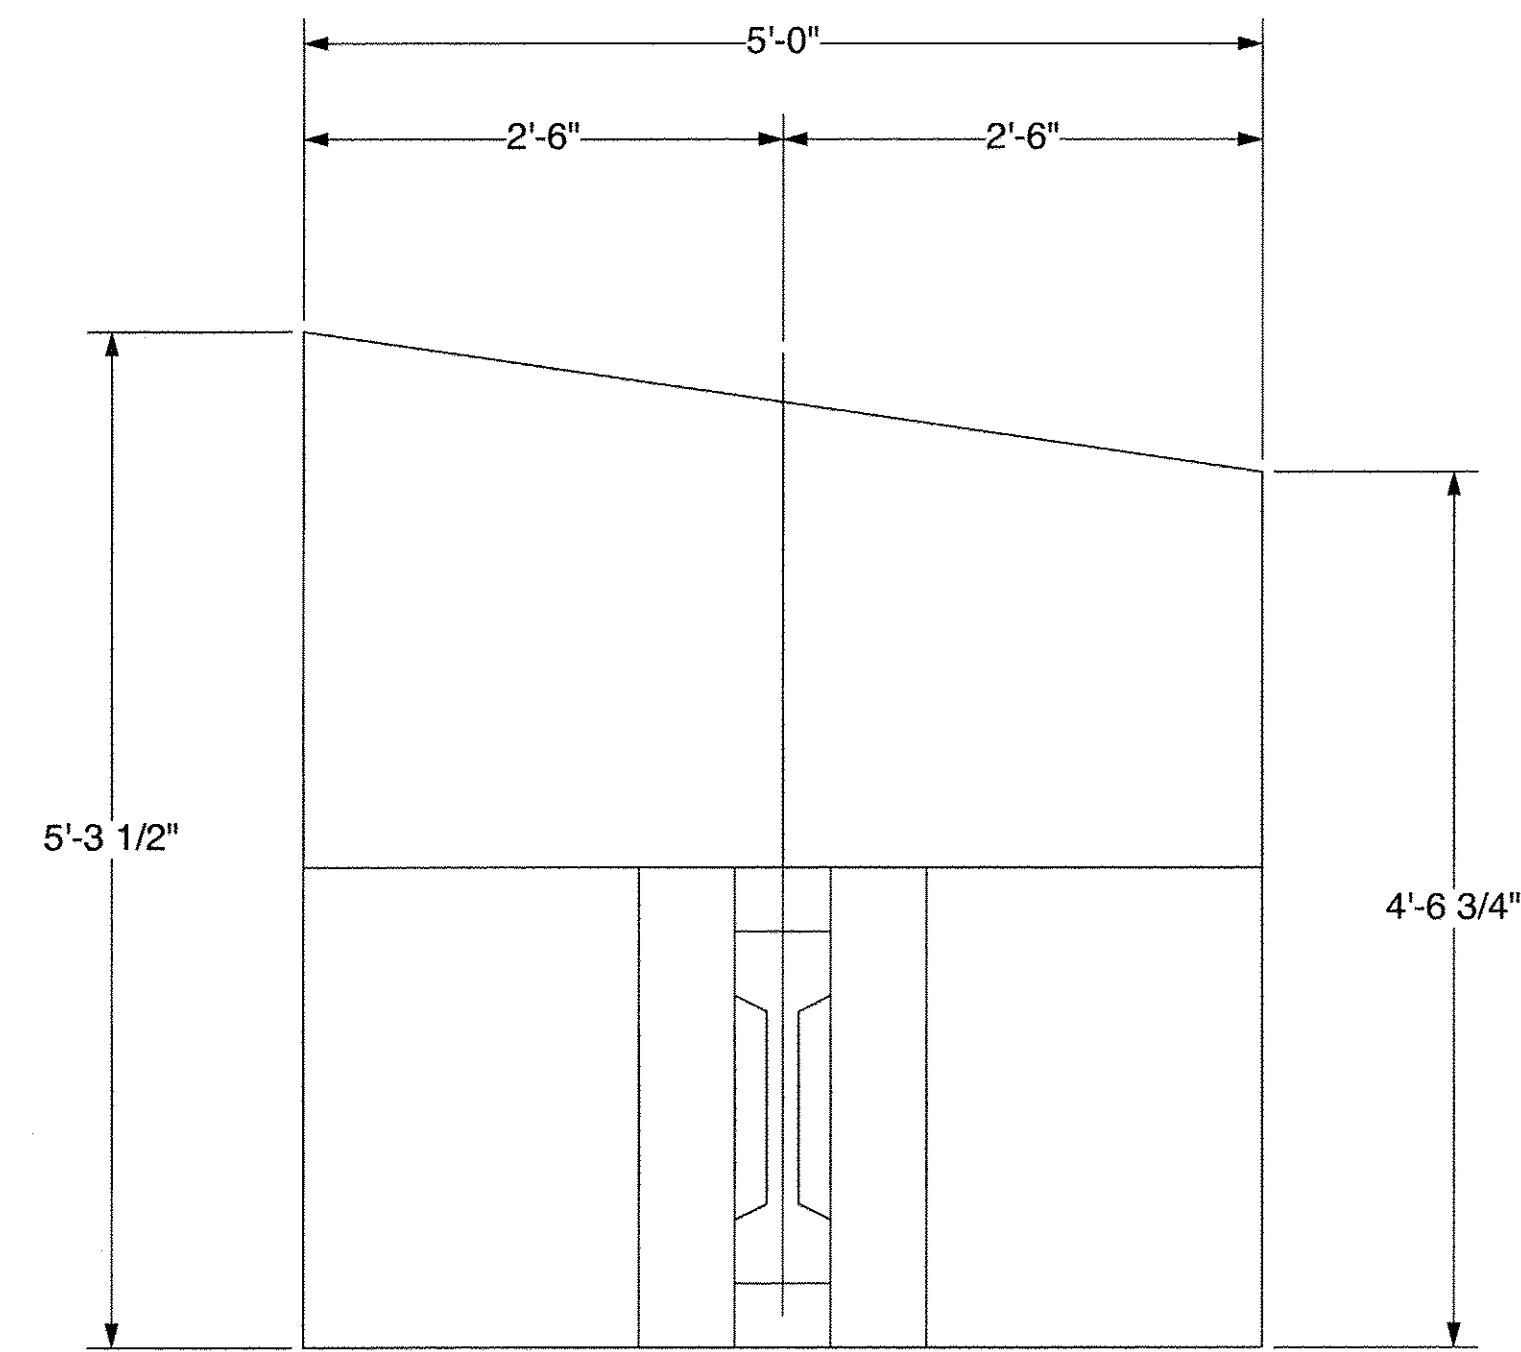


SP15 - FRONT VIEW

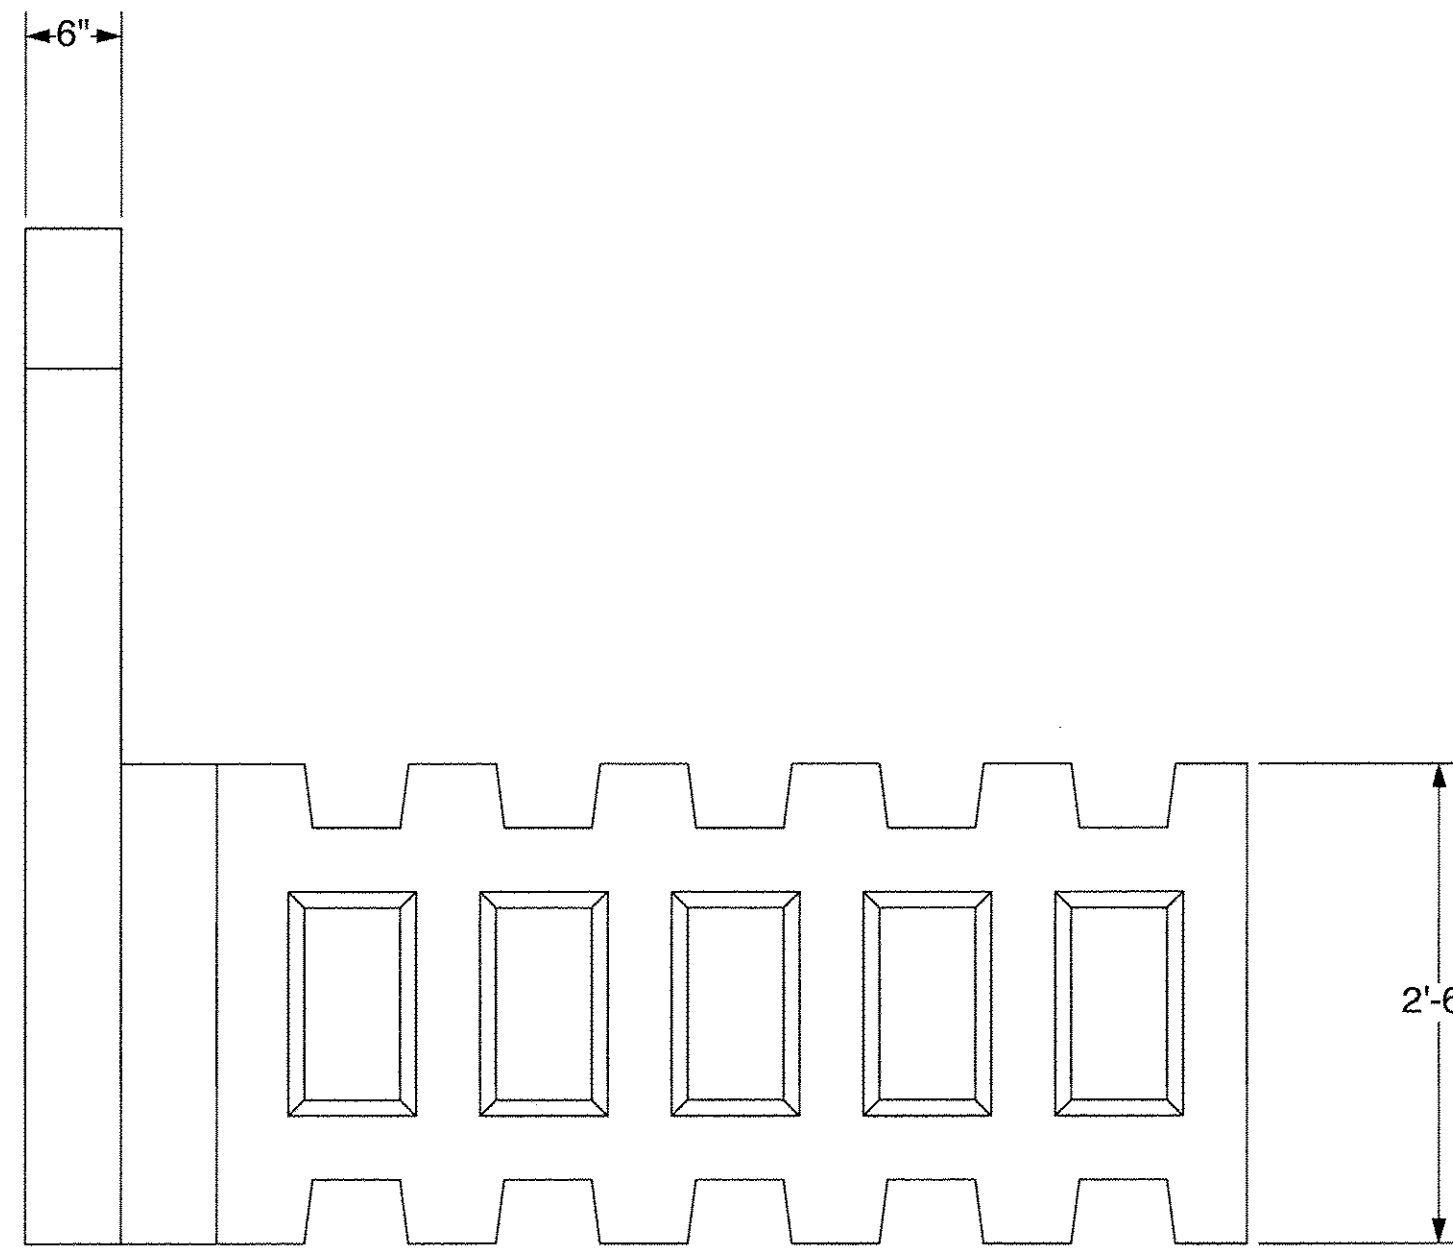


SP15 - SIDE VIEW

<input checked="" type="checkbox"/> Approved <input type="checkbox"/> Rejected	<input type="checkbox"/> Approved As Noted
<p>This review is only for general conformance with the design concept and the information given in the Construction Documents. Corrections or comments made on the shop drawings during the review do not relieve the Contractor from compliance with the requirements of the Plans and Specifications. Review of a specific item shall not include review of an assembly of which an item is a component. The Contractor is responsible for dimensions to be confirmed and corrected at the job site; information that pertains solely to the fabrication process or to the means, methods, techniques, sequences and procedures of construction; coordination of the Work with that of other trades and performing all Work in a safe and satisfactory manner.</p>	
McFarland Johnson	
Date <u>8/8/2014</u> By <u>T. Traver</u>	

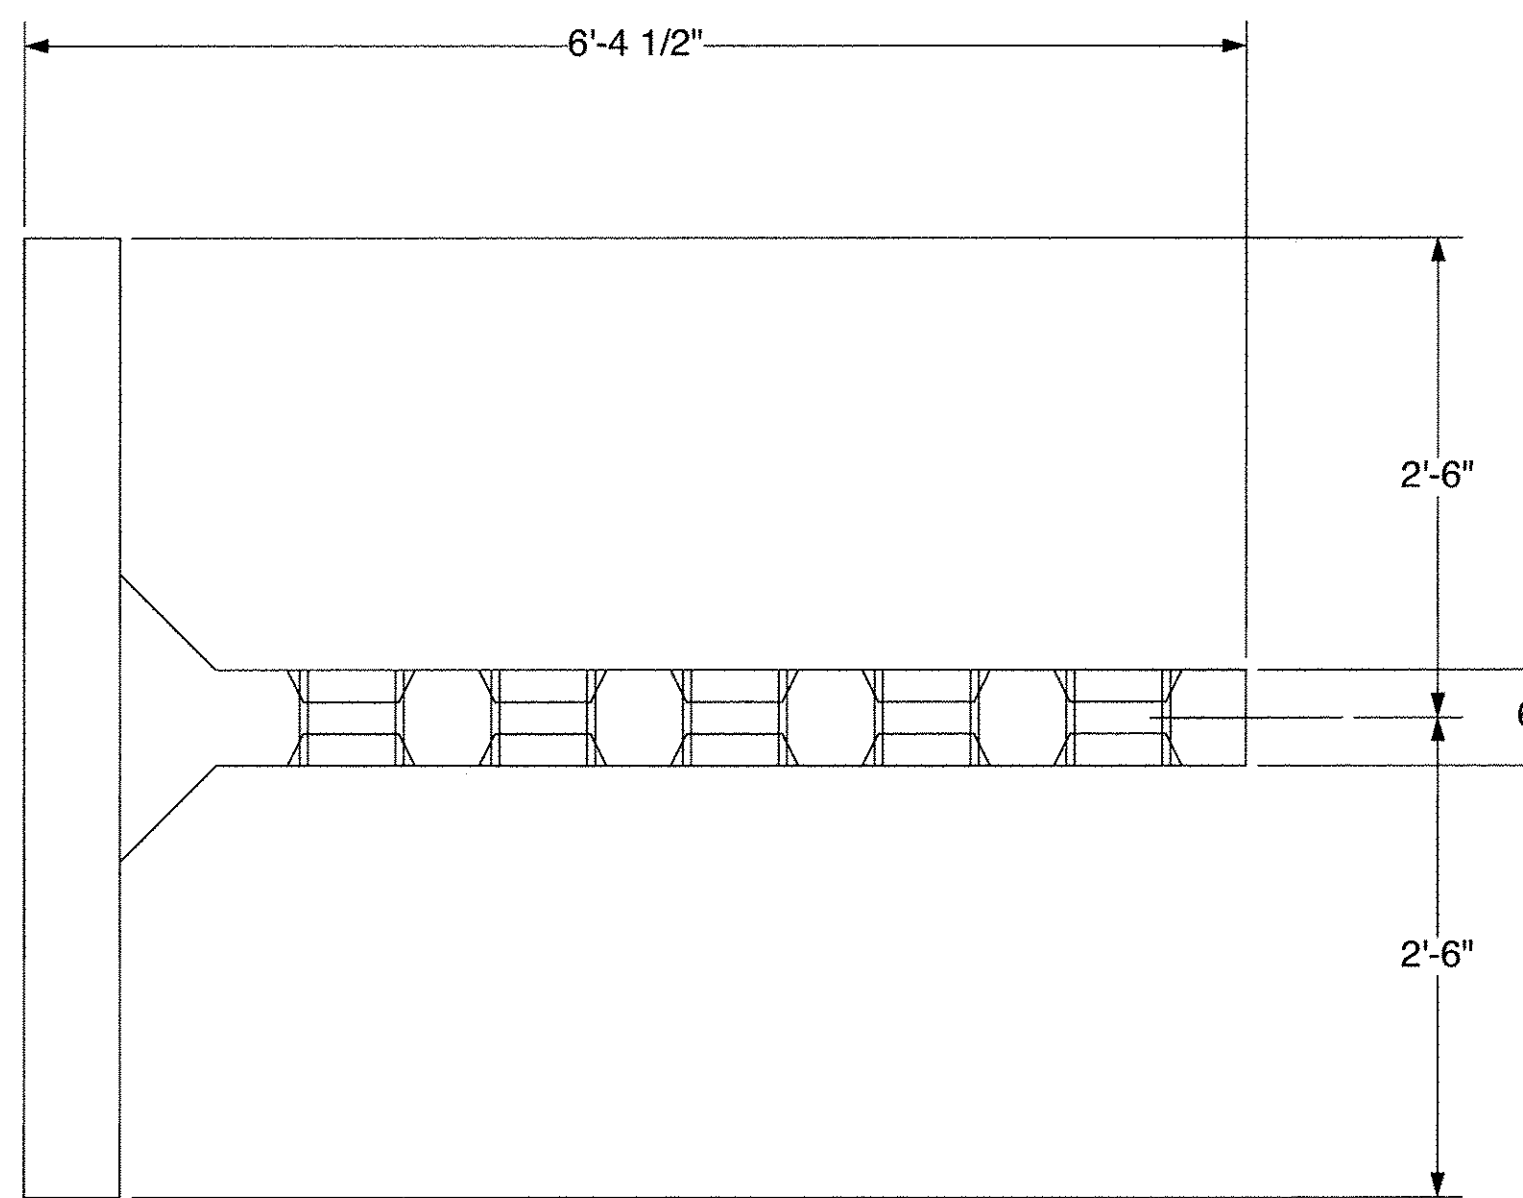

SP15 - PLAN VIEW

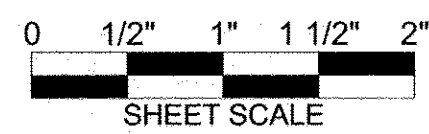

**FABRICATION DRAWING
8-6-14**

RIGIDIFIED TUBE FRP ARCH (RTFA) PROJECT

FAIRFIELD, VT

FABRICATION DRAWING
SPECIAL UNIT SP15

T-WALL® RETAINING WALL SYSTEM

SCALE:	1" = 1'-0"
DATE:	8-6-14
DESIGNED BY:	KD
DRAWN BY:	ABC
CHECKED BY:	KD
SHEET:	TW-FB16

The design contained on these drawings is based upon information provided by the owner. On the basis of this information, The Neel Company has designed, and is responsible for, the internal stability of the structure only. External stability, including foundation and slope stability, is the responsibility of the owner.

This drawing contains information proprietary to The Neel Company. T-WALL® is a registered trademark owned by The Neel Company. ©2012 The Neel Company

PRECASTER: CONCRETE SYSTEMS, INC.
HUDSON, NH
PROJECT #: T21882

CONTRACTOR:
PROJECT #:


DESIGNER

THE NEEL COMPANY
8328-D TRAFORD LANE
SPRINGFIELD, VIRGINIA 22152
PH: (703) 913-7858
FX: (703) 913-7859
WEB: WWW.NEELCO.COM


PROJECT #: TW4301

CERTIFIED WITH RESPECT
TO INTERNAL STABILITY OF
T-WALL® STRUCTURES ONLY


REVISIONS	

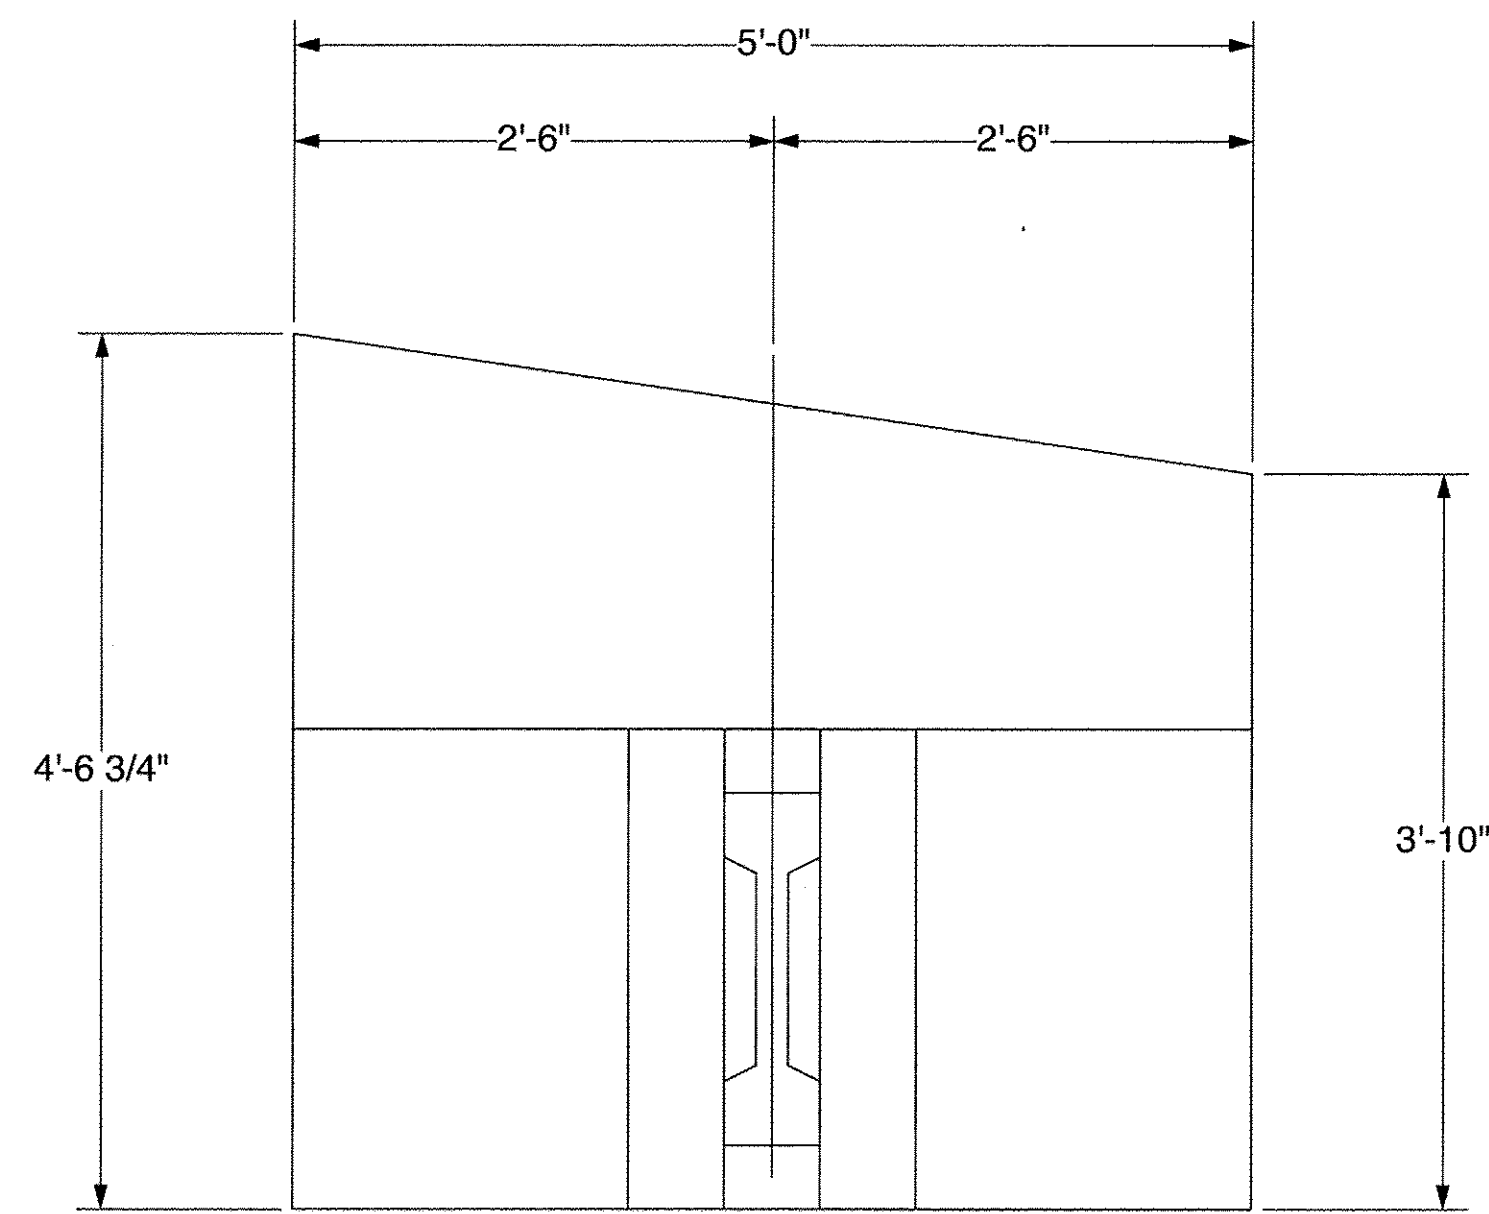

SP16 - FRONT VIEW

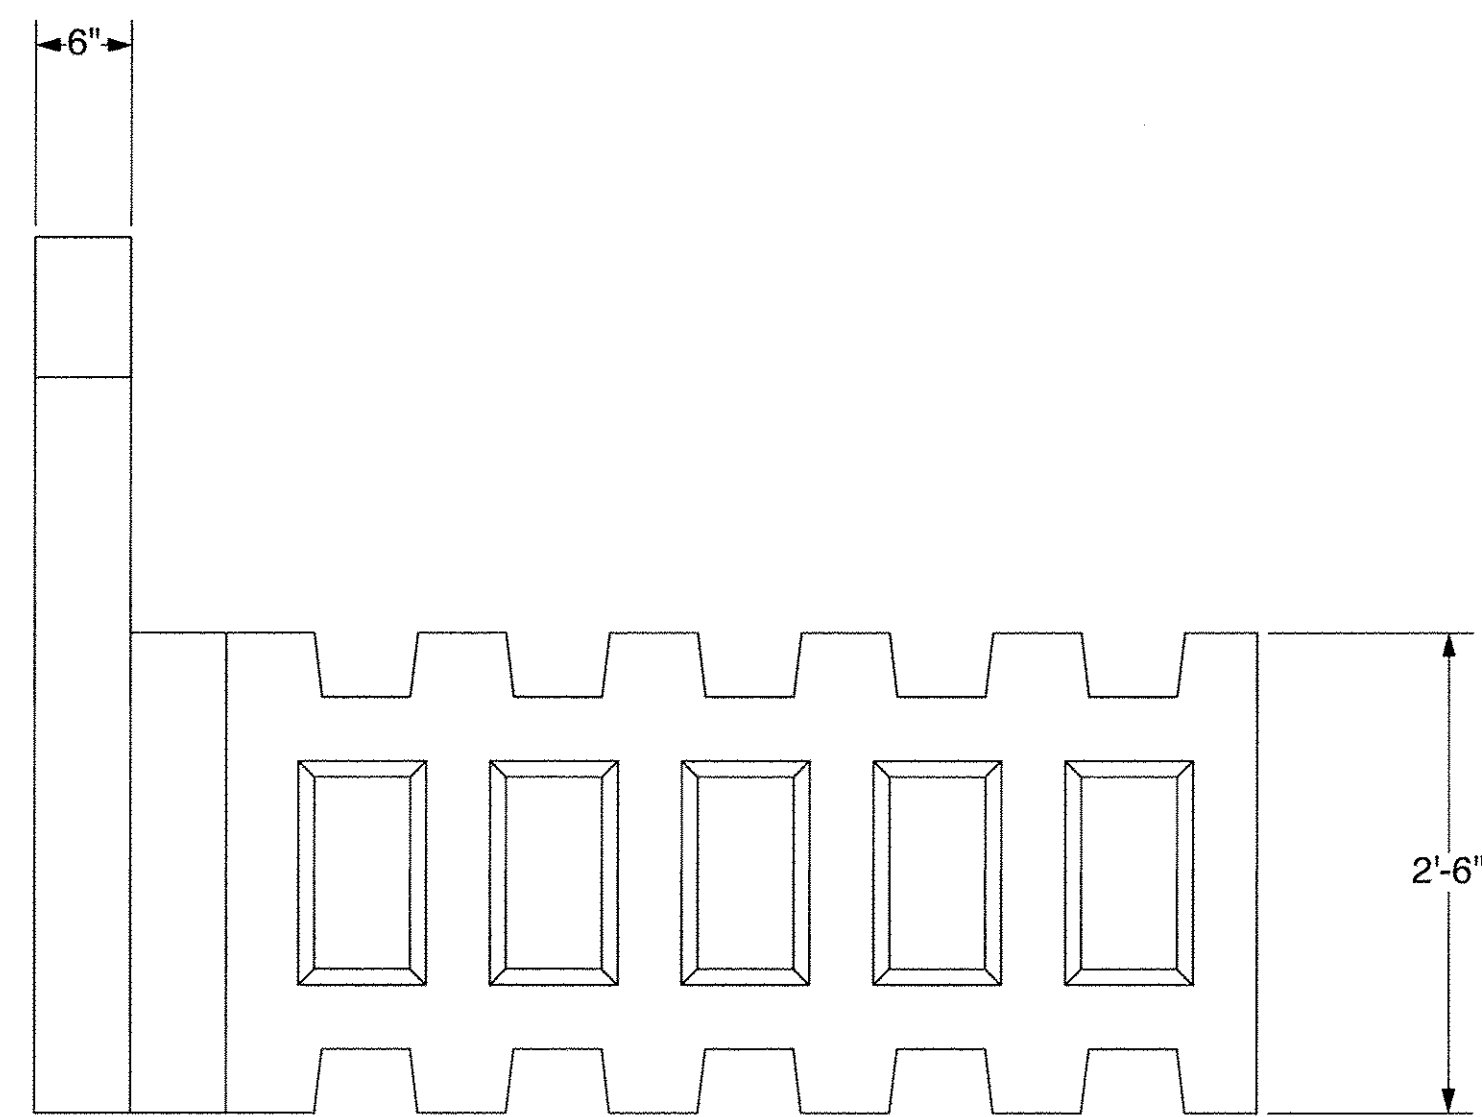

SP16 - SIDE VIEW

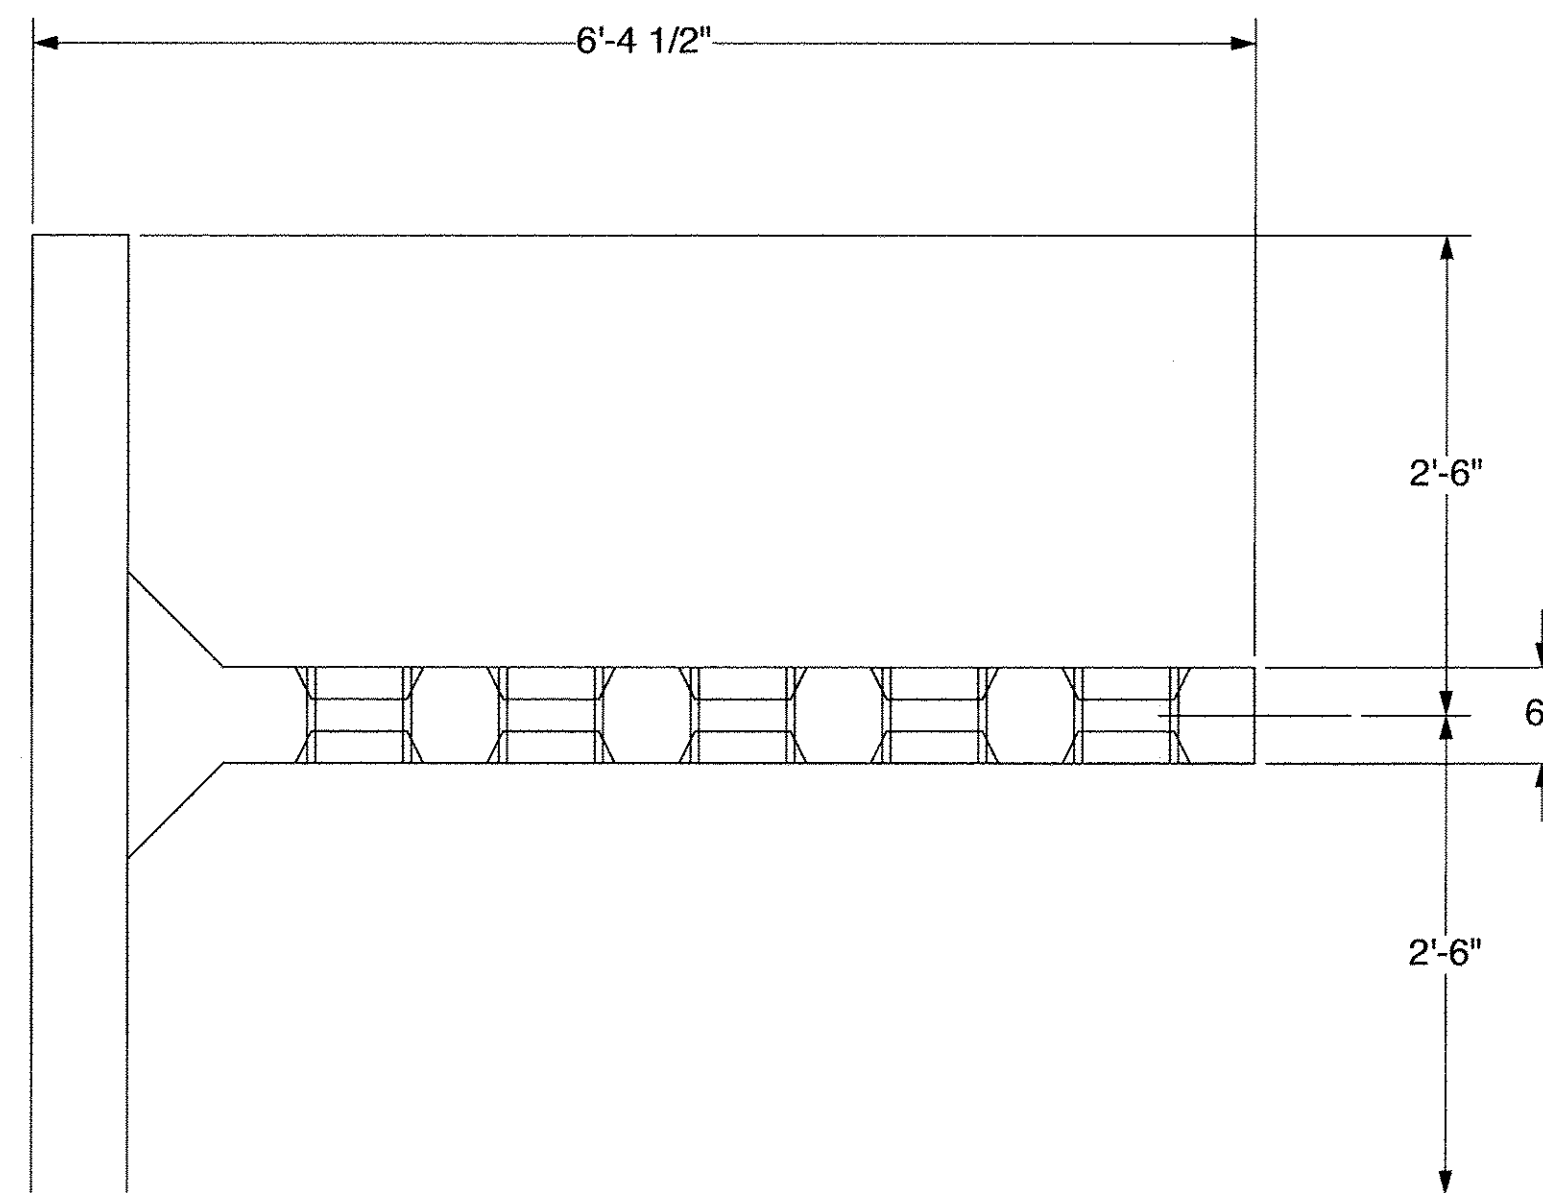

SP16 - PLAN VIEW


Approved Approved As Noted
 Rejected

This review is only for general conformance with the design concept and the information given in the Construction Documents. Corrections or comments made on the shop drawings during the review do not relieve the Contractor from compliance with the requirements of the Plans and Specifications. Review of a specific item shall not include review of an assembly of which an item is a component. The Contractor is responsible for dimensions to be confirmed and corrected at the job site; information that pertains solely to the fabrication process or to the means, methods, techniques, sequences and procedures of construction; coordination of the Work with that of other trades and performing all Work in a safe and satisfactory manner.

Date 8/8/2014



By T. Traver

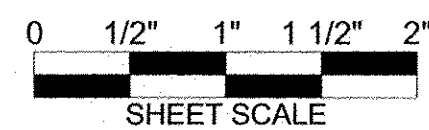

The design contained on these drawings is based upon information provided by the owner. On the basis of this information, The Neel Company has designed, and is responsible for, the internal stability of the structure only. External stability, including foundation and slope stability, is the responsibility of the owner.

This drawing contains information proprietary to The Neel Company. T-WALL® is a registered trademark owned by The Neel Company. ©2012 The Neel Company

PRECASTER: CONCRETE SYSTEMS, INC.
 HUDSON, NH
 PROJECT #: T21882

CONTRACTOR:
 PROJECT #:

DESIGNER

THE NEEL COMPANY
 8328-D TRAFORD LANE
 SPRINGFIELD, VIRGINIA 22152
 PH: (703) 913-7858
 FX: (703) 913-7859
 WEB: WWW.NEELCO.COM

PROJECT #: TW4301

CERTIFIED WITH RESPECT
 TO INTERNAL STABILITY OF
 T-WALL® STRUCTURES ONLY

REVISIONS

**FABRICATION DRAWING
 8-6-14**


RIGIDIFIED TUBE FRP ARCH (RTFA) PROJECT

FAIRFIELD, VT


FABRICATION DRAWING
 SPECIAL UNIT SP16

T-WALL® RETAINING WALL SYSTEM


SCALE:	1" = 1'-0"
DATE:	8-6-14
DESIGNED BY:	KD
DRAWN BY:	ABC
CHECKED BY:	KD
SHEET:	TW-FB17

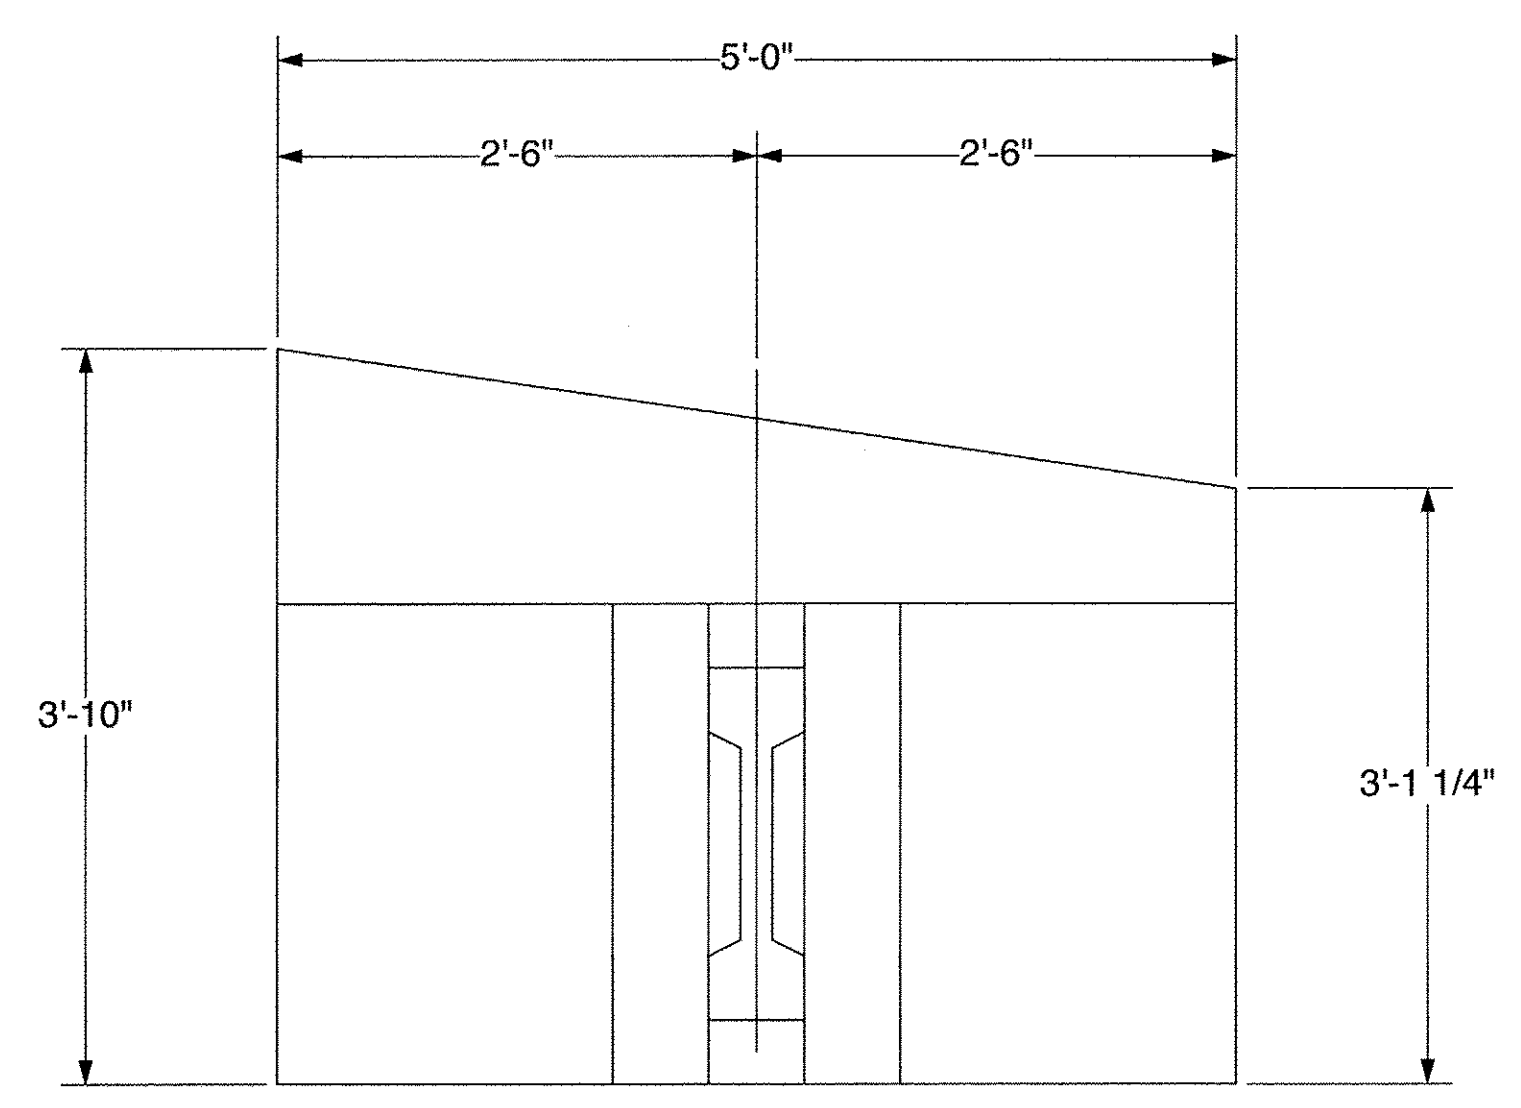

SP17 - FRONT VIEW

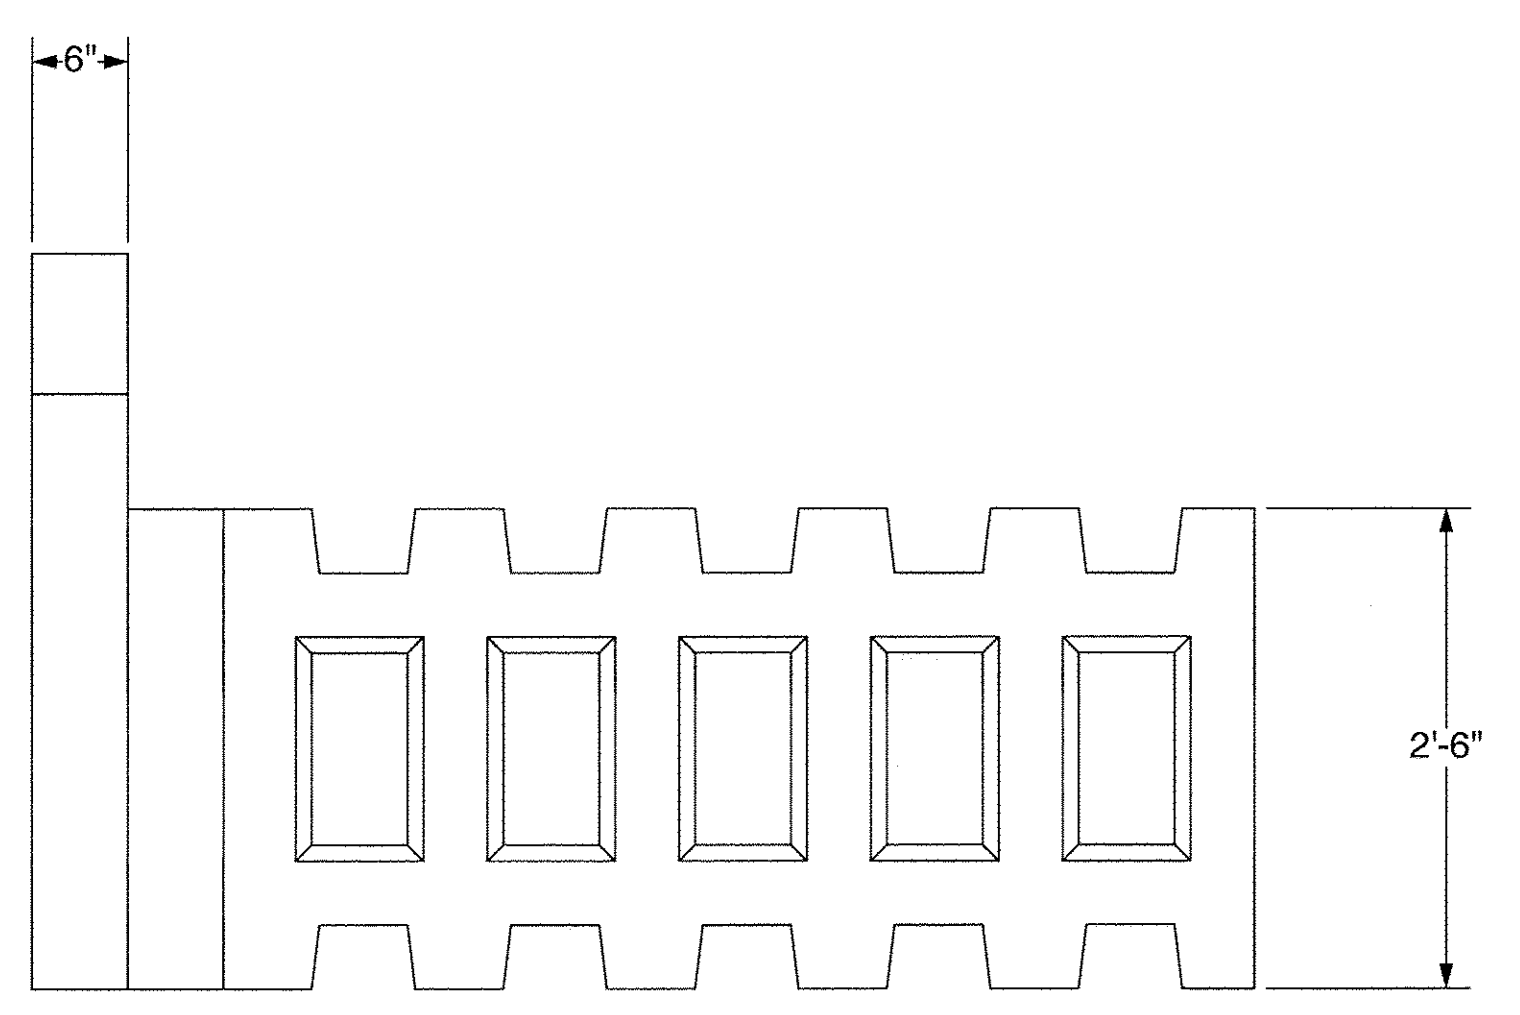

SP17 - SIDE VIEW

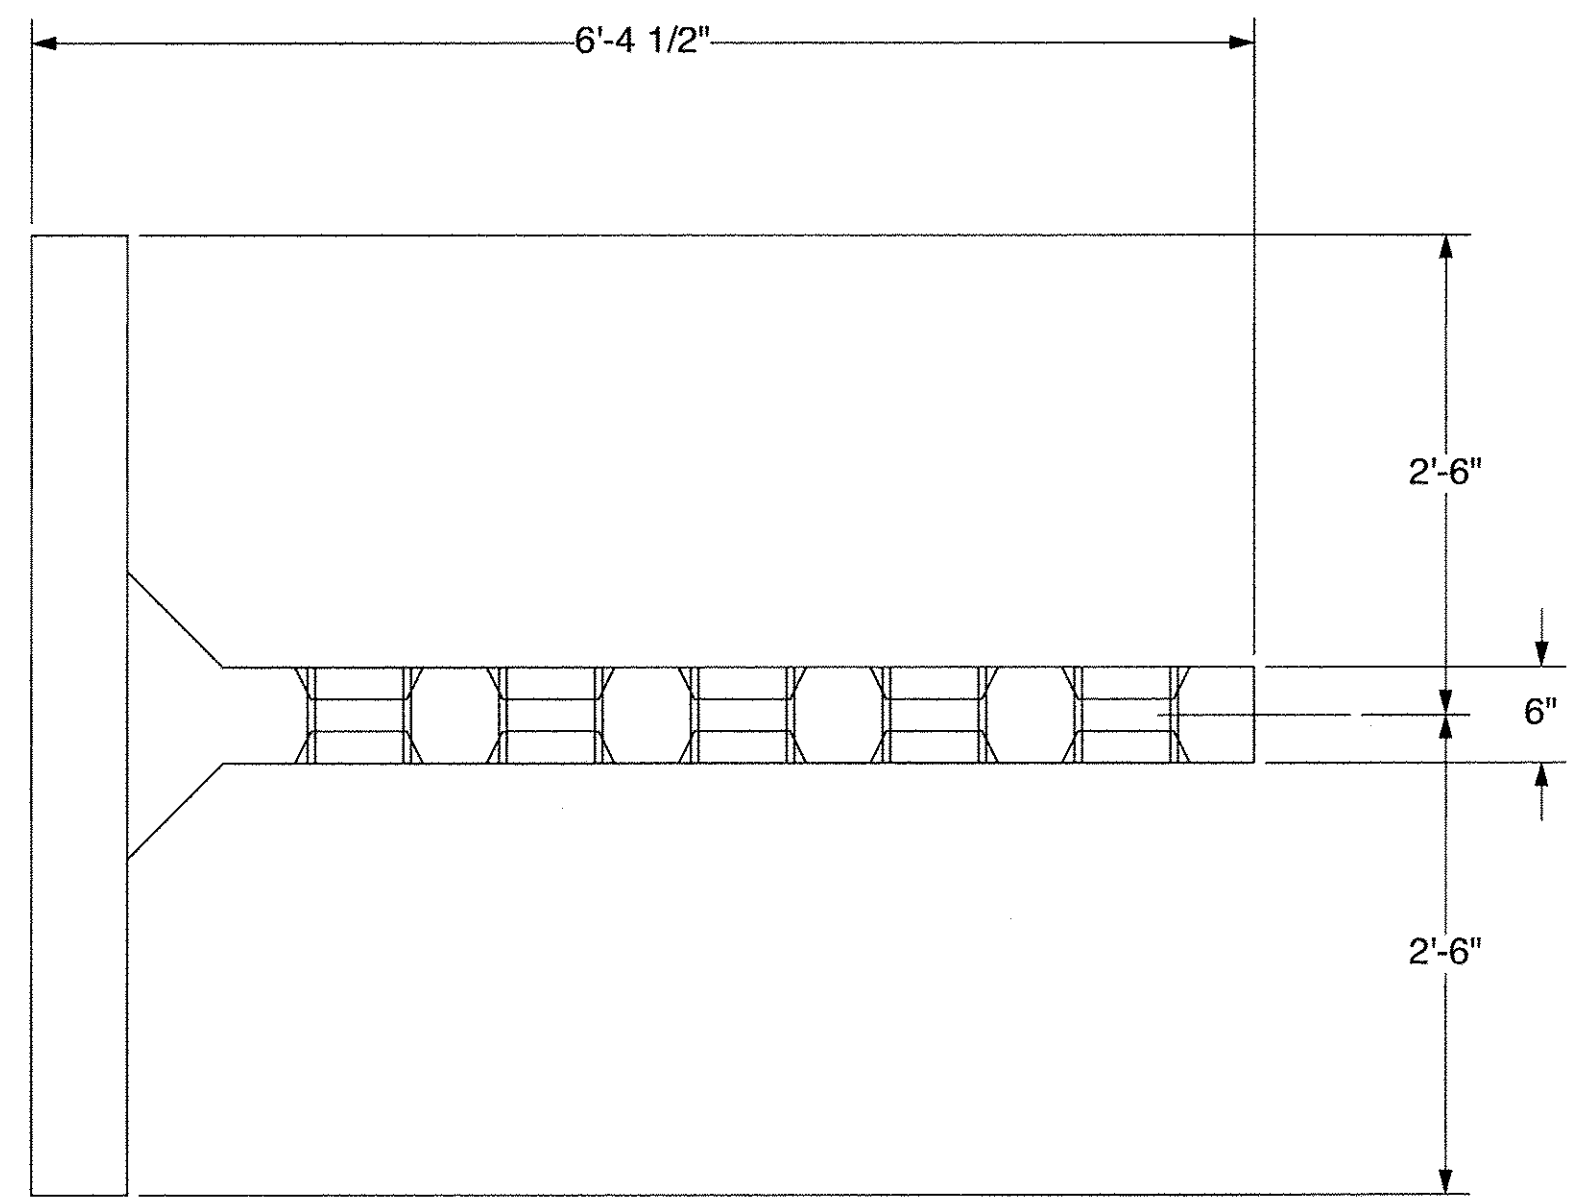


SP17 - PLAN VIEW

Approved Approved As Noted
 Rejected

This review is only for general conformance with the design concept and the information given in the Construction Documents. Corrections or comments made on the shop drawings during the review do not relieve the Contractor from compliance with the requirements of the Plans and Specifications. Review of a specific item shall not include review of an assembly of which an item is a component. The Contractor is responsible for dimensions to be confirmed and corrected at the job site; information that pertains solely to the fabrication process or to the means, methods, techniques, sequences and procedures of construction; coordination of the Work with that of other trades and performing all Work in a safe and satisfactory manner.



Date 8/8/2014
 By T. Traver

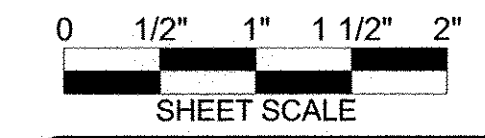

The design contained on these drawings is based upon information provided by the owner. On the basis of this information, The Neel Company has designed, and is responsible for, the internal stability of the structure only. External stability, including foundation and slope stability, is the responsibility of the owner.

This drawing contains information proprietary to The Neel Company. T-WALL® is a registered trademark owned by The Neel Company. ©2012 The Neel Company

PRECASTER: CONCRETE SYSTEMS, INC.
 HUDSON, NH
PROJECT #: T21882

CONTRACTOR:
PROJECT #:

DESIGNER

THE NEEL COMPANY
 8328-D TRAFORD LANE
 SPRINGFIELD, VIRGINIA 22152
 PH: (703) 913-7858
 FX: (703) 913-7859
 WEB: WWW.NEELCO.COM

PROJECT #: TW4301

CERTIFIED WITH RESPECT
 TO INTERNAL STABILITY OF
 T-WALL® STRUCTURES ONLY

REVISIONS	

FABRICATION DRAWING
8-6-14


RIGIDIFIED TUBE FRP ARCH (RTFA) PROJECT

FAIRFIELD, VT


FABRICATION DRAWING
 SPECIAL UNIT SP17

T-WALL® RETAINING WALL SYSTEM

SCALE:	1" = 1'-0"
DATE:	8-6-14
DESIGNED BY:	KD
DRAWN BY:	ABC
CHECKED BY:	KD
SHEET:	TW-FB18

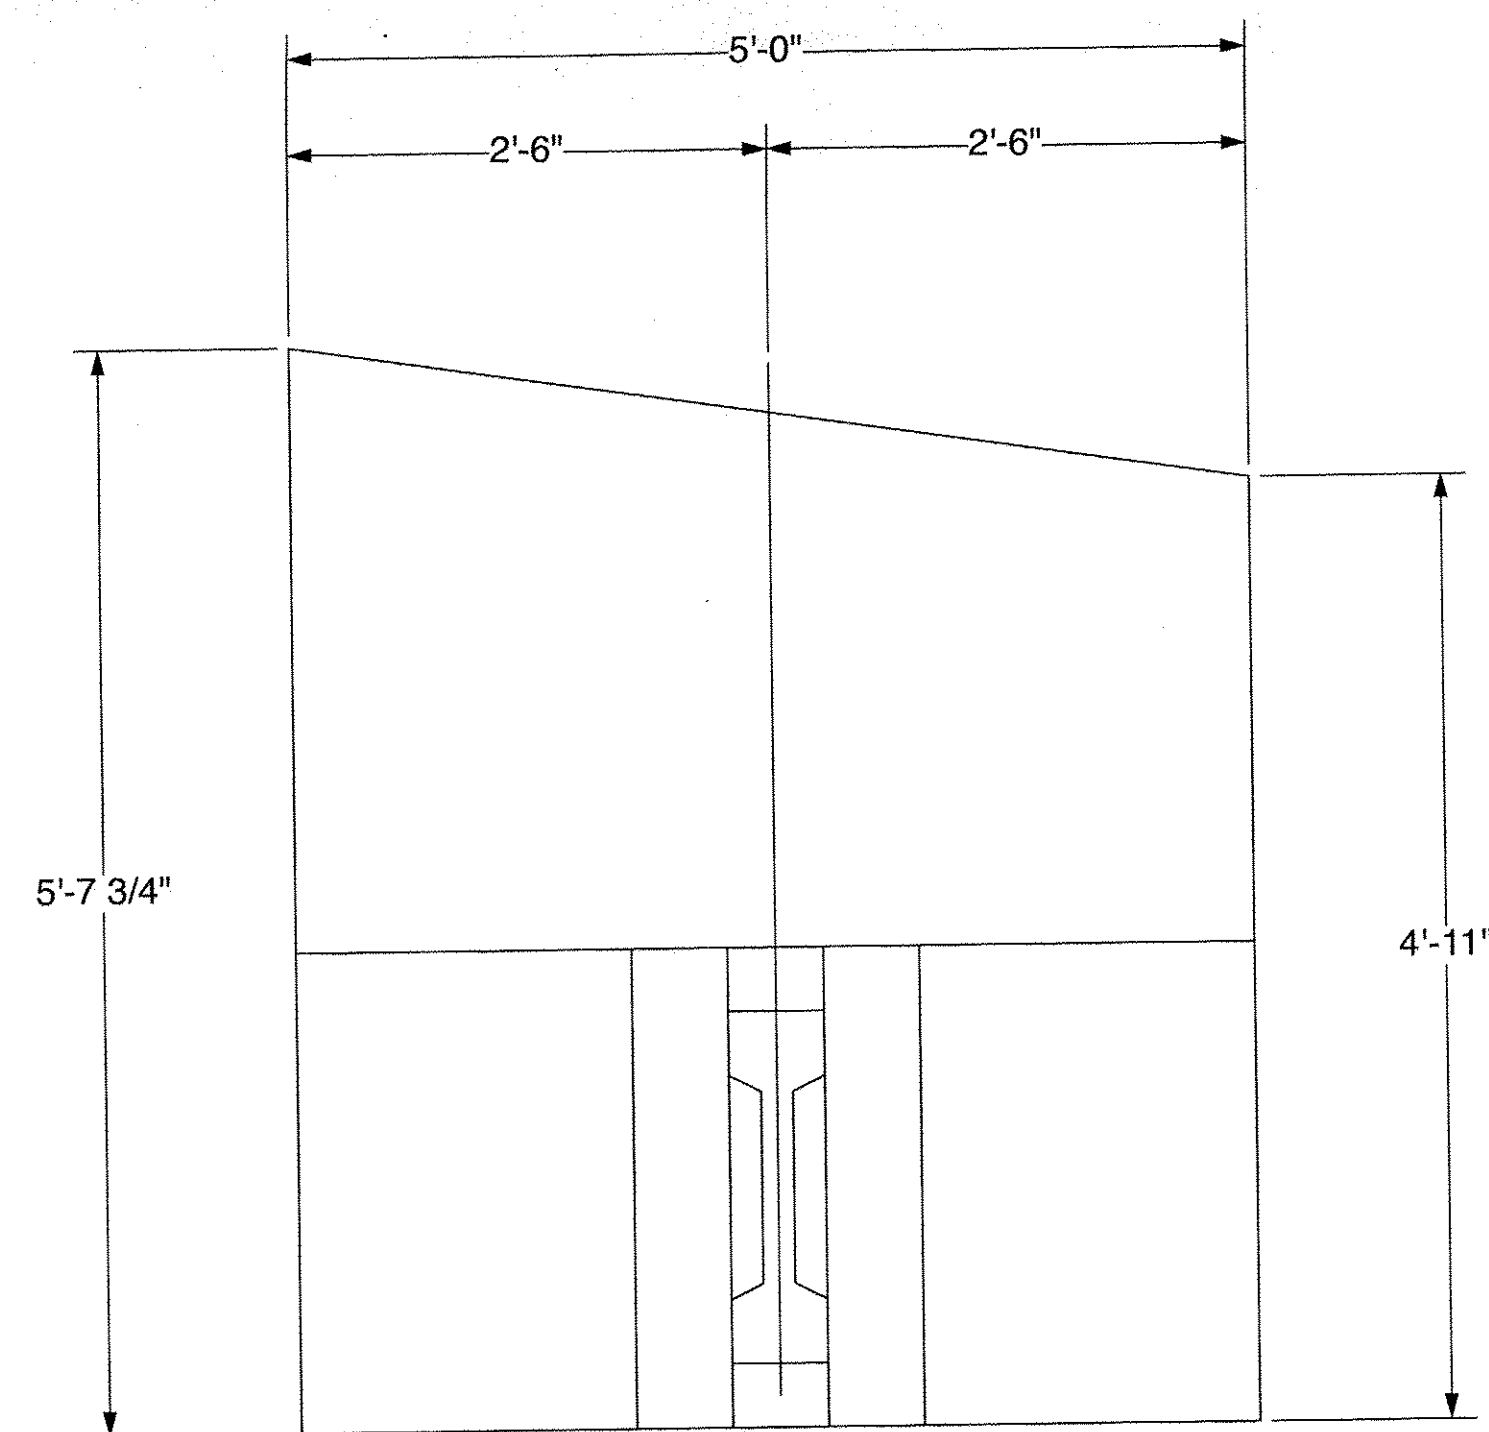


SP18 - FRONT VIEW

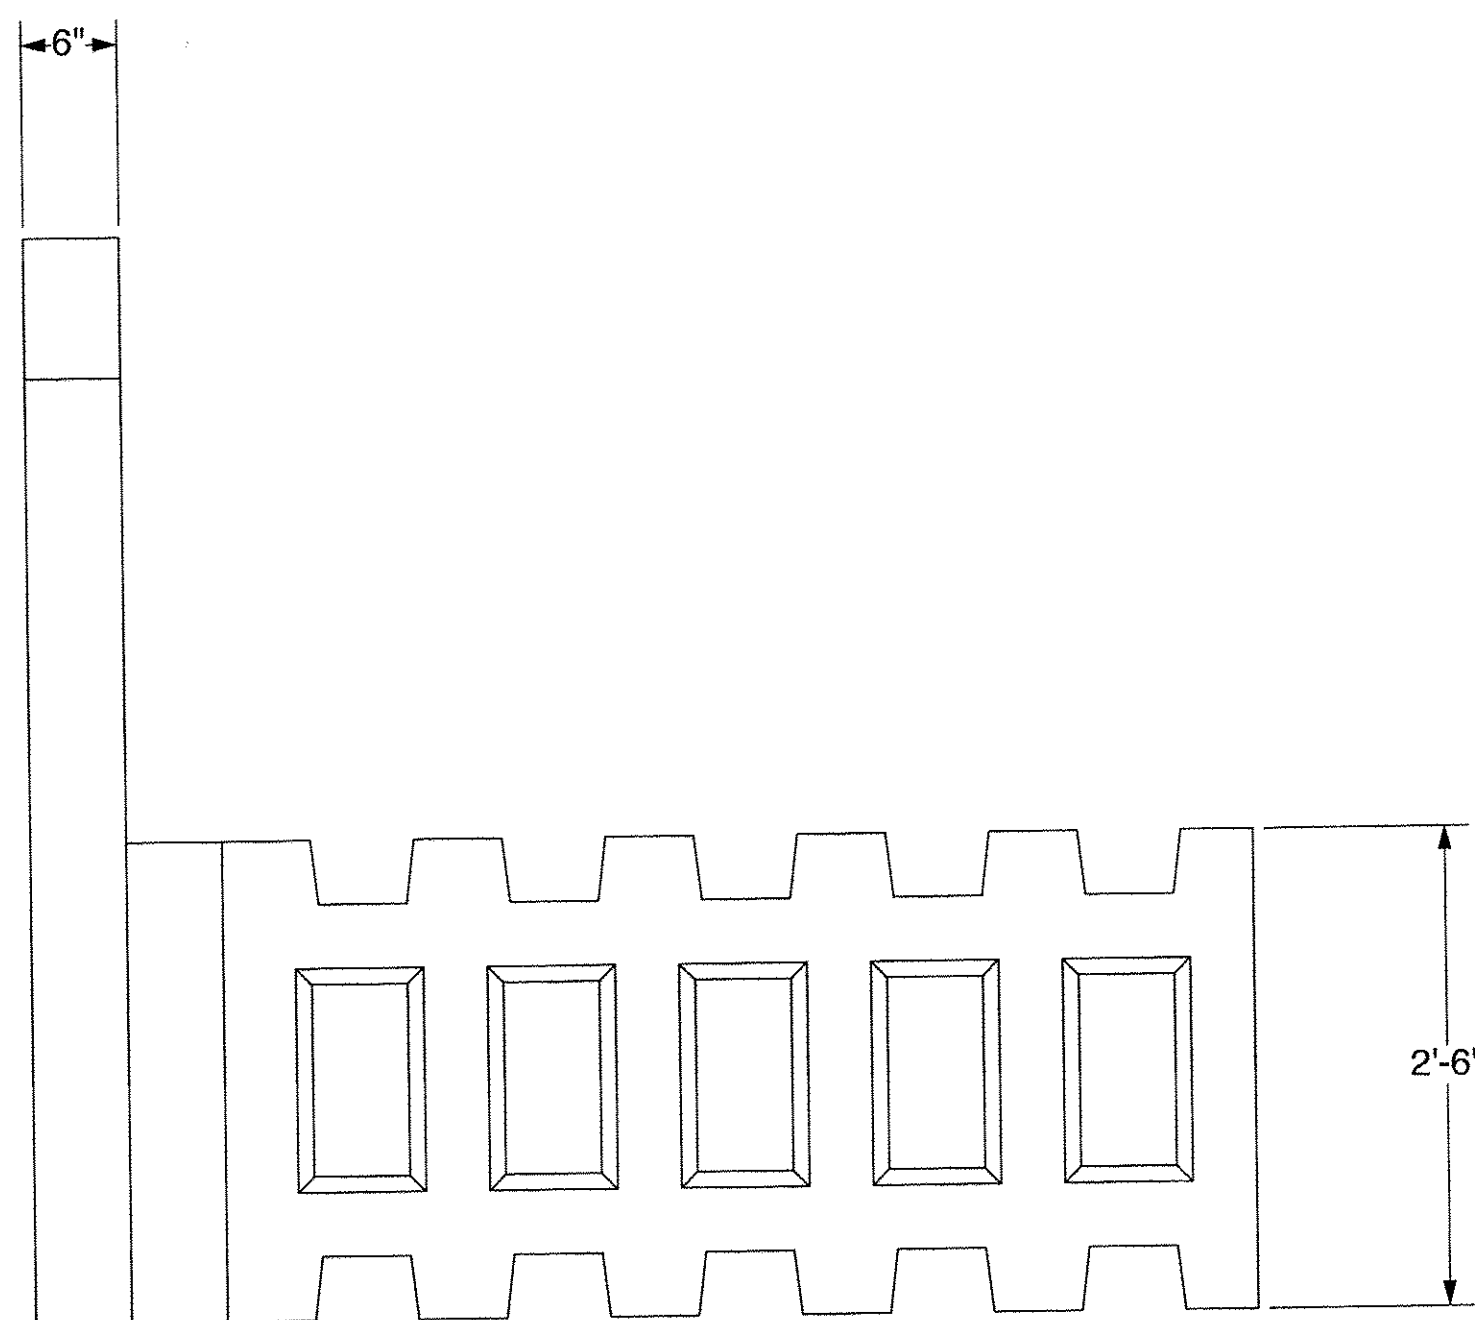

SP18 - SIDE VIEW

<input checked="" type="checkbox"/> Approved <input type="checkbox"/> Rejected	<input type="checkbox"/> Approved As Noted
<p>This review is only for general conformance with the design concept and the information given in the Construction Documents. Corrections or comments made on the shop drawings during the review do not relieve the Contractor from compliance with the requirements of the Plans and Specifications. Review of a specific item shall not include review of an assembly of which an item is a component. The Contractor is responsible for dimensions to be confirmed and corrected at the job site; information that pertains solely to the fabrication process or to the means, methods, techniques, sequences and procedures of construction; coordination of the Work with that of other trades and performing all Work in a safe and satisfactory manner.</p>	
<p>Date <u>8/8/2014</u></p>	
<p>By <u>T. Traver</u></p>	
McFarland Johnson	

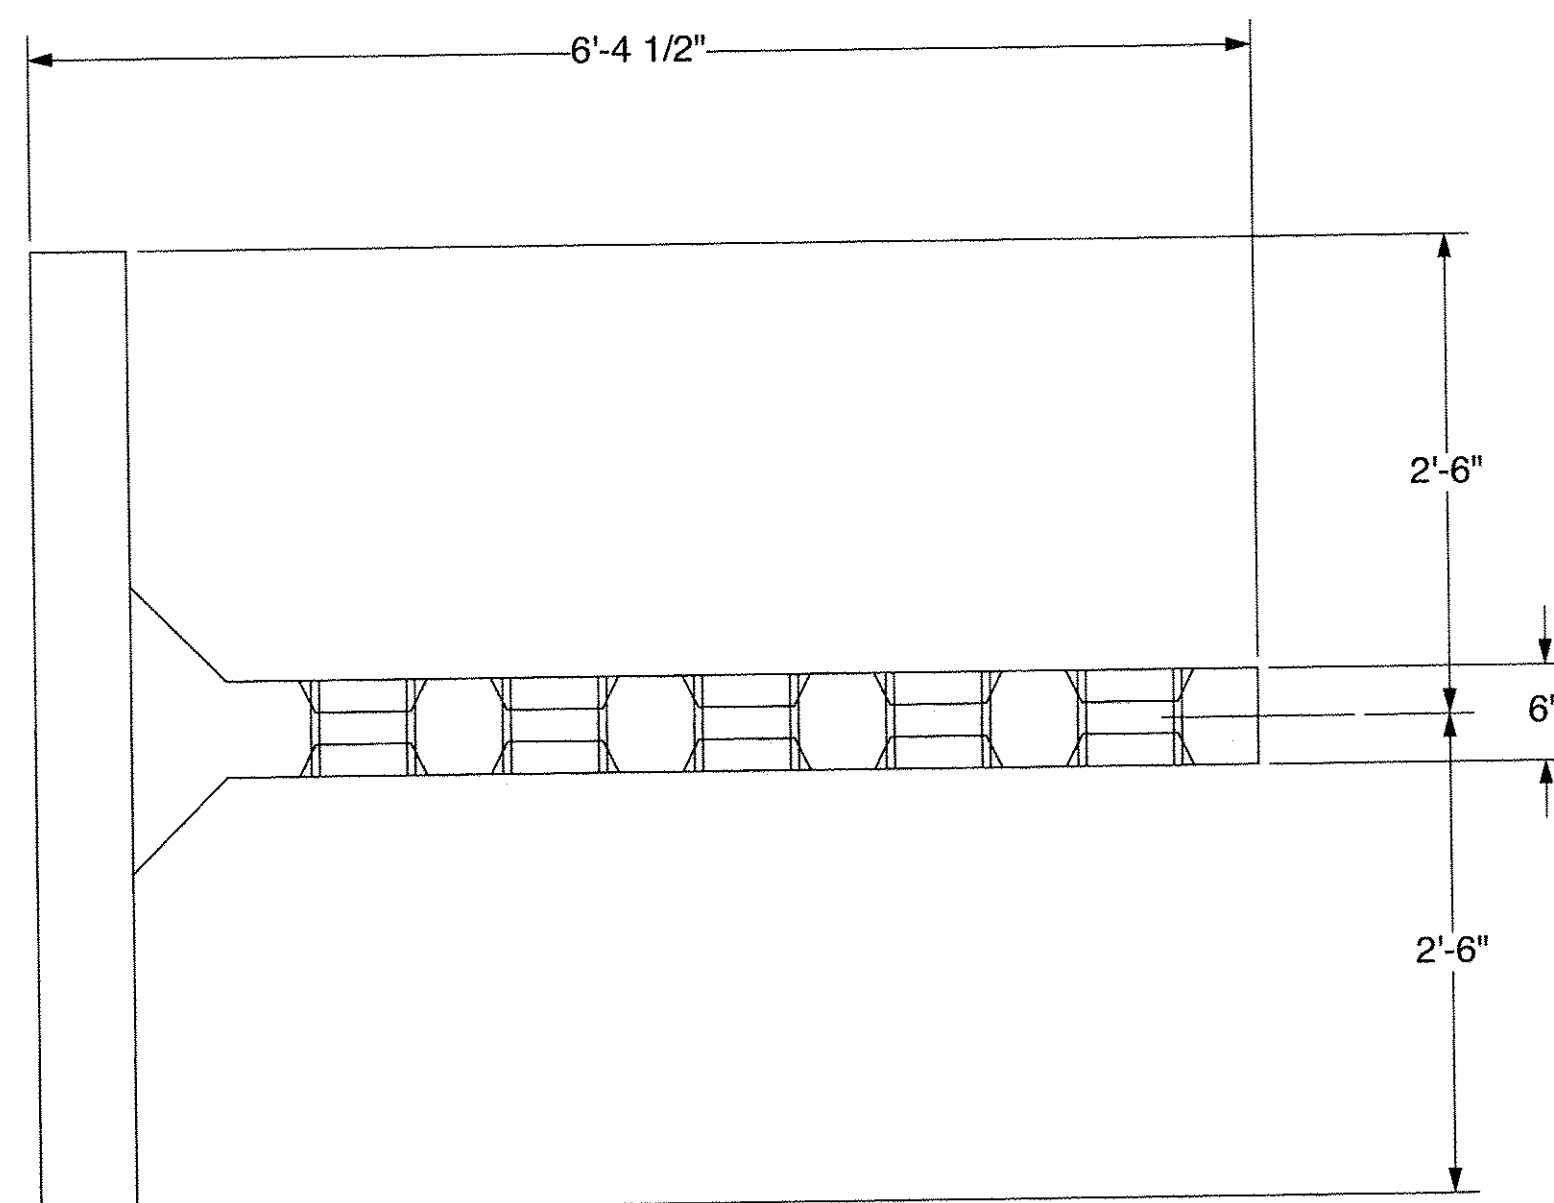

SP18 - PLAN VIEW

FABRICATION DRAWING
8-6-14


RIGIDIFIED TUBE FRP ARCH (RTFA) PROJECT

FAIRFIELD, VT

FABRICATION DRAWING
SPECIAL UNIT SP18

T-WALL® RETAINING WALL SYSTEM

SCALE:	1" = 1'-0"
DATE:	8-6-14
DESIGNED BY:	KD
DRAWN BY:	ABC
CHECKED BY:	KD
SHEET:	TW-FB19

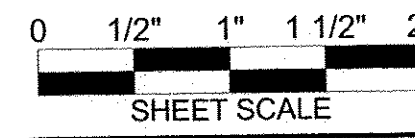

The design contained on these drawings is based upon information provided by the owner. On the basis of this information, The Neel Company has designed, and is responsible for, the internal stability of the structure only. External stability, including foundation and slope stability, is the responsibility of the owner.

This drawing contains information proprietary to The Neel Company. T-WALL® is a registered trademark owned by The Neel Company. ©2012 The Neel Company

PRECASTER: CONCRETE SYSTEMS, INC.
HUDSON, NH
PROJECT #: T21882

CONTRACTOR:

PROJECT #:


DESIGNER

THE NEEL COMPANY
8328-D TRAFORD LANE
SPRINGFIELD, VIRGINIA 22152
PH: (703) 913-7858
FX: (703) 913-7859
WEB: WWW.NEELCO.COM


PROJECT #: TW4301

CERTIFIED WITH RESPECT
TO INTERNAL STABILITY OF
T-WALL® STRUCTURES ONLY

REVISIONS

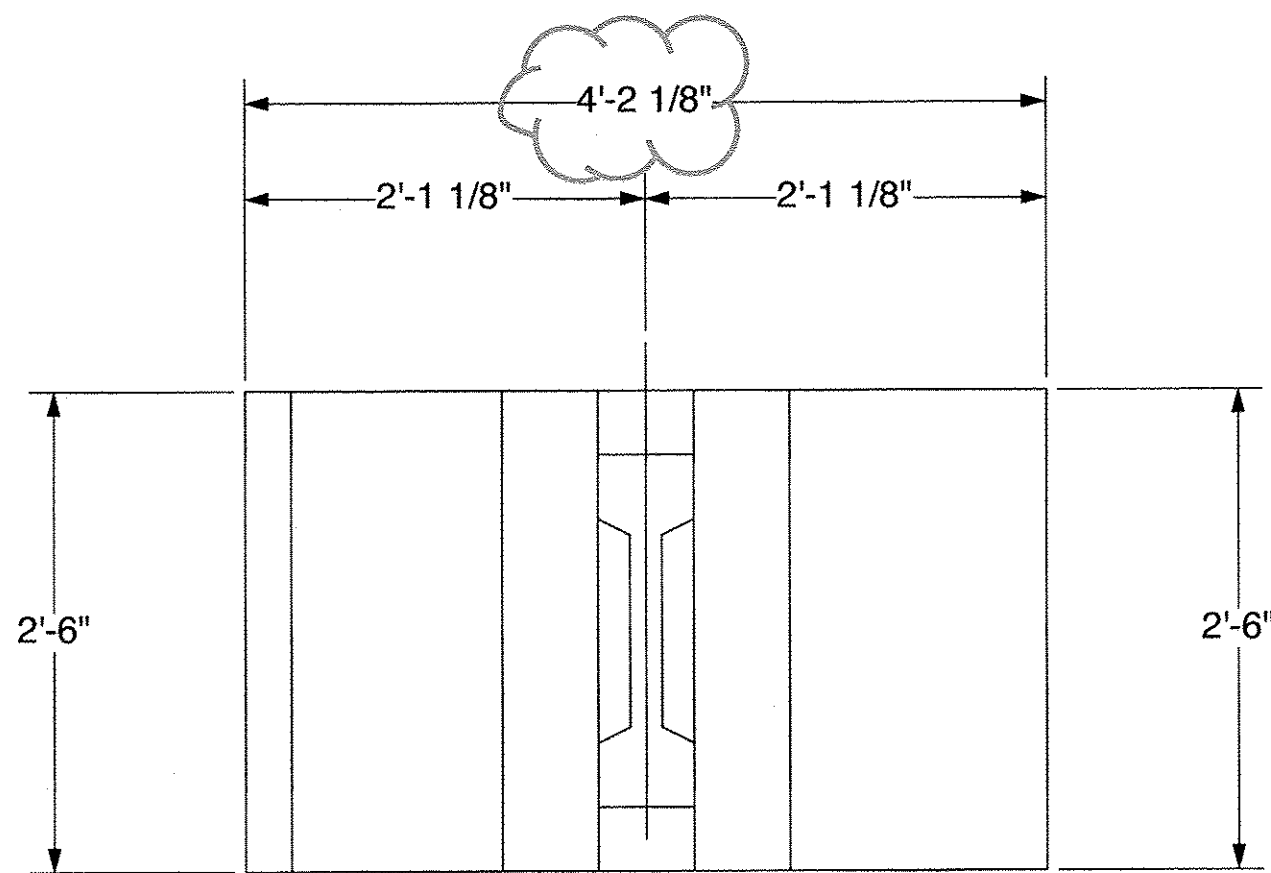


SP20 - FRONT VIEW

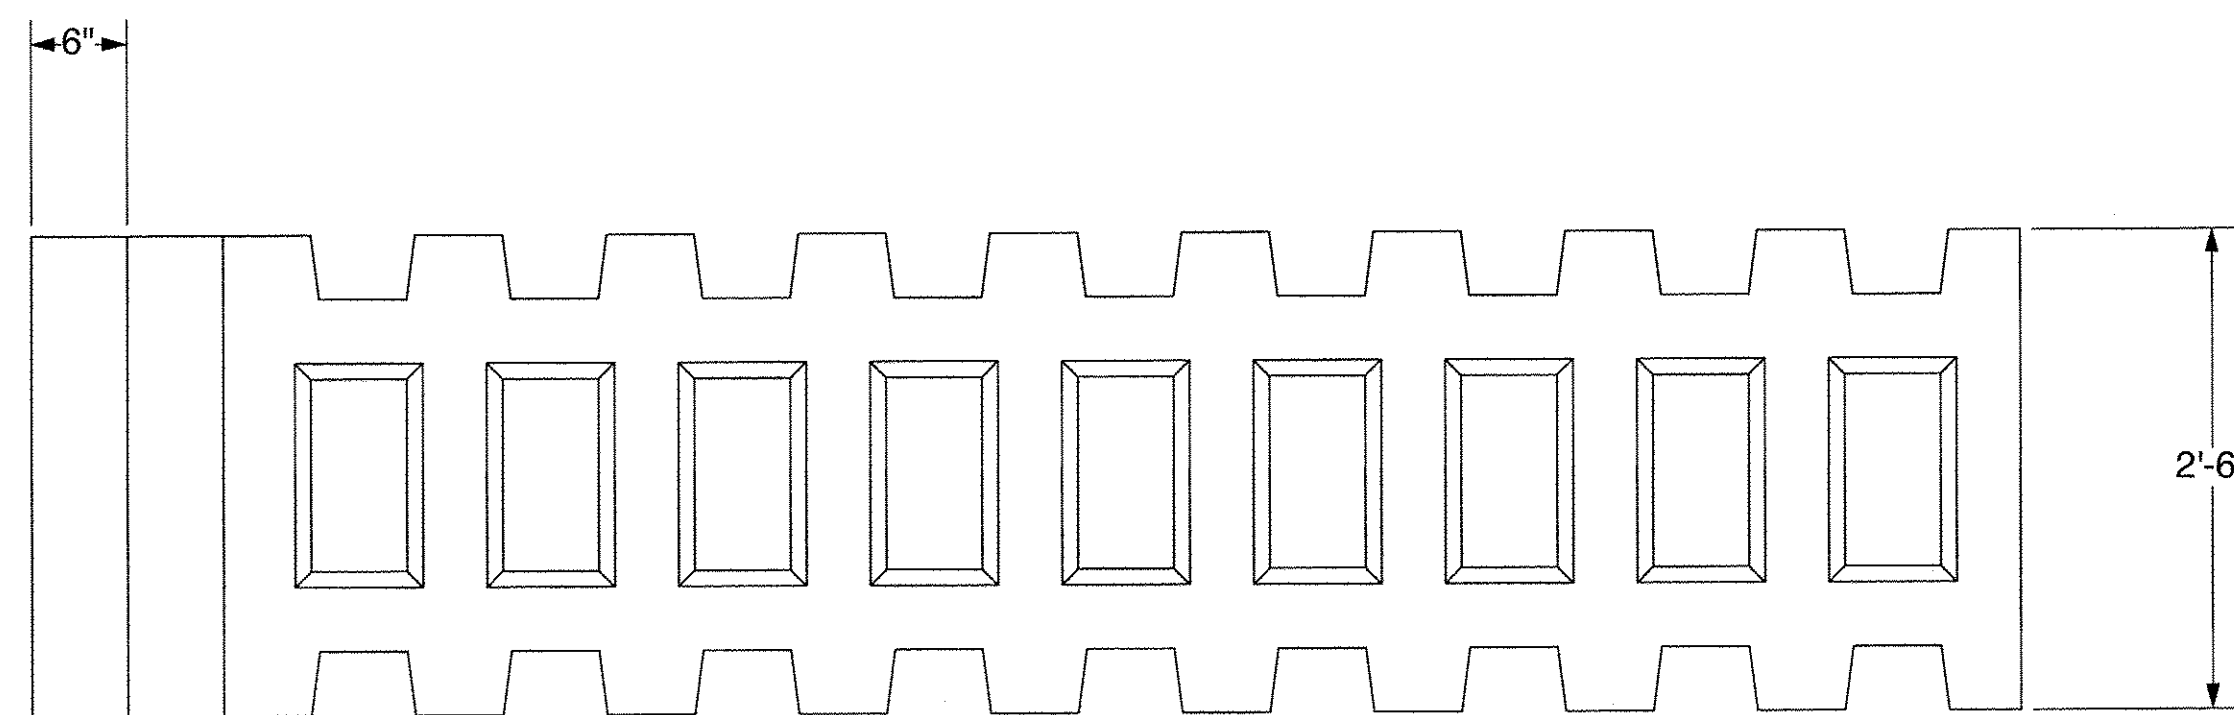

SP20 - SIDE VIEW

check dimensions:
 $2'-5 \frac{1}{4}'' + 1'-8'' - 3 \frac{1}{2}'' + 5 \frac{1}{8}''$ does
 equals $4'-2 \frac{7}{8}''$ not $4'-2 \frac{1}{8}''$.

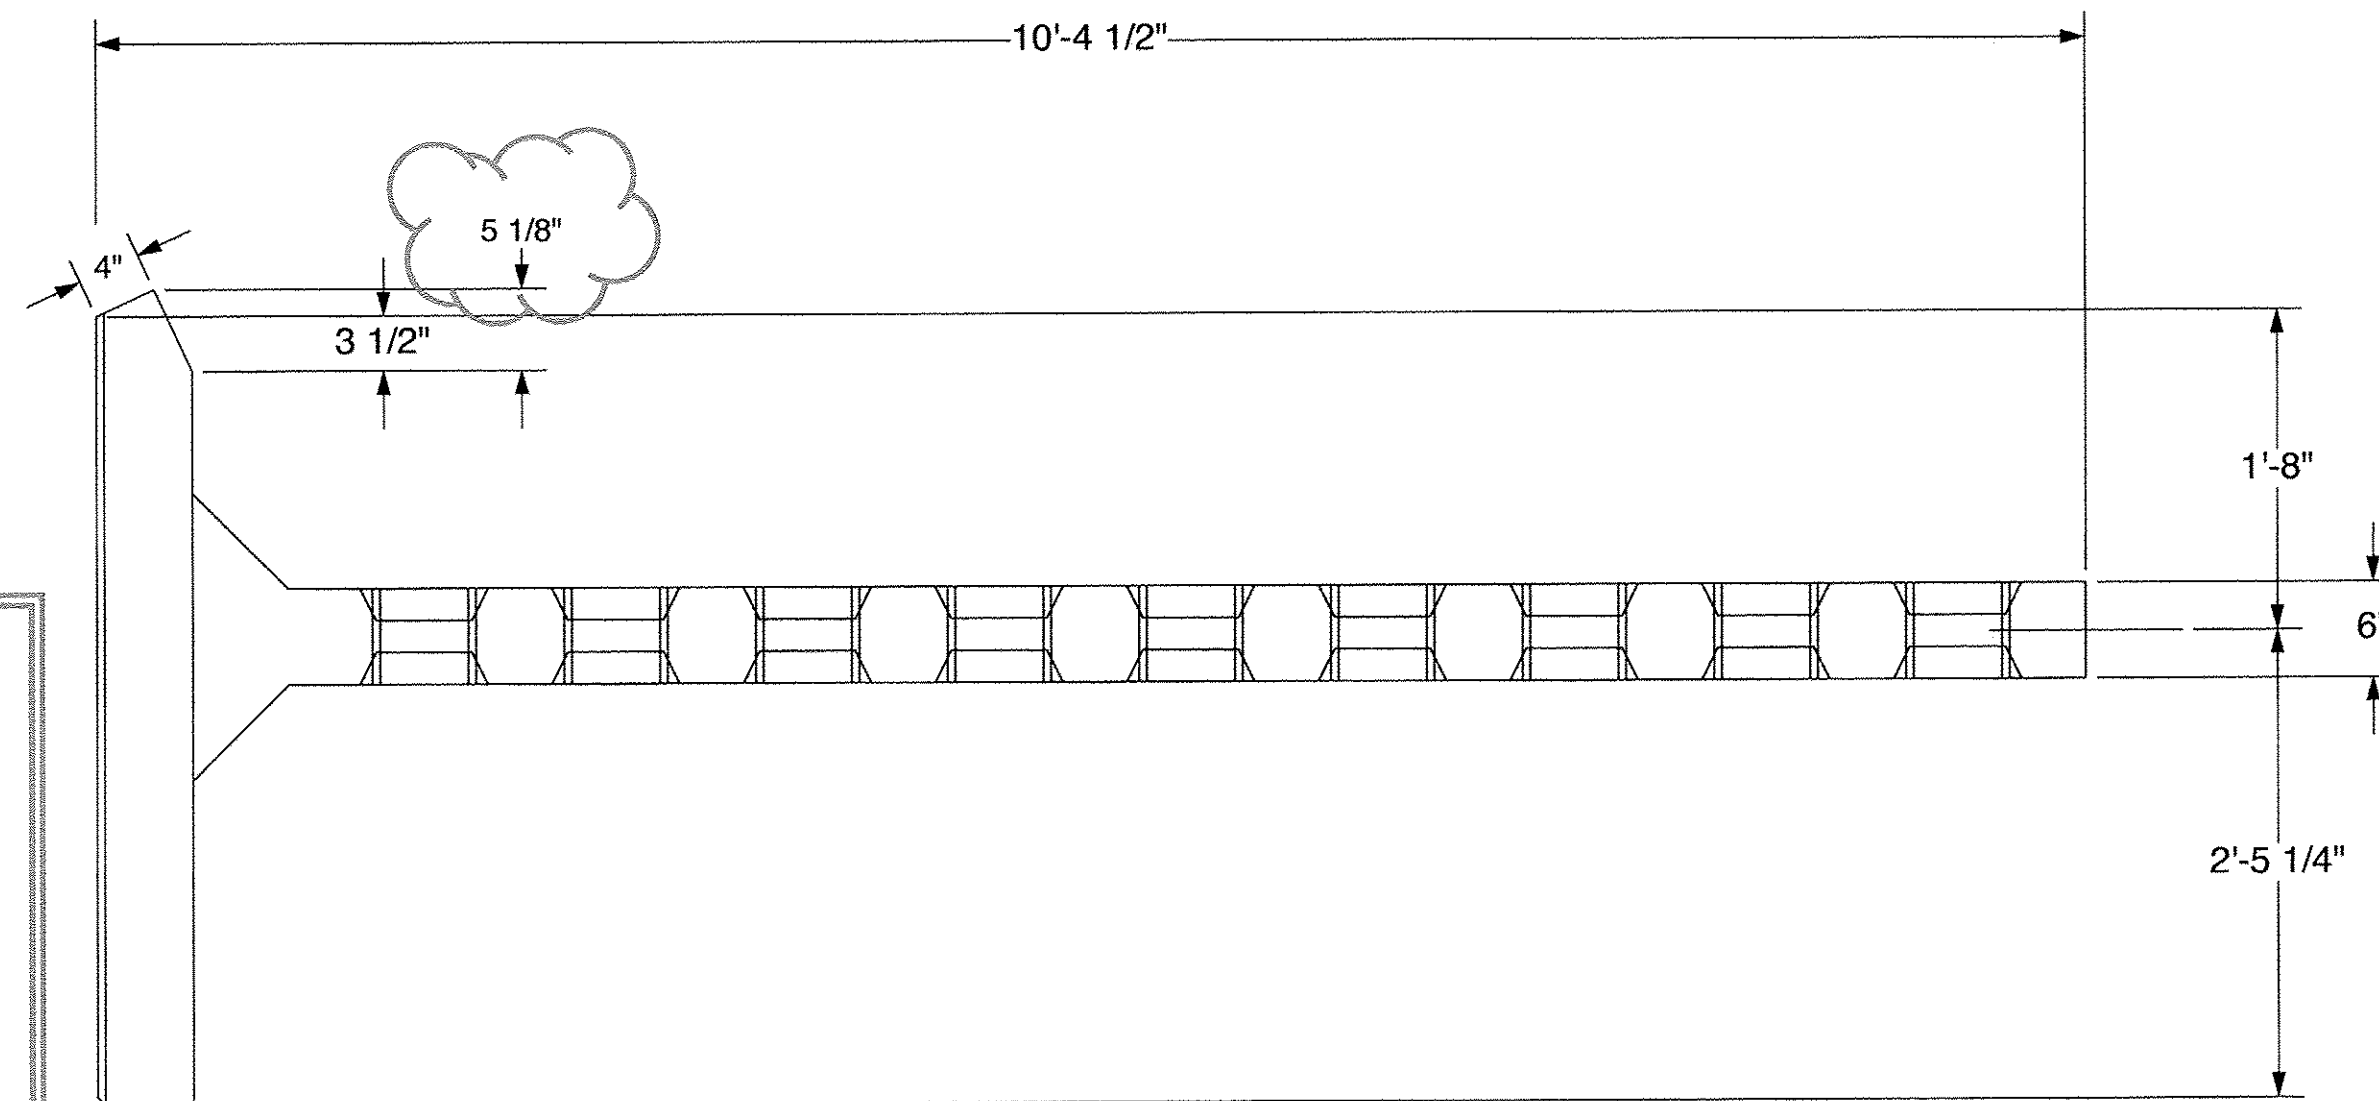

SP20 - PLAN VIEW

Approved
 Rejected


____ Approved As Noted

This review is only for general conformance with the design concept and the information given in the Construction Documents. Corrections or comments made on the shop drawings during the review do not relieve the Contractor from compliance with the requirements of the Plans and Specifications. Review of a specific item shall not include review of an assembly of which an item is a component. The Contractor is responsible for dimensions to be confirmed and corrected at the job site; information that pertains solely to the fabrication process or to the means, methods, techniques, sequences and procedures of construction; coordination of the Work with that of other trades and performing all Work in a safe and satisfactory manner.

Date 8/8/2014

McFarland Johnson

By T. Traver

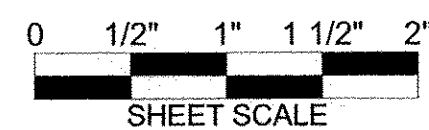

The design contained on these drawings is based upon information provided by the owner. On the basis of this information, The Neel Company has designed, and is responsible for, the internal stability of the structure only. External stability, including foundation and slope stability, is the responsibility of the owner.

This drawing contains information proprietary to The Neel Company. T-WALL® is a registered trademark owned by The Neel Company. ©2012 The Neel Company

PRECASTER: CONCRETE SYSTEMS, INC.
 HUDSON, NH
 PROJECT #: T21882

CONTRACTOR:
 PROJECT #:

DESIGNER



THE NEEL COMPANY
 8328-D TRAFORD LANE
 SPRINGFIELD, VIRGINIA 22152
 PH: (703) 913-7858
 FX: (703) 913-7859
 WEB: WWW.NEELCO.COM

PROJECT #: TW4301

CERTIFIED WITH RESPECT
 TO INTERNAL STABILITY OF
 T-WALL® STRUCTURES ONLY

REVISIONS

**FABRICATION DRAWING
 8-6-14**

RIGIDIFIED TUBE FRP ARCH (RTFA) PROJECT


FAIRFIELD, VT

FABRICATION DRAWING
 SPECIAL UNIT SP20


T-WALL® RETAINING WALL SYSTEM

SCALE:	1" = 1'-0"
DATE:	8-6-14
DESIGNED BY:	KD
DRAWN BY:	ABC
CHECKED BY:	KD
SHEET:	TW-FB20

BORDER-TNC T-WALL HWY v4.1

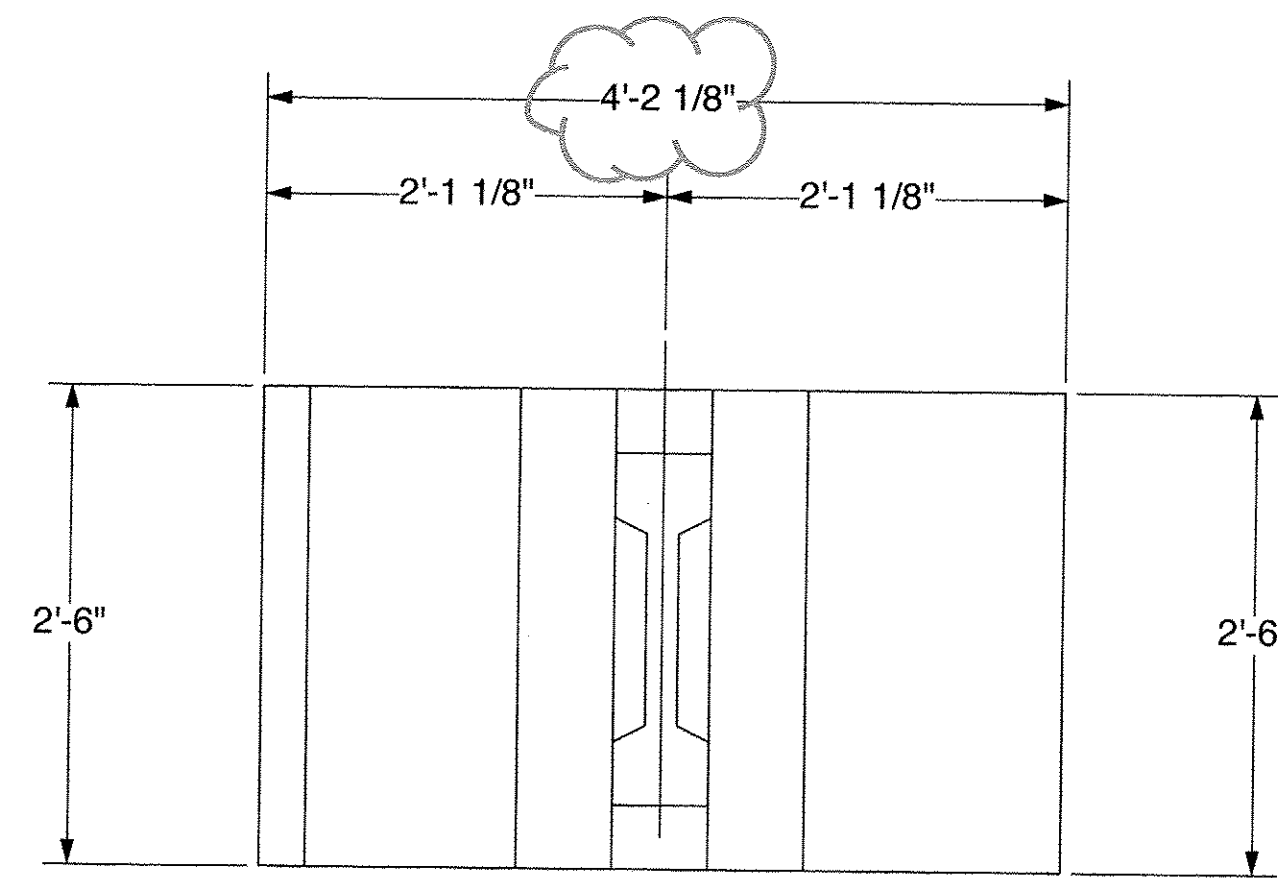


SP21 - FRONT VIEW

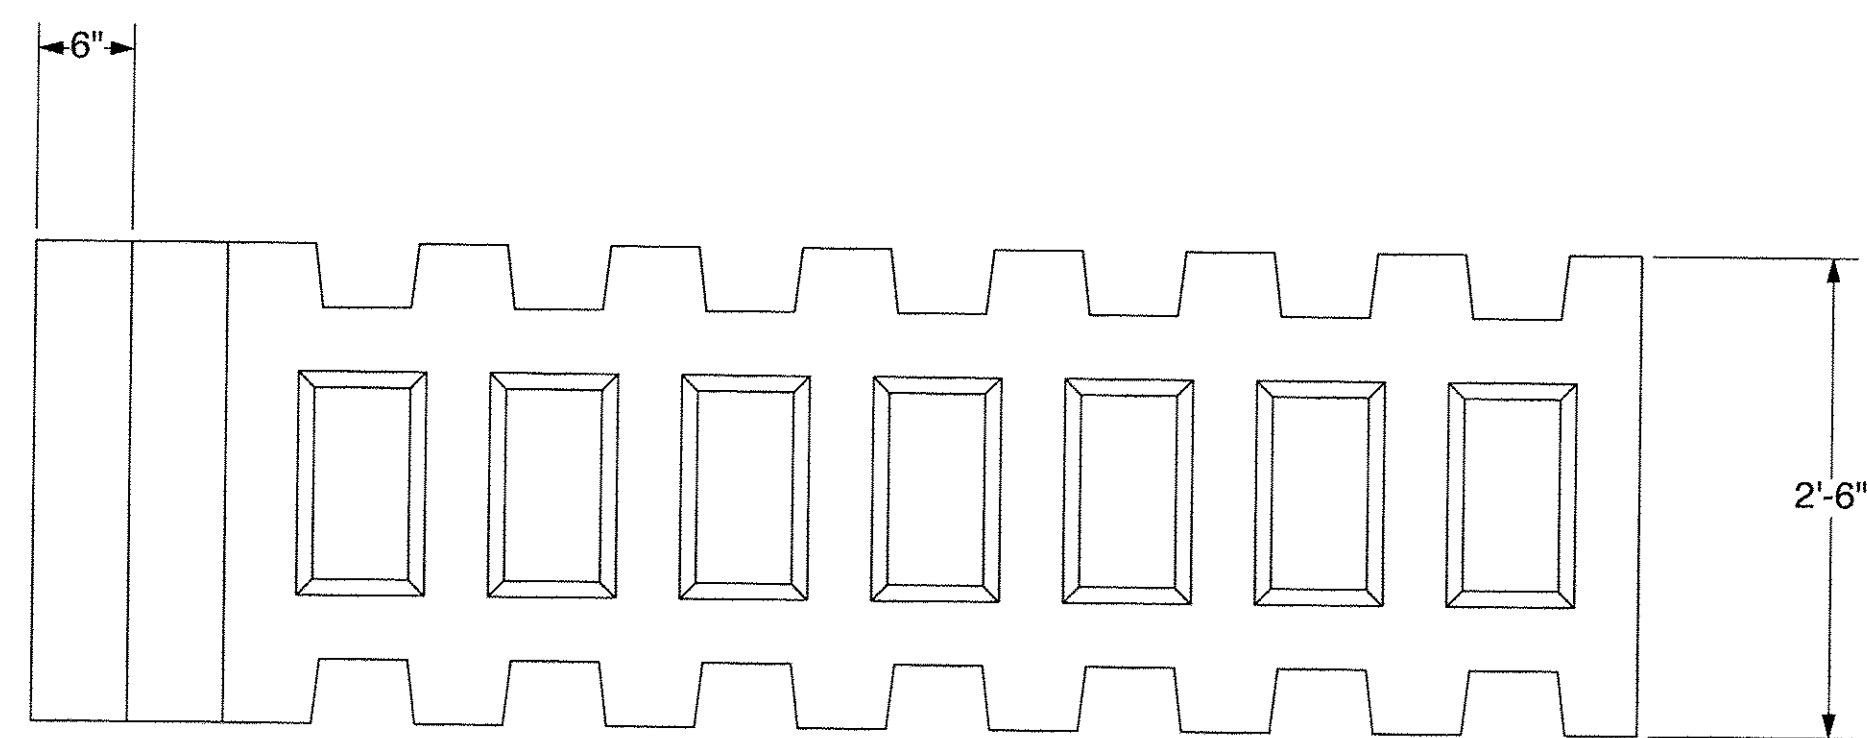

SP21 - SIDE VIEW

check dimensions:
 $2'-5 \frac{1}{4}'' + 1'-8'' - 3 \frac{1}{2}'' + 5 \frac{1}{8}''$ does
 equals $4'-2 \frac{7}{8}''$ not $4'-2 \frac{1}{8}''$.

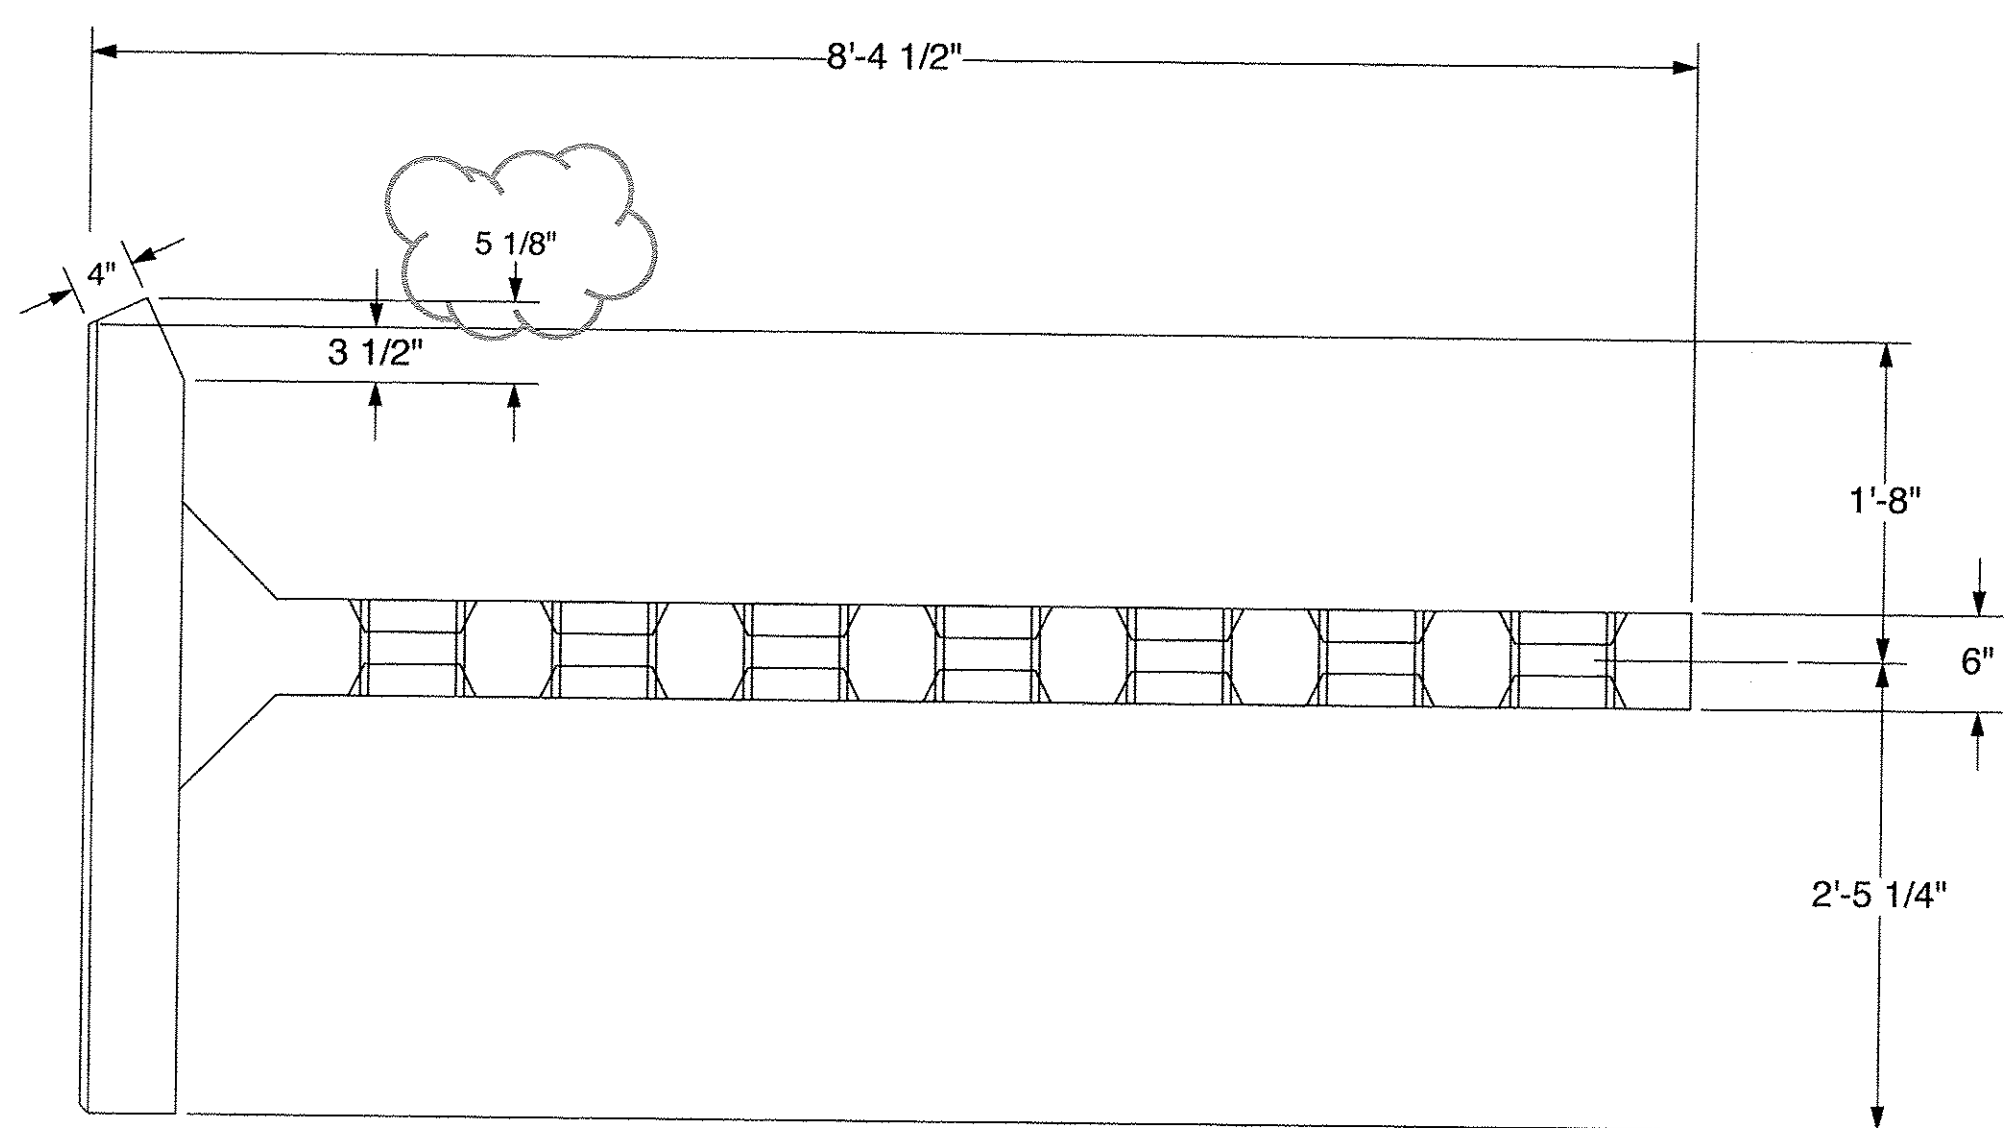

SP21 - PLAN VIEW


Approved
 Rejected

Approved As Noted

This review is only for general conformance with the design concept and the information given in the Construction Documents. Corrections or comments made on the shop drawings during the review do not relieve the Contractor from compliance with the requirements of the Plans and Specifications. Review of a specific item shall not include review of an assembly of which an item is a component. The Contractor is responsible for dimensions to be confirmed and corrected at the job site; information that pertains solely to the fabrication process or to the means, methods, techniques, sequences and procedures of construction; coordination of the Work with that of other trades and performing all Work in a safe and satisfactory manner.

Date 8/8/2014
 By T. Traver

McFarland Johnson

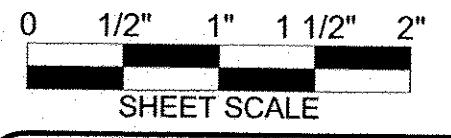

The design contained on these drawings is based upon information provided by the owner. On the basis of this information, The Neel Company has designed, and is responsible for, the internal stability of the structure only. External stability, including foundation and slope stability, is the responsibility of the owner.

This drawing contains information proprietary to The Neel Company. T-WALL® is a registered trademark owned by The Neel Company. ©2012 The Neel Company

PRECASTER: CONCRETE SYSTEMS, INC.
 HUDSON, NH
PROJECT #: T21882

CONTRACTOR:
PROJECT #:

DESIGNER
THE NEEL COMPANY
 8328-D TRAFORD LANE
 SPRINGFIELD, VIRGINIA 22152
 PH: (703) 913-7858
 FX: (703) 913-7859
 WEB: WWW.NEELCO.COM

PROJECT #: TW4301


CERTIFIED WITH RESPECT
 TO INTERNAL STABILITY OF
 T-WALL® STRUCTURES ONLY

REVISIONS	


FABRICATION DRAWING
8-6-14
RIGIDIFIED TUBE FRP ARCH (RTFA) PROJECT
 FAIRFIELD, VT
 FABRICATION DRAWING
 SPECIAL UNIT SP21
 T-WALL® RETAINING WALL SYSTEM

SCALE:	1" = 1'-0"
DATE:	8-6-14
DESIGNED BY:	KD
DRAWN BY:	ABC
CHECKED BY:	KD
SHEET:	TW-FB21

USER NAME: N/A
 VECTORWORKS 2011
 PLOT DATE & TIME: Wednesday, August 6, 2014 1:41:43 PM
 CAD FILE NAME: 02 TW4301 Fab-SP Unit r0.vwx
 VW SHEET NAME: TW-FB02

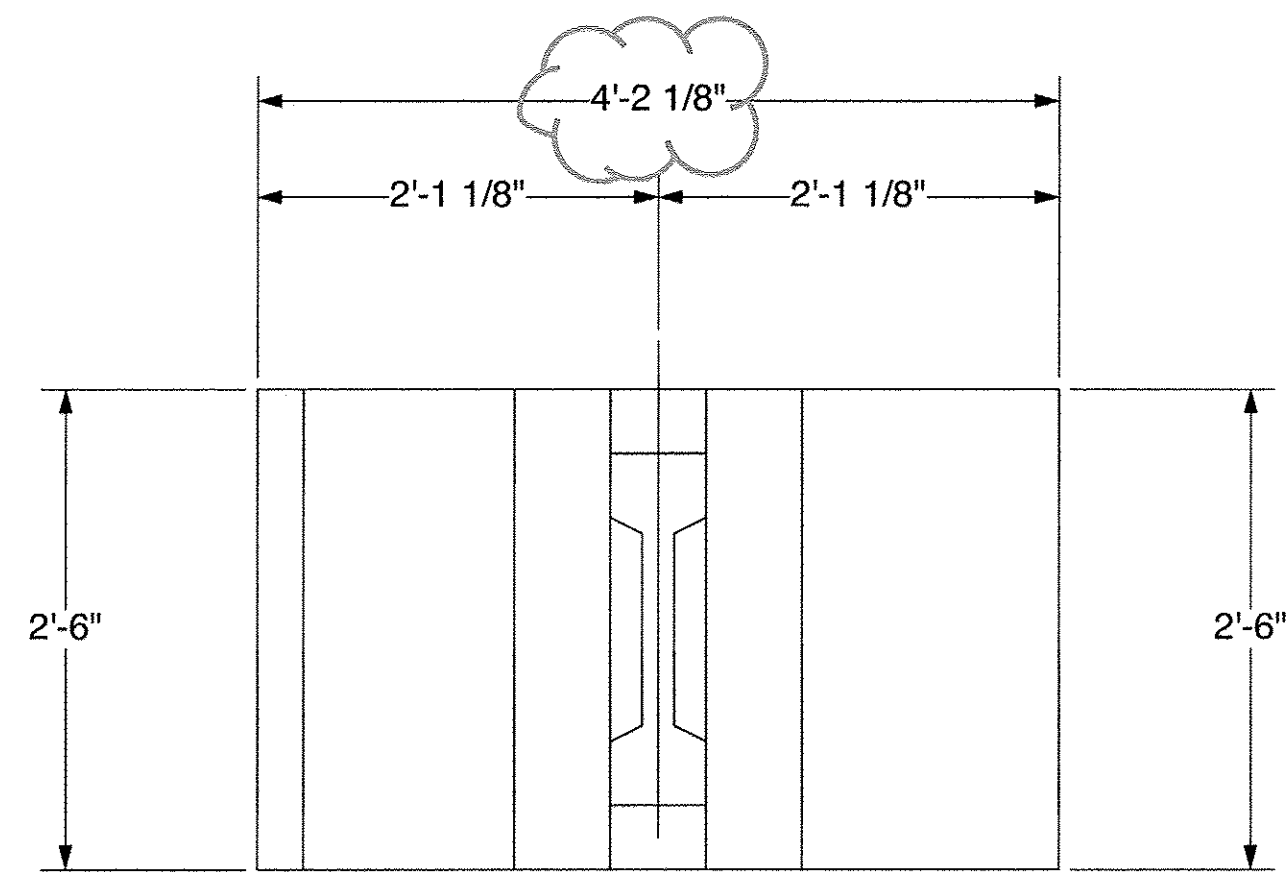


SP22 - FRONT VIEW

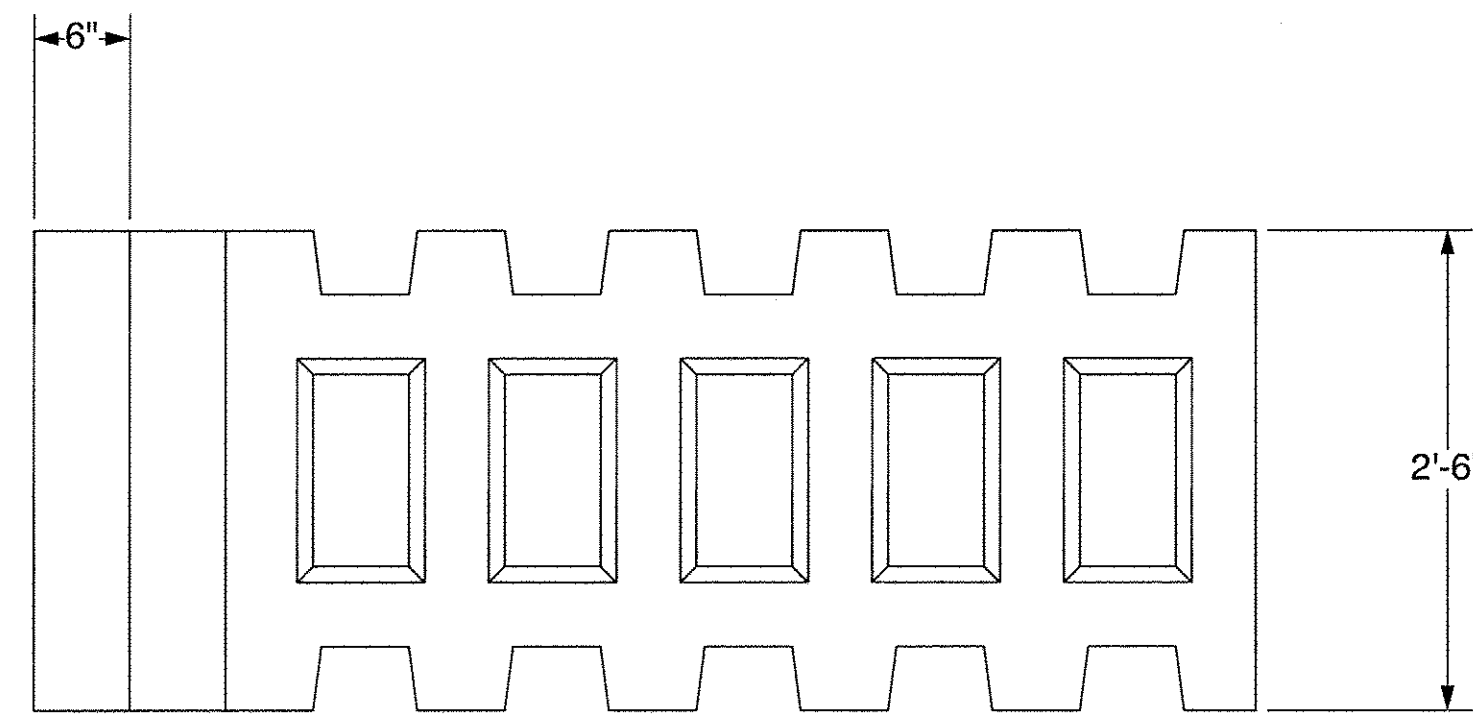


SP22 - SIDE VIEW

check dimensions:
2'-5 1/4"+1'-8"-3 1/2"+5 1/8" does
equals 4'-2 7/8" not 4'-2 1/8".

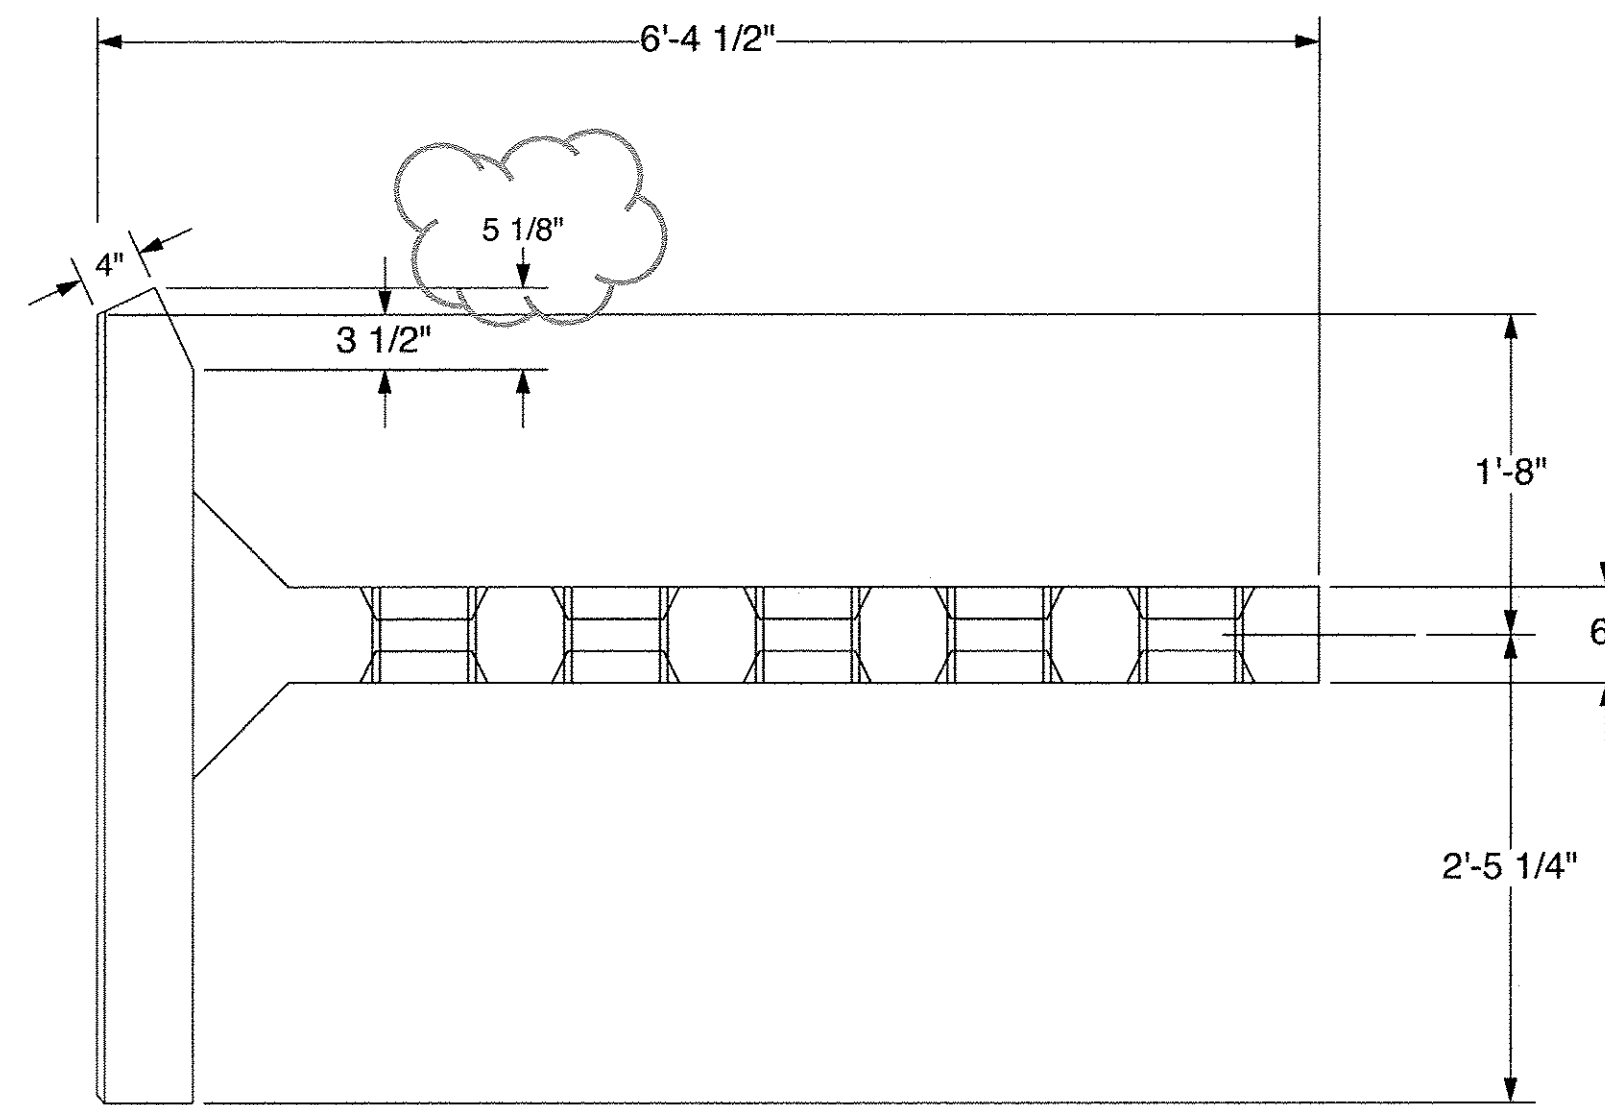

SP22 - PLAN VIEW

<input type="checkbox"/> Approved <input checked="" type="checkbox"/> Rejected	<input type="checkbox"/> Approved As Noted
This review is only for general conformance with the design concept and the information given in the Construction Documents. Corrections or comments made on the shop drawings during the review do not relieve the Contractor from compliance with the requirements of the Plans and Specifications. Review of a specific item shall not include review of an assembly of which an item is a component. The Contractor is responsible for dimensions to be confirmed and corrected at the job site; information that pertains solely to the fabrication process or to the means, methods, techniques, sequences and procedures of construction; coordination of the Work with that of other trades and performing all Work in a safe and satisfactory manner.	
Date <u>8/8/2014</u>	
By <u>T. Traver</u>	

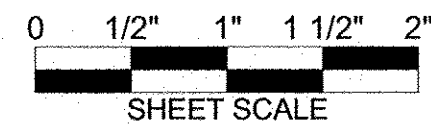

The design contained on these drawings is based upon information provided by the owner. On the basis of this information, The Neel Company has designed, and is responsible for, the internal stability of the structure only. External stability, including foundation and slope stability, is the responsibility of the owner.

This drawing contains information proprietary to The Neel Company. T-WALL® is a registered trademark owned by The Neel Company. ©2012 The Neel Company

PRECASTER: CONCRETE SYSTEMS, INC. HUDSON, NH PROJECT #: T21882
CONTRACTOR: PROJECT #:


DESIGNER THE NEEL COMPANY 8328-D TRAFORD LANE SPRINGFIELD, VIRGINIA 22152 PH: (703) 913-7858 FX: (703) 913-7859 WEB: WWW.NEELCO.COM
PROJECT #: TW4301

CERTIFIED WITH RESPECT
TO INTERNAL STABILITY OF
T-WALL® STRUCTURES ONLY


REVISIONS	

FABRICATION DRAWING 8-6-14 RIGIDIFIED TUBE FRP ARCH (RTFA) PROJECT FAIRFIELD, VT FABRICATION DRAWING SPECIAL UNIT SP22 T-WALL® RETAINING WALL SYSTEM


SCALE:	1" = 1'-0"
DATE:	8-6-14
DESIGNED BY:	KD
DRAWN BY:	ABC
CHECKED BY:	KD
SHEET:	TW-FB22

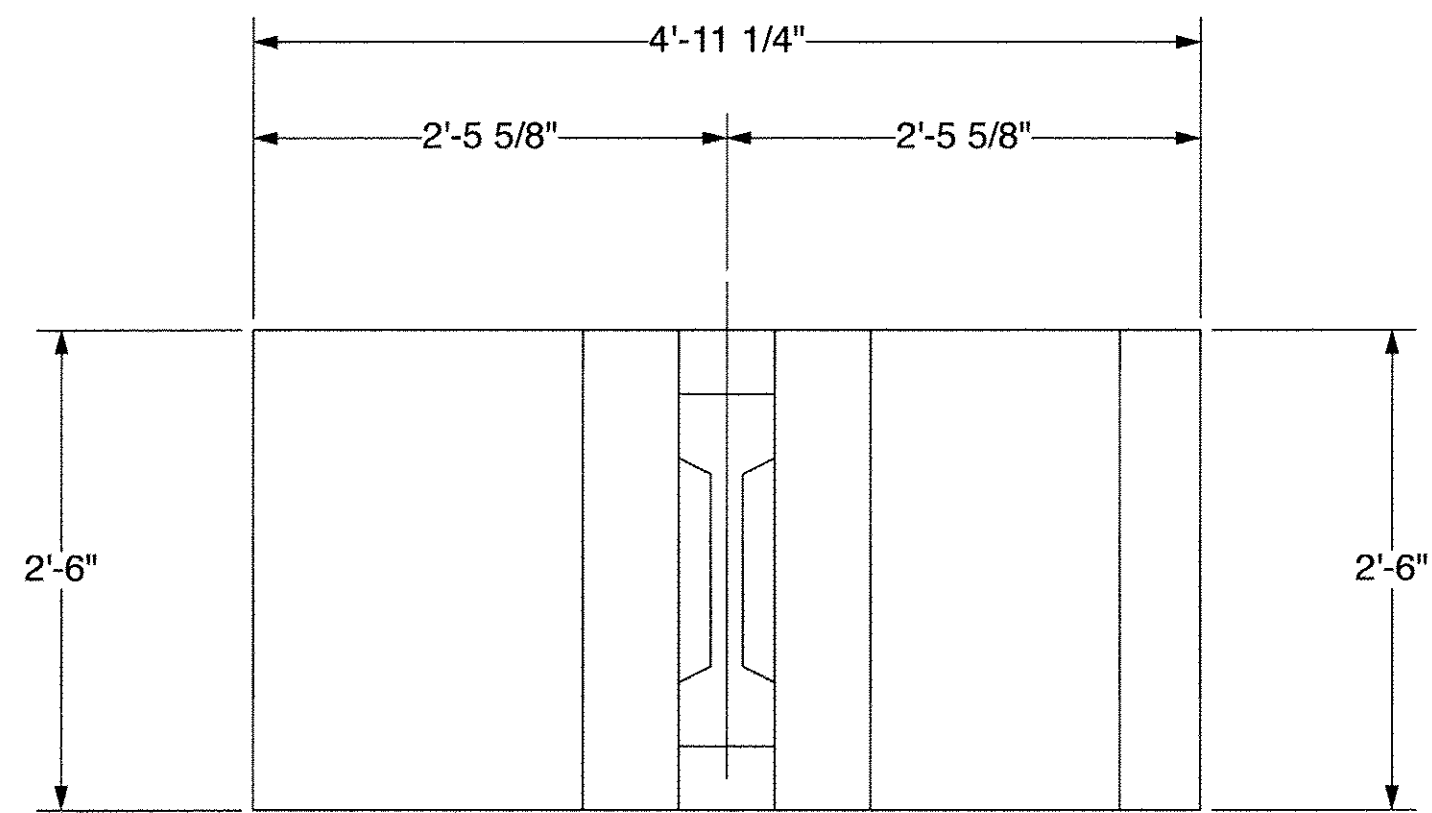

SP23 - FRONT VIEW

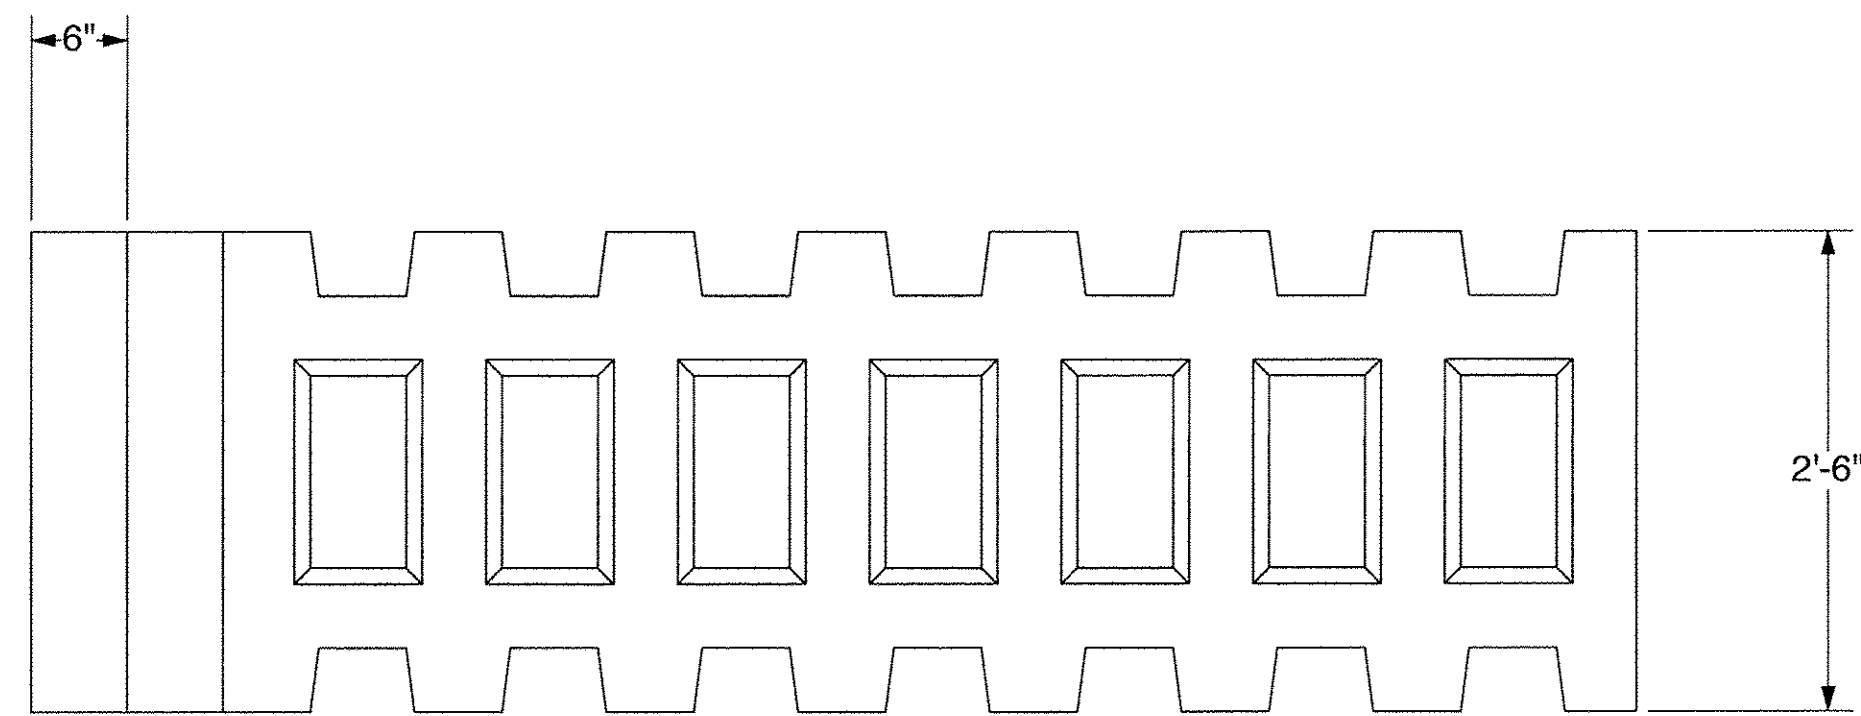

SP23 - SIDE VIEW

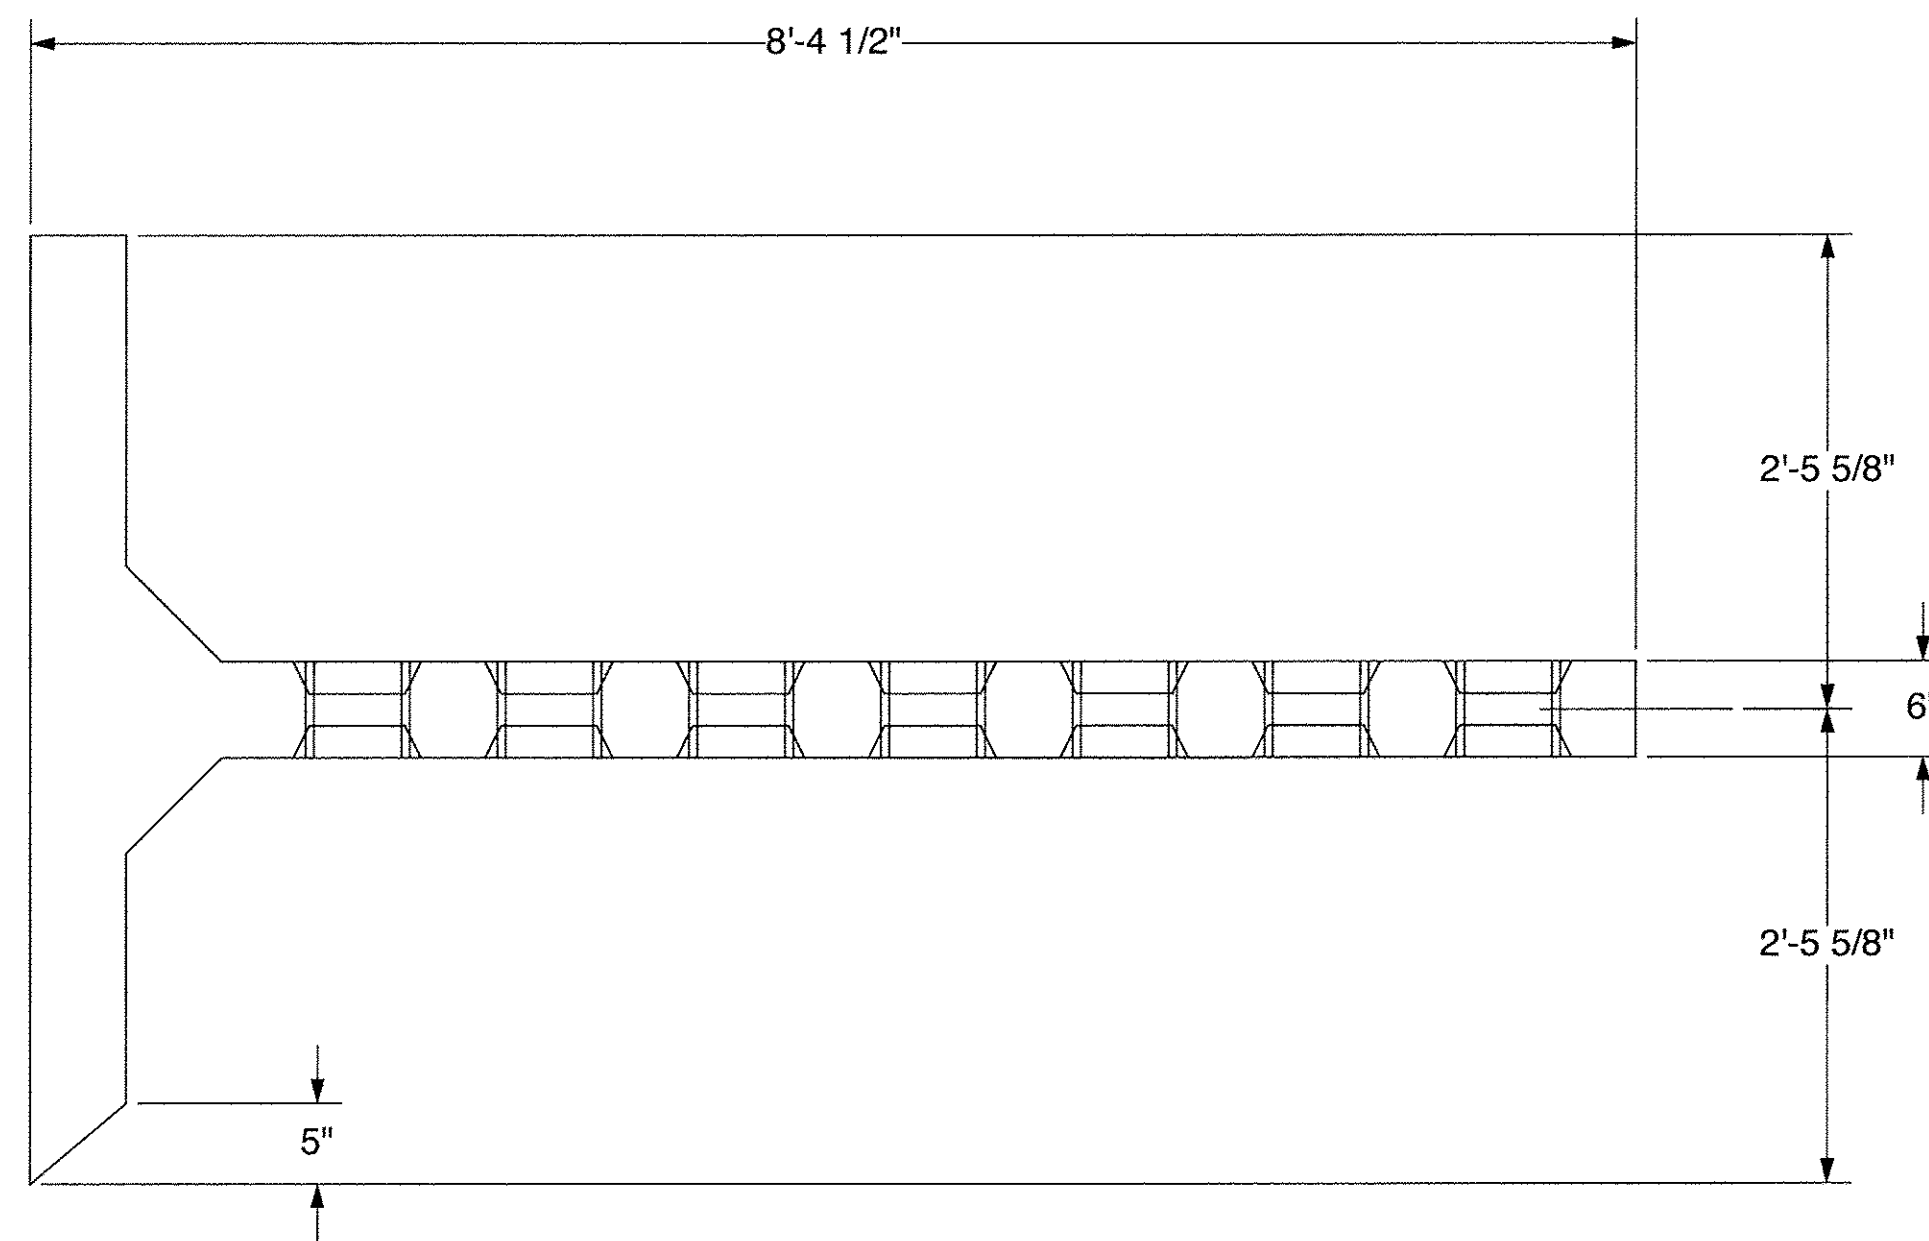


SP23 - PLAN VIEW

Approved
 Rejected

Approved As Noted


This review is only for general conformance with the design concept and the information given in the Construction Documents. Corrections or comments made on the shop drawings during the review do not relieve the Contractor from compliance with the requirements of the Plans and Specifications. Review of a specific item shall not include review of an assembly of which an item is a component. The Contractor is responsible for dimensions to be confirmed and corrected at the job site; information that pertains solely to the fabrication process or to the means, methods, techniques, sequences and procedures of construction; coordination of the Work with that of other trades and performing all Work in a safe and satisfactory manner.

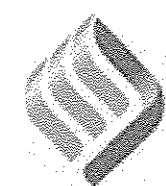

McFarland Johnson

Date 8/8/2014

By T. Traver

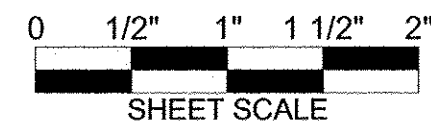

The design contained on these drawings is based upon information provided by the owner. On the basis of this information, The Neel Company has designed, and is responsible for, the internal stability of the structure only. External stability, including foundation and slope stability, is the responsibility of the owner.

This drawing contains information proprietary to The Neel Company. T-WALL® is a registered trademark owned by The Neel Company. ©2012 The Neel Company

PRECASTER: CONCRETE SYSTEMS, INC.
HUDSON, NH
PROJECT #: T21882

CONTRACTOR:
PROJECT #:

DESIGNER
THE NEEL COMPANY
8328-D TRAFORD LANE
SPRINGFIELD, VIRGINIA 22152
PH: (703) 913-7858
FX: (703) 913-7859
WEB: WWW.NEELCO.COM

PROJECT #: TW4301

CERTIFIED WITH RESPECT
TO INTERNAL STABILITY OF
T-WALL® STRUCTURES ONLY

REVISIONS

**FABRICATION DRAWING
8-6-14**


RIGIDIFIED TUBE FRP ARCH (RTFA) PROJECT

FAIRFIELD, VT


FABRICATION DRAWING
SPECIAL UNIT SP23

T-WALL® RETAINING WALL SYSTEM


SCALE:	1" = 1'-0"
DATE:	8-6-14
DESIGNED BY:	KD
DRAWN BY:	ABC
CHECKED BY:	KD
SHEET:	TW-FB23

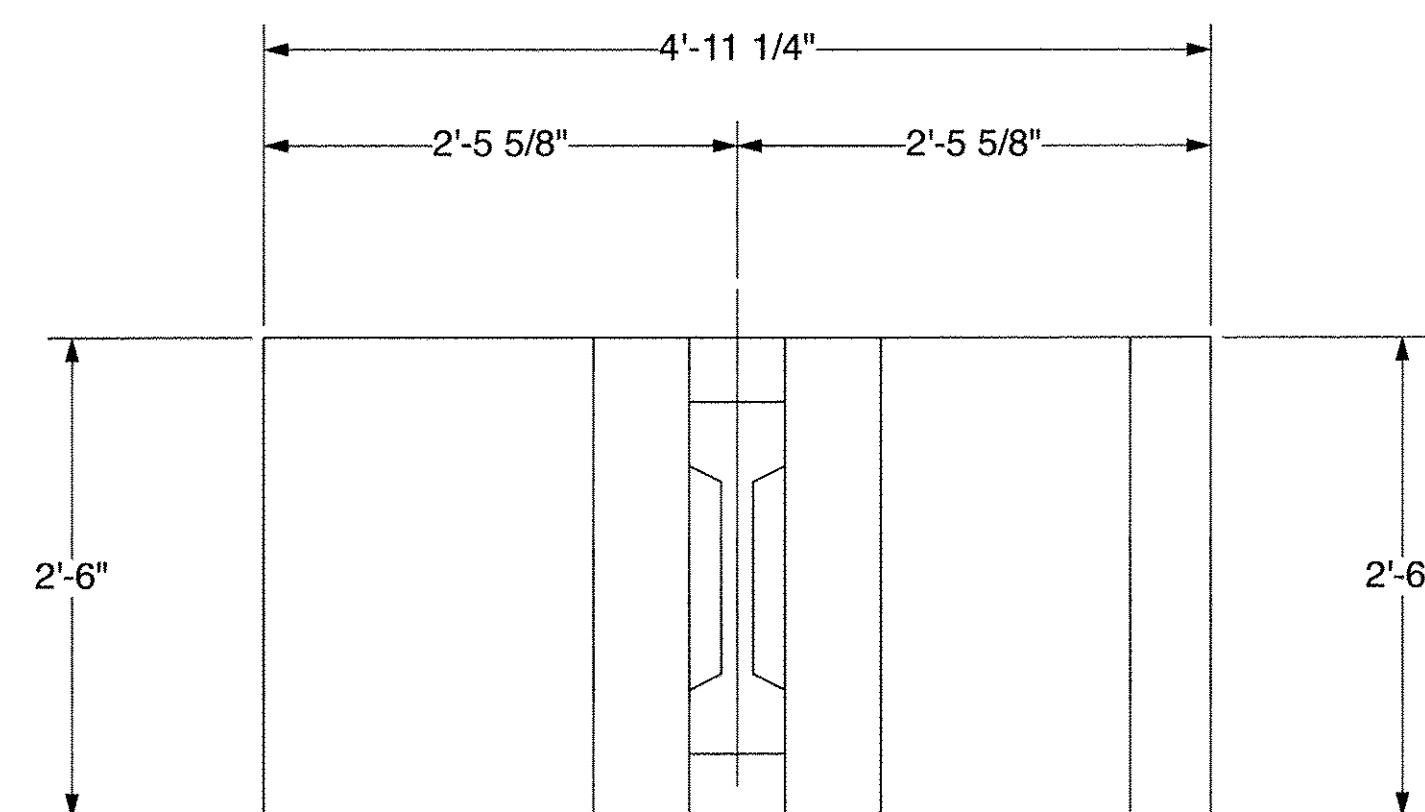

SP24 - FRONT VIEW

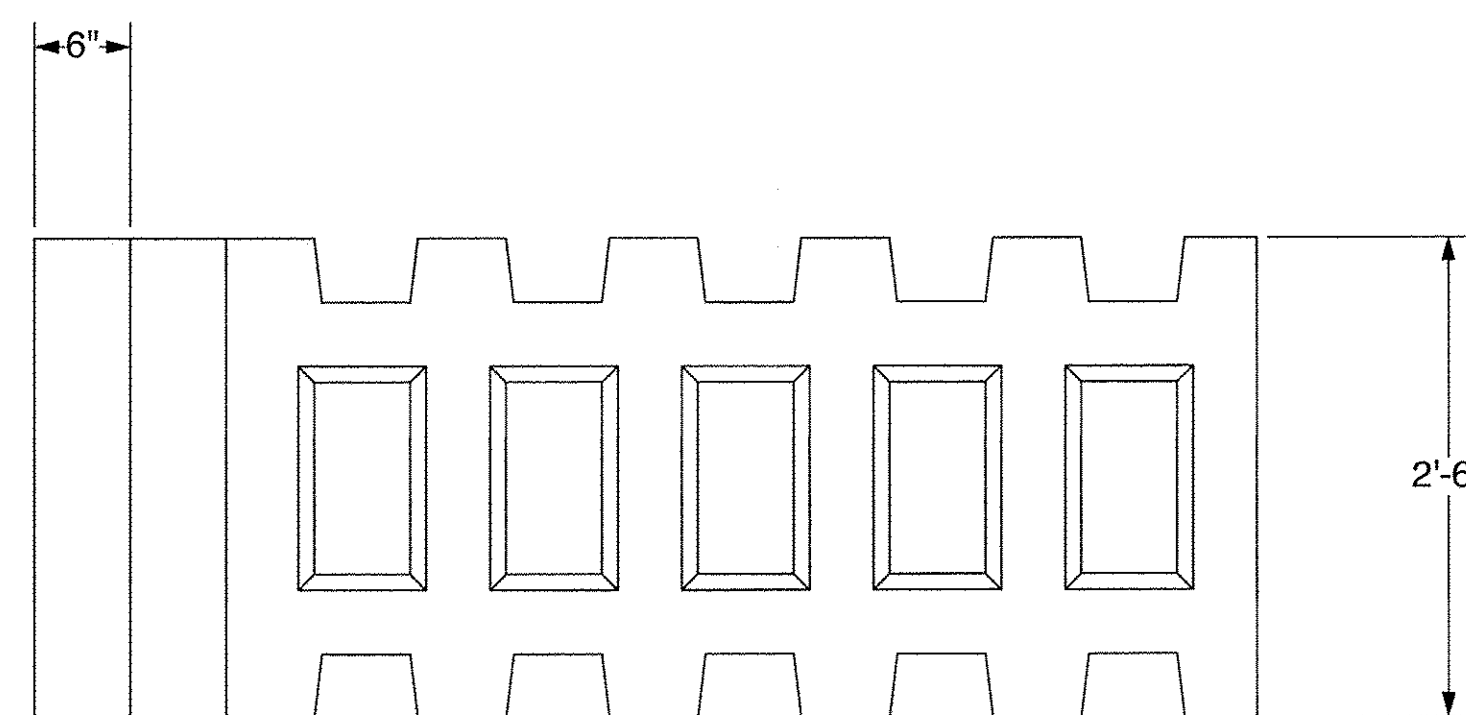

SP24 - SIDE VIEW

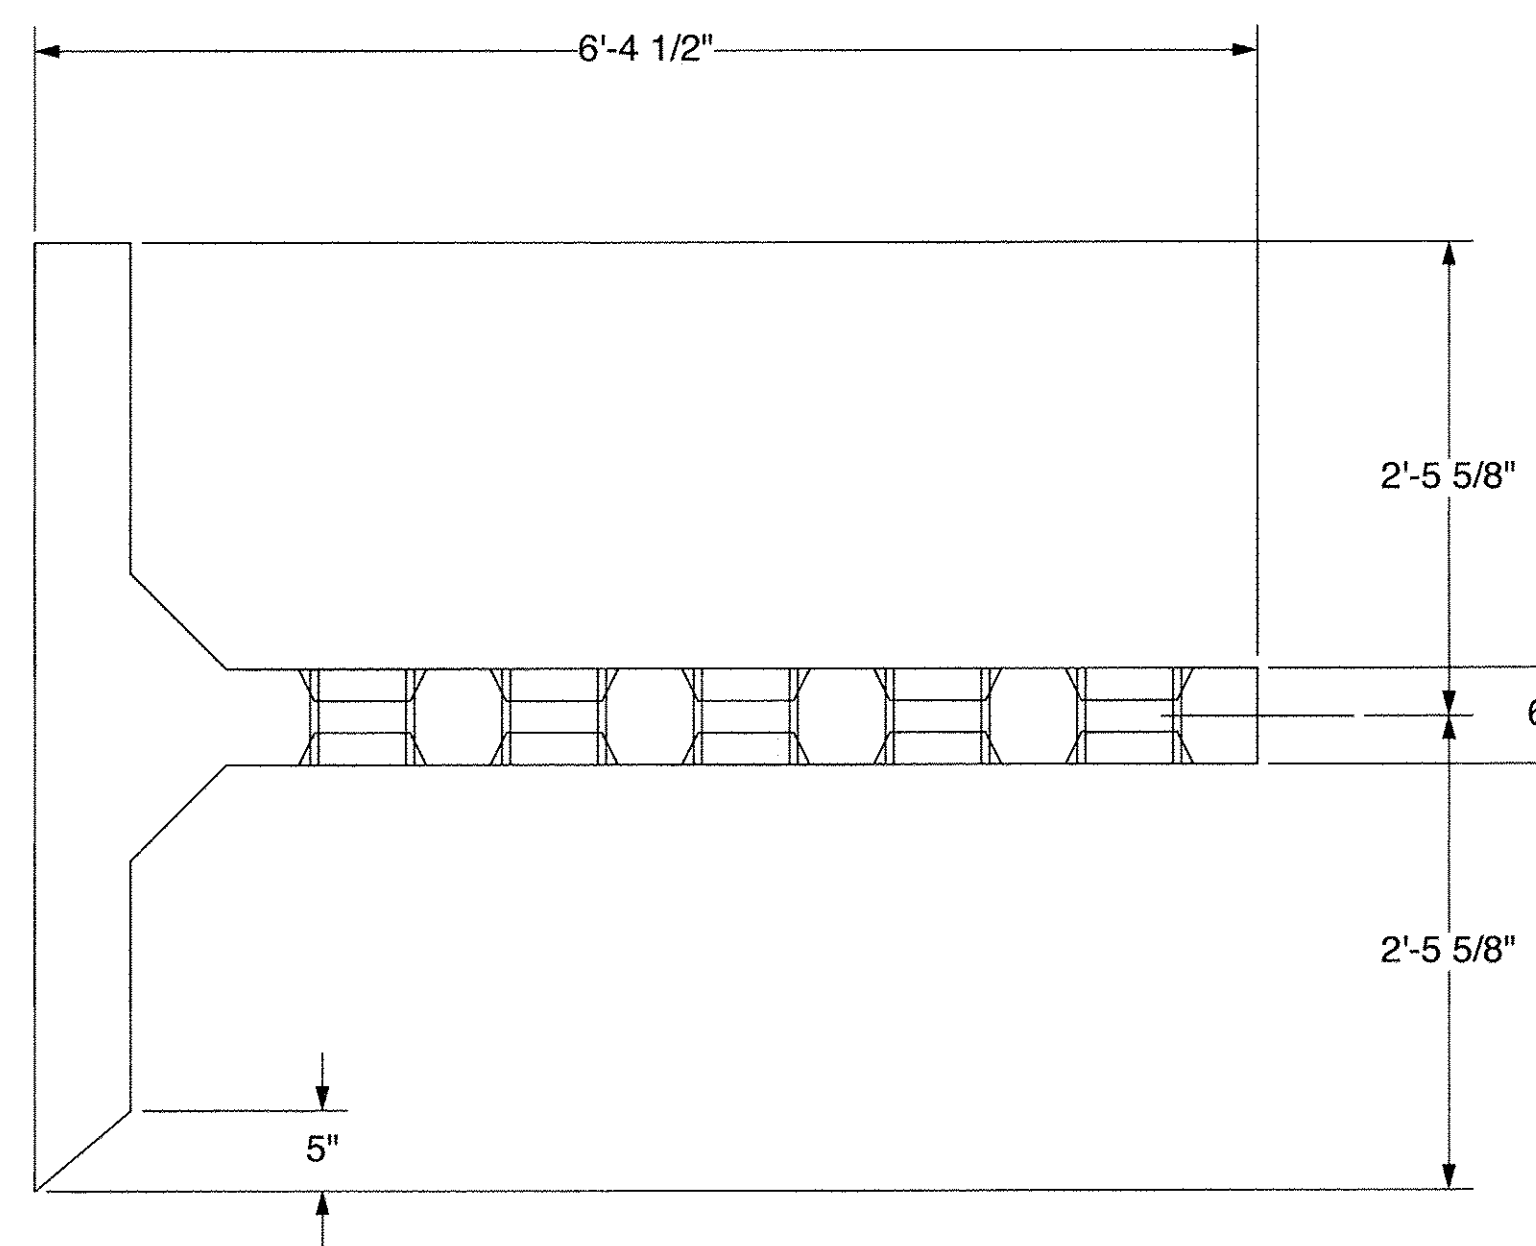


SP24 - PLAN VIEW

Approved Approved As Noted
 Rejected

This review is only for general conformance with the design concept and the information given in the Construction Documents. Corrections or comments made on the shop drawings during the review do not relieve the Contractor from compliance with the requirements of the Plans and Specifications. Review of a specific item shall not include review of an assembly of which an item is a component. The Contractor is responsible for dimensions to be confirmed and corrected at the job site; information that pertains solely to the fabrication process or to the means, methods, techniques, sequences and procedures of construction; coordination of the Work with that of other trades and performing all Work in a safe and satisfactory manner.

Date 8/8/2014
 By T. Traver

 **McFarland Johnson**




The design contained on these drawings is based upon information provided by the owner. On the basis of this information, The Neel Company has designed, and is responsible for, the internal stability of the structure only. External stability, including foundation and slope stability, is the responsibility of the owner.

This drawing contains information proprietary to The Neel Company. T-WALL® is a registered trademark owned by The Neel Company. ©2012 The Neel Company

PRECASTER: CONCRETE SYSTEMS, INC. HUDSON, NH PROJECT #: T21882
CONTRACTOR: PROJECT #:

DESIGNER

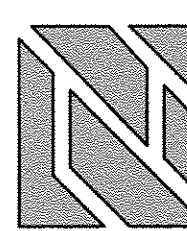
THE NEEL COMPANY
 8328-D TRAFORD LANE
 SPRINGFIELD, VIRGINIA 22152
 PH: (703) 913-7858
 FX: (703) 913-7859
 WEB: WWW.NEELCO.COM

PROJECT #: TW4301

CERTIFIED WITH RESPECT TO INTERNAL STABILITY OF T-WALL® STRUCTURES ONLY

REVISIONS	

FABRICATION DRAWING

8-6-14

RIGIDIFIED TUBE FRP ARCH (RTFA) PROJECT

FAIRFIELD, VT

FABRICATION DRAWING
SPECIAL UNIT SP24

T-WALL® RETAINING WALL SYSTEM

SCALE:	1" = 1'-0"
DATE:	8-6-14
DESIGNED BY:	KD
DRAWN BY:	ABC
CHECKED BY:	KD
SHEET:	TW-FB24