
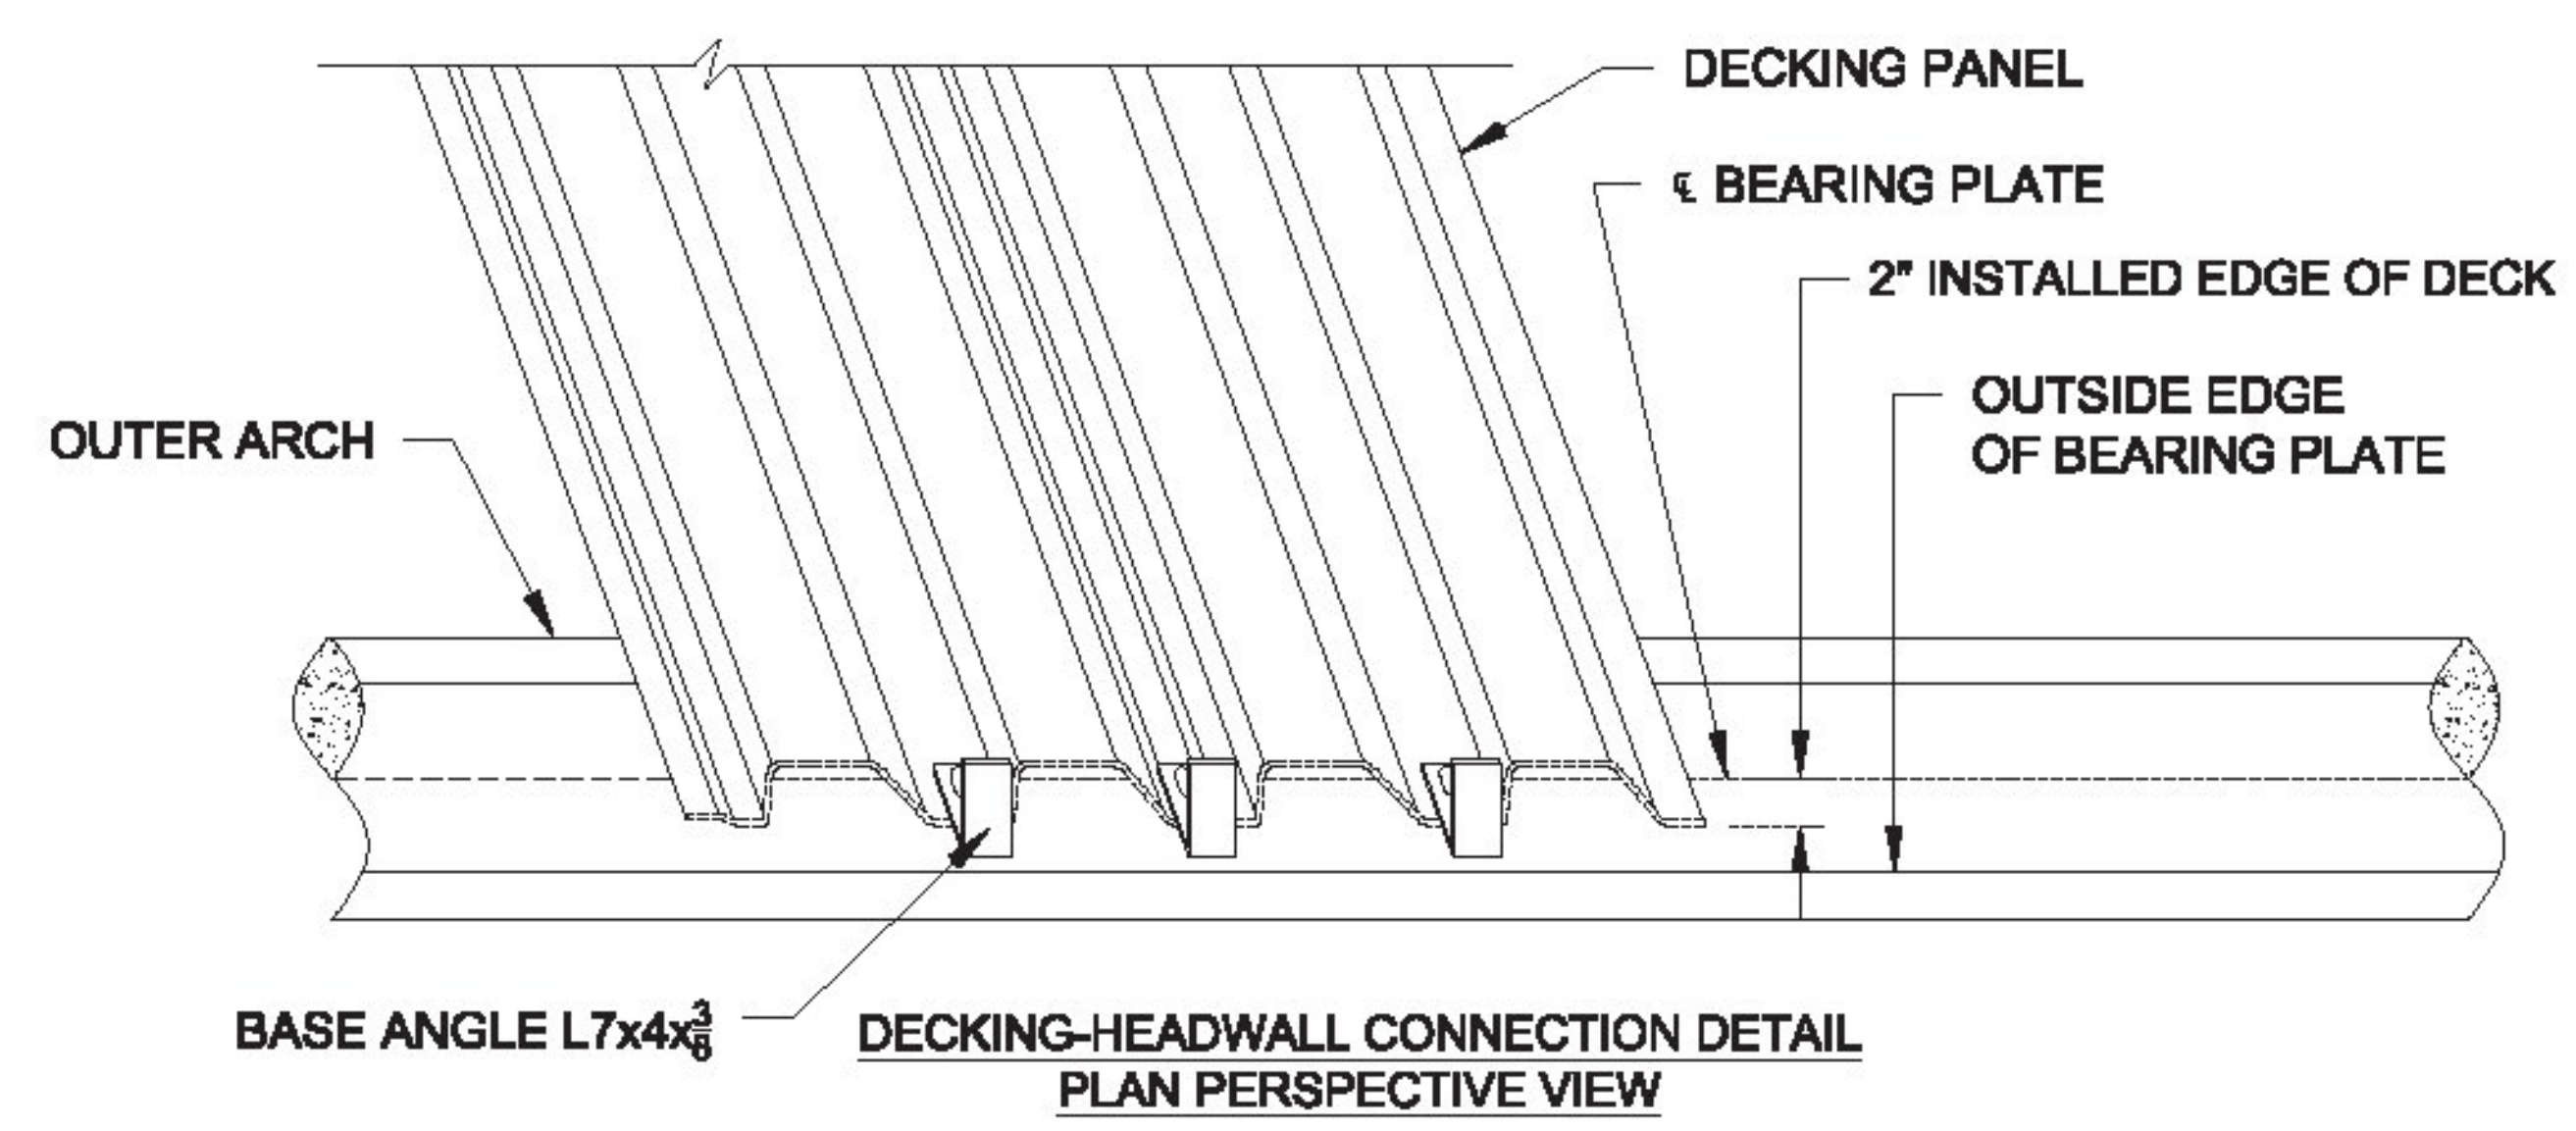


Approved  
 Rejected  
 Approved As Noted

This review is only for general conformance with the design concept and the information given in the Construction Documents. Corrections or comments made on the shop drawings during the review do not relieve the Contractor from compliance with the requirements of the Plans and Specifications. Review of a specific item shall not include review of an assembly of which an item is a component. The Contractor is responsible for dimensions to be confirmed and corrected at the job site; information that pertains solely to the fabrication process or to the means, methods, techniques, sequences and procedures of construction; coordination of the Work with that of other trades and performing all Work in a safe and satisfactory manner.

Date 6/6/2014  
 By T. Traver

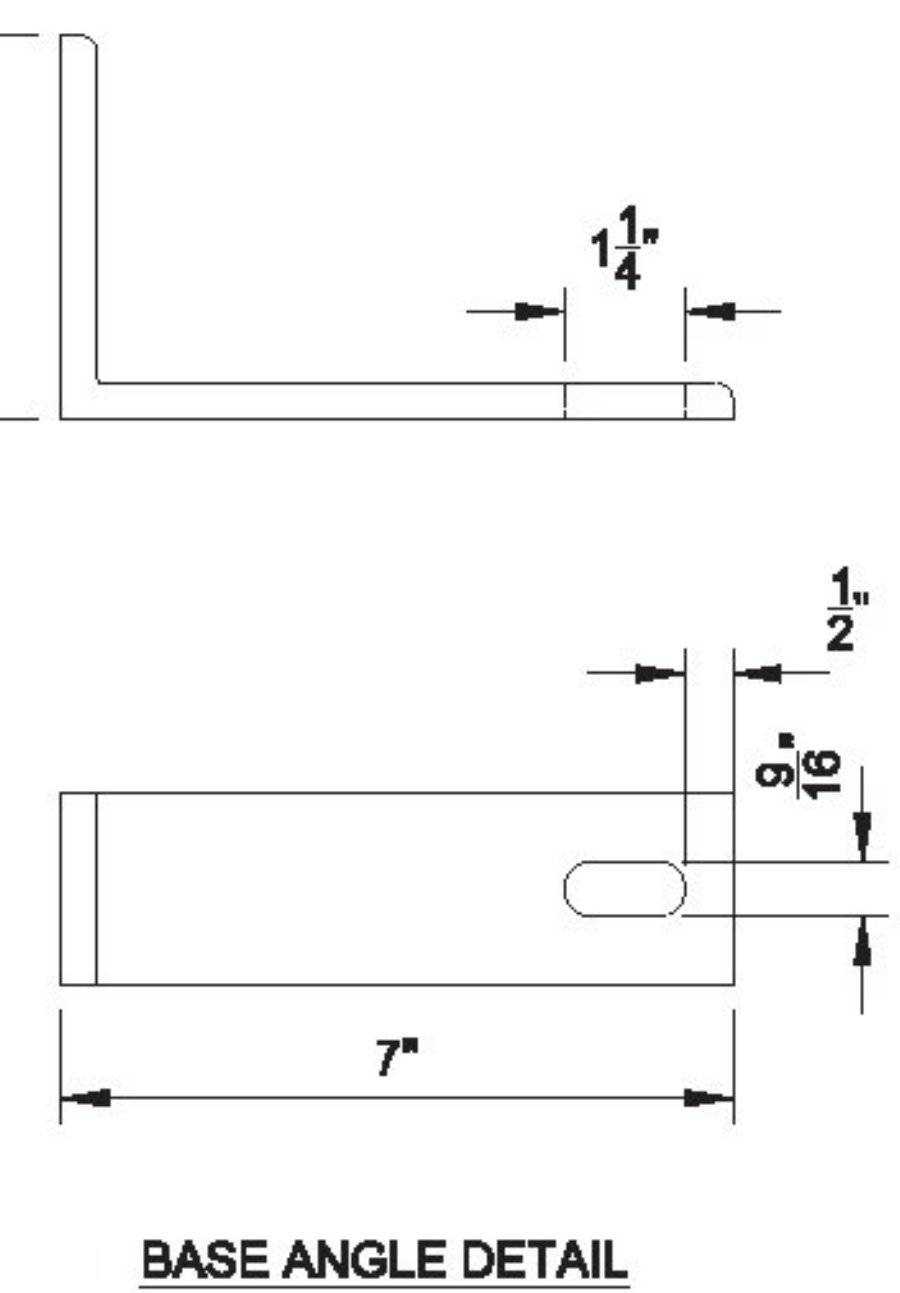

**ADVANCED INFRASTRUCTURE TECHNOLOGIES**

20 Godfrey Drive  
 Orono, Maine 04473  
 Tel 207.866.6526  
 Fax 207.866.6501  
 www.aitbridges.com

PROJECT: Wanzer Road Bridge No. 48	TITLE: HEADWALL DETAILS		SHEET NUMBER:
LOCATION: Fairfield, VT	JN: 12018	INITIALS	DATE
DRAWING STATUS: Approved for Construction	DRAWN BY: JEK	4-9-2014	<b>9</b> OF 10 REV: 05-20-2014
Correct scale on size B paper (11x17 Ledger)	DESIGNED BY: JEK	4-9-2014	
	CHECKED BY: ZU	5-20-2014	