



4 LEVELING PAD DETAIL
Scale: 2" = 1'-0"

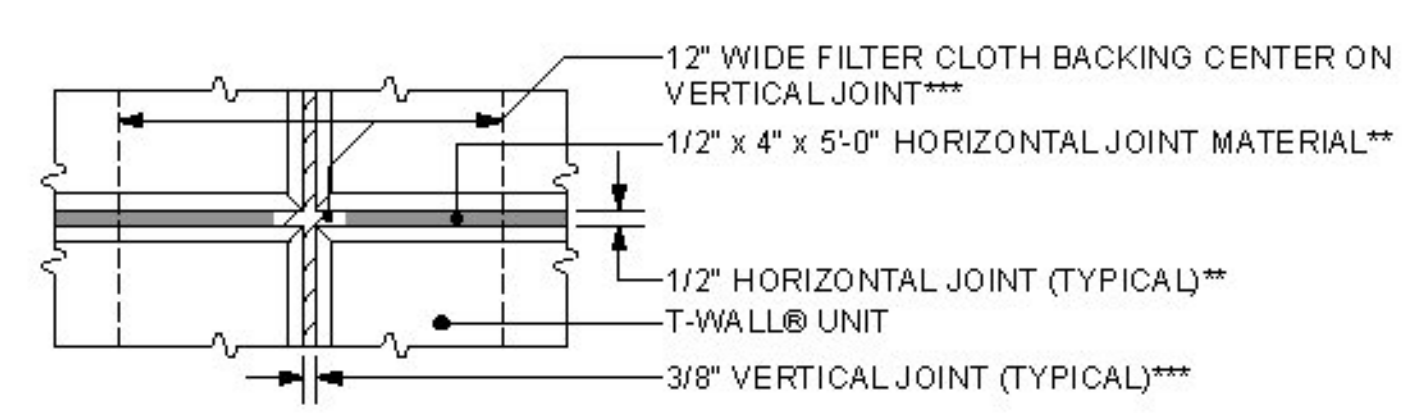

3 HORIZONTAL AND VERTICAL JOINT DETAIL
Scale: 2" = 1'-0"
** SEE GENERAL NOTE 4 ON SHEET 3 FOR ADDITIONAL DETAILS
*** SEE GENERAL NOTE 5 ON SHEET 3 FOR ADDITIONAL DETAILS

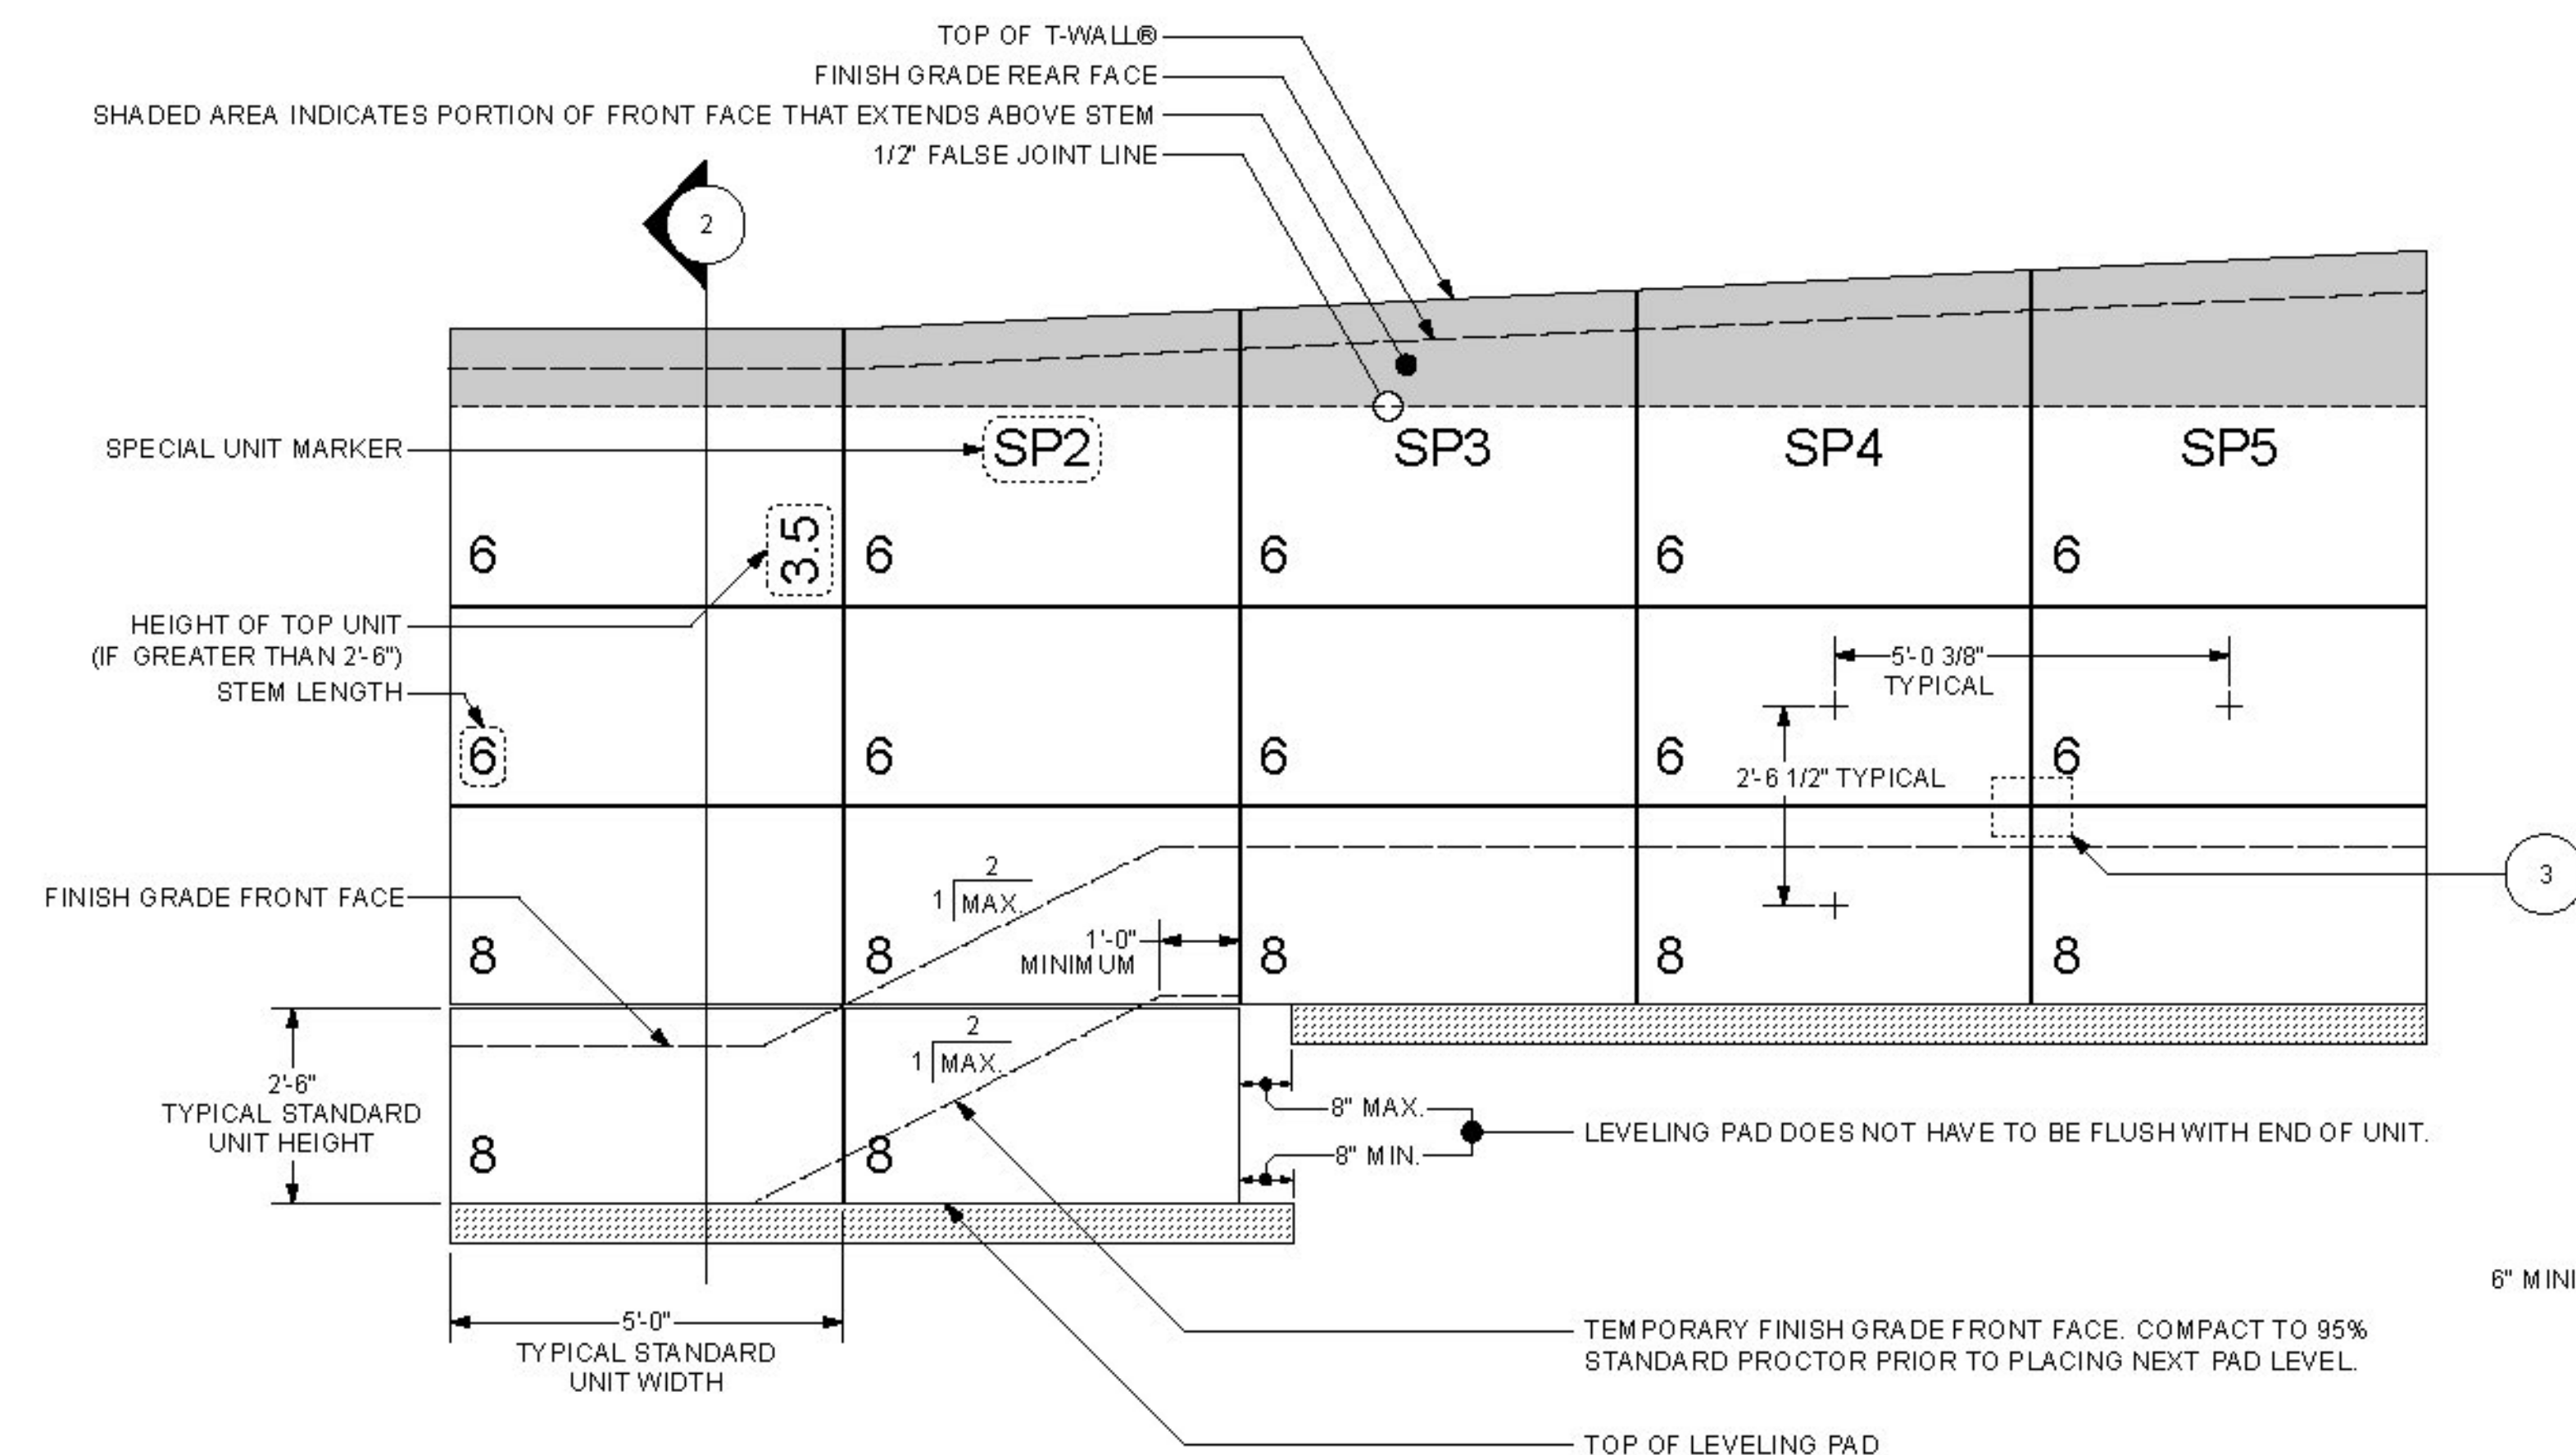

1 PARTIAL ELEVATION SHOWN - TYPICAL DETAILS
Scale: 1/2" = 1'-0"
NOT ALL DETAILS APPLY. SEE SPECIFIC WALL ELEVATIONS

NOMENCLATURE NOTE:

THIS SHEET IS PROVIDED FOR GENERAL INFORMATION PURPOSES ONLY, REFERENCING STANDARD DETAILS APPLICABLE TO ANY T-WALL STRUCTURE. THIS SHEET IS NOT INTENDED TO PROVIDE DETAILS SPECIFIC TO THE WALL STRUCTURES CONTAINED IN THIS DRAWING PACKAGE. FOR INFORMATION SPECIFIC TO THESE WALLS, SEE THE APPLICABLE DRAWING SHEETS.


SHEAR KEY NOTES:

1. WALL IS DESIGNED FOR SPECIFIC NUMBER OF SHEAR KEYS AS SHOWN IN "TYPICAL SECTION AT MAXIMUM HEIGHT" ON SHEET 4. LOCATION OF SHEAR KEYS CAN BE ADJUSTED IF NECESSARY AT A SPECIFIC LEVEL.


Approved **Approved As Noted**
 Rejected

This review is only for general conformance with the design concept and the information given in the Construction Documents. Corrections or comments made on the shop drawings during the review do not relieve the Contractor from compliance with the requirements of the Plans and Specifications. Review of a specific item shall not include review of an assembly of which an item is a component. The Contractor is responsible for dimensions to be confirmed and corrected at the job site; information that pertains solely to the fabrication process or to the means, methods, techniques, sequences and procedures of construction; coordination of the Work with that of other trades and performing all Work in a safe and satisfactory manner.

Date: 8/8/2014
By: T. Traver

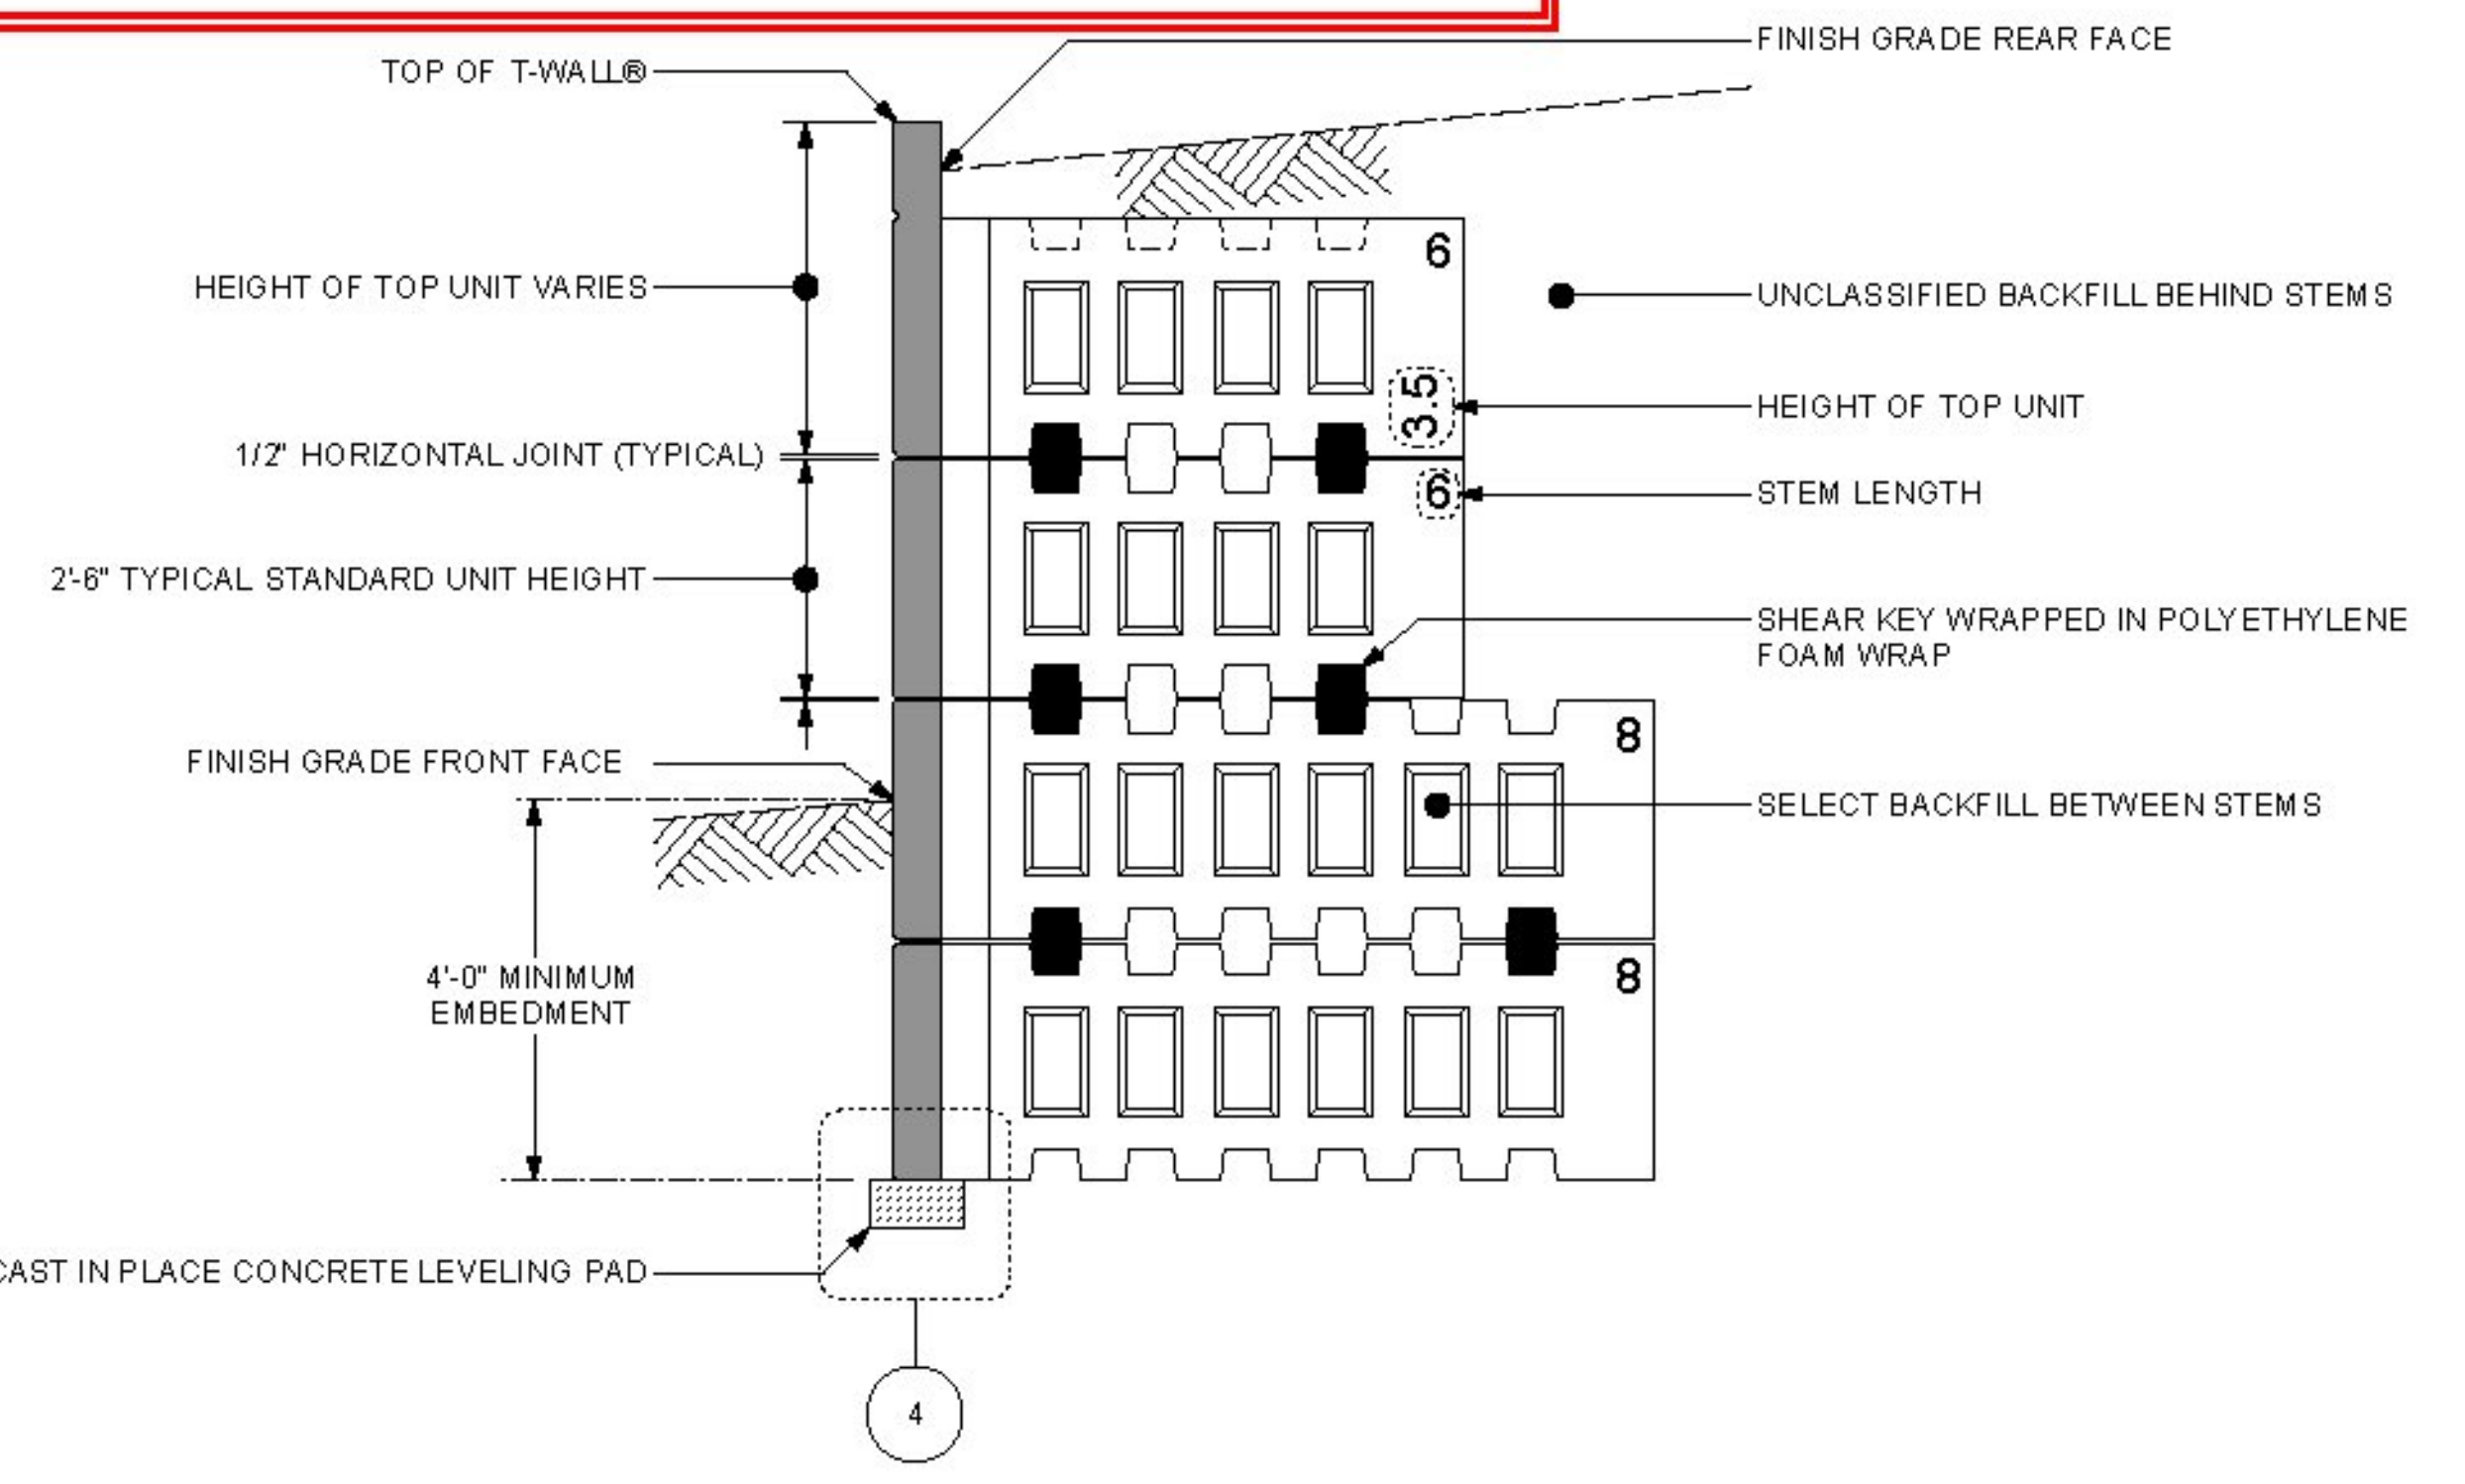

2 PARTIAL ELEVATION SHOWN - TYPICAL DETAILS
Scale: 1/2" = 1'-0"
NOT ALL DETAILS APPLY. SEE SPECIFIC WALL ELEVATIONS

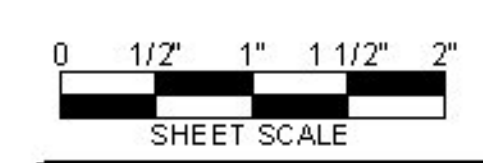

The design contained on these drawings is based upon information provided by the owner. On the basis of this information, The Neel Company has designed, and is responsible for, the internal stability of the structure only. External stability, including foundation and slope stability, is the responsibility of the owner.


This drawing contains information proprietary to The Neel Company. T-WALL is a registered trademark owned by The Neel Company. ©2014 The Neel Company

PRECASTER: CONCRETE SYSTEMS, INC. CSI
PROJECT #: T21882

CONTRACTOR: AL. ST. ONGE CONTRACTORS
PROJECT #:

DESIGNER
THE NEEL COMPANY
8328-D TRAFORD LANE
SPRINGFIELD, VIRGINIA 22152
PH: (703) 913-7888
FX: (703) 913-7889
WEB: WWW.NEELCO.COM

PROJECT #: TW4301

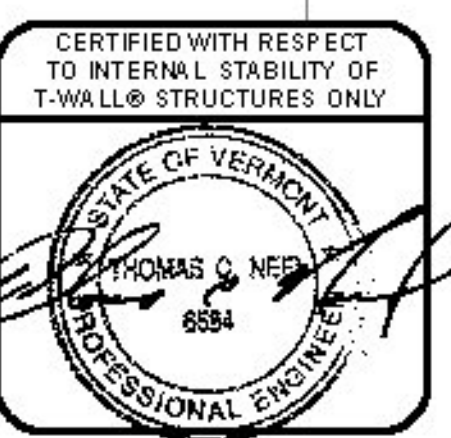

REVISIONS	

RIGIDIFIED TUBE FRP ARCH (RTFA) PROJECT

FAIRFIELD, VT

SHOP DRAWINGS
TYPICAL T-WALL NOMENCLATURE
T-WALL RETAINING WALL SYSTEM

SCALE:	AS NOTED
DATE:	4/21/14
DESIGNED BY:	KD
DRAWN BY:	ABC
CHECKED BY:	CCG
SHEET:	2