




101+25

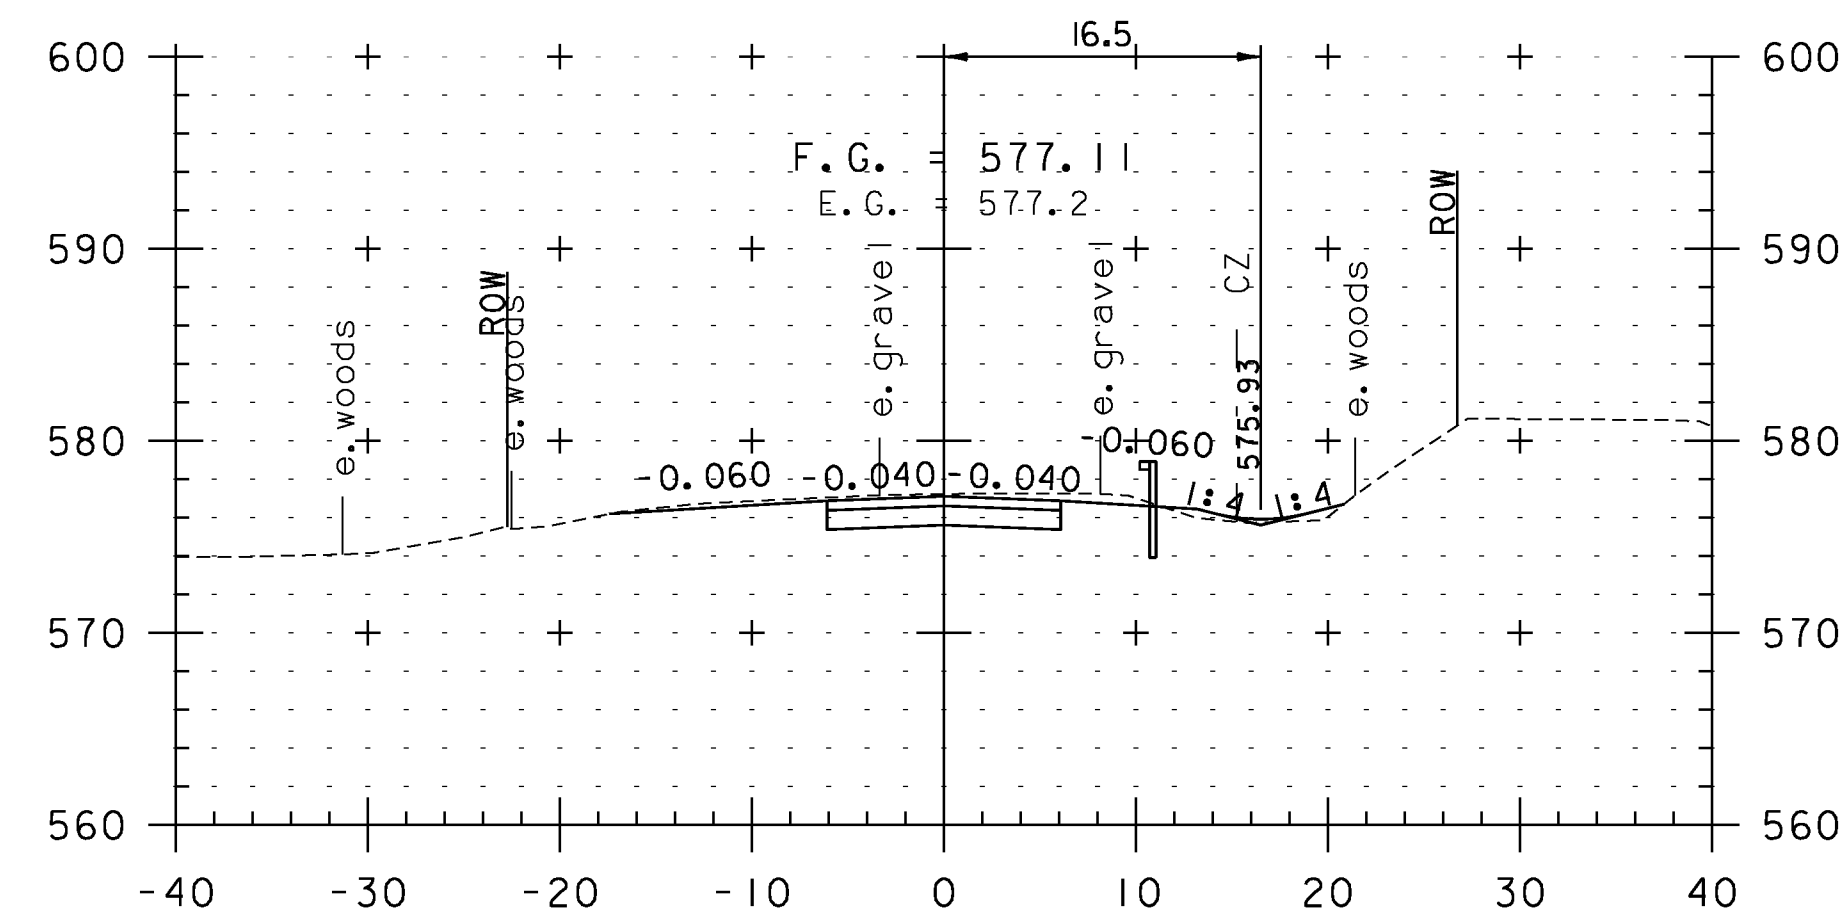


101+00

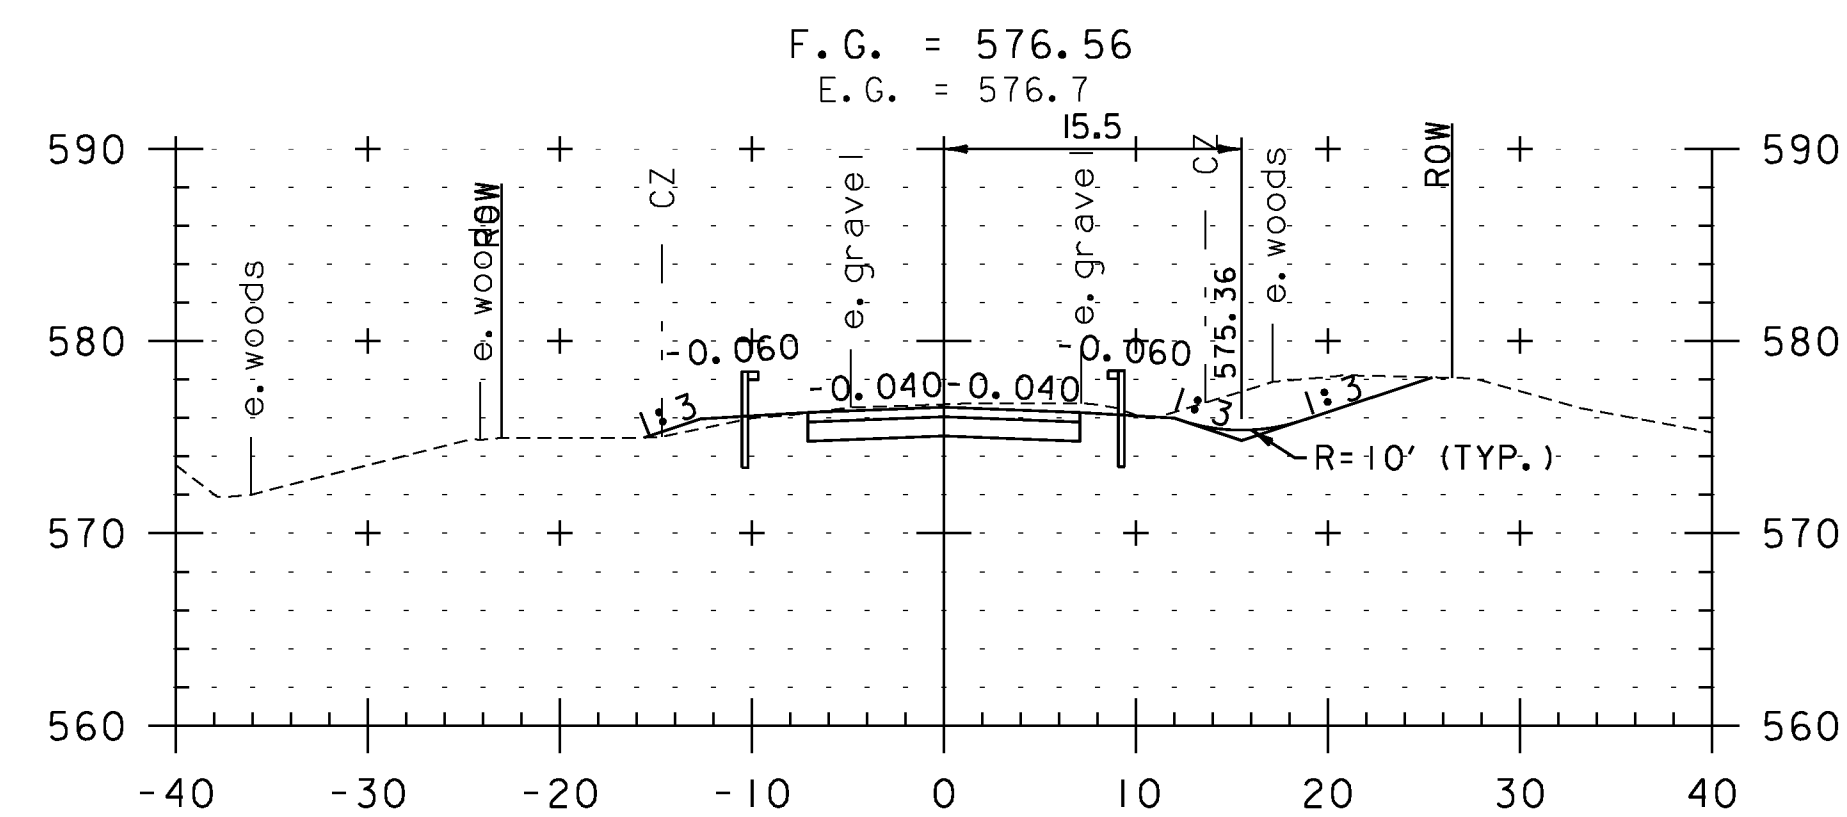


100+75

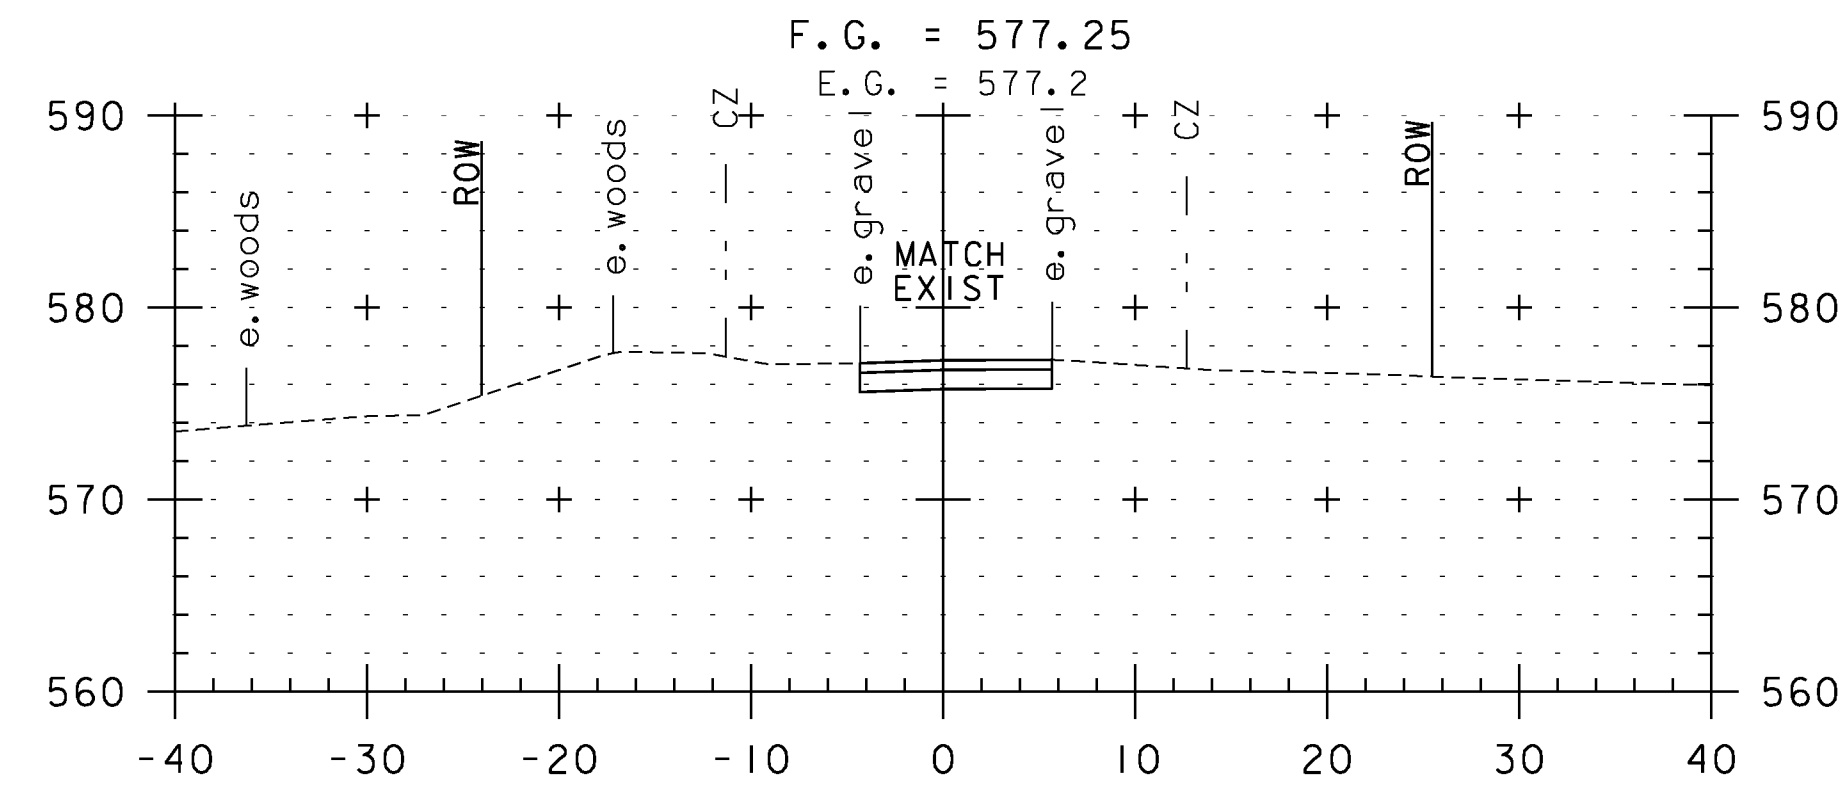

102+00  
END PROJECT

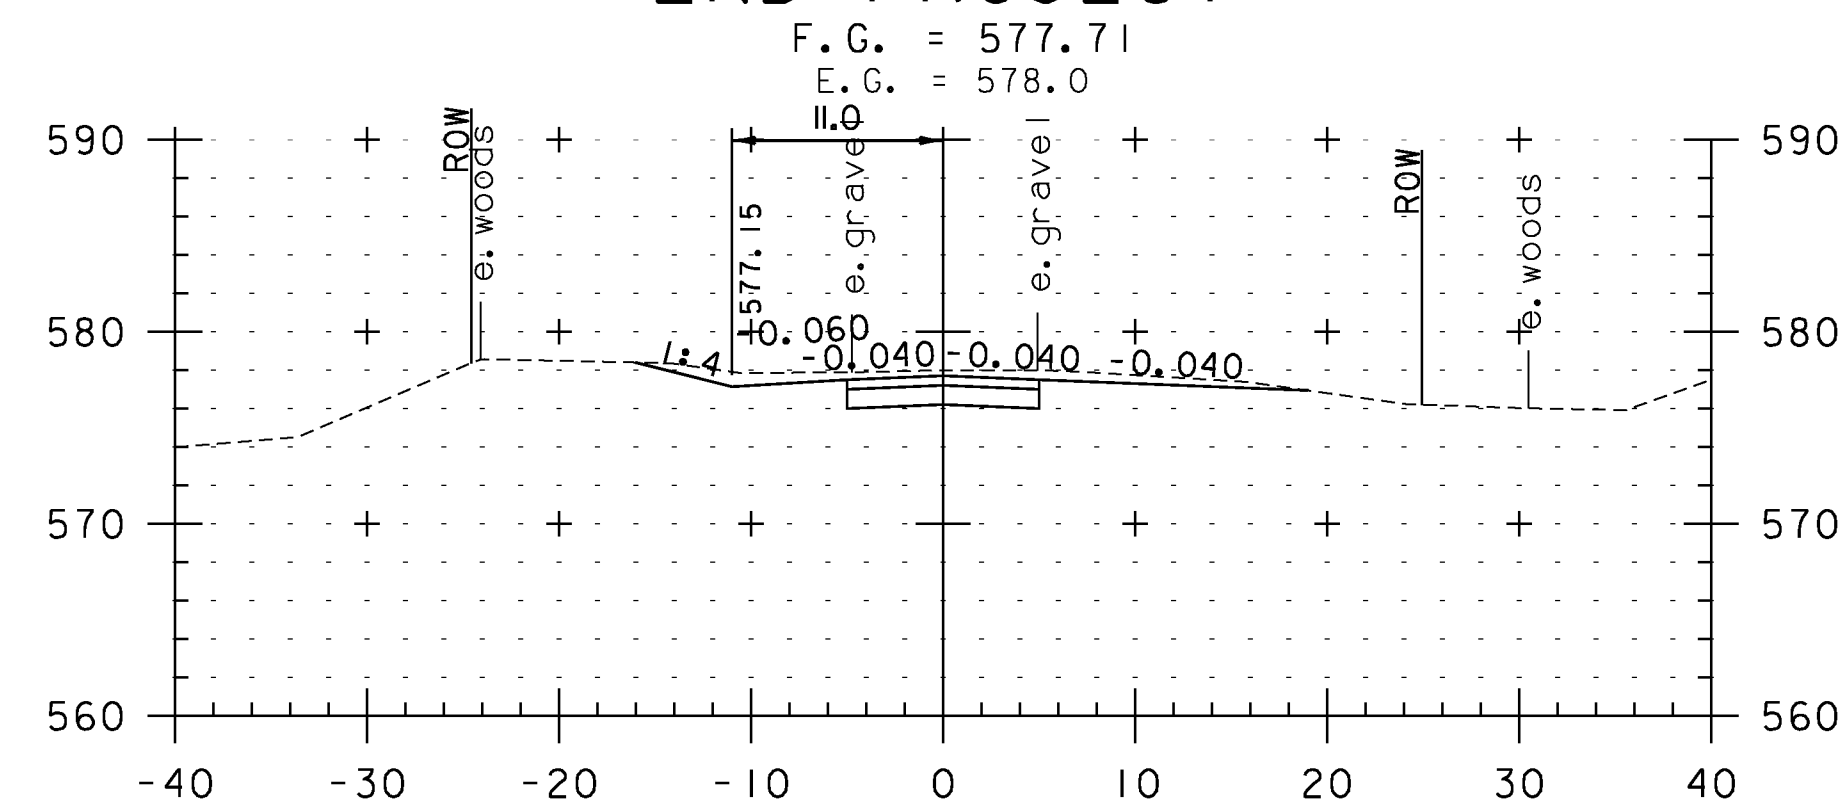

101+75

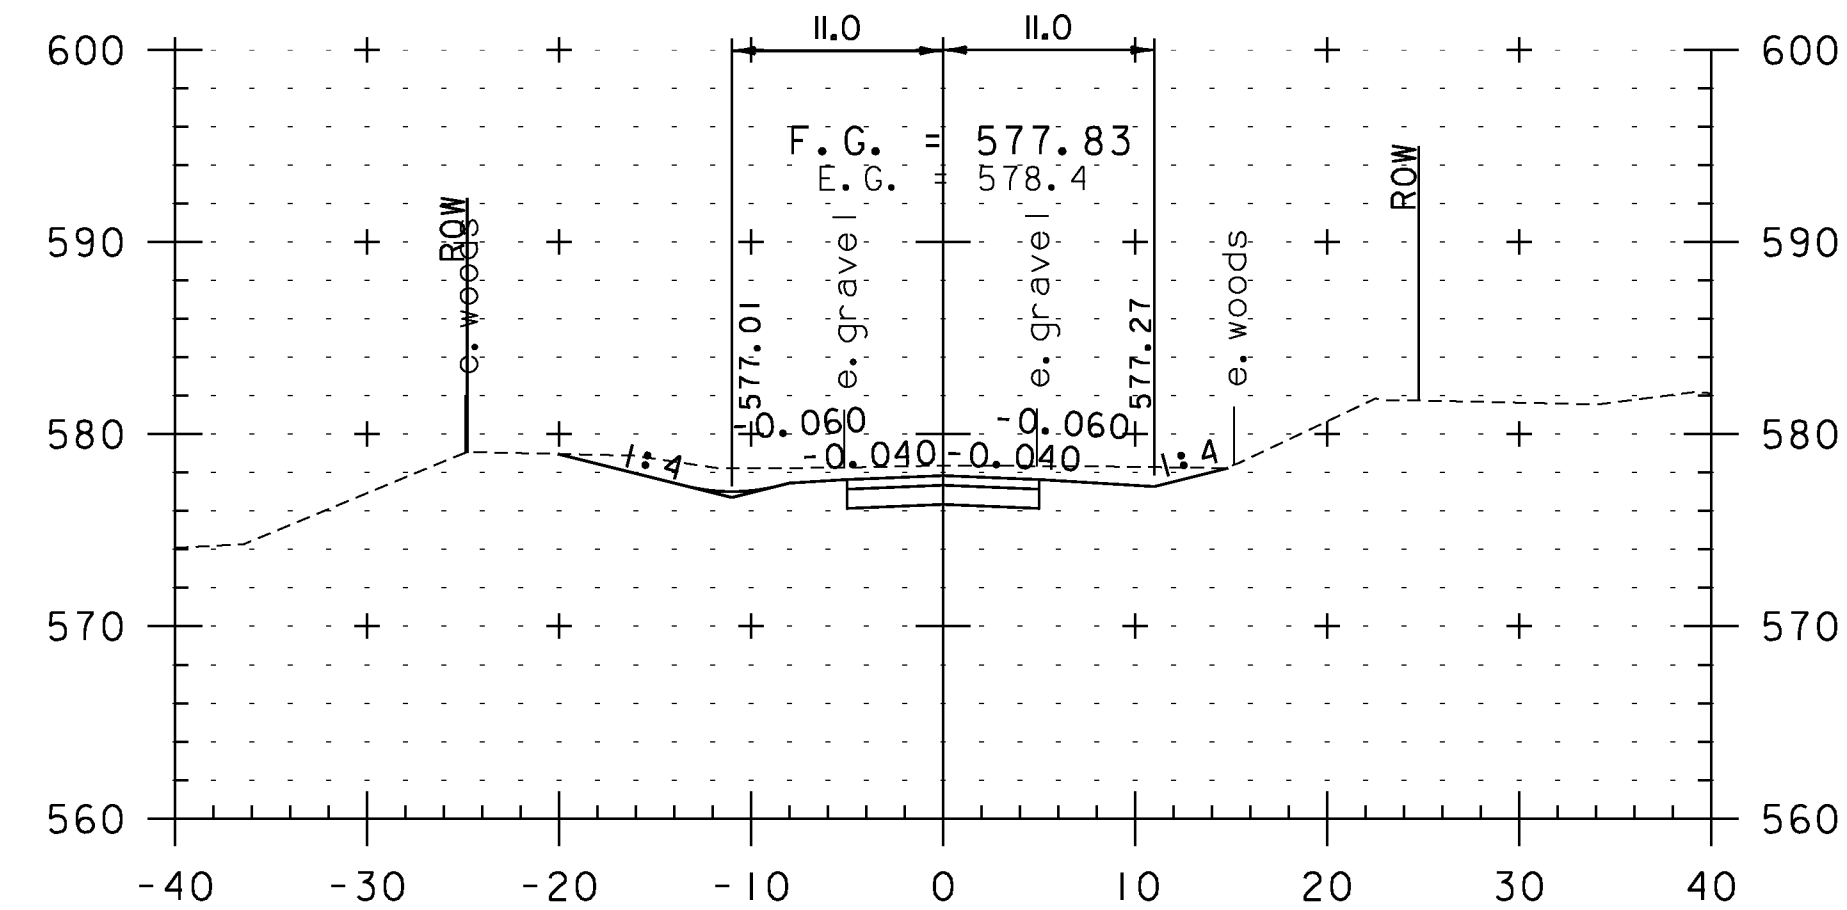

101+50

STA. 100+75 TO STA. 102+00

CLD 12-0175 MODEL: XS02



PROJECT NAME: RANDOLPH  
PROJECT NUMBER: BRO 1444(57)

FILE NAME: z11j078xsl.dgn  
PROJECT LEADER: J. BYATT  
DESIGNED BY: J. SMITH  
ROADWAY CROSS SECTIONS 2

PLOT DATE: 8/12/2014  
DRAWN BY: J. SMITH  
CHECKED BY: D. MUNRO  
SHEET 30 OF 39