

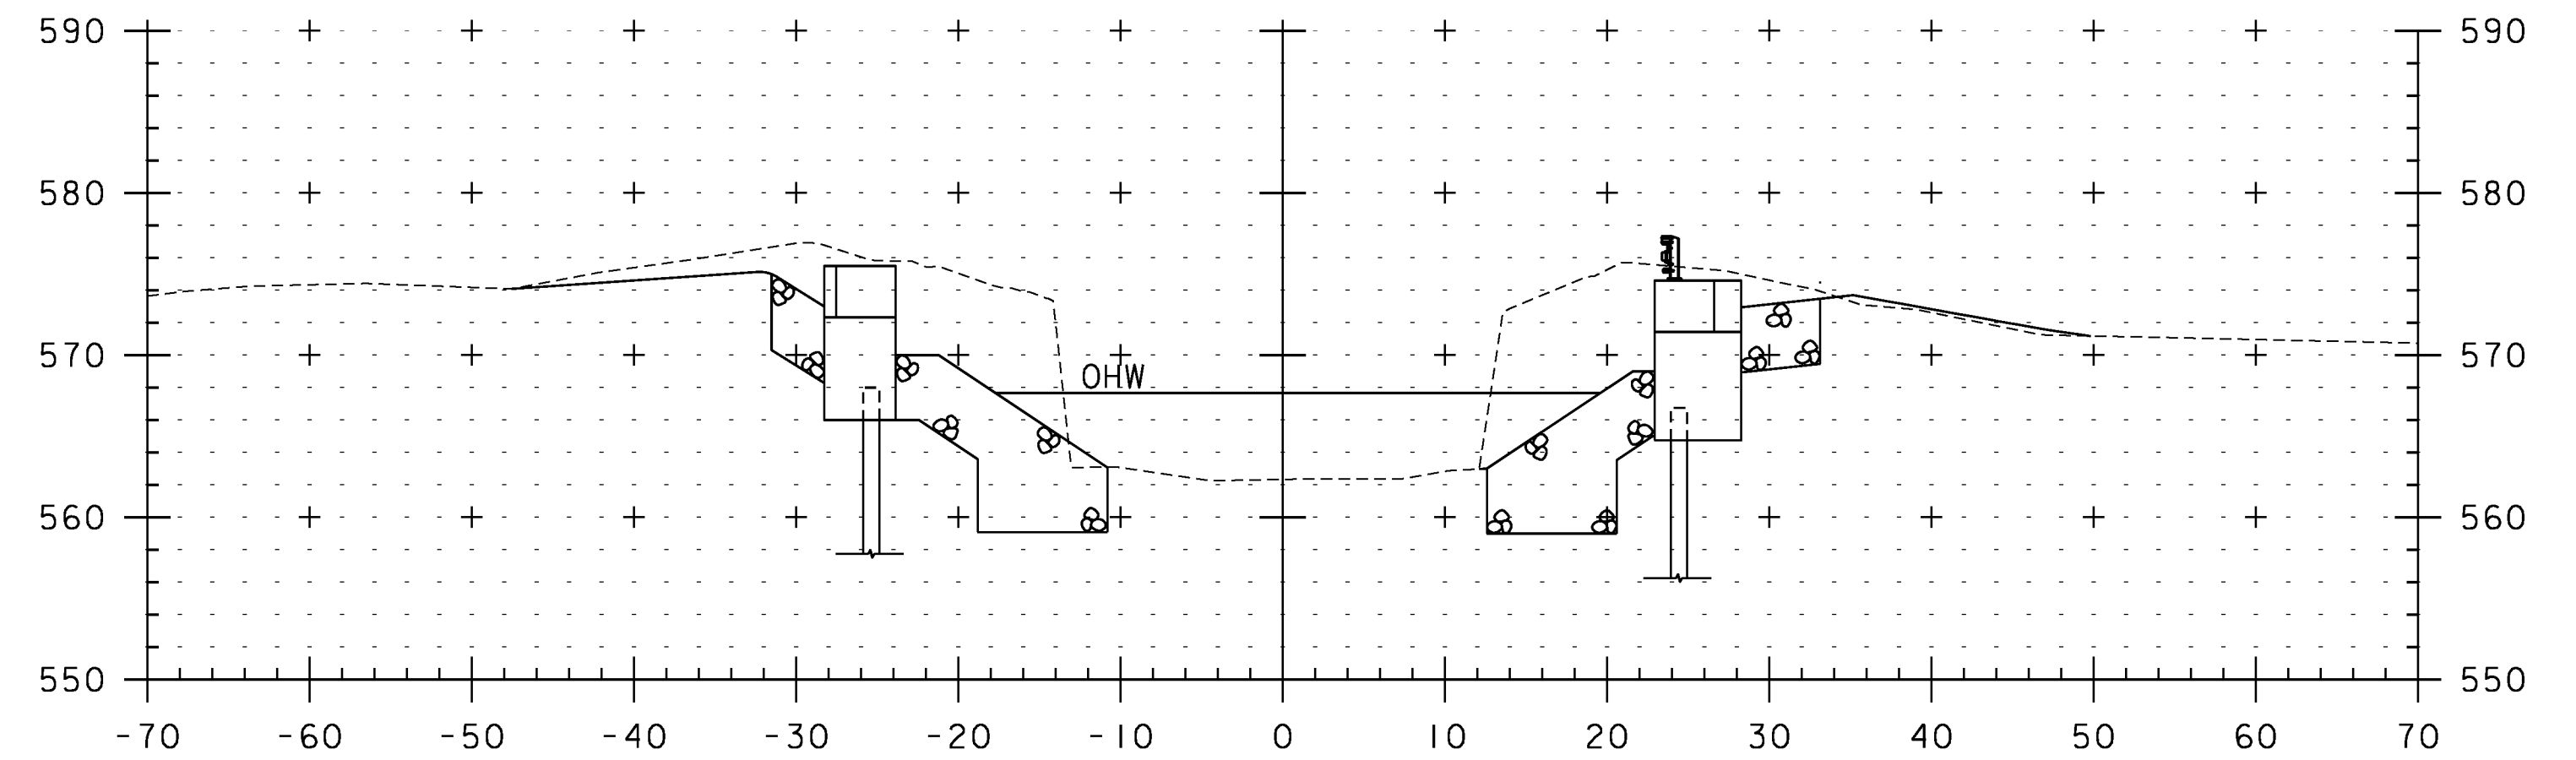


STA. 0+17 RT
 BEGIN UNCLASSIFIED CHANNEL EXCAVATION
 STONE FILL, TYPE IV
 GEOTEXTILE UNDER STONE FILL, TYPE IV
 GRUBBING MATERIAL


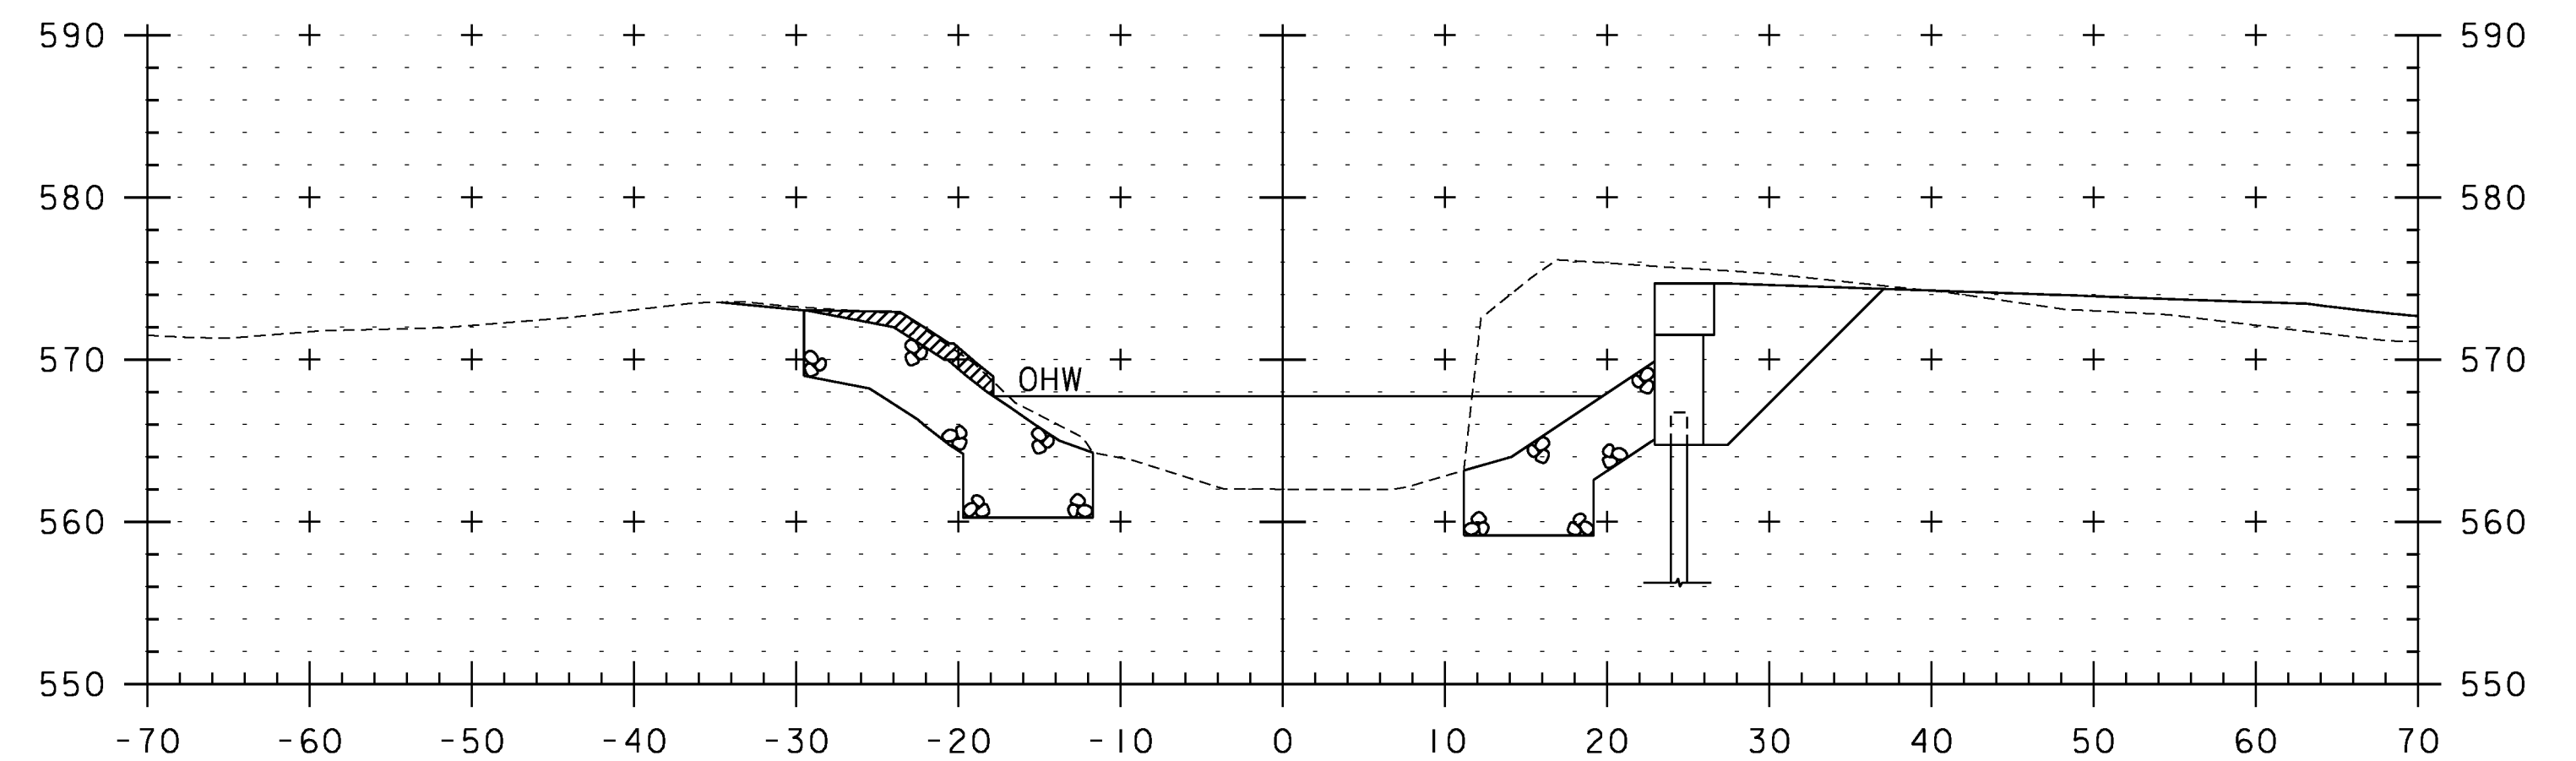


STA. 0+49 LT
 END GRUBBING MATERIAL

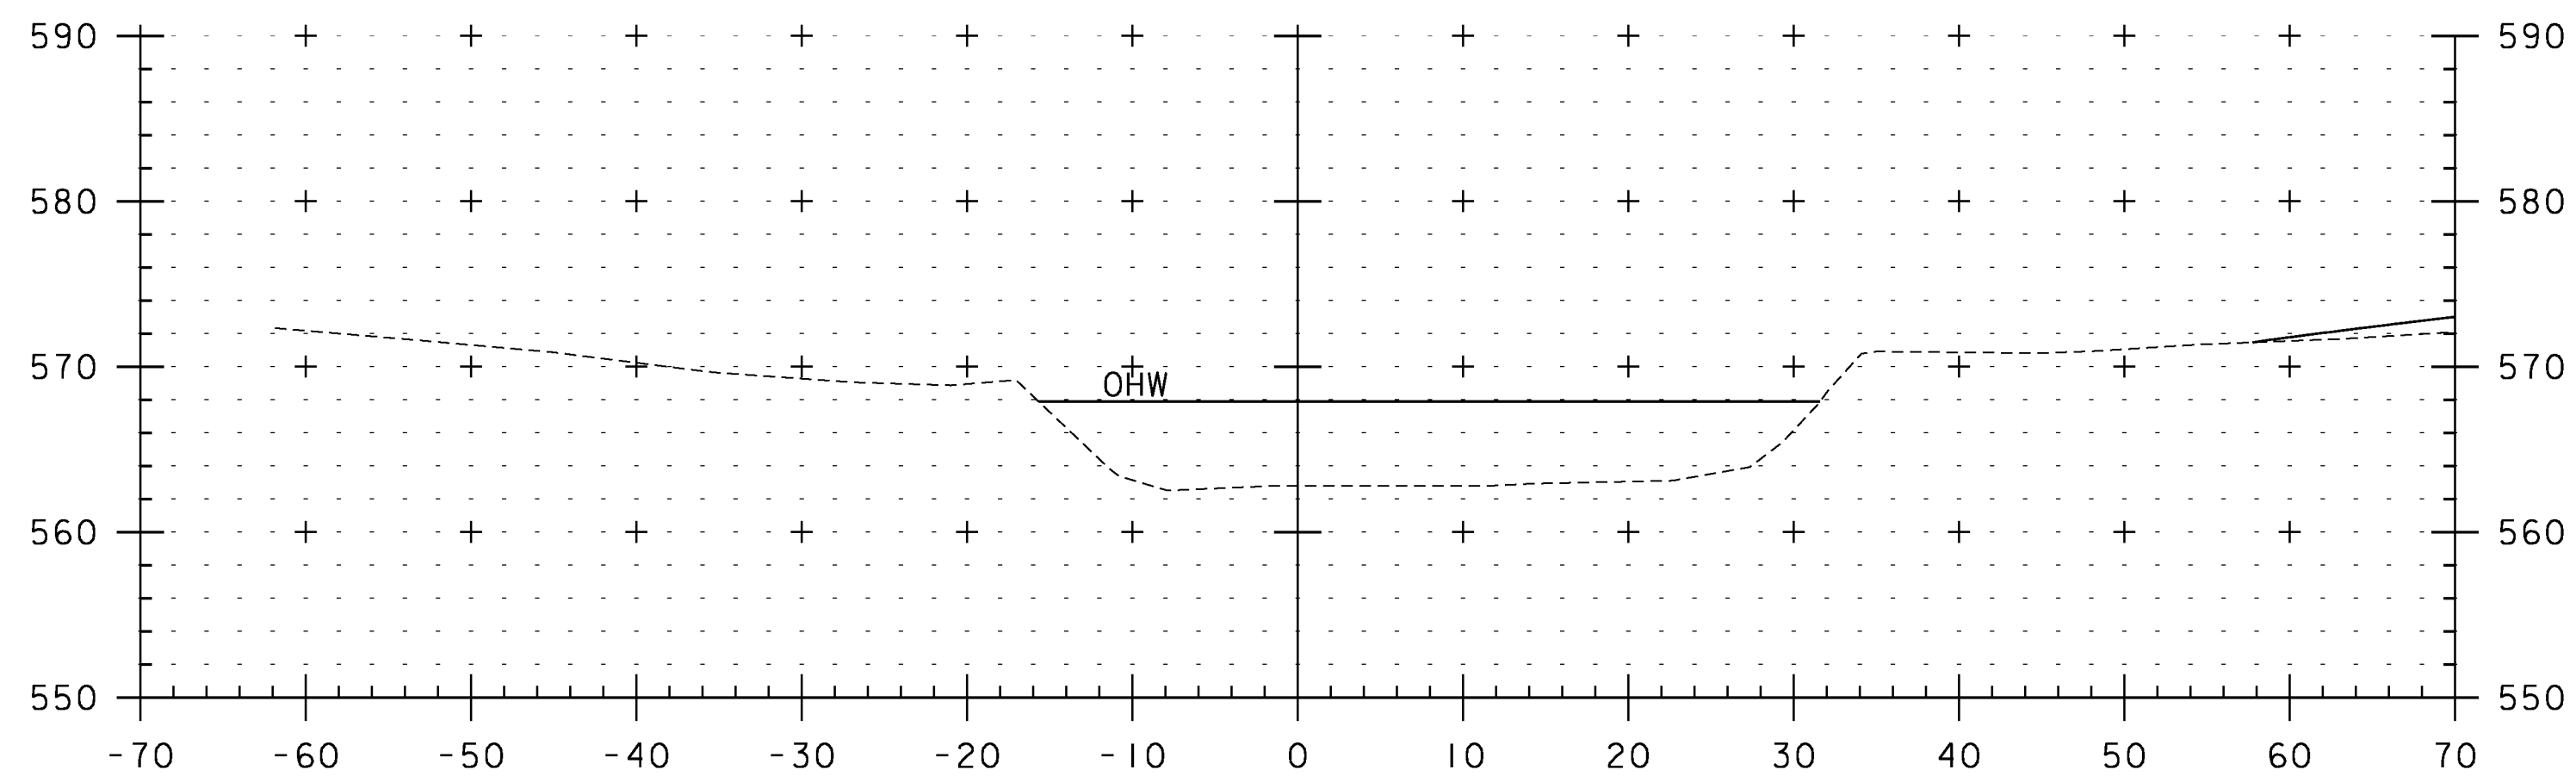

STA. 0+33 LT
 BEGIN UNCLASSIFIED CHANNEL EXCAVATION
 STONE FILL, TYPE IV
 GEOTEXTILE UNDER STONE FILL, TYPE IV
 GRUBBING MATERIAL

STA. 0+36 RT
 END GRUBBING MATERIAL

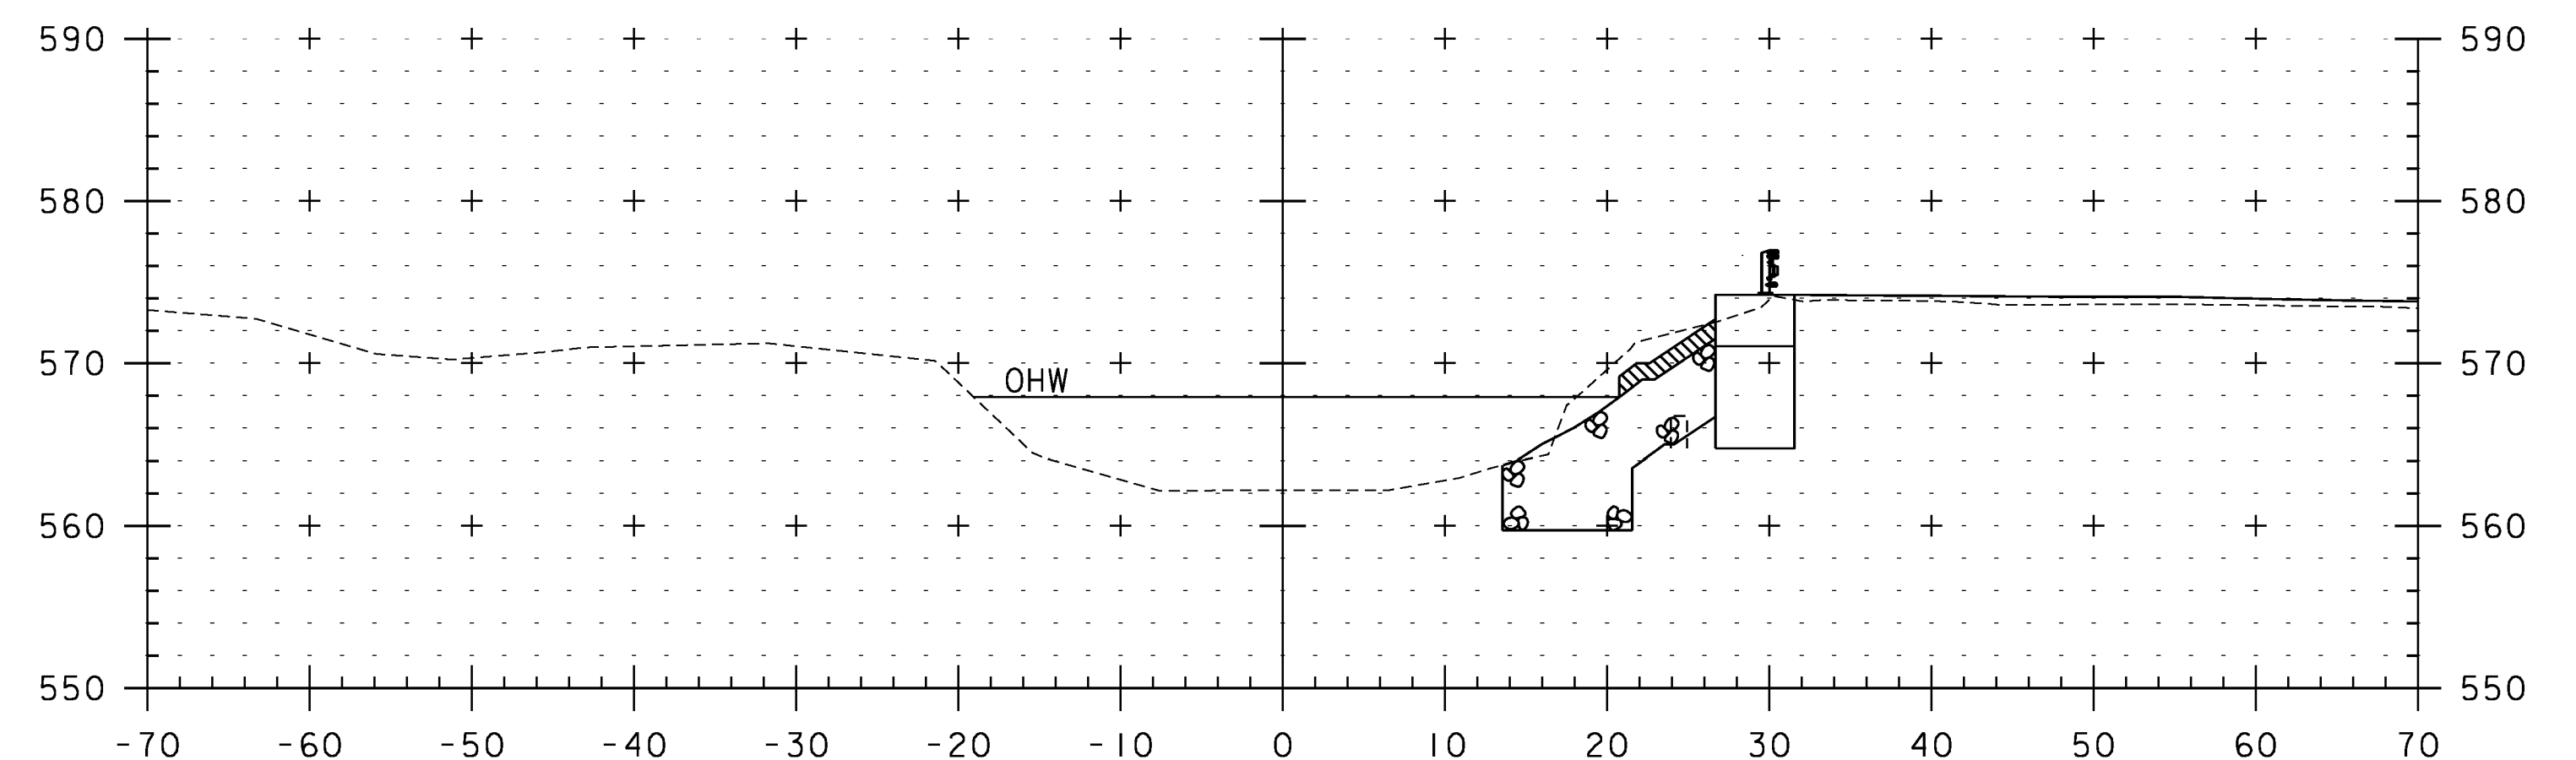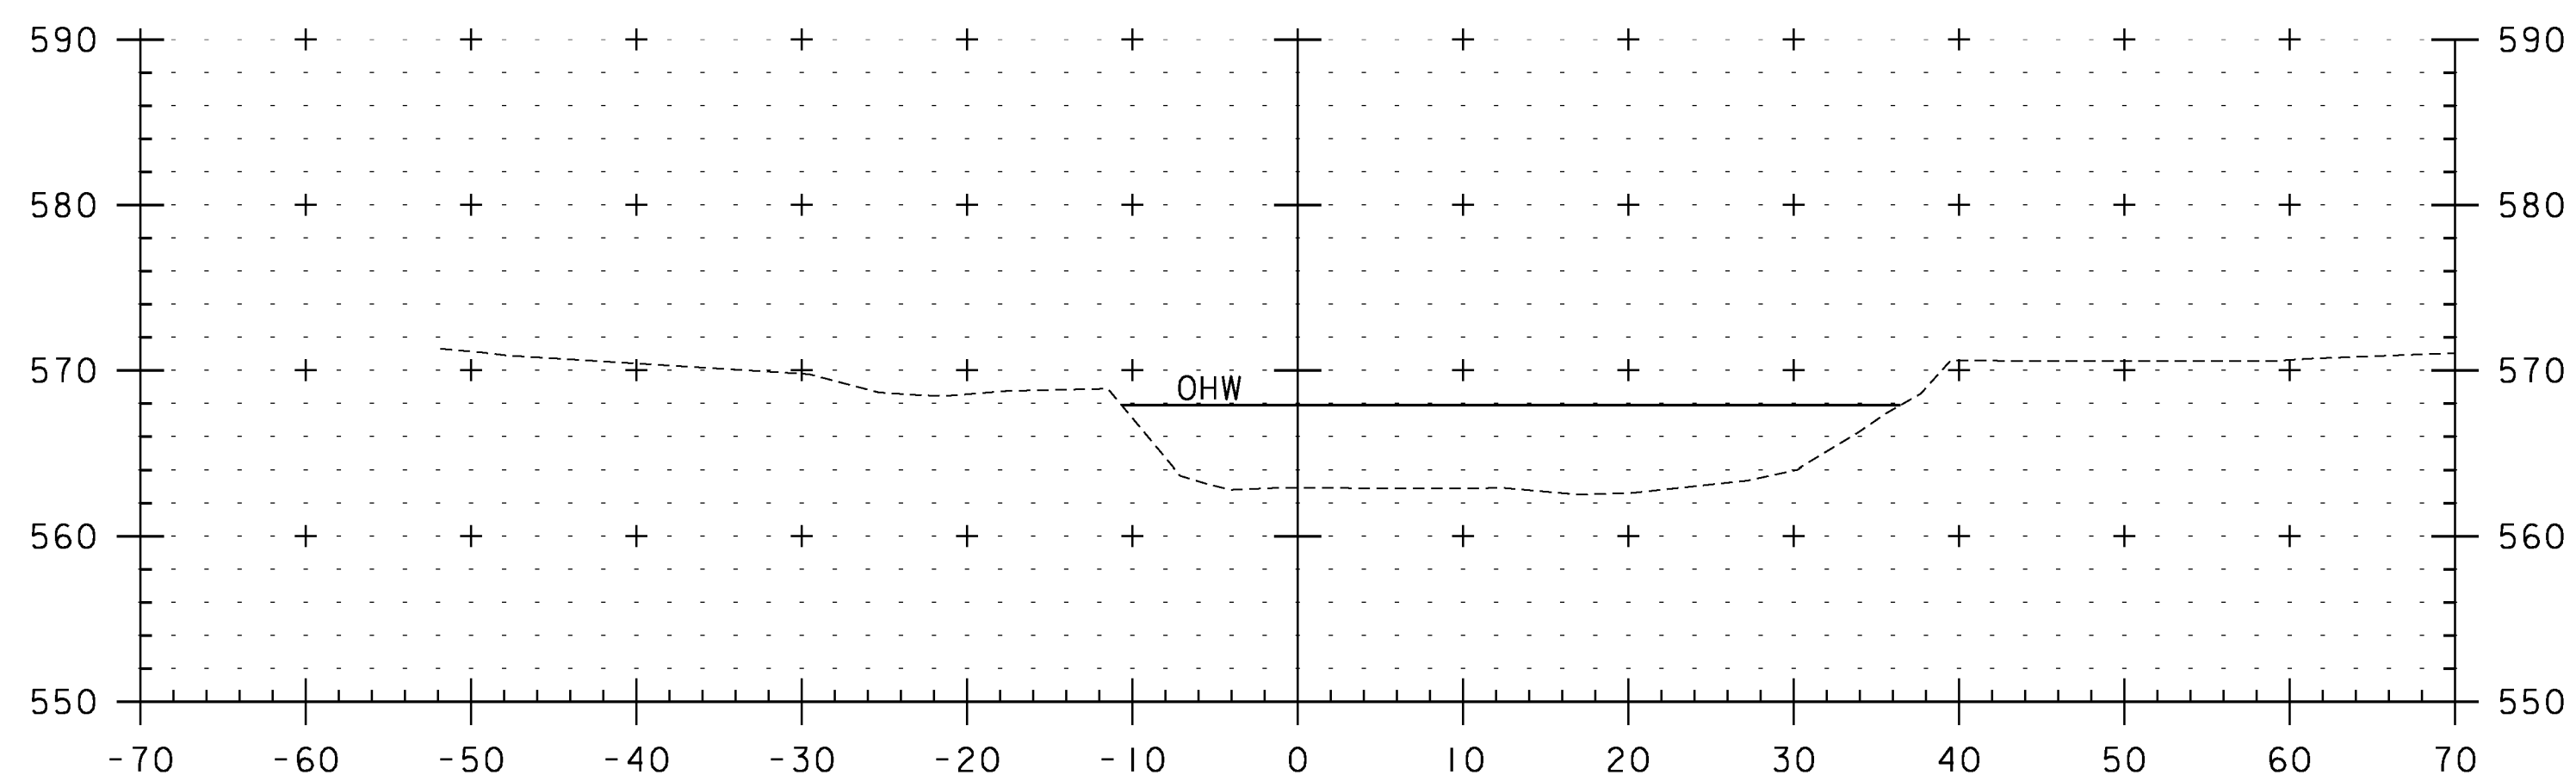

STA. 0+00 TO STA. 0+50

MODEL: XSCHL01
 CLD 12-0175



PROJECT NAME: RANDOLPH
 PROJECT NUMBER: BRO 1444(57)

FILE NAME: z11j078xschl.dgn
 PROJECT LEADER: J. BYATT
 DESIGNED BY: N. CARON
 CHANNEL CROSS SECTIONS (1 OF 2)

PLOT DATE: 8/12/2014
 DRAWN BY: M. SMITH
 CHECKED BY: J. BYATT
 SHEET 31 OF 39