
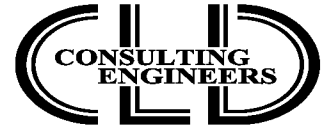


SOIL INFORMATION: WINOOSKI VERY FINE SANDY LOAM
K = 0.49, HIGHLY ERODIBLE
HYDROLOGIC SOIL GROUP: B

SOIL INFORMATION: MERRIMAC FINE SANDY LOAM, 25 TO 50 PERCENT SLOPES
K = 0.24, NOT HIGHLY ERODIBLE
HYDROLOGIC SOIL GROUP: A

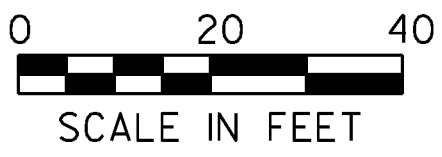

PROJECT NAME: RANDOLPH
PROJECT NUMBER: BRO 1444(57)

FILE NAME: z11j078bdreroex.dgn
PROJECT LEADER: J. BYATT
DESIGNED BY: J. SMITH
EPSC EXISTING PLAN SHEET

PLOT DATE: 8/12/2014
DRAWN BY: S. GOODWIN
CHECKED BY: D. MUNRO
SHEET 34 OF 39

CLD 12-0175 MODEL: 01