



**1 ABUTMENT #1 ELEVATION**  
 F2  
 1/2" = 1'-0"

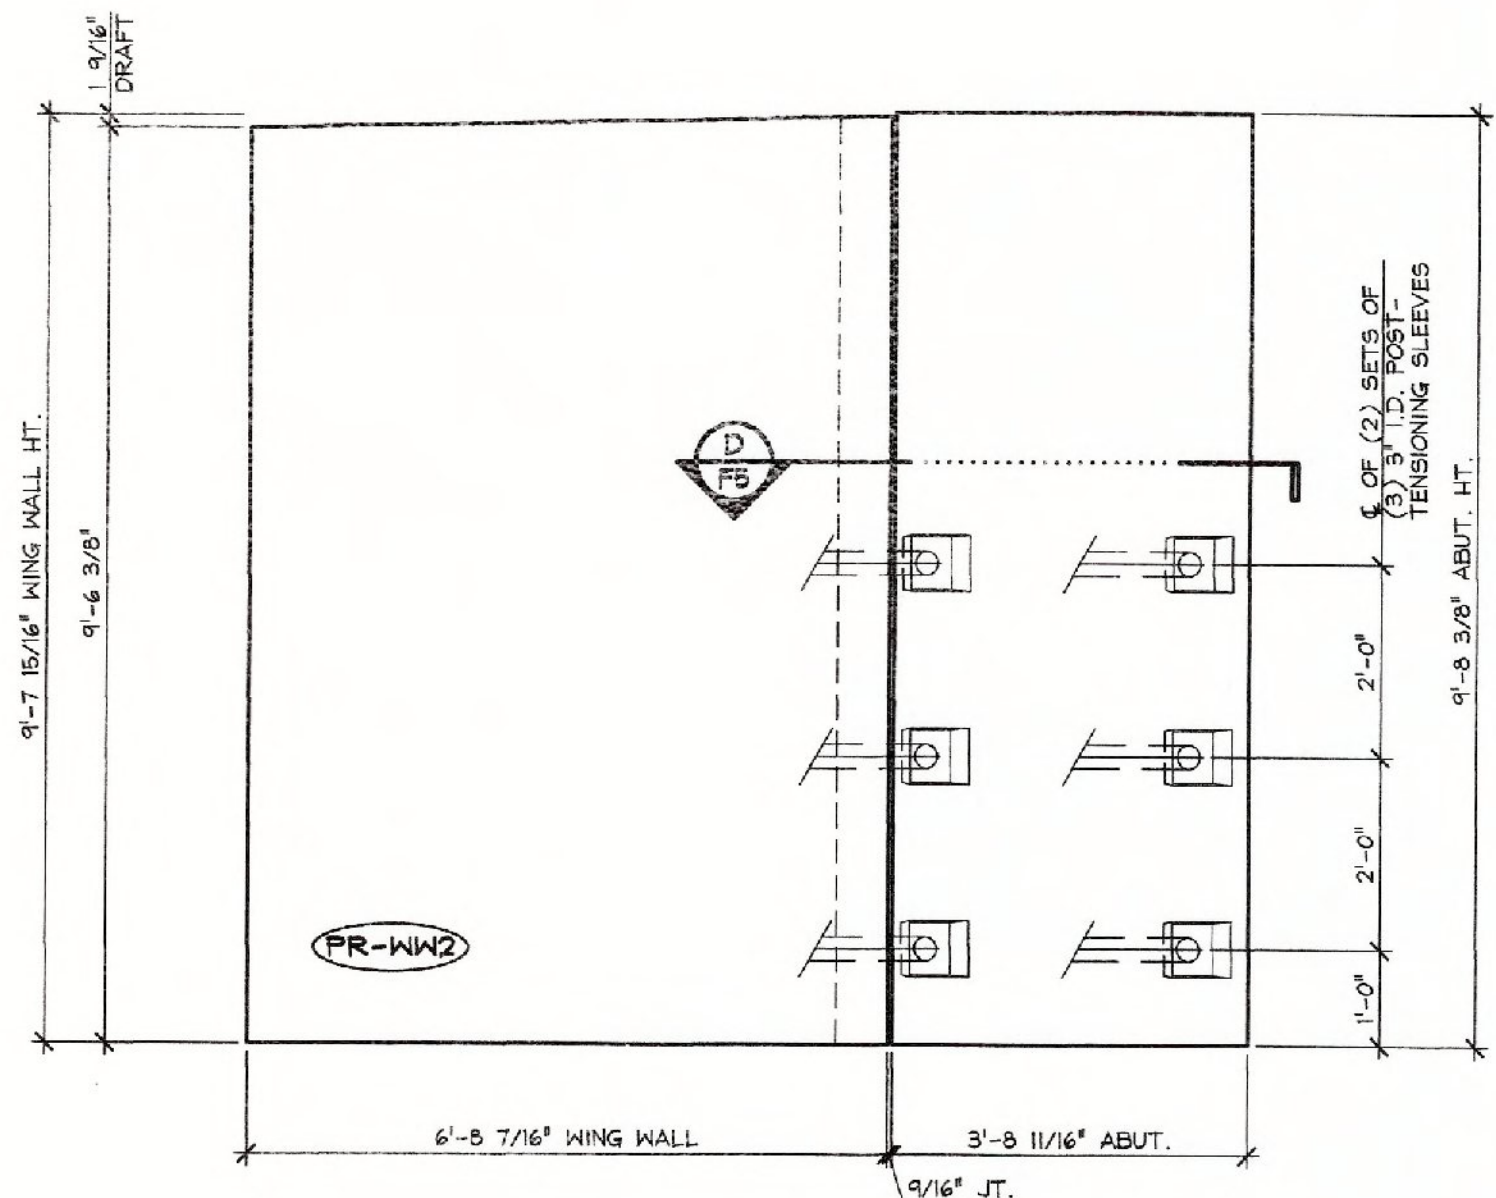

**2 WING WALL ELEVATION "PR-WW2"**  
 F2  
 1/2" = 1'-0"

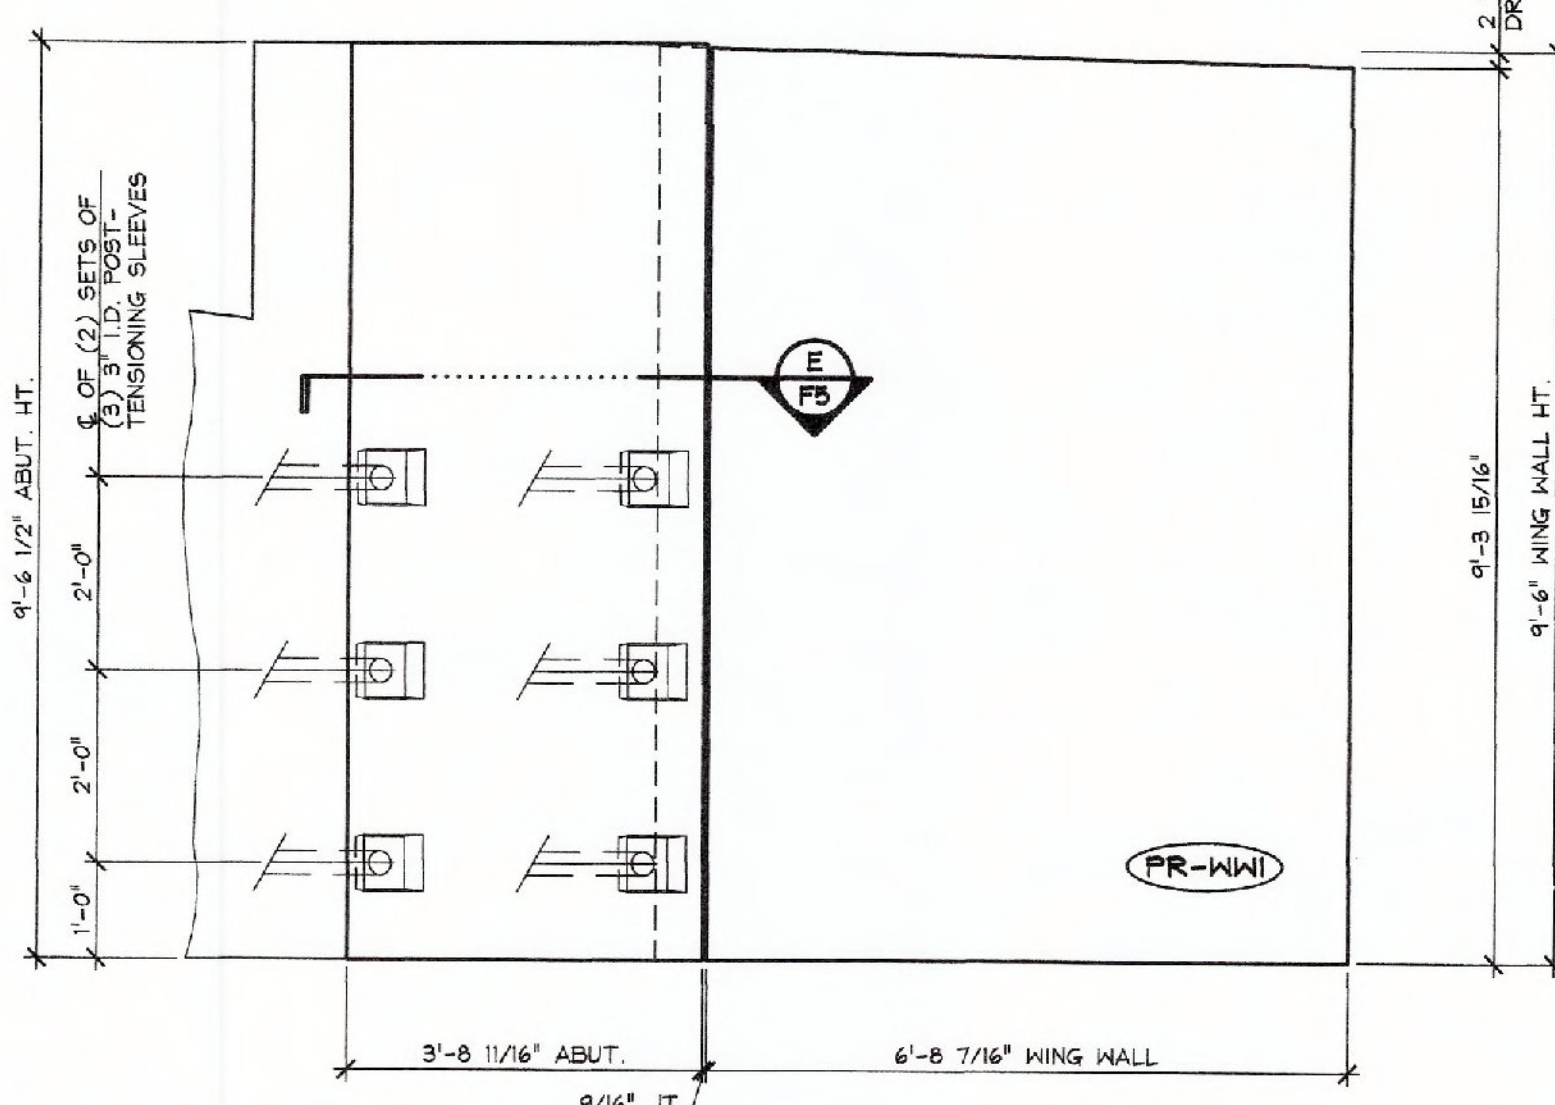

**3 WING WALL ELEVATION "PR-WW1"**  
 F2  
 1/2" = 1'-0"

Vermont Agency of Transportation  
**RECEIVED**  
 ON: February 19, 2015  
 and Checked for  
**CONFORMANCE**  
 BY: T. A. Sumner DATE: 02/25/15

**SHOP DRAWING REVIEW**

REVIEWED AS REQUIRED BY THE CONSTRUCTION CONTRACT DOCUMENTS AND APPROVED, BUT ONLY FOR CONFORMANCE TO THE DESIGN CONCEPT OF THE WORK, AND SUBJECT TO FURTHER CLARIFICATIONS AND REQUIREMENTS CONTAINED IN THE CONSTRUCTION CONTRACT DOCUMENTS.

REJECTED  REVISE AND RESUBMIT  APPROVED AS NOTED

CORRECTIONS OR COMMENTS MADE ON THE SHOP DRAWINGS DURING THIS REVIEW DO NOT RELIEVE CONTRACTOR FROM COMPLIANCE WITH REQUIREMENTS OF THE DRAWINGS AND SPECIFICATIONS. THIS CHECK IS ONLY FOR REVIEW OF GENERAL CONFORMANCE WITH THE INFORMATION GIVEN IN THE CONTRACT DOCUMENTS. THE CONTRACTOR IS RESPONSIBLE FOR OBTAINING AND CORRELATING ALL QUANTITIES AND DIMENSIONS, SELECTING FABRICATION PROCESSES AND TECHNIQUES OF CONSTRUCTION, COORDINATING THEIR WORK WITH THAT OF ALL OTHER TRADES, AND PERFORMING THEIR WORK IN A SAFE AND SATISFACTORY MANNER.

CLD CONSULTING ENGINEERS, INC.  
 145 Deaneville Street  
 Montpelier, VT 05601  
 802-249-4028

Job Number: **12-0173**  
 Reviewed By: **ABC**  
 Date: **2/20/15**

APPROVAL STAMP:	<b>J.P. CARRARA &amp; SONS INC.</b> Precast & Prestress Manufacturer <small>144 OAK ST., WOODBURY, VERMONT 05753 Phone: (802)388-6361 Fax: (802)388-9010</small>		<b>J.P. SICARD, INC.</b> CONTRACTOR BARTON, VERMONT	
	STATE OF VERMONT AGENCY OF TRANSPORTATION COUNTY OF ORANGE		DATE: NOV. 18, 2014 SCALE: NOTED	
	TOWN OF RANDOLPH TOWN HIGHWAY 65 (PALMER ROAD) CLASS 3 LOCAL ROAD BRIDGE NO.: 35 PROJECT NO.: BRO 1444(57)		CHKD: B.C. DFTM: B.L. JOB NO: 23449-014	
	PRECAST ABUTMENT #1 ELEVATIONS		DWG. NO: <b>F2</b>	