


# BILL OF MATERIAL

QTY.	MARK	SHAPE	LENGTH	REMARKS
8		1'-0 1/2" x 1/4" Stl P	1' 0 1/2"	ASTM A-36 Domestic Steel P

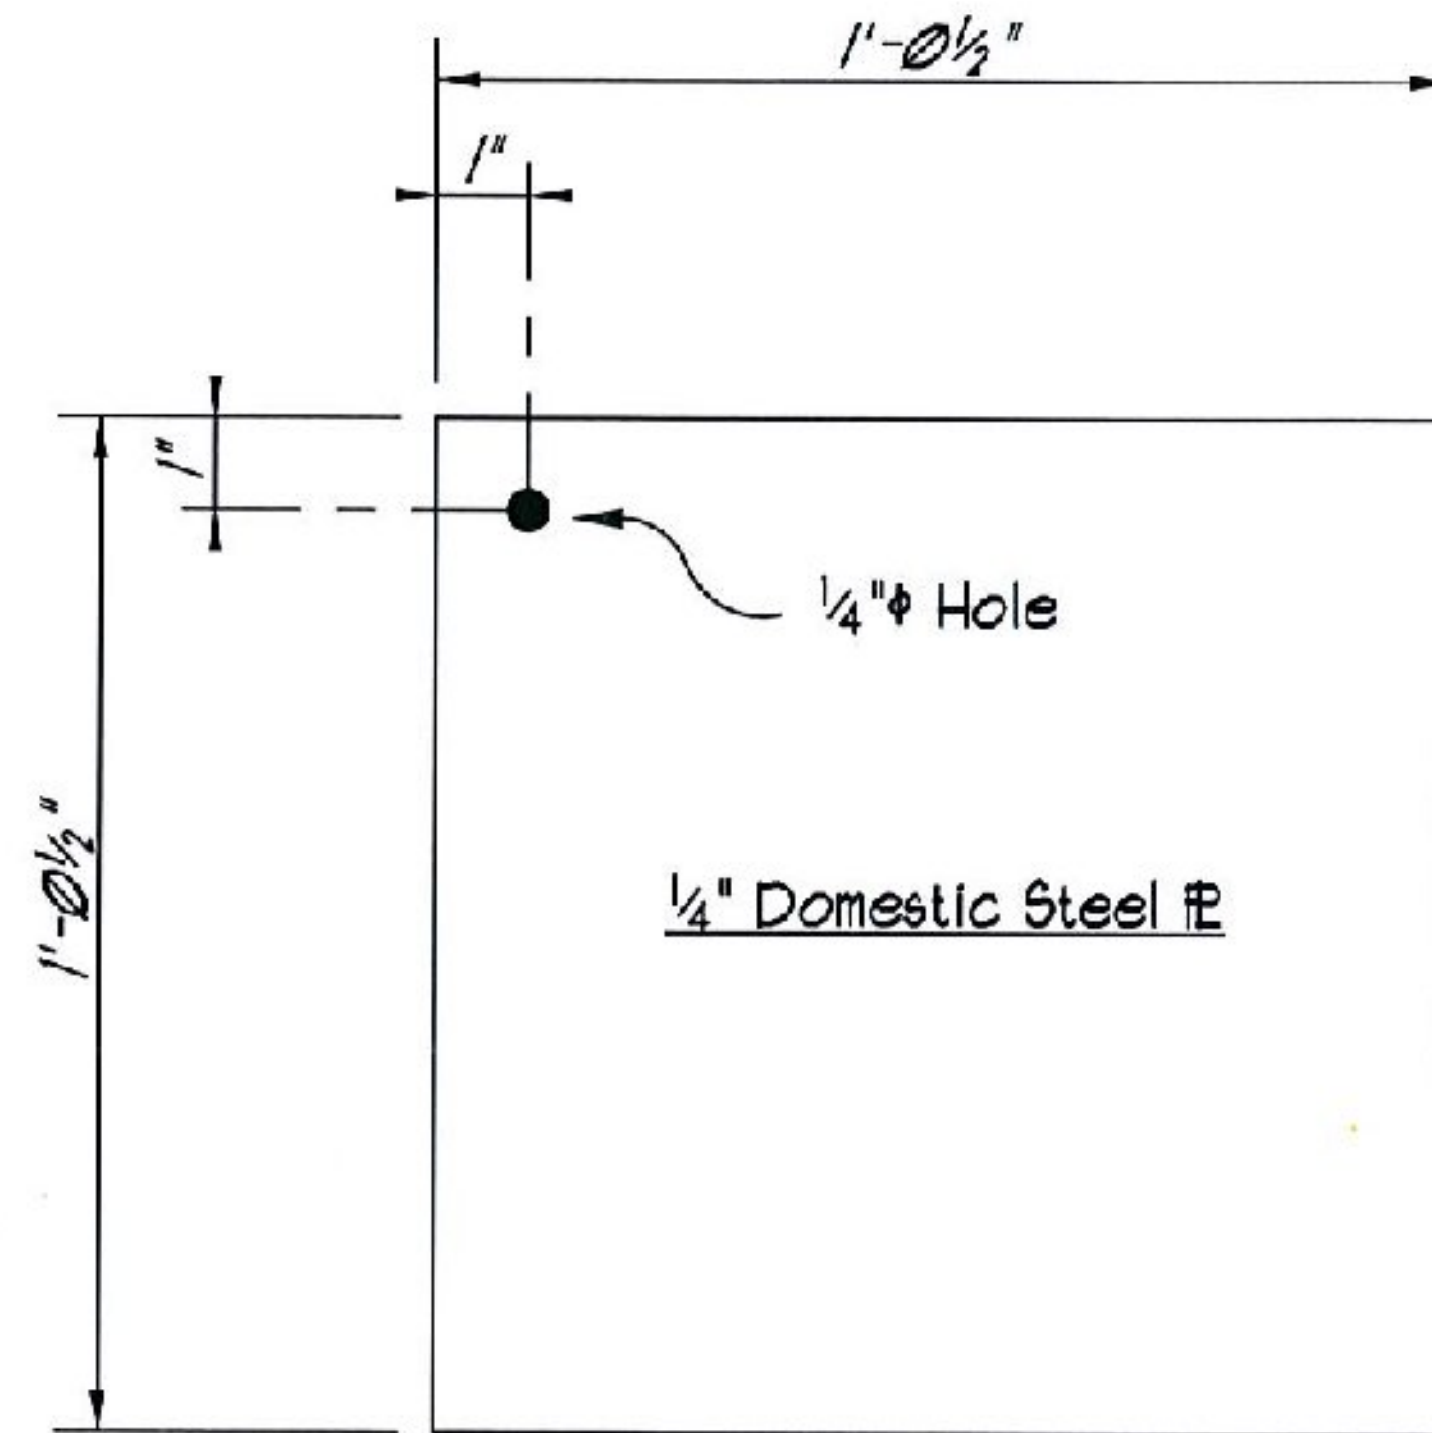

**Make 8  
Shims**

Vermont Agency of Transportation

**RECEIVED**

ON: February 11, 2015  
and Checked for

**CONFORMANCE**

BY: T. A. Sumner DATE: 02/12/15

General Notes:

Steel plate to be domestic ASTM A-36.

Prior to galvanizing, all corners and edges of steel plates, shapes, etc., shall be ground to a 1/16" (1.6mm) radius.

Surfaces to be galvanized shall be zinc coated in conformance with AASHTO M III M / M III or, when applicable, AASHTO M 232M / M232.

SHOP DRAWING REVIEW	
<input checked="" type="checkbox"/> REVIEWED AS REQUIRED BY THE CONSTRUCTION CONTRACT DOCUMENTS AND APPROVED, BUT ONLY FOR CONFORMANCE TO THE DESIGN CONCEPT OF THE WORK, AND SUBJECT TO FURTHER LIMITATIONS AND REQUIREMENTS CONTAINED IN THE CONSTRUCTION CONTRACT DOCUMENTS.	
<input type="checkbox"/> REJECTED <input type="checkbox"/> REVISIONS <input type="checkbox"/> APPROVED AS NOTED	
<small>CORRECTIONS OR COMMENTS MADE ON THE SHOP DRAWINGS DURING THIS REVIEW DO NOT RELIEVE CONTRACTOR FROM COMPLIANCE WITH REQUIREMENTS OF THE DRAWINGS AND SPECIFICATIONS. THIS CHECK IS ONLY FOR REVIEW OF GENERAL CONFORMANCE WITH THE DESIGN CONCEPT OF THE PROJECT AND GENERAL COMPLIANCE WITH THE REQUIREMENTS OF THE CONTRACT DOCUMENTS. THE CONTRACTOR IS RESPONSIBLE FOR CORRECTING AND CORRELATING ALL QUANTITIES AND DIMENSIONS, SELECTING FABRICATION PROCESSES AND TECHNIQUES OF CONSTRUCTION, COORDINATING THEIR WORK WITH THAT OF ALL OTHER TRADES, AND PERFORMING THEIR WORK IN A SAFE AND SATISFACTORY MANNER.</small>	
<small>CEC Consulting Engineers 60 Commercial Street Newbury, VT 05245 803-886-8225</small>	Job Number: 12-0175 Reviewed by: NBC Date: 2/12/15

02-10-2015 Revised & Resub Per App

**OSGOOD WELDING**

144 Grissom Lane, Claremont, N.H. 03743  
Phone: 603-643-1703

PROJECT: Randolph BRO 1444 (51)  
LOCATION: Town Highway 65 (Palmer Rd) Bridge 35  
GEN'L. CONTR.: Town of Randolph, County of Orange, Vt

DESCRIPTION: Steel Shim PEs Per Customer Information			
DR:	HOLES	DATE	JOB NO.
WFM	1/4"	2-03-2015	
C.H.	BOLTS	APPROVED	SK. NO.
PANT	None - Galv'd Per Specs		SK-1