


INDEX OF SHEETS
SEE PAGE 2

STATE OF VERMONT AGENCY OF TRANSPORTATION

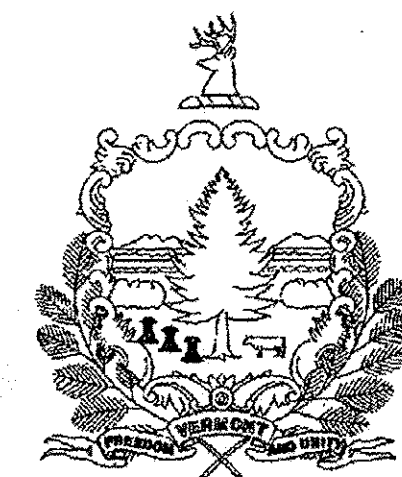

PROPOSED IMPROVEMENT

STATEWIDE SOUTHEAST REGION STP HRRR(14)
TOWNS OF ATHENS, BETHEL, GRAFTON, RANDOLPH, SPRINGFIELD AND WEATHERSFIELD
COUNTIES OF ORANGE, WINDHAM AND WINDSOR
VARIOUS TOWN HIGHWAYS

PROJECT DESCRIPTION: WORK TO BE PERFORMED UNDER THIS PROJECT INCLUDES THE REMOVAL OF EXISTING SIGNS, SIGN POSTS, AND GUARDRAIL; THE INSTALLATION OF NEW SIGNS, SIGN POSTS, AND GUARDRAIL; PAVEMENT MARKINGS (CENTERLINE, EDGELINE, SYMBOLS AND LETTERS); AND OTHER HIGHWAY RELATED ITEMS FOR THE DESCRIBED WORK.

PROJECT LOCATIONS:	TH	MM	0.000 -	
	TH-1,	MM	0.000 - 1.389	ATHENS (STATE NUMBERED TOWN HIGHWAY 35)
	TH-2,	MM	0.000 - 3.100	BETHEL (CAMP BROOK ROAD)
	TH-12,	MM	0.000 - 0.311	BETHEL (VT ROUTE 12)
	TH-38,	MM	0.000 - 0.157	BETHEL (WATERSHED ROAD)
	TH-1,	MM	0.000 - 2.373	GRAFTON (STATE NUMBERED TOWN HIGHWAY 121)
	TH-38,	MM	0.000 - 0.061	GRAFTON (FISHER HILL ROAD)
	TH-4,	MM	0.000 - 0.207	GRAFTON (STATE NUMBERED TOWN HIGHWAY 35 / GRAFTON STREET)
	TH-3,	MM	0.000 - 2.130	RANDOLPH (CHELSEA MOUNTAIN ROAD)
	TH-8,	MM	0.000 - 1.965	SPRINGFIELD (FRENCH MEADOW ROAD)
	TH-10,	MM	0.000 - 0.250	SPRINGFIELD (SPOONERVILLE ROAD)
	TH-4,	MM	0.000 - 0.400	WEATHERSFIELD (RESERVOIR ROAD)
	TH-62,	MM	0.000 - 0.113	WEATHERSFIELD (WELLWOOD ORCHARD ROAD)

PROJECT LENGTHS:	MILES	(FEET)
1.389 MILES	1.389	(7333.92 FT)
3.100 MILES	3.100	(16368.00 FT)
0.311 MILES	0.311	(1642.08 FT)
0.157 MILES	0.157	(828.96 FT)
2.373 MILES	2.373	(12529.44 FT)
0.061 MILES	0.061	(322.08 FT)
0.207 MILES	0.207	(1092.96 FT)
2.130 MILES	2.130	(11246.40 FT)
1.965 MILES	1.965	(10375.20 FT)
0.250 MILES	0.250	(1320.00 FT)
0.400 MILES	0.400	(2112.00 FT)
0.113 MILES	0.113	(596.64 FT)
TOTAL LENGTH:	12.456 MILES	(65767.68 FT)


STATEWIDE SOUTHEAST REGION HES HSIP(5)

TOWN OF CHESTER
COUNTY OF WINDSOR

PROJECT DESCRIPTION: WORK TO BE PERFORMED UNDER THIS PROJECT INCLUDES THE REMOVAL OF EXISTING SIGNS, SIGN POSTS; THE INSTALLATION OF NEW SIGNS, SIGN POSTS; AND OTHER HIGHWAY RELATED ITEMS FOR THE DESCRIBED WORK.

PROJECT LOCATIONS:	TH	MM	0.000 -	
	TH-3,	MM	0.000 - 0.949	CHESTER (GRAFTON ROAD)
	TH-10,	MM	0.000 - 0.290	CHESTER (POPPLE DUNGEON ROAD)

PROJECT LENGTHS:	MILES	(FEET)
0.949 MILES	0.949	(5010.72 FT)
0.290 MILES	0.290	(1531.20 FT)
TOTAL LENGTH:	1.239 MILES	(6541.92 FT)

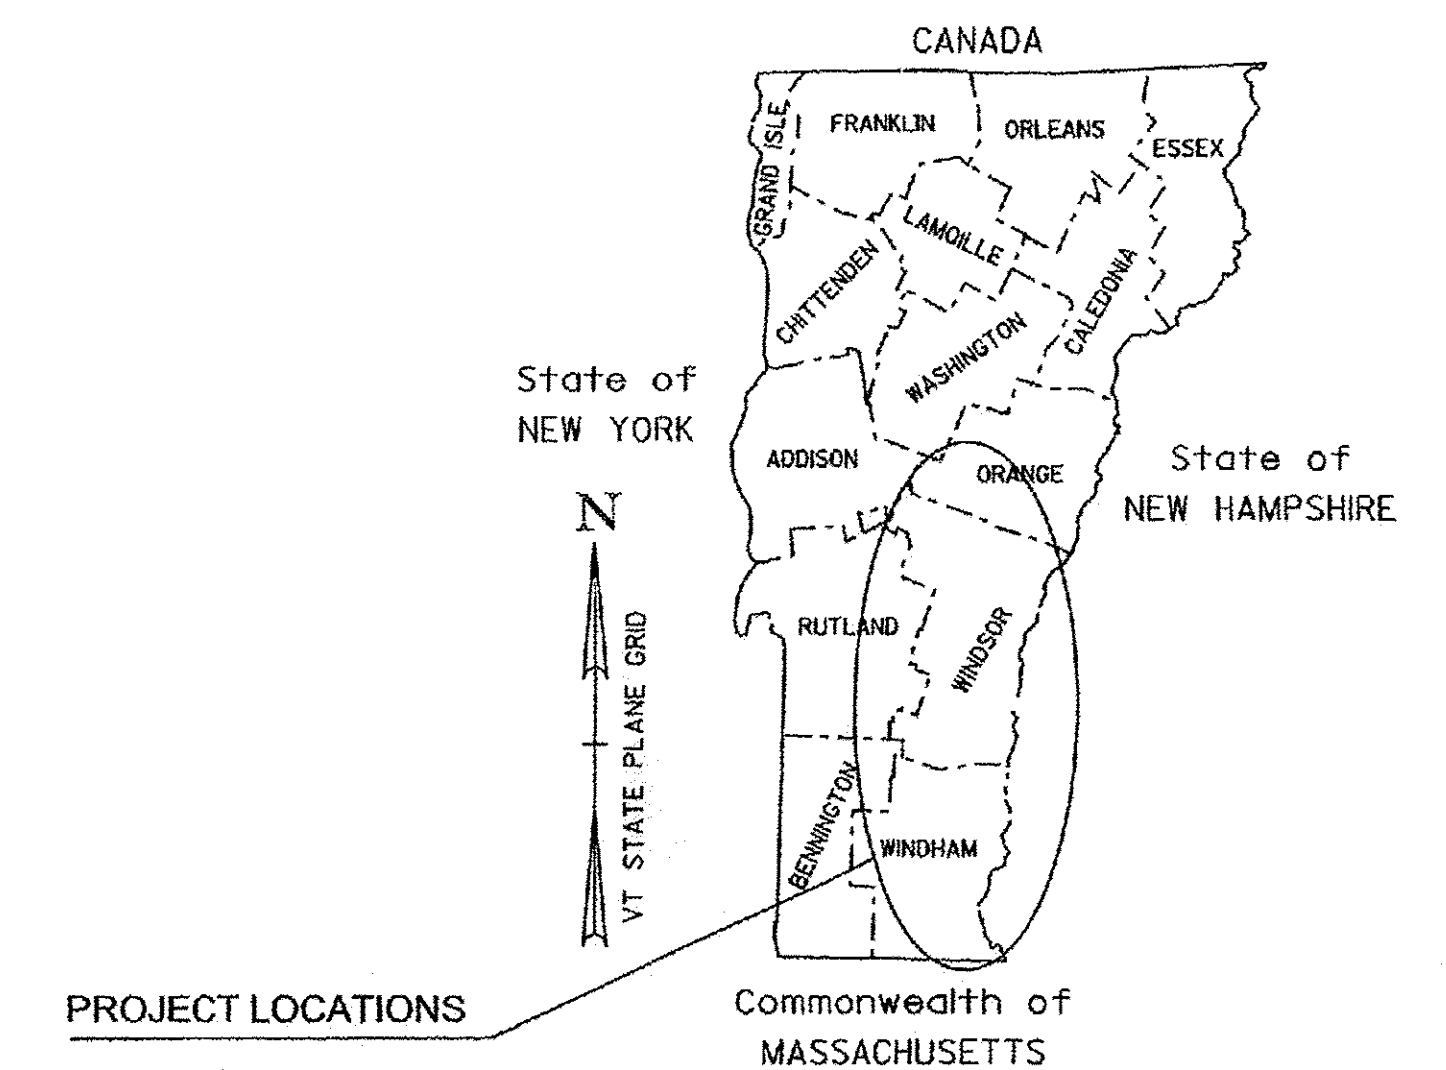

RECORD PLANS	
CONTRACTOR:	F. R. LAFAYETTE, INC. - ESSEX JUNCTION, VT
RESIDENT ENGINEER:	TOM CHASE
CONSTRUCTION BEGAN:	MAY 16, 2013
CONSTRUCTION COMPLETE:	AUGUST 21, 2013
RECORD PLANS BY:	TOM CHASE & JENNA HYDE
I HEREBY CERTIFY THAT ALL THE CONSTRUCTION REQUIRED BY THIS SET OF DRAWINGS HAS BEEN ACCOMPLISHED AS INDICATED HEREIN.	
BY	<i>Thomas A. Chase</i> RESIDENT ENGINEER
DATE	02/27/14
NOTE: Any further information concerning final quantities, amounts or other details relative to this project may be found at Central Files in the electronic archives.	

QUALITY ASSURANCE PROGRAM: LEVEL 3

CONVENTIONAL SYMBOLS	
COUNTY LINE	
TOWN LINE	
LIMITS OF ACCESS	
POINT OF ACCESS	
FENCE LINE	
STONE WALL	
TRAVELED WAY	
GUARD RAIL	
RAILROAD	
SURVEY LINE	
CULVERT	
POWER POLE	
TELEPHONE POLE	
TREES	
CONTROL OF ACCESS	
PROPERTY LINE	
R.O.W. TAKING LINE	
SLOPE RIGHTS	
TOP OF CUT	
TOE OF SLOPE	

SURVEYED BY :	N/A
SURVEYED DATE :	N/A
DATUM	
VERTICAL	N/A
HORIZONTAL	N/A

THESE PLANS ARE SUBJECT TO SUCH ENGINEERING CHANGES AS MAY BE REQUIRED BY THE FEDERAL HIGHWAY ADMINISTRATION OR THE DIRECTOR OF PROGRAM DEVELOPMENT.

CONSTRUCTION IS TO BE CARRIED ON IN ACCORDANCE WITH THESE PLANS AND THE STANDARD SPECIFICATIONS FOR CONSTRUCTION DATED 2014, AS APPROVED BY THE FEDERAL HIGHWAY ADMINISTRATION ON JULY 20, 2011 FOR USE ON THIS PROJECT, INCLUDING ALL SUBSEQUENT REVISIONS AND SUCH REVISED SPECIFICATIONS AND SPECIAL PROVISIONS AS ARE INCORPORATED IN THESE PLANS.

DIRECTOR OF PROGRAM DEVELOPMENT	
APPROVED <i>[Signature]</i>	DATE 7-23-12
PROJECT MANAGER : JOSH SCHULTZ	
PROJECT NAME : STATEWIDE - SOUTHEAST REGION	
PROJECT NUMBER : STP HRRR(14) / HES HSIP(5)	
SHEET 1 OF 65 SHEETS	