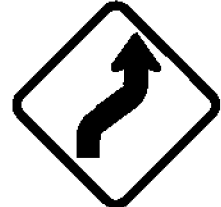
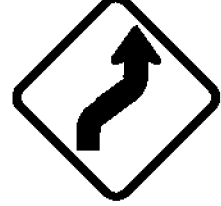
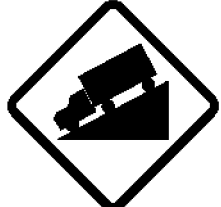
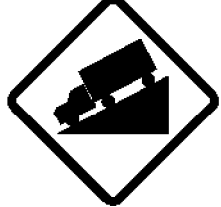
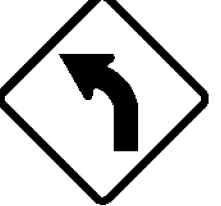



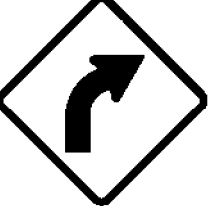


TRAFFIC SIGN SUMMARY SHEET 2

DIRECTION	MILEMARKER, STATION, OR SIGN NUMBER	LOCATION	MANUAL ON UNIFORM TRAFFIC DEVICES OR STATE CODE	SIGN DIMENSIONS		SHEETING REMARKS	SIGN LEGEND	NEW SIGNS		EXISTING SIGNS				EXISTING POST	NO. OF NEW POSTS	SQUARE STEEL (in)			TUBULAR STEEL O/(in)				SIGN FRAME REQUIRED	REMARKS SHSM = STANDARD HIGHWAY SIGN & MARKING BOOK	SIGN DETAIL					
				WIDTH	HEIGHT			"A"	"B"	RETAIN	SALVAGE FROM	SALVAGE TO	REMOVE			RETAIN	REMOVE	1.75	2.00	2.50	FOUNDATION	3.00			3.50	4.00	5.00	DETAIL IN SHSM	DETAIL ON SHEET NUMBER	STANDARD SHEET NUMBER
																		lb/ft				lb/ft								
EB	MM 2.070, RT.	A	W1-4R	30	30			6.25							1.00	15							INSTALL NEW ASSEMBLY 50' EAST OF POLE # V239.	X						
WB	MM 2.240, LT.	F	W1-4R	30	30			6.25							1.00	15							INSTALL NEW ASSEMBLY ^{230'} 127' EAST OF POLE # WASH ELEC / L24 / R18.	X						
EB	MM 2.840, RT.	A	W7-1	30	30			6.25							1.00	15							INSTALL NEW ASSEMBLY 132' EAST AND ACROSS FROM POLE # WASH ELEC / L24 / R2 / R4.	X						
WB	MM 2.884, LT.	F	W7-1	30	30			6.25							1.00	15							INSTALL NEW ASSEMBLY 100' WEST OF POLE # WASH ELEC / L24 / R2 / R4.	X						
EB	MM 2.950, RT.	A	W1-2L	30	30			6.25							1.00	15							INSTALL NEW ASSEMBLY 80' WEST AND ACROSS FROM POLE WASH ELEC / R2 / R2 / 64.	X						
		A	W13-1	18	18			2.25															INSTALL BELOW W1-2 L SIGN ON SAME POST.	X						
EB	MM 2.998, RT.	A	W1-6L	48	24			8.00							2.00	30							INSTALL NEW W1-6 SIGN 180' EAST AND ACROSS FROM POLE # WASH ELEC / R2 / R2 / 64.	X						
EB	MM 3.021, RT.	B	W1-6R	48	24			8.00							2.00	30							INSTALL NEW W1-6 SIGN 300' EAST AND ACROSS FROM POLE # WASH ELEC / R2 / R2 / 64.	X						
WB	MM 3.081, LT.	F	W1-2R	30	30			6.25							1.00	15							INSTALL NEW W1-2R SIGN 618' EAST OF POLE # WASH ELEC / R2 / R2 / 64.	X						
<p>FINAL POST LENGTHS ARE TO BE DETERMINED IN THE FIELD. POST SIZES ARE COMPUTED BASED ON INFORMATION FURNISHED ON THE STANDARD SHEETS AND THE VTRANS "SIGN POST DESIGN GUIDE".</p>																														
										EA	EA	EA	EA	EA	EA		FT	FT	FT	150		LB	LB	LB	LB					
								SF	SF								EA	FT	150	EA		LB								
																		<p>PROJECT NAME: STATEWIDE SOUTHEAST REGION PROJECT NUMBER: STP HRRR(I4)</p>		<p>FILE NAME: I2k022wrk.dgn PROJECT LEADER: JLS DESIGNED BY: NLA</p>		<p>PLOT DATE: 23-JUL-2012 DRAWN BY: TDS CHECKED BY: NLA</p>		<p>RANDOLPH TRAFFIC SIGN SUMMARY SHEET 2 SHEET 45 OF 65</p>						