


TOWNSTATE HIGHWAY INVENTORY FOR PAVEMENT MARKINGS

* NOTE ALL LOCATIONS ARE MEASURED FROM THE CENTER OF THE INTERSECTING ROADWAYS FOR THAT INTERSECTION AND ARE APPROXIMATE. FIELD VERIFY BEFORE INSTALLING OR AS DIRECTED BY THE ENGINEER.

TOWN/STATE HIGHWAY NAME	LOCATION MM	EXISTING PAVED/ GRAVEL	MAINLINE CENTERLINE BREAK	MAINLINE EDGE LINE BREAK	4" YELLOW CENTERLINE	4" WHITE EDGE LINE	8" WHITE LINE	STOP BAR	STOP SIGN	STOP LETTERS	YIELD SIGN	YIELD SYMBOLS	YIELD AHEAD LETTERS	STOP AHEAD LETTERS	STOP AHEAD SIGN	MAINLINE CROSSWALK	TH CROSSWALK	GRINDING	REMARKS	
BETHEL																				
CAMP BROOK ROAD	MM 6.075 MM 6.095							STA 0+16 LT STA 0+60 LT MM 6.10 RT	YES YES YES	STA 0+20 LT STA 0+56 LT MM 6.099 RT										
GRAFTON																				
SNTH 35 / GRAFTON ST.	MM 0.020				MM 0.001~0.095			MM 0.001	YES	MM 0.002				MM 0.083 RT	YES					
FISHER HILL RD	MM 1.129				MM 0.005~0.028						YES	STA 0+16 LT								
SPRINGFIELD																				
FRENCH MEADOW RD					MM 1.957~1.965			MM 1.965 RT	YES	MM 1.962 RT				MM 1.900 RT	YES					
WEATHERSFIELD																				
WELLWOOD ORCHARD RD					MM 0.005~0.041			MM 0.005 LT	YES	MM 0.006 RT				MM 0.060 LT	YES				NOT DONE - ROAD IS UNPAVED HERE SIGN WAS INSTALLED, THOUGH.	
					1700 FT						96 FT			24 EA			4 EA			27 EA
TOTAL																				

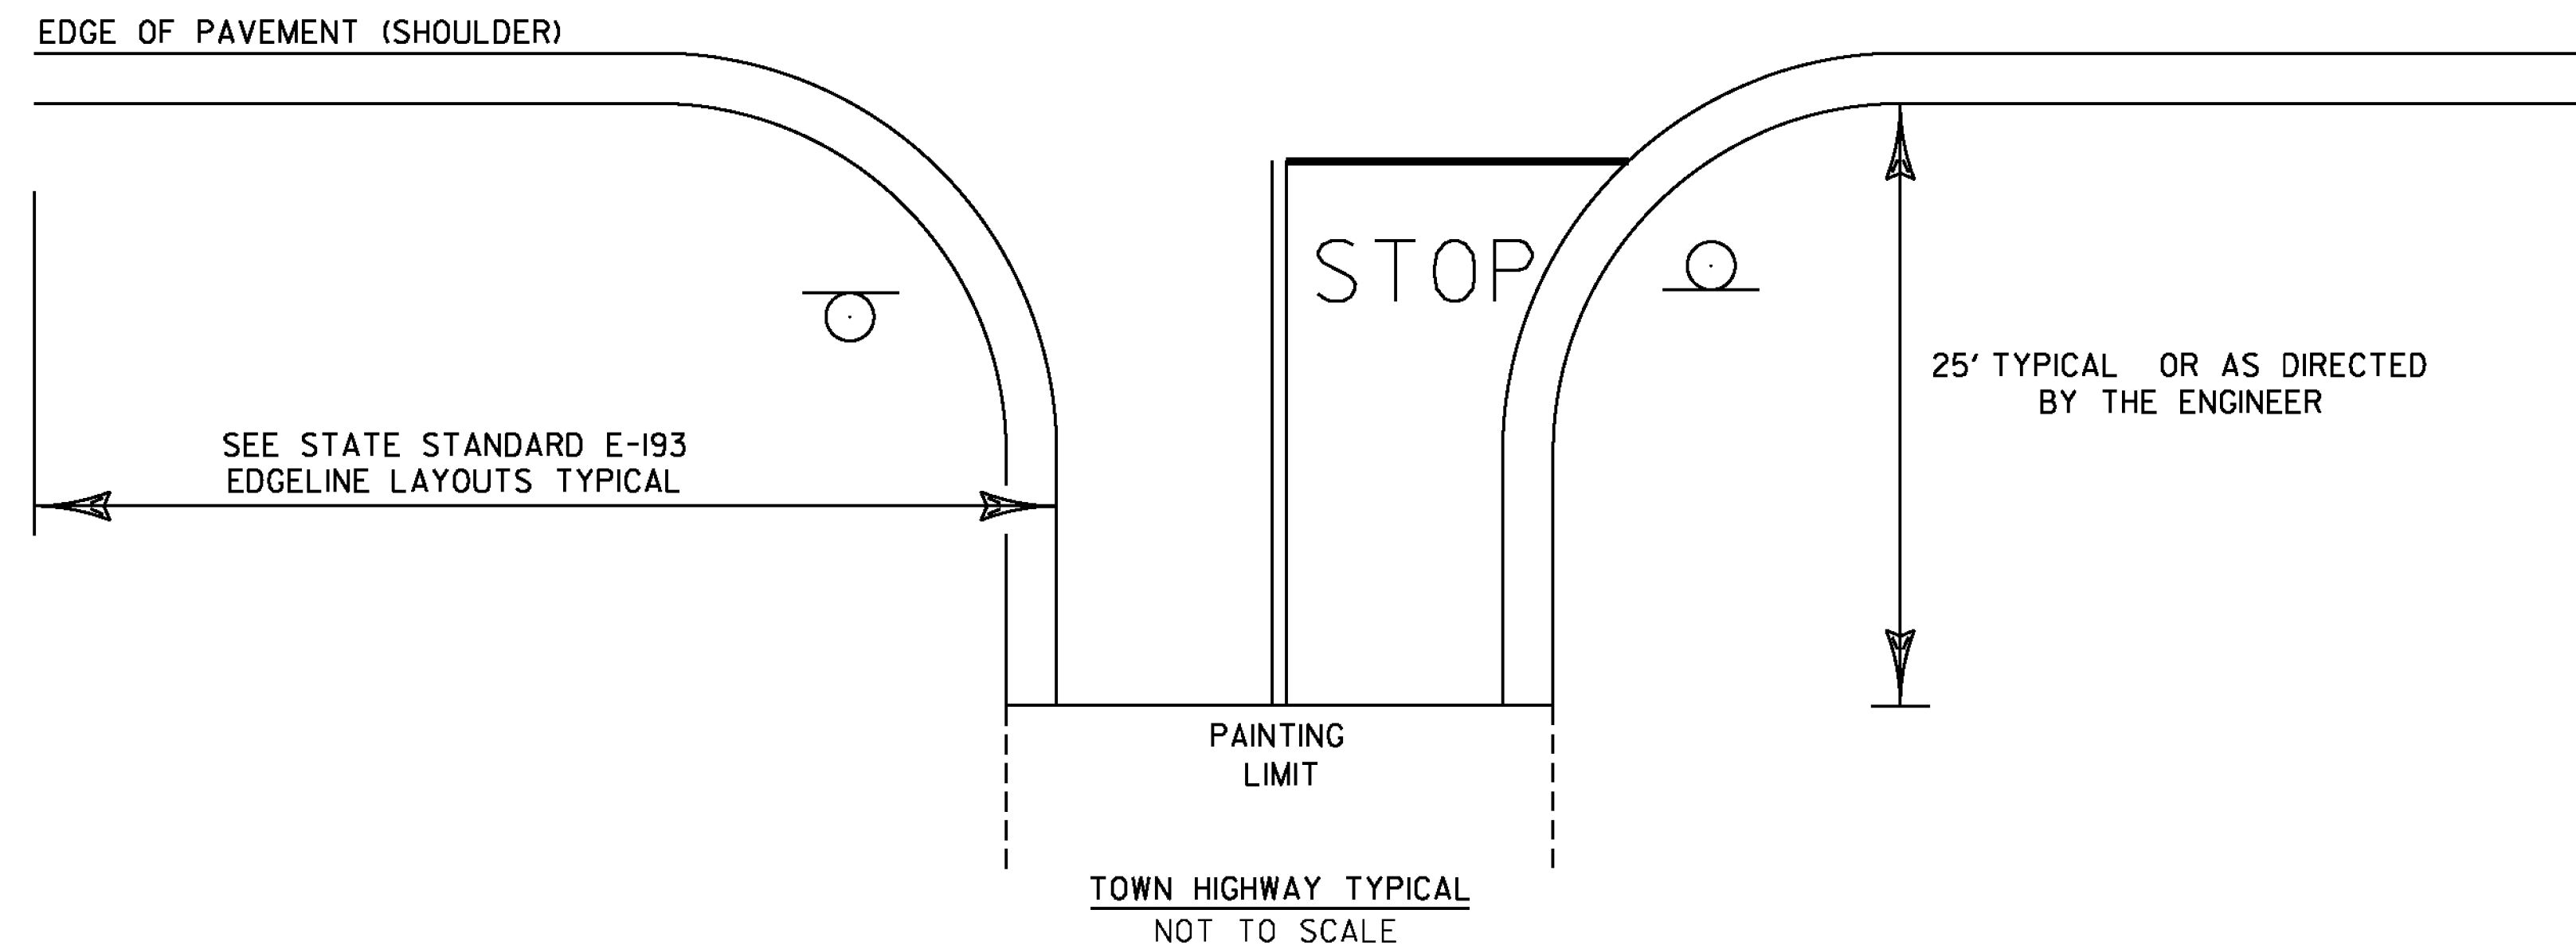

- NOTES:
- 1.) SEE STD E-121 FOR THE PLACEMENT OF STOP AND LEGAL LOAD LIMIT SIGNS.
 - 2.) SEE STD E-193 FOR THE PLACEMENT OF CENTERLINE, EDGELINE, STOP BARS, AND STOP LETTERS.

PROJECT NAME: STATEWIDE SOUTHEAST REGION	PLOT DATE: 23-JUL-2012
PROJECT NUMBER: STP HRRR(14)	DRAWN BY: TDS
FILE NAME: i2k022wrk.dgn	CHECKED BY: NLA
PROJECT LEADER: JLS	SHEET 57 OF 65
DESIGNED BY: NLA	TOWN HIGHWAY PAVEMENT MARKINGS SHEET