



SEE SHEET 2 FOR INDEX OF SHEETS AND STANDARDS LIST

# STATE OF VERMONT AGENCY OF TRANSPORTATION

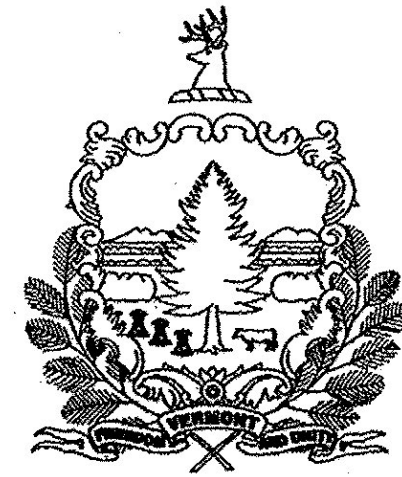

## PROPOSED IMPROVEMENT BRIDGE PROJECT TOWN OF TOWNSHEND COUNTY OF WINDHAM SCOTT COVERED BRIDGE BRIDGE NO. 45

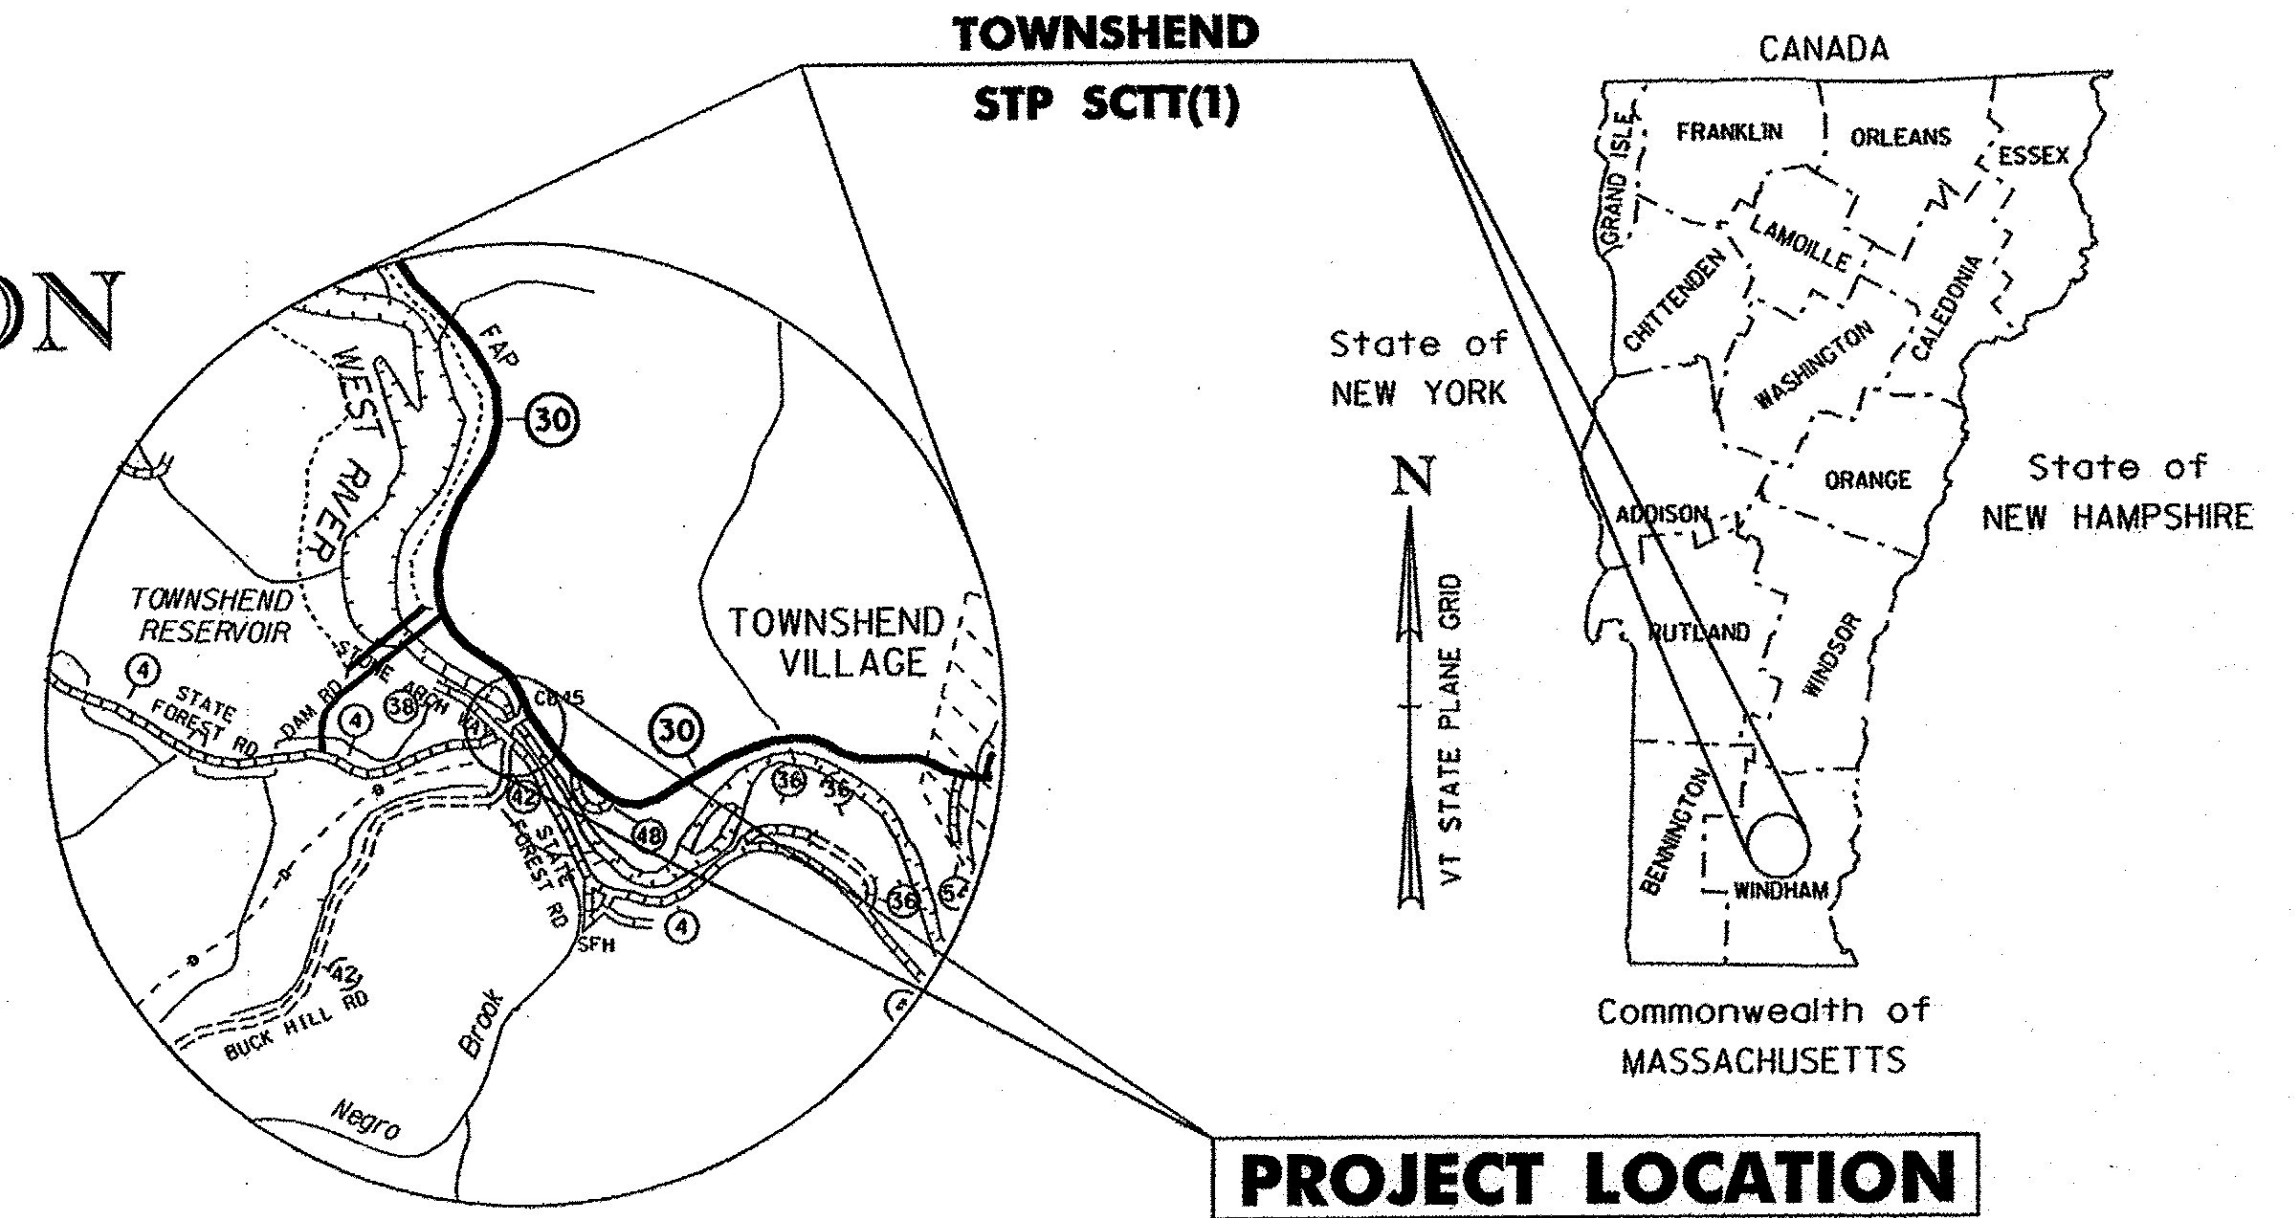


RECORD PLANS	
CONTRACTOR:	RENAUD BROTHERS, INC. - VERNON, VT
RESIDENT ENGINEER:	CHAD GREENWOOD
CONSTRUCTION BEGAN:	NOVEMBER 2, 2015
CONSTRUCTION COMPLETE:	MAY 17, 2017
RECORD PLANS BY:	CHAD GREENWOOD & AARON WEAVER
I HEREBY CERTIFY THAT ALL THE CONSTRUCTION REQUIRED BY THIS SET OF DRAWINGS HAS BEEN ACCOMPLISHED AS INDICATED HEREIN.	
BY	RESIDENT ENGINEER
DATE	7/17/18
NOTE: Any further information concerning final quantities, amounts or other details relative to this project may be found at Central Files in the electronic archives.	

**PROJECT LOCATION:** ADJACENT TO VT ROUTE 30 BEGINNING APPROXIMATELY 10 FEET EAST OF ITS INTERSECTION WITH TH-4 (CLASS 3) AND TH-38 (CLASS 3) AND EXTENDING EASTERLY FOR 331.18 FEET.

**PROJECT DESCRIPTION:** REHABILITATION OF BRIDGE NO. 45 INCLUDES REHABILITATION OF EXISTING TRUSSES, REPLACEMENT OF EXISTING DECK, REMOVAL AND DISPOSAL OF FAILED SUPPLEMENTAL ARCHES, REPLACEMENT OF SIDING AND METAL ROOFING AS WELL AS MINOR SUBSTRUCTURE AND APPROACH WORK.

LENGTH OF STRUCTURE: 276.35 FEET  
LENGTH OF ROADWAY: 54.83 FEET  
LENGTH OF PROJECT: 331.18 FEET

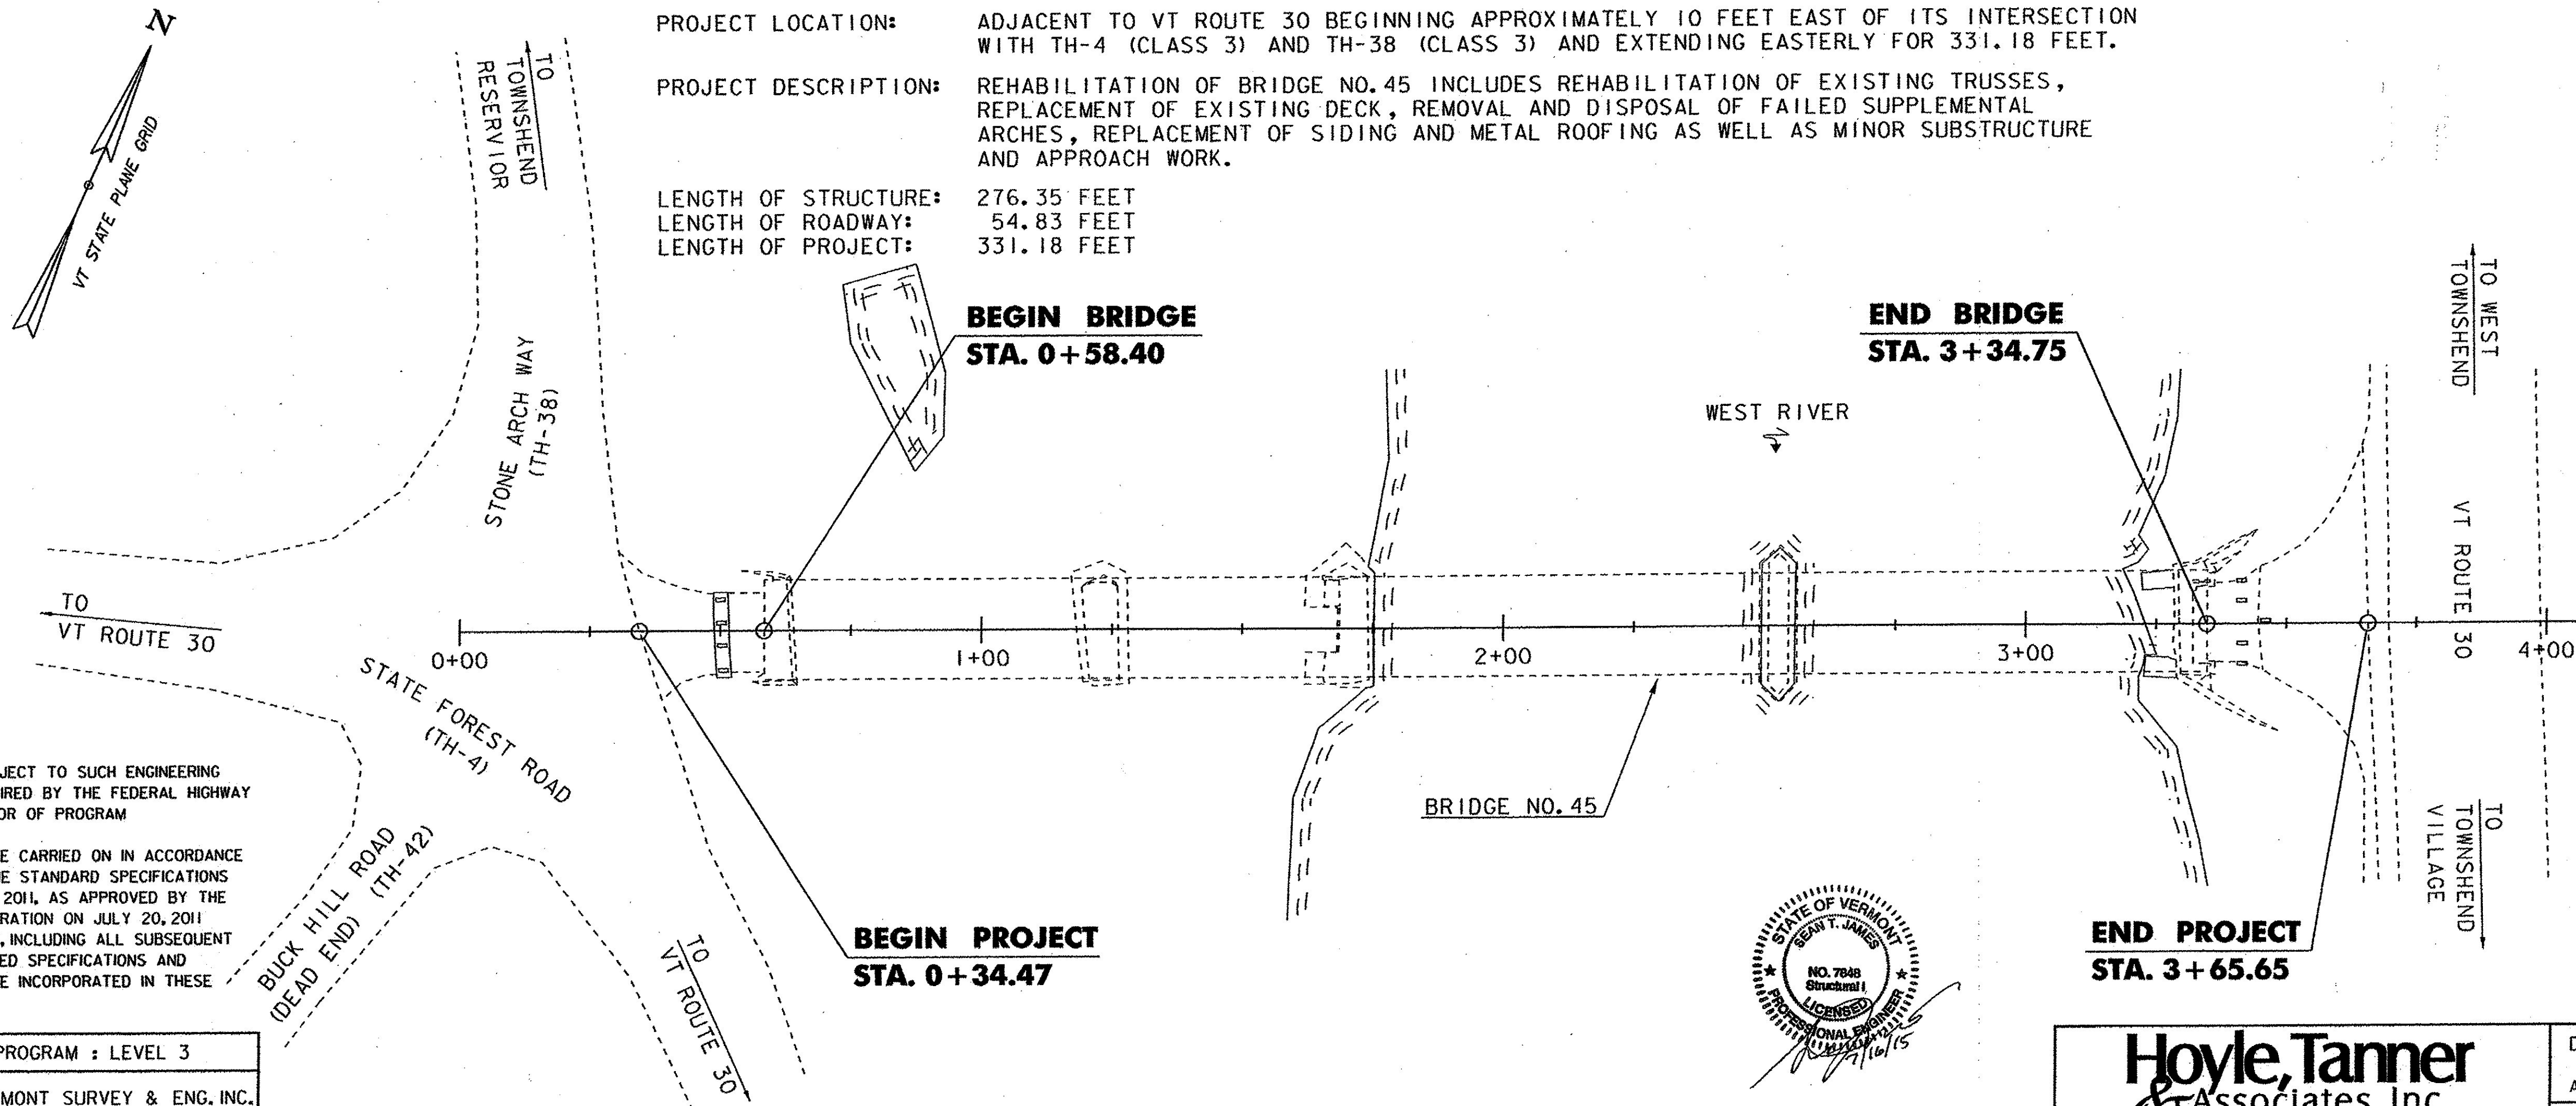


THESE PLANS ARE SUBJECT TO SUCH ENGINEERING CHANGES AS MAY BE REQUIRED BY THE FEDERAL HIGHWAY ADMINISTRATION OR DIRECTOR OF PROGRAM DEVELOPMENT.

CONSTRUCTION IS TO BE CARRIED ON IN ACCORDANCE WITH THESE PLANS AND THE STANDARD SPECIFICATIONS FOR CONSTRUCTION DATED 2011, AS APPROVED BY THE FEDERAL HIGHWAY ADMINISTRATION ON JULY 20, 2011 FOR USE ON THIS PROJECT, INCLUDING ALL SUBSEQUENT REVISIONS AND SUCH REVISED SPECIFICATIONS AND SPECIAL PROVISIONS AS ARE INCORPORATED IN THESE PLANS.

QUALITY ASSURANCE PROGRAM : LEVEL 3  
SURVEYED BY : VERMONT SURVEY & ENG. INC.  
SURVEYED DATE : 7-26-2012

DATUM  
VERTICAL NAVD 88 (GEO1D09)  
HORIZONTAL NAD 83 (CORS)

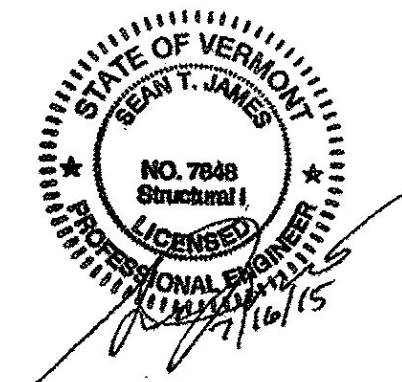

SCALE: 1" = 20' - 0"  
0 20 40

<b>Hoyle, Tanner &amp; Associates, Inc.</b> 125 College St., 4th Floor Burlington, VT 05401 Telephone: 802-860-1331 Fax: 802-860-6499 Web Page: www.hoyletanner.com		DIRECTOR OF PROJECT DELIVERY
		APPROVED  DATE 7/16/2015
HTA PROJECT NO.	MODEL	PROJECT MANAGER : M. D. SARGENT
904225	904225FSC	PROJECT NAME : TOWNSHEND PROJECT NUMBER : STP SCTT (1)
		SHEET 1 OF 60 SHEETS