


**EXISTING TYPICAL TOWN LATTICE BRIDGE SECTION
(LOOKING EAST)**
SCALE: 1/4" = 1'-0"

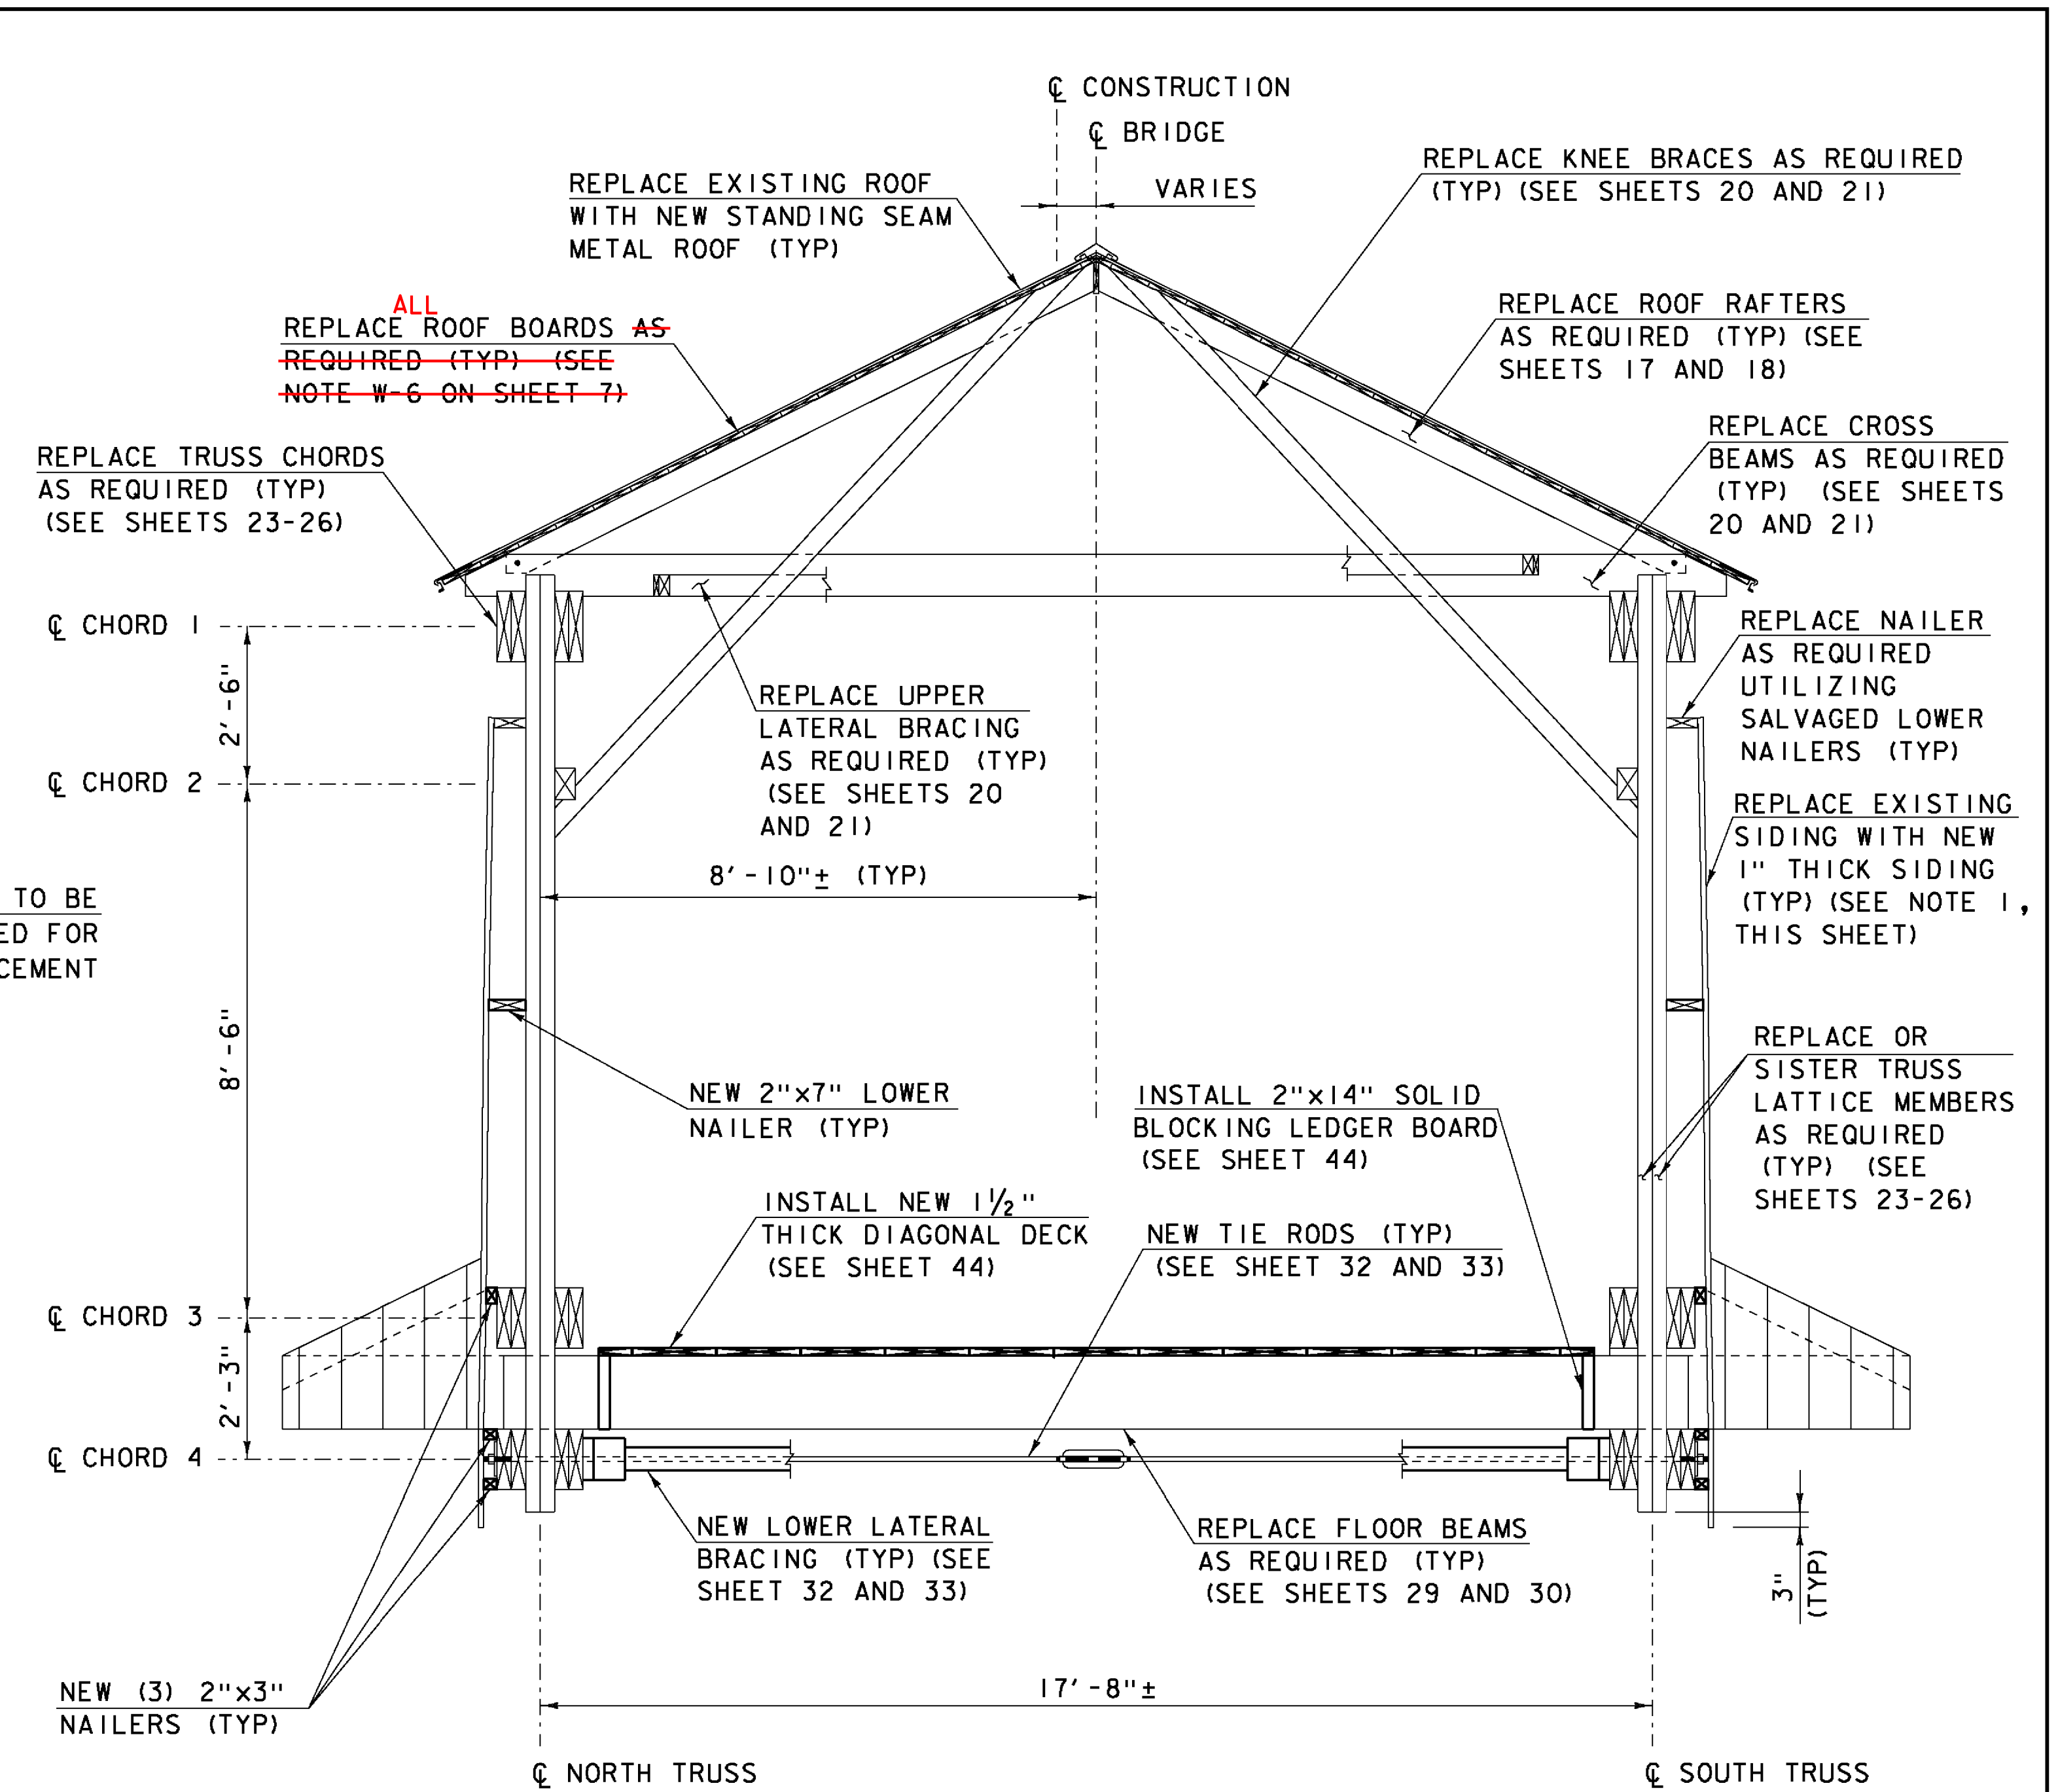

**PROPOSED TYPICAL TOWN LATTICE BRIDGE SECTION
(LOOKING EAST)**
SCALE: 1/4" = 1'-0"

DIMENSIONS OF TIMBER AND LUMBER MEMBERS SHOWN ON THE PLANS ARE THE ACTUAL SIZES UNLESS NOTED OTHERWISE.

NOTE
1. SEE SHEET 4 FOR NOTES THAT APPLY TO THIS SHEET.



HTA PROJECT	MODEL
904225	904225sup20

PROJECT NAME:	TOWNSHEND
PROJECT NUMBER:	STP SCTT(I)
FILE NAME:	904225sup20.dgn
PROJECT LEADER:	M.D.SARGENT
DESIGNED BY:	J.C.RIPLEY
EXIST. & PROP. TOWN LATTICE SECTIONS	
PLOT DATE:	8/13/2015
DRAWN BY:	T.A.GELINAS
CHECKED BY:	S.T.JAMES
SHEET	5 OF 60

8/13/2015 1:00:25 PM C:\Users\jcr\OneDrive\Documents\904225sup20.dgn