


WEST RIVER

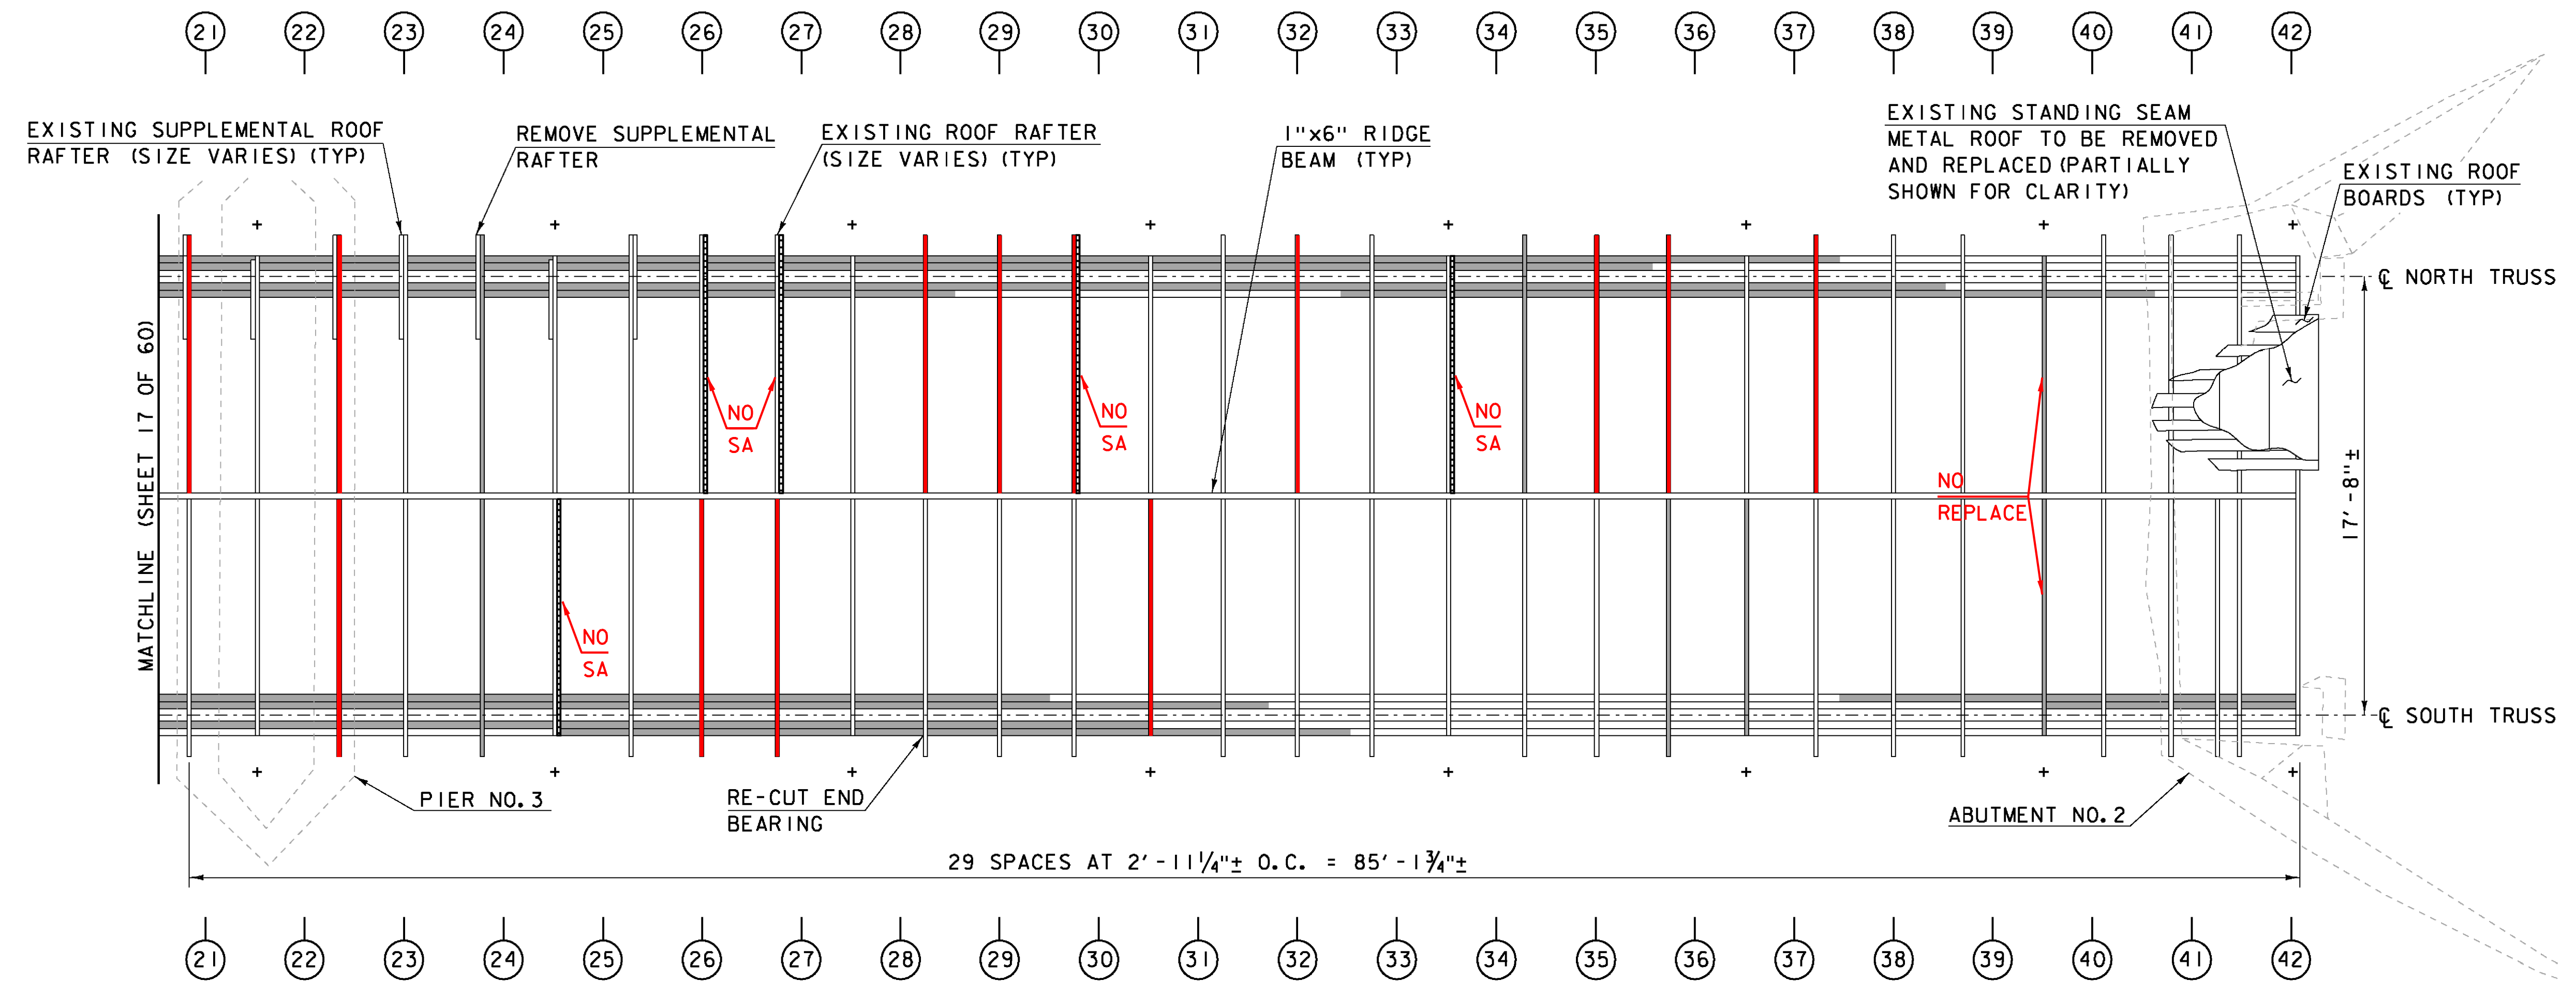

STATIONING
TOWN LATTICE ROOF FRAMING PLAN
 SCALE: 1/4" = 1'-0"

SA: SUPPLEMENTAL ADDED

LEGEND

- PREDETERMINED MEMBER TO BE REPLACED
- NEW SUPPLEMENTAL RAFTERS (SEE DETAIL ON SHEET 17)
- TRUSS NODE LOCATION
- APPROXIMATE LOCATION OF CROSS BEAM (NOT SHOWN FOR CLARITY)

NOTE

I. SEE SHEET 17 FOR DETAILS PERTAINING TO THIS SHEET.

8/13/2015 1:00:22 PM I:\04225\sup3\p\hoyle\hoyle\904225sup3.dgn



HTA PROJECT	MODEL
904225	904225sup3

PROJECT NAME:	TOWNSHEND
PROJECT NUMBER:	STP SCTT(I)
FILE NAME:	904225sup3.dgn
PROJECT LEADER:	M.D.SARGENT
DESIGNED BY:	J.C.RIPLEY
PLOT DATE:	8/13/2015
DRAWN BY:	T.A.GELINAS
CHECKED BY:	S.T.JAMES
ROOF FRAMING PLAN & DETAILS (3 OF 3)	
SHEET 18 OF 60	