


NOTE
 LOWER LATERAL BRACING AND DECK NOT SHOWN FOR CLARITY.
TOWN LATTICE FLOOR FRAMING PLAN
 SCALE: 1/4" = 1'-0"

LEGEND


- PREDETERMINED MEMBER TO BE REPLACED
- PREDETERMINED MEMBER TO BE REMOVED
- TRUSS NODE LOCATION
- REPLACE WITH NEW 17'-2" LONG FLOOR BEAM
- REPLACE WITH NEW 19'-2" LONG FLOOR BEAM

NOTES

1. ALL EXISTING TOWN LATTICE STRINGERS (NOT SHOWN FOR CLARITY) ARE TO BE REMOVED. STRINGERS ARE 4"x4" ON AVERAGE. REMOVAL AND DISPOSAL IS PAID UNDER ITEM 529.20, PARTIAL REMOVAL OF BRIDGE STRUCTURE.
2. ALL THROUGH BOLT HOLES IN CHORD 4 SHALL BE FILLED WITH A WOOD DOWEL ONCE DISTRIBUTION BEAMS ARE REMOVED. PAID UNDER ITEM 900.645, SPECIAL PROVISION (REHABILITATING COVERED BRIDGE SUPERSTRUCTURE).

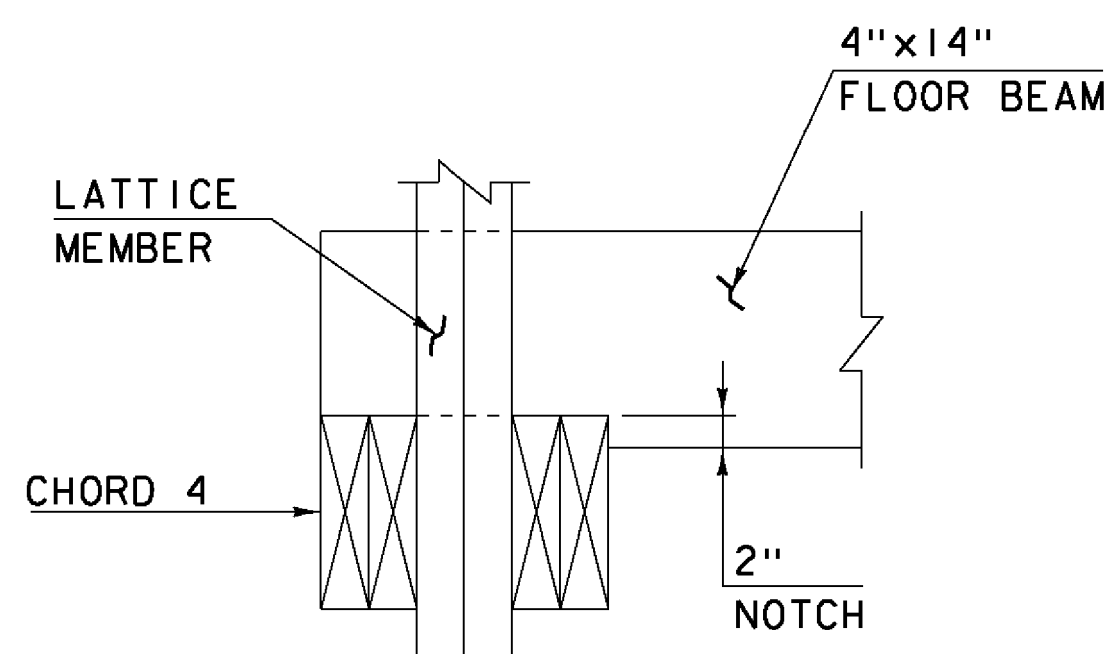

SECTION A-A
 SCALE: 1" = 1'-0"

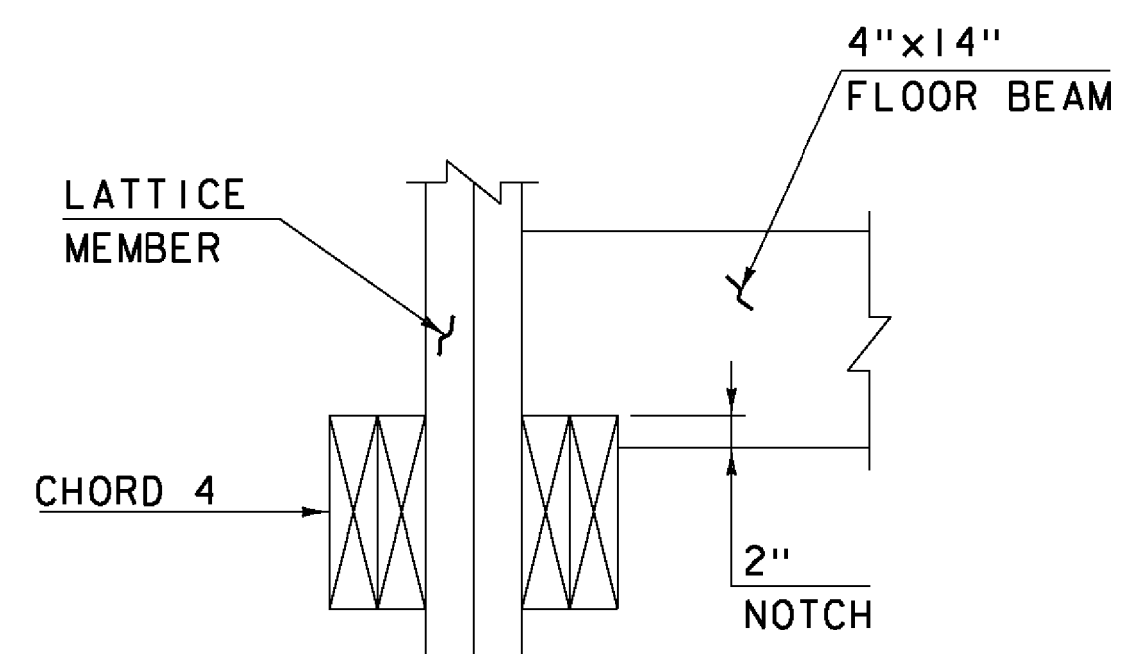

SECTION B-B
 SCALE: 1" = 1'-0"



HTA PROJECT	MODEL
904225	904225sup14

PROJECT NAME:	TOWNSHEND
PROJECT NUMBER:	STP SCTT(1)
FILE NAME:	904225sup14.dgn
PROJECT LEADER:	M.D.SARGENT
DESIGNED BY:	J.C.RIPLEY
PLOT DATE:	8/13/2015
DRAWN BY:	T.A.GELINAS
CHECKED BY:	S.T.JAMES
FLOOR FRAMING PLAN & DETAILS (2 OF 3) SHEET 29 OF 60	