


PLAN
SCALE: 3/8" = 1'-0"

NOTES

1. CONTRACTOR SHALL SAND BLAST ALL CONCRETE SURFACES TO REMOVE ALL EFFLORESCENCE AND GRAFFITI. PAYMENT WILL BE MADE UNDER ITEM 900.625, SPECIAL PROVISION (CONCRETE STAINING AND SEALING). SAND BLASTING SHALL BE COMPLETED PRIOR TO ANY CONCRETE OR CRACK REPAIR.
2. FOR NEW BEDDING TIMBERS, SEE SHEET 46.
3. ALL EXPOSED CONCRETE SURFACES SHALL BE STAINED TO PROVIDE A UNIFORM APPEARANCE AFTER CLEANING AND REPAIRING. PAYMENT WILL BE MADE UNDER ITEM 900.625, SPECIAL PROVISION (CONCRETE STAINING AND SEALING).

LEGEND

- LIMITS OF REPAIR OF CONCRETE SUBSTRUCTURE SURFACE, CLASS II
- ROUTE AND SEAL CRACKS (SEE CRACK SEAL DETAIL ON SHEET 46)

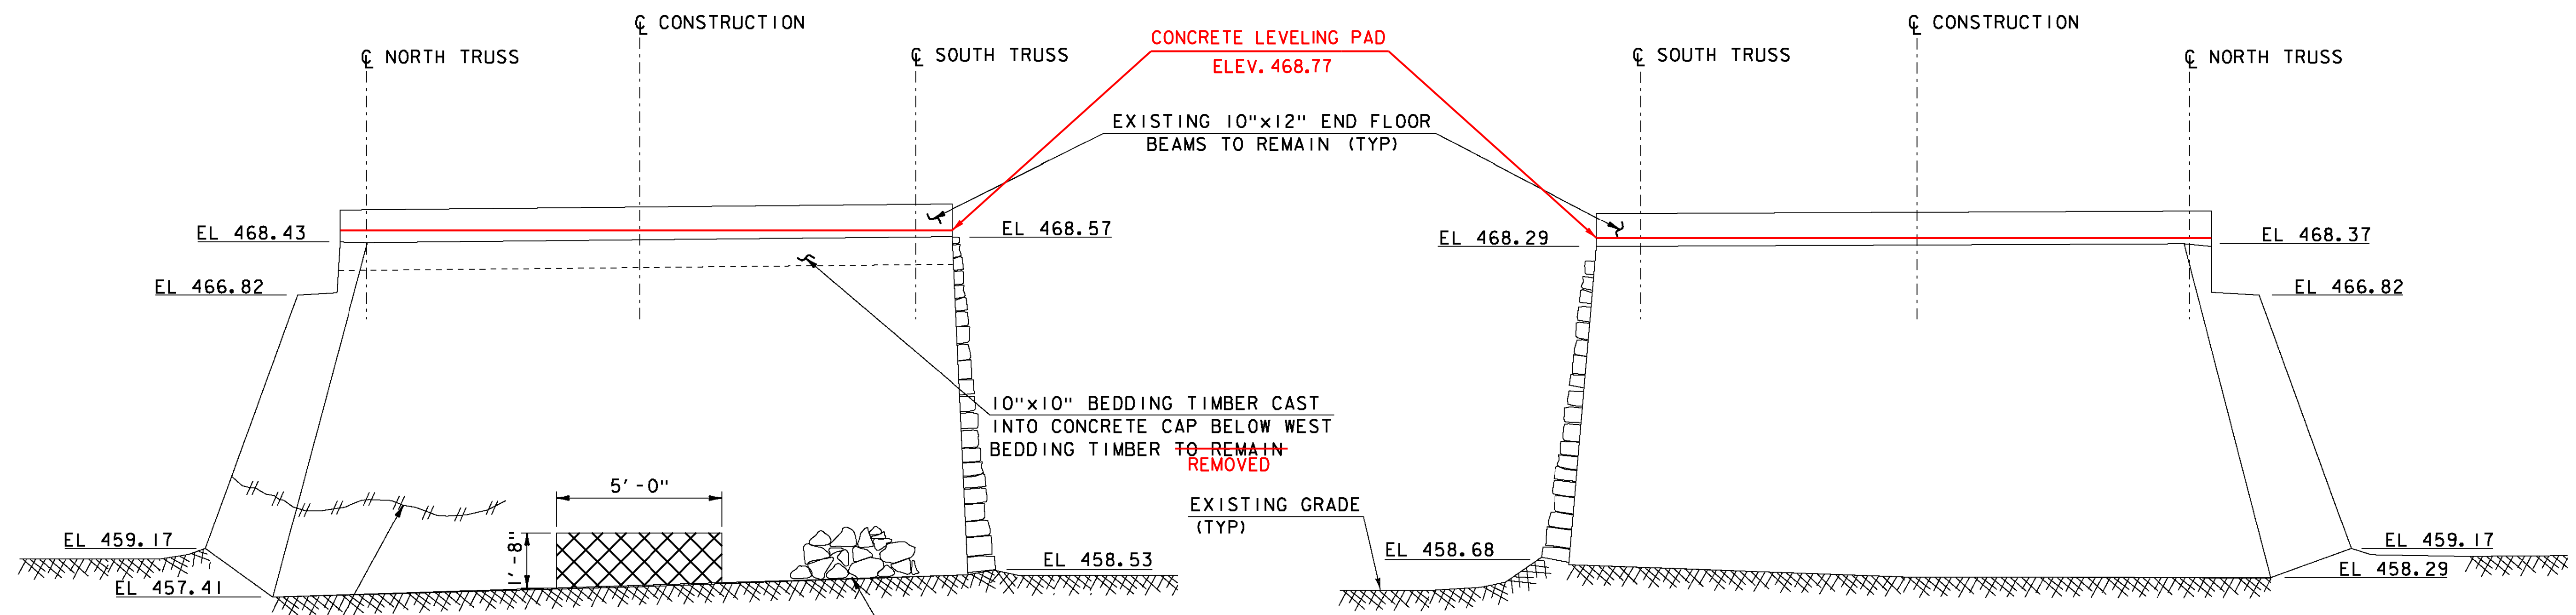

WEST ELEVATION
(LOOKING EAST)
SCALE: 3/8" = 1'-0"

EAST ELEVATION
(LOOKING WEST)
SCALE: 3/8" = 1'-0"

ROUTE AND SEAL ALL CRACKS IN CONCRETE (TYP) (SEE CRACK SEAL DETAIL ON SHEET 46)

REMOVE STONE AND EXISTING SOIL



HTA PROJECT	MODEL
904225	904225sub3

PROJECT NAME:	TOWNSHEND
PROJECT NUMBER:	STP SCTT(I)
FILE NAME:	904225sub3.dgn
PROJECT LEADER:	M.D.SARGENT
DESIGNED BY:	J.C.RIPLEY
PIER NO. 1 PLAN & ELEVATION	
PLOT DATE:	8/13/2015
DRAWN BY:	T.A.CELINAS
CHECKED BY:	S.T.JAMES
SHEET	38 OF 60

8/13/2015 11:00:25am k:\04225sub3\p1\ta\holetanner\904225sub3.dgn