

GOULD, LARRY C
PO BOX 181
TOWNSHEND, VT 05353-0181
BOOK 62 PAGE 141
PARCEL ID# 08033-000

SOIL INFORMATION
ONDAWA FINE SANDY LOAM
0% TO 3% SLOPES
K = 0.14 - TO 14.17 IN/HR
HYDRAULIC SOIL GROUP: B
DEPTH TO BEDROCK: >80"
DEPTH TO WATER TABLE: >80"
OCCASIONALLY FLOODED

GOULD, LARRY C
PO BOX 181
TOWNSHEND, VT 05353-0181
BOOK 62 PAGE 141
PARCEL ID# 08033-000


FIRST TENNESSEE BANK
NATIONAL ASSOCIATION
165 MADISON AVE
MEMPHIS, TN 38103
BOOK 106 PAGE 208
PARCEL ID# 09078-300

FIRST TENNESSEE BANK
NATIONAL ASSOCIATION
165 MADISON AVE
MEMPHIS, TN 38103
BOOK 106 PAGE 208
PARCEL ID# 09078-300

UNITED STATES OF AMERICA
696 VIRGINIA ROAD
CONCORD, MA 01742-2751
BOOK 36 PAGE 261
PARCEL ID# 08003-000

SOIL INFORMATION
ONDAWA FINE SANDY LOAM
0% TO 3% SLOPES
K = 0.14 TO 14.17 IN/HR
HYDRAULIC SOIL GROUP: B
DEPTH TO BEDROCK: >80"
DEPTH TO WATER TABLE: >80"
OCCASIONALLY FLOODED

SOIL INFORMATION
RAWSONVILLE - HOGBACK
FINE SANDY LOAMS
25% TO 50% SLOPES, ROCKY
K = 0.01 TO 6.00 IN/HR
HYDRAULIC SOIL GROUP: C
DEPTH TO BEDROCK: 20"-40"
DEPTH TO WATER TABLE: >80"

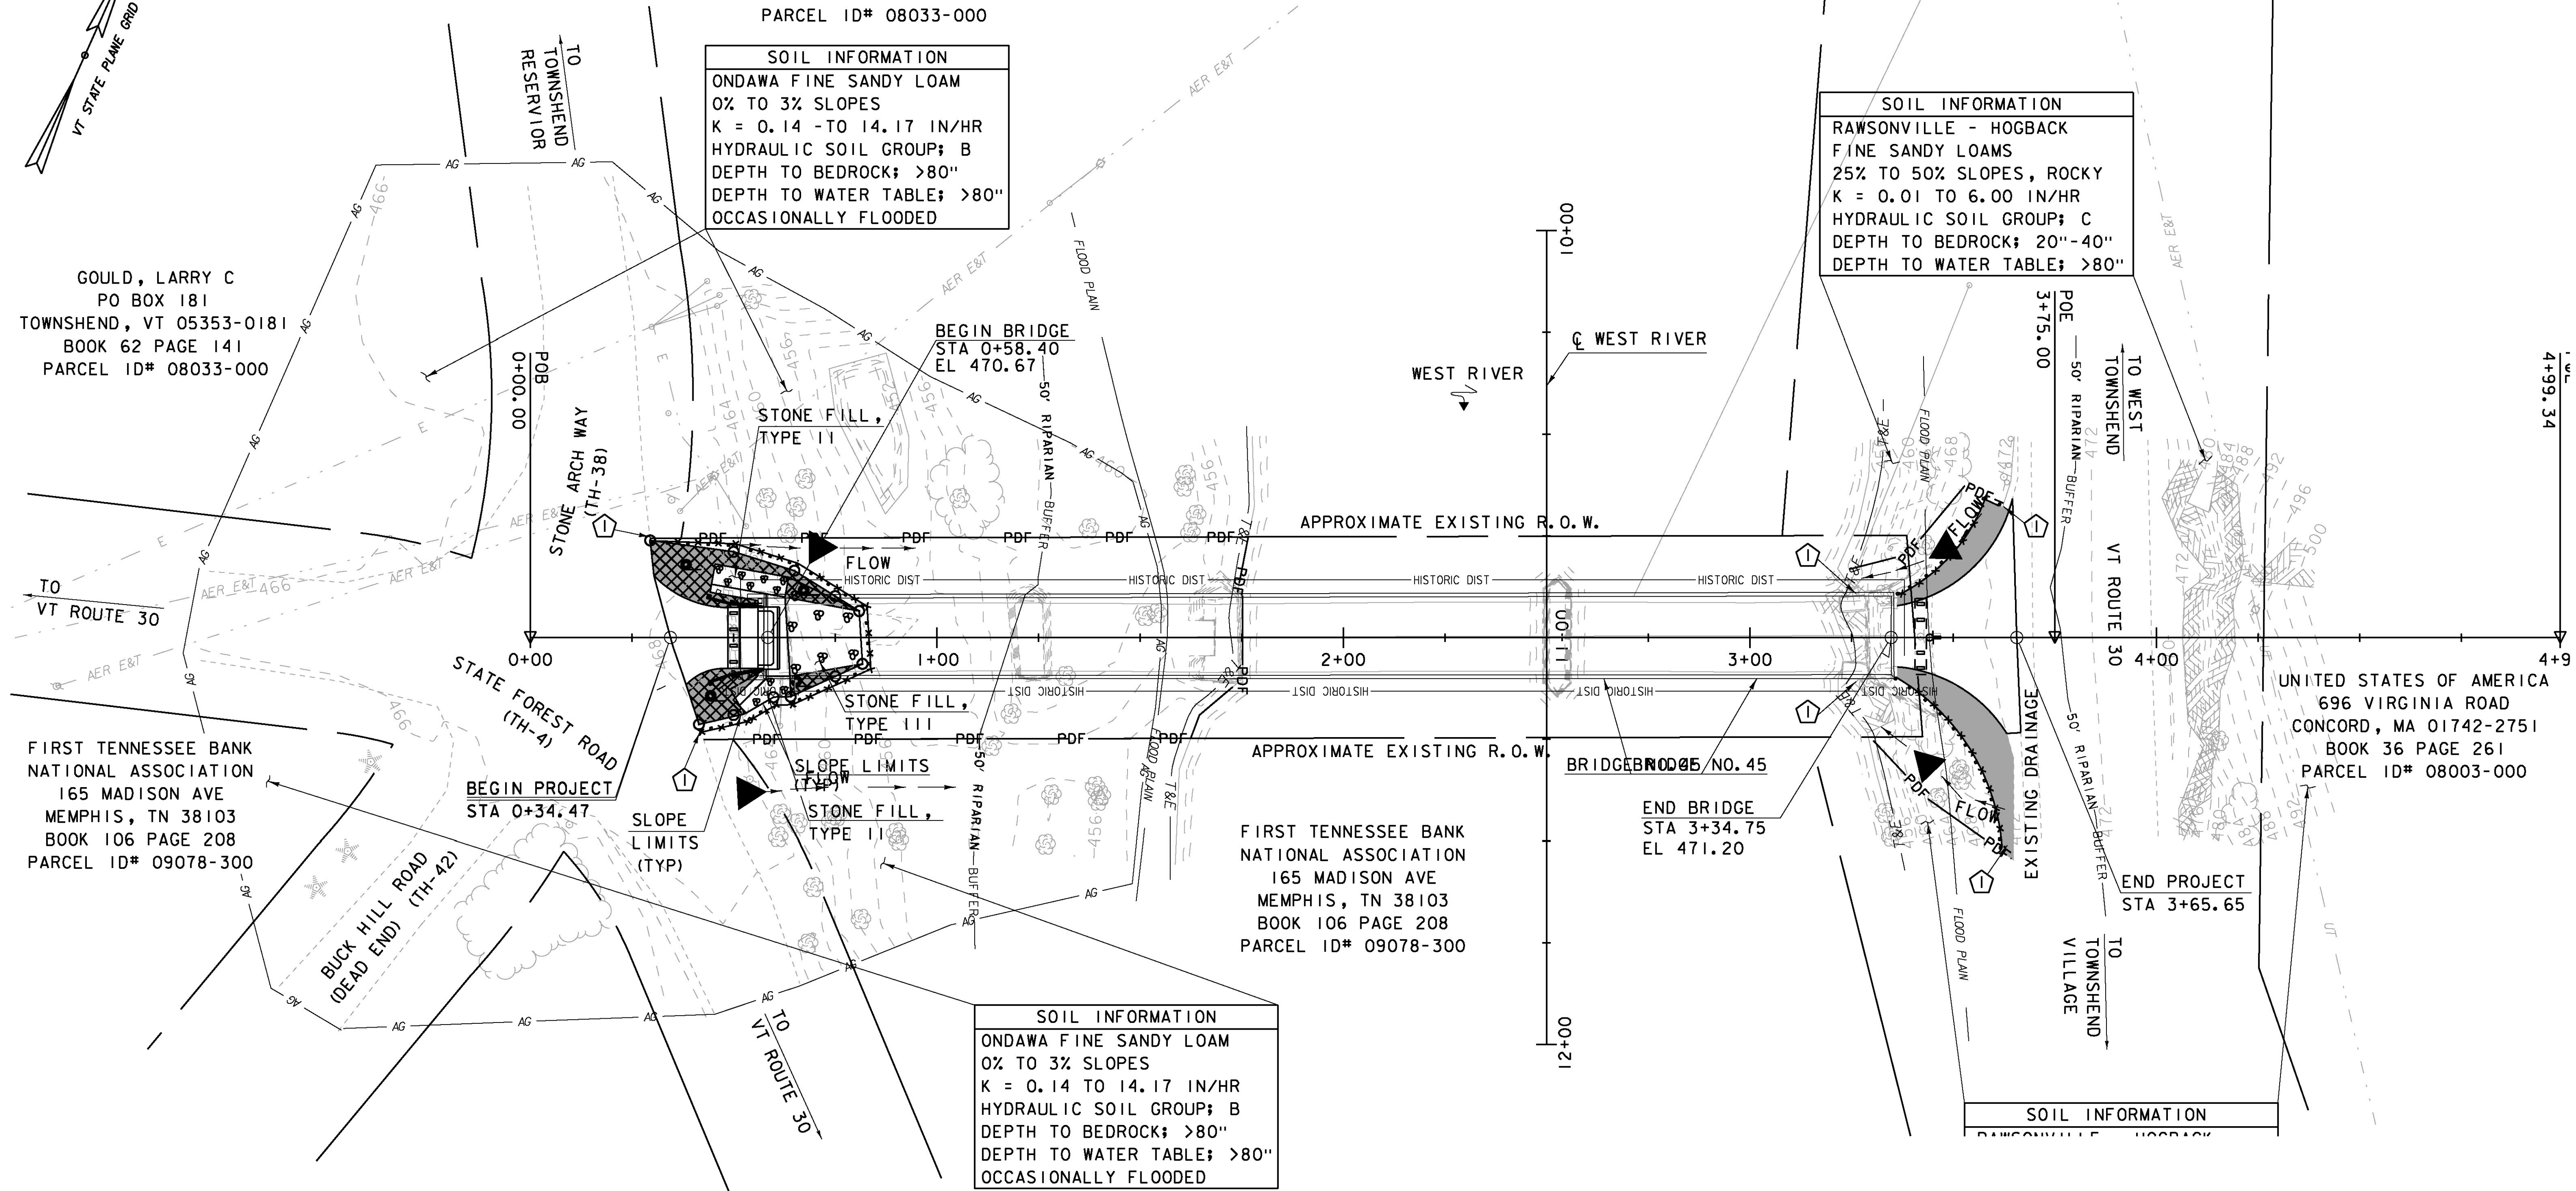

CONTOURS SELECT EXISTING CONDITIONS,
SEE CROSS SECTIONS FOR FINAL GRADING.

LEGEND

- DENOTES DISTURBED AREAS REQUIRING RE-VEGETATION. USE 4" OF TOPSOIL, HAY MULCH AND SEED
- TEMPORARY EROSION CONTROL MATTING
- STONE FILL

DATUM	
VERTICAL	NAVD 88(GEIOD09) FT
HORIZONTAL	NAD 83(CORS) sFT
ADJUSTMENT	LSQ

SCALE: 1" = 20'-0"
20 0 20

Hoyle, Tanner & Associates, Inc.

HTA PROJECT	MODEL
904225	904225er04

PROJECT NAME:	TOWNSHEND	PLOT DATE:	8/13/2015
PROJECT NUMBER:	STP SCTT(I)	DRAWN BY:	T.A.GELINAS
FILE NAME:	904225er04.dgn	DESIGNED BY:	J.C.RIPLEY
PROJECT LEADER:	M.D.SARGENT	CHECKED BY:	S.T.JAMES
EPSC FINAL SITE PLAN		SHEET 58 OF 60	

8/13/2015 10:56:42 AM C:\Users\mtd\Documents\904225er04.dgn