



SEE SHEET 7 FOR
INDEX OF SHEETS AND
LIST OF STANDARDS

STATE OF VERMONT AGENCY OF TRANSPORTATION

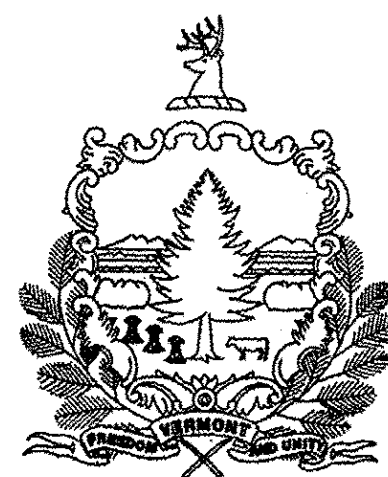


PROPOSED IMPROVEMENT BRIDGE PROJECT

TOWN OF FAIRFIELD
COUNTY OF FRANKLIN

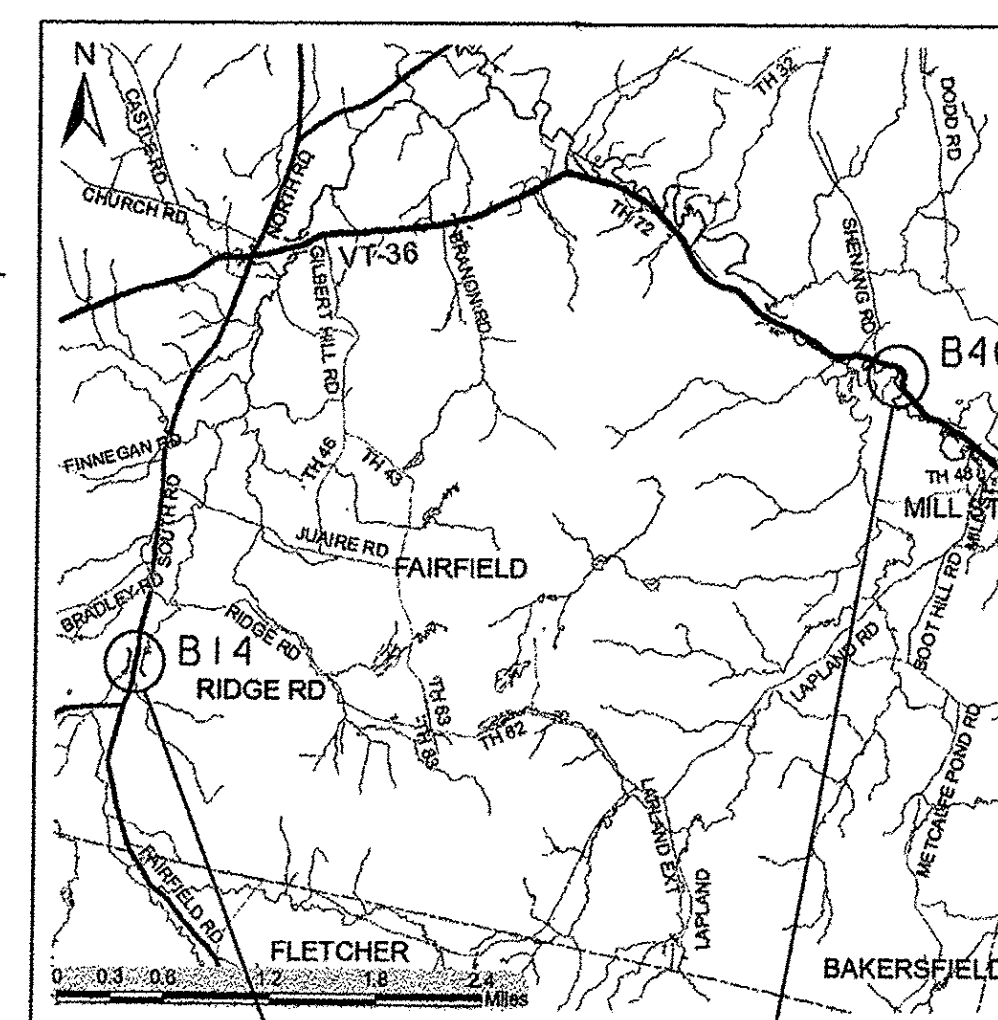

FAIRFIELD
BRF 0281 (25)

FAIRFIELD
BRO 1448 (41)

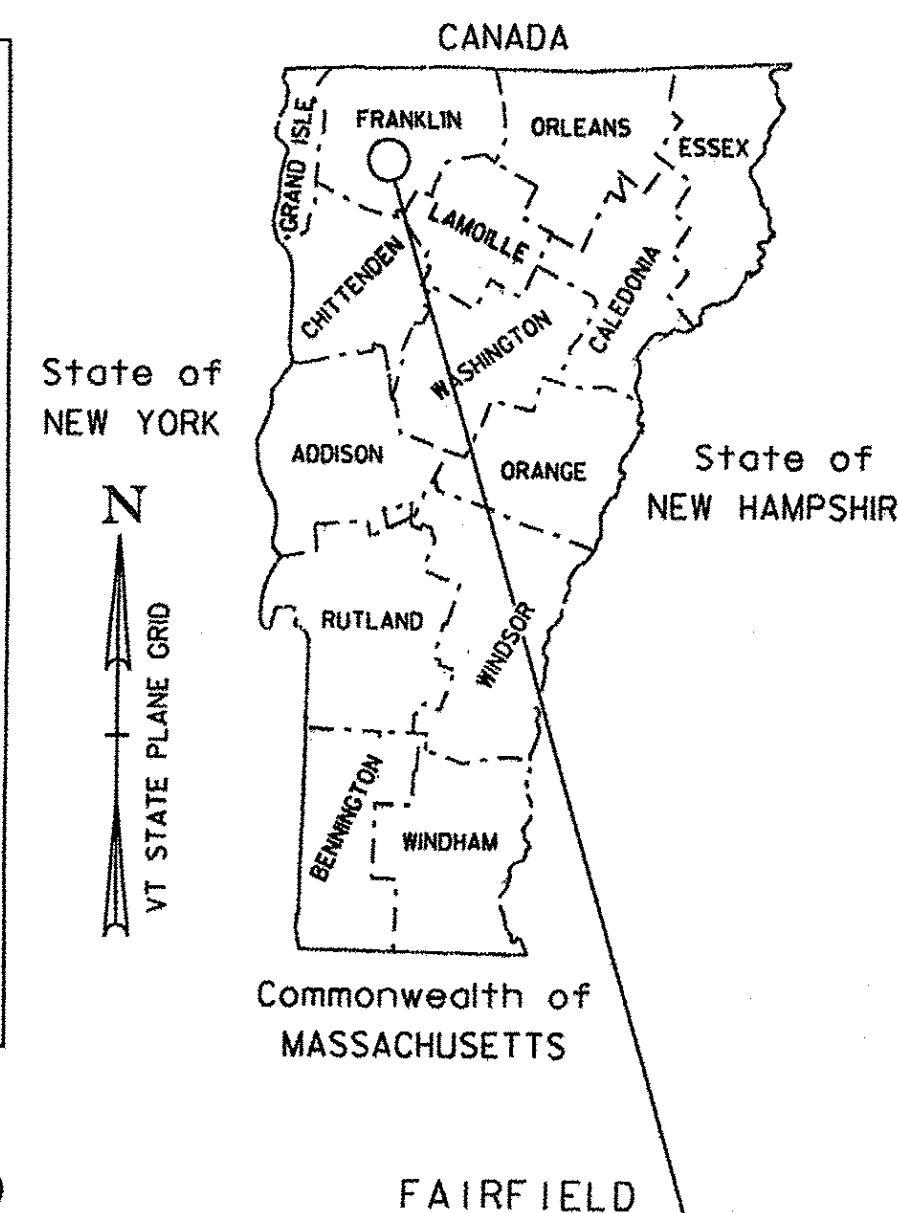


RECORD PLANS	
CONTRACTOR:	A.L. ST. ONGE CONTRACTOR, INC. - MONTGOMERY, VT
RESIDENT ENGINEER:	SCOTT WHEATLEY
CONSTRUCTION BEGAN:	MAY 26, 2015
CONSTRUCTION COMPLETE:	AUGUST 14, 2015
RECORD PLANS BY:	SCOTT WHEATLEY & CRAIG PIERCE
I HEREBY CERTIFY THAT ALL THE CONSTRUCTION REQUIRED BY THIS SET OF DRAWINGS HAS BEEN ACCOMPLISHED AS INDICATED HEREIN.	
BY:	<i>[Signature]</i> RESIDENT ENGINEER
DATE:	JUNE 2, 2016
NOTE: Any further information concerning final quantities, amounts or other details relative to this project may be found at Central Files in the electronic archives.	

FAIRFIELD BRF 0281 (25)

ROUTE NO.: SOUTH ROAD, FAS 0281 (RURAL MAJOR COLLECTOR), CLASS 2 TOWN HIGHWAY
BRIDGE NO.: 14
PROJECT LOCATION: ON TH 1 (FAS 0281), APPROXIMATELY 2.5 MILES SOUTH OF ITS JUNCTION WITH VT 36.
PROJECT DESCRIPTION: REPLACEMENT OF EXISTING BRIDGE (BRIDGE NO. 14) WITH RELATED ROADWAY APPROACH AND CHANNEL WORK.

LENGTH OF STRUCTURE: 44.00 FEET
LENGTH OF ROADWAY: 131.00 FEET
LENGTH OF PROJECT: 175.00 FEET

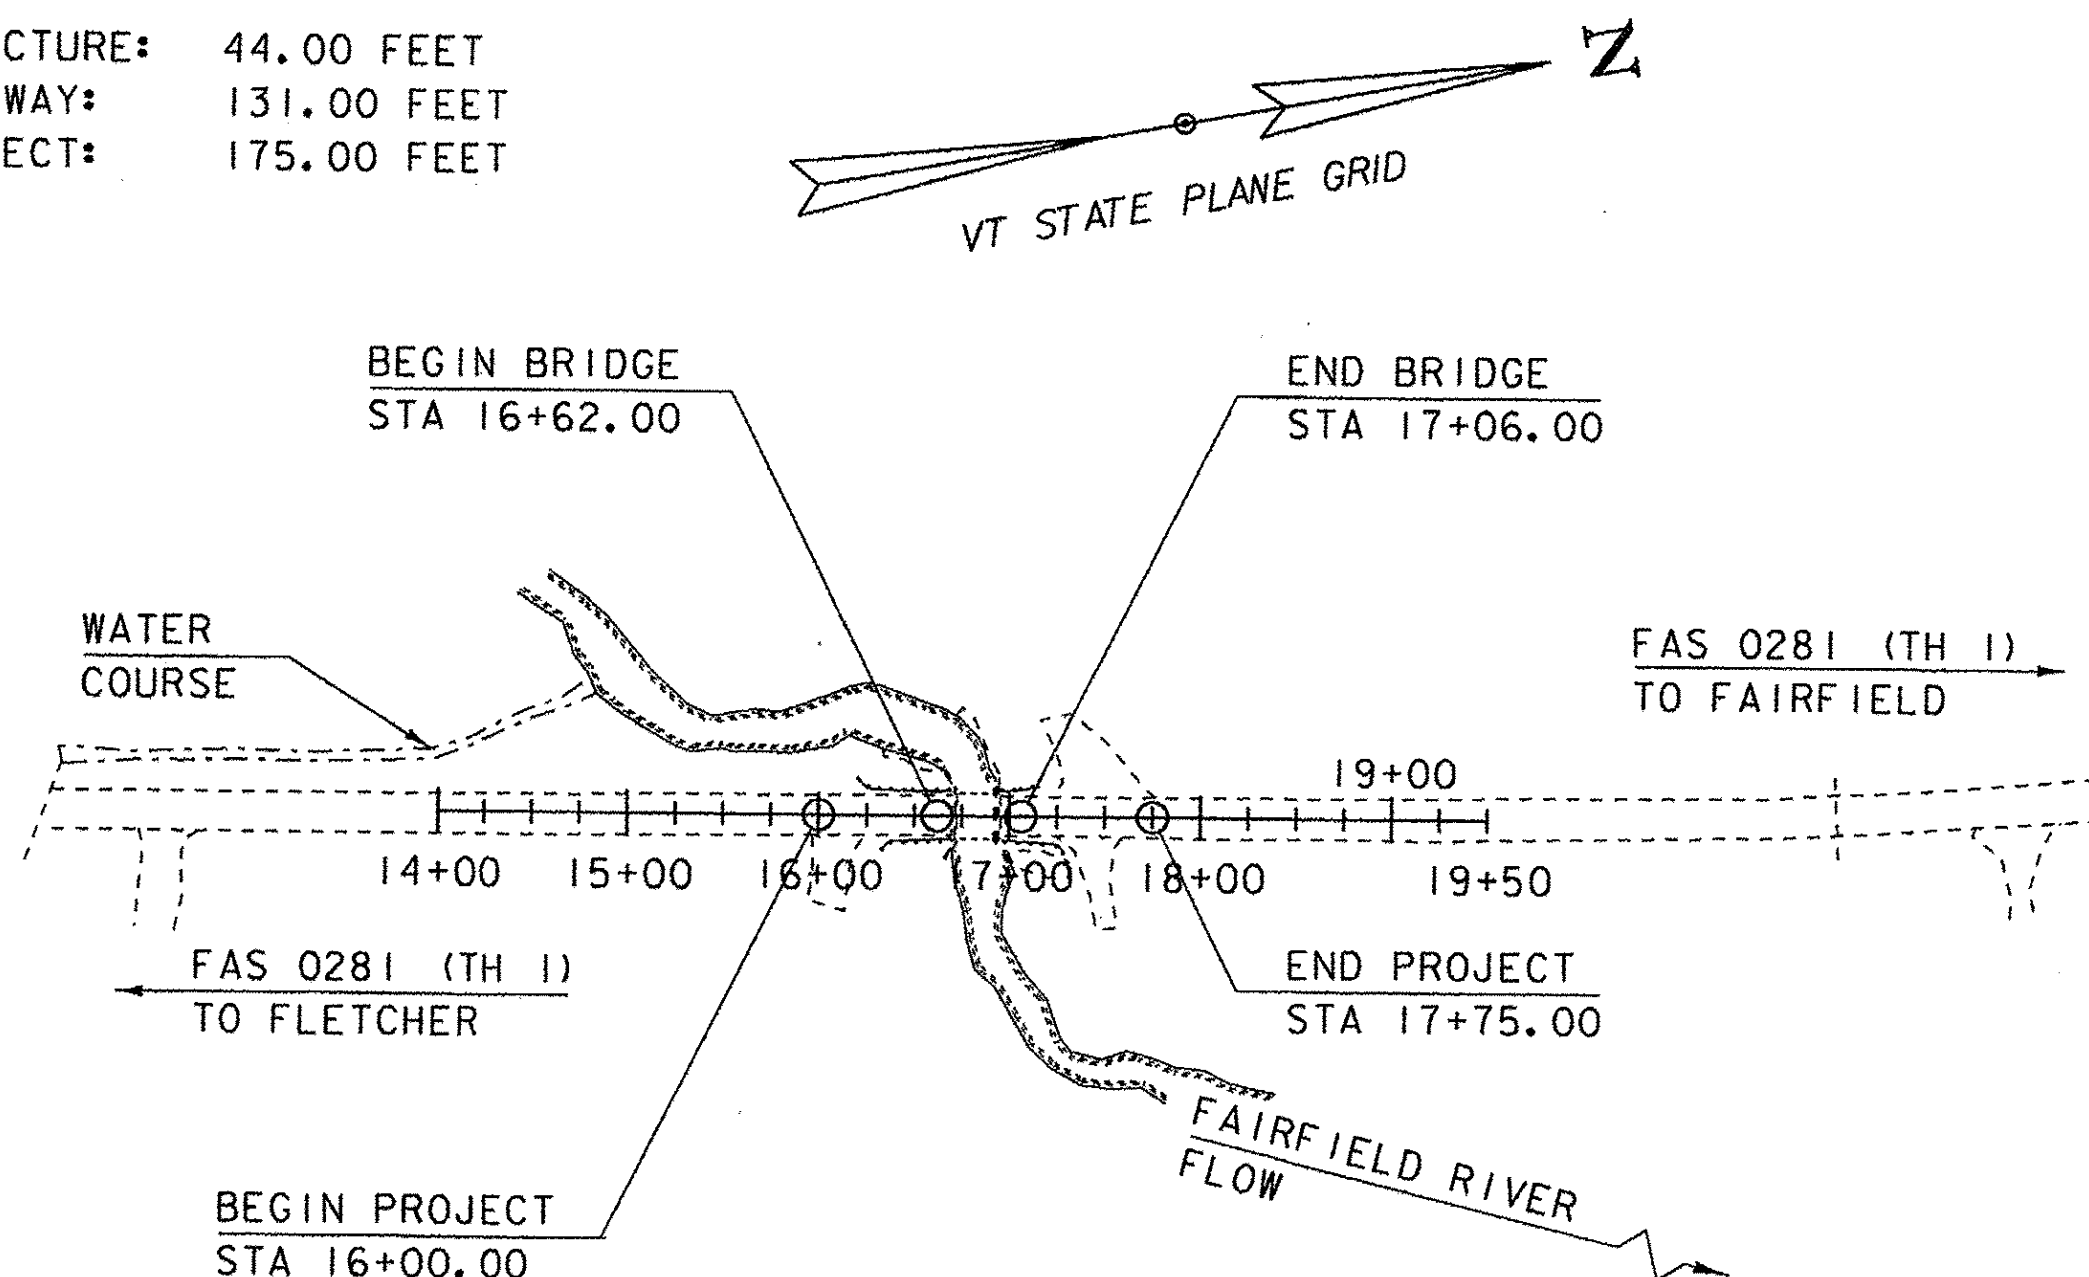

CONSTRUCTION IS TO BE CARRIED ON IN ACCORDANCE WITH THESE PLANS AND THE STANDARD SPECIFICATIONS FOR CONSTRUCTION DATED 2011, AS APPROVED BY THE FEDERAL HIGHWAY ADMINISTRATION ON JULY 20, 2011 FOR USE ON THIS PROJECT, INCLUDING ALL SUBSEQUENT REVISIONS AND SUCH REVISED SPECIFICATIONS AND SPECIAL PROVISIONS AS ARE INCORPORATED IN THESE PLANS.


QUALITY ASSURANCE PROGRAM : LEVEL 2	
SURVEYED BY :	L. ORVIS
SURVEYED DATE :	3/25/12 & 3/11/12
DATUM	
VERTICAL	NAVD88
HORIZONTAL	NAD (83) 2007

SCALE 1" = 100'-0"
50 0 50

FAIRFIELD BRO 1448 (41)

ROUTE NO.: ELM BROOK ROAD, TOWN HIGHWAY 47 (CLASS 3)
BRIDGE NO.: 46
PROJECT LOCATION: 0.05 MILES WESTERLY OF THE JUNCTION OF TOWN HIGHWAY 47 AND VT ROUTE 36.
PROJECT DESCRIPTION: REPLACEMENT OF EXISTING BRIDGE (BRIDGE NO. 46) WITH RELATED ROADWAY APPROACH AND CHANNEL WORK.

LENGTH OF STRUCTURE: 54.00 FEET
LENGTH OF ROADWAY: 21.00 FEET
LENGTH OF PROJECT: 75.00 FEET

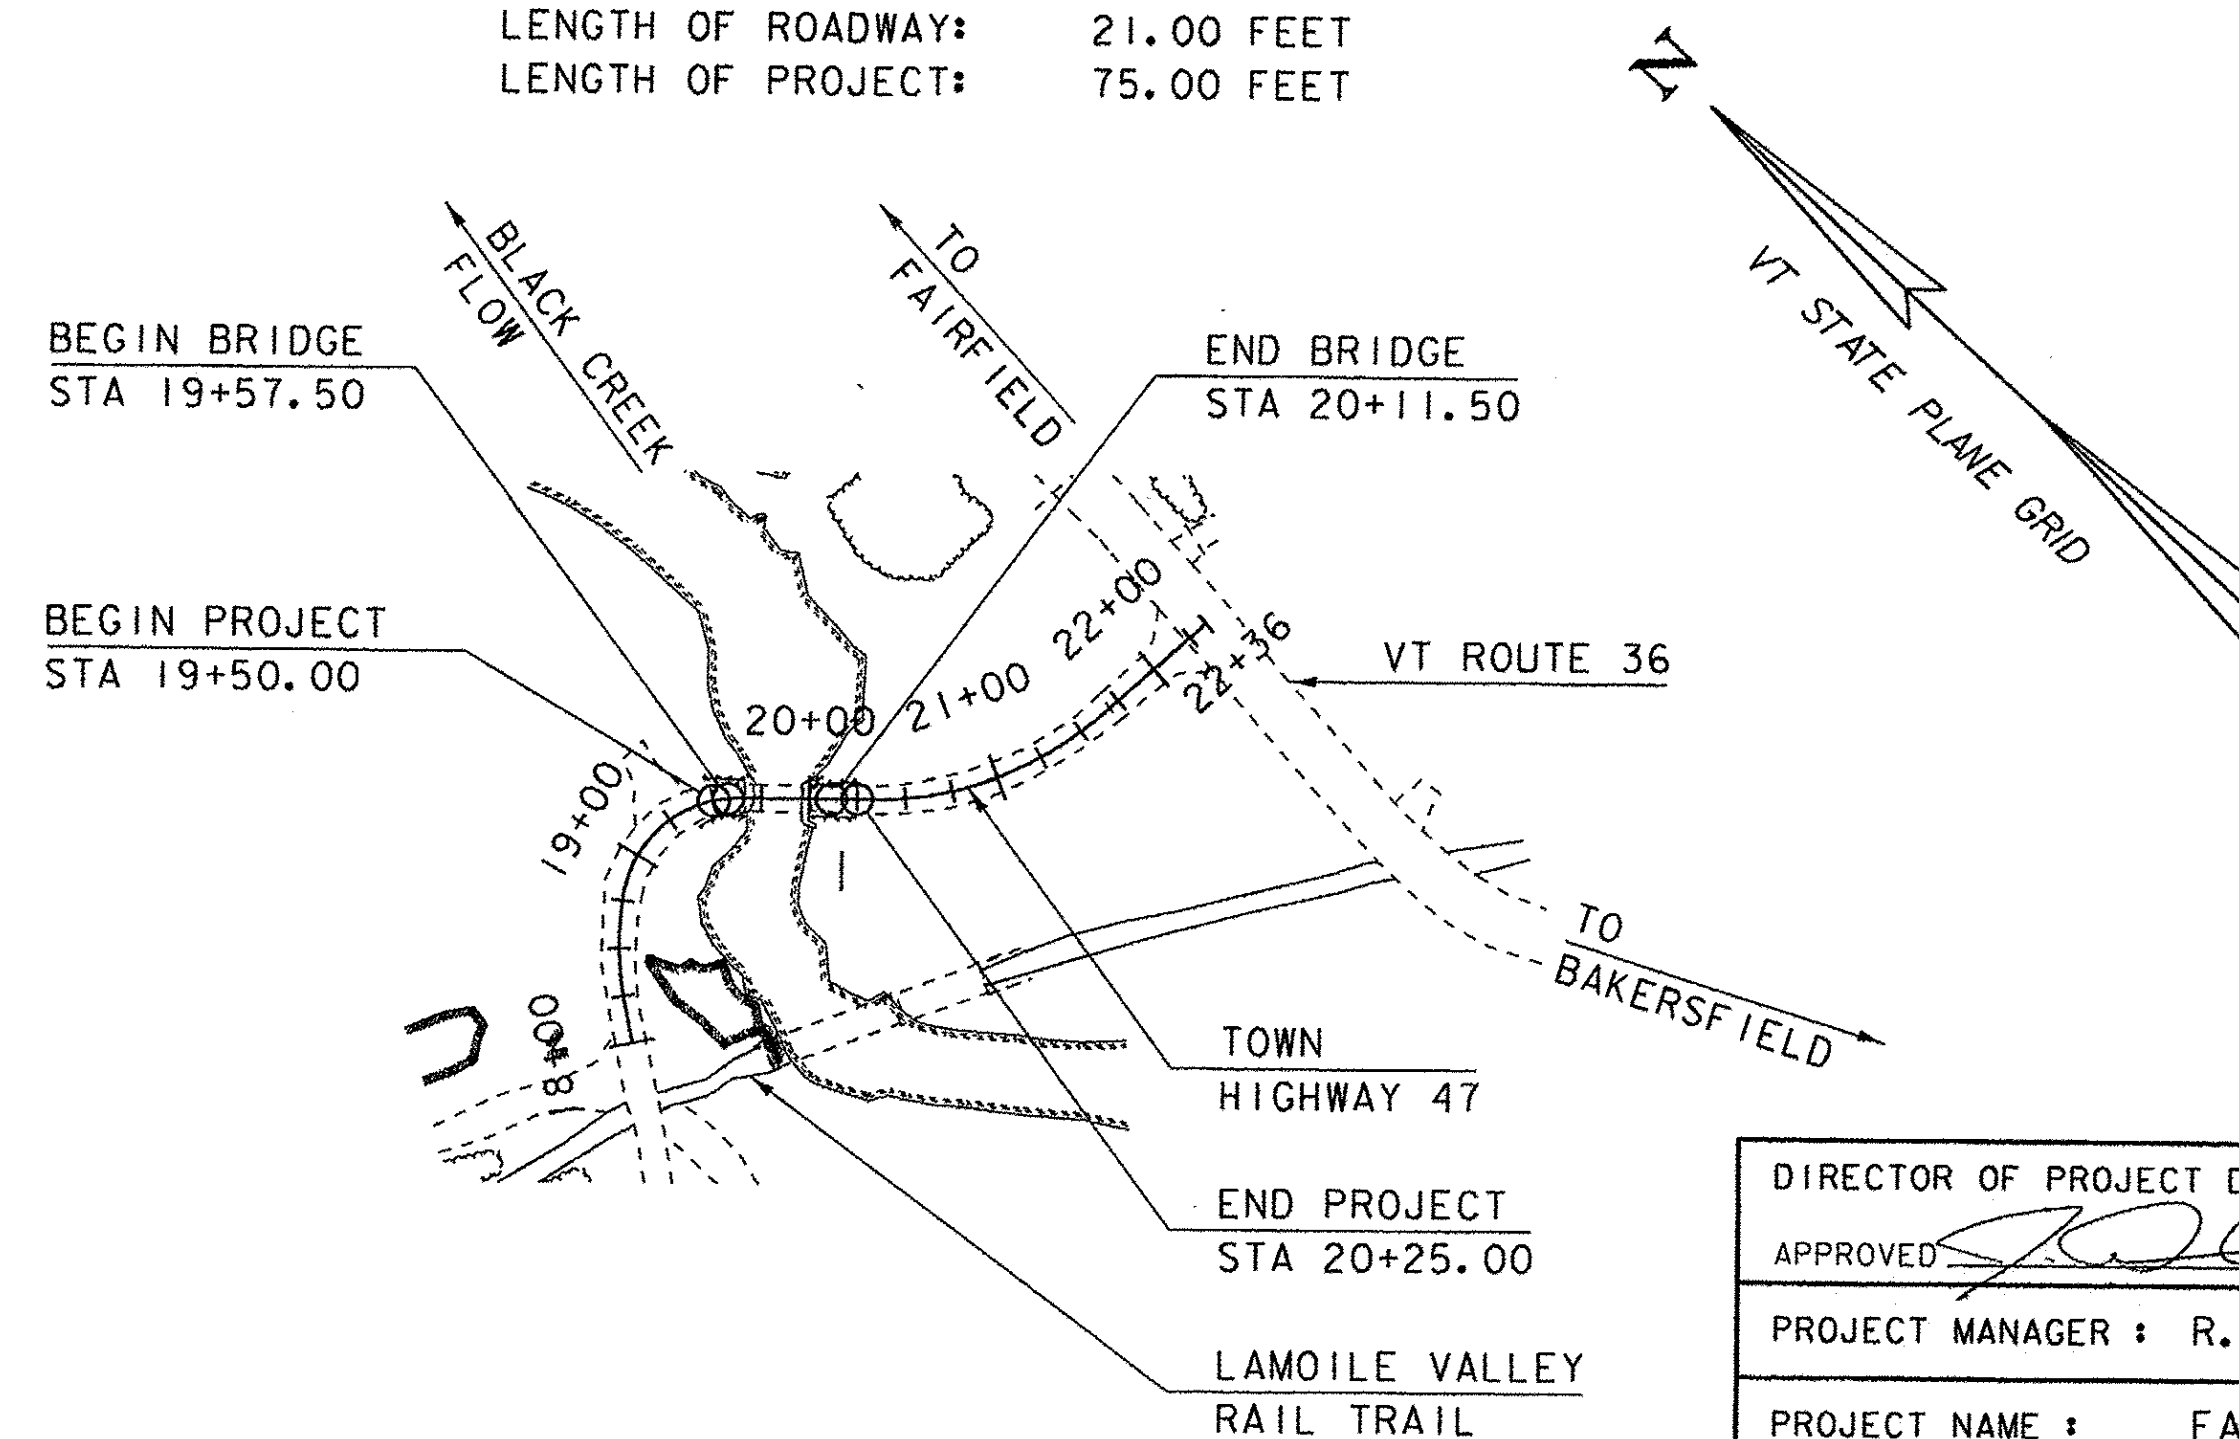

DIRECTOR OF PROJECT DELIVERY	
APPROVED:	<i>[Signature]</i> DATE 8/18/2014
PROJECT MANAGER : R. YOUNG, P.E.	
PROJECT NAME : FAIRFIELD	
PROJECT NUMBER : BRF 0281 (25) & BRO 1448 (41)	
SHEET 1 OF 69 SHEETS	