


ROADWAY TYPICAL SECTION
SCALE $\frac{3}{8}'' = 1' - 0''$

- * $1\frac{1}{2}''$ SUPERPAVE BITUMINOUS CONCRETE PAVEMENT TYPE IVS, OVER
- $1\frac{1}{2}''$ SUPERPAVE BITUMINOUS CONCRETE PAVEMENT TYPE IVS, OVER
- 2" SUPERPAVE BITUMINOUS CONCRETE PAVEMENT ~~TYPE IIS~~ TYPE IIIS AS PER W0*3 (5-14-15) STW

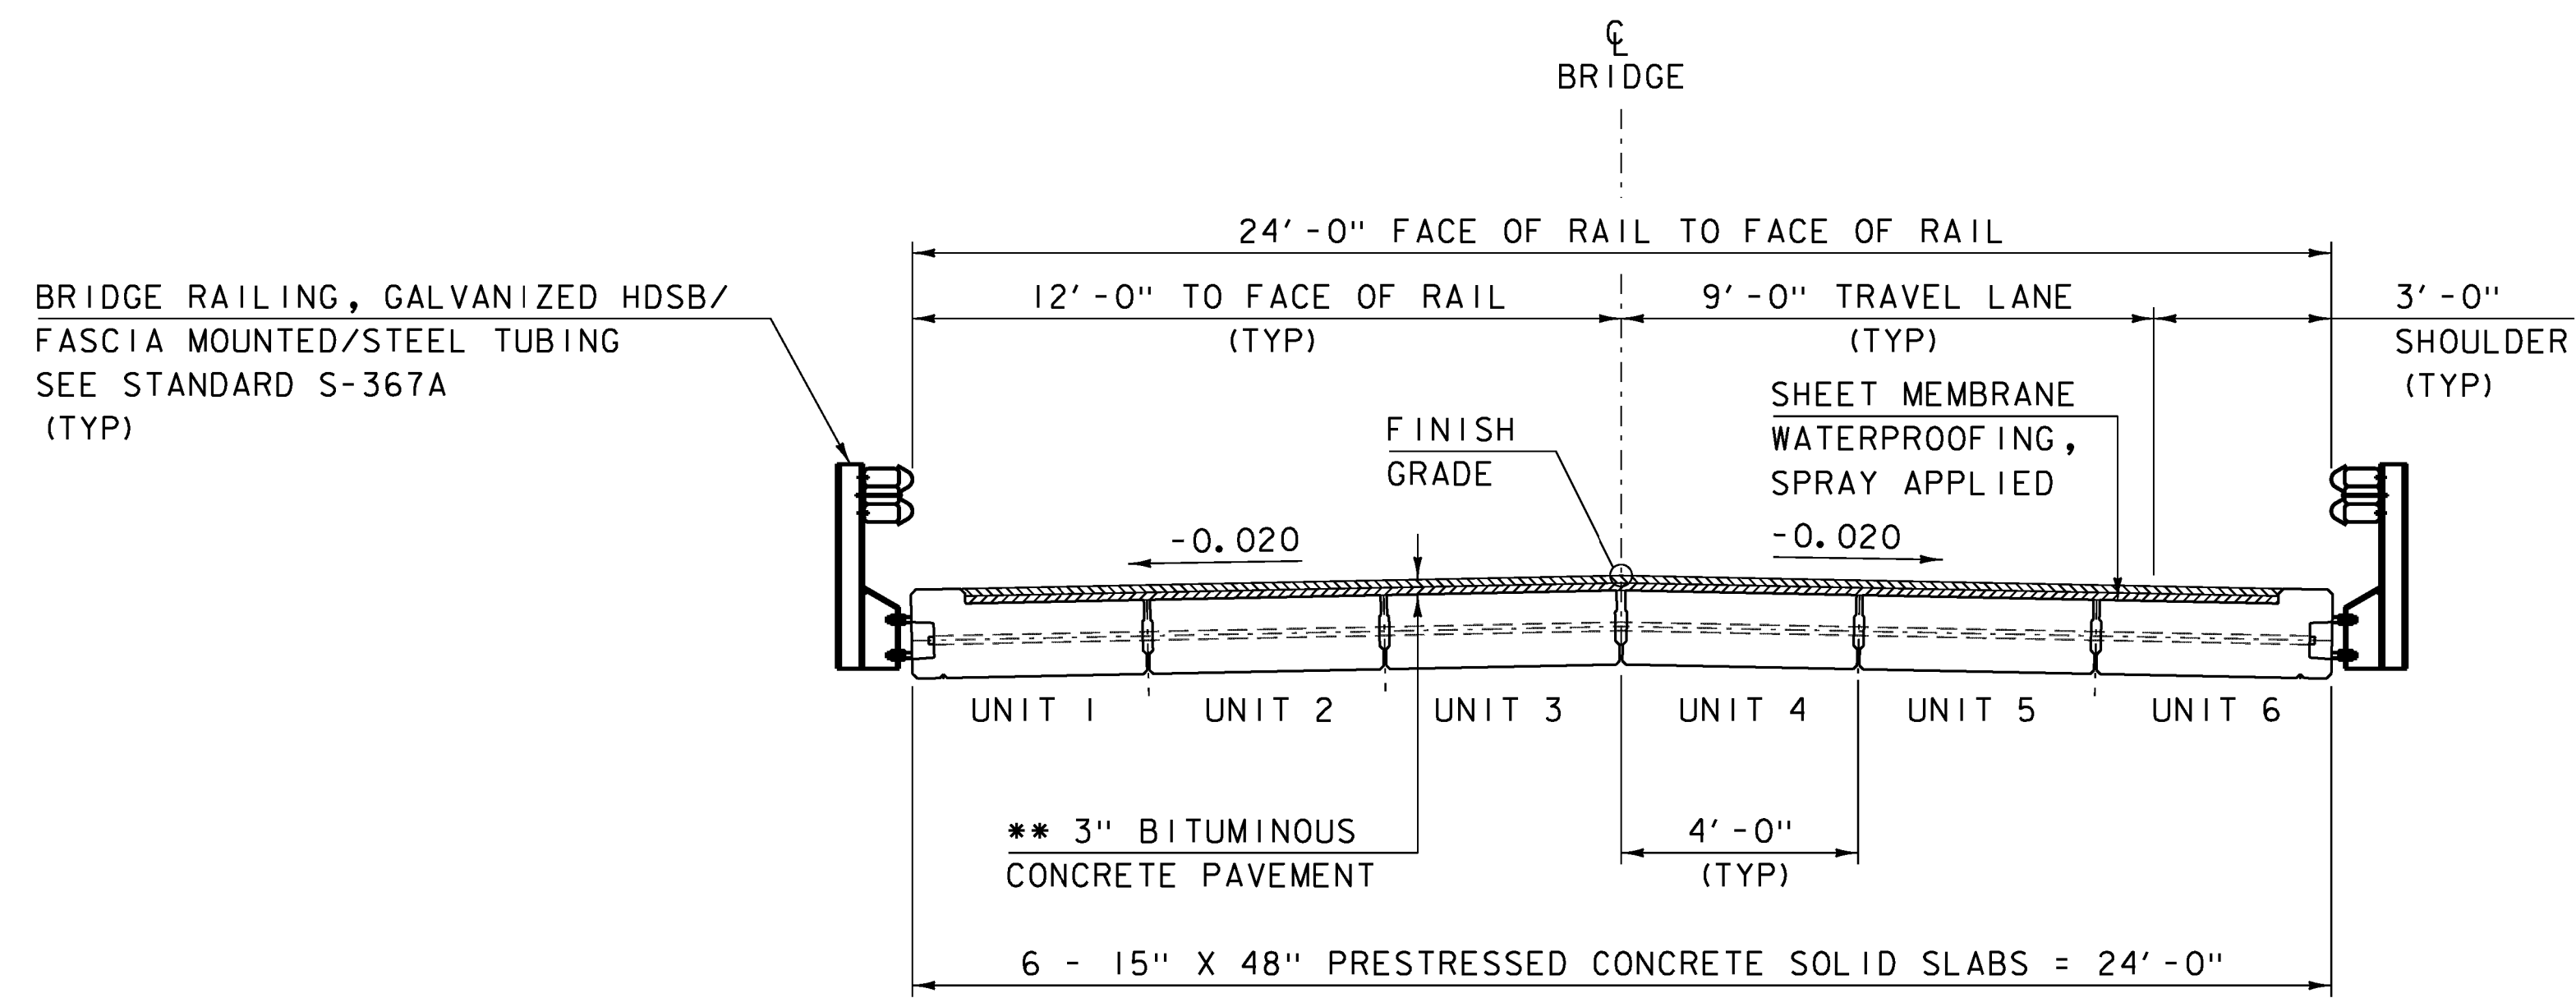

BRIDGE TYPICAL SECTION
SCALE $\frac{3}{8}'' = 1' - 0''$

- ** $1\frac{1}{2}''$ SUPERPAVE BITUMINOUS CONCRETE PAVEMENT TYPE IVS, OVER
- $1\frac{1}{2}''$ SUPERPAVE BITUMINOUS CONCRETE PAVEMENT TYPE IVS

MATERIAL TOLERANCES
(IF USED ON PROJECT)

SURFACE	
- PAVEMENT (TOTAL THICKNESS)	+/- $\frac{1}{4}''$
- AGGREGATE SURFACE COURSE	+/- $\frac{1}{2}''$
SUBBASE	+/- 1"
SAND BORROW	+/- 1"

PROJECT NAME:	FAIRFIELD
PROJECT NUMBER:	BRF 0281(25)
FILE NAME:	sl2j156+typical.dgn
PROJECT LEADER:	R. YOUNG
DESIGNED BY:	R. KLINEFELTER
TYPICAL SECTIONS 1	
PLOT DATE:	18-AUG-2014
DRAWN BY:	K. FRIEDLAND
CHECKED BY:	J. SALVATORI
SHEET	12 OF 69