



BANKING DIAGRAM

HORIZONTAL SCALE 1"=20'
NO VERTICAL SCALE

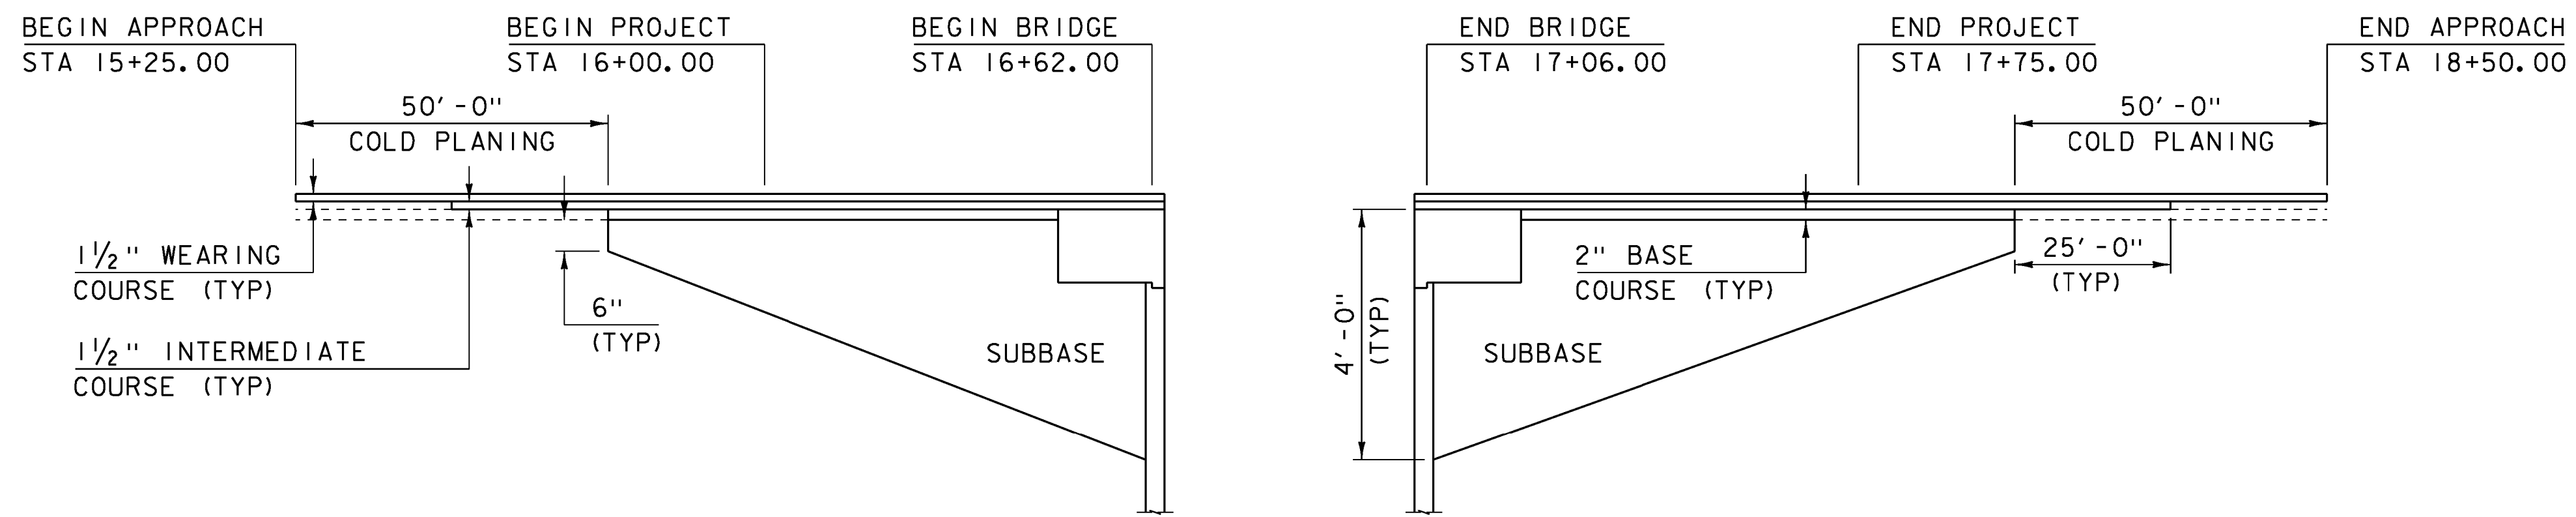

MATERIAL TRANSITION

HORIZONTAL SCALE 1"=20'
NO VERTICAL SCALE

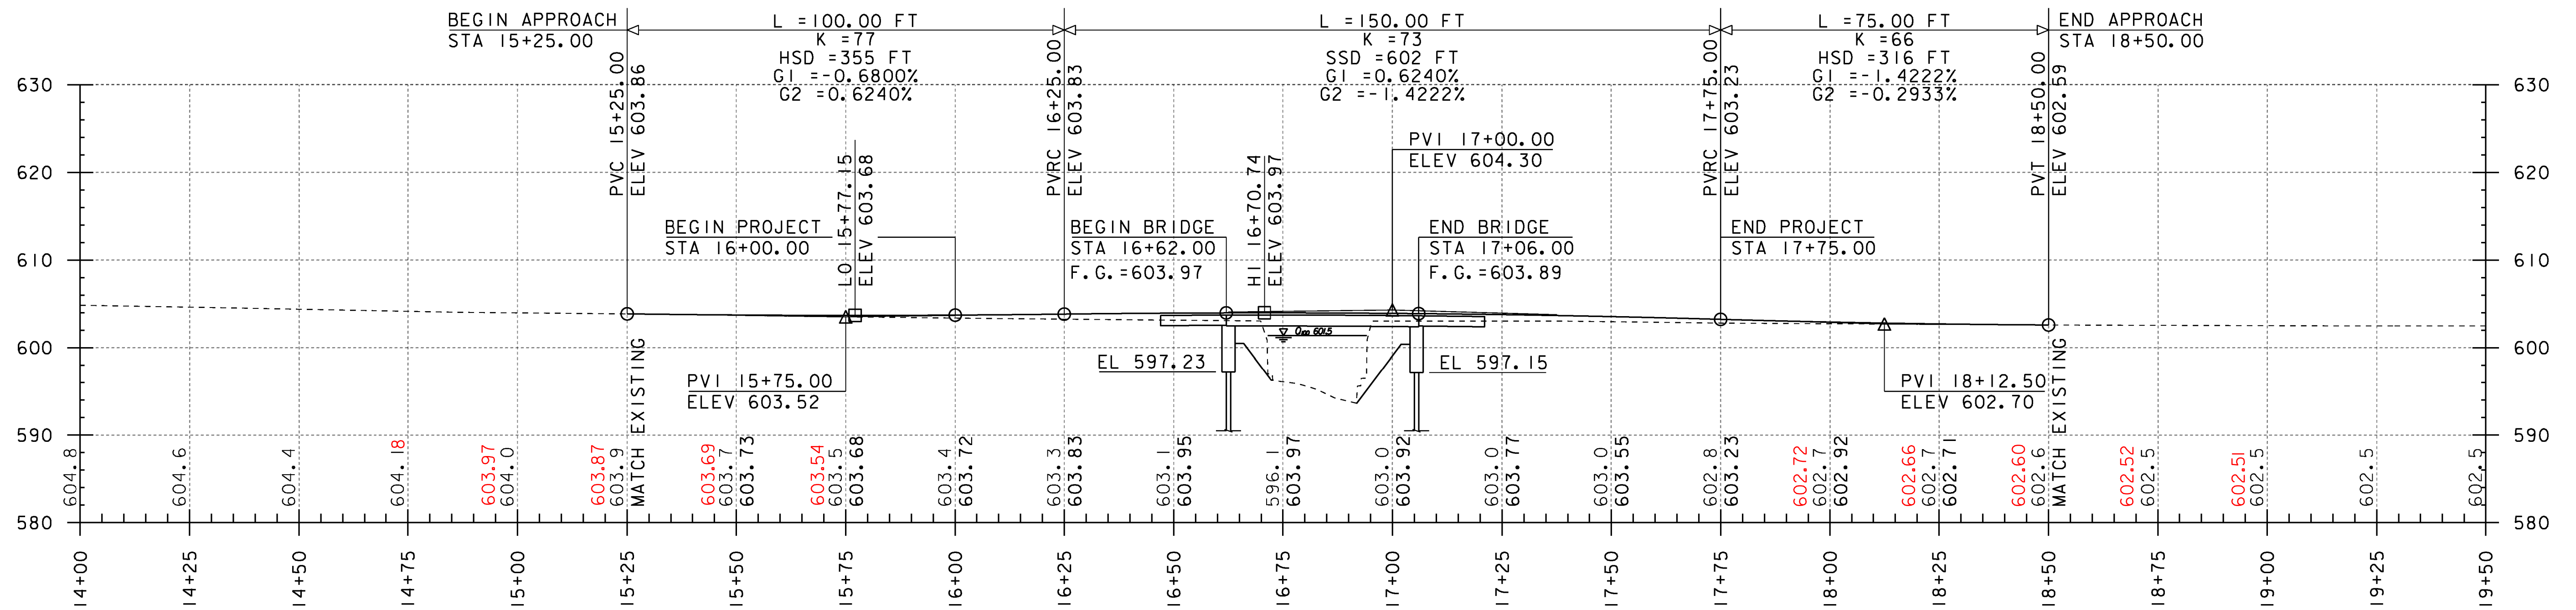

MAINLINE PROFILE

HORIZONTAL SCALE 1"=20'
VERTICAL SCALE 1"=10'

THE GRADES SHOWN TO THE NEAREST TENTH ARE THE ORIGINAL GROUND ELEVATIONS ALONG THE PROPOSED ALIGNMENT.
THE GRADES SHOWN TO THE NEAREST HUNDRETH ARE THE FINISH GRADES ALONG THE PROPOSED ALIGNMENT.

PROJECT NAME:	FAIRFIELD	PLOT DATE:	18-AUG-2014
PROJECT NUMBER:	BRF 0281(25)	DRAWN BY:	K. FRIEDLAND
FILE NAME:	sl2j156profile.dgn	CHECKED BY:	J. SALVATORI
PROJECT LEADER:	R. YOUNG		
DESIGNED BY:	R. KLINEFELTER		
MAINLINE PROFILE & BANKING DIAGRAM			SHEET 17 OF 69