


DELINEATOR W/STEEL POST  
 STA 16+20 LT (GREEN)  
 STA 16+20 RT (BLUE)  
 STA 17+45 LT (GREEN)  
 STA 17+45 RT (BLUE)

ANCHOR FOR STEEL BEAM RAIL  
 STA 16+33 LT  
 STA 16+33 RT  
 STA 17+35 LT  
 STA 17+35 RT

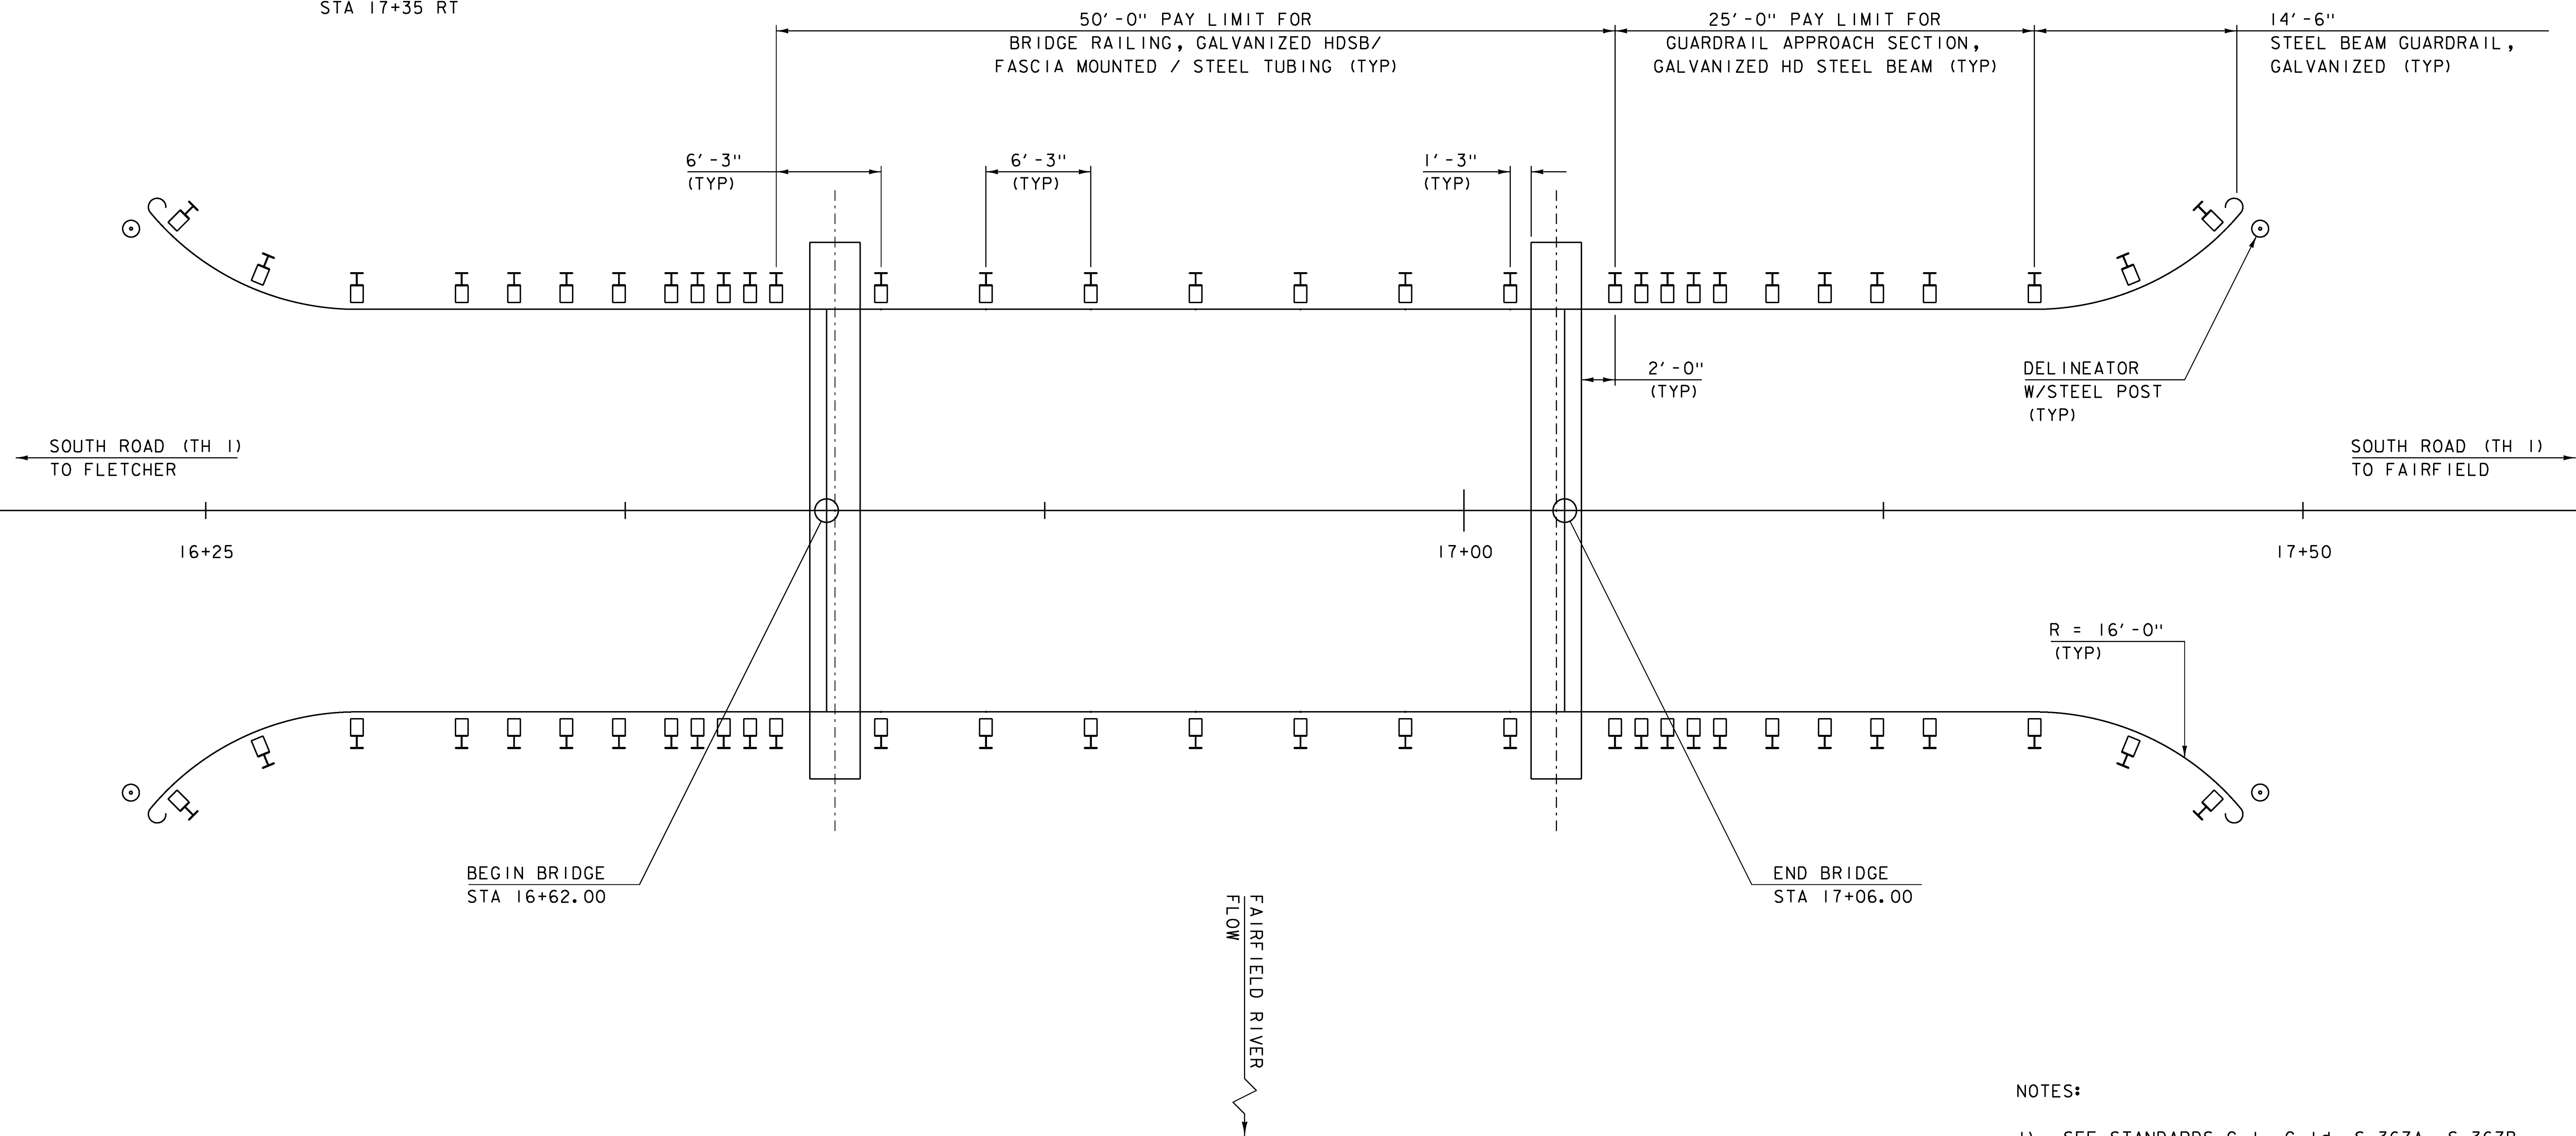

NOTES:

- 1) SEE STANDARDS G-1, G-1d, S-367A, S-367B, T-40 AND T-45 FOR FURTHER DETAILS.

RAIL LAYOUT SHEET

SCALE 1" = 5'-0"

PROJECT NAME: FAIRFIELD	PLOT DATE: 18-AUG-2014
PROJECT NUMBER: BRF 028(25)	DRAWN BY: K. FRIEDLAND
FILE NAME: sl2j156r.dgn	CHECKED BY: J. SALVATORI
PROJECT LEADER: R. YOUNG	SHEET 19 OF 69
DESIGNED BY: R. KLINEFELTER	
RAIL LAYOUT SHEET	