


FRAMING PLAN
SCALE 3/8" = 1'-0"

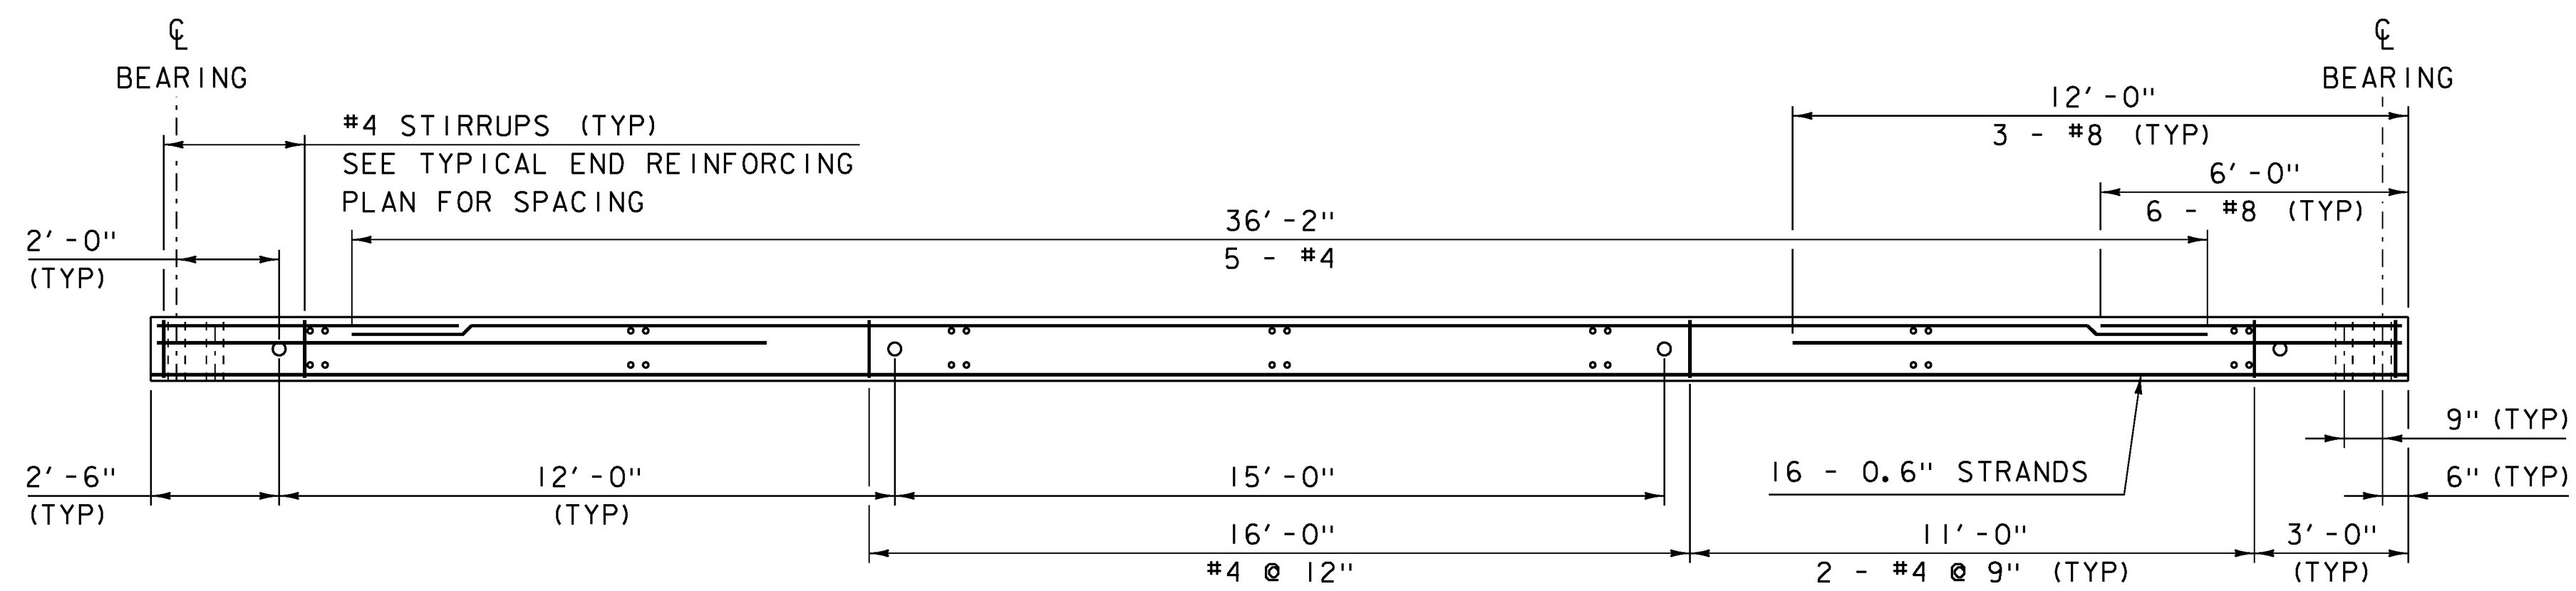

SLAB ELEVATION
SCALE 3/8" = 1'-0"

NOTES:
1) ALL REINFORCING SHALL BE LEVEL 2 OR HIGHER.

PROJECT NAME: FAIRFIELD	PLOT DATE: 18-AUG-2014
PROJECT NUMBER: BRF 028(25)	DRAWN BY: K. FRIEDLAND
FILE NAME: sl2j156sup.dgn	CHECKED BY: R. KLINEFELTER
PROJECT LEADER: R. YOUNG	SHEET 22 OF 69
DESIGNED BY: T. FILLBACH	
FRAMING PLAN	