




15+50

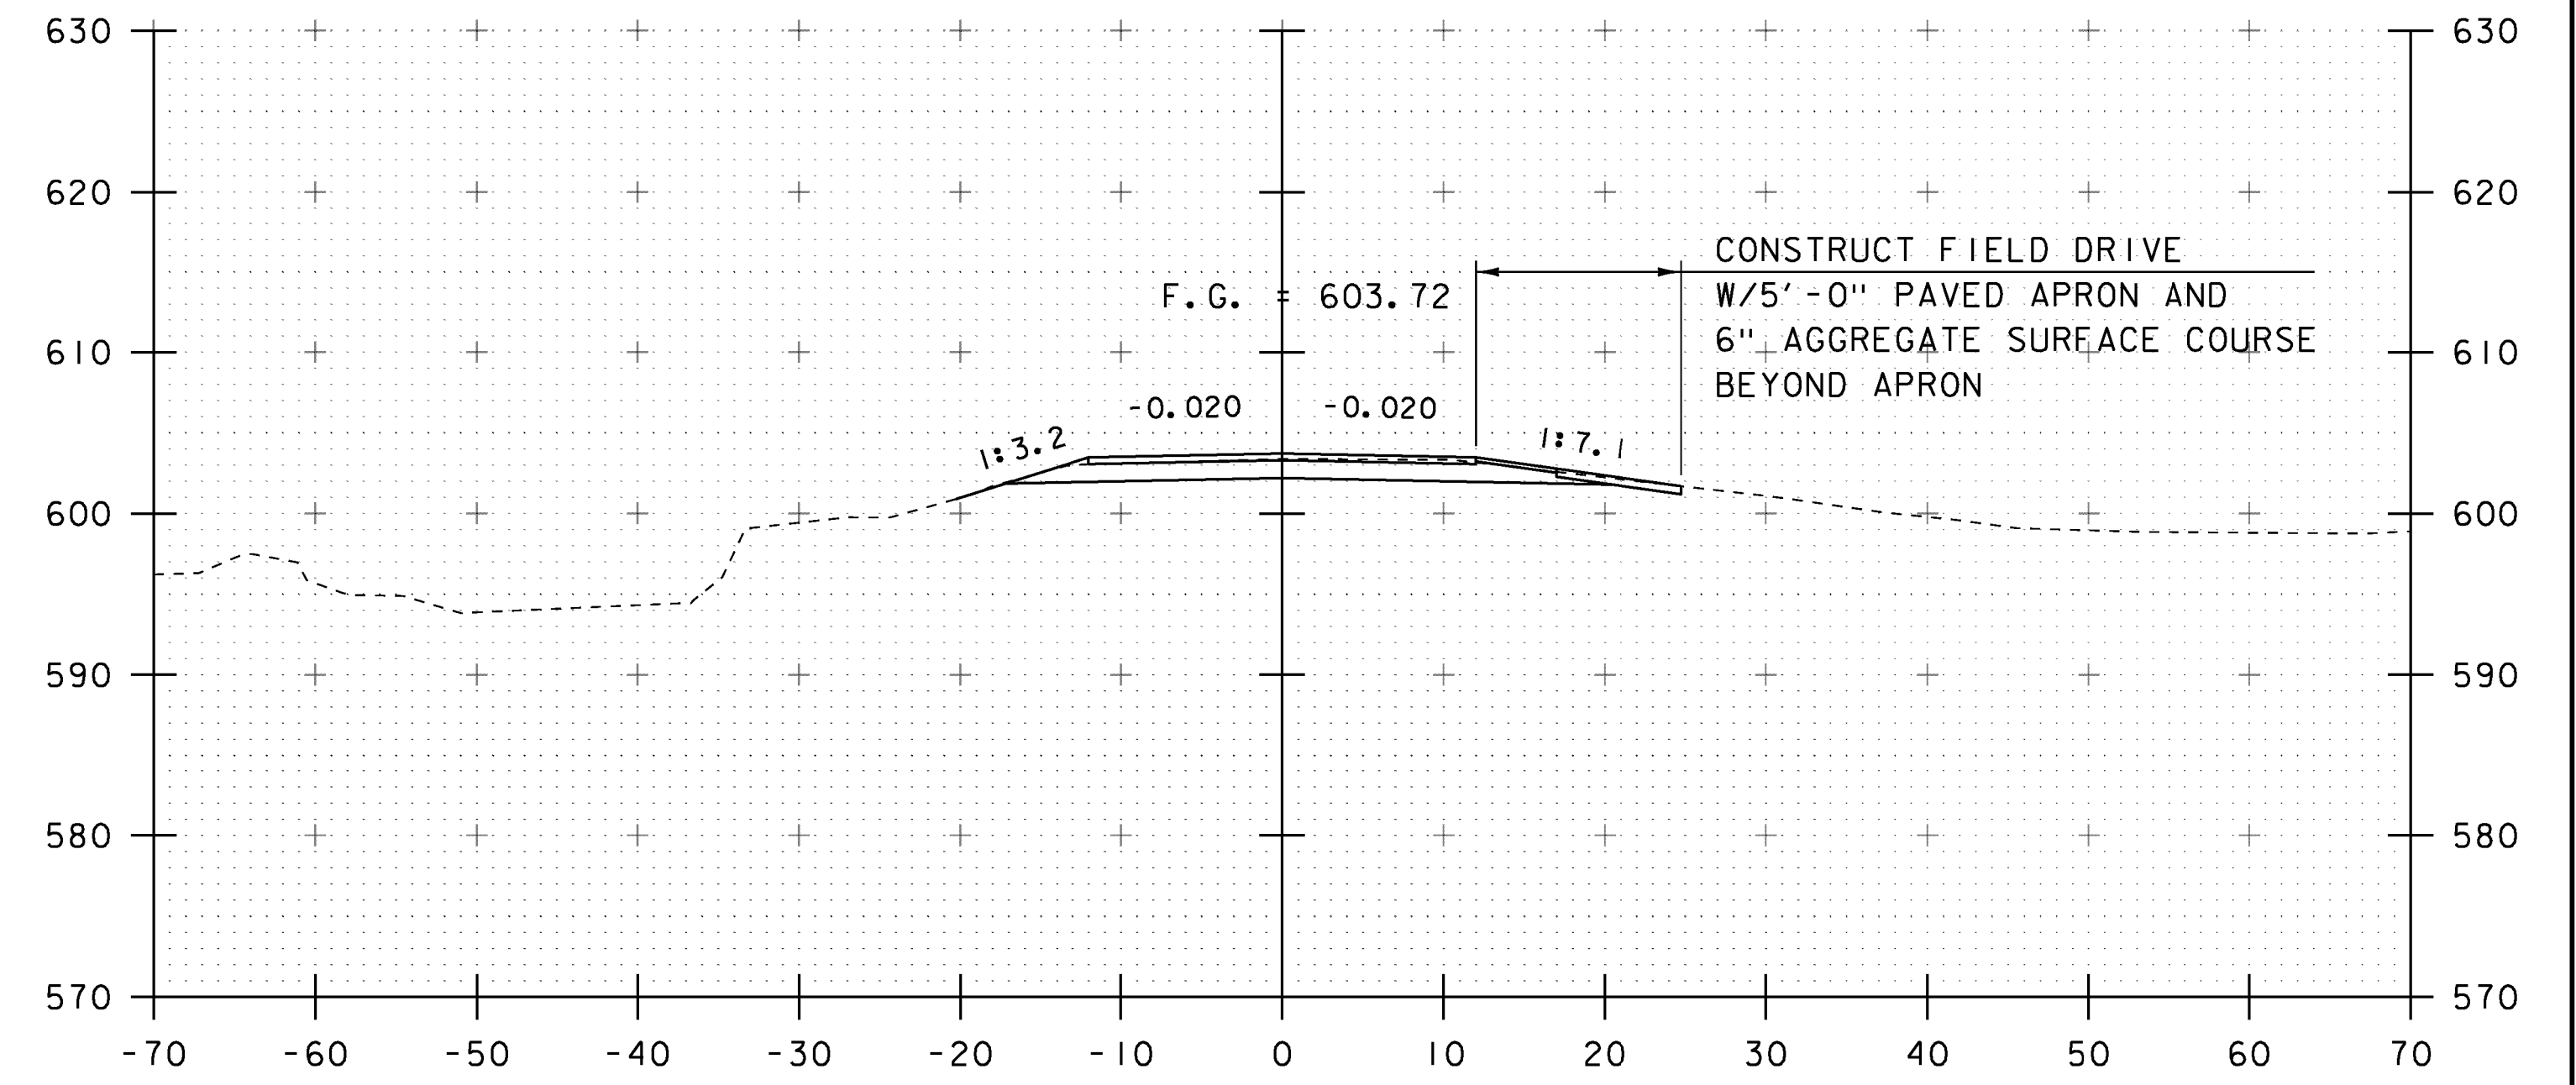

16+00
BEGIN PROJECT

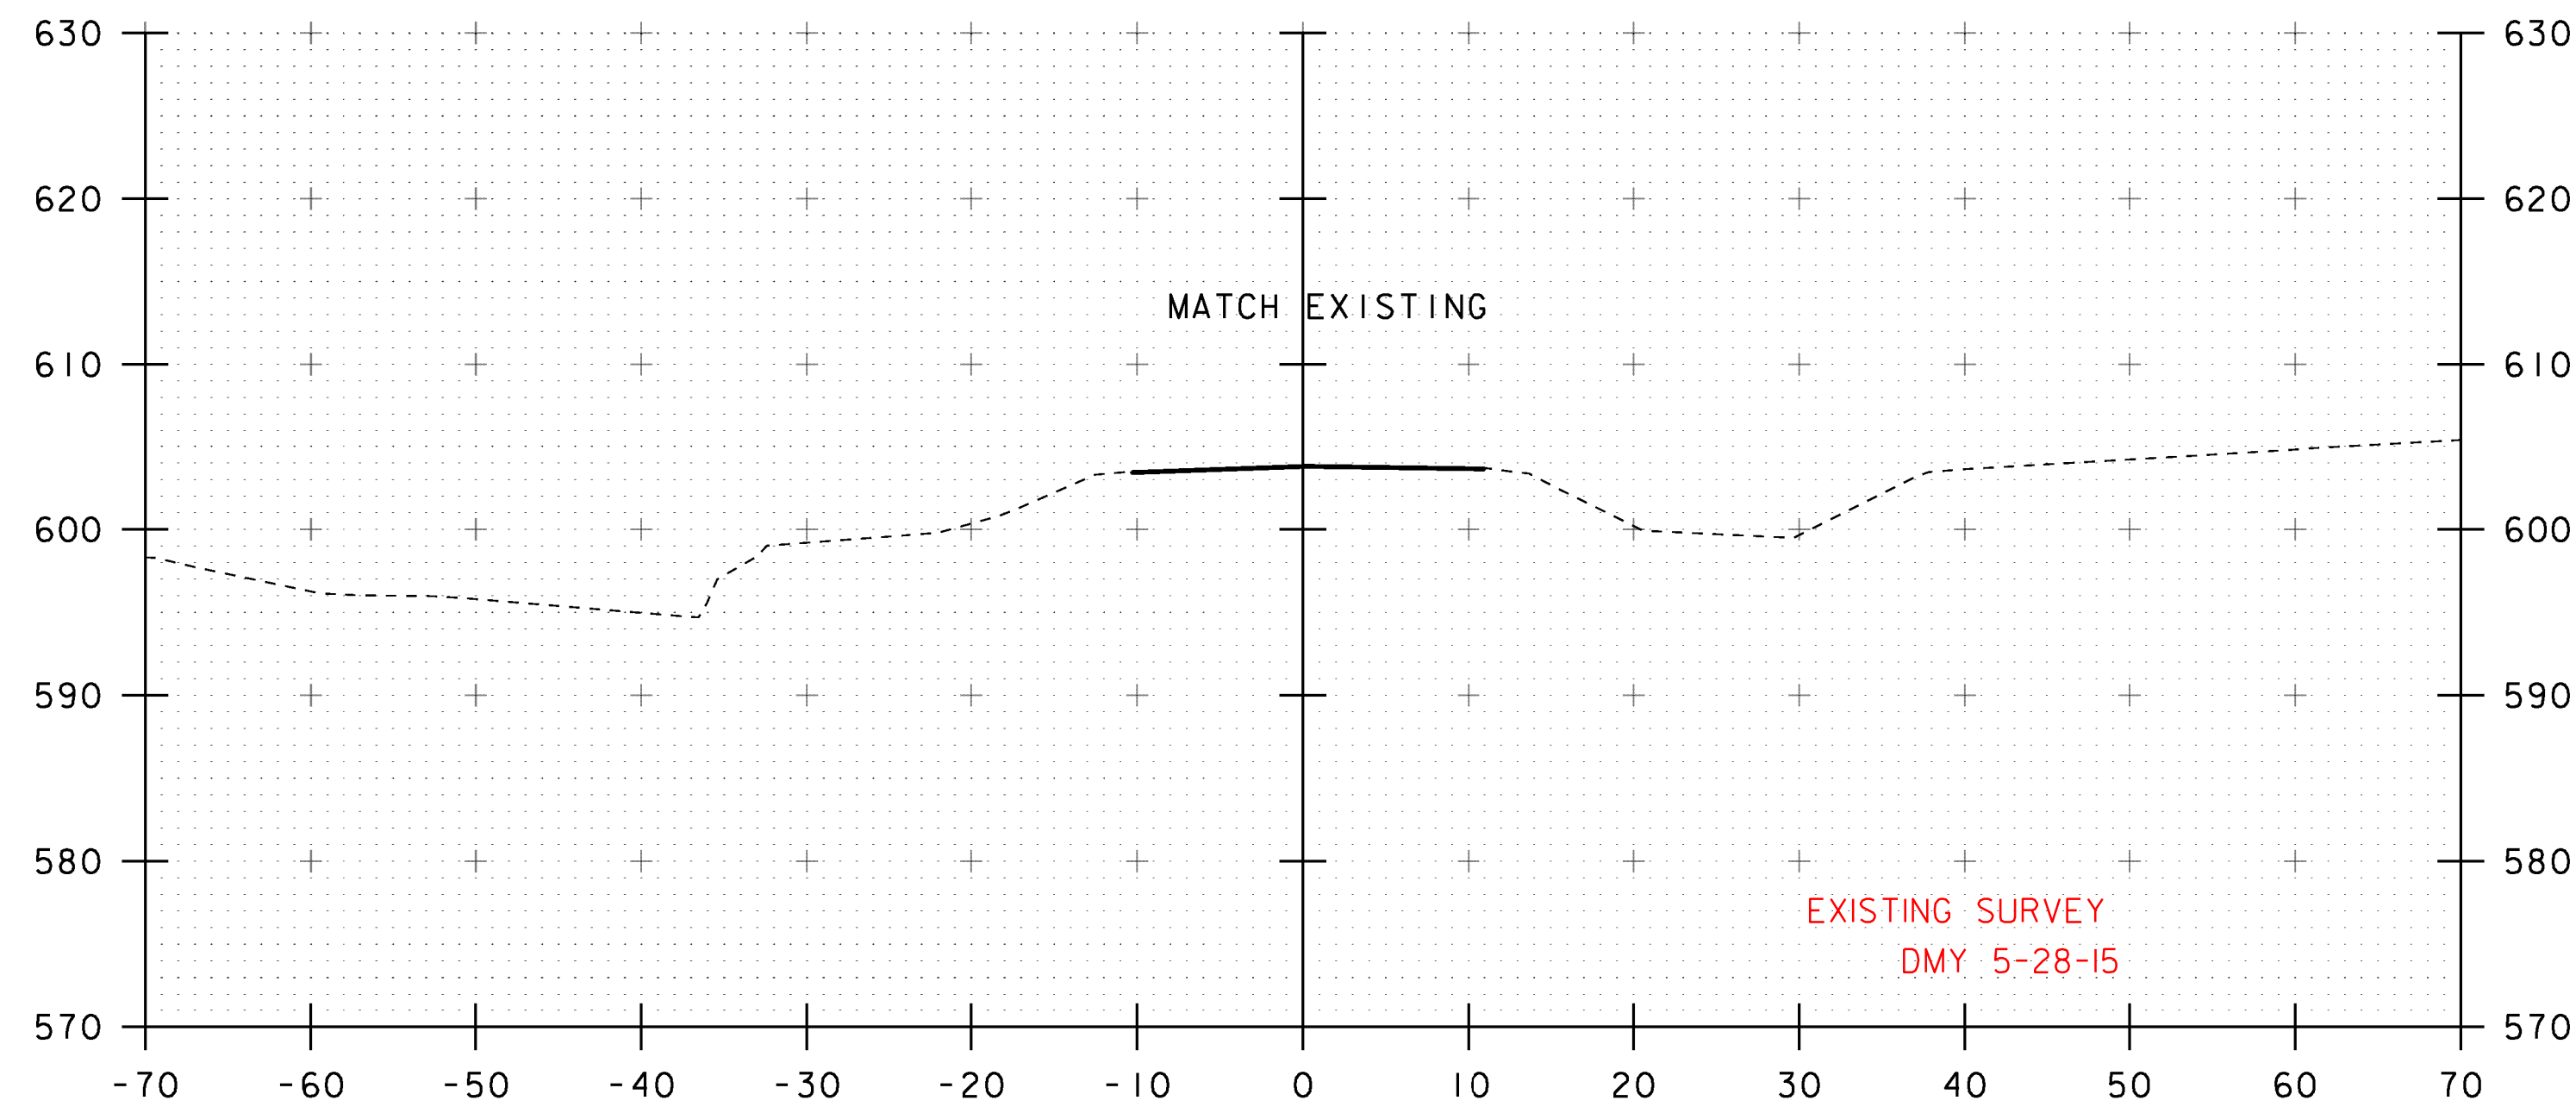

15+25
BEGIN APPROACH

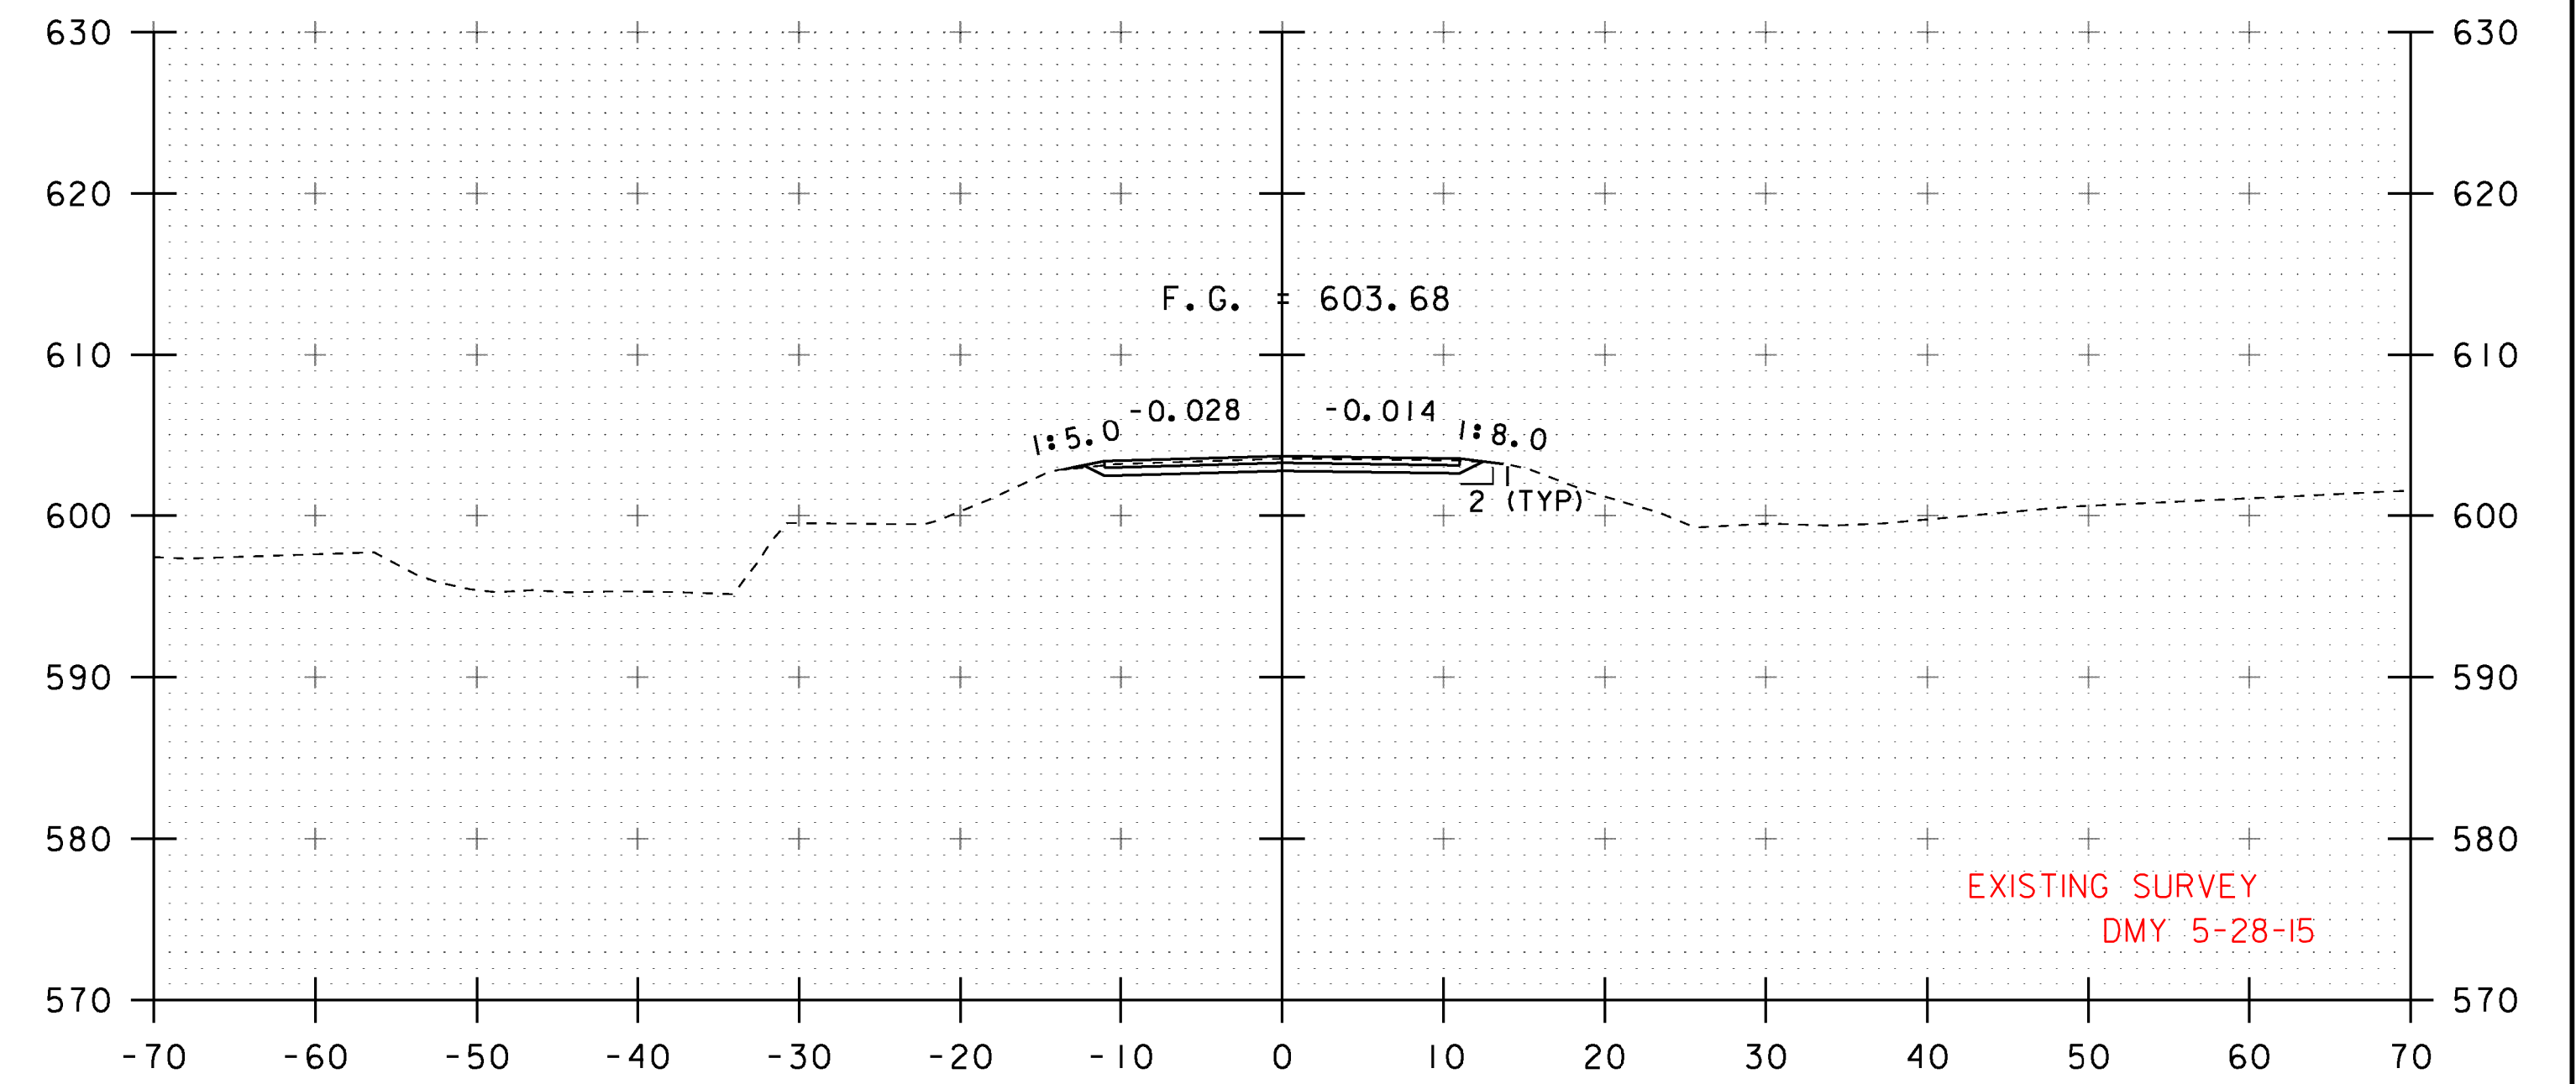

15+75

STA. 15+25 TO STA. 16+00

| | | | |
|-----------------|----------------|-------------------|----------------|
| PROJECT NAME: | FAIRFIELD | PLOT DATE: | 18-AUG-2014 |
| PROJECT NUMBER: | BRF 0281(25) | DRAWN BY: | R. KLINEFELTER |
| FILE NAME: | sl2j156xs.dgn | CHECKED BY: | J. SALVATORI |
| PROJECT LEADER: | R. YOUNG | SHEET | 32 OF 69 |
| DESIGNED BY: | R. KLINEFELTER | MAINLINE SECTIONS | |