




17+50

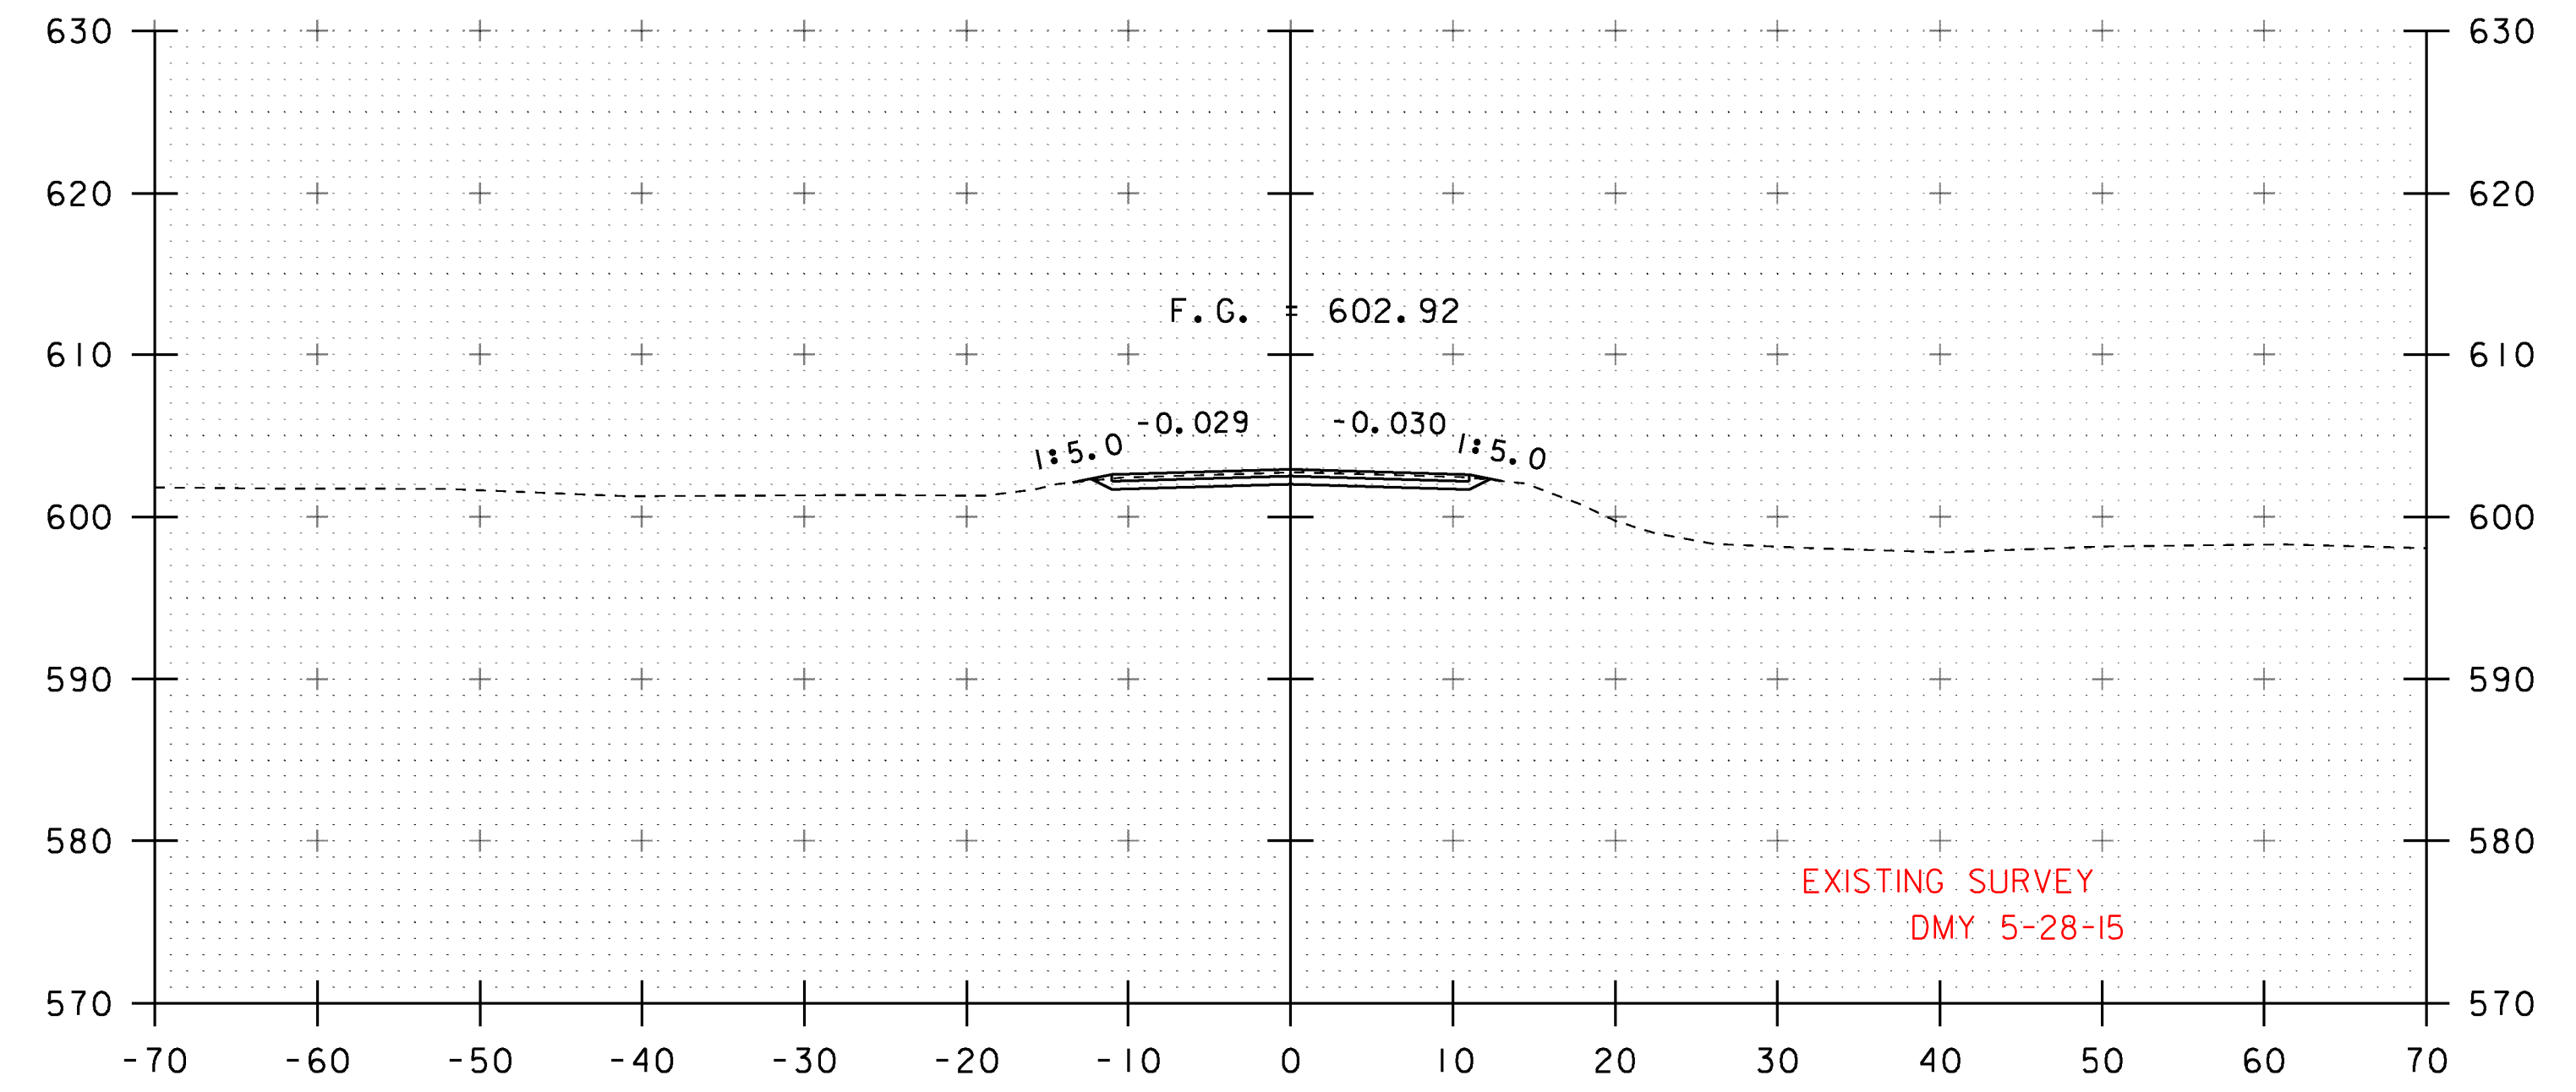

18+00

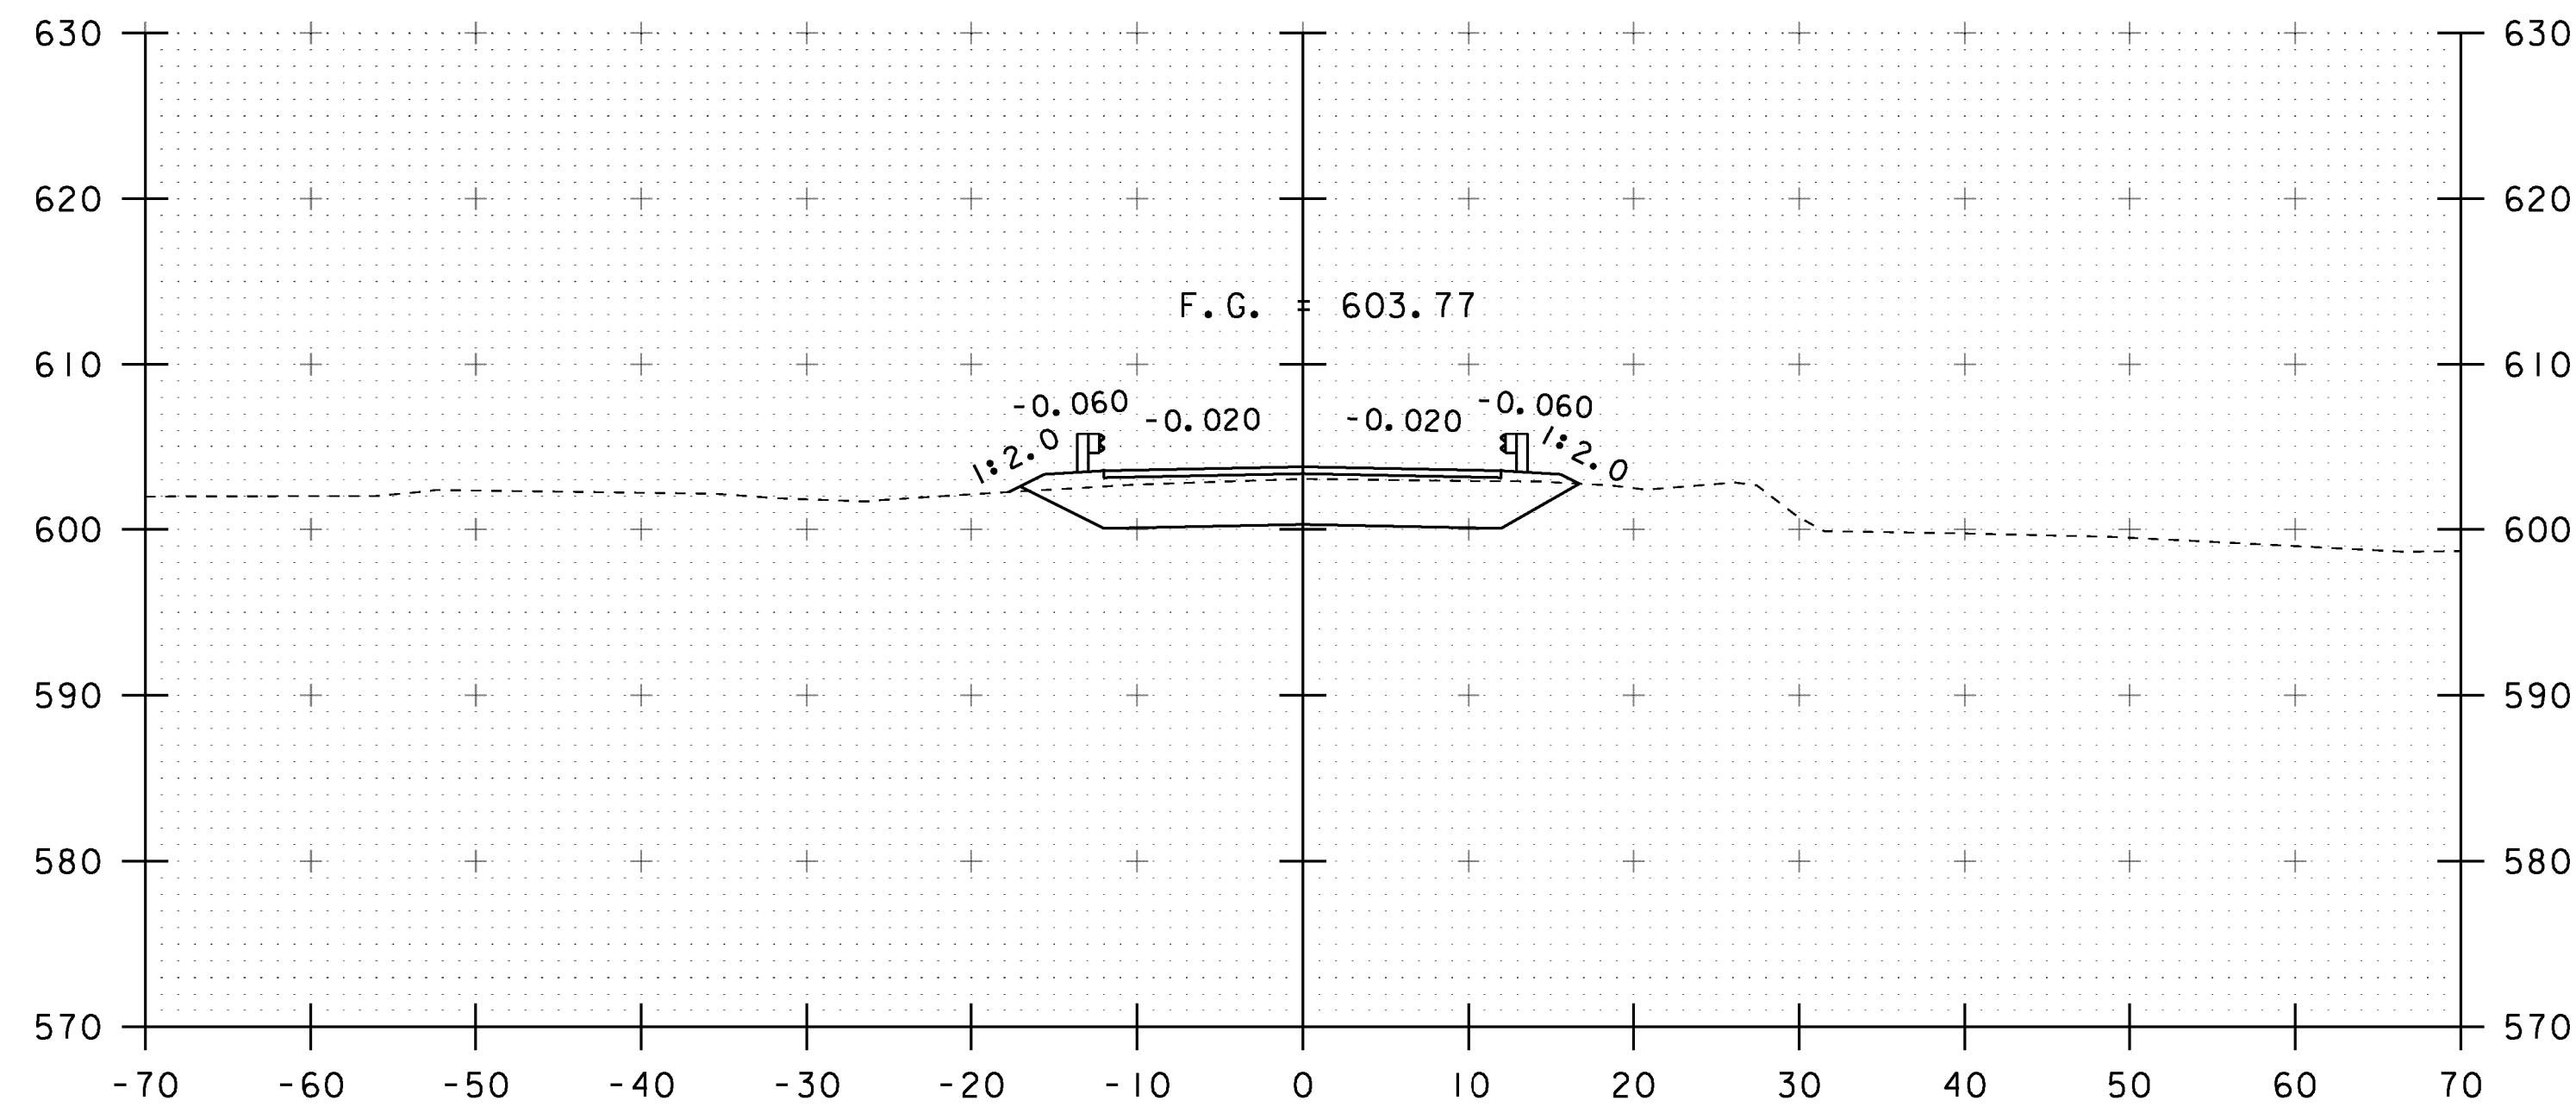

17+25

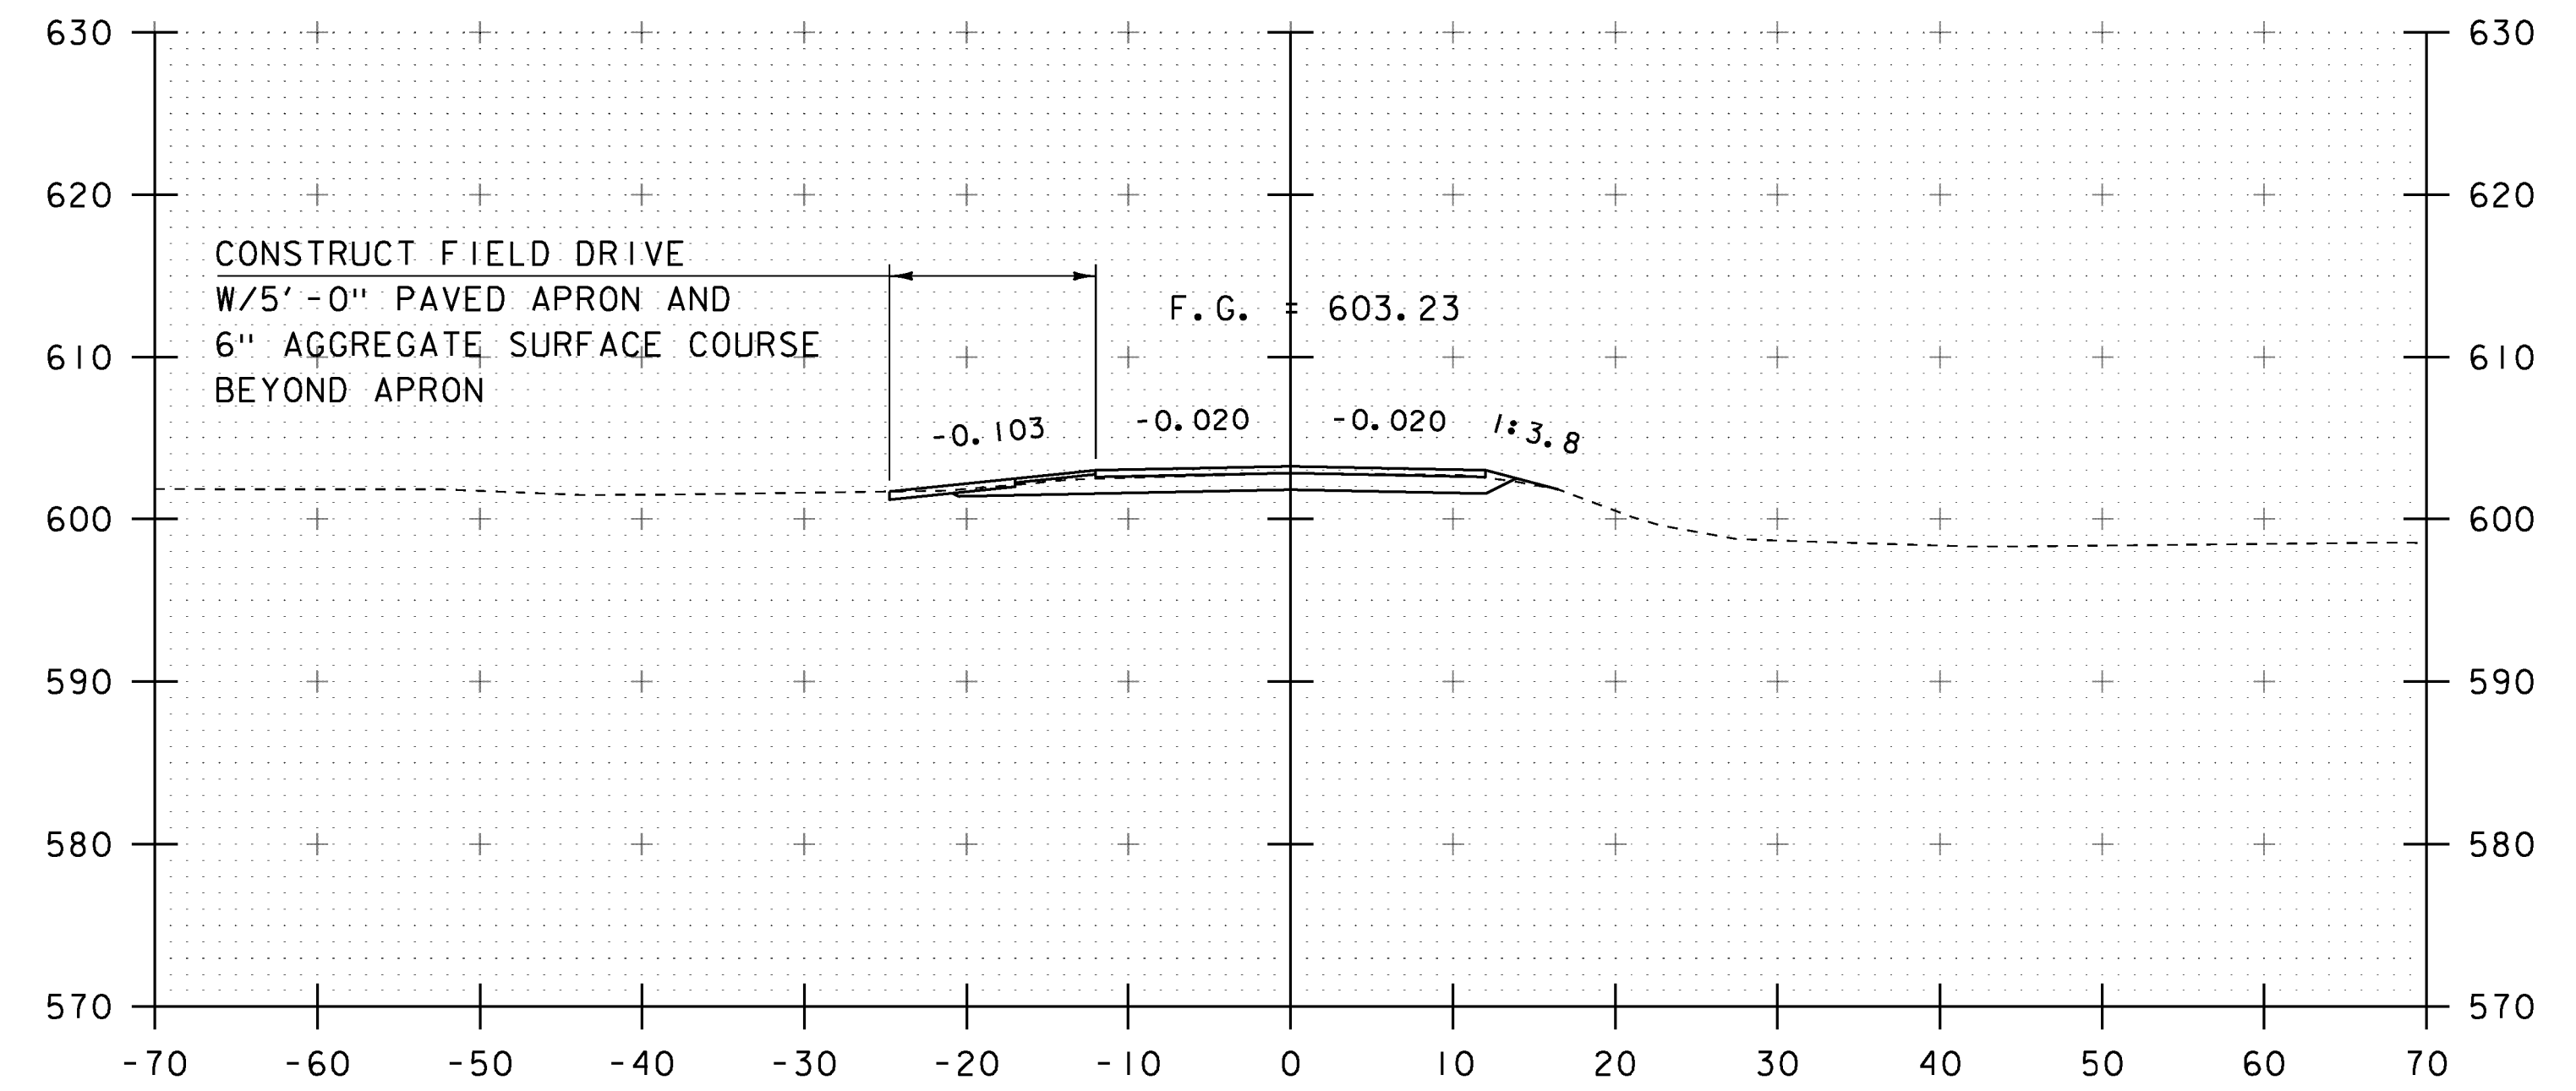

17+75
END PROJECT

STA. 17+25 TO STA. 18+00

PROJECT NAME:	FAIRFIELD	PLOT DATE:	18-AUG-2014
PROJECT NUMBER:	BRF 0281(25)	DRAWN BY:	R. KLINEFELTER
FILE NAME:	sl2j156xs.dgn	DESIGNED BY:	R. KLINEFELTER
PROJECT LEADER:	R. YOUNG	CHECKED BY:	J. SALVATORI
MAINLINE SECTIONS		SHEET 34 OF 69	