


18+50  
END APPROACH

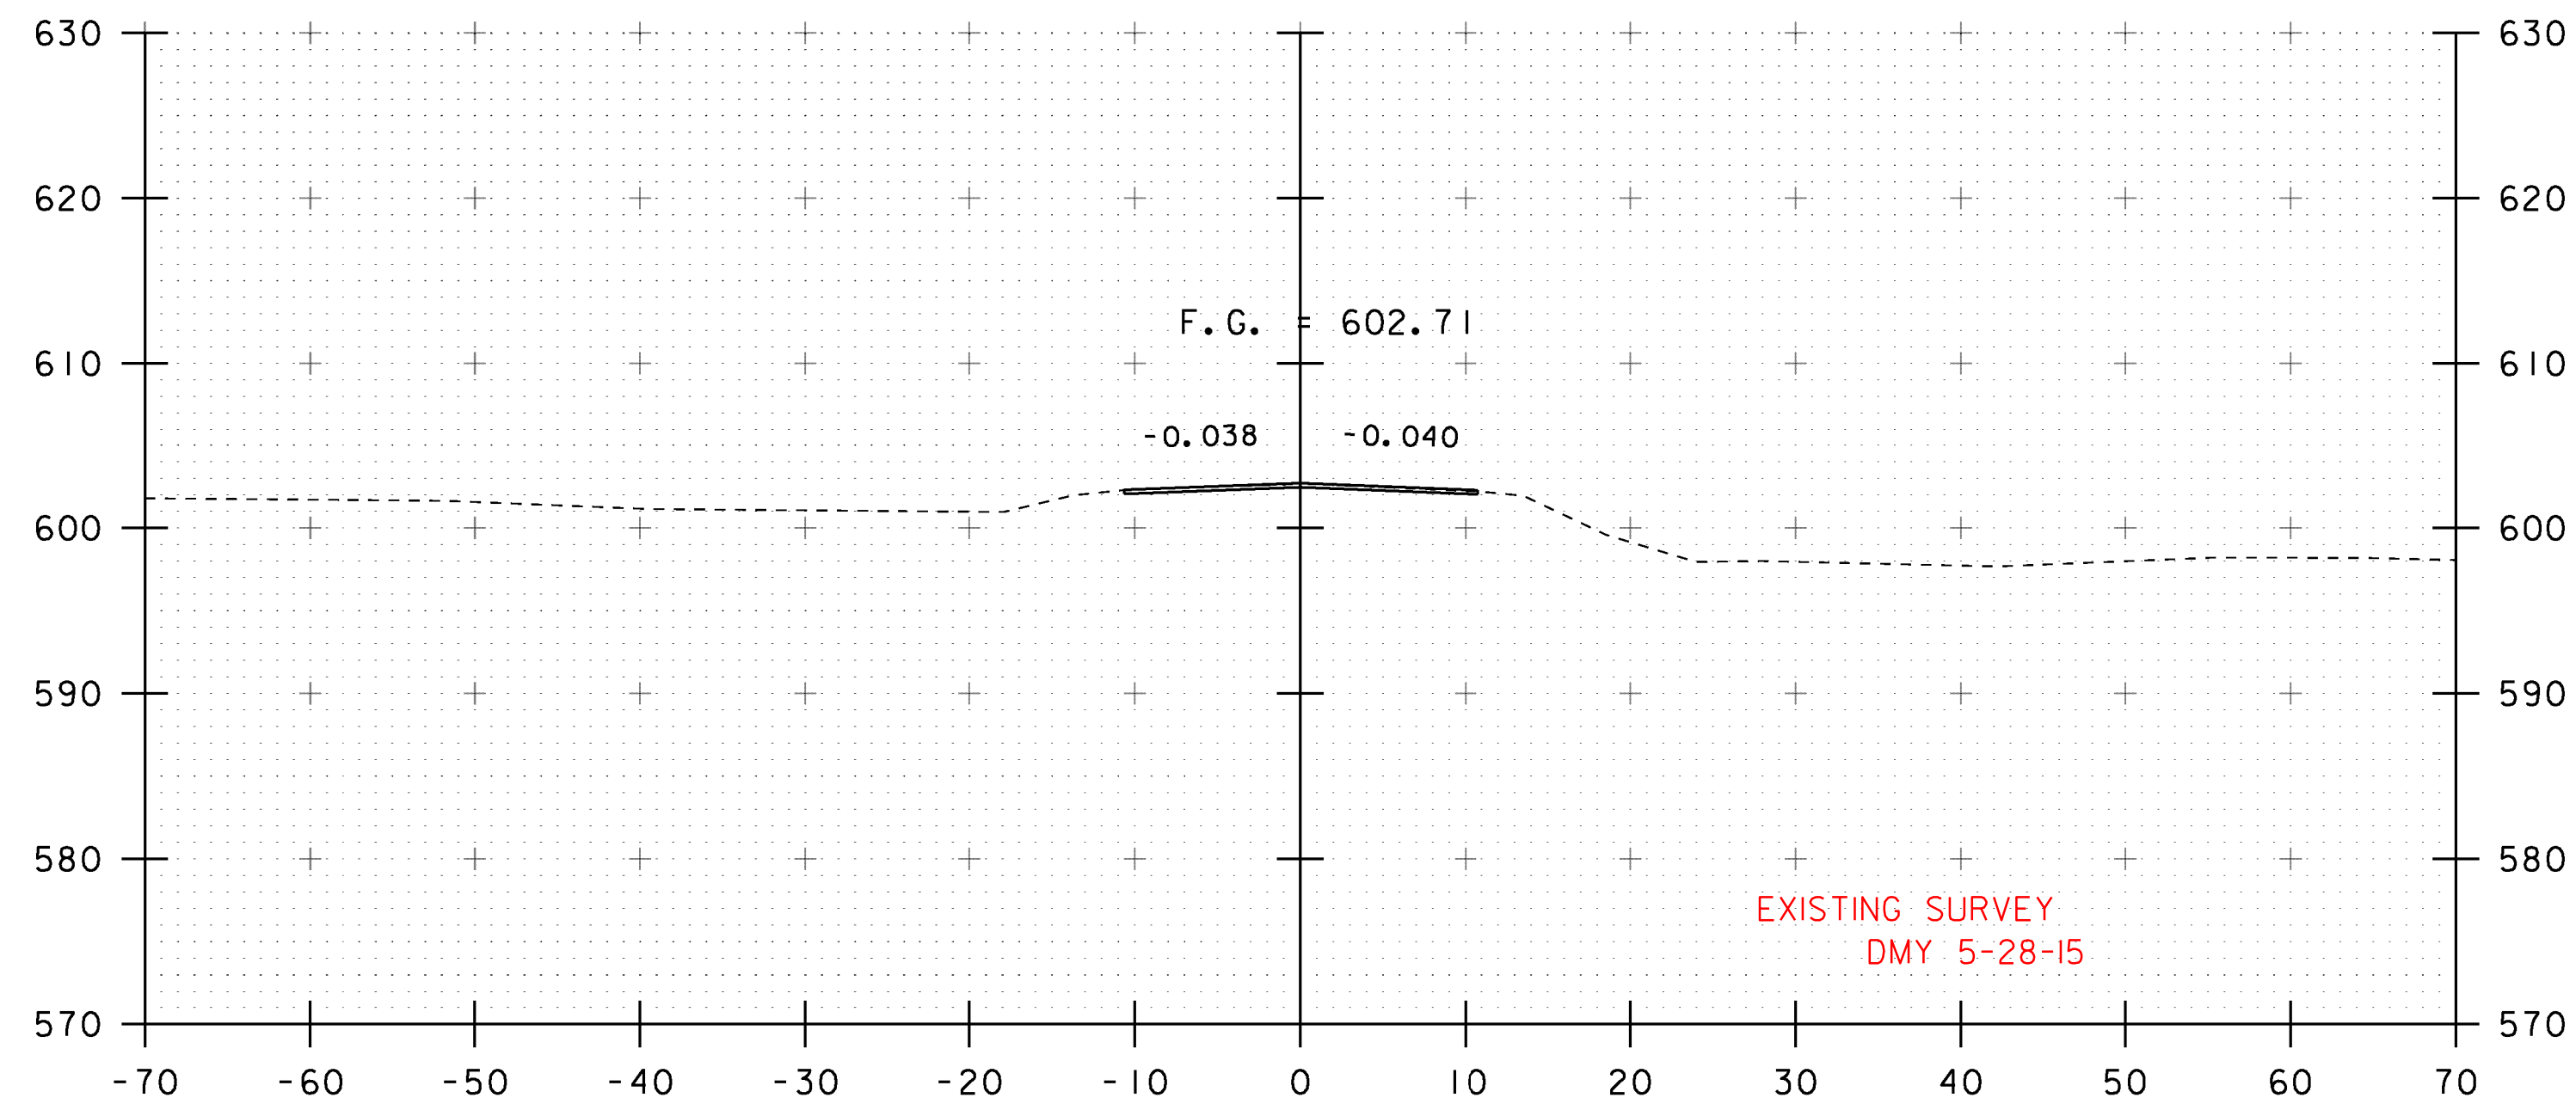

18+25

STA. 18+25 TO STA. 18+50

PROJECT NAME: FAIRFIELD	PLOT DATE: 18-AUG-2014
PROJECT NUMBER: BRF 0281(25)	DRAWN BY: R. KLINEFELTER
FILE NAME: sl2j156xs.dgn	CHECKED BY: J. SALVATORI
PROJECT LEADER: R. YOUNG	SHEET 35 OF 69
DESIGNED BY: R. KLINEFELTER	MAINLINE SECTIONS