



ABUTMENT REINFORCING PLAN (PCU)

SCALE 1/2" = 1'-0"

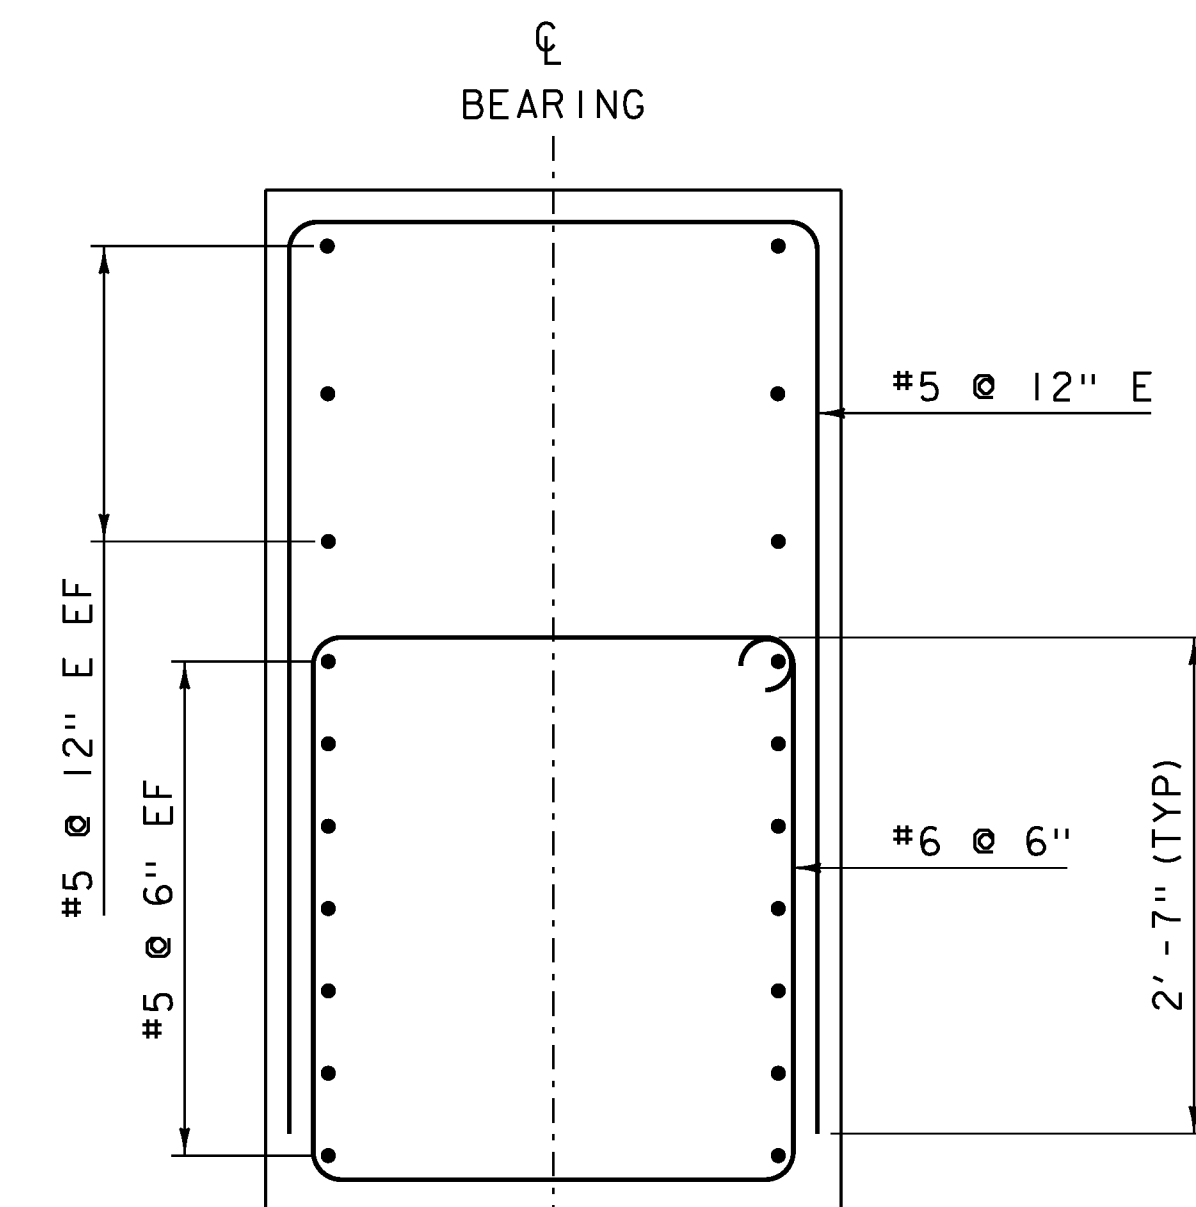


SECTION B-B

SCALE 1" = 1'-0"

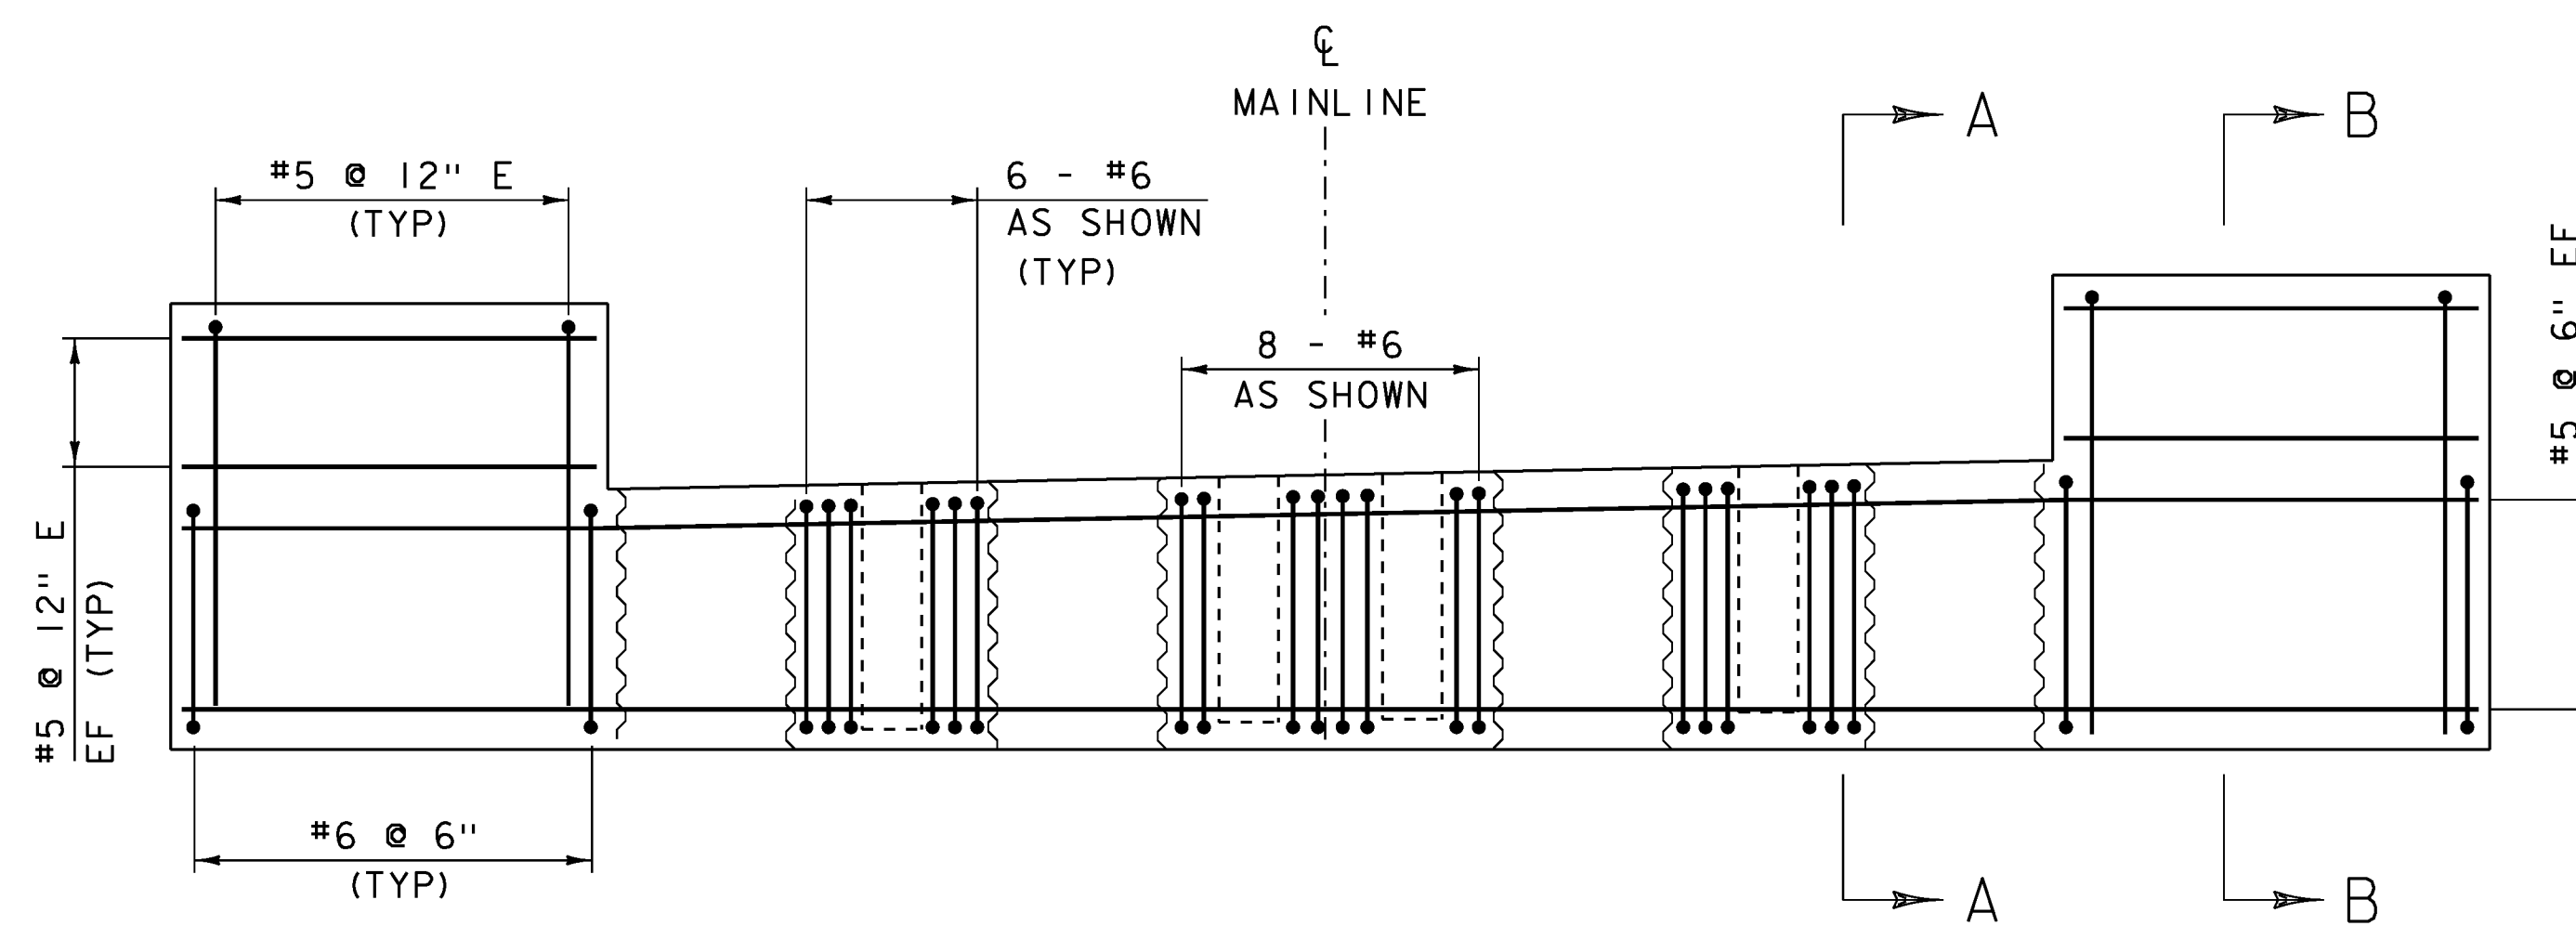

ABUTMENT REINFORCING ELEVATION (PCU)

SCALE 1/2" = 1'-0"

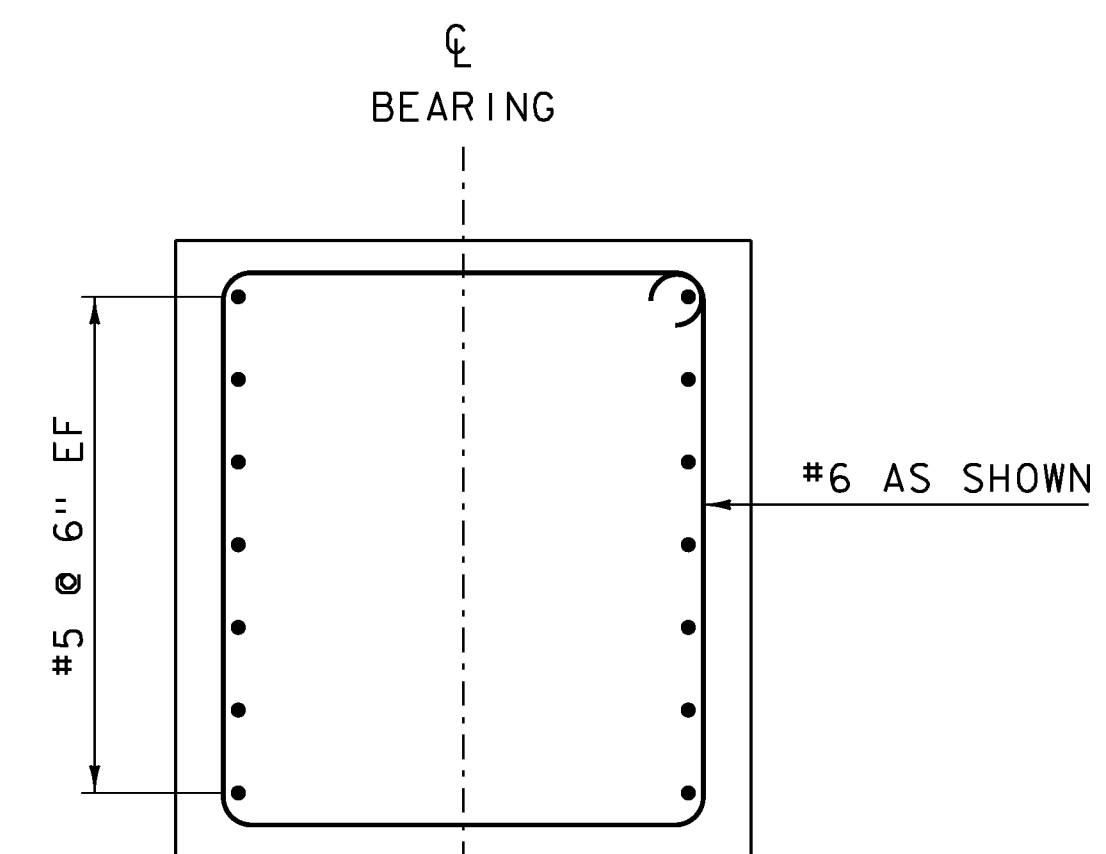

SECTION A-A

SCALE 1" = 1'-0"

NOTES:

- 1) PCU 1 SHOWN, PCU 2 SIMILAR.

NOTE:

- E = LEVEL 1 (EPOXY) REINFORCING
- NF = NEAR FACE
- FF = FAR FACE
- EF = EACH FACE
- ▲ = CUT TO FIT IN FIELD
- 3" CLEAR, UNLESS OTHERWISE SPECIFIED ON THE PLANS.
- SPLICES NOT DETAILED SHALL BE DESIGNED

PROJECT NAME: FAIRFIELD  
PROJECT NUMBER: BRO 1448 (4)

FILE NAME: sl2j170sub.dgn  
PROJECT LEADER: R. YOUNG  
DESIGNED BY: T. FILLBACH  
ABUTMENT REINFORCING

PLOT DATE: 18-AUG-2014  
DRAWN BY: K. FRIEDLAND  
CHECKED BY: R. KLINEFELTER  
SHEET 60 OF 69