




19+75

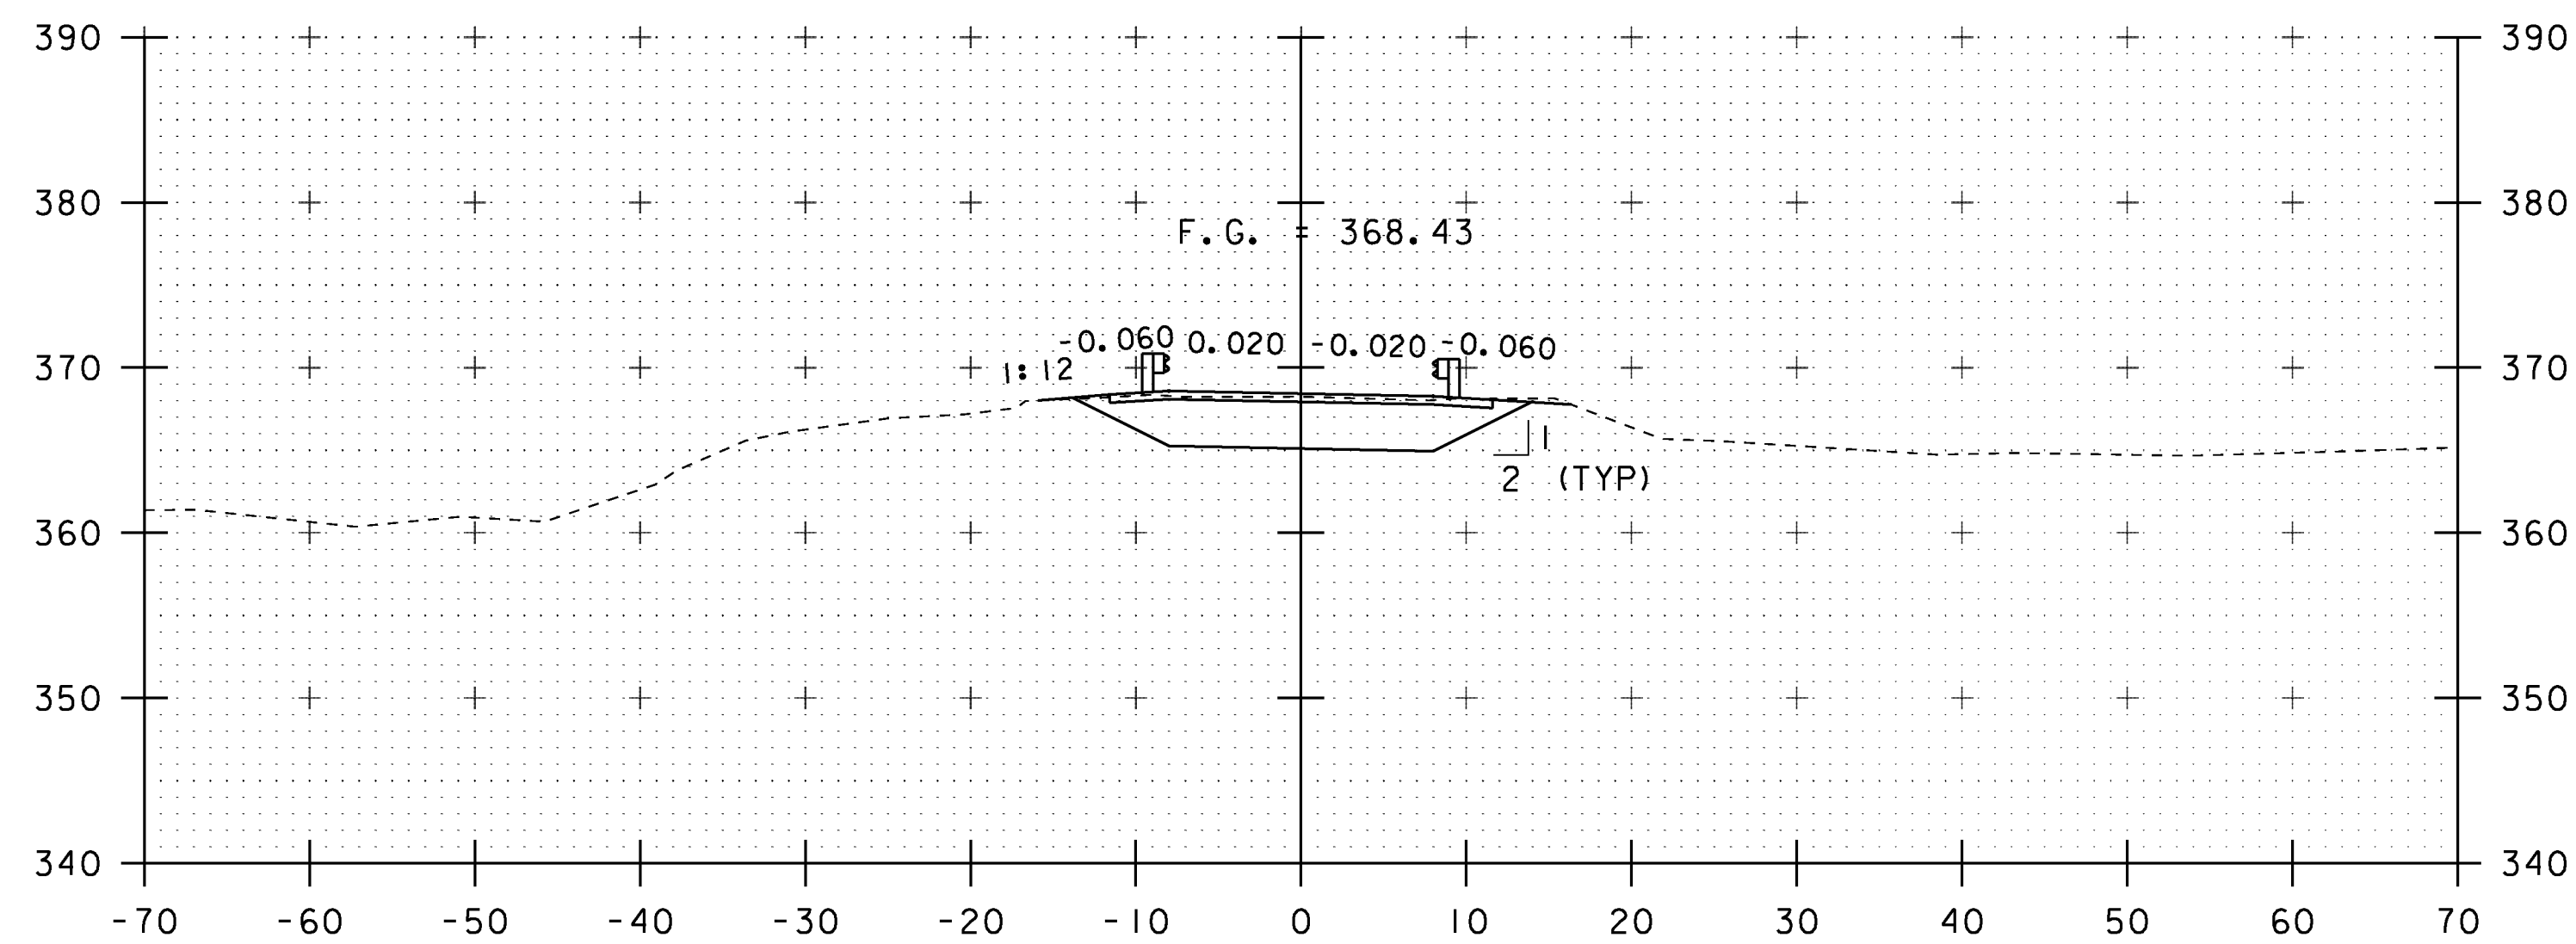

20+25
END PROJECT

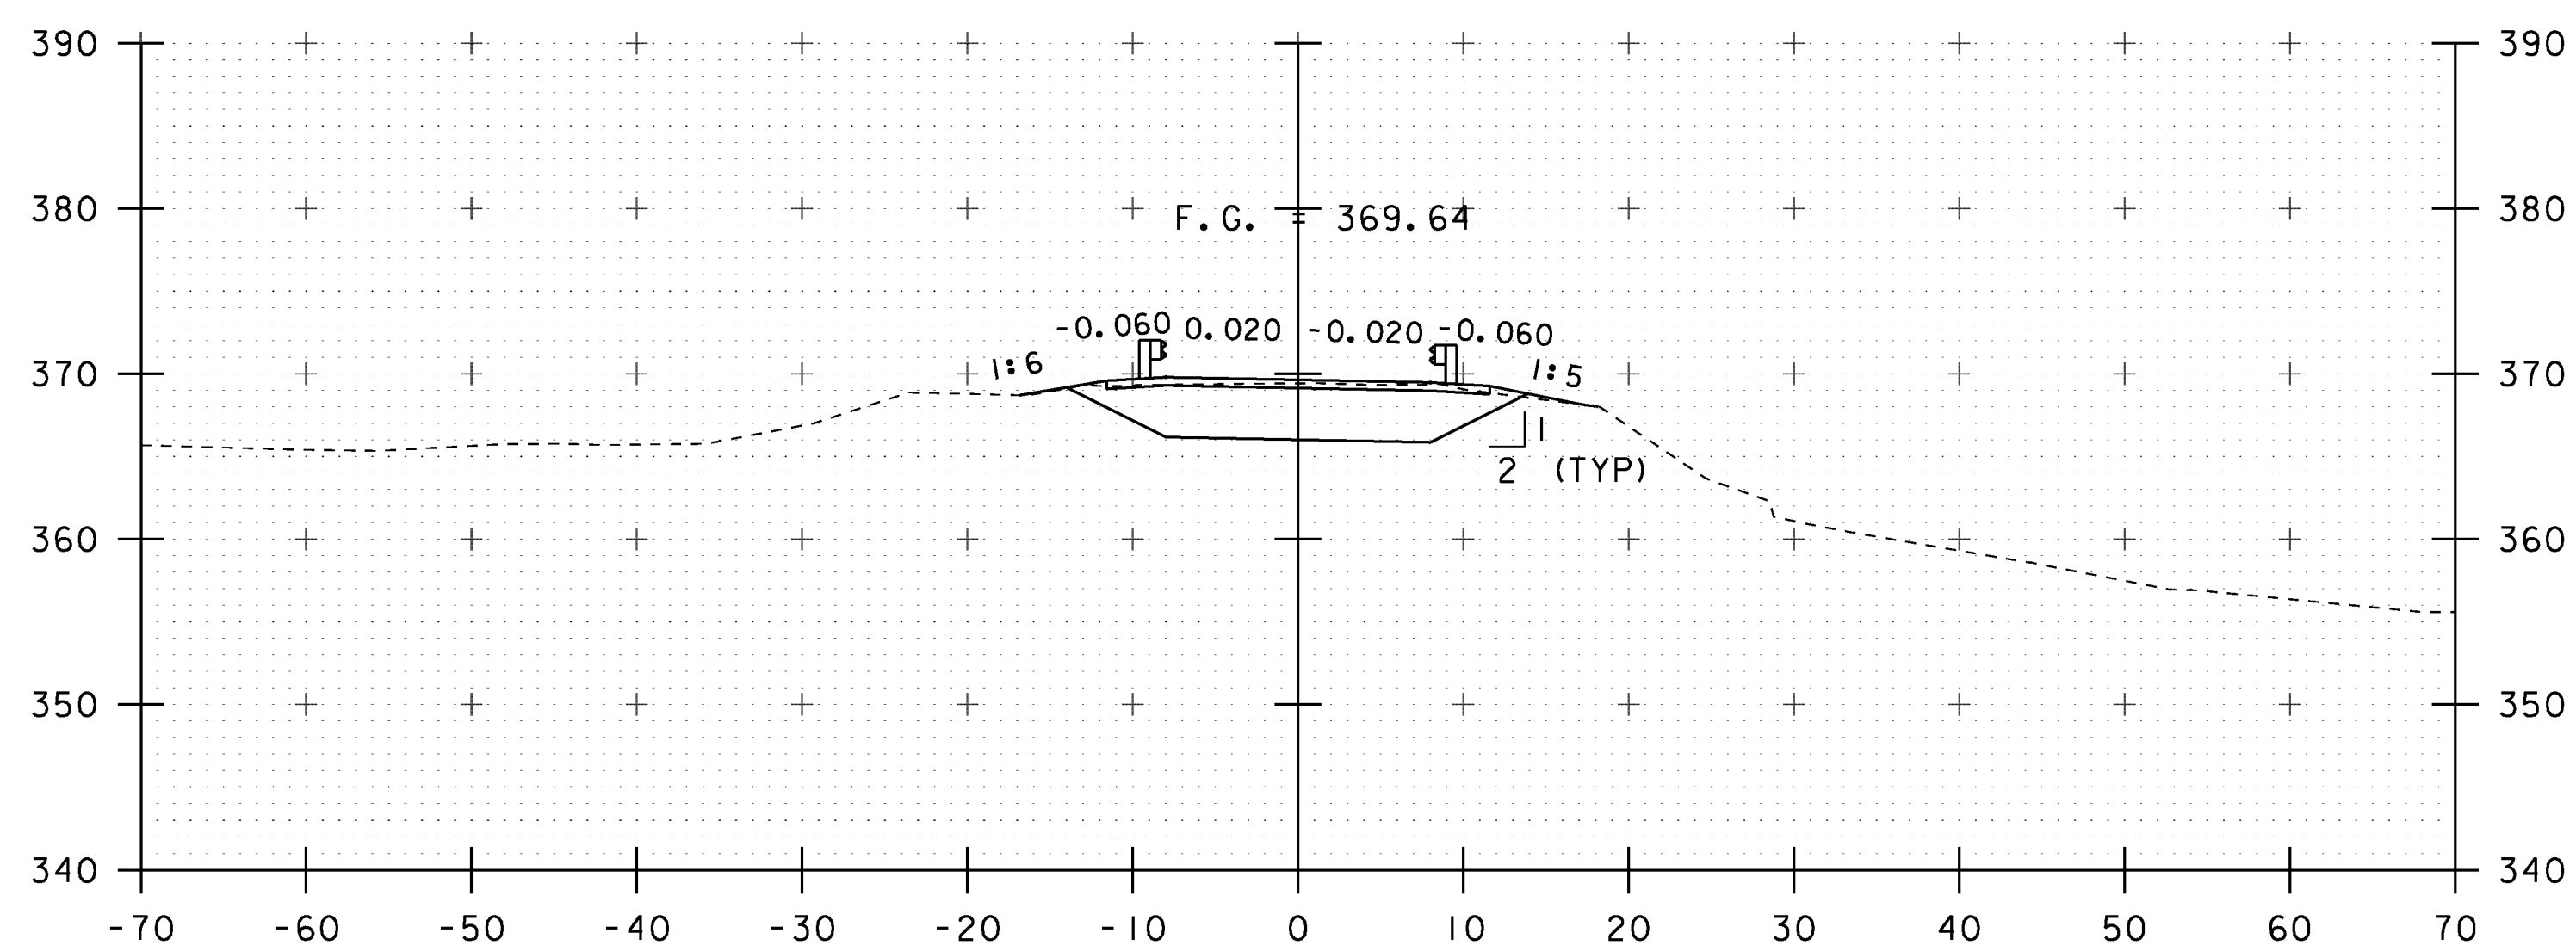

19+50
BEGIN PROJECT
BEGIN BRIDGE STA 19+57.50

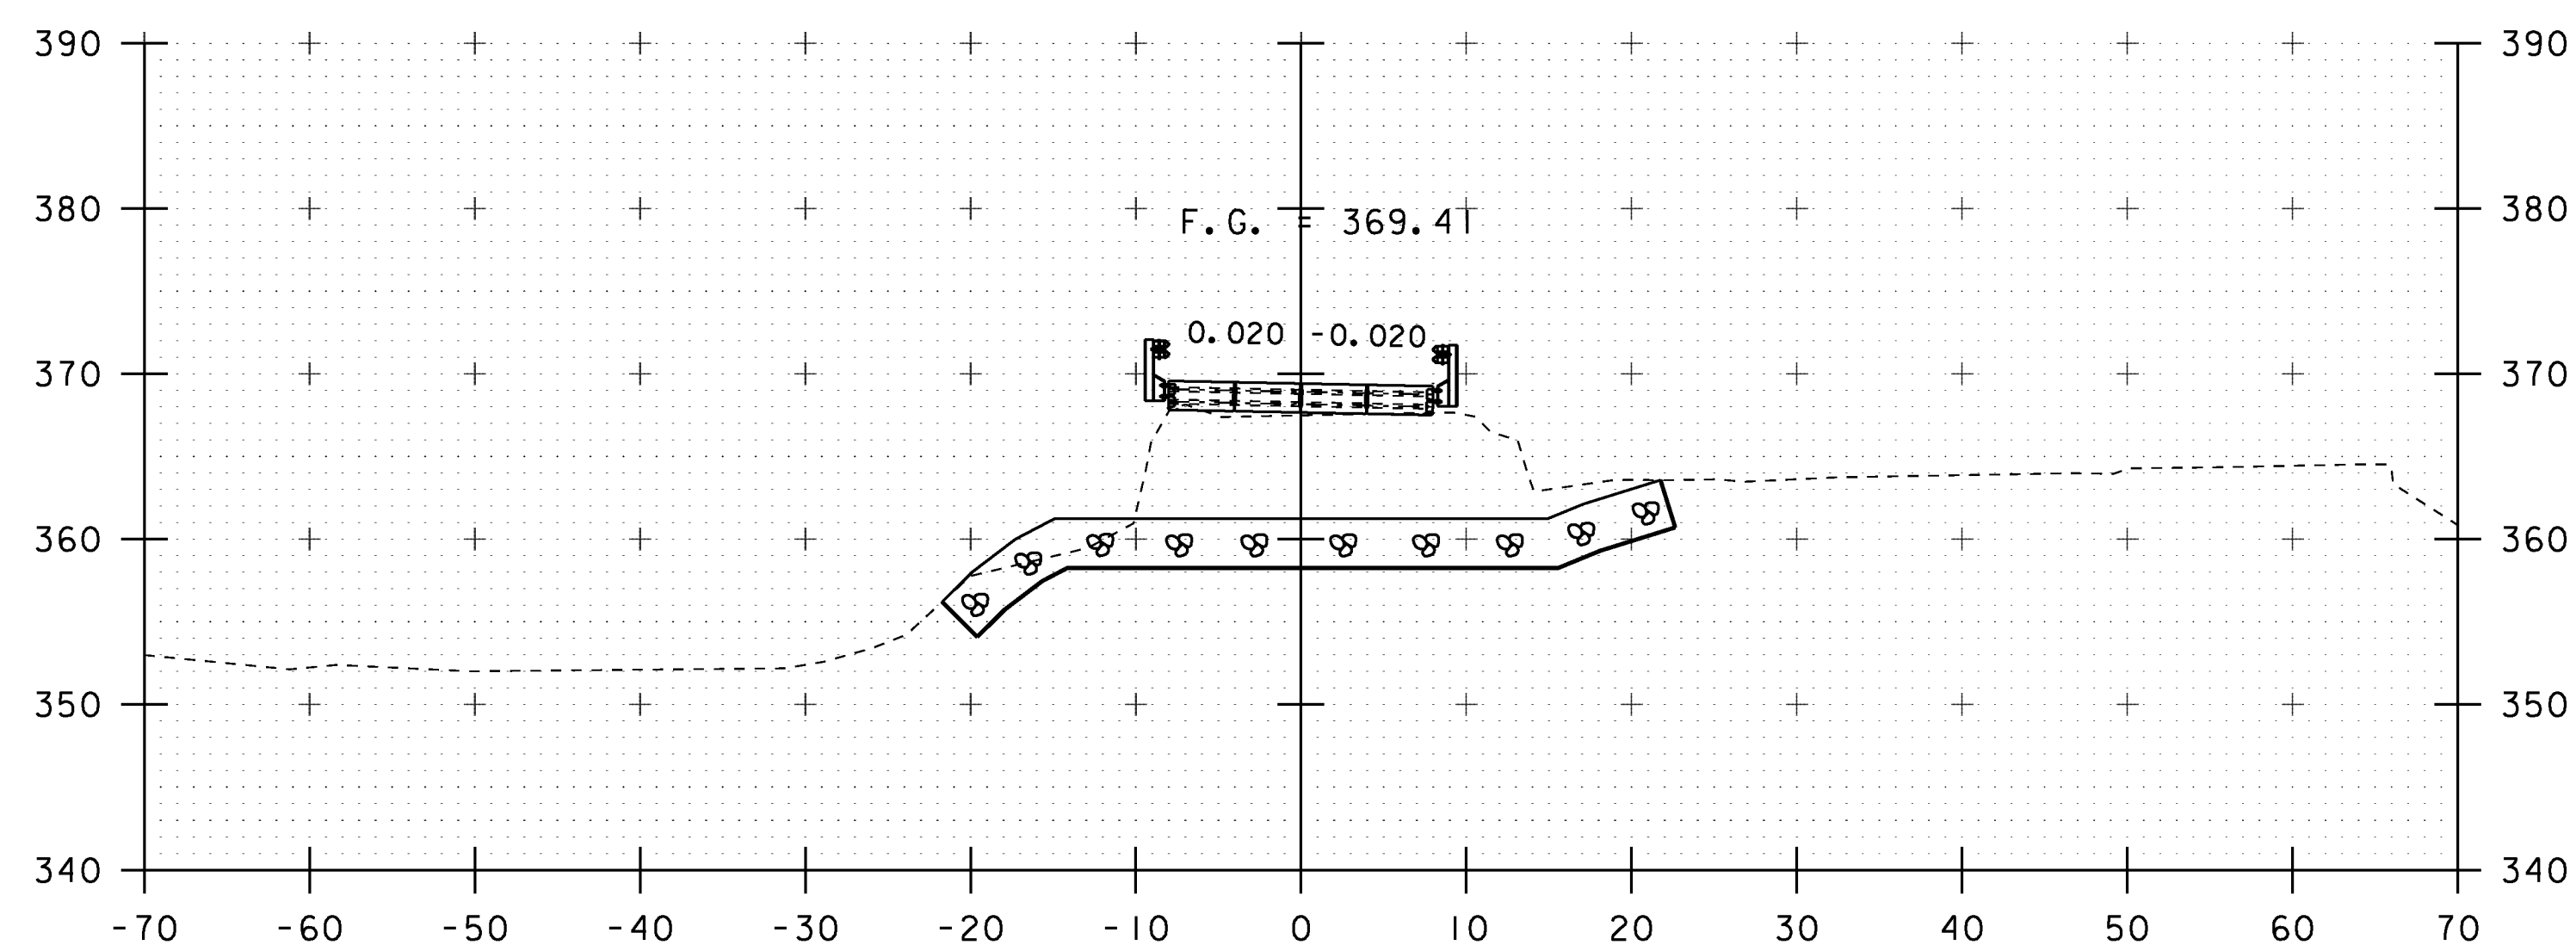

20+00
END BRIDGE STA 20+11.50

STA. 19+50 TO STA. 20+25

PROJECT NAME: FAIRFIELD	PLOT DATE: 18-AUG-2014
PROJECT NUMBER: BRO 1448(4I)	DRAWN BY: K. FRIEDLAND
FILE NAME: sl2j170xs.dgn	CHECKED BY: J. SALVATORI
PROJECT LEADER: R. YOUNG	SHEET 65 OF 69
DESIGNED BY: R. KLINEFELTER	
MAINLINE SECTIONS	