




20+75

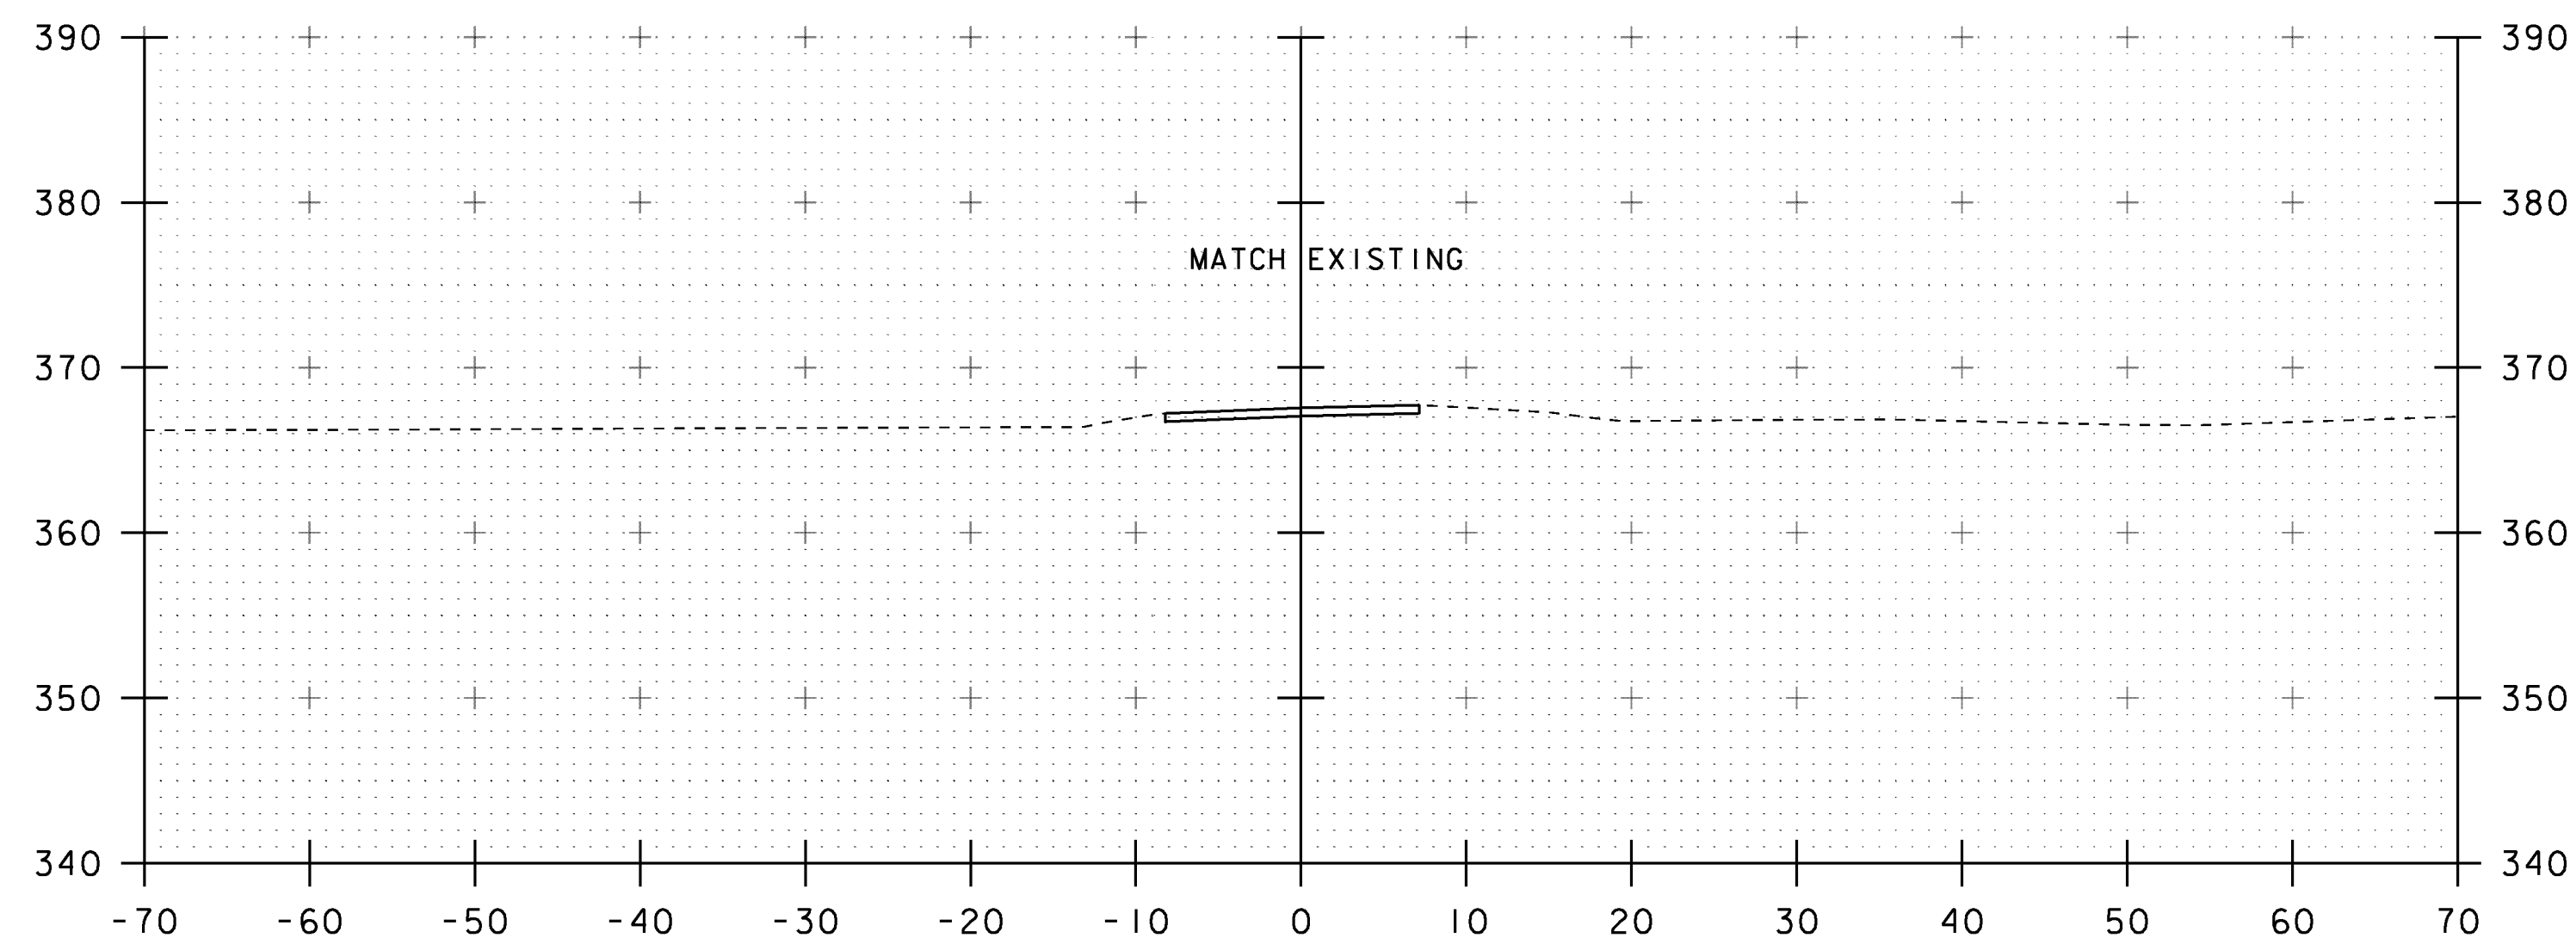

21+25
END APPROACH

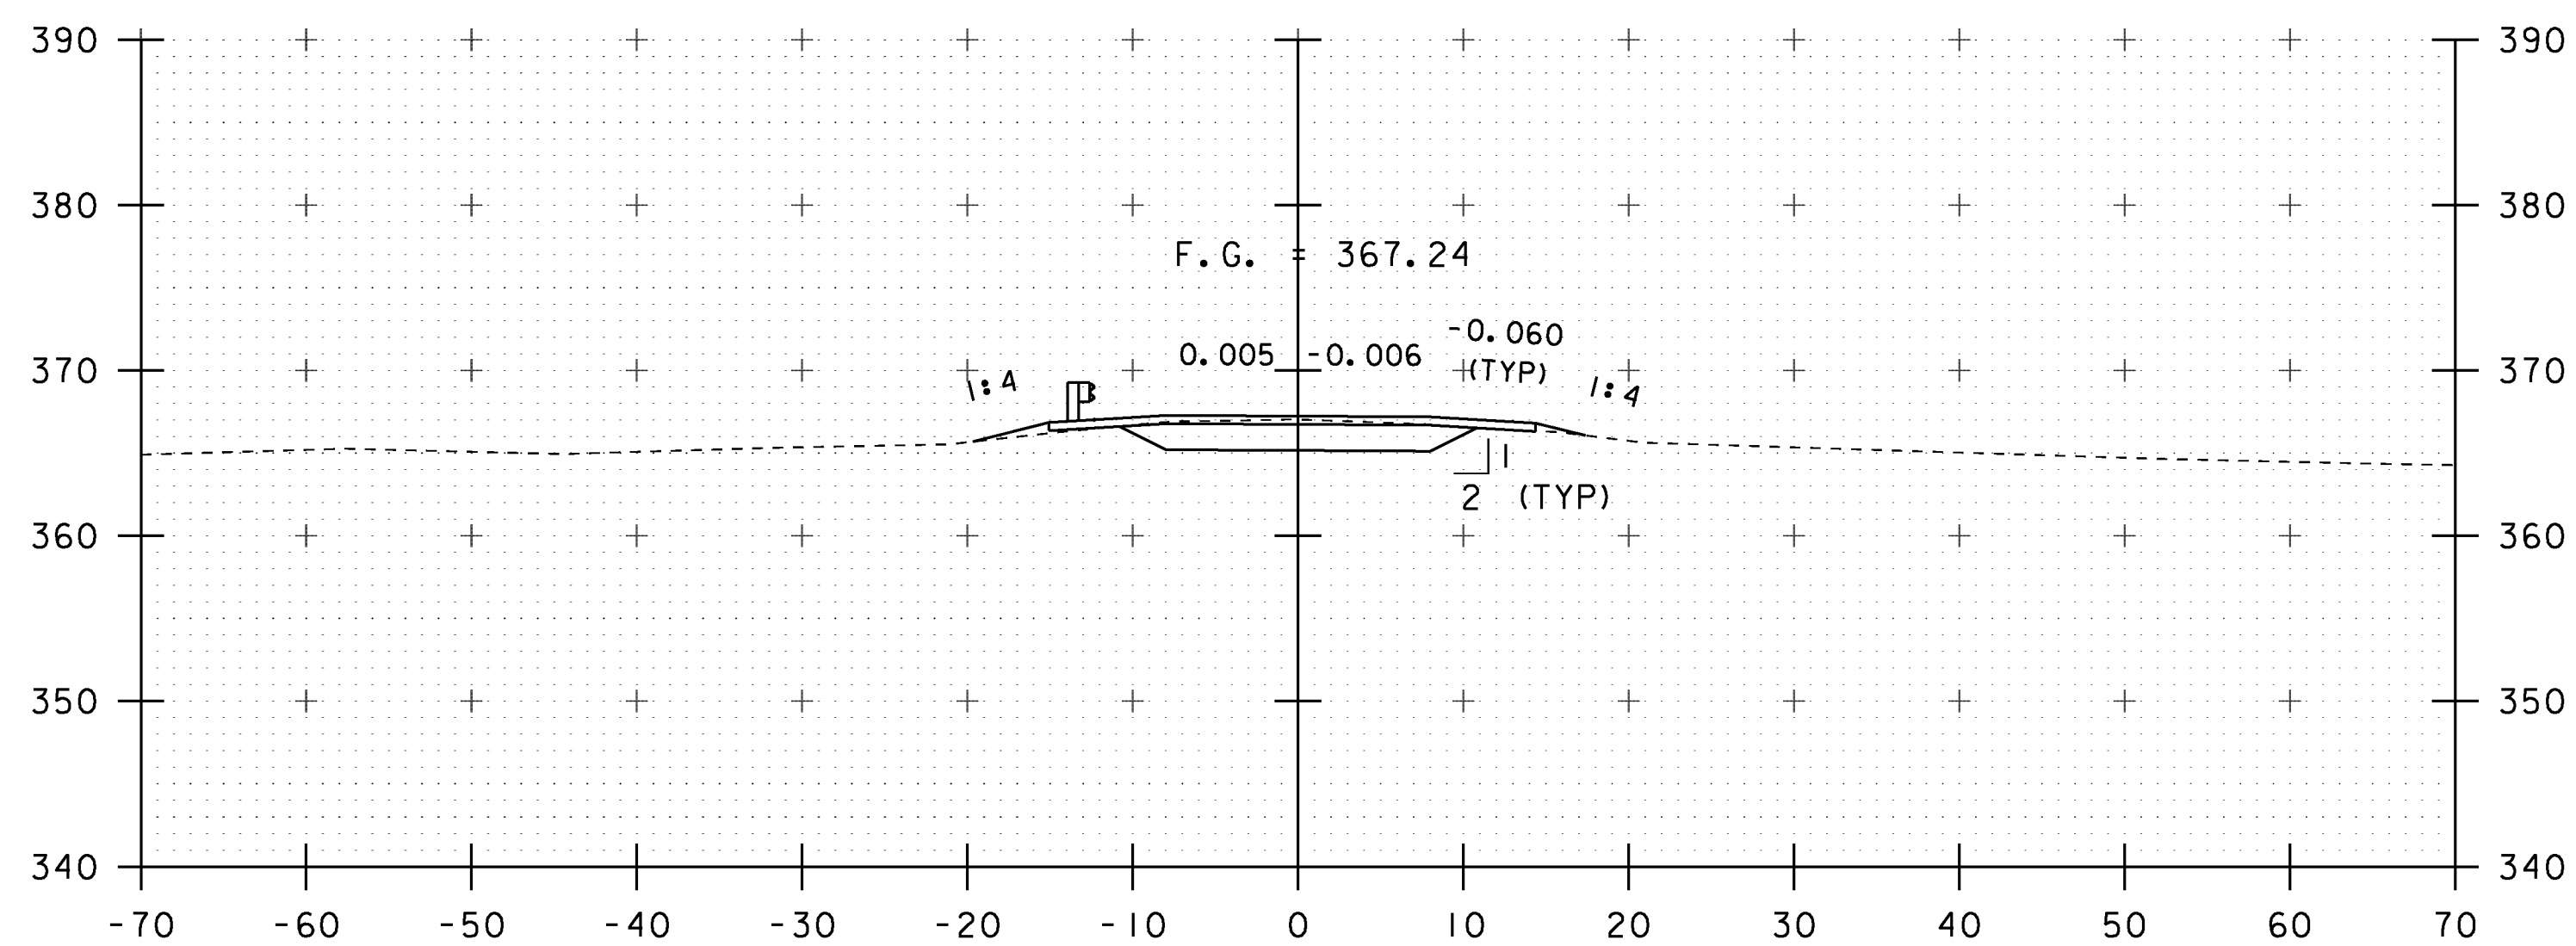

20+50

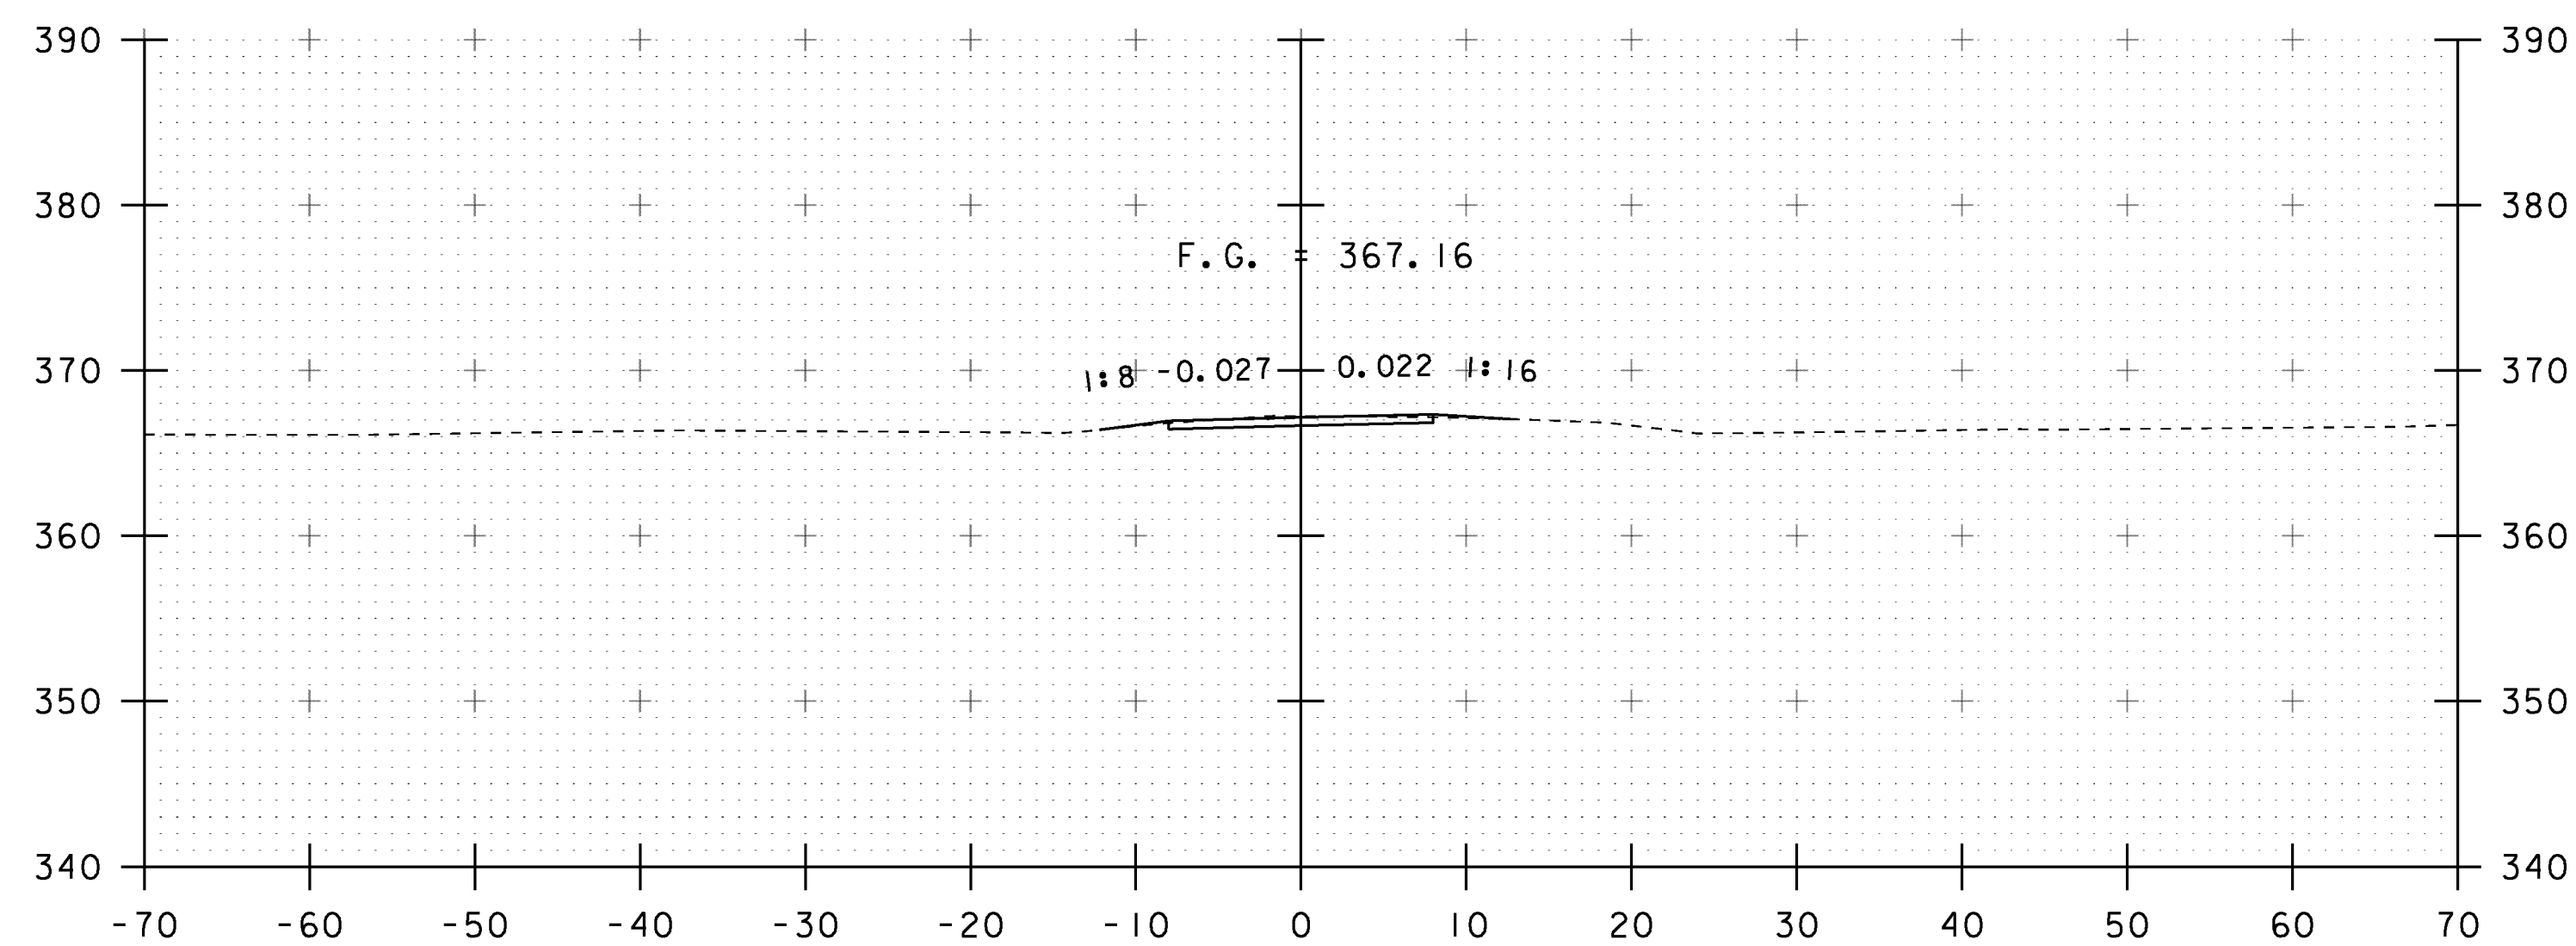

21+00

STA. 20+50 TO STA. 21+25

PROJECT NAME: FAIRFIELD	PLOT DATE: 18-AUG-2014
PROJECT NUMBER: BRO 1448(4)	DRAWN BY: K. FRIEDLAND
FILE NAME: sl2j170xs.dgn	CHECKED BY: J. SALVATORI
PROJECT LEADER: R. YOUNG	SHEET 66 OF 69
DESIGNED BY: R. KLINEFELTER	MAINLINE SECTIONS