



50+25

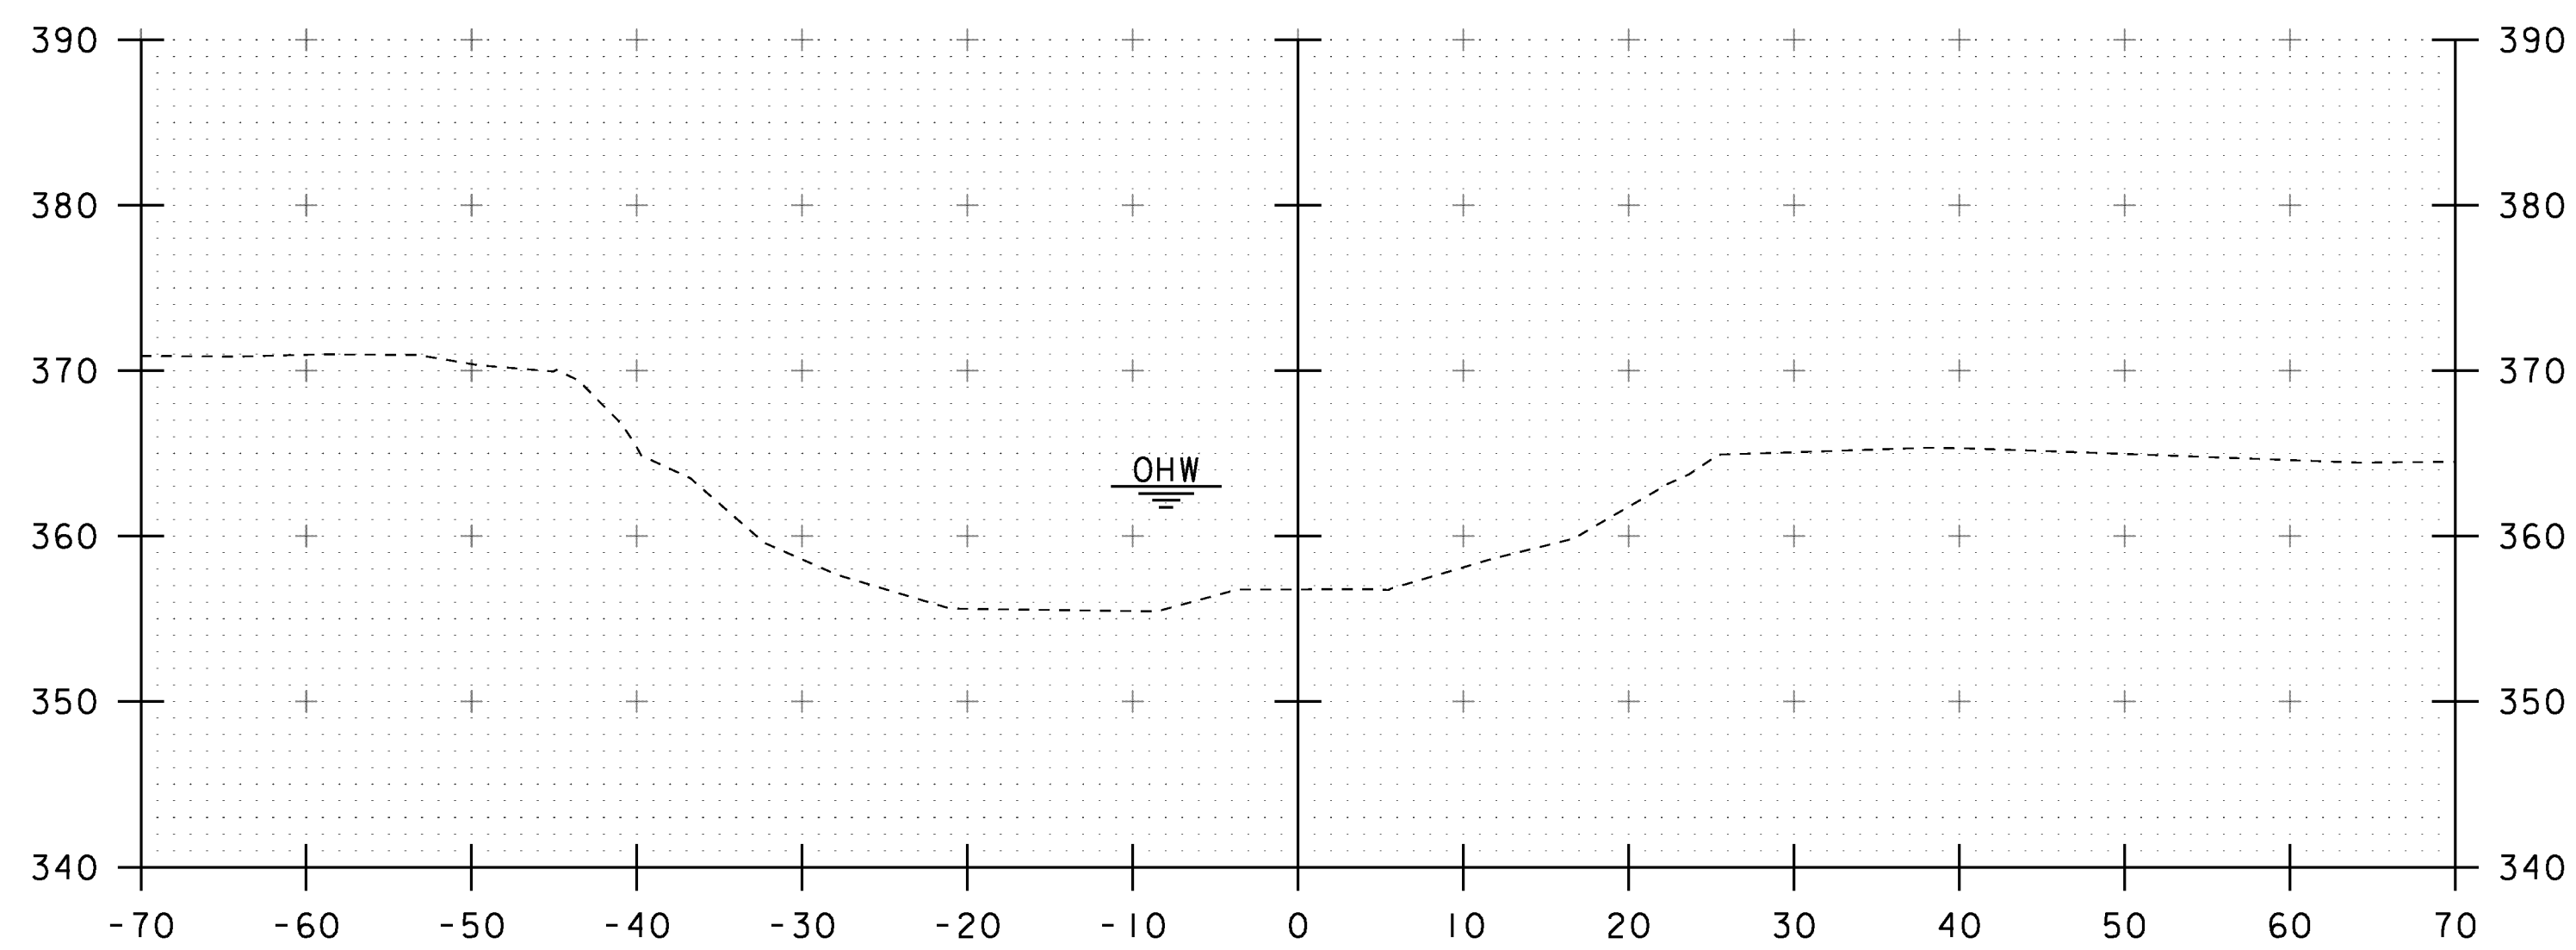

50+00

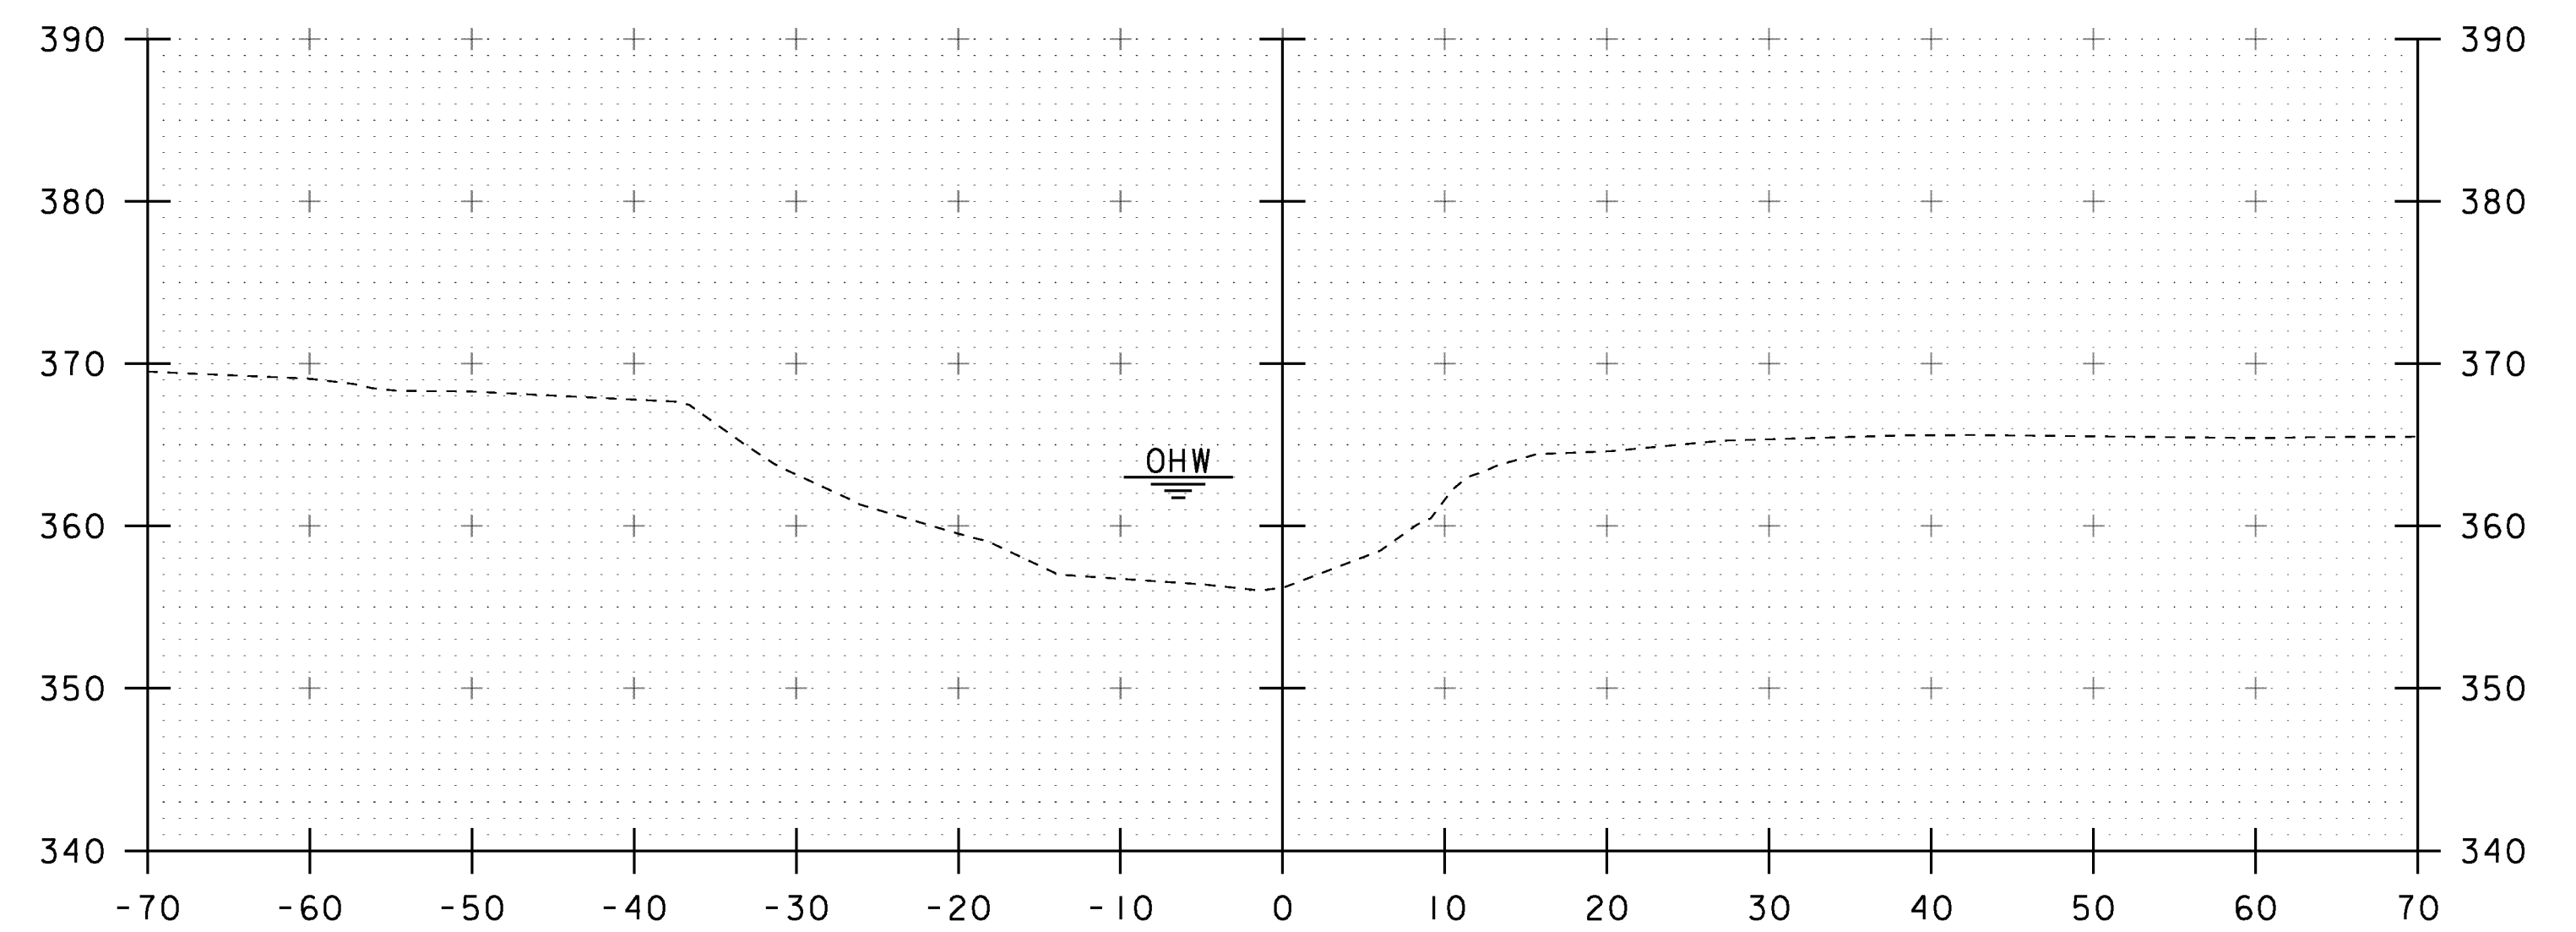

50+50

STA 50+53.00 LT AND RT
 BEGIN STONE FILL, TYPE III
 GEOTEXTILE UNDER STONE FILL
 GRUBBING MATERIAL
 UNCLASSIFIED CHANNEL EXCAVATION

STA. 50+00 TO STA. 50+50

PROJECT NAME: FAIRFIELD	PLLOT DATE: 18-AUG-2014
PROJECT NUMBER: BRO 1448(4)	DRAWN BY: K. FRIEDLAND
FILE NAME: sl2j170xs.dgn	CHECKED BY: J. SALVATORI
PROJECT LEADER: R. YOUNG	SHEET 67 OF 69
DESIGNED BY: R. KLINEFELTER	
CHANNEL SECTIONS	