



50+75

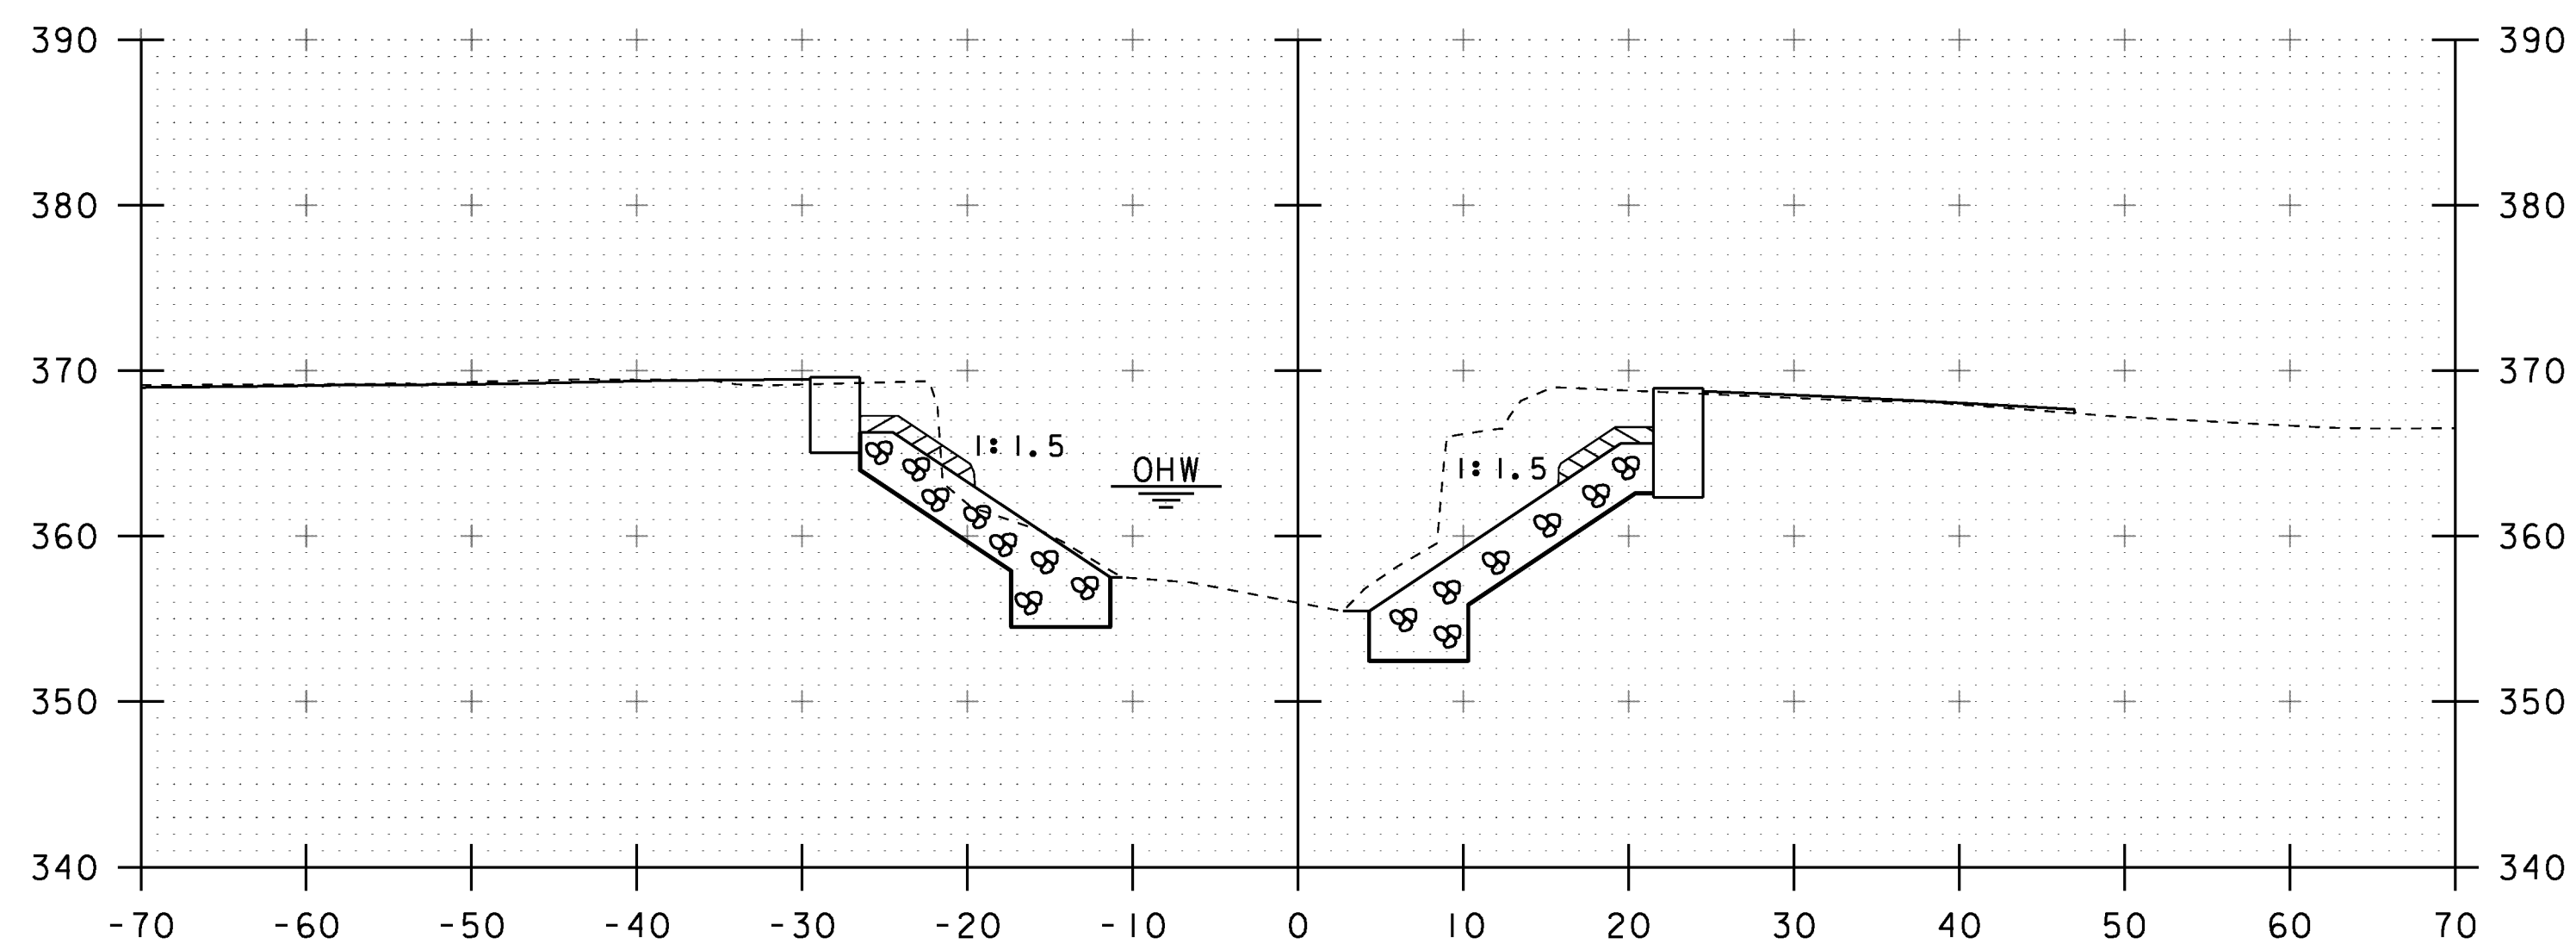

STA 50+67.00 LT AND RT
END GRUBBING MATERIAL

50+65

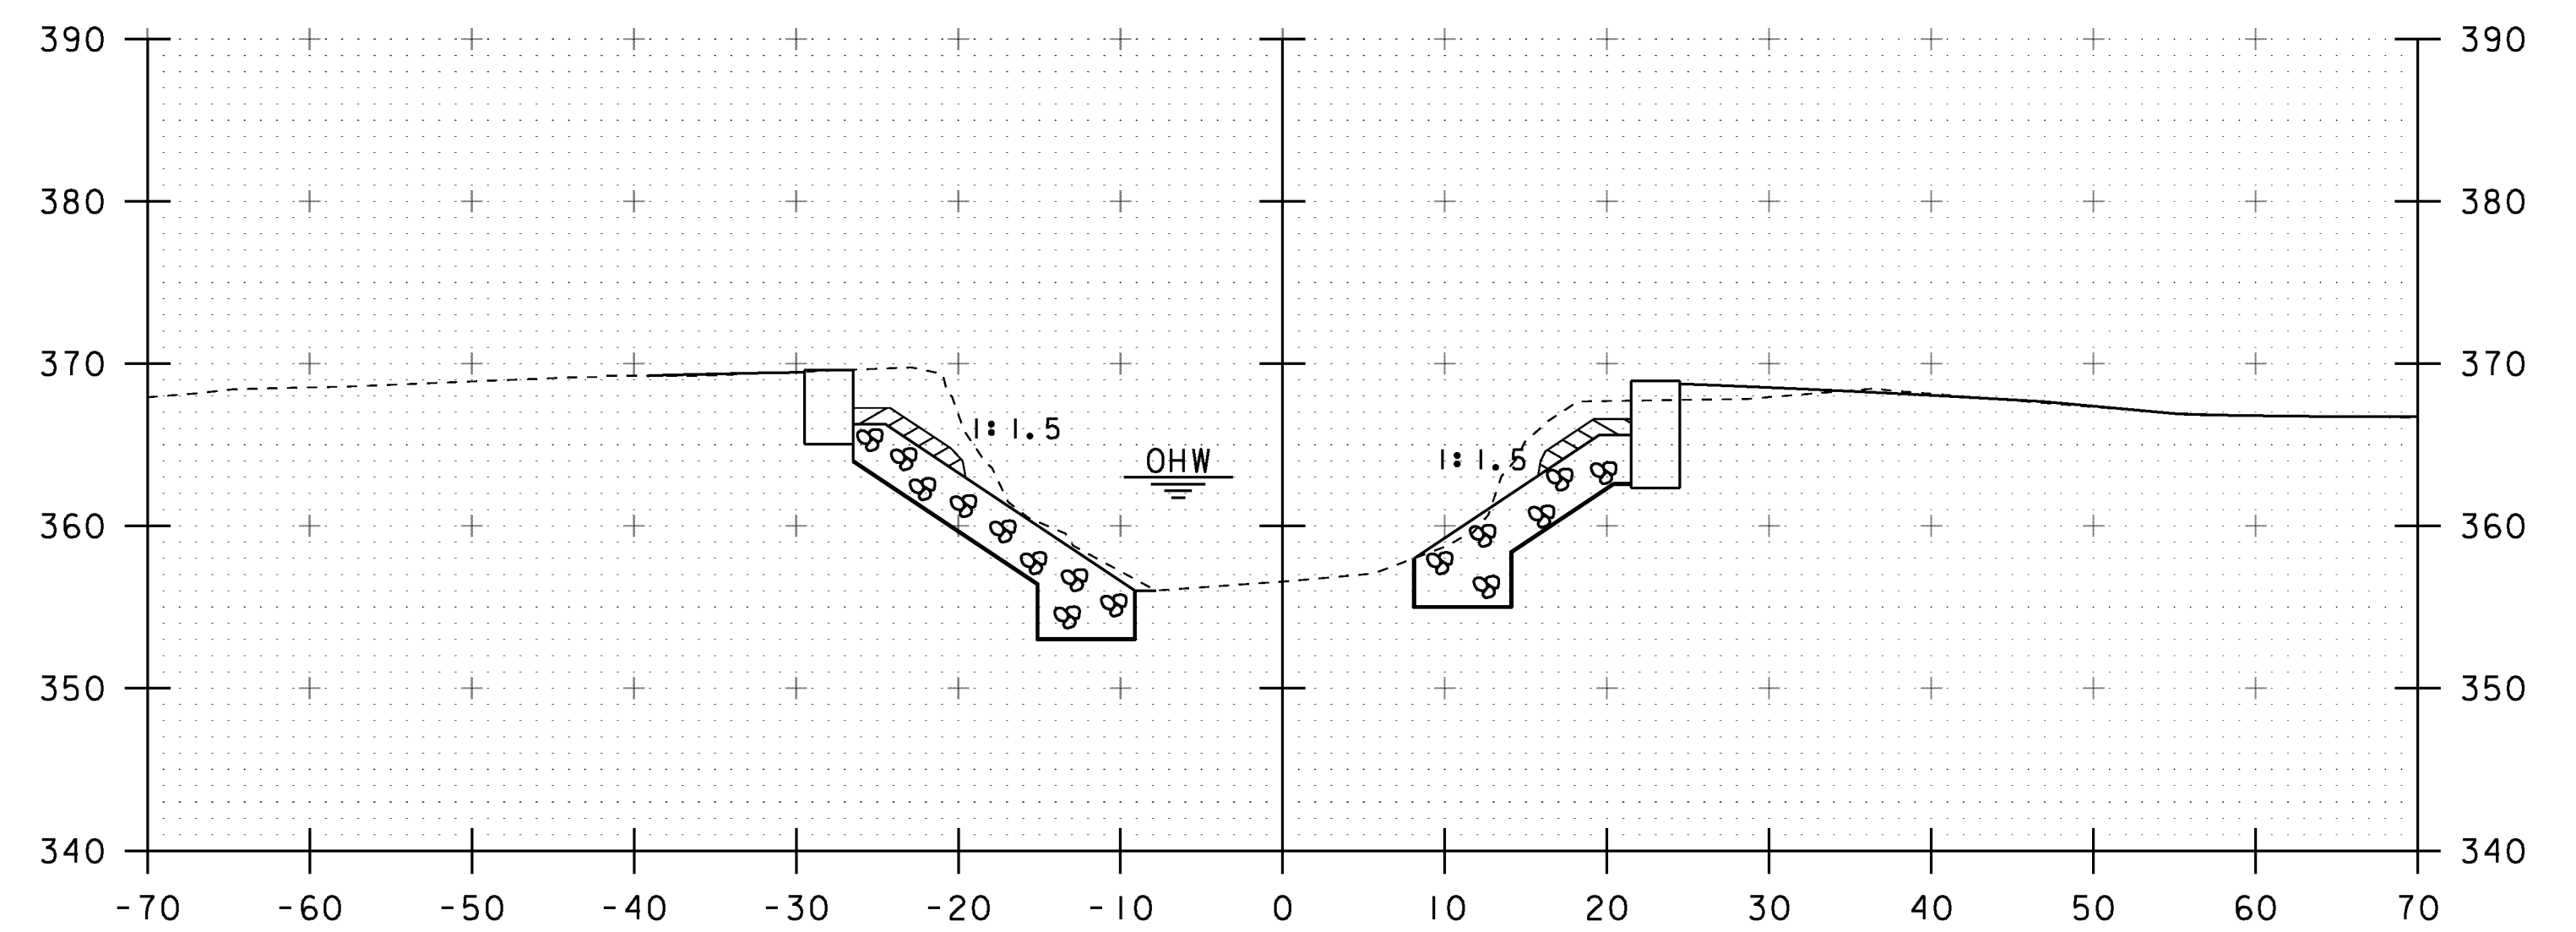

STA 50+83.00 LT AND RT
BEGIN GRUBBING MATERIAL

50+85

PROJECT NAME: FAIRFIELD
PROJECT NUMBER: BRO 1448(4)

FILE NAME: sl2j170xs.dgn
PROJECT LEADER: R. YOUNG
DESIGNED BY: R. KLINEFELTER
CHANNEL SECTIONS

PLOT DATE: 18-AUG-2014
DRAWN BY: K. FRIEDLAND
CHECKED BY: J. SALVATORI
SHEET 68 OF 69

STA. 50+65 TO STA. 50+85