



SEE SHEET 7 FOR
INDEX OF SHEETS AND
LIST OF STANDARDS

STATE OF VERMONT AGENCY OF TRANSPORTATION

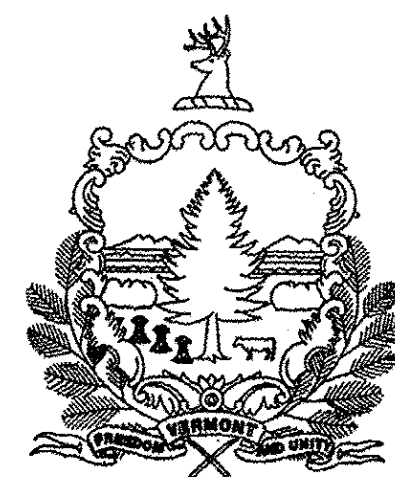


PROPOSED IMPROVEMENT BRIDGE PROJECT

TOWN OF FAIRFIELD
COUNTY OF FRANKLIN

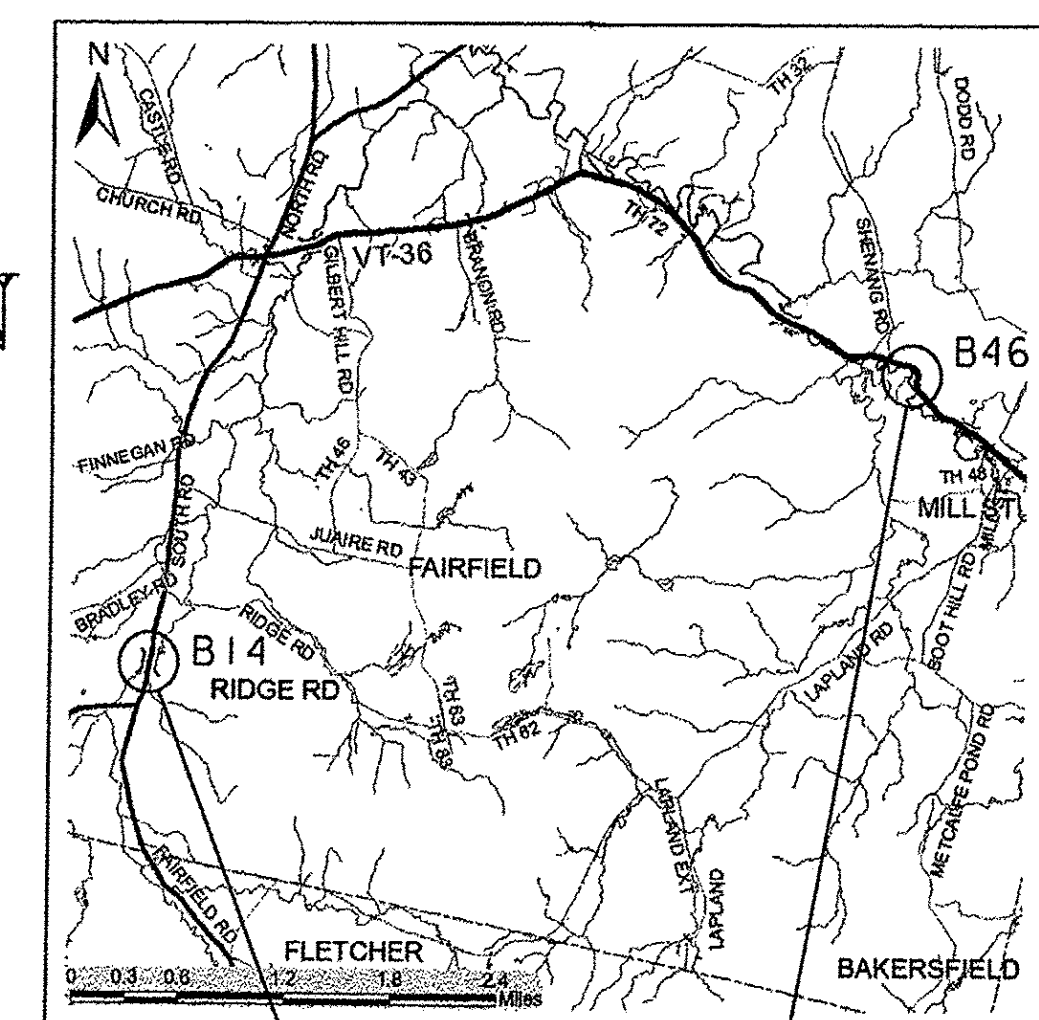

FAIRFIELD
BRF 0281 (25)

FAIRFIELD
BRO 1448 (41)

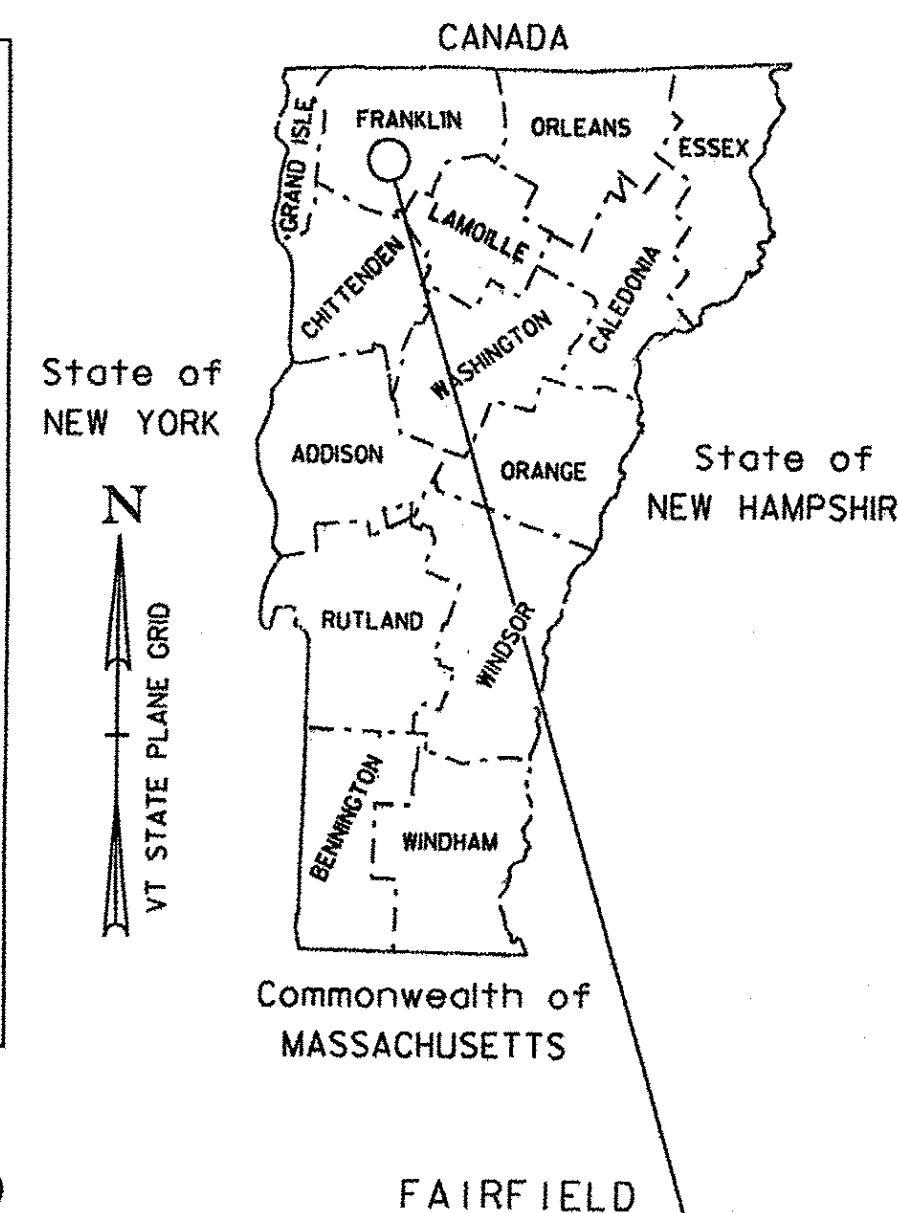


RECORD PLANS	
CONTRACTOR:	A.L. ST. ONGE CONTRACTOR, INC. - MONTGOMERY, VT
RESIDENT ENGINEER:	SCOTT WHEATLEY
CONSTRUCTION BEGAN:	MAY 26, 2015
CONSTRUCTION COMPLETE:	AUGUST 14, 2015
RECORD PLANS BY:	SCOTT WHEATLEY & CRAIG PIERCE
I HEREBY CERTIFY THAT ALL THE CONSTRUCTION REQUIRED BY THIS SET OF DRAWINGS HAS BEEN ACCOMPLISHED AS INDICATED HEREIN.	
BY:	<i>[Signature]</i> RESIDENT ENGINEER
DATE:	JUNE 2, 2016
NOTE: Any further information concerning final quantities, amounts or other details relative to this project may be found at Central Files in the electronic archives.	

FAIRFIELD BRF 0281 (25)

ROUTE NO.: SOUTH ROAD, FAS 0281 (RURAL MAJOR COLLECTOR), CLASS 2 TOWN HIGHWAY
BRIDGE NO.: 14
PROJECT LOCATION: ON TH 1 (FAS 0281), APPROXIMATELY 2.5 MILES SOUTH OF ITS JUNCTION WITH VT 36.
PROJECT DESCRIPTION: REPLACEMENT OF EXISTING BRIDGE (BRIDGE NO. 14) WITH RELATED ROADWAY APPROACH AND CHANNEL WORK.

LENGTH OF STRUCTURE: 44.00 FEET
LENGTH OF ROADWAY: 131.00 FEET
LENGTH OF PROJECT: 175.00 FEET

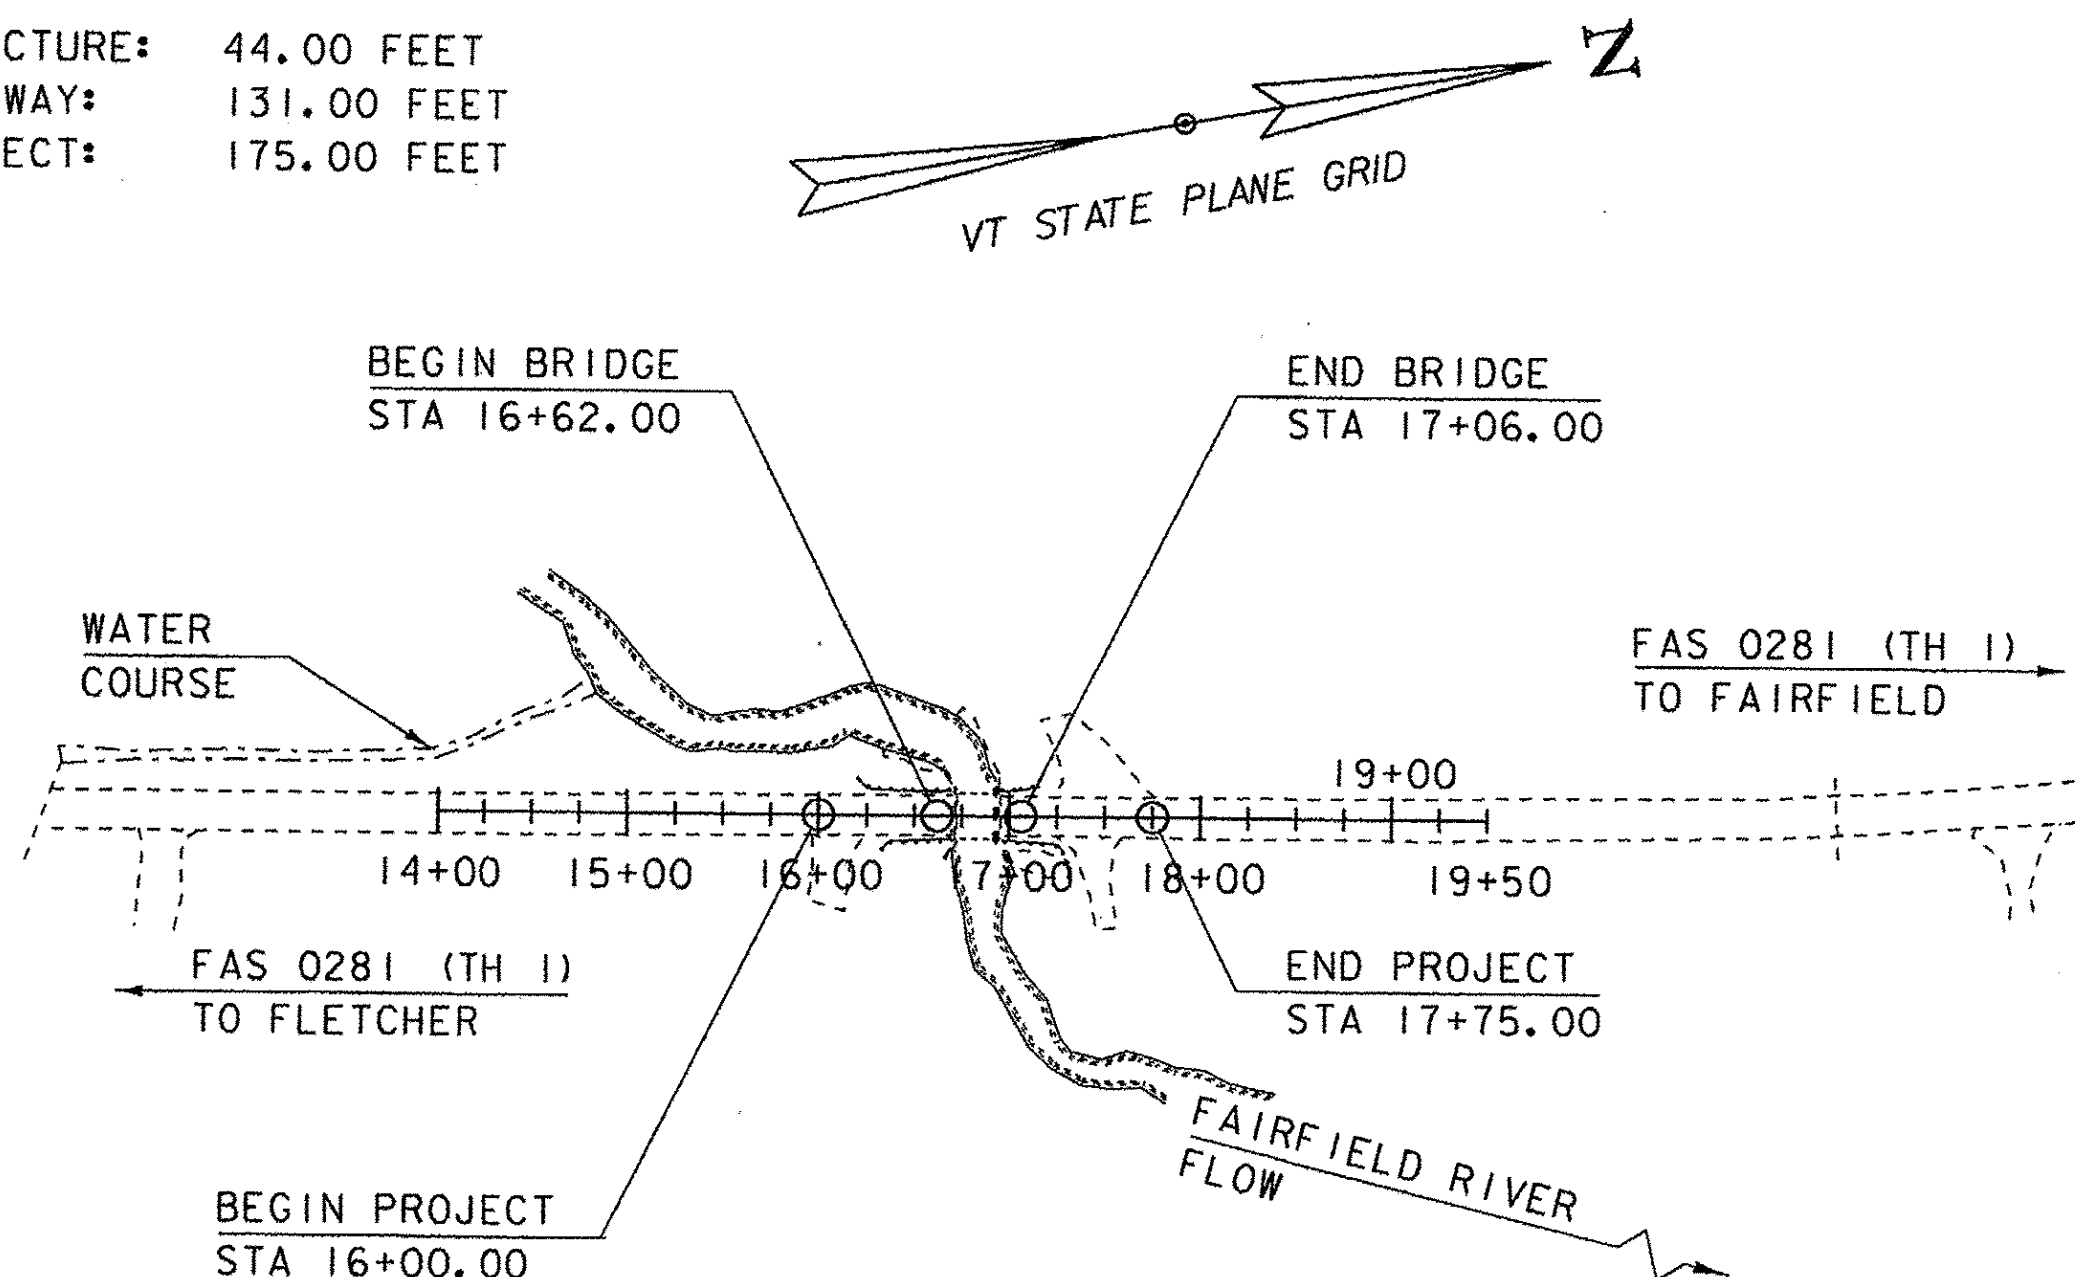

CONSTRUCTION IS TO BE CARRIED ON IN ACCORDANCE WITH THESE PLANS AND THE STANDARD SPECIFICATIONS FOR CONSTRUCTION DATED 2011, AS APPROVED BY THE FEDERAL HIGHWAY ADMINISTRATION ON JULY 20, 2011 FOR USE ON THIS PROJECT, INCLUDING ALL SUBSEQUENT REVISIONS AND SUCH REVISED SPECIFICATIONS AND SPECIAL PROVISIONS AS ARE INCORPORATED IN THESE PLANS.


QUALITY ASSURANCE PROGRAM : LEVEL 2	
SURVEYED BY :	L. ORVIS
SURVEYED DATE :	3/25/12 & 3/11/12
DATUM	
VERTICAL	NAVD88
HORIZONTAL	NAD (83) 2007

SCALE 1" = 100'-0"
50 0 50

FAIRFIELD BRO 1448 (41)

ROUTE NO.: ELM BROOK ROAD, TOWN HIGHWAY 47 (CLASS 3)
BRIDGE NO.: 46
PROJECT LOCATION: 0.05 MILES WESTERLY OF THE JUNCTION OF TOWN HIGHWAY 47 AND VT ROUTE 36.
PROJECT DESCRIPTION: REPLACEMENT OF EXISTING BRIDGE (BRIDGE NO. 46) WITH RELATED ROADWAY APPROACH AND CHANNEL WORK.

LENGTH OF STRUCTURE: 54.00 FEET
LENGTH OF ROADWAY: 21.00 FEET
LENGTH OF PROJECT: 75.00 FEET

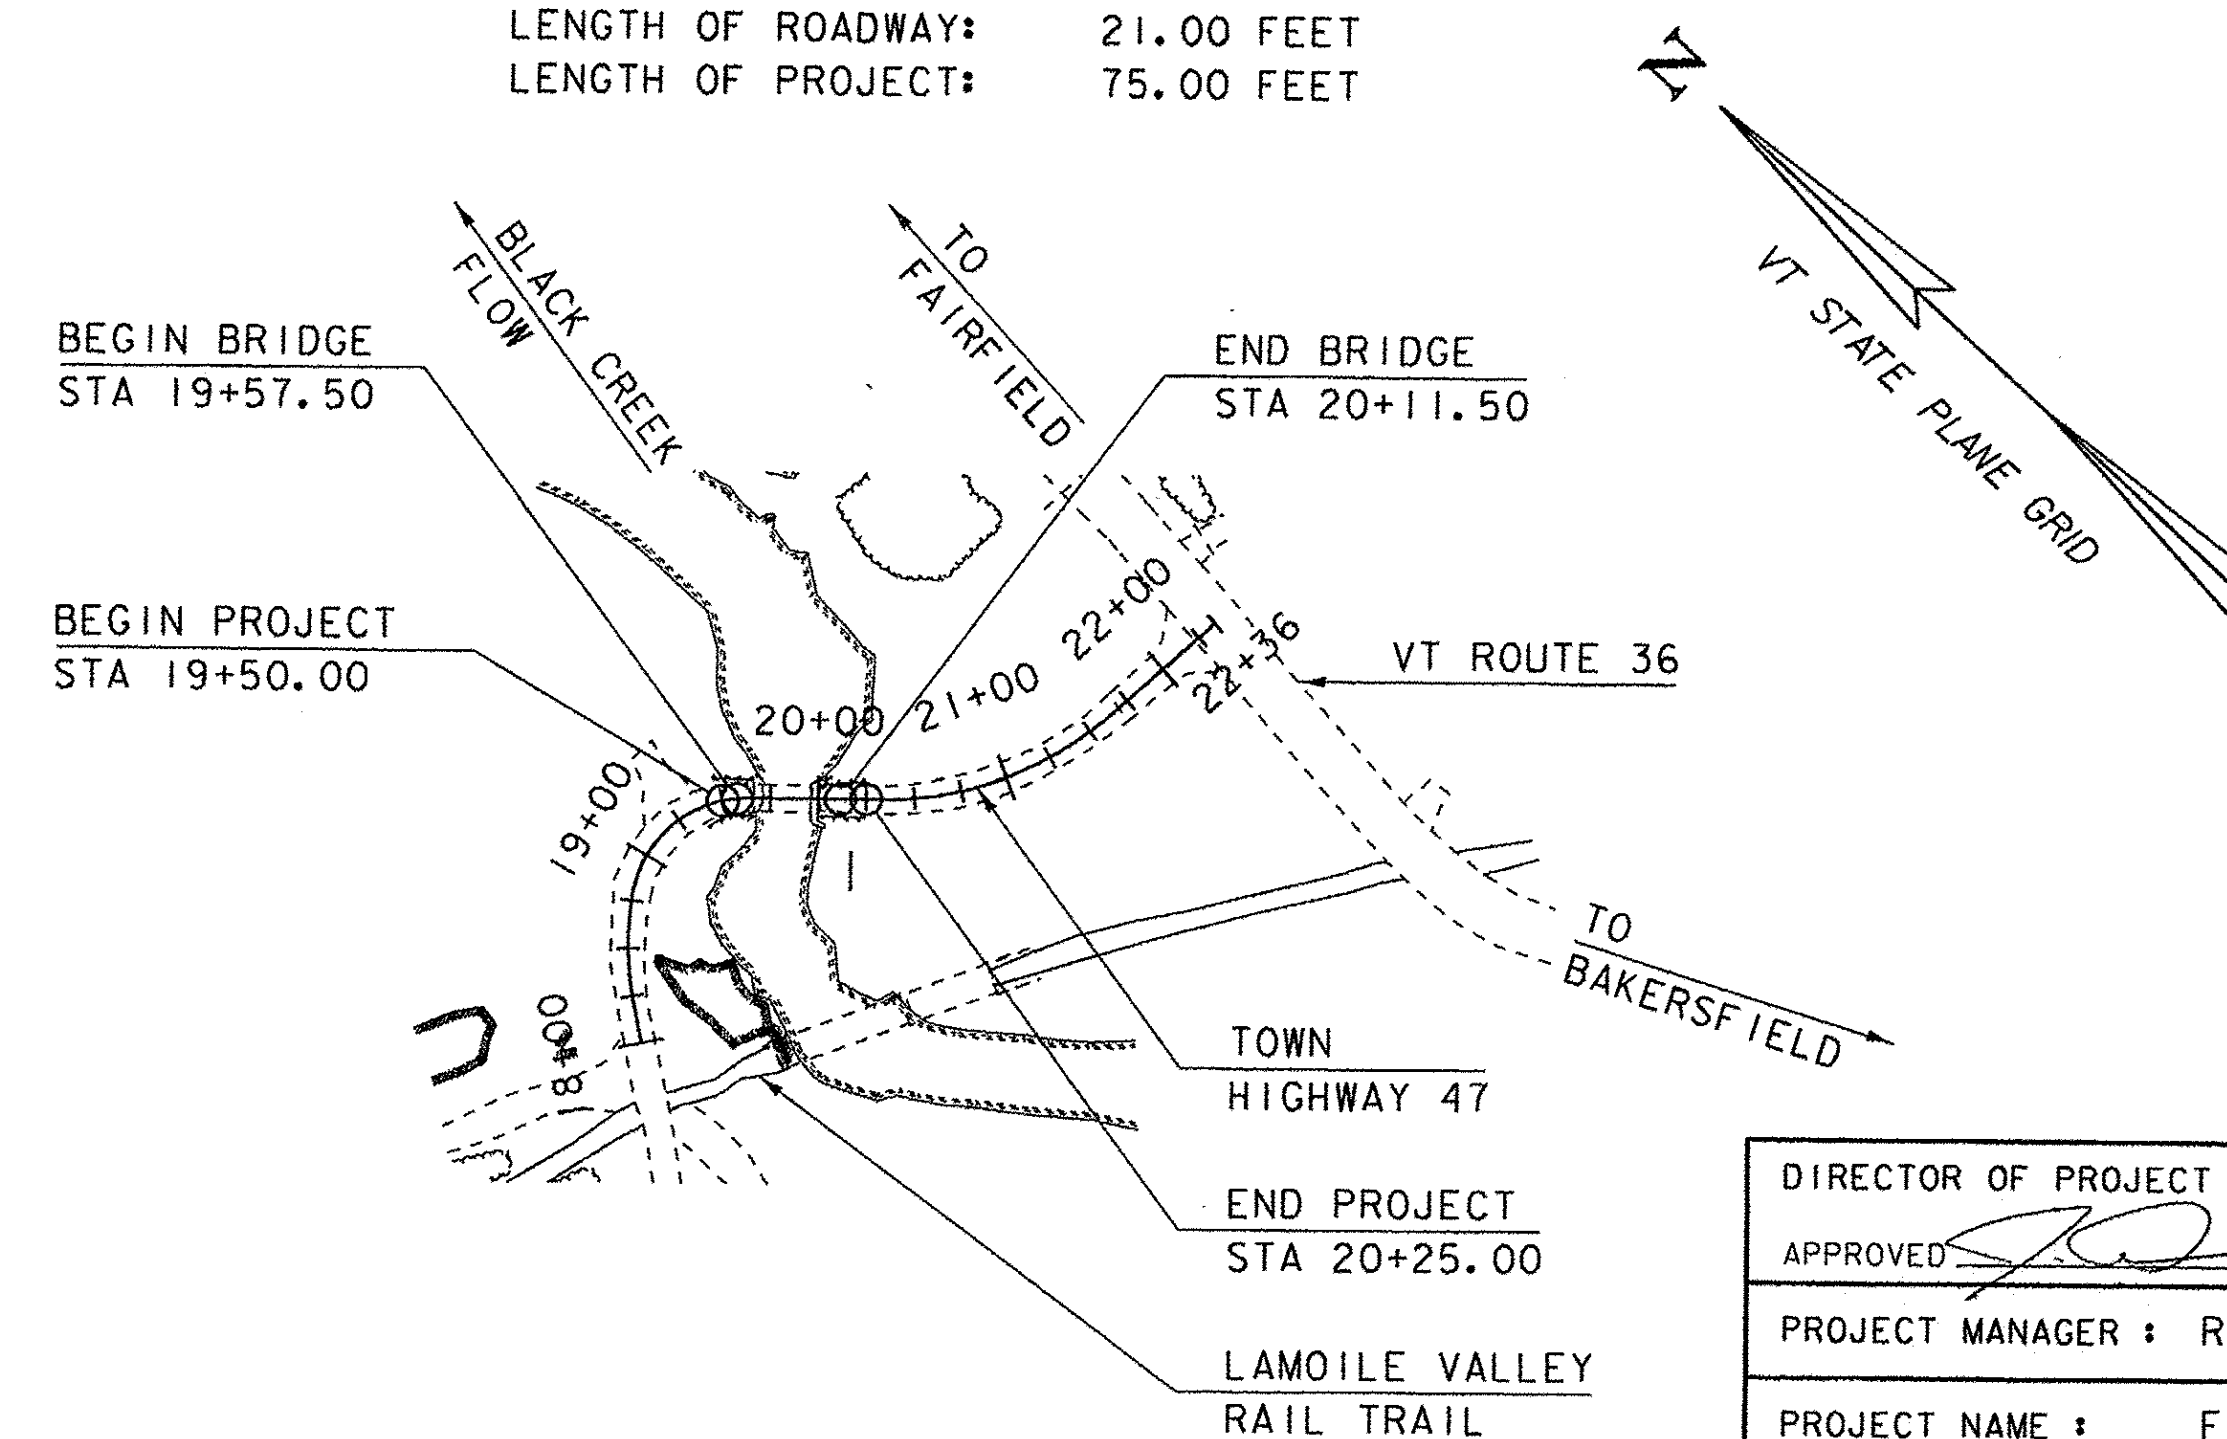

DIRECTOR OF PROJECT DELIVERY	
APPROVED:	<i>[Signature]</i> DATE 8/18/2014
PROJECT MANAGER : R. YOUNG, P.E.	
PROJECT NAME :	FAIRFIELD
PROJECT NUMBER :	BRF 0281 (25) & BRO 1448 (41)
SHEET 1 OF 69	SHEETS

GENERAL INFORMATION

SYMBOLY LEGEND NOTE

THE SYMBOLY ON THIS SHEET IS INTENDED TO COVER STANDARD CONVENTIONAL SYMBOLY. THE SYMBOLY IS USED FOR EXISTING & PROPOSED FEATURES WITH HEAVIER LINEWEIGHT, IN COMBINATION WITH PROJECT ANNOTATION, AS NOTED ON PROJECT PLAN SHEETS. THIS LEGEND SHEET COVERS THE BASICS. SYMBOLY ON PLANS MAY VARY, PLAN ANNOTATIONS AND NOTES SHOULD BE USED TO CLARIFY AS NEEDED.

R. O. W. ABBREVIATIONS (CODES) & SYMBOLS

POINT CODE	DESCRIPTION
CH	CHANNEL EASEMENT
CONST	CONSTRUCTION EASEMENT
CUL	CULVERT EASEMENT
D&C	DISCONNECT & CONNECT
DIT	DITCH EASEMENT
DR	DRAINAGE EASEMENT
DRIVE	DRIVEWAY EASEMENT
EC	EROSION CONTROL
HWY	HIGHWAY EASEMENT
I&M	INSTALL & MAINTAIN EASEMENT
LAND	LANDSCAPE EASEMENT
R&RES	REMOVE & RESET
R&REP	REMOVE & REPLACE
SR	SLOPE RIGHT
UE	UTILITY EASEMENT
(P)	PERMANENT EASEMENT
(T)	TEMPORARY EASEMENT
■	BNDNS BOUND SET
▣	BNDNS BOUND TO BE SET
●	IPNS IRON PIN SET
⊙	IPNS IRON PIN TO BE SET
⊠	CALC EXISTING ROW POINT
○	PROW PROPOSED ROW POINT
[LENGTH]	LENGTH CARRIED ON NEXT SHEET

COMMON TOPOGRAPHIC POINT SYMBOLS

POINT CODE	DESCRIPTION
⊕	APL BOUND APPARENT LOCATION
◻	BM BENCHMARK
▣	BND BOUND
▣	CB CATCH BASIN
⊕	COMB COMBINATION POLE
▣	DITHR DROP INLET THROATED DNC
⊕	EL ELECTRIC POWER POLE
◦	FPOLE FLAGPOLE
○	GASFIL GAS FILLER
○	GP GUIDE POST
×	GSO GAS SHUT OFF
◦	GUY GUY POLE
◦	GUYW GUY WIRE
×	GV GATE VALVE
⊕	H TREE HARDWOOD
△	HCTRL CONTROL HORIZONTAL
▲	HVCTRL CONTROL HORIZ. & VERTICAL
◇	HYD HYDRANT
◦	IP IRON PIN
◦	IPIPE IRON PIPE
⊕	LI LIGHT - STREET OR YARD
⊕	MB MAILBOX
◦	MH MANHOLE (MH)
▣	MM MILE MARKER
◦	PM PARKING METER
▣	PMK PROJECT MARKER
◦	POST POST STONE/WOOD
⊕	RRSIG RAILROAD SIGNAL
⊕	RRSL RAILROAD SWITCH LEVER
⊕	S TREE SOFTWOOD
⊕	SAT SATELLITE DISH
⊕	SHRUB SHRUB
⊕	SIGN SIGN
⊕	STUMP STUMP
⊕	TEL TELEPHONE POLE
◦	TIE TIE
⊕	TSIGN SIGN W/DOUBLE POST
⊕	VCTRL CONTROL VERTICAL
◦	WELL WELL
×	WSO WATER SHUT OFF

THESE ARE COMMON VAOT SURVEY POINT SYMBOLS FOR EXISTING FEATURES, ALSO USED FOR PROPOSED FEATURES WITH HEAVIER LINEWEIGHT, IN COMBINATION WITH PROPOSED ANNOTATION.

PROPOSED GEOMETRY CODES

CODE	DESCRIPTION
PC	POINT OF CURVATURE
PI	POINT OF INTERSECTION
CC	CENTER OF CURVE
PT	POINT OF TANGENCY
PCC	POINT OF COMPOUND CURVE
PRC	POINT OF REVERSE CURVE
POB	POINT OF BEGINNING
POE	POINT OF ENDING
STA	STATION PREFIX
AH	AHEAD STATION SUFFIX
BK	BACK STATION SUFFIX
D	CURVE DEGREE OF (100FT)
R	CURVE RADUIS OF
T	CURVE TANGENT LENGTH
L	CURVE LENGTH OF
E	CURVE EXTERNAL DISTANCE

UTILITY SYMBOLY

UNDERGROUND UTILITIES

— UGU —	UTILITY (GENERIC-UNKNOWN)
— UT —	TELEPHONE
— UE —	ELECTRIC
— UC —	CABLE (TV)
— UEC —	ELECTRIC+CABLE
— UET —	ELECTRIC+TELEPHONE
— UCT —	CABLE+TELEPHONE
— UECT —	ELECTRIC+CABLE+TELEP.
— G —	GAS LINE
— W —	WATER LINE
— S —	SANITARY SEWER (SEPTIC)

ABOVE GROUND UTILITIES (AERIAL)

— AGU —	UTILITY (GENERIC-UNKNOWN)
— T —	TELEPHONE
— E —	ELECTRIC
— C —	CABLE (TV)
— EC —	ELECTRIC+CABLE
— ET —	ELECTRIC+TELEPHONE
— AER E&T —	ELECTRIC+TELEPHONE
— CT —	CABLE+TELEPHONE
— ECT —	ELECTRIC+CABLE+TELEP.
—	UTILITY POLE GUY WIRE

PROJECT CONSTRUCTION SYMBOLY

PROJECT DESIGN & LAYOUT SYMBOLY

— — — — — CZ — — — — —	CLEAR ZONE
— — — — —	PLAN LAYOUT MATCHLINE

PROJECT CONSTRUCTION FEATURES

▲ — — — — — ▲	TOP OF CUT SLOPE
○ — — — — — ○	TOE OF FILL SLOPE
⊕ ⊕ ⊕ ⊕ ⊕	STONE FILL
⊕ — — — — — ⊕	BOTTOM OF DITCH
— — — — —	CULVERT PROPOSED
— — — — —	STRUCTURE SUBSURFACE
PDF — — — — — PDF	PROJECT DEMARCATION FENCE
BF — — — — — BF	BARRIER FENCE
XXXXXXXXXXXXXXXXXXXX	TREE PROTECTION ZONE (TPZ)
//////	STRIPING LINE REMOVAL
~~~~~	SHEET PILES

**CONVENTIONAL BOUNDARY SYMBOLY**

**BOUNDARY LINES**

— — — — —	TOWN BOUNDARY LINE
— — — — —	COUNTY BOUNDARY LINE
— — — — —	STATE BOUNDARY LINE
— — — — —	PROPOSED STATE R.O.W. (LIMITED ACCESS)
— — — — —	PROPOSED STATE R.O.W.
— — — — —	STATE ROW (LIMITED ACCESS)
— — — — —	STATE ROW
— — — — —	TOWN ROW
— — — — —	PERMANENT EASEMENT LINE (P)
— — — — —	TEMPORARY EASEMENT LINE (T)
+	SURVEY LINE
— P — — — — — P — — — — —	PROPERTY LINE (P/L)
▲ — — — — — SR — — — — — SR — — — — — SR — — — — —	SLOPE RIGHTS
6f — — — — — 6f — — — — —	6F PROPERTY BOUNDARY
4f — — — — — 4f — — — — —	4F PROPERTY BOUNDARY
HAZ — — — — — HAZ — — — — —	HAZARDOUS WASTE

**EPSC LAYOUT PLAN SYMBOLY**

**EPSC MEASURES**

ONNOONNOONNO	FILTER CURTAIN
— — — — —	SILT FENCE
— — — — —	SILT FENCE WOVEN WIRE
— — — — —	CHECK DAM
▣	DISTURBED AREAS REQUIRING RE-VEGETATION
⊕	EROSION MATTING

**ENVIRONMENTAL RESOURCES**

— — — — —	WETLAND BOUNDARY
— — — — —	RIPARIAN BUFFER ZONE
— — — — —	WETLAND BUFFER ZONE
— — — — —	SOIL TYPE BOUNDARY
— T&E — — — — —	THREATENED & ENDANGERED SPECIES
— HAZ — — — — —	HAZARDOUS WASTE AREA
— AG — — — — —	AGRICULTURAL LAND
— HABITAT — — — — —	FISH & WILDLIFE HABITAT
— FLOOD PLAIN — — — — —	FLOOD PLAIN
— OHW — — — — —	ORDINARY HIGH WATER (OHW)
— — — — —	STORM WATER
— — — — —	USDA FOREST SERVICE LANDS
— — — — —	WILDLIFE HABITAT SUIT/CONN

**ARCHEOLOGICAL & HISTORIC**

— ARCH — — — — —	ARCHEOLOGICAL BOUNDARY
— HISTORIC DIST — — — — —	HISTORIC DISTRICT BOUNDARY
— HISTORIC — — — — —	HISTORIC AREA
⊕	HISTORIC STRUCTURE

**CONVENTIONAL TOPOGRAPHIC SYMBOLY**

**EXISTING FEATURES**

— — — — —	ROAD EDGE PAVEMENT
— — — — —	ROAD EDGE GRAVEL
— — — — —	DRIVEWAY EDGE
— — — — —	DITCH
— — — — —	FOUNDATION
— — — — —	FENCE (EXISTING)
— — — — —	FENCE WOOD POST
— — — — —	FENCE STEEL POST
— — — — —	GARDEN
— — — — —	ROAD GUARDRAIL
— — — — —	RAILROAD TRACKS
— — — — —	CULVERT (EXISTING)
— — — — —	STONE WALL
— — — — —	WALL
— — — — —	WOOD LINE
— — — — —	BRUSH LINE
— — — — —	HEDGE
— — — — —	BODY OF WATER EDGE
— — — — —	LEDGE EXPOSED

PROJECT NAME: FAIRFIELD  
PROJECT NUMBER: BRF 028(25) & BRO 1448(41)

FILE NAME: sl2j156excel.dgn  
PROJECT LEADER: R. YOUNG  
DESIGNED BY: R. KLINEFELTER  
COMPOSITE LEGEND SHEET

PLOT DATE: 18-AUG-2014  
DRAWN BY: M. LONGSTREET  
CHECKED BY: J. SALVATORI  
SHEET 2 OF 69

# COMPOSITE QUANTITY SHEET 1

FAIRFIELD BRF 0281(25)				FAIRFIELD BRO 1448(41)				TOTALS		DESCRIPTIONS				DETAILED SUMMARY OF QUANTITIES		
ROADWAY	EROSION CONTROL	BRIDGE	FULL C.E. ITEMS	ROADWAY	EROSION CONTROL	BRIDGE	FULL C.E. ITEMS	GRAND TOTAL	FINAL	UNIT	ITEMS	ITEM NUMBER	ROUND	QUANTITIES	UNIT	ITEMS
1								1		LS	CLEARING AND GRUBBING, INCLUDING INDIVIDUAL TREES AND STUMPS (BRF 0281(25))	201.10				
				1				1		LS	CLEARING AND GRUBBING, INCLUDING INDIVIDUAL TREES AND STUMPS (BRO 1448(41))	201.10				
400				250				650		CY	COMMON EXCAVATION	203.15				
						5		5		CY	SOLID ROCK EXCAVATION	203.16				
		270				340		610		CY	UNCLASSIFIED CHANNEL EXCAVATION	203.27				
1				1				2		CY	TRENCH EXCAVATION OF EARTH, EXPLORATORY (N.A.B.I.)	204.22				
		50				100		150		CY	STRUCTURE EXCAVATION	204.25				
		10				60		70		CY	GRANULAR BACKFILL FOR STRUCTURES	204.30				
240								240		SY	COLD PLANING, BITUMINOUS PAVEMENT	210.10				
450				180				630		CY	SUBBASE OF CRUSHED GRAVEL, COARSE GRADED	301.25				
10				90				100		CY	AGGREGATE SURFACE COURSE	401.10				
15								15		CY	AGGREGATE SHOULDERS, IN PLACE	402.10				
6								6		CWT	EMULSIFIED ASPHALT	404.65				
1								1		LU	PRICE ADJUSTMENT, ASPHALT CEMENT (N.A.B.I.)	406.50				
		1						1		LS	FURNISHING EQUIPMENT FOR DRIVING PILING (BRF 0281(25))	504.10				
						1		1		LS	FURNISHING EQUIPMENT FOR DRIVING PILING (BRO 1448(41))	504.10				
		300				100		400		LF	STEEL PILING, HP 12 X 84	505.165				
		2						2		EACH	DYNAMIC PILE LOADING TEST	505.45				
		2400				1800		4200		LB	STRUCTURAL STEEL (FPQ)	506.60				
		220				162		382		LF	GROUTING SHEAR KEYS	510.24				
		48						48		LF	BRIDGE EXPANSION JOINT, ASPHALTIC PLUG	516.10				
		125						125		SY	MEMBRANE WATERPROOFING, SPRAY APPLIED	520.10				
48								48		LF	JOINT SEALER, HOT POURED	524.11				
		100				112.5		212.5		LF	BRIDGE RAILING, GALVANIZED HDSB / FASCIA MOUNTED / STEEL TUBING	525.44				
		1						1		EACH	REMOVAL OF STRUCTURE (605 SF - EST.)	529.15				
						1		1		EACH	REMOVAL OF STRUCTURE (705 SF - EST.)	529.15				
		12				16		28		EACH	BEARING DEVICE ASSEMBLY, PLAIN ELASTOMERIC PAD	531.16				
											BEGIN OPTION AA					
		1						1		LS	PRECAST CONCRETE STRUCTURE (ABUTMENT #1)(BRF 0281(25))	540.10				
		1						1		LS	SPECIAL PROVISION (CONTRACTOR-FABRICATED PRECAST CONCRETE STRUCTURE)(ABUTMENT #1)(BRF 0281(25))	900.645				
											END OPTION AA					
											BEGIN OPTION BB					
						1		1		LS	PRECAST CONCRETE STRUCTURE (ABUTMENT #1)(BRO 1448(41))	540.10				
						1		1		LS	SPECIAL PROVISION (CONTRACTOR-FABRICATED PRECAST CONCRETE STRUCTURE)(ABUTMENT #1)(BRO 1448(41))	900.645				
											END OPTION BB					

PROJECT NAME: FAIRFIELD	PLOT DATE: 11-SEP-2014
PROJECT NUMBER: BRF 0281(25) & BRO 1448(41)	DRAWN BY: K. FRIEDLAND
FILE NAME: sl2j156qs_composite.dgn	CHECKED BY: J. SALVATORI
PROJECT LEADER: R. YOUNG	SHEET 3 OF 69
DESIGNED BY: R. KLINEFELTER	
COMPOSITE QUANTITY SHEET 1	

# COMPOSITE QUANTITY SHEET 2

FAIRFIELD BRF 0281(25)				FAIRFIELD BRO 1448(41)				TOTALS		DESCRIPTIONS				DETAILED SUMMARY OF QUANTITIES		
ROADWAY	EROSION CONTROL	BRIDGE	FULL C.E. ITEMS	ROADWAY	EROSION CONTROL	BRIDGE	FULL C.E. ITEMS	GRAND TOTAL	FINAL	UNIT	ITEMS	ITEM NUMBER	ROUND	QUANTITIES	UNIT	ITEMS
											BEGIN OPTION CC					
		1						1		LS	PRECAST CONCRETE STRUCTURE (ABUTMENT #2)(BRF 0281(25))	540.10				
		1						1		LS	SPECIAL PROVISION (CONTRACTOR-FABRICATED PRECAST CONCRETE STRUCTURE)(ABUTMENT #2)(BRF 0281(25))	900.645				
											END OPTION CC					
											BEGIN OPTION DD					
						1		1		LS	PRECAST CONCRETE STRUCTURE (ABUTMENT #2)(BRO 1448(41))	540.10				
						1		1		LS	SPECIAL PROVISION (CONTRACTOR-FABRICATED PRECAST CONCRETE STRUCTURE)(ABUTMENT #2)(BRO 1448(41))	900.645				
											END OPTION DD					
											BEGIN OPTION EE					
		1						1		LS	PRECAST CONCRETE STRUCTURE (APPROACH SLAB #1)	540.10				
		1						1		LS	SPECIAL PROVISION (CONTRACTOR-FABRICATED PRECAST CONCRETE STRUCTURE)(APPROACH SLAB #1)	900.645				
											END OPTION EE					
											BEGIN OPTION FF					
		1						1		LS	PRECAST CONCRETE STRUCTURE (APPROACH SLAB #2)	540.10				
		1						1		LS	SPECIAL PROVISION (CONTRACTOR-FABRICATED PRECAST CONCRETE STRUCTURE)(APPROACH SLAB #2)	900.645				
											END OPTION FF					
	1				1			2		TON	DUST AND ICE CONTROL WITH CALCIUM CHLORIDE	609.15				
25								25		CY	STONE FILL, TYPE I	613.10				
		170				230		400		CY	STONE FILL, TYPE III	613.12				
58				58				116		LF	STEEL BEAM GUARDRAIL, GALVANIZED	621.20				
4				4				8		EACH	ANCHOR FOR STEEL BEAM RAIL	621.60				
4				4				8		EACH	GUARDRAIL APPROACH SECTION, GALV HD STEEL BEAM	621.737				
148				93				241		LF	REMOVAL AND DISPOSAL OF GUARDRAIL	621.80				
500								500		HR	FLAGGERS	630.15				
			0.5				0.5	1		LS	FIELD OFFICE, ENGINEERS	631.10				
			0.5				0.5	1		LS	TESTING EQUIPMENT, CONCRETE	631.16				
			1				1	1		LS	TESTING EQUIPMENT, BITUMINOUS	631.17				
			1500				1500	3000		DL	FIELD OFFICE TELEPHONE (N.A.B.I.)	631.26				
0.5				0.5				1		LS	MOBILIZATION/DEMOBILIZATION	635.11				
650								650		LF	4 INCH YELLOW LINE	646.21				
600				160				760		SY	GEOTEXTILE FOR ROADBED SEPARATOR	649.11				
		190				280		470		SY	GEOTEXTILE UNDER STONE FILL	649.31				
	180				180			360		SY	GEOTEXTILE FOR SILT FENCE, WOVEN WIRE REINFORCED	649.515				
	60				80			140		SY	GEOTEXTILE FOR FILTER CURTAIN	649.61				
	5				5			10		LB	SEED	651.15				
	40				30			70		LB	FERTILIZER	651.18				
	1				1			2		TON	AGRICULTURAL LIMESTONE	651.20				
	1				1			2		TON	HAY MULCH	651.25				


PROJECT NAME: FAIRFIELD  
 PROJECT NUMBER: BRF 0281(25) & BRO 1448(41)  
 FILE NAME: sl2j156qs_composite.dgn  
 PROJECT LEADER: R. YOUNG  
 DESIGNED BY: R. KLINEFELTER  
 COMPOSITE QUANTITY SHEET 2  
 PLOT DATE: 11-SEP-2014  
 DRAWN BY: K. FRIEDLAND  
 CHECKED BY: J. SALVATORI  
 SHEET 4 OF 69

# COMPOSITE QUANTITY SHEET 3

FAIRFIELD BRF 0281(25)				FAIRFIELD BRO 1448(41)				TOTALS		DESCRIPTIONS				DETAILED SUMMARY OF QUANTITIES		
ROADWAY	EROSION CONTROL	BRIDGE	FULL C.E. ITEMS	ROADWAY	EROSION CONTROL	BRIDGE	FULL C.E. ITEMS	GRAND TOTAL	FINAL	UNIT	ITEMS	ITEM NUMBER	ROUND	QUANTITIES	UNIT	ITEMS
	20				25			45		CY	TOPSOIL	651.35				
		110				70		180		SY	GRUBBING MATERIAL	651.40				
	1							1		LS	EPSC PLAN (BRF 0281(25))	652.10				
					1			1		LS	EPSC PLAN (BRO 1448(41))	652.10				
	40				20			60		HR	MONITORING EPSC PLAN	652.20				
	1							1		LU	MAINTENANCE OF EPSC PLAN (N.A.B.I.) (BRF 0281(25))	652.30				
					1			1		LU	MAINTENANCE OF EPSC PLAN (N.A.B.I.) (BRO 1448(41))	652.30				
	60							60		SY	TEMPORARY EROSION MATTING	653.20				
	36				18			54		CY	VEHICLE TRACKING PAD	653.35				
	290				480			770		LF	BARRIER FENCE	653.50				
	280							280		LF	PROJECT DEMARCATION FENCE	653.55				
0.66				0.66				1.32		SF	TRAFFIC SIGNS, TYPE A	675.20				
16				30				46		LF	SQUARE TUBE SIGN POST AND ANCHOR	675.341				
				2				2		EACH	REMOVING SIGNS	675.50				
				2				2		EACH	ERECTING SALVAGED SIGNS	675.60				
4				4				8		EACH	DELINEATOR WITH STEEL POST	676.10				
		6				4		10		CY	SPECIAL PROVISION (HIGH PERFORMANCE CONCRETE, RAPID SET)(FPQ)	900.608				
						50		50		LF	SPECIAL PROVISION (PRE-EXCAVATION OF INTEGRAL ABUTMENT PILES, EARTH)	900.640				
						30		30		LF	SPECIAL PROVISION (PRE-EXCAVATION OF INTEGRAL ABUTMENT PILES, ROCK)	900.640				
		264						264		LF	SPECIAL PROVISION (PRESTRESSED CONCRETE SOLID SLABS)(15" x 48")	900.640				
						216		216		LF	SPECIAL PROVISION (PRESTRESSED CONCRETE SOLID SLABS)(21" x 48")	900.640				
0.5				0.5				1		LS	SPECIAL PROVISION (CPM SCHEDULE)	900.645				
1								1		LS	SPECIAL PROVISION (TRAFFIC CONTROL, ALL-INCLUSIVE)(BRF 0281(25))	900.645				
				1				1		LS	SPECIAL PROVISION (TRAFFIC CONTROL, ALL-INCLUSIVE)(BRO 1448(41))	900.645				
1								1		LU	SPECIAL PROVISION (INCENTIVE/DISINCENTIVE)(N.A.B.I.)	900.650				
1								1		LU	SPECIAL PROVISION (MAT DENSITY PAY ADJUSTMENT, SMALL QUANTITY)(N.A.B.I.)	900.650				
1								1		LU	SPECIAL PROVISION (MIXTURE PAY ADJUSTMENT)(N.A.B.I.)	900.650				
185								185		TON	SPECIAL PROVISION ((BITUMINOUS CONCRETE PAVEMENT, SMALL QUANTITY)	900.680				

PROJECT NAME: FAIRFIELD  
 PROJECT NUMBER: BRF 0281(25) & BRO 1448(41)  
 FILE NAME: sl2j156qs_composite.dgn  
 PROJECT LEADER: R. YOUNG  
 DESIGNED BY: R. KLINEFELTER  
 COMPOSITE QUANTITY SHEET 3  
 PLOT DATE: 18-AUG-2014  
 DRAWN BY: K. FRIEDLAND  
 CHECKED BY: J. SALVATORI  
 SHEET 5 OF 69

# STATE OF VERMONT AGENCY OF TRANSPORTATION

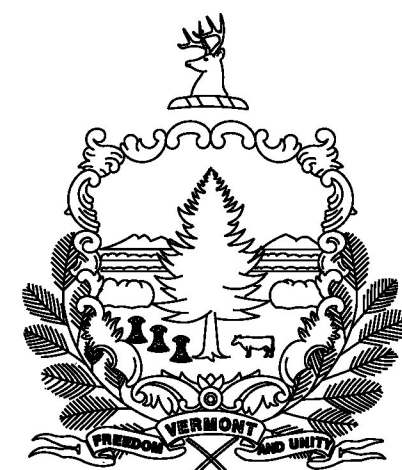

## PROPOSED IMPROVEMENT BRIDGE PROJECT




TOWN OF FAIRFIELD  
COUNTY OF FRANKLIN

ROUTE NO : SOUTH ROAD, FAS 0281 (RURAL MAJOR COLLECTOR), CLASS 2 TOWN HIGHWAY      BRIDGE NO : 14

PROJECT LOCATION:      ON TH 1 (FAS 0281), APPROXIMATELY 2.5 MILES SOUTH OF ITS JUNCTION WITH VT 36.

PROJECT DESCRIPTION: REPLACEMENT OF EXISTING BRIDGE (BRIDGE NO. 14) WITH RELATED ROADWAY APPROACH AND CHANNEL WORK.

LENGTH OF STRUCTURE:      44.00 FEET  
LENGTH OF ROADWAY:      131.00 FEET  
LENGTH OF PROJECT:      175.00 FEET

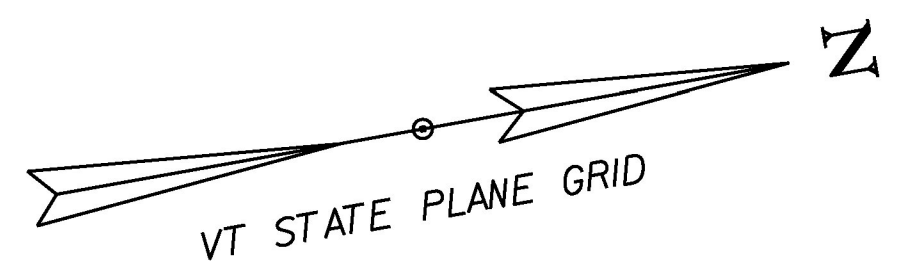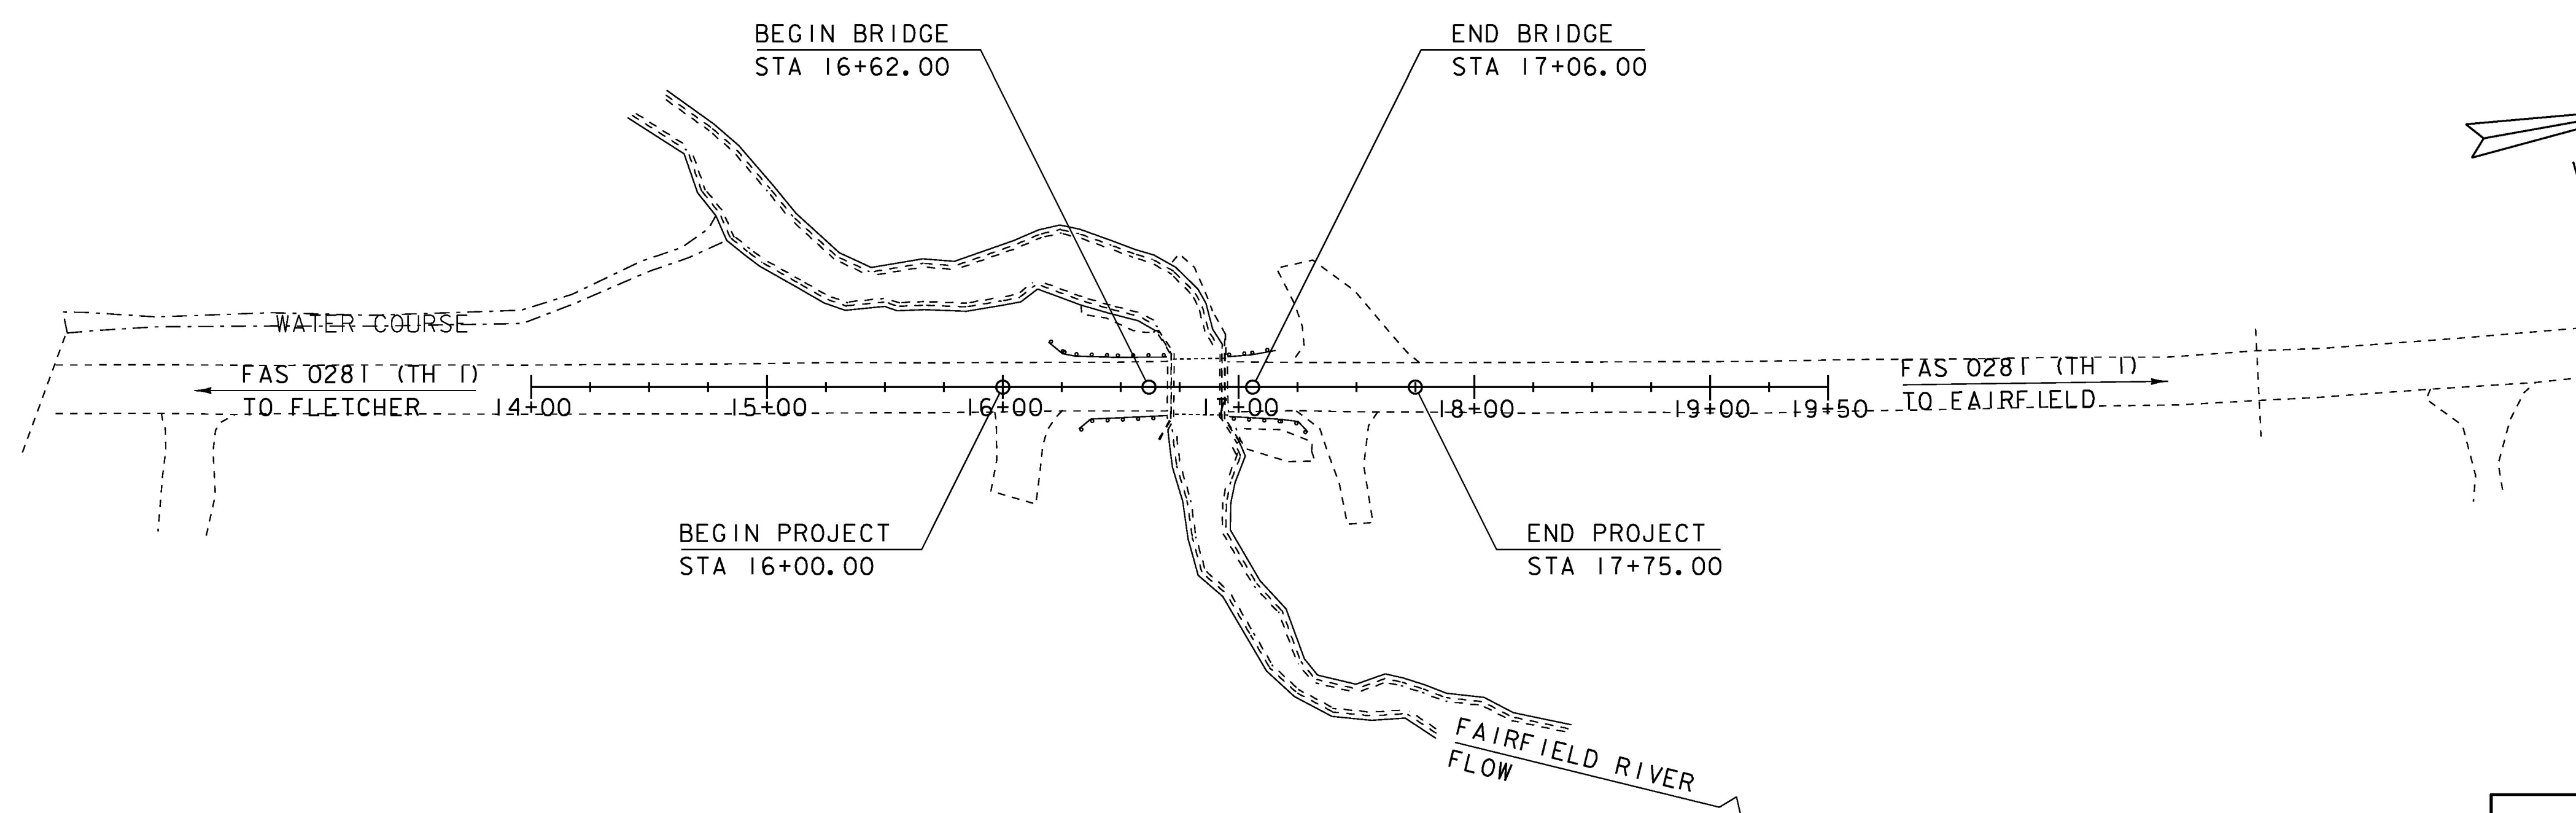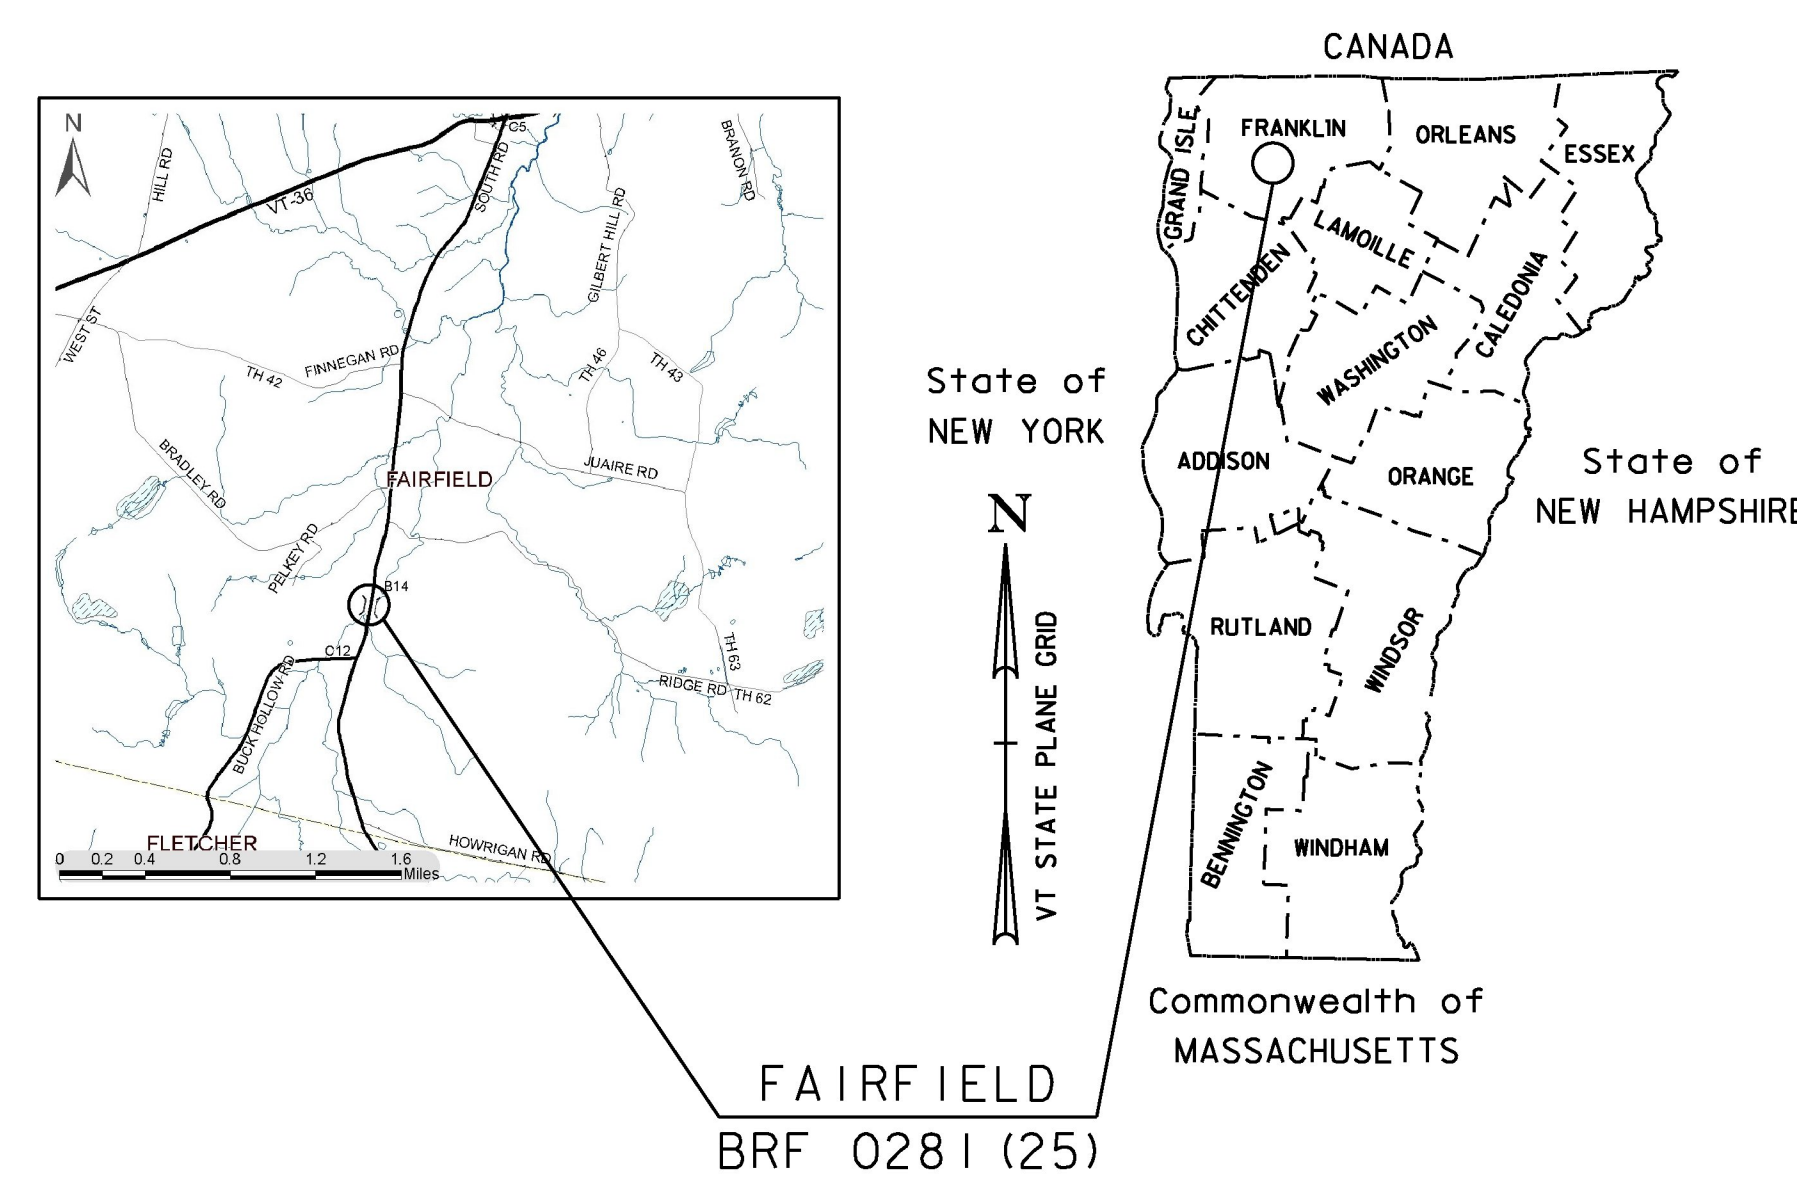

THESE PLANS ARE SUBJECT TO SUCH ENGINEERING CHANGES AS MAY BE REQUIRED BY THE FEDERAL HIGHWAY ADMINISTRATION OR THE DIRECTOR OF PROGRAM DEVELOPMENT.  
CONSTRUCTION IS TO BE CARRIED ON IN ACCORDANCE WITH THESE PLANS AND THE STANDARD SPECIFICATIONS FOR CONSTRUCTION DATED 2011, AS APPROVED BY THE FEDERAL HIGHWAY ADMINISTRATION ON JULY 20, 2011 FOR USE ON THIS PROJECT, INCLUDING ALL SUBSEQUENT REVISIONS AND SUCH REVISED SPECIFICATIONS AND SPECIAL PROVISIONS AS ARE INCORPORATED IN THESE PLANS.

QUALITY ASSURANCE PROGRAM : LEVEL 2	
SURVEYED BY :	L. ORVIS
SURVEYED DATE :	3/25/2012
DATUM	
VERTICAL	NAVD88
HORIZONTAL	NAD (83) 2007

SCALE 1" = 50' - 0"  
50      0      50

PROJECT MANAGER :	R. YOUNG, P. E.
PROJECT NAME :	FAIRFIELD
PROJECT NUMBER :	BRF 0281 (25)
SHEET	6 OF 69 SHEETS

# PRELIMINARY INFORMATION SHEET (BRIDGE)

LRFD

INDEX OF SHEETS

FINAL HYDRAULIC REPORT

PLAN SHEETS

1	COMPOSITE TITLE SHEET
2	COMPOSITE LEGEND SHEET
3 - 5	COMPOSITE QUANTITY SHEETS 1-3
6	TITLE SHEET - FAIRFIELD BRIDGE 0281 (25)
7	PRELIMINARY INFORMATION SHEET
8	GENERAL NOTES
9 - 11	QUANTITY SHEET 1-3
12 - 13	TYPICAL SECTIONS 1-2
14	TIE SHEET
15	EXISTING CONDITIONS
16	LAYOUT SHEET
17	MAINLINE PROFILE & BANKING DIAGRAM
18	TRAFFIC LAYOUT SHEET
19	RAIL LAYOUT SHEET
20	BORING LAYOUT
21	BORING LOGS
22	FRAMING PLAN
23 - 24	SUPERSTRUCTURE DETAILS 1-2
25	BEARING DETAILS
26	APPROACH SLAB DETAILS
27	ABUTMENT PLAN
28	ABUTMENT REINFORCING
29	EPSC NARRATIVE
30	EPSC PLAN
31	EPSC DETAILS
32 - 35	MAINLINE SECTIONS
36 - 37	CHANNEL SECTIONS
38	TITLE SHEET - FAIRFIELD BRO 1448 (41)
39	PRELIMINARY INFORMATION SHEET
40	GENERAL NOTES
41 - 42	QUANTITY SHEETS 1-2
43 - 44	TYPICAL SECTIONS 1-2
45	TIE SHEET
46	EXISTING CONDITIONS
47	LAYOUT SHEET
48	MAINLINE PROFILE & BANKING DIAGRAM
49	TRAFFIC LAYOUT SHEET
50	RAIL LAYOUT SHEET
51	BORING LAYOUT
52 - 54	BORING LOGS 1-3
55	FRAMING PLAN
56 - 57	SUPERSTRUCTURE DETAILS 1-2
58	BEARING DETAILS
59	ABUTMENT PLAN
60	ABUTMENT REINFORCING
61	EPSC NARRATIVE
62	EPSC PLAN
63	EPSC DETAILS
64 - 66	MAINLINE SECTIONS 1-3
67 - 69	CHANNEL SECTIONS 1-3

STANDARDS LIST

G-1	STEEL BEAM GUARDRAIL DETAILS (POST, DELINEATOR, TYPICALS)	01-03-2000
G-1D	STEEL BEAM GUARDRAIL DETAILS (END TERMINAL, ANCHOR, MEDIAN)	01-03-2000
S-367A	BRIDGE RAILING, GALVANIZED HDSB/FASCIA MOUNTED/STEEL TUBING	05-24-2012
S-367B	GUARDRAIL APPROACH SECTION, GALVANIZED HD STEEL BEAM	05-24-2012
T-1	TRAFFIC CONTROL GENERAL NOTES	08-06-2012
T-10	CONVENTIONAL ROADS CONSTRUCTION APPROACH SIGNING	08-06-2012
T-11	CONSTRUCTION APPROACH SIGNING DIVIDED HIGHWAY ONE LANE CLOSED	08-06-2012
T-28	CONSTRUCTION SIGN DETAILS	08-06-2012
T-29	CONSTRUCTION SIGN DETAILS	08-06-2012
T-30	CONSTRUCTION SIGN DETAILS	08-06-2012
T-31	CONSTRUCTION SIGN DETAILS	08-06-2012
T-40	DELINEATORS AND MILEPOSTS	01-02-2013
T-42	BRIDGE NUMBER PLAQUE	04-09-2014
T-45	SQUARE TUBE SIGN POST AND ANCHOR	01-02-2013

STRUCTURES DETAIL SHEETS

SD-501.00	CONCRETE DETAILS AND NOTES	5/7/2010
SD-502.00	CONCRETE DETAILS AND NOTES	5/7/2010
SD-516.10	BRIDGE JOINT ASPHALTIC PLUG	5/7/2010
SD-601.00	STRUCTURAL STEEL DETAILS AND NOTES	6/4/2010

HYDROLOGIC DATA

Date: April 2013

DRAINAGE AREA : 7.9 sq. mi.  
 CHARACTER OF TERRAIN : Mix of fields and forest, rural  
 STREAM CHARACTERISTICS : Incised and alluvial  
 NATURE OF STREAMBED : Silt, sand and gravel

PEAK FLOW DATA

Q 2.33 =	360 cfs	Q 50 =	1150 cfs
Q 10 =	670 cfs	Q 100 =	1320 cfs
Q 25 =	920 cfs	Q 500 =	1740 cfs

DATE OF FLOOD OF RECORD : Unknown  
 ESTIMATED DISCHARGE : Unknown  
 WATER SURFACE ELEV. : Unknown  
 NATURAL STREAM VELOCITY : @ Q50 = 7.4 fps  
 ICE CONDITIONS : Moderate  
 DEBRIS : Little to moderate  
 DOES THE STREAM REACH MAXIMUM HIGHWATER ELEV. RAPIDLY? No  
 IS ORDINARY RISE RAPID? No  
 IS STAGE AFFECTED BY UPSTREAM OR DOWNSTREAM CONDITIONS? No  
 IF YES, DESCRIBE :

WATERSHED STORAGE : <1% HEADWATERS :  
 UNIFORM : X  
 IMMEDIATELY ABOVE SITE :

EXISTING STRUCTURE INFORMATION

STRUCTURE TYPE : Single span concrete slab bridge  
 YEAR BUILT : 1949, reconstructed in 2004  
 CLEAR SPAN(NORMAL TO STREAM) : 23'  
 VERTICAL CLEARANCE ABOVE STREAMBED : ~7'  
 WATERWAY OF FULL OPENING : 130 sq. ft.  
 DISPOSITION OF STRUCTURE : Remove and replace  
 TYPE OF MATERIAL UNDER SUBSTRUCTURE : See borings

WATER SURFACE ELEVATIONS AT:

Q2.33 =	598.7'	VELOCITY =	5.6 fps
Q10 =	600.1'	"	8.4 fps
Q25 =	602.2'	"	11.7 fps
Q50 =	602.6'	"	8.3 fps
Q100 =	602.9'	"	9.0 fps

LONG TERM STREAMBED CHANGES : None noted

IS THE ROADWAY OVERTOPPED BELOW Q100 : Yes  
 FREQUENCY : Below Q50  
 RELIEF ELEVATION : 602.7'  
 DISCHARGE OVER ROAD @Q100 : 280 cfs

UPSTREAM STRUCTURE

TOWN : Fairfield DISTANCE : 2200'  
 HIGHWAY # : TH 3 STRUCTURE # : BR 12  
 CLEAR SPAN : 21' CLEAR HEIGHT : 8'  
 YEAR BUILT : 1996 FULL WATERWAY :  
 STRUCTURE TYPE : Precast Concrete Box

DOWNSTREAM STRUCTURE

TOWN : Fairfield DISTANCE : 2800'  
 HIGHWAY # : TH 62 STRUCTURE # : BR 39  
 CLEAR SPAN : 20' CLEAR HEIGHT : 11'  
 YEAR BUILT : 1963 FULL WATERWAY :  
 STRUCTURE TYPE : Concrete Slab Bridge

LRFR LOAD RATING FACTORS

LOADING LEVELS	TRUCK						
	H-20	HL-93	3S2	6 AXLE	3A. STR.	4A. STR.	5A. SEMI
TONNAGE	20	36	36	66	30	34.5	38
INVENTORY	1.8	1.11					
POSTING							
OPERATING	2.34	1.44	2.35	1.29	1.73	1.59	1.9
COMMENTS:							

AS BUILT "REBAR" DETAIL

LEVEL I			LEVEL II			LEVEL III		
TYPE:			TYPE:			TYPE:		
GRADE:			GRADE:			GRADE:		

TRAFFIC DATA

YEAR	ADT	DHV	% D	% T	ADTT	
2015	580	90	50	6.7	40	20 year ESAL for flexible pavement from 2015 to 2035 : 206000
2035	620	95	50	10.8	60	40 year ESAL for flexible pavement from 2015 to 2055 : 506000
						Design Speed : 40 mph

PROPOSED STRUCTURE

STRUCTURE TYPE : Solid Slab  
 CLEAR SPAN(NORMAL TO STREAM) : 40'  
 VERTICAL CLEARANCE ABOVE STREAMBED : ~8'  
 WATERWAY OF FULL OPENING : 210 sq. ft.

WATER SURFACE ELEVATIONS AT:

Q2.33 =	598.7'	VELOCITY =	4.5 fps
Q10 =	599.8'	"	6.2 fps
Q25 =	600.5'	"	7.7 fps
Q50 =	601.1'	"	9.2 fps
Q100 =	601.5'	"	10.4 fps

IS THE ROADWAY OVERTOPPED BELOW Q100 : No  
 FREQUENCY : N/A  
 RELIEF ELEVATION : 602.7'  
 DISCHARGE OVER ROAD @Q100 : N/A

AVERAGE LOW ELEVATION OF SUPERSTRUCTURE : 602.4'  
 VERTICAL CLEARANCE : @ Q50 = 1.3'

SCOUR : Contraction scour at Q100 = 1.0'

REQUIRED CHANNEL PROTECTION : Stone Fill, Type III

PERMIT INFORMATION

AVERAGE DAILY FLOW : 20 cfs DEPTH OR ELEVATION :  
 ORDINARY LOW WATER : 10 cfs 1.5'  
 ORDINARY HIGH WATER : 155 cfs 3.0'

TEMPORARY BRIDGE REQUIREMENTS

STRUCTURE TYPE : None required. Detour to be used.  
 CLEAR SPAN (NORMAL TO STREAM) :  
 VERTICAL CLEARANCE ABOVE STREAMBED :  
 WATERWAY AREA OF FULL OPENING :

ADDITIONAL INFORMATION

TRAFFIC MAINTENANCE NOTES

1. MAINTAIN TRAFFIC ON AN OFF SITE DETOUR.
2. TRAFFIC SIGNALS ARE NOT NECESSARY.
3. SIDEWALKS ARE NOT NECESSARY

DESIGN VALUES

1. DESIGN LIVE LOAD	HL-93
2. FUTURE PAVEMENT	d _p : 0.0 INCH
3. DESIGN SPAN	L: 43.00 FT
4. MIN. MID-SPAN POS. CAMBER @ RELEASE (PRESTRESSED UNITS)	Δ: ---
5. PRESTRESSING STRAND (0.60 INCH DIAMETER - LOW RELAX)	f _y : 270 KSI
6. PRESTRESSED CONCRETE STRENGTH	f' _c : 8.0 KSI
7. PRESTRESSED CONCRETE RELEASE STRENGTH	f' _{cr} : 6.0 KSI
8. CONCRETE, HIGH PERFORMANCE CLASS AA	f' _c : 4.0 KSI
9. CONCRETE, HIGH PERFORMANCE CLASS A	f' _c : 4.0 KSI
10. CONCRETE, HIGH PERFORMANCE CLASS B	f' _c : 3.5 KSI
11. CONCRETE, CLASS C	f' _c : 3.0 KSI
12. REINFORCING STEEL	f _y : 60 KSI
13. STRUCTURAL STEEL AASHTO M270	f _y : ---
14. NOMINAL BEARING RESISTANCE OF SOIL	q _n : 4.0 KSF
15. SOIL BEARING RESISTANCE FACTOR (REFER TO AASHTO LRFD)	φ: ---
16. NOMINAL BEARING RESISTANCE OF ROCK	q _n : 10.0 KSF
17. ROCK BEARING RESISTANCE FACTOR (REFER TO AASHTO LRFD)	φ: ---
18. PILE RESISTANCE FACTOR	φ: 0.65
19. LATERAL PILE DEFLECTION	Δ: 0.38 INCH
20. BASIC WIND SPEED	V _{3s} : ---
21. MINIMUM GROUND SNOW LOAD	p _g : ---
22. SEISMIC DATA	PGA: 0.65 S _s : ---
	S ₁ : ---
23.	---
24.	---
25.	---
26.	---

PROJECT NAME : FAIRFIELD  
 PROJECT NUMBER : BRF 0281 (25)  
 FILE NAME : s12j156excel.dgn PLOT DATE : 8/18/2014  
 PROJECT LEADER : R. YOUNG DRAWN BY : K. FRIEDLAND  
 DESIGNED BY : R. KLINFELTER CHECKED BY : J. SALVATORI  
 PRELIMINARY INFORMATION SHEET SHEET 7 OF 69

## GENERAL

1. ALL MATERIALS AND CONSTRUCTION SHALL CONFORM TO THE VERMONT AGENCY OF TRANSPORTATION 2011 STANDARD SPECIFICATIONS FOR CONSTRUCTION, THE 2012 AASHTO LRFD BRIDGE DESIGN SPECIFICATIONS, AND THEIR LATEST REVISIONS.
2. ALL PRECAST/PRESTRESSED CONCRETE ELEMENTS SHALL BE FABRICATED TO THE SPECIFIED DIMENSIONS AND ERECTED IN THE SPECIFIED LOCATIONS, ALL WITHIN TOLERANCES DEFINED ON THE PLANS AND IN THE PRECAST/PRESTRESSED CONCRETE INSTITUTE TOLERANCE MANUAL FOR PRECAST AND PRESTRESSED CONCRETE CONSTRUCTION, MNL 135-00, AND ITS LATEST REVISIONS.
3. ALL DIMENSIONS ARE HORIZONTAL OR VERTICAL, AND ARE GIVEN AT 68 DEGREES FAHRENHEIT, UNLESS NOTED OTHERWISE.
4. THE WEARING SURFACE SHALL BE SHIMMED TRANSVERSELY AS NECESSARY TO ACCOUNT FOR DIFFERENTIAL CAMBER OF THE ADJACENT PRESTRESSED SLABS.

## TRAFFIC CONTROL

5. THE CONTRACTOR SHALL BE RESPONSIBLE FOR SUPPLYING A SITE SPECIFIC TRAFFIC CONTROL PACKAGE IDENTIFYING CONSTRUCTION ACTIVITIES BEFORE, DURING, AND AFTER THE BRIDGE CLOSURE PERIOD. THE CONTRACTOR SHALL SUBMIT A DETAILED TRAFFIC CONTROL PLAN TO THE PROJECT MANAGER FOR ALL STAGES OF CONSTRUCTION, FOR APPROVAL PER SUBSECTION 105.03. ALL COSTS SHALL BE INCLUDED IN ITEM 900.645, "SPECIAL PROVISION (TRAFFIC CONTROL, ALL-INCLUSIVE) (BRF 0281(25))". SEE SPECIAL PROVISIONS FOR ADDITIONAL INFORMATION.
6. ALL ITEMS REQUIRED TO IMPLEMENT THE CONTRACTOR'S TRAFFIC CONTROL PLAN WILL NOT BE PAID FOR DIRECTLY BUT WILL BE CONSIDERED INCLUDED IN THE BID PRICE FOR ITEM 900.645, "SPECIAL PROVISION (TRAFFIC CONTROL, ALL-INCLUSIVE) (BRF 0281(25))".
7. THE CONTRACTOR IS NOT RESPONSIBLE FOR THE OFF-SITE DETOUR. THE CONTRACTOR SHALL NOTIFY THE TOWN A MINIMUM OF TWO WEEKS IN ADVANCE OF THE BRIDGE CLOSURE PERIOD.
8. ALL SIGNING SHALL BE IN ACCORDANCE WITH THE LATEST EDITION OF THE MUTCD. FOR ADDITIONAL SIGNING INSTRUCTIONS SEE THE T SERIES OF THE STANDARDS. WHERE CONFLICTS EXIST, THE MUTCD SHALL GOVERN.

## EARTHWORK

9. REMOVAL OF THE EXISTING STRUCTURE SHALL BE PAID FOR UNDER ITEM 529.15, "REMOVAL OF STRUCTURE". THIS WORK SHALL INCLUDE REMOVAL OF ANY PORTIONS OF THE EXISTING ABUTMENTS THAT FALL OUTSIDE THE LIMITS OF STRUCTURE EXCAVATION OR UNCLASSIFIED CHANNEL EXCAVATION.
10. THE "STONE FILL, TYPE III" UNDER THE BRIDGE AS SHOWN IN THE PLANS SHALL BE PLACED BEFORE THE PRESTRESSED SLABS ARE SET.

## CONCRETE AND REINFORCING STEEL

11. TEST BARS SHALL BE PROVIDED IN ACCORDANCE WITH THE "VERMONT AGENCY OF TRANSPORTATION MATERIAL SAMPLING MANUAL" AVAILABLE ON THE AGENCY WEBSITE. A MINIMUM OF TWO TEST SECTIONS ARE REQUIRED FOR EACH SIZE, BRAND, AND GRADE OR TYPE OF REINFORCING. SEE THE MANUAL FOR ACCEPTABLE DIMENSIONS OF TEST SECTIONS. ALL COSTS ASSOCIATED WITH PROVIDING BARS FOR TESTING SHALL BE INCLUDED IN THE BID PRICE FOR EACH 540.10, 900.640, "SPECIAL PROVISION, (PRESTRESSED CONCRETE SOLID SLABS)(15" x 48")", AND 900.645, "SPECIAL PROVISION, (CONTRACTOR-FABRICATED PRECAST CONCRETE STRUCTURE)" CONTRACT ITEM AS APPROPRIATE.
12. WATER REPELLENT, SILANE SHALL BE FURNISHED IN ACCORDANCE WITH SECTION 514 AND SHALL BE APPLIED TO ALL EXPOSED CONCRETE ON THE BRIDGE SUPERSTRUCTURE AND SUBSTRUCTURE, WITH THE EXCEPTION OF THE BOTTOM OF THE SLABS BETWEEN THE DRIP NOTCHES. ALL COSTS ASSOCIATED WITH APPLYING SILANE SHALL BE INCLUDED IN THE BID PRICE FOR EACH 540.10, 900.640, "SPECIAL PROVISION, (PRESTRESSED CONCRETE SOLID SLABS)(15" x 48")", AND 900.645, "SPECIAL PROVISION, (CONTRACTOR-FABRICATED PRECAST CONCRETE STRUCTURE)" CONTRACT ITEM AS APPROPRIATE.
13. CONCRETE FOR APPROACH SLAB CLOSURE POURS AND ABUTMENT PILE CAVITIES SHALL MEET THE REQUIREMENTS OF ITEM 900.608, "SPECIAL PROVISION (HIGH PERFORMANCE CONCRETE, RAPID SET)(FPQ)".
14. GROUT FOR SHEAR KEYS BETWEEN THE PRESTRESSED SLABS SHALL BE MORTAR, TYPE IV IN ACCORDANCE WITH SECTION 510 - PRESTRESSED CONCRETE. GROUT FOR ANCHOR BOLTS SHALL BE MORTAR, TYPE IV IN ACCORDANCE WITH SECTION 531 - BRIDGE BEARING DEVICES. THE CONTRACTOR SHALL SUBMIT A GROUTING PROCEDURE PROPOSAL TO THE ENGINEER, INCLUDING A PREMIX NAME BRAND FOR APPROVAL.
15. ALL REINFORCING STEEL SHALL BE DETAILED AND FABRICATED USING PROCEDURES AND TOLERANCES IN ACCORDANCE WITH APPLICABLE PUBLICATIONS OF THE "CONCRETE REINFORCING STEEL INSTITUTE".
16. ALL REINFORCING STEEL IN THE PRESTRESSED SLABS, APPROACH SLABS, APPROACH SLAB CLOSURE POURS, AND ABUTMENTS & WINGWALLS ABOVE THE BRIDGE SEAT SHALL MEET THE REQUIREMENTS FOR LEVEL II CORROSION RESISTANCE IN ACCORDANCE WITH SECTION 507.

17. REINFORCING STEEL IN THE ABUTMENTS & WINGWALLS BELOW THE BRIDGE SEAT SHALL MEET THE REQUIREMENTS FOR LEVEL I CORROSION RESISTANCE IN ACCORDANCE WITH SECTION 507.
18. ALL COSTS ASSOCIATED WITH THE APPROACH SLAB CLOSURE POUR REINFORCING SHALL BE INCLUDED IN THE BID PRICE FOR EACH 540.10 AND 900.645, "SPECIAL PROVISION, (CONTRACTOR-FABRICATED PRECAST CONCRETE STRUCTURE)" CONTRACT ITEM AS APPROPRIATE.
19. CORRUGATED STEEL PIPES IN THE PRECAST ABUTMENTS FOR PILE CAVITIES AND ANCHOR BOLT CAVITIES SHALL MEET THE REQUIREMENTS OF SUBSECTION 711.01, BE COATED IN ACCORDANCE WITH AASHTO M 218, AND BE TYPE 1. ALL COSTS ASSOCIATED WITH PLACING THE CORRUGATED STEEL PIPES SHALL BE INCLUDED IN THE BID PRICE FOR EACH 540.10 AND 900.645, "SPECIAL PROVISION, (CONTRACTOR-FABRICATED PRECAST CONCRETE STRUCTURE)" CONTRACT ITEM AS APPROPRIATE.
20. CORRUGATED POST-TENSIONING DUCTS IN THE PRESTRESSED SLABS AND PRECAST APPROACH SLABS FOR ANCHOR BOLT AND DOWEL CONNECTIONS SHALL BE CONSTRUCTED FROM EITHER POLYETHYLENE OR POLYPROPYLENE. THE DUCT SHALL HAVE A MINIMUM MATERIAL THICKNESS OF 0.080 IN. +/- 0.010 IN. AND SHALL HAVE A WHITE COATING ON THE OUTSIDE OR SHALL BE OF WHITE MATERIAL WITH ULTRAVIOLET STABILIZERS ADDED. POLYETHYLENE DUCT SHALL BE FABRICATED FROM RESINS MEETING OR EXCEEDING THE REQUIREMENTS OF ASTM D 3350 WITH A CELL CLASSIFICATION OF 345464A. POLY PROPYLENE DUCT SHALL BE FABRICATED FROM RESINS MEETING OR EXCEEDING THE REQUIREMENTS OF ASTM D 4101 WITH A CELL CLASSIFICATION RANGE OF PP0340B44544 TO PP0340B65884. ALL COSTS ASSOCIATED WITH PLACING THE DUCTS SHALL BE INCLUDED IN THE BID PRICE FOR EACH 540.10, 900.640, "SPECIAL PROVISION, (PRESTRESSED CONCRETE SOLID SLABS)(15" x 48")", AND 900.645, "SPECIAL PROVISION, (CONTRACTOR-FABRICATED PRECAST CONCRETE STRUCTURE)" CONTRACT ITEM AS APPROPRIATE.

## PRECAST ABUTMENTS AND APPROACH SLABS

21. CONCRETE COMPRESSIVE STRENGTH:  $f_c = 5$  KSI.
22. PROPOSED SEQUENCE OF SUBSTRUCTURE CONSTRUCTION:
  - a. PREPARE AND GRADE FOUNDATION TO REQUIRED ELEVATION.
  - b. DRIVE PILES.
  - c. PLACE PRECAST ABUTMENTS.
  - d. INSTALL ANCHOR BOLTS AND SECURE IN FINAL POSITION.
  - e. FILL ABUTMENT PILE CAVITIES WITH ITEM 900.608, "SPECIAL PROVISION (HIGH PERFORMANCE CONCRETE, RAPID SET)(FPQ)".
  - f. GROUT ANCHOR BOLTS IN ABUTMENT ANCHOR BOLT CAVITIES.
  - g. THE PILE CAVITY CONCRETE SHALL ATTAIN A MINIMUM COMPRESSIVE STRENGTH OF 3.5 KSI BEFORE ABUTMENT BACKFILL IS PLACED AND PRESTRESSED SLABS ARE ERECTED.
23. ALTERNATE SEQUENCE OF CONSTRUCTION MAY BE SUBMITTED FOR APPROVAL BY THE PROJECT MANAGER.

## PRESTRESSED SOLID SLABS

24. DESIGN VALUES:
  - a. CONCRETE COMPRESSIVE STRENGTH:  $f_c = 8$  KSI
  - b. CONCRETE COMPRESSIVE STRENGTH AT RELEASE:  $f_{ci} = 6$  KSI
  - c. PRESTRESSING STRANDS: 0.6 INCH DIAMETER, 270 KSI, LOW-RELAXATION 7-WIRE STRANDS
  - d. JACKING FORCE PER PRESTRESSING STRAND = 44 KIPS
  - e. POST-TENSIONING STRANDS: 0.6 INCH DIAMETER, 270 KSI, LOW RELAXATION 7-WIRE STRANDS.
  - f. JACKING FORCE PER POST-TENSIONING STRAND = 47 KIPS
  - g. THERE SHALL BE 2 STRANDS PER POST-TENSIONING DUCT.
  - h. ASSUMED MODULUS OF ELASTICITY FOR THE STRAND IS 28,500 KSI.
25. DUE TO STABILITY CONCERNS AT THE ABUTMENTS DURING THE ERECTION OF THE SUPERSTRUCTURE, THE CONTRACTOR SHALL SUBMIT THE ERECTION PLAN A MINIMUM OF 30 WORKING DAYS PRIOR TO THE BRIDGE CLOSURE PERIOD. UNDER NO CIRCUMSTANCES SHALL A BRIDGE CLOSURE PERIOD BEGIN PRIOR TO HAVING AN ACCEPTED ERECTION PLAN.
26. THE METHOD OF FORMING FOR SUBSEQUENT POURS AFTER PLACING PRECAST/PRESTRESSED SUPERSTRUCTURE UNITS SHALL BE DETERMINED BY THE CONTRACTOR. THE CONTRACTOR IS ENCOURAGED TO WORK WITH THE FABRICATOR IF ADDITIONAL SUPPORTS MAY BE REQUIRED. IN NO CASE SHALL THE CONTRACTOR ATTACH ADDITIONAL FORM OR SCREED SUPPORTS BY DRILLING OR SIMILAR MEANS INTO ANY PRECAST/PRESTRESSED SUPERSTRUCTURE UNIT.
27. ALL POST-TENSIONING STRAND SHALL CONFORM TO THE REQUIREMENTS OF SECTION 510 - PRESTRESSED CONCRETE. PAYMENT FOR GALVANIZED ANCHOR ASSEMBLIES, DUCTS, AND POST-TENSIONING STRANDS SHALL BE INCLUDED UNDER ITEM 900.640, "SPECIAL PROVISION, (PRESTRESSED CONCRETE SOLID SLABS)(15" x 48")".

28. PROPOSED SEQUENCE OF SUPERSTRUCTURE CONSTRUCTION:
  - a. LAY OUT WORKING LINES THE ENTIRE WIDTH OF THE BRIDGE ALONG CENTERLINE OF BEARING, MEASURED FROM A SINGLE WORKING POINT. THE WORKING LINES SHALL BE BASED ON THE NOMINAL PRESTRESSED SLAB WIDTHS.
  - b. PREPARE GRADE FOR APPROACH SLABS.
  - c. VERIFY THE BRIDGE SEAT ELEVATIONS AND TAKE CORRECTIVE ACTION IF NECESSARY.
  - d. POWER WASH ALL SURFACES THAT WILL BE IN CONTACT WITH GROUT.
  - e. INSTALL BEARINGS.
  - f. ERECT THE PRESTRESSED SLABS TO FIT WITHIN THE WORKING LINES.
  - g. ADJUST THE EXTERIOR SLAB SO THAT THE FASCIA FITS SNUG AGAINST THE CORK ON INTERIOR OF CHEEK WALL.
  - h. INSTALL HARDWOOD WEDGES BETWEEN ADJACENT SLABS TO MAINTAIN PROPER JOINT OPENING (A MINIMUM OF ONE WEDGE AT EACH TRANSVERSE POST-TENSIONING LOCATION).
  - i. INSTALL BACKER ROD BELOW THE BOTTOM OF THE KEYWAY.
  - j. INSTALL POST-TENSIONING STRANDS AND TENSION TO 3 KIPS TO REMOVE SAG AND SEAT CHUCK.
  - k. INSTALL PRECAST APPROACH SLABS.
  - l. PUMP GROUT FROM LOW ENDS OF BRIDGE SEAT THROUGH ANCHOR BOLT DUCTS CLOSEST TO EACH FASCIA TO FILL VOID BETWEEN BRIDGE SEAT AND BOTTOM OF PRESTRESSED SLABS AND APPROACH SLABS. PUMP GROUT UNTIL ALL ANCHOR BOLT DUCTS AND APPROACH SLAB DOWEL DUCTS ARE FULL.
  - m. INSTALL ANCHOR PLATES, WASHERS AND NUTS FOR ANCHOR BOLTS.
  - n. GROUT SHEAR KEYS.
  - o. FULLY TENSION TRANSVERSE TENDONS PER SUBSECTION 510.14.
  - p. INSTALL APPROACH SLAB CLOSURE POUR REINFORCING AND COMPLETE CLOSURE POUR.
29. ALTERNATE SEQUENCE OF CONSTRUCTION MAY BE SUBMITTED FOR APPROVAL BY THE PROJECT MANAGER.

## H-PILES

30. THE PILES SHALL BE HP 12x84.
31. TO PREVENT DAMAGE TO THE PILES, PILE SHOES ARE REQUIRED AND SHALL CONFORM TO SUBSECTION 505.04 (f).
32. THE PILES SHALL BE DRIVEN TO A NOMINAL AXIAL RESISTANCE OF 290 KIPS AND EMBEDDED A MINIMUM OF 20 FEET BELOW THE PILE CAP.
33. A MINIMUM OF ONE DYNAMIC PILE LOADING TEST SHALL BE PERFORMED PER ABUTMENT.
34. THE TOPS OF THE PILES AFTER DRIVING SHALL NOT VARY FROM THE POSITION SHOWN ON THE PLANS BY MORE THAN 3 INCHES. THE PILE ORIENTATION SHALL NOT VARY BY MORE THAN 5 DEGREES. THE CONTRACTOR SHALL DEMONSTRATE TO THE SATISFACTION OF THE ENGINEER HOW THE TOLERANCES WILL BE MET. THESE MEASURES SHALL BE DEMONSTRATED IN A SUBMITTAL TO BE ACCEPTED BEFORE PILE DRIVING COMMENCES.
35. FOR ESTIMATING PURPOSES, THE PILE TIP ELEVATIONS WERE ASSUMED AS SHOWN ON THE BORING LOGS. THE ACTUAL IN PLACE LENGTHS MAY VARY.

## MISCELLANEOUS

36. ITEM 520.10, "MEMBRANE WATERPROOFING, SPRAY APPLIED" SHALL BE APPLIED TO THE BRIDGE DECK AS PER THE MANUFACTURER'S INSTRUCTIONS AND EXTEND ONTO THE APPROACH SLABS TWO FEET BEYOND THE BEGIN BRIDGE/END OF BRIDGE. IF TRAFFIC WILL BE DRIVING DIRECTLY ON THE MEMBRANE SURFACE, AN AGGREGATE WEARING SURFACE SHALL BE ADHERED TO THE TOP MEMBRANE COAT PER THE SPECIFICATIONS.
37. EMULSIFIED ASPHALT SHALL BE APPLIED TO ALL COLD PLANED SURFACES AT A RATE OF 0.080 GAL/SY AND BETWEEN EACH LIFT OF PAVEMENT AT A RATE OF 0.040 GAL/SY.
38. EXISTING CONDITIONS SHEET HAS BEEN INCLUDED FOR THE CONTRACTOR TO USE FOR SUBMITTALS.

PROJECT NAME: FAIRFIELD  
PROJECT NUMBER: BRF 0281(25)

FILE NAME: sl2j156gen.dgn  
PROJECT LEADER: R. YOUNG  
DESIGNED BY: R. KLINEFELTER  
GENERAL NOTES

PLOT DATE: 11-SEP-2014  
DRAWN BY: R. KLINEFELTER  
CHECKED BY: J. SALVATORI  
SHEET 8 OF 69

# QUANTITY SHEET 1

SUMMARY OF ESTIMATED QUANTITIES										TOTALS		DESCRIPTIONS				DETAILED SUMMARY OF QUANTITIES		
						ROADWAY	EROSION CONTROL	BRIDGE	FULL C.E. ITEMS	GRAND TOTAL	FINAL	UNIT	ITEMS	ITEM NUMBER	ROUND	QUANTITIES	UNIT	ITEMS
						1				1		LS	CLEARING AND GRUBBING, INCLUDING INDIVIDUAL TREES AND STUMPS (BRF 0281(25))	201.10				<b>EARTHWORK SUMMARY</b>
						400				400		CY	COMMON EXCAVATION	203.15				400 CY COMMON EXCAVATION (400*1.0)
								270		270		CY	UNCLASSIFIED CHANNEL EXCAVATION	203.27				202.5 CY UNCLASSIFIED EXCAVATION (270*0.75)
						1				1		CY	TRENCH EXCAVATION OF EARTH, EXPLORATORY (N.A.B.I.)	204.22				37.5 CY STRUCTURE EXCAVATION (50*0.75)
								50		50		CY	STRUCTURE EXCAVATION	204.25				640 CY SUBTOTAL
								10		10		CY	GRANULAR BACKFILL FOR STRUCTURES	204.30				10 CY ROUNDING
						240				240		SY	COLD PLANING, BITUMINOUS PAVEMENT	210.10				650 CY TOTAL FILL AVAILABLE
						450				450		CY	SUBBASE OF CRUSHED GRAVEL, COARSE GRADED	301.25				0 CY TOTAL FILL REQUIRED
						10				10		CY	AGGREGATE SURFACE COURSE	401.10				650 CY TOTAL WASTE
						15				15		CY	AGGREGATE SHOULDERS, IN PLACE	402.10				
						6				6		CWT	EMULSIFIED ASPHALT	404.65				
						1				1		LU	PRICE ADJUSTMENT, ASPHALT CEMENT (N.A.B.I.)	406.50				
								1		1		LS	FURNISHING EQUIPMENT FOR DRIVING PILING (BRF 0281(25))	504.10				
								300		300		LF	STEEL PILING, HP 12 X 84	505.165				
								2		2		EACH	DYNAMIC PILE LOADING TEST	505.45				
								2400		2400		LB	STRUCTURAL STEEL (FPQ)	506.60				
								220		220		LF	GROUTING SHEAR KEYS	510.24				
								48		48		LF	BRIDGE EXPANSION JOINT, ASPHALTIC PLUG	516.10				
								125		125		SY	MEMBRANE WATERPROOFING, SPRAY APPLIED	520.10				
						48				48		LF	JOINT SEALER, HOT POURED	524.11				
								100		100		LF	BRIDGE RAILING, GALVANIZED HDSB/FASCIA MOUNTED/STEEL TUBING	525.44				
								1		1		EACH	REMOVAL OF STRUCTURE (605 SF - EST.)	529.15				
								12		12		EACH	BEARING DEVICE ASSEMBLY, PLAIN ELASTOMERIC PAD	531.16				
													BEGIN OPTION AA					
								1		1		LS	PRECAST CONCRETE STRUCTURE (ABUTMENT #1)(BRF 0281(25))	540.10				
								1		1		LS	SPECIAL PROVISION (CONTRACTOR-FABRICATED PRECAST CONCRETE STRUCTURE)(ABUTMENT #1)(BRF 0281(25))	900.645				
													END OPTION AA					
													BEGIN OPTION CC					
								1		1		LS	PRECAST CONCRETE STRUCTURE (ABUTMENT #2)(BRF 0281(25))	540.10				
								1		1		LS	SPECIAL PROVISION (CONTRACTOR-FABRICATED PRECAST CONCRETE STRUCTURE)(ABUTMENT #2)(BRF 0281(25))	900.645				
													END OPTION CC					
													BEGIN OPTION EE					
								1		1		LS	PRECAST CONCRETE STRUCTURE (APPROACH SLAB #1)	540.10				
								1		1		LS	SPECIAL PROVISION (CONTRACTOR-FABRICATED PRECAST CONCRETE STRUCTURE)(APPROACH SLAB #1)	900.645				
													END OPTION EE					

PROJECT NAME: FAIRFIELD  
 PROJECT NUMBER: BRF 0281(25)  
 FILE NAME: sl2j156qs.dgn  
 PROJECT LEADER: R. YOUNG  
 DESIGNED BY: R. KLINEFELTER  
 QUANTITY SHEET 1  
 PLOT DATE: 11-SEP-2014  
 DRAWN BY: K. FRIEDLAND  
 CHECKED BY: J. SALVATORI  
 SHEET 9 OF 69

# QUANTITY SHEET 2

SUMMARY OF ESTIMATED QUANTITIES										TOTALS		DESCRIPTIONS				DETAILED SUMMARY OF QUANTITIES			
							ROADWAY	EROSION CONTROL	BRIDGE	FULL C.E. ITEMS	GRAND TOTAL	FINAL	UNIT	ITEMS	ITEM NUMBER	ROUND	QUANTITIES	UNIT	ITEMS
														BEGIN OPTION FF					
									1		1		LS	PRECAST CONCRETE STRUCTURE (APPROACH SLAB #2)	540.10				
									1		1		LS	SPECIAL PROVISION (CONTRACTOR-FABRICATED PRECAST CONCRETE STRUCTURE)(APPROACH SLAB #2)	900.645				
														END OPTION FF					
								1			1		TON	DUST AND ICE CONTROL WITH CALCIUM CHLORIDE	609.15				
							25				25		CY	STONE FILL, TYPE I	613.10				
									170		170		CY	STONE FILL, TYPE III	613.12				
							58				58		LF	STEEL BEAM GUARDRAIL, GALVANIZED	621.20				
							4				4		EACH	ANCHOR FOR STEEL BEAM RAIL	621.60				
							4				4		EACH	GUARDRAIL APPROACH SECTION, GALV HD STEEL BEAM	621.737				
							148				148		LF	REMOVAL AND DISPOSAL OF GUARDRAIL	621.80				
							500				500		HR	FLAGGERS	630.15				
										0.5	0.5		LS	FIELD OFFICE, ENGINEERS	631.10				
										0.5	0.5		LS	TESTING EQUIPMENT, CONCRETE	631.16				
										1	1		LS	TESTING EQUIPMENT, BITUMINOUS	631.17				
										1500	1500		DL	FIELD OFFICE TELEPHONE (N.A.B.I.)	631.26				
							0.5				0.5		LS	MOBILIZATION/DEMobilIZATION	635.11				
							650				650		LF	4 INCH YELLOW LINE	646.21				
							600				600		SY	GEOTEXTILE FOR ROADBED SEPARATOR	649.11				
									190		190		SY	GEOTEXTILE UNDER STONE FILL	649.31				
								180			180		SY	GEOTEXTILE FOR SILT FENCE, WOVEN WIRE REINFORCED	649.515				
								60			60		SY	GEOTEXTILE FOR FILTER CURTAIN	649.61				
								5			5		LB	SEED	651.15				
								40			40		LB	FERTILIZER	651.18				
								1			1		TON	AGRICULTURAL LIMESTONE	651.20				
								1			1		TON	HAY MULCH	651.25				
								20			20		CY	TOPSOIL	651.35				
									110		110		SY	GRUBBING MATERIAL	651.40				
								1			1		LS	EPSC PLAN (BRF 0281(25))	652.10				
								40			40		HR	MONITORING EPSC PLAN	652.20				
								1			1		LU	MAINTENANCE OF EPSC PLAN (N.A.B.I.) (BRF 0281(25))	652.30				
								60			60		SY	TEMPORARY EROSION MATTING	653.20				
								36			36		CY	VEHICLE TRACKING PAD	653.35				
								290			290		LF	BARRIER FENCE	653.50				
								280			280		LF	PROJECT DEMARCATION FENCE	653.55				
							0.66				0.66		SF	TRAFFIC SIGNS, TYPE A	675.20				
								16			16		LF	SQUARE TUBE SIGN POST AND ANCHOR	675.341				
								4			4		EACH	DELINEATOR WITH STEEL POST	676.10				
									6		6		CY	SPECIAL PROVISION (HIGH PERFORMANCE CONCRETE, RAPID SET)(FPQ)	900.608				
									264		264		LF	SPECIAL PROVISION (PRESTRESSED CONCRETE SOLID SLABS)(15" x 48")	900.640				

PROJECT NAME: FAIRFIELD  
PROJECT NUMBER: BRF 0281(25)


FILE NAME: sl2j156qs.dgn  
PROJECT LEADER: R. YOUNG  
DESIGNED BY: R. KLINEFELTER  
QUANTITY SHEET 2

PLOT DATE: 11-SEP-2014  
DRAWN BY: K. FRIEDLAND  
CHECKED BY: J. SALVATORI  
SHEET 10 OF 69

# QUANTITY SHEET 3


SUMMARY OF ESTIMATED QUANTITIES										TOTALS		DESCRIPTIONS				DETAILED SUMMARY OF QUANTITIES		
						ROADWAY	EROSION CONTROL	BRIDGE	FULL C.E. ITEMS	GRAND TOTAL	FINAL	UNIT	ITEMS	ITEM NUMBER	ROUND	QUANTITIES	UNIT	ITEMS
						0.5				0.5		LS	SPECIAL PROVISION (CPM SCHEDULE)	900.645				
						1				1		LS	SPECIAL PROVISION (TRAFFIC CONTROL, ALL-INCLUSIVE)(BRF 0281(25))	900.645				
						1				1		LU	SPECIAL PROVISION (INCENTIVE/DISINCENTIVE)(N.A.B.I.)	900.650				
						1				1		LU	SPECIAL PROVISION (MAT DENSITY PAY ADJUSTMENT, SMALL QUANTITY)(N.A.B.I.)	900.650				
						1				1		LU	SPECIAL PROVISION (MXTURE PAY ADJUSTMENT)(N.A.B.I.)	900.650				
						185				185		TON	SPECIAL PROVISION ((BITUMINOUS CONCRETE PAVEMENT, SMALL QUANTITY)	900.680				

PROJECT NAME: FAIRFIELD  
 PROJECT NUMBER: BRF 0281(25)  
 FILE NAME: sl2j156qs.dgn  
 PROJECT LEADER: R. YOUNG  
 DESIGNED BY: R. KLINEFELTER  
 QUANTITY SHEET 3  
 PLOT DATE: 18-AUG-2014  
 DRAWN BY: K. FRIEDLAND  
 CHECKED BY: J. SALVATORI  
 SHEET II OF 69

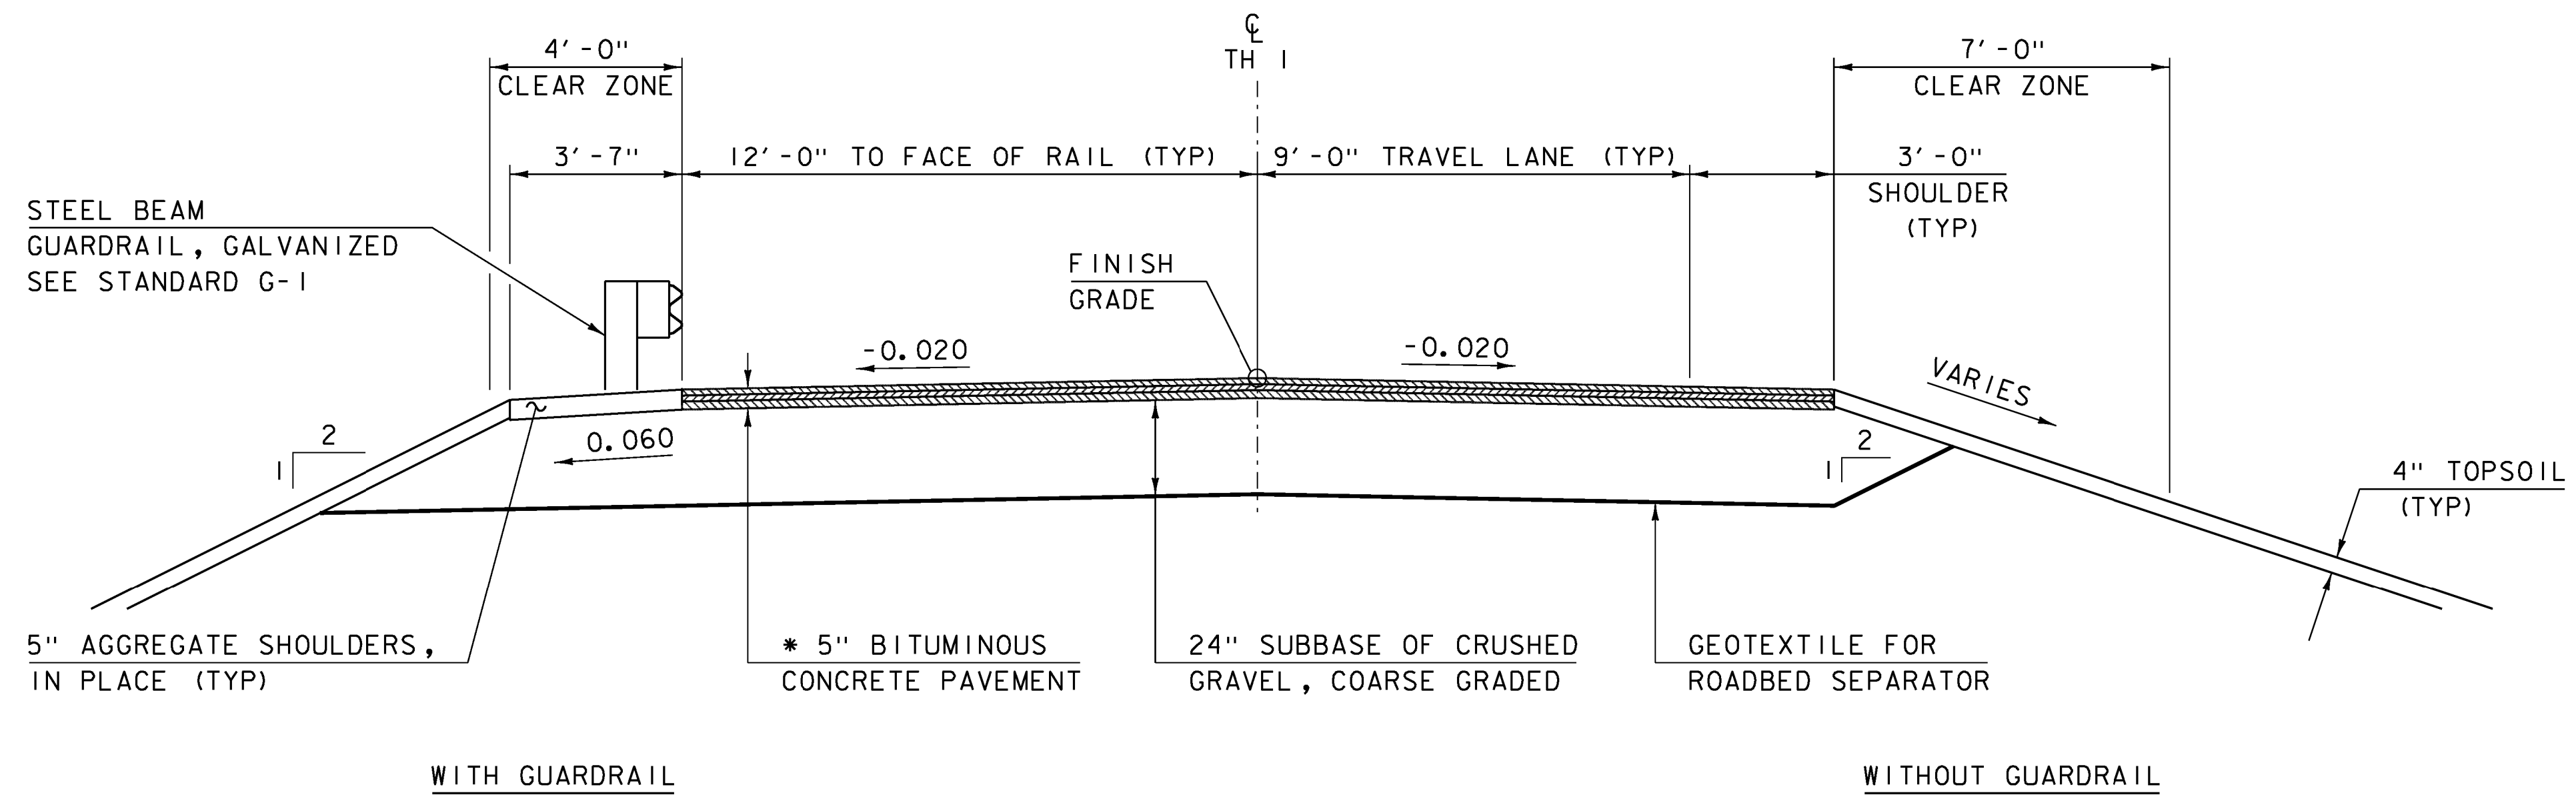

**ROADWAY TYPICAL SECTION**  
SCALE  $\frac{3}{8}'' = 1' - 0''$

- *  $1\frac{1}{2}''$  SUPERPAVE BITUMINOUS CONCRETE PAVEMENT TYPE IVS, OVER
- $1\frac{1}{2}''$  SUPERPAVE BITUMINOUS CONCRETE PAVEMENT TYPE IVS, OVER
- 2" SUPERPAVE BITUMINOUS CONCRETE PAVEMENT ~~TYPE IIS~~ TYPE IIIS AS PER W0*3 (5-14-15) STW

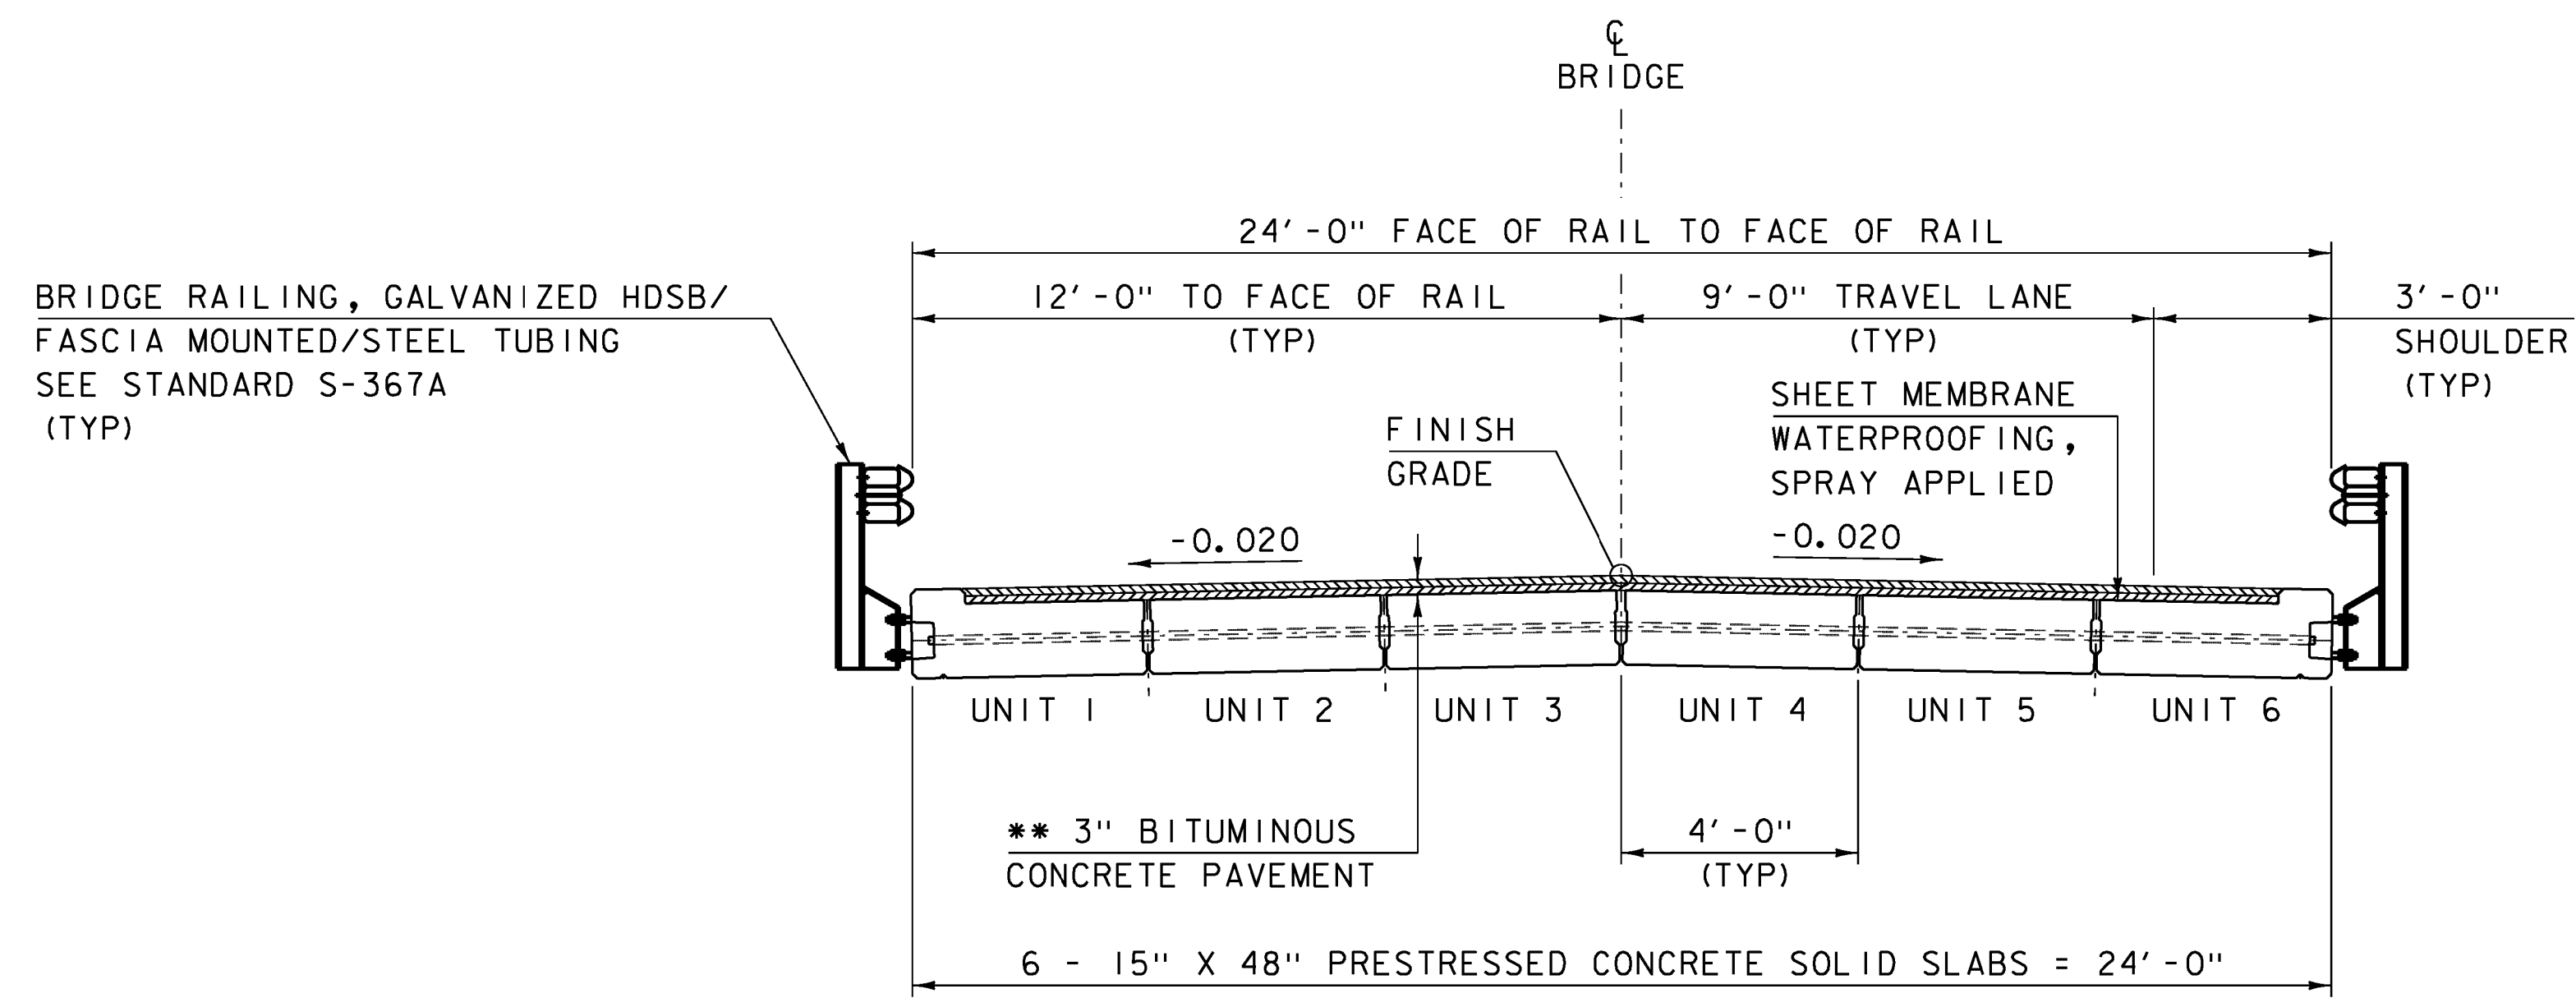


**BRIDGE TYPICAL SECTION**  
SCALE  $\frac{3}{8}'' = 1' - 0''$

- **  $1\frac{1}{2}''$  SUPERPAVE BITUMINOUS CONCRETE PAVEMENT TYPE IVS, OVER
- $1\frac{1}{2}''$  SUPERPAVE BITUMINOUS CONCRETE PAVEMENT TYPE IVS


**MATERIAL TOLERANCES**  
(IF USED ON PROJECT)

SURFACE	
- PAVEMENT (TOTAL THICKNESS)	+/- $\frac{1}{4}''$
- AGGREGATE SURFACE COURSE	+/- $\frac{1}{2}''$
SUBBASE	+/- 1"
SAND BORROW	+/- 1"

PROJECT NAME:	FAIRFIELD
PROJECT NUMBER:	BRF 0281(25)
FILE NAME:	sl2j156+typical.dgn
PROJECT LEADER:	R. YOUNG
DESIGNED BY:	R. KLINEFELTER
TYPICAL SECTIONS 1	
PLOT DATE:	18-AUG-2014
DRAWN BY:	K. FRIEDLAND
CHECKED BY:	J. SALVATORI
SHEET	12 OF 69

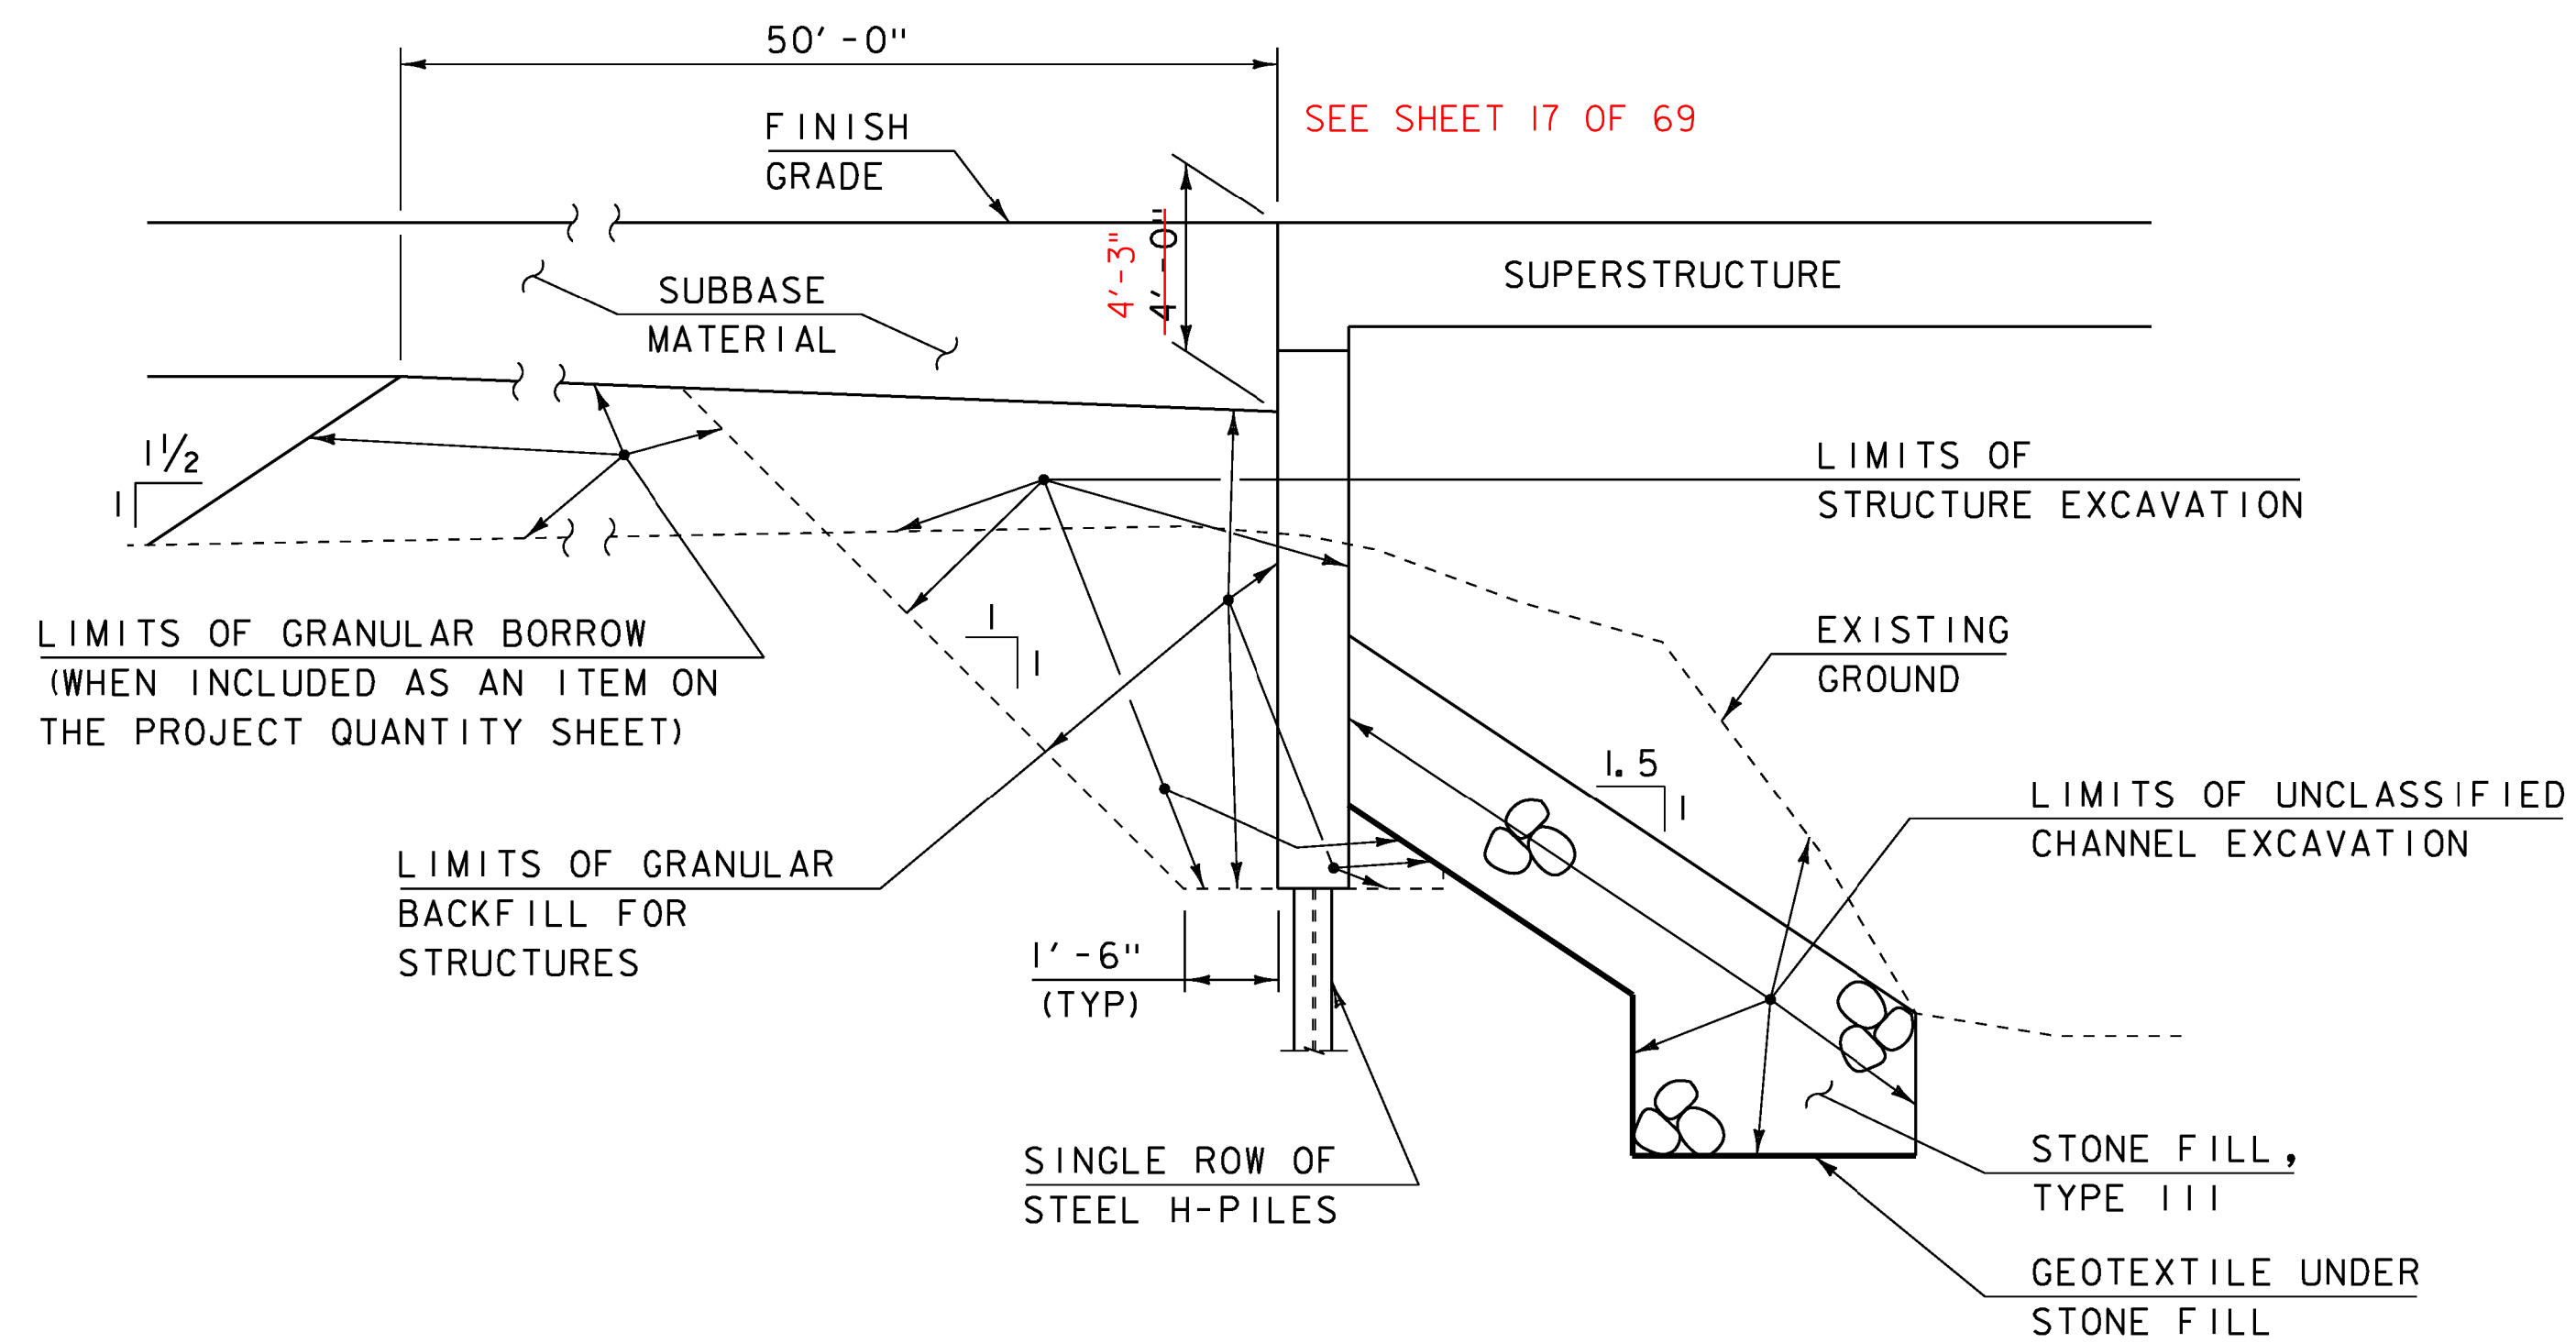


**TYPICAL INTEGRAL ABUTMENT SECTION**  
(NOT TO SCALE)

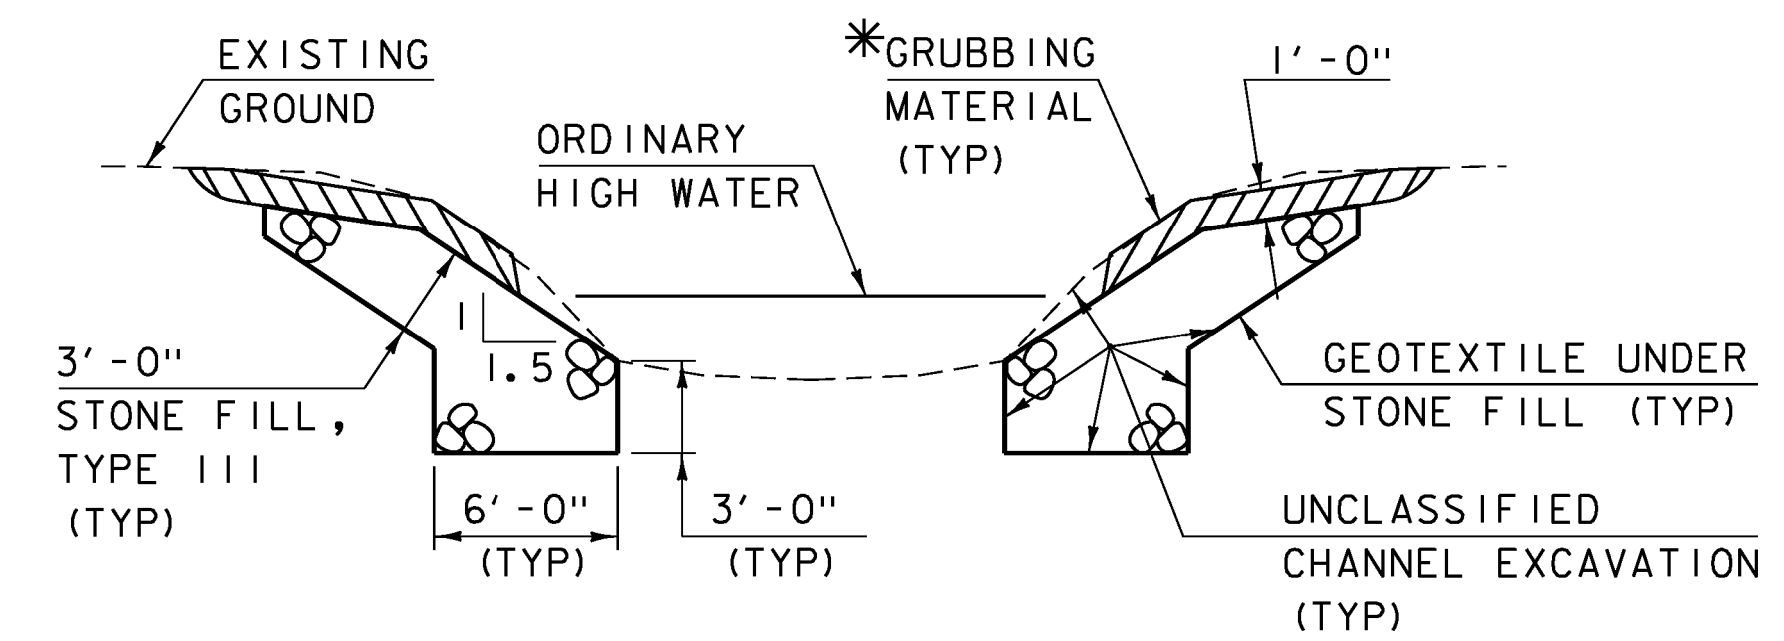


**TYPICAL CHANNEL SECTION**  
(NOT TO SCALE)

*GRUBBING MATERIAL SHALL NOT BE PLACED ON THE STONE FILL IN THE AREA UNDER THE BRIDGE. WHENEVER CHANNEL SLOPE INTERSECTS ROADWAY SUBBASE, GRUBBING MATERIAL SHALL BEGIN AT THE BOTTOM OF SUBBASE.

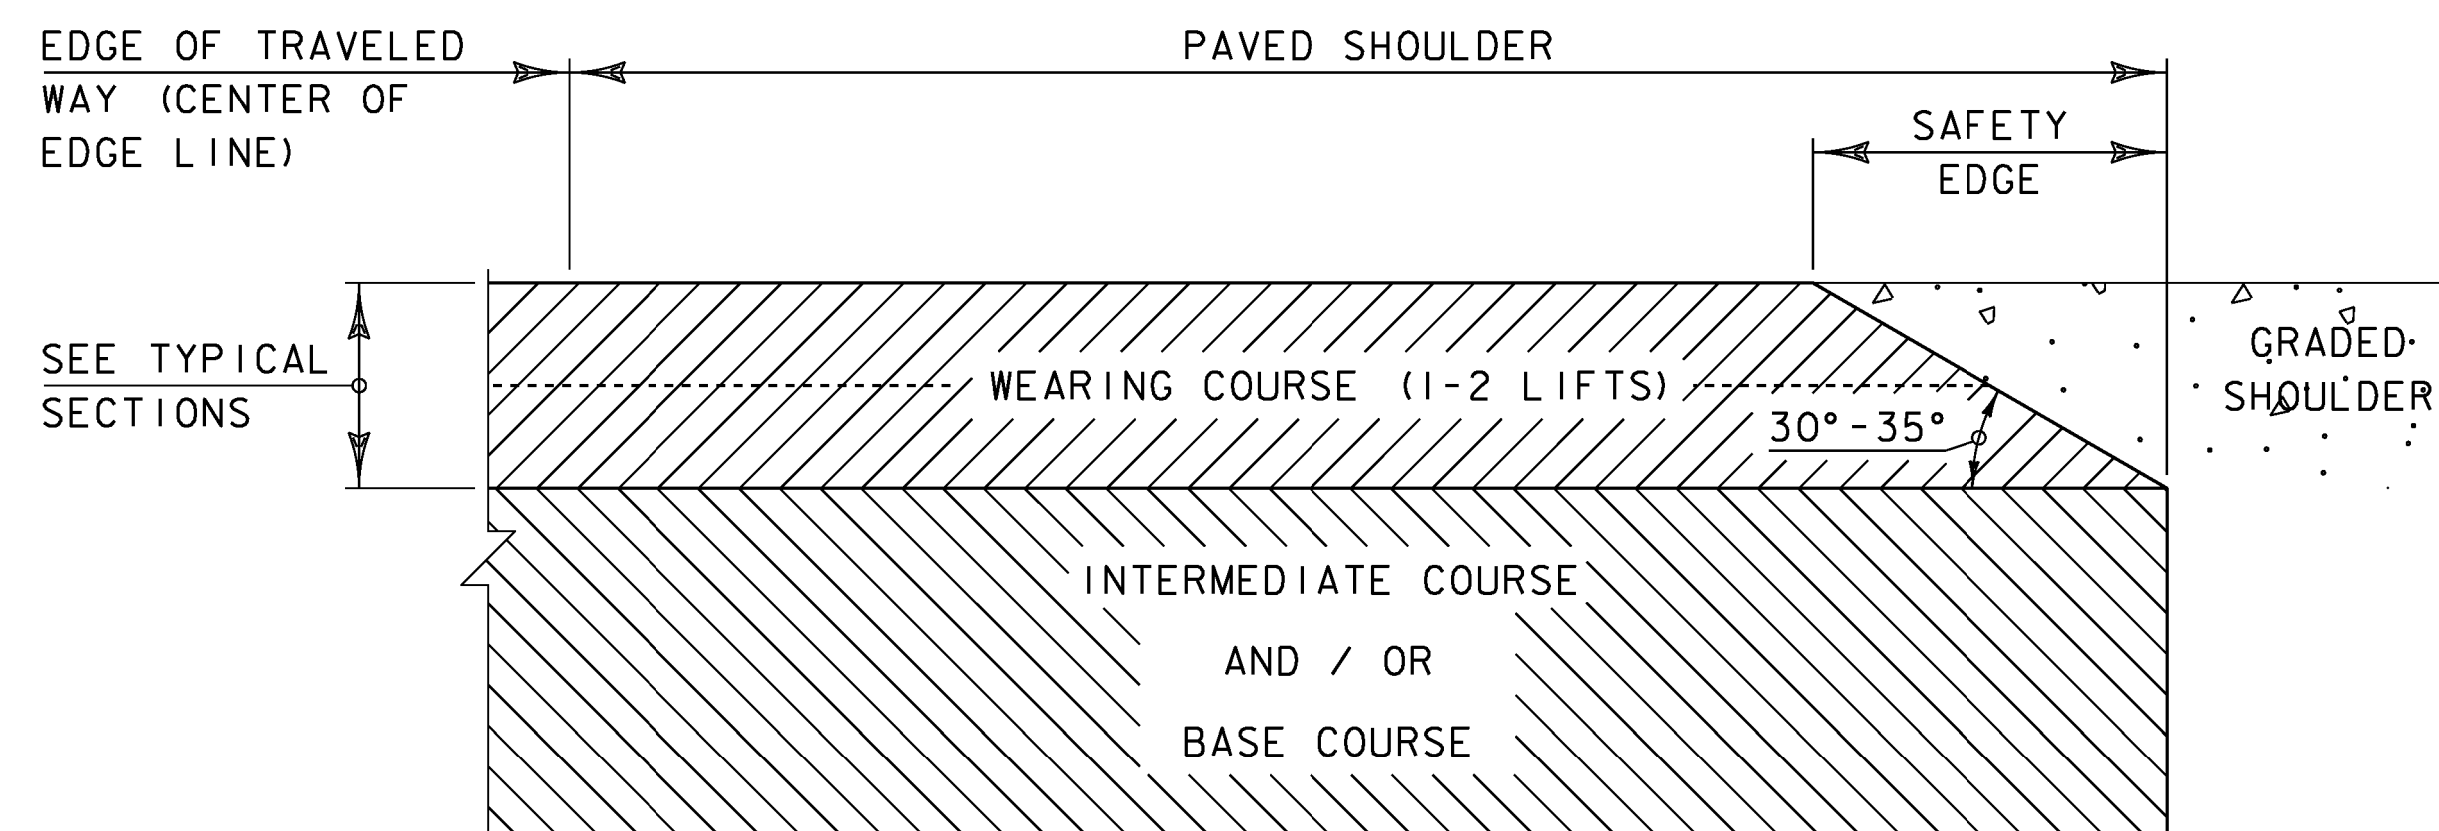

**SAFETY EDGE DETAIL**  
NOT TO SCALE

1. LEVELING COURSE MAY INCLUDE THE "SAFETY EDGE" AT THE CONTRACTOR'S CHOICE.
2. THE EDGE OF PAVEMENT SHALL BE FORMED IN SUCH A WAY THAT THE BITUMINOUS CONCRETE PAVEMENT IS EXTRUDED OR COMPRESSED TO FORM THE 30 TO 35 DEGREE ANGLE. DEVICES THAT SIMPLY STRIKE-OFF THE MIX WITHOUT PROVIDING ANY COMPACTIVE EFFORT WILL NOT BE ALLOWED.
3. THE PAVED SHOULDER EXTENDS FROM THE EDGE OF TRAVELED WAY TO THE EDGE OF THE WEARING COURSE, INCLUDING THE "SAFETY EDGE".

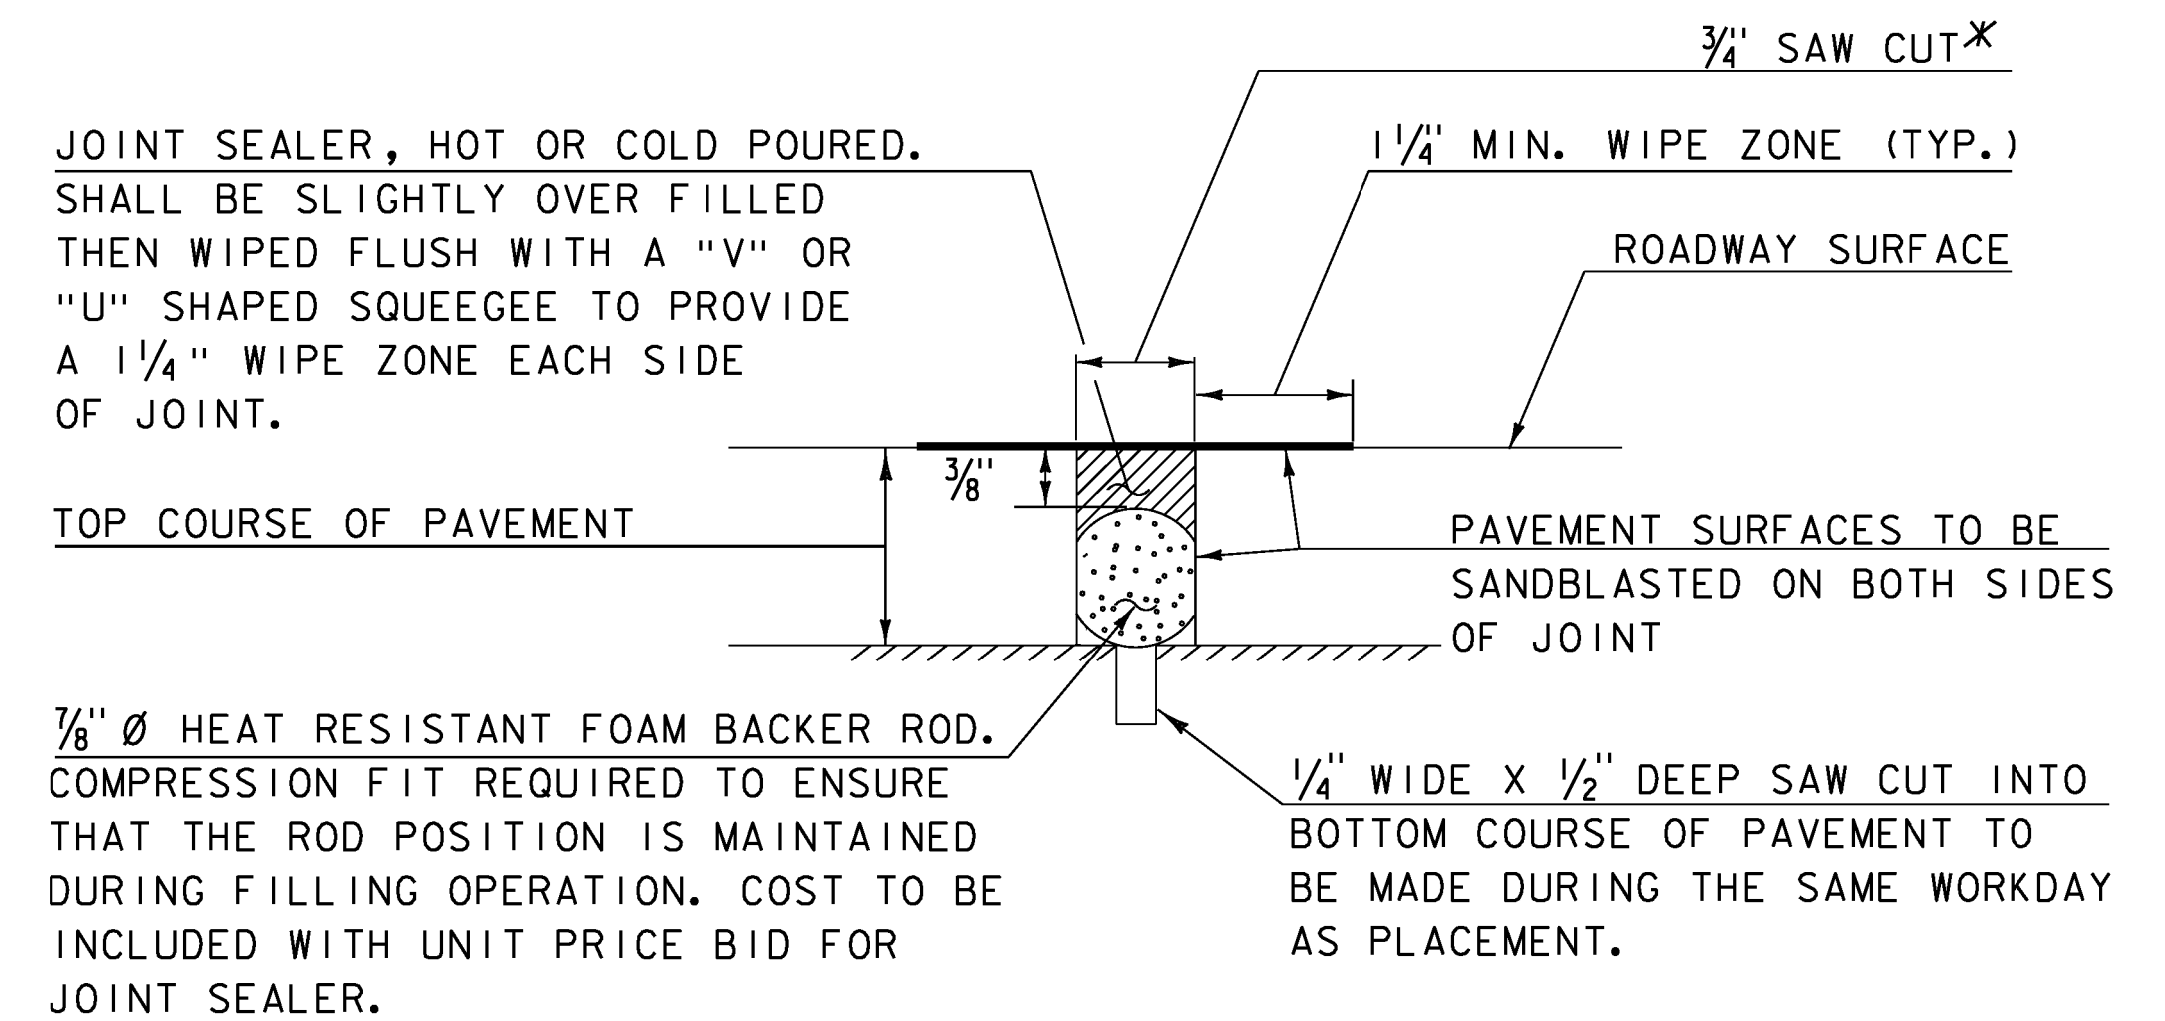

**SAWED PAVEMENT JOINT DETAIL**  
(NOT TO SCALE)

*JOINT IS TO BE LOCATED ACCURATELY BY STRING LINING, OR OTHER MEANS, PRIOR TO PAVING, SO THAT THE SAW CUTS WILL BE MADE DIRECTLY OVER THE END OF CONCRETE DECK. JOINT SHALL BE CUT DRY IN A SINGLE PASS AND BE SEALED WITHIN 24 HOURS OR PRIOR TO EXPOSURE TO TRAFFIC. JOINT SHALL BE CLEANED PRIOR TO APPLYING THE JOINT SEALER.

PROJECT NAME: FAIRFIELD  
PROJECT NUMBER: BRF 0281(25)

FILE NAME: sl2j156+ypical.dgn  
PROJECT LEADER: R. YOUNG  
DESIGNED BY: R. KLINFELTER  
TYPICAL SECTIONS 2

PLOT DATE: 18-AUG-2014  
DRAWN BY: K. FRIEDLAND  
CHECKED BY: J. SALVATORI  
SHEET 13 OF 69

GPS CONTROL POINTS

Zone: Vermont 4400  
 Geoid: GEOID09 (Conus)

HVCTRL #1


FFP1 [TEMPORARY]  
 NORTH = 825855.295  
 EAST = 1520013.268  
 ELEV. = 616.620

GENERAL LOCATION, FAIRFIELD, VT.  
 THE MARK IS A 14 CM (6 INCH) SPIKE DRIVEN INTO THE GROUND.  
 TO REACH FROM THE INTERSECTION OF VT ROUTE 36 AND SOUTH ROAD IN FAIRFIELD, GO SOUTH ALONG SOUTH ROAD FOR 2.3 MI (3.7 KM) TO THE SITE OF THE MARK ON THE LEFT SET IN THE SHOULDER ON THE EAST SIDE OF SOUTH ROAD. IT IS ABOUT 0.3 MI (0.5 KM) NORTH ALONG SOUTH ROAD FROM THE INTERSECTION OF BUCK HOLLOW ROAD.

HVCTRL #2

FFP2 [TEMPORARY]  
 NORTH = 827674.479  
 EAST = 1521551.675  
 ELEV. = 602.150


GENERAL LOCATION, FAIRFIELD, VT.  
 THE MARK IS A 14 CM (6 INCH) LONG SPIKE DRIVEN INTO THE GROUND.  
 TO REACH FROM THE INTERSECTION OF VT ROUTE 36 AND SOUTH ROAD IN FAIRFIELD, GO SOUTH ALONG SOUTH ROAD FOR 2.6 MI (4.2 KM) TO THE INTERSECTION OF BUCK HOLLOW ROAD RIGHT. * TURN RIGHT AND GO WEST ALONG BUCK HOLLOW ROAD FOR 0.2 MI (0.3 KM) TO THE MARK ON THE RIGHT SET IN THE SHOULDER ON THE NORTH SIDE OF THE ROAD.

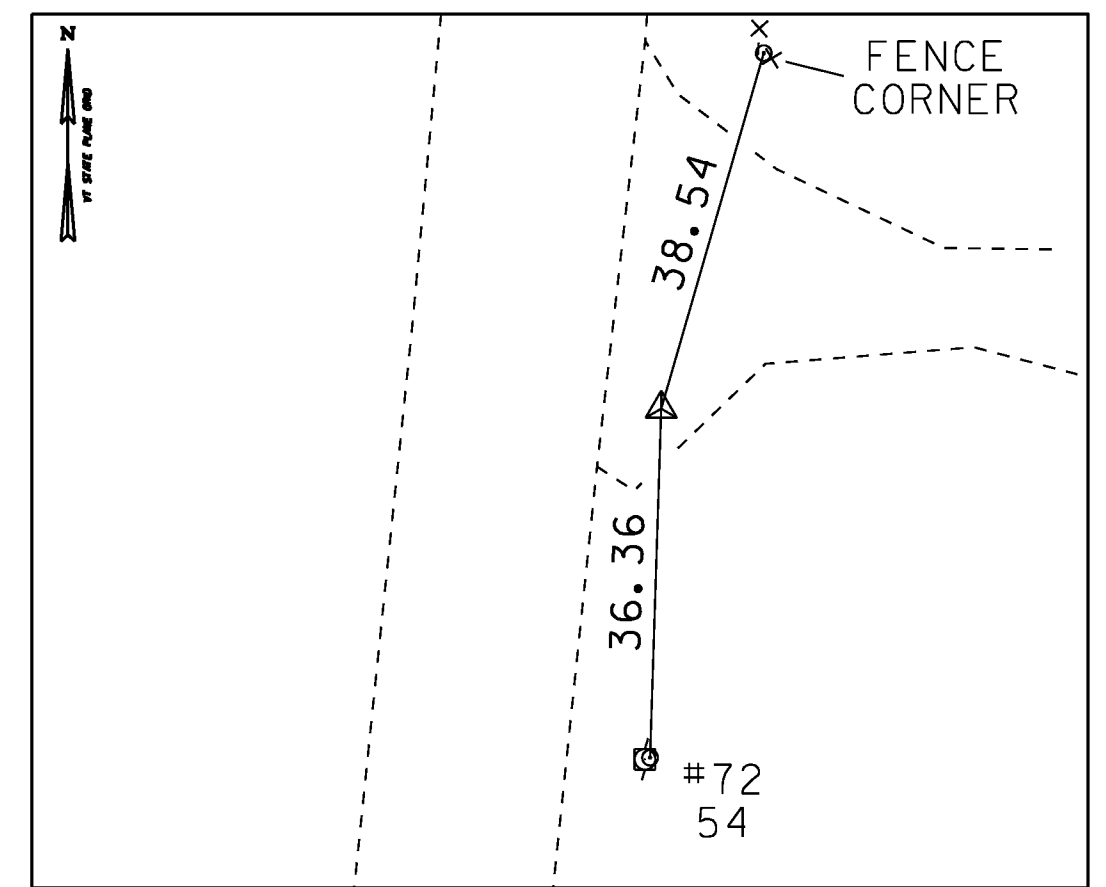

TRAVERSE TIES

HVCTRL #3





NORTH = 827176.115  
 EAST = 1521472.496  
 ELEV. = 602.691

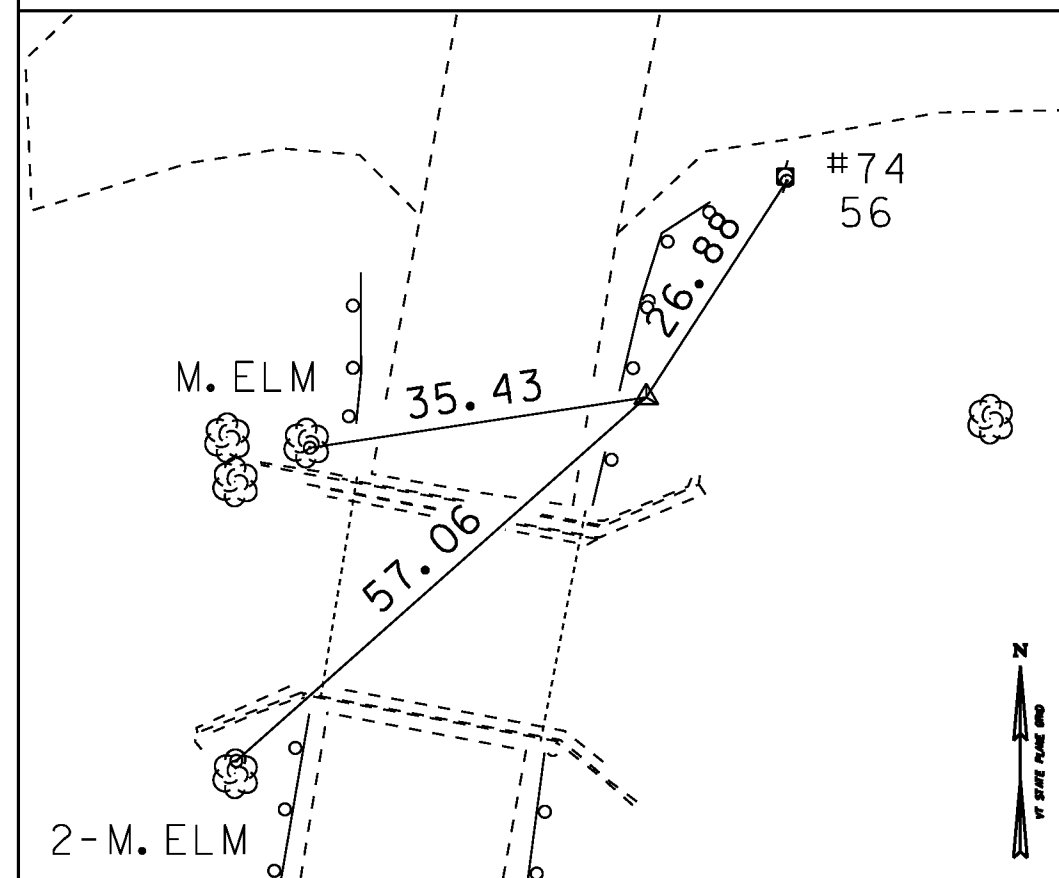

*MAIN TRAVERSE COMPLETED 3/25/2012 BY L. ORVIS P.C. & G. HITCHCOCK

HVCTRL #4

   
NORTH = 826705.981  
 EAST = 1521357.860  
 ELEV. = 605.531

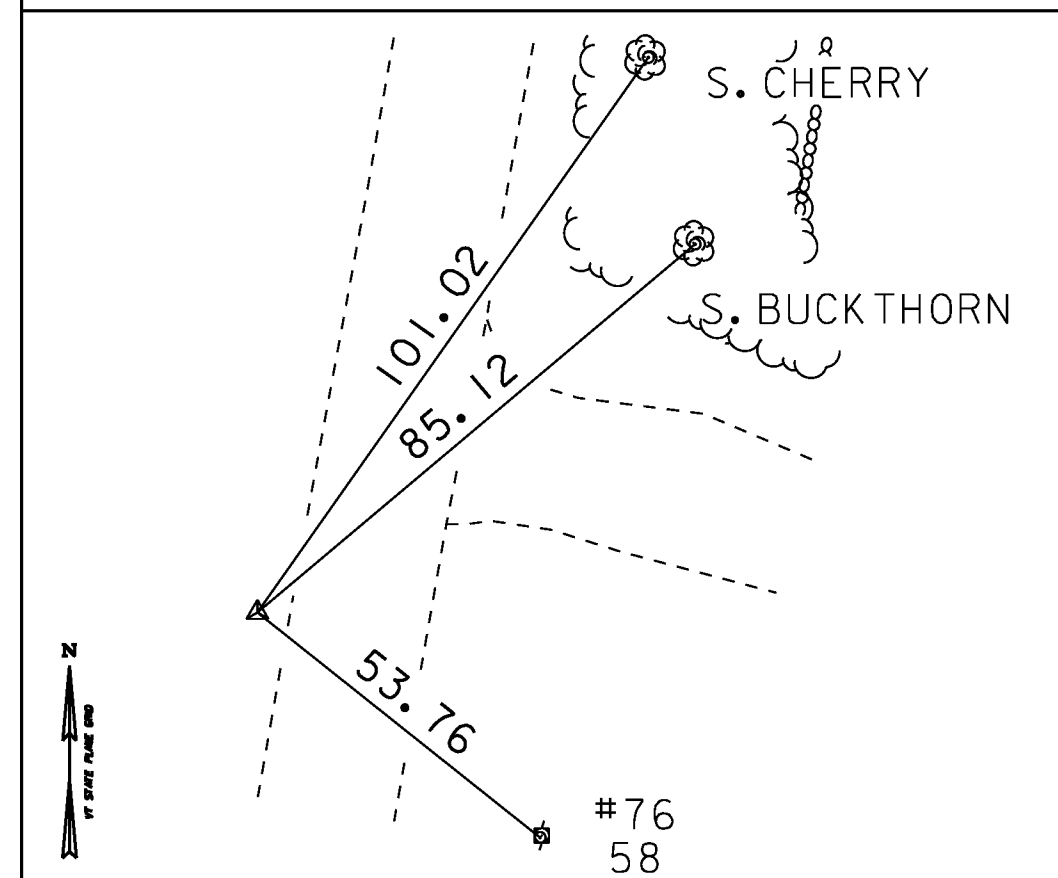

DATUM	
VERTICAL	NAVD 88
HORIZONTAL	NAD 83(07)
ADJUSTMENT	COMPASS

PROJECT NAME:	FAIRFIELD
PROJECT NUMBER:	BRF 028(25)
FILE NAME:	sl2j156tie.dgn
PROJECT LEADER:	R. YOUNG
DESIGNED BY:	R. KLINEFELTER
TIE SHEET	
PLOT DATE:	18-AUG-2014
DRAWN BY:	R. KLINEFELTER
CHECKED BY:	J. SALVATORI
SHEET	14 OF 69

BINGHAMVILLE SILT LOAM  
 0-2% SLOPE  
 TYPE C SOIL  
 K VALUE = 0.49  
 NOT HIGHLY ERODIBLE

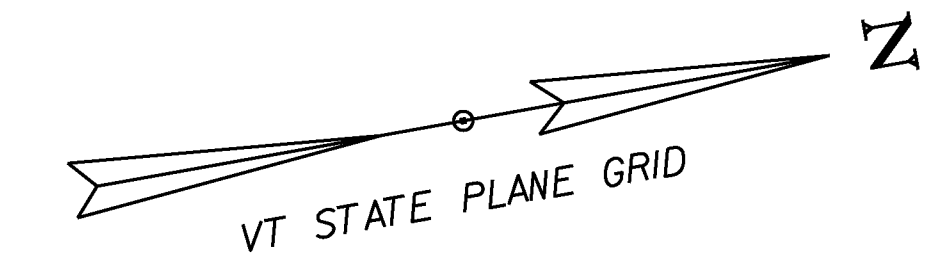

**FAIRFIELD RIVER FARM**


**FAIRCHILD, GEORGE**

**EXISTING CONDITIONS**

EXISTING BRIDGE DATA  
 CONCRETE SLAB BUILT IN 1949  
 SPAN LENGTH = 23 FEET  
 STRUCTURE LENGTH = 26 FEET  
 DECK WIDTH OUT TO OUT = 27.4 FEET  
 BRIDGE WIDTH CURB TO CURB = 23.8 FEET

WINDSOR LOAMY FINE SAND  
 3-8% SLOPE  
 TYPE C SOIL  
 K VALUE = 0.17  
 NOT HIGHLY ERODIBLE


WINOOSKI SILT LOAM  
 0-3% SLOPE  
 TYPE C SOIL  
 K VALUE = 0.49  
 NOT HIGHLY ERODIBLE

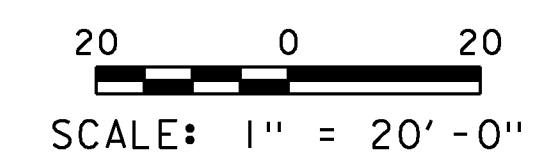

PROJECT NAME: FAIRFIELD  
 PROJECT NUMBER: BRF 028(25)

FILE NAME: sl2j156bdr_ero.dgn  
 PROJECT LEADER: R. YOUNG  
 DESIGNED BY: R. KLINEFELTER  
 EXISTING CONDITIONS



PLOT DATE: 18-AUG-2014  
 DRAWN BY: K. FRIEDLAND  
 CHECKED BY: J. SALVATORI  
 SHEET 15 OF 69

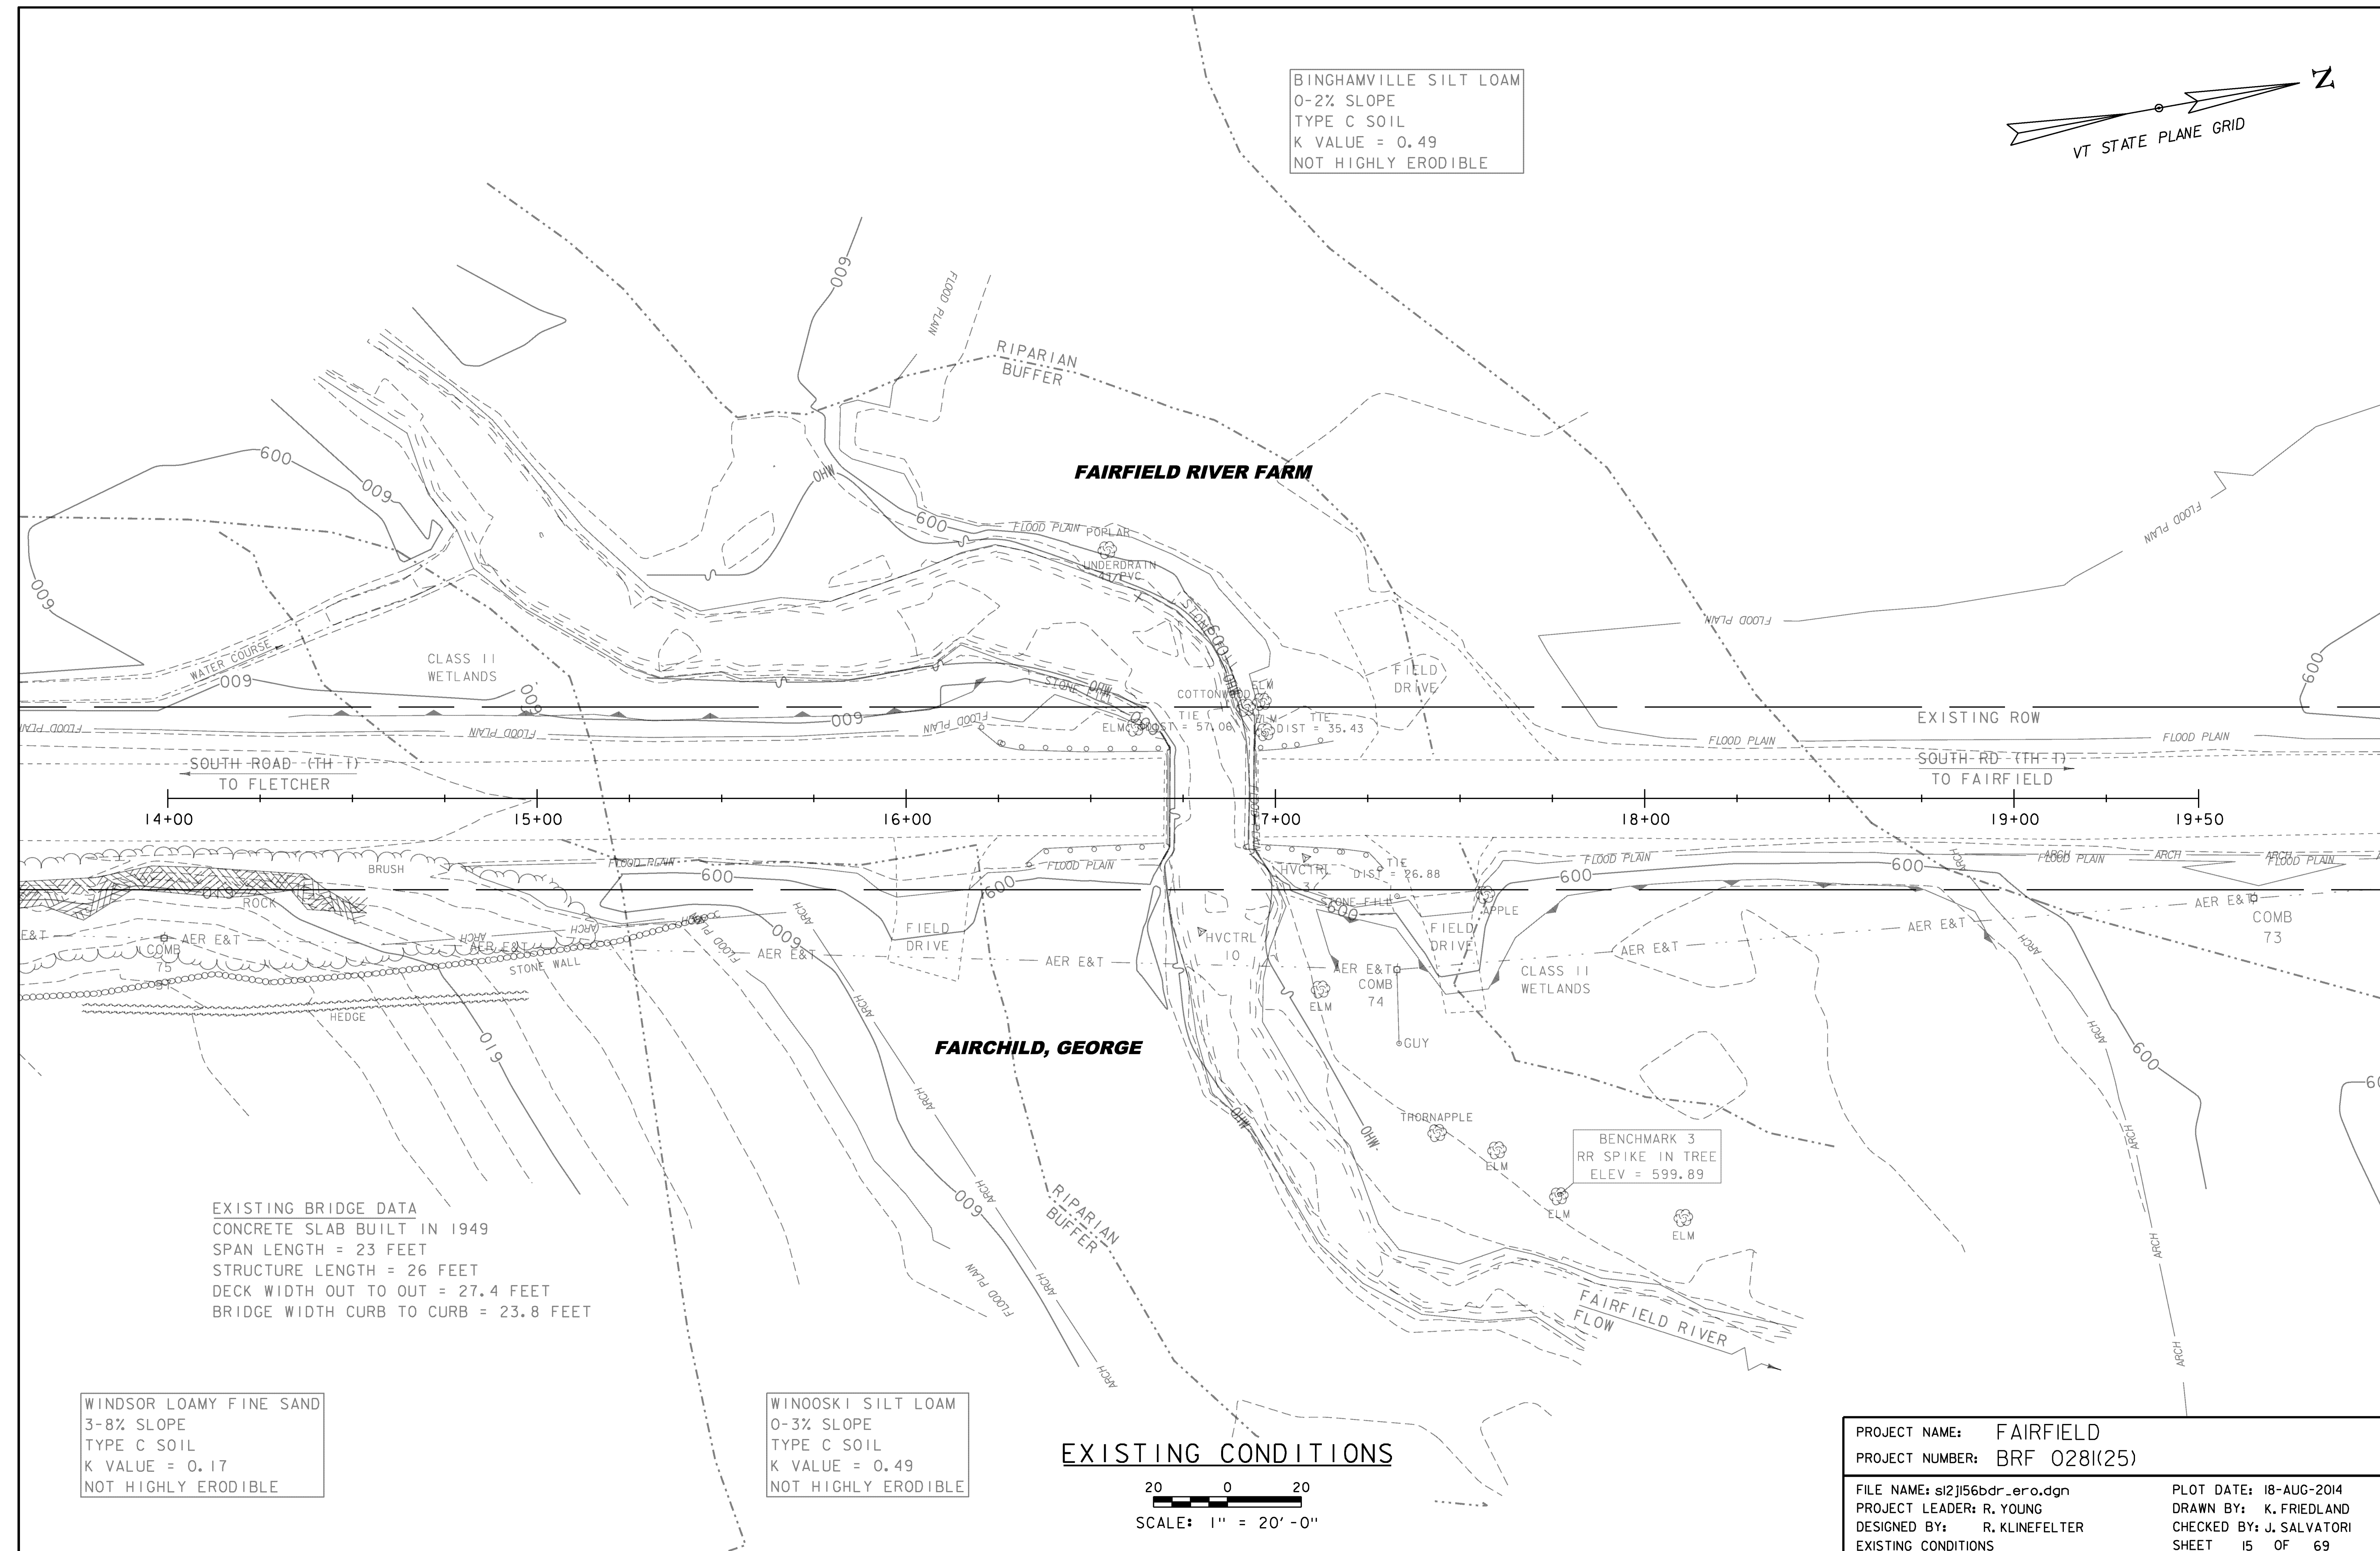

4" YELLOW LINE (DOUBLE)  
STA 15+25.00 - 18+50.00 CL

REMOVAL AND DISPOSAL OF GUARDRAIL  
STA 16+19.00 - 16+70.00 LT  
STA 16+32.00 - 16+70.00 RT  
STA 16+95.00 - 17+16.00 LT  
STA 16+96.00 - 17+29.00 RT

CONSTRUCT FIELD DRIVE  
W/ 5'-0" PAVED APRON AND  
6" AGGREGATE SURFACE COURSE BEYOND APRON  
STA 15+82.22 - 16+32.62 RT  
STA 17+34.00 - 17+94.84 LT

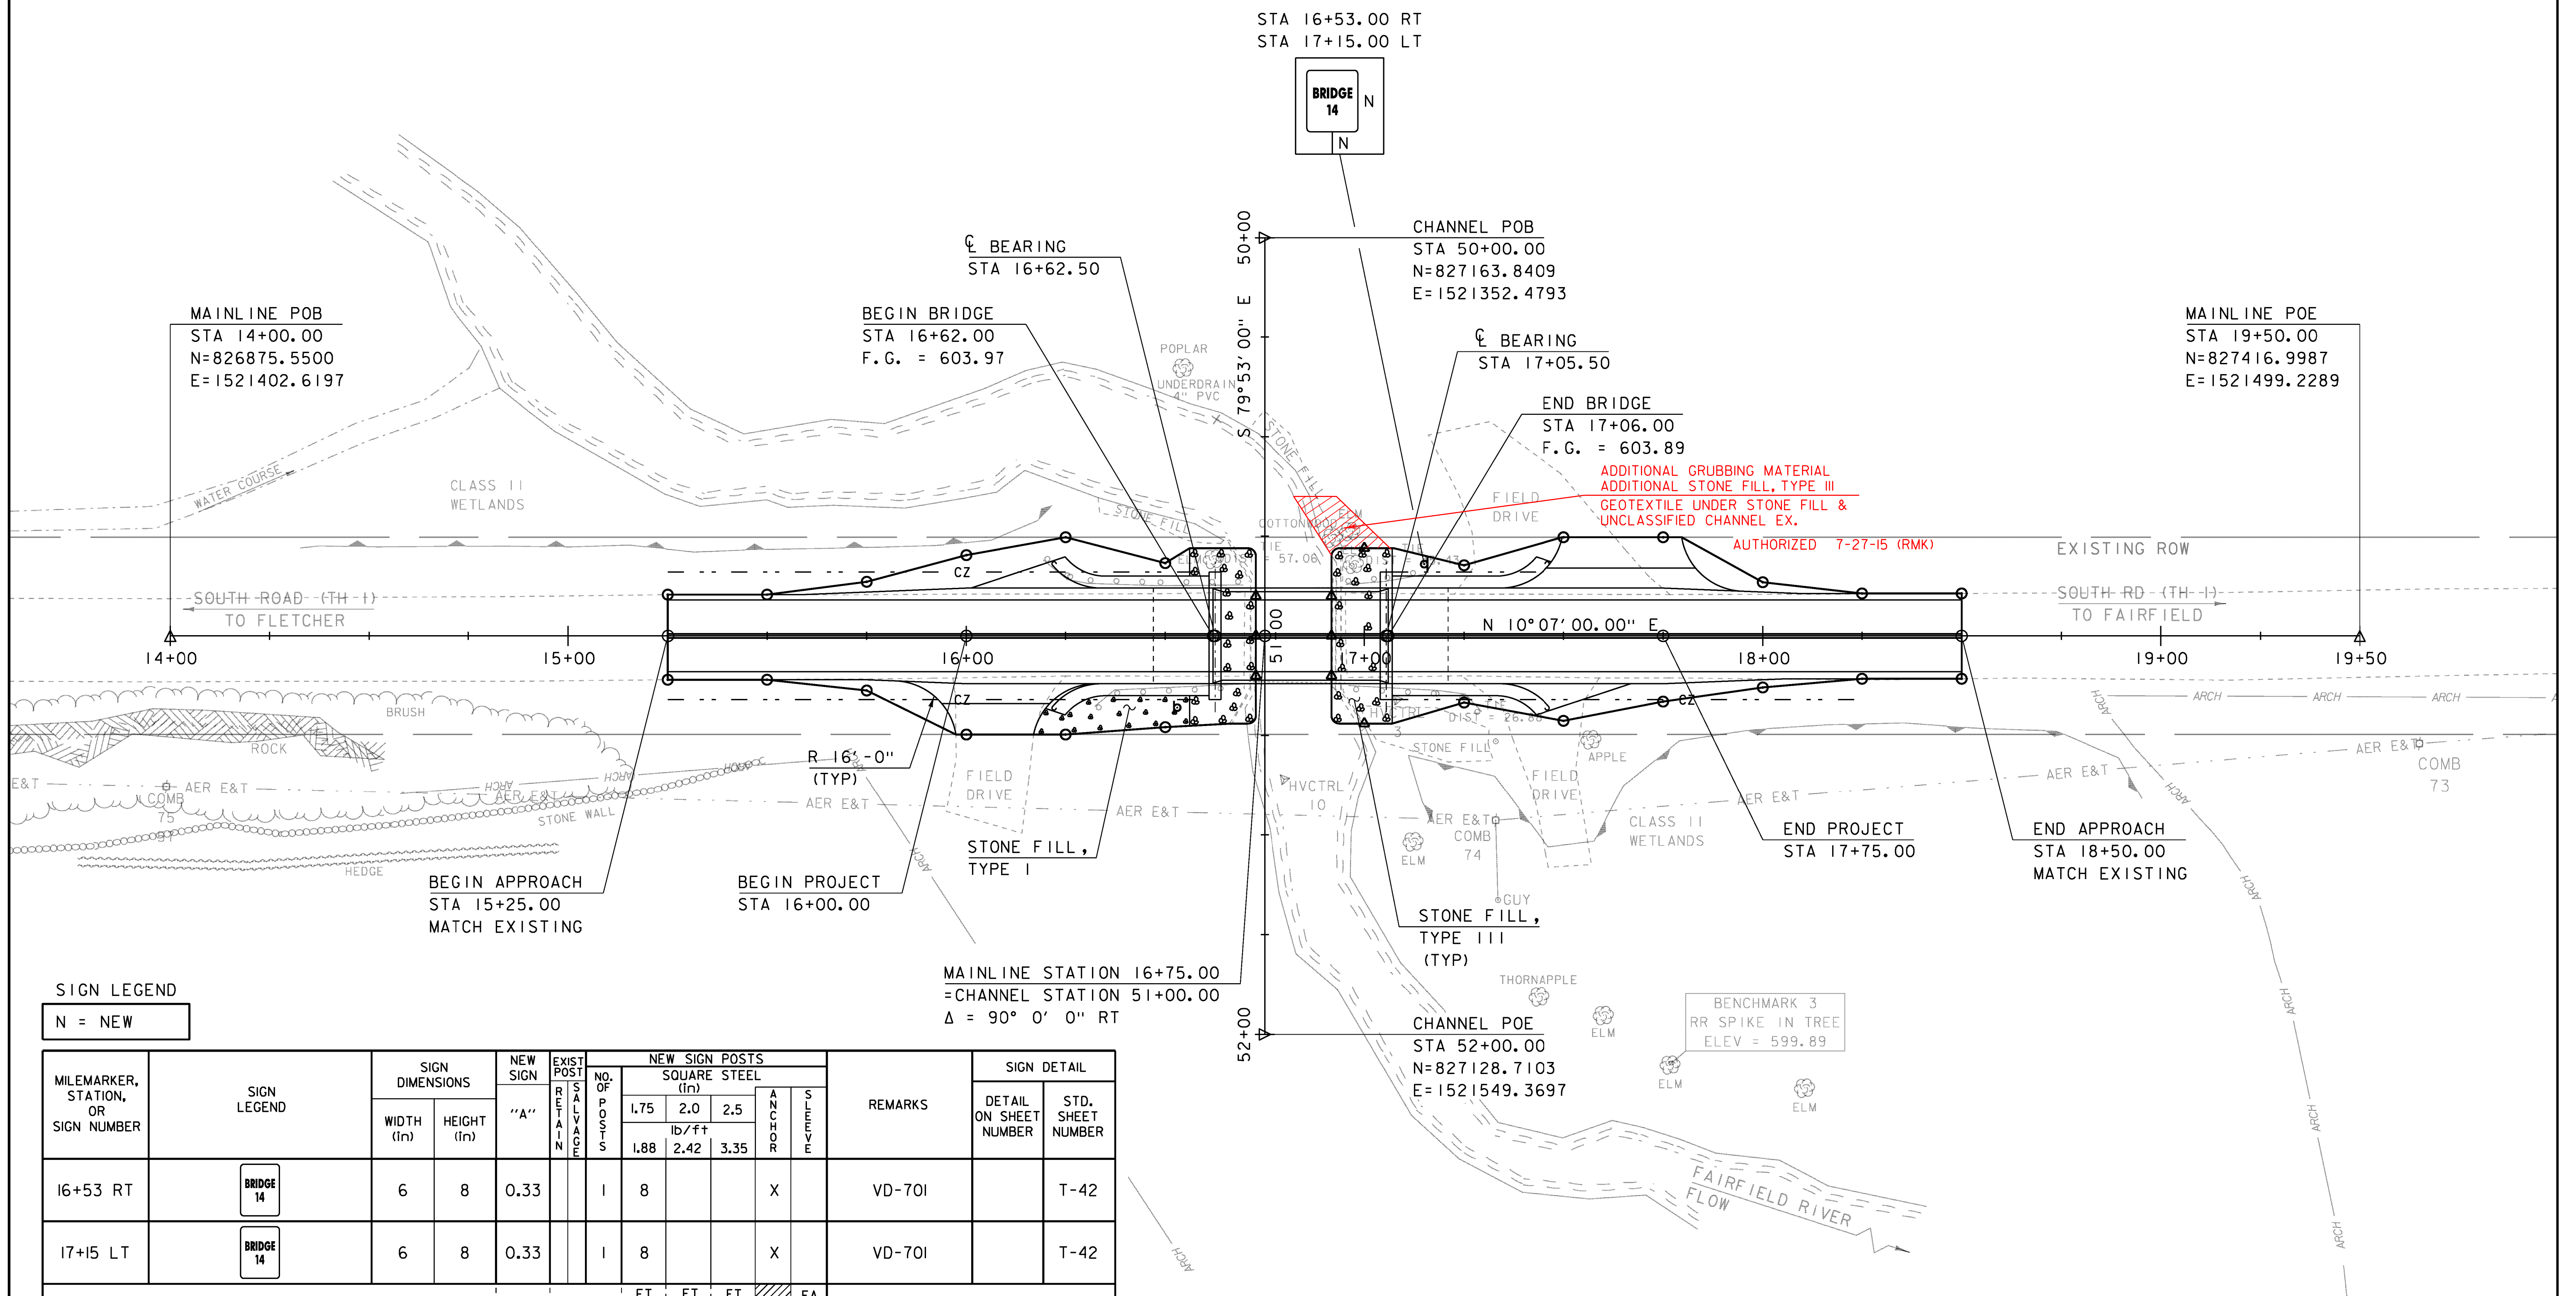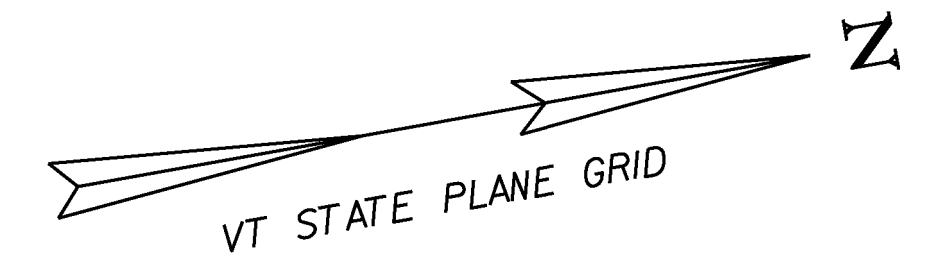

SIGN LEGEND


N = NEW

MILEMARKER, STATION, OR SIGN NUMBER	SIGN LEGEND	SIGN DIMENSIONS		NEW SIGN "A"	EXIST. SIGN RETAINAGE	NO. OF POSTS	NEW SIGN POSTS SQUARE STEEL (in)				REMARKS	SIGN DETAIL		
		WIDTH (in)	HEIGHT (in)				SQUARE STEEL			ANCHOR		SUPPORT	DETAIL ON SHEET NUMBER	STD. SHEET NUMBER
							1.75	2.0	2.5					
16+53 RT	BRIDGE 14	6	8	0.33		1	8			X		VD-70I	T-42	
17+15 LT	BRIDGE 14	6	8	0.33		1	8			X		VD-70I	T-42	
		TOTALS		SF 0.66			16	FT	FT	FT	EA			

FINAL POST LENGTHS ARE TO BE DETERMINED IN THE FIELD. POST SIZES ARE COMPUTED BASED ON INFORMATION FURNISHED ON THE STANDARD SHEETS AND THE VTRANS "SIGN POST DESIGN GUIDELINE."


SHS = STANDARD HIGHWAY SIGNS (MUTCD)

LAYOUT SHEET

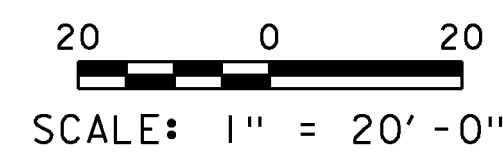


NOTE:  
ADJUST NEW CENTERLINE AND EDGE LINES TO MATCH EXISTING LINES AT BEGIN/END APPROACH

PROJECT NAME: FAIRFIELD	PLOT DATE: 18-AUG-2014
PROJECT NUMBER: BRF 0281(25)	DRAWN BY: K. FRIEDLAND
FILE NAME: sl2j156bdr.dgn	CHECKED BY: J. SALVATORI
DESIGNED BY: R. KLINFELTER	SHEET 16 OF 69
LAYOUT SHEET	

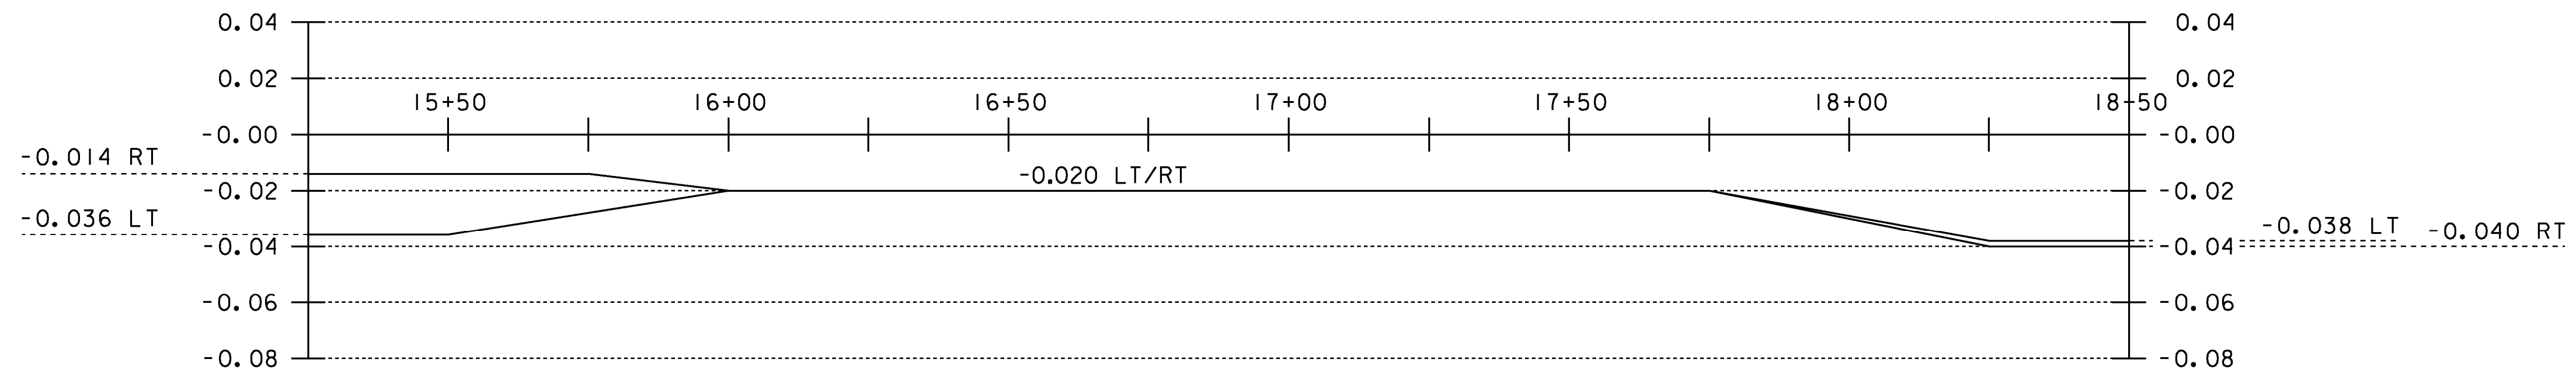


**BANKING DIAGRAM**

HORIZONTAL SCALE 1"=20'  
NO VERTICAL SCALE

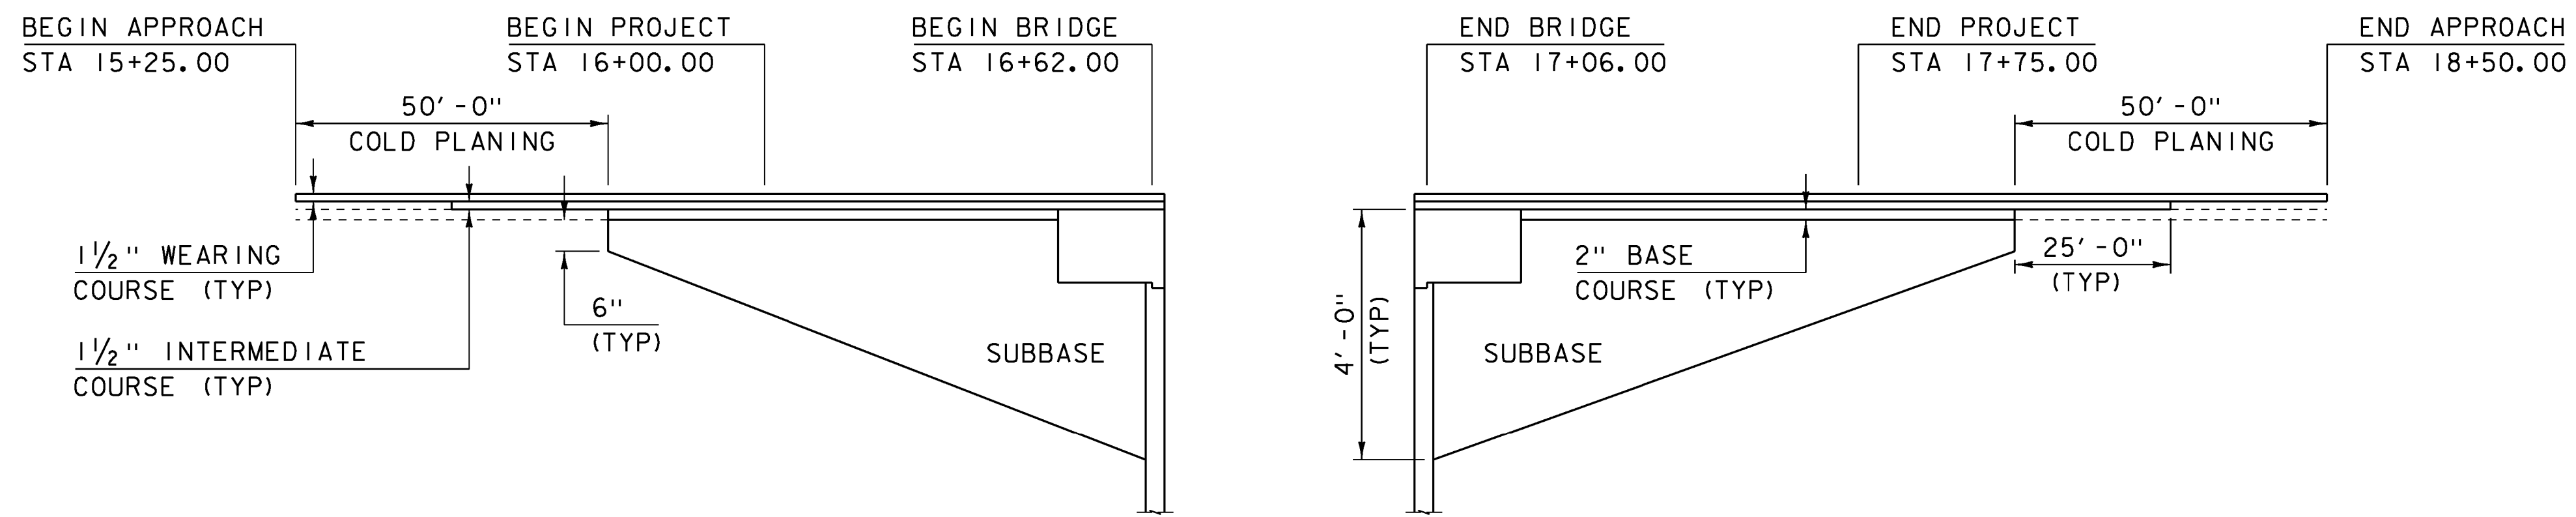

**MATERIAL TRANSITION**

HORIZONTAL SCALE 1"=20'  
NO VERTICAL SCALE

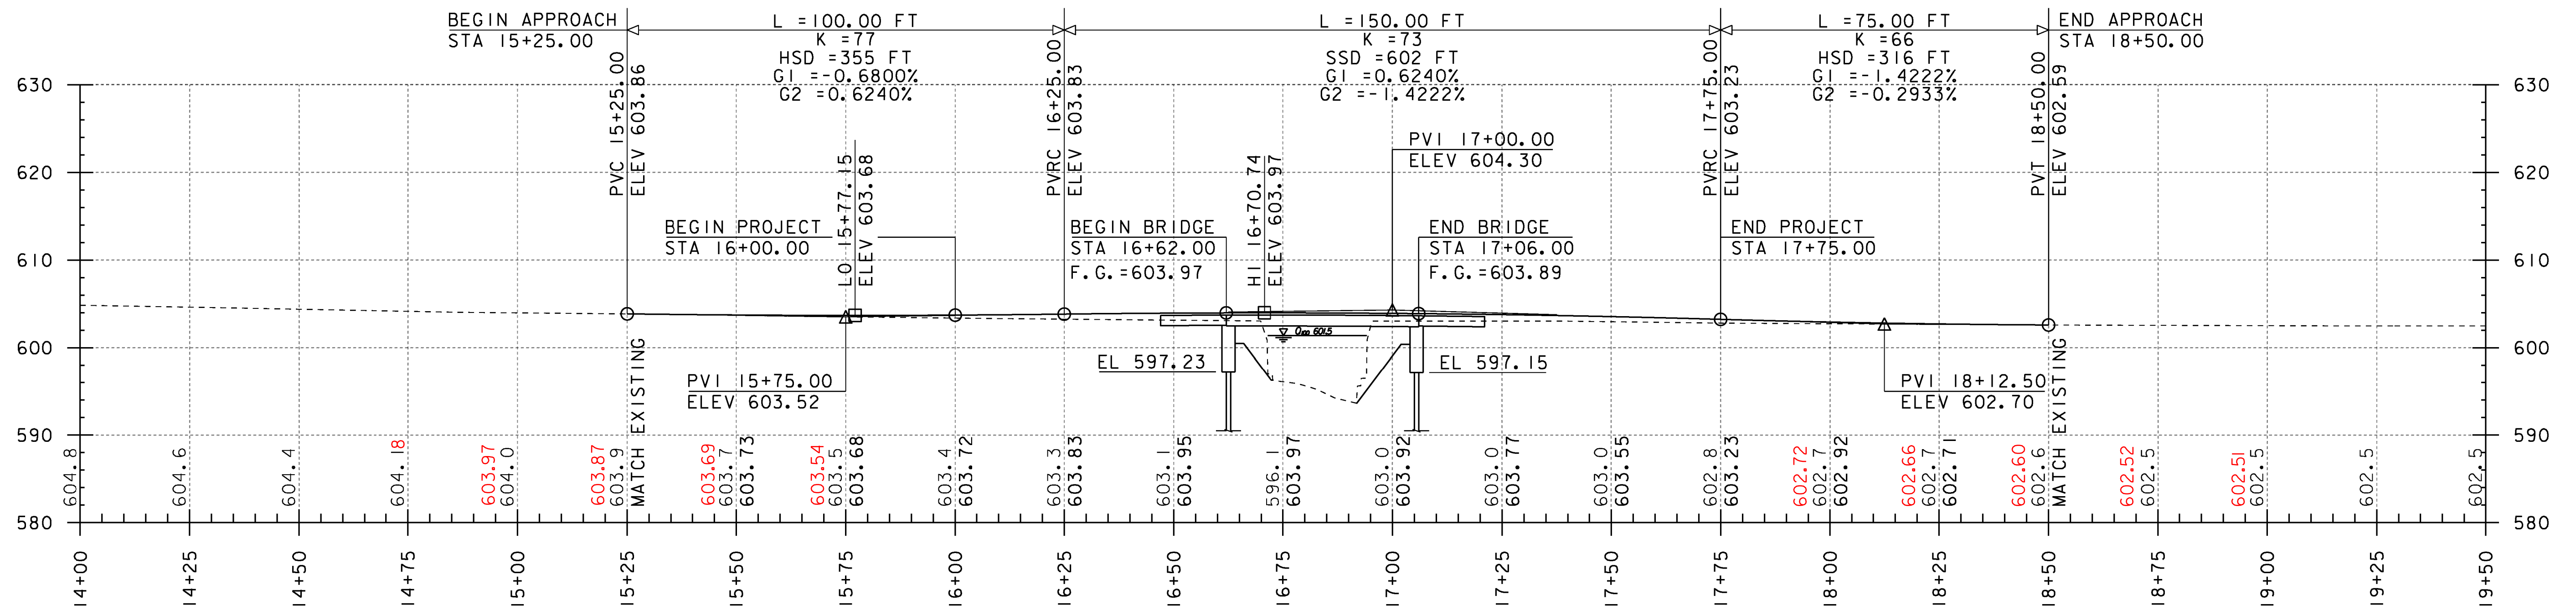

**MAINLINE PROFILE**




HORIZONTAL SCALE 1"=20'  
VERTICAL SCALE 1"=10'

THE GRADES SHOWN TO THE NEAREST TENTH ARE THE ORIGINAL GROUND ELEVATIONS ALONG THE PROPOSED ALIGNMENT.  
THE GRADES SHOWN TO THE NEAREST HUNDRETH ARE THE FINISH GRADES ALONG THE PROPOSED ALIGNMENT.

PROJECT NAME:	FAIRFIELD	PLOT DATE:	18-AUG-2014
PROJECT NUMBER:	BRF 0281(25)	DRAWN BY:	K. FRIEDLAND
FILE NAME:	sl2j156profile.dgn	CHECKED BY:	J. SALVATORI
PROJECT LEADER:	R. YOUNG	SHEET	17 OF 69
DESIGNED BY:	R. KLINEFELTER	MAINLINE PROFILE & BANKING DIAGRAM	

**NOTES:**

1. THE CONTRACTOR SHALL BE RESPONSIBLE FOR SIGNS AND BARRICADES SHOWN ON THIS SHEET. THEY SHALL BE PAID FOR UNDER ITEM 900.645, "SPECIAL PROVISION (TRAFFIC CONTROL, ALL-INCLUSIVE)".
2. TEMPORARY TRAFFIC BARRIER AT EACH END OF THE PROJECT SHALL BE FURNISHED IN ACCORDANCE WITH SECTION 621 AND PAYMENT SHALL BE CONSIDERED INCIDENTAL TO PAY ITEM 900.645, "SPECIAL PROVISION (TRAFFIC CONTROL, ALL-INCLUSIVE)".
3. SEE STANDARD T-10 FOR TYPICAL APPROACH SIGNING.

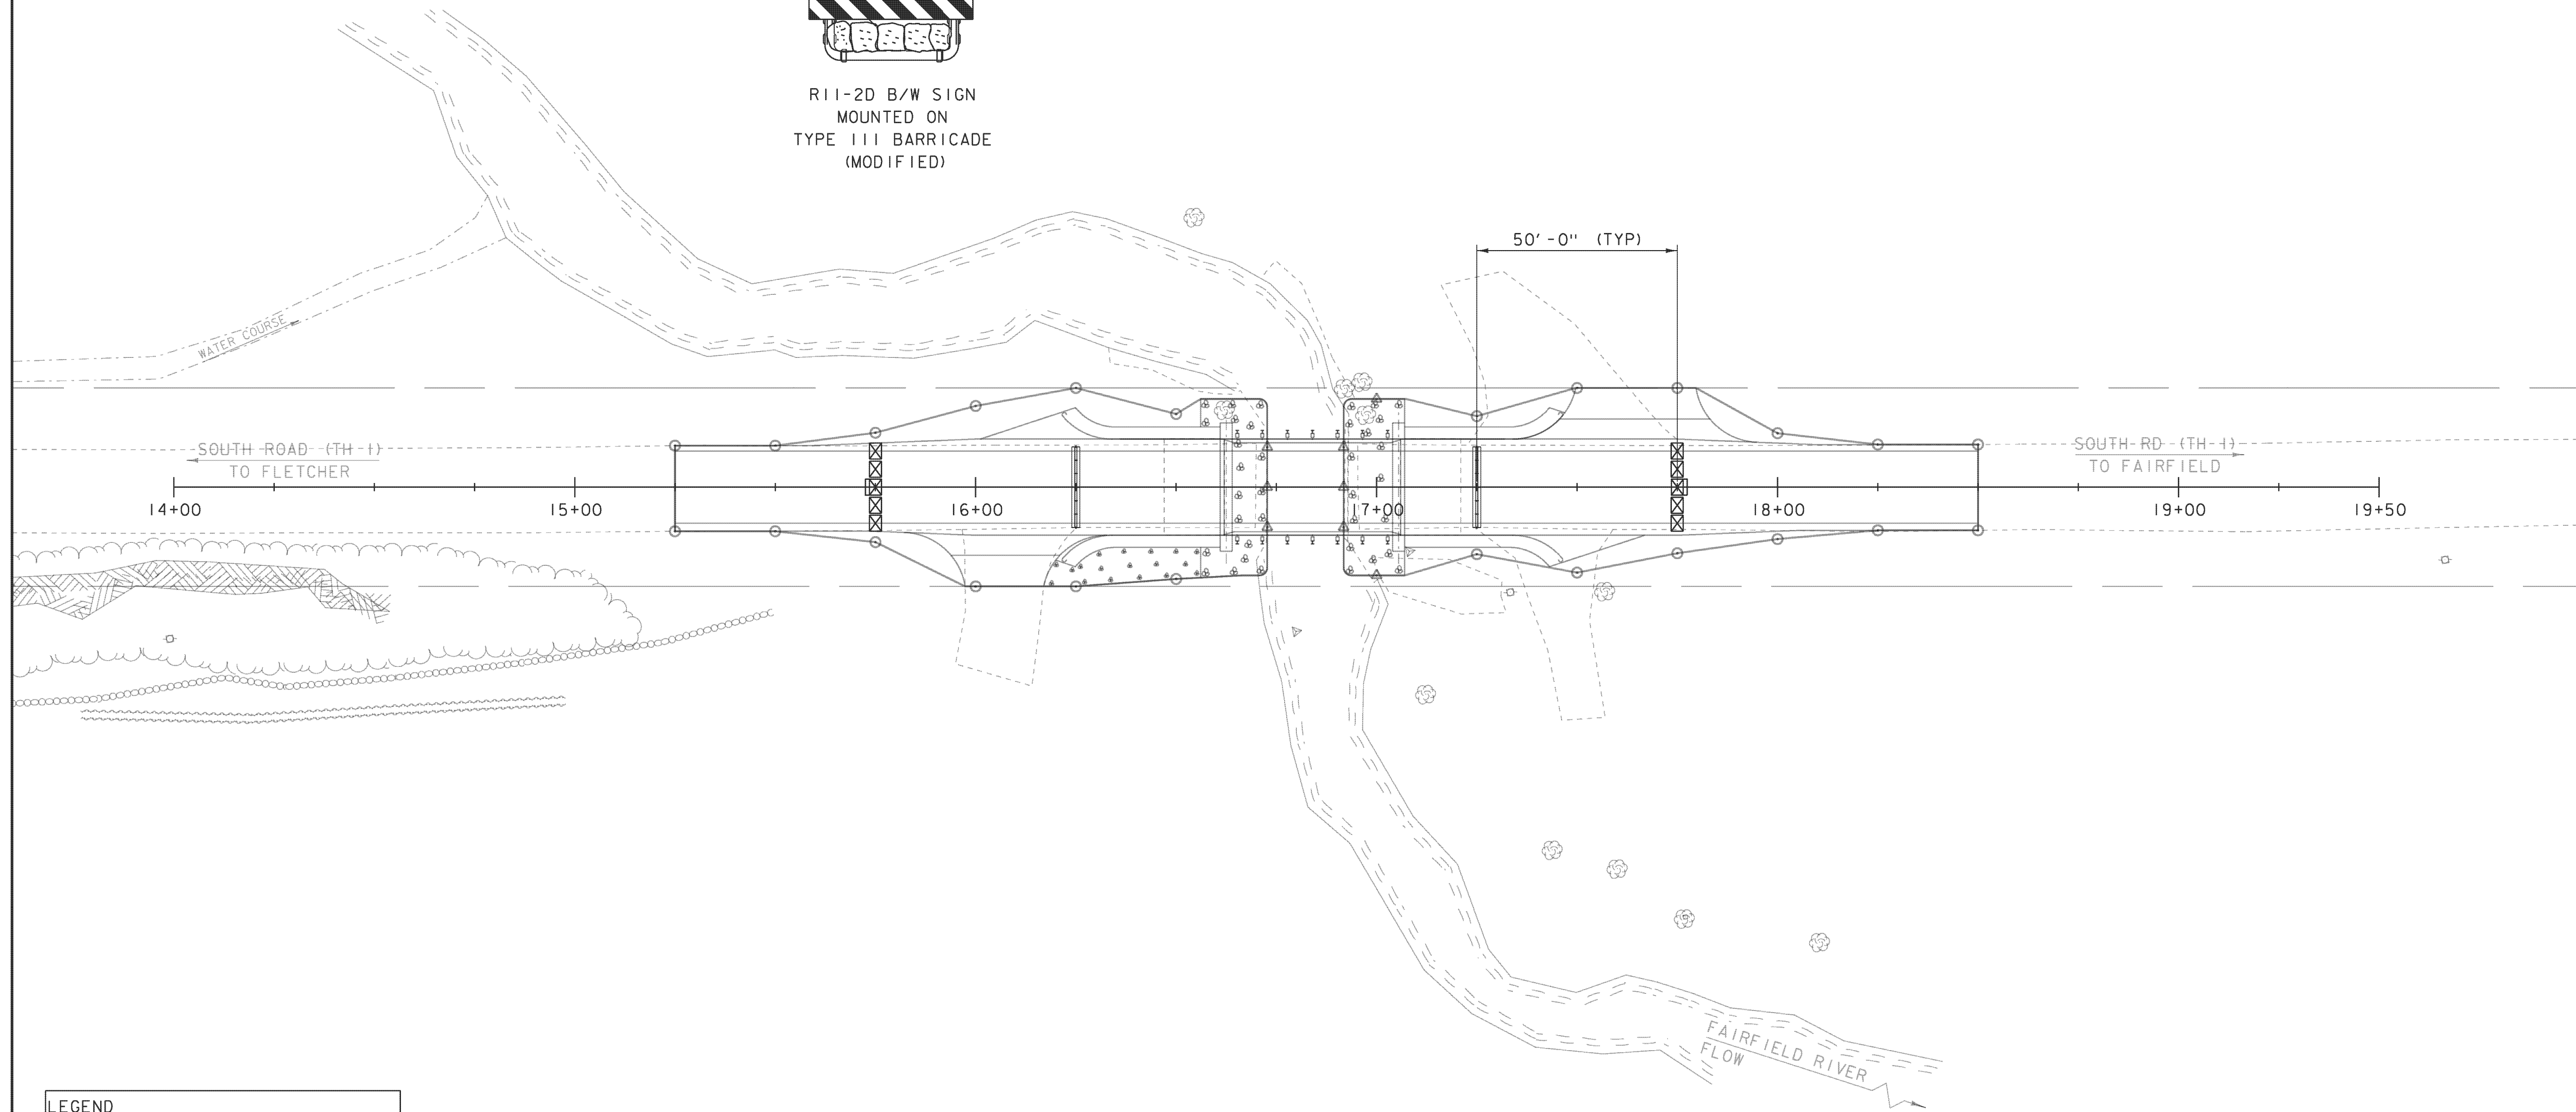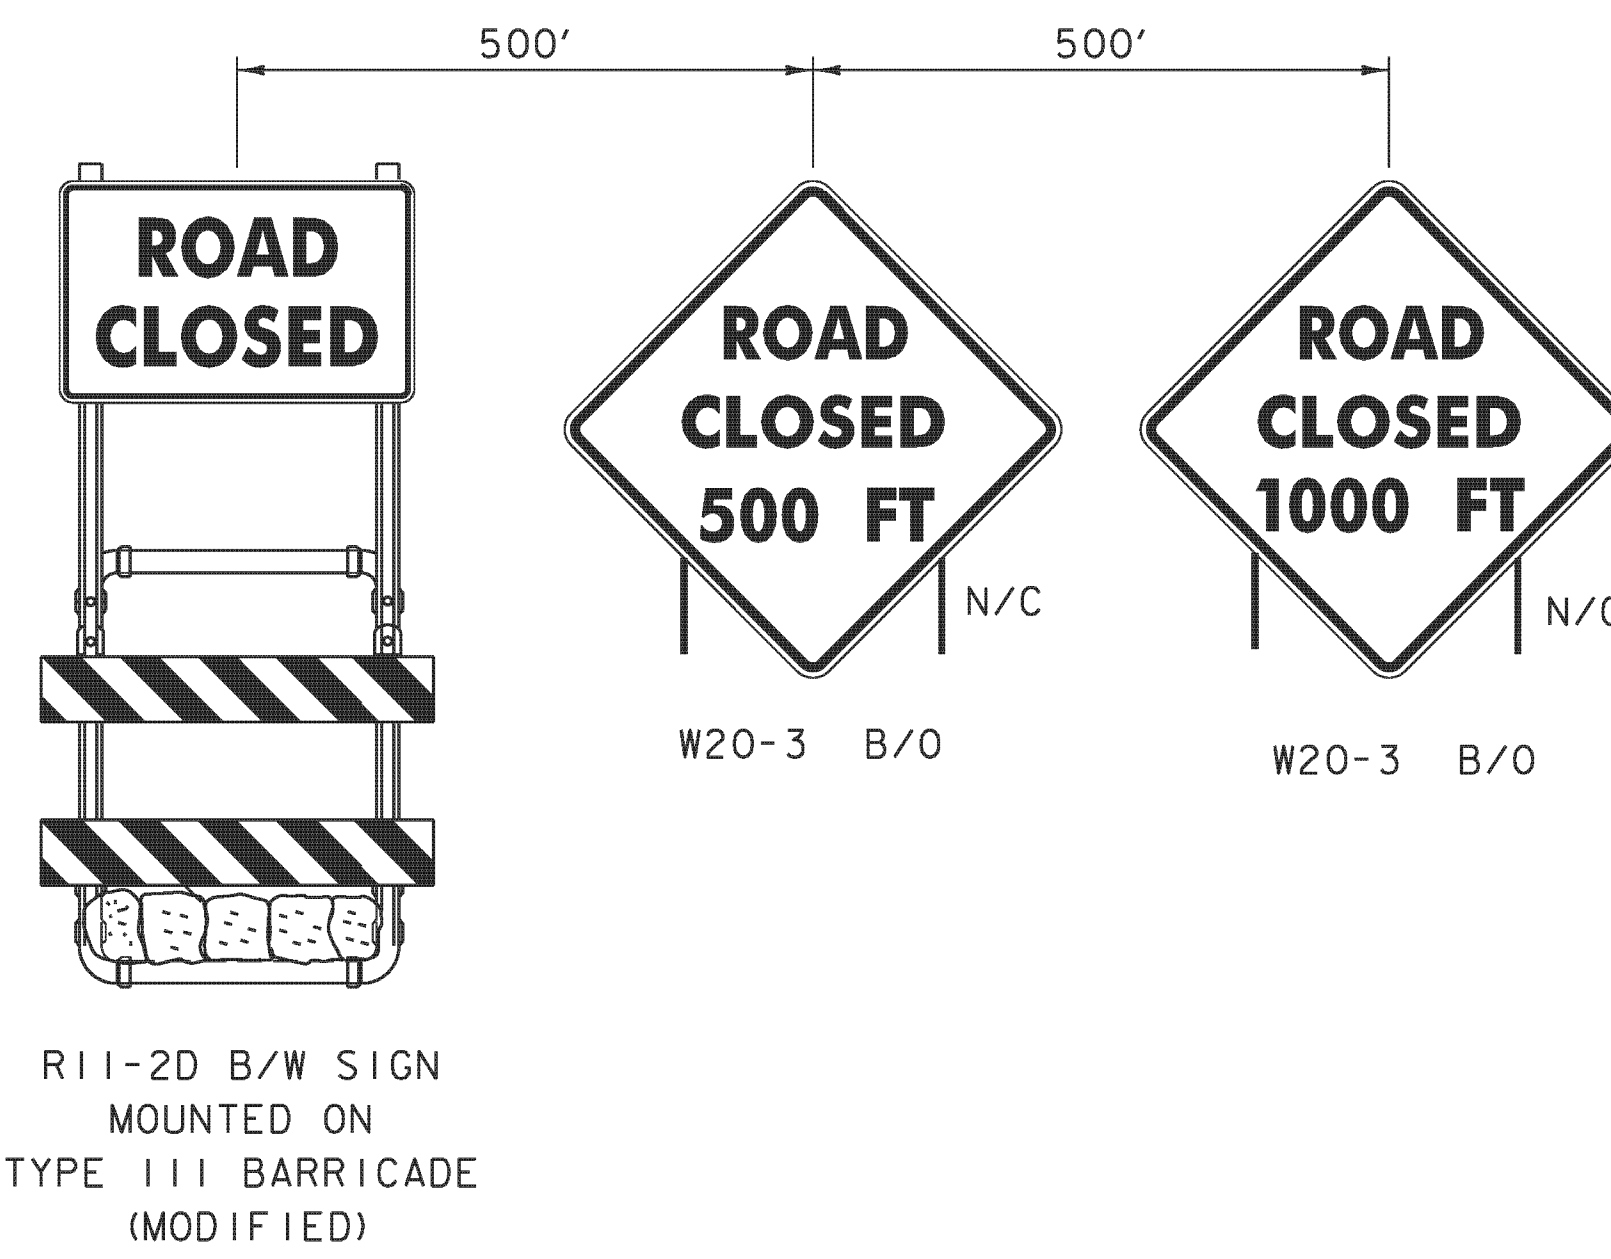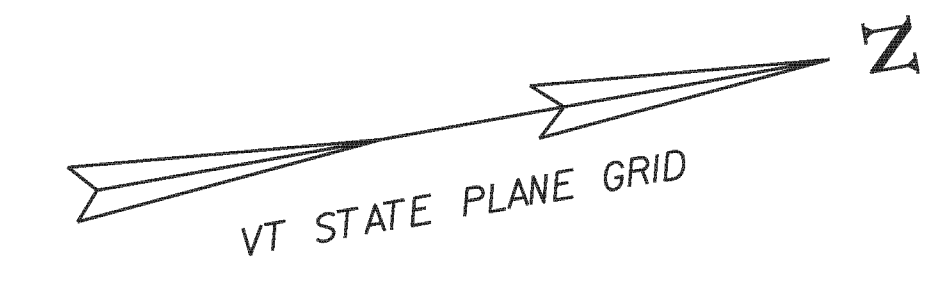


LEGEND	
N/C	- NEW/CONSTRUCTION ONLY
B/O	- BLACK/ORANGE
B/W	- BLACK/WHITE
	- TYPE III BARRICADE
	- TYPE III BARRICADE (MOD.)
	- TEMPORARY TRAFFIC BARRIER

**TRAFFIC LAYOUT SHEET**

SCALE 1" = 20'-0"


PROJECT NAME: FAIRFIELD  
 PROJECT NUMBER: BRF 028(25)

FILE NAME: sl2j156traff.dgn	PLOT DATE: 10-SEP-2014
PROJECT LEADER: R. YOUNG	DRAWN BY: K. FRIEDLAND
DESIGNED BY: R. KLINFELTER	CHECKED BY: J. SALVATORI
TRAFFIC LAYOUT SHEET	SHEET 18 OF 69

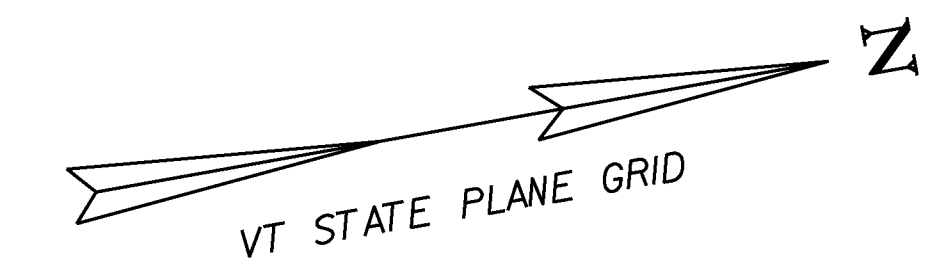

DELINEATOR W/STEEL POST  
 STA 16+20 LT (GREEN)  
 STA 16+20 RT (BLUE)  
 STA 17+45 LT (GREEN)  
 STA 17+45 RT (BLUE)

ANCHOR FOR STEEL BEAM RAIL  
 STA 16+33 LT  
 STA 16+33 RT  
 STA 17+35 LT  
 STA 17+35 RT

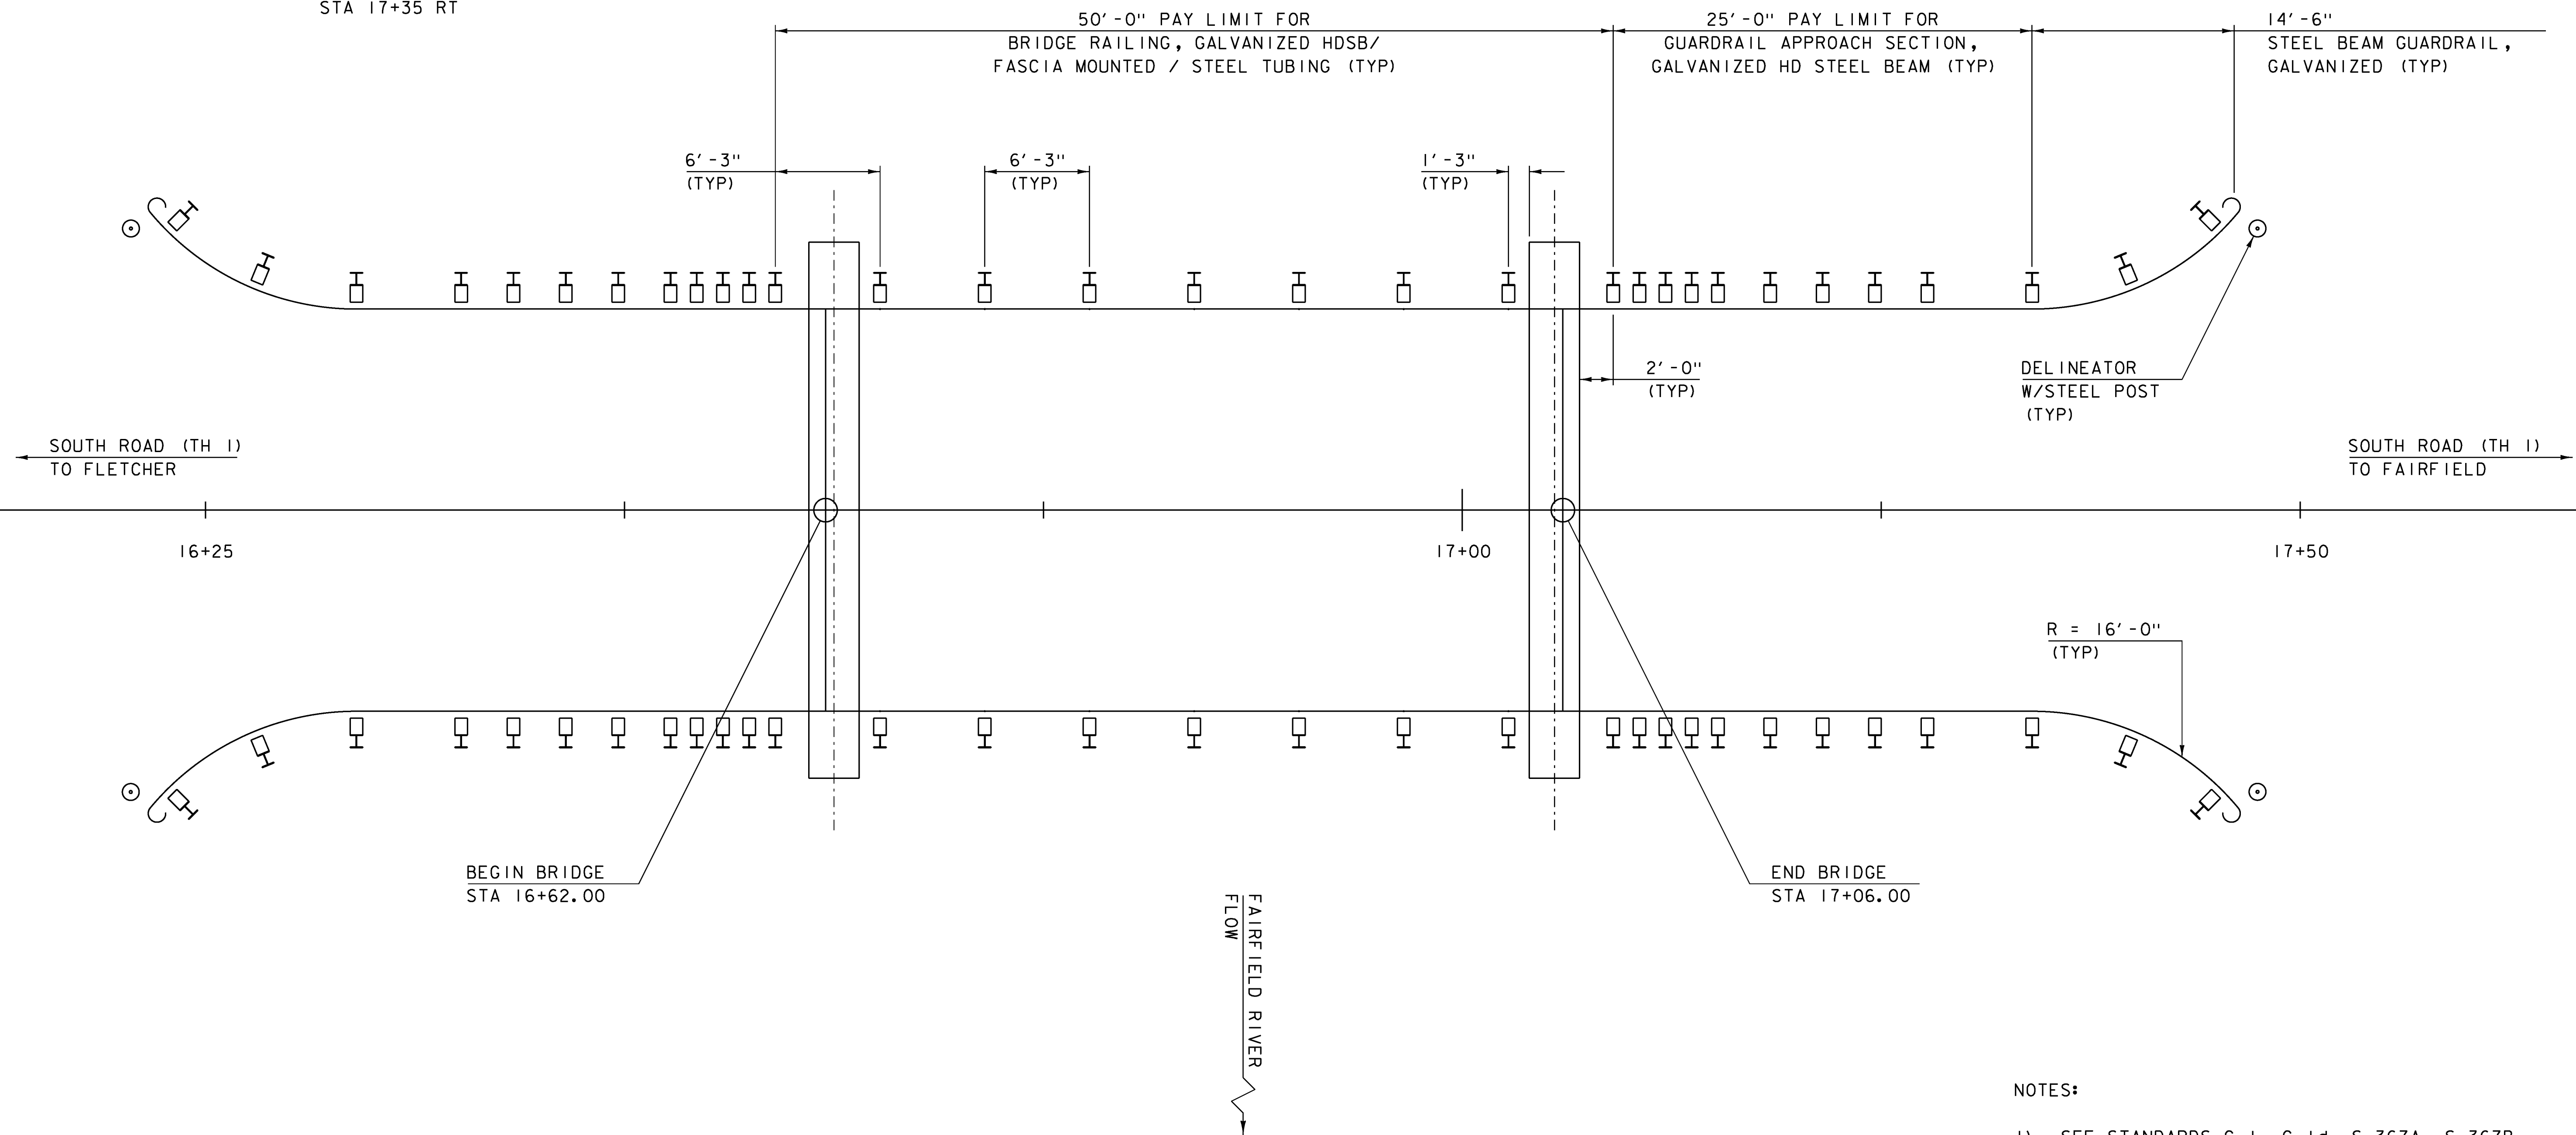

NOTES:

- 1) SEE STANDARDS G-1, G-1d, S-367A, S-367B, T-40 AND T-45 FOR FURTHER DETAILS.

RAIL LAYOUT SHEET

SCALE 1" = 5'-0"  
 5 0 5

PROJECT NAME: FAIRFIELD	PLOT DATE: 18-AUG-2014
PROJECT NUMBER: BRF 028(25)	DRAWN BY: K. FRIEDLAND
FILE NAME: sl2j156r.dgn	CHECKED BY: J. SALVATORI
PROJECT LEADER: R. YOUNG	SHEET 19 OF 69
DESIGNED BY: R. KLINEFELTER	
RAIL LAYOUT SHEET	

**SOIL CLASSIFICATION**

AASHTO

A1	Gravel and Sand
A3	Fine Sand
A2	Silty or Clayey Gravel and Sand
A4	Silty Soil - Low Compressibility
A5	Silty Soil - Highly Compressible
A6	Clayey Soil - Low Compressibility
A7	Clayey Soil - Highly Compressible

**ROCK QUALITY DESIGNATION**

R.Q.D. (%)	ROCK DESCRIPTION
<25	Very Poor
25 to 50	Poor
51 to 75	Fair
76 to 90	Good
>90	Excellent

**SHEAR STRENGTH**

UNDRAINED SHEAR STRENGTH IN P.S.F.	CONSISTENCY
<250	Very Soft
250-500	Soft
500-1000	Med. Stiff
1000-2000	Stiff
2000-4000	Very Stiff
>4000	Hard

**CORRELATION GUIDE OF "N" TO DENSITY/CONSISTENCY**

DENSITY (GRANULAR SOILS)		CONSISTENCY (COHESIVE SOILS)	
N	DESCRIPTIVE TERM	N	DESCRIPTIVE TERM
<5	Very Loose	<2	Very Soft
5-10	Loose	2-4	Soft
11-24	Med. Dense	5-8	Med. Stiff
25-50	Dense	9-15	Stiff
>50	Very Dense	16-30	Very Stiff
		31-60	Hard
		>60	Very Hard

**COMMONLY USED SYMBOLS**


- ▼ Water Elevation
- ⊕ Standard Penetration Boring
- ⊕ Auger Boring
- ⊙ Rod Sounding
- S Sample
- N Standard Penetration Test
- Blow Count Per Foot For:
- 2" O.D. Sampler
- 1 3/8" I.D. Sampler
- Hammer Weight Of 140 Lbs.
- Hammer Fall Of 30"
- VS Field Vane Shear Test
- US Undisturbed Soil Sample
- B Blast
- DC Diamond Core
- MD Mud Drill
- WA Wash Ahead
- HSA Hollow Stem Auger
- AX Core Size 1 1/8"
- BX Core Size 1 3/8"
- NX Core Size 2 1/8"
- M Double Tube Core Barrel Used
- LL Liquid Limit
- PL Plastic Limit
- PI Plasticity Index
- NP Non Plastic
- w Moisture Content (Dry Wgt. Basis)
- D Dry
- M Moist
- MTW Moist To Wet
- W Wet
- Sat Saturated
- Bo Boulder
- Gr Gravel
- Sa Sand
- Sl Silt
- Cl Clay
- HP Hardpan
- Le Ledge
- NLTD No Ledge To Depth
- CNPF Can Not Penetrate Further
- TLOB Top of Ledge Or Boulder
- NR No Recovery
- Rec. Recovery
- %Rec. Percent Recovery
- ROD Rock Quality Designation
- CBR California Bearing Ratio
- < Less Than
- > Greater Than
- R Refusal (N > 100)
- VTSPG NAD83 - See Note 7

**COLOR**

blk	Black	pnk	Pink
bl	Blue	pu	Purple
brn	Brown	rd	Red
dk	Dark	tn	Tan
gry	Gray	wh	White
gn	Green	yel	Yellow
lt	Light	mltc	Multicolored
or	Orange		

**DEFINITIONS (AASHTO)**

- BEDROCK (LEDGE) - Rock in its native location of indefinite thickness.
- BOULDER - A rock fragment with an average dimension > 12 inches.
- COBBLE - Rock fragments with an average dimension between 3 and 12 inches.
- GRAVEL - Rounded particles of rock < 3" and > 0.0787" (#10 sieve).
- SAND - Particles of rock < 0.0787" (#10 sieve) and > 0.0029" (#200 sieve).
- SILT - Soil < 0.0029" (#200 sieve), non or slightly plastic and exhibits no strength when air-dried.
- CLAY - Fine grained soil, exhibits plasticity when moist and considerable strength when air-dried.
- VARVED - Alternate layers of silt and clay.
- HARDPAN - Extremely dense soil, cemented layer, not softened when wet.
- MUCK - Soft organic soil (containing > 10% organic material).
- MOISTURE CONTENT - Weight of water divided by dry weight of soil.
- FLOWING SAND - Granular soil so saturated (loose) that it flows into drill casing during extraction of wash rod.
- STRIKE - Angle from magnetic north to line of intersection of bed with a horizontal plane.
- DIP - Inclination of bed with a horizontal plane.

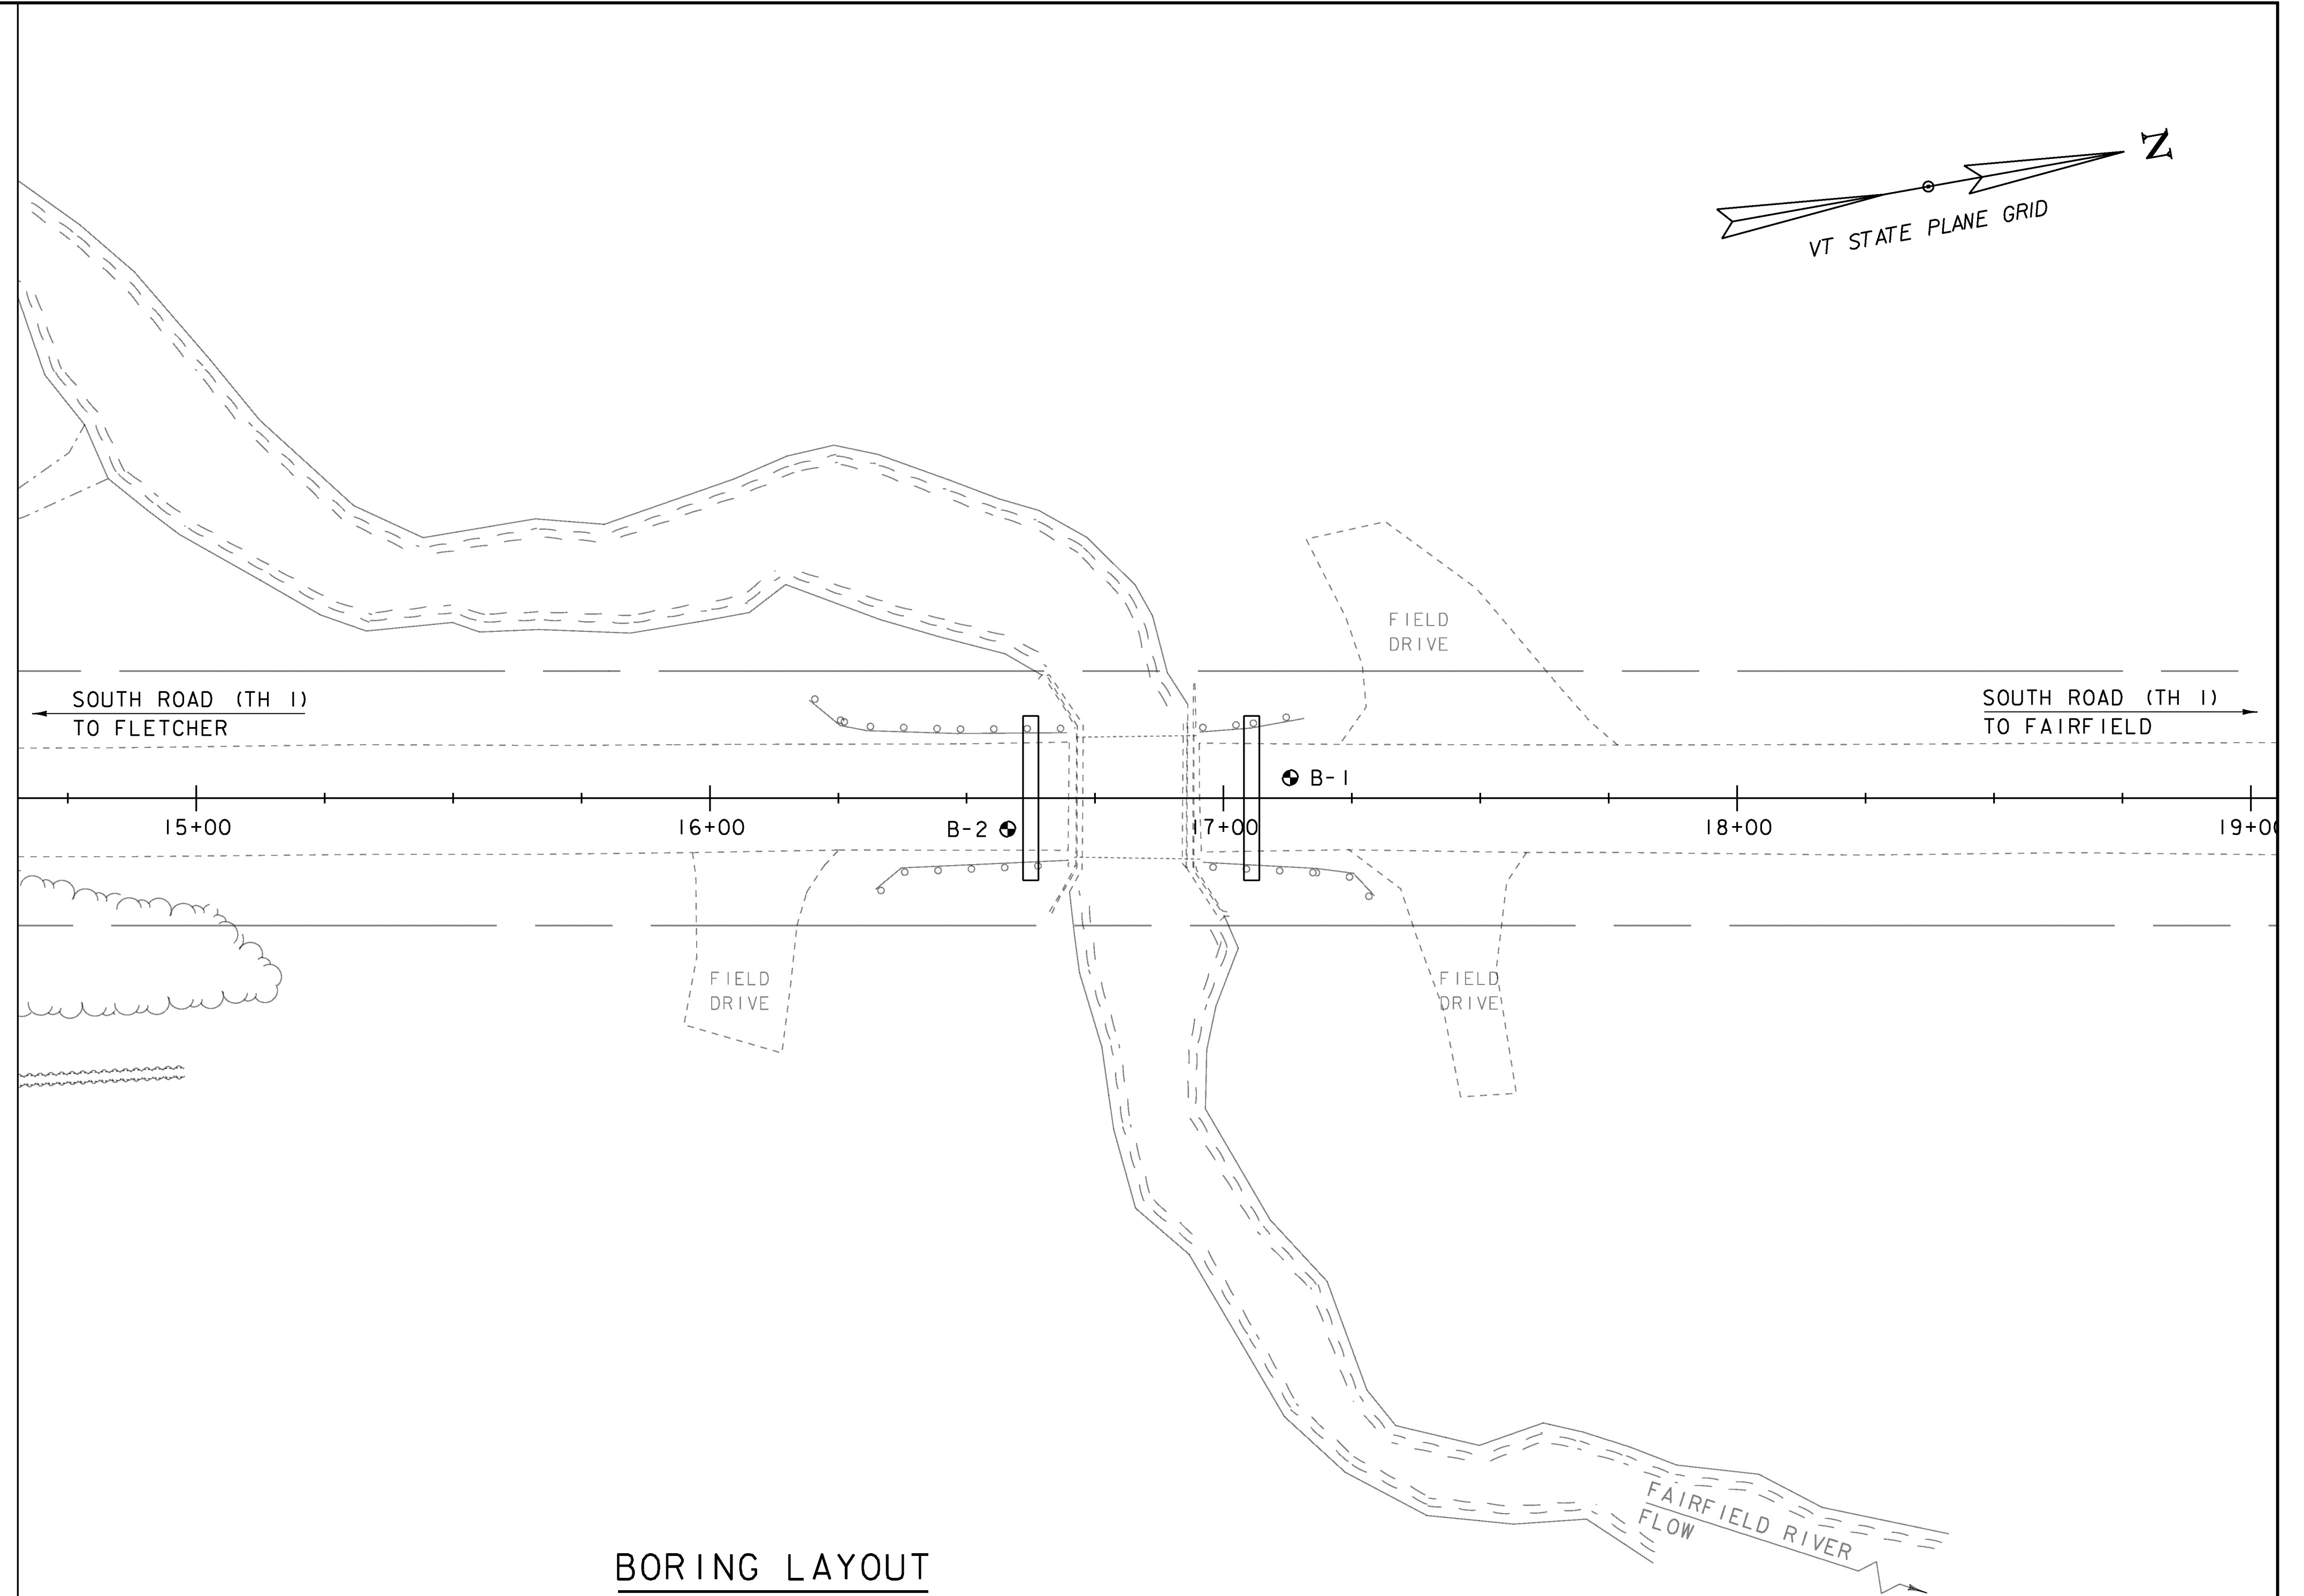

**BORING LAYOUT**

SCALE 1" = 20' - 0"  
 20 0 20

**GENERAL NOTES**

1. The subsurface explorations shown herein were made between 02/11/13 and 02/14/13 by New Hampshire Boring, Inc.
2. Soil and rock classifications, properties and descriptions are based on engineering interpretation from available subsurface information by the Agency and may not necessarily reflect actual variations in subsurface conditions that may be encountered between individual boring or sample locations.
3. Observed water levels and/or conditions indicated are as recorded at the time of exploration and may vary according to the prevailing rainfall, methods of exploration and other factors.
4. Engineering judgment was exercised in preparing the subsurface information presented herein. Analysis and interpretation of subsurface data was performed and interpreted for Agency design and estimating purposes. Presentation of the information in the Contract is intended to provide the Contractor access to the same data available to the Agency. The subsurface information is presented in good faith and is not intended as a substitute for personal investigation, independent interpretation, independent analysis or judgment by the Contractor.
5. Pictorial structure details shown on the boring plan layout or soils profile are for illustrative purposes only and may not accurately portray final contract details.
6. Terminology used on boring logs to describe the hardness, degree of weathering, and spacing of fractures, joints and other discontinuities in the bedrock is defined in the AASHTO Manual on Subsurface Investigations, 1988.
7. Northing and Easting coordinates are shown in Vermont State Plane Grid North American Datum 1983 in meters and survey feet.

**BORING CHART**

HOLE NO.	SURV. STATION	OFFSET	GROUND ELEV.	ELEV. TLOB
B1	17+13	4.0 LT	600.0	562.0
B2	16+58	6.0 RT	599.0	565.0

PROJECT NAME: FAIRFIELD  
 PROJECT NUMBER: BRF 028(25)

FILE NAME: sl2j156boring.dgn  
 PROJECT LEADER: R. YOUNG  
 DESIGNED BY: R. KLINFELTER  
 BORING LAYOUT

PLOT DATE: 18-AUG-2014  
 DRAWN BY: K. FRIEDLAND  
 CHECKED BY: J. SALVATORI  
 SHEET 20 OF 69

Boring Crew: P. Schofield, K. Owens	Casing: WB	Sampler: SS	Groundwater Observations		
Date Started: 2/13/13 Date Finished: 2/14/13	Type: I.D.: 4 in 1.38 in	Hammer Wt: 300 lb. 140 lb.	Date: 02/01/13	Depth (ft): 8.2	Notes:
VTSPG NAD83: N 827129.99 ft E 1521444.47 ft	Hammer Fall: 30 in. 30 in.	Hammer/Rod Type: Manual/NW			
Station: 16+58.0 Offset: 6.0R	Rig: TRUCK D50	CE = 1.0			
Ground Elevation: 599.0 ft					

Depth (ft)	Strata (1)	CLASSIFICATION OF MATERIALS (Description)	Run (Dip deg.)	Cone Rec. % (RQD %)	Drill Rate minutes/ft	Blows/6" (N Value)	Moisture Content %	Gravel %	Sand %	Fines %	LL %	PI %
0-0.5		Asphalt, 0.0 ft - 0.5 ft, Advanced rollerbit through asphalt.										
0.5-4.0		0.5 ft - 4.0 ft, and frost layer.										
5-7	A-1-a	f.c. SAND, little silt, little f. gravel, medium compact, brown, Moist, Rec. = 0.7 ft, (FILL)			15-10-8-7	10.4	21.4	63.9	14.7			
7-10	A-1-a	f.c. SAND, little f. gravel, trace silt, trace organics, compact, brown, Moist, Rec. = 0.9 ft, (FILL) Turns gray at 6.8'			7-10-22-16							
10-11	A-1-a	Rec. = 0.4 ft, (FILL) Becomes medium compact			9-9-7-3							
11-17	A-6	Silty CLAY, trace f.c. gravel, very stiff, gray, Wet			3-2-3-3	41.4	0.8	99.2	37	15		
17-18	A-6	Rec. = 1.7 ft, Becomes medium stiff			(5)							
18-20	A-4	Clayey SILT, little f. sand, very stiff, gray, Wet, Rec. = 0.6 ft			14-15-5-3							
20-22	A-4	Rec. = 0.6 ft, Becomes stiff			(9)							
22-25	A-4	Clayey SILT, Some f. Sand, little f.c. gravel, very stiff, gray, Moist, Rec. = 0.5 ft			5-7-10-5							
25-30	A-4	Rec. = 0.0 ft, No recovery, coarse gravel blocked shoe of spoon.			17-10-7-5							
30-34	A-4	Rec. = 0.0 ft, Spoon bouncing at 34 feet. Casing refusal at 34 feet.			50/0"							
34-35	R-1	34.0 ft - 35.0 ft, Rollerbit to 35 feet to start core.		89 (56)	13							
35-39.5	R-1	35.0 ft - 39.5 ft, Gray, Phyllite, Very close fracture spacing. Moderately soft to moderately hard, Moderately weathered, NXDC, Fair RQD. Highly fractured/severely weathered zone at bottom 1' of recovered sample.										
39.5-44.5	R-2	39.5 ft - 44.5 ft, Gray, Phyllite, Medium close fracture spacing. Moderately hard, Slightly weathered, NXDC, Good RQD		85 (85)	8							
44.5-45		Hole stopped @ 44.5 ft										

Notes:

1. Stratification lines represent approximate boundary between material types. Transition may be gradual.
2. N Values have not been corrected for hammer energy. CE is the hammer energy correction factor.
3. Water level readings have been made at times and under conditions stated. Fluctuations of groundwater may occur due to other factors than those present at the time measurements were made.

Boring Crew: P. Schofield, K. Owens	Casing: WB	Sampler: SS	Groundwater Observations		
Date Started: 2/11/13 Date Finished: 2/13/13	Type: I.D.: 4 in 1.38 in	Hammer Wt: 300 lb. 140 lb.	Date: 02/11/13	Depth (ft): 11.0	Notes:
VTSPG NAD83: N 827128.08 ft E 1521459.04 ft	Hammer Fall: 30 in. 30 in.	Hammer/Rod Type: Manual/NW			
Station: 17+13.0 Offset: 4.0L	Rig: TRUCK D50	CE = 1.0			
Ground Elevation: 600.0 ft					

Depth (ft)	Strata (1)	CLASSIFICATION OF MATERIALS (Description)	Run (Dip deg.)	Cone Rec. % (RQD %)	Drill Rate minutes/ft	Blows/6" (N Value)	Moisture Content %	Gravel %	Sand %	Fines %	LL %	PI %
0-0.5		Asphalt, 0.0 ft - 0.5 ft, Advanced rollerbit through asphalt.										
0.5-5	A-2-4	f.c. SAND, Some Silt, trace f. gravel, very compact, brown, Moist, Rec. = 0.1 ft, (FILL) Sample advanced within frost zone.				70/3" (6)						
5-12	A-2-4	Similar Soil, Rec. = 0.6 ft, (FILL) Becomes brown, moist to wet.				70-50/3" (R)						
12-13	A-4	f.c. SAND, AND SILT, little f. gravel, medium compact, brown, Moist, Rec. = 0.5 ft, (FILL)				12-8-6-10 (14)						
13-16	A-1-b	f.c. GRAVEL, little silt, little f.c. sand, compact, brn-orange, Moist, Rec. = 0.7 ft, (FILL)				13-16-19-14 (35)						
16-18	A-4	Rec. = 0.0 ft, No recovery				2-2-2-2 (4)						
18-20	A-4	Clayey SILT, little f.c. sand, trace f. gravel, medium stiff, gray, Wet, Rec. = 2.0 ft				3-2-3-3 (5)	18.4	0.7	15.2	84.1	19	3
20-22	A-4	Similar Soil, Rec. = 2.0 ft				2-3-4-5 (7)						
22-25	A-2-4	f.c. GRAVEL, Some clayey Silt, Some f.c. Sand, medium compact, gray, Wet, Rec. = 1.0 ft				8-11-16-8 (27)						
25-27	A-2-4	f.c. SAND, little silt, little f.c. gravel, very compact, gray, Moist, Rec. = 0.2 ft, (TILL)				58/6" (R)						
27-30	A-4	Rec. = 0.0 ft, No recovery, spoon bouncing.				85/2" (R)						
30-38	A-4	Clayey SILT, trace f.c. sand, trace f. gravel, hard, gray, Moist, Rec. = 0.2 ft, (TILL)				100/6" (R)						
38-40	A-4	Similar Soil, Rec. = 0.3 ft, (TILL)										
40-42	A-4	Rec. = 0.0 ft, No recovery, spoon bouncing.										
42-44	R-1	38.0 ft - 42.0 ft, Dark gray, Phyllite, Medium close fracture spacing. Moderately soft to moderately hard, Moderately weathered, NXDC, Excellent RQD		100 (95)	15	50/0" (R)						
44-47	R-2	42.0 ft - 44.0 ft, Dark gray, Phyllite, Very close fracture spacing. Moderately soft to moderately hard, Moderately to severely weathered, NXDC, Very poor RQD										
47-48	R-3	44.0 ft - 47.0 ft, Gray, Phyllite, Close fracture spacing. Moderately soft to moderately hard, Slightly to moderately weathered, NXDC, Very poor RQD										
48-49		Hole stopped @ 47.0 ft										

Notes:

1. Stratification lines represent approximate boundary between material types. Transition may be gradual.
2. N Values have not been corrected for hammer energy. CE is the hammer energy correction factor.
3. Water level readings have been made at times and under conditions stated. Fluctuations of groundwater may occur due to other factors than those present at the time measurements were made.

ABUT. 1 BTM.  
EL 597.23


EST. PILE TIP  
EL 565.00

BORING LOG 25045_BRF0281_LOGS.GPJ VERMONT AOT.GDT 5/6/13


ABUT. 2 BTM.  
EL 597.15

EST. PILE TIP  
EL 562.00

BORING LOG 25045_BRF0281_LOGS.GPJ VERMONT AOT.GDT 5/6/13

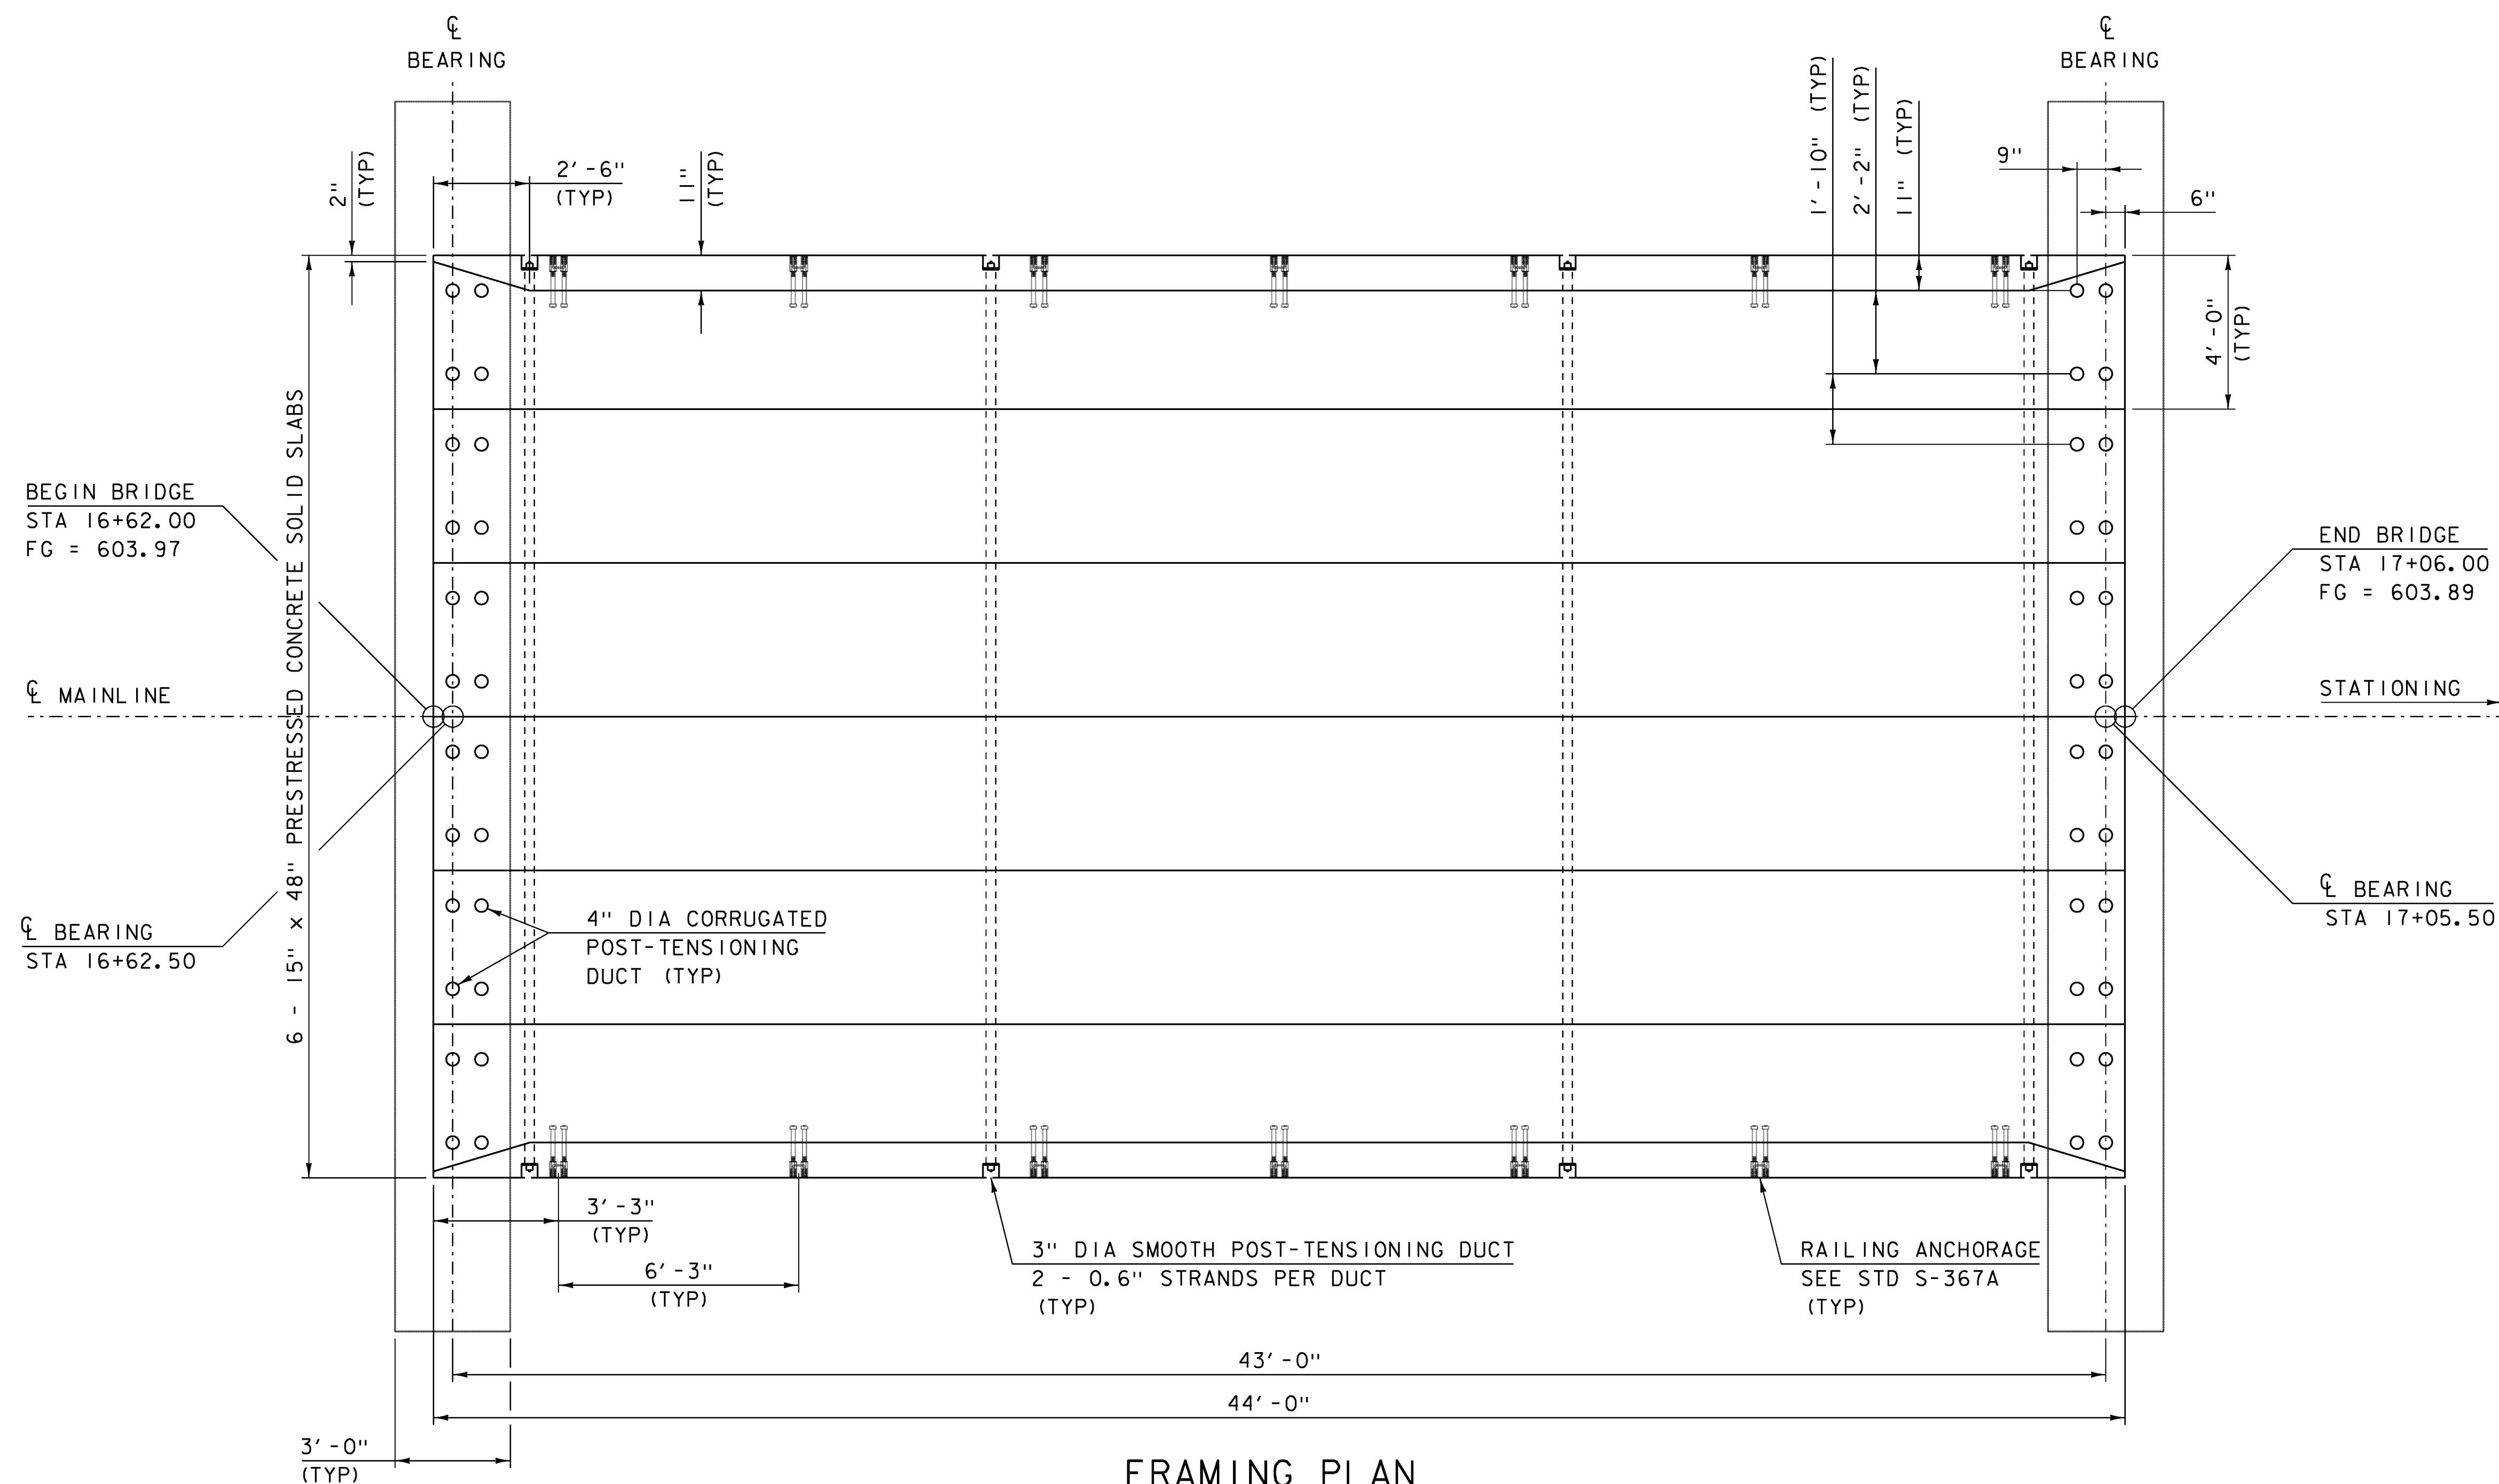


**FRAMING PLAN**  
SCALE 3/8" = 1'-0"

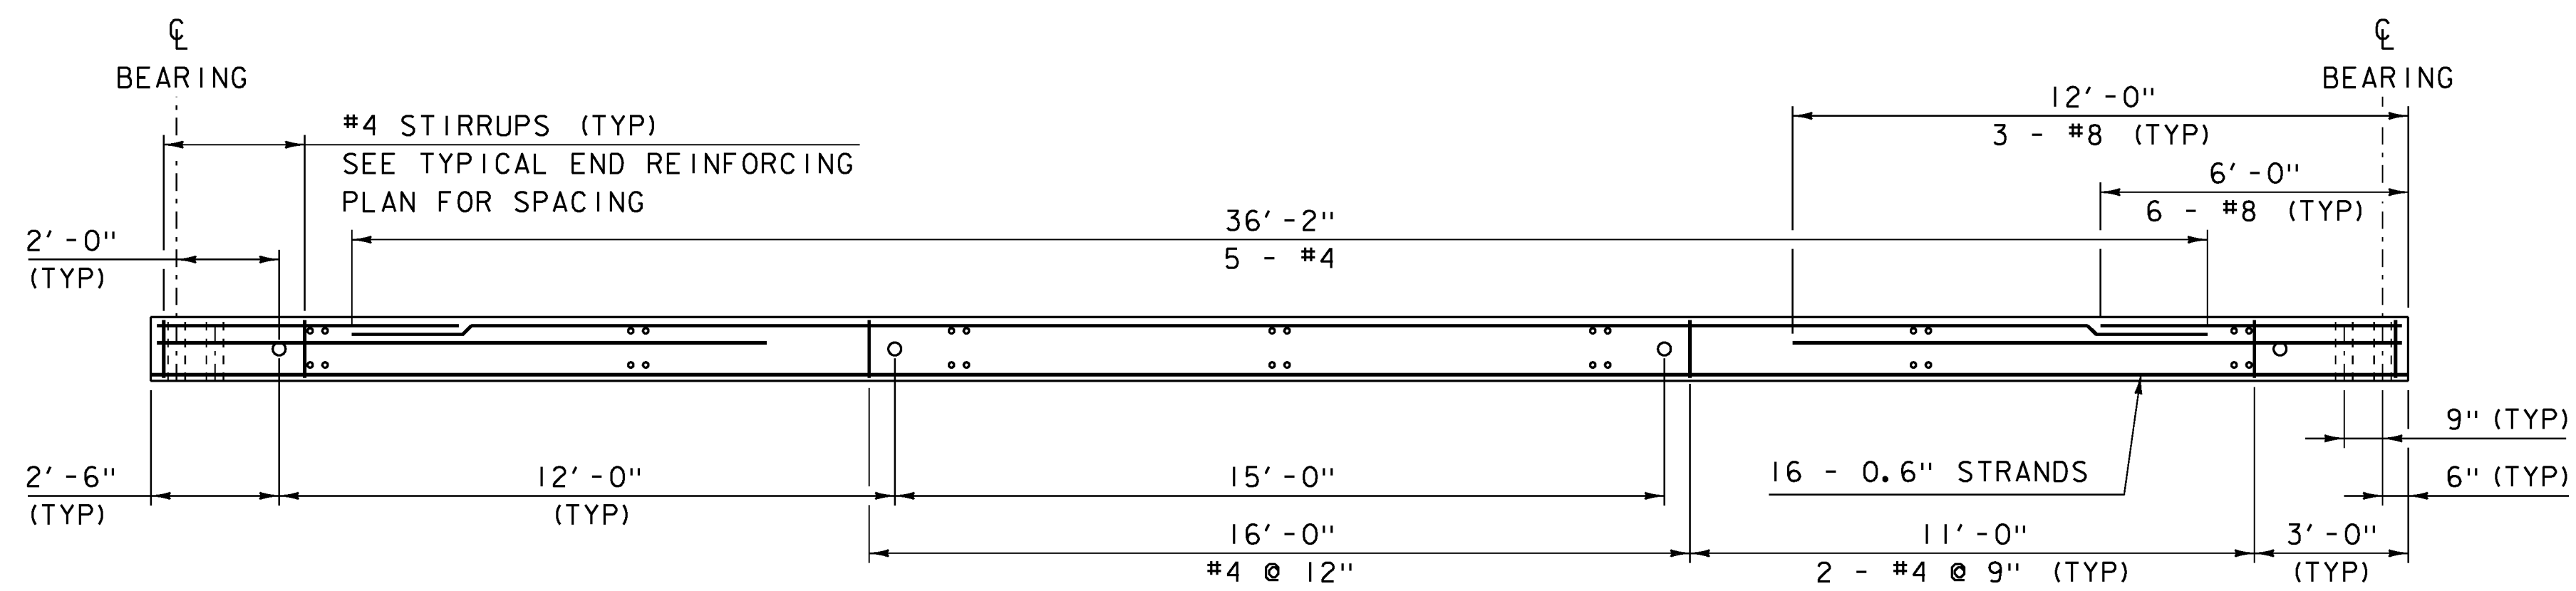

**SLAB ELEVATION**  
SCALE 3/8" = 1'-0"


NOTES:  
1) ALL REINFORCING SHALL BE LEVEL 2 OR HIGHER.

PROJECT NAME: FAIRFIELD	PLOT DATE: 18-AUG-2014
PROJECT NUMBER: BRF 028(25)	DRAWN BY: K. FRIEDLAND
FILE NAME: sl2j156sup.dgn	CHECKED BY: R. KLINEFELTER
PROJECT LEADER: R. YOUNG	SHEET 22 OF 69
DESIGNED BY: T. FILLBACH	
FRAMING PLAN	

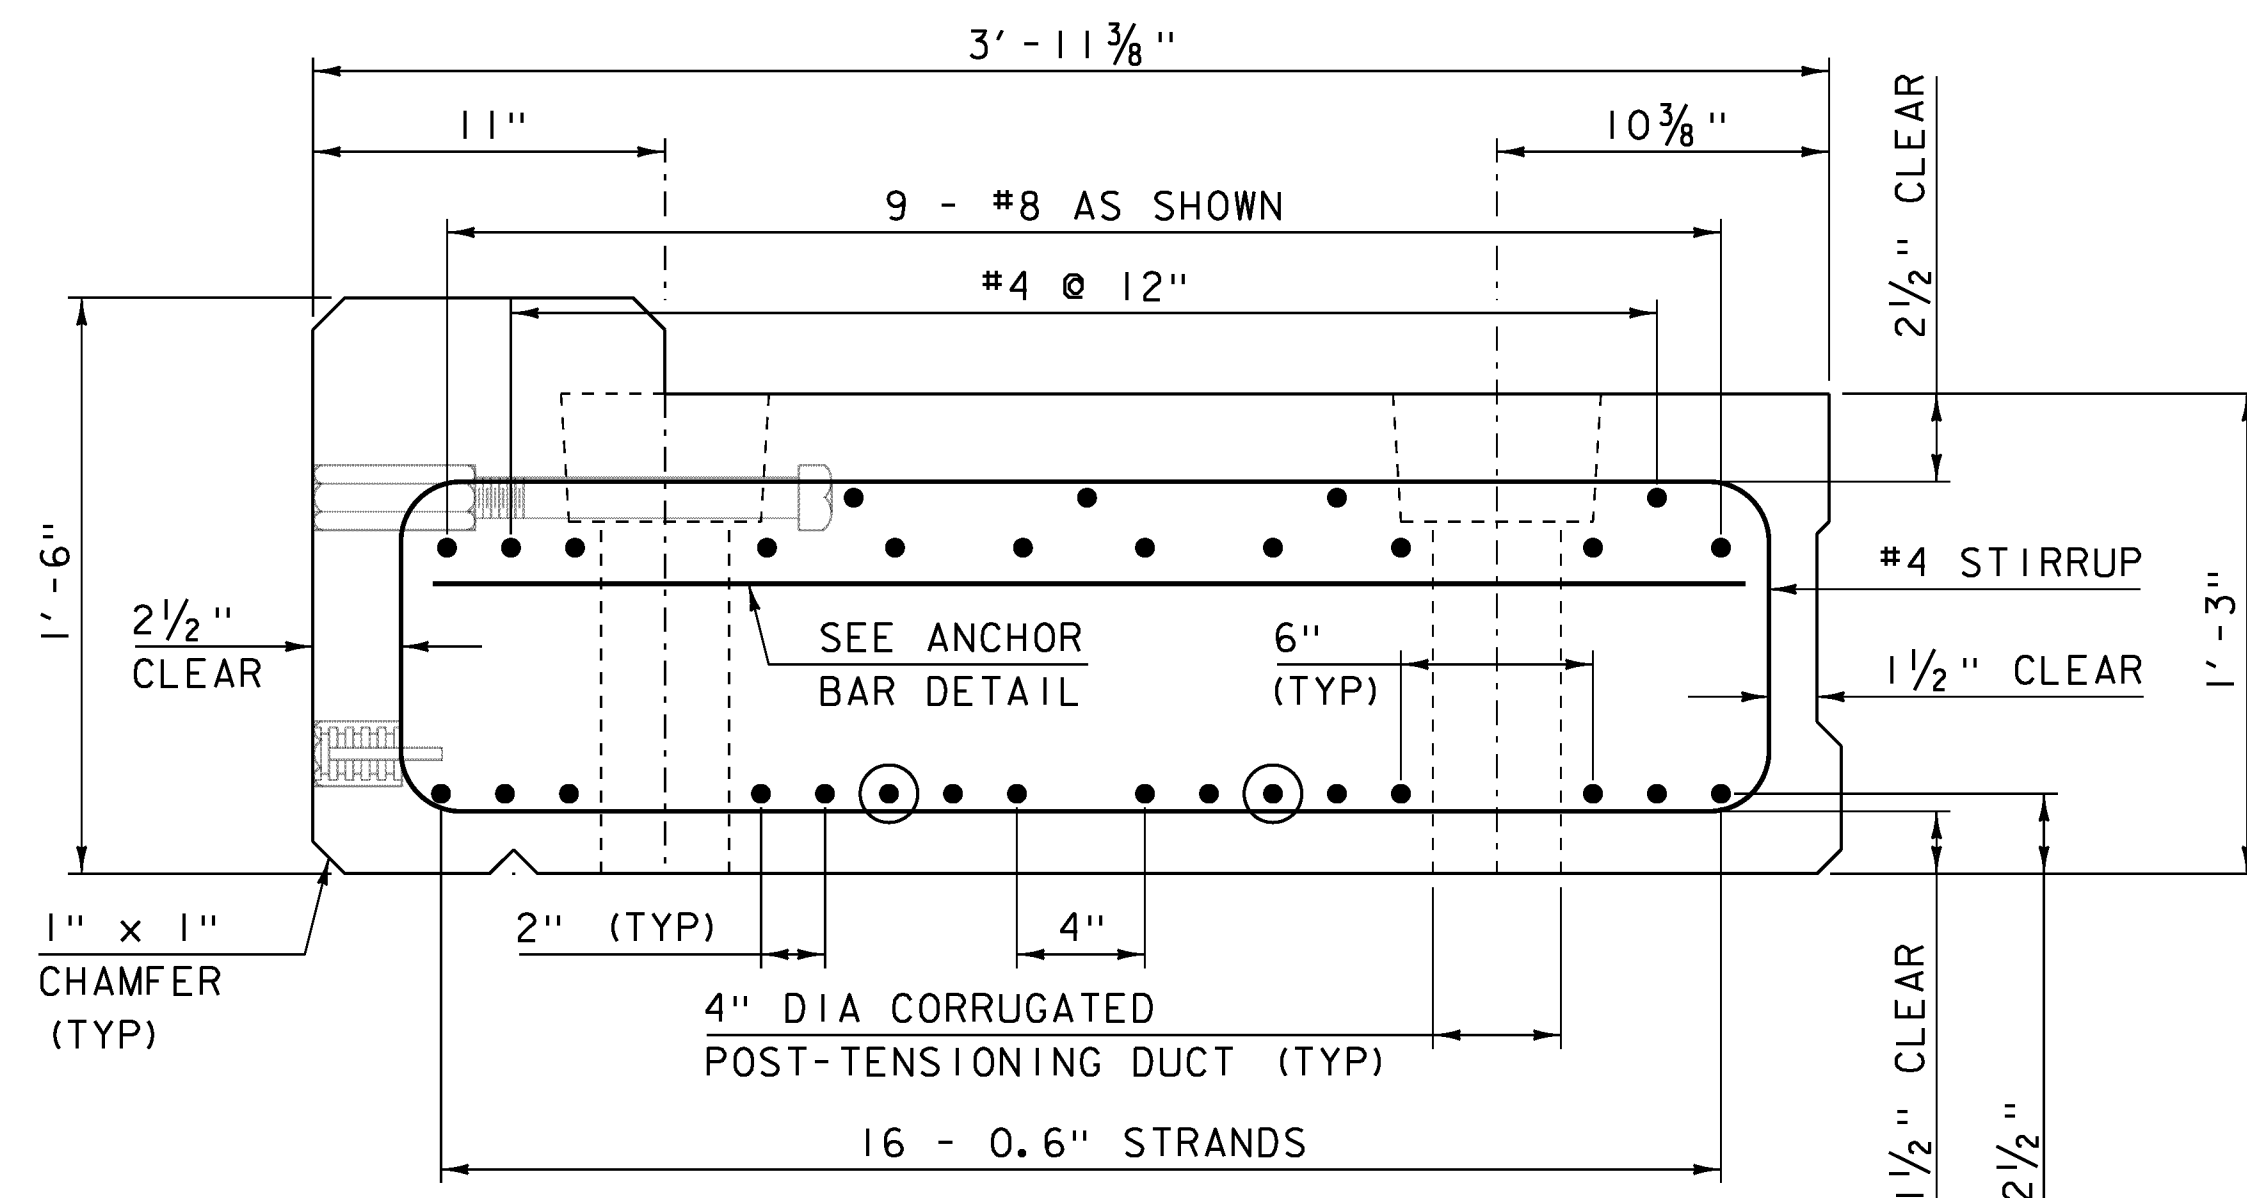

**TYPICAL EXTERIOR SECTION**


SCALE 2" = 1'-0"

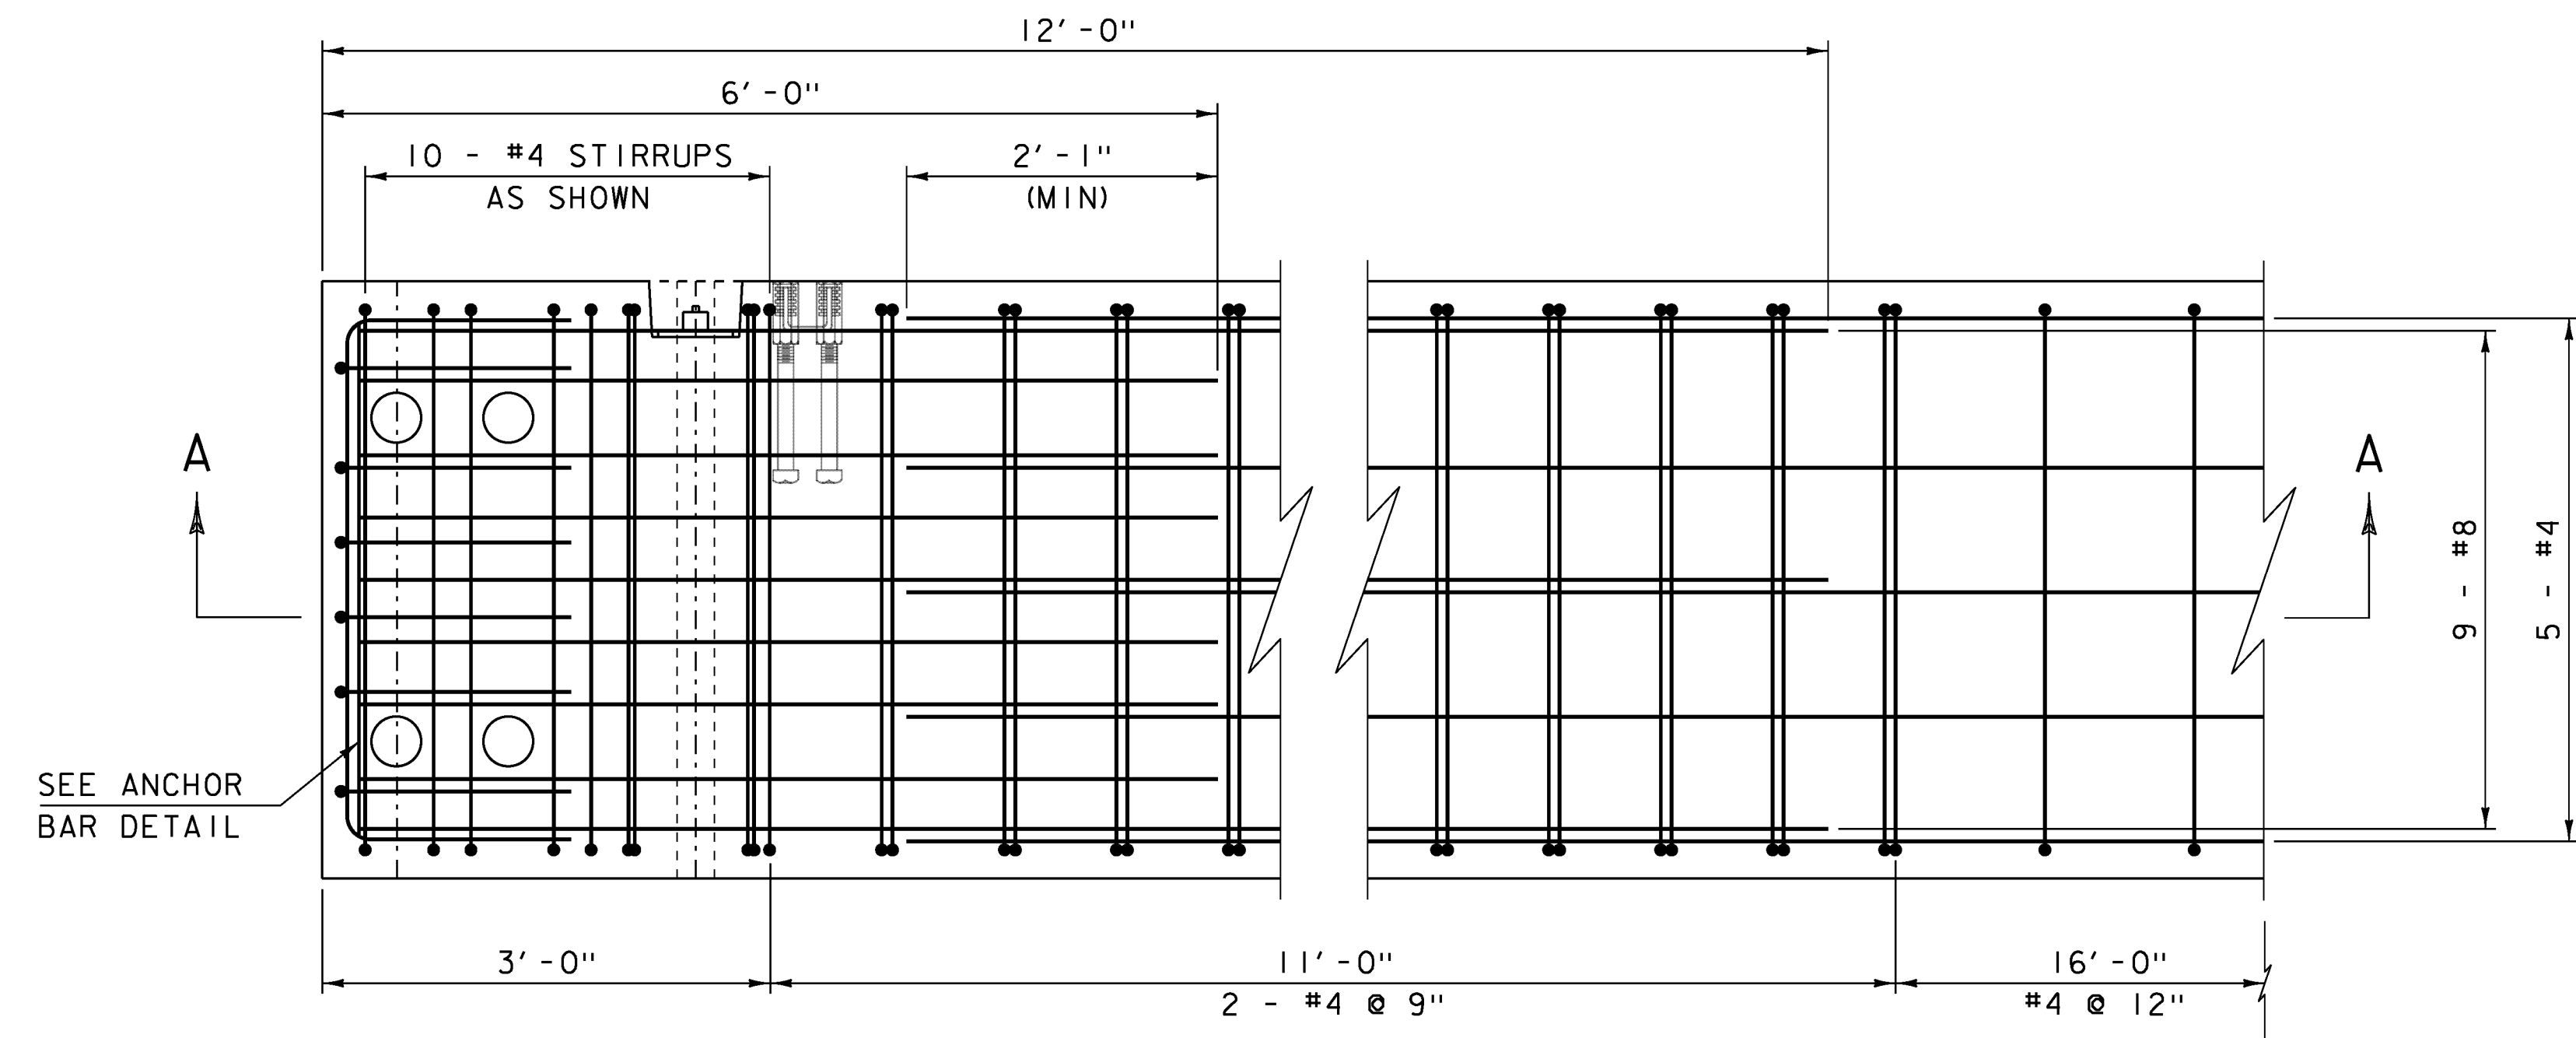

**TYPICAL END REINFORCING PLAN**


SCALE 1" = 1'-0"

○ - 2'-0" DEBOND EACH END

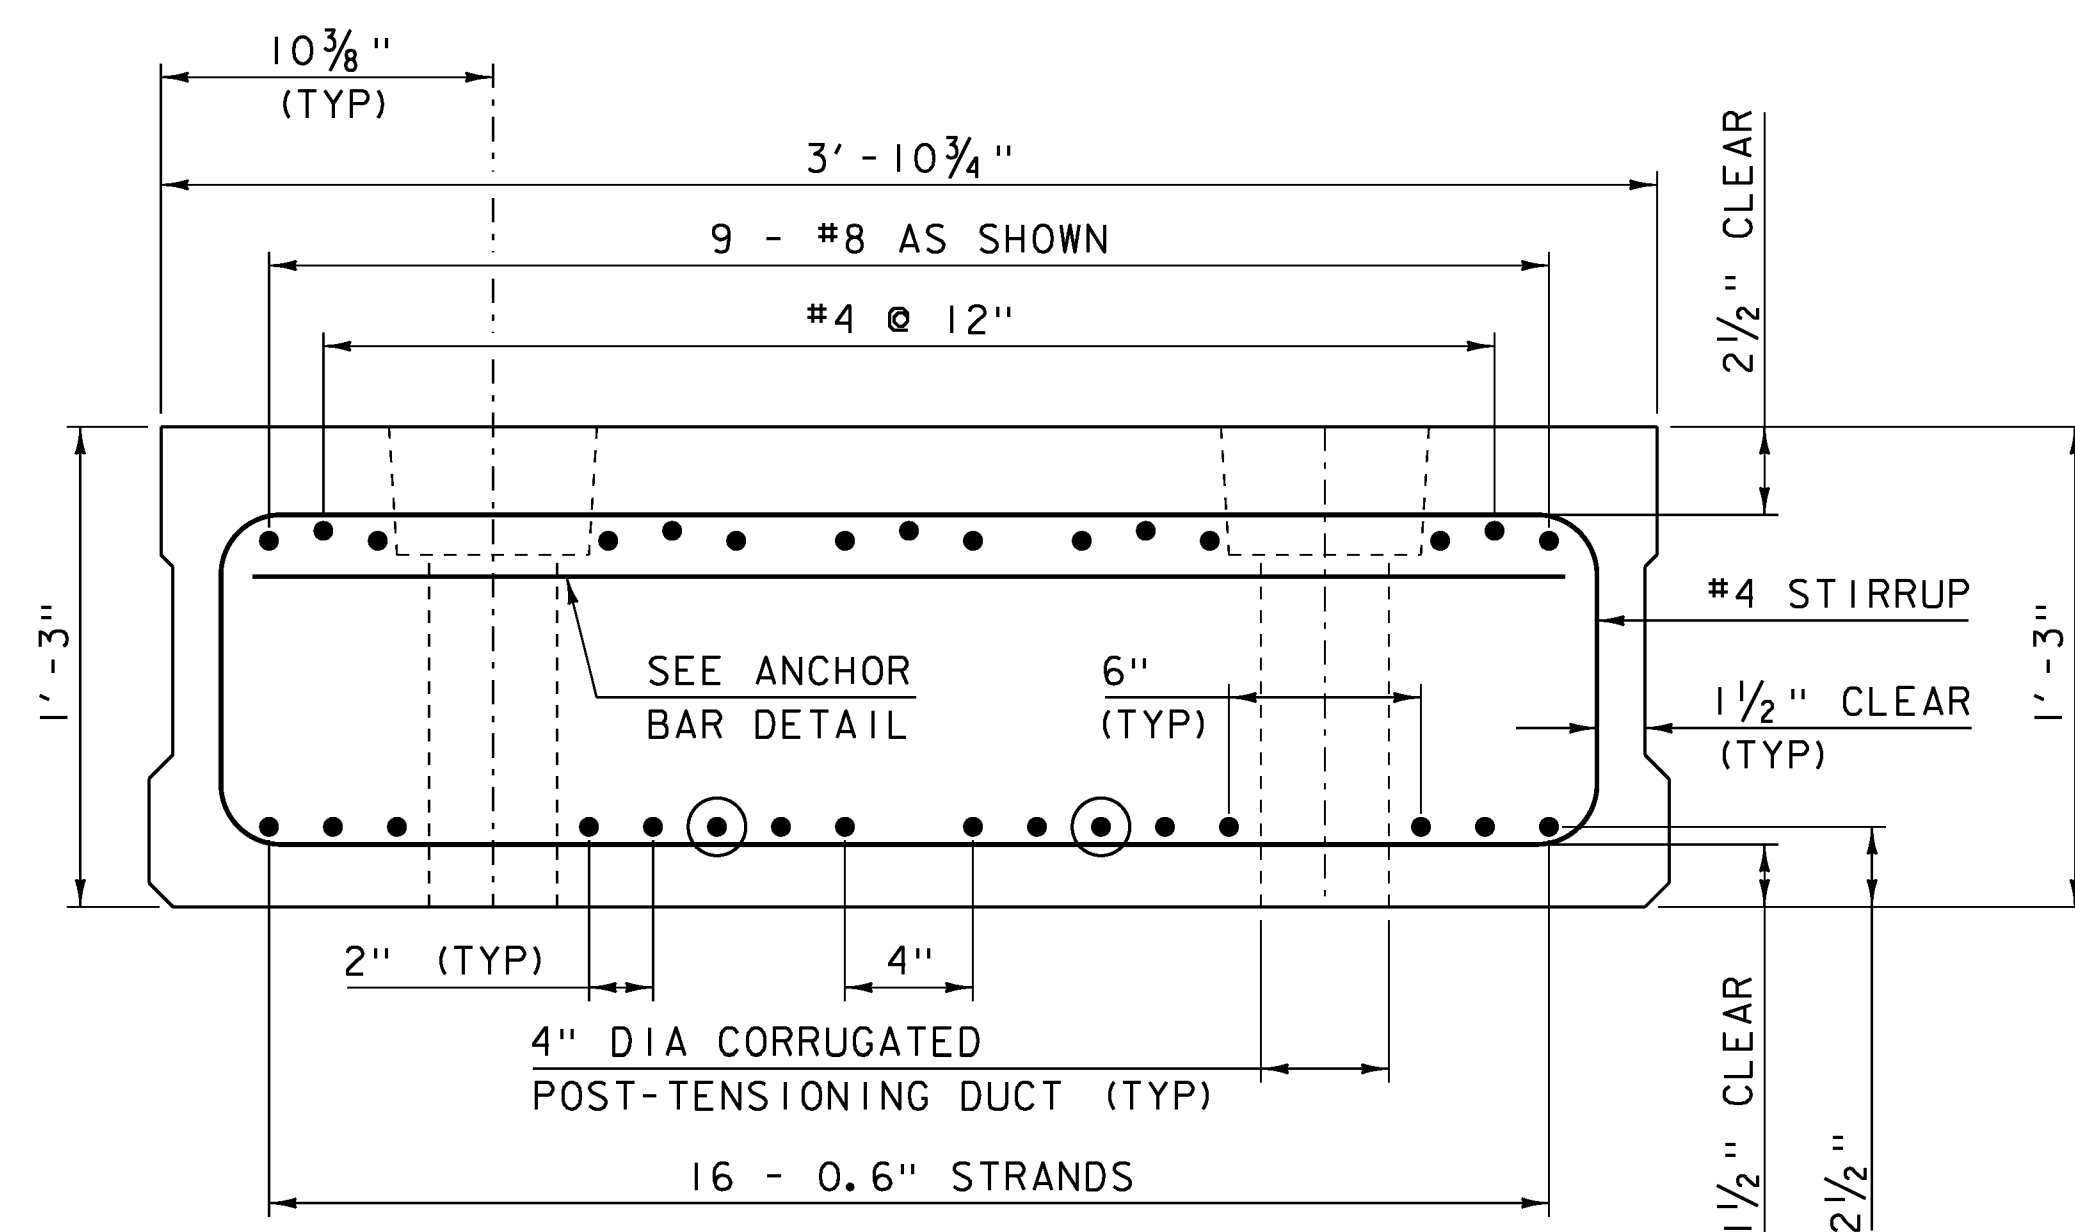


**TYPICAL INTERIOR SECTION**

SCALE 2" = 1'-0"

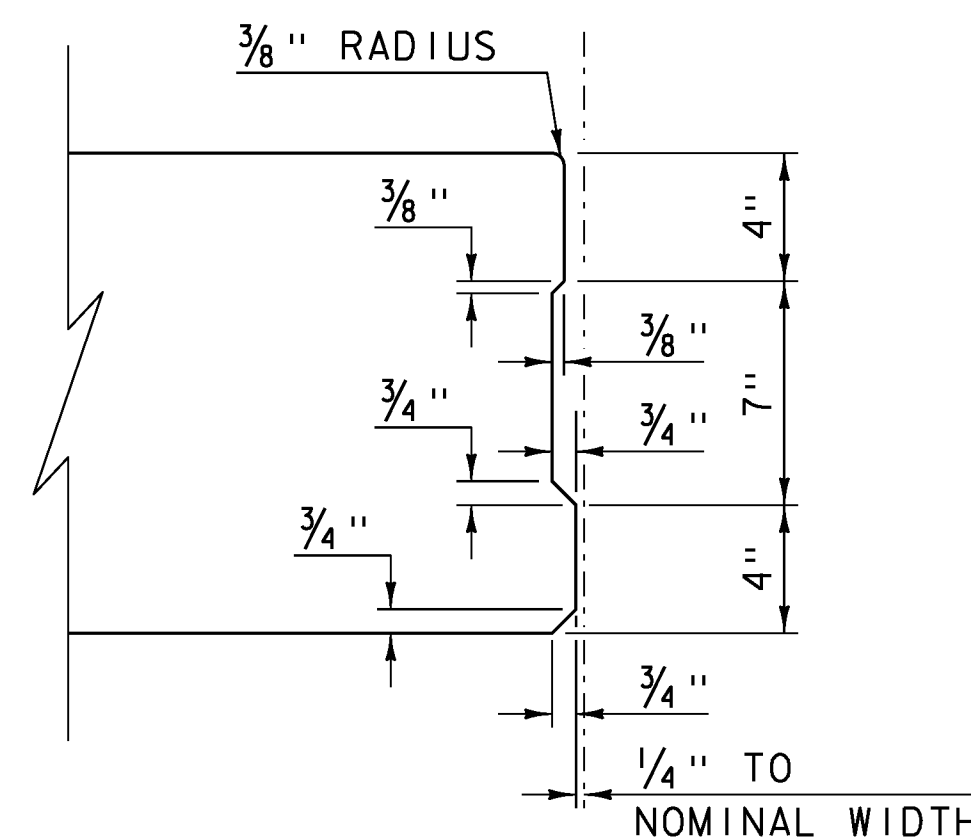


**SHEAR KEY DETAIL**

SCALE 2" = 1'-0"

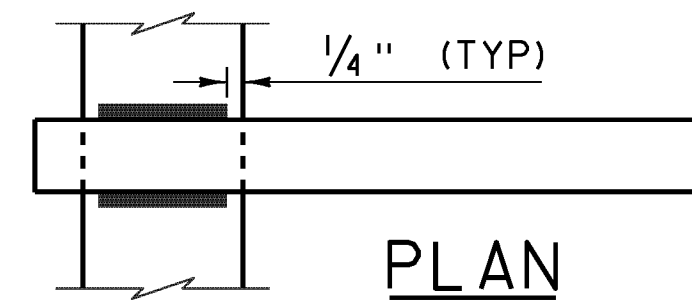

**PLAN**

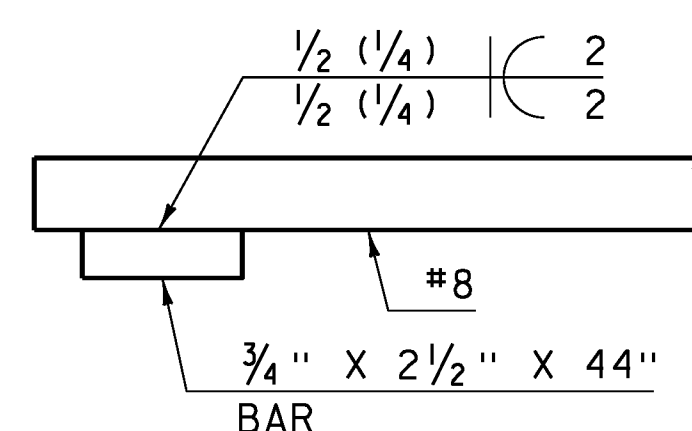


**ELEVATION ANCHOR BAR DETAILS**

OPTION "A"

NOT TO SCALE


**NOTES:**

1) EXTERIOR SLAB SHOWN, INTERIOR SLAB SIMILAR.

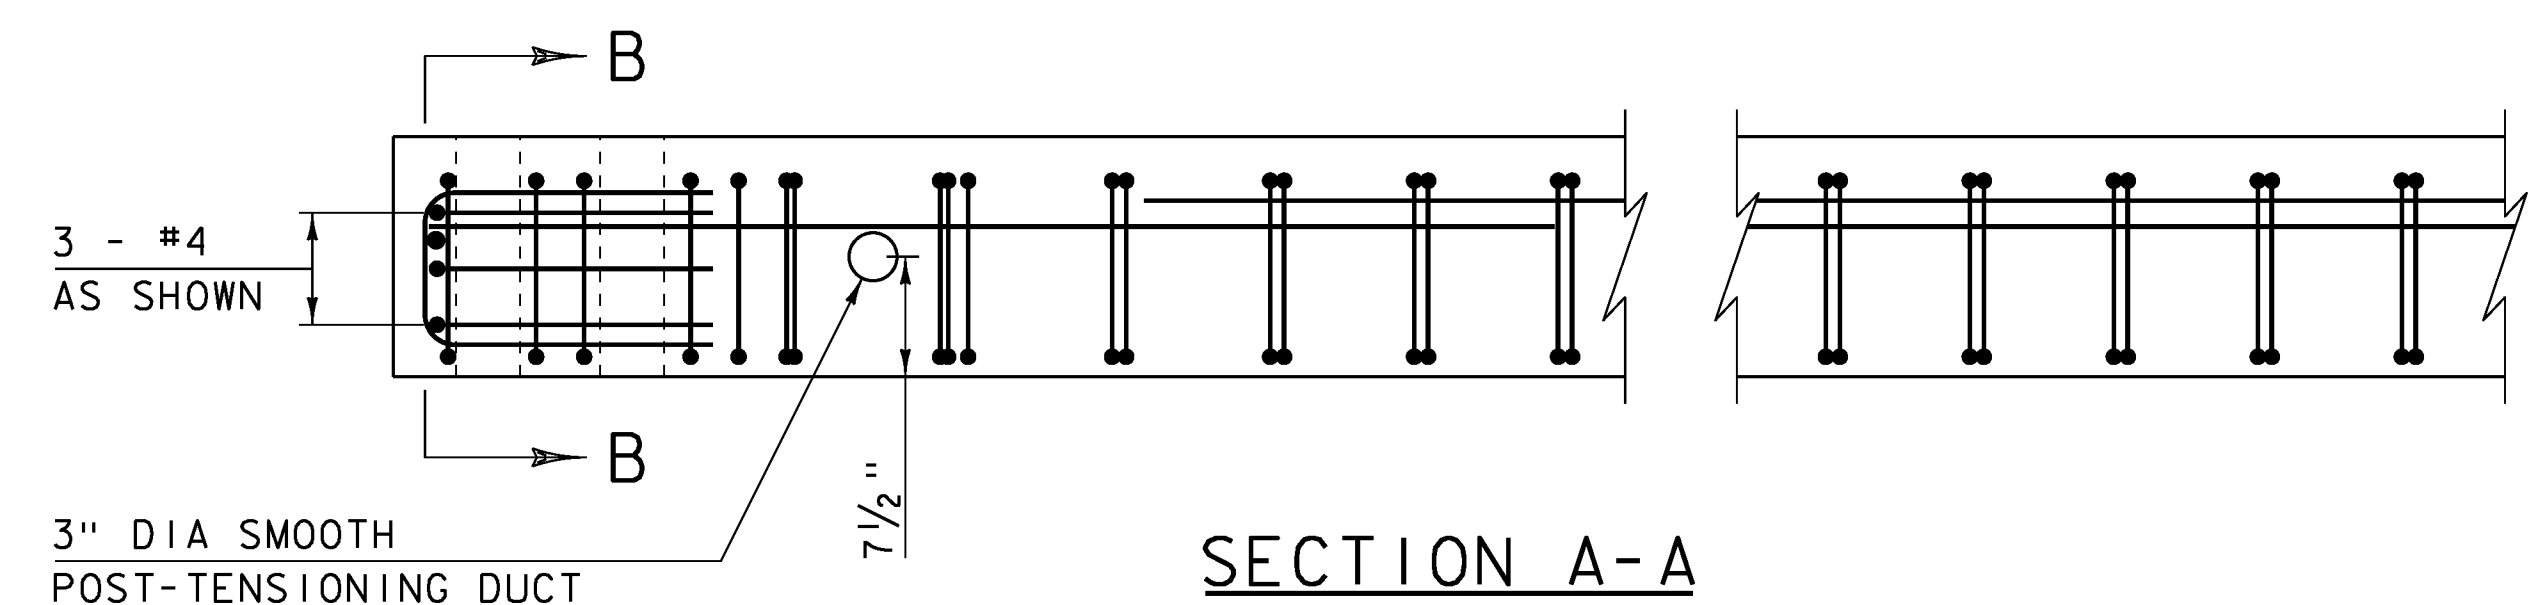

**SECTION A-A**


SCALE 1" = 1'-0"

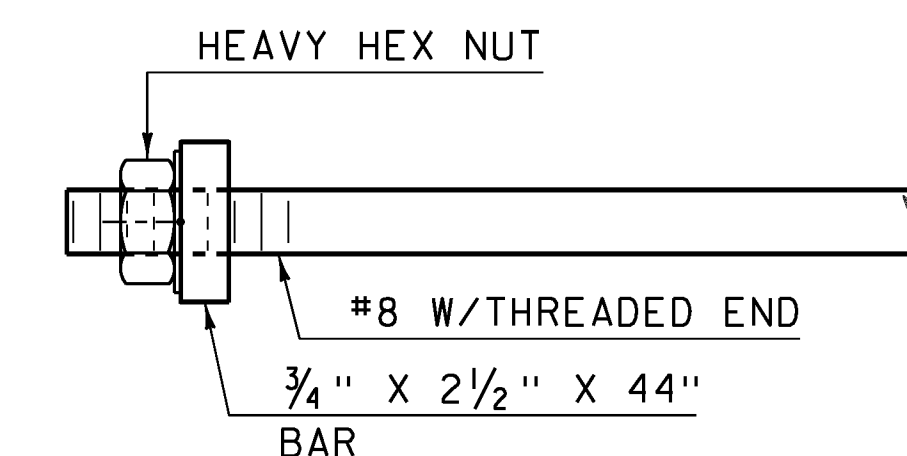

**ANCHOR BAR DETAILS**

OPTION "B"

NOT TO SCALE

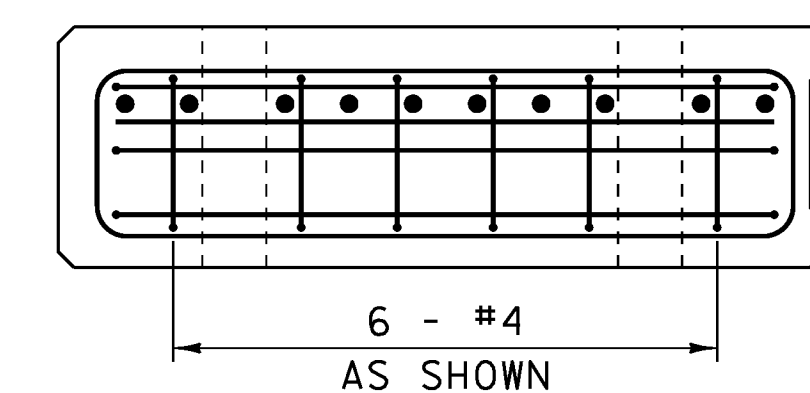

**SECTION B-B**

SCALE 1" = 1'-0"


**NOTES:**

- 1) ALL REINFORCING SHALL BE LEVEL 2 OR HIGHER.
- 2) ANCHOR BAR SHALL BE ASTM A36 AND SHALL BE GALVANIZED IN ACCORDANCE WITH AASHTO M 111M/M 111.
- 3) DAMAGED GALVANIZING OR REINFORCEMENT COATING ON THE ANCHOR BAR ASSEMBLY SHALL BE REPAIRED BY AN APPROVED METHOD.

PROJECT NAME: FAIRFIELD  
PROJECT NUMBER: BRF 028(25)


FILE NAME: sl2j156sup.dgn  
PROJECT LEADER: R. YOUNG  
DESIGNED BY: T. FILLBACH  
SUPERSTRUCTURE DETAILS I

PLOT DATE: 18-AUG-2014  
DRAWN BY: K. FRIEDLAND  
CHECKED BY: R. KLINEFELTER  
SHEET 23 OF 69

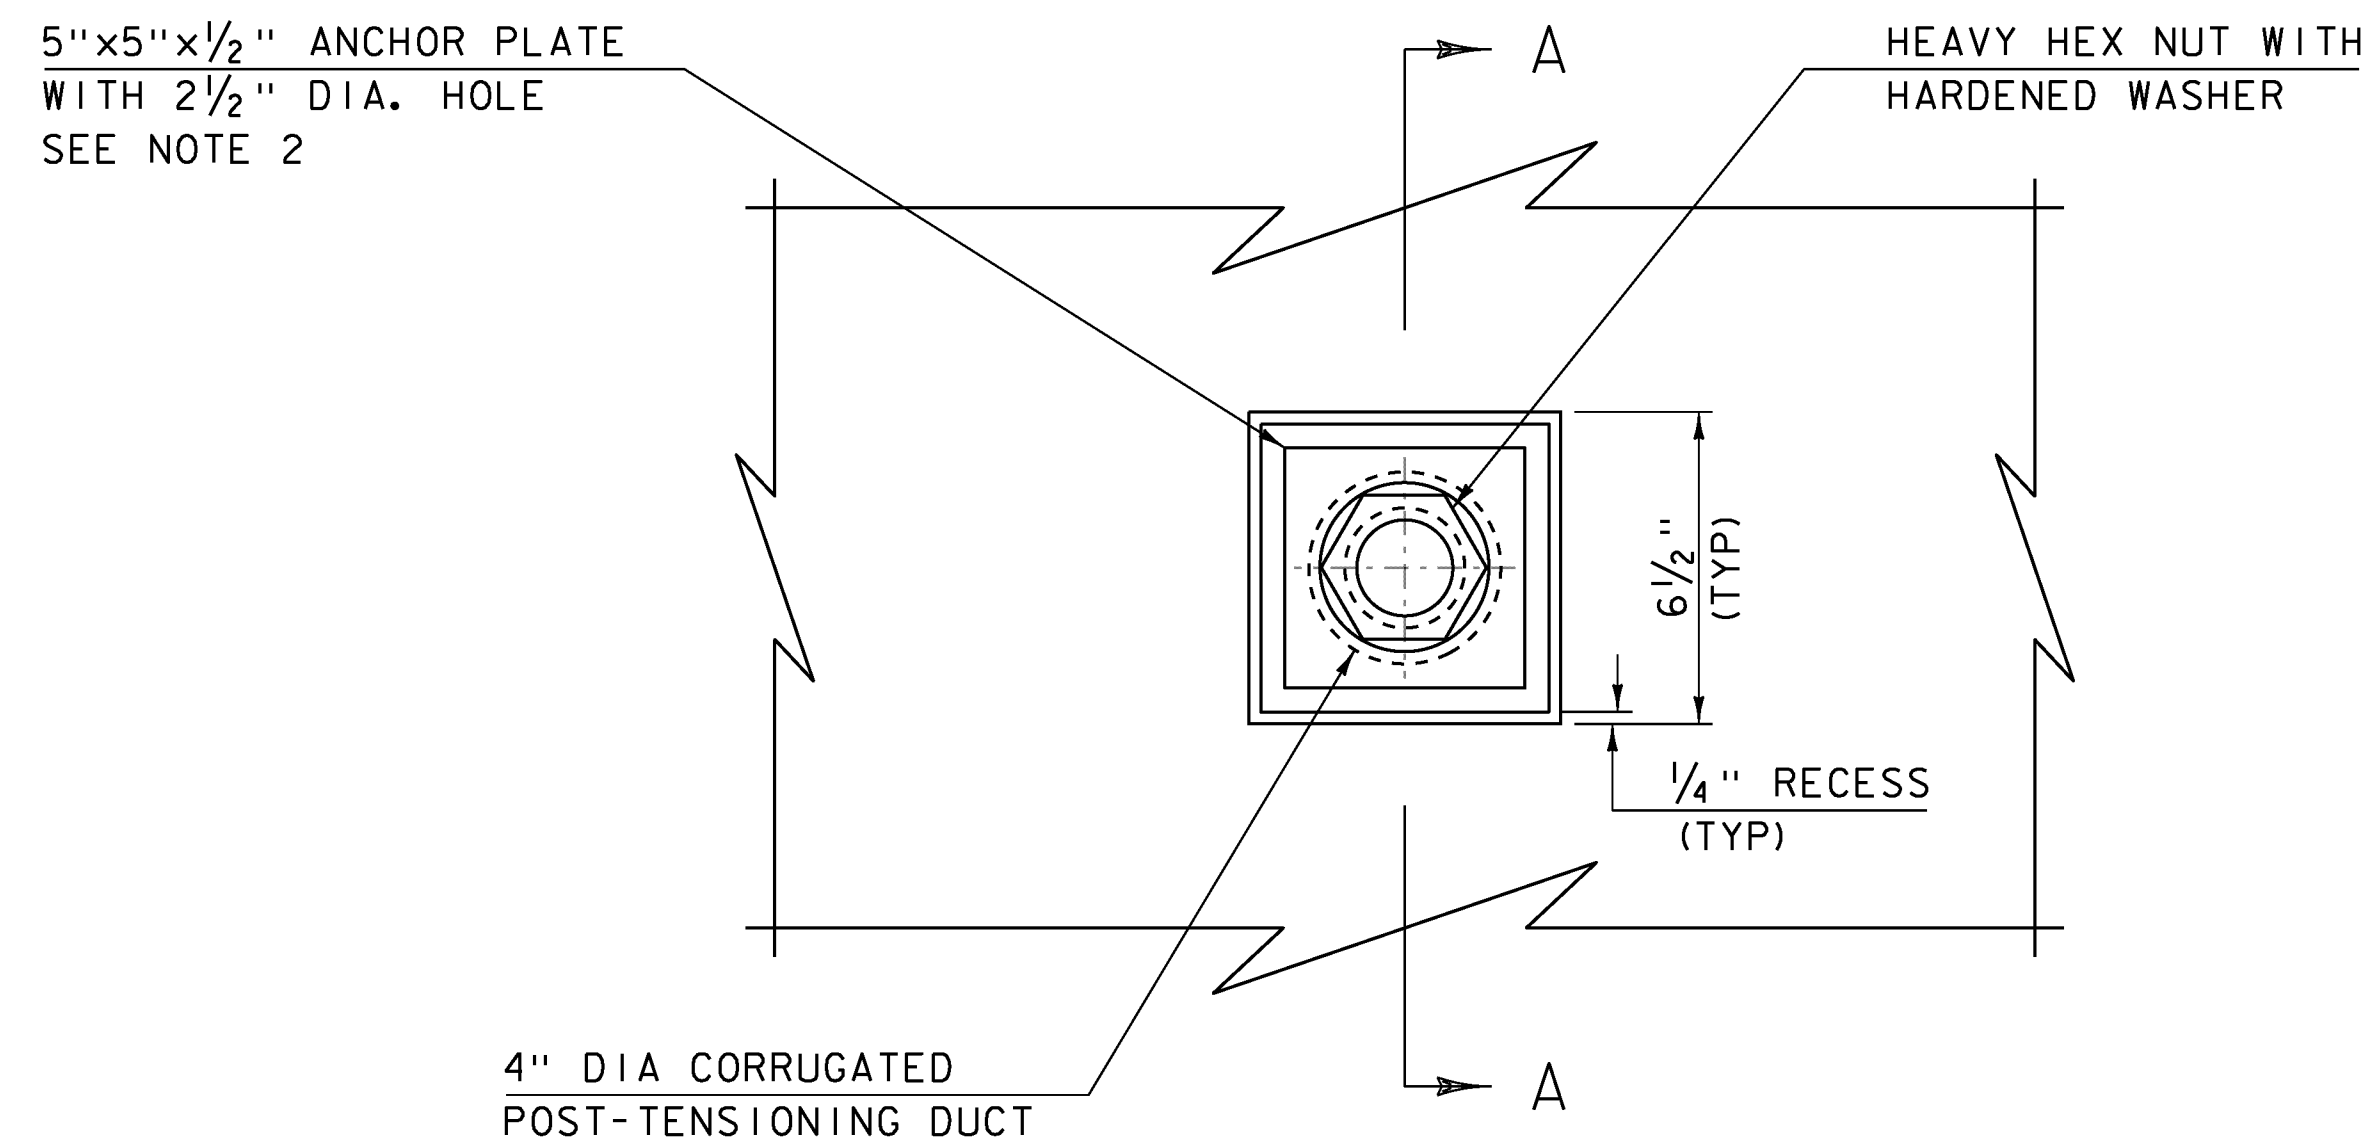


**ANCHOR BOLT DETAIL  
PLAN**

SCALE 3" = 1'-0"

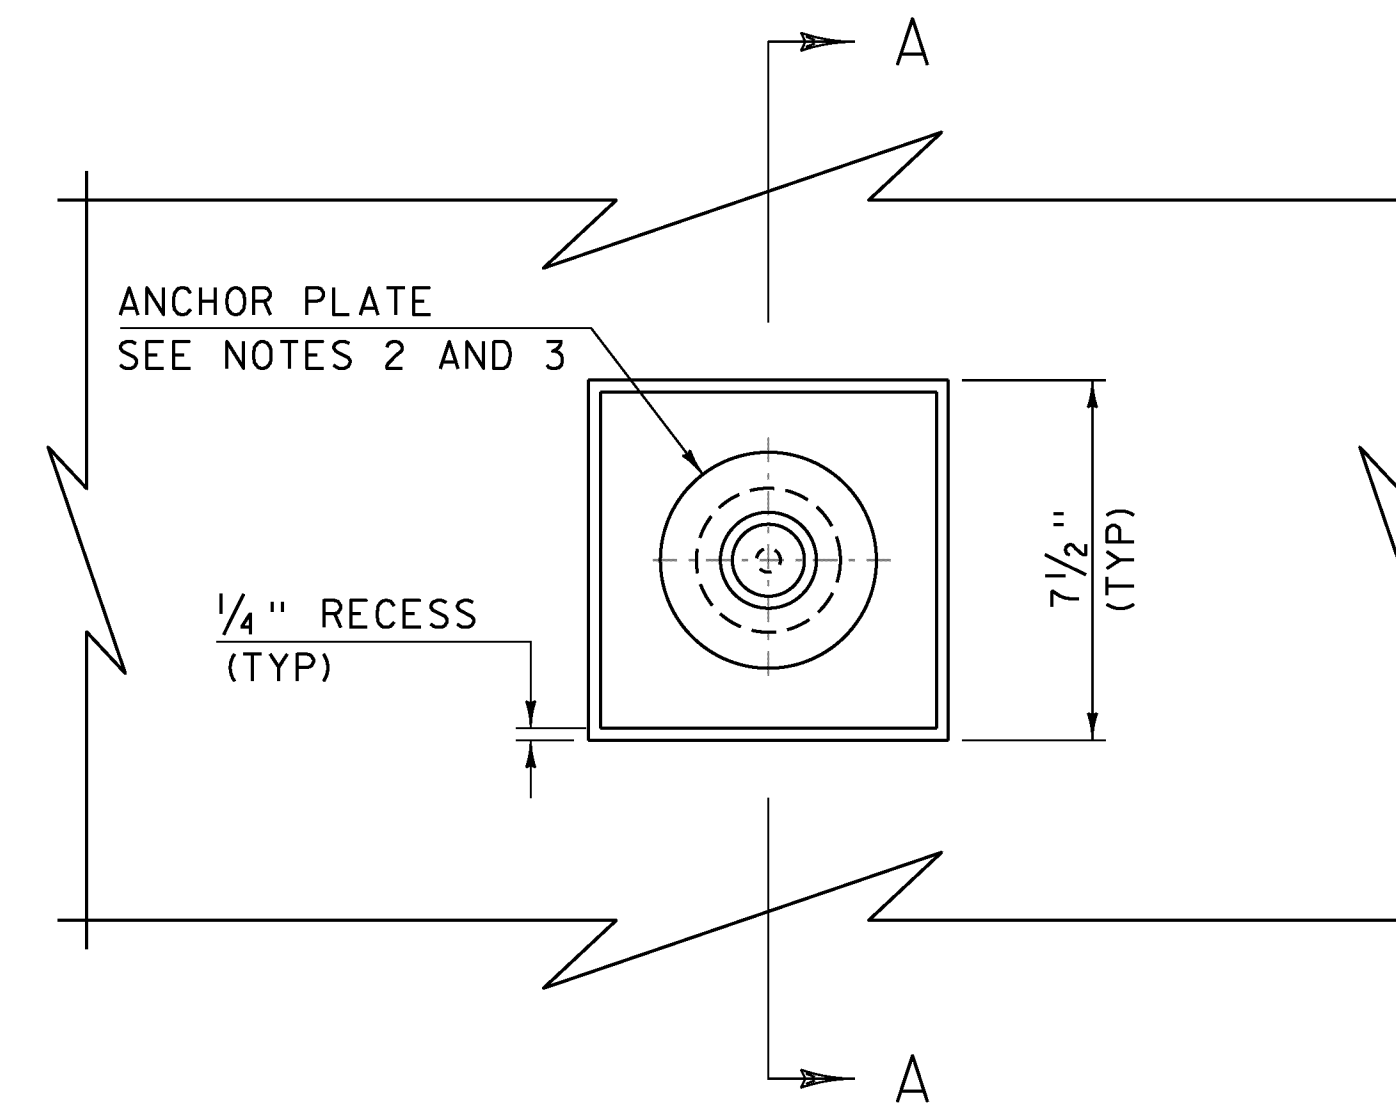


**TRANSVERSE POST-TENSIONING DETAIL  
ELEVATION**

SCALE 3" = 1'-0"

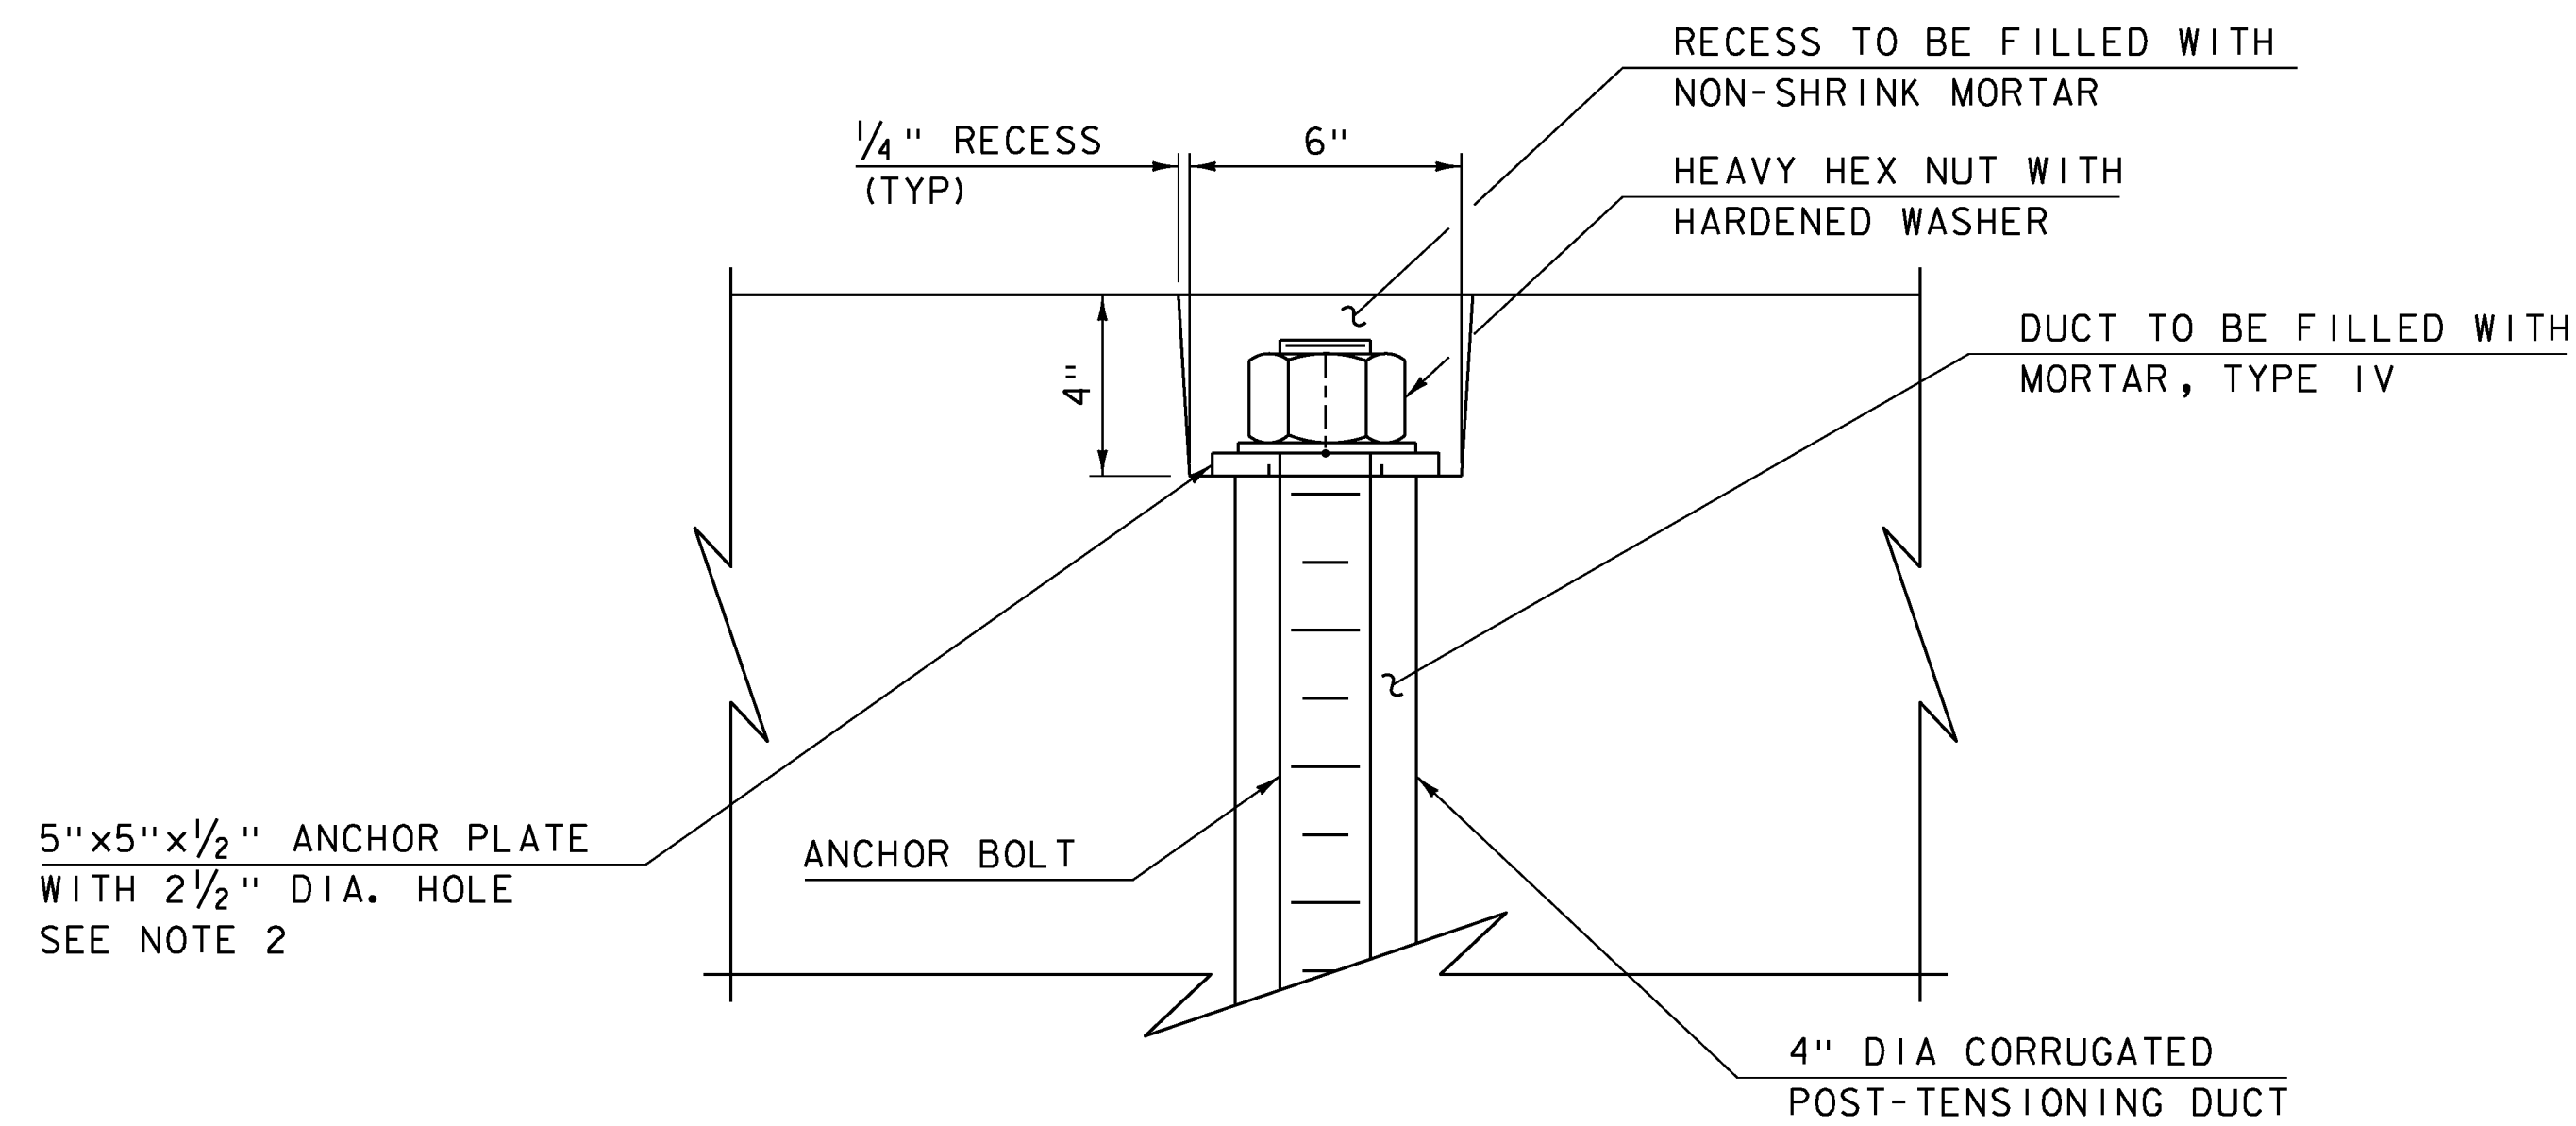

**ANCHOR BOLT DETAIL  
SECTION A-A**

SCALE 3" = 1'-0"

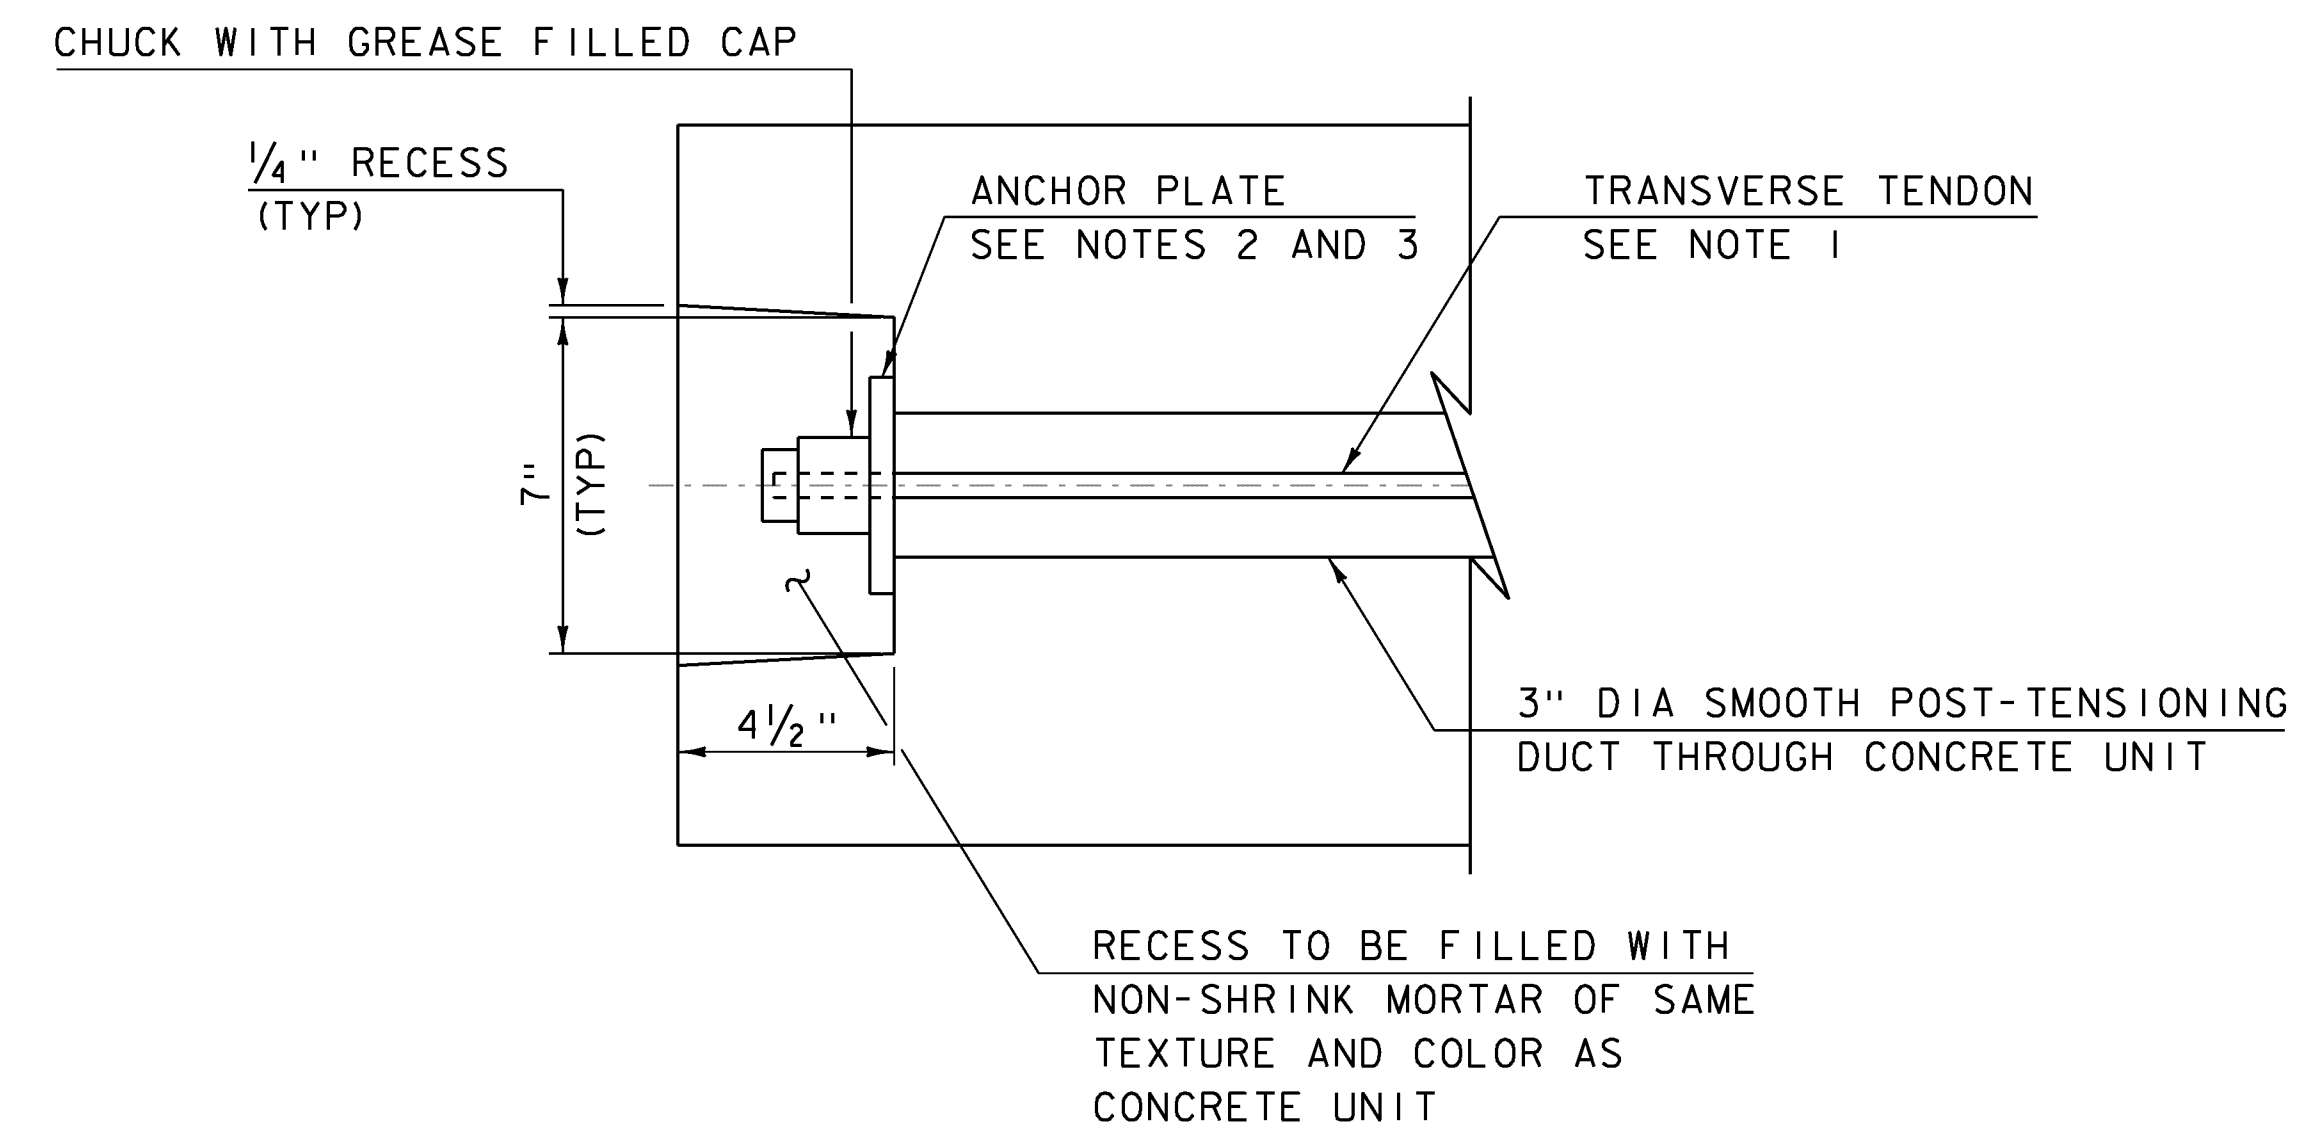

**TRANSVERSE POST-TENSIONING DETAIL  
SECTION A-A**

SCALE 3" = 1'-0"


**NOTES:**

- 1) TRANSVERSE TENDONS SHALL BE COVERED BY SEAMLESS POLYPROPYLENE SHEATH (WITH CORROSION INHIBITER GREASE BETWEEN SHEATH AND STRAND) FOR THE LENGTH OF STRAND, EXCEPT AT ANCHORAGE LOCATIONS. EACH STRAND SHALL BE TENSIONED TO 33 KIPS FOR 0.5" DIA STRAND AND TO 47 KIPS FOR 0.6" DIA STRAND.
- 2) ANCHOR PLATES SHALL CONFORM TO AASHTO M 270M/M 270, GRADE 345 (GRADE 50) AND BE GALVANIZED IN ACCORDANCE WITH AASHTO M 111M/M 111.
- 3) ANCHOR PLATES FOR TRANSVERSE POST-TENSIONING ARE TO BE DESIGNED BY THE FABRICATOR FOR THE SPECIFIC POST-TENSIONING SYSTEM USED. DETAILS FOR THE ANCHOR PLATE SHALL BE PROVIDED ON THE FABRICATION DRAWINGS.

PROJECT NAME: FAIRFIELD  
PROJECT NUMBER: BRF 028(25)


FILE NAME: sl2j156sup.dgn  
PROJECT LEADER: R. YOUNG  
DESIGNED BY: T. FILLBACH  
SUPERSTRUCTURE DETAILS 2

PLOT DATE: 18-AUG-2014  
DRAWN BY: K. FRIEDLAND  
CHECKED BY: R. KLINEFELTER  
SHEET 24 OF 69

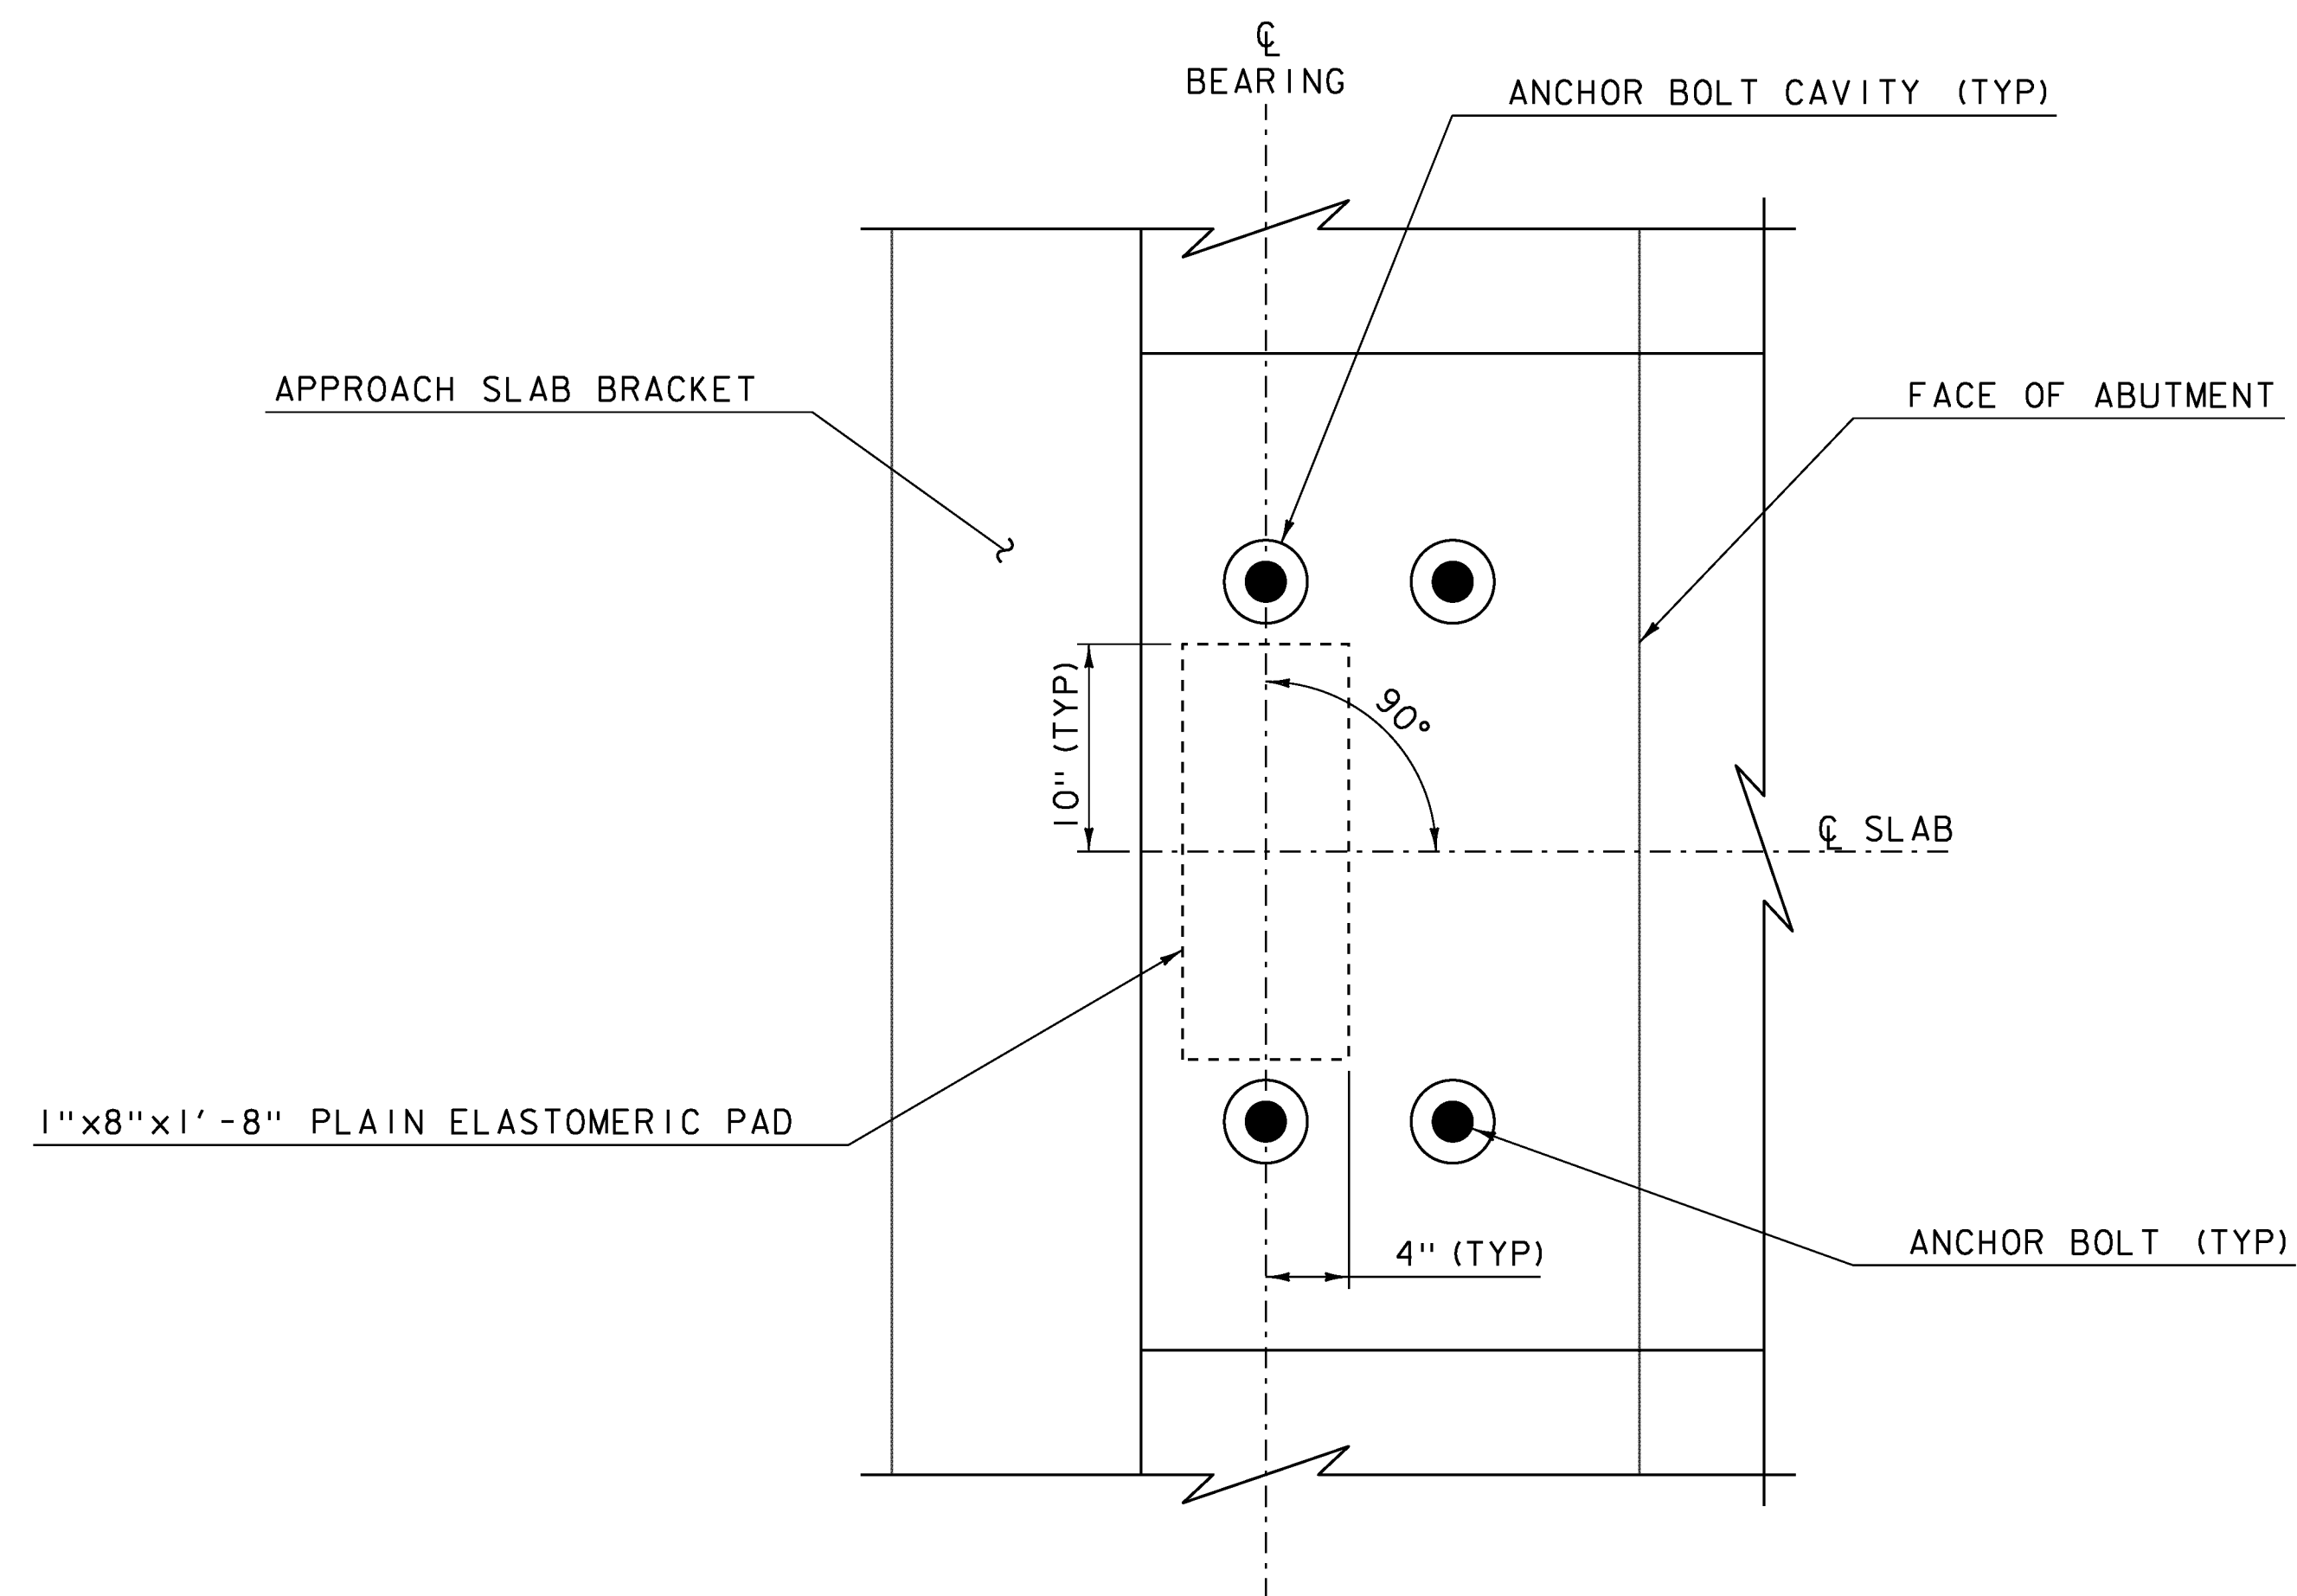

**BEARING LAYOUT**

SCALE 1/2" = 1'-0"

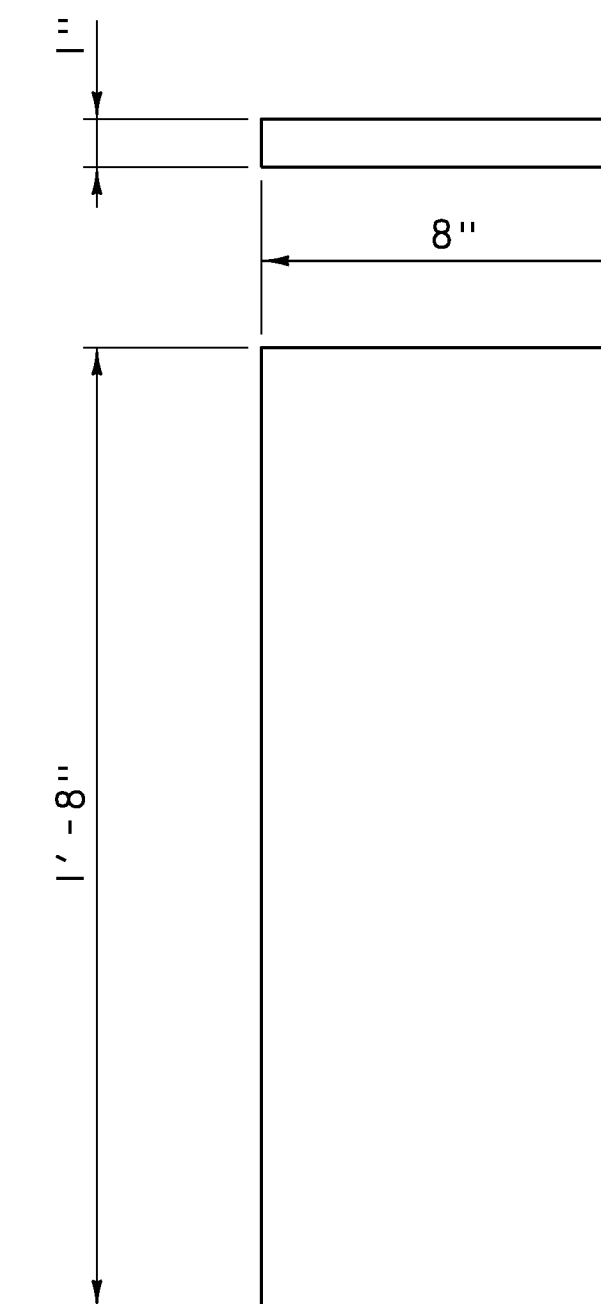


**BEARING DETAIL**

SCALE 3" = 1'-0"

**BEARING NOTES:**


1. BEARINGS SHALL CONFORM TO THE APPLICABLE SUBSECTIONS OF SECTIONS 531 AND 731.
2. THE ELASTOMER WAS DESIGNED WITH A SHEAR MODULUS OF 110 PSI +/- 15%.
3. THE CONTRACTOR IS ADVISED TO HAVE A MINIMUM OF 12 - 1/4" x 8" x 1'-8" GALVANIZED STEEL SHIMS AVAILABLE FOR USE FOR ELEVATION ADJUSTMENTS UPON THE SETTING OF THE SUPERSTRUCTURE UNITS. THE SHIMS SHALL BE FABRICATED ACCORDING TO SECTION 531 AND SHALL BE INCLUDED UNDER ITEM 531.16, "BEARING DEVICE ASSEMBLY, PLAIN ELASTOMERIC PAD".

PROJECT NAME: FAIRFIELD	
PROJECT NUMBER: BRF 028(25)	
FILE NAME: sl2j156sup.dgn	PLOT DATE: 18-AUG-2014
PROJECT LEADER: R. YOUNG	DRAWN BY: R. KLINEFELTER
DESIGNED BY: R. KLINEFELTER	CHECKED BY: J. SALVATORI
BEARING DETAILS	SHEET 25 OF 69

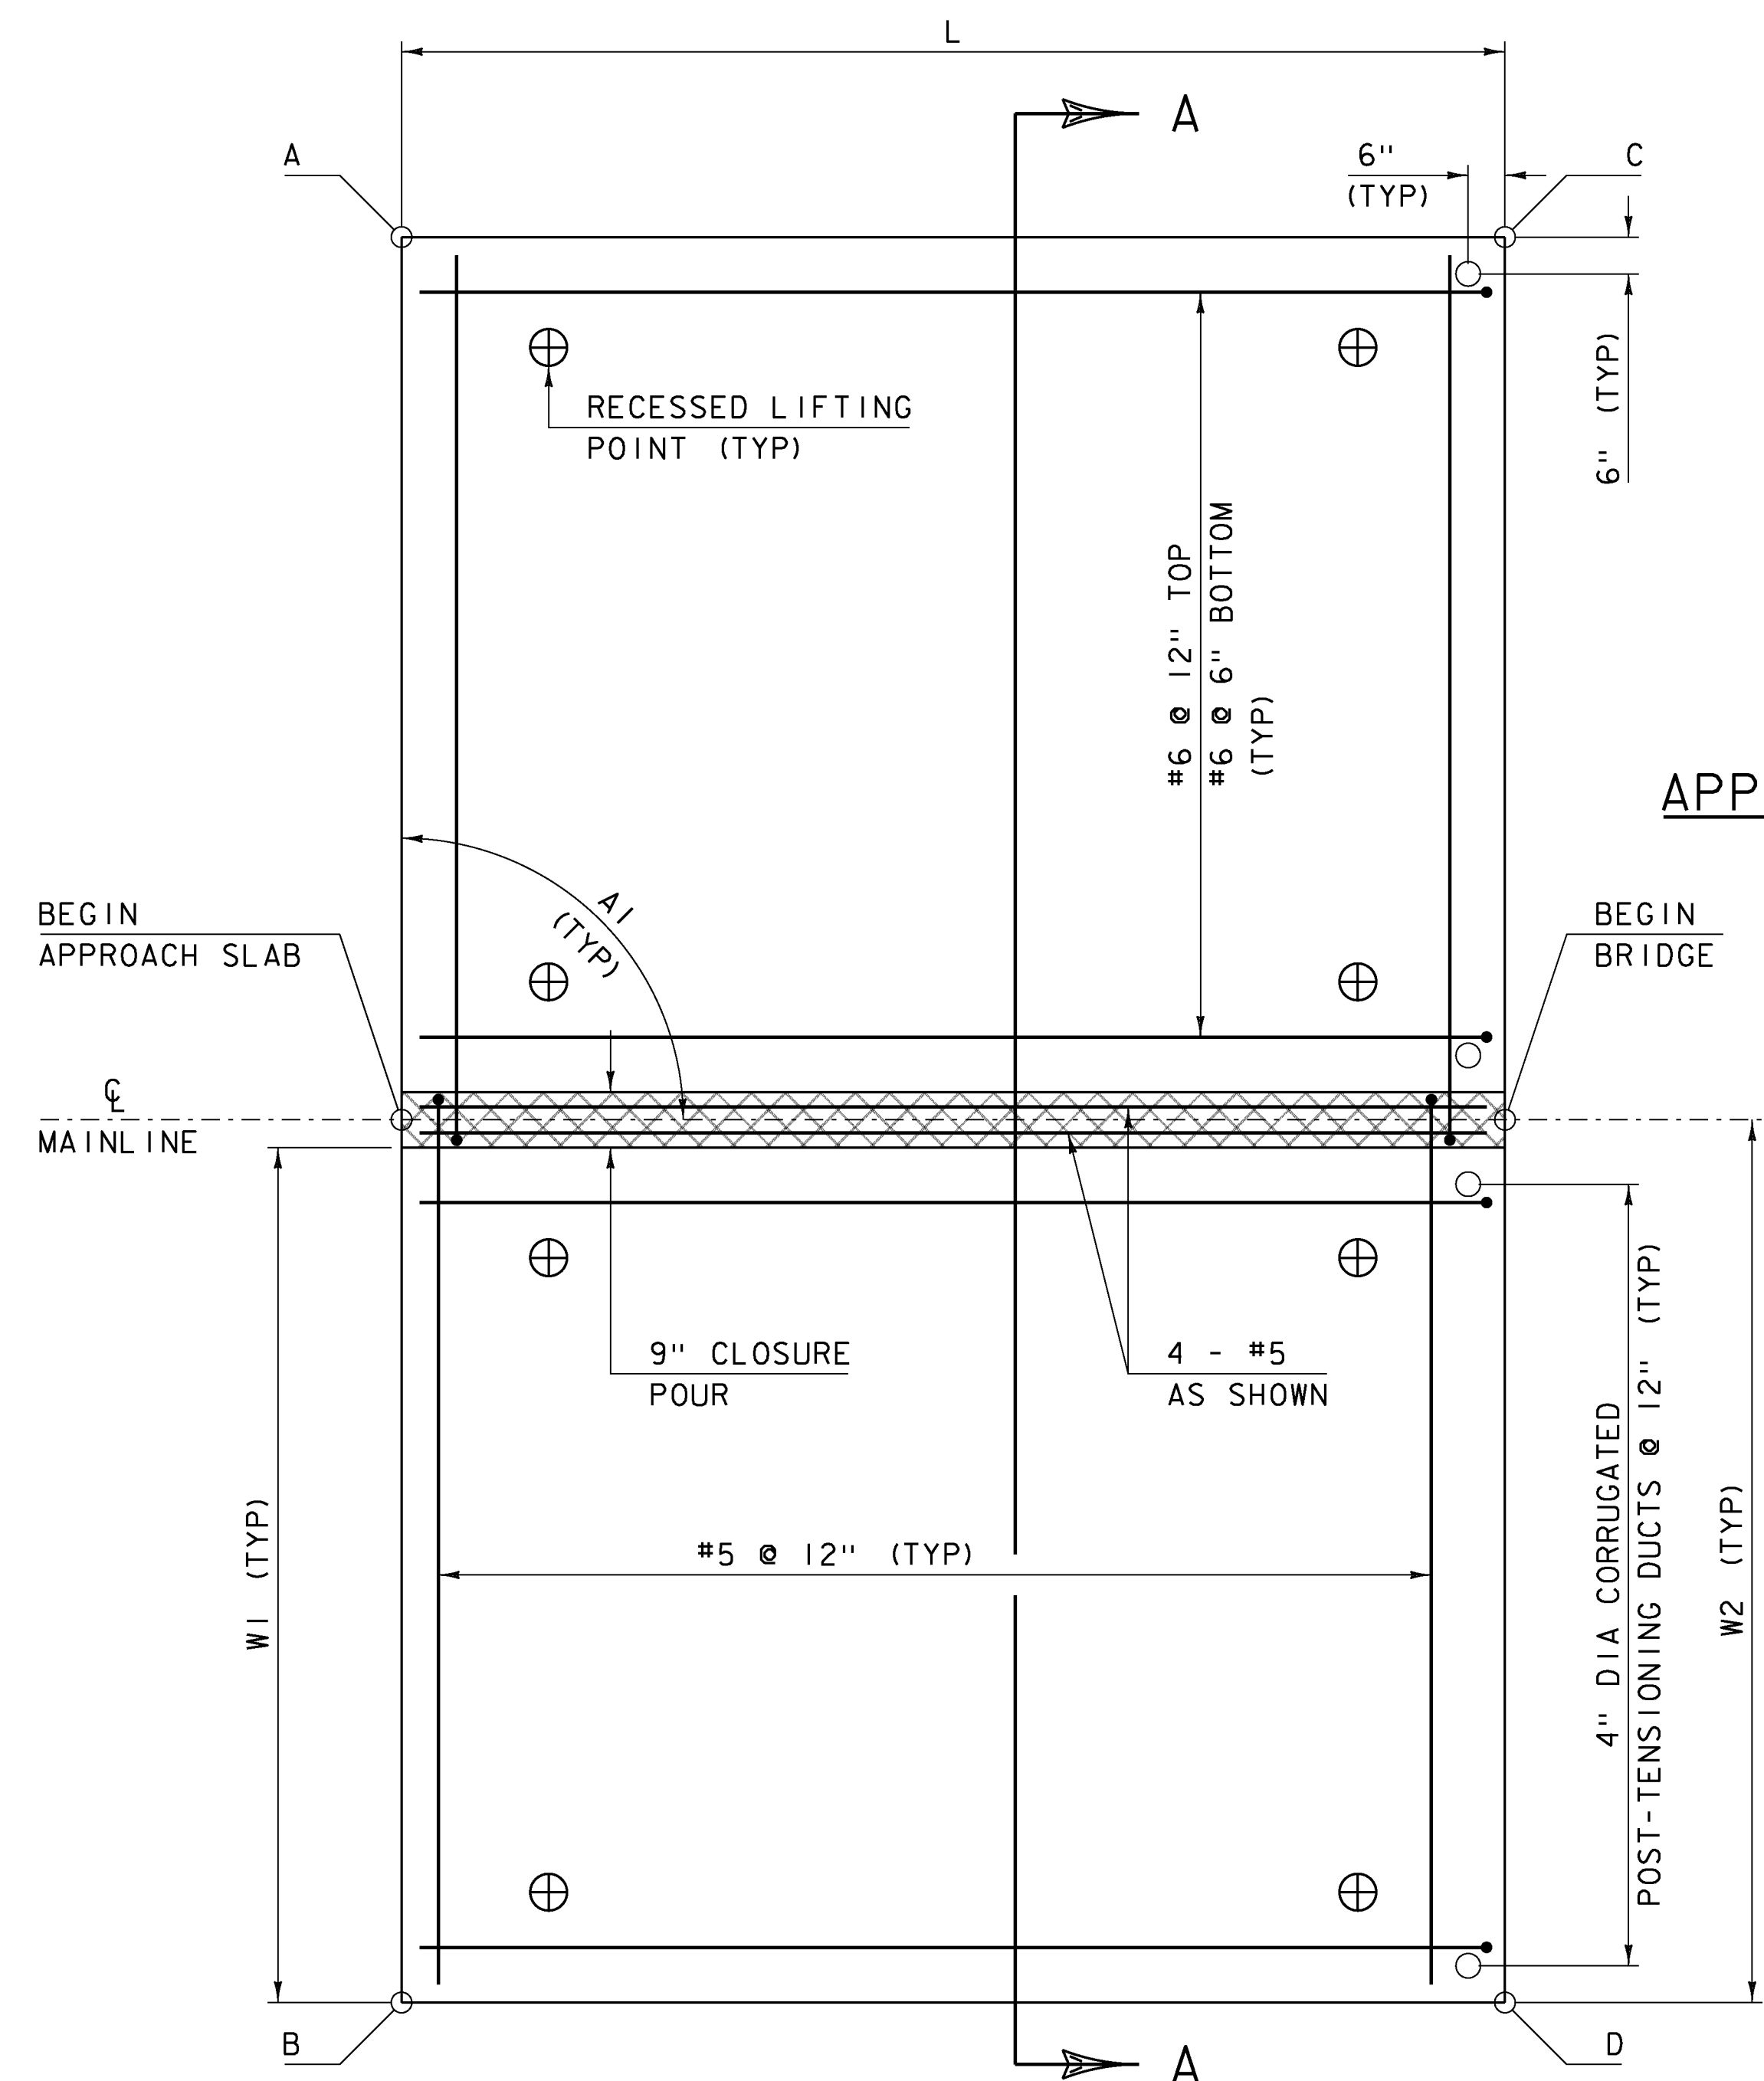

**APPROACH SLAB #1 PLAN VIEW**

SCALE 1/2" = 1'-0"

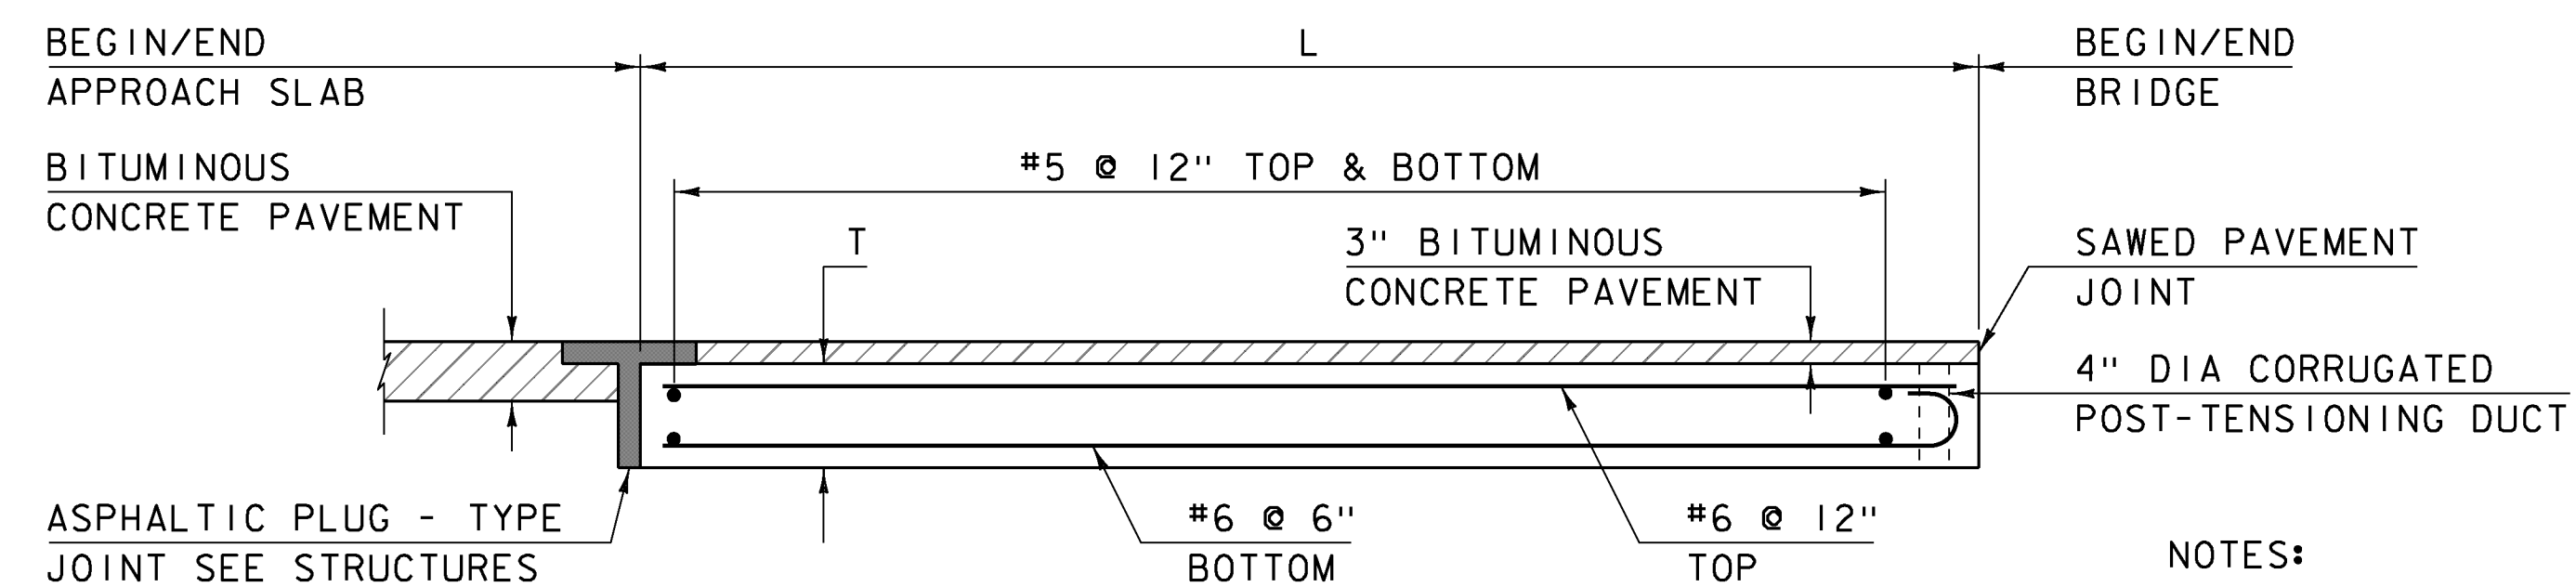


**APPROACH SLAB ELEVATION VIEW**

SCALE 1/2" = 1'-0"


NOTES:

- 1) ALL REINFORCING SHALL BE LEVEL 2 OR HIGHER.
- 2) LIFTING POINTS SHALL BE DESIGNED BY FABRICATOR AND SUBMITTED WITH CALCULATIONS.

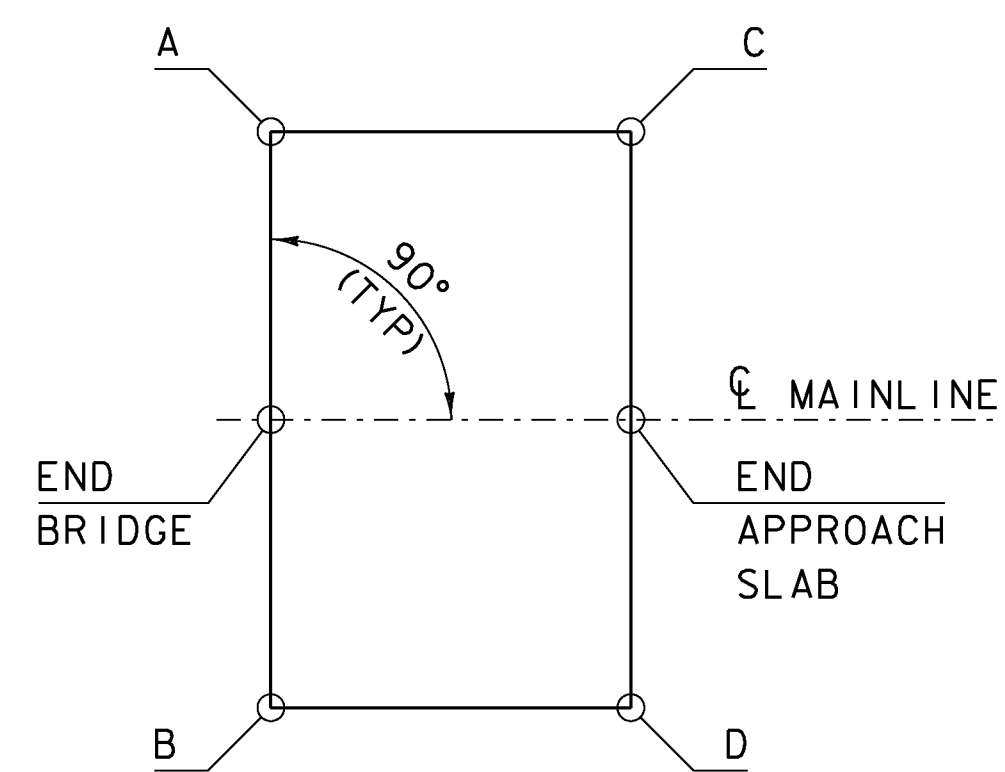

**APPROACH SLAB #2 PLAN VIEW**

NOT TO SCALE

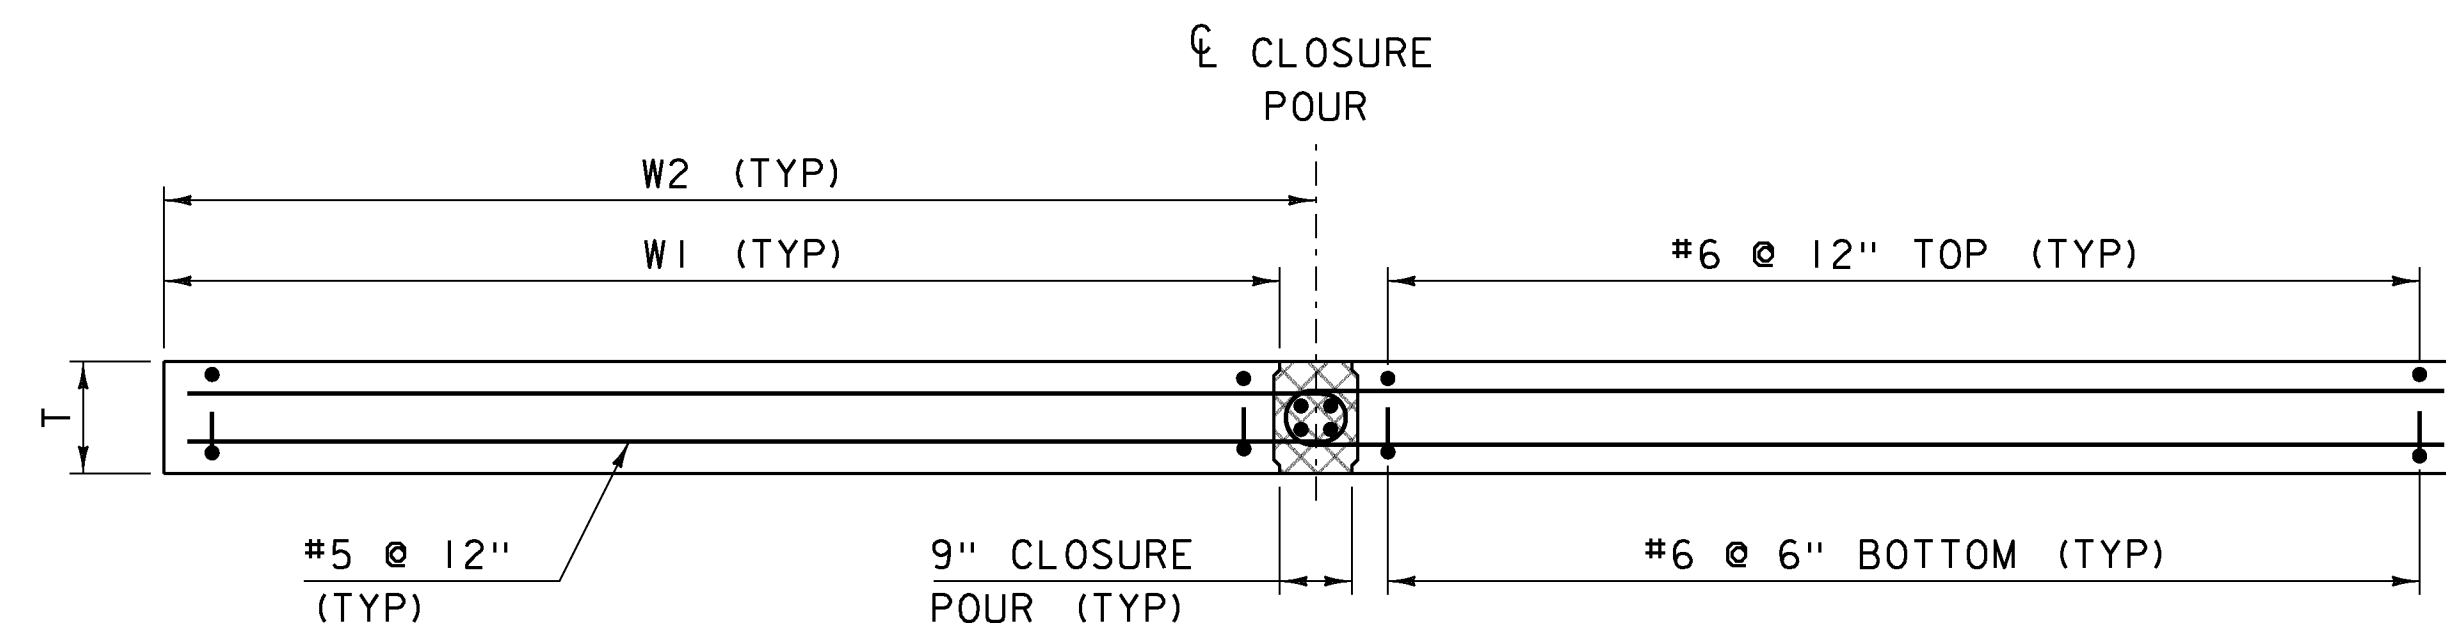

**SECTION A-A**

SCALE 1/2" = 1'-0"

T	1' - 3"
L	15' - 0"
W1	11' - 7 1/2"
W2	12' - 0"
A1	90°


**APPROACH SLAB DIMENSIONS**

APPROACH SLAB #1			
	STATION	OFFSET	ELEVATION
1A	16+47.00	-12.00	603.45
BEGIN AS #1	16+47.00	CL	603.69
1B	16+47.00	12.00	603.45
1C	16+62.00	-12.00	603.48
END AS #1	16+62.00	CL	603.72
1D	16+62.00	12.00	603.48

APPROACH SLAB #2			
	STATION	OFFSET	ELEVATION
2A	17+06.00	-12.00	603.40
BEGIN AS #2	17+06.00	CL	603.64
2B	17+06.00	12.00	603.40
2C	17+21.00	-12.00	603.31
END AS #2	17+21.00	CL	603.55
2D	17+21.00	12.00	603.31


**APPROACH SLAB ELEVATIONS**

ALL ELEVATIONS ARE TOP OF SLAB

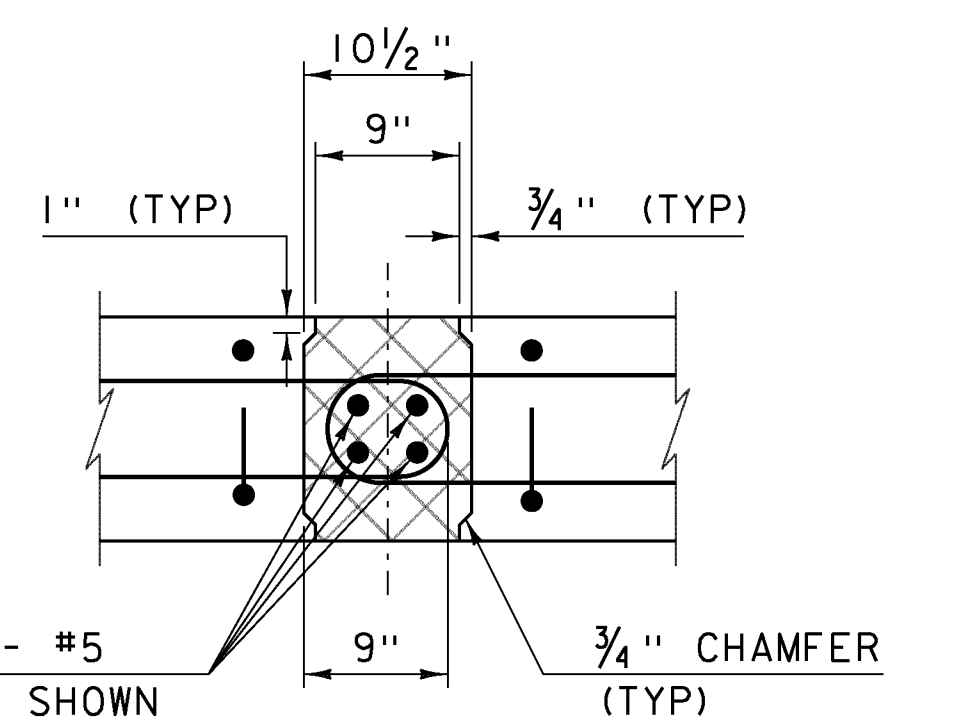

**CONNECTION DETAIL SECTION**

SCALE 1" = 1'-0"

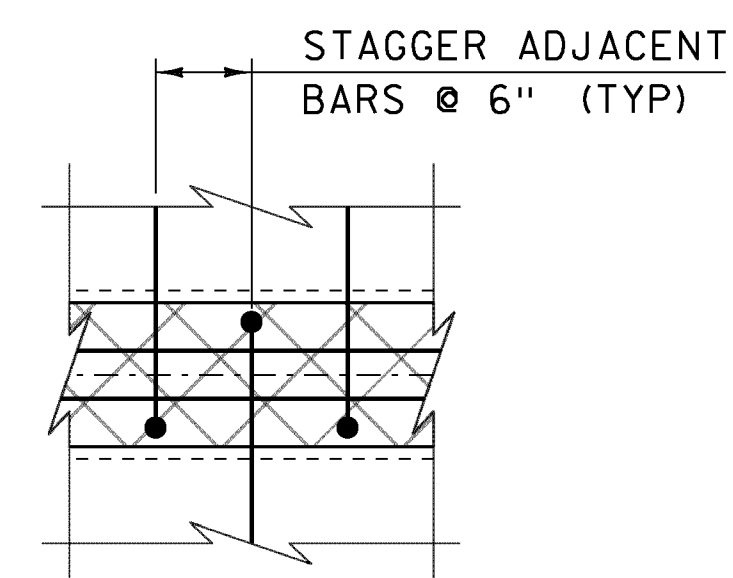

**CONNECTION DETAIL PLAN**

SCALE 1" = 1'-0"


NOTE:

- NF = NEAR FACE
- FF = FAR FACE
- EF = EACH FACE
- ▲ = CUT TO FIT IN FIELD
- 3" CLEAR, UNLESS OTHERWISE SPECIFIED ON THE PLANS.
- SPLICES NOT DETAILED SHALL BE DESIGNED

PROJECT NAME: FAIRFIELD  
PROJECT NUMBER: BRF 028(25)

FILE NAME: sl2j156opslab.dgn  
PROJECT LEADER: R. YOUNG  
DESIGNED BY: R. KLINEFELTER  
APPROACH SLAB DETAILS

PLOT DATE: 10-SEP-2014  
DRAWN BY: K. FRIEDLAND  
CHECKED BY: J. SALVATORI  
SHEET 26 OF 69

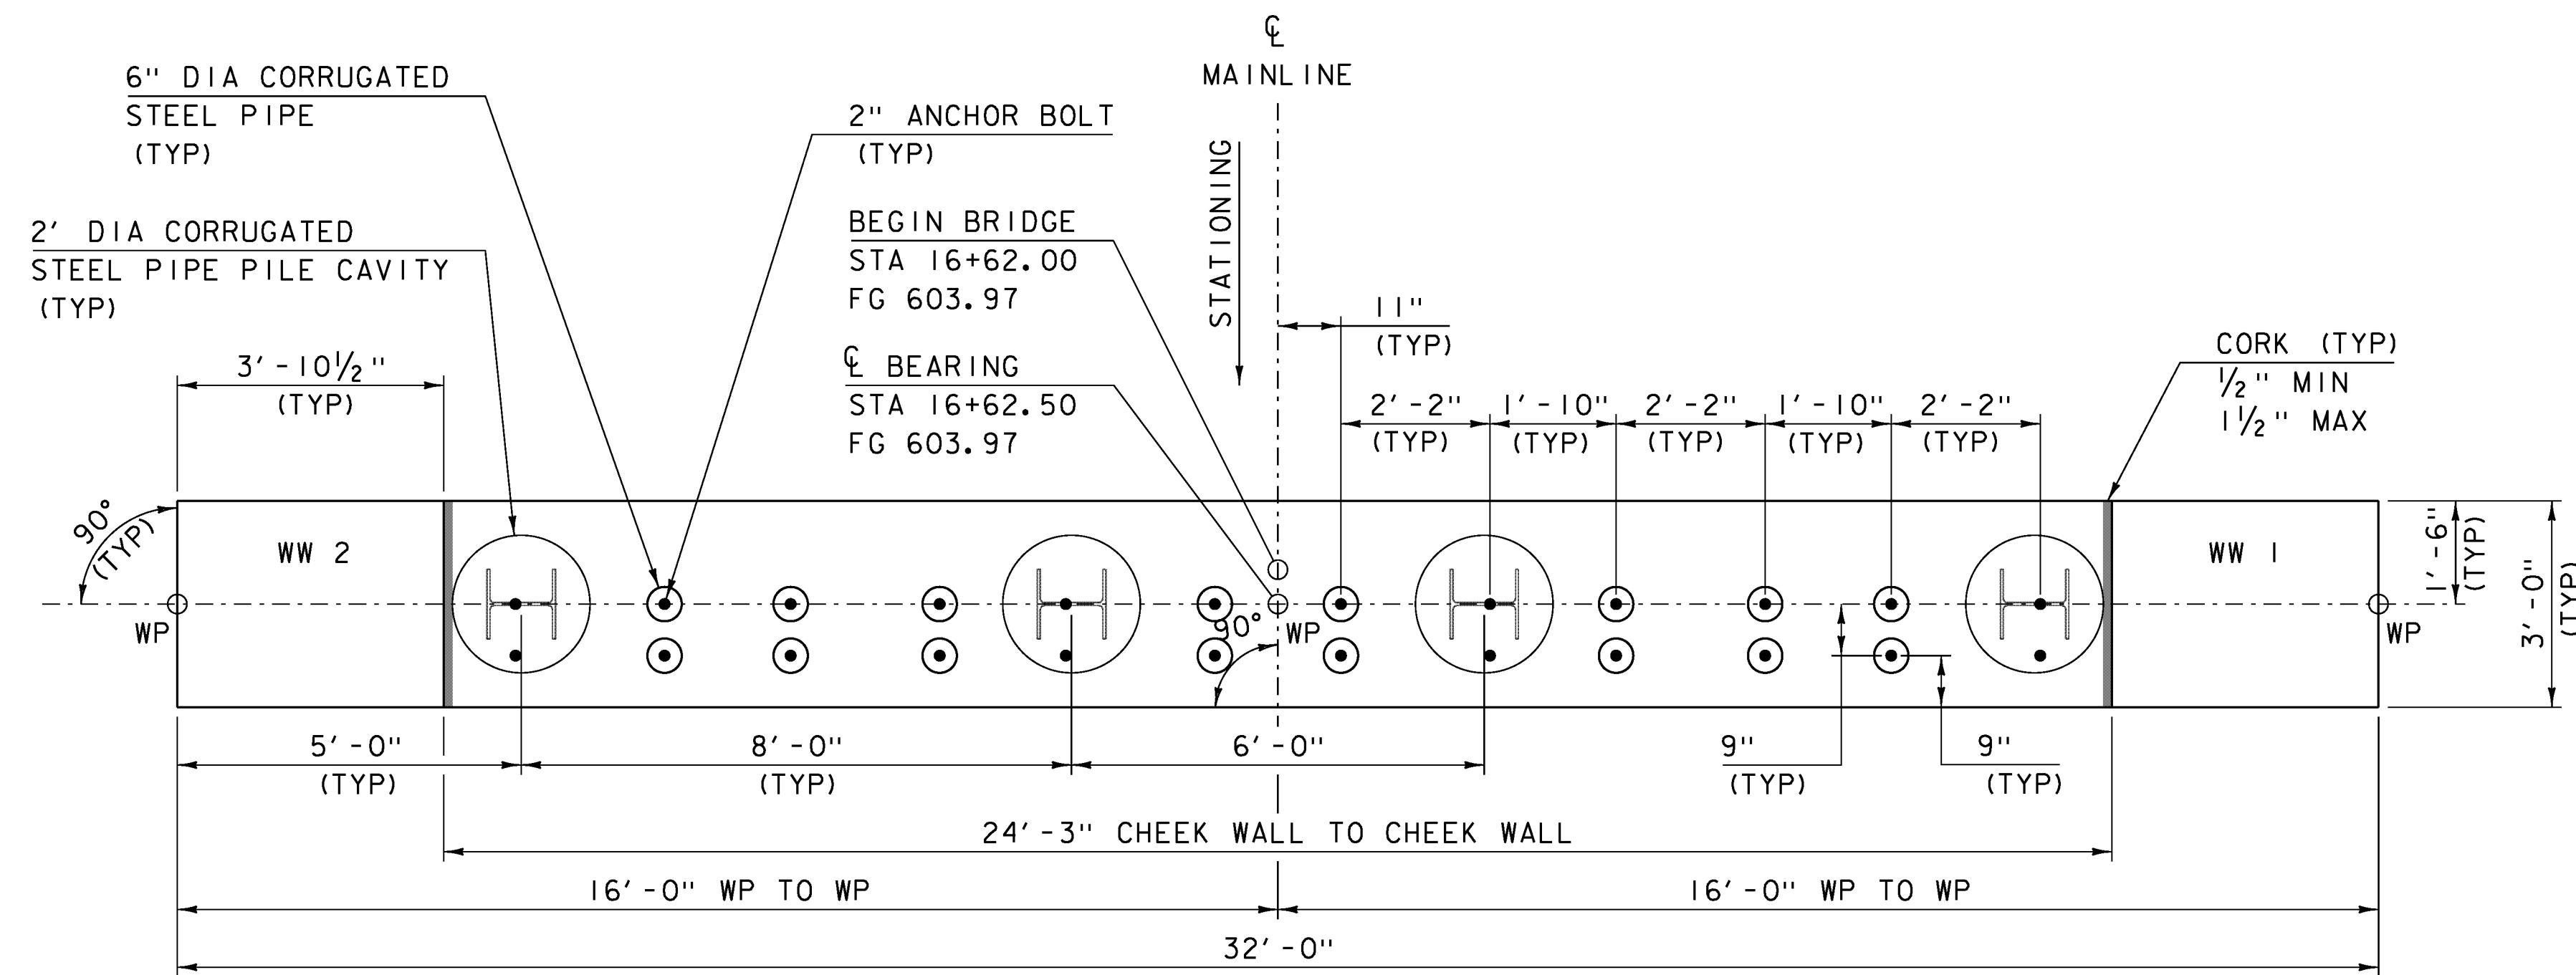

**ABUTMENT PLAN (PCU)**


SCALE 1/2" = 1'-0"

**PCU 1 ELEVATIONS**

ELEV "A"	603.98
ELEV "B"	602.15
ELEV "C"	597.23
ELEV "D"	602.39
ELEV "E"	603.98
ELEV "F"	602.15

**PCU 2 ELEVATIONS**

ELEV "A"	603.90
ELEV "B"	602.07
ELEV "C"	597.15
ELEV "D"	602.31
ELEV "E"	603.90
ELEV "F"	602.07

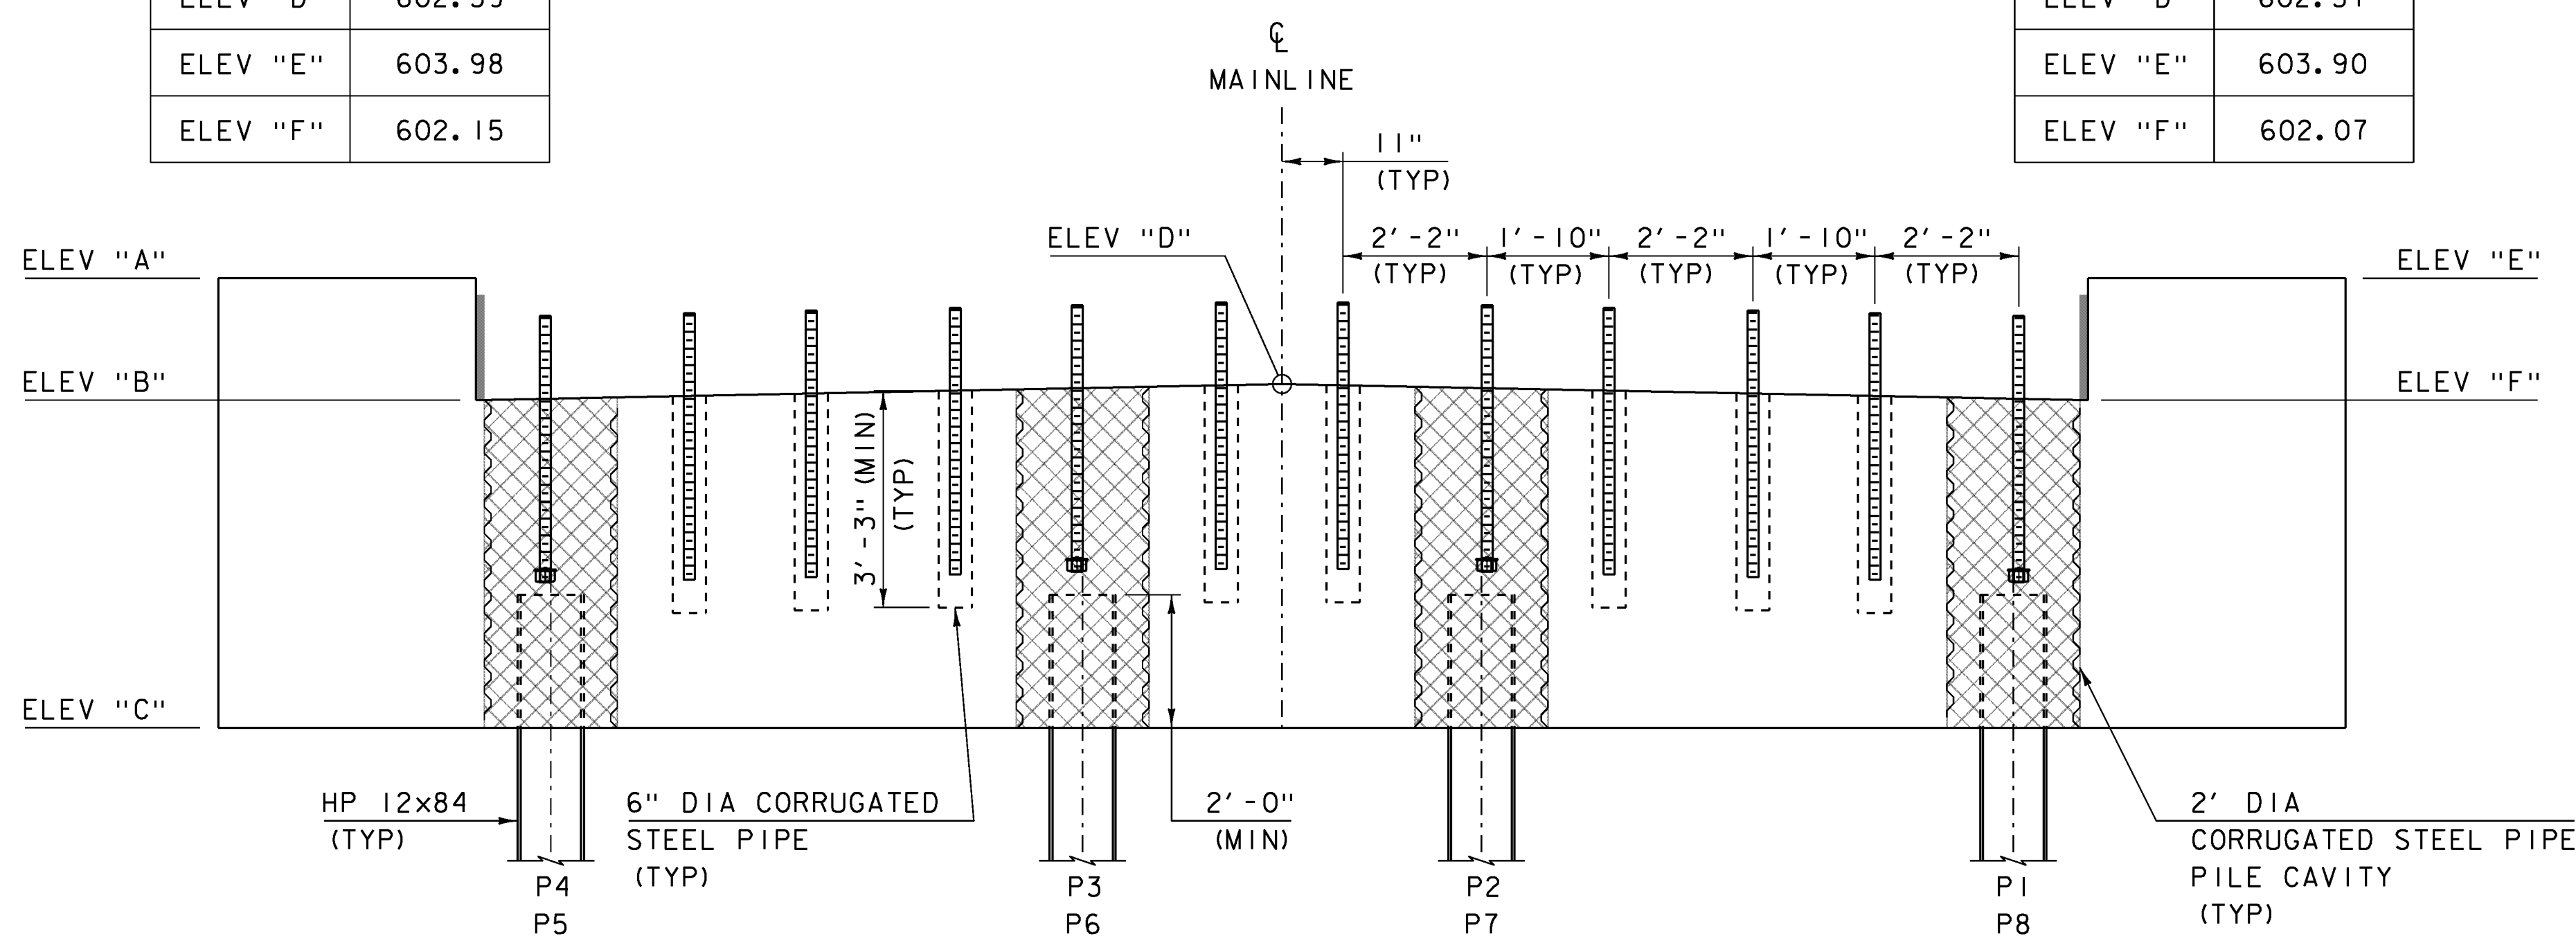


**ABUTMENT ELEVATION (PCU)**

SCALE 1/2" = 1'-0"

**NOTES:**


- 1) ANCHOR BOLTS SHALL BE ASTM F1554 GRADE 105.
- 2) ANCHOR BOLTS, NUTS, AND WASHERS SHALL BE GALVANIZED.
- 3) 6" DIA CORRUGATED STEEL PIPES FOR ANCHOR BOLTS SHALL BE PRECAST INTO THE PILE CAPS. DRILLING AND GROUTING ANCHOR BOLTS WILL NOT BE PERMITTED.
- 4) ANCHOR BOLTS, NUTS, WASHERS, AND ANCHOR PLATES SHALL BE PAID FOR UNDER ITEM 506.60, STRUCTURAL STEEL (FPQ).
- 5) GROUT IN 6" DIA CORRUGATED STEEL PIPES FOR ANCHOR BOLTS SHALL HAVE A MINIMUM COMPRESSIVE STRENGTH OF 10 KSI AT 28 DAYS.
- 6) ANCHOR BOLTS LOCATED IN PILE CAVITIES SHALL HAVE A HEAVY HEX NUT AND HARDENED WASHER ON THE BOTTOM END OF EACH ANCHOR BOLT AND SHALL BE SECURED IN THE FINAL POSITION BEFORE THE PILE CAVITY CONCRETE IS PLACED.
- 7) A TEMPLATE SHALL BE USED TO LAYOUT ANCHOR BOLT DUCTS IN THE SOLID SLABS. THE SAME TEMPLATE SHALL BE USED TO LAYOUT ANCHOR BOLT DUCTS AND ANCHOR BOLTS IN THE ABUTMENTS.
- 8) PCU 1 SHOWN, PCU 2 SIMILAR.

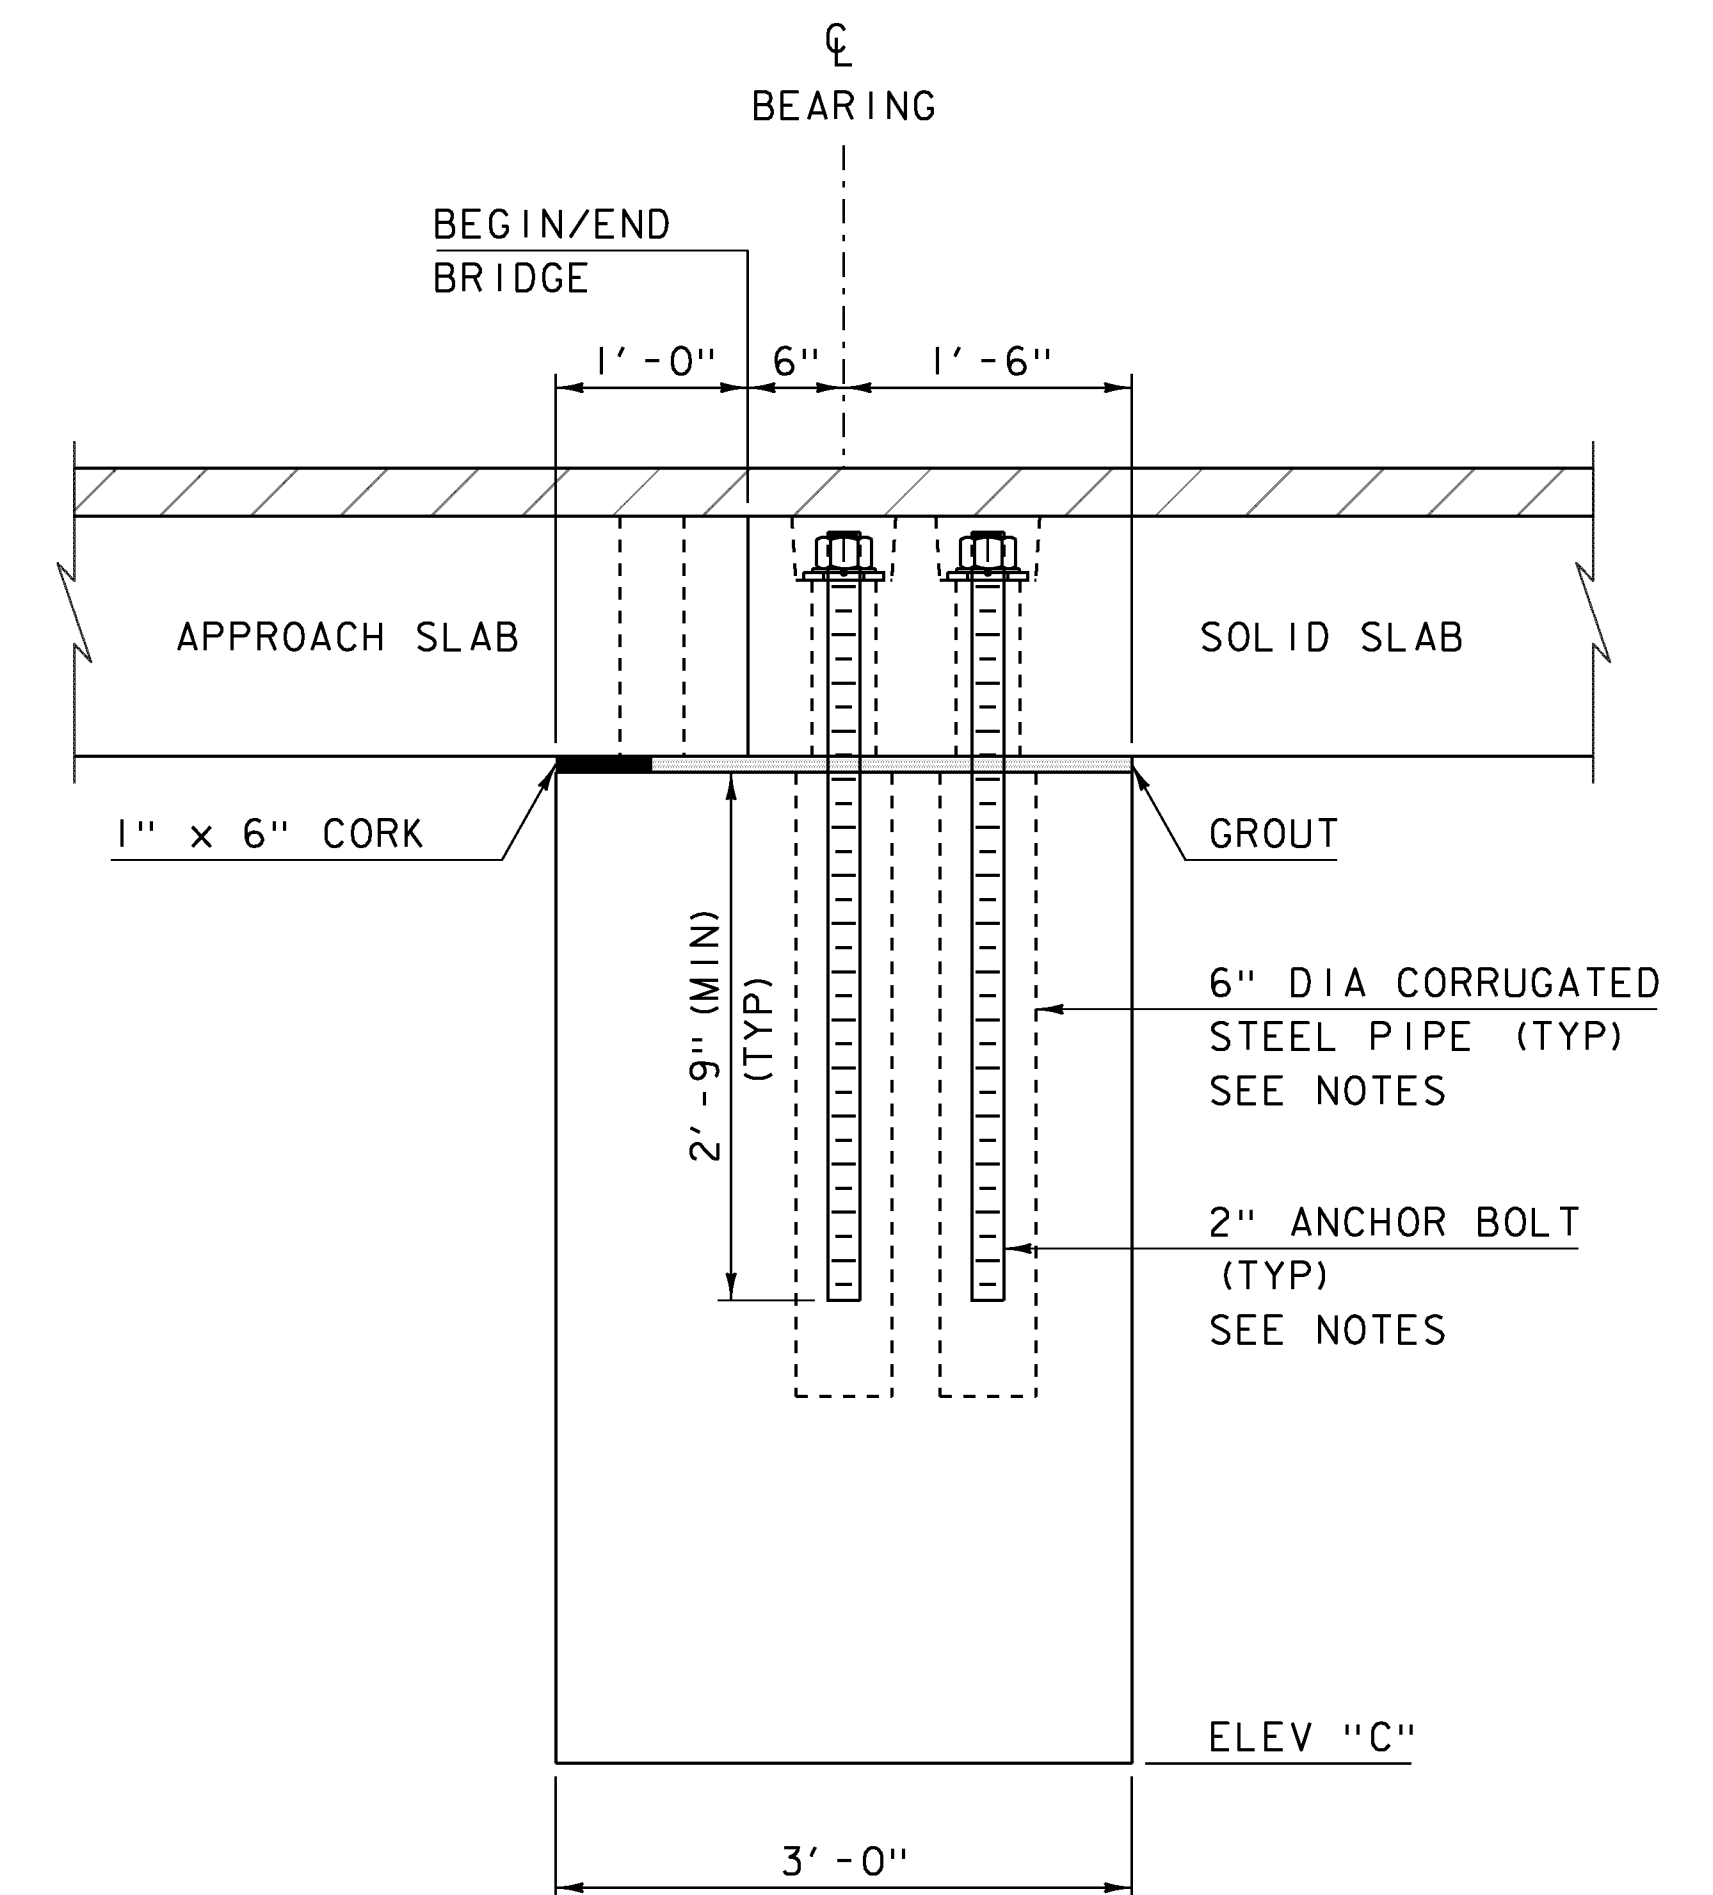

**ABUTMENT TYPICAL (PCU)**


SCALE 1" = 1'-0"

PROJECT NAME:	FAIRFIELD	PLOT DATE:	11-SEP-2014
PROJECT NUMBER:	BRF 028(25)	PROJECT LEADER:	R. YOUNG
FILE NAME:	sl2j156sub.dgn	DESIGNED BY:	T. FILLBACH
		CHECKED BY:	R. KLINEFELTER
		ABUTMENT PLAN	SHEET 27 OF 69

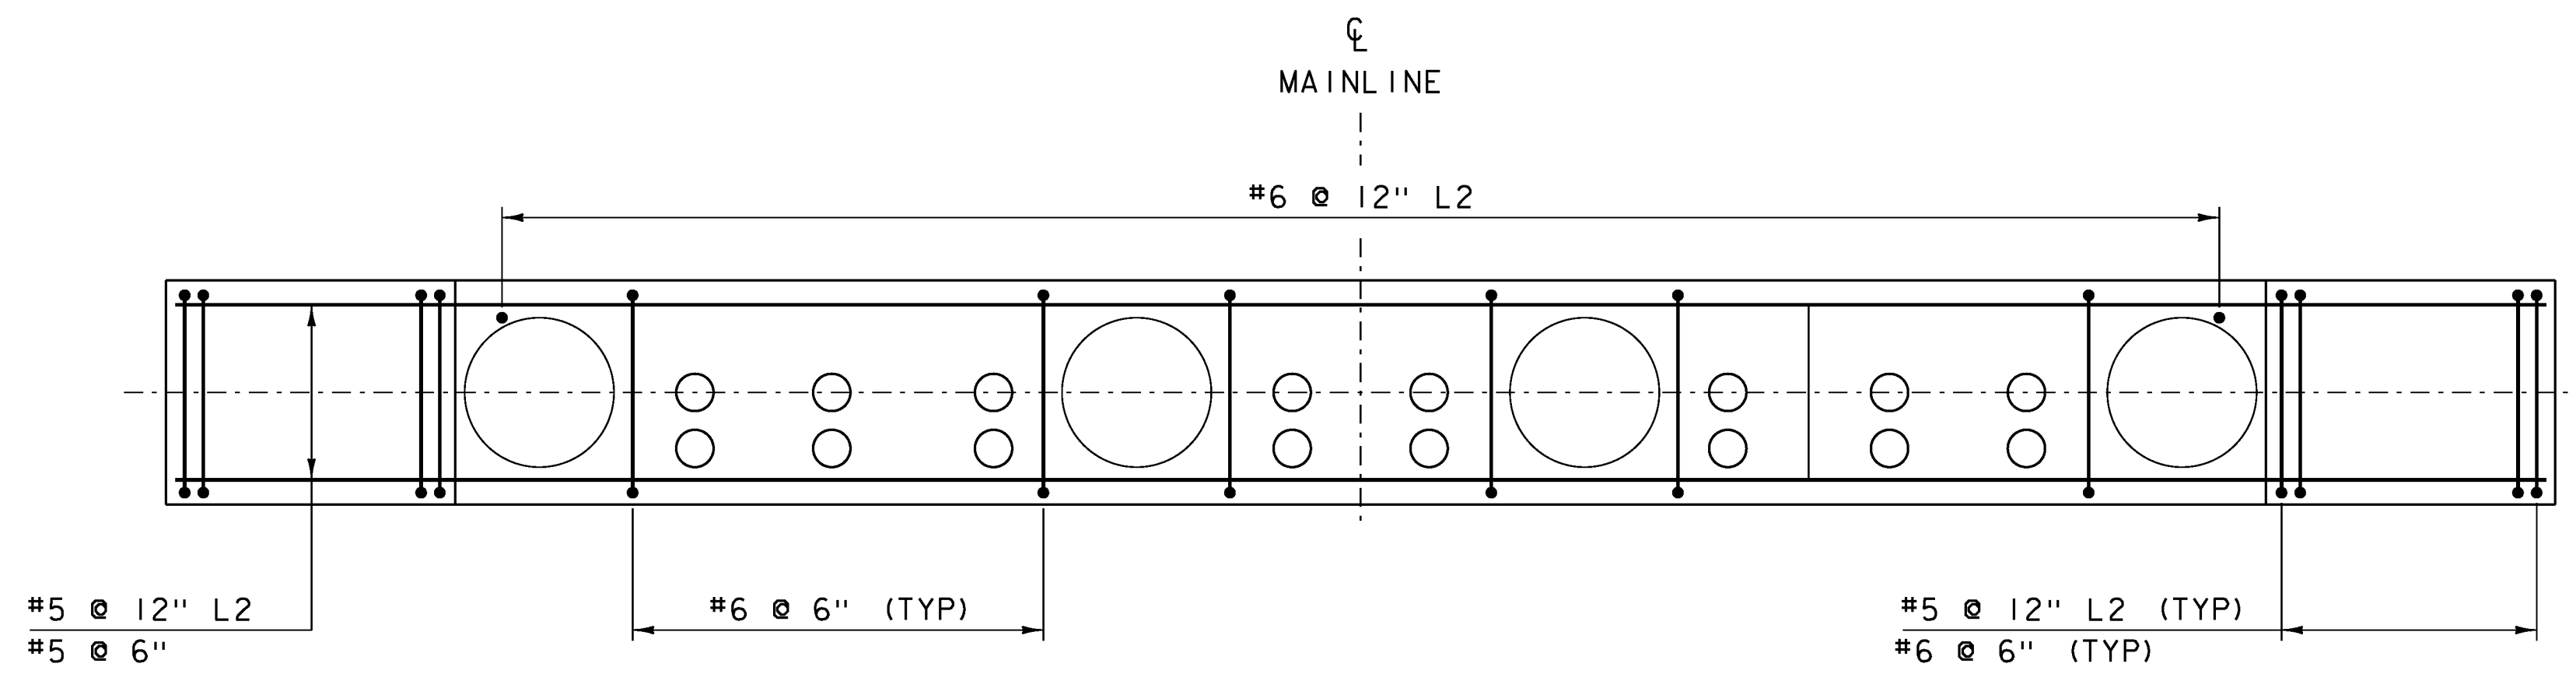

ABUTMENT REINFORCING PLAN (PCU)

SCALE 1/2" = 1'-0"

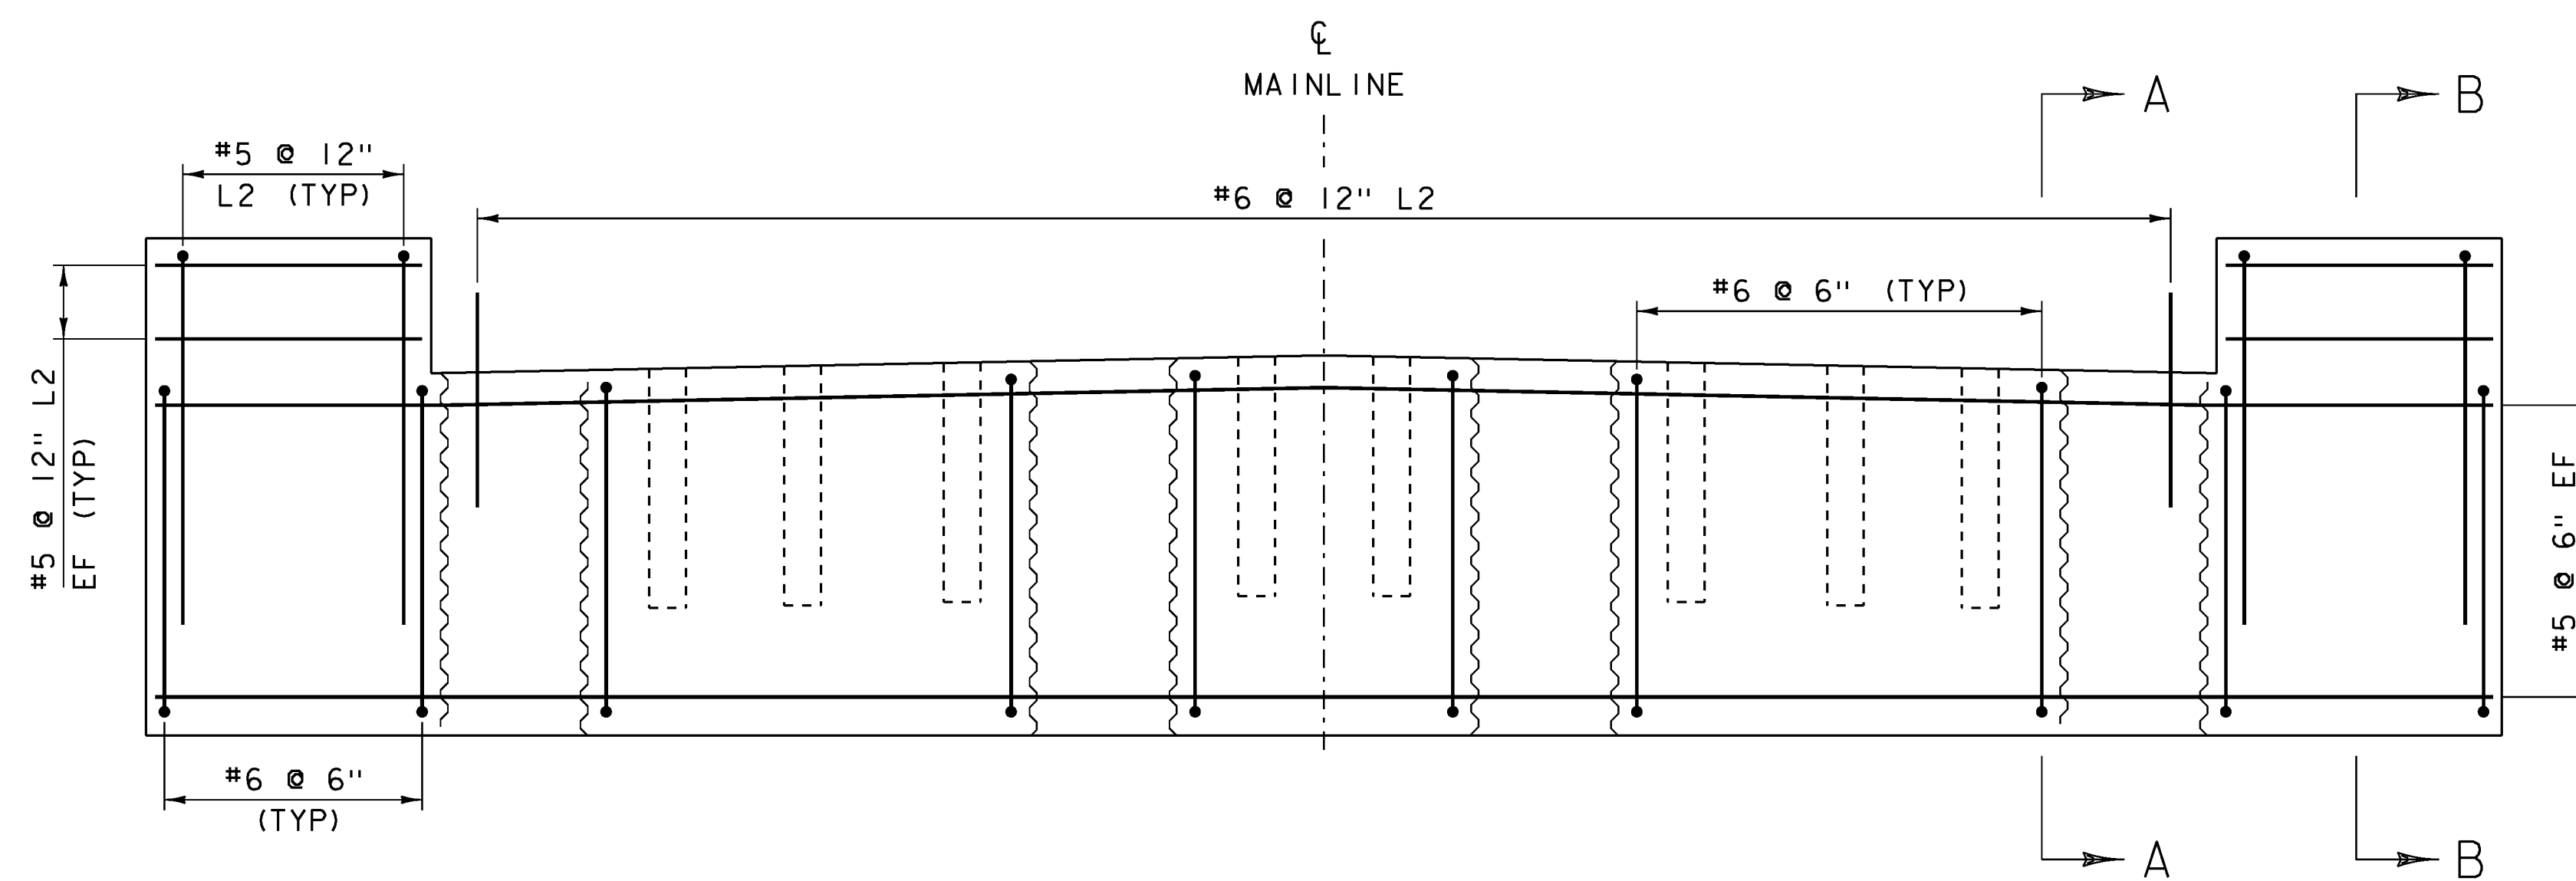


ABUTMENT REINFORCING ELEVATION (PCU)

SCALE 1/2" = 1'-0"


NOTES:

- 1) PCU 1 SHOWN, PCU 2 SIMILAR.
- 2) A TEMPLATE SHALL BE USED TO LAYOUT DOWEL DUCTS IN THE APPROACH SLABS. THE SAME TEMPLATE SHALL BE USED TO LAYOUT THE #6 @ 12" L2 APPROACH SLAB DOWELS IN THE ABUTMENTS.

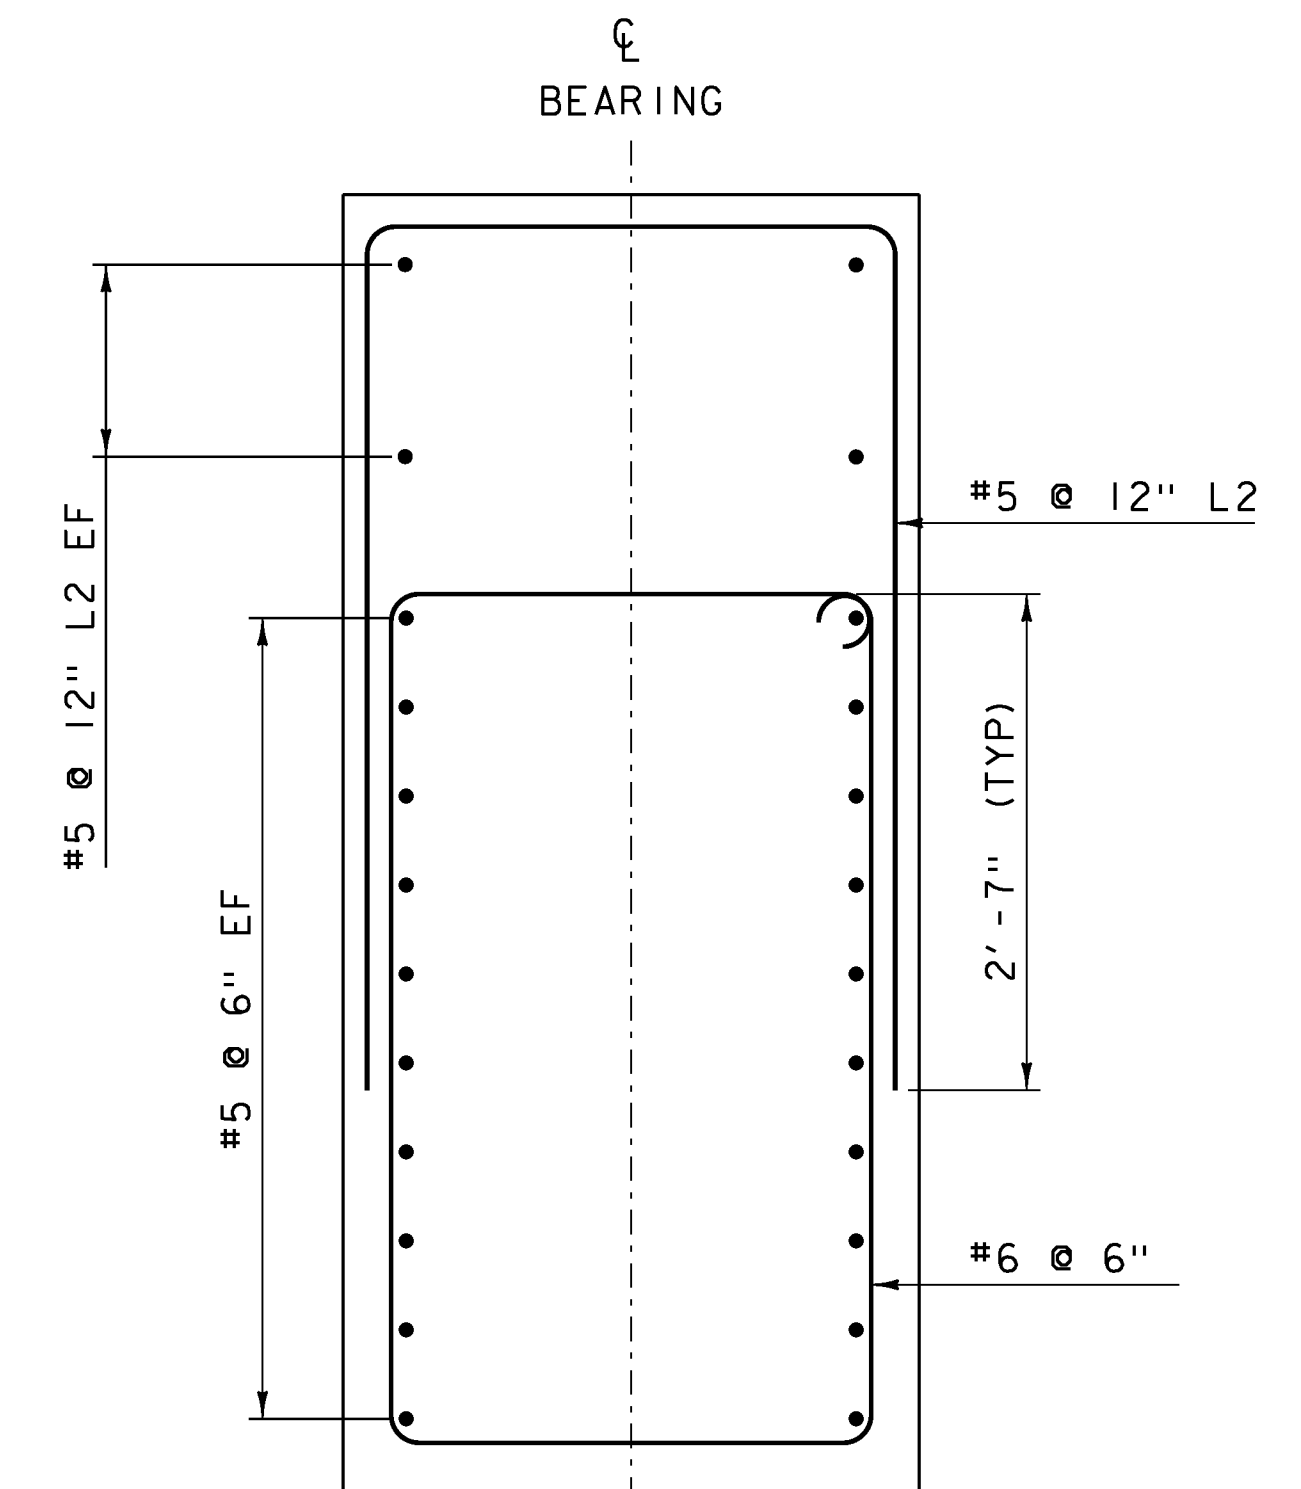

SECTION B-B

SCALE 1" = 1'-0"

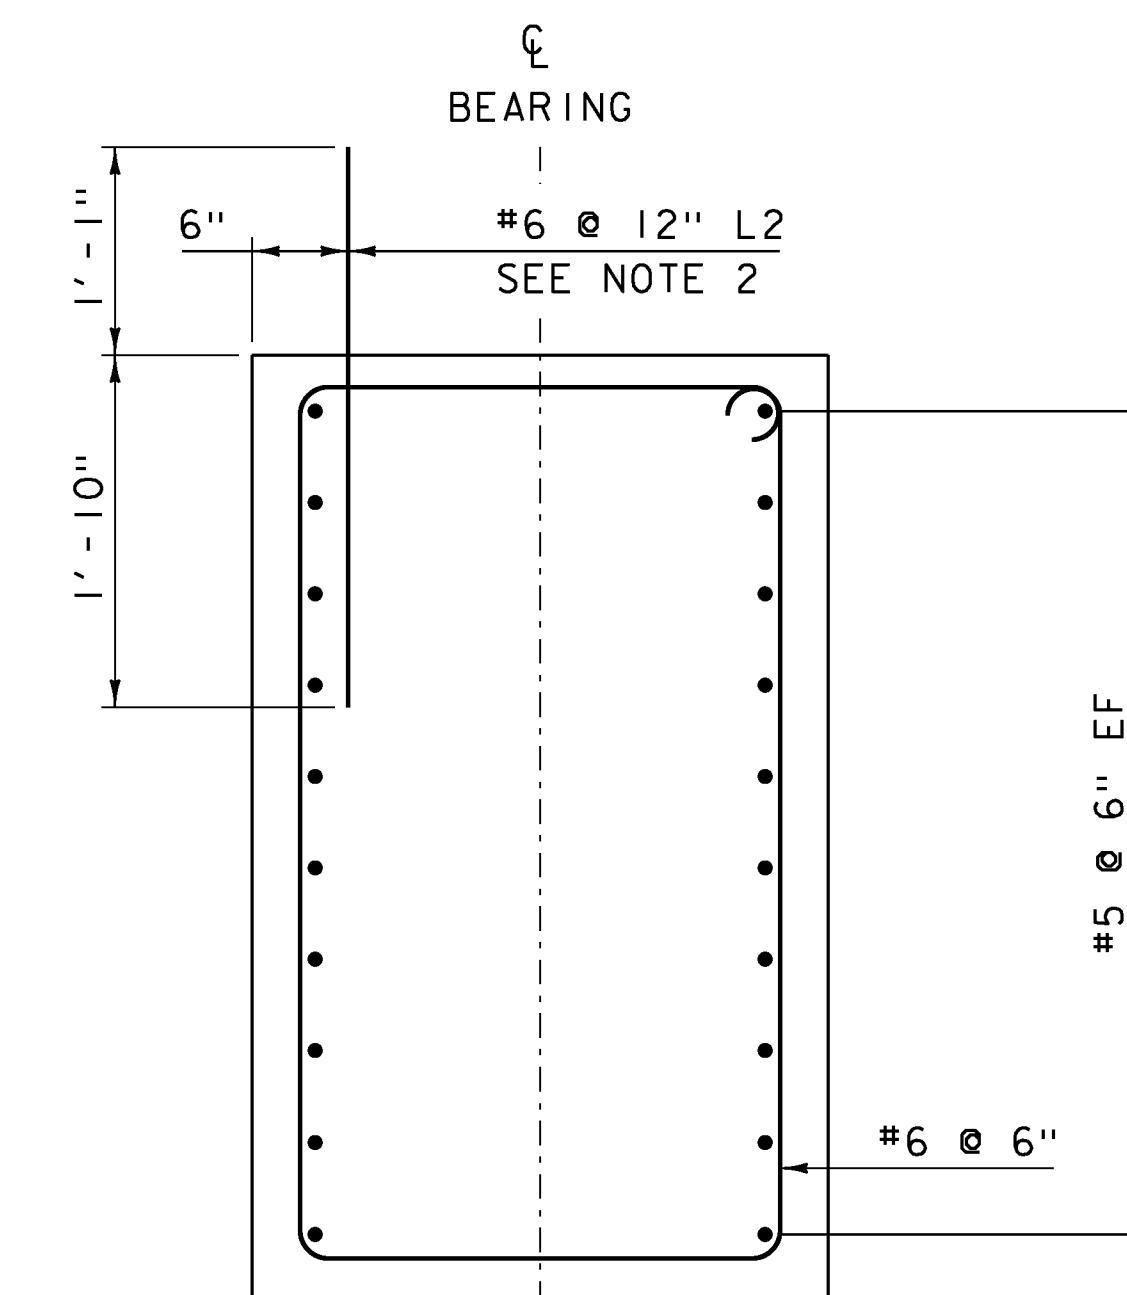

SECTION A-A

SCALE 1" = 1'-0"

NOTE:

L2 = LEVEL II REINFORCING  
 NF = NEAR FACE  
 FF = FAR FACE  
 EF = EACH FACE  
 ▲ = CUT TO FIT IN FIELD  
 3" CLEAR, UNLESS OTHERWISE SPECIFIED ON THE PLANS.  
 SPLICES NOT DETAILED SHALL BE DESIGNED

PROJECT NAME: FAIRFIELD  
 PROJECT NUMBER: BRF 028(25)

FILE NAME: sl2j156sub.dgn  
 PROJECT LEADER: R. YOUNG  
 DESIGNED BY: T. FILLBACH  
 ABUTMENT REINFORCING

PLOT DATE: 18-AUG-2014  
 DRAWN BY: K. FRIEDLAND  
 CHECKED BY: R. KLINEFELTER  
 SHEET 28 OF 69

## EPSC PLAN NARRATIVE

### 1.1 PROJECT DESCRIPTION

THIS PROJECT INVOLVES THE REMOVAL OF BRIDGE 14 IN ITS ENTIRETY. BRIDGE 14 WILL BE REPLACED WITH A NEW STRUCTURE, SPANNING 44 FEET OVER THE FAIRFIELD RIVER, ON NEW ABUTMENTS ALONG THE EXISTING ALIGNMENT. BRIDGE 14 IS LOCATED IN THE TOWN OF FAIRFIELD, ON TOWN HIGHWAY 1, APPROXIMATELY 2.5 MILES SOUTH OF THE INTERSECTION OF VT 36.

NOTE: AREA OF DISTURBANCE INCLUDES LIMITS OF EARTH DISTURBANCE WITHIN THE PROJECT AREA, AS WELL AS WASTE, BORROW AND STAGING AREAS, AND OTHER EARTH DISTURBING ACTIVITIES WITHIN OR DIRECTLY ADJACENT TO THE PROJECT LIMITS AS SHOWN ON THE ATTACHED EPSC PLAN.

TOTAL AREA OF DISTURBANCE AS SHOWN ON THE ATTACHED EPSC PLAN IS APPROXIMATELY 0.24 ACRES.

IT IS ANTICIPATED THAT THIS PROJECT WILL LAST ONE CONSTRUCTION SEASON.

### 1.2 SITE INVENTORY

#### 1.2.1 TOPOGRAPHY

THE TOPOGRAPHY OF THE AREA IS A FLOODPLAIN AND WETLANDS BUFFERED BY FARMLAND, WITH FORESTED AREAS NEARBY. TOWN HIGHWAY 1 IS THE ONLY ROADWAY WITHIN THE PROJECT SITE. TOWN HIGHWAYS 3, 61, AND 62 ARE ALL NEARBY THE PROJECT SITE. THERE ARE NO RESIDENCES NEAR THE PROJECT.

#### 1.2.2 DRAINAGE, WATERWAYS, BODIES OF WATER, AND PROXIMITY TO NATURAL OR MAN-MADE WATER FEATURES

THE FAIRFIELD RIVER IS THE ONLY WATER SOURCE ON THE PROJECT SITE. THE RIVER IS CLASSIFIED AS INCISED AND ALLUVIAL. THE STREAM BED CONSISTS OF SILT, SAND AND GRAVEL. THE TRIBUTARY AREA AT THE BRIDGE IS 7.9 MILES².

#### 1.2.3 VEGETATION

THE VEGETATION IN THE PROJECT AREA CONSISTS OF SOFTWOOD TREES AND UNDERGROWTH AS WELL AS WHATEVER CROP HAS BEEN PLANTED. THE IMPACT TO VEGETATION WILL BE LIMITED TO THAT WHICH IS DIRECTLY AFFECTED BY REPLACEMENT OF THE EXISTING BRIDGE. UPON PROJECT COMPLETION, THE CHANNEL WILL BE ARMORED WITH STONE FILL TYPE 3 AS SPECIFIED ON THE PLANS. DISTURBED VEGETATION WILL BE REESTABLISHED WITH STANDARD SEED AND MULCH PRACTICES.

#### 1.2.4 SOILS

ALL SOIL DATA CAME FROM THE U.S. DEPARTMENT OF AGRICULTURE SOIL CONSERVATION SERVICE FOR THE COUNTY OF FRANKLIN, VERMONT. THE SOIL ON THE PROJECT SITE IS WINOOSKI SILT LOAM, 0% TO 3% SLOPES, "K FACTOR" = 0.49. THE SOIL IS CONSIDERED NOT HIGHLY ERODIBLE. NEAR THE SOUTHERN EDGE OF THE PLAN LIMITS THE SOIL IS WINDSOR LOAMY FINE SAND, 3% TO 8% SLOPES, "K FACTOR" = 0.17. NEAR THE NORTHERN EDGE OF THE PLAN LIMITS THE SOIL IS BINGHAMVILLE SILT LOAM, 0% TO 2% SLOPES, "K FACTOR" = 0.49. BOTH OF THESE SOILS ARE CONSIDERED NOT HIGHLY ERODIBLE.

NOTE: K-VALUES GENERALLY INDICATE THE FOLLOWING:

0.0-0.23 = LOW EROSION POTENTIAL  
0.24-0.36 = MODERATE EROSION POTENTIAL  
0.37 AND HIGHER = HIGH EROSION POTENTIAL

#### 1.2.5 SENSITIVE RESOURCE AREAS

CRITICAL HABITATS: NO  
HISTORICAL OR ARCHEOLOGICAL AREAS: YES, ARCHAEOLOGY TO THE NORTHEAST AND SOUTHEAST OF THE PROJECT.  
PRIME AGRICULTURAL LAND: NO  
THREATENED AND ENDANGERED SPECIES: NO  
WATER RESOURCE: FAIRFIELD RIVER.  
WETLANDS: YES, TO THE NORTHEAST AND SOUTHWEST OF THE PROJECT.

### 1.3 RISK EVALUATION

THIS PROJECT DOES NOT FALL UNDER THE JURISDICTION OF GENERAL PERMIT 3-9020 FOR STORMWATER RUNOFF FROM CONSTRUCTION SITES. SHOULD CHANGES PRIOR TO OR DURING CONSTRUCTION RESULT IN ONE OR MORE ACRES OF EARTH DISTURBANCE OR SHOULD THE PROJECT BECOME PART OF A LARGER PLAN OF DEVELOPMENT, THE CONTRACTOR WILL BE RESPONSIBLE FOR ANY ADDITIONAL PERMITTING.

### 1.4 EROSION PREVENTION AND SEDIMENT CONTROL

THE EROSION CONTROL PLANS ARE MEANT AS A GUIDELINE FOR PREVENTING EROSION AND CONTROLLING SEDIMENT TRANSPORT. THE PRINCIPLES OUTLINED IN THIS NARRATIVE CONSIST OF APPLYING MEASURES THROUGHOUT CONSTRUCTION OF THE PROJECT IN ORDER TO MINIMIZE SEDIMENT TRANSPORT TO THE RECEIVING WATERS. THE MEASURES INCLUDE STABILIZATION AND STRUCTURAL PRACTICES, STORM WATER CONTROLS AND OTHER POLLUTION PREVENTION PRACTICES. THEY HAVE BEEN PROPOSED BY THE DESIGNER AS A BASIS FOR PROTECTING RESOURCES AND WILL NEED TO BE BUILT UPON BASED ON THE SPECIFIC MEANS AND METHODS OF THE CONTRACTOR. REFER TO THE LOW RISK SITE HANDBOOK AND APPROPRIATE DETAIL SHEETS FOR SPECIFIC GUIDANCE AND CONSTRUCTION DETAILING.

ALL MEASURES SHALL BE REGULARLY MAINTAINED AND SHALL BE CHECKED FOR SEDIMENT BUILD-UP. SEDIMENT SHALL BE DISPOSED OF AT AN APPROVED SITE WHERE IT WILL NOT BE SUBJECT TO EROSION.

#### 1.4.1 MARK SITE BOUNDARIES

SITE BOUNDARIES AND AREAS CONSTRUCTION EQUIPMENT CAN ACCESS SHALL BE DELINEATED.

PROJECT DEMARCATION FENCING (PDF) SHALL BE USED TO PHYSICALLY MARK SITE BOUNDARIES, BARRIER FENCE SHALL BE USED INSTEAD OF PROJECT DEMARCATION FENCE WITHIN 100 FEET OF A WATER RESOURCE (STREAM, BROOK, LAKE, POND, WETLAND, ETC).

#### 1.4.2 LIMIT DISTURBANCE AREA

PREVENTING INITIAL SOIL EROSION BY MINIMIZING THE EXPOSED AREA IS MUCH MORE EFFECTIVE THAN TREATING ERODED SEDIMENT. EARTH DISTURBANCE CAN BE MINIMIZED THROUGH CONSTRUCTION PHASING BY ONLY OPENING UP EARTH AS NECESSARY. THIS CAN LIMIT THE AREA THAT WILL BE DISTURBED AND EXPOSED TO EROSION. EMPLOY TEMPORARY CONSTRUCTION STABILIZATION PRACTICES IN INCREMENTAL STAGES AS PHASES CHANGE. FOR PROJECTS WHICH FALL UNDER THE CONSTRUCTION GENERAL PERMIT, ONLY THE ACREAGE LISTED ON THE PERMIT AUTHORIZATION MAY BE EXPOSED AT ANY GIVEN TIME.

MAINTAINING VEGETATED BUFFERS ALONG STREAM BANKS, WETLANDS OR OTHER SENSITIVE AREAS IS A CRUCIAL EROSION AND SEDIMENT CONTROL MEASURE THAT SHOULD BE ESTABLISHED WHEREVER POSSIBLE.

#### 1.4.3 SITE ENTRANCE/EXIT STABILIZATION

TRACKING OF SEDIMENT ONTO PUBLIC HIGHWAYS SHALL BE MINIMIZED TO REDUCE THE POTENTIAL FOR RUNOFF ENTERING RECEIVING WATERS. INSTALLATION SHALL COINCIDE WITH THE CONTRACTORS PROGRESS SCHEDULE.

STABILIZED CONSTRUCTION ENTRANCES SHALL BE INSTALLED AS PROPOSED ON THE EPSC PLAN AND ANYWHERE EQUIPMENT WILL BE GOING FROM AREAS OF EXPOSED SOILS TO PAVED SURFACES.

#### 1.4.4 INSTALL SEDIMENT BARRIERS

SEDIMENT BARRIERS SHALL BE UTILIZED TO INTERCEPT RUNOFF AND ALLOW SUSPENDED SEDIMENT TO SETTLE OUT. THEY SHALL BE INSTALLED PRIOR TO ANY UP SLOPE WORK.

SILT FENCE WILL BE INSTALLED AS PROPOSED ON THE EPSC PLAN. WOVEN WIRE REINFORCED SILT FENCE SHALL BE USED INSTEAD OF SILT FENCE WITHIN 100 FEET UPSLOPE OF RECEIVING WATERS.

#### 1.4.5 DIVERT UPLAND RUNOFF

DIVERSIONARY MEASURES SHALL BE USED TO INTERCEPT RUNOFF FROM ABOVE THE CONSTRUCTION AND DIRECT IT AROUND THE DISTURBED AREA SO THAT CLEAN WATER DOES NOT BECOME MUDDIED WHILE TRAVELING OVER EXPOSED SOILS ON THE CONSTRUCTION SITE.

THE PROJECT AREA IS RELATIVELY FLAT. THEREFORE IT IS NOT ANTICIPATED THAT DIVERSION MEASURES WILL BE NECESSARY.

#### 1.4.6 SLOW DOWN CHANNELIZED RUNOFF

CHECK STRUCTURES SHALL BE UTILIZED TO REDUCE THE VELOCITY, AND THUS THE EROSION POTENTIAL, OF CONCENTRATED FLOW IN CHANNELS.

#### 1.4.7 CONSTRUCT PERMANENT CONTROLS

PERMANENT STORMWATER TREATMENT DEVICES SHALL BE INSTALLED AS SHOWN ON THE PLANS AND IN ACCORDANCE WITH PERMIT CONDITIONS.

#### 1.4.8 STABILIZE EXPOSED SOILS DURING CONSTRUCTION

ALL AREAS OF DISTURBANCE MUST HAVE TEMPORARY STABILIZATION IN PLACE WITHIN 48 HOURS OF DISTURBANCE OR IN ACCORDANCE WITH THE CONSTRUCTION GENERAL PERMIT 3-9020 AUTHORIZATION.

SURFACE ROUGHENING OF ALL EXPOSED SLOPES, COMBINED WITH TEMPORARY MULCHING, SHALL BE UTILIZED ON A REGULAR BASIS. BIODEGRADABLE EROSION CONTROL MATTING OR AN EQUIVALENT SHALL BE USED TO STABILIZE ALL SLOPES STEEPER THAN 1:3.

THE FORECAST OF RAINFALL EVENTS SHALL TRIGGER IMMEDIATE PROTECTION OF EXPOSED SOILS.

#### 1.4.9 WINTER STABILIZATION

VARIOUS MEASURES SPECIFIC TO WINTER MAY BE NECESSARY SHOULD THE PROJECT EXTEND INTO WINTER (OCTOBER 15 THROUGH APRIL 15). REFER TO THE LOW RISK SITE HANDBOOK FOR GUIDANCE.

#### 1.4.10 STABILIZE SOIL AT FINAL GRADE

EXPOSED SOIL MUST BE STABILIZED WITHIN 48 HOURS OF REACHING FINAL GRADE.

SEED, MULCH, FERTILIZER AND LIME SHALL BE USED TO ESTABLISH PERMANENT VEGETATION. FOR SLOPES STEEPER THAN 1:3, BIODEGRADABLE EROSION CONTROL MATTING OR AN EQUIVALENT SHALL BE USED INSTEAD OF MULCH.

#### 1.4.11 DE-WATERING ACTIVITIES

DISCHARGE FROM DEWATERING ACTIVITIES THAT FLOWS OFF OF THE CONSTRUCTION SITE MUST NOT CAUSE OR CONTRIBUTE TO A VIOLATION OF THE VERMONT WATER QUALITY STANDARDS.

TREATMENT OF DEWATERING COFFERDAM IS NOT ANTICIPATED.

#### 1.4.12 INSPECT YOUR SITE

INSPECT THE PROJECT SITE BASED ON SPECIAL PROVISION REQUIREMENTS OR CONSTRUCTION GENERAL PERMIT AUTHORIZATION STIPULATIONS.

### 1.5 SEQUENCE AND STAGING

THIS SECTION WILL BE DEVELOPED BY THE CONTRACTOR USING THE GUIDANCE OUTLINED IN THE VTRANS EPSC PLAN CONTRACTOR CHECKLIST.

#### 1.5.1 CONSTRUCTION SEQUENCE

#### 1.5.2 OFF-SITE ACTIVITIES

IN ADDITION TO THE CONTRACTOR CHECKLIST ANY ACTIVITIES OUTSIDE THE CONSTRUCTION LIMITS SHALL FOLLOW SPECIFICATION 105.25- 105.29 OF THE STANDARD SPECIFICATIONS FOR CONSTRUCTION.



#### 1.5.3 UPDATES

PROJECT NAME: FAIRFIELD  
PROJECT NUMBER: BRF 028(25)

FILE NAME: sl2j156erode+atls.dgn  
PROJECT LEADER: R. YOUNG  
DESIGNED BY: R. KLINEFELTER  
EPSC NARRATIVE

PLOT DATE: 18-AUG-2014  
DRAWN BY: K. FRIEDLAND  
CHECKED BY: J. SALVATORI  
SHEET 29 OF 69

BINGHAMVILLE SILT LOAM  
 0-2% SLOPE  
 TYPE C SOIL  
 K VALUE = 0.49  
 NOT HIGHLY ERODIBLE

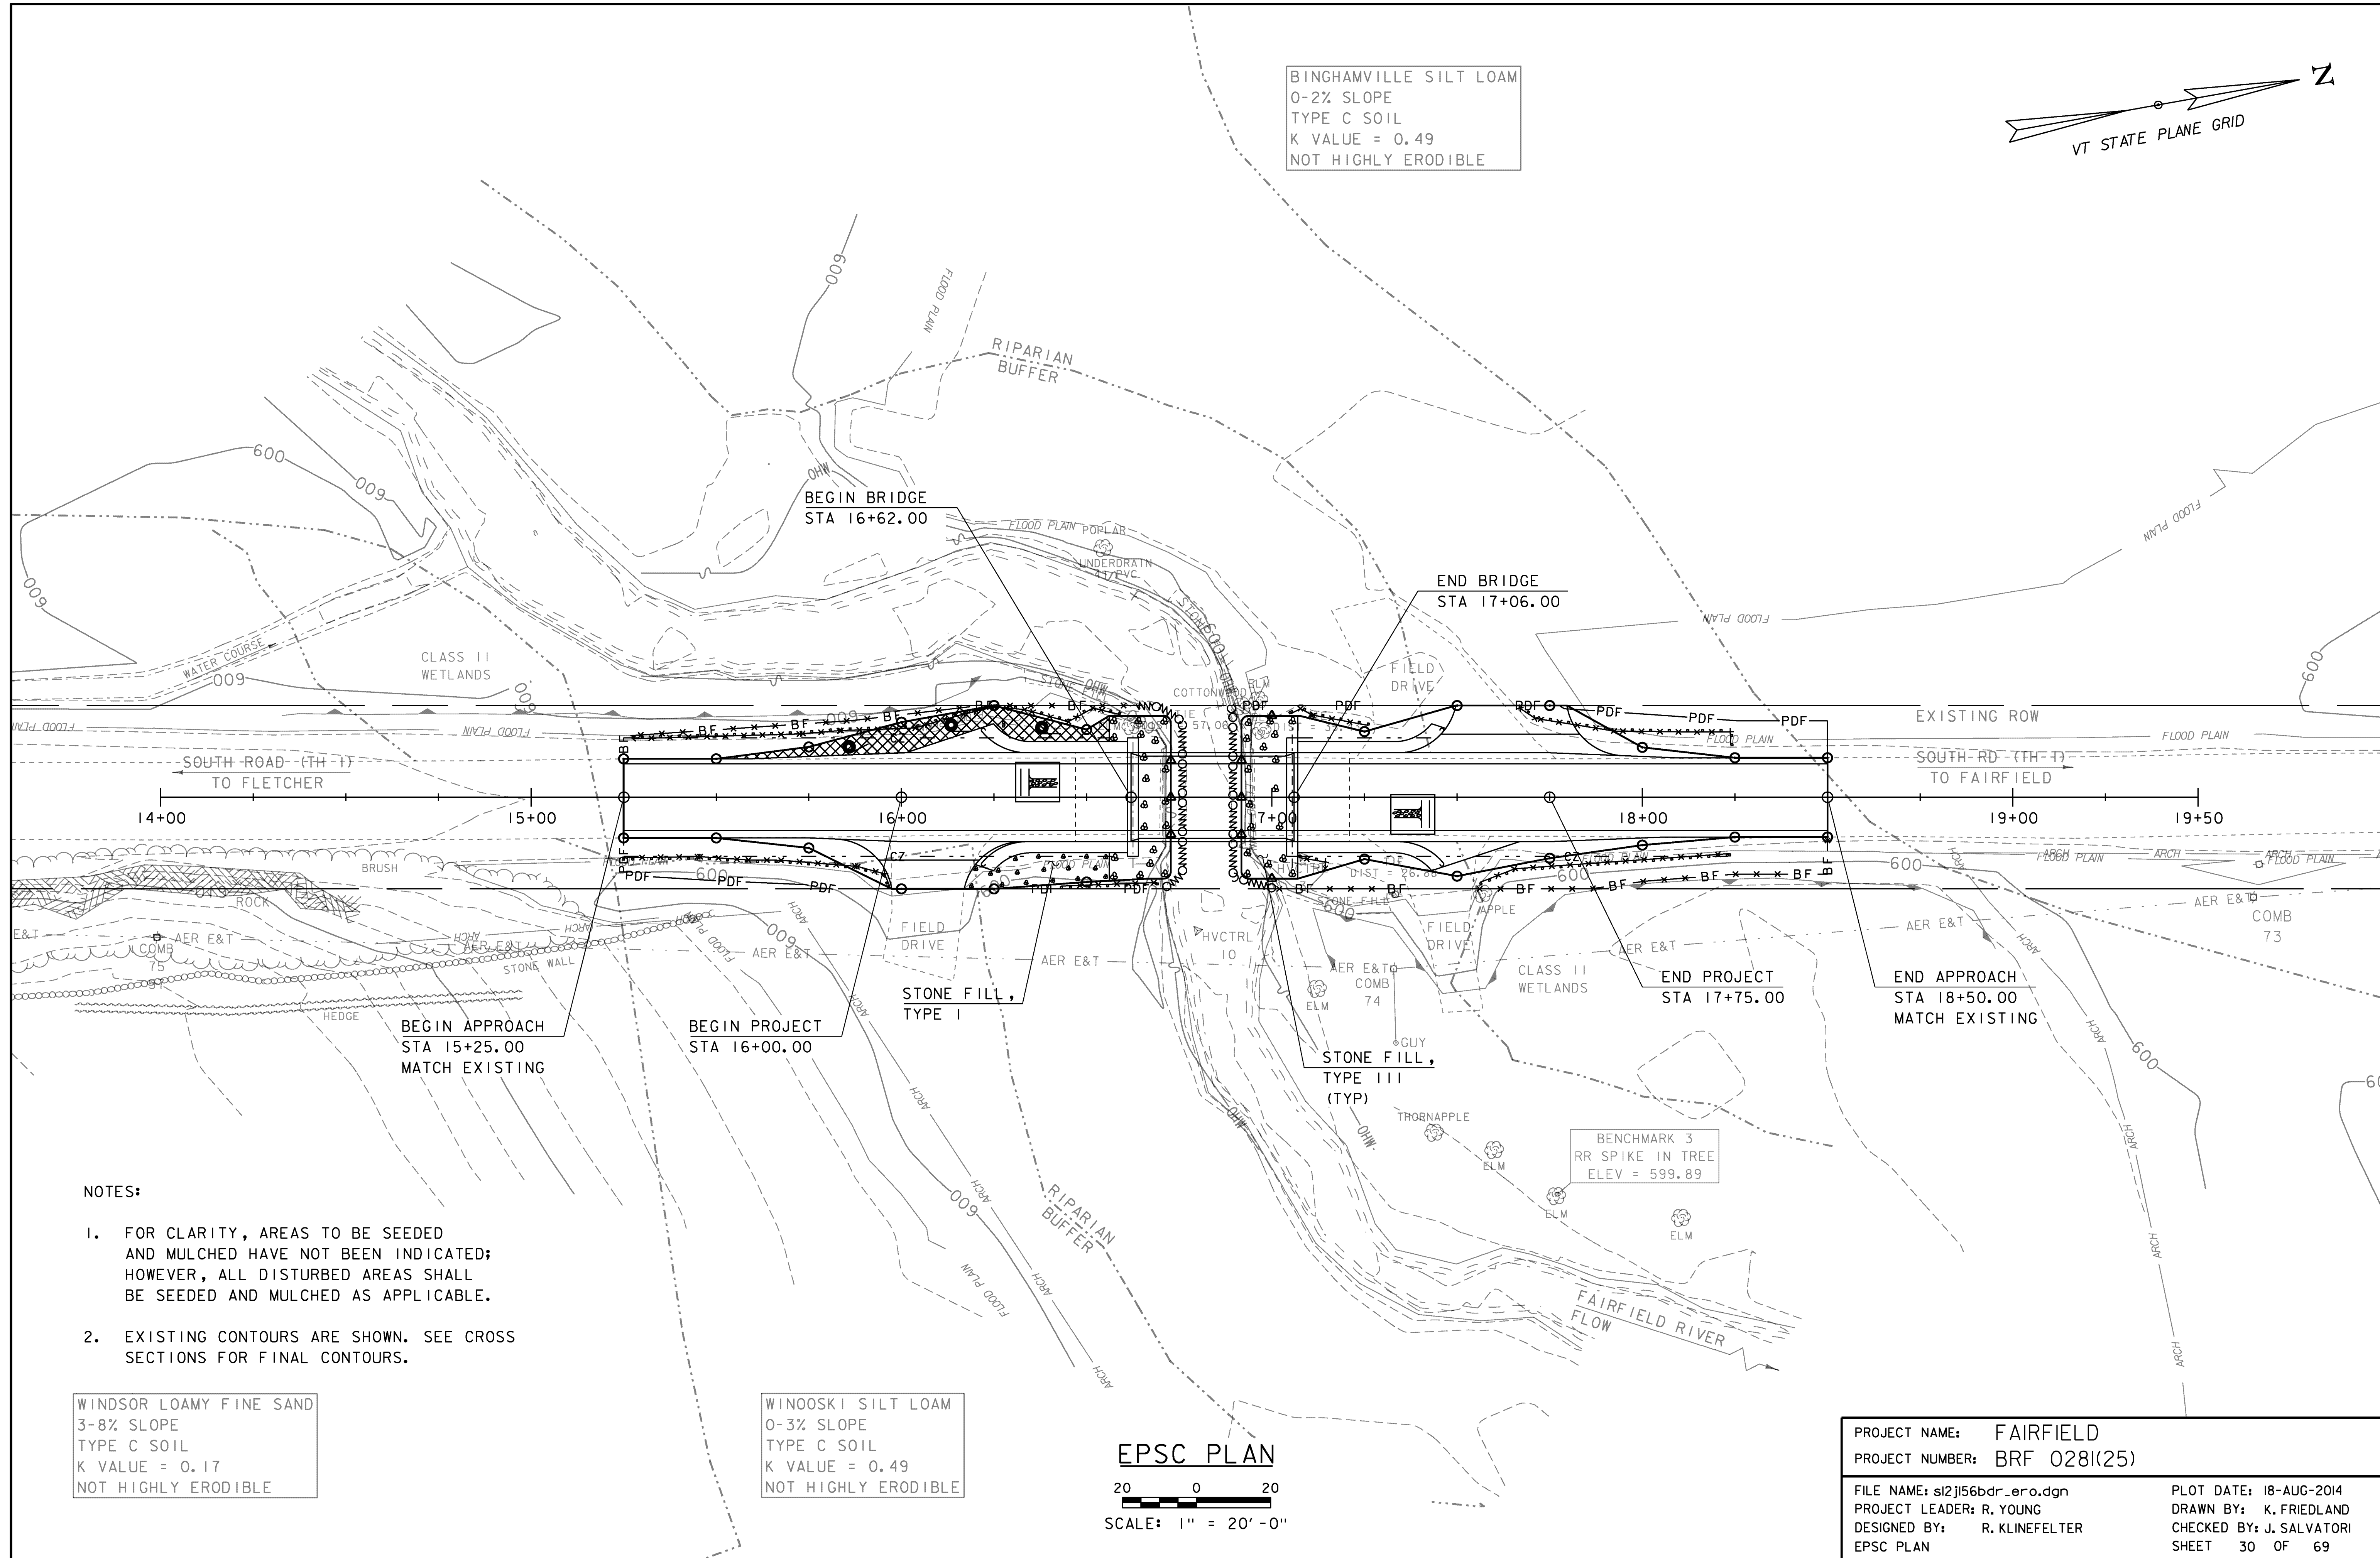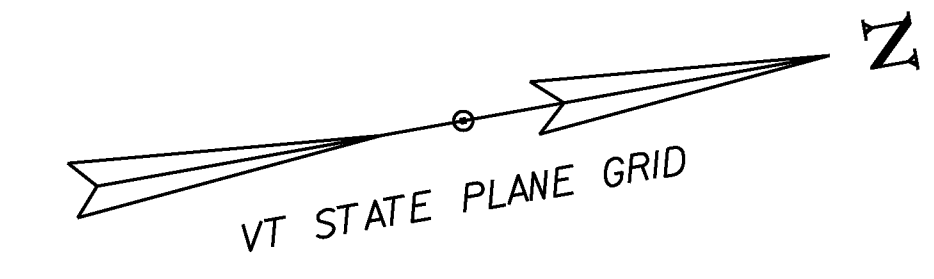



- NOTES:
- FOR CLARITY, AREAS TO BE SEEDED AND MULCHED HAVE NOT BEEN INDICATED; HOWEVER, ALL DISTURBED AREAS SHALL BE SEEDED AND MULCHED AS APPLICABLE.
  - EXISTING CONTOURS ARE SHOWN. SEE CROSS SECTIONS FOR FINAL CONTOURS.

WINDSOR LOAMY FINE SAND  
 3-8% SLOPE  
 TYPE C SOIL  
 K VALUE = 0.17  
 NOT HIGHLY ERODIBLE

WINOOSKI SILT LOAM  
 0-3% SLOPE  
 TYPE C SOIL  
 K VALUE = 0.49  
 NOT HIGHLY ERODIBLE

EPSC PLAN  
 20 0 20  
 SCALE: 1" = 20'-0"

PROJECT NAME: FAIRFIELD  
 PROJECT NUMBER: BRF 028(25)  
 FILE NAME: sl2j156bdr_ero.dgn  
 PROJECT LEADER: R. YOUNG  
 DESIGNED BY: R. KLINEFELTER  
 EPSC PLAN  
 PLOT DATE: 18-AUG-2014  
 DRAWN BY: K. FRIEDLAND  
 CHECKED BY: J. SALVATORI  
 SHEET 30 OF 69

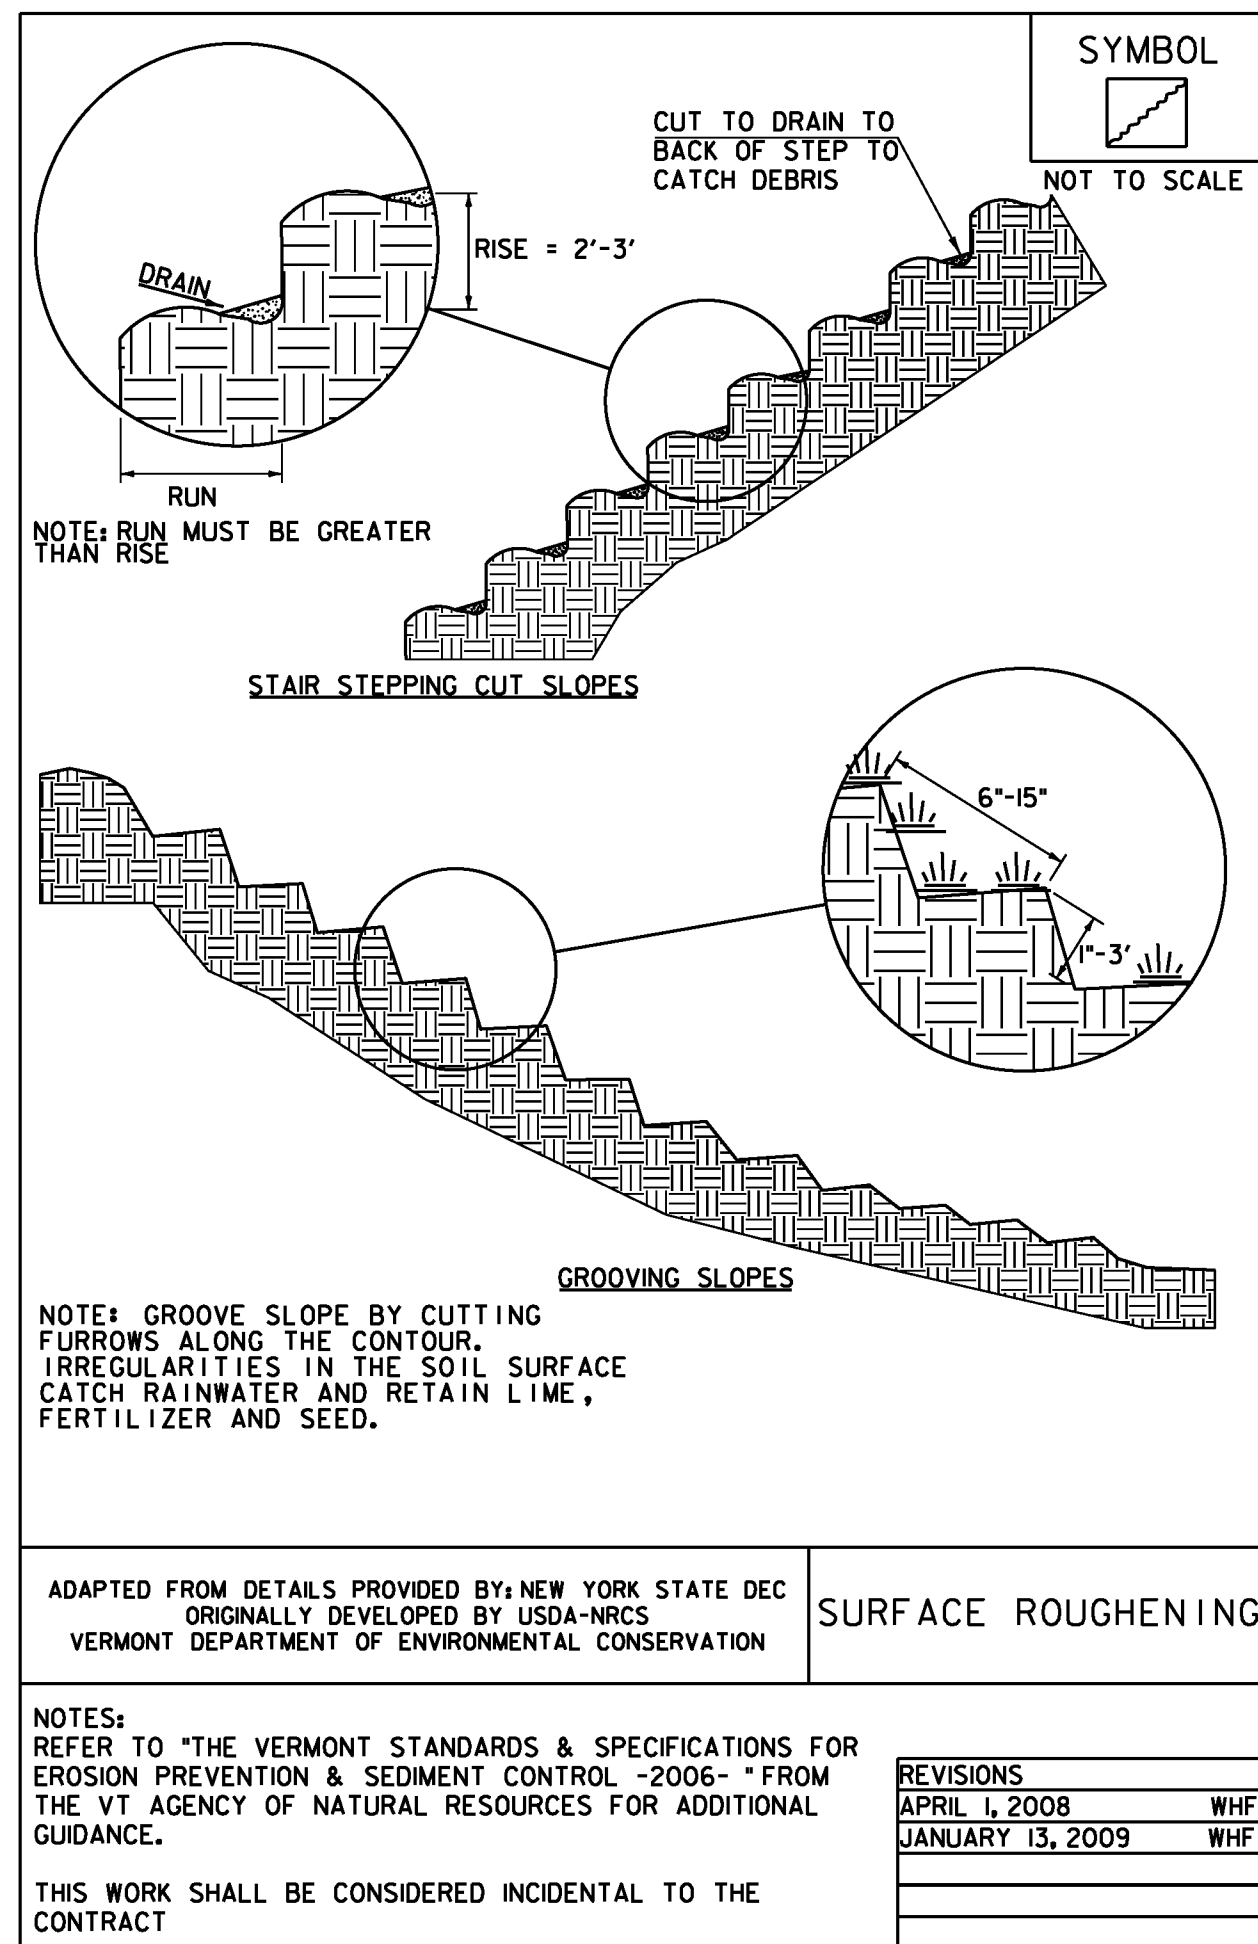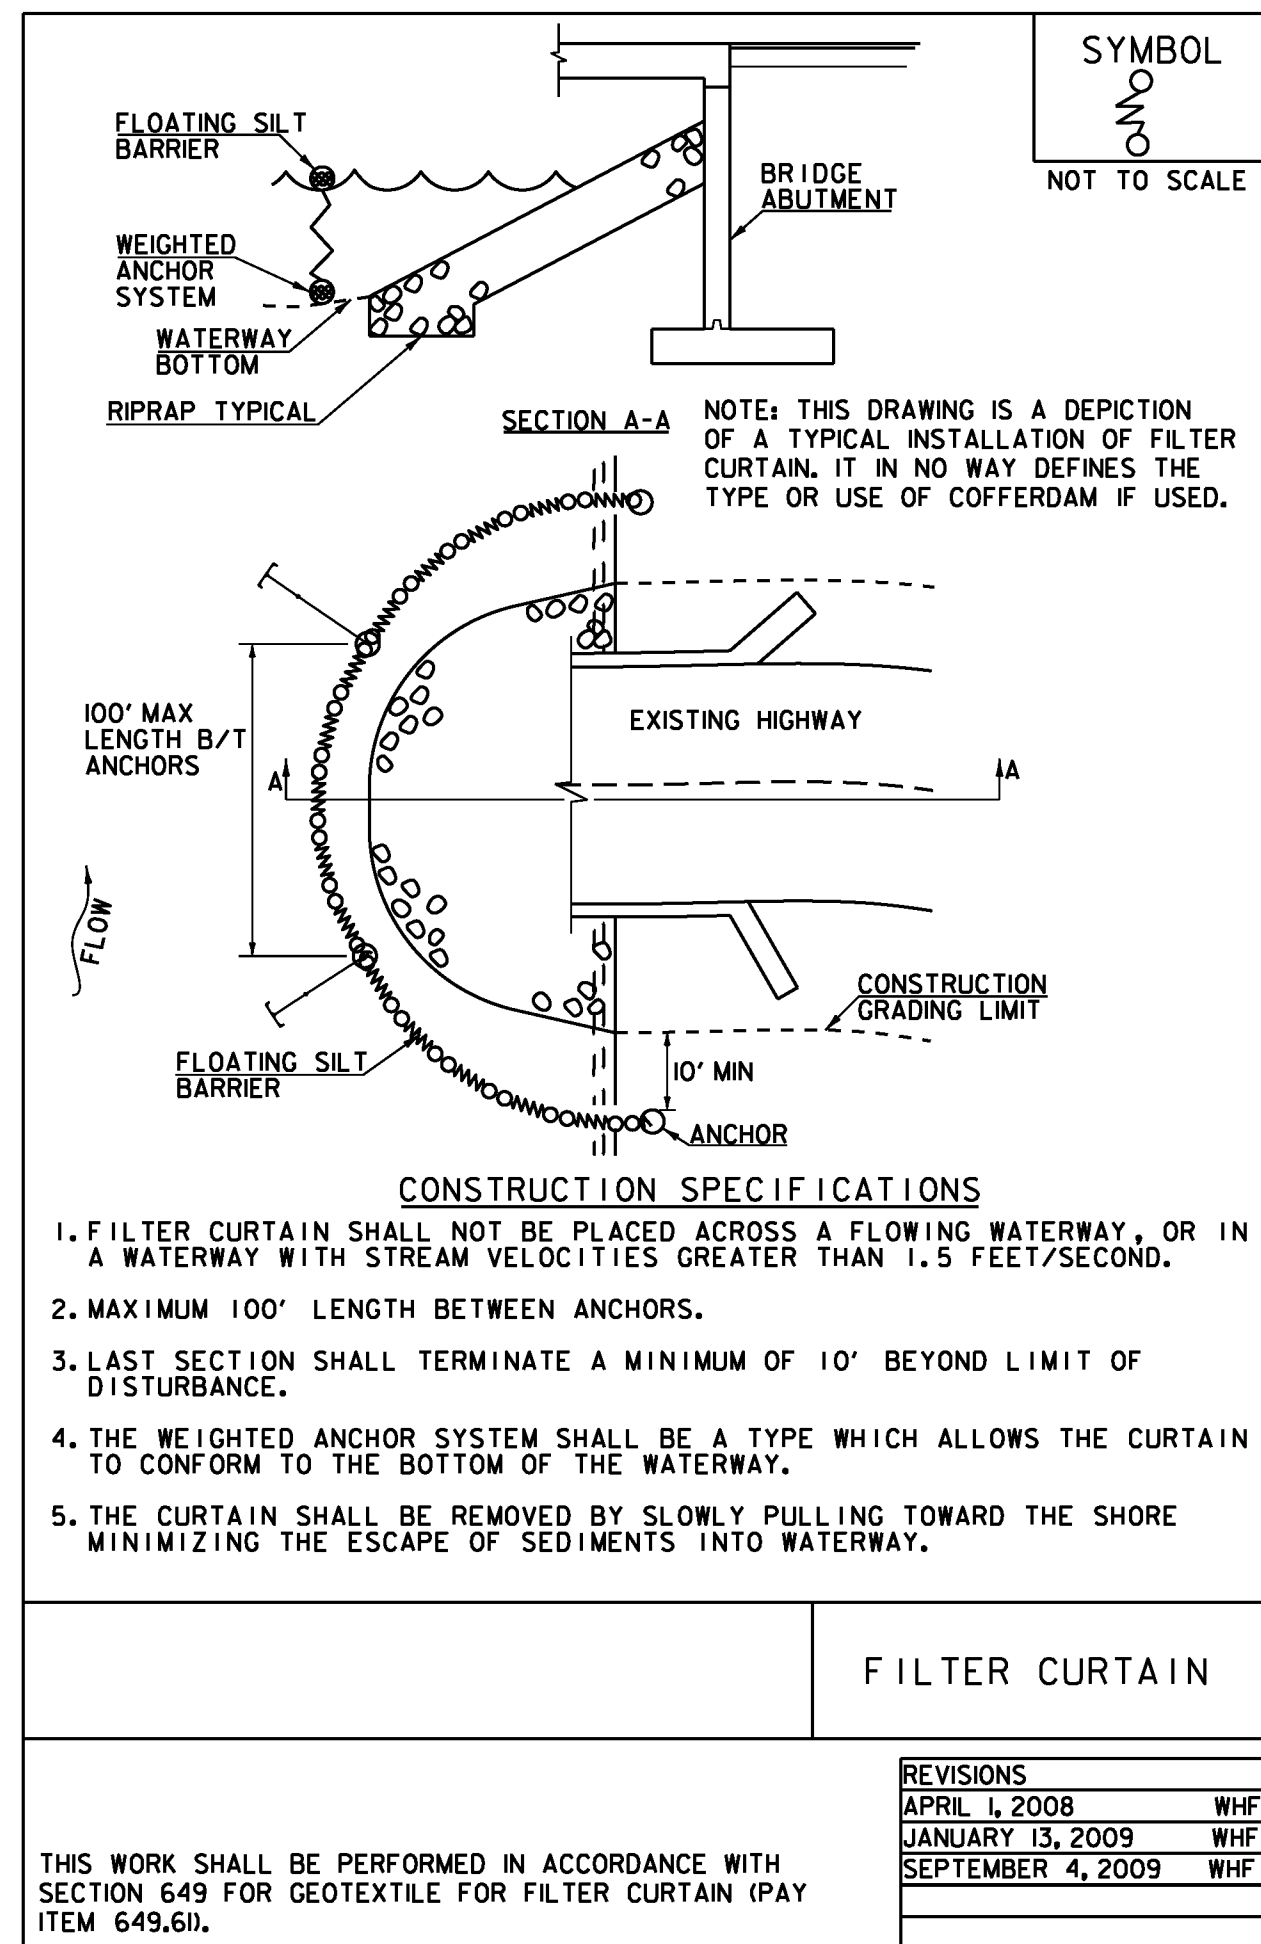

**VAOT RURAL AREA MIX**

% WEIGHT	BROADCAST	HYDROSEED	NAME	GERM %	PURITY %
37.5%	22.5	45	CREeping RED FESCUE	85%	98%
37.5%	22.5	45	TALL FESCUE	90%	95%
5.0%	3	6	RED TOP	90%	95%
15.0%	9	18	BIRDSFOOT TREFOIL	85%	98%
5.0%	3	6	ANNUAL RYE GRASS	85%	95%
100%	60	120			

**VAOT URBAN AREA MIX**

% WEIGHT	BROADCAST	HYDROSEED	NAME	GERM %	PURITY %
42.5%	34	68	CREeping RED FESCUE	85%	98%
10.0%	8	16	PERENNIAL RYE GRASS	90%	95%
42.5%	34	68	KENTUCKY BLUE GRASS	85%	85%
5.0%	4	8	ANNUAL RYE GRASS	85%	95%
100%	80	160			

**SOIL AMENDMENT GUIDANCE**

FERTILIZER		LIME	
BROADCAST	HYDROSEED	BROADCAST	HYDROSEED
10-20-10	FOLLOW	PELLETIZED	FOLLOW
500 LBS/AC	MANUFACTURER	2 TONS/AC	MANUFACTURER

**CONSTRUCTION GUIDANCE**




1. RURAL SEED MIX: USE AS INDICATED IN THE PLANS AND/OR FOR ALL ESTABLISHED UPLAND (NON WETLAND) AREAS DISTURBED BY THE CONTRACTOR.
2. URBAN SEED MIX: USE AS INDICATED IN THE PLANS AND/OR FOR ALL ESTABLISHED LAWN AREAS DISTURBED BY THE CONTRACTOR.
3. ALL SEED MIXTURES: SHALL NOT HAVE A WEED CONTENT EXCEEDING 0.40% BY WEIGHT AND SHALL BE FREE OF ALL NOXIOUS SEED.
4. FERTILIZER AND LIMESTONE: SHALL FOLLOW RATES SHOWN ON PLAN OR AS DIRECTED BY THE ENGINEER
5. HAY MULCH: TO BE PLACED ON EARTH SLOPES AT THE RATE OF 2 TONS/ACRE, ACHIEVE 90% GROUND COVER OR AS DIRECTED BY THE ENGINEER.
6. TOPSOIL: TO BE USED WITH SEED AS INDICATED ON THE PLANS, OR AS DIRECTED BY THE ENGINEER.
7. HYDROSEEDING: ALTHOUGH GUIDANCE IS GIVEN ABOVE THE SITE CONDITIONS AND THE TYPE OF HYDROSEED WILL ULTIMATELY DICTATE THE AMOUNTS AND TYPES OF SOIL AMENDMENTS TO BE APPLIED
8. TURF ESTABLISHMENT: PLACING SEED, FERTILIZER, LIME AND MULCH PRIOR TO SEPTEMBER 15 AND AFTER APRIL 15 CAN BETTER ENSURE A VIGOROUS GROWTH OF GRASS.

ADAPTED FROM VTTRANS TECHNICAL LANDSCAPE MANUAL FOR ROADWAYS AND TRANSPORTATION FACILITIES

**TURF ESTABLISHMENT**

THIS WORK SHALL BE PERFORMED IN ACCORDANCE WITH SECTION 651 FOR SEED (PAY ITEM 651.15)


REVISIONS  
JUNE 23, 2009 WHF  
JANUARY 15, 2010 WHF  
FEBRUARY 16, 2011 WHF

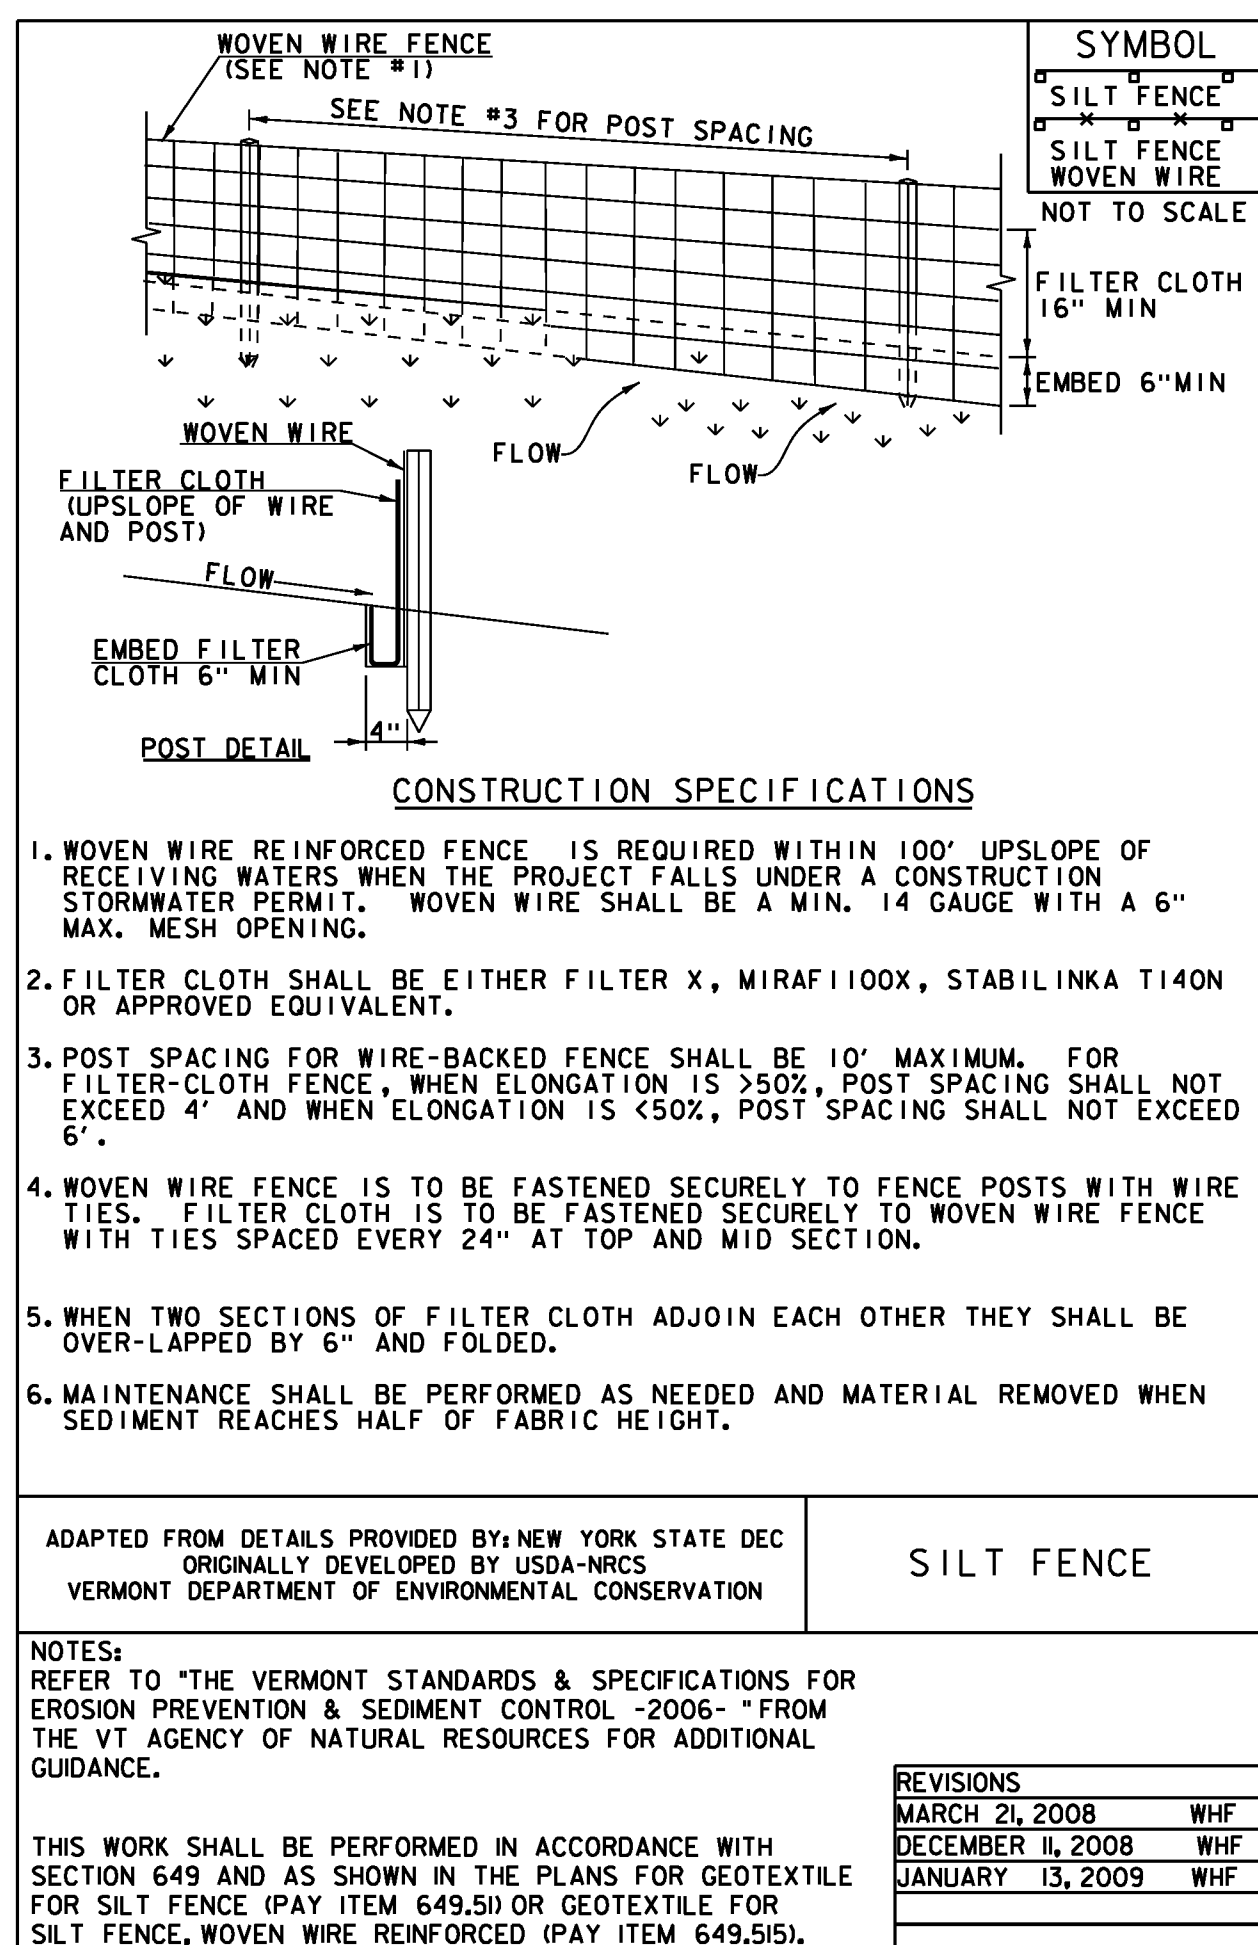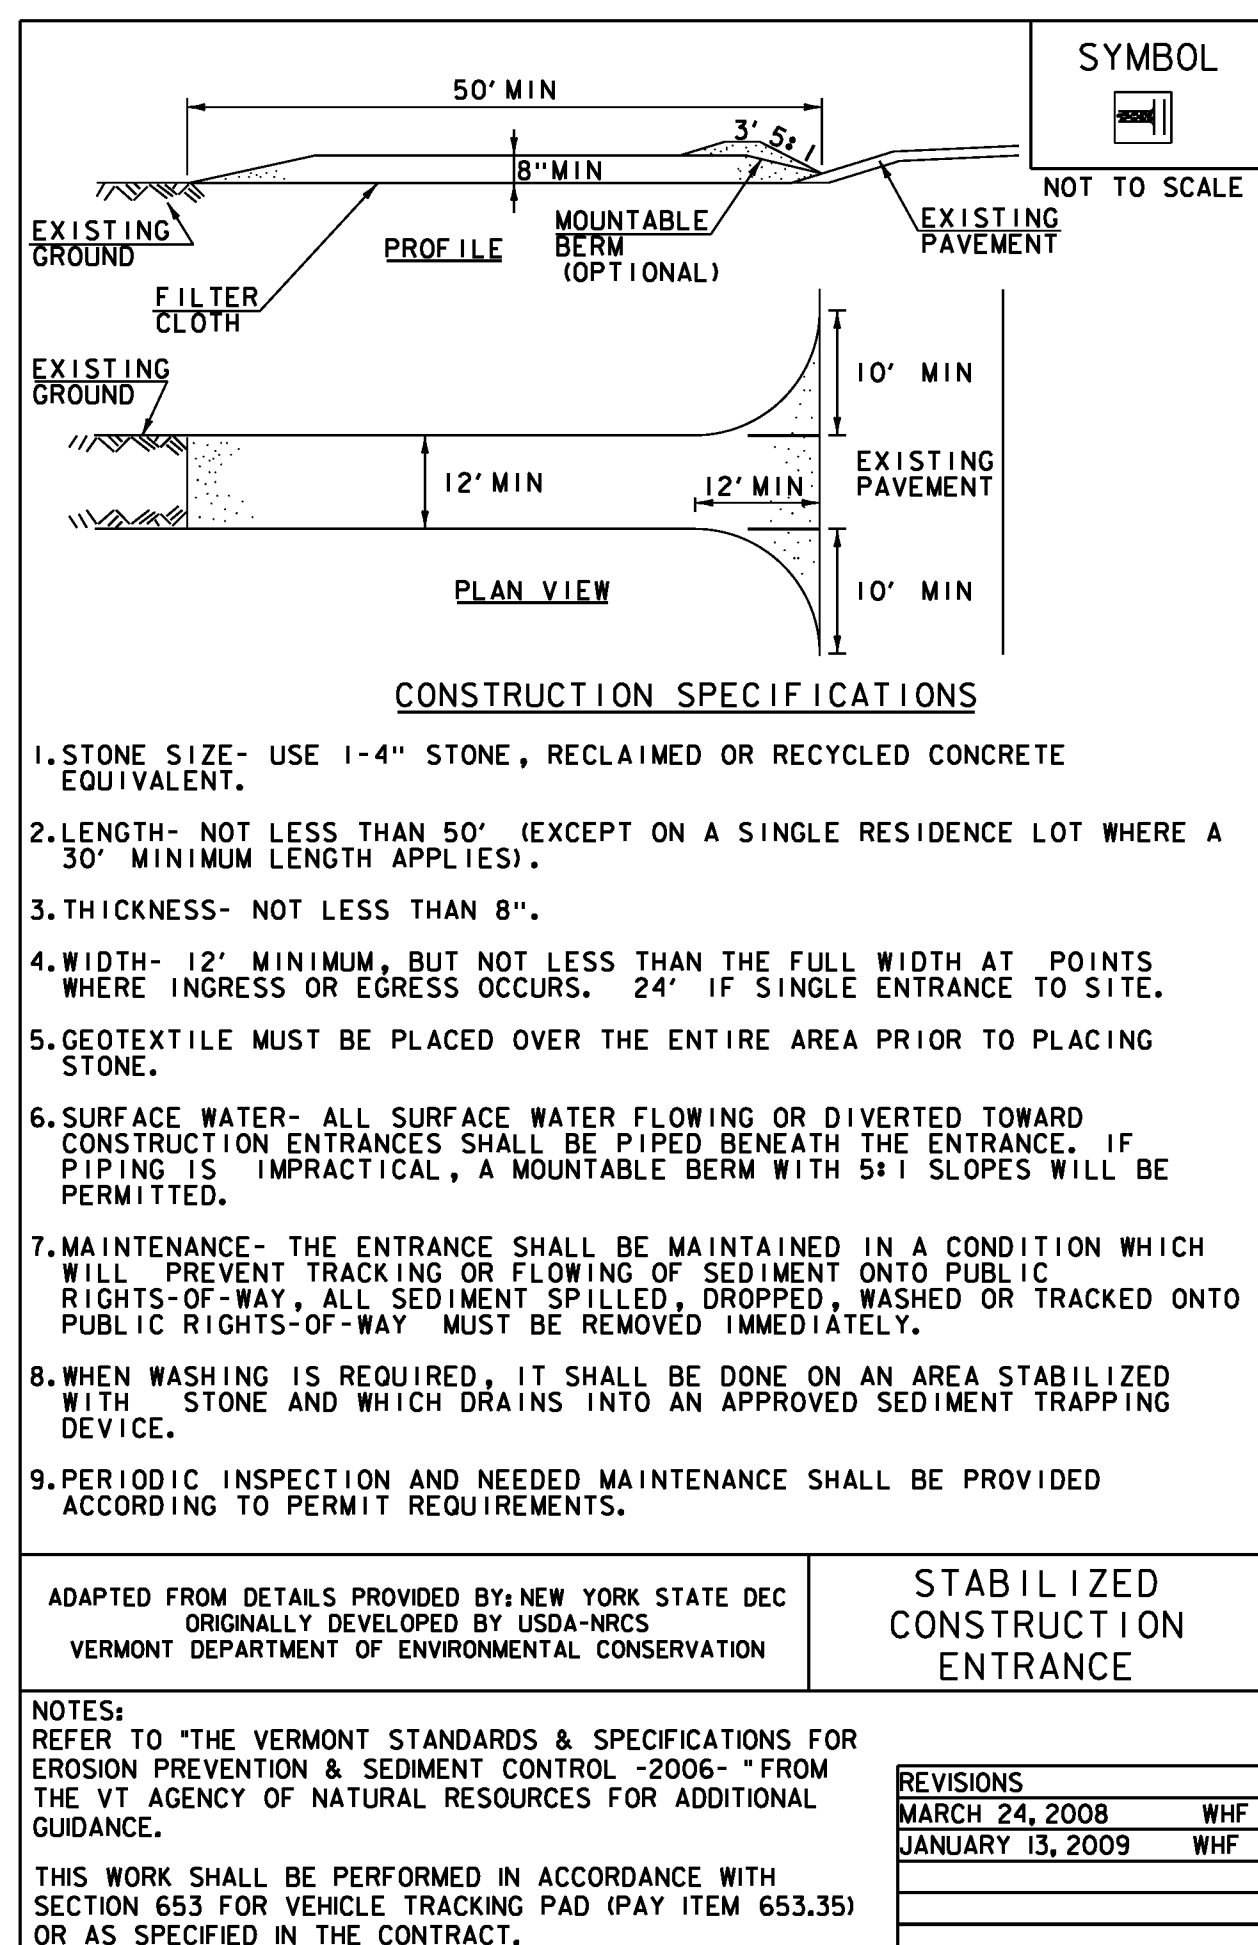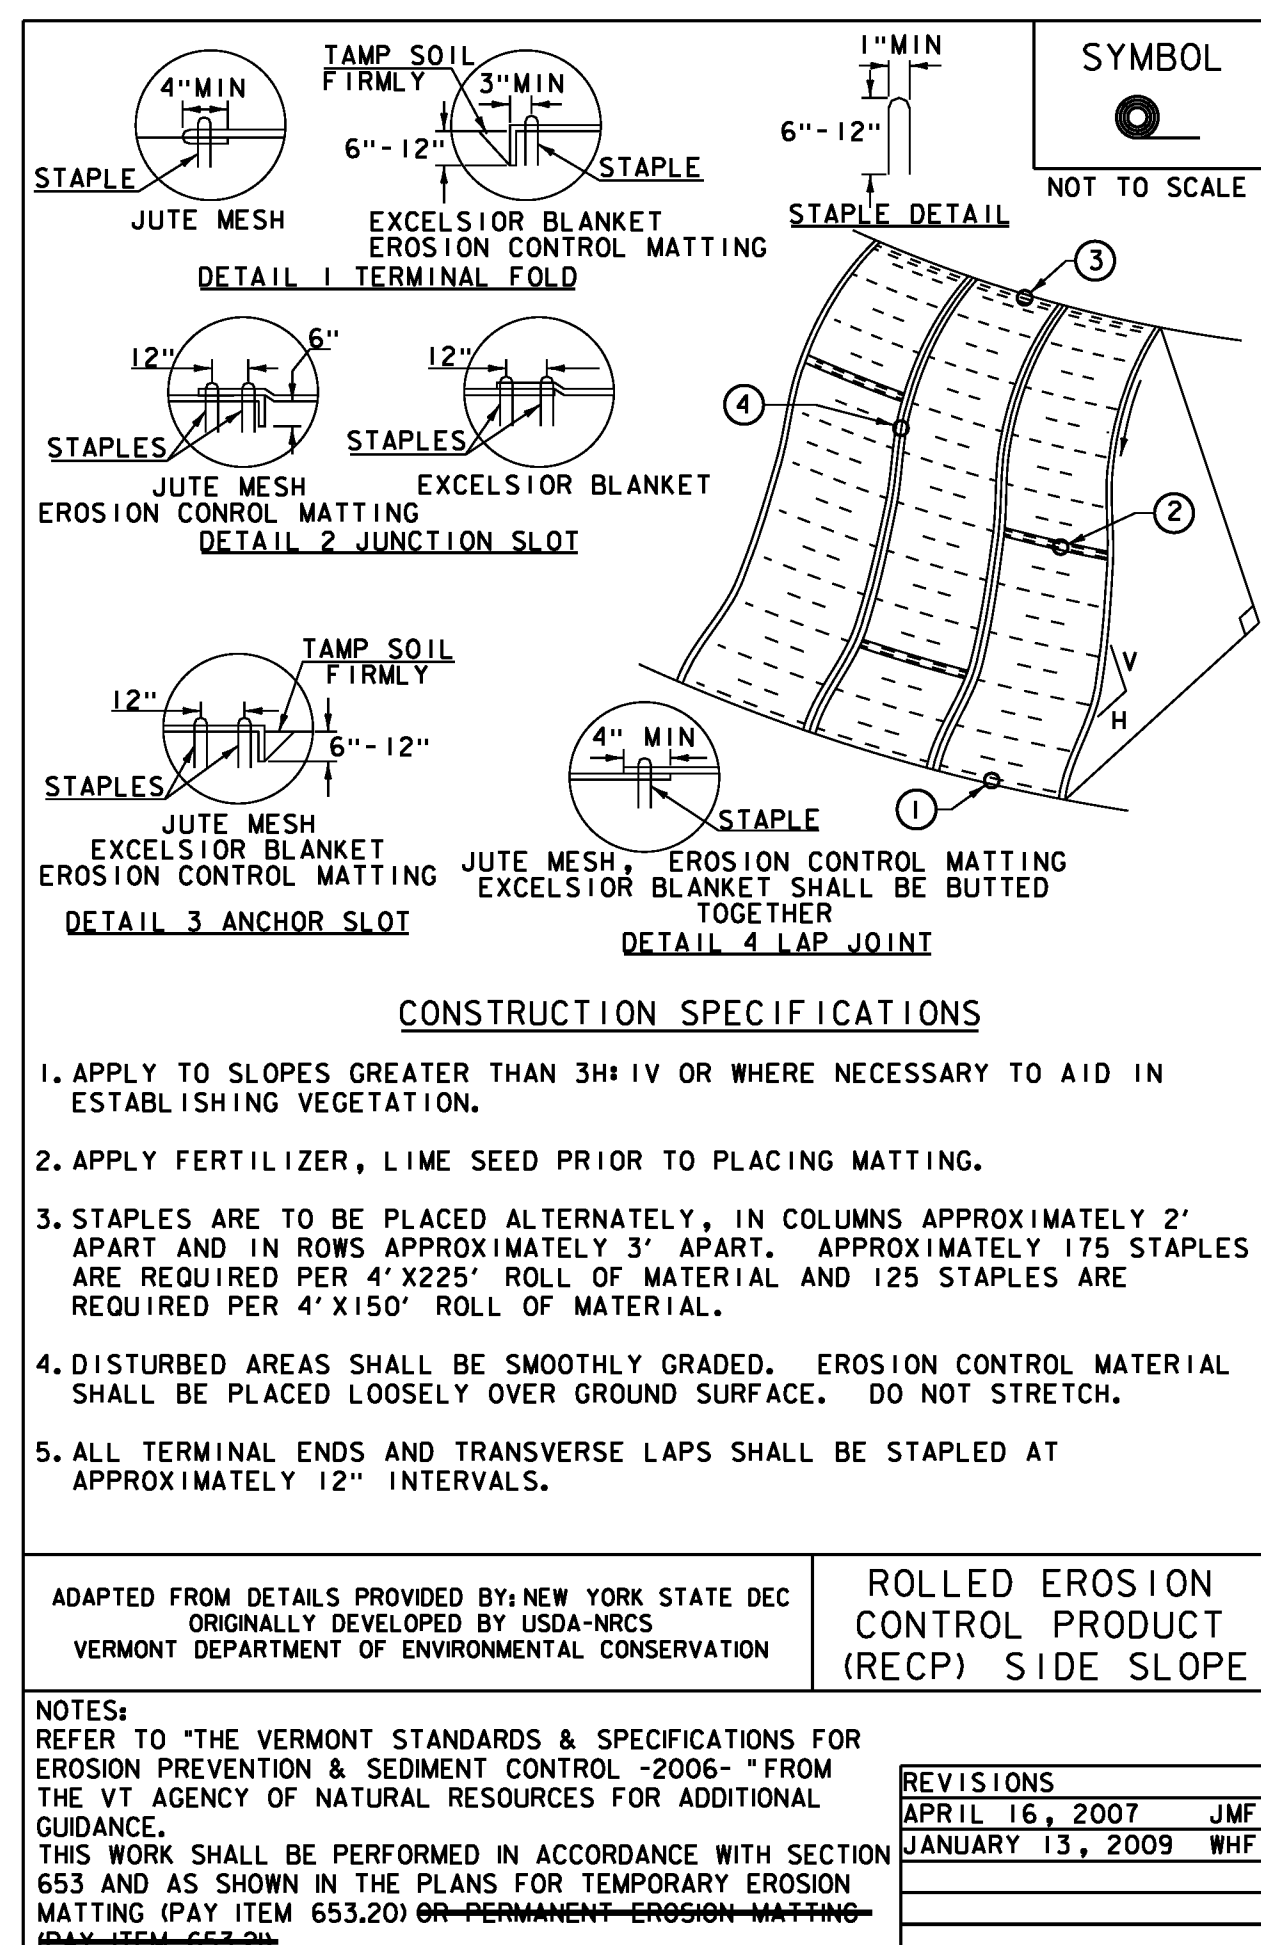


PROJECT NAME: FAIRFIELD  
PROJECT NUMBER: BRF 028(25)

FILE NAME: sl2j156erodetalis.dgn  
PROJECT LEADER: R. YOUNG  
DESIGNED BY: R. KLINEFELTER  
EPSC DETAILS


PLOT DATE: 18-AUG-2014  
DRAWN BY: K. FRIEDLAND  
CHECKED BY: J. SALVATORI  
SHEET 31 OF 69

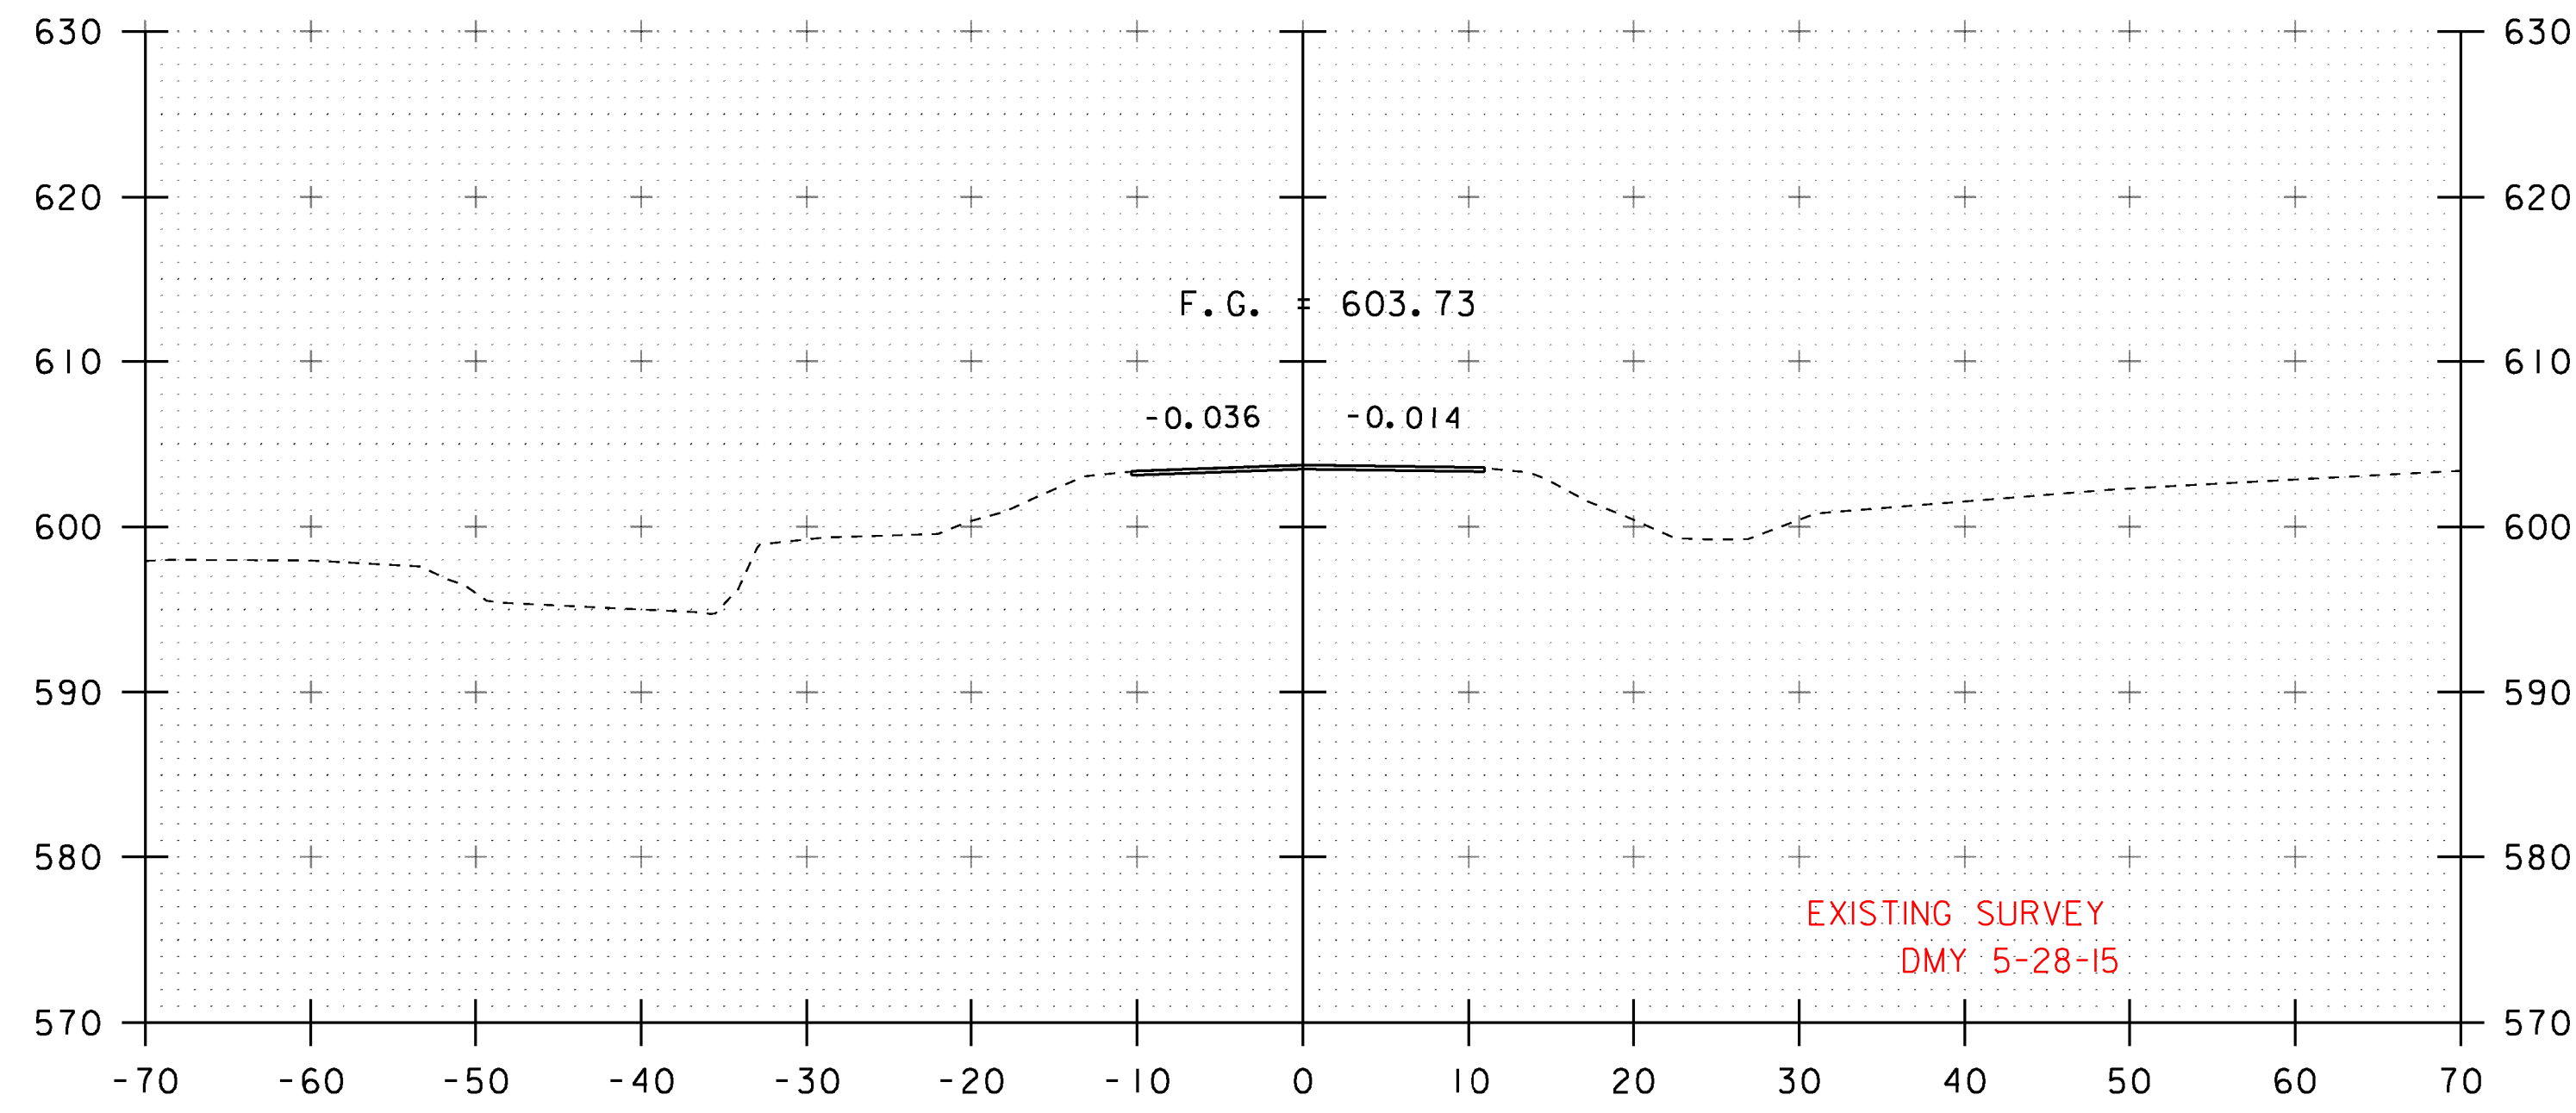


15+50

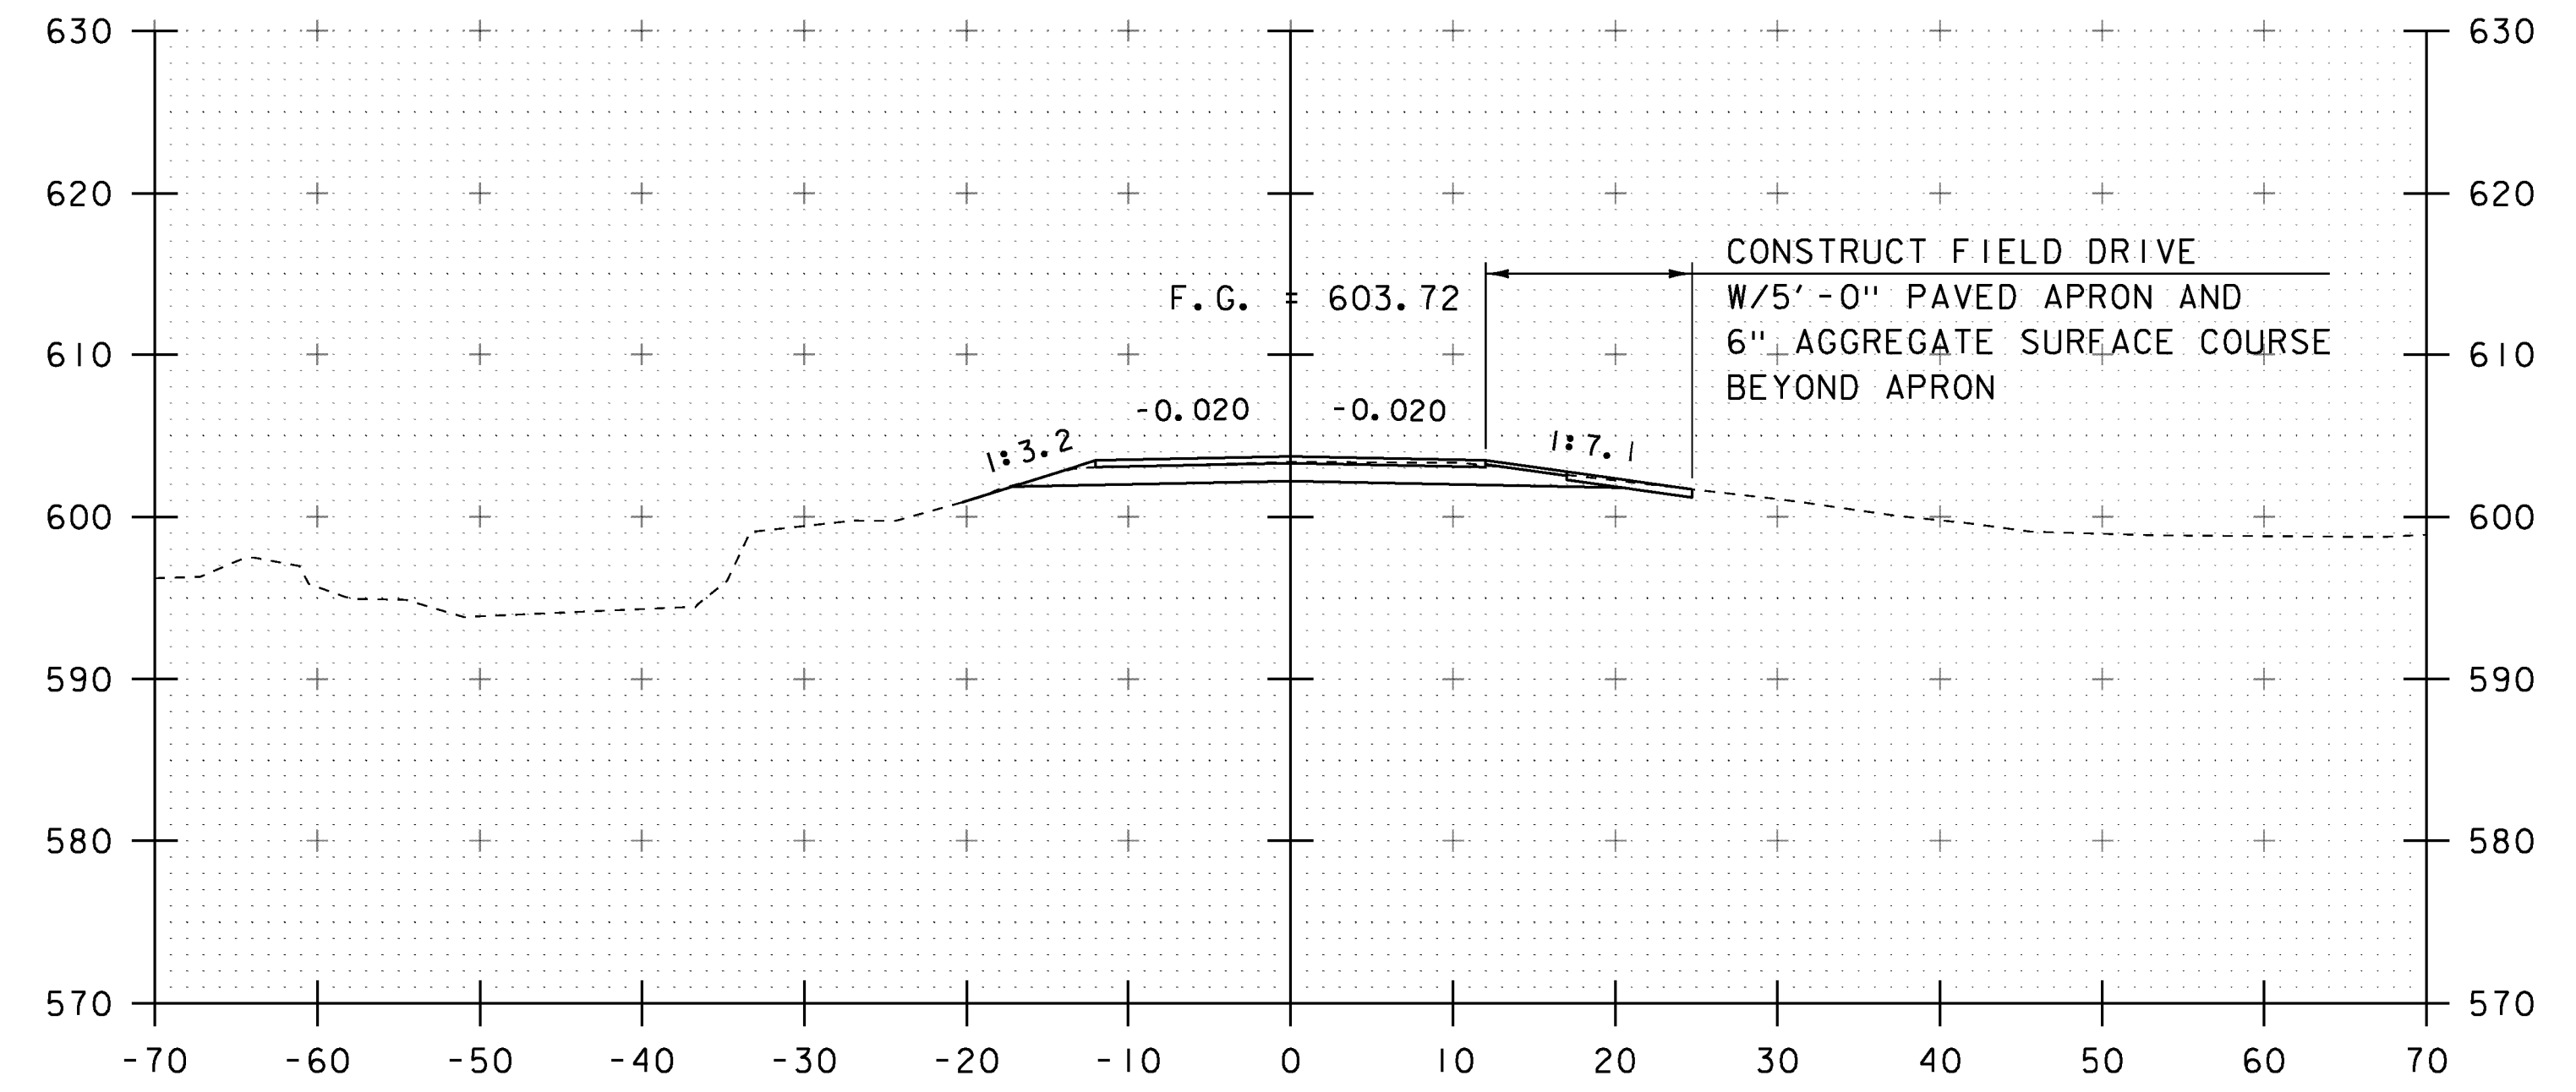

16+00  
BEGIN PROJECT

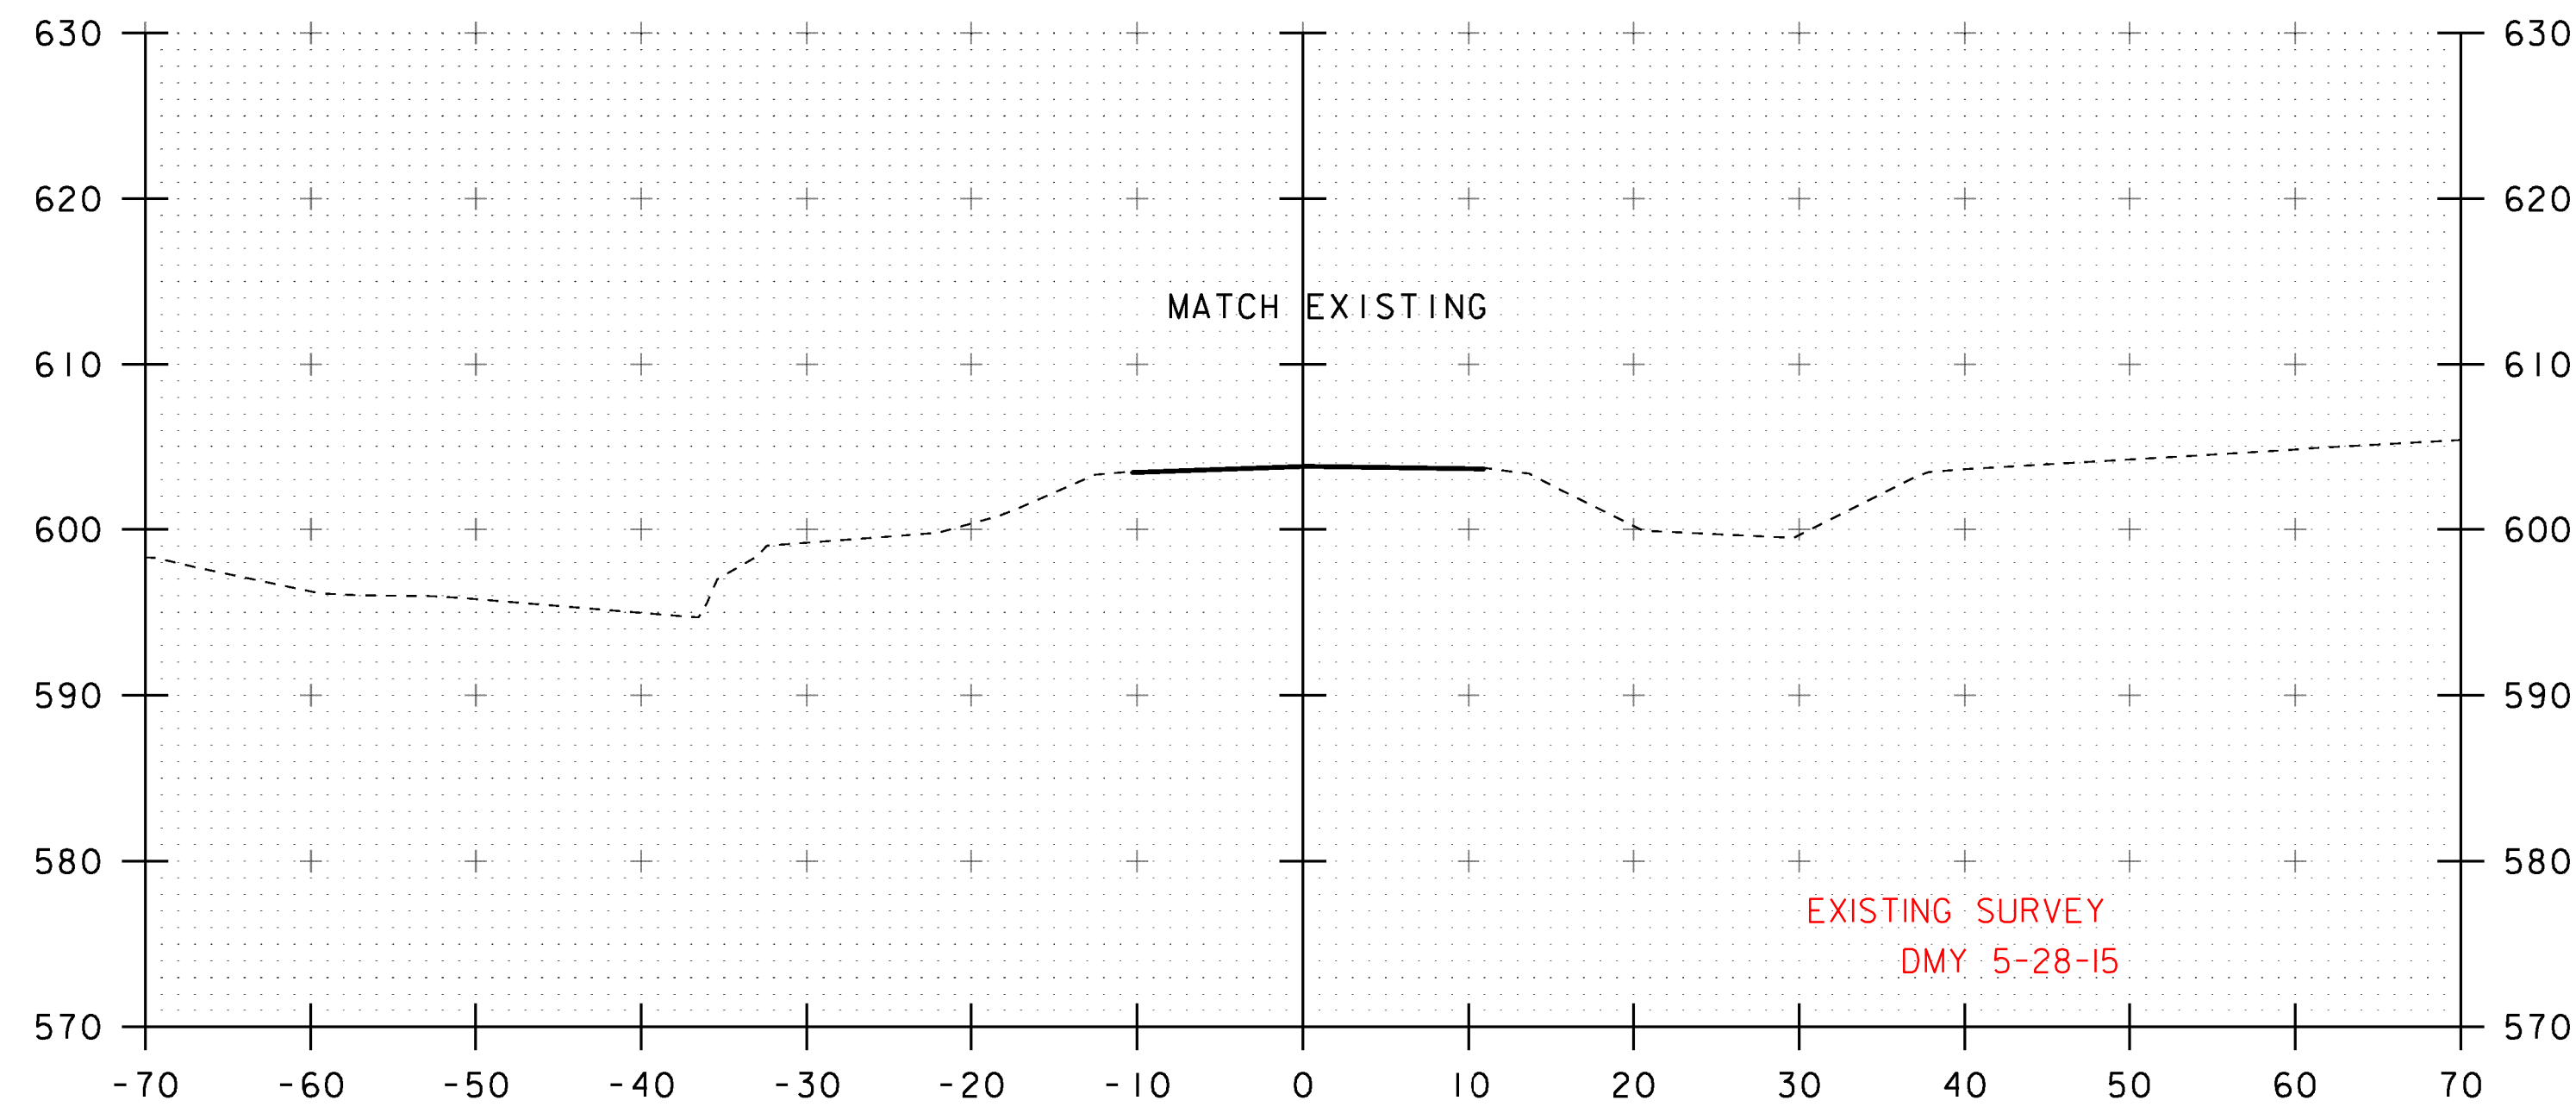


15+25  
BEGIN APPROACH

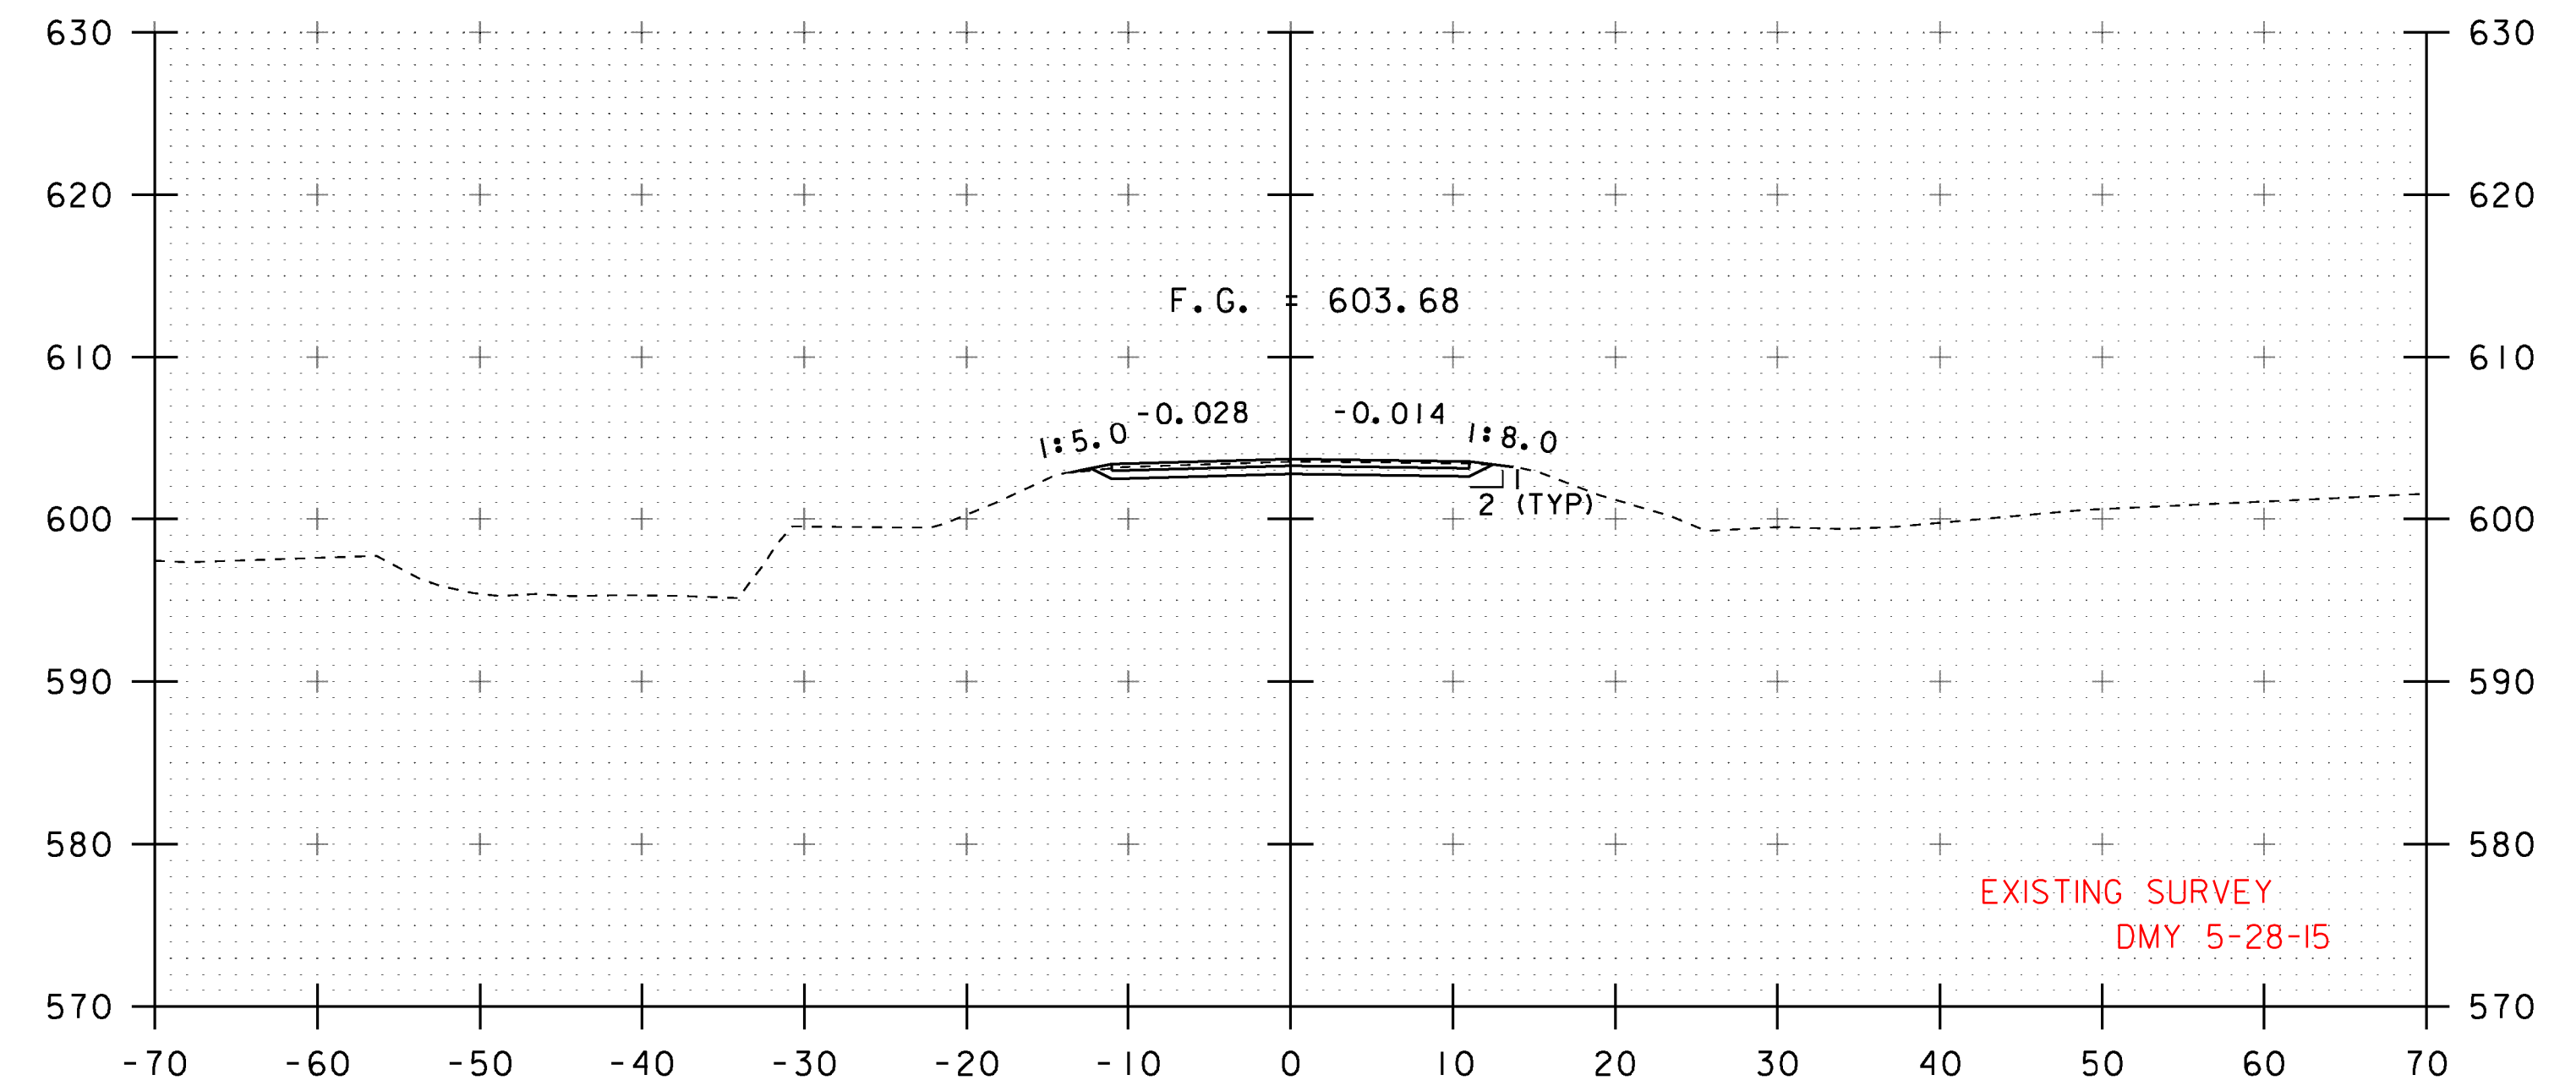


15+75

STA. 15+25 TO STA. 16+00


PROJECT NAME:	FAIRFIELD	PLOT DATE:	18-AUG-2014
PROJECT NUMBER:	BRF 0281(25)	DRAWN BY:	R. KLINEFELTER
FILE NAME:	sl2j156xs.dgn	CHECKED BY:	J. SALVATORI
PROJECT LEADER:	R. YOUNG	SHEET	32 OF 69
DESIGNED BY:	R. KLINEFELTER	MAINLINE SECTIONS	

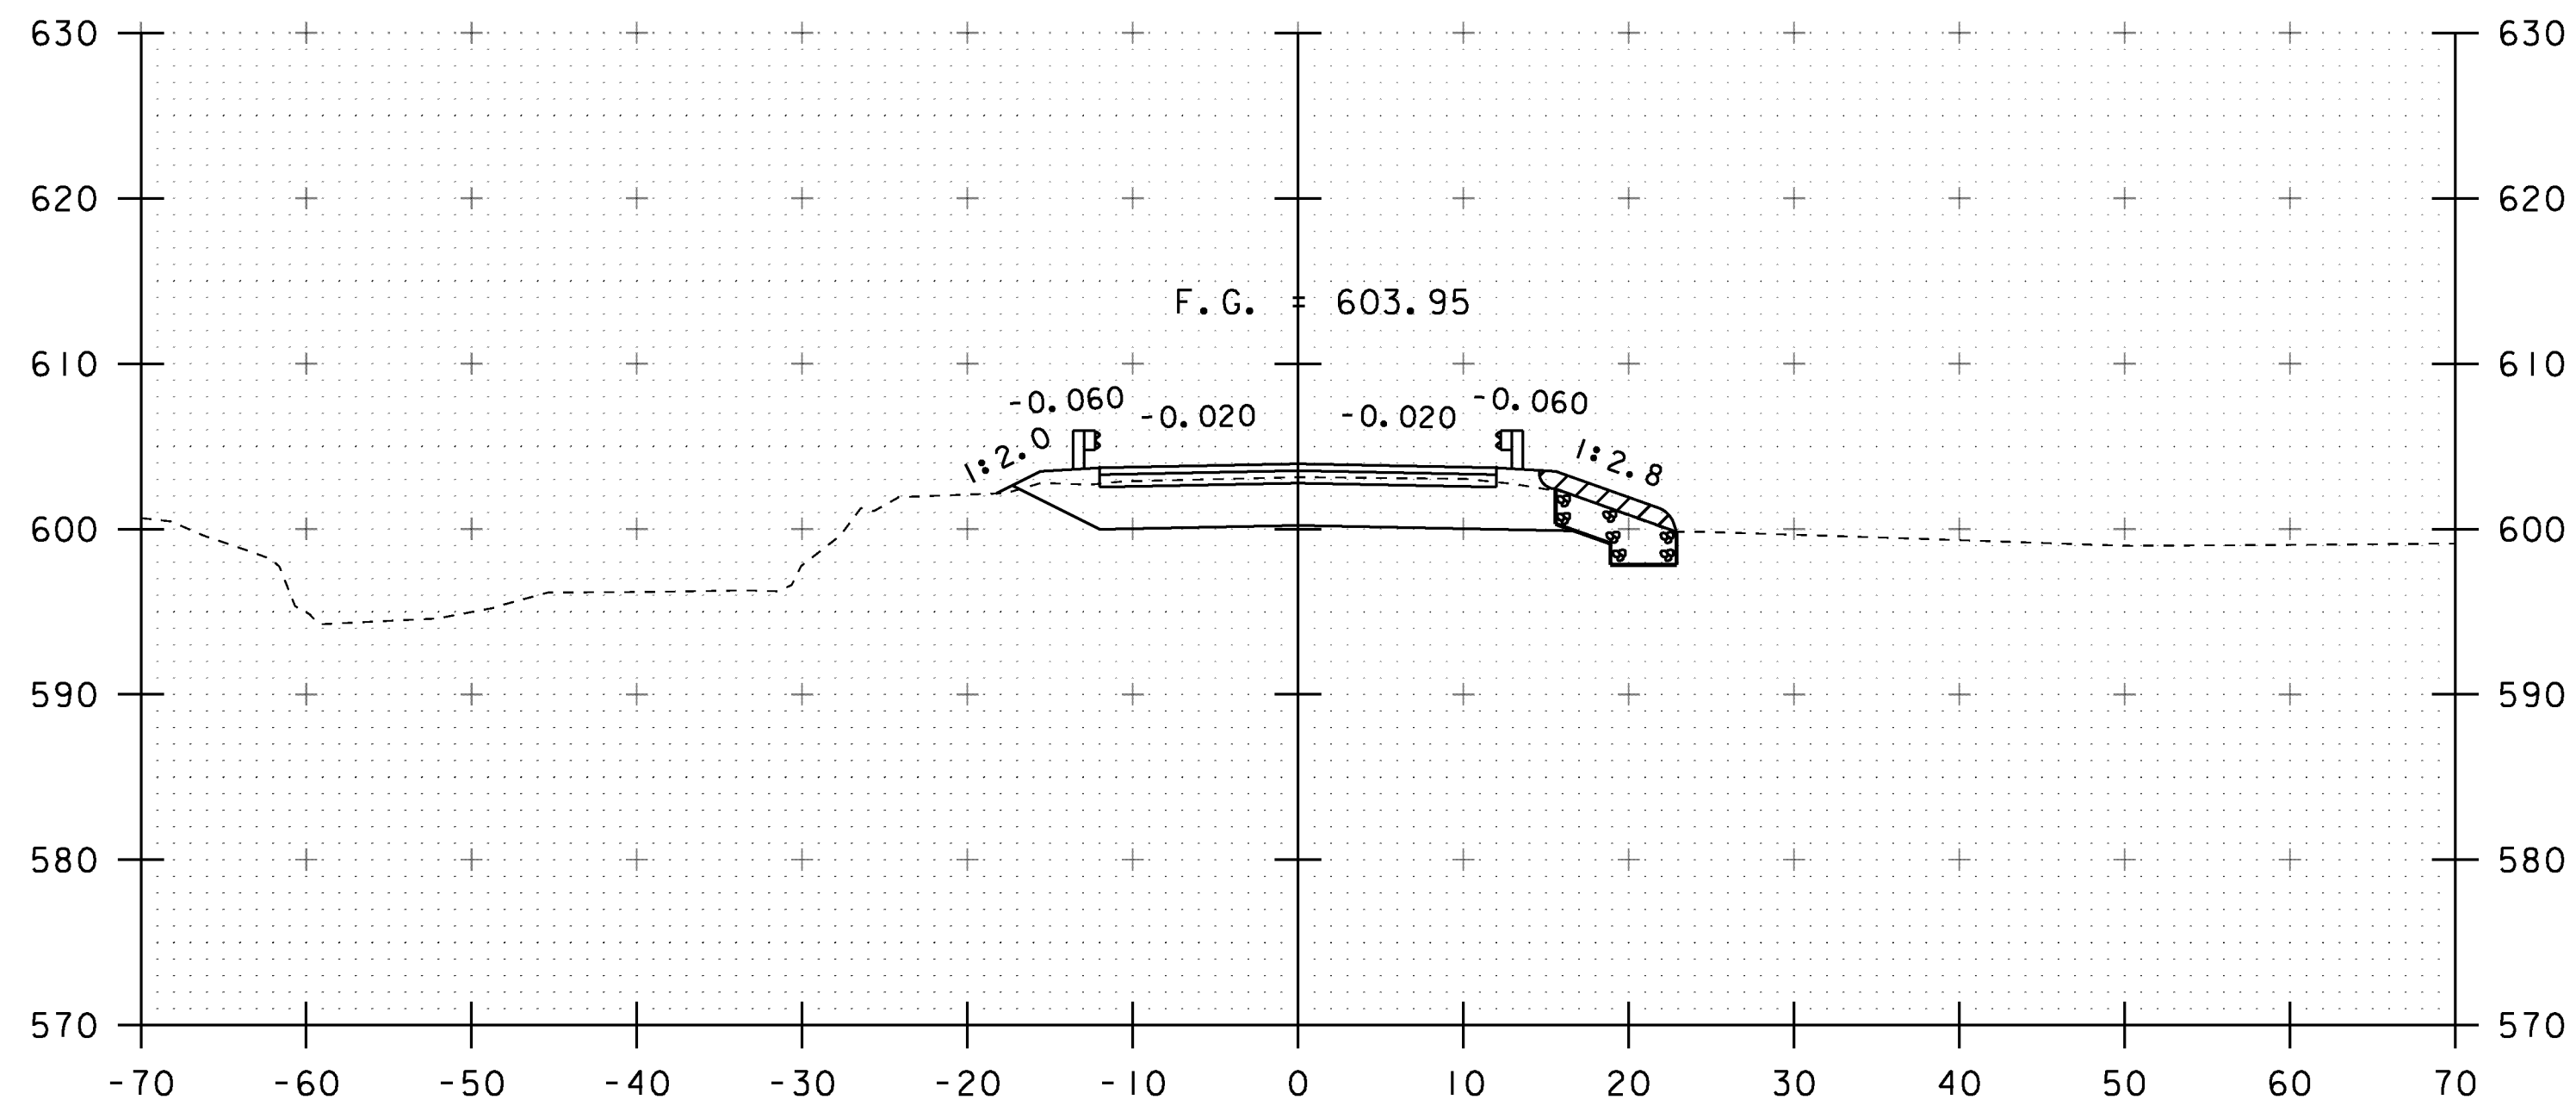


16+50  
BEGIN BRIDGE STA 16+62.00

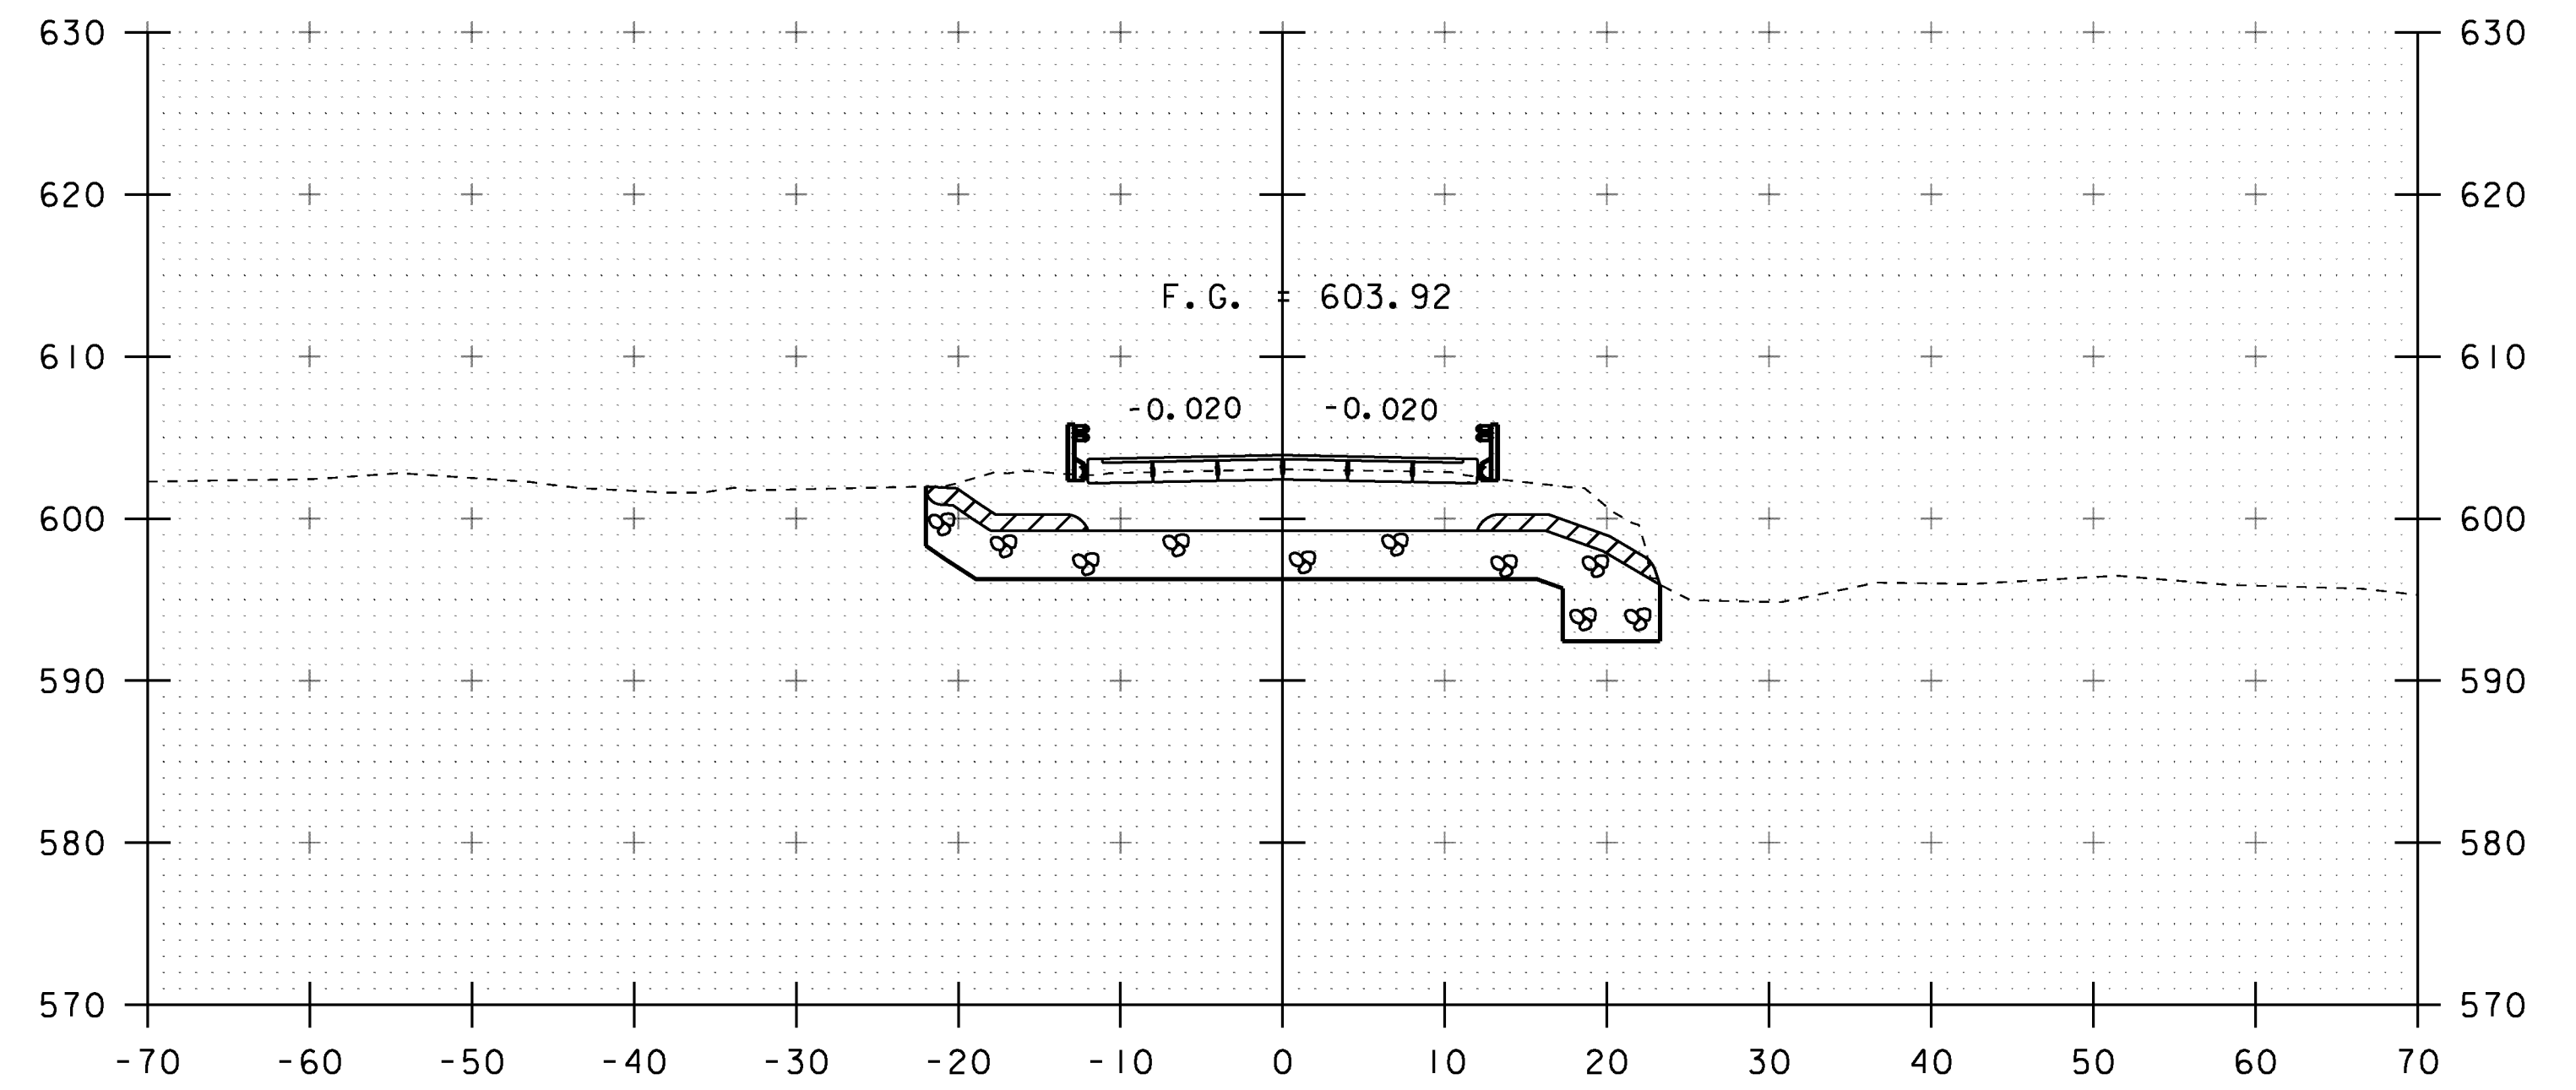

17+00  
END BRIDGE STA 17+06.00

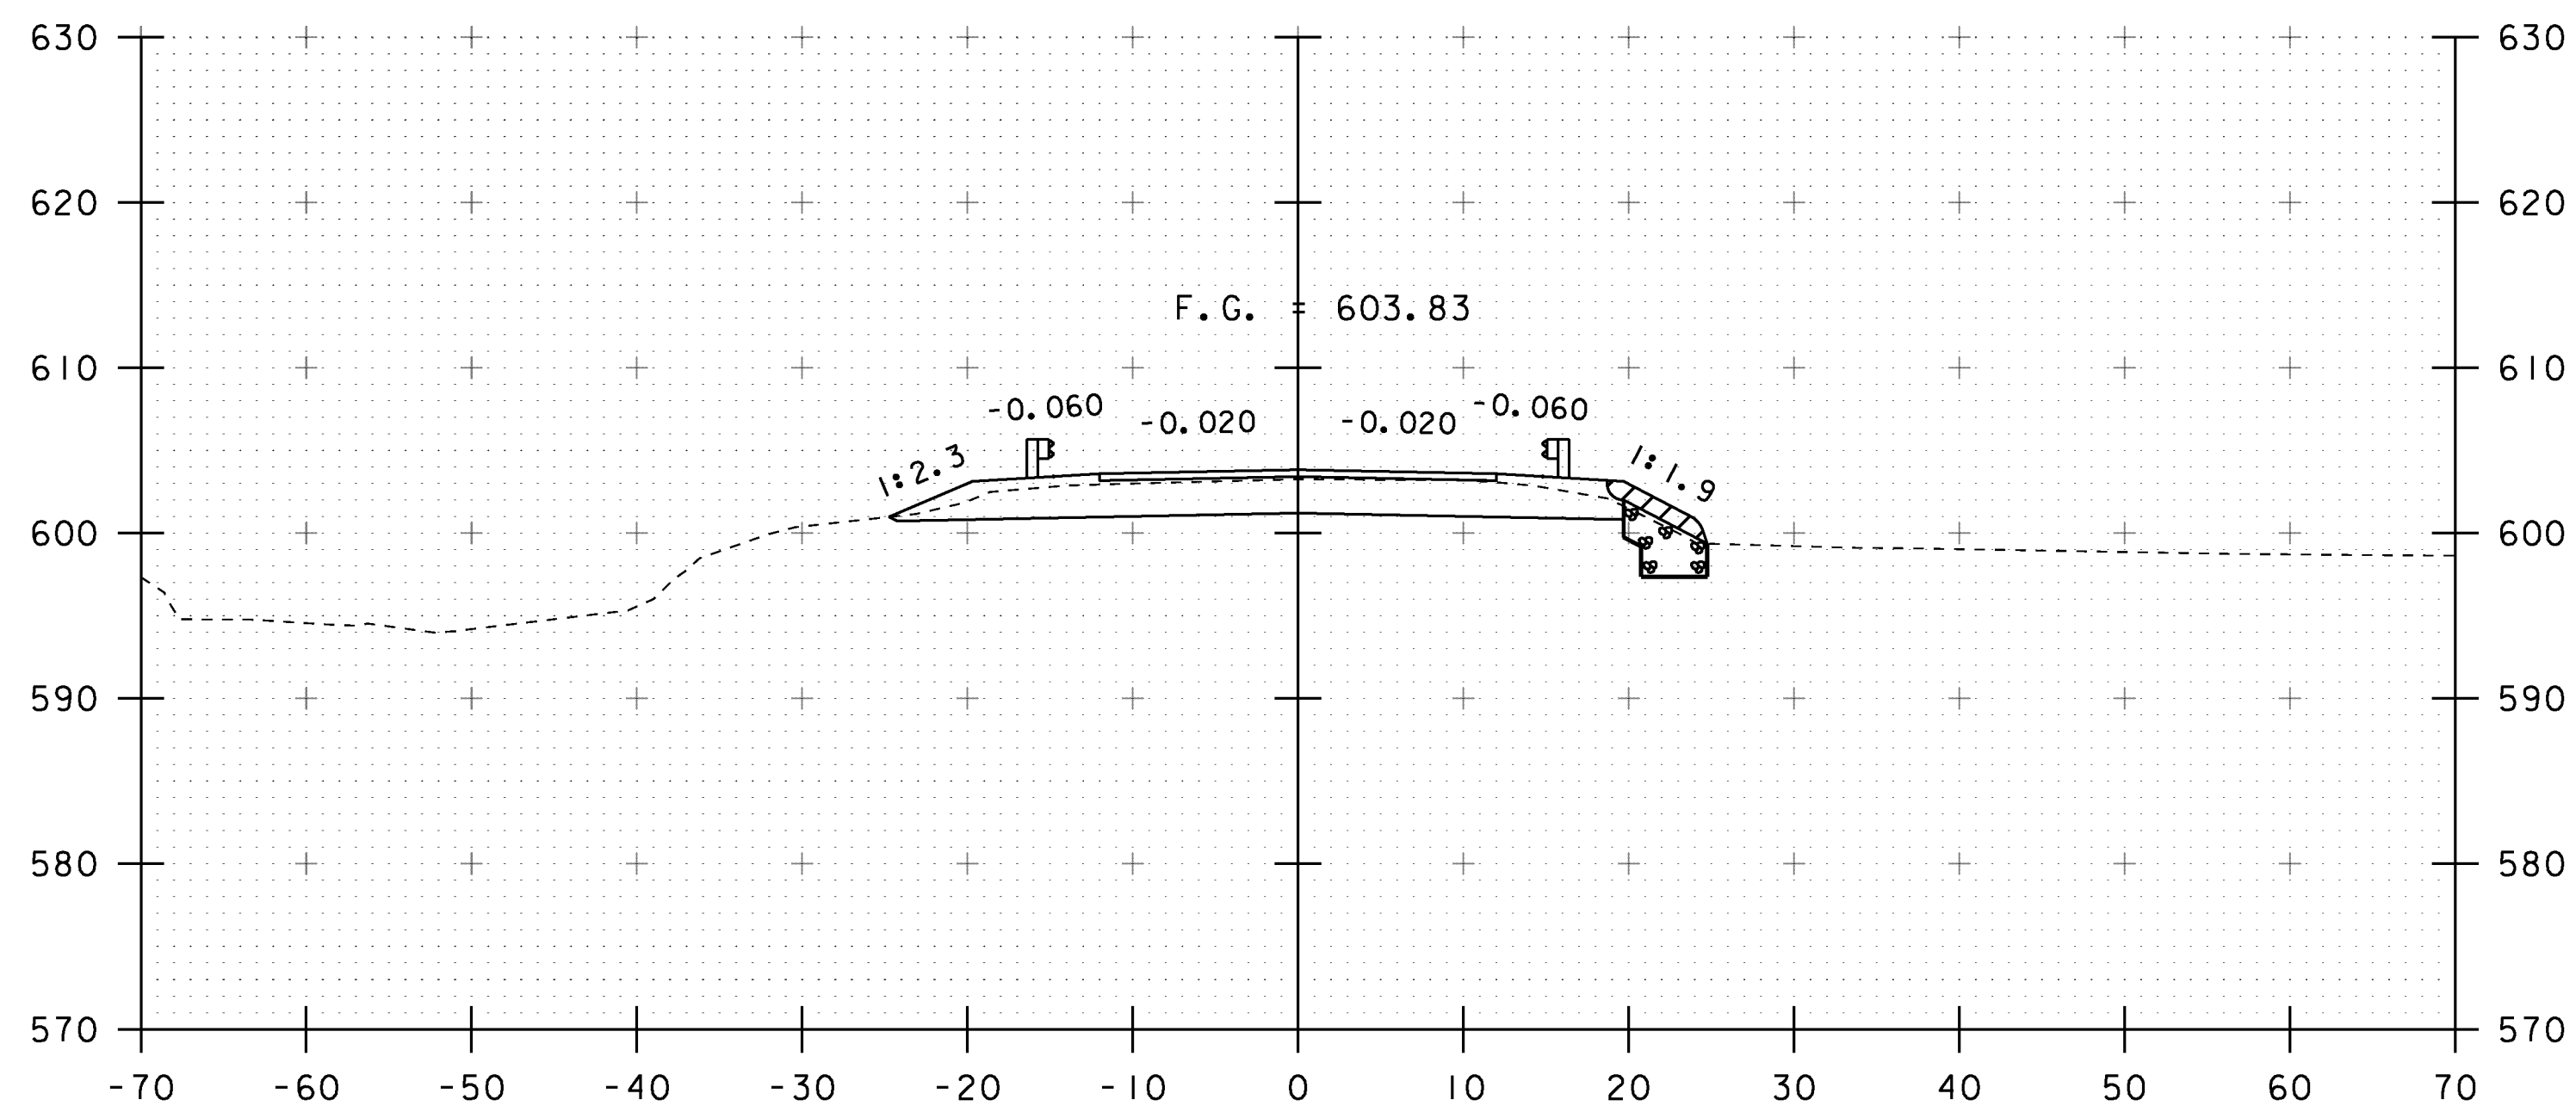

16+25

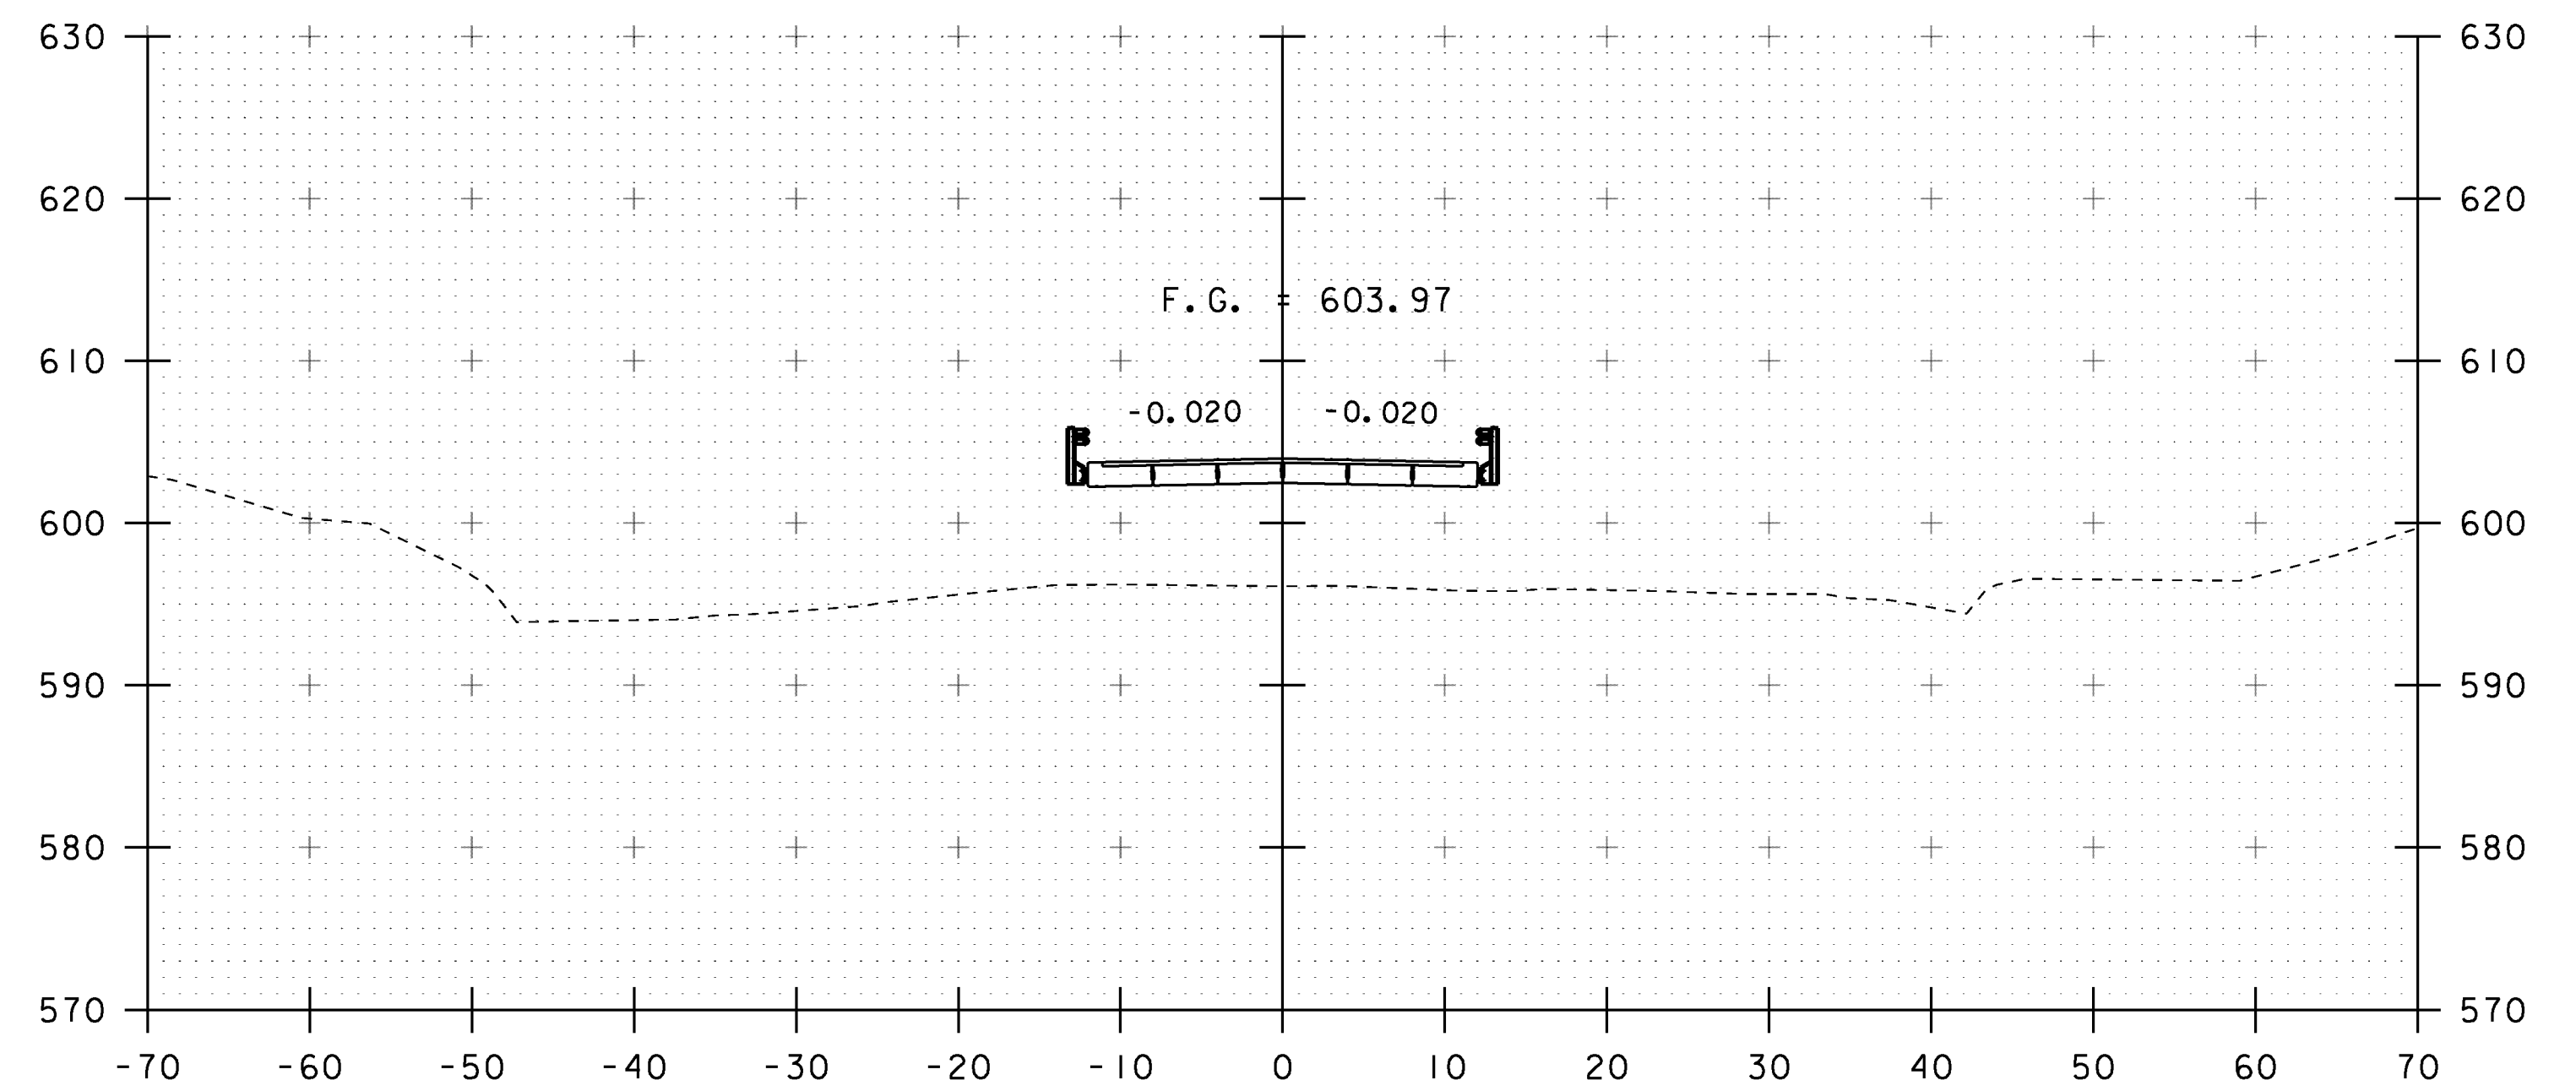


16+75

PROJECT NAME: FAIRFIELD  
PROJECT NUMBER: BRF 028(25)


FILE NAME: sl2j156xs.dgn  
PROJECT LEADER: R. YOUNG  
DESIGNED BY: R. KLINEFELTER  
MAINLINE SECTIONS

PLOT DATE: 18-AUG-2014  
DRAWN BY: R. KLINEFELTER  
CHECKED BY: J. SALVATORI  
SHEET 33 OF 69


STA. 16+25 TO STA. 17+00

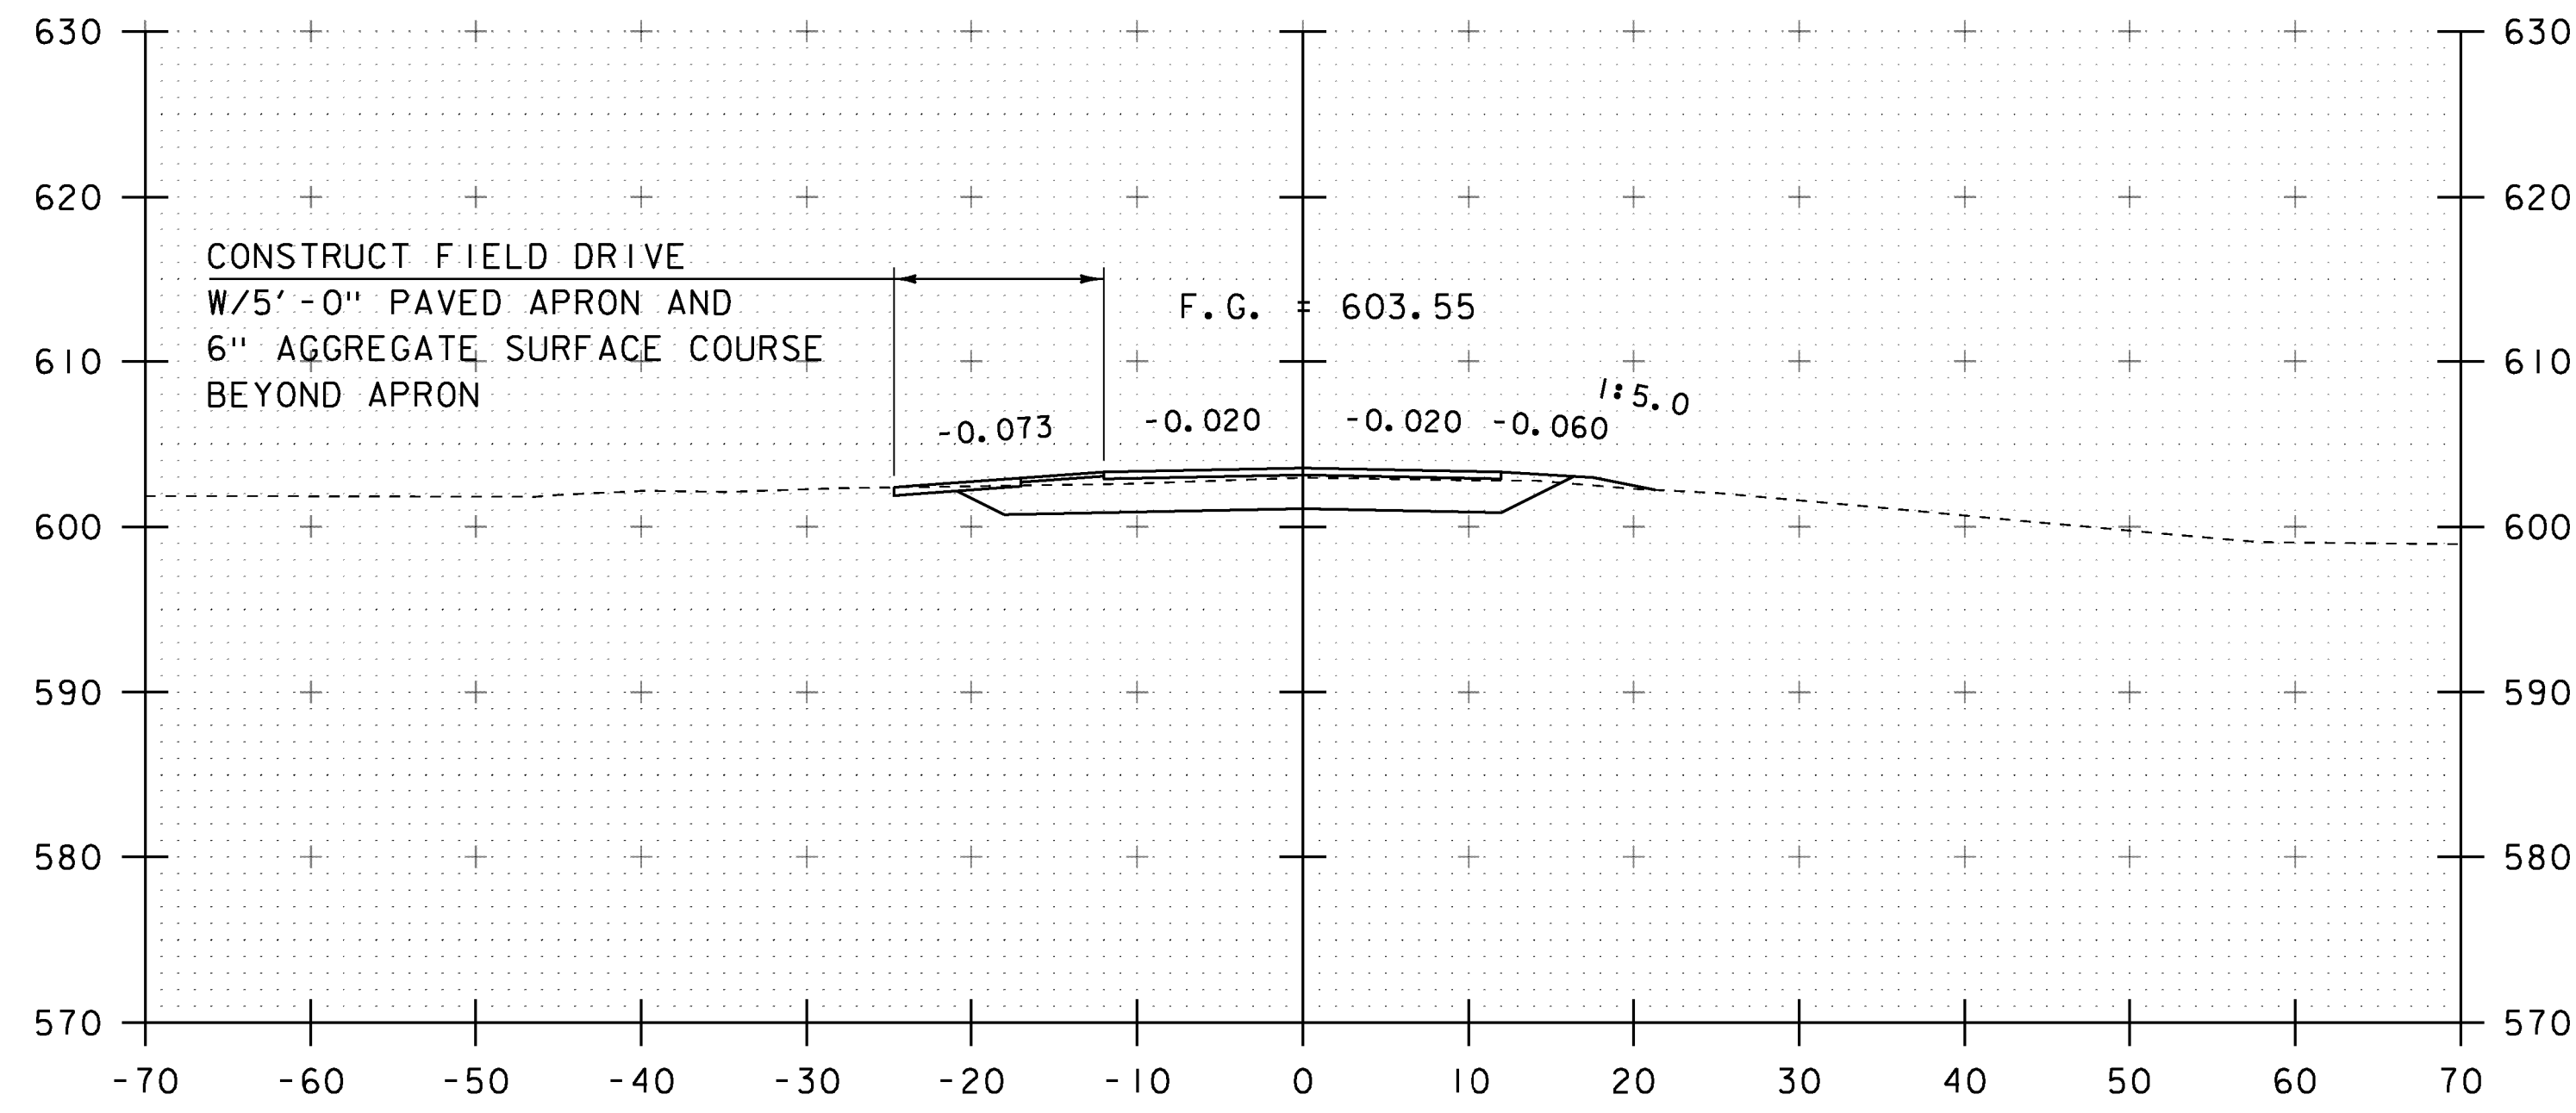


17+50

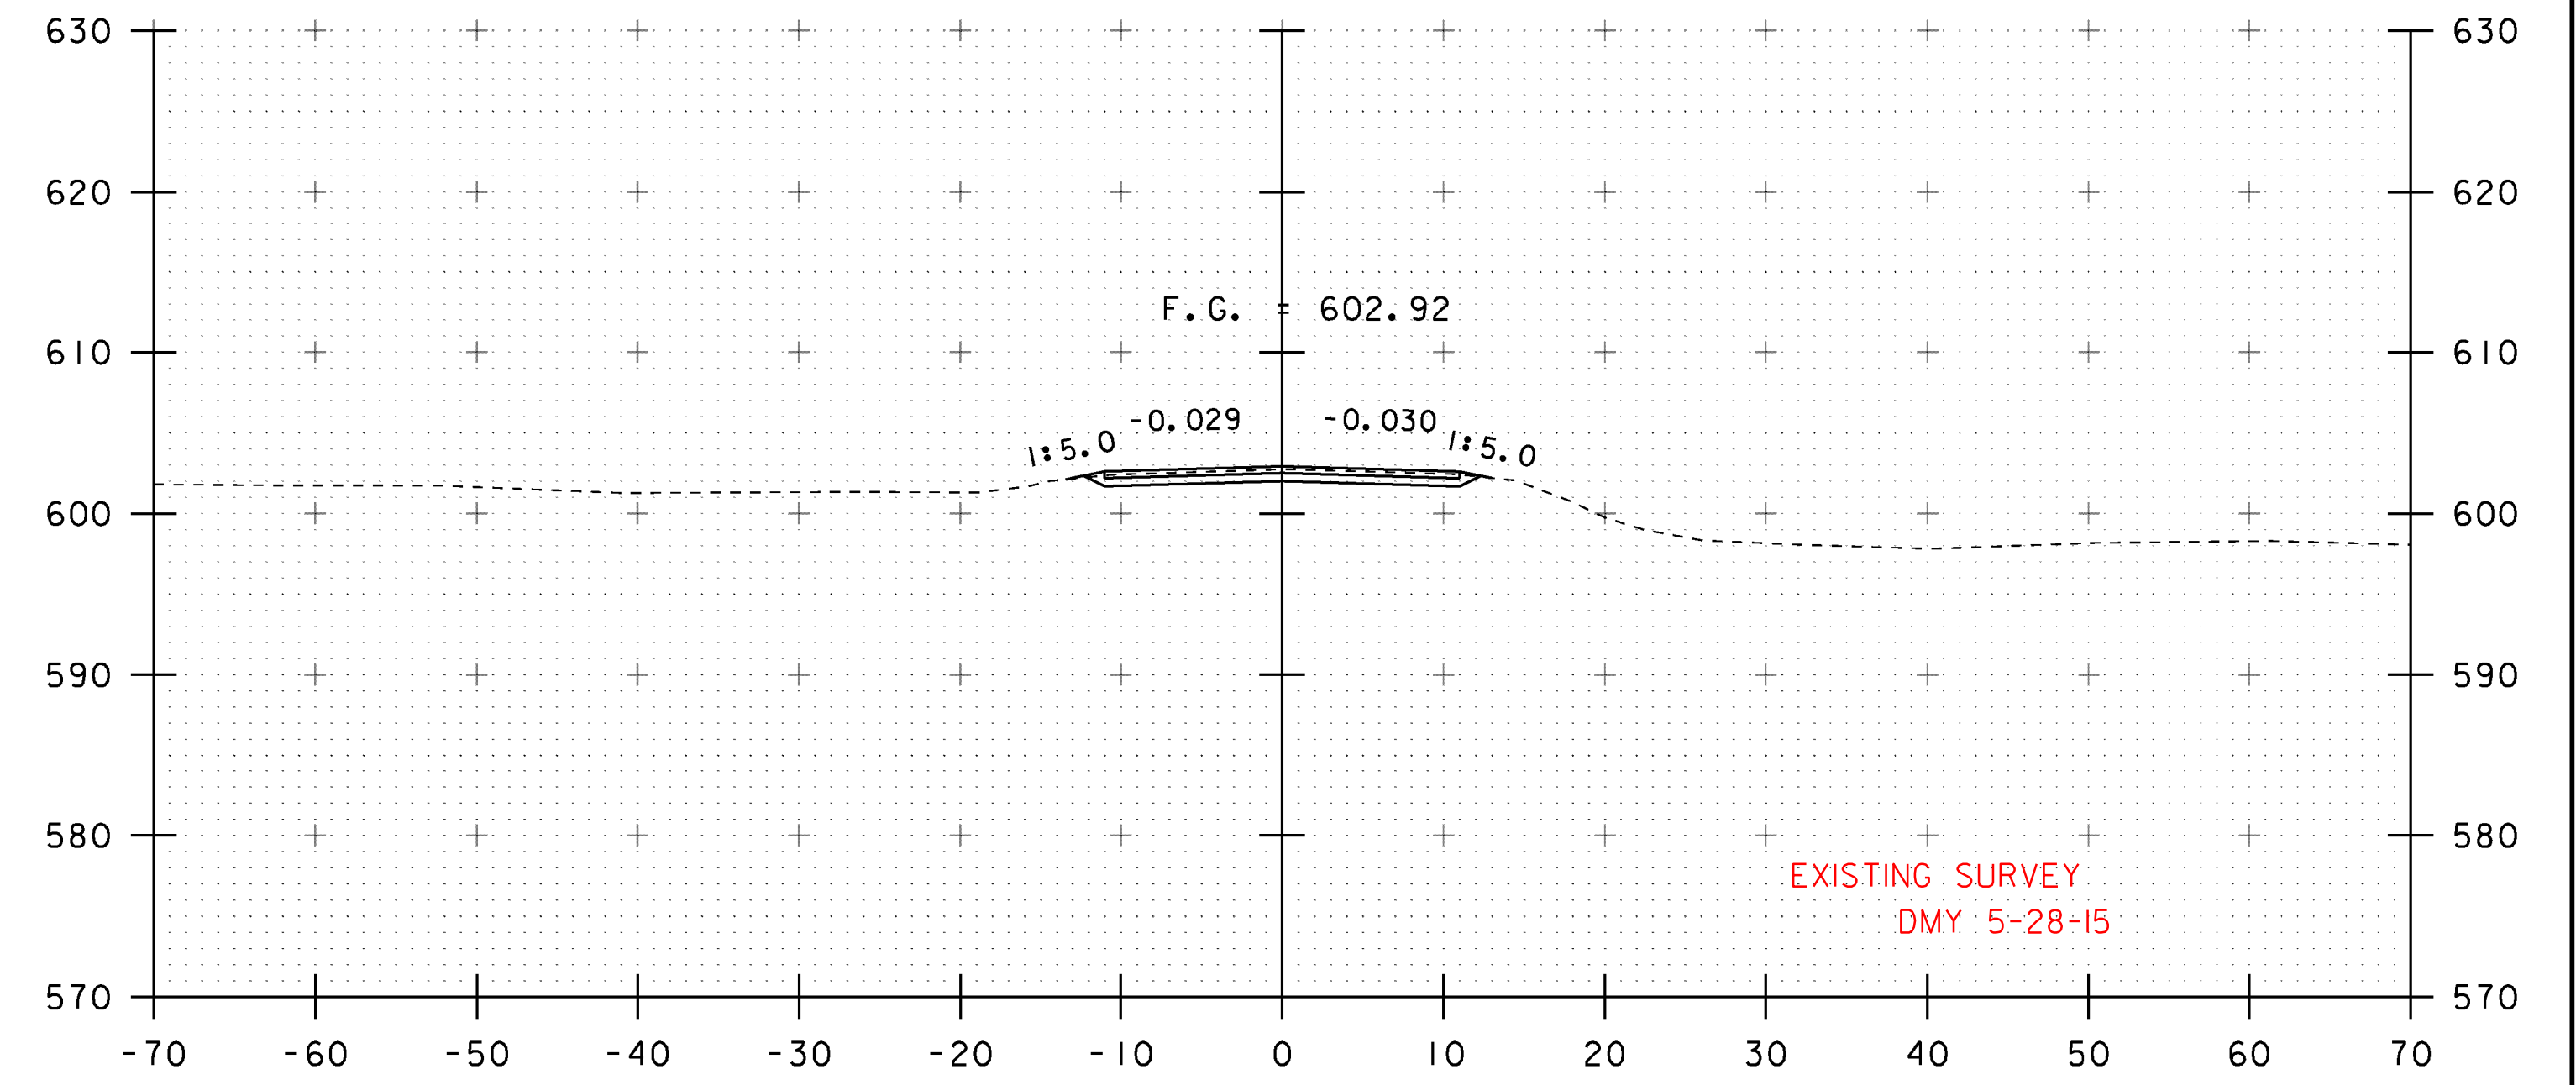

18+00

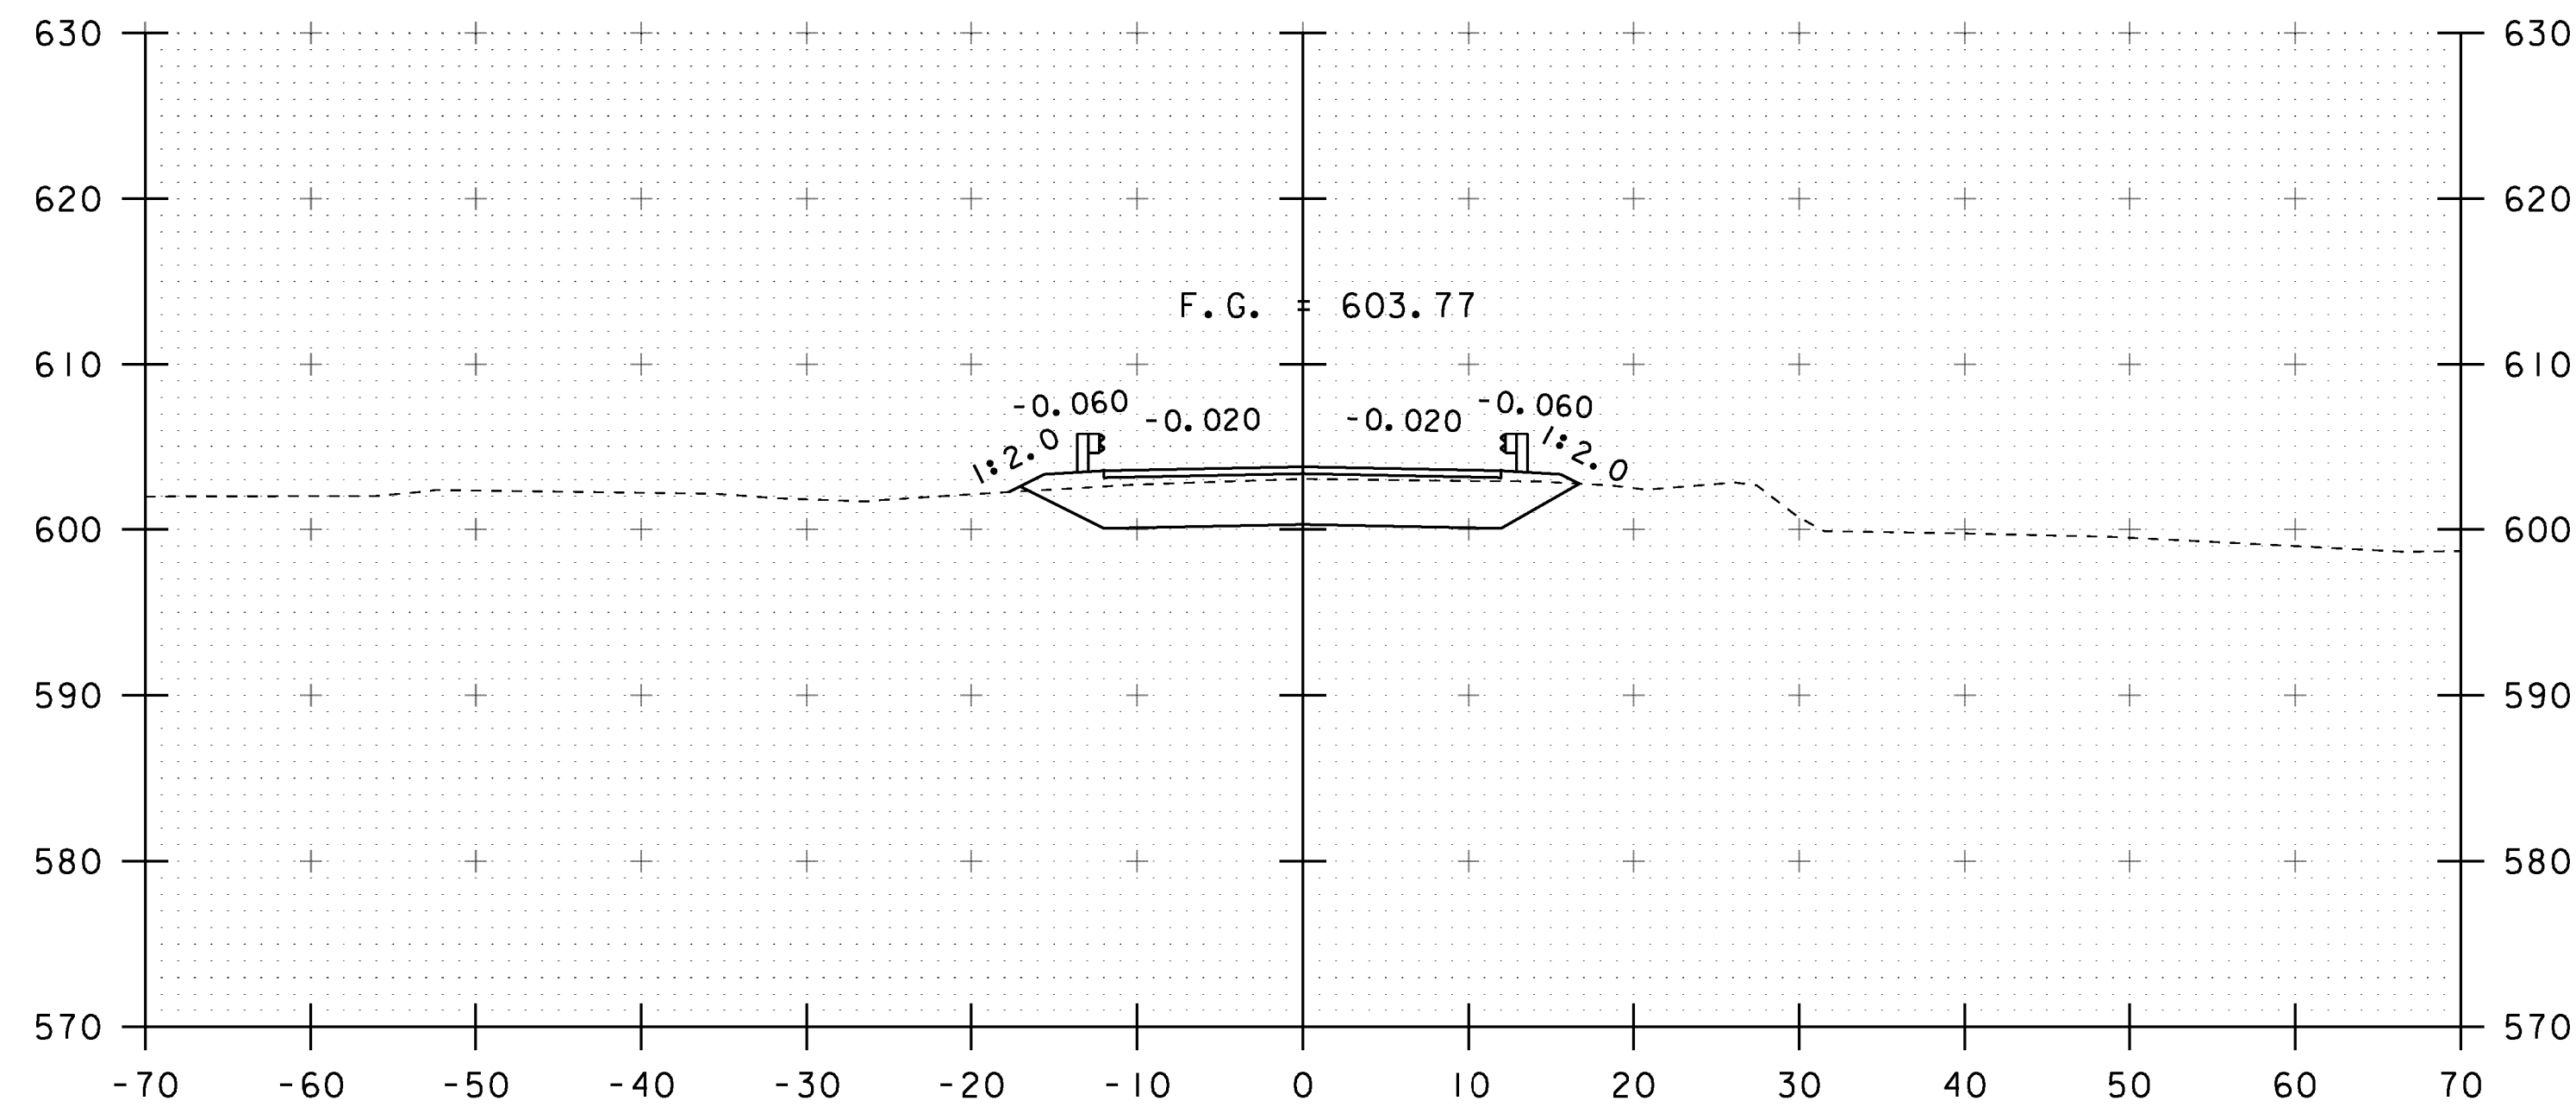


17+25

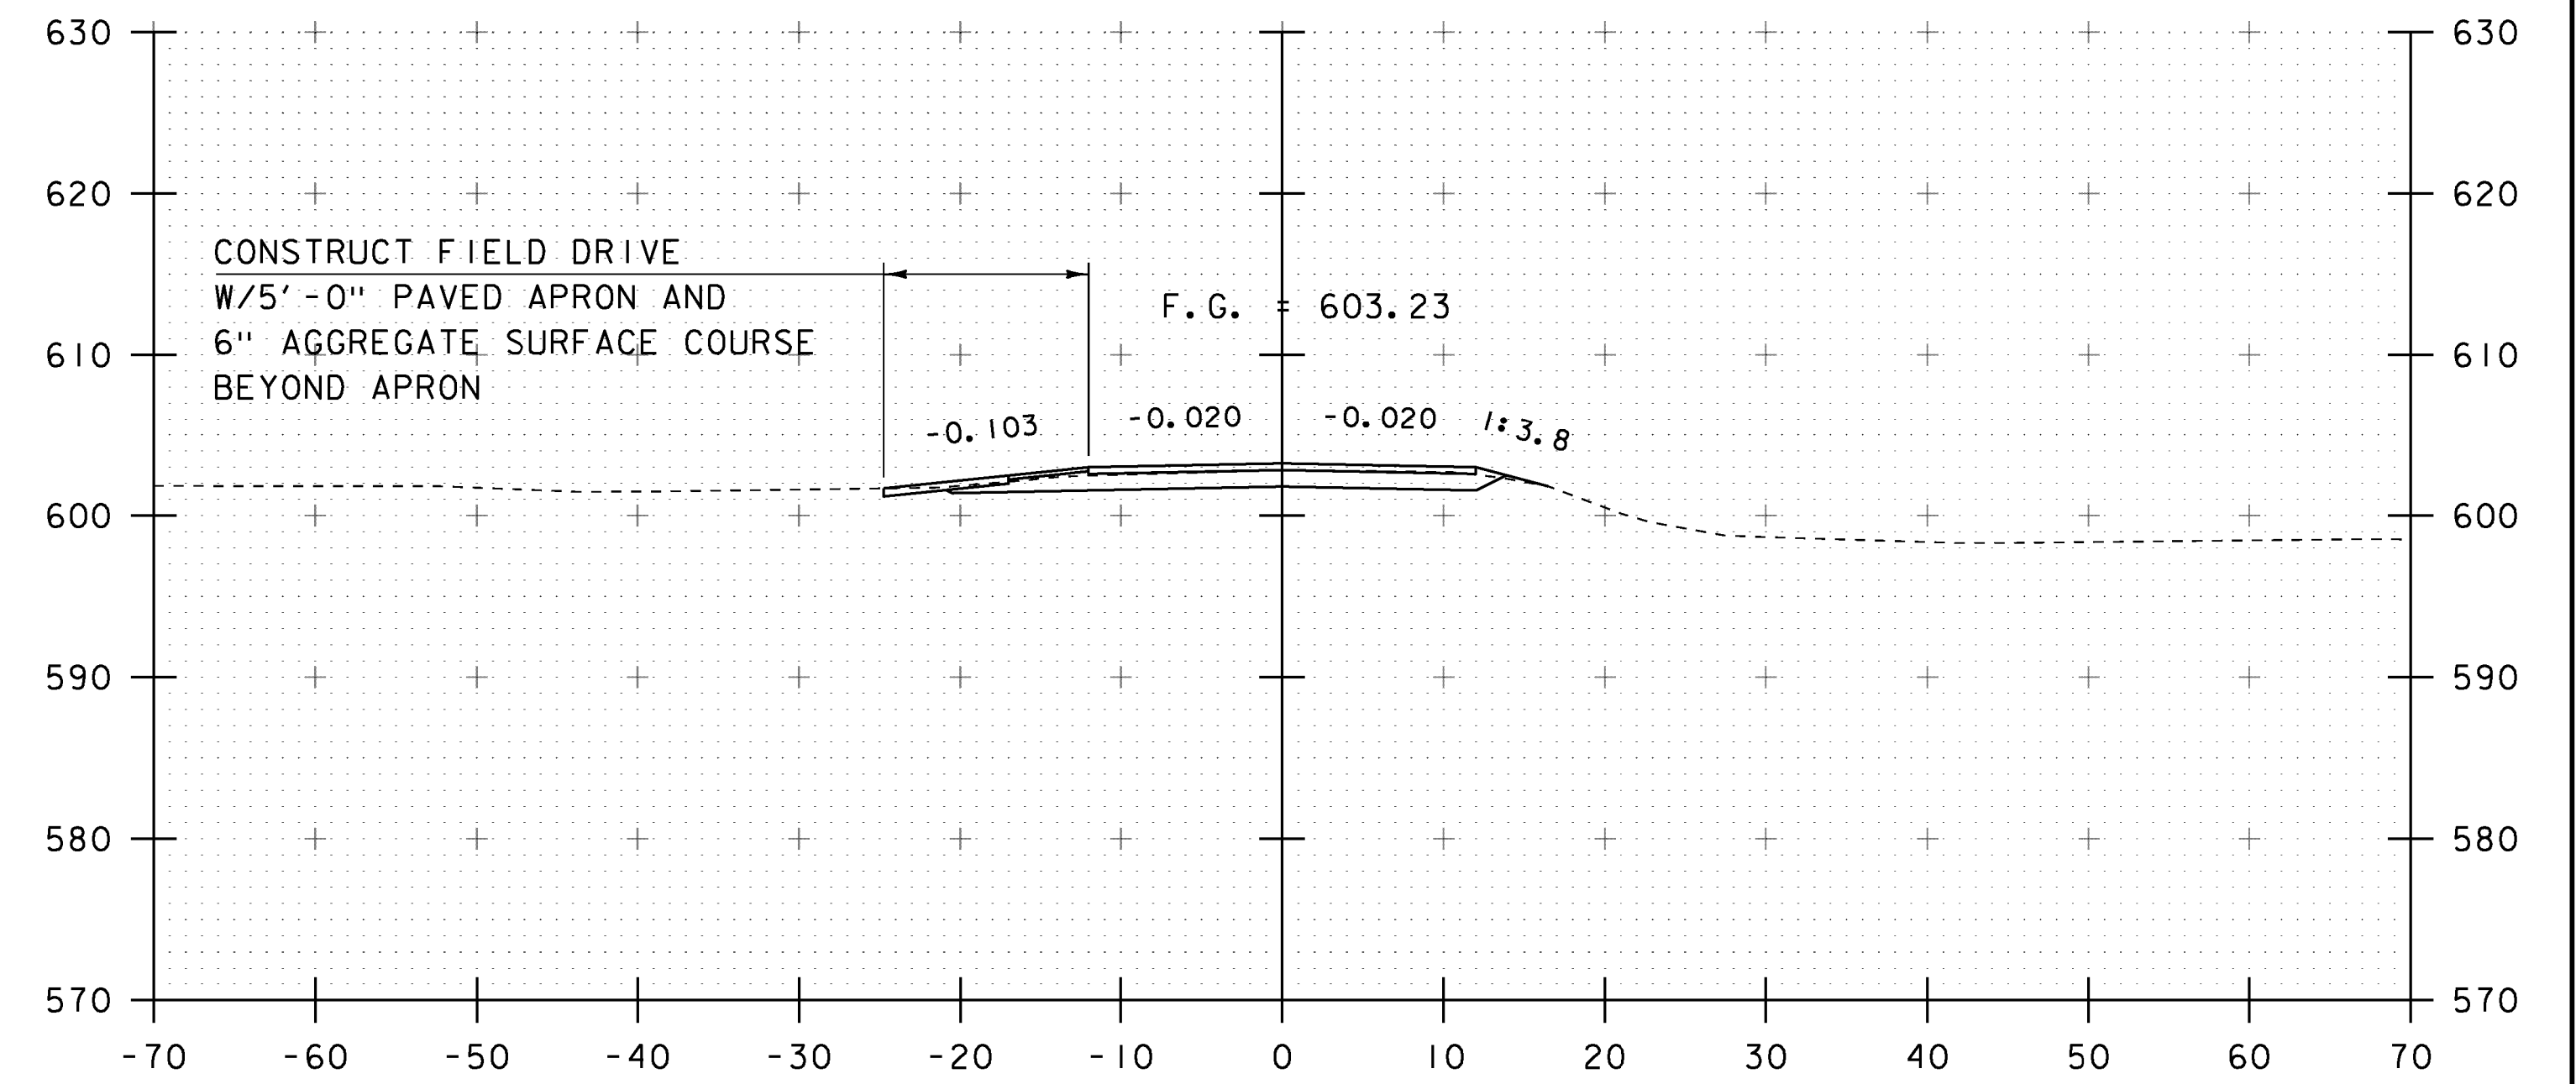


17+75  
END PROJECT

STA. 17+25 TO STA. 18+00

PROJECT NAME:	FAIRFIELD	PLOT DATE:	18-AUG-2014
PROJECT NUMBER:	BRF 0281(25)	DRAWN BY:	R. KLINEFELTER
FILE NAME:	sl2j156xs.dgn	DESIGNED BY:	R. KLINEFELTER
PROJECT LEADER:	R. YOUNG	CHECKED BY:	J. SALVATORI
DESIGNED BY:	R. KLINEFELTER	SHEET	34 OF 69
MAINLINE SECTIONS			

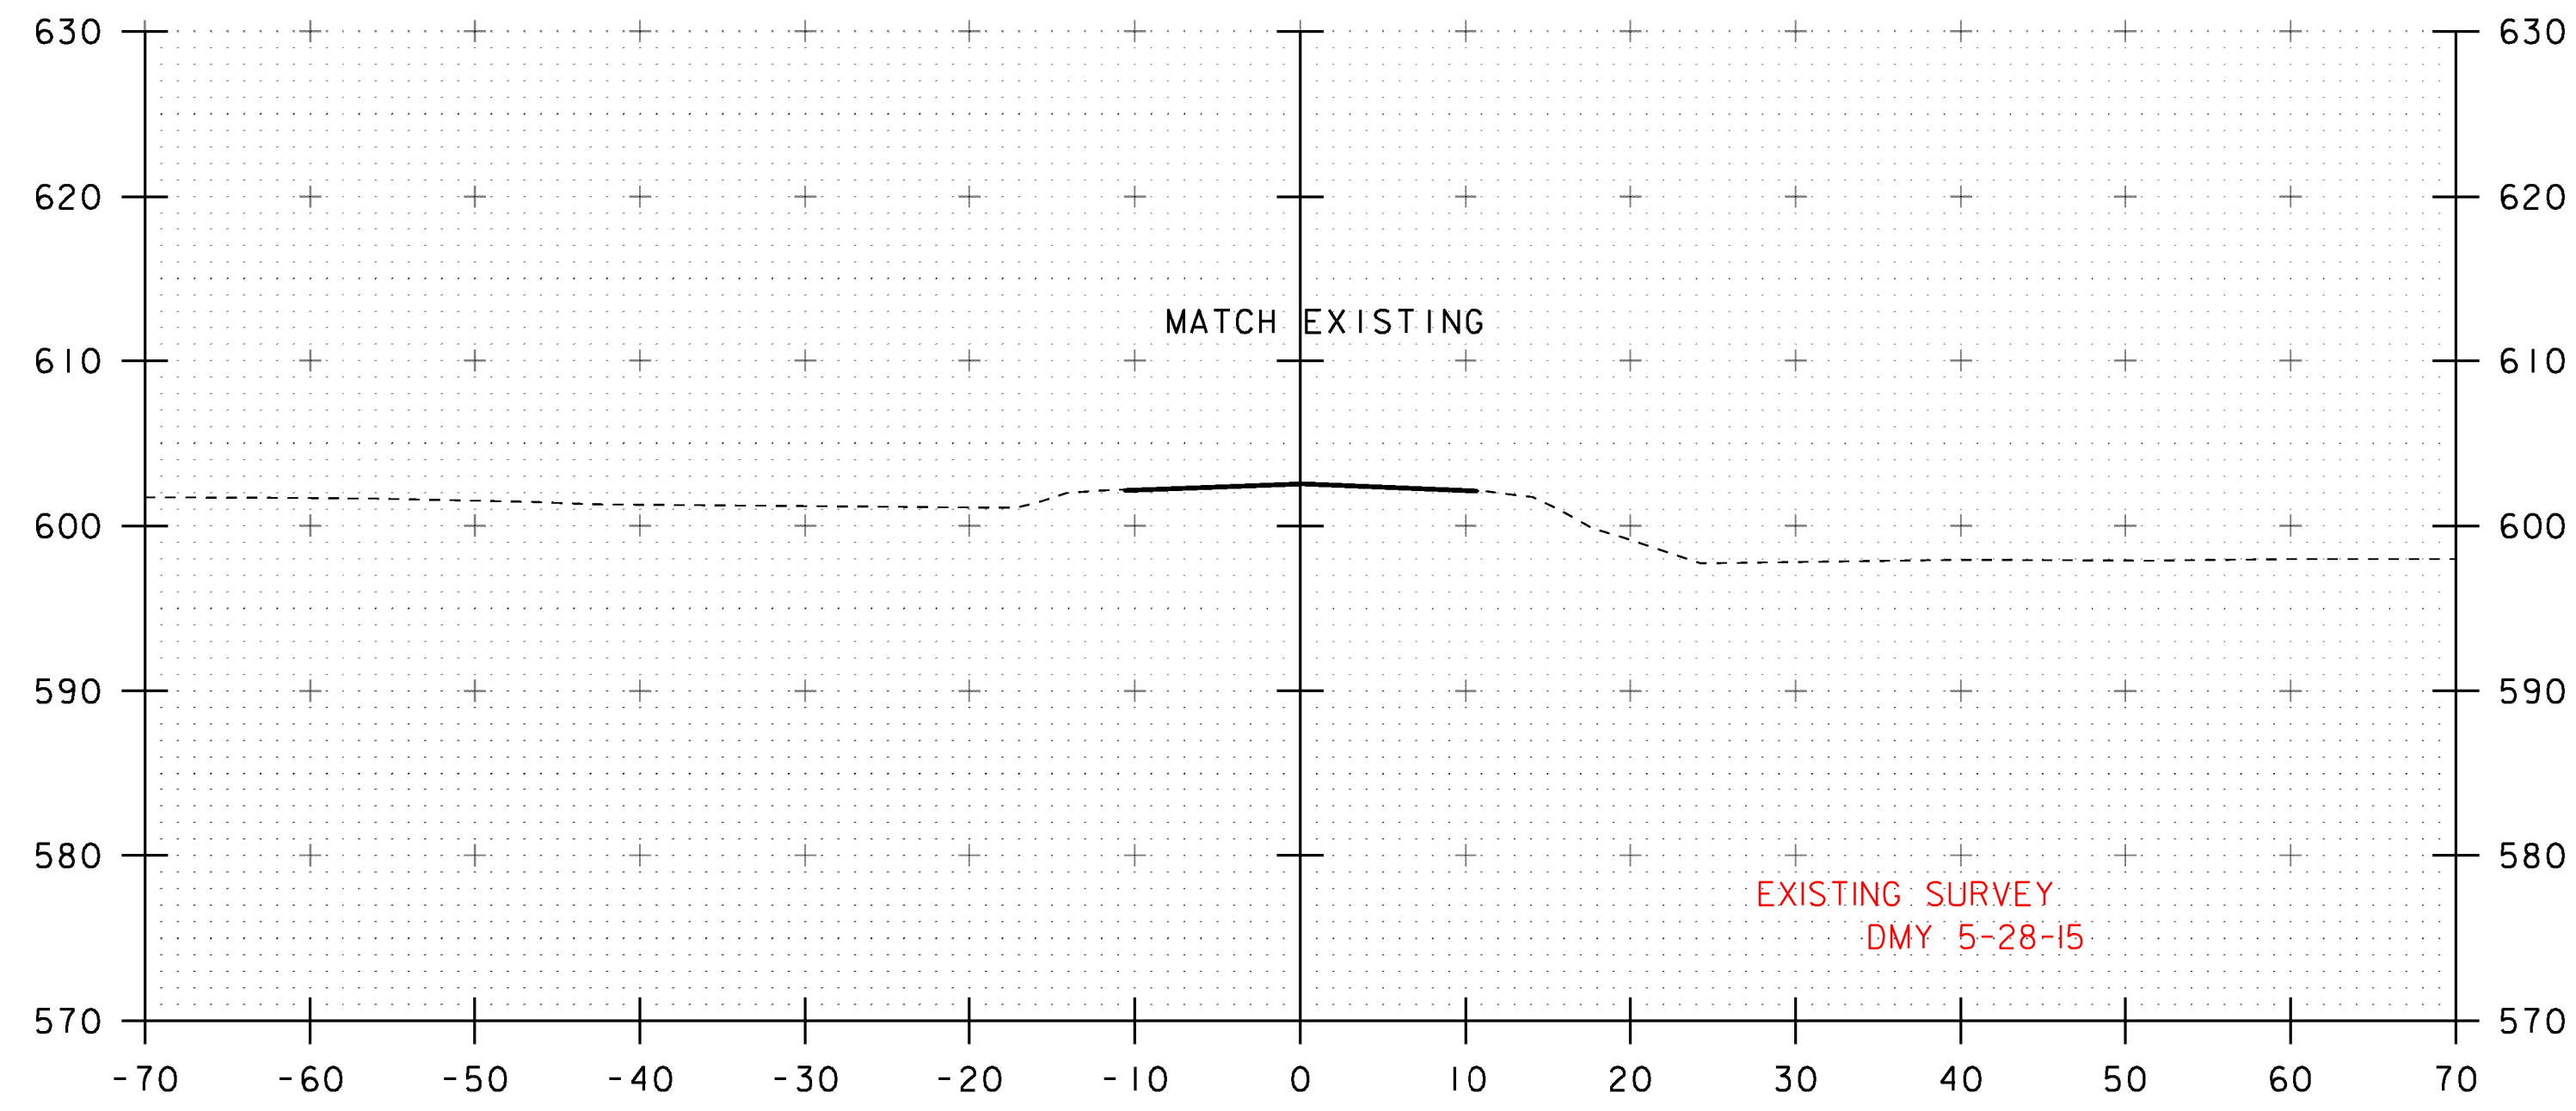


18+50  
END APPROACH

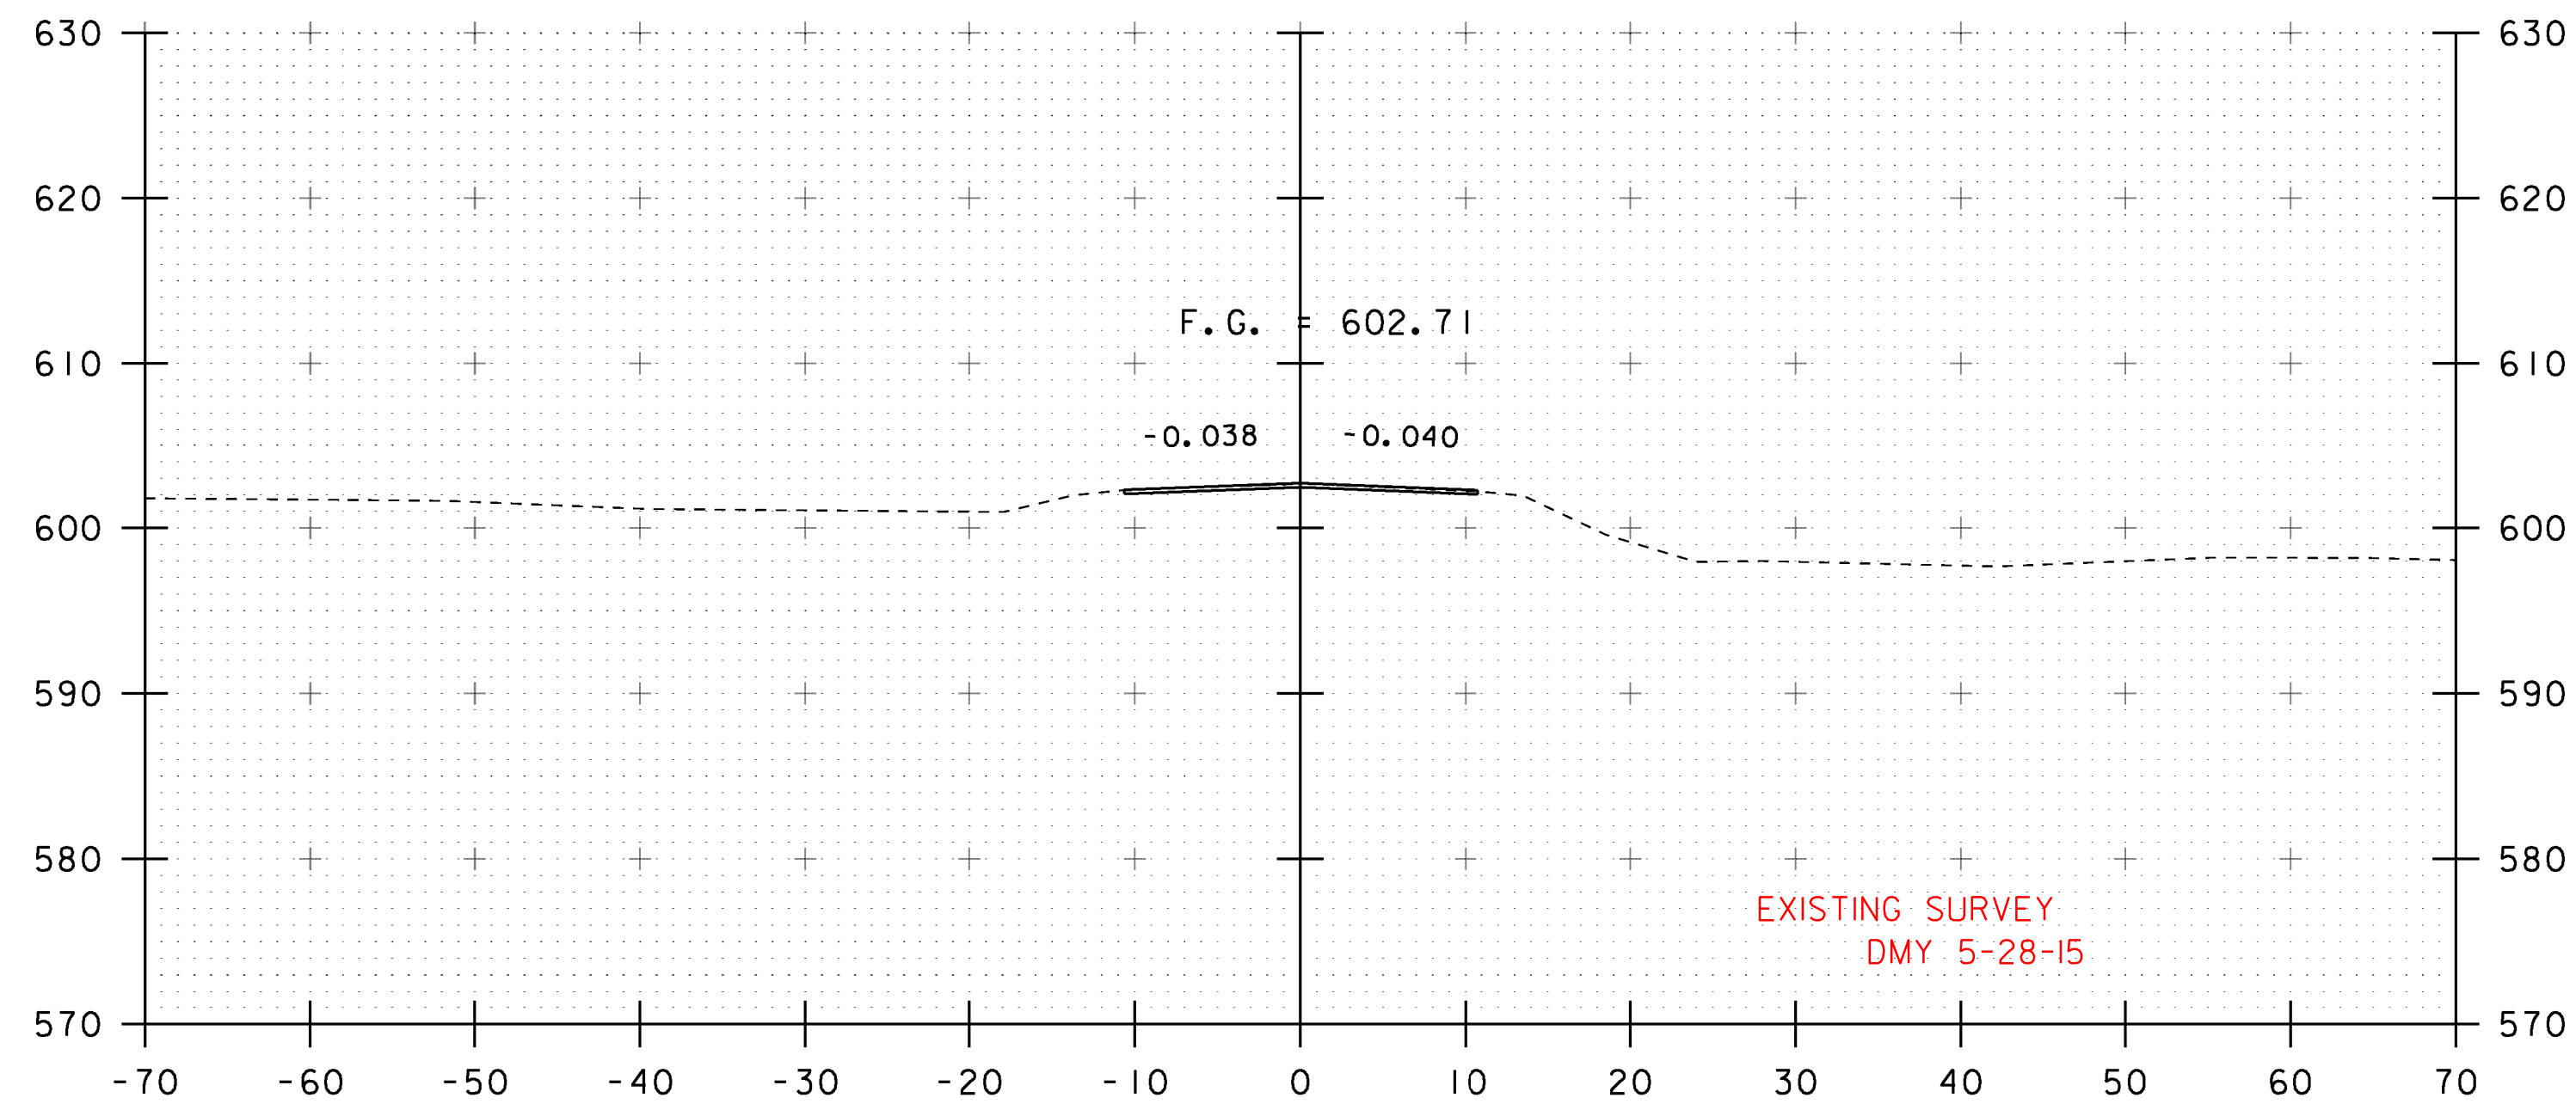

18+25


STA. 18+25 TO STA. 18+50

PROJECT NAME: FAIRFIELD	
PROJECT NUMBER: BRF 0281(25)	
FILE NAME: sl2j156xs.dgn	PLOT DATE: 18-AUG-2014
PROJECT LEADER: R. YOUNG	DRAWN BY: R. KLINEFELTER
DESIGNED BY: R. KLINEFELTER	CHECKED BY: J. SALVATORI
MAINLINE SECTIONS	SHEET 35 OF 69

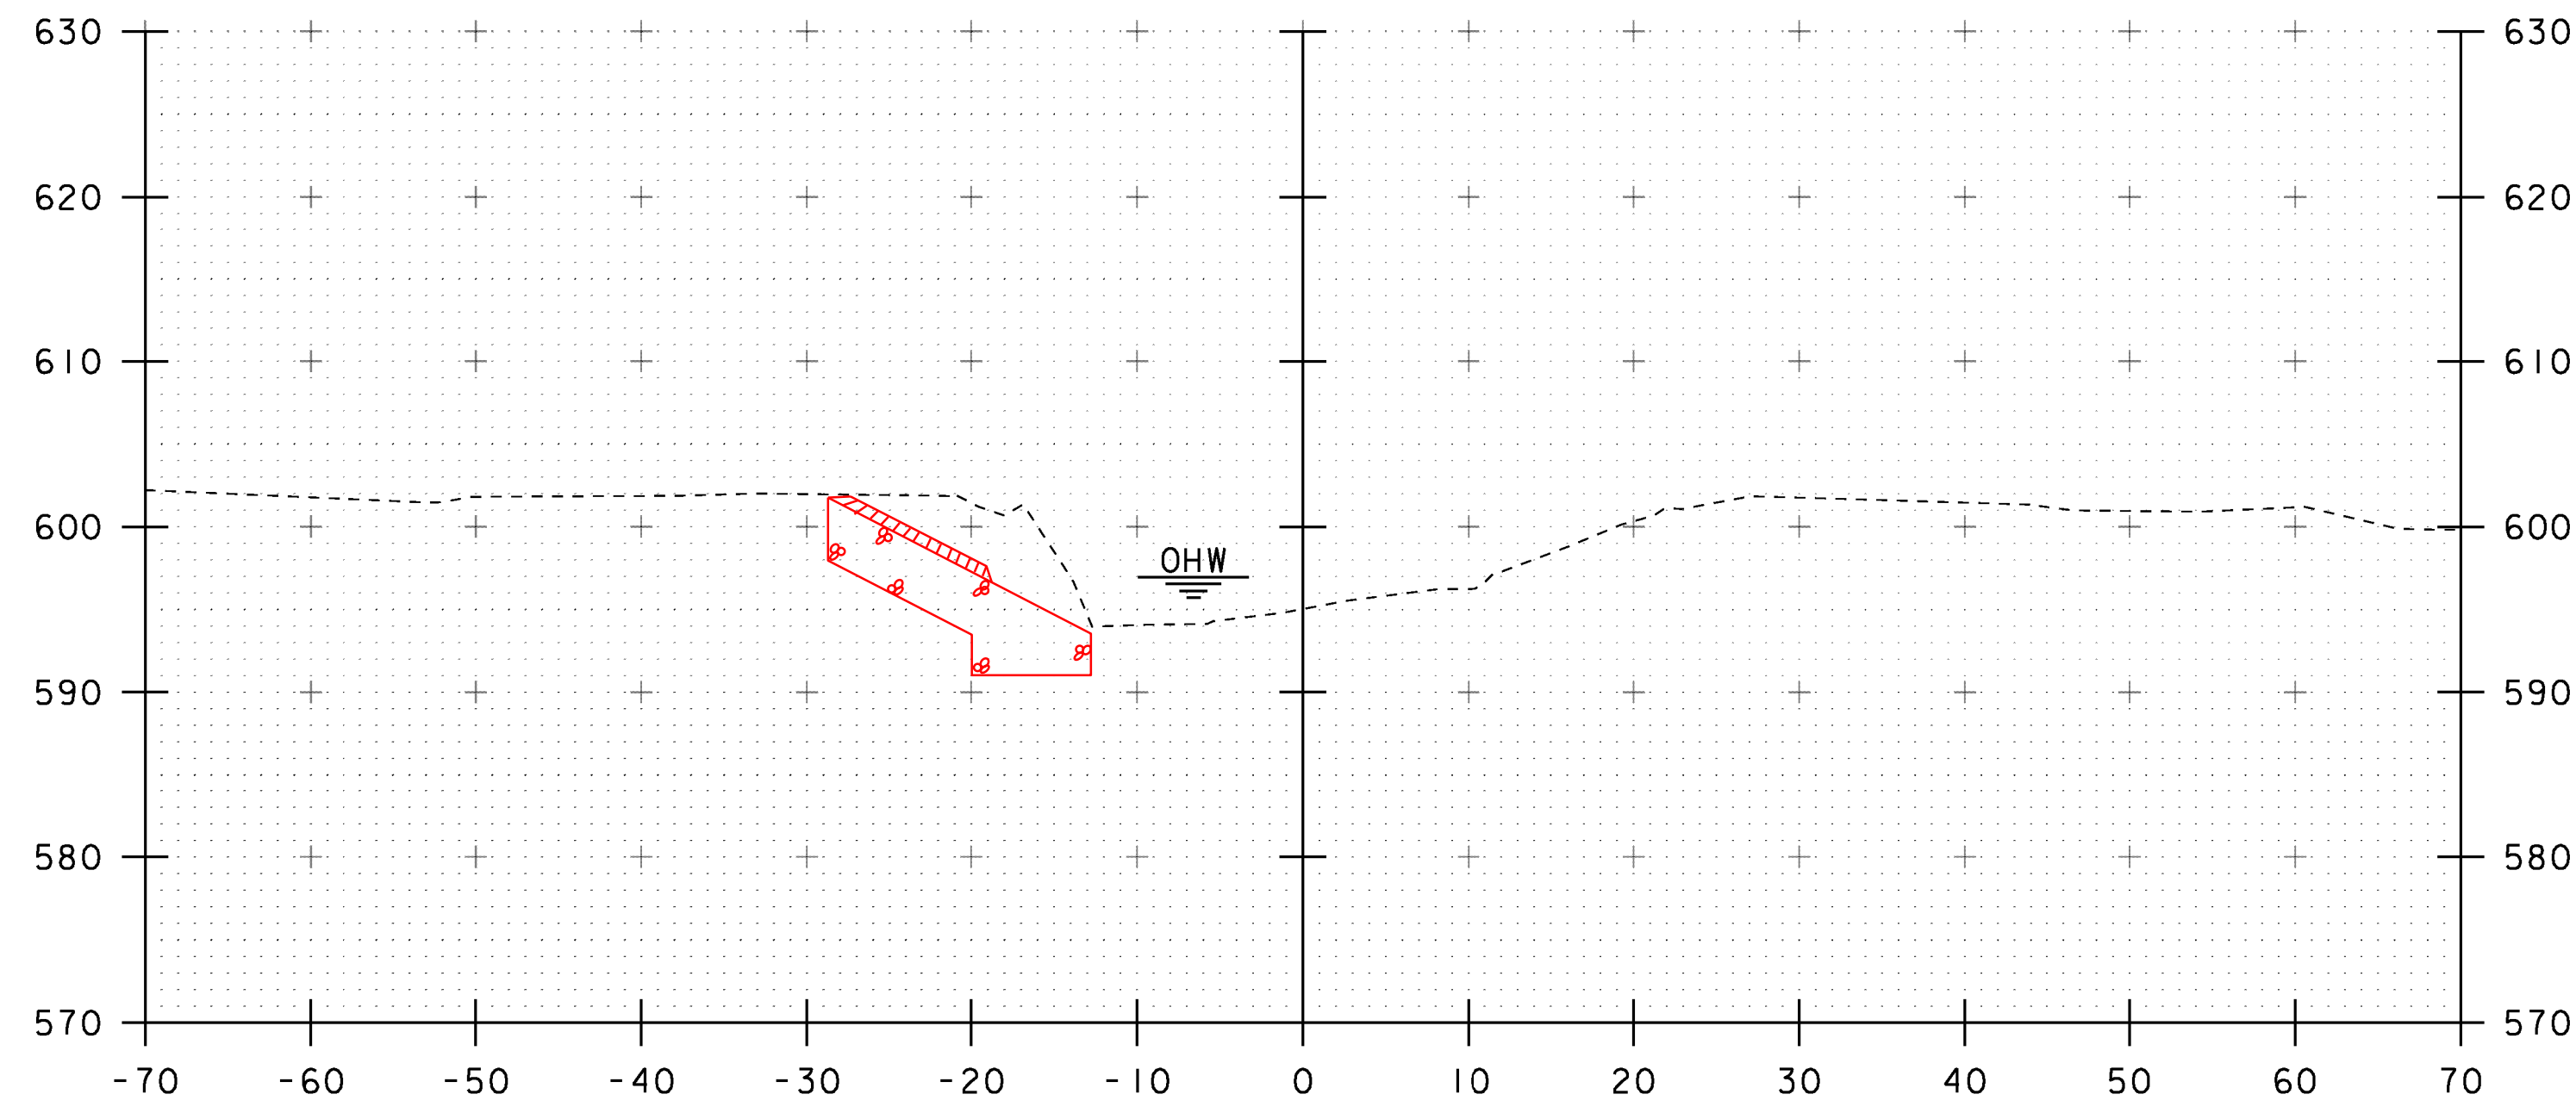


STA 50+65.00 LT - AUTHORIZED 7-27-15 (RMK)  
 STA 50+78.00 LT AND RT  
 BEGIN STONE FILL, TYPE III  
 GEOTEXTILE UNDER STONE FILL  
 GRUBBING MATERIAL  
 UNCLASSIFIED CHANNEL EXCAVATION


50+75

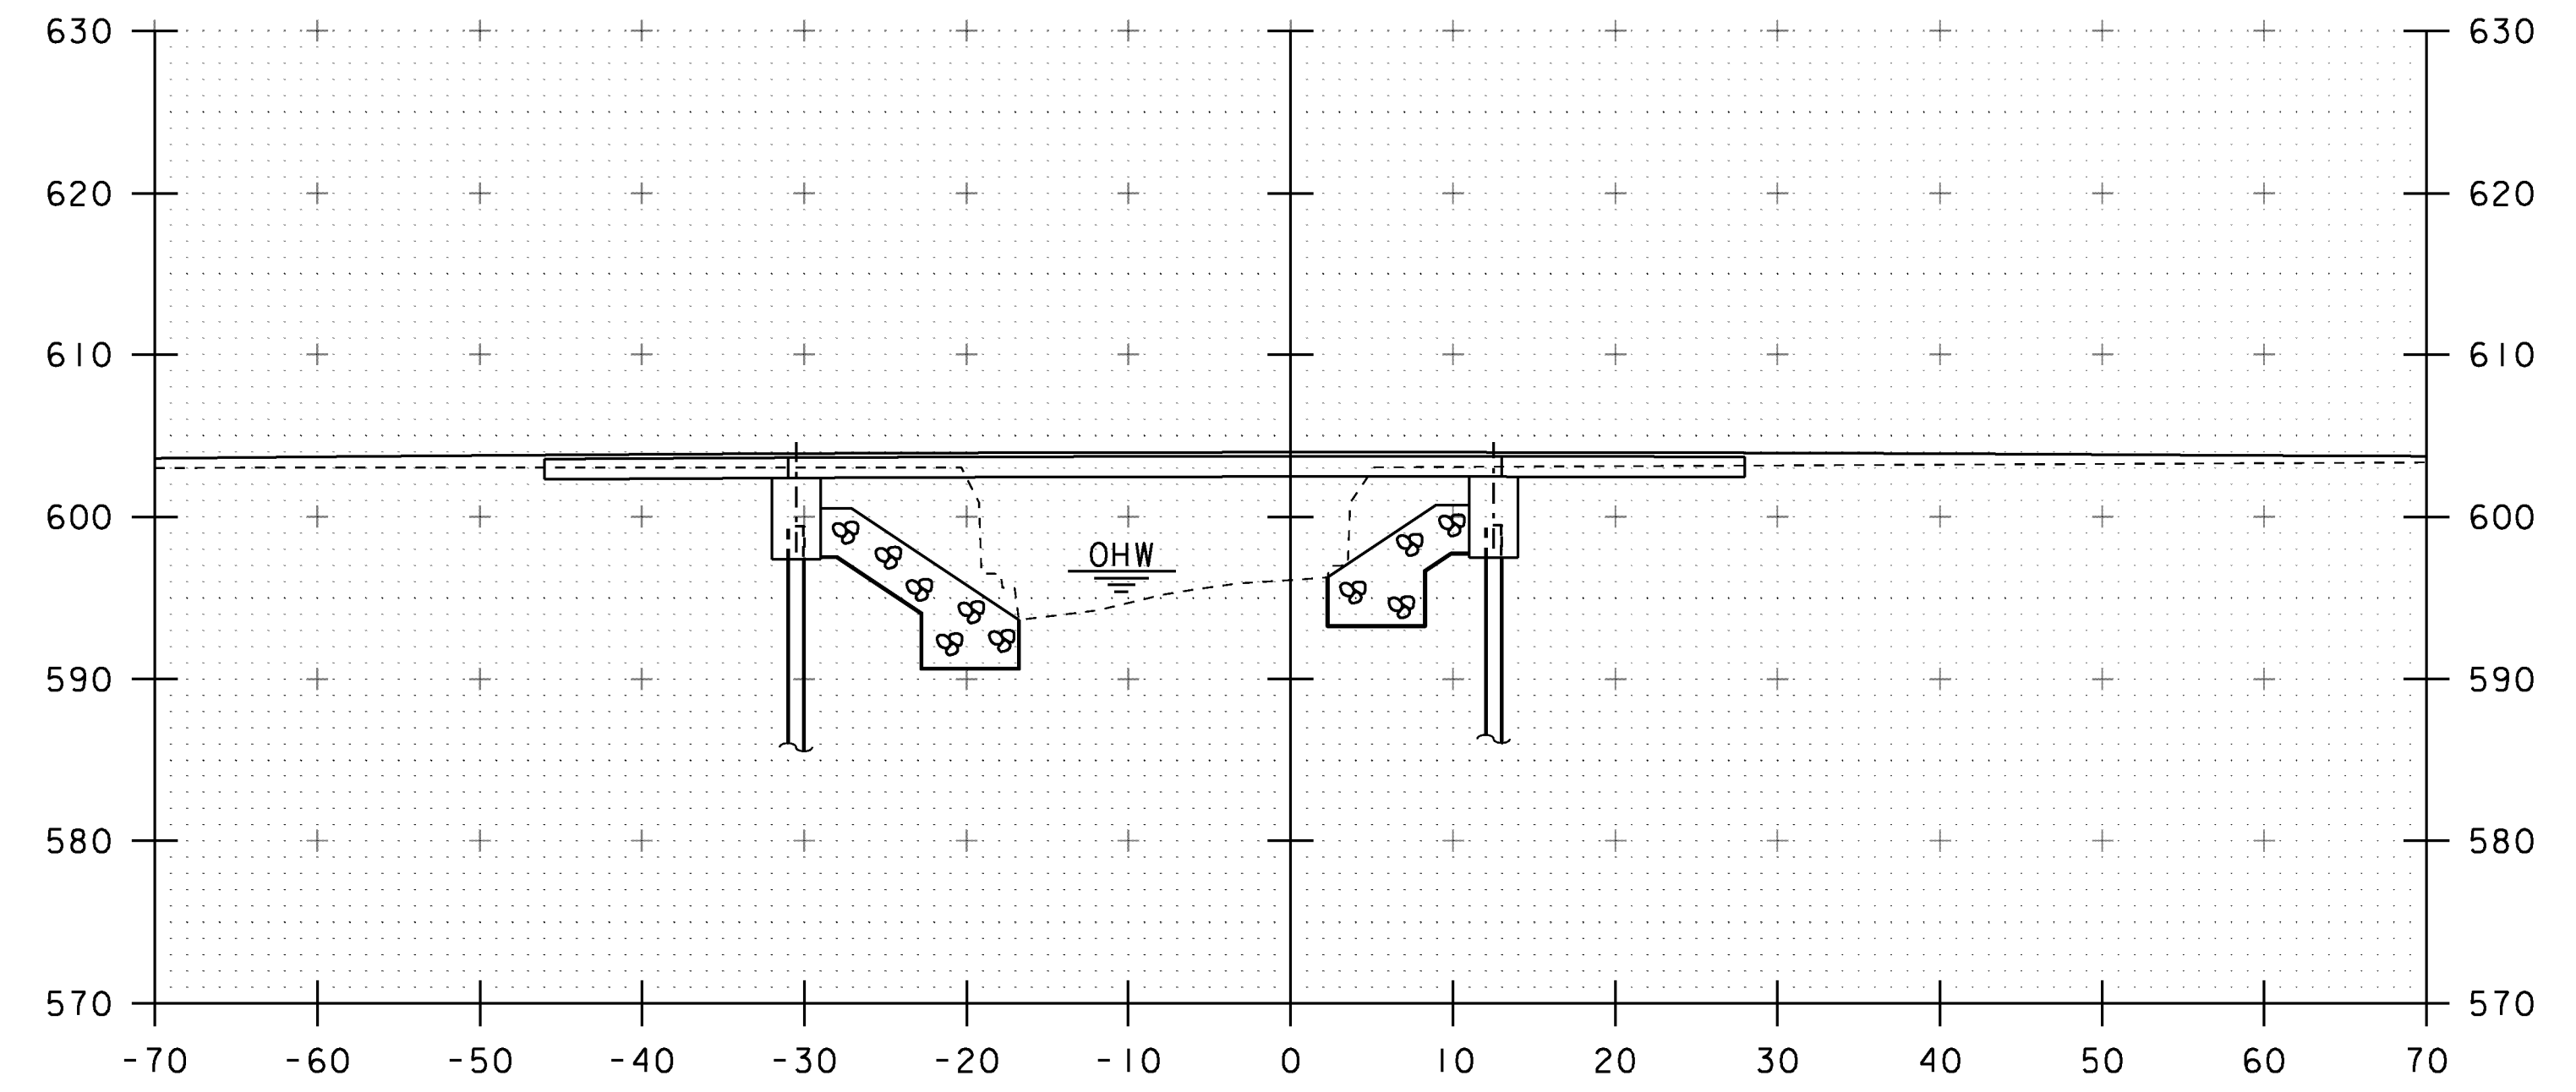

51+00

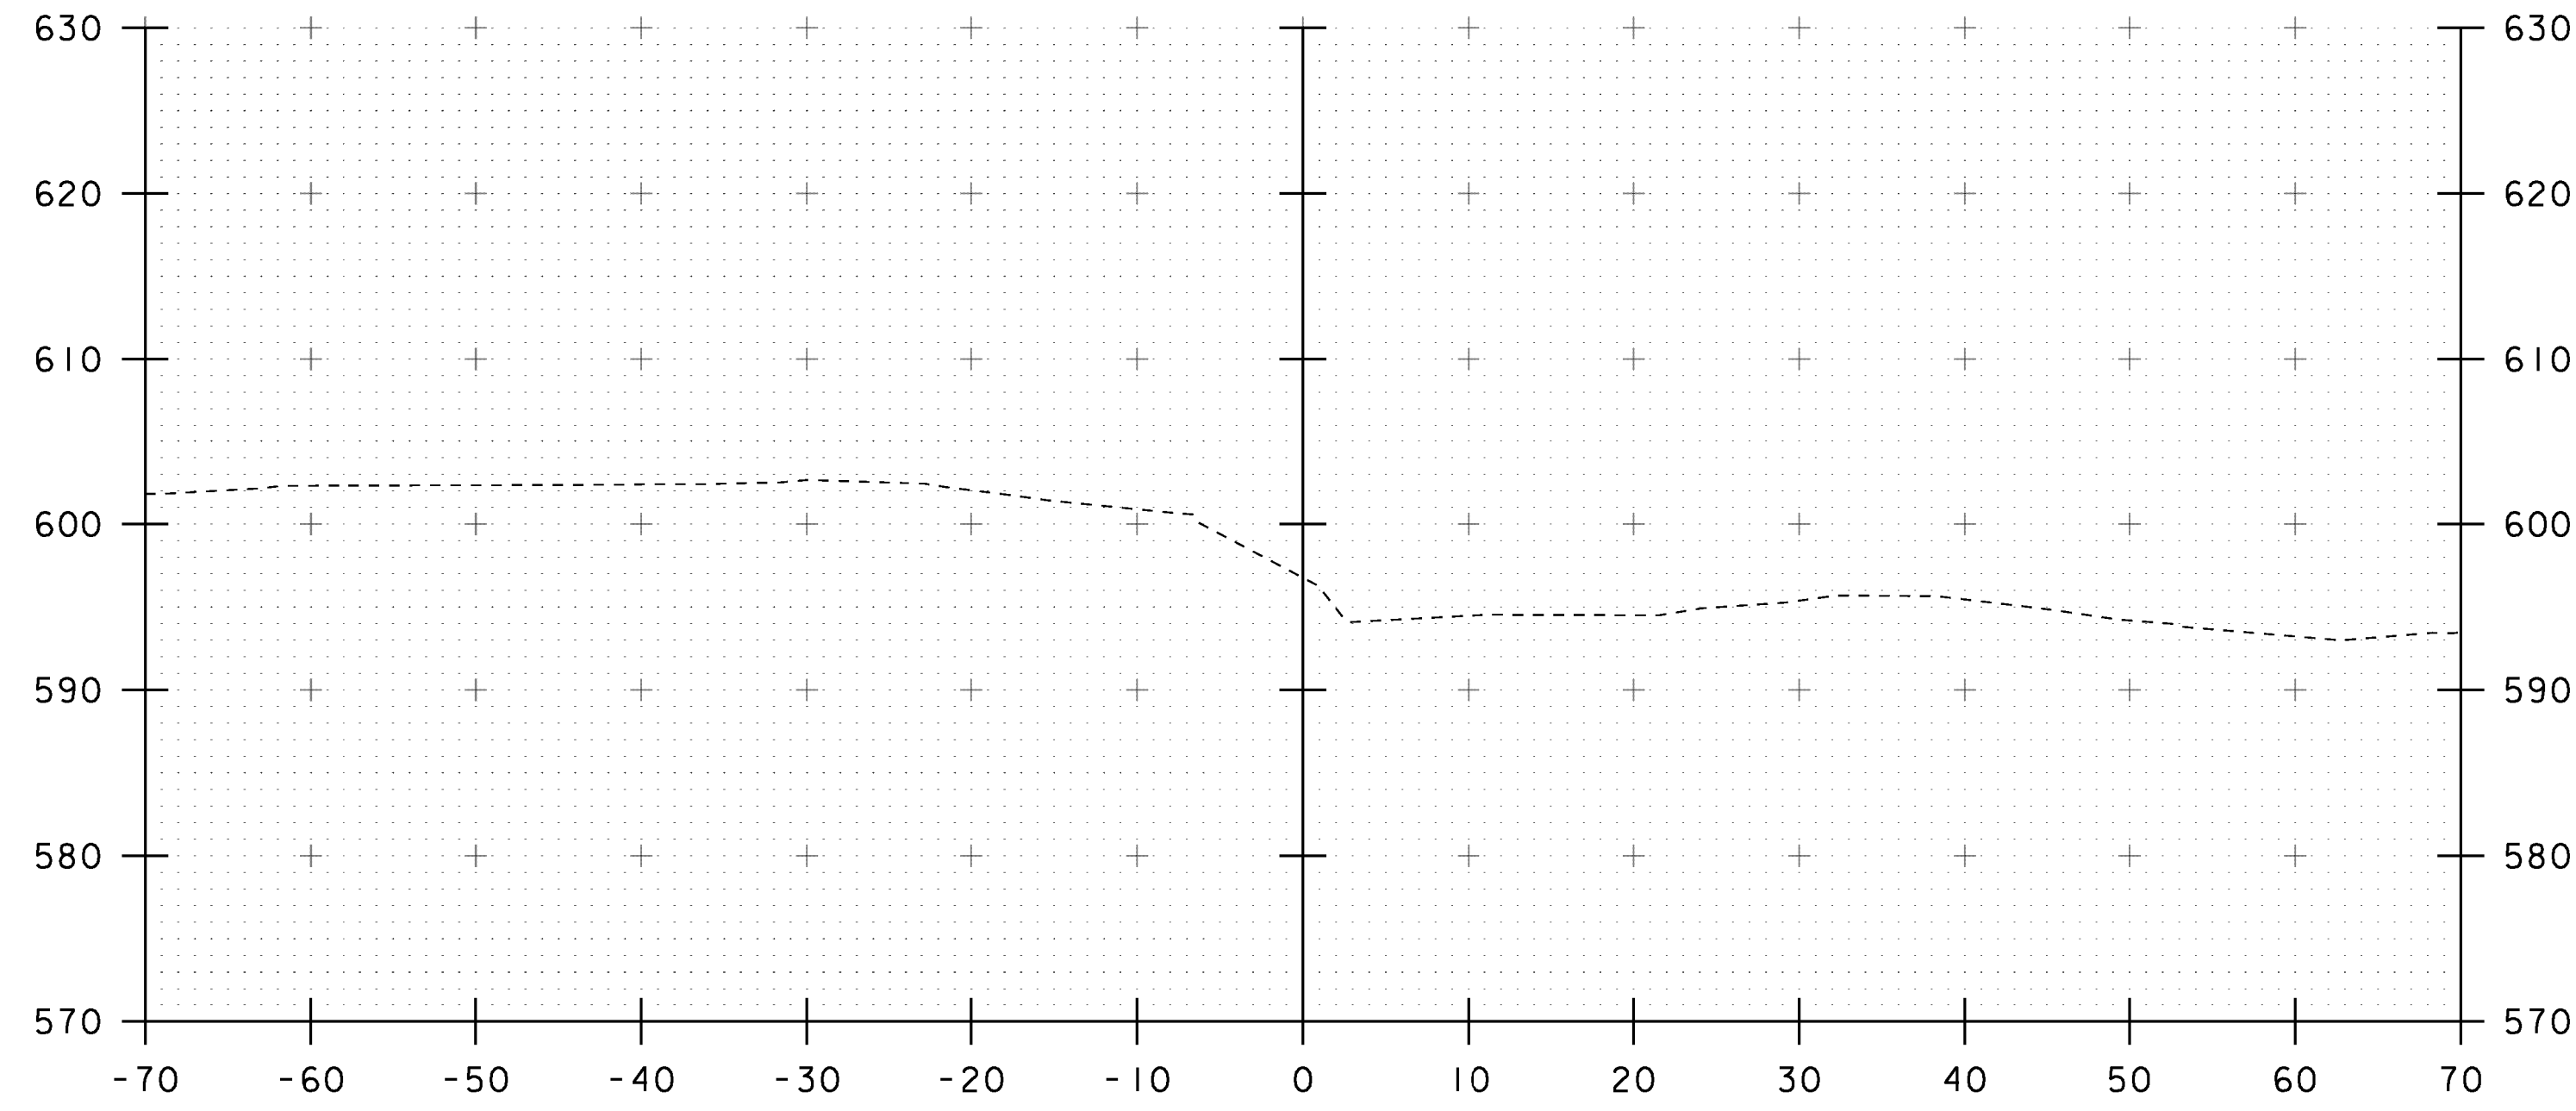

50+50

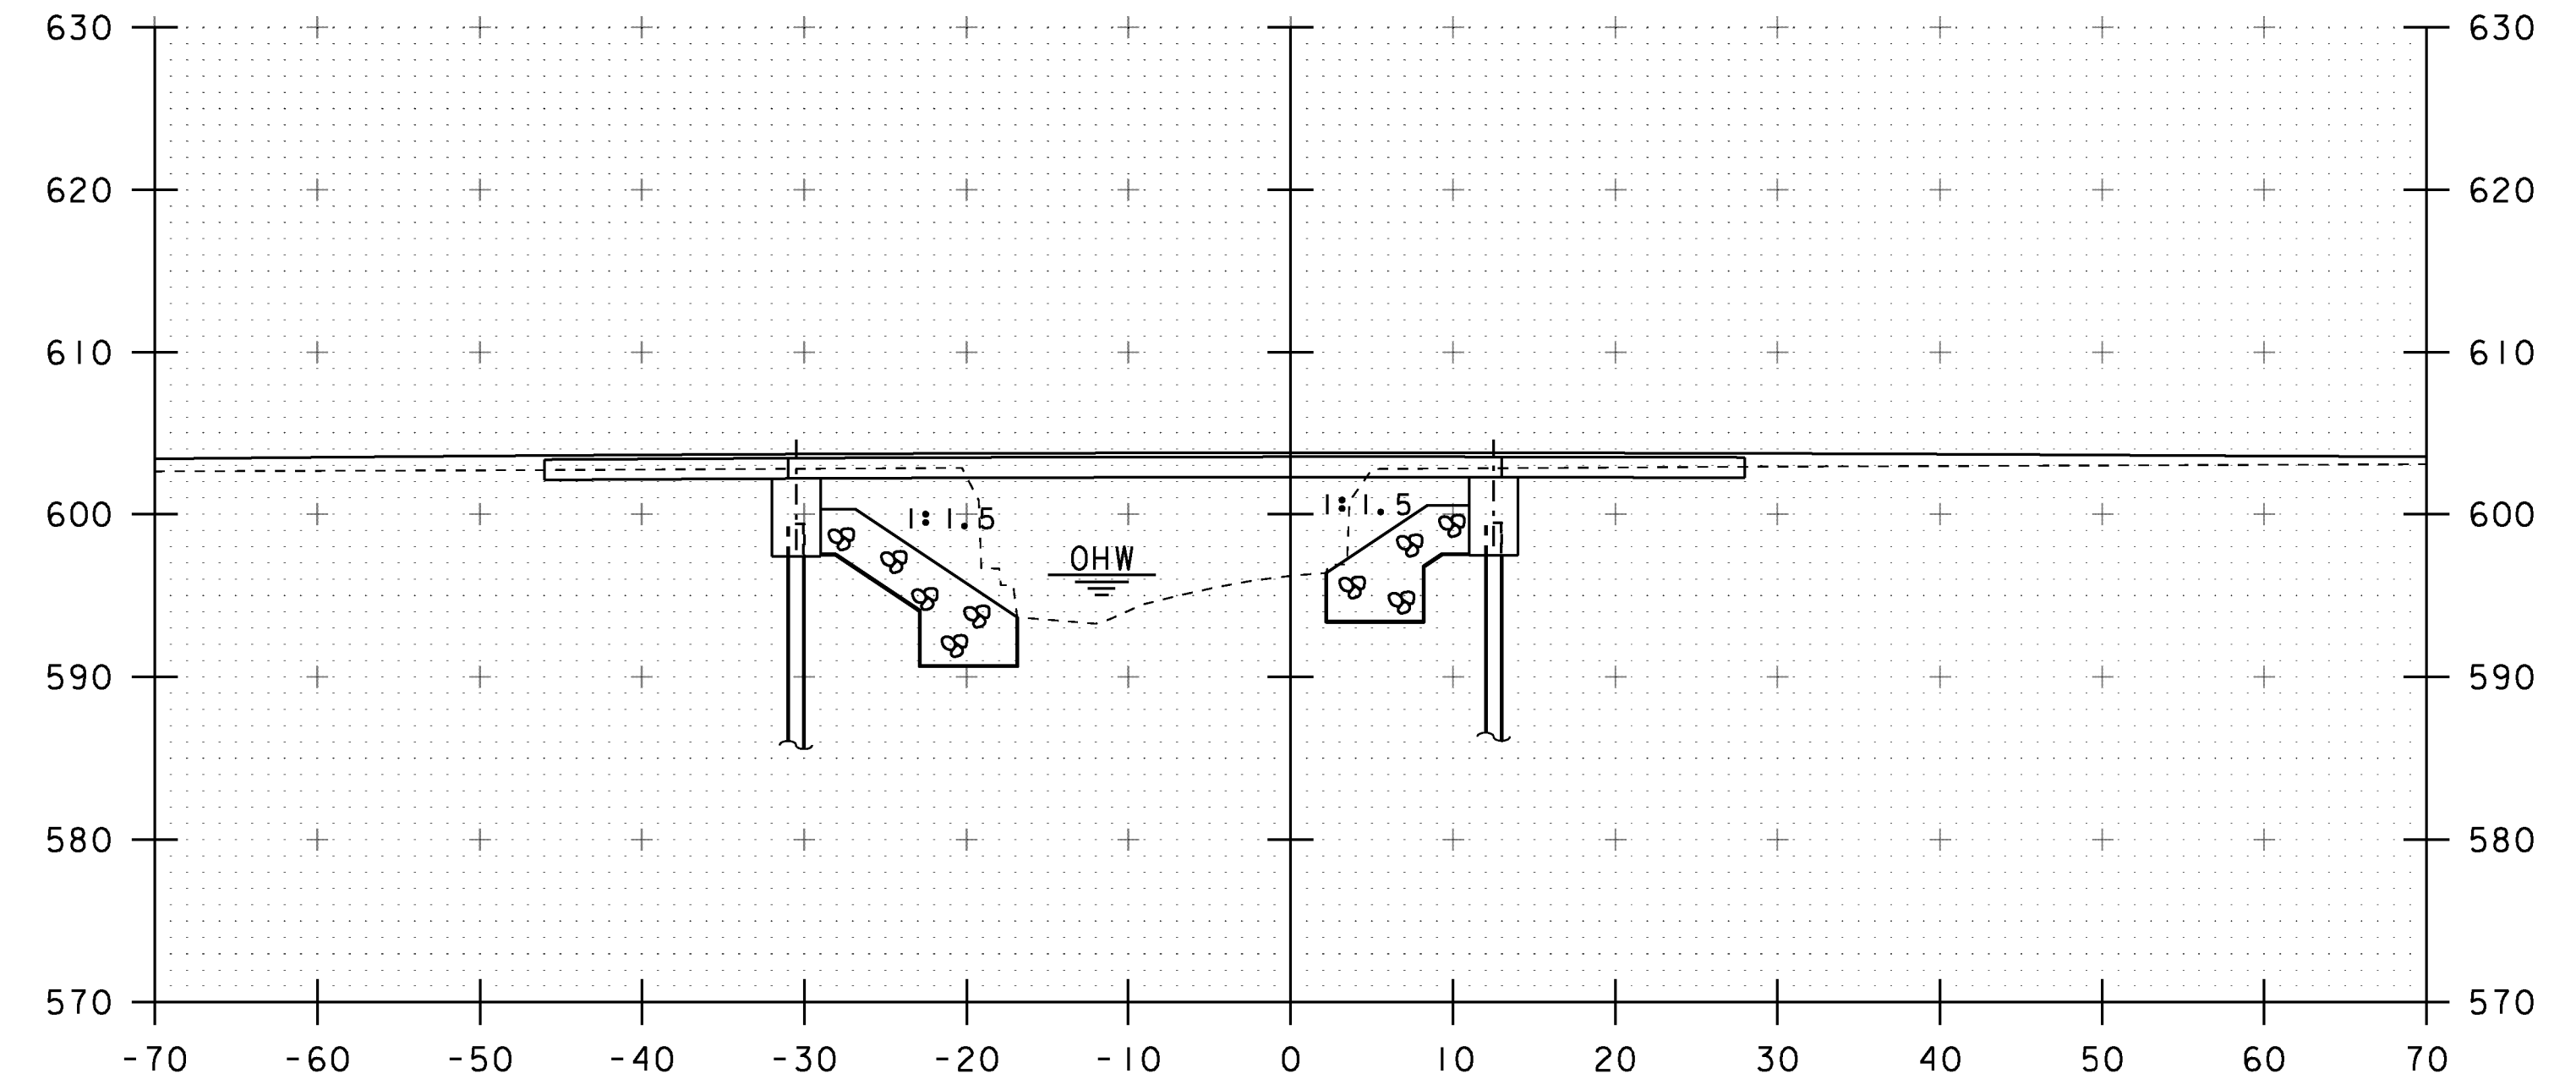


STA 50+85.00 LT AND RT  
 END GRUBBING MATERIAL


50+90

STA. 50+50 TO STA. 51+00


PROJECT NAME:	FAIRFIELD	PLOT DATE:	18-AUG-2014
PROJECT NUMBER:	BRF 0281(25)	DRAWN BY:	R. KLINEFELTER
FILE NAME:	sl2j156xs.dgn	CHECKED BY:	J. SALVATORI
PROJECT LEADER:	R. YOUNG	SHEET	36 OF 69
DESIGNED BY:	R. KLINEFELTER	CHANNEL SECTIONS	

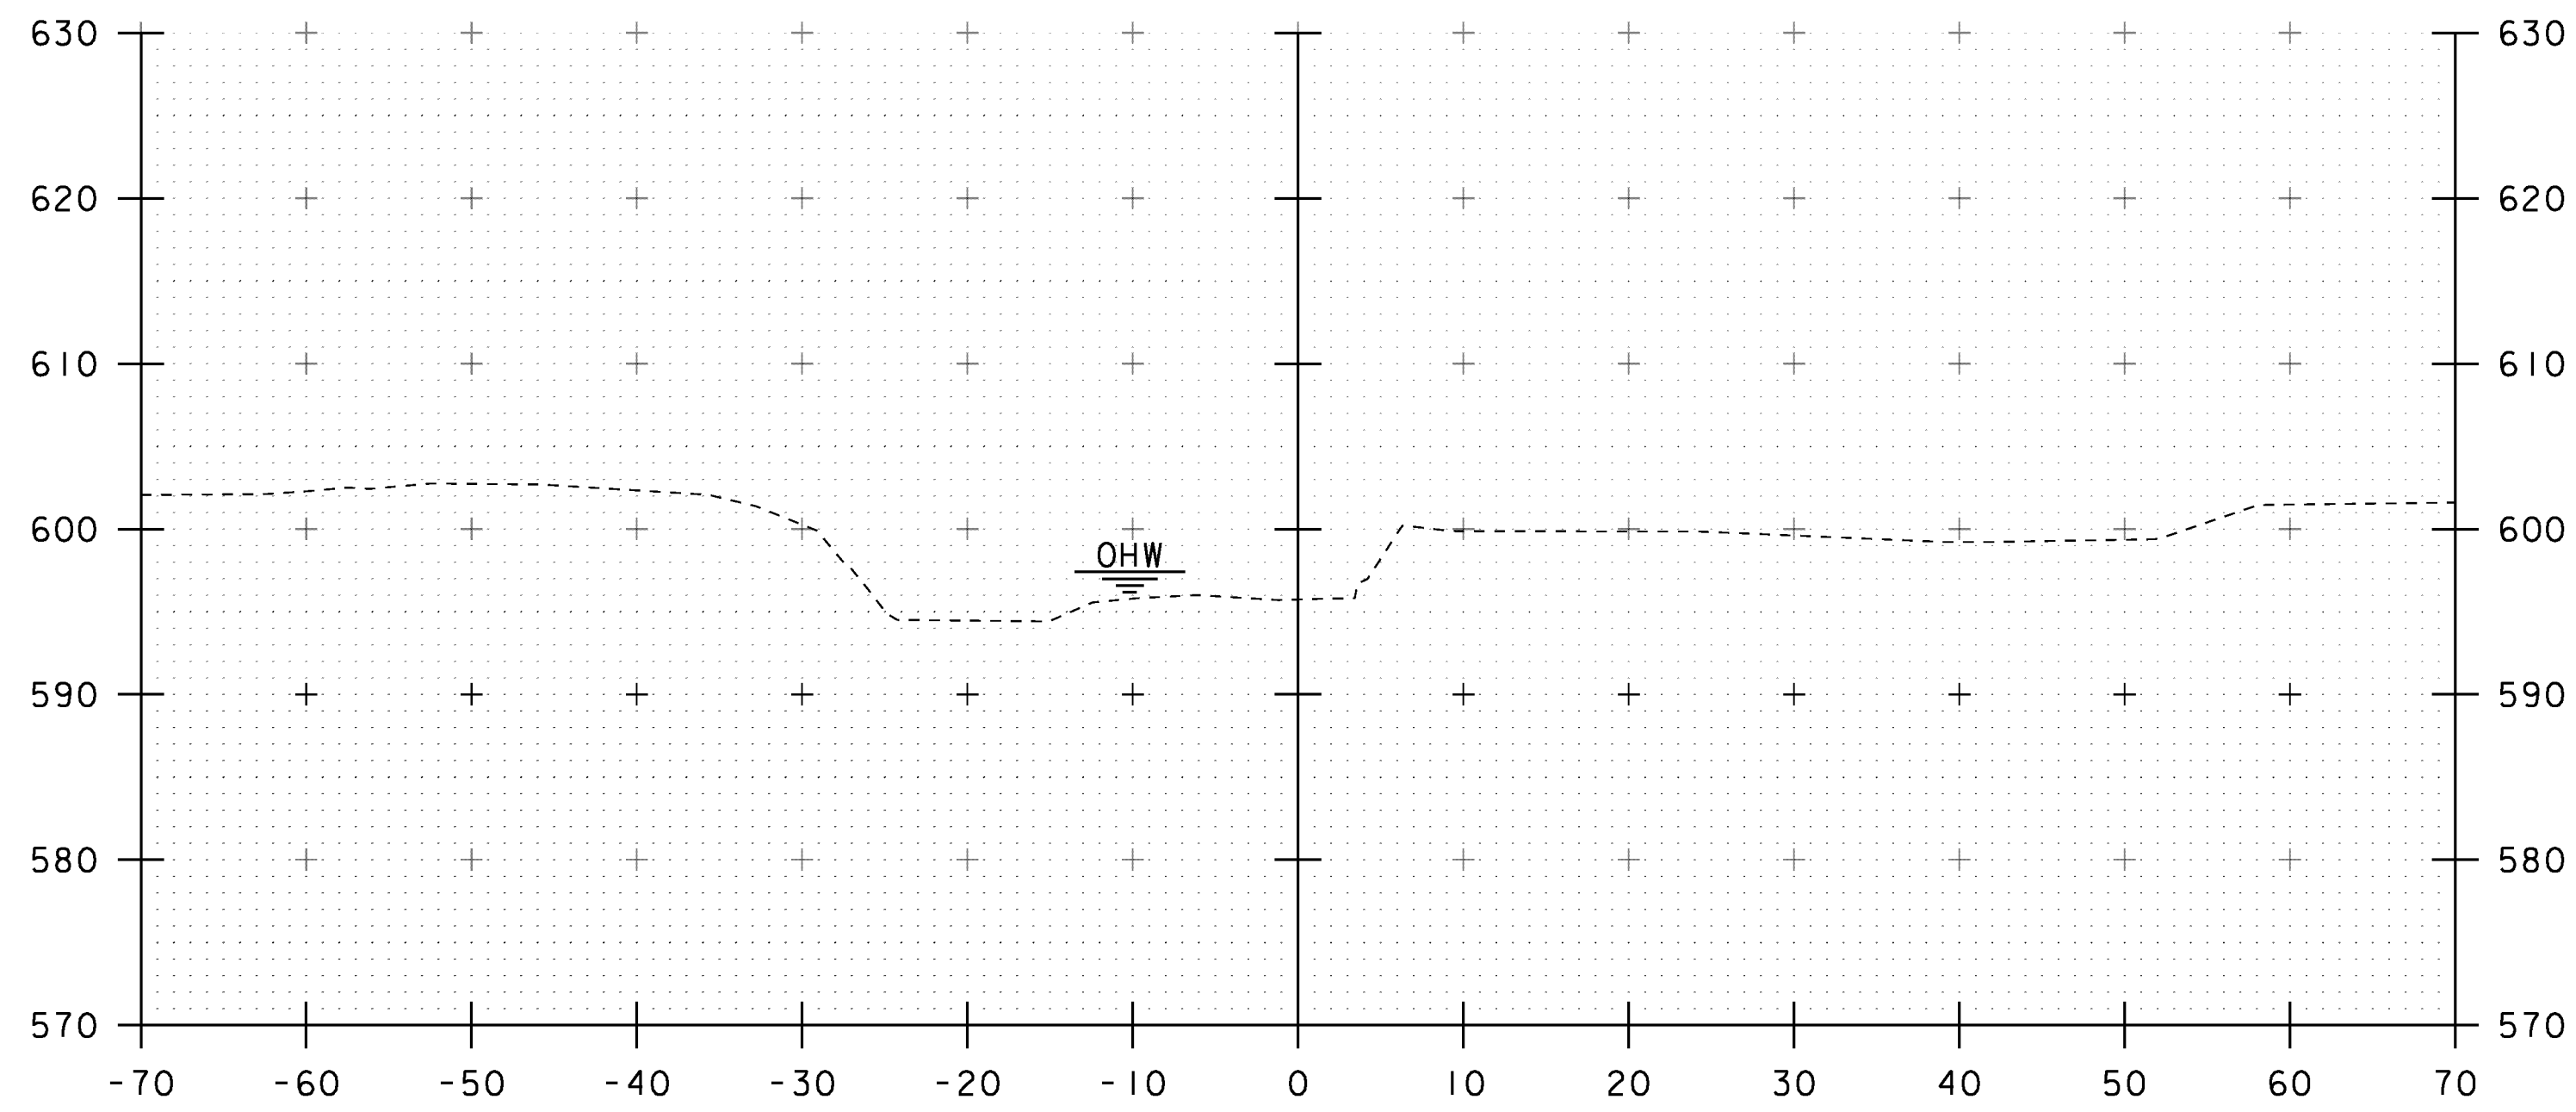


51+25

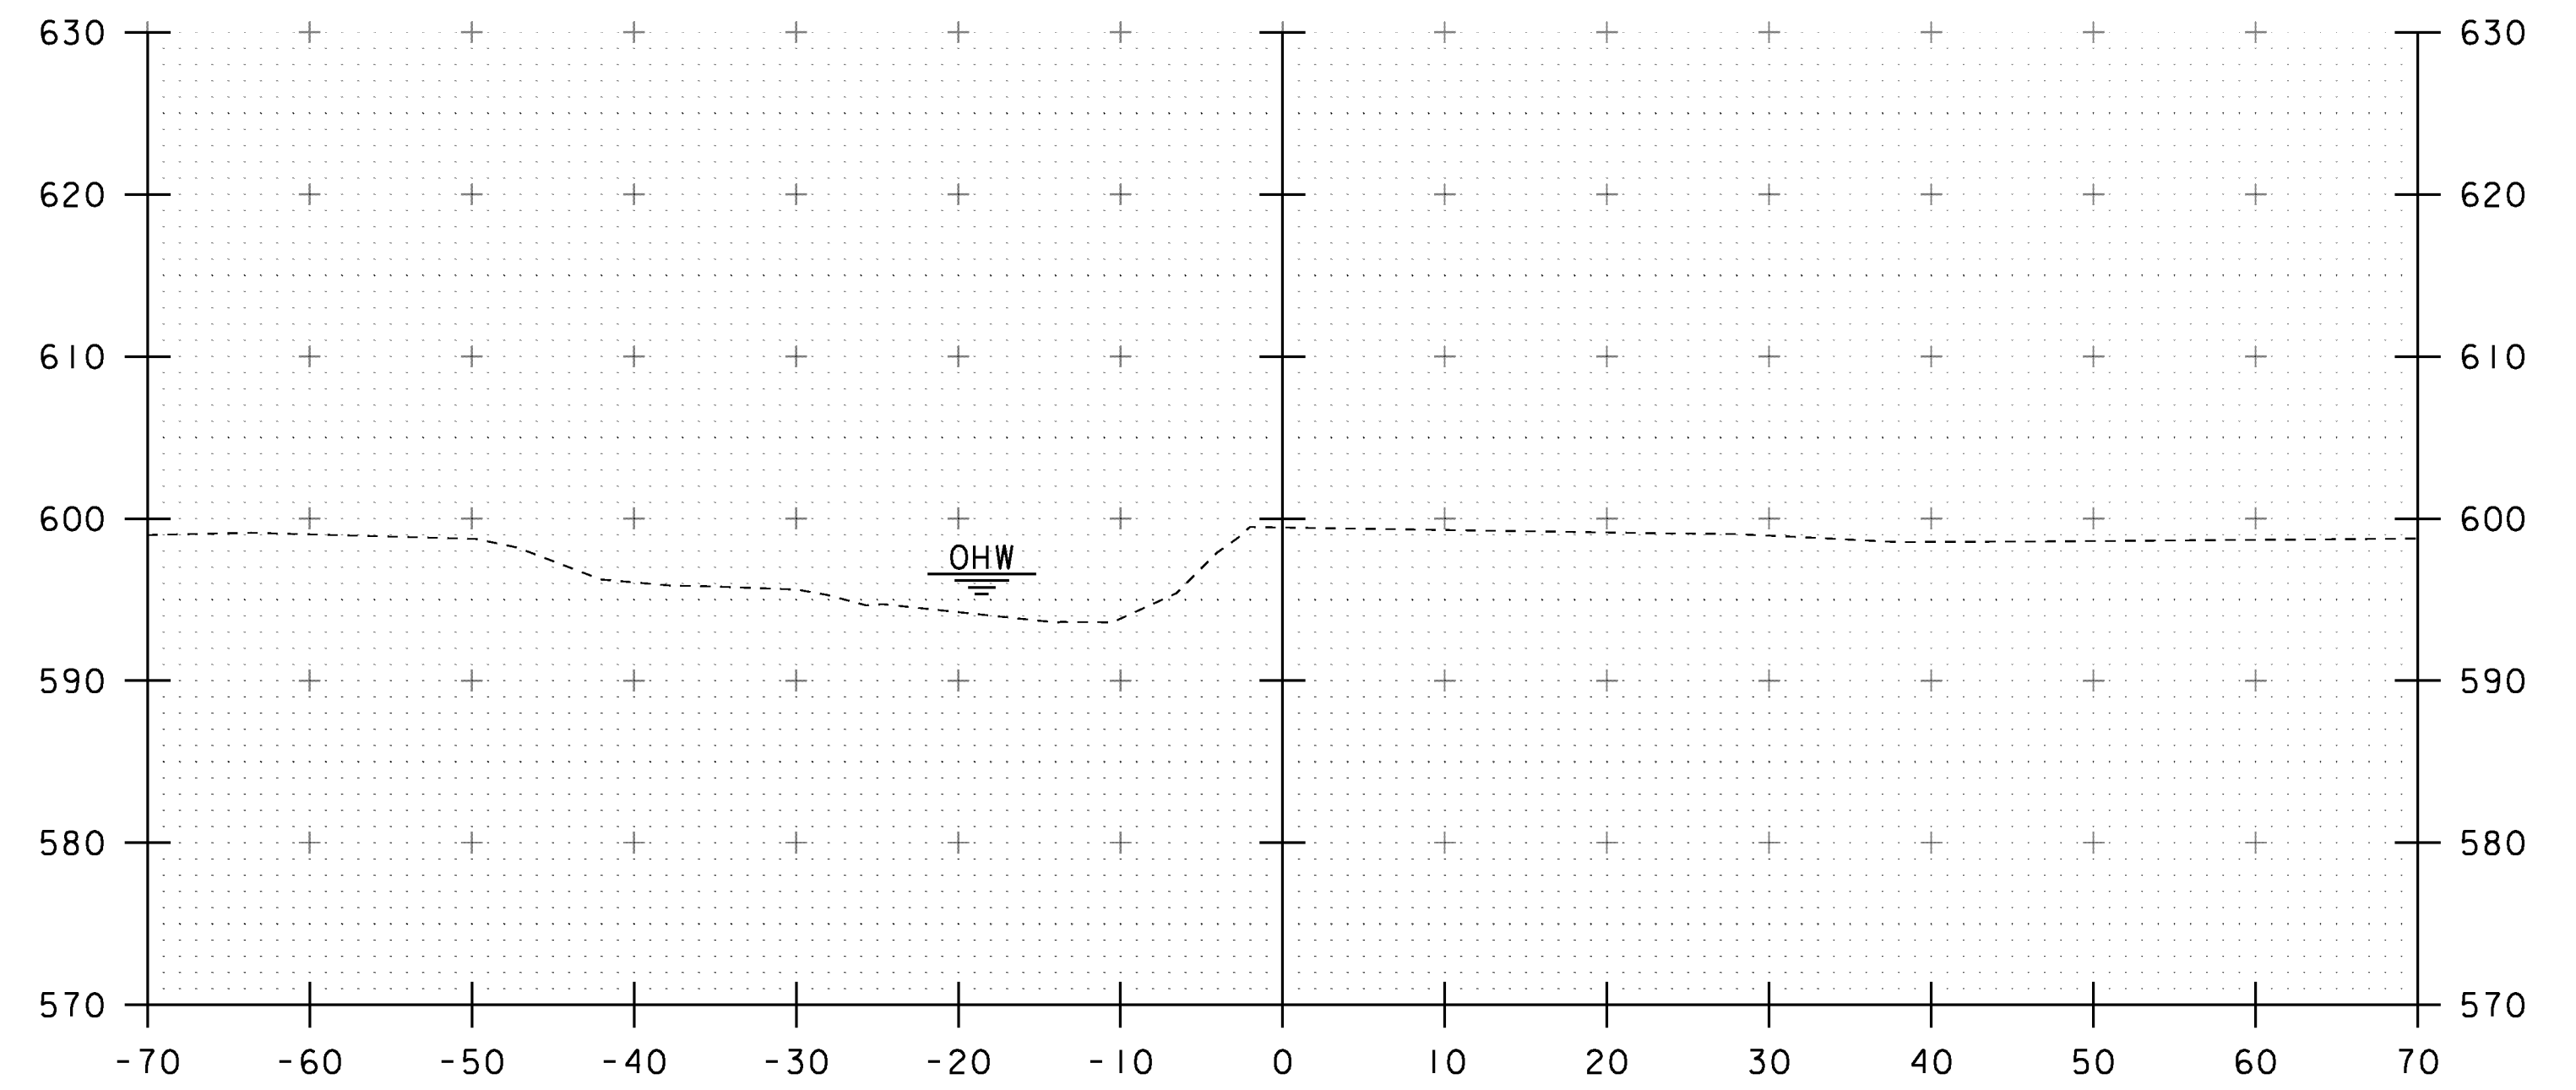

51+75

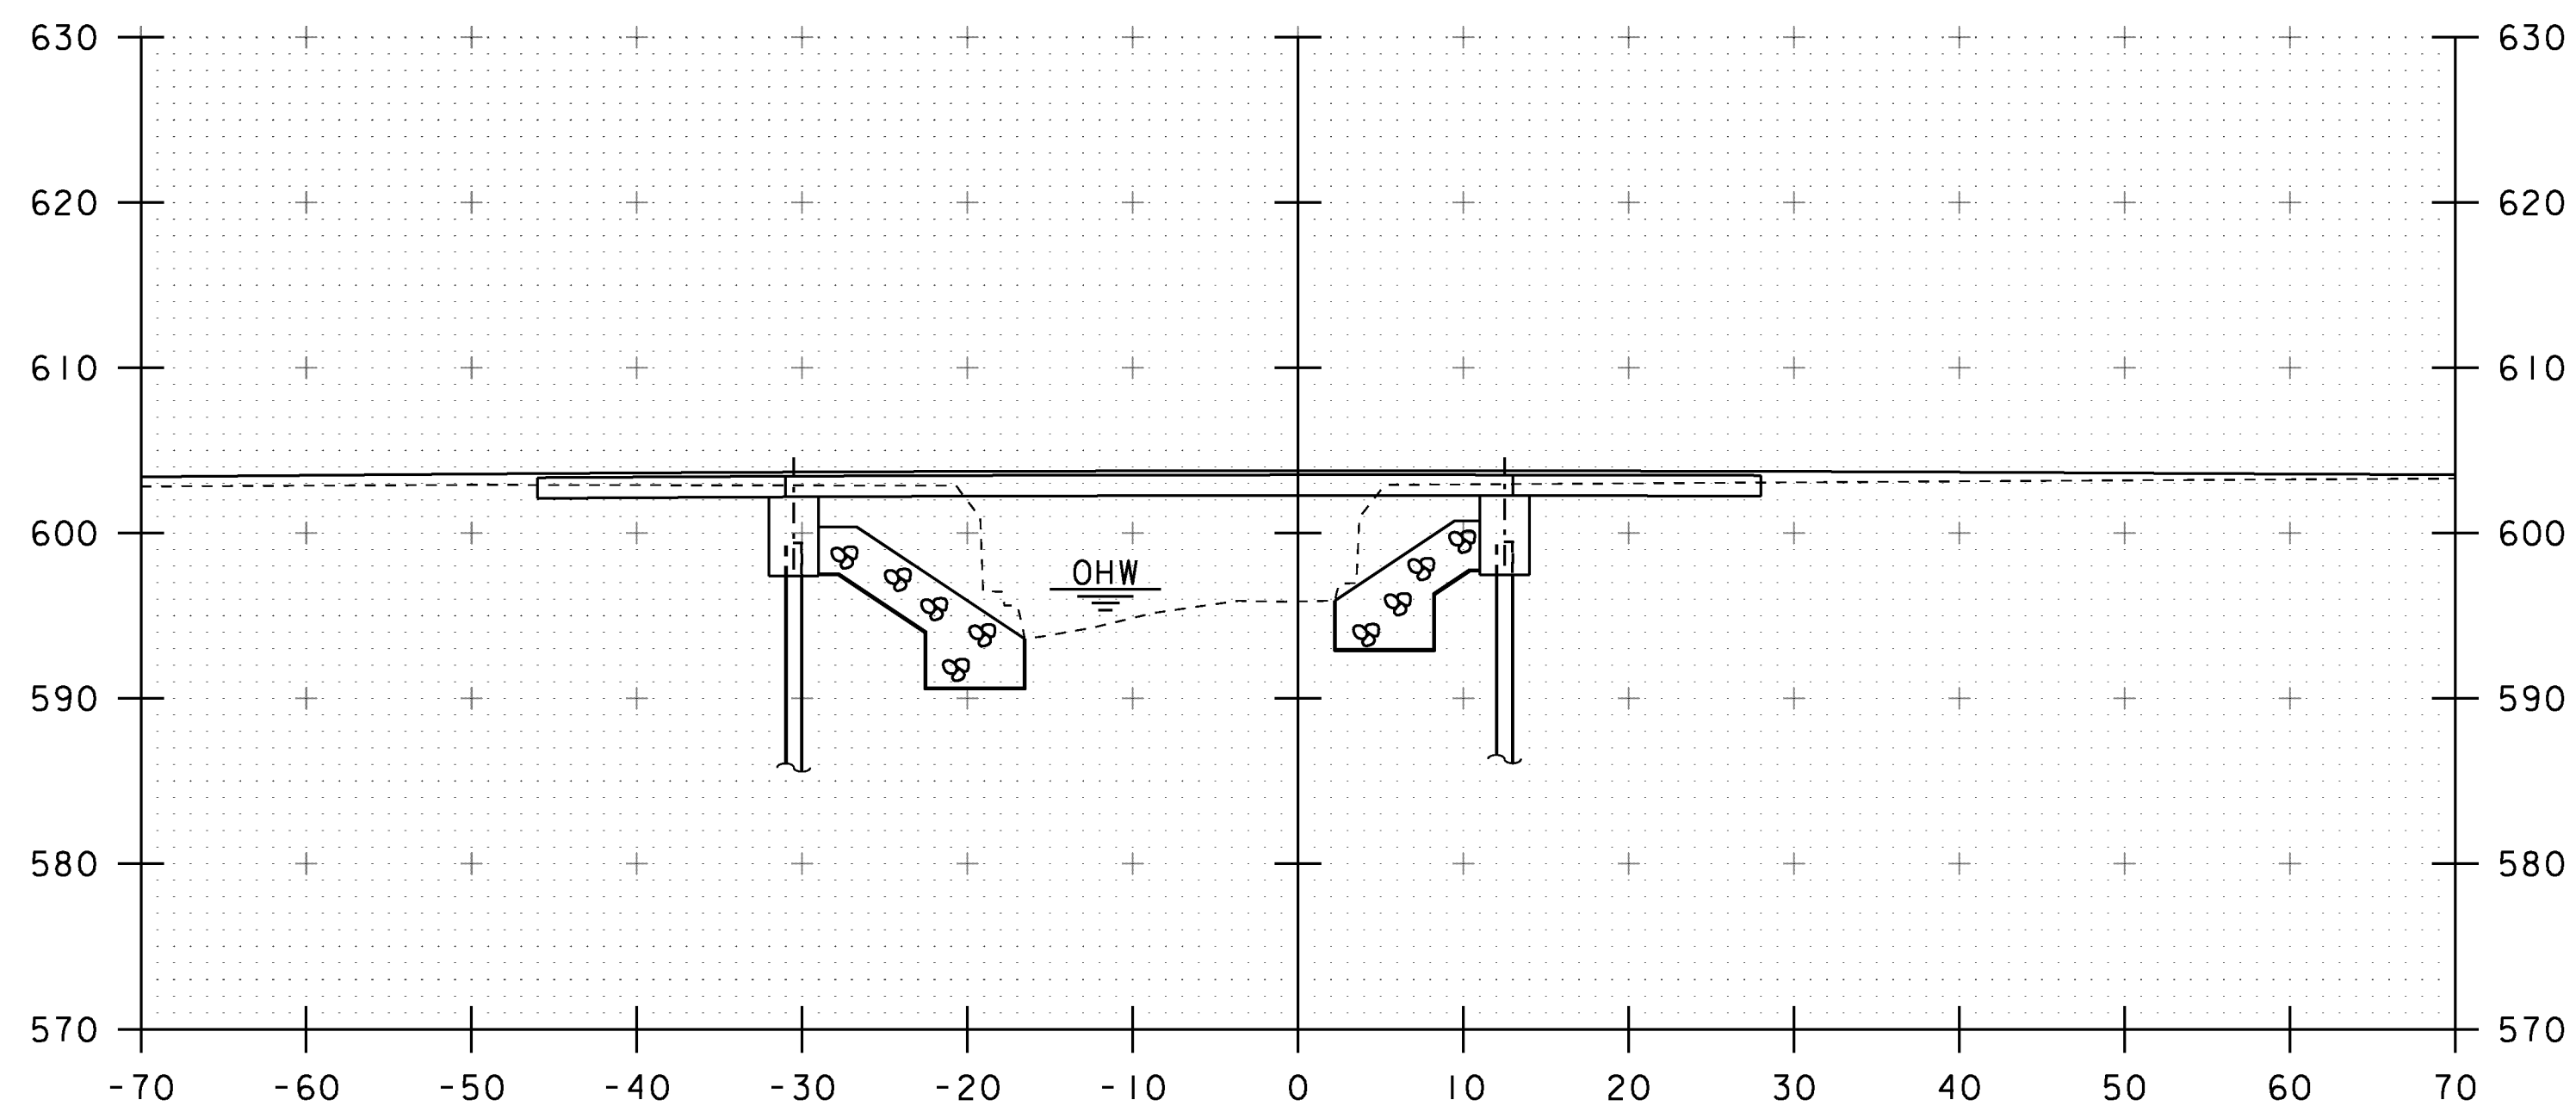

51+10

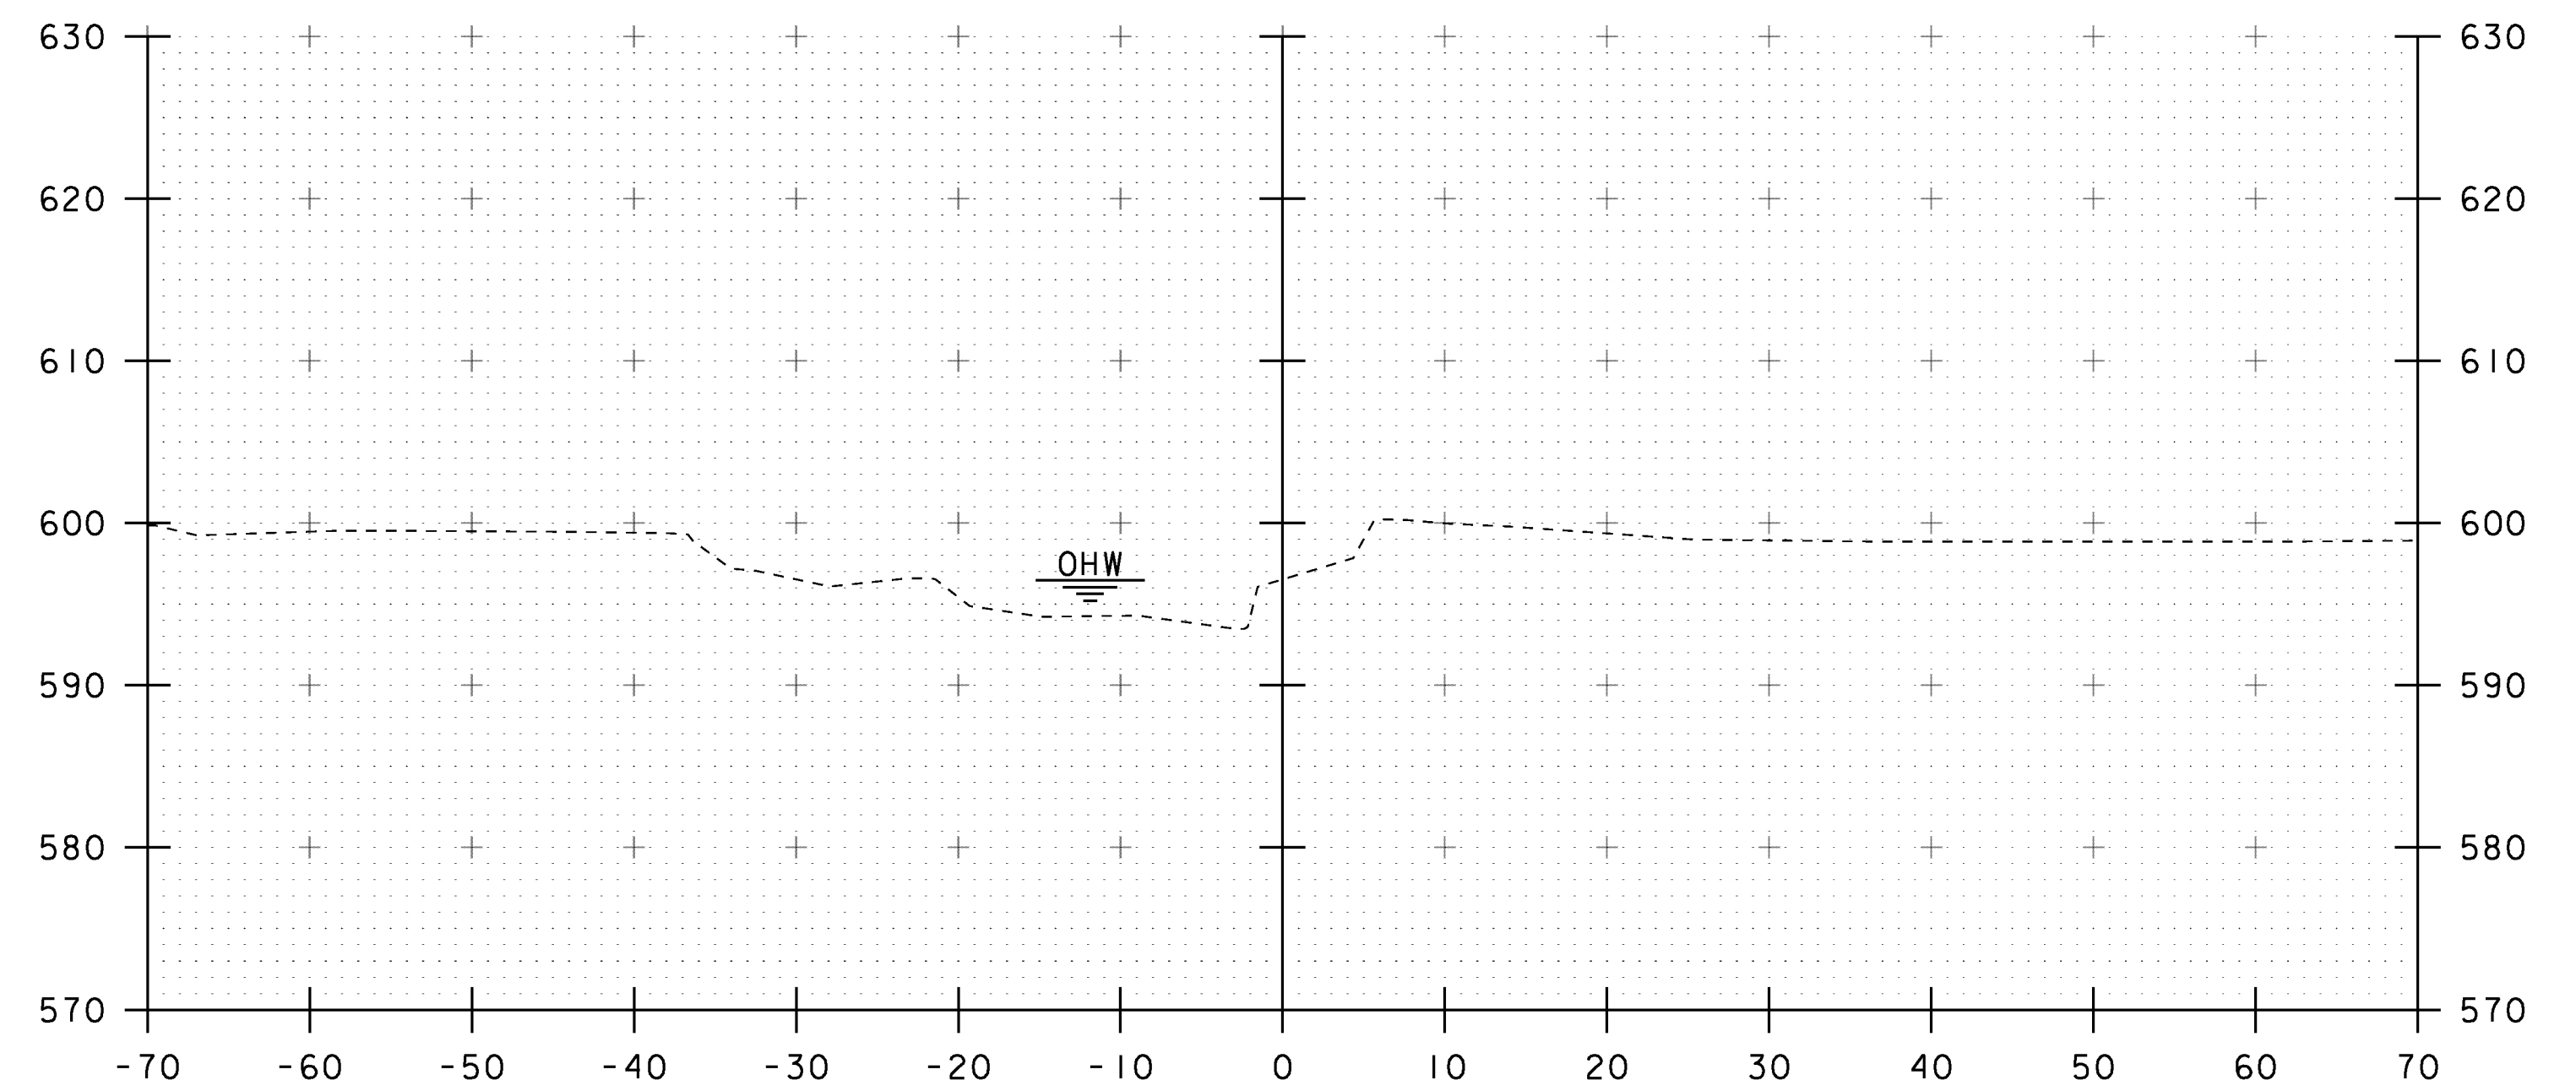

51+50

STA 51+22.00 LT AND RT  
 END STONE FILL, TYPE III  
 GEOTEXTILE UNDER STONE FILL  
 GRUBBING MATERIAL  
 UNCLASSIFIED CHANNEL EXCAVATION

STA 51+15.00 LT AND RT  
 BEGIN GRUBBING MATERIAL


STA. 51+10 TO STA. 51+75

PROJECT NAME: FAIRFIELD  
 PROJECT NUMBER: BRF 028(25)

FILE NAME: sl2j156xs.dgn  
 PROJECT LEADER: R. YOUNG  
 DESIGNED BY: R. KLINEFELTER  
 CHANNEL SECTIONS

PLOT DATE: 18-AUG-2014  
 DRAWN BY: R. KLINEFELTER  
 CHECKED BY: J. SALVATORI  
 SHEET 37 OF 69

# STATE OF VERMONT AGENCY OF TRANSPORTATION

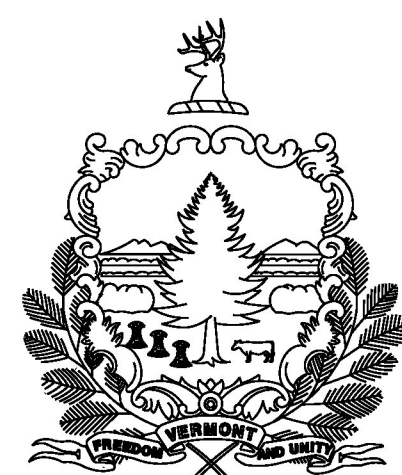

## PROPOSED IMPROVEMENT BRIDGE PROJECT




TOWN OF FAIRFIELD  
COUNTY OF FRANKLIN

ROUTE NO : ELM BROOK ROAD, TOWN HIGHWAY 47 (CLASS 3)      TOWN BRIDGE NO : 46

PROJECT LOCATION:      LOCATED 0.05 MILES WESTERLY OF THE JUNCTION OF TOWN HIGHWAY 47 AND VT ROUTE 36.

PROJECT DESCRIPTION: REPLACEMENT OF EXISTING BRIDGE WITH RELATED ROADWAY APPROACH  
AND CHANNEL WORK.

LENGTH OF STRUCTURE:      54.00 FEET  
LENGTH OF ROADWAY:      21.00 FEET  
LENGTH OF PROJECT:      75.00 FEET

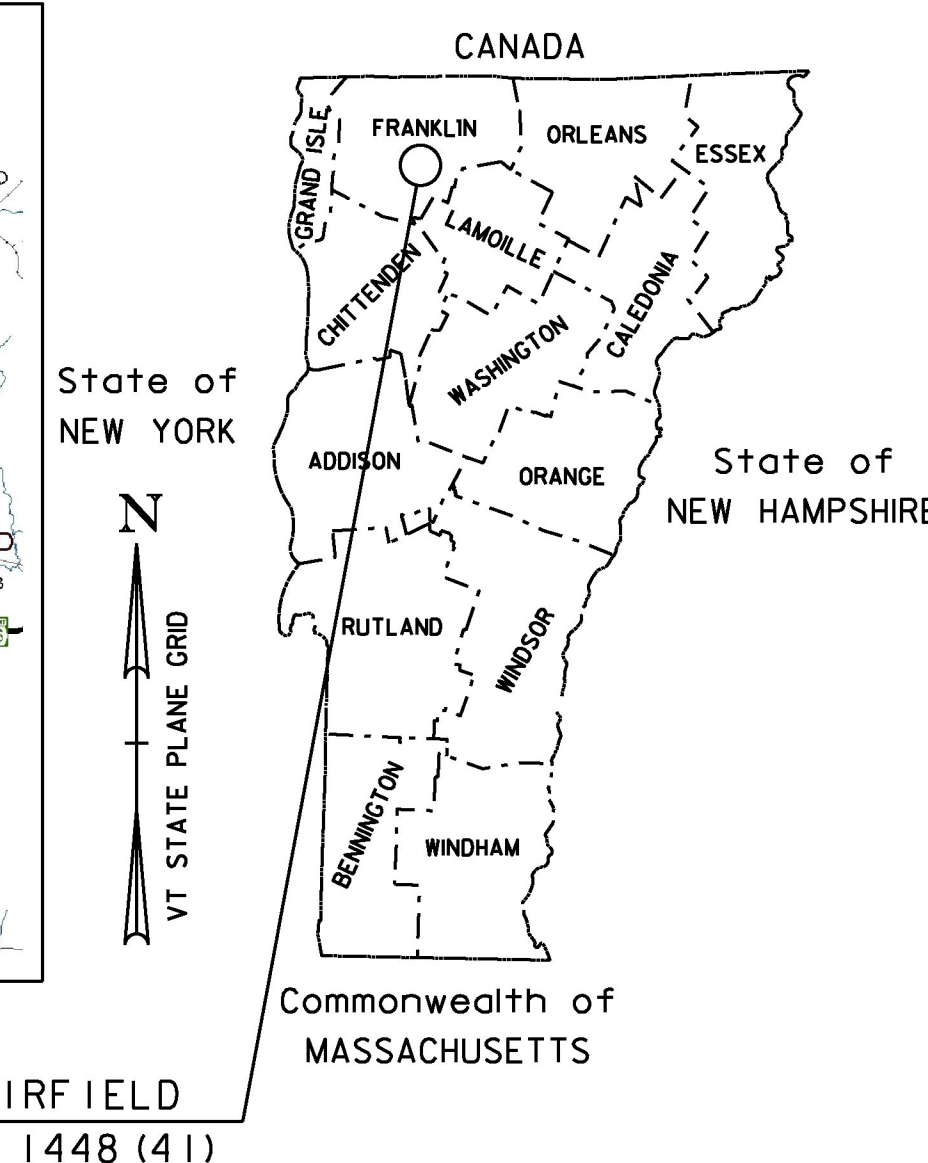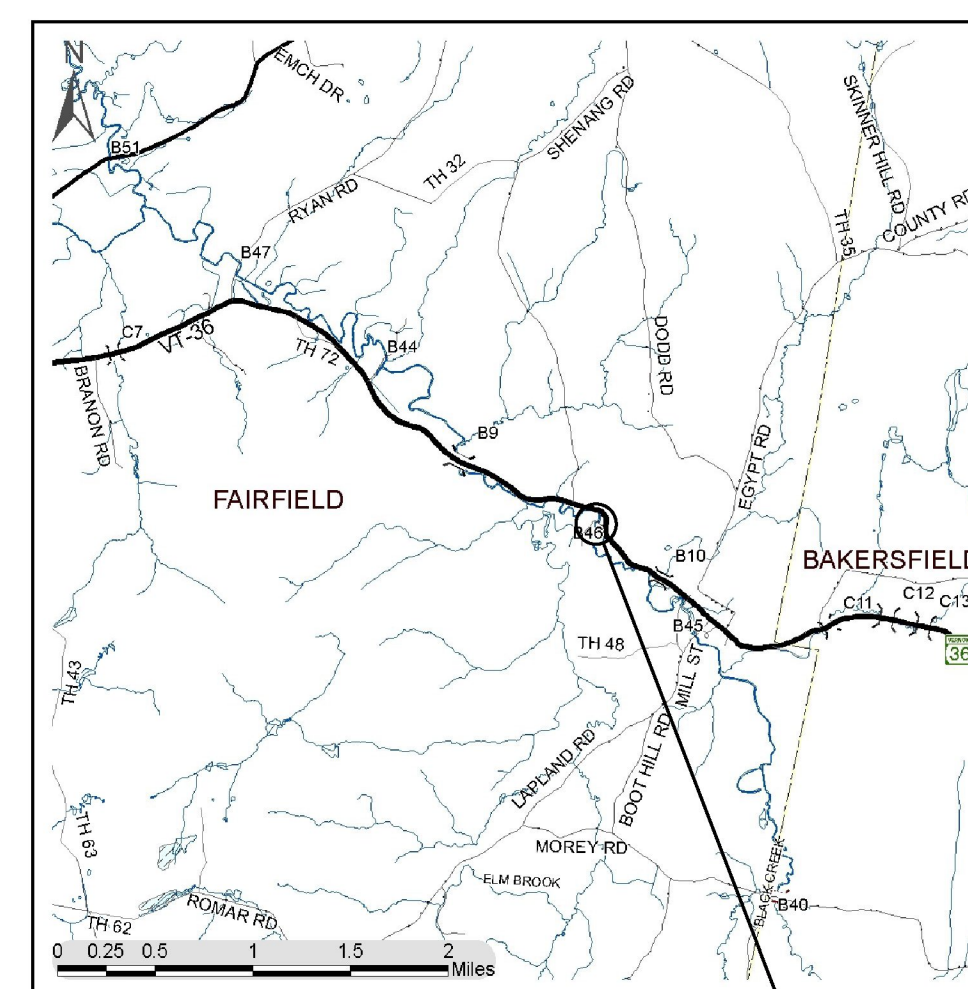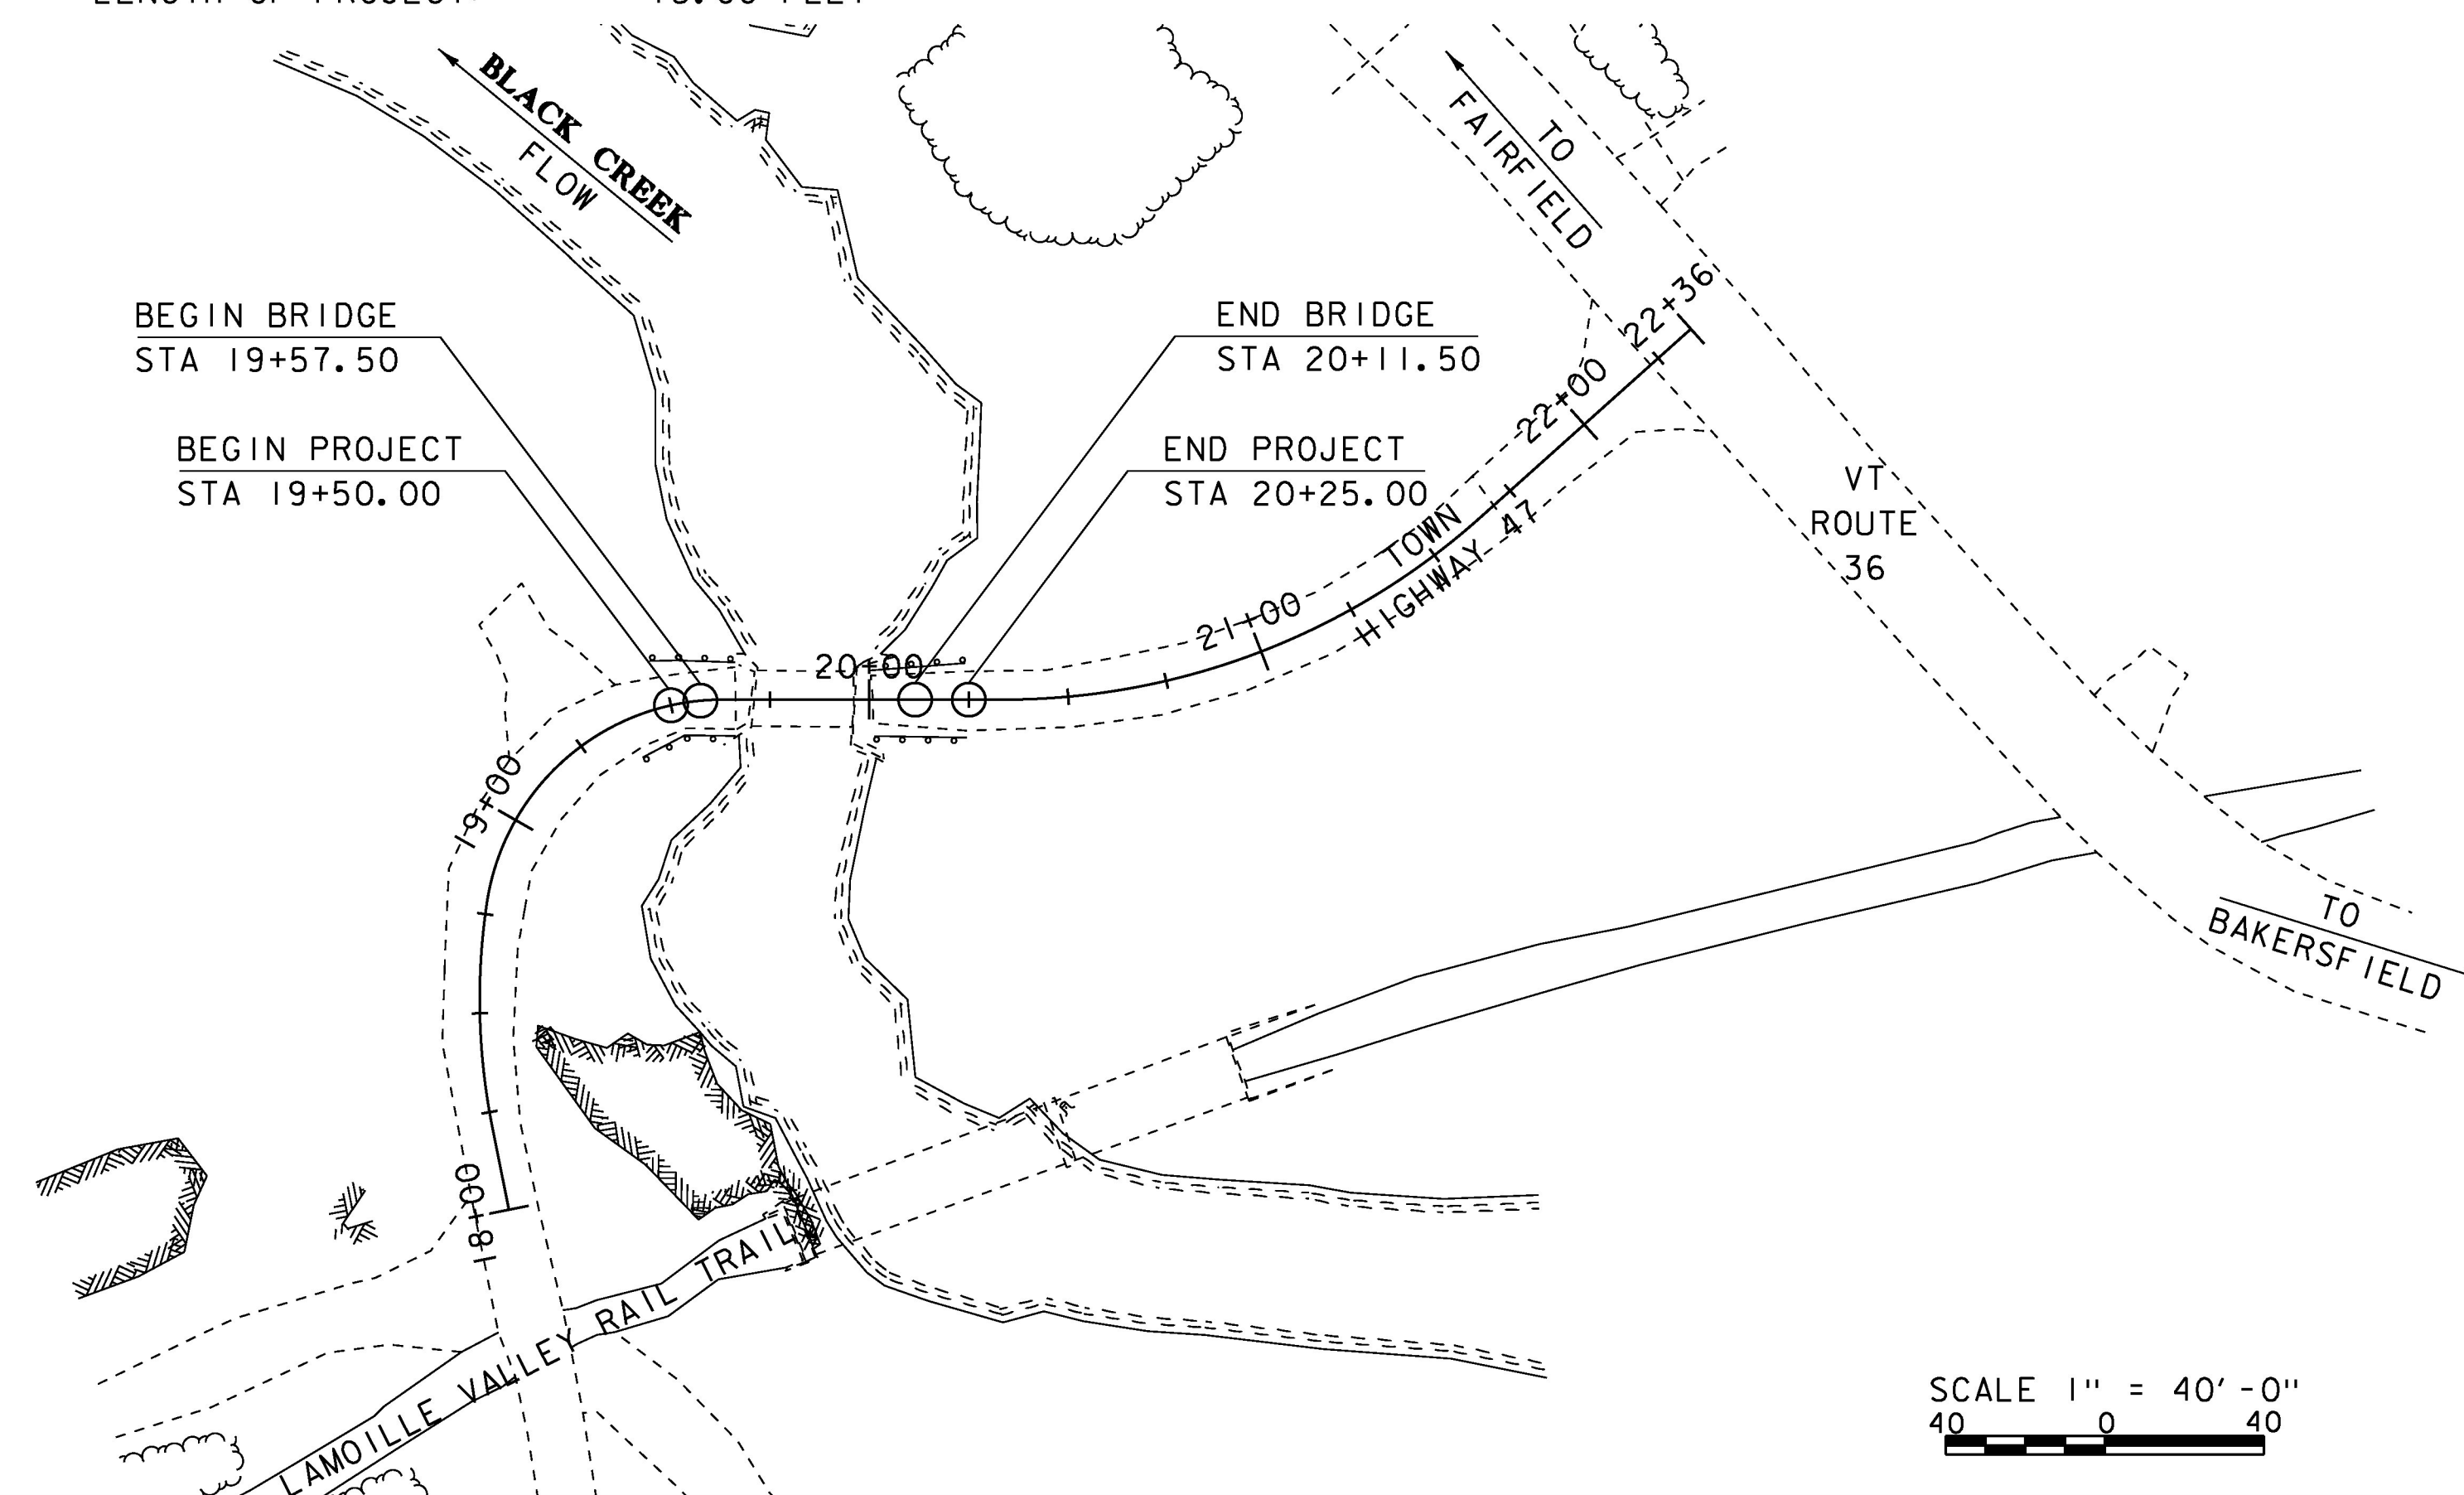

THESE PLANS ARE SUBJECT TO SUCH ENGINEERING CHANGES AS MAY BE REQUIRED BY THE FEDERAL HIGHWAY ADMINISTRATION OR THE DIRECTOR OF PROGRAM DEVELOPMENT.

CONSTRUCTION IS TO BE CARRIED ON IN ACCORDANCE WITH THESE PLANS AND THE STANDARD SPECIFICATIONS FOR CONSTRUCTION DATED 2011, AS APPROVED BY THE FEDERAL HIGHWAY ADMINISTRATION ON JULY 20, 2011 FOR USE ON THIS PROJECT, INCLUDING ALL SUBSEQUENT REVISIONS AND SUCH REVISED SPECIFICATIONS AND SPECIAL PROVISIONS AS ARE INCORPORATED IN THESE PLANS.

QUALITY ASSURANCE PROGRAM : LEVEL 2	
SURVEYED BY :	L. ORVIS
SURVEYED DATE :	3-11-2012
DATUM	
VERTICAL	NAVD88
HORIZONTAL	NAD 83 (07)

PROJECT MANAGER :	R. YOUNG, P.E.
PROJECT NAME :	FAIRFIELD
PROJECT NUMBER :	BRO 1448 (41)
SHEET	38 OF 69 SHEETS

# PRELIMINARY INFORMATION SHEET (BRIDGE)

LRFD

INDEX OF SHEETS

FINAL HYDRAULIC REPORT

PLAN SHEETS

STANDARDS LIST

HYDROLOGIC DATA

Date: February 2013

DRAINAGE AREA : 39.2 sq. mi.  
 CHARACTER OF TERRAIN : Hilly, rural, mix of forest and meadow  
 STREAM CHARACTERISTICS : Sinuous, alluvial, incised  
 NATURE OF STREAMBED : Clay and silt

PEAK FLOW DATA

Q 2.33 = 1750 cfs                      Q 50 = 4050 cfs  
 Q 10 = 2650 cfs                      Q 100 = 4740 cfs  
 Q 25 = 3450 cfs                      Q 500 = 6050 cfs

DATE OF FLOOD OF RECORD: Unknown  
 ESTIMATED DISCHARGE: Unknown  
 WATER SURFACE ELEV.: Unknown  
 NATURAL STREAM VELOCITY: @ Q25 = 7.4 cfs  
 ICE CONDITIONS : Moderate  
 DEBRIS: Moderate  
 DOES THE STREAM REACH MAXIMUM HIGHWATER ELEV. RAPIDLY? No  
 IS ORDINARY RISE RAPID? No  
 IS STAGE AFFECTED BY UPSTREAM OR DOWNSTREAM CONDITIONS? No  
 IF YES, DESCRIBE:

WATERSHED STORAGE: <1%      HEADWATERS:  
 UNIFORM: X  
 IMMEDIATELY ABOVE SITE:

EXISTING STRUCTURE INFORMATION

STRUCTURE TYPE: Single span rolled beam bridge  
 YEAR BUILT: 1919  
 CLEAR SPAN(NORMAL TO STREAM): 27'  
 VERTICAL CLEARANCE ABOVE STREAMBED: ~11'  
 WATERWAY OF FULL OPENING: 265 sq. ft.  
 DISPOSITION OF STRUCTURE: Replace  
 TYPE OF MATERIAL UNDER SUBSTRUCTURE: See borings

WATER SURFACE ELEVATIONS AT:

Q2.33 = 366.7'                      VELOCITY = 9.3 fps  
 Q10 = 368.9'                      "                      7.7 fps  
 Q25 = 369.4'                      "                      8.8 fps  
 Q50 = 369.4'                      "                      8.6 fps  
 Q100 = 369.4'                      "                      8.2 fps

LONG TERM STREAMBED CHANGES: None noted

IS THE ROADWAY OVERTOPPED BELOW Q100: Yes  
 FREQUENCY: Below Q10  
 RELIEF ELEVATION: 367.0'  
 DISCHARGE OVER ROAD @Q100: 1010 cfs

UPSTREAM STRUCTURE

TOWN: Fairfield                      DISTANCE: 120'  
 HIGHWAY #: Lamoille Valley Rail Trail                      STRUCTURE #:  
 CLEAR SPAN: 115'                      CLEAR HEIGHT: ~14'  
 YEAR BUILT:                      FULL WATERWAY: 1060 sq. ft.  
 STRUCTURE TYPE: 2-span steel girder

DOWNSTREAM STRUCTURE

TOWN: Fairfield                      DISTANCE: 5350'  
 HIGHWAY #: VT 36                      STRUCTURE #: BR 9  
 CLEAR SPAN: 80'                      CLEAR HEIGHT: 17'  
 YEAR BUILT: 1983                      FULL WATERWAY: 1250 sq. ft.  
 STRUCTURE TYPE: Welded Girder

LRFR LOAD RATING FACTORS

LOADING LEVELS	TRUCK						
	H-20	HL-93	3S2	6 AXLE	3A STR	4A STR	5A SEMI
TONNAGE	20	36	36	66	30	34.5	38
INVENTORY	1.82	1.04					
POSTING							
OPERATING	2.35	1.35	2.39	1.3	1.7	1.55	1.88
COMMENTS:							

PROPOSED STRUCTURE

STRUCTURE TYPE: Concrete solid slab bridge  
 CLEAR SPAN(NORMAL TO STREAM): 48'  
 VERTICAL CLEARANCE ABOVE STREAMBED: ~11'  
 WATERWAY OF FULL OPENING: 360 sq. ft.

WATER SURFACE ELEVATIONS AT:

Q2.33 = 365.7'                      VELOCITY = 8.9 fps  
 Q10 = 367.6'                      "                      11.3 fps  
 Q25 = 369.1'                      "                      8.1 fps  
 Q50 = 369.4'                      "                      8.8 fps  
 Q100 = 369.4'                      "                      10.2 fps

IS THE ROADWAY OVERTOPPED BELOW Q100: Yes  
 FREQUENCY: Below Q10  
 RELIEF ELEVATION: 366.8'  
 DISCHARGE OVER ROAD @Q100: 1100 cfs  
 AVERAGE LOW ELEVATION OF SUPERSTRUCTURE: 367.6'  
 VERTICAL CLEARANCE: @ Q25 = -1.5'

SCOUR: Contraction scour ~ 6' at Q2.33 and 10' at Q10.

REQUIRED CHANNEL PROTECTION: Stone Fill, Type III

PERMIT INFORMATION

AVERAGE DAILY FLOW: 80 cfs                      DEPTH OR ELEVATION:  
 ORDINARY LOW WATER: 40 cfs                      358'  
 ORDINARY HIGH WATER: 750 cfs                      363'

TEMPORARY BRIDGE REQUIREMENTS

STRUCTURE TYPE: None required  
 CLEAR SPAN (NORMAL TO STREAM):  
 VERTICAL CLEARANCE ABOVE STREAMBED:  
 WATERWAY AREA OF FULL OPENING:

ADDITIONAL INFORMATION

TRAFFIC MAINTENANCE NOTES

1. MAINTAIN ONE-WAY TRAFFIC ON THE EXISTING STRUCTURE.
2. TRAFFIC SIGNALS ARE NOT NECESSARY.
3. SIDEWALKS ARE NOT NECESSARY

DESIGN VALUES

1. DESIGN LIVE LOAD	HL-93
2. FUTURE PAVEMENT	dp: 3.0 INCH
3. DESIGN SPAN	L: 51.00 FT
4. MIN. MID-SPAN POS. CAMBER @ RELEASE (PRESTRESSED UNITS)	Δ: ---
5. PRESTRESSING STRAND (0.60 INCH DIAMETER - LOW RELAX)	fy: 270 KSI
6. PRESTRESSED CONCRETE STRENGTH	f'c: 8.0 KSI
7. PRESTRESSED CONCRETE RELEASE STRENGTH	f'cr: 6.0 KSI
8. CONCRETE, HIGH PERFORMANCE CLASS AA	f'c: 4.0 KSI
9. CONCRETE, HIGH PERFORMANCE CLASS A	f'c: 4.0 KSI
10. CONCRETE, HIGH PERFORMANCE CLASS B	f'c: 3.5 KSI
11. CONCRETE, CLASS C	f'c: 3.0 KSI
12. REINFORCING STEEL	fy: 60 KSI
13. STRUCTURAL STEEL AASHTO M270	fy: ---
14. NOMINAL BEARING RESISTANCE OF SOIL	qn: 4.0 KSF
15. SOIL BEARING RESISTANCE FACTOR (REFER TO AASHTO LRFD)	φ: ---
16. NOMINAL BEARING RESISTANCE OF ROCK	qn: 10.0 KSF
17. ROCK BEARING RESISTANCE FACTOR (REFER TO AASHTO LRFD)	φ: ---
18. PILE RESISTANCE FACTOR	φ: 0.65
19. LATERAL PILE DEFLECTION	Δ: 0.94 INCH
20. BASIC WIND SPEED	V3s: ---
21. MINIMUM GROUND SNOW LOAD	pg: ---
22. SEISMIC DATA	PGA: 0.65                      Ss: ---                      S1: ---
23.	---
24.	---
25.	---
26.	---

PROJECT NAME: **FAIRFIELD**  
 PROJECT NUMBER: **BRO 1448 (41)**

FILE NAME: s12j170excel.dgn                      PLOT DATE: 8/18/2014  
 PROJECT LEADER: R. YOUNG                      DRAWN BY: K. FRIEDLAND  
 DESIGNED BY: R. KLINFELTER                      CHECKED BY: J. SALVATORI  
**PRELIMINARY INFORMATION SHEET**                      SHEET 39 OF 69

TRAFFIC DATA

YEAR	ADT	DHV	% D	% T	ADTT	20 year ESAL for flexible pavement from 2015 to 2035 : 4000
2015	20	5	60	7.8	5	40 year ESAL for flexible pavement from 2015 to 2055 : 8000
2035	20	5	60	9.6	5	Design Speed : 15 mph

AS BUILT "REBAR" DETAIL

LEVEL I	LEVEL II	LEVEL III
TYPE:	TYPE:	TYPE:
GRADE:	GRADE:	GRADE:

## GENERAL

1. ALL MATERIALS AND CONSTRUCTION SHALL CONFORM TO THE VERMONT AGENCY OF TRANSPORTATION 2011 STANDARD SPECIFICATIONS FOR CONSTRUCTION, THE 2012 AASHTO LRFD BRIDGE DESIGN SPECIFICATIONS, AND THEIR LATEST REVISIONS.
2. ALL PRECAST/PRESTRESSED CONCRETE ELEMENTS SHALL BE FABRICATED TO THE SPECIFIED DIMENSIONS AND ERECTED IN THE SPECIFIED LOCATIONS, ALL WITHIN TOLERANCES DEFINED ON THE PLANS AND IN THE PRECAST/PRESTRESSED CONCRETE INSTITUTE TOLERANCE MANUAL FOR PRECAST AND PRESTRESSED CONCRETE CONSTRUCTION, MNL 135-00, AND ITS LATEST REVISIONS.
3. ALL DIMENSIONS ARE HORIZONTAL OR VERTICAL, AND ARE GIVEN AT 68 DEGREES FAHRENHEIT, UNLESS NOTED OTHERWISE.

## TRAFFIC CONTROL

4. THE CONTRACTOR SHALL BE RESPONSIBLE FOR SUPPLYING A SITE SPECIFIC TRAFFIC CONTROL PACKAGE IDENTIFYING CONSTRUCTION ACTIVITIES BEFORE, DURING, AND AFTER THE BRIDGE CLOSURE PERIOD. THE CONTRACTOR SHALL SUBMIT A DETAILED TRAFFIC CONTROL PLAN TO THE PROJECT MANAGER FOR ALL STAGES OF CONSTRUCTION, FOR APPROVAL PER SUBSECTION 105.03. ALL COSTS SHALL BE INCLUDED IN ITEM 900.645, "SPECIAL PROVISION (TRAFFIC CONTROL, ALL-INCLUSIVE)(BRO 1448(41))". SEE SPECIAL PROVISIONS FOR ADDITIONAL INFORMATION.
5. ALL ITEMS REQUIRED TO IMPLEMENT THE CONTRACTOR'S TRAFFIC CONTROL PLAN WILL NOT BE PAID FOR DIRECTLY BUT WILL BE CONSIDERED INCLUDED IN THE BID PRICE FOR ITEM 900.645, "SPECIAL PROVISION (TRAFFIC CONTROL, ALL-INCLUSIVE)( BRO 1448(41))".
6. THE TOWN OF FAIRFIELD IS RESPONSIBLE FOR PROVIDING MEANS OF ACCESS FOR THE RESIDENTS OF ELM BROOK ROAD DURING THE BRIDGE CLOSURE PERIODS.
7. ALL SIGNING SHALL BE IN ACCORDANCE WITH THE LATEST EDITION OF THE MUTCD. FOR ADDITIONAL SIGNING INSTRUCTIONS SEE THE T SERIES OF THE STANDARDS. WHERE CONFLICTS EXIST, THE MUTCD SHALL GOVERN.

## EARTHWORK

8. REMOVAL OF THE EXISTING STRUCTURE SHALL BE PAID FOR UNDER ITEM 529.15, "REMOVAL OF STRUCTURE". THIS WORK SHALL INCLUDE REMOVAL OF ANY PORTIONS OF THE EXISTING ABUTMENTS THAT FALL OUTSIDE THE LIMITS OF STRUCTURE EXCAVATION OR UNCLASSIFIED CHANNEL EXCAVATION.
9. THE "STONE FILL, TYPE III" UNDER THE BRIDGE AS SHOWN IN THE PLANS SHALL BE PLACED BEFORE THE PRESTRESSED SLABS ARE SET.
10. GEOTEXTILE MEETING THE REQUIREMENTS OF ITEM 649.11, "GEOTEXTILE FOR ROADBED SEPARATOR" SHALL BE USED TO WRAP THE GRANULAR BACKFILL FOR STRUCTURES MATERIAL BEHIND ABUTMENT #1 AS SHOWN ON THE PLANS. ALL COSTS ASSOCIATED WITH PLACING THE GEOTEXTILE AND WRAPPING THE BACKFILL MATERIAL SHALL BE INCLUDED IN THE BID PRICE FOR ITEM 649.11, "GEOTEXTILE FOR ROADBED SEPARATOR".
11. IF SHALLOW BEDROCK IS ENCOUNTERED IN FRONT OF ABUTMENT #1 PREVENTING INSTALLATION OF THE STONE FILL KEYWAY AS SHOWN ON THE PLANS, THE CONTRACTOR SHALL CONSTRUCT A STABLE BASE FOR THE STONE FILL SLOPE TO THE SATISFACTION OF THE ENGINEER. RESTACKING STONES FROM THE EXISTING ABUTMENT OR OTHER MEANS MAY BE USED TO PROVIDE A STABLE BASE. ALL COSTS ASSOCIATED WITH CONSTRUCTING A STABLE BASE FOR THE STONE FILL SLOPE, IF NECESSARY, SHALL BE INCLUDED IN THE BID PRICE FOR ITEM 613.12, STONE FILL, TYPE III.

## CONCRETE AND REINFORCING STEEL

12. TEST BARS SHALL BE PROVIDED IN ACCORDANCE WITH THE "VERMONT AGENCY OF TRANSPORTATION MATERIAL SAMPLING MANUAL" AVAILABLE ON THE AGENCY WEBSITE. A MINIMUM OF TWO TEST SECTIONS ARE REQUIRED FOR EACH SIZE, BRAND, AND GRADE OR TYPE OF REINFORCING. SEE THE MANUAL FOR ACCEPTABLE DIMENSIONS OF TEST SECTIONS. ALL COSTS ASSOCIATED WITH PROVIDING BARS FOR TESTING SHALL BE INCLUDED IN THE BID PRICE FOR EACH 540.10, 900.640, "SPECIAL PROVISION, (PRESTRESSED CONCRETE SOLID SLABS)(21" x 48")", AND 900.645, "SPECIAL PROVISION, (CONTRACTOR-FABRICATED PRECAST CONCRETE STRUCTURE)" CONTRACT ITEM AS APPROPRIATE.
13. WATER REPELLENT, SILANE SHALL BE FURNISHED IN ACCORDANCE WITH SECTION 514 AND SHALL BE APPLIED TO ALL EXPOSED CONCRETE ON THE BRIDGE SUPERSTRUCTURE AND SUBSTRUCTURE, WITH THE EXCEPTION OF THE BOTTOM OF THE SLABS BETWEEN THE DRIP NOTCHES. ALL COSTS ASSOCIATED WITH APPLYING SILANE SHALL BE INCLUDED IN THE BID PRICE FOR EACH 540.10, 900.640, "SPECIAL PROVISION, (PRESTRESSED CONCRETE SOLID SLABS)(21" x 48")", AND 900.645, "SPECIAL PROVISION, (CONTRACTOR-FABRICATED PRECAST CONCRETE STRUCTURE)" CONTRACT ITEM AS APPROPRIATE.
14. CONCRETE FOR ABUTMENT PILE CAVITIES SHALL MEET THE REQUIREMENTS OF ITEM 900.608, "SPECIAL PROVISION (HIGH PERFORMANCE CONCRETE, RAPID SET)(FPQ)".
15. GROUT FOR SHEAR KEYS BETWEEN THE PRESTRESSED SLABS SHALL BE MORTAR, TYPE IV IN ACCORDANCE WITH SECTION 510 - PRESTRESSED CONCRETE. GROUT FOR ANCHOR BOLTS SHALL BE MORTAR, TYPE IV IN ACCORDANCE WITH SECTION 531 - BRIDGE BEARING DEVICES. THE CONTRACTOR SHALL SUBMIT A GROUTING PROCEDURE PROPOSAL TO THE ENGINEER, INCLUDING A PREMIX NAME BRAND FOR APPROVAL.

16. ALL REINFORCING STEEL SHALL BE DETAILED AND FABRICATED USING PROCEDURES AND TOLERANCES IN ACCORDANCE WITH APPLICABLE PUBLICATIONS OF THE "CONCRETE REINFORCING STEEL INSTITUTE".

17. ALL REINFORCING STEEL IN THE PRESTRESSED SLABS AND ABUTMENTS & WINGWALLS ABOVE THE BRIDGE SEAT SHALL MEET THE REQUIREMENTS FOR LEVEL I (EPOXY COATED) CORROSION RESISTANCE IN ACCORDANCE WITH SECTION 507.

18. REINFORCING STEEL IN THE ABUTMENTS & WINGWALLS BELOW THE BRIDGE SEAT SHALL MEET THE REQUIREMENTS FOR LEVEL I CORROSION RESISTANCE IN ACCORDANCE WITH SECTION 507.

19. CORRUGATED STEEL PIPES IN THE PRECAST ABUTMENTS FOR PILE CAVITIES AND ANCHOR BOLT CAVITIES SHALL MEET THE REQUIREMENTS OF SUBSECTION 711.01, BE COATED IN ACCORDANCE WITH AASHTO M 218, AND BE TYPE 1. ALL COSTS ASSOCIATED WITH PLACING THE CORRUGATED STEEL PIPES SHALL BE INCLUDED IN THE BID PRICE FOR EACH 540.10 AND 900.645, "SPECIAL PROVISION, (CONTRACTOR-FABRICATED PRECAST CONCRETE STRUCTURE)" CONTRACT ITEM AS APPROPRIATE.

20. CORRUGATED POST-TENSIONING DUCTS IN THE PRESTRESSED SLABS FOR ANCHOR BOLT CONNECTIONS SHALL BE CONSTRUCTED FROM EITHER POLYETHYLENE OR POLYPROPYLENE. THE DUCT SHALL HAVE A MINIMUM MATERIAL THICKNESS OF 0.080 IN. +/- 0.010 IN. AND SHALL HAVE A WHITE COATING ON THE OUTSIDE OR SHALL BE OF WHITE MATERIAL WITH ULTRAVIOLET STABILIZERS ADDED. POLYETHYLENE DUCT SHALL BE FABRICATED FROM RESINS MEETING OR EXCEEDING THE REQUIREMENTS OF ASTM D 3350 WITH A CELL CLASSIFICATION OF 345464A. POLY PROPYLENE DUCT SHALL BE FABRICATED FROM RESINS MEETING OR EXCEEDING THE REQUIREMENTS OF ASTM D 4101 WITH A CELL CLASSIFICATION RANGE OF PP0340B44544 TO PP0340B65884. ALL COSTS ASSOCIATED WITH PLACING THE DUCTS SHALL BE INCLUDED IN THE BID PRICE FOR ITEM 900.640, "SPECIAL PROVISION, (PRESTRESSED CONCRETE SOLID SLABS)( 21" x 48")" AS APPROPRIATE.

## PRECAST ABUTMENTS

21. CONCRETE COMPRESSIVE STRENGTH:  $f_c = 5$  KSI.

22. THE CONTRACTOR IS ADVISED THAT ABUTMENT #1 MAY BE UNSTABLE UNTIL THE CONNECTIONS BETWEEN THE ABUTMENT AND PRESTRESSED SLABS ARE COMPLETE. IF ANY BACKFILL WILL BE PLACED ABOVE THE BOTTOM OF ABUTMENT BEFORE THE CONNECTIONS ARE COMPLETE, THE CONTRACTOR SHALL SUBMIT A SHORING PLAN FOR ABUTMENT #1 TO THE PROJECT MANAGER FOR APPROVAL. THE SHORING PLAN SHALL INCLUDE ASSOCIATED DETAILS, PROCEDURES, AND CALCULATIONS PREPARED, STAMPED, AND SIGNED BY A QUALIFIED LICENSED PROFESSIONAL ENGINEER. ALL COSTS ASSOCIATED WITH SHORING ABUTMENT #1, IF APPLICABLE, SHALL BE INCLUDED IN THE BID PRICE FOR ITEM 540.10, "PRECAST CONCRETE STRUCTURE (ABUTMENT#1)(BRO 1448(41))" AND 900.645, "SPECIAL PROVISION, (CONTRACTOR-FABRICATED PRECAST CONCRETE STRUCTURE)(ABUTMENT#1)(BRO 1448(41))".

23. PROPOSED SEQUENCE OF SUBSTRUCTURE CONSTRUCTION:

- a. DAILY BRIDGE CLOSURES:
  - i. PRE-EXCAVATE HOLES FOR PILES.
  - ii. BACKFILL HOLES WITH SAND.
- b. BRIDGE CLOSURE PERIOD:
  - i. PREPARE AND GRADE FOUNDATION TO REQUIRED ELEVATION.
  - ii. DRIVE PILES.
  - iii. PLACE PRECAST ABUTMENTS.
  - iv. INSTALL ANCHOR BOLTS AND SECURE IN FINAL POSITION.
  - v. FILL ABUTMENT PILE CAVITIES WITH ITEM 900.608, "SPECIAL PROVISION (HIGH PERFORMANCE CONCRETE, RAPID SET)(FPQ)".
  - vi. GROUT ANCHOR BOLTS IN ABUTMENT ANCHOR BOLT CAVITIES.
  - vii. INSTALL TEMPORARY SHORING FOR ABUTMENT #1 BEFORE BACKFILLING (IF APPLICABLE).
  - viii. THE PILE CAVITY CONCRETE SHALL ATTAIN A MINIMUM COMPRESSIVE STRENGTH OF 3.5 KSI BEFORE ABUTMENT #2 BACKFILL IS PLACED AND PRESTRESSED SLABS ARE ERECTED. SHORED ABUTMENTS MAY BE BACKFILLED IMMEDIATELY FOLLOWING PILE CAVITY CONCRETE PLACEMENT IF SHORING DESIGN ALLOWS.

24. ALTERNATE SEQUENCE OF CONSTRUCTION MAY BE SUBMITTED FOR APPROVAL BY THE PROJECT MANAGER.

## PRESTRESSED SOLID SLABS

25. DESIGN VALUES:
  - a. CONCRETE COMPRESSIVE STRENGTH:  $f_c = 8$  KSI
  - b. CONCRETE COMPRESSIVE STRENGTH AT RELEASE:  $f_{ci} = 6$  KSI
  - c. PRESTRESSING STRANDS: 0.6 INCH DIAMETER, 270 KSI, LOW-RELAXATION 7-WIRE STRANDS
  - d. JACKING FORCE PER PRESTRESSING STRAND = 44 KIPS
  - e. POST-TENSIONING STRANDS: 0.6 INCH DIAMETER, 270 KSI, LOW RELAXATION 7-WIRE STRANDS
  - f. JACKING FORCE PER POST-TENSIONING STRAND = 47 KIPS
  - g. THERE SHALL BE 2 STRANDS PER POST-TENSIONING DUCT.
  - h. ASSUMED MODULUS OF ELASTICITY FOR THE STRAND IS 28,500 KSI.

26. DUE TO STABILITY CONCERNS AT THE ABUTMENTS DURING THE ERECTION OF THE SUPERSTRUCTURE, THE CONTRACTOR SHALL SUBMIT THE ERECTION PLAN A MINIMUM OF 30 WORKING DAYS PRIOR TO THE BRIDGE CLOSURE PERIOD. UNDER NO CIRCUMSTANCES SHALL A BRIDGE CLOSURE PERIOD BEGIN PRIOR TO HAVING AN ACCEPTED ERECTION PLAN.

27. THE METHOD OF FORMING FOR SUBSEQUENT POURS AFTER PLACING PRECAST/PRESTRESSED SUPERSTRUCTURE UNITS SHALL BE DETERMINED BY THE CONTRACTOR. THE CONTRACTOR IS ENCOURAGED TO WORK WITH THE FABRICATOR IF ADDITIONAL SUPPORTS MAY BE REQUIRED. IN NO CASE SHALL THE CONTRACTOR ATTACH ADDITIONAL FORM OR SCREED SUPPORTS BY DRILLING OR SIMILAR MEANS INTO ANY PRECAST/PRESTRESSED SUPERSTRUCTURE UNIT.

28. ALL POST-TENSIONING STRAND SHALL CONFORM TO THE REQUIREMENTS OF SECTION 510 - PRESTRESSED CONCRETE. PAYMENT FOR GALVANIZED ANCHOR ASSEMBLIES, DUCTS, AND POST-TENSIONING STRANDS SHALL BE INCLUDED UNDER ITEM 900.640, "SPECIAL PROVISION, (PRESTRESSED CONCRETE SOLID SLABS)(21" x 48")".

29. PROPOSED SEQUENCE OF SUPERSTRUCTURE CONSTRUCTION:

- a. LAY OUT WORKING LINES THE ENTIRE WIDTH OF THE BRIDGE ALONG CENTERLINE OF BEARING, MEASURED FROM A SINGLE WORKING POINT. THE WORKING LINES SHALL BE BASED ON THE NOMINAL PRESTRESSED SLAB WIDTHS.
- b. VERIFY THE BRIDGE SEAT ELEVATIONS AND TAKE CORRECTIVE ACTION IF NECESSARY.
- c. POWER WASH ALL SURFACES THAT WILL BE IN CONTACT WITH GROUT.
- d. INSTALL BEARINGS.
- e. ERECT THE PRESTRESSED SLABS TO FIT WITHIN THE WORKING LINES.
- f. ADJUST THE EXTERIOR SLAB SO THAT THE FASCIA FITS SNUG AGAINST THE CORK ON INTERIOR OF CHEEK WALL.
- g. INSTALL HARDWOOD WEDGES BETWEEN ADJACENT SLABS TO MAINTAIN PROPER JOINT OPENING (A MINIMUM OF ONE WEDGE AT EACH TRANSVERSE POST-TENSIONING LOCATION).
- h. INSTALL BACKER ROD BELOW THE BOTTOM OF THE KEYWAY.
- i. INSTALL POST-TENSIONING STRANDS AND TENSION TO 3 KIPS TO REMOVE SAG AND SEAT CHUCK.
- j. PUMP GROUT FROM LOW END OF BRIDGE SEAT THROUGH ANCHOR BOLT DUCTS CLOSEST TO THE FASCIA TO FILL VOID BETWEEN BRIDGE SEAT AND BOTTOM OF PRESTRESSED SLABS. PUMP GROUT UNTIL ALL ANCHOR BOLT DUCTS ARE FULL.
- k. INSTALL ANCHOR PLATES, WASHERS AND NUTS FOR ANCHOR BOLTS.
- l. GROUT SHEAR KEYS.
- m. FULLY TENSION TRANSVERSE TENDONS. POST-TENSIONING OF TRANSVERSE TENDONS WILL BE PERMITTED ONCE SHEAR KEY GROUT HAS REACHED A MINIMUM COMPRESSIVE STRENGTH OF 600 PSI. THE GROUT NEED NOT BE CURED FOR THREE DAYS PRIOR TO COMMENCING OF POST-TENSIONING. THE CONTRACTOR SHALL MOLD AND CURE A SUFFICIENT NUMBER OF CUBES DURING THE GROUT PLACEMENT FOR TESTING.

30. ALTERNATE SEQUENCE OF CONSTRUCTION MAY BE SUBMITTED FOR APPROVAL BY THE PROJECT MANAGER.

## H-PILES

31. THE PILES SHALL BE HP 12x84.

32. TO PREVENT DAMAGE TO THE PILES, PILE SHOES ARE REQUIRED AND SHALL CONFORM TO SUBSECTION 505.04 (f).

33. ALL PILE LOCATIONS SHALL BE PRE-EXCAVATED WITH A MINIMUM PENETRATION OF 3 FEET INTO COMPETENT BEDROCK. THIS WORK SHALL BE DONE DURING DAILY BRIDGE CLOSURES IN A 14 DAY PERIOD PRIOR TO THE BRIDGE CLOSURE PERIOD.

34. IN ORDER TO BE CONSIDERED PART OF THE 3 FOOT PENETRATION INTO COMPETENT BEDROCK, THE HOLES SHALL BE BETWEEN 24 AND 30 INCHES IN DIAMETER. THE ENTIRE PRE-EXCAVATED HOLE SHALL BE BACKFILLED WITH SAND CONFORMING TO THE REQUIREMENTS OF SUBSECTION 703.03.

35. THE PILES SHALL BE DRIVEN TO A NOMINAL AXIAL RESISTANCE OF 253 KIPS. DYNAMIC PILE LOADING TESTS ARE NOT REQUIRED.

36. THE TOPS OF THE PILES AFTER DRIVING SHALL NOT VARY FROM THE POSITION SHOWN ON THE PLANS BY MORE THAN 3 INCHES. THE PILE ORIENTATION SHALL NOT VARY BY MORE THAN 5 DEGREES. THE CONTRACTOR SHALL DEMONSTRATE TO THE SATISFACTION OF THE ENGINEER HOW THE TOLERANCES WILL BE MET. THESE MEASURES SHALL BE DEMONSTRATED IN A SUBMITTAL TO BE ACCEPTED BEFORE PILE DRIVING COMMENCES.

37. FOR ESTIMATING PURPOSES, THE PILE TIP ELEVATIONS WERE ASSUMED AS SHOWN ON THE BORING LOGS. THE ACTUAL IN PLACE LENGTHS MAY VARY.

## MISCELLANEOUS

38. EXISTING CONDITIONS SHEET HAS BEEN INCLUDED FOR THE CONTRACTOR TO USE FOR SUBMITTALS.

PROJECT NAME: FAIRFIELD  
PROJECT NUMBER: BRO 1448 (41)

FILE NAME: sl2j170gen.dgn	PLOT DATE: 11-SEP-2014
PROJECT LEADER: R. YOUNG	DRAWN BY: R. KLINEFELTER
DESIGNED BY: R. KLINEFELTER	CHECKED BY: J. SALVATORI
GENERAL NOTES	SHEET 40 OF 69

# QUANTITY SHEET 1

SUMMARY OF ESTIMATED QUANTITIES										TOTALS		DESCRIPTIONS				DETAILED SUMMARY OF QUANTITIES		
						ROADWAY	EROSION CONTROL	BRIDGE	FULL C.E. ITEMS	GRAND TOTAL	FINAL	UNIT	ITEMS	ITEM NUMBER	ROUND	QUANTITIES	UNIT	ITEMS
						1				1		LS	CLEARING AND GRUBBING, INCLUDING INDIVIDUAL TREES AND STUMPS (BRO 1448(41))	201.10				<b>EARTHWORK SUMMARY</b>
						250				250		CY	COMMON EXCAVATION	203.15		250	CY	COMMON EXCAVATION (250*1.0)
								5		5		CY	SOLID ROCK EXCAVATION	203.16		255	CY	UNCLASSIFIED EXCAVATION (340*0.75)
								340		340		CY	UNCLASSIFIED CHANNEL EXCAVATION	203.27		75	CY	STRUCTURE EXCAVATION (100*0.75)
						1				1		CY	TRENCH EXCAVATION OF EARTH, EXPLORATORY (N.A.B.I.)	204.22		580	CY	SUBTOTAL
								100		100		CY	STRUCTURE EXCAVATION	204.25		20	CY	ROUNDING
								60		60		CY	GRANULAR BACKFILL FOR STRUCTURES	204.30		600	CY	TOTAL FILL AVAILABLE
						180				180		CY	SUBBASE OF CRUSHED GRAVEL, COARSE GRADED	301.25		0	CY	TOTAL FILL REQUIRED
						90				90		CY	AGGREGATE SURFACE COURSE	401.10		600	CY	TOTAL WASTE
								1		1		LS	FURNISHING EQUIPMENT FOR DRIVING PILING (BRO 1448(41))	504.10				
								100		100		LF	STEEL PILING, HP 12 X 84	505.165				
								1800		1800		LB	STRUCTURAL STEEL (FPQ)	506.60				
								162		162		LF	GROUTING SHEAR KEYS	510.24				
								112.5		112.5		LF	BRIDGE RAILING, GALVANIZED HDSB/FASCIA MOUNTED/STEEL TUBING	525.44				
								1		1		EACH	REMOVAL OF STRUCTURE (705 SF - EST.)	529.15				
								16		16		EACH	BEARING DEVICE ASSEMBLY, PLAIN ELASTOMERIC PAD	531.16				
													BEGIN OPTION BB					
								1		1		LS	PRECAST CONCRETE STRUCTURE (ABUTMENT #1)(BRO 1448(41))	540.10				
								1		1		LS	SPECIAL PROVISION (CONTRACTOR-FABRICATED PRECAST CONCRETE STRUCTURE)(ABUTMENT #1)(BRO 1448(41))	900.645				
													END OPTION BB					
													BEGIN OPTION DD					
								1		1		LS	PRECAST CONCRETE STRUCTURE (ABUTMENT #2)(BRO 1448(41))	540.10				
								1		1		LS	SPECIAL PROVISION (CONTRACTOR-FABRICATED PRECAST CONCRETE STRUCTURE)(ABUTMENT #2)(BRO 1448(41))	900.645				
													END OPTION DD					
							1			1		TON	DUST AND ICE CONTROL WITH CALCIUM CHLORIDE	609.15				
								230		230		CY	STONE FILL, TYPE III	613.12				
						58				58		LF	STEEL BEAM GUARDRAIL, GALVANIZED	621.20				
						4				4		EACH	ANCHOR FOR STEEL BEAM RAIL	621.60				
						4				4		EACH	GUARDRAIL APPROACH SECTION, GALV HD STEEL BEAM	621.737				
						93				93		LF	REMOVAL AND DISPOSAL OF GUARDRAIL	621.80				
									0.5	0.5		LS	FIELD OFFICE, ENGINEERS	631.10				
									0.5	0.5		LS	TESTING EQUIPMENT, CONCRETE	631.16				
									1500	1500		DL	FIELD OFFICE TELEPHONE (N.A.B.I.)	631.26				
						0.5				0.5		LS	MOBILIZATION/DEMOBILIZATION	635.11				
						160				160		SY	GEOTEXTILE FOR ROADBED SEPARATOR	649.11				
								280		280		SY	GEOTEXTILE UNDER STONE FILL	649.31				
							180			180		SY	GEOTEXTILE FOR SILT FENCE, WOVEN WIRE REINFORCED	649.515				
							80			80		SY	GEOTEXTILE FOR FILTER CURTAIN	649.61				
							5			5		LB	SEED	651.15				

PROJECT NAME: FAIRFIELD  
PROJECT NUMBER: BRO 1448(41)


FILE NAME: sl2j170qs.dgn  
PROJECT LEADER: R. YOUNG  
DESIGNED BY: R. KLINEFELTER  
QUANTITY SHEET 1

PLOT DATE: 11-SEP-2014  
DRAWN BY: K. FRIEDLAND  
CHECKED BY: J. SALVATORI  
SHEET 41 OF 69

# QUANTITY SHEET 2


SUMMARY OF ESTIMATED QUANTITIES										TOTALS		DESCRIPTIONS				DETAILED SUMMARY OF QUANTITIES			
							ROADWAY	EROSION CONTROL	BRIDGE	FULL C.E. ITEMS	GRAND TOTAL	FINAL	UNIT	ITEMS	ITEM NUMBER	ROUND	QUANTITIES	UNIT	ITEMS
								30			30		LB	FERTILIZER	651.18				
								1			1		TON	AGRICULTURAL LIMESTONE	651.20				
								1			1		TON	HAY MULCH	651.25				
								25			25		CY	TOPSOIL	651.35				
									70		70		SY	GRUBBING MATERIAL	651.40				
								1			1		LS	EPSC PLAN (BRO 1448(41))	652.10				
								20			20		HR	MONITORING EPSC PLAN	652.20				
								1			1		LU	MAINTENANCE OF EPSC PLAN (N.A.B.I.) (BRO 1448(41))	652.30				
								18			18		CY	VEHICLE TRACKING PAD	653.35				
								480			480		LF	BARRIER FENCE	653.50				
							0.66				0.66		SF	TRAFFIC SIGNS, TYPE A	675.20				
							30				30		LF	SQUARE TUBE SIGN POST AND ANCHOR	675.341				
							2				2		EACH	REMOVING SIGNS	675.50				
							2				2		EACH	ERECTING SALVAGED SIGNS	675.60				
							4				4		EACH	DELINEATOR WITH STEEL POST	676.10				
									4		4		CY	SPECIAL PROVISION (HIGH PERFORMANCE CONCRETE, RAPID SET)(FPQ)	900.608				
									50		50		LF	SPECIAL PROVISION (PRE-EXCAVATION OF INTEGRAL ABUTMENT PILES, EARTH)	900.640				
									30		30		LF	SPECIAL PROVISION (PRE-EXCAVATION OF INTEGRAL ABUTMENT PILES, ROCK)	900.640				
									216		216		LF	SPECIAL PROVISION (PRESTRESSED CONCRETE SOLID SLABS)(21" x 48")	900.640				
							0.5				0.5		LS	SPECIAL PROVISION (CPM SCHEDULE)	900.645				
							1				1		LS	SPECIAL PROVISION (TRAFFIC CONTROL, ALL-INCLUSIVE)(BRO 1448(41))	900.645				

PROJECT NAME: FAIRFIELD  
 PROJECT NUMBER: BRO 1448(41)  
 FILE NAME: sl2j170qs.dgn  
 PROJECT LEADER: R. YOUNG  
 DESIGNED BY: R. KLINEFELTER  
 QUANTITY SHEET 2  
 PLOT DATE: 18-AUG-2014  
 DRAWN BY: K. FRIEDLAND  
 CHECKED BY: J. SALVATORI  
 SHEET 42 OF 69

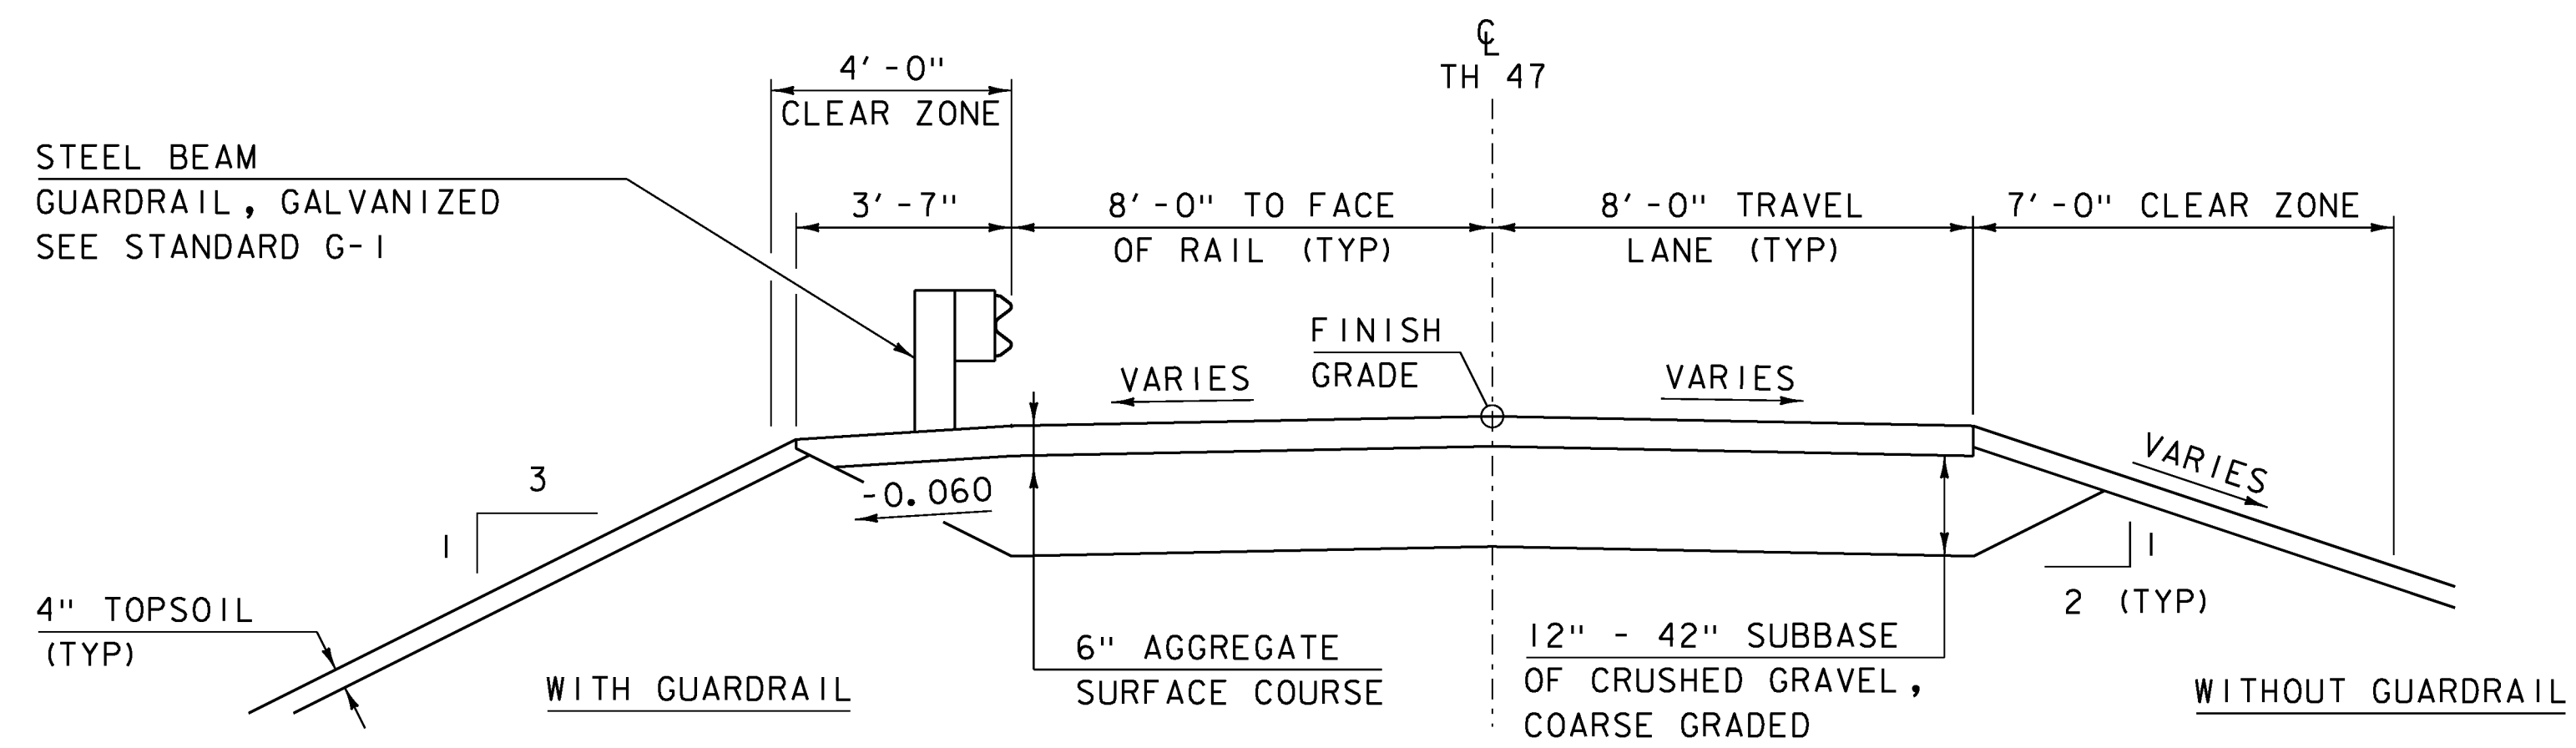

**ROADWAY TYPICAL SECTION**

SCALE 3/8" = 1'-0"

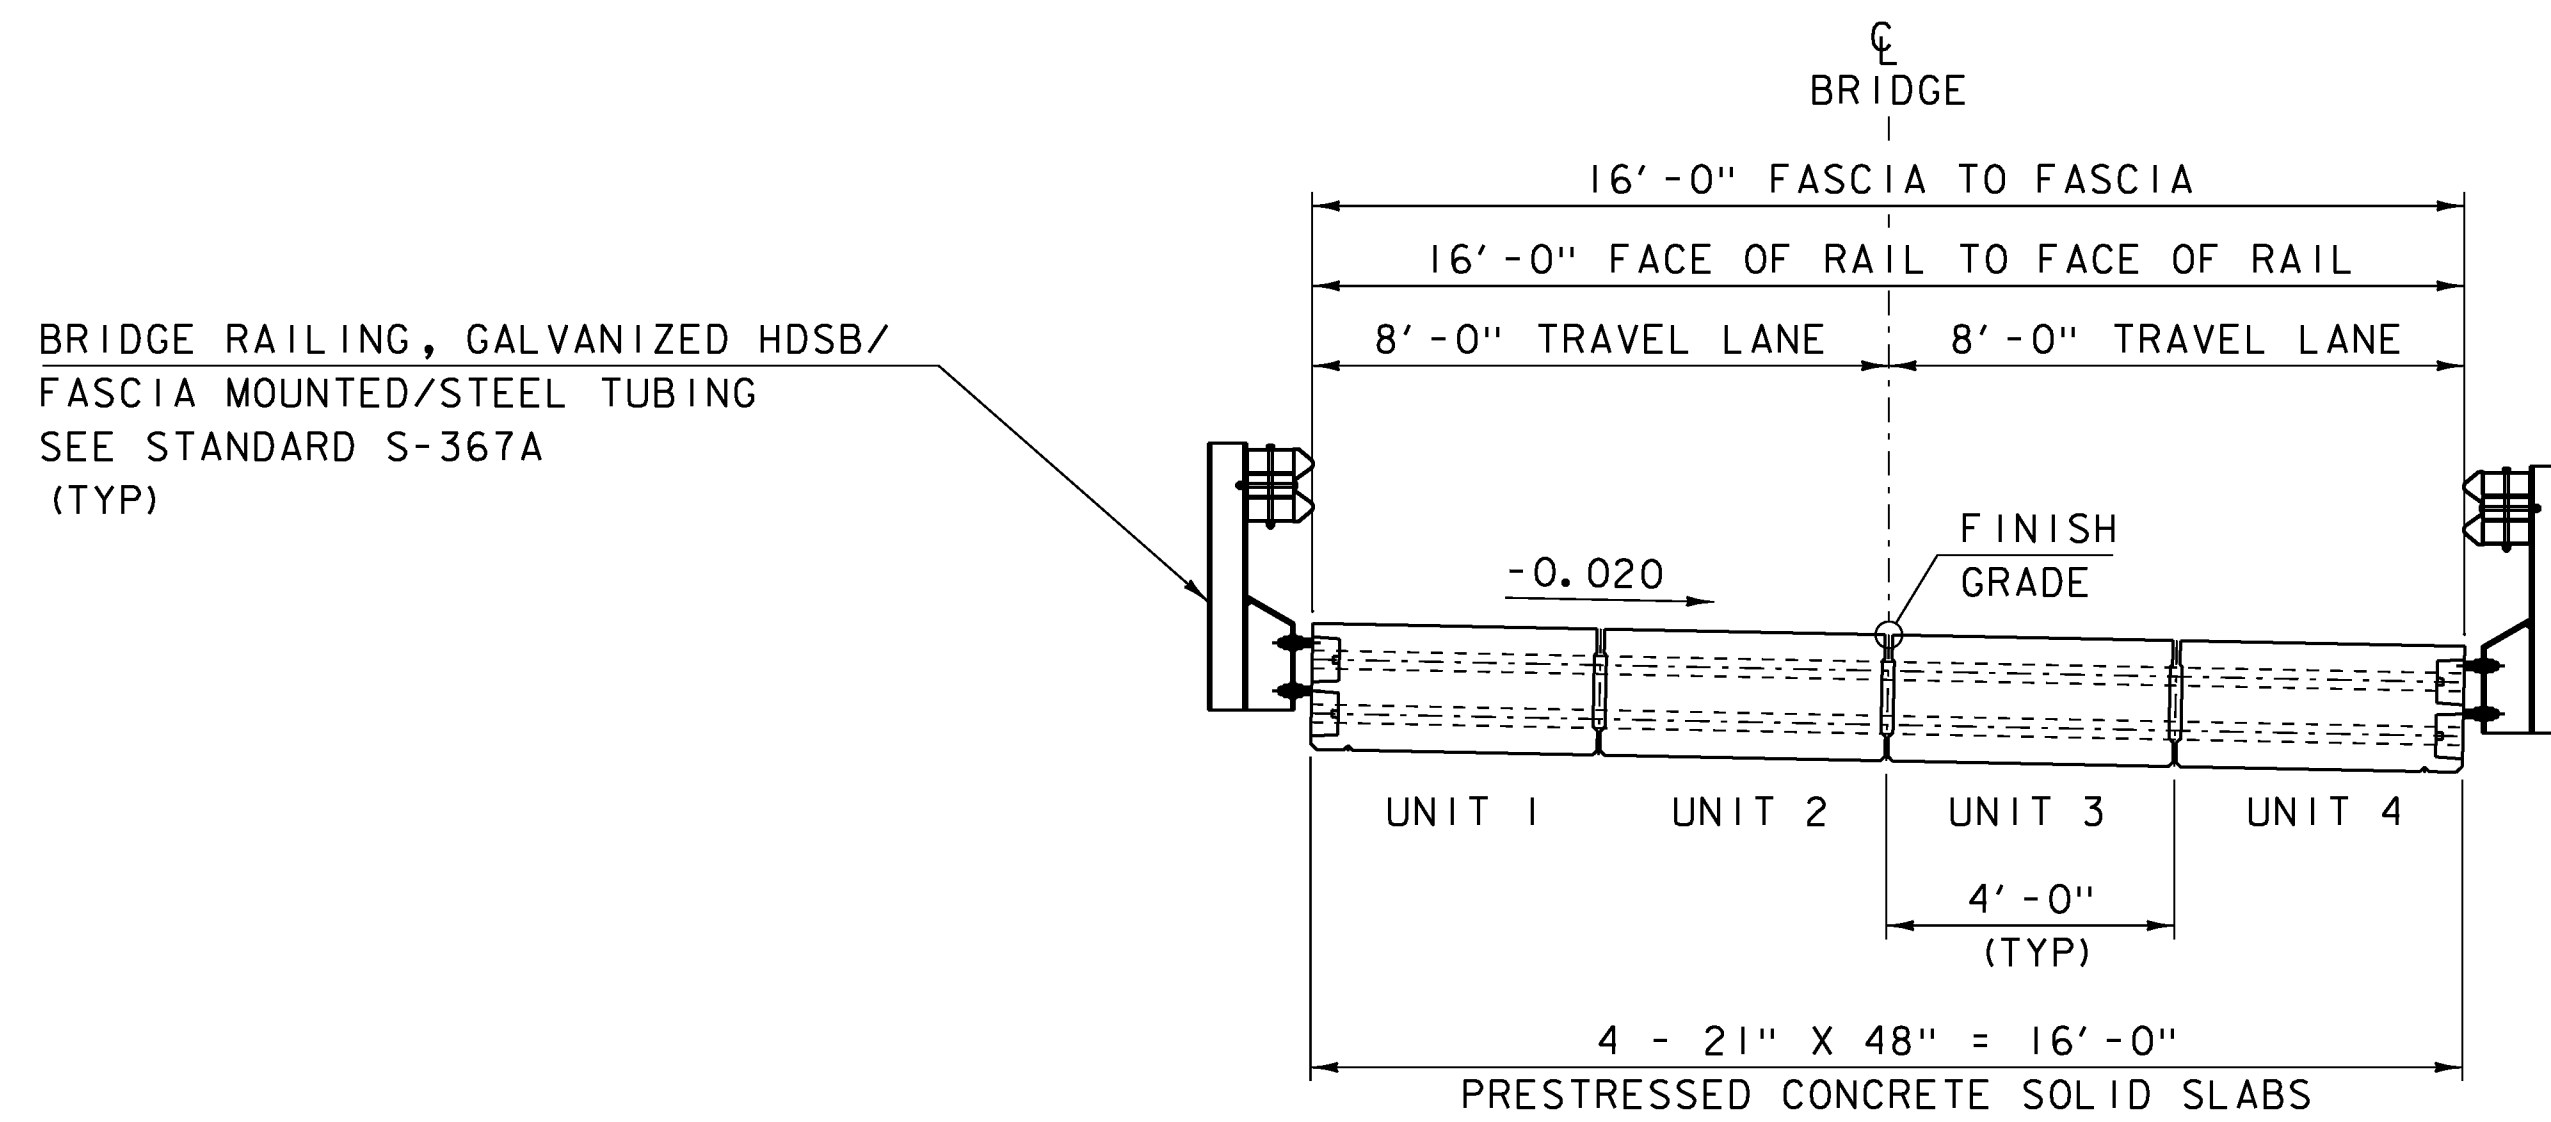

**BRIDGE TYPICAL SECTION**


SCALE 3/8" = 1'-0"

MATERIAL TOLERANCES (IF USED ON PROJECT)	
SURFACE	
- PAVEMENT (TOTAL THICKNESS)	+/- 1/4"
- AGGREGATE SURFACE COURSE	+/- 1/2"
SUBBASE	+/- 1"
SAND BORROWS	+/- 1"

PROJECT NAME: FAIRFIELD  
PROJECT NUMBER: BRO 1448(41)

FILE NAME: sl2j170+yp.dgn  
PROJECT LEADER: R. YOUNG  
DESIGNED BY: R. KLINEFELTER  
TYPICAL SECTIONS 1

PLOT DATE: 18-AUG-2014  
DRAWN BY: K. FRIEDLAND  
CHECKED BY: J. SALVATORI  
SHEET 43 OF 69

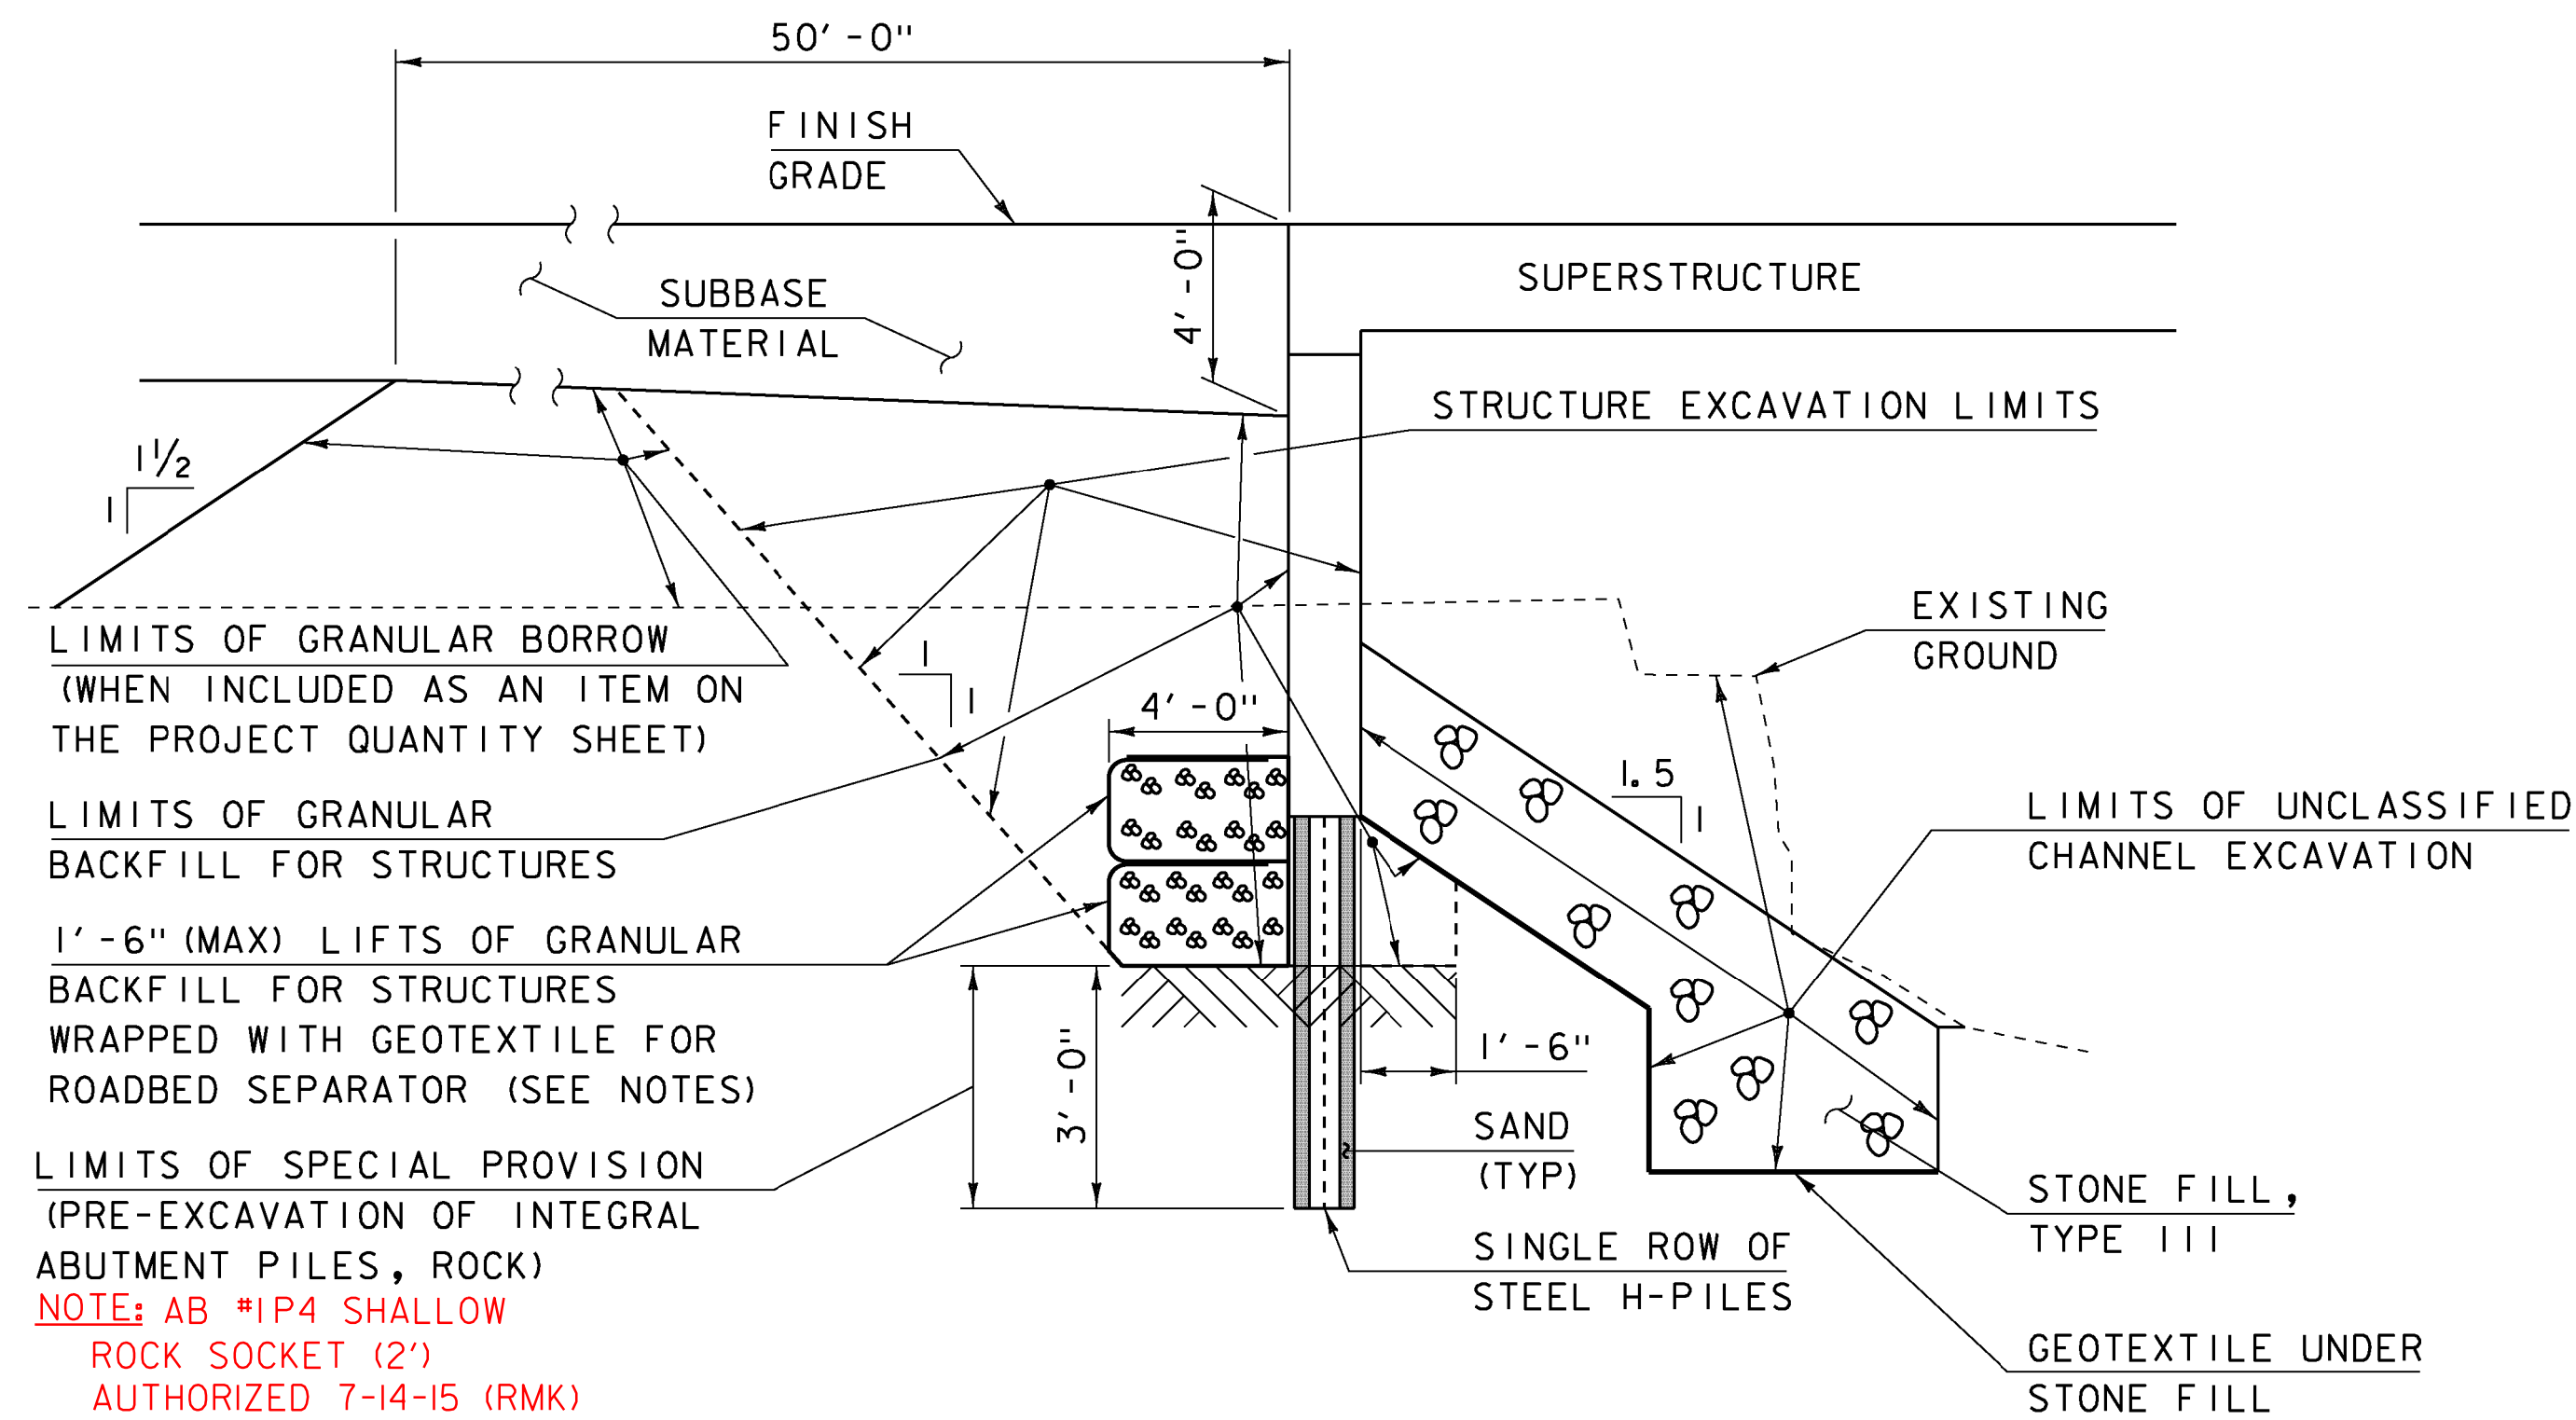


NOTE: AB *IP4 SHALLOW  
ROCK SOCKET (2')  
AUTHORIZED 7-14-15 (RMK)

NOTES:

- 1) WRAPPED MATERIAL BEHIND ABUTMENT SHALL REST ON BEDROCK AND BE PLACED IN LEVEL LIFTS. IF SLOPING BEDROCK IS ENCOUNTERED, LIFTS SHALL BE STEPPED AS NEEDED.
- 2) WRAPPED MATERIAL SHALL EXTEND A MINIMUM OF 1'-0" ABOVE THE BOTTOM OF ABUTMENT AND EXTEND THE FULL WIDTH OF THE ABUTMENT.


**ABUTMENT 1 TYPICAL INTEGRAL ABUTMENT SECTION**

(NOT TO SCALE)

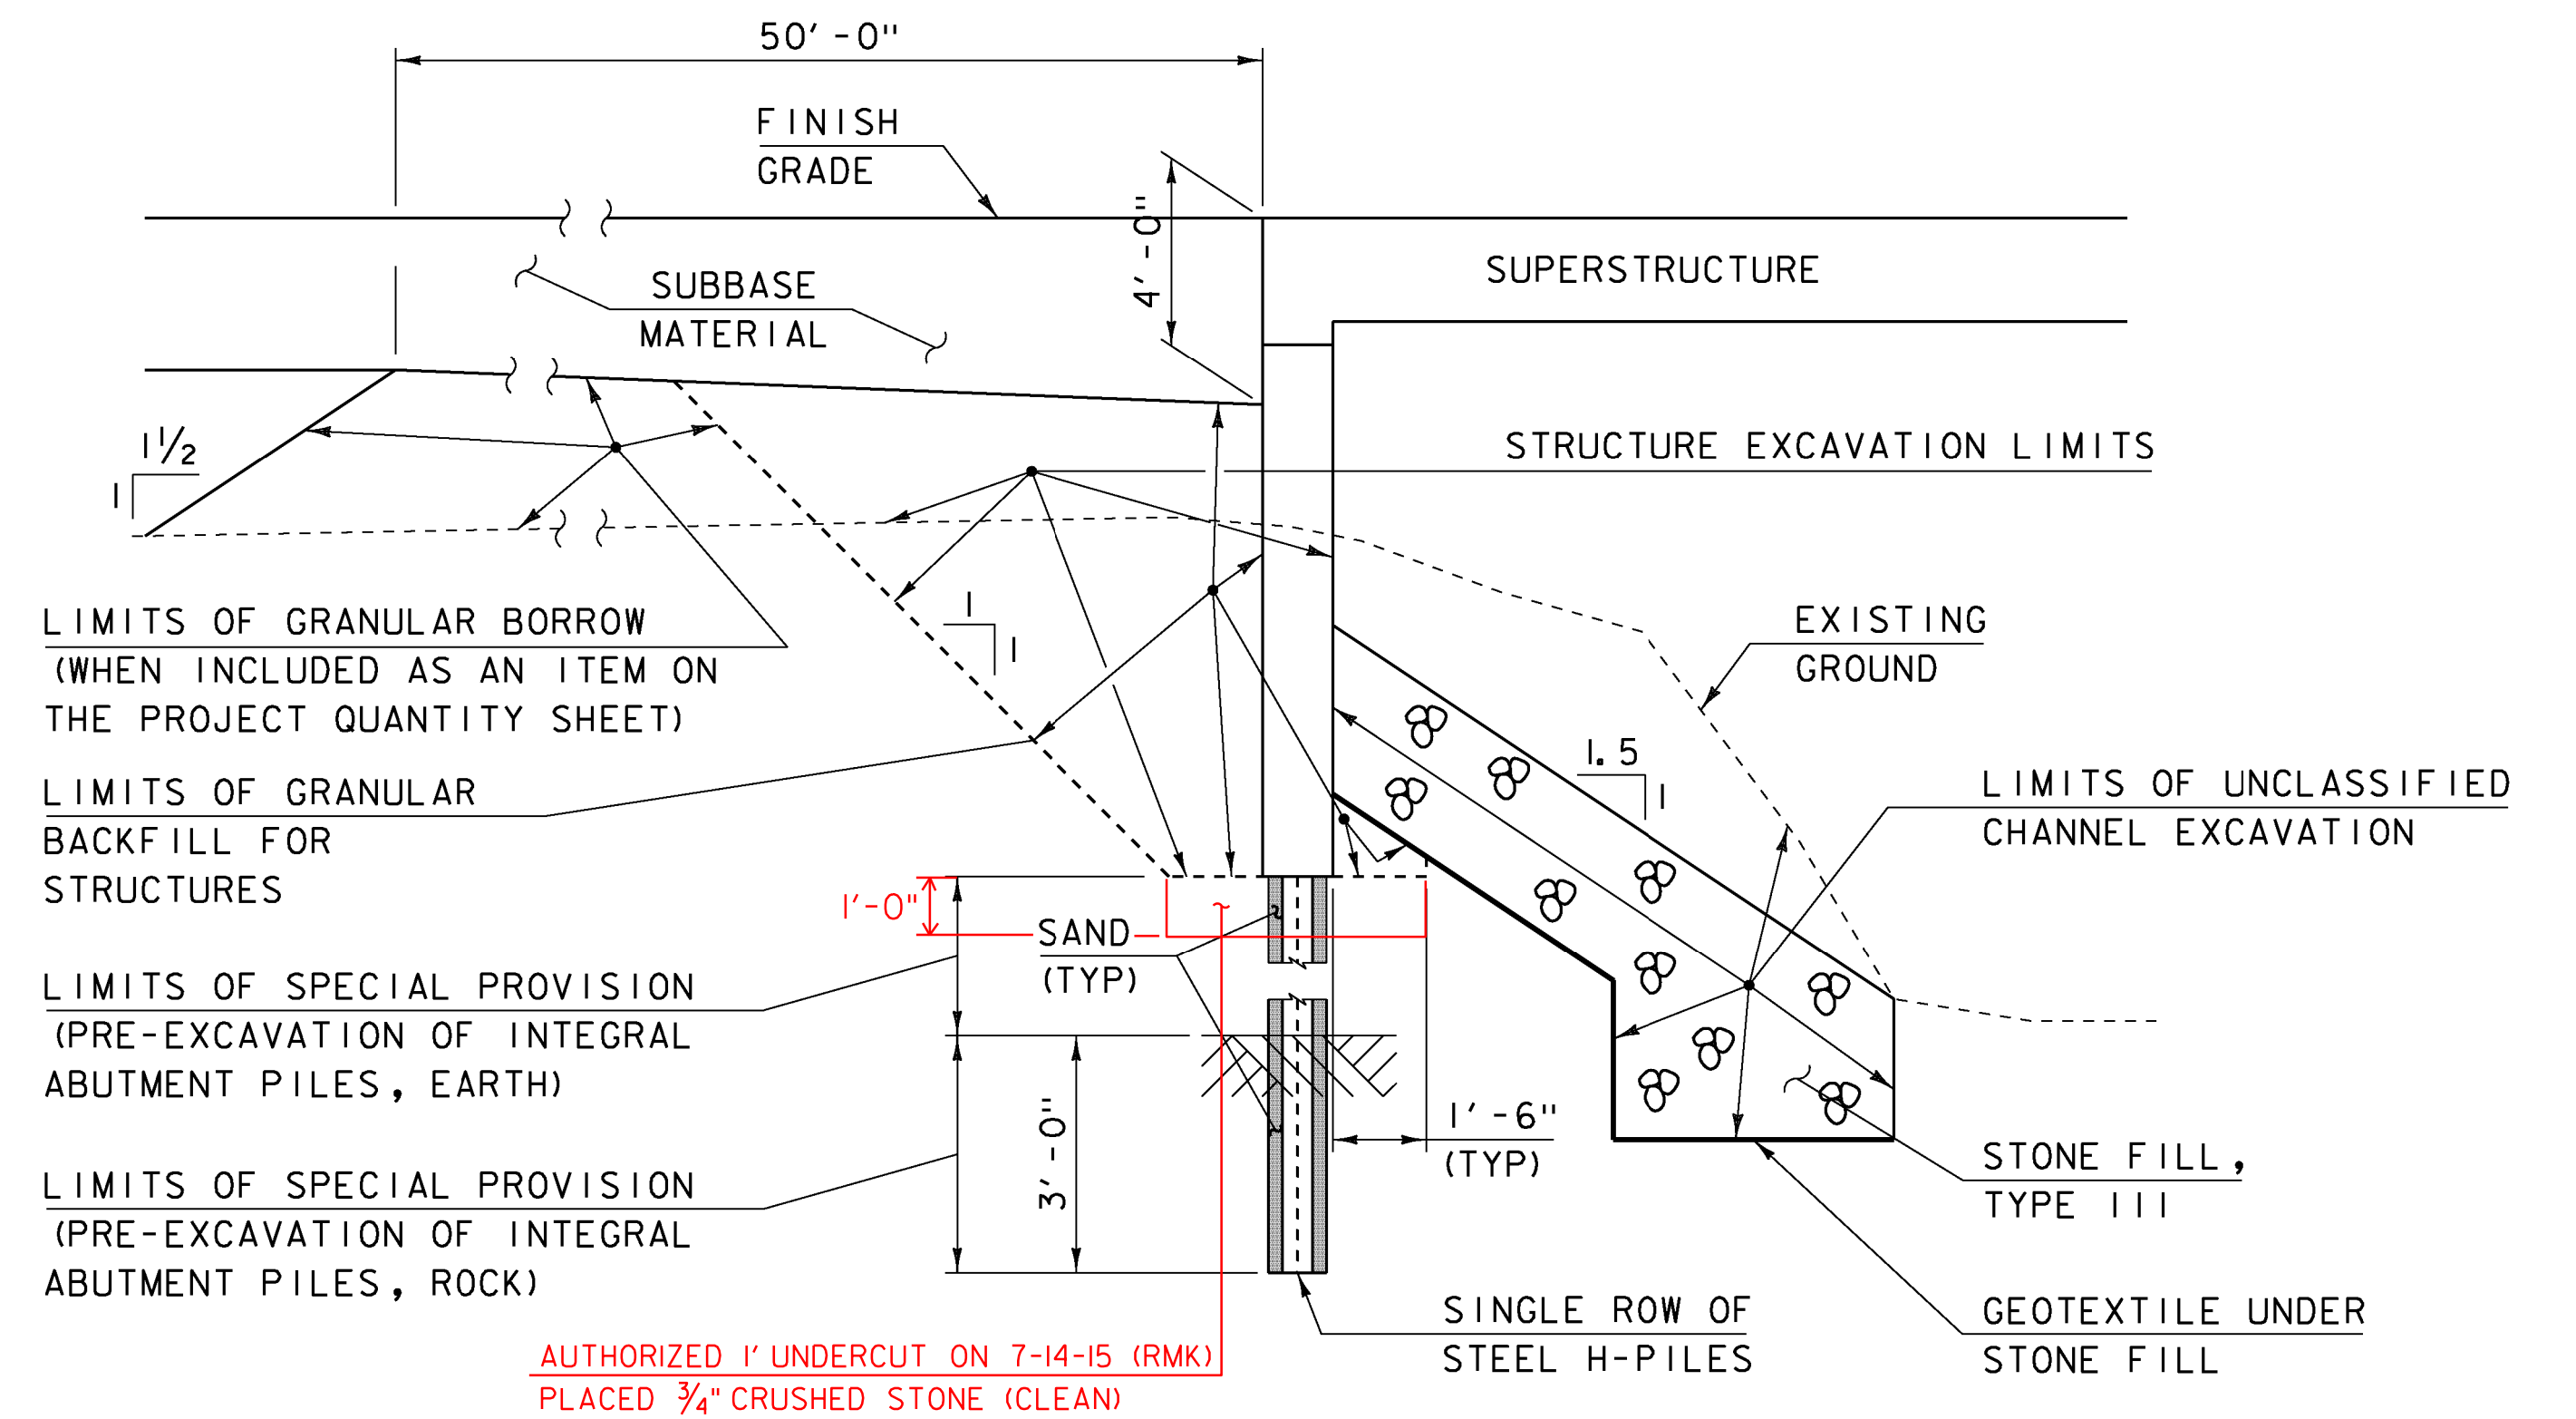

**ABUTMENT 2 TYPICAL INTEGRAL ABUTMENT SECTION**

(NOT TO SCALE)

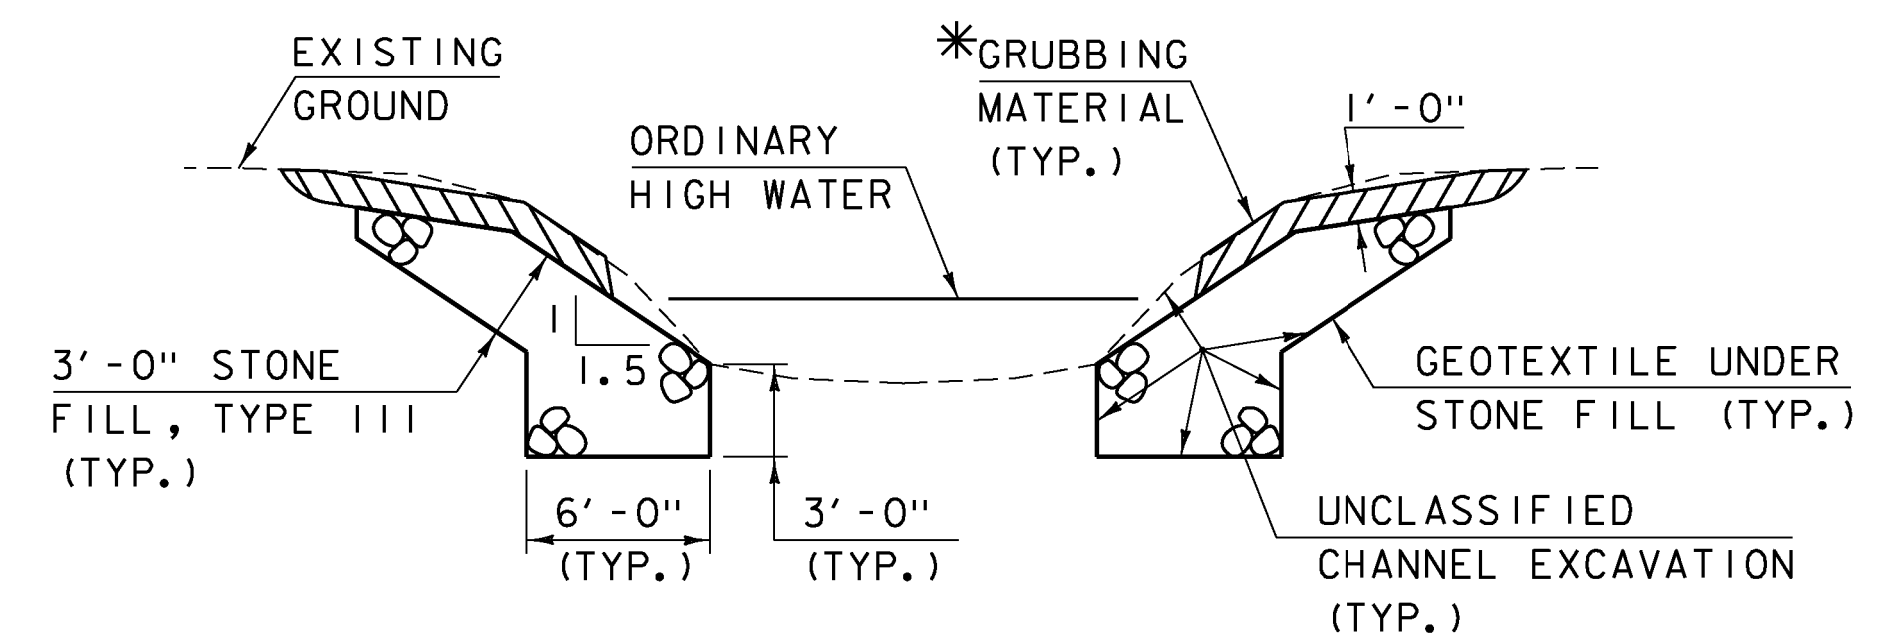

**TYPICAL CHANNEL SECTION**

(NOT TO SCALE)

*GRUBBING MATERIAL SHALL NOT BE PLACED ON THE STONE FILL IN THE AREA UNDER THE BRIDGE. WHENEVER CHANNEL SLOPE INTERSECTS ROADWAY SUBBASE, GRUBBING MATERIAL SHALL BEGIN AT THE BOTTOM OF SUBBASE.

PROJECT NAME: FAIRFIELD	PLOT DATE: 10-SEP-2014
PROJECT NUMBER: BRO 1448(41)	DRAWN BY: K. FRIEDLAND
FILE NAME: sl2j170+yp.dgn	CHECKED BY: J. SALVATORI
PROJECT LEADER: R. YOUNG	SHEET 44 OF 69
DESIGNED BY: R. KLINFELTER	
TYPICAL SECTIONS 2	

GPS CONTROL POINTS

HVCTRL #1

ELMBROOK  
 NORTH = 835145.869  
 EAST = 1543642.073  
 ELEV. = 402.610

GENERAL LOCATION, FAIRFIELD, VT., IN EAST FAIRFIELD. TO REACH FROM THE INTERSECTION VT ROUTE 36 AND VT ROUTE 108 IN BAKERSFIELD, GO WEST ALONG VT ROUTE 36 FOR 3.0 MI TO THE INTERSECTION OF MILL STREET LEFT. CONTINUE STRAIGHT AHEAD AND GO NORTHWEST ALONG VT ROUTE 36 FOR 0.7 MI TO THE INTERSECTION OF ELM BROOK ROAD LEFT. TURN LEFT AND GO NORTHWEST AND THEN SOUTHWEST ALONG ELM BROOK ROAD FOR 0.2 MI TO THE SITE OF THE MARK ON THE LEFT. THE MARK IS SET 2 CM BELOW GROUND SURFACE IN THE TOP OF A 30 CM DIAMETER CONCRETE MONUMENT POURED 1.2 M DEEP. IT IS 3.4 M EAST OF AND ABOUT 0.2 M LOWER THAN THE CENTERLINE OF ELM BROOK ROAD, 38.7 M SOUTH SOUTHWEST OF POLE NO 201/1, AND 31.0 M NORTH NORTHWEST OF POLE NO 2 AND A FIBERGLASS WITNESS POST.

HVCTRL #2


ELMBROOK AZ MK  
 NORTH = 833823.024  
 EAST = 1546286.569  
 ELEV. = 398.720

GENERAL LOCATION, FAIRFIELD, VT., IN EAST FAIRFIELD. OWNERSHIP, SHANNON MITCHELL, 9240 VT ROUTE 36, EAST FAIRFIELD, VT 05448. TO REACH FROM THE INTERSECTION VT ROUTE 36 AND VT ROUTE 108 IN BAKERSFIELD, GO WEST ALONG VT ROUTE 36 FOR 3.0 MI TO THE INTERSECTION OF MILL STREET LEFT. CONTINUE STRAIGHT AHEAD AND GO NORTHWEST ALONG VT ROUTE 36 FOR 0.15 MI TO THE SITE OF THE MARK ON THE LEFT. THE MARK IS SET IN THE TOP OF A MASSIVE ROCK OUTCROP JUST NORTHWEST OF HOUSE NO 9240. IT IS 14.7 M SOUTHWEST OF AND ABOUT 4 M HIGHER THAN THE CENTERLINE OF VT ROUTE 36, 10.9 M NORTHWEST OF THE NORTH CORNER OF HOUSE NO 9240, 12.0 M NORTH OF THE WEST CORNER OF THE HOUSE, 2.1 M NORTH NORTHEAST OF A 14 MM DIAMETER STEEL BOLT WITH SQUARE NUT SET IN THE TOP OF THE OUTCROP, AND 3.6 M WEST SOUTHWEST OF THE WEST CORNER OF A GARDEN SHED.

TRAVERSE TIES

HVCTRL #3





NORTH = 835608.228  
 EAST = 1544118.760  
 ELEV. = 378.248

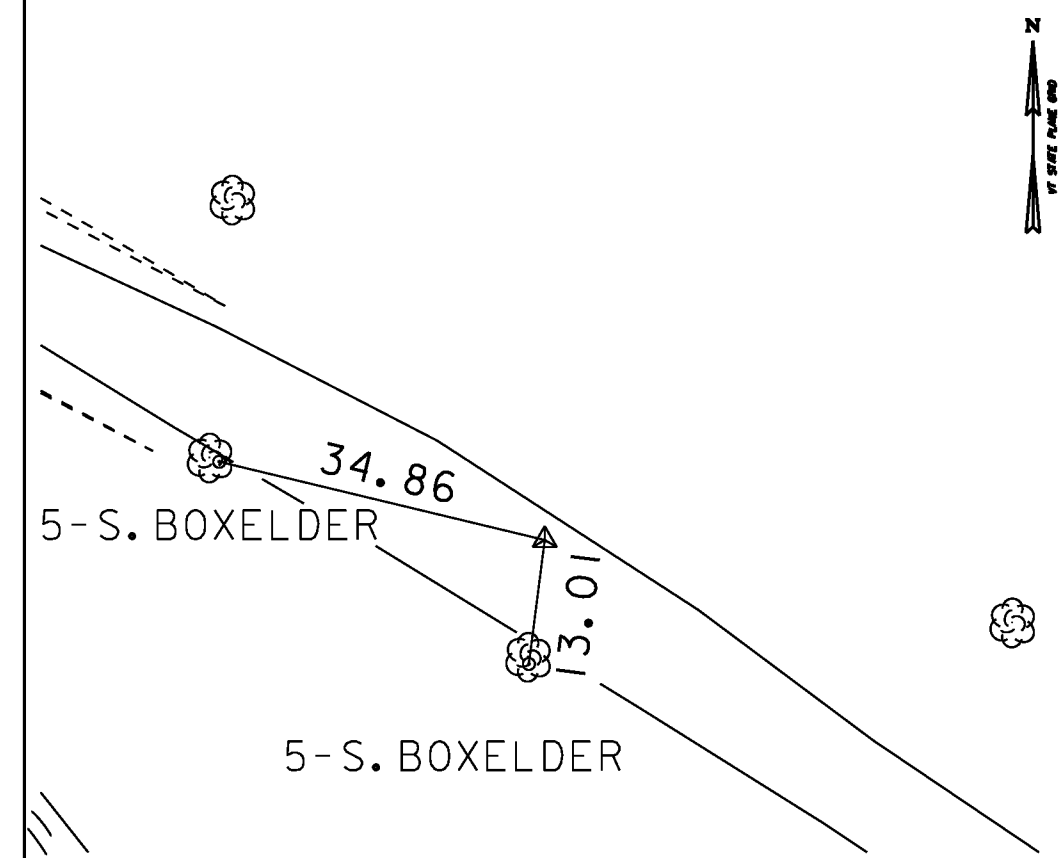

*MAIN TRAVERSE COMPLETED 3/11/2012 BY L. ORVIS P.C. & G. HITCHCOCK



HVCTRL #4

   NORTH = 835545.864  
 EAST = 1543760.945  
 ELEV. = 393.952

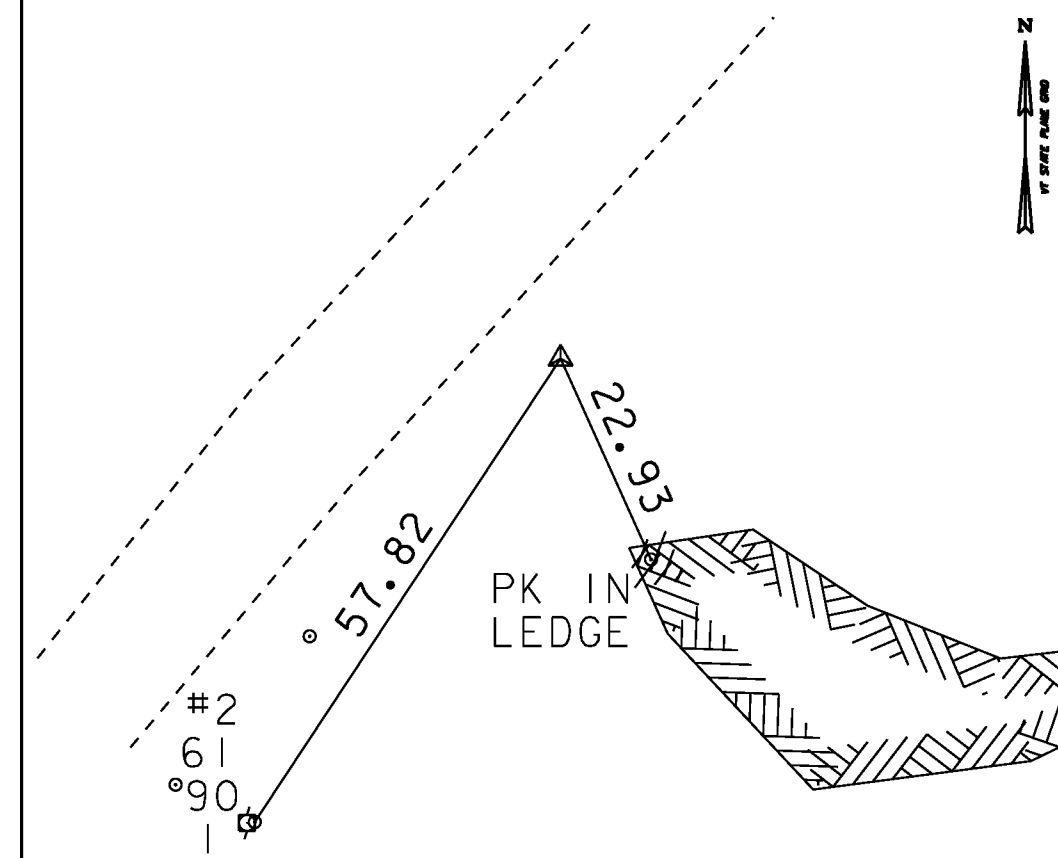

DATUM	
VERTICAL	NAVD 88
HORIZONTAL	NAD 83 (07)
ADJUSTMENT	COMPASS

PROJECT NAME: FAIRFIELD	
PROJECT NUMBER: BRO 1448 (41)	
FILE NAME: x12j170+1.dgn	PLOT DATE: 18-AUG-2014
PROJECT LEADER: R. YOUNG	DRAWN BY: K. FRIEDLAND
DESIGNED BY: R. KLINEFELTER	CHECKED BY: R. KLINEFELTER
TIE SHEET	SHEET 45 OF 69

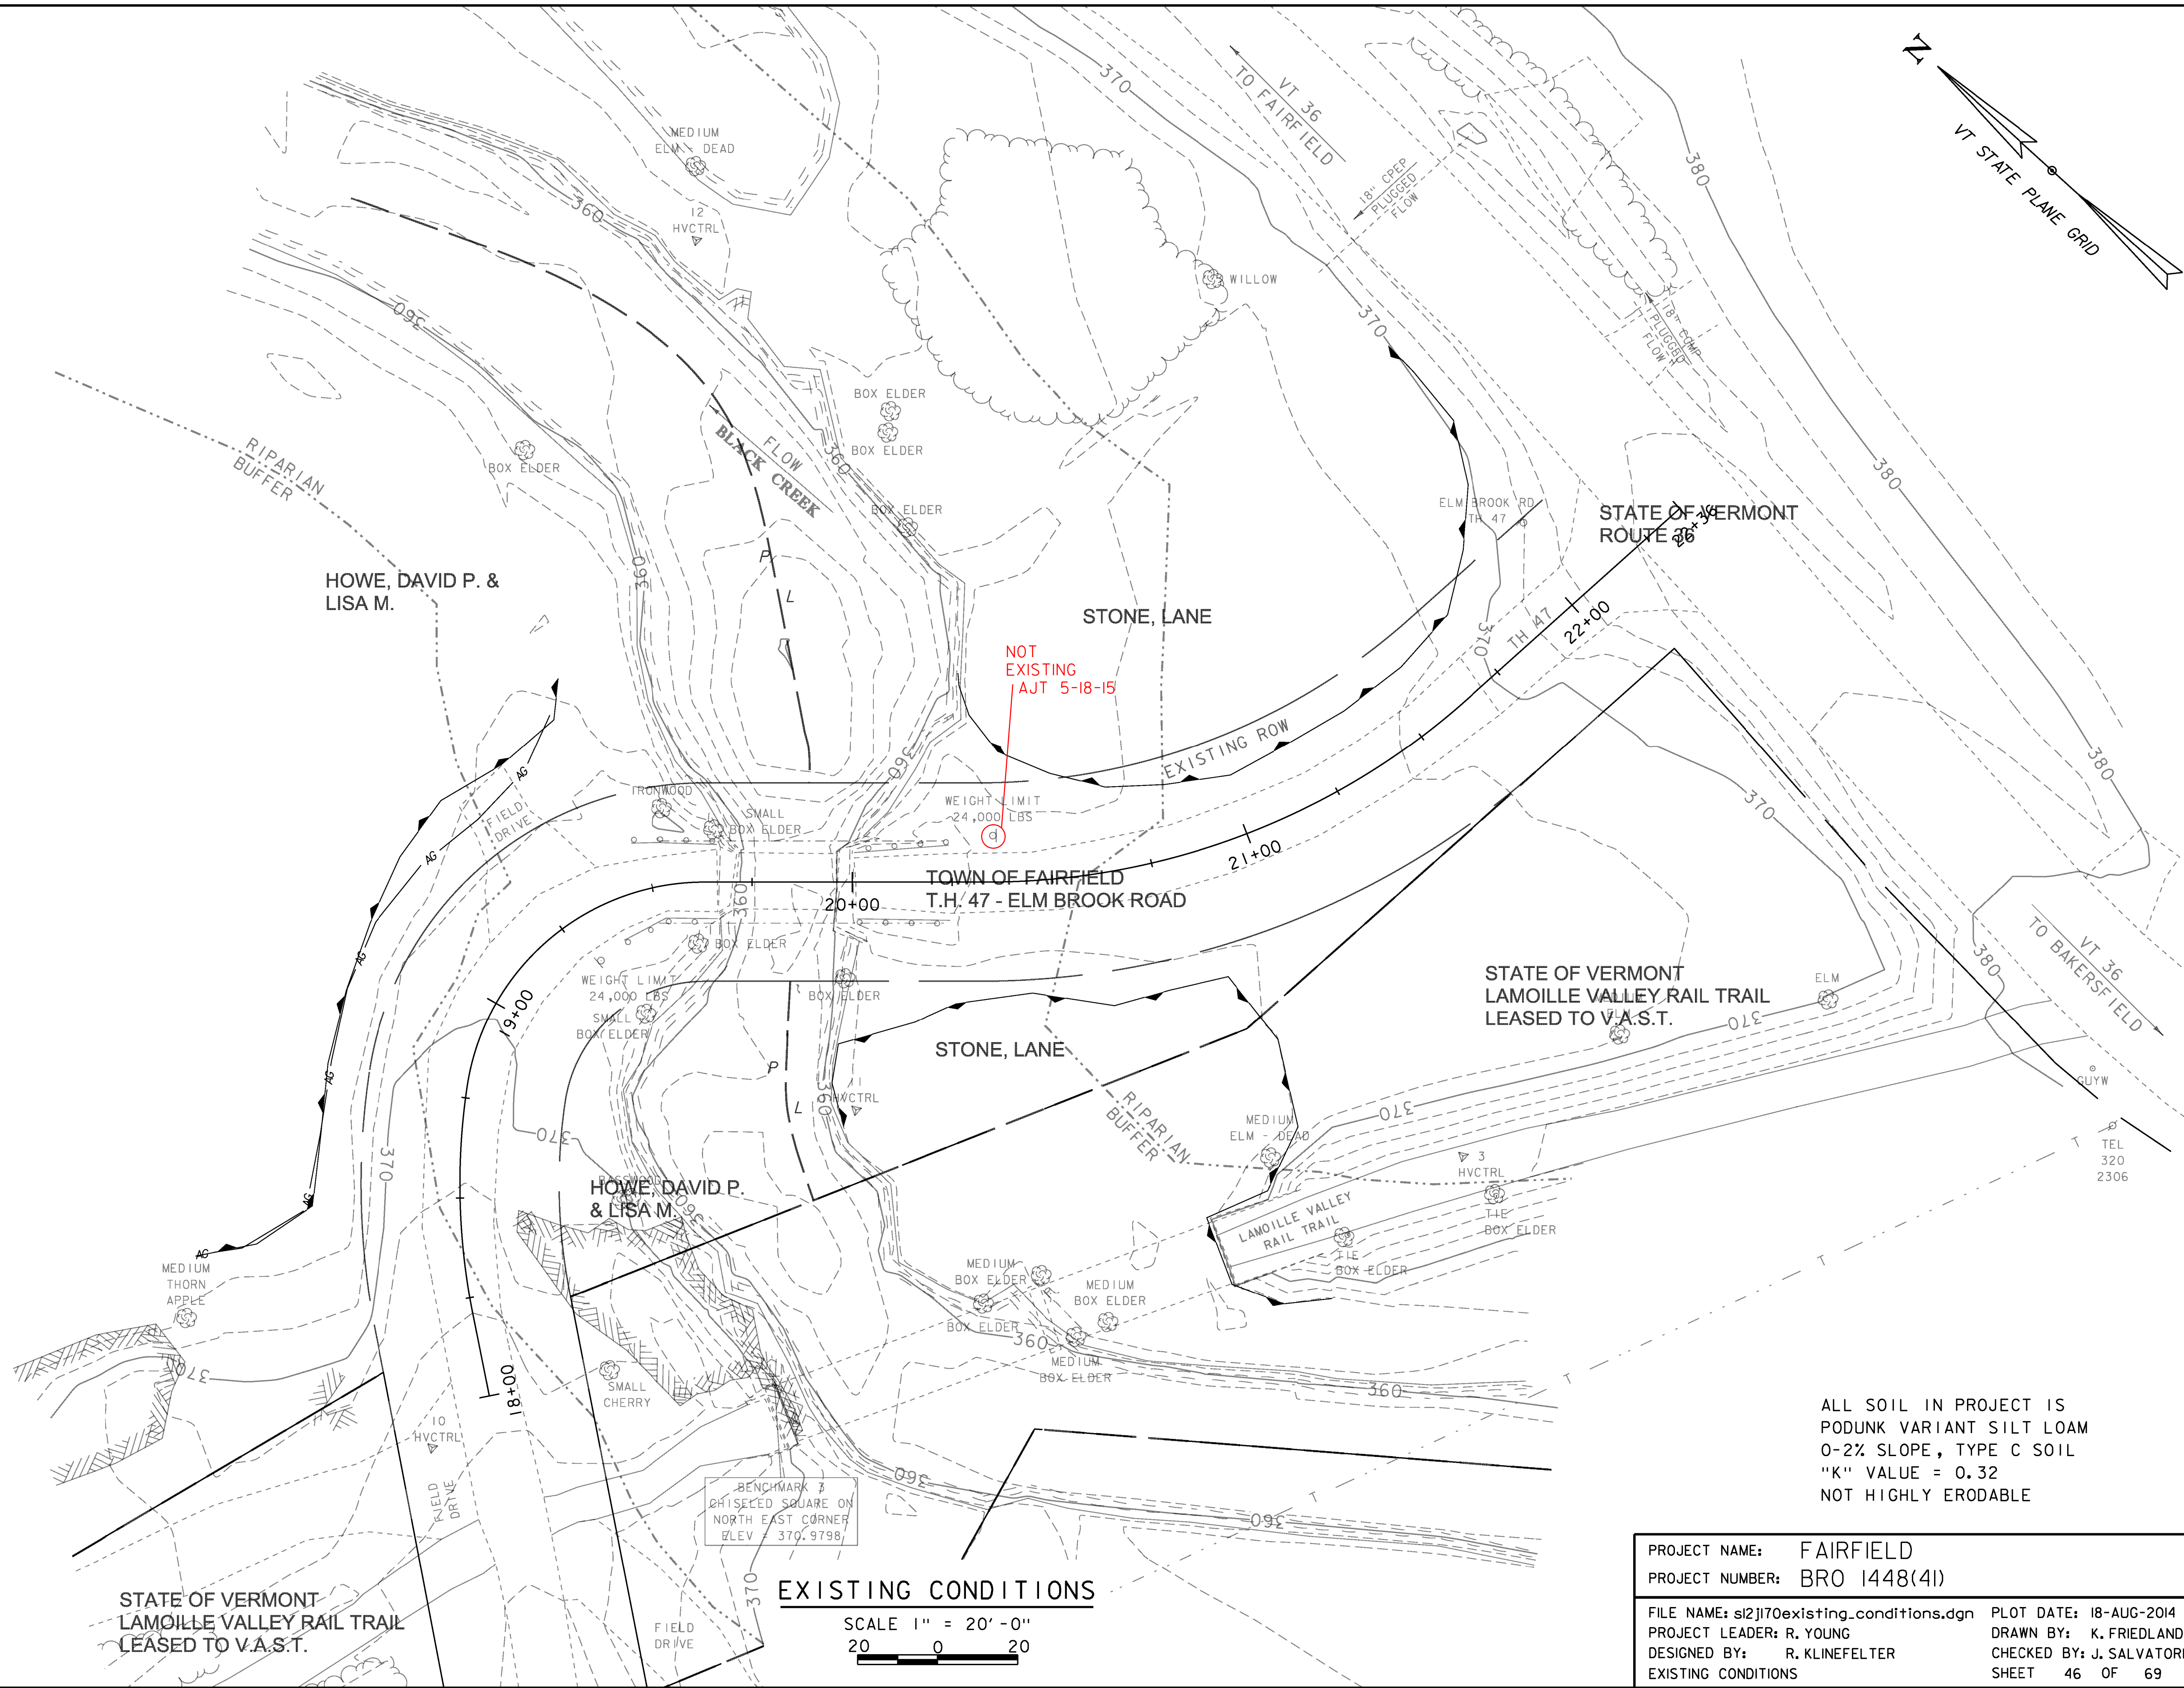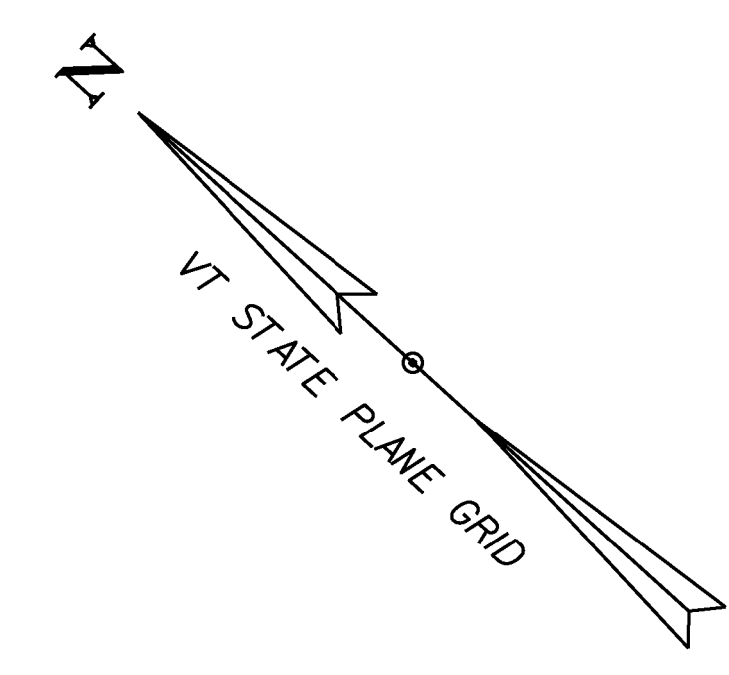

EXISTING BRIDGE DATA  
 YEAR BUILT = 1919  
 SINGLE SPAN ROLLED BEAM  
 LENGTH = 35 FEET  
 CLEAR SPAN = 27 FEET  
 ROADWAY WIDTH = 14 FEET

STATE OF VERMONT  
 LAMOILLE VALLEY RAIL TRAIL  
 LEASED TO V.A.S.T.

EXISTING CONDITIONS  
 SCALE 1" = 20'-0"  
 20 0 20

ALL SOIL IN PROJECT IS  
 PODUNK VARIANT SILT LOAM  
 0-2% SLOPE, TYPE C SOIL  
 "K" VALUE = 0.32  
 NOT HIGHLY ERODABLE

PROJECT NAME:	FAIRFIELD	PLOT DATE:	18-AUG-2014
PROJECT NUMBER:	BRO 1448(41)	DRAWN BY:	K. FRIEDLAND
FILE NAME:	sl2j170existing_conditions.dgn	DESIGNED BY:	R. KLINFELTER
EXISTING CONDITIONS		CHECKED BY:	J. SALVATORI
		SHEET	46 OF 69

MILEMARKER, STATION, OR SIGN NUMBER	SIGN LEGEND	SIGN DIMENSIONS		NEW SIGN "A"	EXISTING SIGN RETAIN	NO. OF POSTS	NEW SIGN POSTS SQUARE STEEL (in)					REMARKS	SIGN DETAIL	
		WIDTH	HEIGHT				SIZES			ANCHOR RODS	NUTS & WASHERS		DETAIL ON SHEET NUMBER	STD. SHEET NUMBER
							1.75	2.0	2.5					
19+50.00 RT	BRIDGE 46	6	8	0.33		1	1.88	2.42	3.35		X	VD-701	T-42	
20+20.00 LT	BRIDGE 46	6	8	0.33		1	1.88	2.42	3.35		X	VD-701	T-42	
FINAL POST LENGTHS ARE TO BE DETERMINED IN THE FIELD. POST SIZES ARE COMPUTED BASED ON INFORMATION FURNISHED ON THE STANDARD SHEETS AND THE VTRANS "SIGN POST DESIGN GUIDELINE."							FT	FT	FT	EA				
<b>TOTALS</b>							SF	FT						
							0.66	30			N = NEW R = REMOVE & SALVAGE SHS = STANDARD HIGHWAY SIGNS (MUTCD)			

NOTE:

1) BRIDGE NUMBER PLAQUE AND LEGAL LOAD LIMIT SIGN SHALL BE MOUNTED ON THE SAME POST.

CURVE (1)  
 DELTA = 19°50'18"  
 D = 34°56'11"  
 R = 164.00'  
 T = 28.68'  
 L = 56.78'  
 E = 2.49'

CURVE (2)  
 DELTA = 81°30'38"  
 D = 95°29'35"  
 R = 60.00'  
 T = 51.71'  
 L = 85.36'  
 E = 19.21'

CURVE (3)  
 DELTA = 41°49'53"  
 D = 31°49'52"  
 R = 180.00'  
 T = 68.79'  
 L = 131.42'  
 E = 12.70'

CONSTRUCT DRIVE  
 STA 19+05.00 LT - 19+46.00 LT  
 REMOVAL AND DISPOSAL OF GUARDRAIL  
 STA 19+48.00 LT - 19+66.00 LT  
 STA 19+38.00 RT - 19+66.00 RT  
 STA 20+00.00 LT - 20+24.00 LT  
 STA 20+01.00 RT - 20+24.00 RT  
 REMOVING SIGNS  
 STA 19+29.00 RT  
 STA 20+35.00 LT  
 ERECTING SALVAGED SIGNS  
 STA 19+50.00 RT  
 STA 20+20.00 LT

PI #1  
 STA 18+49.12 AHD=  
 STA 18+49.69 BK  
 N= 835788.2014  
 E= 1543940.8316

BEGIN APPROACH  
 STA 18+50.00  
 MATCH EXISTING

MAINLINE POB  
 STA 18+00.00  
 N= 835748.2511  
 E= 1543911.2823

BEGIN BRIDGE  
 STA 19+57.50

BEGIN PROJECT  
 STA 19+50.00

PI #2  
 STA 19+11.44 AHD=  
 STA 19+29.51 BK  
 N= 835832.7735  
 E= 1544007.7329

CL BRG  
 STA 19+59.00  
 FG = 369.77

CHANNEL POE  
 STA 51+00.00  
 N= 835827.1022  
 E= 1544114.0496

CHANNEL POB  
 STA 50+00.00  
 N= 835726.4171  
 E= 1544002.8628

CL BRG  
 STA 20+10.00  
 FG = 369.09

END APPROACH  
 STA 21+25.00  
 MATCH EXISTING

PROJECT LIMITS  
 (TYP)

END PROJECT  
 STA 20+25.00


END BRIDGE  
 STA 20+11.50

STONE FILL,  
 TYPE III  
 (TYP)

ML STA 19+87.00 =  
 CHAN STA 50+75.00  
 Δ = 90° 0' 0" RT

PI #3  
 STA 20+96.30 AHD=  
 STA 21+02.47 BK  
 N= 835691.1790  
 E= 1544135.9536

MAINLINE POE  
 STA 22+36.01  
 N= 835676.5609  
 E= 1544274.8903

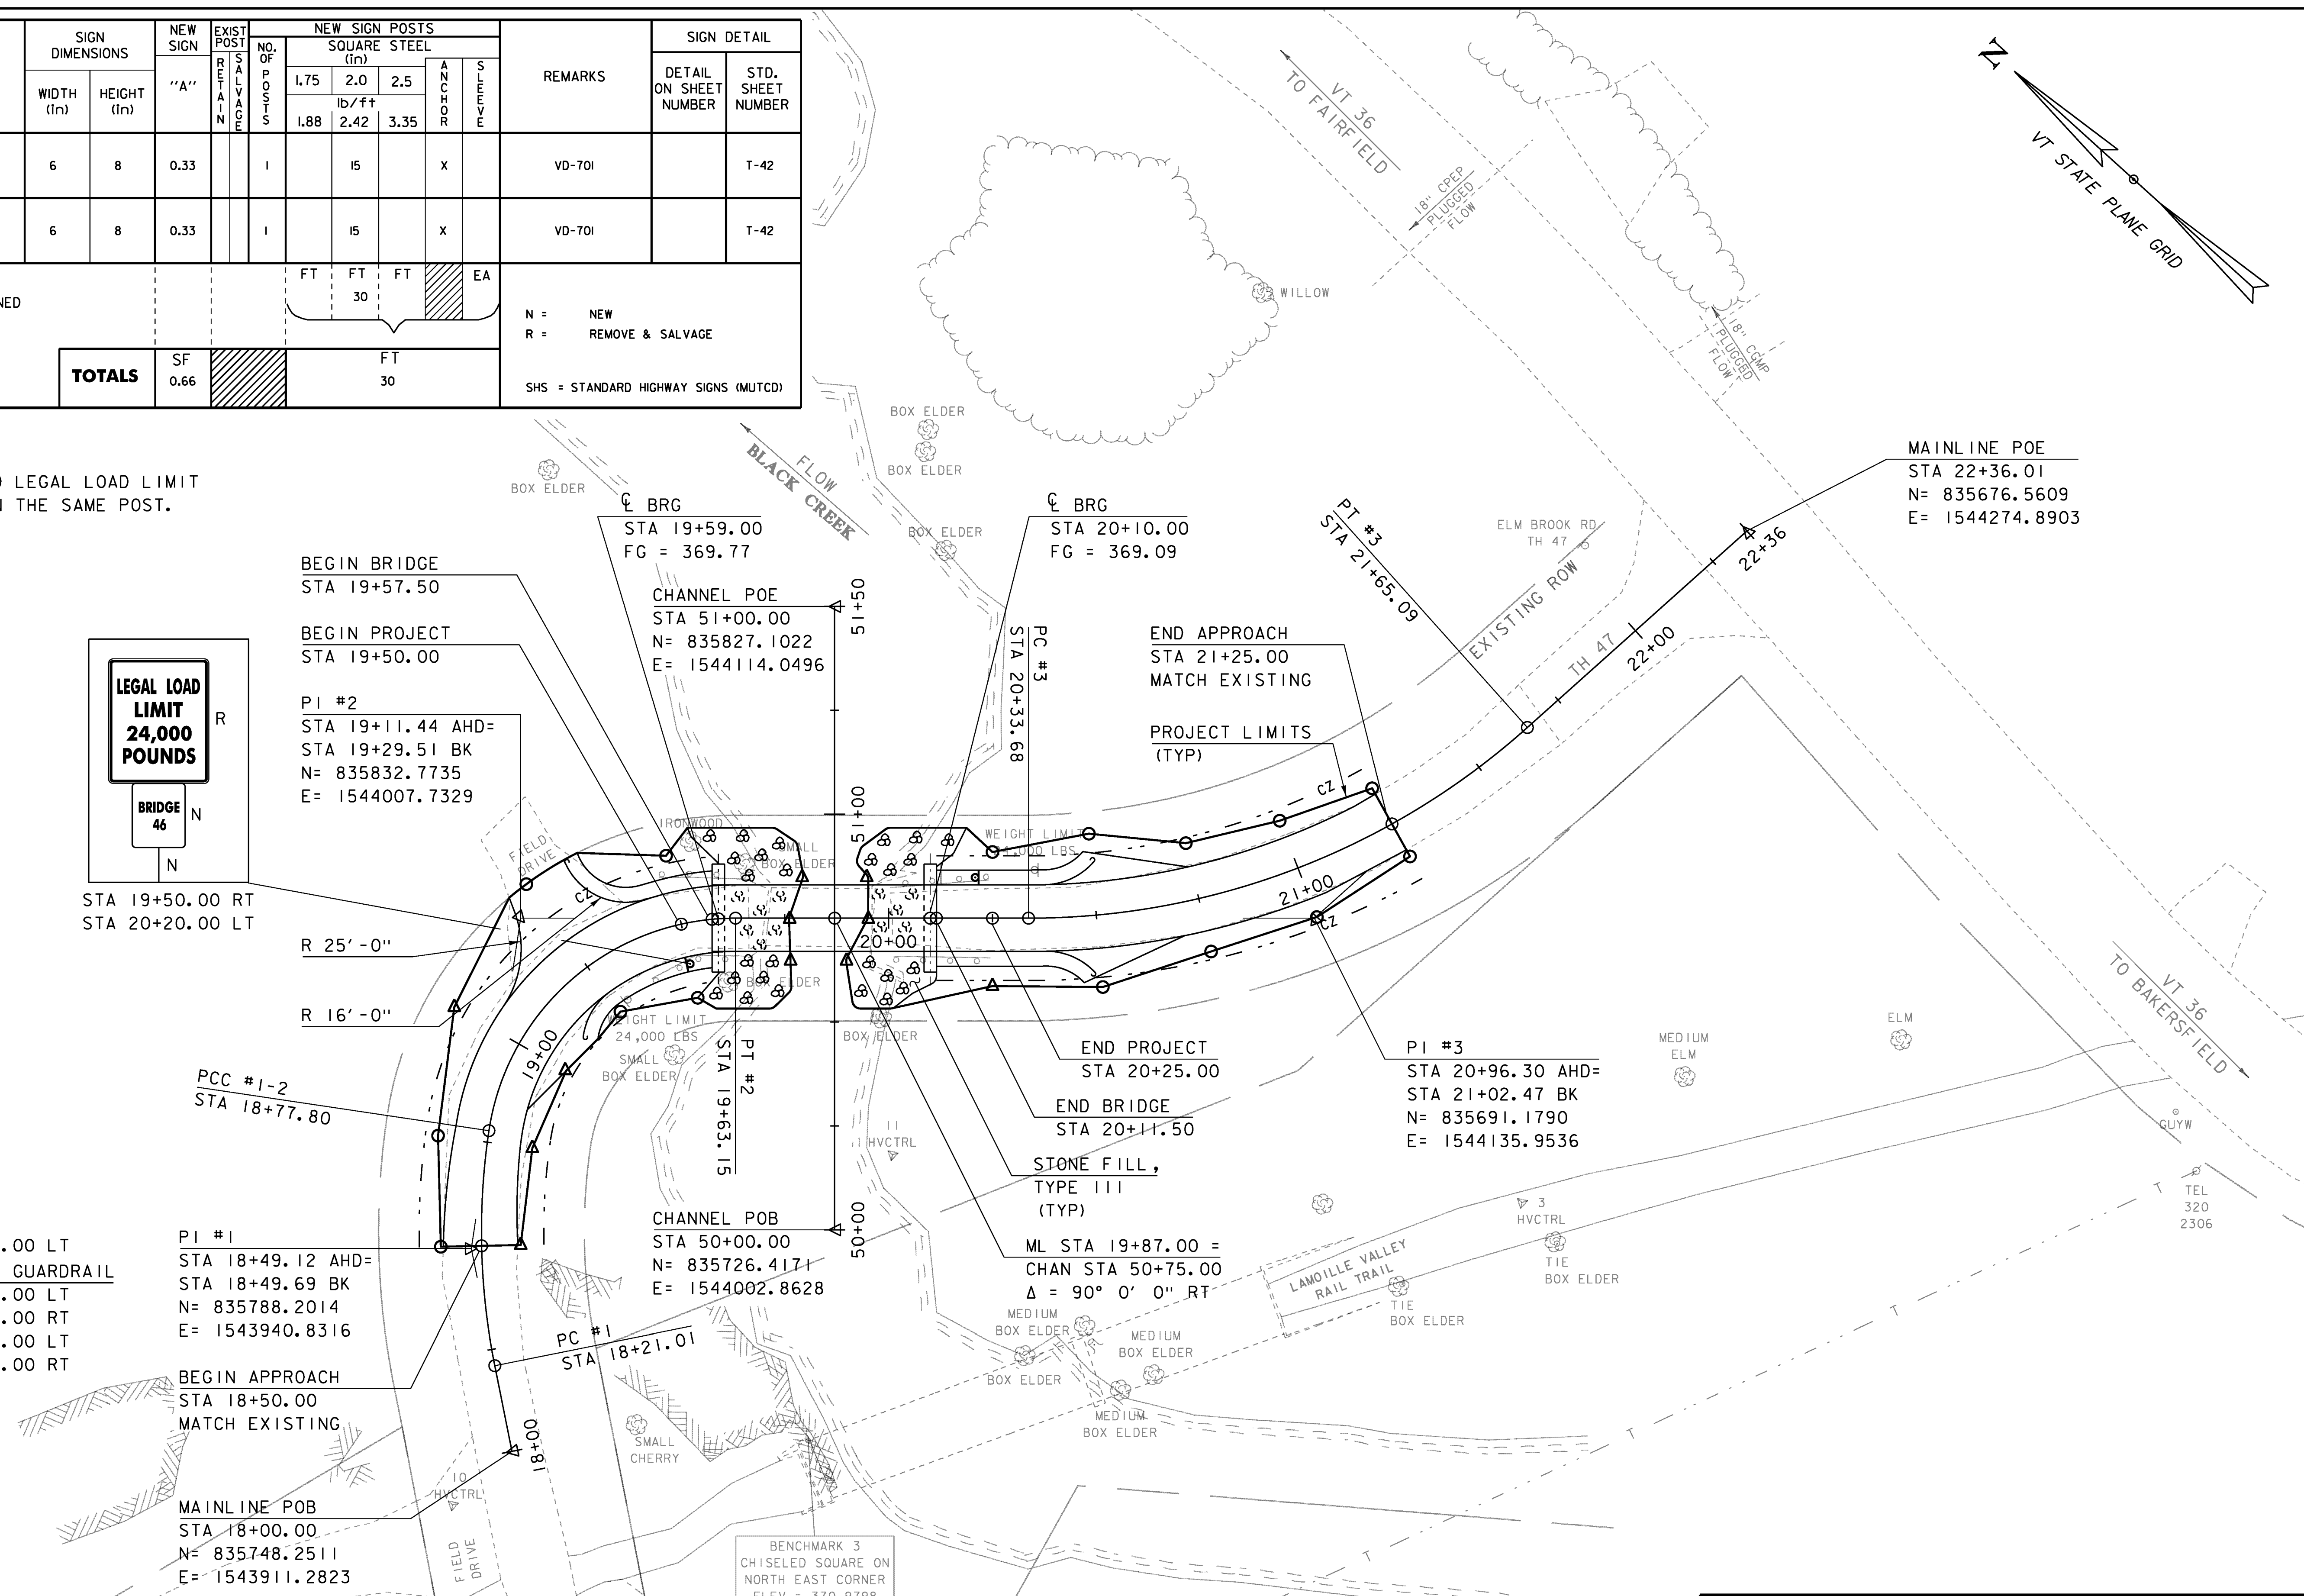


LAYOUT SHEET

SCALE 1" = 20'-0"  
 20 0 20

PROJECT NAME: FAIRFIELD  
 PROJECT NUMBER: BRO 1448(41)

FILE NAME: sl2j170bdr.dgn  
 PROJECT LEADER: R. YOUNG  
 DESIGNED BY: R. KLINEFELTER  
 LAYOUT SHEET


PLOT DATE: 18-AUG-2014  
 DRAWN BY: K. FRIEDLAND  
 CHECKED BY: J. SALVATORI  
 SHEET 47 OF 69

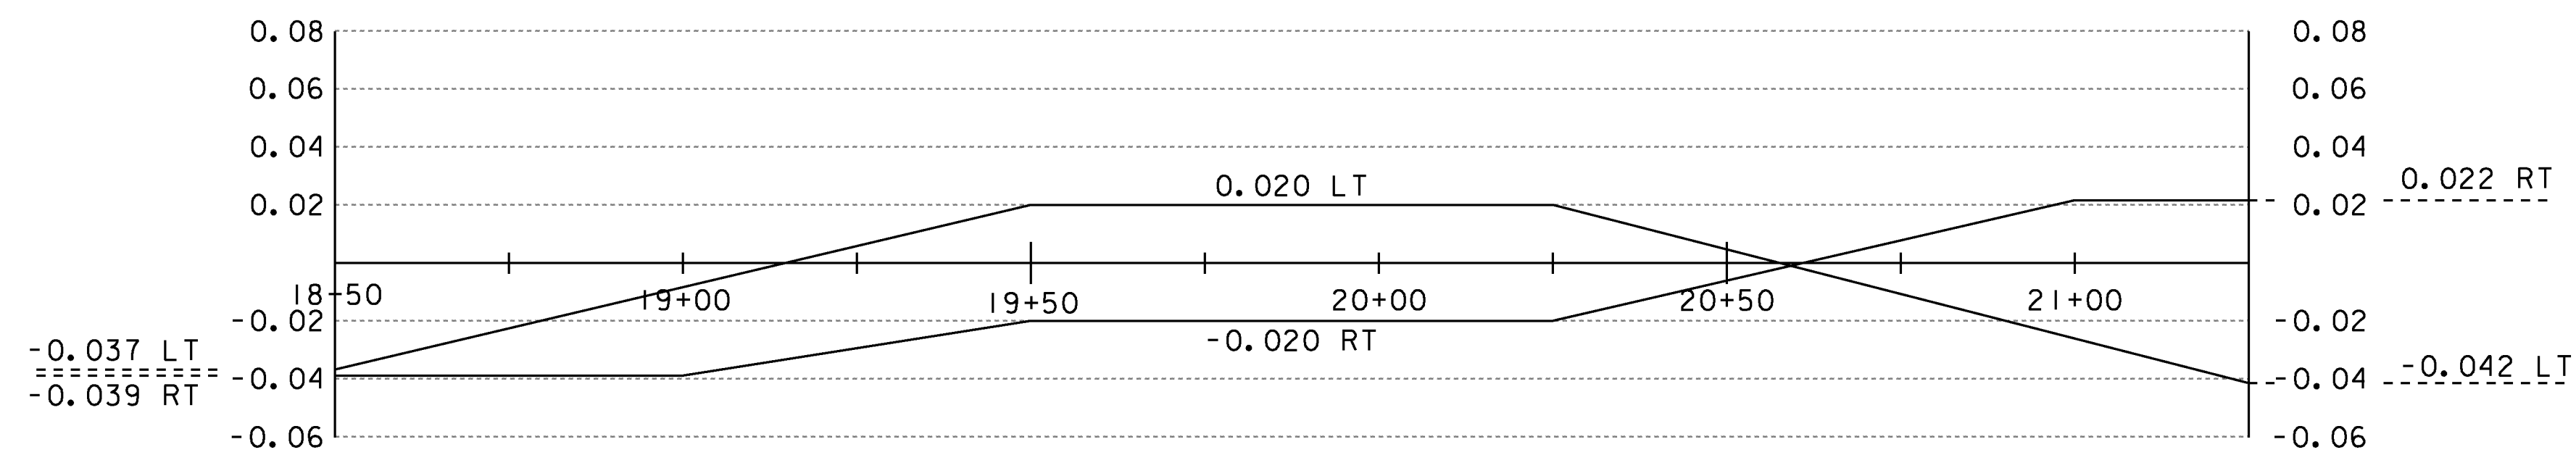

**BANKING DIAGRAM**

HORIZONTAL SCALE: 1" = 20'-0"


VERTICAL SCALE: NOT TO SCALE

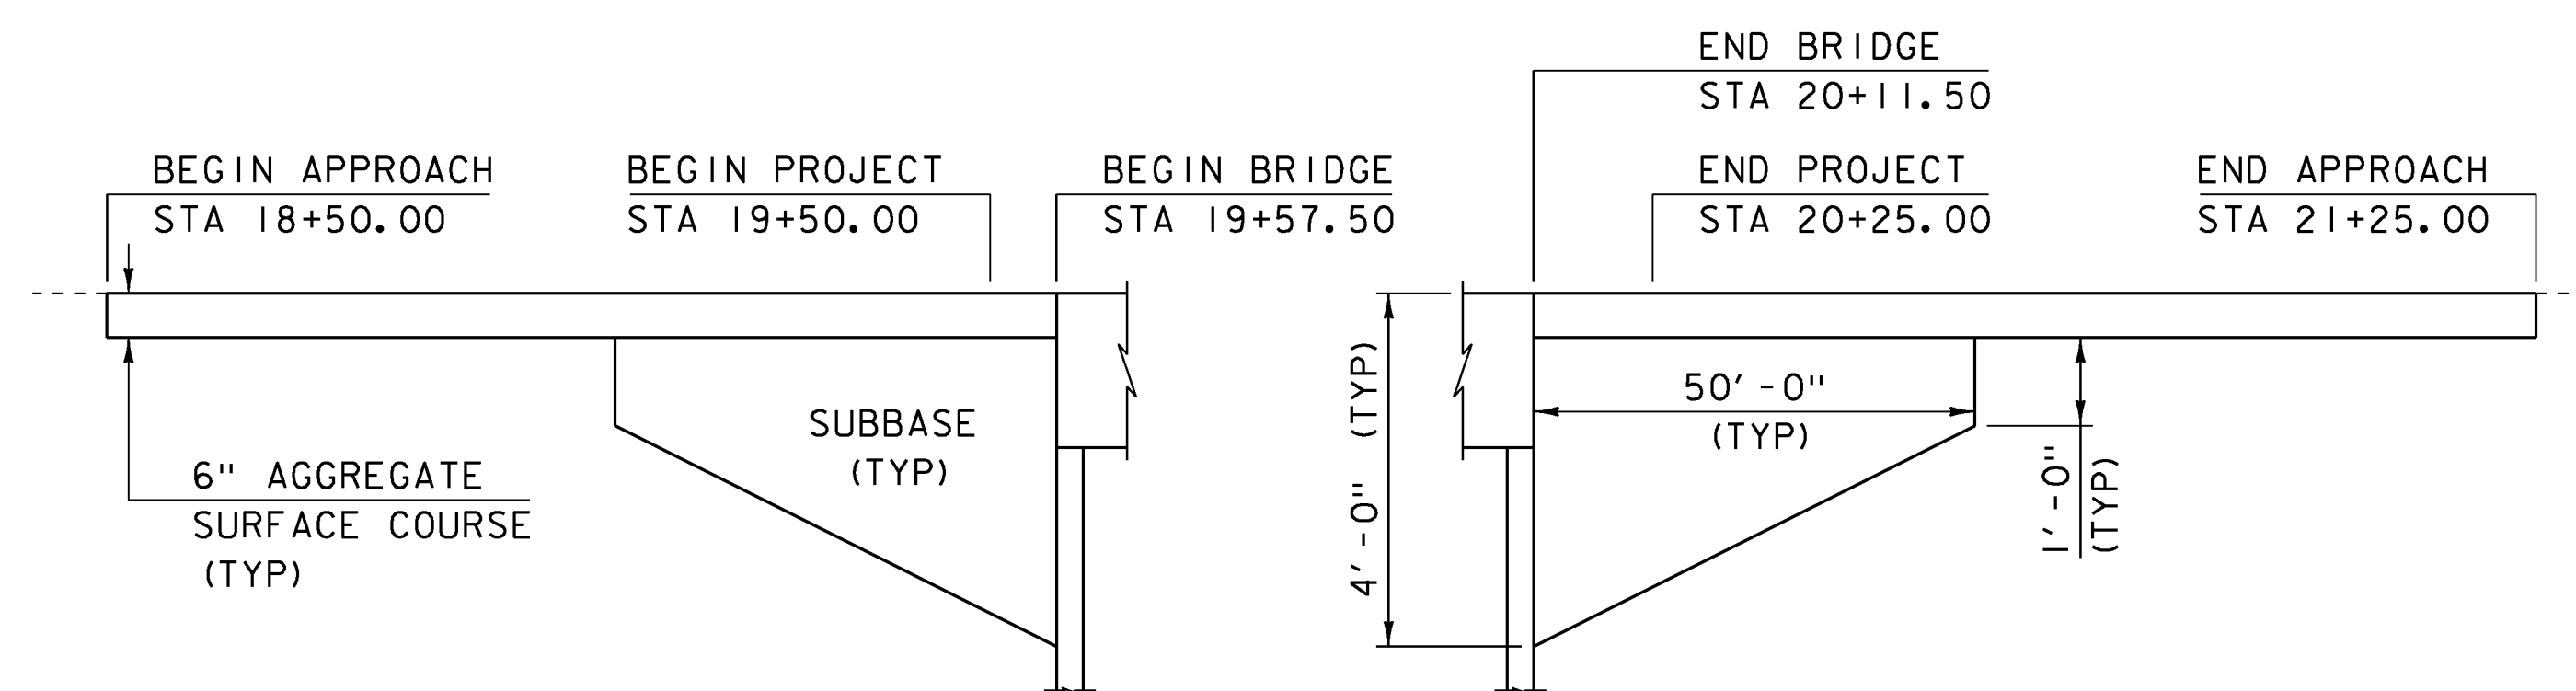

**MATERIAL TRANSITION**

HORIZONTAL SCALE 1"=20'

NO VERTICAL SCALE

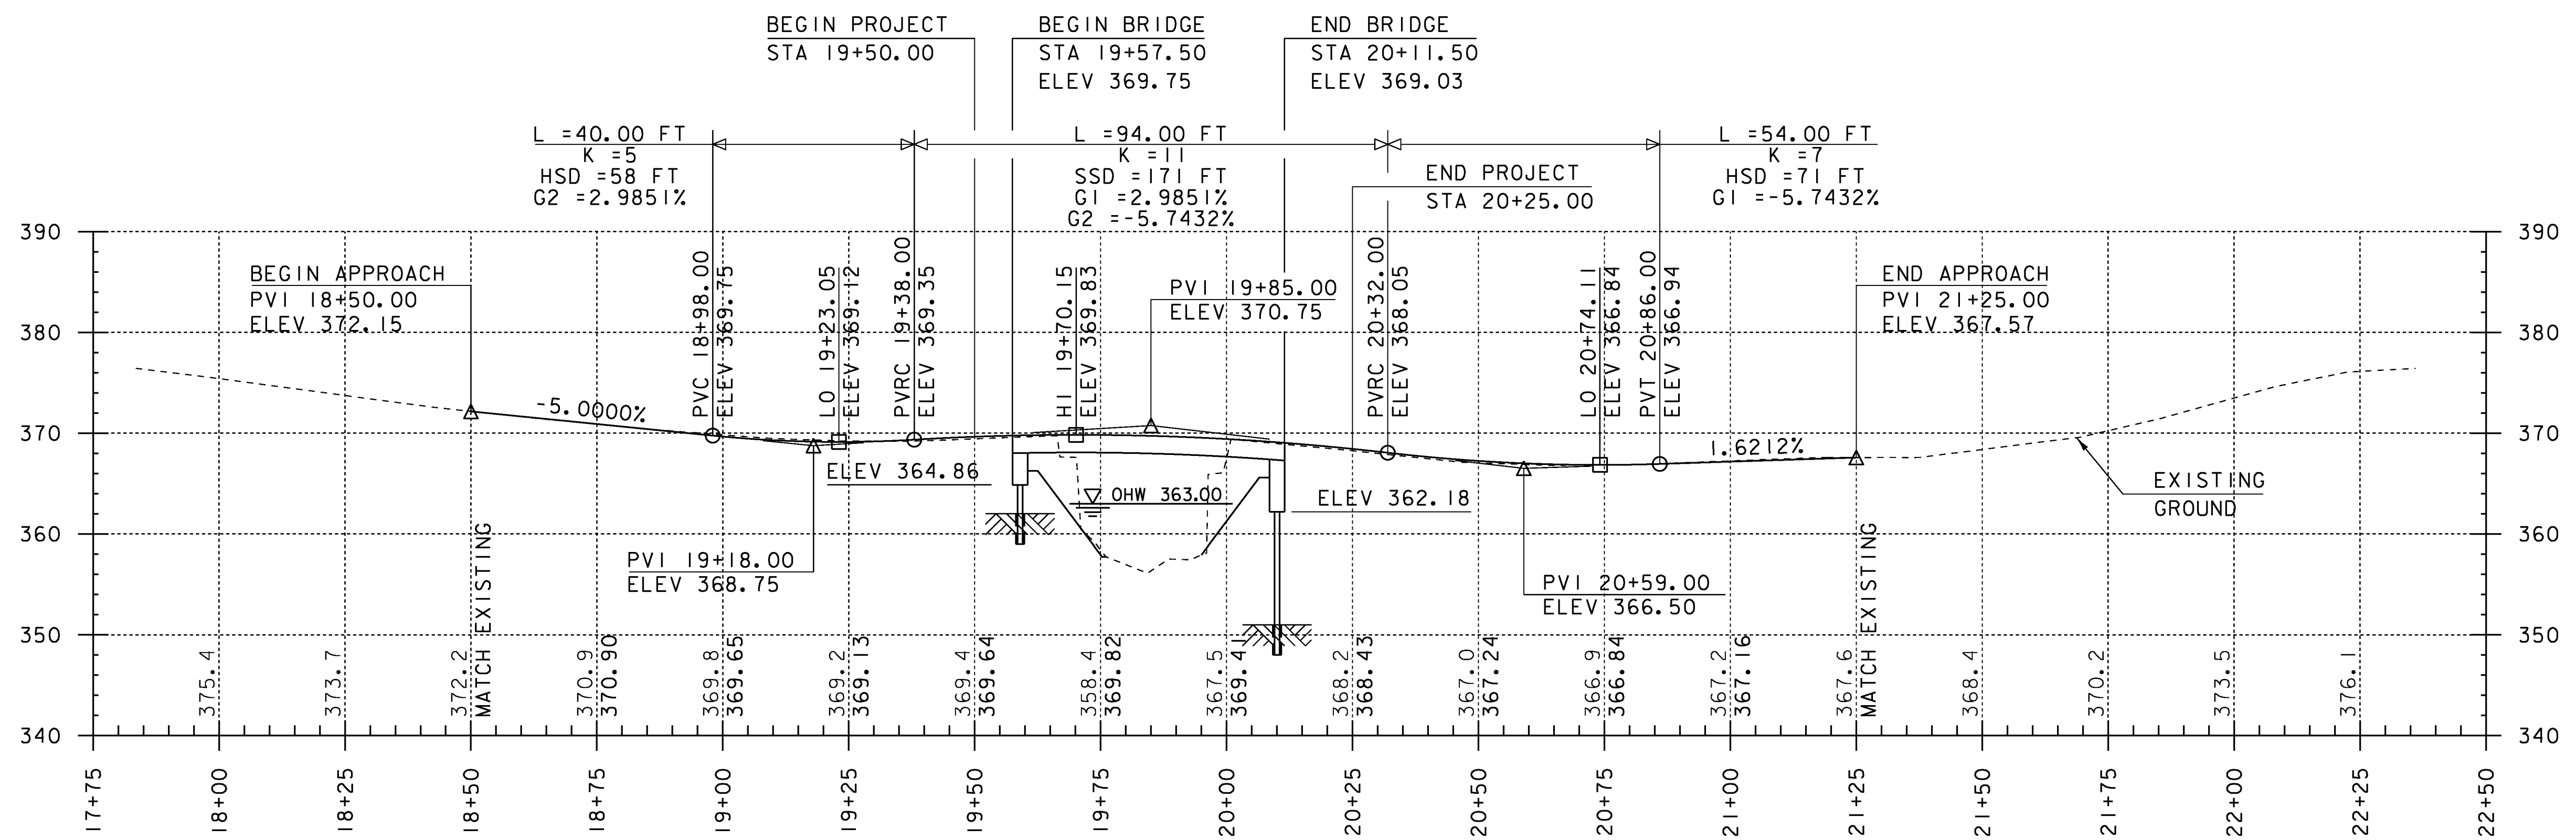

**TH 47 PROFILE**

HORIZONTAL SCALE 1"=20'

VERTICAL SCALE 1"=10'

THE GRADES SHOWN TO THE NEAREST TENTH ARE THE ORIGINAL GROUND ELEVATIONS ALONG THE PROPOSED ALIGNMENT.

THE GRADES SHOWN TO THE NEAREST HUNDREDTH ARE THE FINISH GRADES ALONG THE PROPOSED ALIGNMENT.


PROJECT NAME: FAIRFIELD  
PROJECT NUMBER: BRO 1448(41)

FILE NAME: sl2j170pro.dgn  
PROJECT LEADER: R. YOUNG  
DESIGNED BY: R. KLINEFELTER  
MAINLINE PROFILE AND BANKING DIAGRAM


PLOT DATE: 18-AUG-2014  
DRAWN BY: K. FRIEDLAND  
CHECKED BY: J. SALVATORI  
SHEET 48 OF 69

**NOTES:**


1. THE CONTRACTOR SHALL BE RESPONSIBLE FOR SIGNS AND BARRICADES SHOWN ON THIS SHEET AND SIDE ROAD APPROACH SIGNING ON VT ROUTE 36. THEY SHALL BE PAID FOR UNDER ITEM 900.645, "SPECIAL PROVISION (TRAFFIC CONTROL, ALL-INCLUSIVE)".
2. TEMPORARY TRAFFIC BARRIER AT EACH END OF THE PROJECT SHALL BE FURNISHED IN ACCORDANCE WITH SECTION 621 AND PAYMENT SHALL BE CONSIDERED INCIDENTAL TO PAY ITEM 900.645, "SPECIAL PROVISION (TRAFFIC CONTROL, ALL-INCLUSIVE)".
3. SIDE ROAD APPROACH SIGNING SHALL BE INSTALLED ON VT 36 IN ACCORDANCE WITH STANDARD T-10.

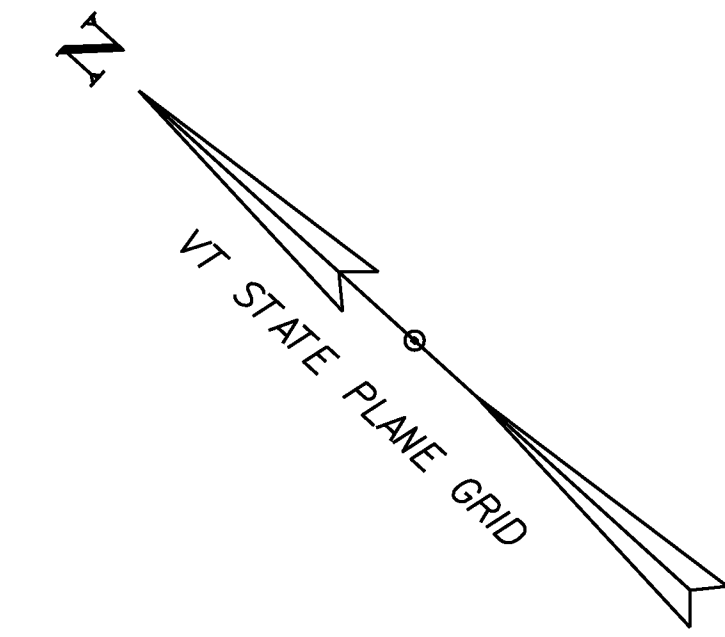

* = OMIT SIGNS BETWEEN BRIDGE AND VT 36.

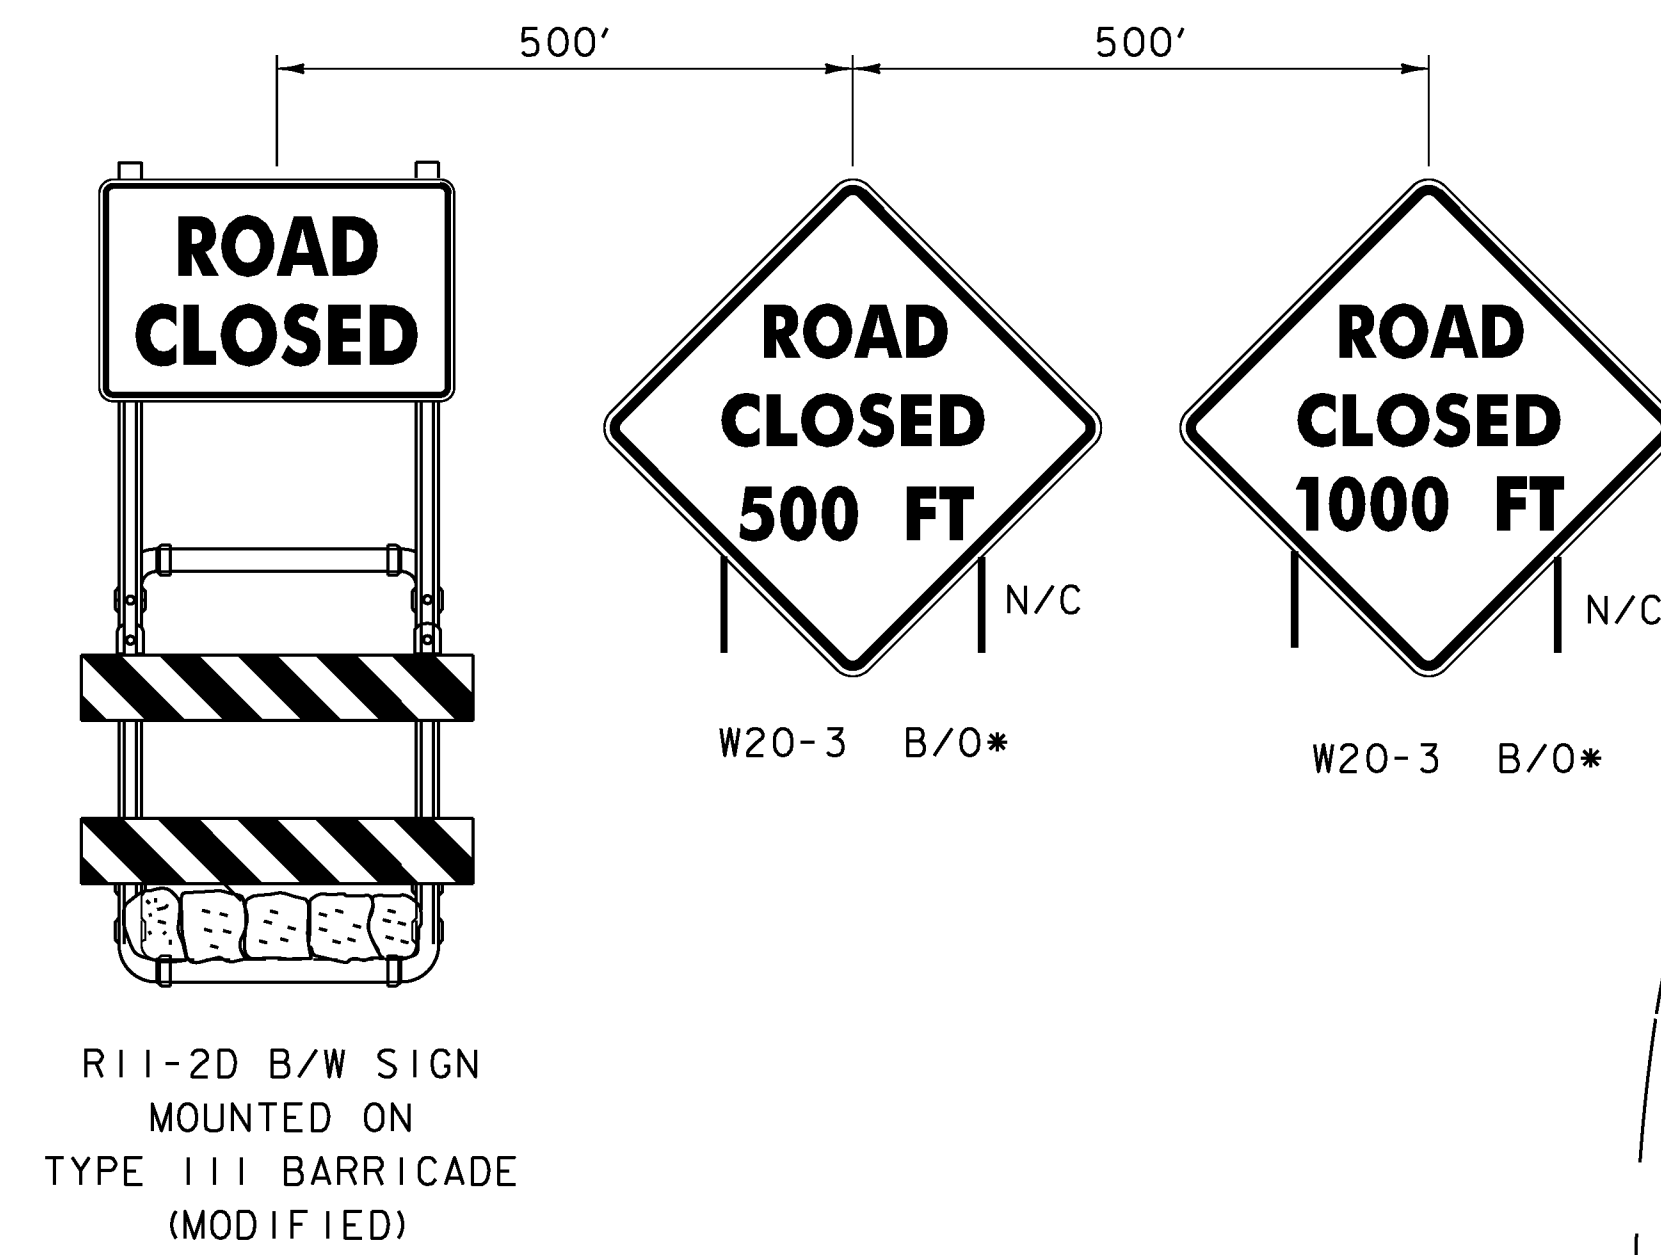

LEGEND	
N/C	- NEW/CONSTRUCTION ONLY
B/O	- BLACK/ORANGE
B/W	- BLACK/WHITE
	- TYPE III BARRICADE
	- TYPE III BARRICADE (MOD.)
	- TEMPORARY TRAFFIC BARRIER

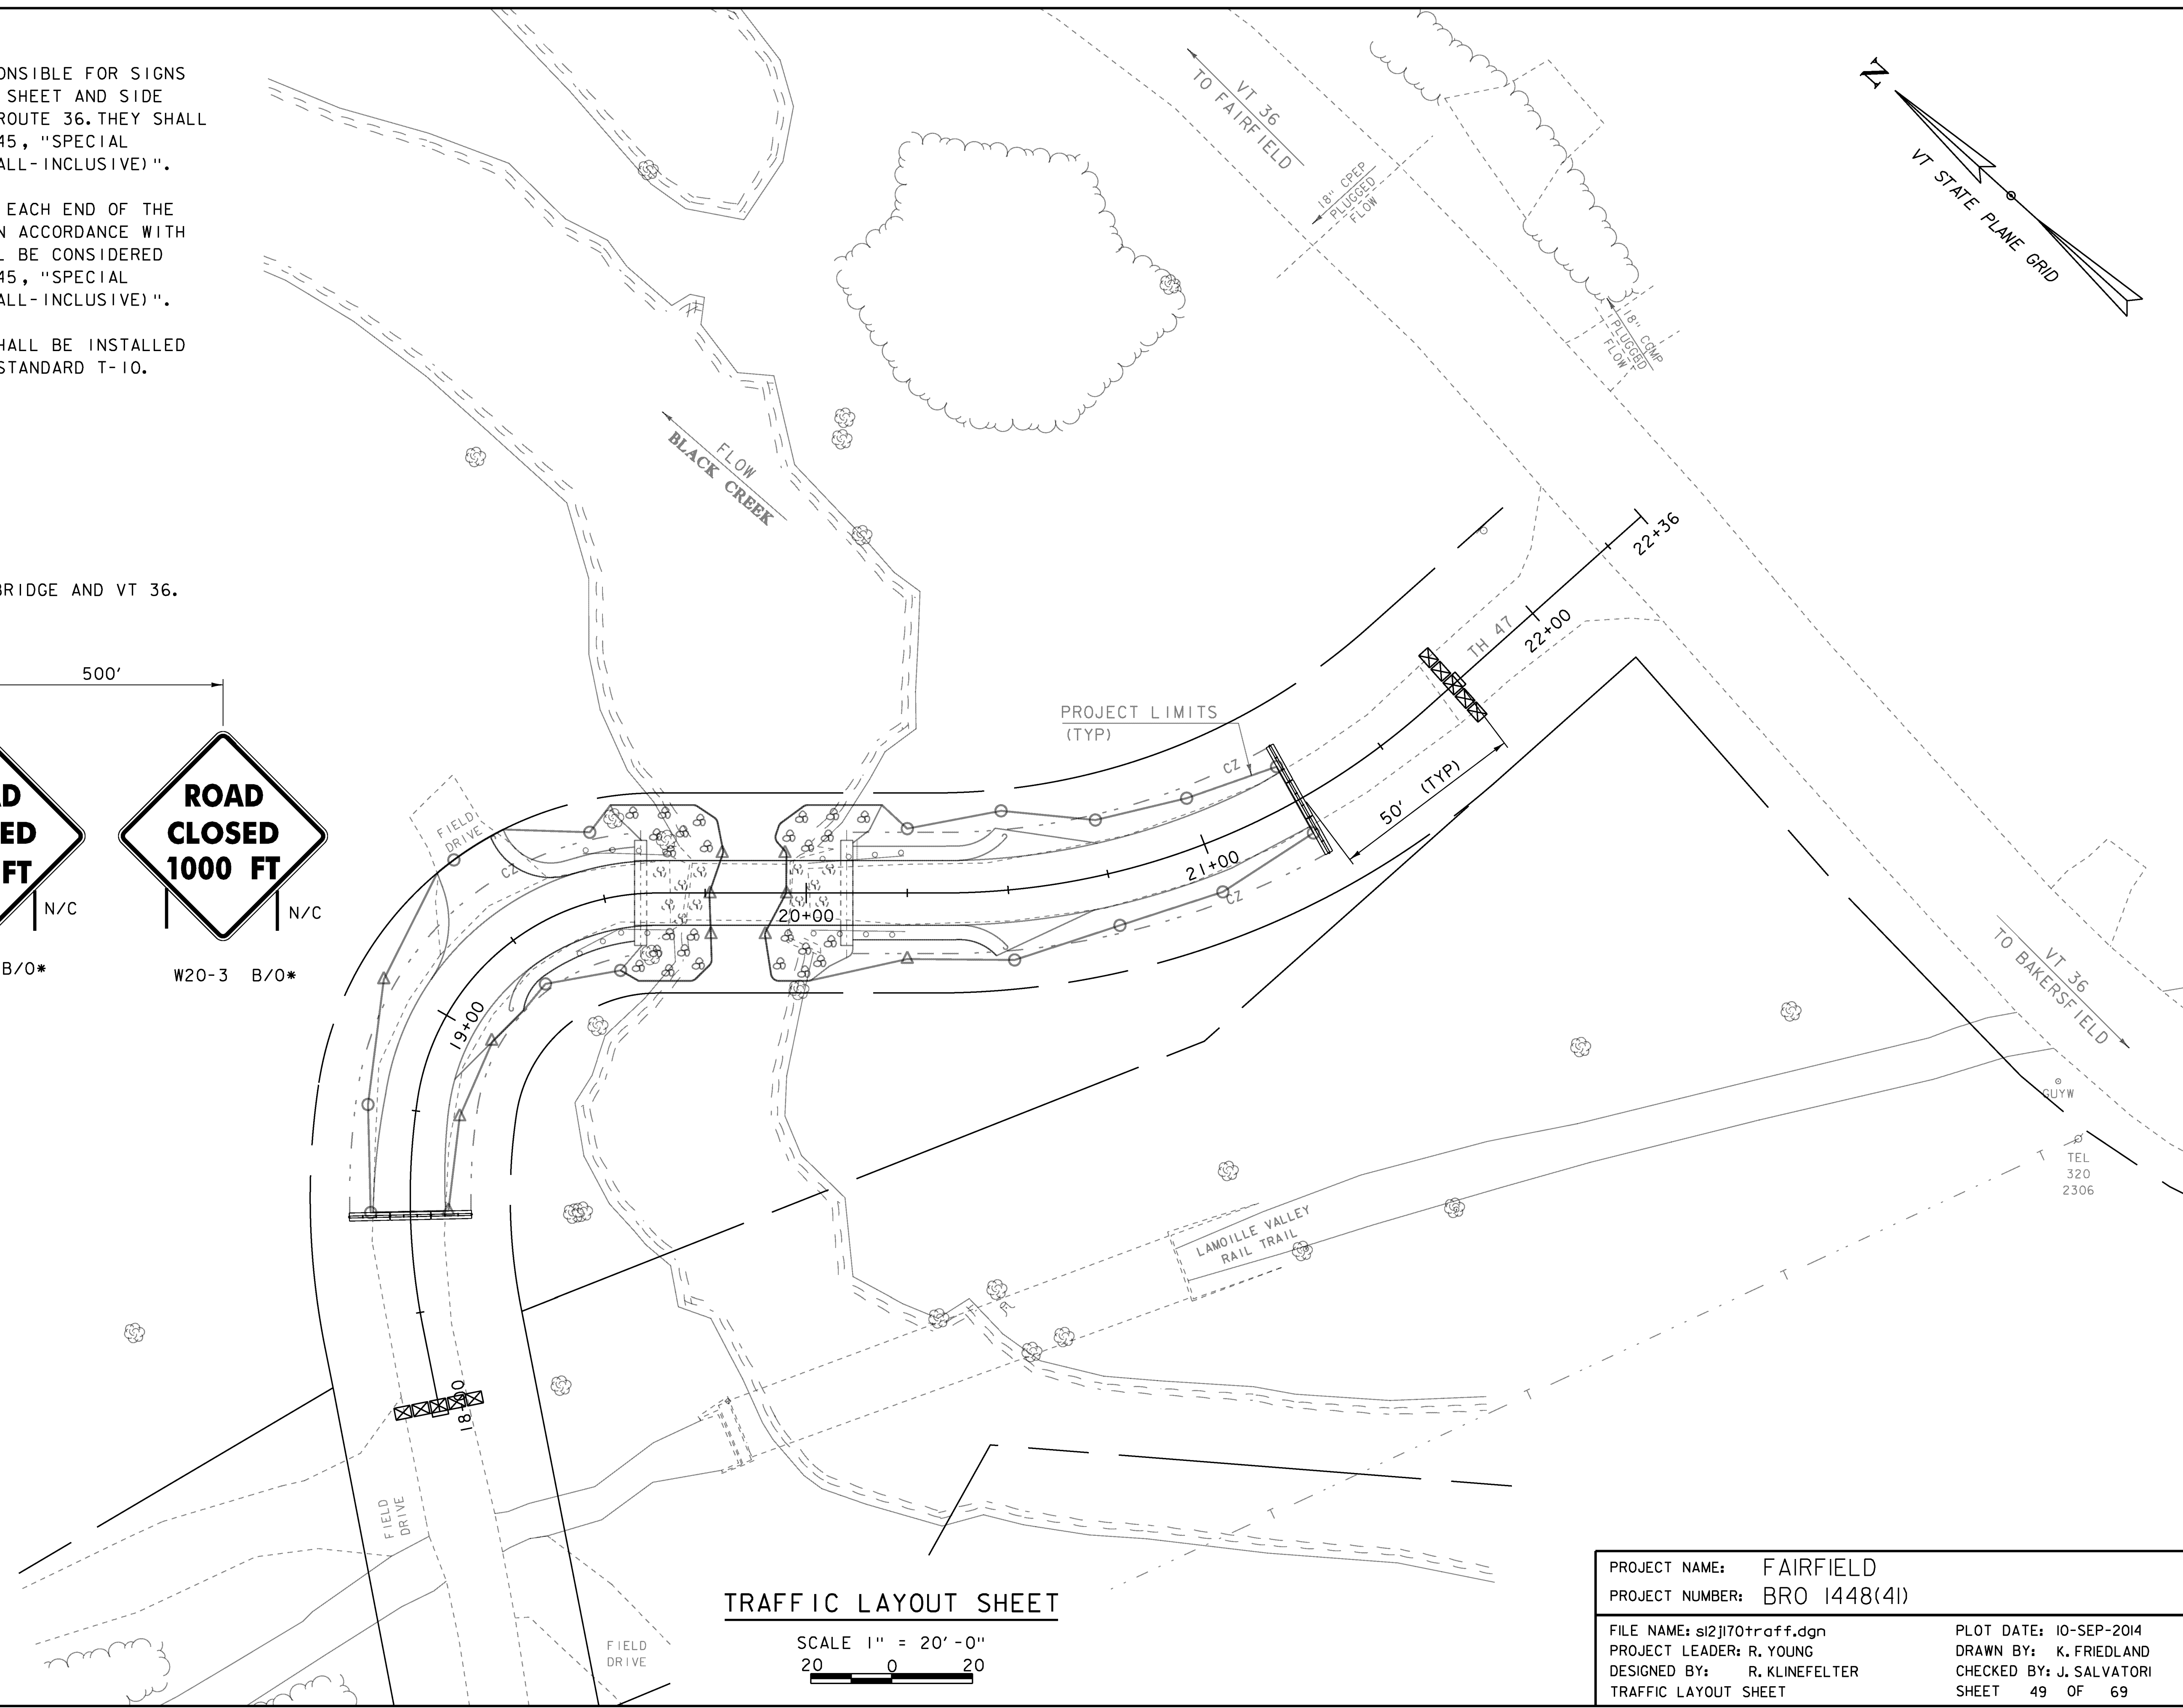


**TRAFFIC LAYOUT SHEET**

SCALE 1" = 20'-0"  
 20 0 20


PROJECT NAME:	FAIRFIELD	PLOT DATE:	10-SEP-2014
PROJECT NUMBER:	BRO 1448(4I)	DRAWN BY:	K. FRIEDLAND
FILE NAME:	sl2j170traff.dgn	DESIGNED BY:	R. KLINEFELTER
PROJECT LEADER:	R. YOUNG	CHECKED BY:	J. SALVATORI
TRAFFIC LAYOUT SHEET		SHEET	49 OF 69

DELINEATOR W/STEEL POST  
 STA 19+31.90 LT (GREEN)  
 STA 19+10.30 RT (BLUE)  
 STA 20+51.80 LT (GREEN)  
 STA 20+49.60 RT (BLUE)

ANCHOR FOR STEEL BEAM RAIL  
 STA 19+35.50 LT  
 STA 19+25.00 RT  
 STA 20+38.50 LT  
 STA 20+38.50 RT

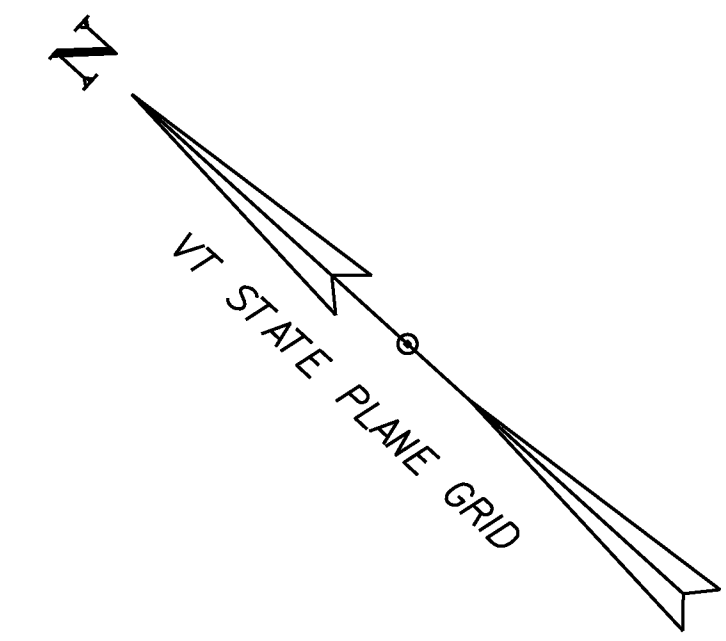

FLOW  
 BLACK CREEK

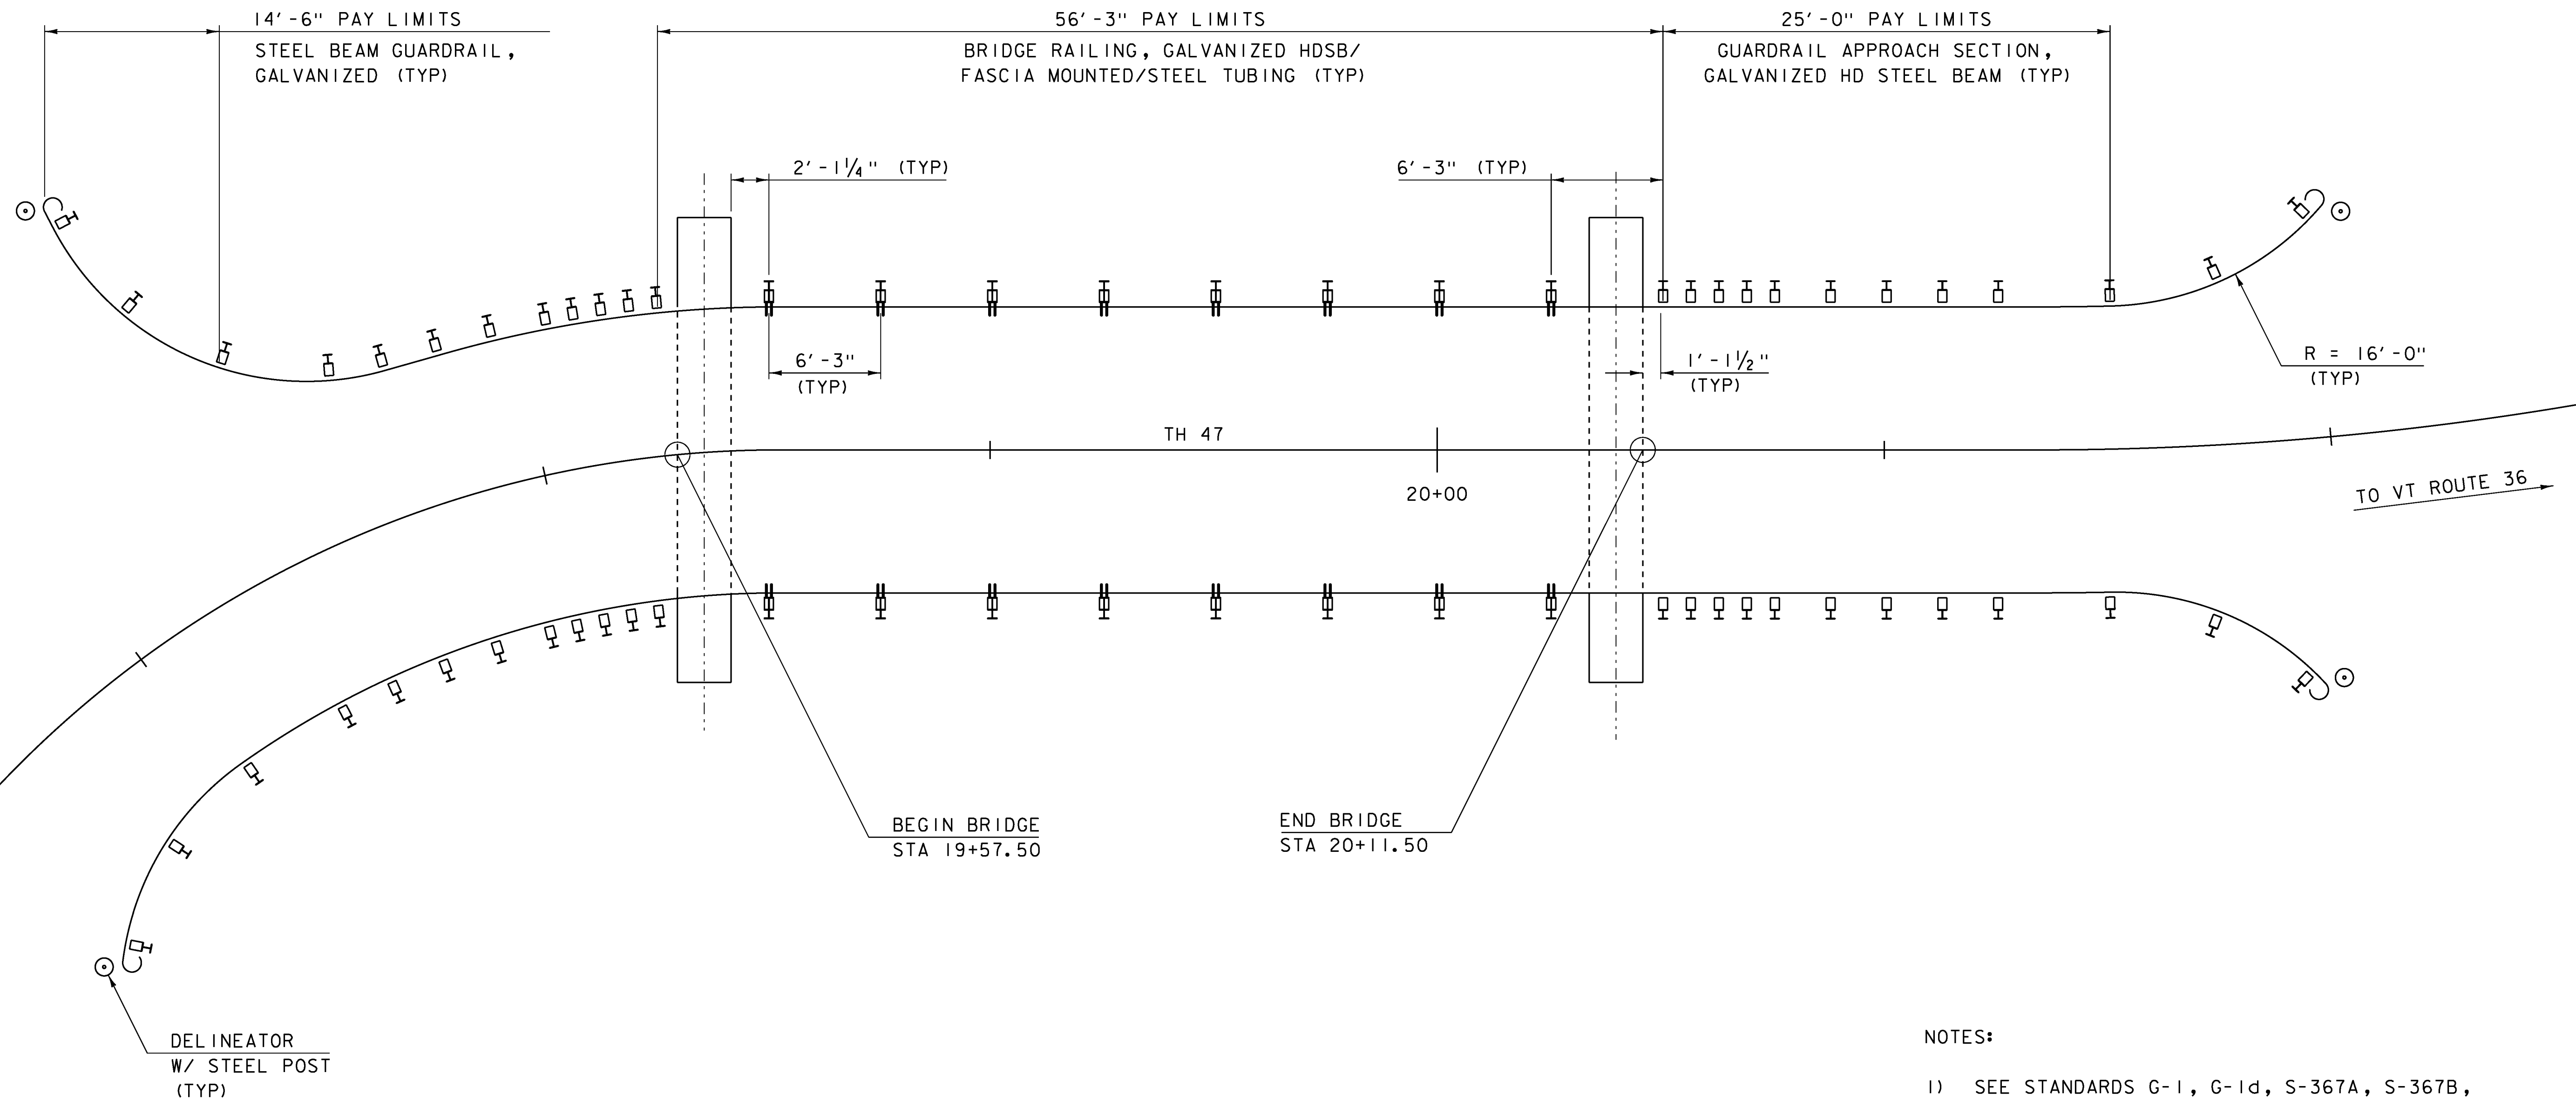

BEGIN BRIDGE  
 STA 19+57.50

END BRIDGE  
 STA 20+11.50

NOTES:

- 1) SEE STANDARDS G-1, G-1d, S-367A, S-367B, T-40 AND T-45 FOR FURTHER DETAILS.

RAIL LAYOUT SHEET

SCALE 1" = 5'-0"  
 5 0 5

PROJECT NAME: FAIRFIELD	PLOT DATE: 18-AUG-2014
PROJECT NUMBER: BRO 1448(41)	DRAWN BY: K. FRIEDLAND
FILE NAME: sl2j170rail.dgn	CHECKED BY: J. SALVATORI
PROJECT LEADER: R. YOUNG	SHEET 50 OF 69
DESIGNED BY: R. KLINEFELTER	
RAIL LAYOUT SHEET	

**SOIL CLASSIFICATION**

AASHTO

A1	Gravel and Sand
A3	Fine Sand
A2	Silty or Clayey Gravel and Sand
A4	Silty Soil - Low Compressibility
A5	Silty Soil - Highly Compressible
A6	Clayey Soil - Low Compressibility
A7	Clayey Soil - Highly Compressible

**ROCK QUALITY DESIGNATION**

R.Q.D. (%)	ROCK DESCRIPTION
<25	Very Poor
25 to 50	Poor
51 to 75	Fair
76 to 90	Good
>90	Excellent

**SHEAR STRENGTH**

UNDRAINED SHEAR STRENGTH IN P.S.F.	CONSISTENCY
<250	Very Soft
250-500	Soft
500-1000	Med. Stiff
1000-2000	Stiff
2000-4000	Very Stiff
>4000	Hard

**CORRELATION GUIDE OF "N" TO DENSITY/CONSISTENCY**

DENSITY (GRANULAR SOILS)		CONSISTENCY (COHESIVE SOILS)	
N	DESCRIPTIVE TERM	N	DESCRIPTIVE TERM
<5	Very Loose	<2	Very Soft
5-10	Loose	2-4	Soft
11-24	Med. Dense	5-8	Med. Stiff
25-50	Dense	9-15	Stiff
>50	Very Dense	16-30	Very Stiff
		31-60	Hard
		>60	Very Hard

**COMMONLY USED SYMBOLS**


- ▼ Water Elevation
- ⊕ Standard Penetration Boring
- ⊕ Auger Boring
- ⊕ Rod Sounding
- S Sample
- N Standard Penetration Test
- Blow Count Per Foot For:
- 2" O. D. Sampler
- 1 1/2" I. D. Sampler
- Hammer Weight Of 140 Lbs.
- Hammer Fall Of 30"
- YS Field Vane Shear Test
- US Undisturbed Soil Sample
- B Blast
- DC Diamond Core
- MD Mud Drill
- WA Wash Ahead
- HSA Hollow Stem Auger
- AX Core Size 1 1/8"
- BX Core Size 1 3/8"
- NX Core Size 2 1/8"
- M Double Tube Core Barrel Used
- LL Liquid Limit
- PL Plastic Limit
- PI Plasticity Index
- NP Non Plastic
- w Moisture Content (Dry Wgt. Basis)
- D Dry
- M Moist
- MTW Moist To Wet
- W Wet
- Sat Saturated
- Bo Boulder
- Gr Gravel
- Sa Sand
- Sl Silt
- Cl Clay
- HP Hardpan
- Le Ledge
- NLTD No Ledge To Depth
- CNPF Can Not Penetrate Further
- TLOB Top of Ledge Or Boulder
- NR No Recovery
- Rec. Recovery
- %Rec. Percent Recovery
- ROD Rock Quality Designation
- CBR California Bearing Ratio
- < Less Than
- > Greater Than
- R Refusal (N > 100)
- VTSPG NAD83 - See Note 7

**COLOR**

blk	Black	pnk	Pink
bl	Blue	pu	Purple
brn	Brown	rd	Red
dk	Dark	tn	Tan
gry	Gray	wh	White
gn	Green	yel	Yellow
lt	Light	mltc	Multicolored
or	Orange		

**DEFINITIONS (AASHTO)**

- BEDROCK (LEDGE) - Rock in its native location of indefinite thickness.
- BOULDER - A rock fragment with an average dimension > 12 inches.
- COBBLE - Rock fragments with an average dimension between 3 and 12 inches.
- GRAVEL - Rounded particles of rock < 3" and > 0.075" (#10 sieve).
- SAND - Particles of rock < 0.075" (#10 sieve) and > 0.0025" (#200 sieve).
- SILT - Soil < 0.0025" (#200 sieve), non or slightly plastic and exhibits no strength when air-dried.
- CLAY - Fine grained soil, exhibits plasticity when moist and considerable strength when air-dried.
- VARVED - Alternate layers of silt and clay.
- HARDPAN - Extremely dense soil, cemented layer, not softened when wet.
- MUCK - Soft organic soil (containing > 10% organic material).
- MOISTURE CONTENT - Weight of water divided by dry weight of soil.
- FLOWING SAND - Granular soil so saturated (loose) that it flows into drill casing during extraction of wash rod.
- STRIKE - Angle from magnetic north to line of intersection of bed with a horizontal plane.
- DIP - Inclination of bed with a horizontal plane.

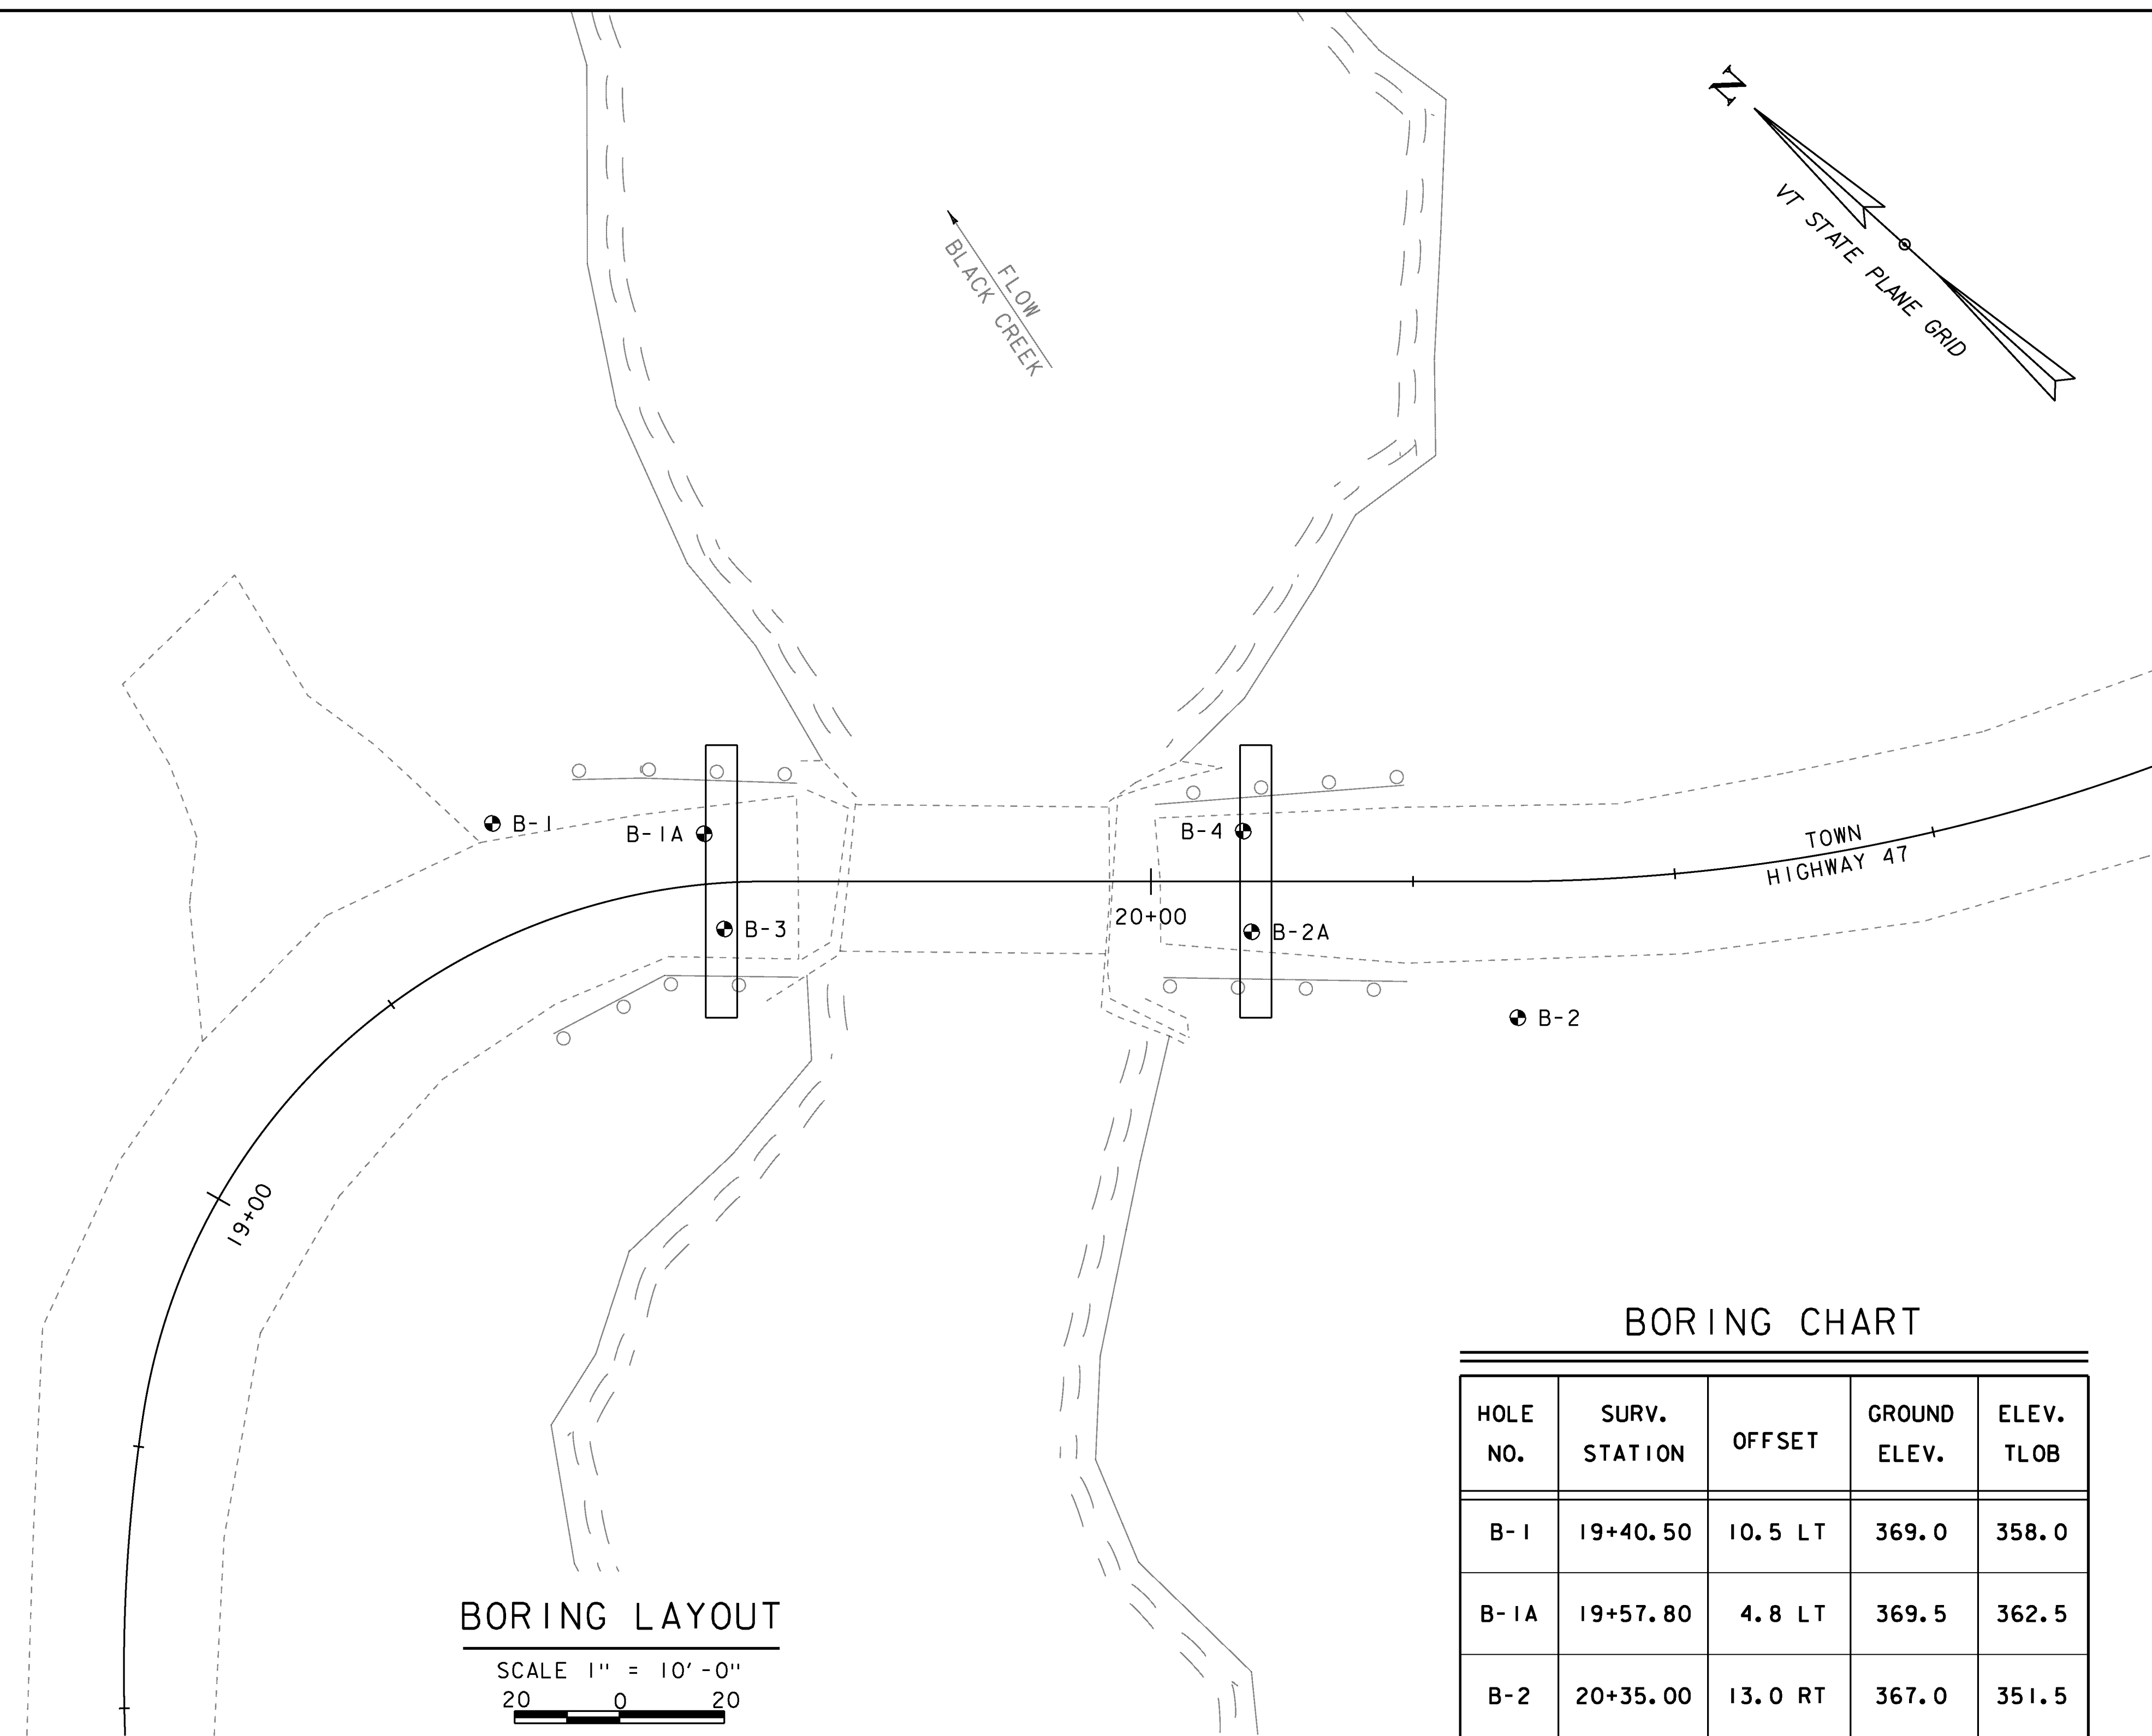

**BORING LAYOUT**

SCALE 1" = 10' - 0"  
20 0 20

**GENERAL NOTES**

1. The subsurface explorations shown herein were made between 2-14-13 and 4-30-13 by the CHA/New Hampshire Boring, INC.
2. Soil and rock classifications, properties and descriptions are based on engineering interpretation from available subsurface information by the Agency and may not necessarily reflect actual variations in subsurface conditions that may be encountered between individual boring or sample locations.
3. Observed water levels and/or conditions indicated are as recorded at the time of exploration and may vary according to the prevailing rainfall, methods of exploration and other factors.
4. Engineering judgment was exercised in preparing the subsurface information presented herein. Analysis and interpretation of subsurface data was performed and interpreted for Agency design and estimating purposes. Presentation of the information in the Contract is intended to provide the Contractor access to the same data available to the Agency. The subsurface information is presented in good faith and is not intended as a substitute for personal investigation, independent interpretation, independent analysis or judgment by the Contractor.
5. Pictorial structure details shown on the boring plan layout or soils profile are for illustrative purposes only and may not accurately portray final contract details.
6. Terminology used on boring logs to describe the hardness, degree of weathering, and spacing of fractures, joints and other discontinuities in the bedrock is defined in the AASHTO Manual on Subsurface Investigations, 1988.
7. Northing and Easting coordinates are shown in Vermont State Plane Grid North American Datum 1983 in meters and survey feet.

**BORING CHART**

HOLE NO.	SURV. STATION	OFFSET	GROUND ELEV.	ELEV. TLOB
B-1	19+40.50	10.5 LT	369.0	358.0
B-1A	19+57.80	4.8 LT	369.5	362.5
B-2	20+35.00	13.0 RT	367.0	351.5
B-2A	20+09.60	4.8 RT	369.0	350.5
B-3	19+59.00	4.4 RT	369.5	361.5
B-4	20+08.80	4.8 LT	369.0	351.5


PROJECT NAME: FAIRFIELD  
PROJECT NUMBER: BRO 1448(41)

FILE NAME: sl2j170bor.dgn  
PROJECT LEADER: R. YOUNG  
DESIGNED BY: R. KLINEFELTER  
BORING LAYOUT

PLOT DATE: 18-AUG-2014  
DRAWN BY: K. FRIEDLAND  
CHECKED BY: J. SALVATORI  
SHEET 51 OF 69

VTTrans		STATE OF VERMONT AGENCY OF TRANSPORTATION MATERIALS & RESEARCH SECTION SUBSURFACE INFORMATION		BORING LOG		Boring No.: <b>B-1</b>						
		FAIRFIELD BRO 1448(41) Elm Brook Road, Fairfield, VT				Page No.: 1 of 1						
						Pin No.: 12J170						
						Checked By: J. MacGregor						
Boring Crew: P. Schofield, K. Owens		Casing: WB		Sampler: SS		Groundwater Observations						
Date Started: 2/14/13 Date Finished: 2/14/12		I.D.: 4 in		1.38 in		Date: 02/14/13						
VTSPG NAD83: N 835816.59 ft E 1544031.13 ft		Hammer Wt: 300 lb.		140 lb.		Depth (ft): 6.0						
Station: 19+40.5 Offset: 10.5L		Hammer Fall: 30 in.		30 in.		Notes:						
Ground Elevation: 369.0 ft		Hammer/Rod Type: Manual/NW		Rig: TRUCK D50		C _e = 1.0						
Depth (ft)	Strata (1)	CLASSIFICATION OF MATERIALS (Description)	Run (Dip deg.)	Core Rec. % (RQD %)	Drill Rate (minutes/ft)	Blows/6" (N Value)	Moisture Content %	Gravel %	Sand %	Fines %	LL %	PI %
0-5	x x x	A-1-a, <b>f.c. SAND</b> . Some f.c. Gravel, trace silt, trace organics, very compact, brown, Moist, Rec. = 0.6 ft, (FILL) Rollerbit through frost layer.				38-50/4" (R)						
5-10	x x x	A-2-4 A-2-4, <b>f.c. SAND</b> , AND SILT, trace organics, loose, brown, Moist, Rec. = 1.7 ft				3-3-2-1 (5)		59.8	40.2			
10-15	x x x	A-2-4, <b>f. SAND</b> . Some Silt, trace organics, very loose, red-brn, Wet, Rec. = 1.5 ft				1-1-0-1 (1)						
15-20	x x x	A-4, <b>Clayey SILT</b> , AND f. SAND, trace organics, very soft, brown, Wet				2-2-1-4 (3)	24.8	20.0	80.0	18	1	
20-22.5		A-4, Rec. = 1.6 ft, Becomes soft										
22.5-17.5		Not Sampled, Advanced rollerbit 11.0 ft to 12.5 ft. Rock coring started at 12.5 ft.										
17.5-12.5		12.5 ft - 17.5 ft, Greenish gray, Schist, Medium close fracture spacing, near vertical bedding. Hard, Slightly to moderately weathered, NXDC, Excellent RQD. Zones of white-pink quartz embedded within rock core.	R-1	96 (90)	12							
12.5-0		17.5 ft - 22.5 ft, Similar Rock. NXDC	R-2	100 (94)	12							
Top of Bedrock @ 11.0 ft												
Hole stopped @ 22.5 ft												
Remarks: Project performed under CHA project No. 25043.												
Notes: 1. Stratification lines represent approximate boundary between material types. Transition may be gradual. 2. N Values have not been corrected for hammer energy. C _e is the hammer energy correction factor. 3. Water level readings have been made at times and under conditions stated. Fluctuations of groundwater may occur due to other factors than those present at the time measurements were made.												

VTTrans		STATE OF VERMONT AGENCY OF TRANSPORTATION MATERIALS & RESEARCH SECTION SUBSURFACE INFORMATION		BORING LOG		Boring No.: <b>B-1A</b>						
		FAIRFIELD BRO 1448(41) Elm Brook Road, Fairfield, VT				Page No.: 1 of 1						
						Pin No.: 12J170						
						Checked By: K. Adams						
Boring Crew: P. LaVossiere, K. Owens		Casing: WB		Sampler: SS		Groundwater Observations						
Date Started: 4/29/13 Date Finished: 4/29/13		I.D.: 4 in		1.38 in		Date: 04/29/13						
VTSPG NAD83: N 835801.89 ft E 1544041.49 ft		Hammer Wt: 300 lb.		140 lb.		Depth (ft): 9.0						
Station: 19+57.8 Offset: 4.8L		Hammer Fall: 30 in.		30 in.		Notes:						
Ground Elevation: 369.5 ft		Hammer/Rod Type: Manual/NW		Rig: TRUCK MOBILE B-47		C _e = 1.0						
Depth (ft)	Strata (1)	CLASSIFICATION OF MATERIALS (Description)	Run (Dip deg.)	Core Rec. % (RQD %)	Drill Rate (minutes/ft)	Blows/6" (N Value)	Moisture Content %	Gravel %	Sand %	Fines %	LL %	PI %
0-5	x x x	A-1-b, <b>f.c. GRAVEL</b> . Some f.c. Sand, little silt, medium compact, brown, Moist, Rec. = 0.9 ft, (FILL)				15-13-9-5 (22)						
5-10	x x x	A-1-b, <b>Similar Soil</b> , Rec. = 0.9 ft, (FILL)				4-13-10-13 (23)						
10-15	x x x	A-4, <b>Clayey SILT</b> , little f.c. gravel, hard, brown, Moist, Rec. = 0.3 ft, Cobble/boulder fragments recovered in shoe of spoon.				12-50/3" (R)						
15-20		No Recovery, Rec. = 0.0 ft, Casing refusal at 7.0 ft, interpreted as top of competent bedrock surface.				7-50/2" (R)						
20-22.5		Not Sampled, Advanced rollerbit 7.0 ft to 9.0 ft. Rock coring started at 9.0 ft.										
22.5-14.0		9.0 ft - 14.0 ft, Gray, Schist, Very close fracture spacing. Moderately hard to hard, Moderately to severely weathered, NXDC, Poor RQD. Seams of quartz embedded within rock core.	R-1	100 (28)	4.2							
14.0-0		14.0 ft - 19.0 ft, Similar Rock. NXDC	R-2	100 (40)	4.81							
Top of Bedrock @ 7.0 ft												
Hole stopped @ 19.0 ft												
Remarks: Project performed under CHA project No. 25043.												
Notes: 1. Stratification lines represent approximate boundary between material types. Transition may be gradual. 2. N Values have not been corrected for hammer energy. C _e is the hammer energy correction factor. 3. Water level readings have been made at times and under conditions stated. Fluctuations of groundwater may occur due to other factors than those present at the time measurements were made.												

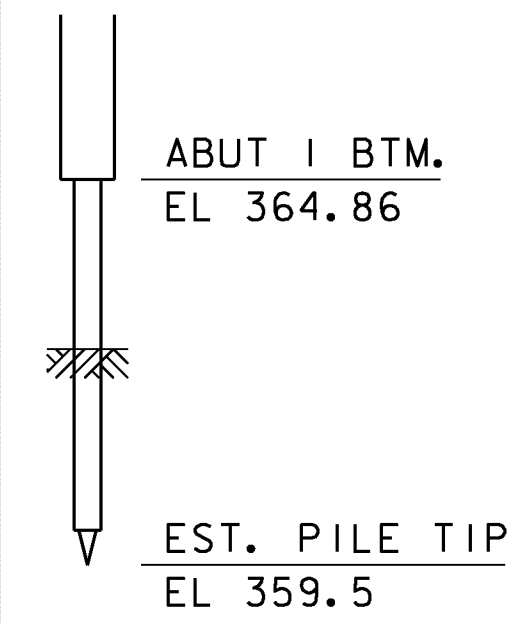


PROJECT NAME: FAIRFIELD  
PROJECT NUMBER: BRO 1448(41)

FILE NAME: sl2j170bor.dgn  
PROJECT LEADER: R. YOUNG  
DESIGNED BY: R. KLINEFELTER  
BORING LOGS 1

PLOT DATE: 18-AUG-2014  
DRAWN BY: K. FRIEDLAND  
CHECKED BY: J. SALVATORI  
SHEET 52 OF 69

VT Trans		STATE OF VERMONT AGENCY OF TRANSPORTATION MATERIALS & RESEARCH SECTION SUBSURFACE INFORMATION		BORING LOG		Boring No.: <b>B-2</b>					
VT Trans		STATE OF VERMONT AGENCY OF TRANSPORTATION MATERIALS & RESEARCH SECTION SUBSURFACE INFORMATION		FAIRFIELD BRO 1448(41) Elm Brook Road, Fairfield, VT		Page No.: 1 of 1					
VT Trans		STATE OF VERMONT AGENCY OF TRANSPORTATION MATERIALS & RESEARCH SECTION SUBSURFACE INFORMATION		FAIRFIELD BRO 1448(41) Elm Brook Road, Fairfield, VT		Pin No.: 12J170					
VT Trans		STATE OF VERMONT AGENCY OF TRANSPORTATION MATERIALS & RESEARCH SECTION SUBSURFACE INFORMATION		FAIRFIELD BRO 1448(41) Elm Brook Road, Fairfield, VT		Checked By: J. MacGregor					
Boring Crew: P. Schofield, K. Owens		Casing: WB		Sampler: SS		Groundwater Observations					
Date Started: 2/15/13		Date Finished: 2/15/13		I.D.: 4 in		Date					
VTSPG NAD83: N 835730.62 ft E 1544081.80 ft		Hammer Wt: 300 lb		140 lb		Depth (ft)					
Station: 20+35.0		Hammer Fall: 30 in		30 in		Notes					
Ground Elevation: 367.0 ft		Hammer/Rod Type: Manual/NW		Rig: TRUCK D50		02/15/13					
		C _e = 1.0									
Depth (ft)	Strata (1)	CLASSIFICATION OF MATERIALS (Description)		Run (Dip deg.)	Core Rec. % (RQD %)	Drill Rate (min/ft)	Blows/6" (N Value)	Moisture Content %	Gravel %	Sand %	Fines %
0-5	A-1-b, <b>f.m.c. GRAVEL</b> , Some Silt, little f.c. sand, trace organics, very compact, brown, Moist, Rec. = 0.6 ft, (FILL) Advanced rollerbit to 4 feet through frost layer.						37-45-50/2" (R)				
5-10	A-4 <b>Clayey SILT</b> , little f. sand, little f.c. gravel, medium stiff, brn-gry, Moist, Rec. = 0.3 ft						15-4-1-1 (5)				
10-15	A-2-4, <b>f. SAND</b> , Some clayey Silt, very loose, red-brn, Wet, Rec. = 1.4 ft						1-1-1-1 (2)				
15-20	A-4 <b>Clayey SILT</b> , AND f. SAND, little organics, soft, red-brn, Moist, Moderate organic odor observed in sample from 7 to 9.3 feet.						4-2-3-4 (5)				
20-25	A-4, Rec. = 1.0 ft, Becomes medium stiff						9-17-50/6" (R)				
25-30	A-2-4, <b>f. SAND</b> , Some clayey Silt, loose, gray, Wet						Top of Bedrock @ 15.5 ft				
30-35	A-4, Rec. = 0.8 ft, (TILL)										
35-40	Not Sampled, Advanced rollerbit 15.5 ft to 16 ft. Rock coring started at 16 ft.			R-1	100 (100)	6					
40-45	16.0 ft - 21.0 ft, Greenish gray, Schist, Medium close fracture spacing, near vertical bedding. Moderately hard, Slightly weathered, NXDC, Excellent RQD										
45-50	21.0 ft - 26.0 ft, NXDC, Similar Rock			R-2	98 (98)	6					
50-55	Hole stopped @ 26.0 ft										
Remarks: Project performed under CHA project No. 25043.											
Notes: 1. Stratification lines represent approximate boundary between material types. Transition may be gradual. 2. N Values have not been corrected for hammer energy. C _e is the hammer energy correction factor. 3. Water level readings have been made at times and under conditions stated. Fluctuations of groundwater may occur due to other factors than those present at the time measurements were made.											

VT Trans		STATE OF VERMONT AGENCY OF TRANSPORTATION MATERIALS & RESEARCH SECTION SUBSURFACE INFORMATION		BORING LOG		Boring No.: <b>B-2A</b>					
VT Trans		STATE OF VERMONT AGENCY OF TRANSPORTATION MATERIALS & RESEARCH SECTION SUBSURFACE INFORMATION		FAIRFIELD BRO 1448(41) Elm Brook Road, Fairfield, VT		Page No.: 1 of 2					
VT Trans		STATE OF VERMONT AGENCY OF TRANSPORTATION MATERIALS & RESEARCH SECTION SUBSURFACE INFORMATION		FAIRFIELD BRO 1448(41) Elm Brook Road, Fairfield, VT		Pin No.: 12J170					
VT Trans		STATE OF VERMONT AGENCY OF TRANSPORTATION MATERIALS & RESEARCH SECTION SUBSURFACE INFORMATION		FAIRFIELD BRO 1448(41) Elm Brook Road, Fairfield, VT		Checked By: K. Adams					
Boring Crew: P. LaVossiere, K. Owens		Casing: WB		Sampler: SS		Groundwater Observations					
Date Started: 4/29/13		Date Finished: 4/29/13		I.D.: 4 in		Date					
VTSPG NAD83: N 835756.72 ft E 1544070.03 ft		Hammer Wt: 300 lb		140 lb		Depth (ft)					
Station: 20+9.6		Hammer Fall: 30 in		30 in		Notes					
Ground Elevation: 369.0 ft		Hammer/Rod Type: Manual/NW		Rig: TRUCK MOBILE B-47		04/29/13					
		C _e = 1.0									
Depth (ft)	Strata (1)	CLASSIFICATION OF MATERIALS (Description)		Run (Dip deg.)	Core Rec. % (RQD %)	Drill Rate (min/ft)	Blows/6" (N Value)	Moisture Content %	Gravel %	Sand %	Fines %
0-5	A-1-a, <b>f.c. GRAVEL</b> , AND f.c. SAND, trace silt, trace brick, compact, brown, Moist, Rec. = 1.2 ft, (FILL)						19-22-26-15 (48)				
5-10	A-1-b, <b>f.c. GRAVEL</b> , Some Silt, Some f.c. Sand, medium compact, gray, Moist, Rec. = 0.4 ft, (FILL)						47-22-8-10 (30)				
10-15	A-2-4, <b>f.c. SAND</b> , little silt, medium compact, brown, Moist, Rec. = 0.7 ft						8-6-5-4 (11)				
15-20	A-2-4, Rec. = 1.0 ft, becomes loose						4-3-5-4 (8)				
20-25	A-1-b, <b>f.c. SAND</b> , trace silt, very loose, brown, Wet, Rec. = 1.4 ft						3-1-2-1 (3)				
25-30	A-1-b, Rec. = 1.1 ft, turns gray, becomes loose						3-4-4-6 (8)				
30-35	A-1-b, <b>f.c. SAND</b> , little organics, trace silt, compact, gray, Wet, Rec. = 1.0 ft, Portion of tree branch recovered in sample spoon.						6-5-33-34 (38)				
35-40	A-1-b, Rec. = 0.3 ft, becomes loose						5-4-5-4 (9)				
40-45	A-1-b, Rec. = 1.4 ft, turns dark gray						4-4-3-5 (7)				
45-50	Not Sampled, Advanced rollerbit 18.5 ft to 19.0 ft. Rock core started at 19.0 ft.			R-1	100 (90)	3.4					
50-55	19.0 ft - 24.0 ft, Gray, Schist, Close fracture spacing. Moderately hard to hard, Slightly weathered, NXDC, Excellent RQD						Top of Bedrock @ 18.5 ft				
55-60	24.0 ft - 29.0 ft, Gray, Schist, Medium close fracture spacing. Moderately hard to hard, Slightly weathered, NXDC, Good RQD			R-2	96 (82)	3.6					
60-65	Hole stopped @ 29.0 ft										
Notes: 1. Stratification lines represent approximate boundary between material types. Transition may be gradual. 2. N Values have not been corrected for hammer energy. C _e is the hammer energy correction factor. 3. Water level readings have been made at times and under conditions stated. Fluctuations of groundwater may occur due to other factors than those present at the time measurements were made.											

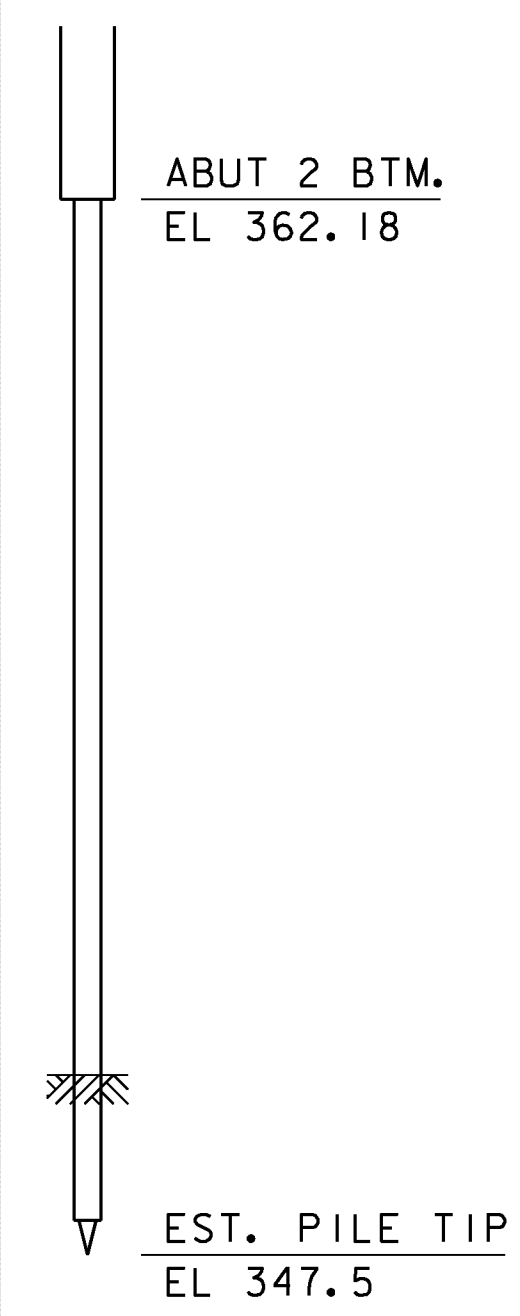

PROJECT NAME: FAIRFIELD  
 PROJECT NUMBER: BRO 1448(41)

FILE NAME: sl2j170bor.dgn  
 PROJECT LEADER: R. YOUNG  
 DESIGNED BY: R. KLINEFELTER  
 BORING LOGS 2

PLOT DATE: 18-AUG-2014  
 DRAWN BY: K. FRIEDLAND  
 CHECKED BY: J. SALVATORI  
 SHEET 53 OF 69

VTTrans		STATE OF VERMONT AGENCY OF TRANSPORTATION MATERIALS & RESEARCH SECTION SUBSURFACE INFORMATION		BORING LOG		Boring No.: <b>B-3</b>				
VTTrans		STATE OF VERMONT AGENCY OF TRANSPORTATION MATERIALS & RESEARCH SECTION SUBSURFACE INFORMATION		FAIRFIELD BRO 1448(41) Elm Brook Road, Fairfield, VT		Page No.: 1 of 1				
VTTrans		STATE OF VERMONT AGENCY OF TRANSPORTATION MATERIALS & RESEARCH SECTION SUBSURFACE INFORMATION		FAIRFIELD BRO 1448(41) Elm Brook Road, Fairfield, VT		Pin No.: 12J170				
VTTrans		STATE OF VERMONT AGENCY OF TRANSPORTATION MATERIALS & RESEARCH SECTION SUBSURFACE INFORMATION		FAIRFIELD BRO 1448(41) Elm Brook Road, Fairfield, VT		Checked By: K. Adnams				
Boring Crew: P. LaVossiere, K. Owens		Casing Type: WB		Sampler: N/A		Groundwater Observations				
Date Started: 4/30/13 Date Finished: 4/30/13		I.D.: 4 in		1.38 in		Date Depth Notes				
VTSPG NAD83: N 835792.41 ft E 1544036.42 ft		Hammer Wt: 300 lb		140 lb		04/30/13 None obs.				
Station: 19+59.0 Offset: 4.4R		Hammer Fall: 30 in		30 in						
Ground Elevation: 369.5 ft		Hammer/Rod Type: Manual/NW		Rig: TRUCK MOBILE B-47		C _e = 1.0				
Depth (ft)	Strata (1)	CLASSIFICATION OF MATERIALS (Description)	Run (Dip deg.)	Core Rec. % (RQD %)	Drill Rate minutes/ft	Blows/6" (N Value)	Moisture Content %	Gravel %	Sand %	Fines %
0		Not Sampled, Advanced boring to top of bedrock without soil sampling.								
5										
8		Not Sampled, Casing refusal at 8.0 ft. Advanced roller bit 8.0 ft to 9.0 ft. Rock coring started at 9.0 ft.								
9		9.0 ft - 12.0 ft, Gry-white, Schist, Very close fracture spacing. Medium hard, Severely weathered, NXDC, Poor RQD. Quartz seams embedded within rock core. Core barrel jammed at 12'.	R-1	100 (47)	5.99					
12		12.0 ft - 14.0 ft, NXDC, Similar Rock	R-2	100 (35)	6.99					
14		Hole stopped @ 14.0 ft								
15		Remarks: Project performed under CHA project No. 25043.								
20										
25										
Notes: 1. Stratification lines represent approximate boundary between material types. Transition may be gradual. 2. N Values have not been corrected for hammer energy. C _e is the hammer energy correction factor. 3. Water level readings have been made at times and under conditions stated. Fluctuations of groundwater may occur due to other factors than those present at the time measurements were made.										

ABUT 1 BTM.  
EL 364.86

EST. PILE TIP  
EL 358.5

VTTrans		STATE OF VERMONT AGENCY OF TRANSPORTATION MATERIALS & RESEARCH SECTION SUBSURFACE INFORMATION		BORING LOG		Boring No.: <b>B-4</b>				
VTTrans		STATE OF VERMONT AGENCY OF TRANSPORTATION MATERIALS & RESEARCH SECTION SUBSURFACE INFORMATION		FAIRFIELD BRO 1448(41) Elm Brook Road, Fairfield, VT		Page No.: 1 of 1				
VTTrans		STATE OF VERMONT AGENCY OF TRANSPORTATION MATERIALS & RESEARCH SECTION SUBSURFACE INFORMATION		FAIRFIELD BRO 1448(41) Elm Brook Road, Fairfield, VT		Pin No.: 12J170				
VTTrans		STATE OF VERMONT AGENCY OF TRANSPORTATION MATERIALS & RESEARCH SECTION SUBSURFACE INFORMATION		FAIRFIELD BRO 1448(41) Elm Brook Road, Fairfield, VT		Checked By: K. Adnams				
Boring Crew: P. LaVossiere, K. Owens		Casing Type: WB		Sampler: N/A		Groundwater Observations				
Date Started: 4/30/13 Date Finished: 4/30/13		I.D.: 4 in		1.38 in		Date Depth Notes				
VTSPG NAD83: N 835763.81 ft E 1544076.93 ft		Hammer Wt: 300 lb		140 lb		04/30/13 None obs.				
Station: 20+8.8 Offset: 4.8L		Hammer Fall: 30 in		30 in						
Ground Elevation: 369.0 ft		Hammer/Rod Type: Manual/NW		Rig: TRUCK MOBILE B-47		C _e = 1.0				
Depth (ft)	Strata (1)	CLASSIFICATION OF MATERIALS (Description)	Run (Dip deg.)	Core Rec. % (RQD %)	Drill Rate minutes/ft	Blows/6" (N Value)	Moisture Content %	Gravel %	Sand %	Fines %
0		Not Sampled, Advanced boring to top of bedrock without soil sampling.								
5										
10										
15										
17		Not Sampled, Casing refusal at 17.5 ft. Advanced roller bit 17.5 ft to 19.0 ft. Rock coring started at 19.0 ft.								
19		19.0 ft - 24.0 ft, Gray, Schist, Medium close fracture spacing. Medium hard, Slightly weathered, NXDC, Excellent RQD. Quartz seams embedded within rock core.	R-1	92 (92)	5.21					
24		Hole stopped @ 24.0 ft								
25		Remarks: Project performed under CHA project No. 25043.								
Notes: 1. Stratification lines represent approximate boundary between material types. Transition may be gradual. 2. N Values have not been corrected for hammer energy. C _e is the hammer energy correction factor. 3. Water level readings have been made at times and under conditions stated. Fluctuations of groundwater may occur due to other factors than those present at the time measurements were made.										



ABUT 2 BTM.  
EL 362.18

EST. PILE TIP  
EL 348.5

PROJECT NAME: FAIRFIELD  
PROJECT NUMBER: BRO 1448(41)

FILE NAME: sl2j170bor.dgn  
PROJECT LEADER: R. YOUNG  
DESIGNED BY: R. KLINEFELTER  
BORING LOGS 3

PLOT DATE: 18-AUG-2014  
DRAWN BY: K. FRIEDLAND  
CHECKED BY: J. SALVATORI  
SHEET 54 OF 69

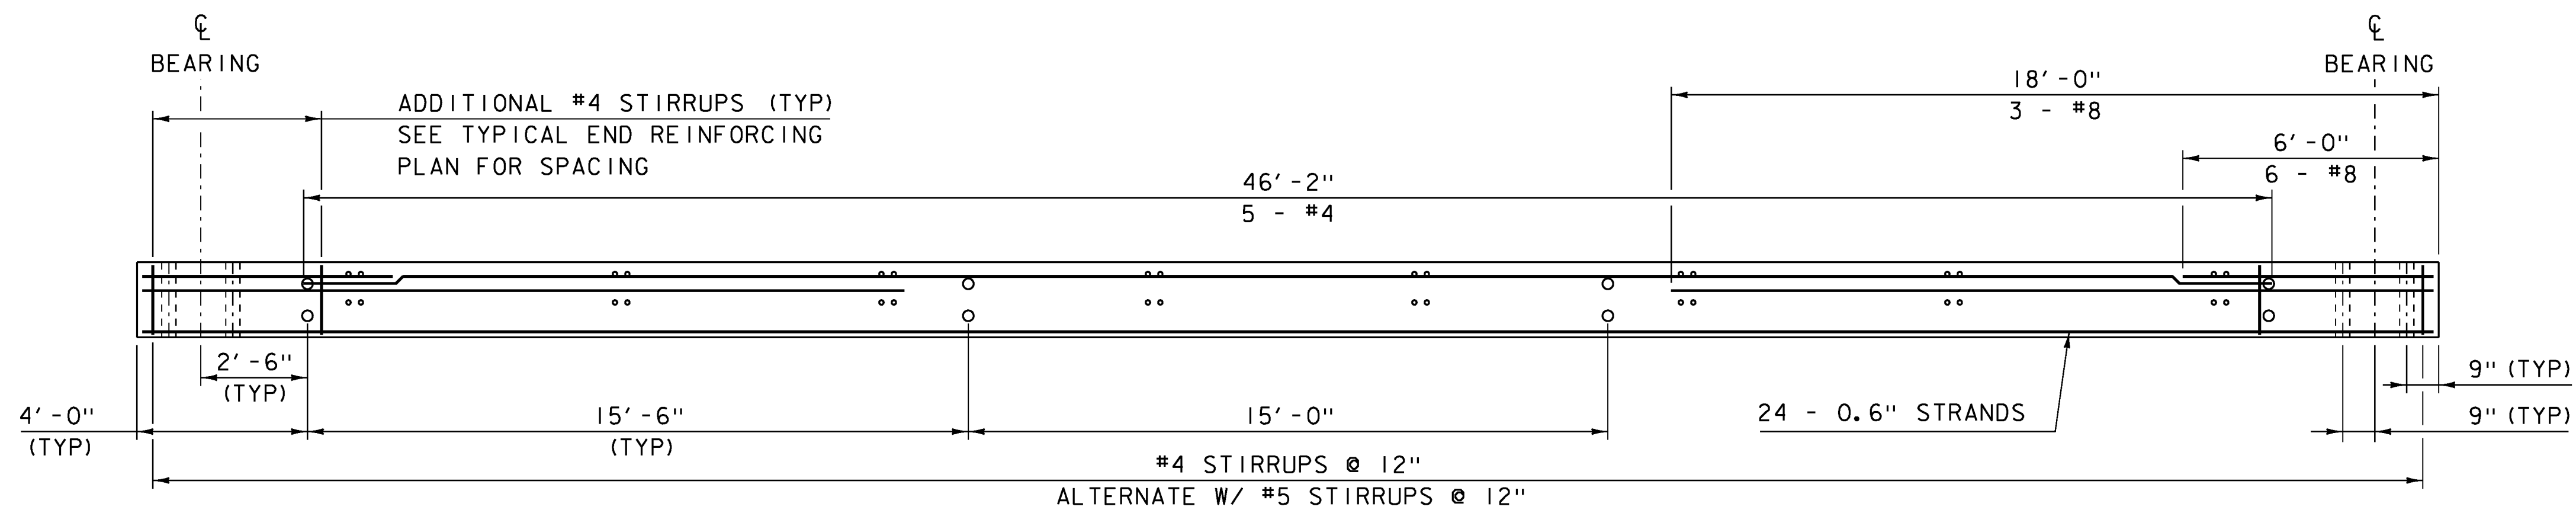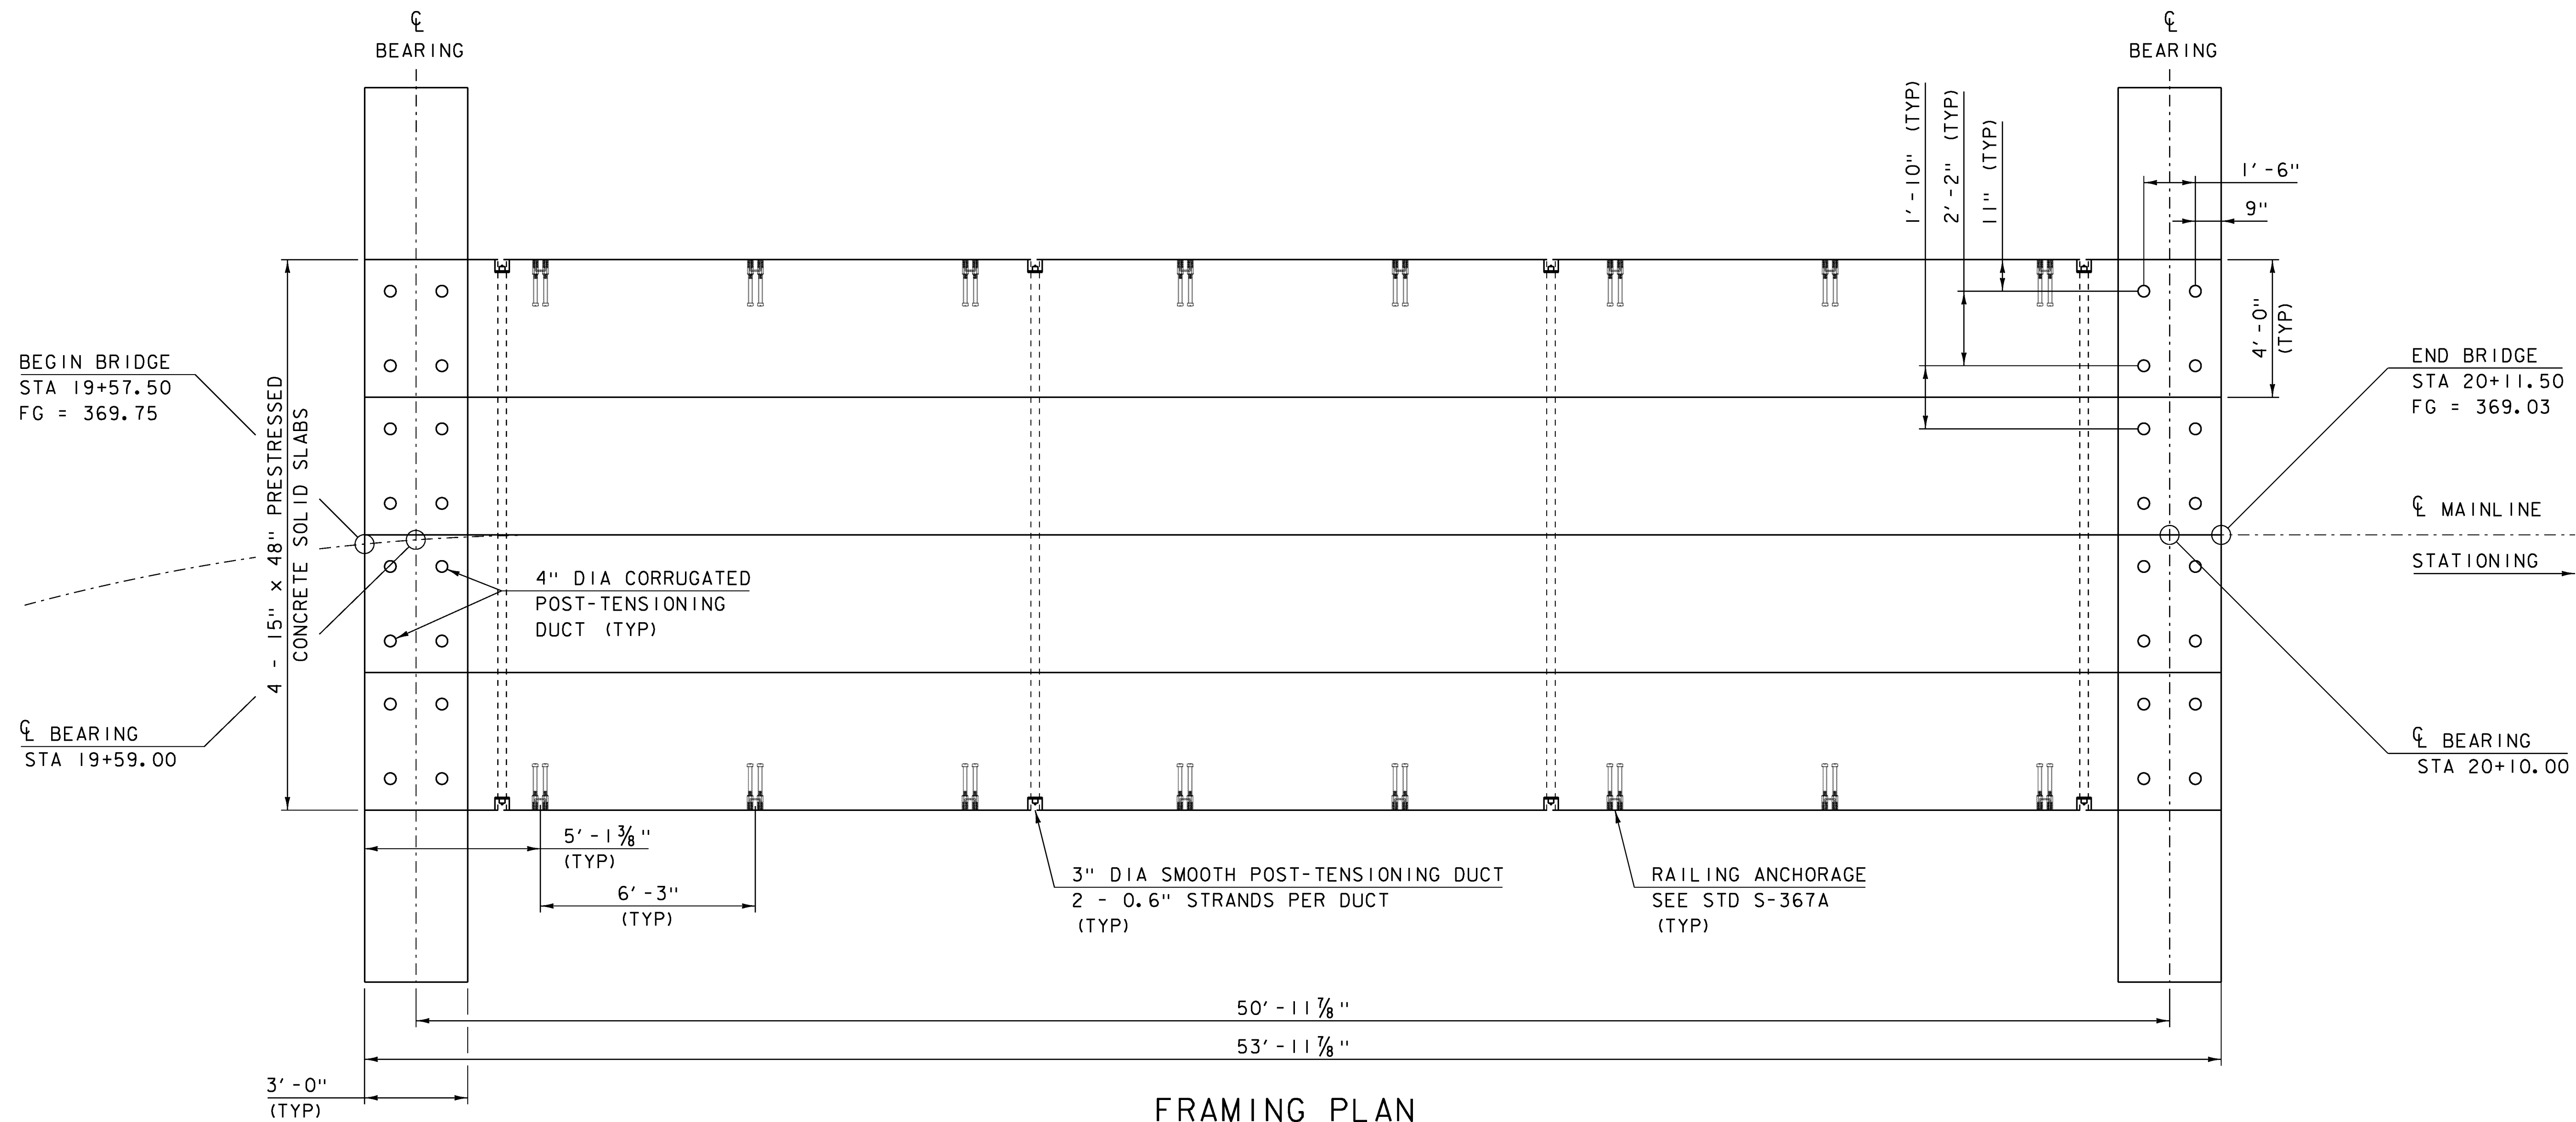


NOTES:

- 1) ALL REINFORCING SHALL BE LEVEL 2 OR HIGHER.

PROJECT NAME: FAIRFIELD  
PROJECT NUMBER: BRO 1448 (4I)

FILE NAME: sl2j170sup.dgn  
PROJECT LEADER: R. YOUNG  
DESIGNED BY: T. FILLBACH  
FRAMING PLAN


PLOT DATE: 18-AUG-2014  
DRAWN BY: K. FRIEDLAND  
CHECKED BY: R. KLINEFELTER  
SHEET 55 OF 69

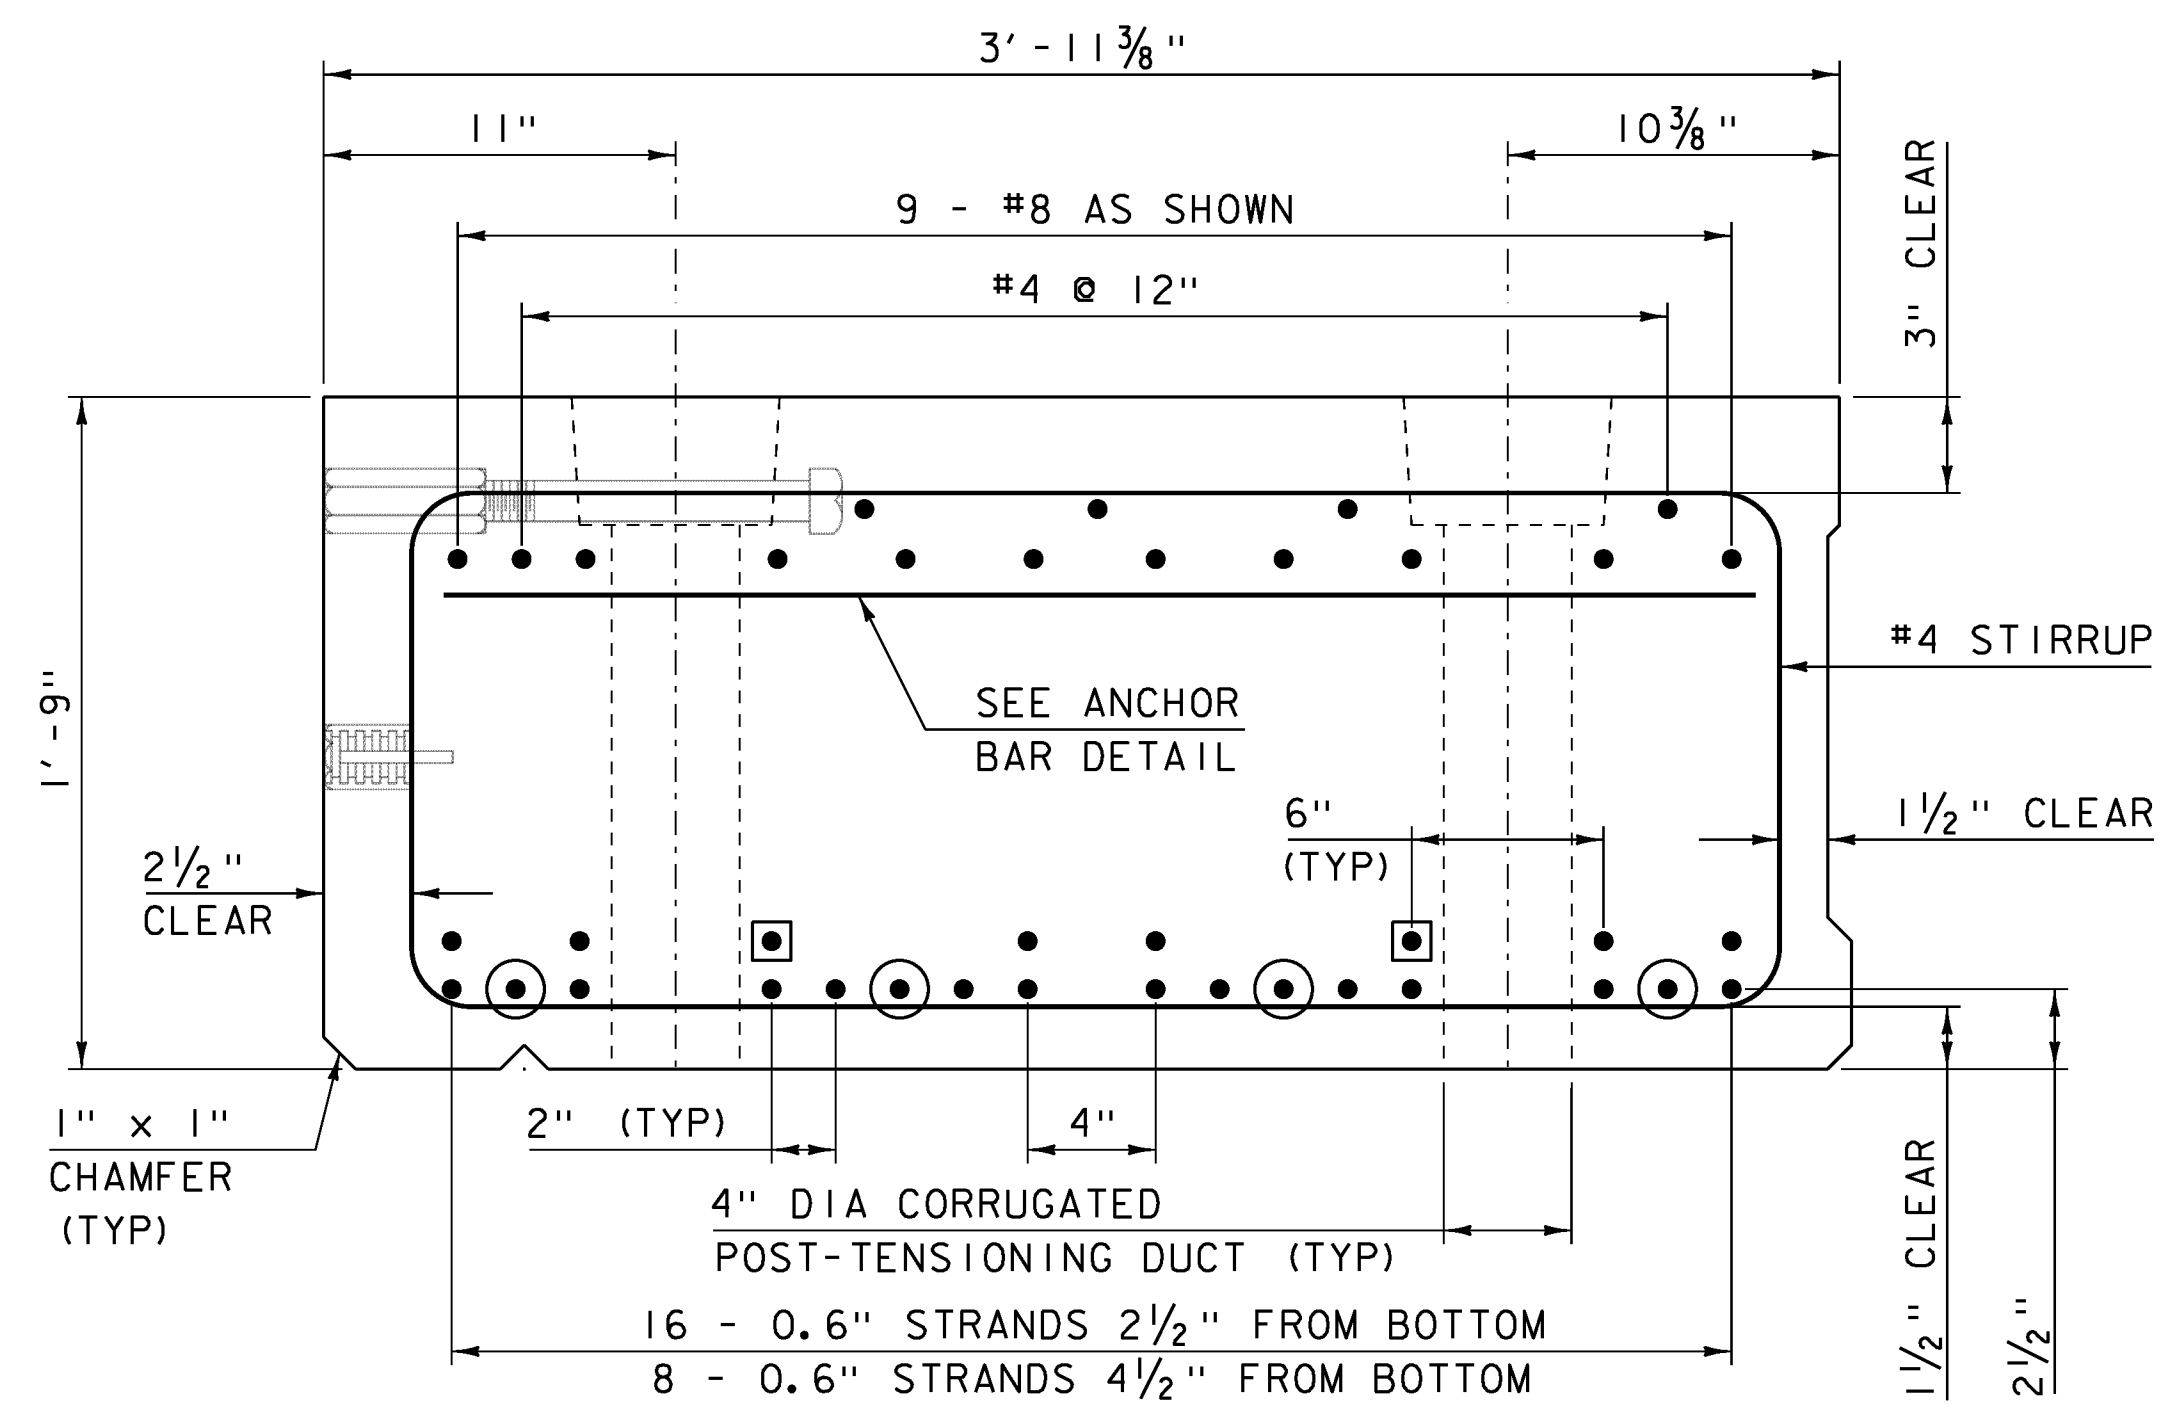

**TYPICAL EXTERIOR SECTION**

SCALE 2" = 1'-0"

- - 8'-0" DEBOND EACH END
- - 6'-0" DEBOND EACH END

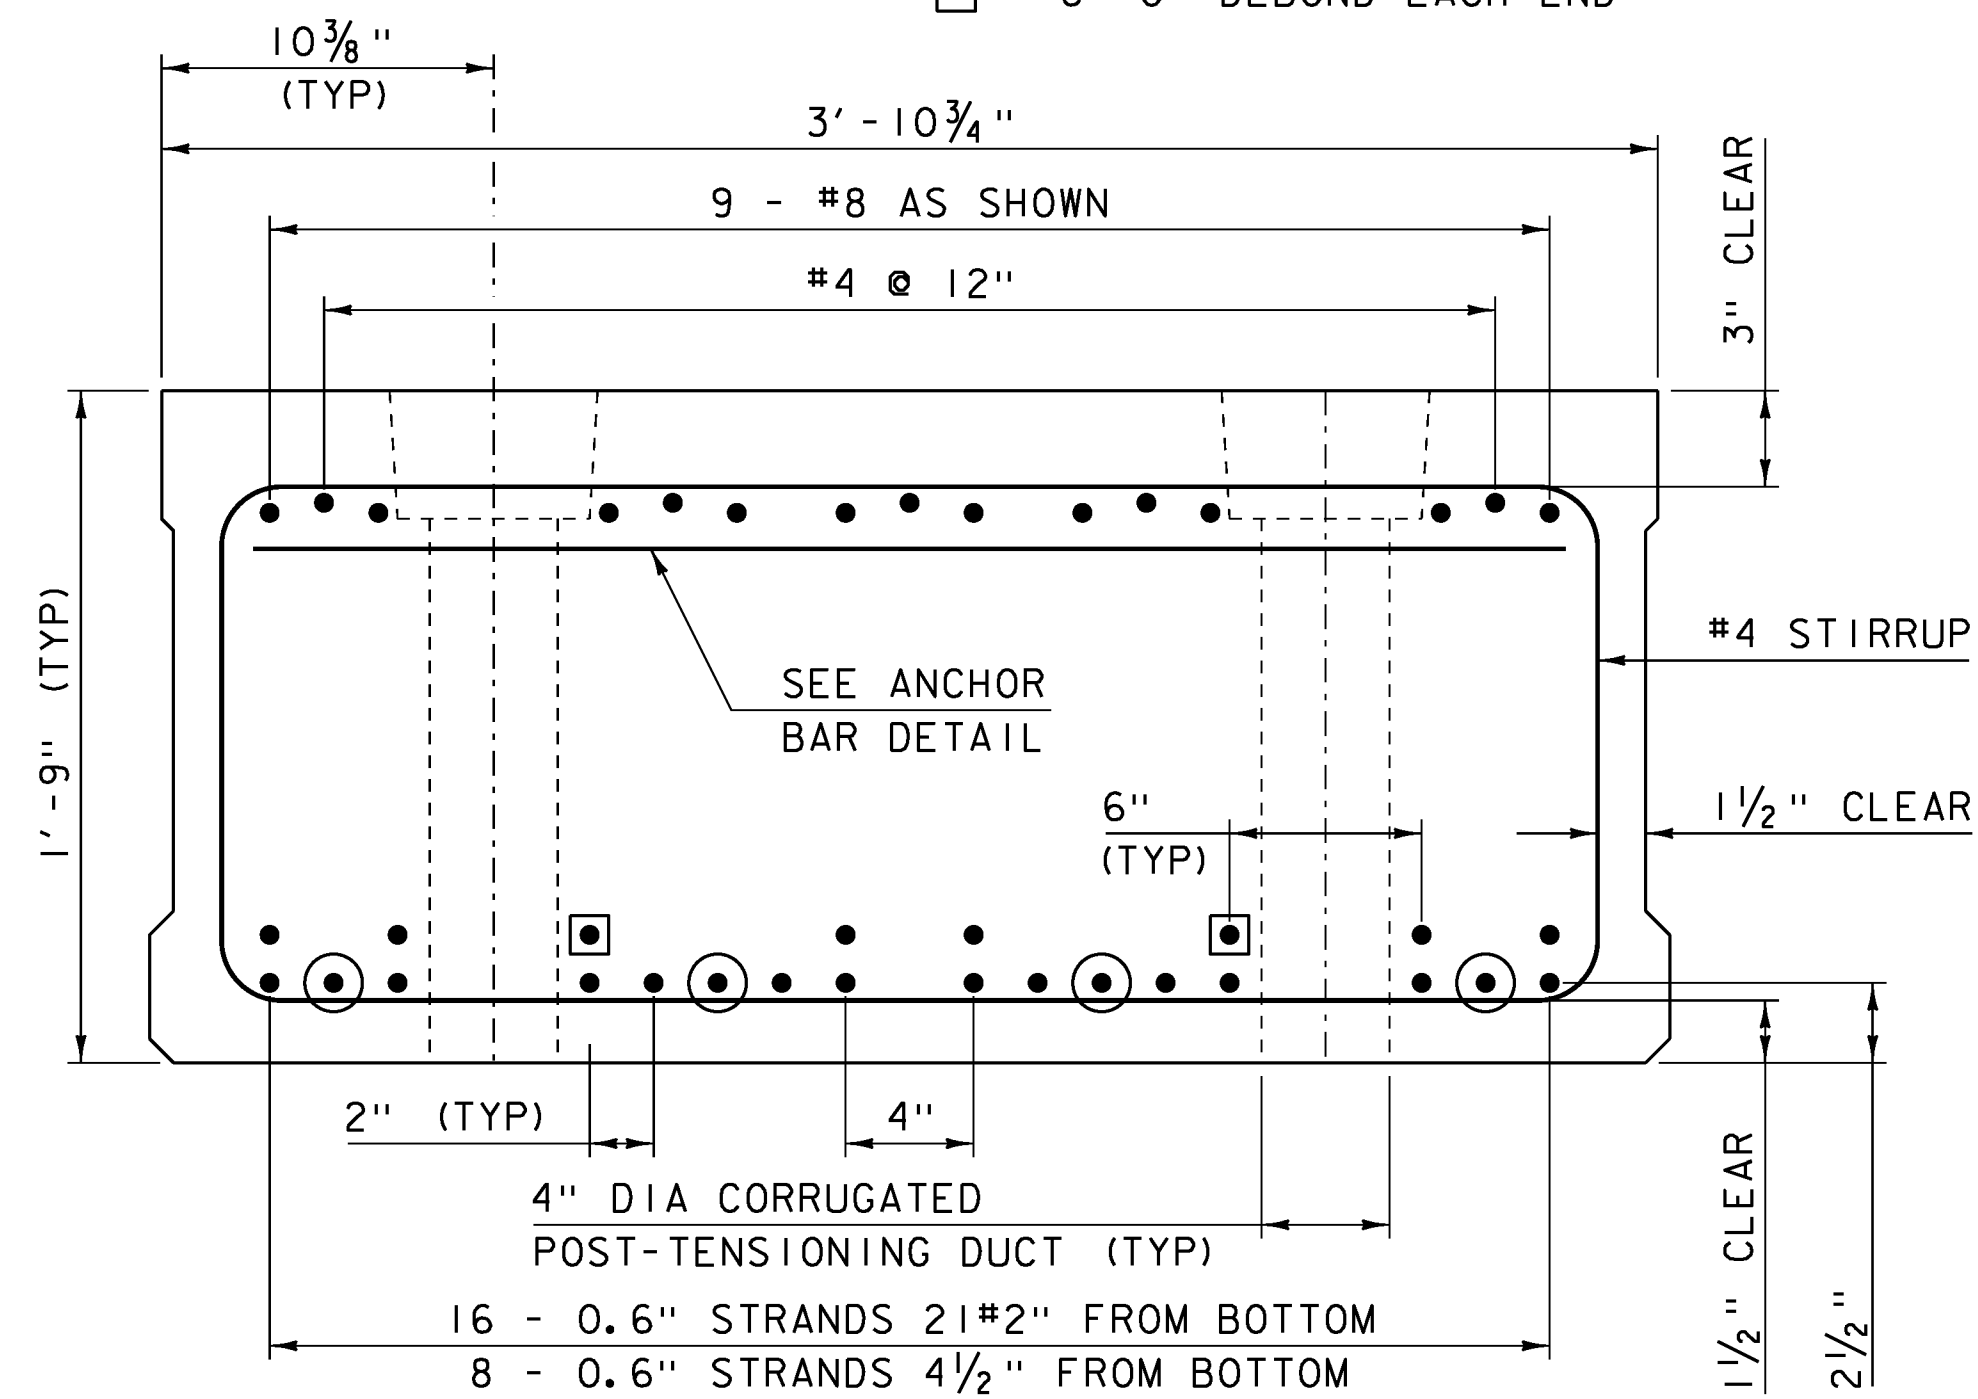


**TYPICAL INTERIOR SECTION**

SCALE 2" = 1'-0"

**NOTES:**

- 1) ALL REINFORCING SHALL BE LEVEL 1 (EPOXY COATED) OR HIGHER.
- 2) ANCHOR BAR SHALL BE ASTM A36 AND SHALL BE GALVANIZED IN ACCORDANCE WITH AASHTO M 111M/M 111.
- 3) DAMAGED GALVANIZING OR REINFORCEMENT COATING ON THE ANCHOR BAR ASSEMBLY SHALL BE REPAIRED BY AN APPROVED METHOD.

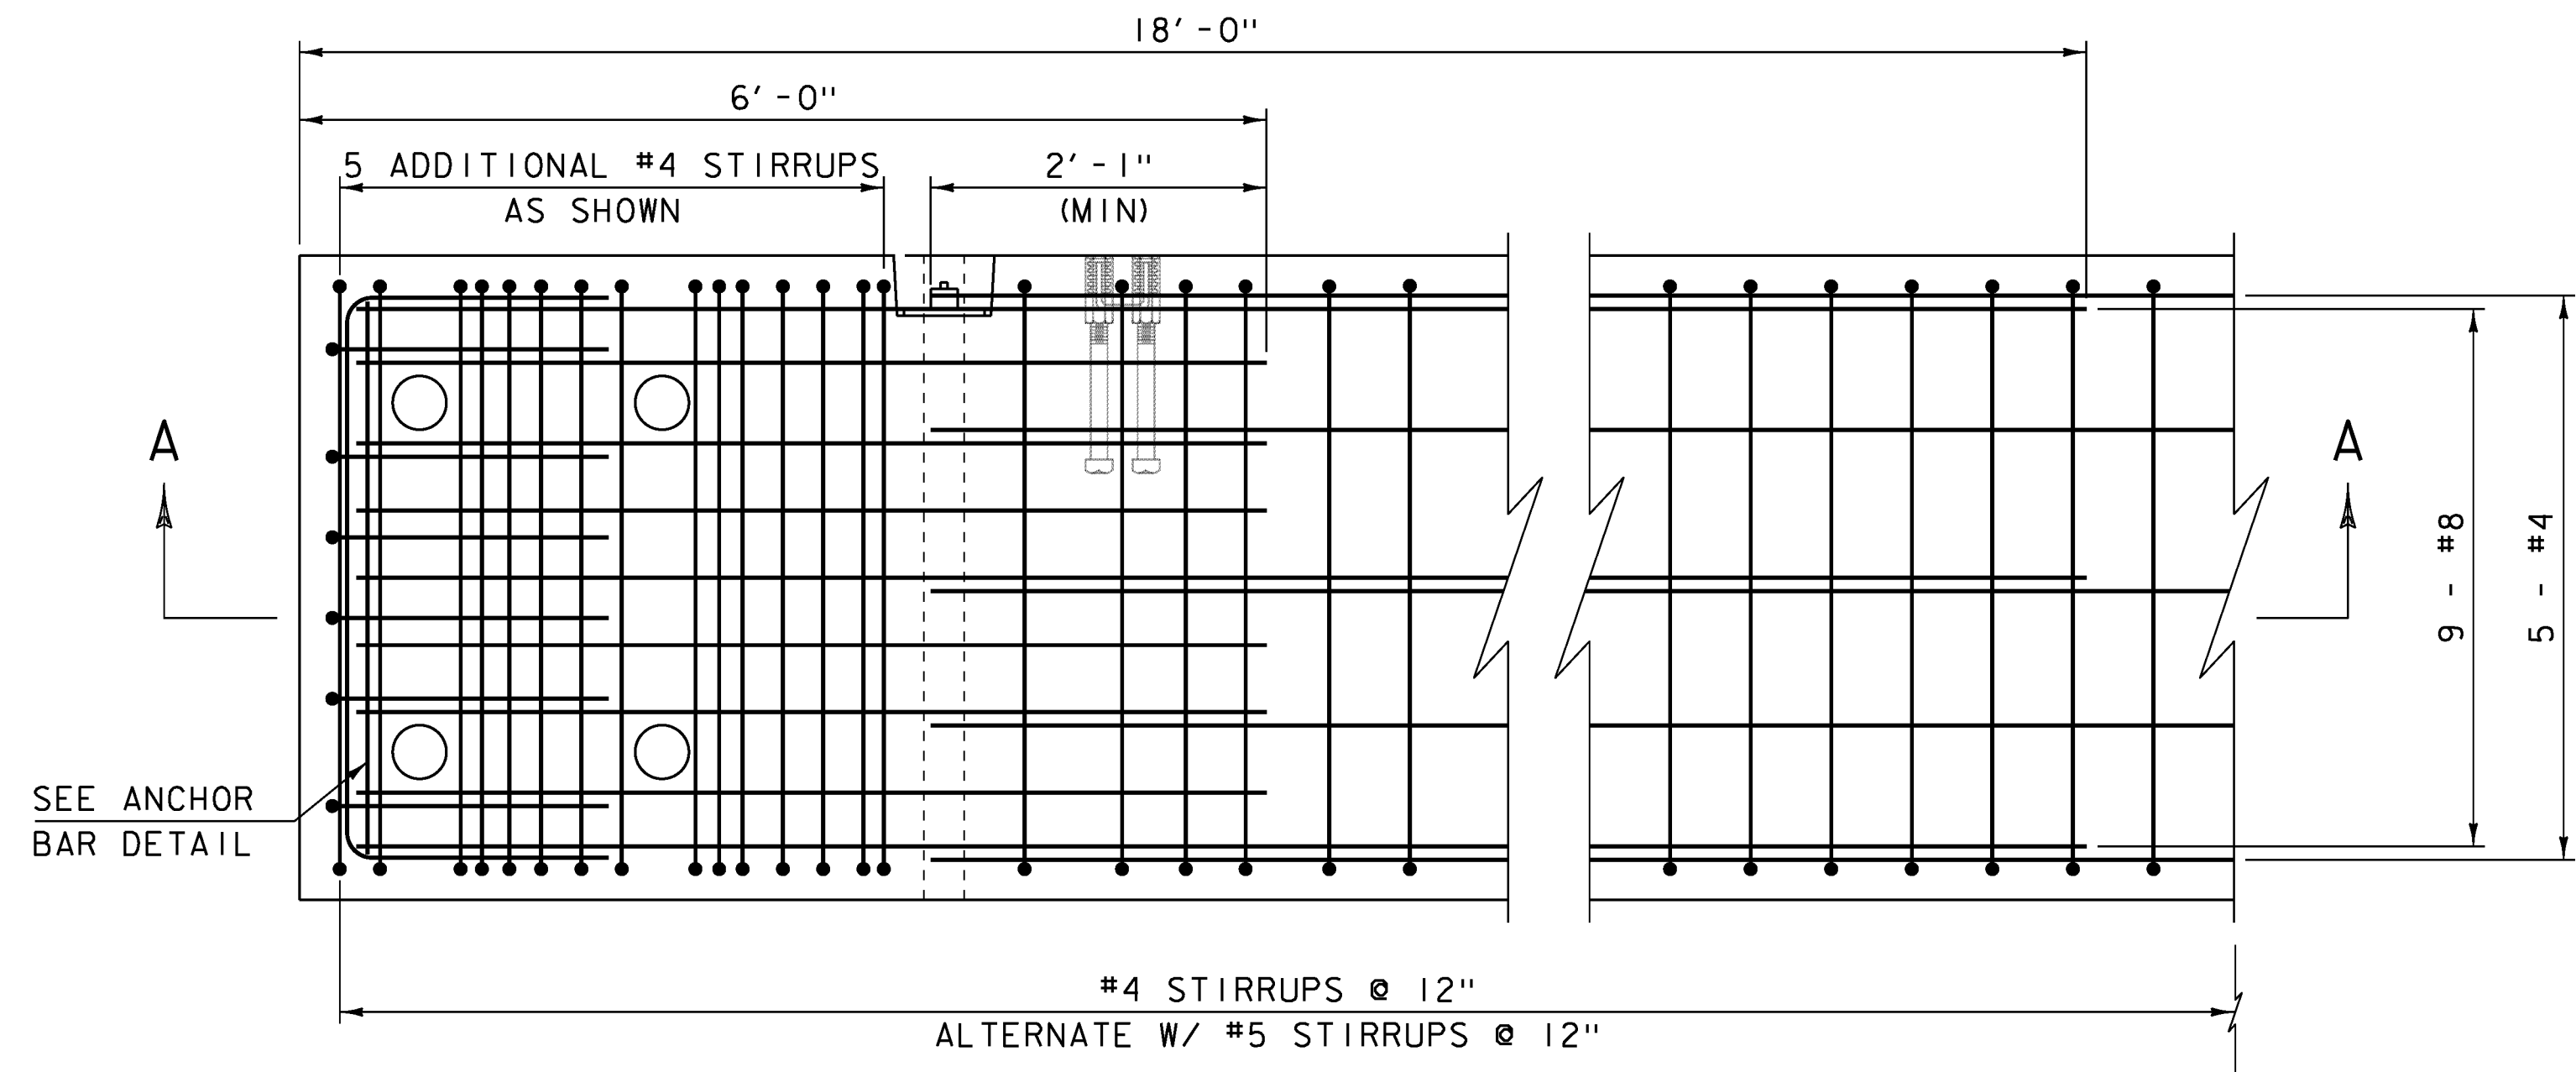


**TYPICAL END REINFORCING PLAN**

SCALE 1" = 1'-0"


**NOTES:**

- 1) EXTERIOR SLAB SHOWN, INTERIOR SLAB SIMILAR.

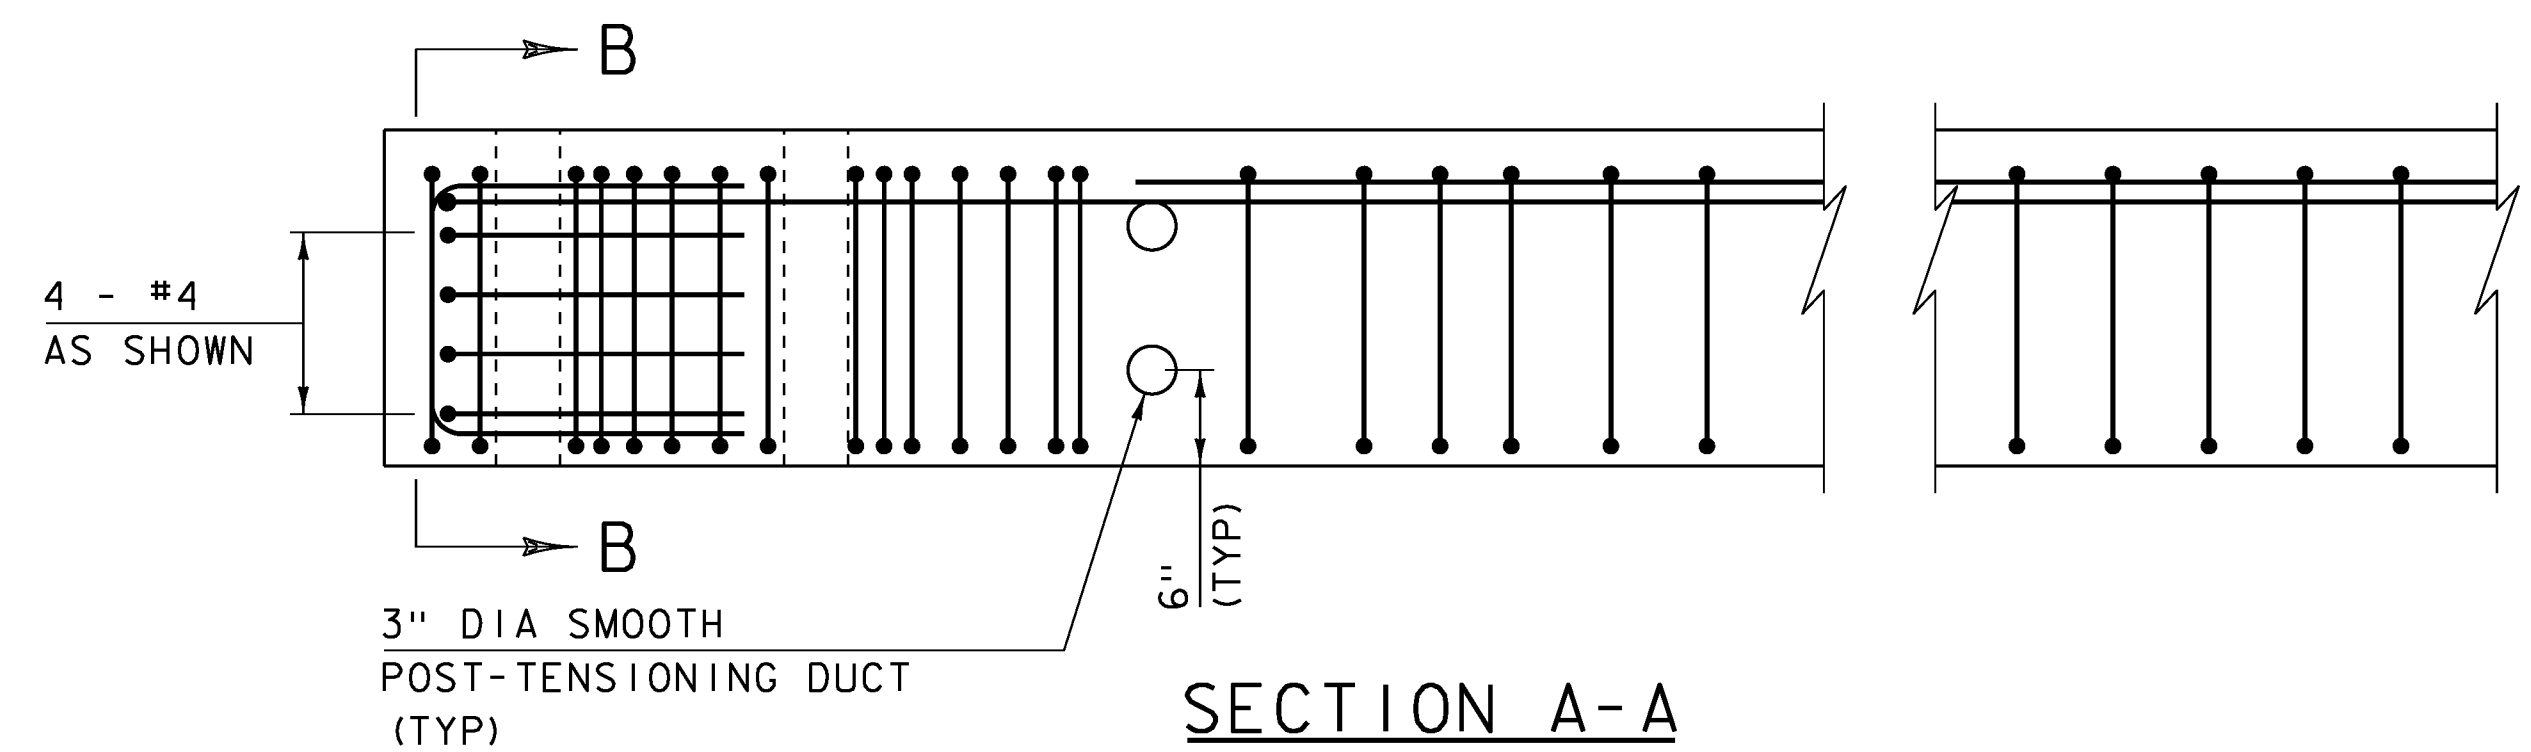


**SECTION A-A**

SCALE 1" = 1'-0"

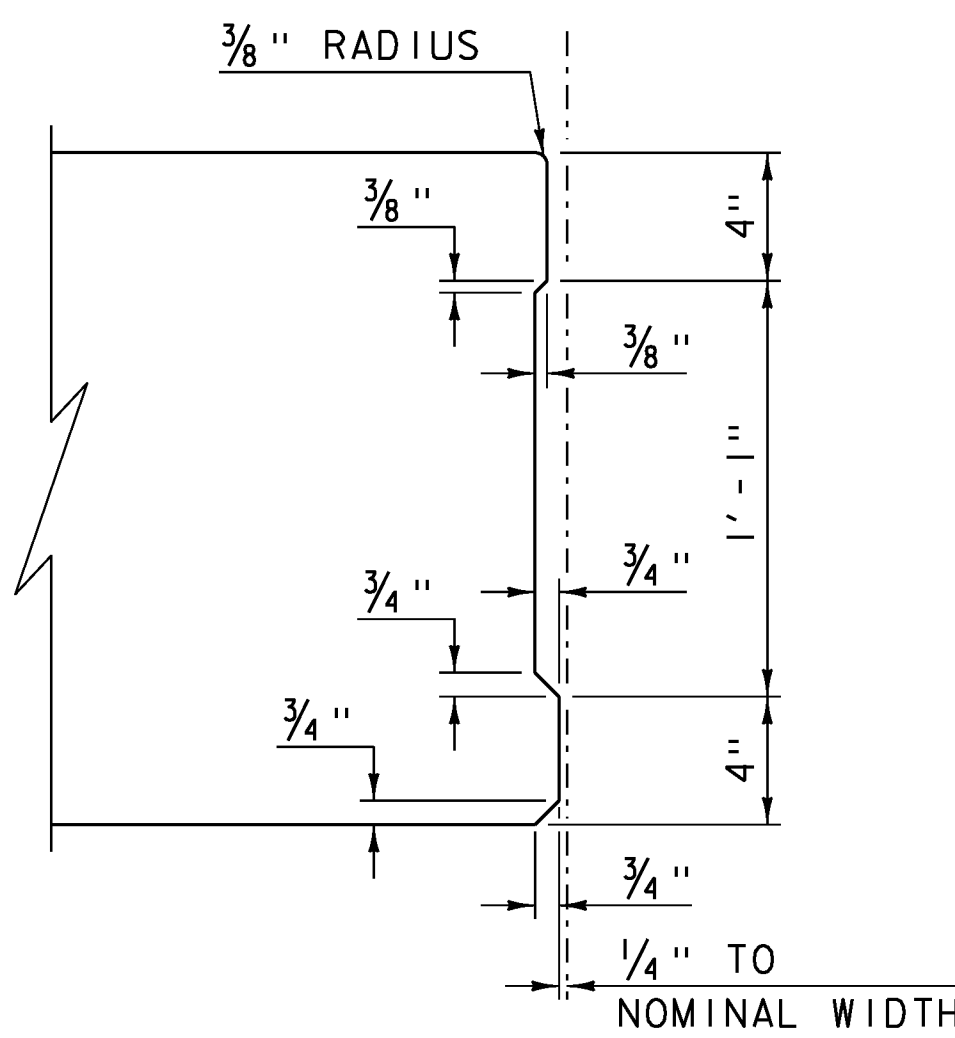


**SHEAR KEY DETAIL**

SCALE 2" = 1'-0"

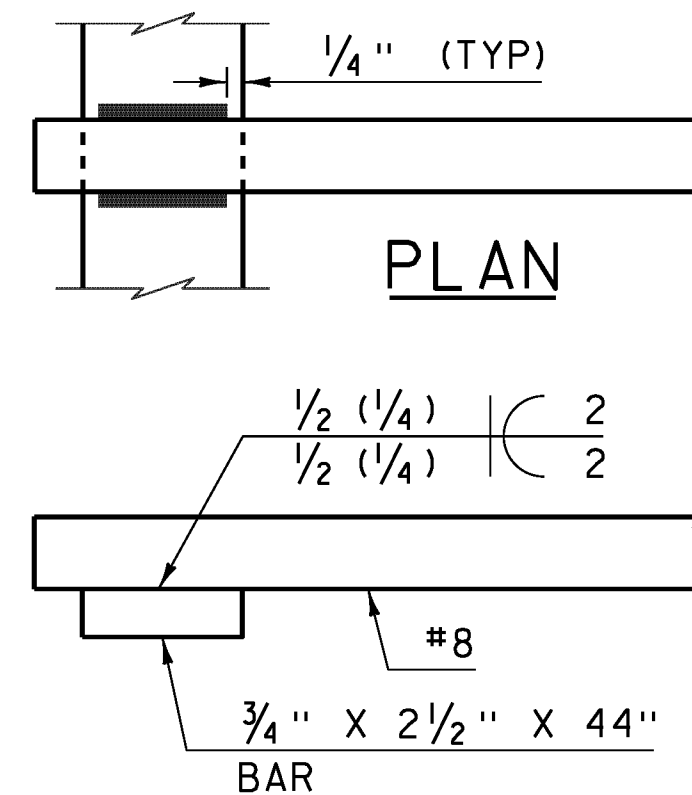


**ELEVATION ANCHOR BAR DETAILS OPTION "A"**

NOT TO SCALE

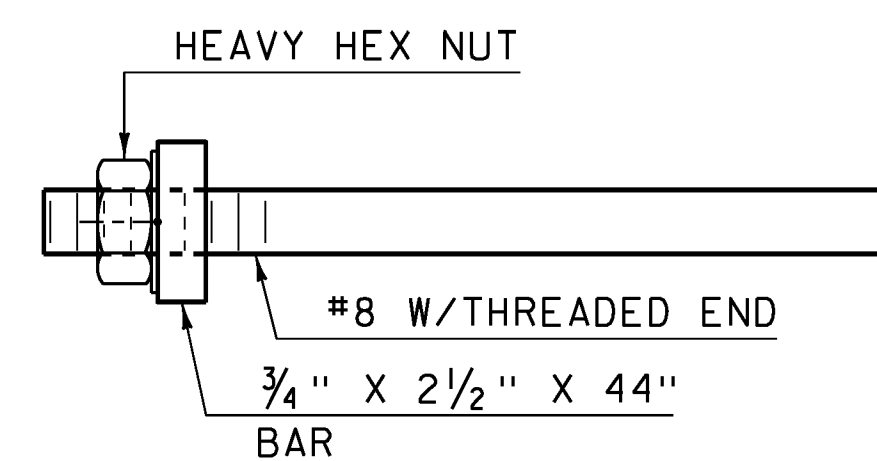

**ANCHOR BAR DETAILS OPTION "B"**

NOT TO SCALE

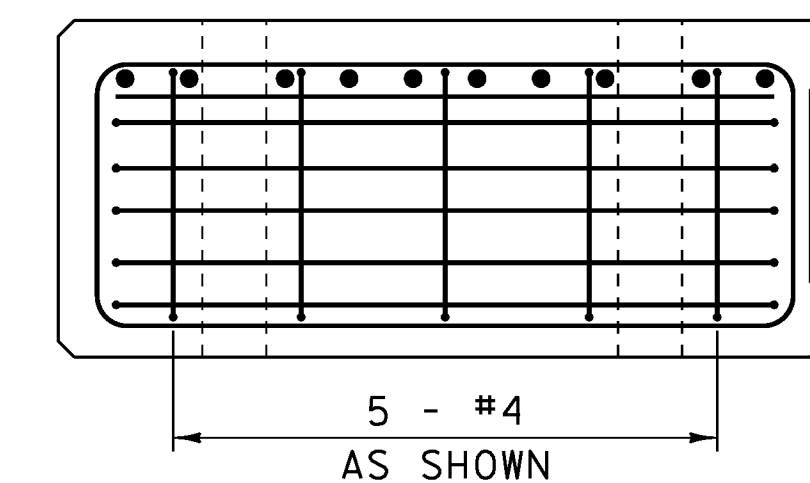


**SECTION B-B**

SCALE 1" = 1'-0"

PROJECT NAME: FAIRFIELD  
PROJECT NUMBER: BRO 1448 (41)


FILE NAME: sl2j170sup.dgn  
PROJECT LEADER: R. YOUNG  
DESIGNED BY: T. FILLBACH  
SUPERSTRUCTURE DETAILS I

PLOT DATE: 18-AUG-2014  
DRAWN BY: K. FRIEDLAND  
CHECKED BY: R. KLINEFELTER  
SHEET 56 OF 69

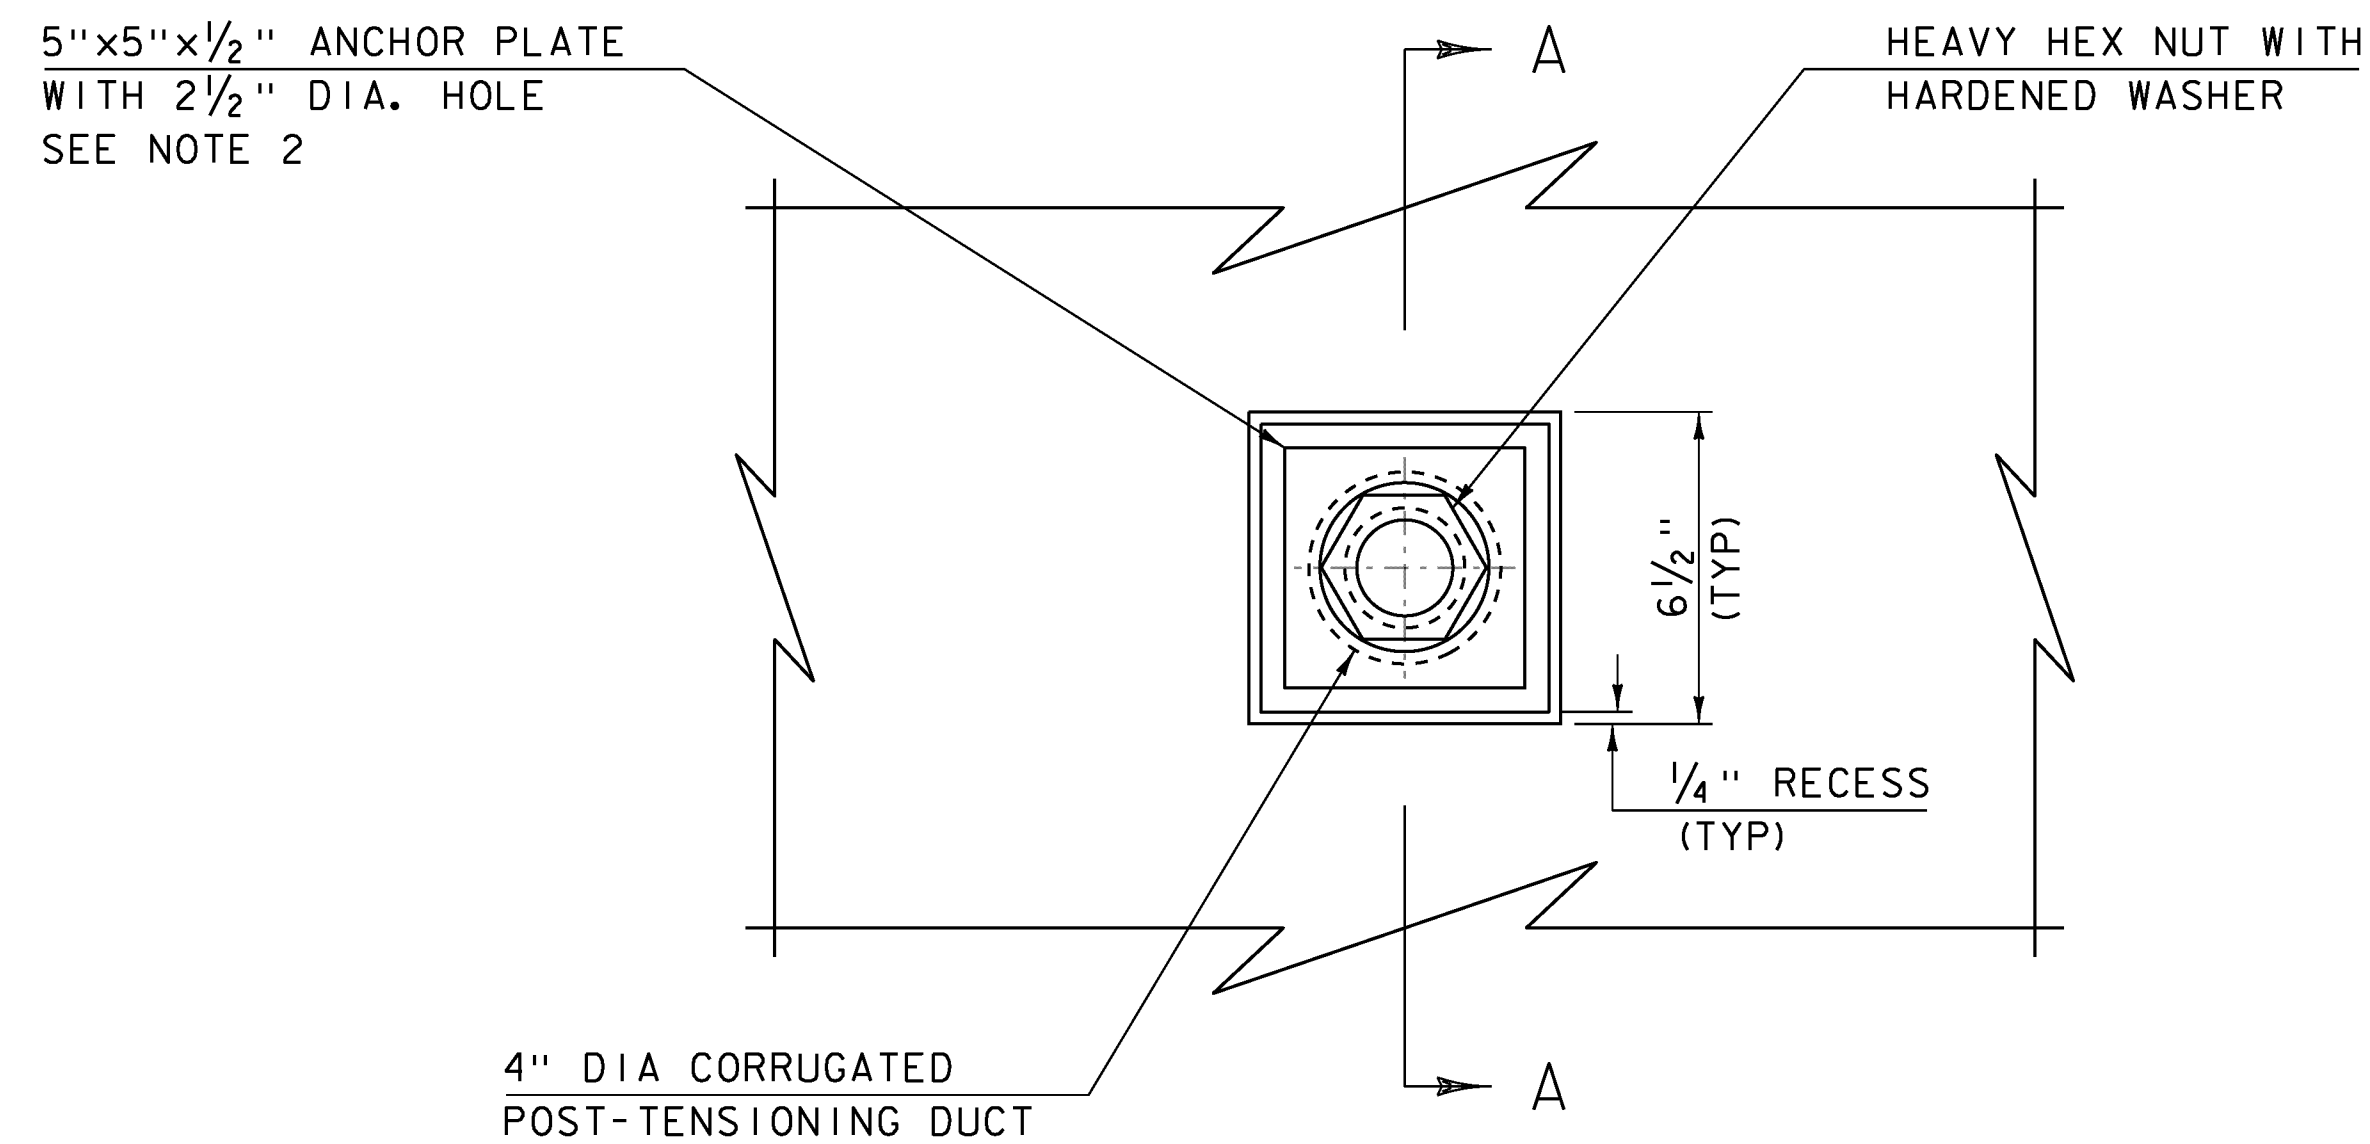


**ANCHOR BOLT DETAIL  
PLAN**

SCALE 3" = 1'-0"

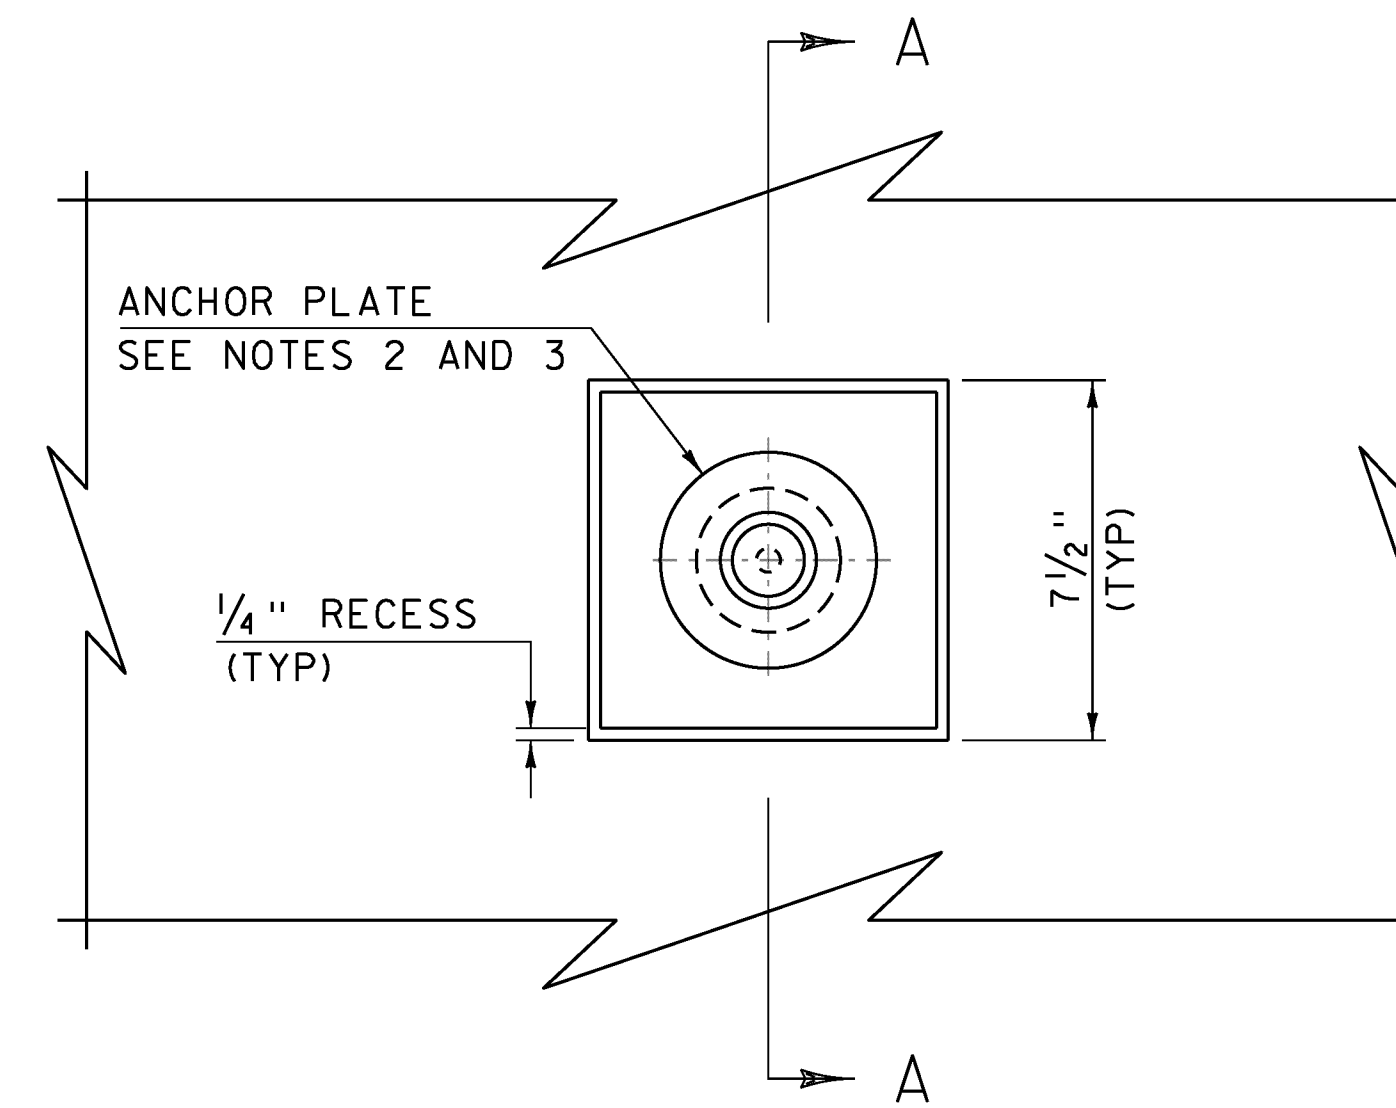


**TRANSVERSE POST-TENSIONING DETAIL  
ELEVATION**

SCALE 3" = 1'-0"

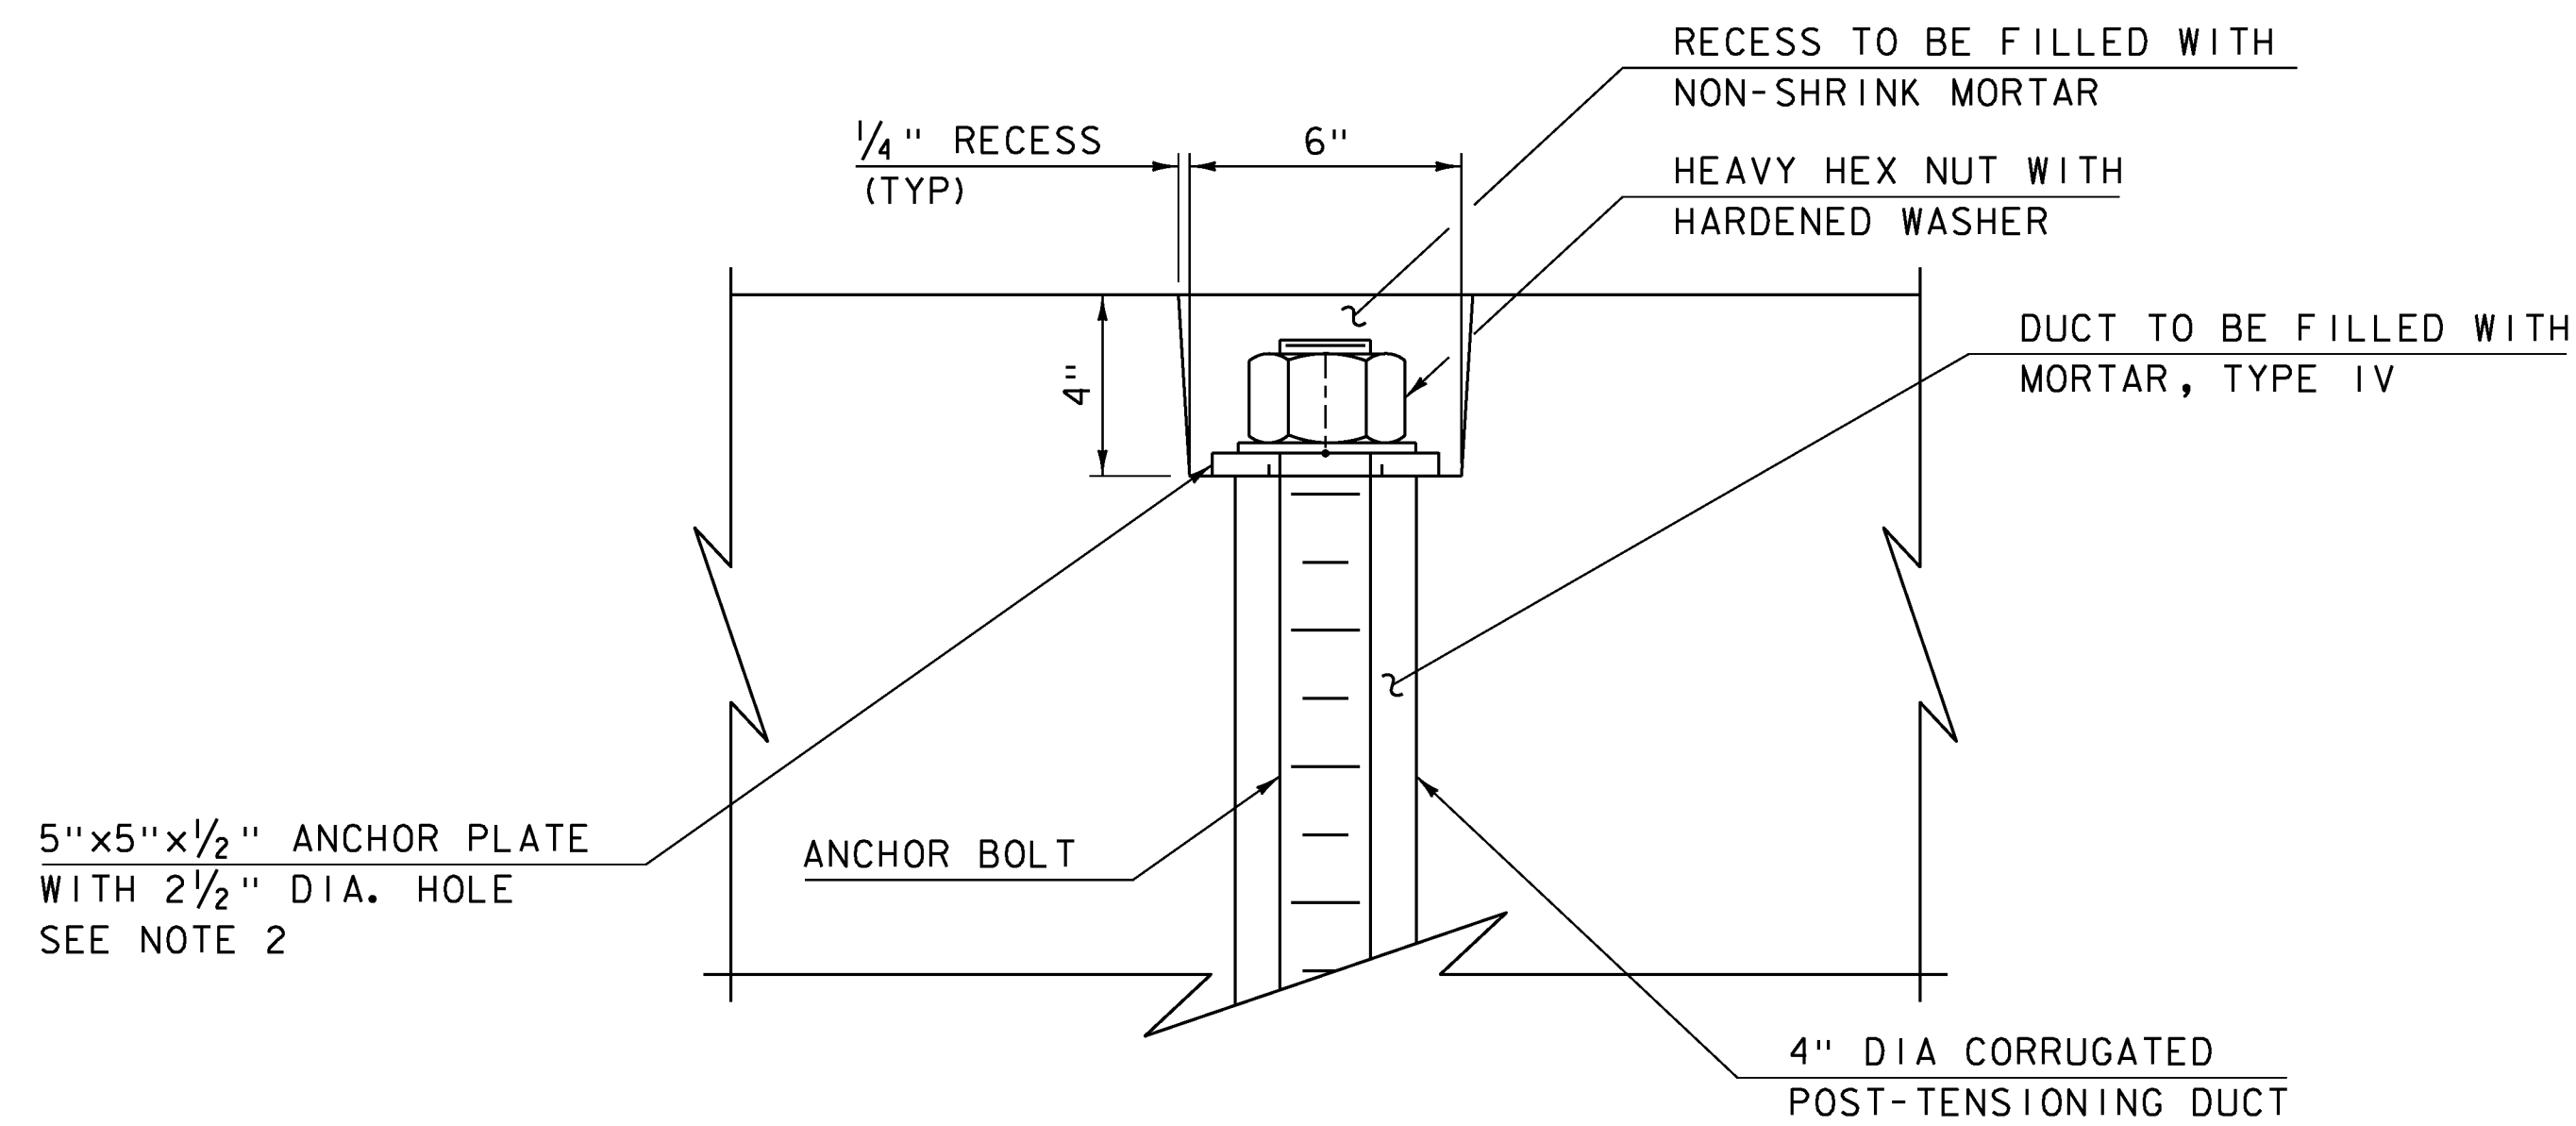

**ANCHOR BOLT DETAIL  
SECTION A-A**

SCALE 3" = 1'-0"

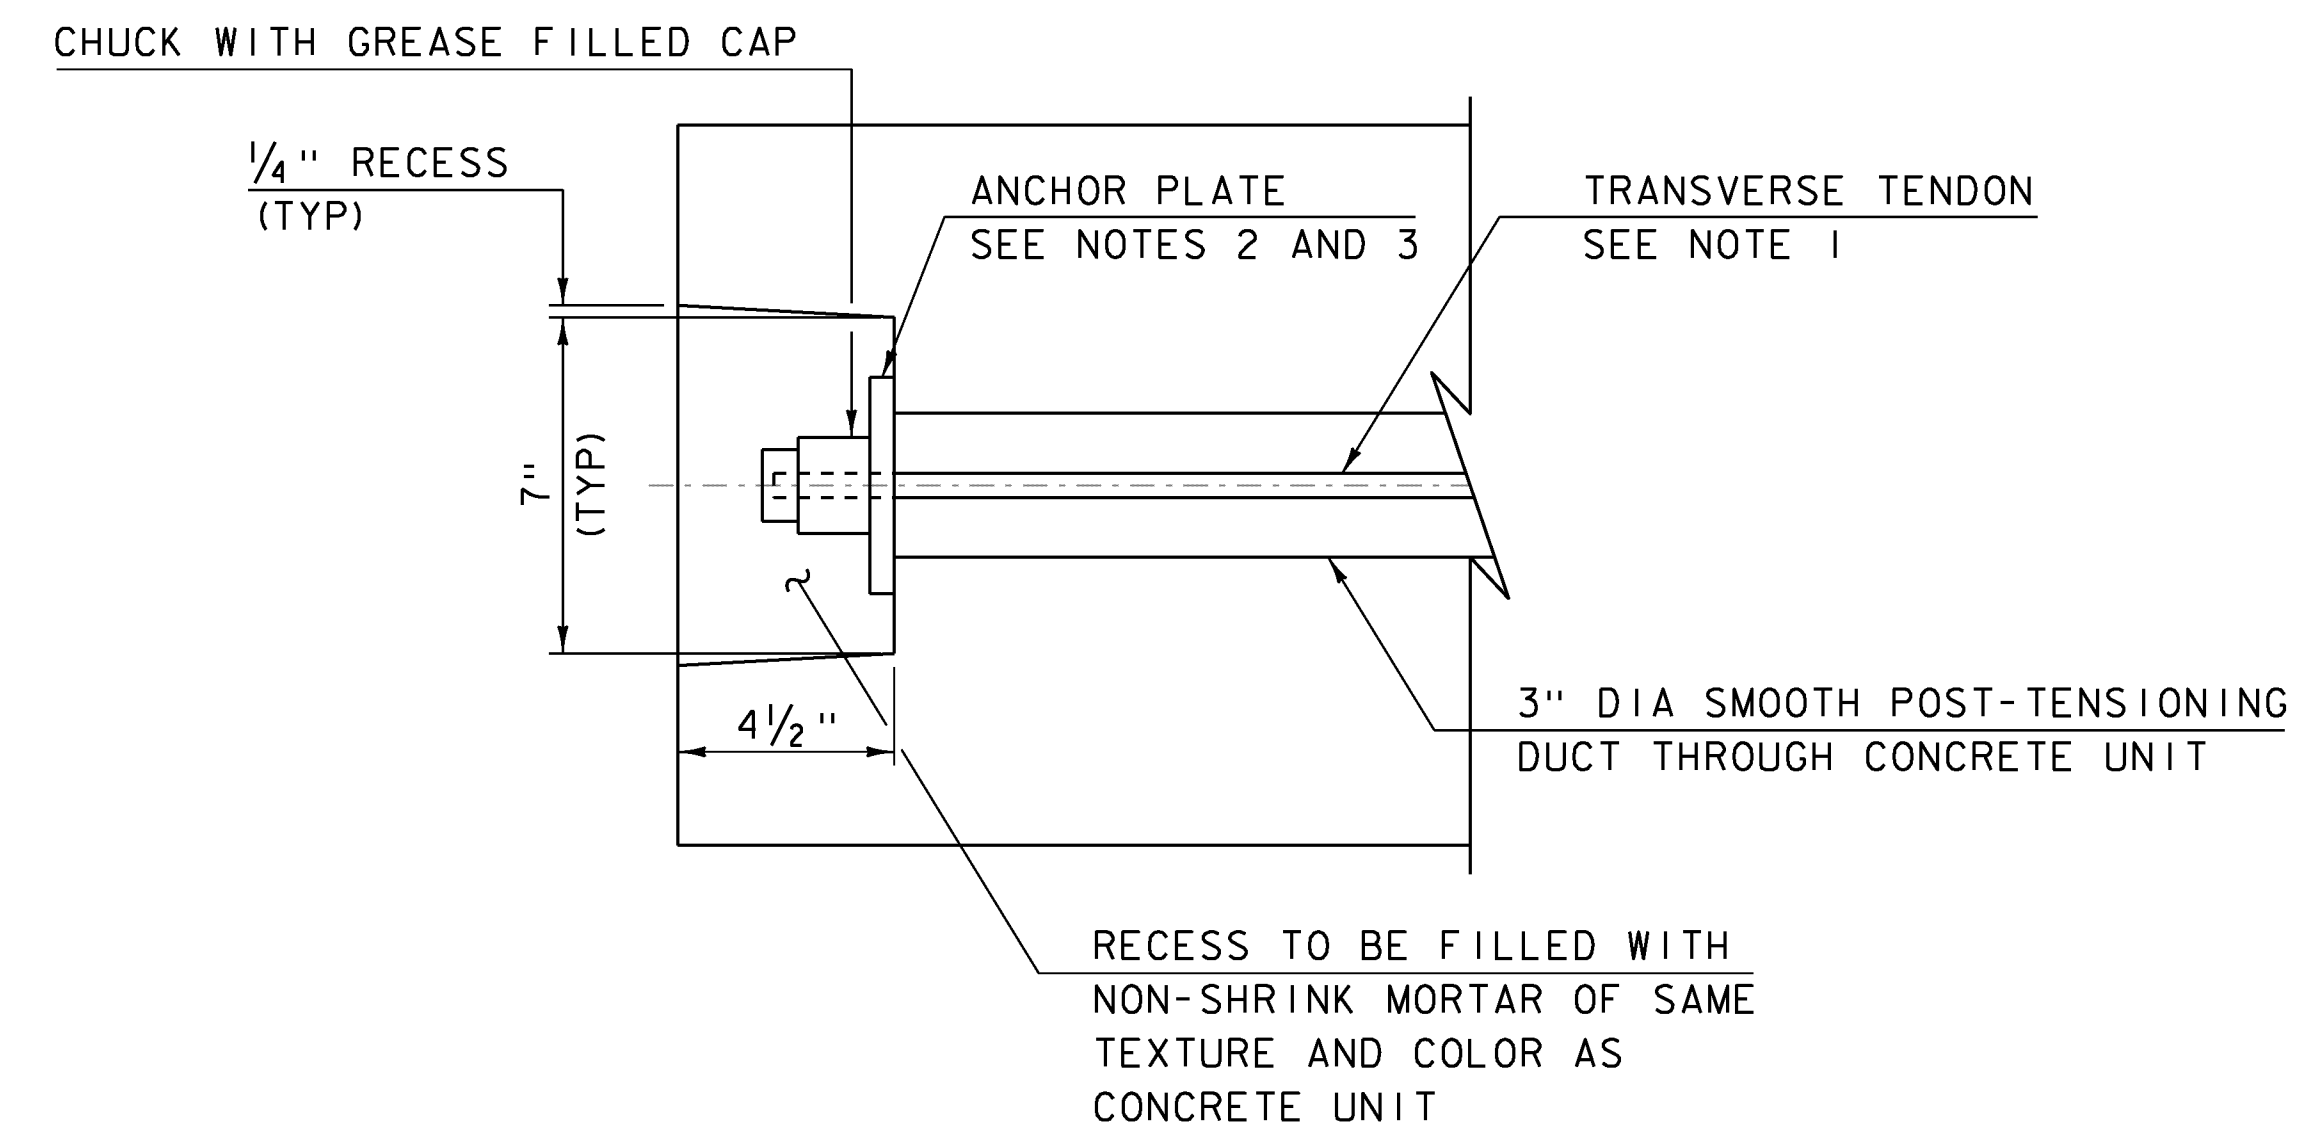


**TRANSVERSE POST-TENSIONING DETAIL  
SECTION A-A**

SCALE 3" = 1'-0"

**NOTES:**


- 1) TRANSVERSE TENDONS SHALL BE COVERED BY SEAMLESS POLYPROPYLENE SHEATH (WITH CORROSION INHIBITER GREASE BETWEEN SHEATH AND STRAND) FOR THE LENGTH OF STRAND, EXCEPT AT ANCHORAGE LOCATIONS. EACH STRAND SHALL BE TENSIONED TO 33 KIPS FOR 0.5" DIA STRAND AND TO 47 KIPS FOR 0.6" DIA STRAND.
- 2) ANCHOR PLATES SHALL CONFORM TO AASHTO M 270M/M 270, GRADE 345 (GRADE 50) AND BE GALVANIZED IN CONFORMANCE WITH AASHTO M 111M/M 111.
- 3) ANCHOR PLATES FOR TRANSVERSE POST-TENSIONING ARE TO BE DESIGNED BY THE FABRICATOR FOR THE SPECIFIC POST-TENSIONING SYSTEM USED. DETAILS FOR THE ANCHOR PLATE SHALL BE PROVIDED ON THE FABRICATION DRAWINGS.

PROJECT NAME: FAIRFIELD	
PROJECT NUMBER: BRO 1448 (4I)	
FILE NAME: sl2j170sup.dgn	PLOT DATE: 18-AUG-2014
PROJECT LEADER: R. YOUNG	DRAWN BY: K. FRIEDLAND
DESIGNED BY: T. FILLBACH	CHECKED BY: R. KLINEFELTER
SUPERSTRUCTURE DETAILS 2	SHEET 57 OF 69

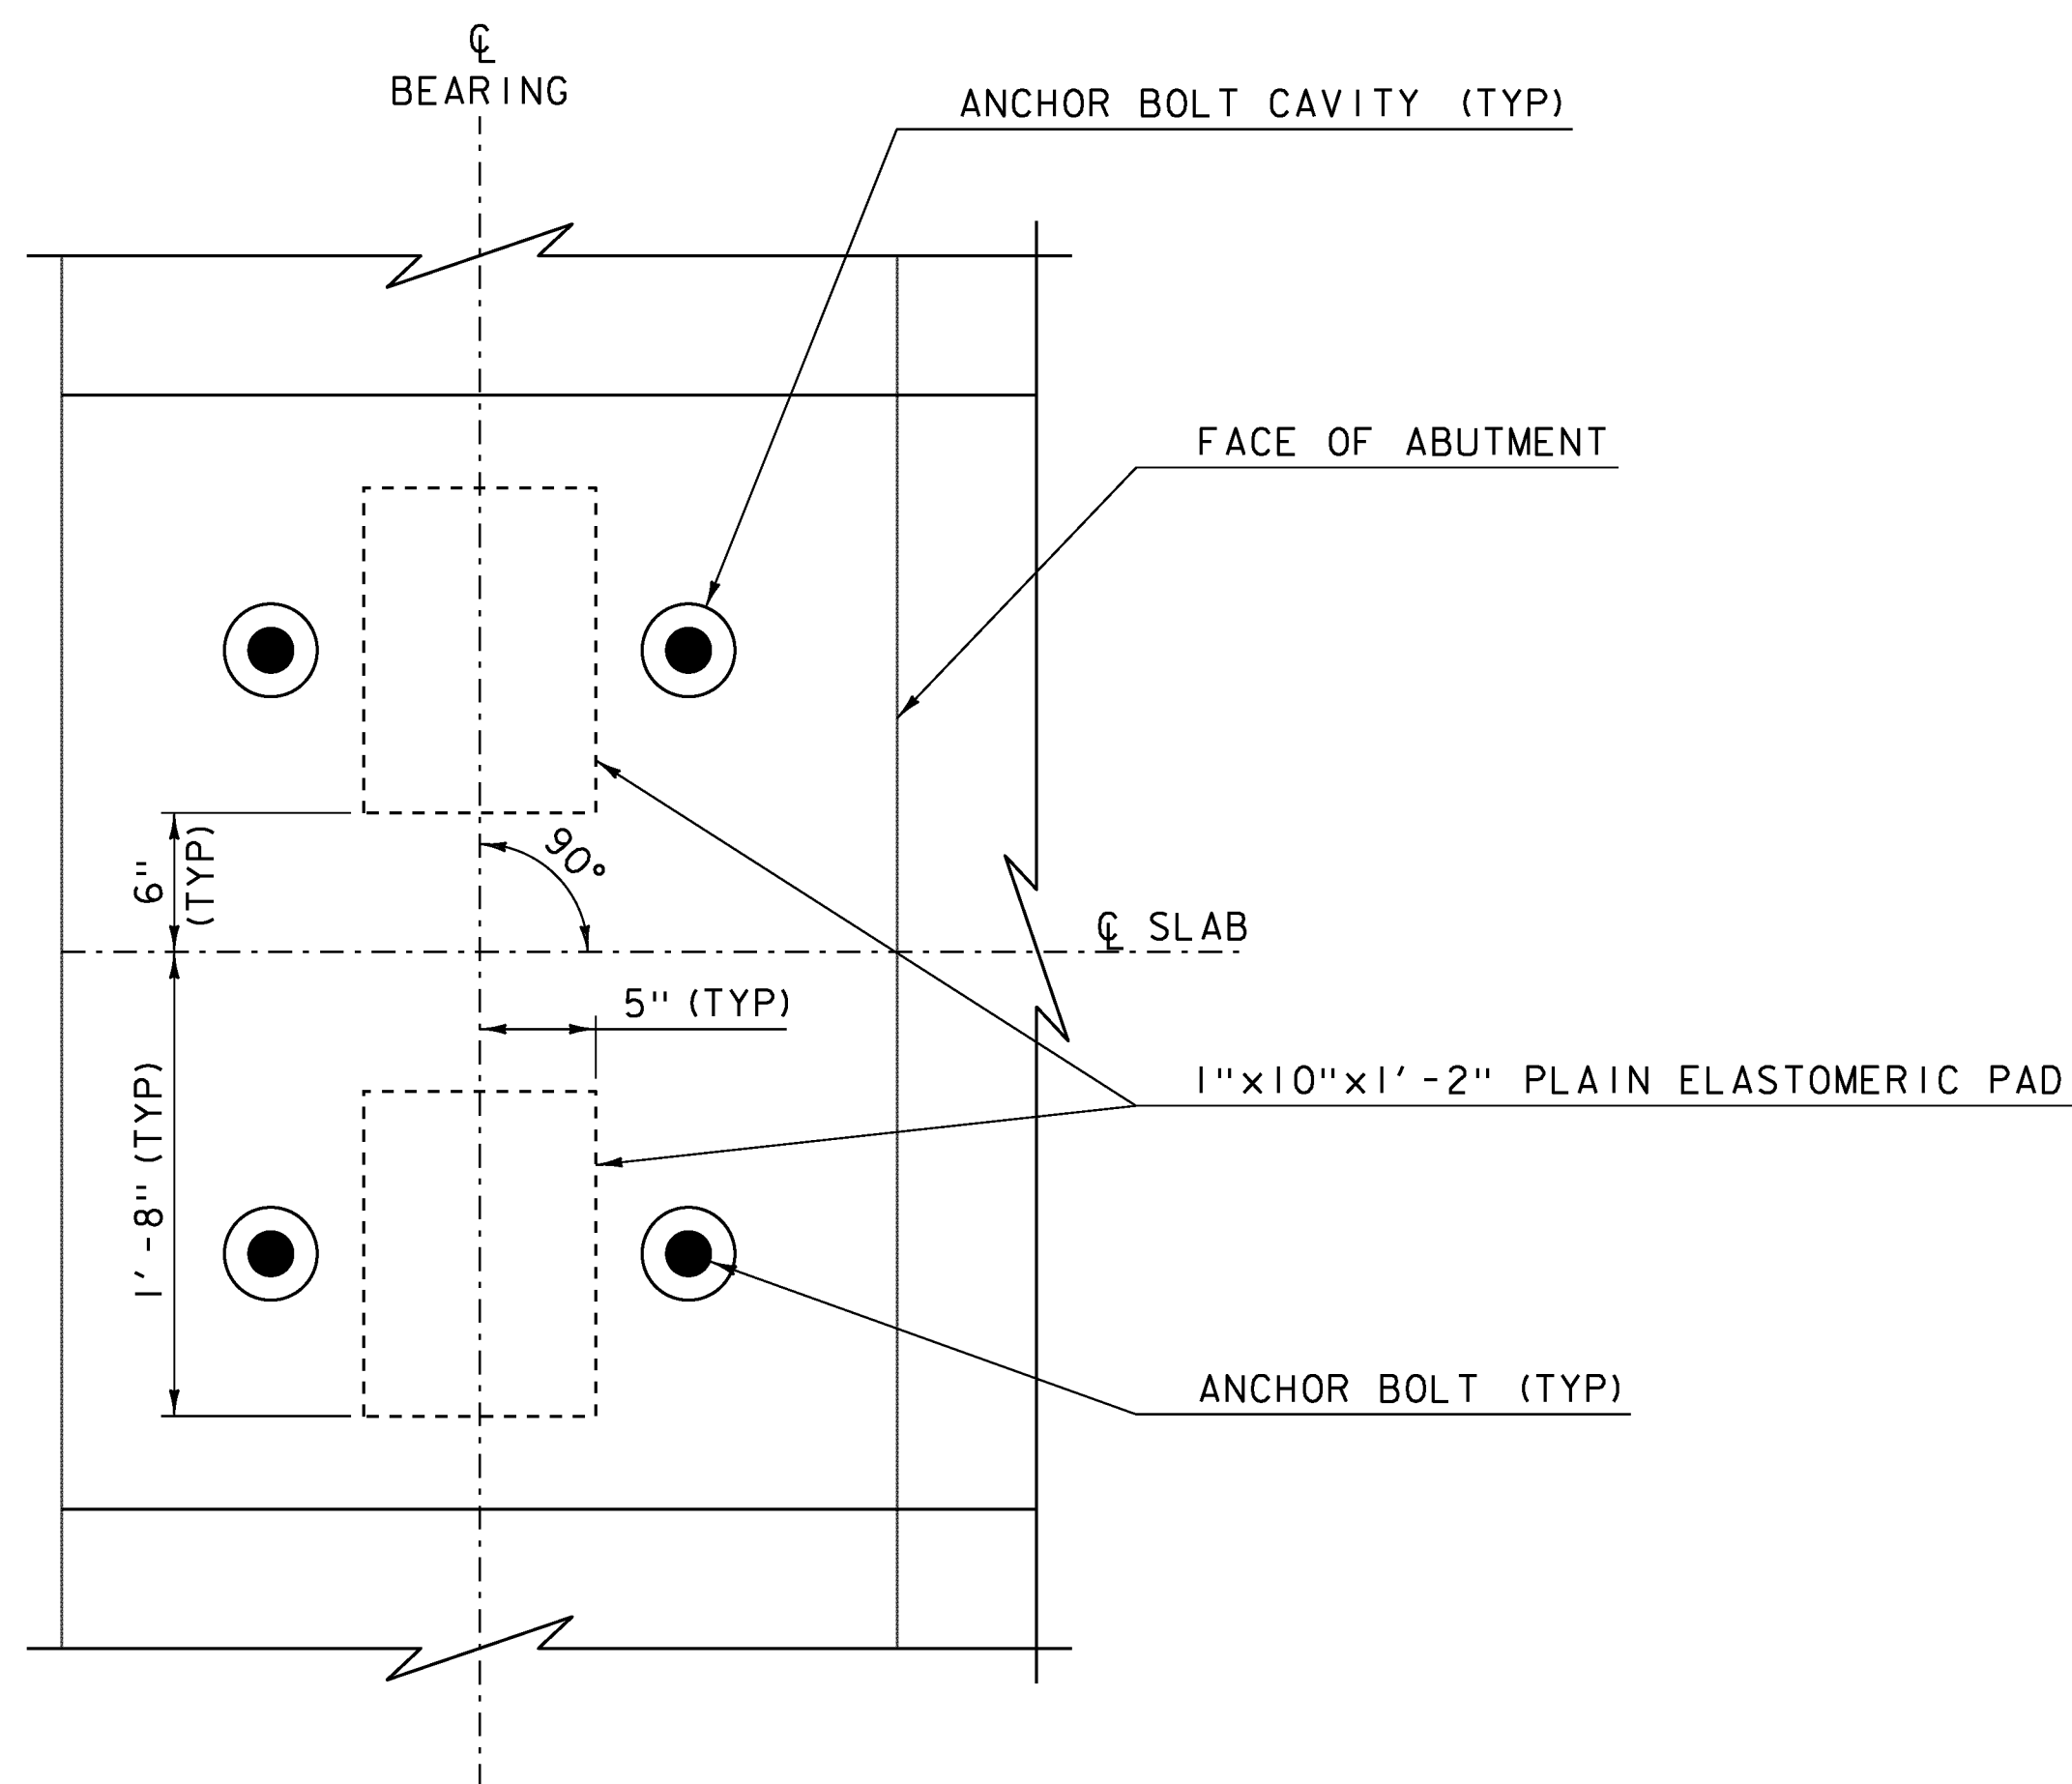

**BEARING LAYOUT**

SCALE 1/2" = 1'-0"

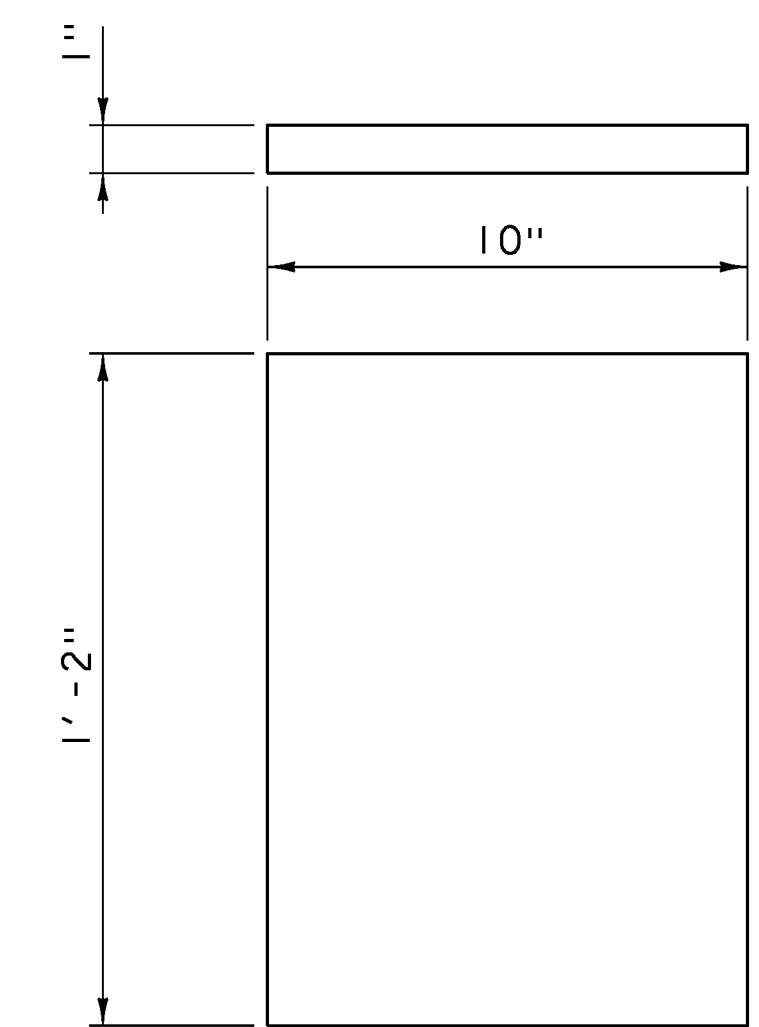


**BEARING DETAIL**

SCALE 3" = 1'-0"

**BEARING NOTES:**

1. BEARINGS SHALL CONFORM TO THE APPLICABLE SUBSECTIONS OF SECTIONS 531 AND 731.
2. THE ELASTOMER WAS DESIGNED WITH A SHEAR MODULUS OF 110 PSI +/- 15%.
3. THE CONTRACTOR IS ADVISED TO HAVE A MINIMUM OF 16 - 1/4"x10"x1'-2" GALVANIZED STEEL SHIMS AVAILABLE FOR USE FOR ELEVATION ADJUSTMENTS UPON THE SETTING OF THE SUPERSTRUCTURE UNITS. THE SHIMS SHALL BE FABRICATED ACCORDING TO SECTION 531 AND SHALL BE INCLUDED UNDER ITEM 531.16, "BEARING DEVICE ASSEMBLY, PLAIN ELASTOMERIC PAD".

PROJECT NAME: FAIRFIELD	
PROJECT NUMBER: BRO 1448 (41)	
FILE NAME: sl2j170sup.dgn	PLOT DATE: 18-AUG-2014
PROJECT LEADER: R. YOUNG	DRAWN BY: R. KLINEFELTER
DESIGNED BY: R. KLINEFELTER	CHECKED BY: J. SALVATORI
BEARING DETAILS	SHEET 58 OF 69

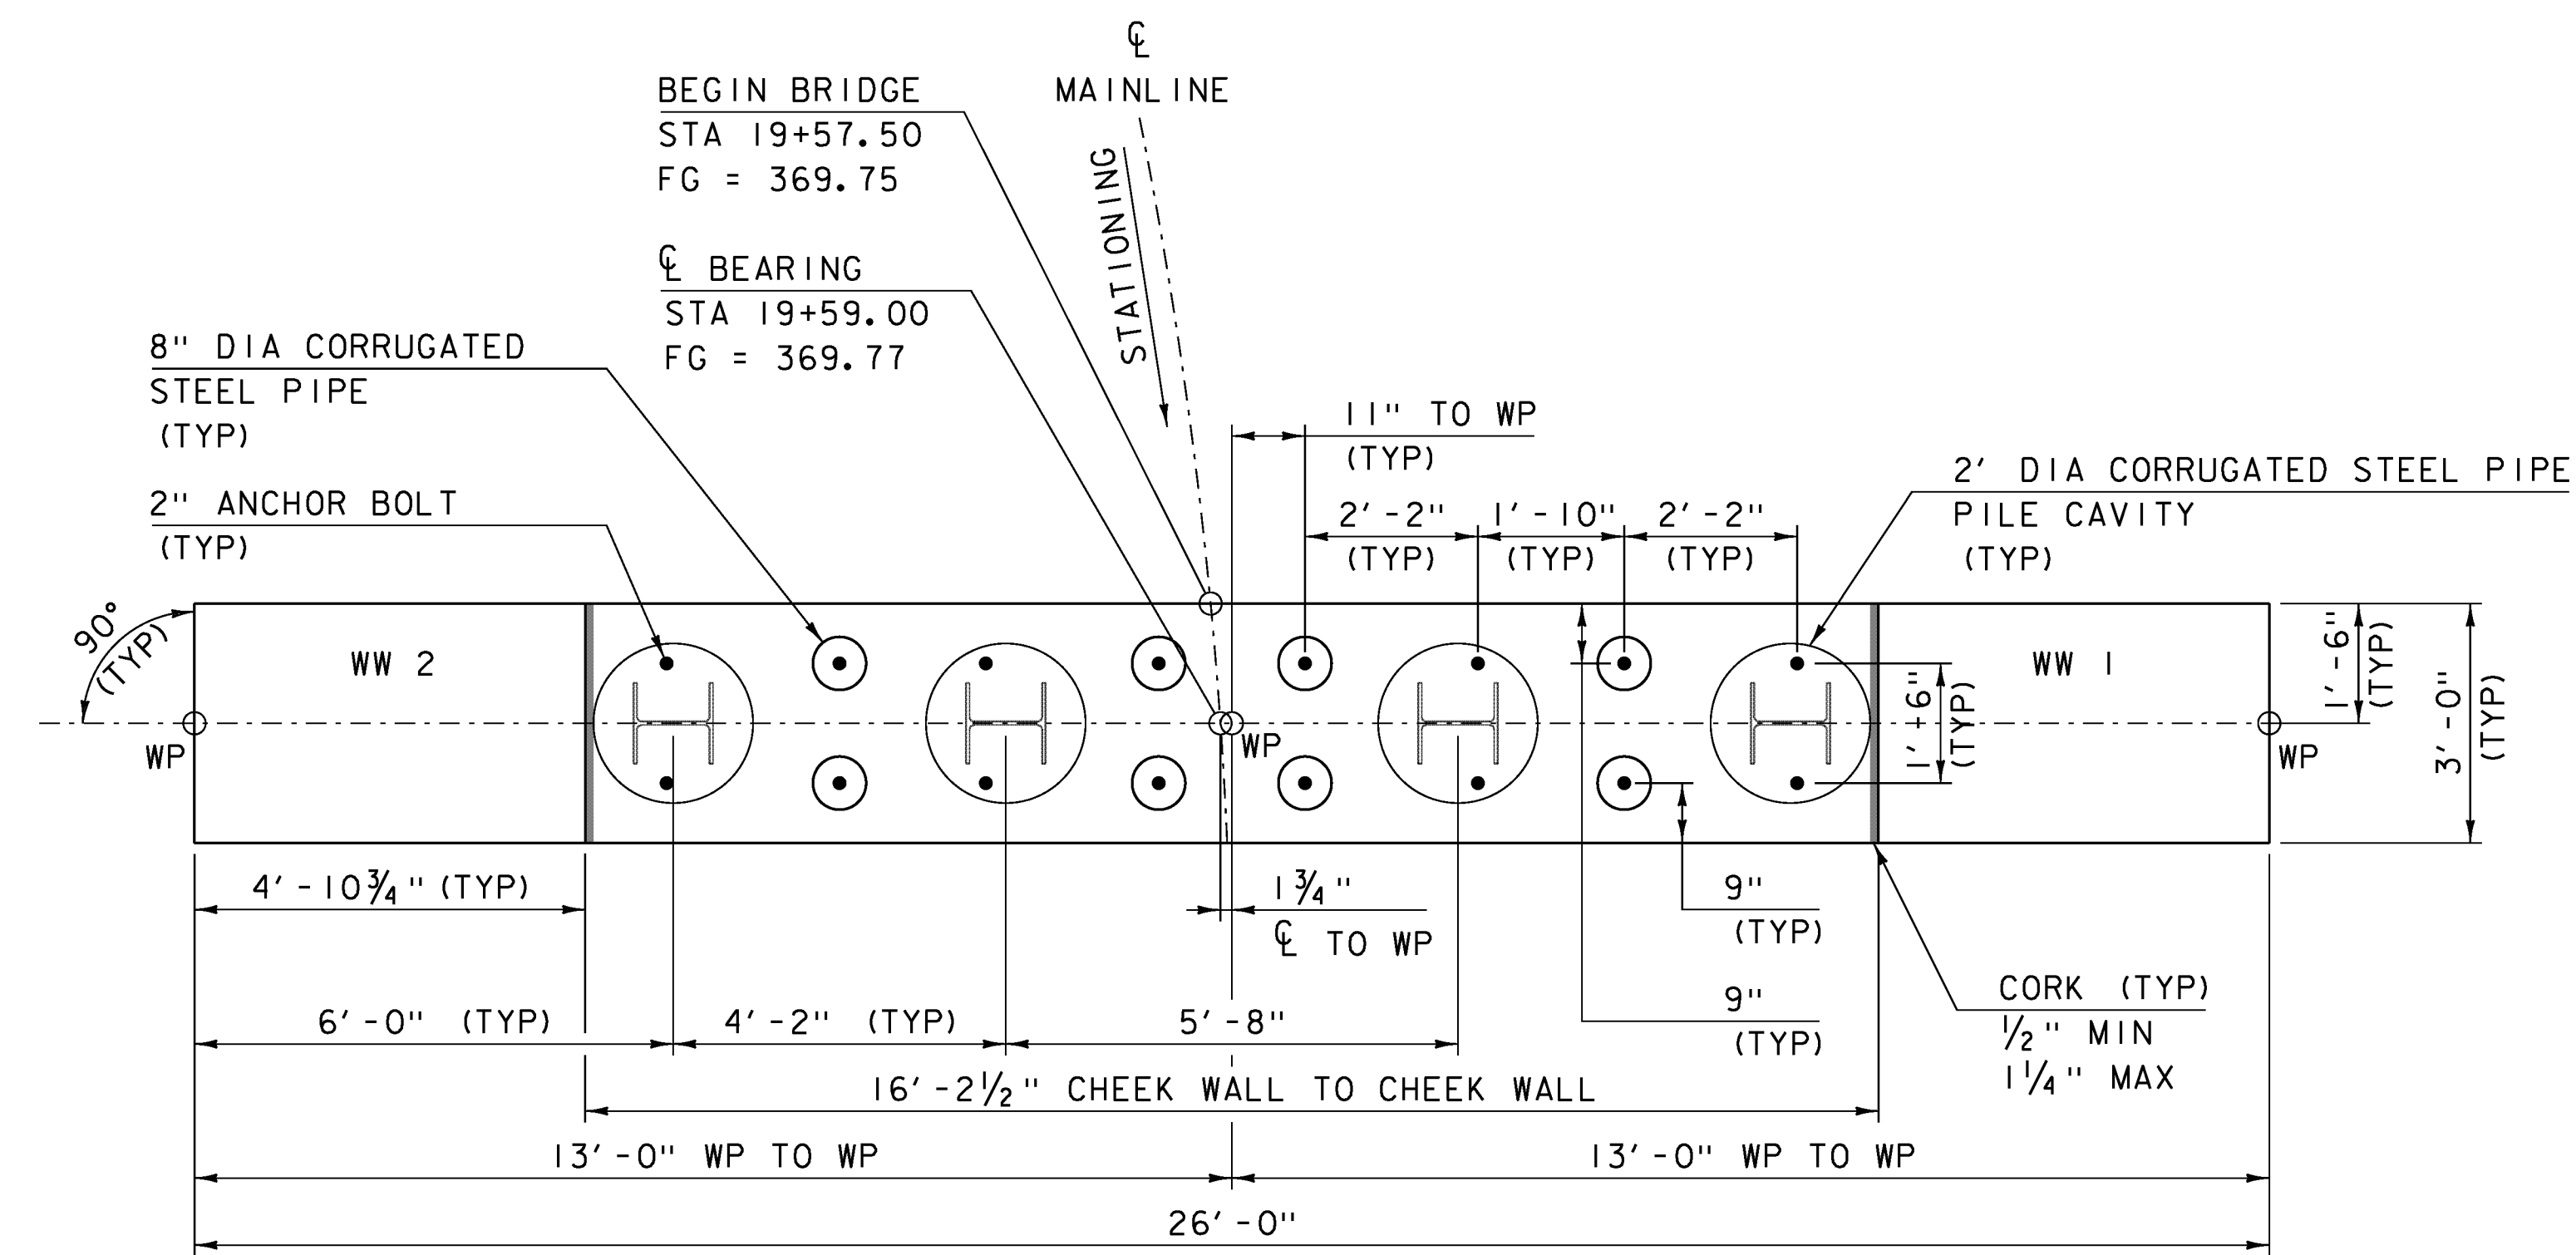

ABUTMENT PLAN (PCU)


SCALE 1/2" = 1'-0"

PCU 1 ELEVATIONS

ELEV "A"	369.86
ELEV "B"	367.78
ELEV "C"	364.86
ELEV "D"	367.94
ELEV "E"	370.18
ELEV "F"	368.10

PCU 2 ELEVATIONS

ELEV "A"	369.50
ELEV "B"	367.42
ELEV "C"	362.18
ELEV "D"	367.26
ELEV "E"	369.18
ELEV "F"	367.10

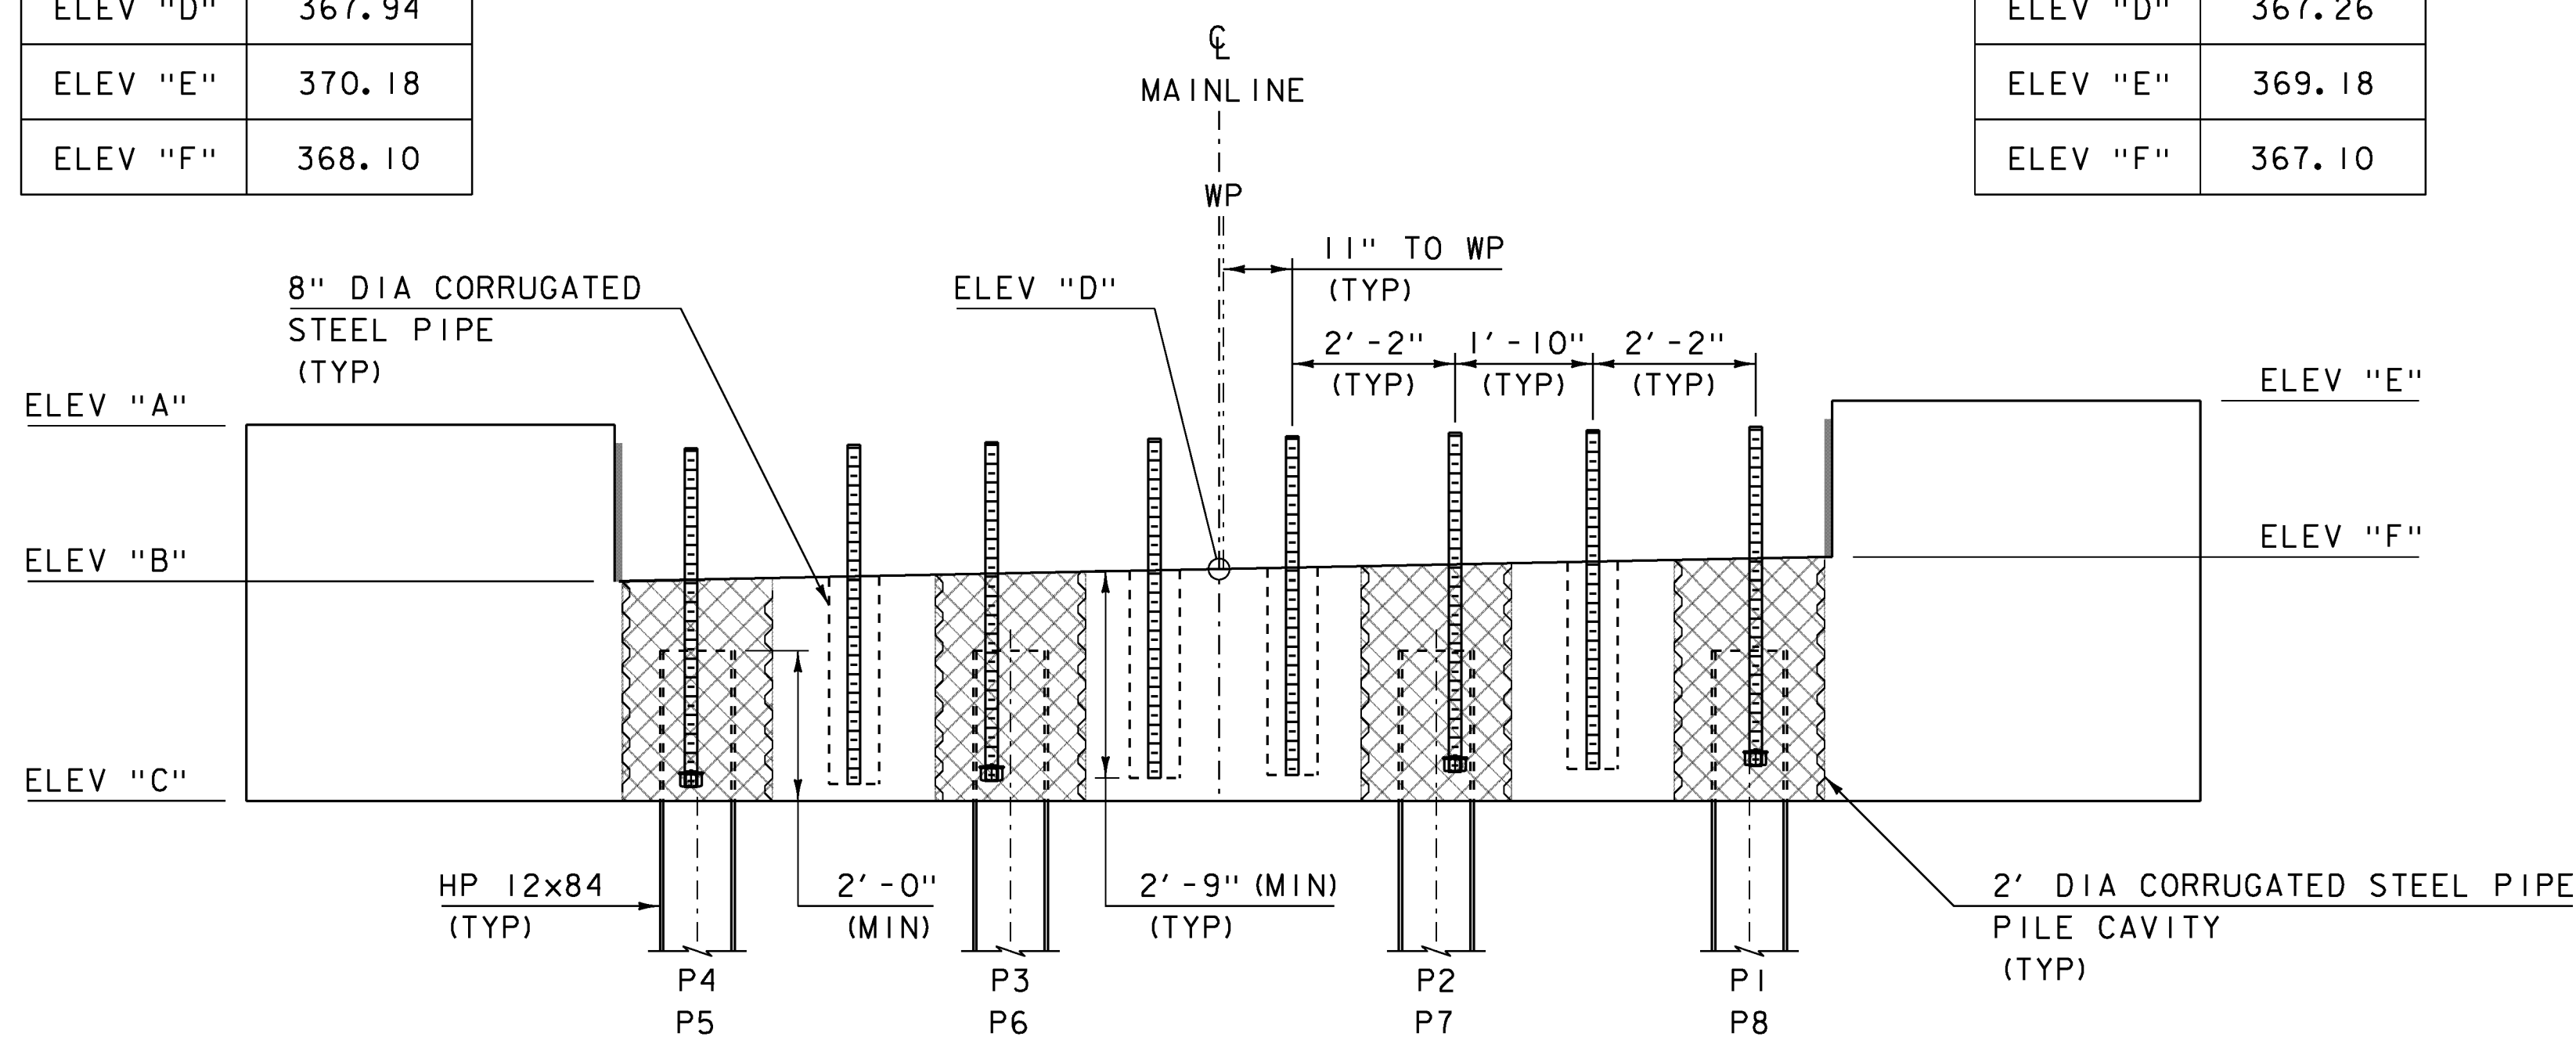


ABUTMENT ELEVATION (PCU)

SCALE 1/2" = 1'-0"

NOTES:

- 1) ANCHOR BOLTS SHALL BE ASTM F1554 GRADE 105.
- 2) ANCHOR BOLTS, NUTS, AND WASHERS SHALL BE GALVANIZED.
- 3) 8" DIA CORRUGATED STEEL PIPES FOR ANCHOR BOLTS SHALL BE PRECAST INTO THE PILE CAPS. DRILLING AND GROUTING ANCHOR BOLTS WILL NOT BE PERMITTED.
- 4) ANCHOR BOLTS, NUTS, WASHERS, AND ANCHOR PLATES SHALL BE PAID FOR UNDER ITEM 506.60, STRUCTURAL STEEL (FPQ).
- 5) GROUT IN 8" DIA CORRUGATED STEEL PIPES FOR ANCHOR BOLTS SHALL HAVE A MINIMUM COMPRESSIVE STRENGTH OF 10 KSI AT 28 DAYS.
- 6) ANCHOR BOLTS LOCATED IN PILE CAVATIES SHALL HAVE A HEAVY HEX NUT AND HARDENED WASHER ON THE BOTTOM END OF EACH ANCHOR BOLT AND SHALL BE SECURED IN THE FINAL POSITION BEFORE THE PILE CAVITY CONCRETE IS PLACED.
- 7) A TEMPLATE SHALL BE USED TO LAYOUT ANCHOR BOLT DUCTS IN THE SOLID SLABS. THE SAME TEMPLATE SHALL BE USED TO LAYOUT ANCHOR BOLT DUCTS AND ANCHOR BOLTS IN THE ABUTMENTS.
- 8) ALL COSTS ASSOCIATED WITH FURNISHING AND INSTALLING SHEET MEMBRANE WATERPROOFING SHALL BE CONSIDERED INCIDENTAL TO THE WORK FOR PRECAST CONCRETE STRUCTURE.
- 9) PCU 1 SHOWN, PCU 2 SIMILAR.

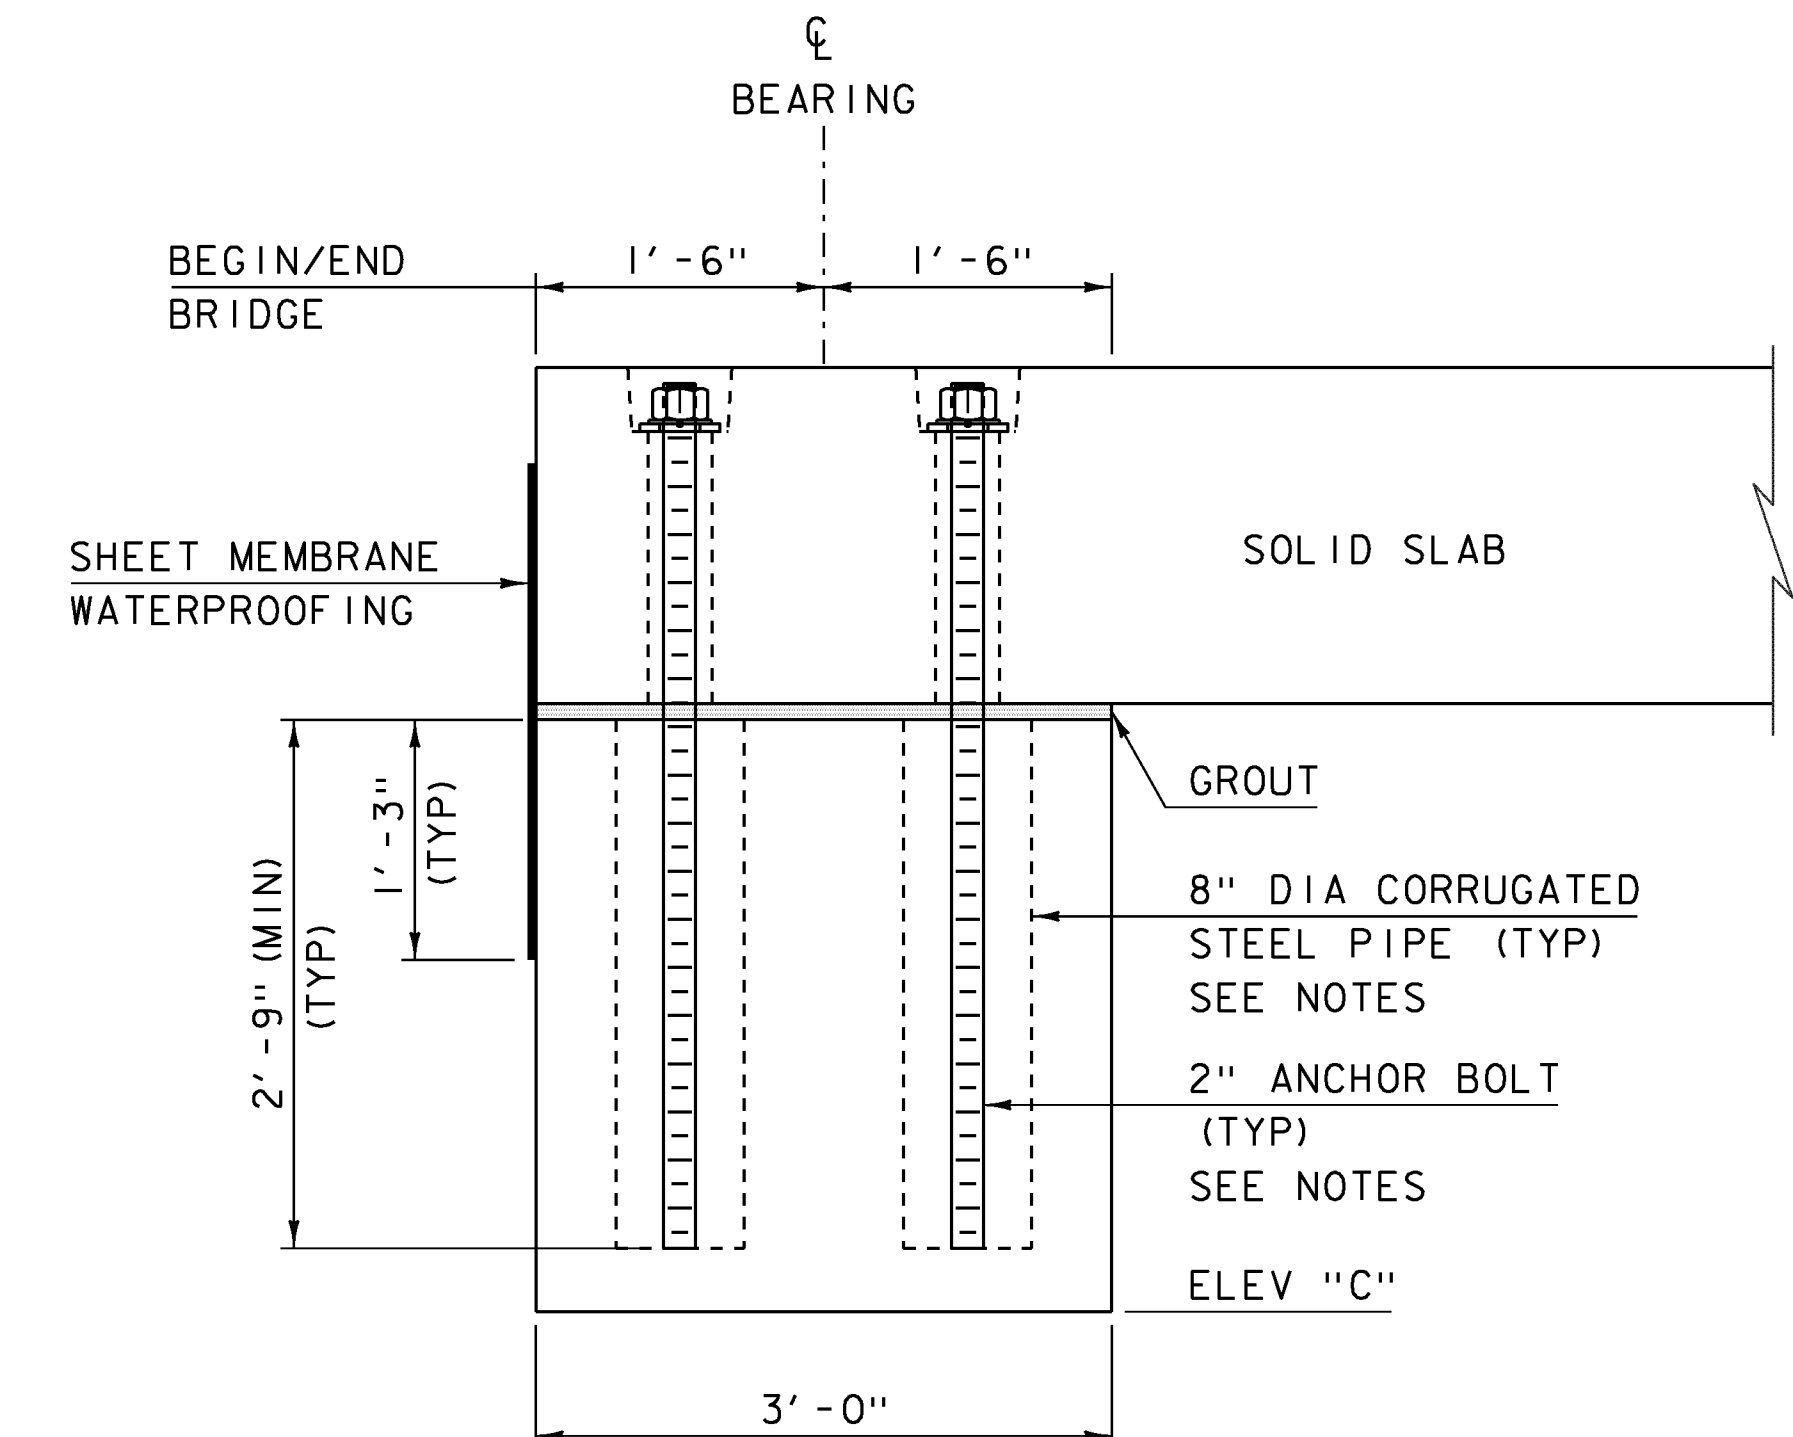


ABUTMENT TYPICAL (PCU)

SCALE 1" = 1'-0"

PROJECT NAME: FAIRFIELD  
PROJECT NUMBER: BRO 1448 (4I)


FILE NAME: sl2j170sub.dgn  
PROJECT LEADER: R. YOUNG  
DESIGNED BY: T. FILLBACH  
ABUTMENT PLAN

PLOT DATE: 11-SEP-2014  
DRAWN BY: K. FRIEDLAND  
CHECKED BY: R. KLINEFELTER  
SHEET 59 OF 69

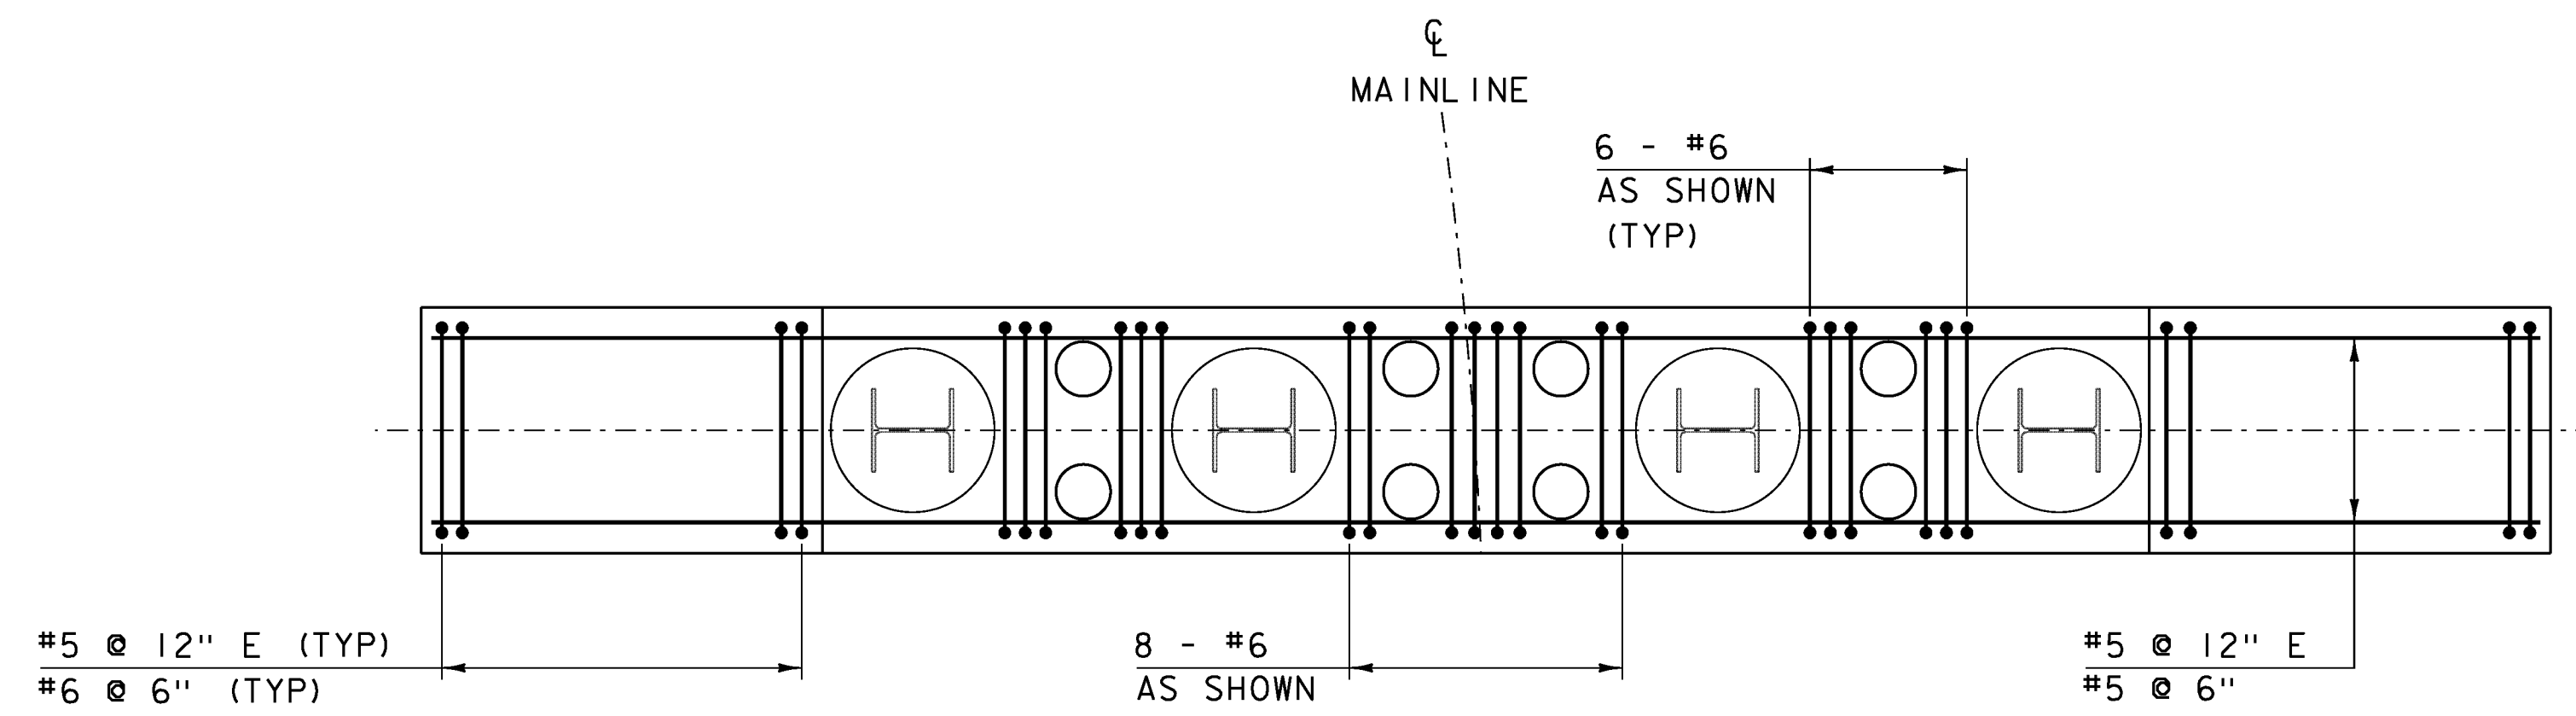


ABUTMENT REINFORCING PLAN (PCU)

SCALE 1/2" = 1'-0"

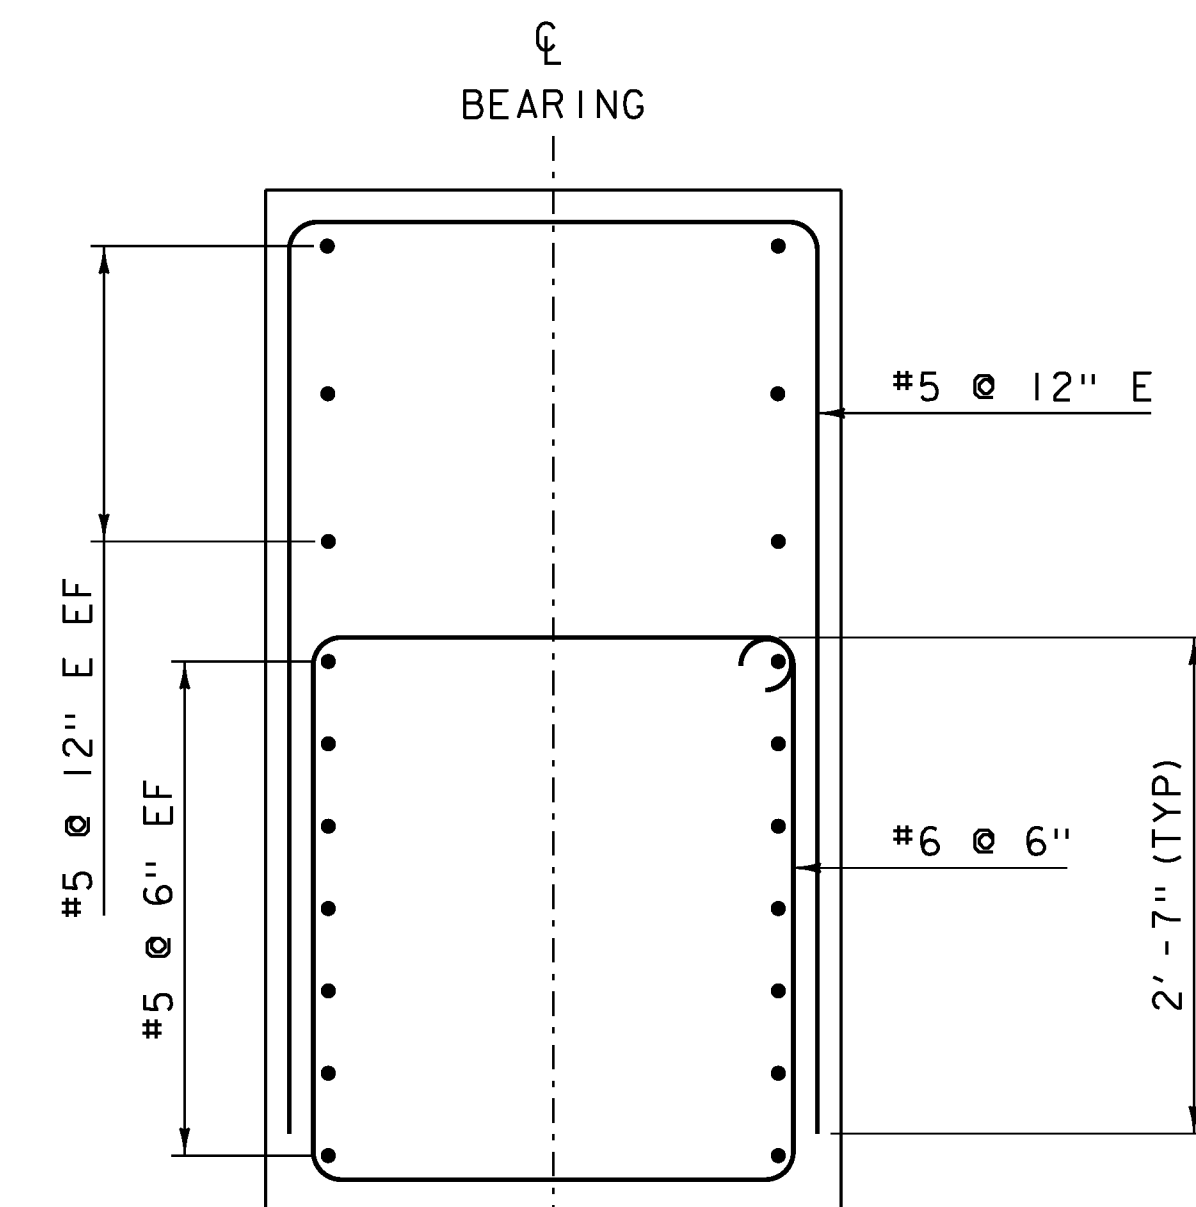


SECTION B-B

SCALE 1" = 1'-0"

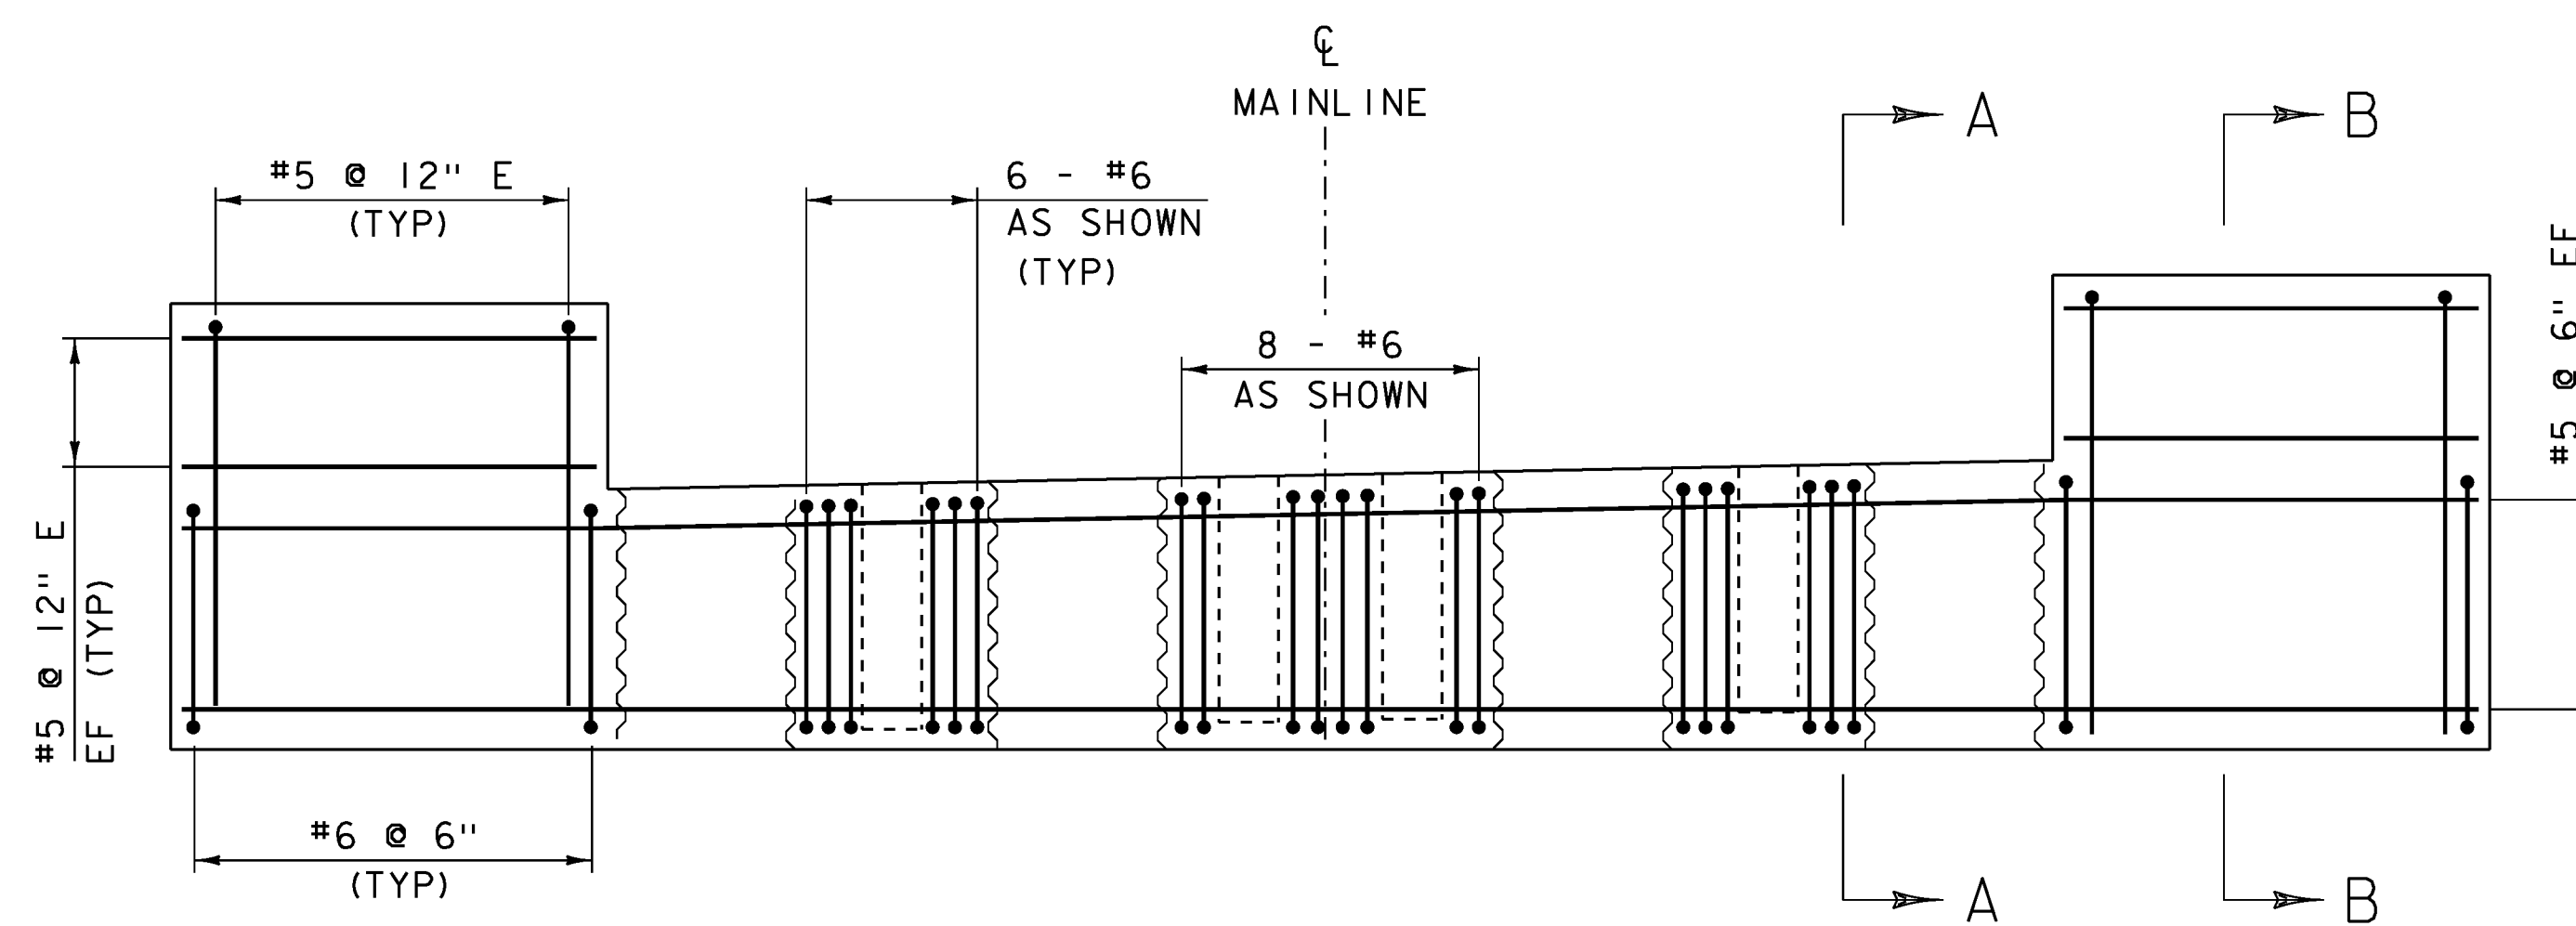

ABUTMENT REINFORCING ELEVATION (PCU)

SCALE 1/2" = 1'-0"

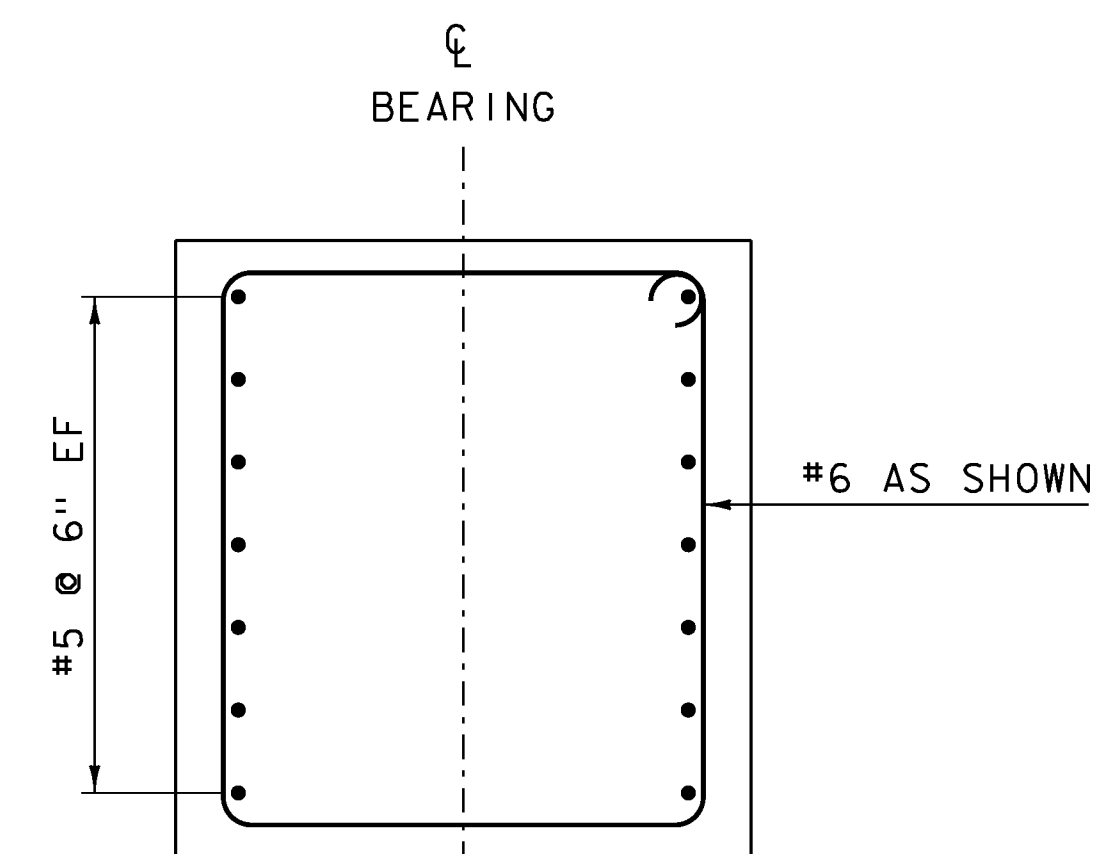

SECTION A-A

SCALE 1" = 1'-0"

NOTES:

- 1) PCU 1 SHOWN, PCU 2 SIMILAR.

NOTE:

- E = LEVEL 1 (EPOXY) REINFORCING
- NF = NEAR FACE
- FF = FAR FACE
- EF = EACH FACE
- ▲ = CUT TO FIT IN FIELD
- 3" CLEAR, UNLESS OTHERWISE SPECIFIED ON THE PLANS.
- SPLICES NOT DETAILED SHALL BE DESIGNED

PROJECT NAME: FAIRFIELD	PLOT DATE: 18-AUG-2014
PROJECT NUMBER: BRO 1448 (4)	DRAWN BY: K. FRIEDLAND
FILE NAME: sl2j170sub.dgn	CHECKED BY: R. KLINEFELTER
PROJECT LEADER: R. YOUNG	SHEET 60 OF 69
DESIGNED BY: T. FILLBACH	
ABUTMENT REINFORCING	

## EPSC PLAN NARRATIVE

### 1.1 PROJECT DESCRIPTION

THIS PROJECT INVOLVES THE REMOVAL OF BRIDGE 46 IN ITS ENTIRETY. BRIDGE 46 WILL BE REPLACED WITH A NEW STRUCTURE, SPANNING 51 FEET OVER BLACK CREEK, ON NEW ABUTMENTS ALONG THE SAME ALIGNMENT. BRIDGE 46 IS LOCATED IN THE TOWN OF FAIRFIELD, ON TOWN HIGHWAY 47, APPROXIMATELY 250 FEET FROM THE INTERSECTION OF VT ROUTE 36 AND TOWN HIGHWAY 47.

NOTE: AREA OF DISTURBANCE INCLUDES LIMITS OF EARTH DISTURBANCE WITHIN THE PROJECT AREA, AS WELL AS WASTE, BORROW AND STAGING AREAS, AND OTHER EARTH DISTURBING ACTIVITIES WITHIN OR DIRECTLY ADJACENT TO THE PROJECT LIMITS AS SHOWN ON THE ATTACHED EPSC PLAN.

TOTAL AREA OF DISTURBANCE AS SHOWN ON THE ATTACHED EPSC PLAN IS APPROXIMATELY 0.27 ACRES.

IT IS ANTICIPATED THAT THIS PROJECT WILL LAST ONE CONSTRUCTION SEASON.

### 1.2 SITE INVENTORY

#### 1.2.1 TOPOGRAPHY

THE TOPOGRAPHY OF THE AREA IS A FLOODPLAIN AND WETLANDS THAT IS BUFFER FARMLAND WITH FOREST UPSLOPE. TOWN HIGHWAY 47 IS THE ONLY ROADWAY WITHIN THE PROJECT SITE, VT ROUTE 36 IS NOT WITHIN THE PROJECT SITE, BUT IS NEARBY. THERE ARE NO RESIDENCES NEAR THE PROJECT.

#### 1.2.2 DRAINAGE, WATERWAYS, BODIES OF WATER, AND PROXIMITY TO NATURAL OR MAN-MADE WATER FEATURES

BLACK CREEK IS THE ONLY WATER SOURCE ON THE PROJECT SITE. THE CREEK IS CLASSIFIED AS SINUOUS, AND ALLUVIAL WITH AN INCISED CHANNEL AT THE SITE. THE STREAM BED CONSISTS OF CLAY AND SILT. THE TRIBUTARY AREA AT THE BRIDGE CROSSING IS 39.2 MILES². DUE TO THE NATURE OF THE SURROUNDING TERRAIN THE PROJECT SITE COULD RECEIVE RUNOFF WATER FROM A FEW NEARBY SLOPES. THERE IS AN OLD RAIL BRIDGE JUST UPSTREAM THAT IS PART OF A RAIL-TRAIL.

#### 1.2.3 VEGETATION

THE VEGETATION IN THE PROJECT AREA CONSISTS OF SCRUB TREES, UNDERGROWTH, AND WHATEVER CROP HAS BEEN PLANTED. THE IMPACT TO VEGETATION WILL BE LIMITED TO THAT WHICH IS DIRECTLY AFFECTED BY REPLACEMENT OF THE EXISTING BRIDGE. UPON PROJECT COMPLETION, THE CHANNEL WILL BE ARMORED WITH STONE FILL TYPE III AS SPECIFIED ON THE PLANS. DISTURBED VEGETATION WILL BE REESTABLISHED WITH STANDARD SEED AND MULCH PRACTICES.

#### 1.2.4 SOILS

ALL SOIL DATA CAME FROM THE U.S. DEPARTMENT OF AGRICULTURE SOIL CONSERVATION SERVICE FOR THE COUNTY OF FRANKLIN, VERMONT. SOIL ON THE PROJECT SITE IS PODUNK VARIANT SILT LOAM, 0% TO 2% SLOPES, "K FACTOR" = 0.32. THE SOIL IS CONSIDERED NOT HIGHLY ERODIBLE.

**NOTE:** K-VALUES GENERALLY INDICATE THE FOLLOWING:

0.0-0.23 = LOW EROSION POTENTIAL

0.24-0.36 = MODERATE EROSION POTENTIAL

0.37 AND HIGHER = HIGH EROSION POTENTIAL

#### 1.2.5 SENSITIVE RESOURCE AREAS

CRITICAL HABITATS: NO

HISTORICAL OR ARCHEOLOGICAL AREAS: NO

PRIME AGRICULTURAL LAND: YES, TO THE EAST OF THE STRUCTURE

THREATENED AND ENDANGERED SPECIES: NO

WATER RESOURCE: BLACK CREEK

WETLANDS: YES, MOST OF THE SURROUNDING AREA IS WETLANDS.

### 1.3 RISK EVALUATION

THIS PROJECT DOES NOT FALL UNDER THE JURISDICTION OF GENERAL PERMIT 3-9020 FOR STORMWATER RUNOFF FROM CONSTRUCTION SITES. SHOULD CHANGES PRIOR TO OR DURING CONSTRUCTION RESULT IN ONE OR MORE ACRES OF EARTH DISTURBANCE OR SHOULD THE PROJECT BECOME PART OF A LARGER PLAN OF DEVELOPMENT, THE CONTRACTOR WILL BE RESPONSIBLE FOR ANY ADDITIONAL PERMITTING.

### 1.4 EROSION PREVENTION AND SEDIMENT CONTROL

THE EROSION CONTROL PLANS ARE MEANT AS A GUIDELINE FOR PREVENTING EROSION AND CONTROLLING SEDIMENT TRANSPORT. THE PRINCIPLES OUTLINED IN THIS NARRATIVE CONSIST OF APPLYING MEASURES THROUGHOUT CONSTRUCTION OF THE PROJECT IN ORDER TO MINIMIZE SEDIMENT TRANSPORT TO THE RECEIVING WATERS. THE MEASURES INCLUDE STABILIZATION AND STRUCTURAL PRACTICES, STORM WATER CONTROLS AND OTHER POLLUTION PREVENTION PRACTICES. THEY HAVE BEEN PROPOSED BY THE DESIGNER AS A BASIS FOR PROTECTING RESOURCES AND WILL NEED TO BE BUILT UPON BASED ON THE SPECIFIC MEANS AND METHODS OF THE CONTRACTOR. REFER TO THE LOW RISK SITE HANDBOOK AND APPROPRIATE DETAIL SHEETS FOR SPECIFIC GUIDANCE AND CONSTRUCTION DETAILING.

ALL MEASURES SHALL BE REGULARLY MAINTAINED AND SHALL BE CHECKED FOR SEDIMENT BUILD-UP. SEDIMENT SHALL BE DISPOSED OF AT AN APPROVED SITE WHERE IT WILL NOT BE SUBJECT TO EROSION.

#### 1.4.1 MARK SITE BOUNDARIES

SITE BOUNDARIES AND AREAS CONSTRUCTION EQUIPMENT CAN ACCESS SHALL BE DELINEATED.

PROJECT DEMARCATION FENCING (PDF) SHALL BE USED TO PHYSICALLY MARK SITE BOUNDARIES, BARRIER FENCE SHALL BE USED INSTEAD OF PROJECT DEMARCATION FENCE WITHIN 100 FEET OF A WATER RESOURCE (STREAM, BROOK, LAKE, POND, WETLAND, ETC).

#### 1.4.2 LIMIT DISTURBANCE AREA

PREVENTING INITIAL SOIL EROSION BY MINIMIZING THE EXPOSED AREA IS MUCH MORE EFFECTIVE THAN TREATING ERODED SEDIMENT. EARTH DISTURBANCE CAN BE MINIMIZED THROUGH CONSTRUCTION PHASING BY ONLY OPENING UP EARTH AS NECESSARY. THIS CAN LIMIT THE AREA THAT WILL BE DISTURBED AND EXPOSED TO EROSION. EMPLOY TEMPORARY CONSTRUCTION STABILIZATION PRACTICES IN INCREMENTAL STAGES AS PHASES CHANGE. FOR PROJECTS WHICH FALL UNDER THE CONSTRUCTION GENERAL PERMIT, ONLY THE ACREAGE LISTED ON THE PERMIT AUTHORIZATION MAY BE EXPOSED AT ANY GIVEN TIME.

MAINTAINING VEGETATED BUFFERS ALONG STREAM BANKS, WETLANDS OR OTHER SENSITIVE AREAS IS A CRUCIAL EROSION AND SEDIMENT CONTROL MEASURE THAT SHOULD BE ESTABLISHED WHEREVER POSSIBLE.

#### 1.4.3 SITE ENTRANCE/EXIT STABILIZATION

TRACKING OF SEDIMENT ONTO PUBLIC HIGHWAYS SHALL BE MINIMIZED TO REDUCE THE POTENTIAL FOR RUNOFF ENTERING RECEIVING WATERS. INSTALLATION SHALL COINCIDE WITH THE CONTRACTORS PROGRESS SCHEDULE.

STABILIZED CONSTRUCTION ENTRANCES SHALL BE INSTALLED AS PROPOSED ON THE EPSC PLAN AND ANYWHERE EQUIPMENT WILL BE GOING FROM AREAS OF EXPOSED SOILS TO PAVED SURFACES.

#### 1.4.4 INSTALL SEDIMENT BARRIERS

SEDIMENT BARRIERS SHALL BE UTILIZED TO INTERCEPT RUNOFF AND ALLOW SUSPENDED SEDIMENT TO SETTLE OUT. THEY SHALL BE INSTALLED PRIOR TO ANY UP SLOPE WORK.

FILTER CURTAIN SHALL BE INSTALLED AS PROPOSED ON THE EPSC PLANS PRIOR TO ANY CHANNEL WORK.

SILT FENCE WILL BE INSTALLED AS PROPOSED ON THE EPSC PLAN, WOVEN WIRE REINFORCED SILT FENCE SHALL BE USED INSTEAD OF SILT FENCE WITHIN 100 FEET UPSLOPE OF RECEIVING WATERS.

#### 1.4.5 DIVERT UPLAND RUNOFF

DIVERSIONARY MEASURES SHALL BE USED TO INTERCEPT RUNOFF FROM ABOVE THE CONSTRUCTION AND DIRECT IT AROUND THE DISTURBED AREA SO THAT CLEAN WATER DOES NOT BECOME MUDDIED WHILE TRAVELING OVER EXPOSED SOILS ON THE CONSTRUCTION SITE.

THE PROJECT AREA IS RELATIVELY FLAT. THEREFORE IT IS NOT ANTICIPATED THAT DIVERSION MEASURES WILL BE NECESSARY.

#### 1.4.6 SLOW DOWN CHANNELIZED RUNOFF

CHECK STRUCTURES SHALL BE UTILIZED TO REDUCE THE VELOCITY, AND THUS THE EROSION POTENTIAL, OF CONCENTRATED FLOW IN CHANNELS.

THE USE OF STONE CHECK DAMS IS NOT ANTICIPATED FOR THIS PROJECT.

#### 1.4.7 CONSTRUCT PERMANENT CONTROLS

PERMANENT STORMWATER TREATMENT DEVICES SHALL BE INSTALLED AS SHOWN ON THE PLANS AND IN ACCORDANCE WITH PERMIT CONDITIONS.

#### 1.4.8 STABILIZE EXPOSED SOILS DURING CONSTRUCTION

ALL AREAS OF DISTURBANCE MUST HAVE TEMPORARY STABILIZATION IN PLACE WITHIN 48 HOURS OF DISTURBANCE OR IN ACCORDANCE WITH THE CONSTRUCTION GENERAL PERMIT 3-9020 AUTHORIZATION.

SURFACE ROUGHENING OF ALL EXPOSED SLOPES, COMBINED WITH TEMPORARY MULCHING, SHALL BE UTILIZED ON A REGULAR BASIS. BIODEGRADABLE EROSION CONTROL MATTING OR AN EQUIVALENT SHALL BE USED TO STABILIZE ALL SLOPES STEEPER THAN 1:3.

THE FORECAST OF RAINFALL EVENTS SHALL TRIGGER IMMEDIATE PROTECTION OF EXPOSED SOILS.

#### 1.4.9 WINTER STABILIZATION

VARIOUS MEASURES SPECIFIC TO WINTER MAY BE NECESSARY SHOULD THE PROJECT EXTEND INTO WINTER (OCTOBER 15 THROUGH APRIL 15). REFER TO THE LOW RISK SITE HANDBOOK FOR GUIDANCE.

#### 1.4.10 STABILIZE SOIL AT FINAL GRADE

EXPOSED SOIL MUST BE STABILIZED WITHIN 48 HOURS OF REACHING FINAL GRADE.

SEED, MULCH, FERTILIZER AND LIME SHALL BE USED TO ESTABLISH PERMANENT VEGETATION. FOR SLOPES STEEPER THAN 1:3, BIODEGRADABLE EROSION CONTROL MATTING OR AN EQUIVALENT SHALL BE USED INSTEAD OF MULCH.

#### 1.4.11 DE-WATERING ACTIVITIES

DISCHARGE FROM DEWATERING ACTIVITIES THAT FLOWS OFF OF THE CONSTRUCTION SITE MUST NOT CAUSE OR CONTRIBUTE TO A VIOLATION OF THE VERMONT WATER QUALITY STANDARDS.

TREATMENT OF DEWATERING COFFERDAM IS NOT ANTICIPATED.

#### 1.4.12 INSPECT YOUR SITE

INSPECT THE PROJECT SITE BASED ON SPECIAL PROVISION REQUIREMENTS OR CONSTRUCTION GENERAL PERMIT AUTHORIZATION STIPULATIONS.

### 1.5 SEQUENCE AND STAGING

THIS SECTION WILL BE DEVELOPED BY THE CONTRACTOR USING THE GUIDANCE OUTLINED IN THE VTRANS EPSC PLAN CONTRACTOR CHECKLIST.

#### 1.5.1 CONSTRUCTION SEQUENCE

#### 1.5.2 OFF-SITE ACTIVITIES



IN ADDITION TO THE CONTRACTOR CHECKLIST ANY ACTIVITIES OUTSIDE THE CONSTRUCTION LIMITS SHALL FOLLOW SPECIFICATION 105.25- 105.29 OF THE STANDARD SPECIFICATIONS FOR CONSTRUCTION.

#### 1.5.3 UPDATES

PROJECT NAME: FAIRFIELD  
PROJECT NUMBER: BRO 1448(41)

FILE NAME: sl2j170erodetail.dgn  
PROJECT LEADER: R. YOUNG  
DESIGNED BY: R. KLINEFELTER  
EPSC NARRATIVE

PLOT DATE: 18-AUG-2014  
DRAWN BY: K. FRIEDLAND  
CHECKED BY: J. SALVATORI  
SHEET 61 OF 69

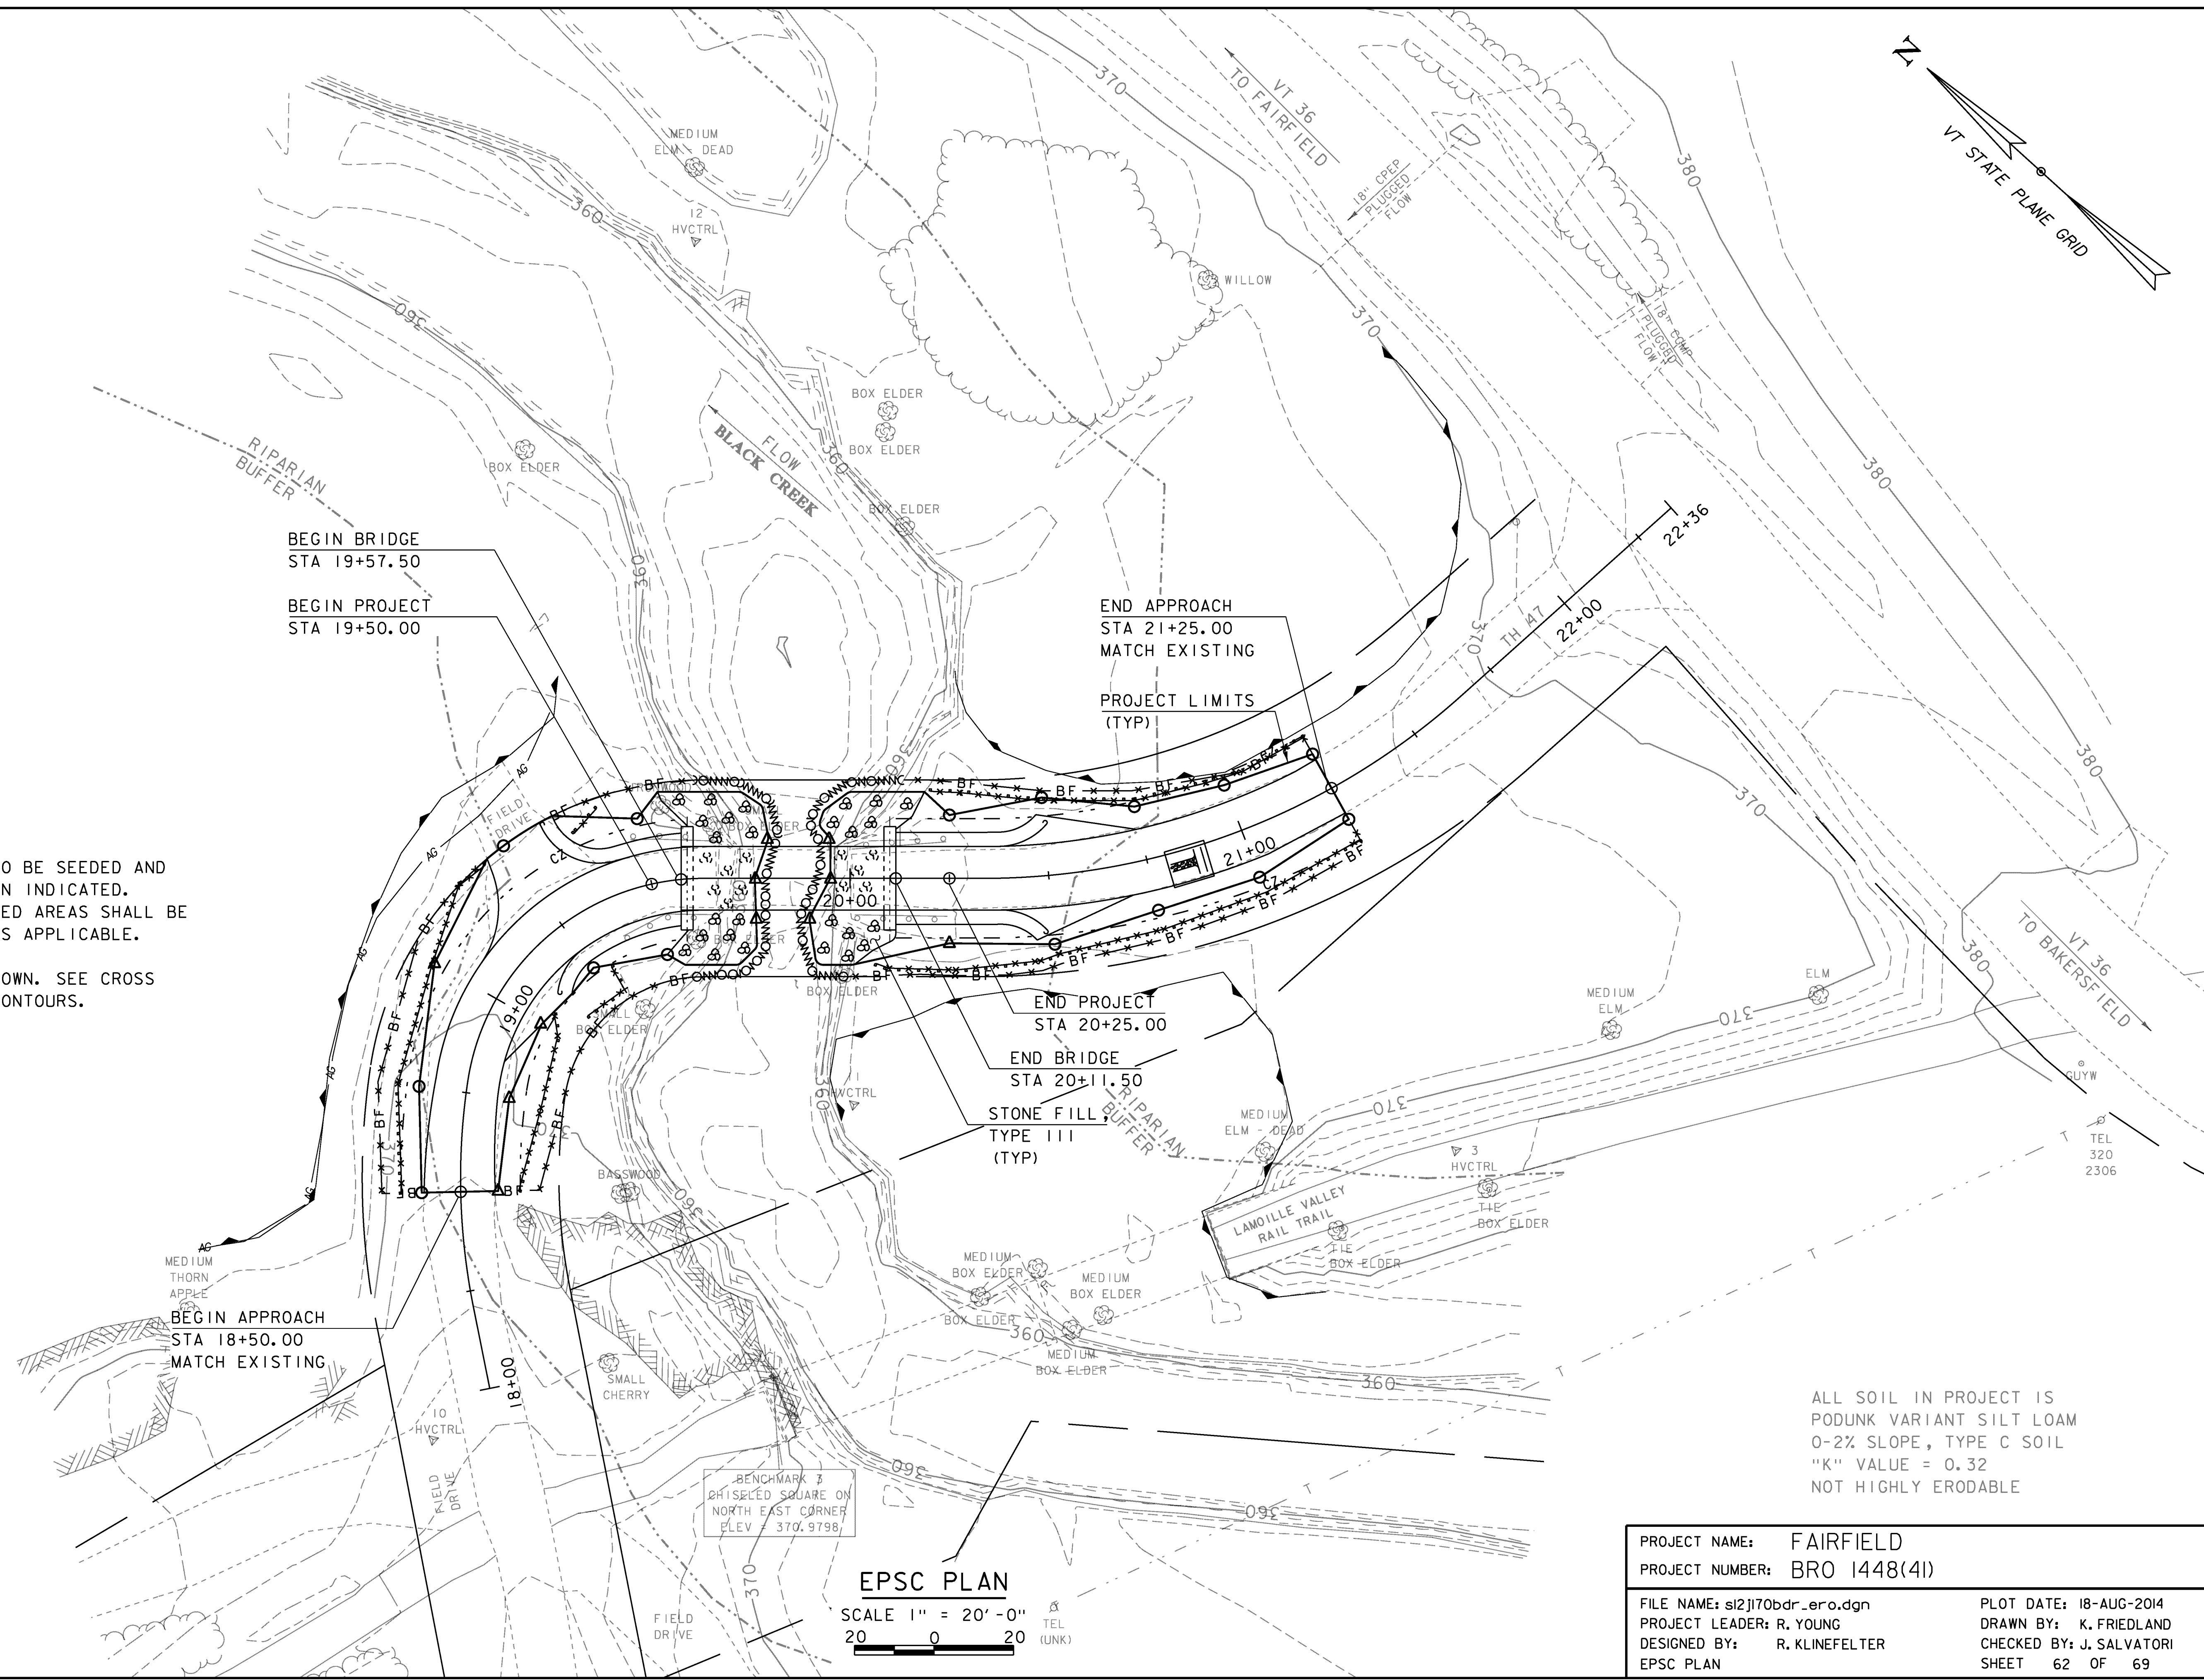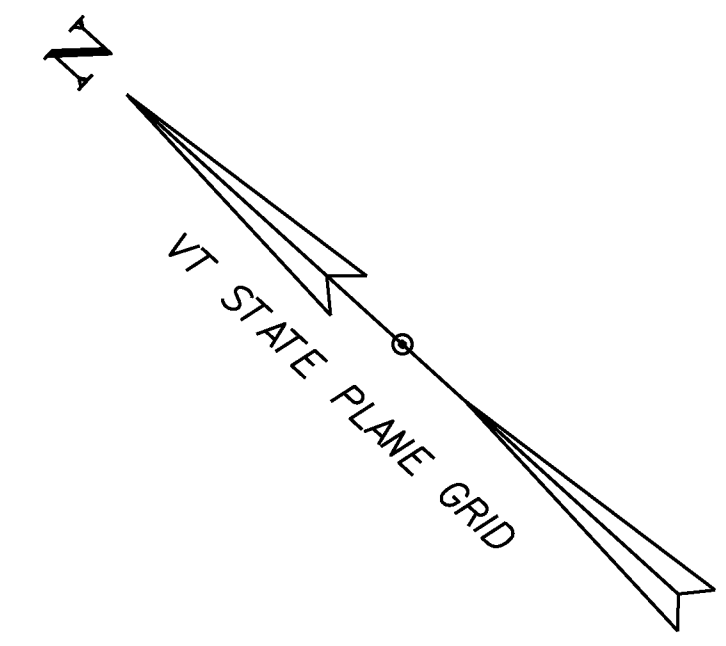

- NOTES:
1. FOR CLARITY, AREAS TO BE SEEDED AND MULCHED HAVE NOT BEEN INDICATED. HOWEVER, ALL DISTURBED AREAS SHALL BE SEEDED AND MULCHED AS APPLICABLE.
  2. EXISTING CONTOURS SHOWN. SEE CROSS SECTIONS FOR FINAL CONTOURS.

ALL SOIL IN PROJECT IS  
 PODUNK VARIANT SILT LOAM  
 0-2% SLOPE, TYPE C SOIL  
 "K" VALUE = 0.32  
 NOT HIGHLY ERODABLE

**EPSC PLAN**  
 SCALE 1" = 20'-0"  
 20 0 20

PROJECT NAME:	FAIRFIELD	PLOT DATE:	18-AUG-2014
PROJECT NUMBER:	BRO 1448(41)	DRAWN BY:	K. FRIEDLAND
FILE NAME:	sl2j170bdr_ero.dgn	CHECKED BY:	J. SALVATORI
PROJECT LEADER:	R. YOUNG	DESIGNED BY:	R. KLINEFELTER
EPSC PLAN			SHEET 62 OF 69

**SYMBOL**  
NOT TO SCALE

**CONSTRUCTION SPECIFICATIONS**

- APPLY TO SLOPES GREATER THAN 3H:1V OR WHERE NECESSARY TO AID IN ESTABLISHING VEGETATION.
- APPLY FERTILIZER, LIME SEED PRIOR TO PLACING MATTING.
- STAPLES ARE TO BE PLACED ALTERNATELY, IN COLUMNS APPROXIMATELY 2' APART AND IN ROWS APPROXIMATELY 3' APART. APPROXIMATELY 175 STAPLES ARE REQUIRED PER 4'x225' ROLL OF MATERIAL AND 125 STAPLES ARE REQUIRED PER 4'x150' ROLL OF MATERIAL.
- DISTURBED AREAS SHALL BE SMOOTHLY GRADED. EROSION CONTROL MATERIAL SHALL BE PLACED LOOSELY OVER GROUND SURFACE. DO NOT STRETCH.
- ALL TERMINAL ENDS AND TRANSVERSE LAPS SHALL BE STAPLED AT APPROXIMATELY 12" INTERVALS.

ADAPTED FROM DETAILS PROVIDED BY: NEW YORK STATE DEC  
ORIGINALLY DEVELOPED BY USDA-NRCS  
VERMONT DEPARTMENT OF ENVIRONMENTAL CONSERVATION

**ROLLED EROSION CONTROL PRODUCT (RECP) SIDE SLOPE**

NOTES:  
REFER TO "THE VERMONT STANDARDS & SPECIFICATIONS FOR EROSION PREVENTION & SEDIMENT CONTROL -2006- "FROM THE VT AGENCY OF NATURAL RESOURCES FOR ADDITIONAL GUIDANCE.  
THIS WORK SHALL BE PERFORMED IN ACCORDANCE WITH SECTION 653 AND AS SHOWN IN THE PLANS FOR TEMPORARY EROSION MATTING (PAY ITEM 653.20) OR PERMANENT EROSION MATTING (PAY ITEM 653.21).

REVISIONS	
APRIL 16, 2007	JWF
JANUARY 13, 2009	WHF

**SYMBOL**  
NOT TO SCALE

**CONSTRUCTION SPECIFICATIONS**

- FILTER CURTAIN SHALL NOT BE PLACED ACROSS A FLOWING WATERWAY, OR IN A WATERWAY WITH STREAM VELOCITIES GREATER THAN 1.5 FEET/SECOND.
- MAXIMUM 100' LENGTH BETWEEN ANCHORS.
- LAST SECTION SHALL TERMINATE A MINIMUM OF 10' BEYOND LIMIT OF DISTURBANCE.
- THE WEIGHTED ANCHOR SYSTEM SHALL BE A TYPE WHICH ALLOWS THE CURTAIN TO CONFORM TO THE BOTTOM OF THE WATERWAY.
- THE CURTAIN SHALL BE REMOVED BY SLOWLY PULLING TOWARD THE SHORE MINIMIZING THE ESCAPE OF SEDIMENTS INTO WATERWAY.

ADAPTED FROM DETAILS PROVIDED BY: NEW YORK STATE DEC  
ORIGINALLY DEVELOPED BY USDA-NRCS  
VERMONT DEPARTMENT OF ENVIRONMENTAL CONSERVATION

**FILTER CURTAIN**

NOTES:  
REFER TO "THE VERMONT STANDARDS & SPECIFICATIONS FOR EROSION PREVENTION & SEDIMENT CONTROL -2006- "FROM THE VT AGENCY OF NATURAL RESOURCES FOR ADDITIONAL GUIDANCE.

REVISIONS	
APRIL 1, 2008	WHF
JANUARY 13, 2009	WHF
SEPTEMBER 4, 2009	WHF

THIS WORK SHALL BE PERFORMED IN ACCORDANCE WITH SECTION 649 FOR GEOTEXTILE FOR FILTER CURTAIN (PAY ITEM 649.6).

**SYMBOL**  
NOT TO SCALE

**CONSTRUCTION SPECIFICATIONS**

- WOVEN WIRE REINFORCED FENCE IS REQUIRED WITHIN 100' UPSLOPE OF RECEIVING WATERS WHEN THE PROJECT FALLS UNDER A CONSTRUCTION STORMWATER PERMIT. WOVEN WIRE SHALL BE A MIN. 14 GAUGE WITH A 6" MAX. MESH OPENING.
- FILTER CLOTH SHALL BE EITHER FILTER X, MIRAF1100X, STABILINKA T140N OR APPROVED EQUIVALENT.
- POST SPACING FOR WIRE-BACKED FENCE SHALL BE 10' MAXIMUM. FOR FILTER-CLOTH FENCE, WHEN ELONGATION IS >50%, POST SPACING SHALL NOT EXCEED 4' AND WHEN ELONGATION IS <50%, POST SPACING SHALL NOT EXCEED 6'.
- WOVEN WIRE FENCE IS TO BE FASTENED SECURELY TO FENCE POSTS WITH WIRE TIES. FILTER CLOTH IS TO BE FASTENED SECURELY TO WOVEN WIRE FENCE WITH TIES SPACED EVERY 24" AT TOP AND MID SECTION.
- WHEN TWO SECTIONS OF FILTER CLOTH ADJOIN EACH OTHER THEY SHALL BE OVER-LAPPED BY 6" AND FOLDED.
- MAINTENANCE SHALL BE PERFORMED AS NEEDED AND MATERIAL REMOVED WHEN SEDIMENT REACHES HALF OF FABRIC HEIGHT.

ADAPTED FROM DETAILS PROVIDED BY: NEW YORK STATE DEC  
ORIGINALLY DEVELOPED BY USDA-NRCS  
VERMONT DEPARTMENT OF ENVIRONMENTAL CONSERVATION

**SILT FENCE**

NOTES:  
REFER TO "THE VERMONT STANDARDS & SPECIFICATIONS FOR EROSION PREVENTION & SEDIMENT CONTROL -2006- "FROM THE VT AGENCY OF NATURAL RESOURCES FOR ADDITIONAL GUIDANCE.

REVISIONS	
MARCH 21, 2008	WHF
DECEMBER 11, 2008	WHF
JANUARY 13, 2009	WHF

THIS WORK SHALL BE PERFORMED IN ACCORDANCE WITH SECTION 649 AND AS SHOWN IN THE PLANS FOR GEOTEXTILE FOR SILT FENCE (PAY ITEM 649.5) OR GEOTEXTILE FOR SILT FENCE, WOVEN WIRE REINFORCED (PAY ITEM 649.515).

**SYMBOL**  
NOT TO SCALE

**CONSTRUCTION SPECIFICATIONS**

- STONE SIZE- USE 1-4" STONE, RECLAIMED OR RECYCLED CONCRETE EQUIVALENT.
- LENGTH- NOT LESS THAN 50' (EXCEPT ON A SINGLE RESIDENCE LOT WHERE A 30' MINIMUM LENGTH APPLIES).
- THICKNESS- NOT LESS THAN 8".
- WIDTH- 12' MINIMUM, BUT NOT LESS THAN THE FULL WIDTH AT POINTS WHERE INGRESS OR EGRESS OCCURS. 24' IF SINGLE ENTRANCE TO SITE.
- GEOTEXTILE MUST BE PLACED OVER THE ENTIRE AREA PRIOR TO PLACING STONE.
- SURFACE WATER- ALL SURFACE WATER FLOWING OR DIVERTED TOWARD CONSTRUCTION ENTRANCES SHALL BE PIPED BENEATH THE ENTRANCE. IF PIPING IS IMPRACTICAL, A MOUNTABLE BERM WITH 5:1 SLOPES WILL BE PERMITTED.
- MAINTENANCE- THE ENTRANCE SHALL BE MAINTAINED IN A CONDITION WHICH WILL PREVENT TRACKING OR FLOWING OF SEDIMENT ONTO PUBLIC RIGHTS-OF-WAY, ALL SEDIMENT SPILLED, DROPPED, WASHED OR TRACKED ONTO PUBLIC RIGHTS-OF-WAY MUST BE REMOVED IMMEDIATELY.
- WHEN WASHING IS REQUIRED, IT SHALL BE DONE ON AN AREA STABILIZED WITH STONE AND WHICH DRAINS INTO AN APPROVED SEDIMENT TRAPPING DEVICE.
- PERIODIC INSPECTION AND NEEDED MAINTENANCE SHALL BE PROVIDED ACCORDING TO PERMIT REQUIREMENTS.

ADAPTED FROM DETAILS PROVIDED BY: NEW YORK STATE DEC  
ORIGINALLY DEVELOPED BY USDA-NRCS  
VERMONT DEPARTMENT OF ENVIRONMENTAL CONSERVATION

**SURFACE ROUGHENING**

NOTES:  
REFER TO "THE VERMONT STANDARDS & SPECIFICATIONS FOR EROSION PREVENTION & SEDIMENT CONTROL -2006- "FROM THE VT AGENCY OF NATURAL RESOURCES FOR ADDITIONAL GUIDANCE.  
THIS WORK SHALL BE CONSIDERED INCIDENTAL TO THE CONTRACT

REVISIONS	
APRIL 1, 2008	WHF
JANUARY 13, 2009	WHF

**SYMBOL**  
NOT TO SCALE

**CONSTRUCTION SPECIFICATIONS**

- STONE SIZE- USE 1-4" STONE, RECLAIMED OR RECYCLED CONCRETE EQUIVALENT.
- LENGTH- NOT LESS THAN 50' (EXCEPT ON A SINGLE RESIDENCE LOT WHERE A 30' MINIMUM LENGTH APPLIES).
- THICKNESS- NOT LESS THAN 8".
- WIDTH- 12' MINIMUM, BUT NOT LESS THAN THE FULL WIDTH AT POINTS WHERE INGRESS OR EGRESS OCCURS. 24' IF SINGLE ENTRANCE TO SITE.
- GEOTEXTILE MUST BE PLACED OVER THE ENTIRE AREA PRIOR TO PLACING STONE.
- SURFACE WATER- ALL SURFACE WATER FLOWING OR DIVERTED TOWARD CONSTRUCTION ENTRANCES SHALL BE PIPED BENEATH THE ENTRANCE. IF PIPING IS IMPRACTICAL, A MOUNTABLE BERM WITH 5:1 SLOPES WILL BE PERMITTED.
- MAINTENANCE- THE ENTRANCE SHALL BE MAINTAINED IN A CONDITION WHICH WILL PREVENT TRACKING OR FLOWING OF SEDIMENT ONTO PUBLIC RIGHTS-OF-WAY, ALL SEDIMENT SPILLED, DROPPED, WASHED OR TRACKED ONTO PUBLIC RIGHTS-OF-WAY MUST BE REMOVED IMMEDIATELY.
- WHEN WASHING IS REQUIRED, IT SHALL BE DONE ON AN AREA STABILIZED WITH STONE AND WHICH DRAINS INTO AN APPROVED SEDIMENT TRAPPING DEVICE.
- PERIODIC INSPECTION AND NEEDED MAINTENANCE SHALL BE PROVIDED ACCORDING TO PERMIT REQUIREMENTS.

ADAPTED FROM DETAILS PROVIDED BY: NEW YORK STATE DEC  
ORIGINALLY DEVELOPED BY USDA-NRCS  
VERMONT DEPARTMENT OF ENVIRONMENTAL CONSERVATION

**STABILIZED CONSTRUCTION ENTRANCE**

NOTES:  
REFER TO "THE VERMONT STANDARDS & SPECIFICATIONS FOR EROSION PREVENTION & SEDIMENT CONTROL -2006- "FROM THE VT AGENCY OF NATURAL RESOURCES FOR ADDITIONAL GUIDANCE.  
THIS WORK SHALL BE PERFORMED IN ACCORDANCE WITH SECTION 653 FOR VEHICLE TRACKING PAD (PAY ITEM 653.35) OR AS SPECIFIED IN THE CONTRACT.

REVISIONS	
MARCH 24, 2008	WHF
JANUARY 13, 2009	WHF

VAOT RURAL AREA MIX					
% WEIGHT	BROADCAST	HYDROSEED	NAME	GERM %	PURITY %
37.5%	22.5	45	68 CREEPING RED FESCUE	85%	98%
37.5%	22.5	45	16 TALL FESCUE	90%	95%
5.0%	3	6	6 RED TOP	90%	95%
15.0%	9	18	18 BIRDSFOOT TREFOIL	85%	98%
5.0%	3	6	6 ANNUAL RYE GRASS	85%	95%
100%	60	120			

VAOT URBAN AREA MIX					
% WEIGHT	BROADCAST	HYDROSEED	NAME	GERM %	PURITY %
42.5%	34	68	68 CREEPING RED FESCUE	85%	98%
10.0%	8	16	16 PERENNIAL RYE GRASS	90%	95%
42.5%	34	68	68 KENTUCKY BLUE GRASS	85%	85%
5.0%	4	8	8 ANNUAL RYE GRASS	85%	95%
100%	80	160			

SOIL AMENDMENT GUIDANCE			
FERTILIZER		LIME	
BROADCAST	HYDROSEED	BROADCAST	HYDROSEED
10-20-10	FOLLOW	PELLETIZED	FOLLOW
500 LBS/AC	MANUFACTURER	2 TONS/AC	MANUFACTURER

**CONSTRUCTION GUIDANCE**

- RURAL SEED MIX: USE AS INDICATED IN THE PLANS AND/OR FOR ALL ESTABLISHED UPLAND (NON WETLAND) AREAS DISTURBED BY THE CONTRACTOR.
- URBAN SEED MIX: USE AS INDICATED IN THE PLANS AND/OR FOR ALL ESTABLISHED LAWN AREAS DISTURBED BY THE CONTRACTOR.
- ALL SEED MIXTURES: SHALL NOT HAVE A WEED CONTENT EXCEEDING 0.40% BY WEIGHT AND SHALL BE FREE OF ALL NOXIOUS SEED.
- FERTILIZER AND LIMESTONE: SHALL FOLLOW RATES SHOWN ON PLAN OR AS DIRECTED BY THE ENGINEER.
- HAY MULCH: TO BE PLACED ON EARTH SLOPES AT THE RATE OF 2 TONS/ACRE, ACHIEVE 90% GROUND COVER OR AS DIRECTED BY THE ENGINEER.
- TOPSOIL: TO BE USED WITH SEED AS INDICATED ON THE PLANS, OR AS DIRECTED BY THE ENGINEER.
- HYDROSEEDING: ALTHOUGH GUIDANCE IS GIVEN ABOVE THE SITE CONDITIONS AND THE TYPE OF HYDROSEED WILL ULTIMATELY DICTATE THE AMOUNTS AND TYPES OF SOIL AMENDMENTS TO BE APPLIED.
- TURF ESTABLISHMENT: PLACING SEED, FERTILIZER, LIME AND MULCH PRIOR TO SEPTEMBER 15 AND AFTER APRIL 15 CAN BETTER ENSURE A VIGOROUS GROWTH OF GRASS.

ADAPTED FROM VTRANS TECHNICAL LANDSCAPE MANUAL FOR ROADWAYS AND TRANSPORTATION FACILITIES

**TURF ESTABLISHMENT**


THIS WORK SHALL BE PERFORMED IN ACCORDANCE WITH SECTION 651 FOR SEED (PAY ITEM 651.15)

REVISIONS	
JUNE 23, 2009	WHF
JANUARY 15, 2010	WHF
FEBRUARY 16, 2011	WHF


PROJECT NAME: FAIRFIELD  
PROJECT NUMBER: BRO 1448(41)

FILE NAME: sl2j170erodetails.dgn  
PROJECT LEADER: R. YOUNG  
DESIGNED BY: R. KLINEFELTER  
EPSC DETAILS


PLOT DATE: 18-AUG-2014  
DRAWN BY: K. FRIEDLAND  
CHECKED BY: J. SALVATORI  
SHEET 63 OF 69

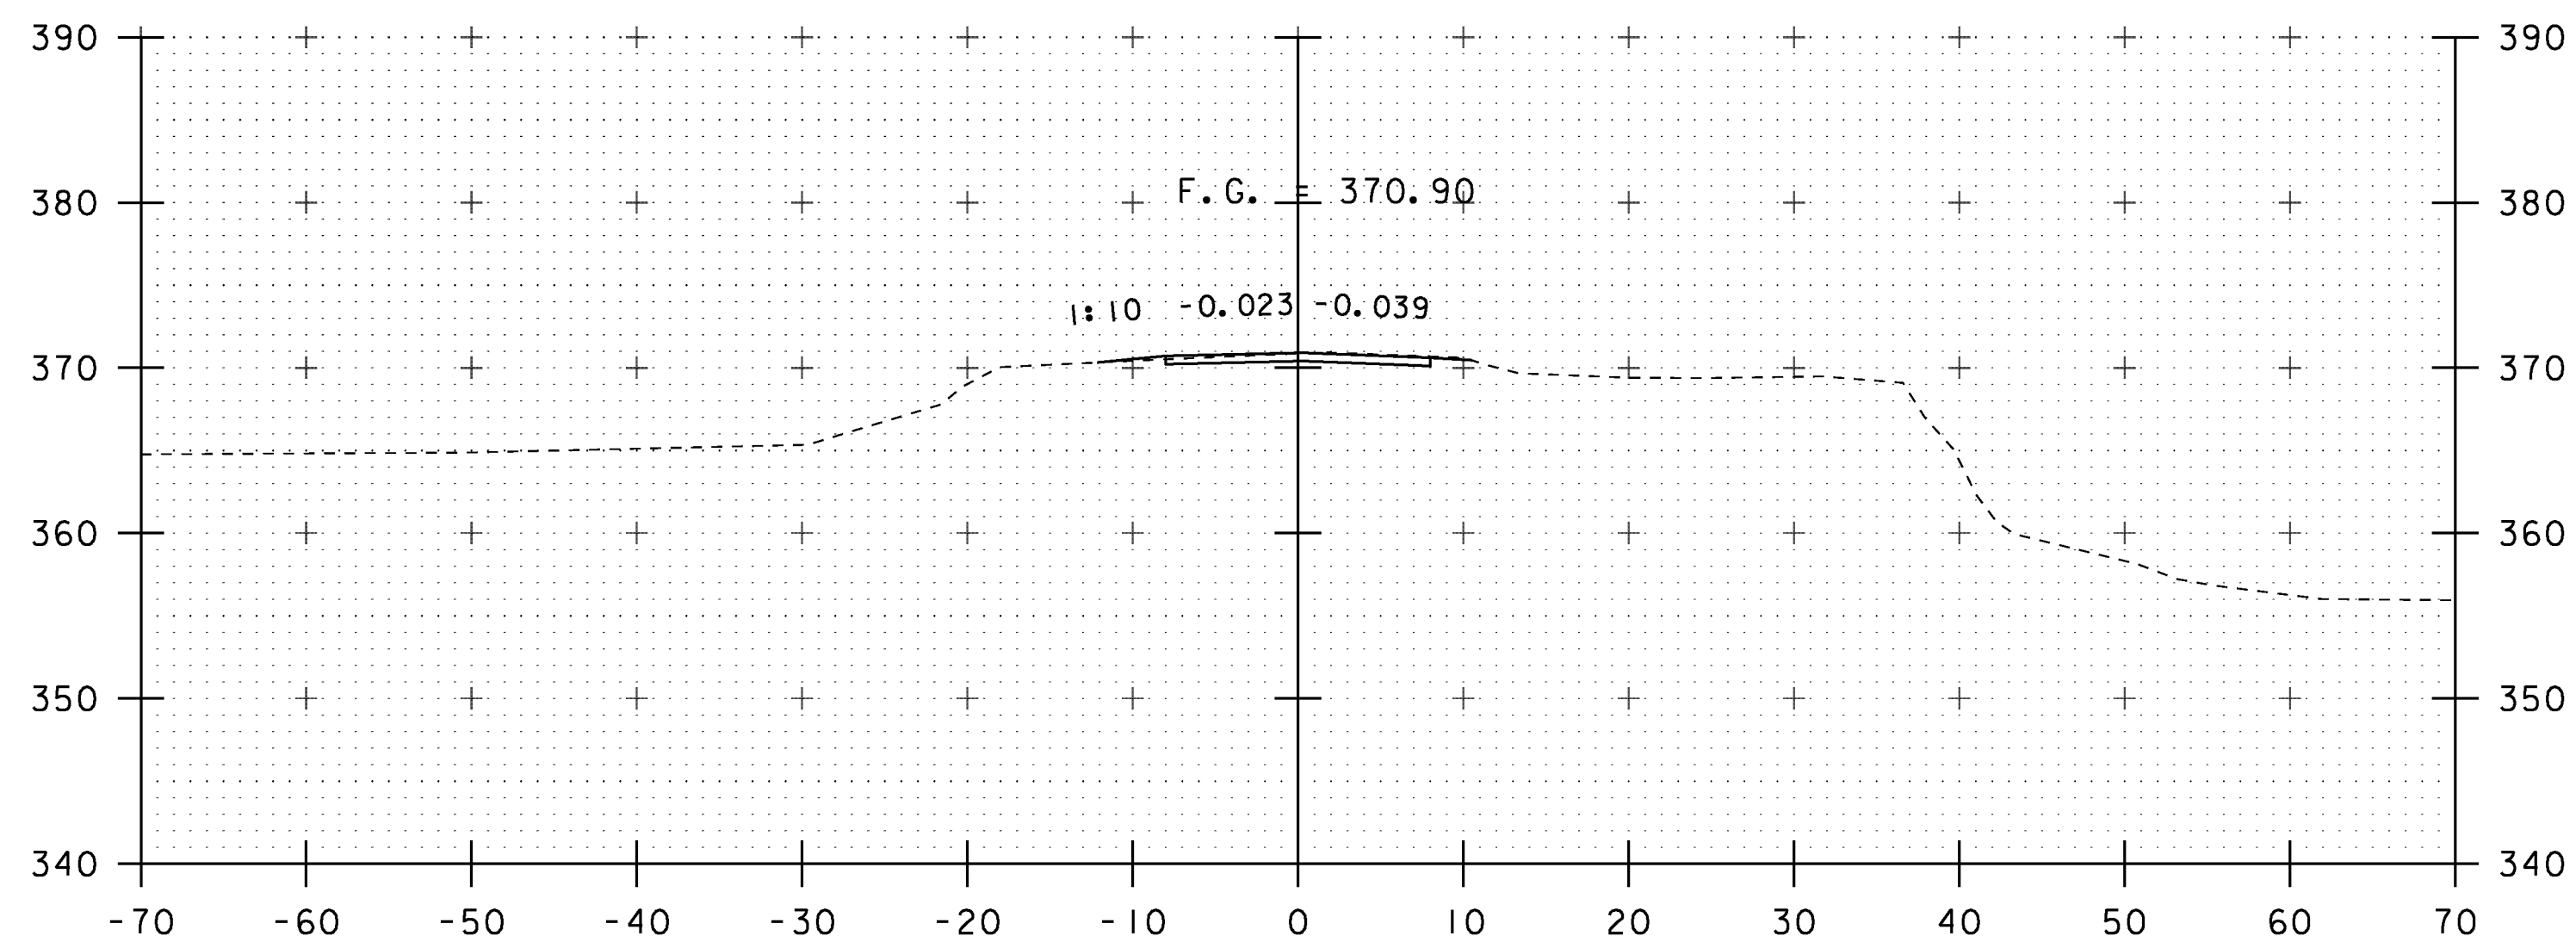


18+75

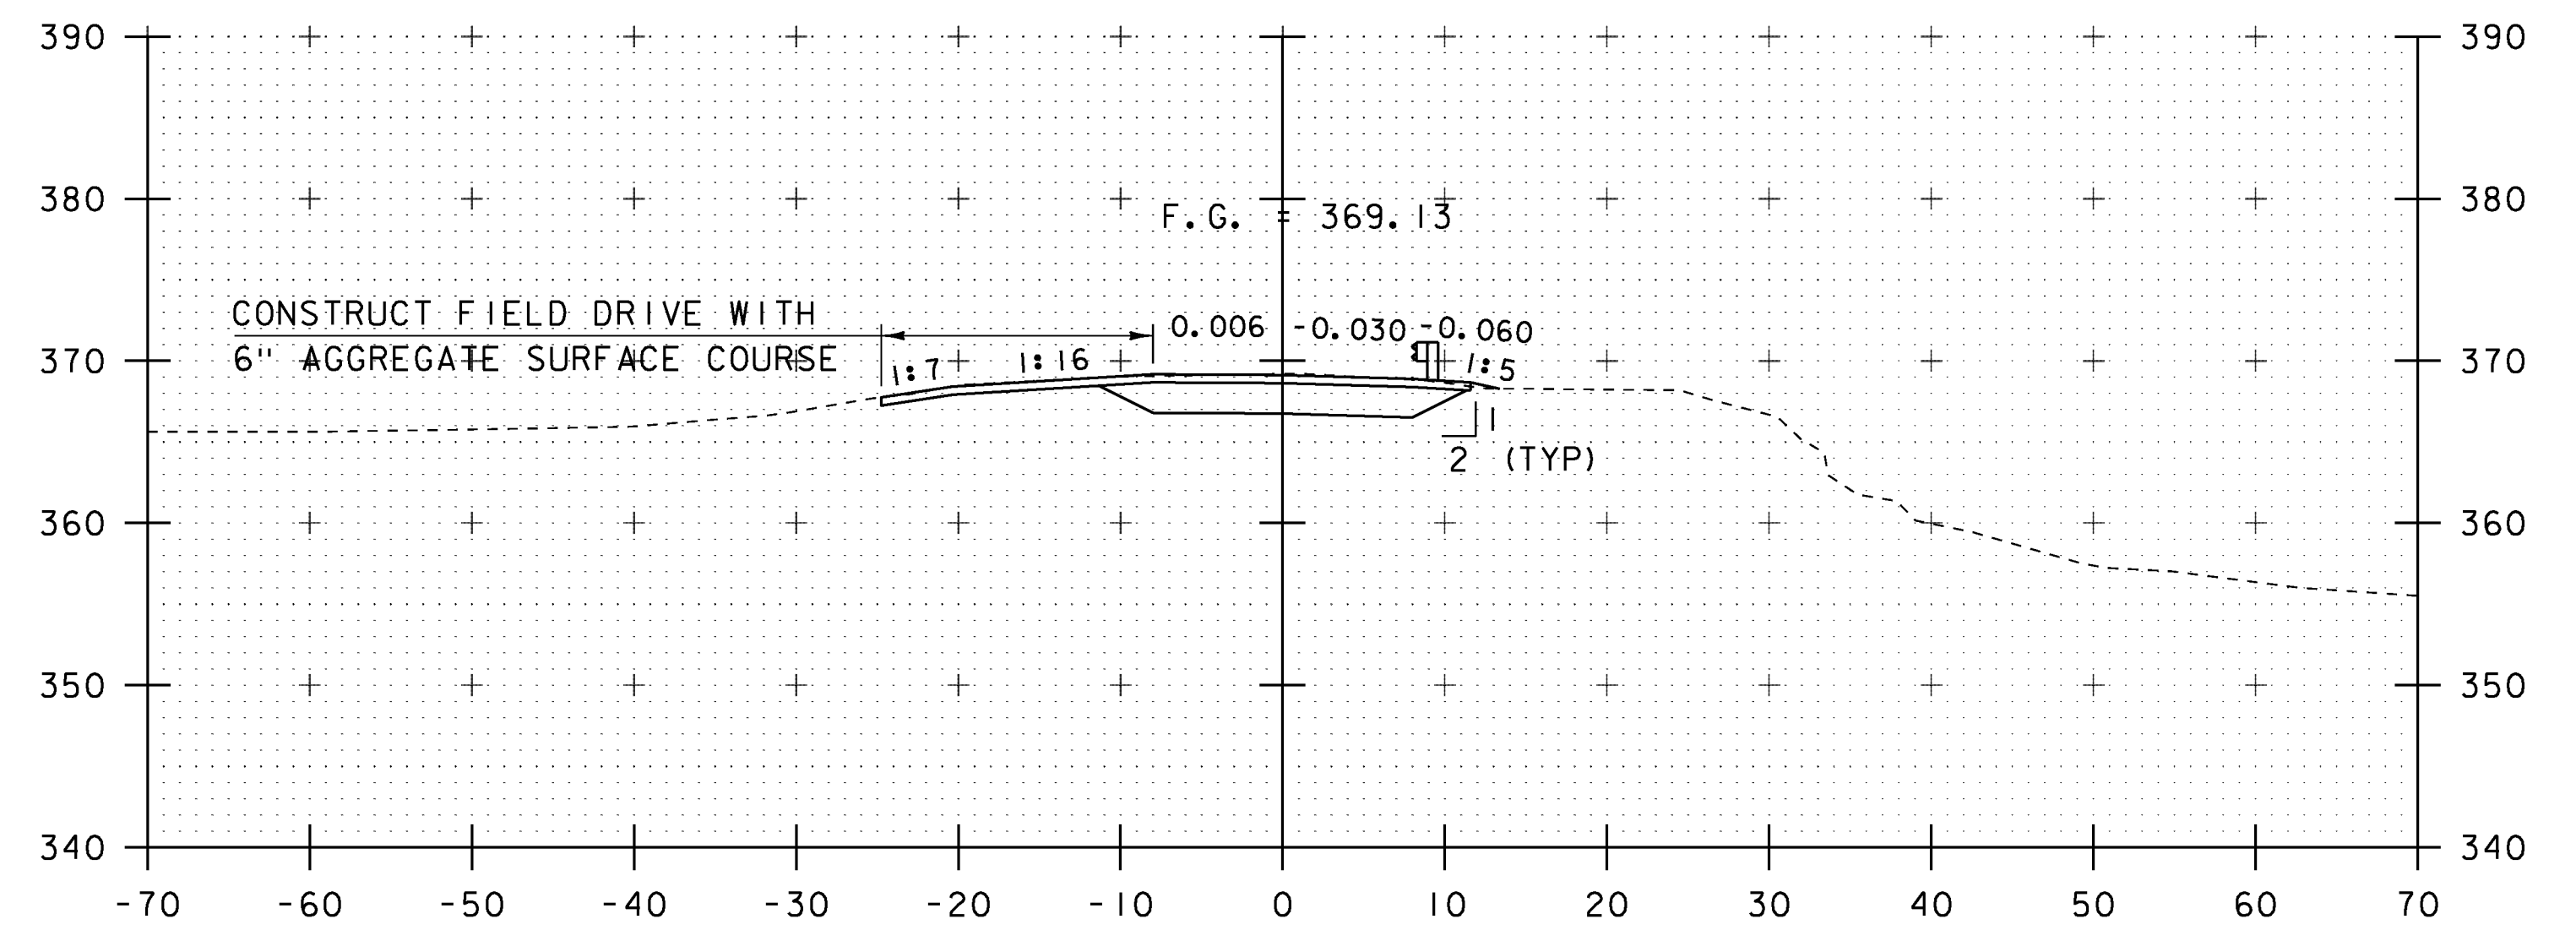

19+25

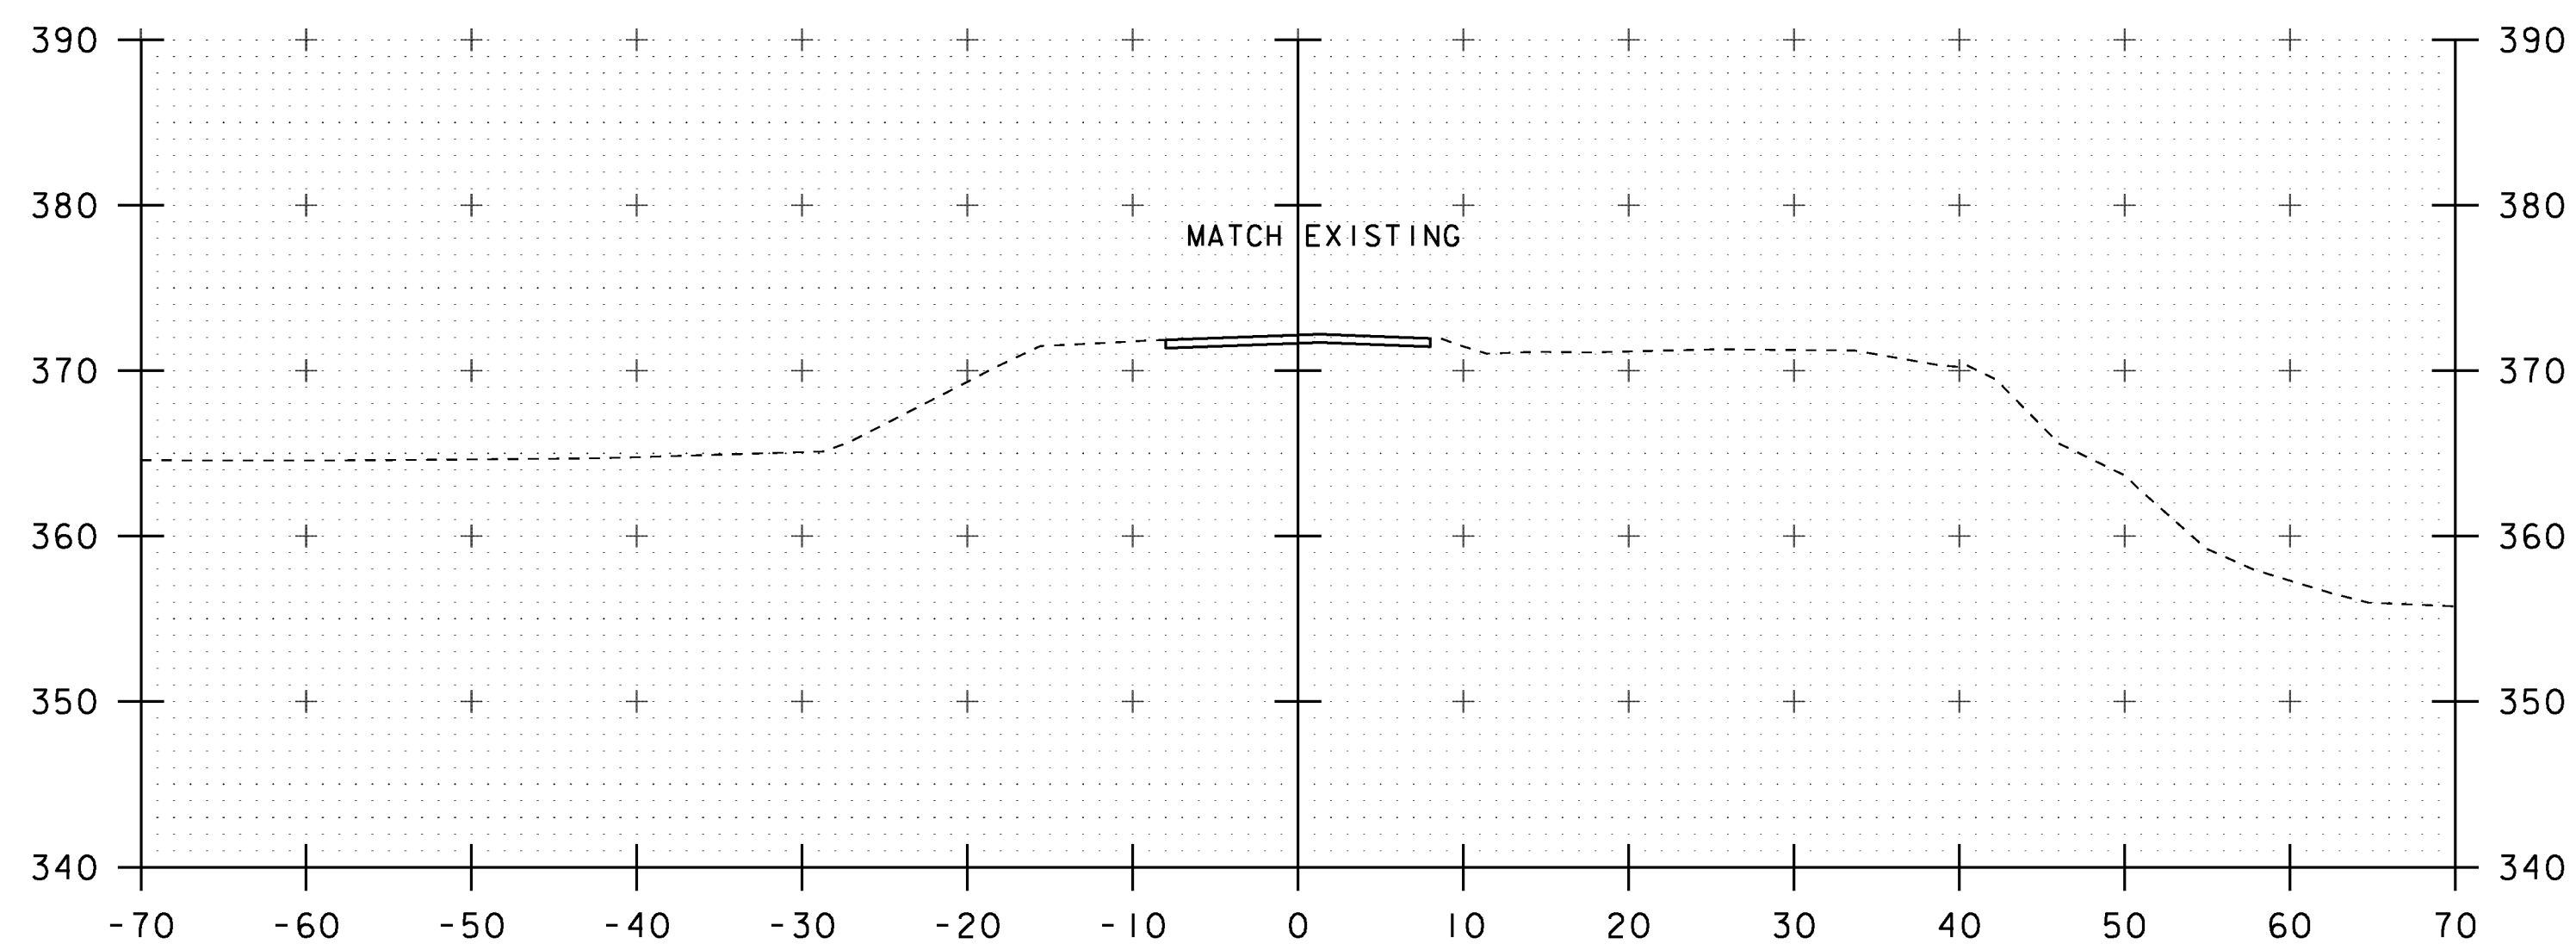


18+50  
BEGIN APPROACH

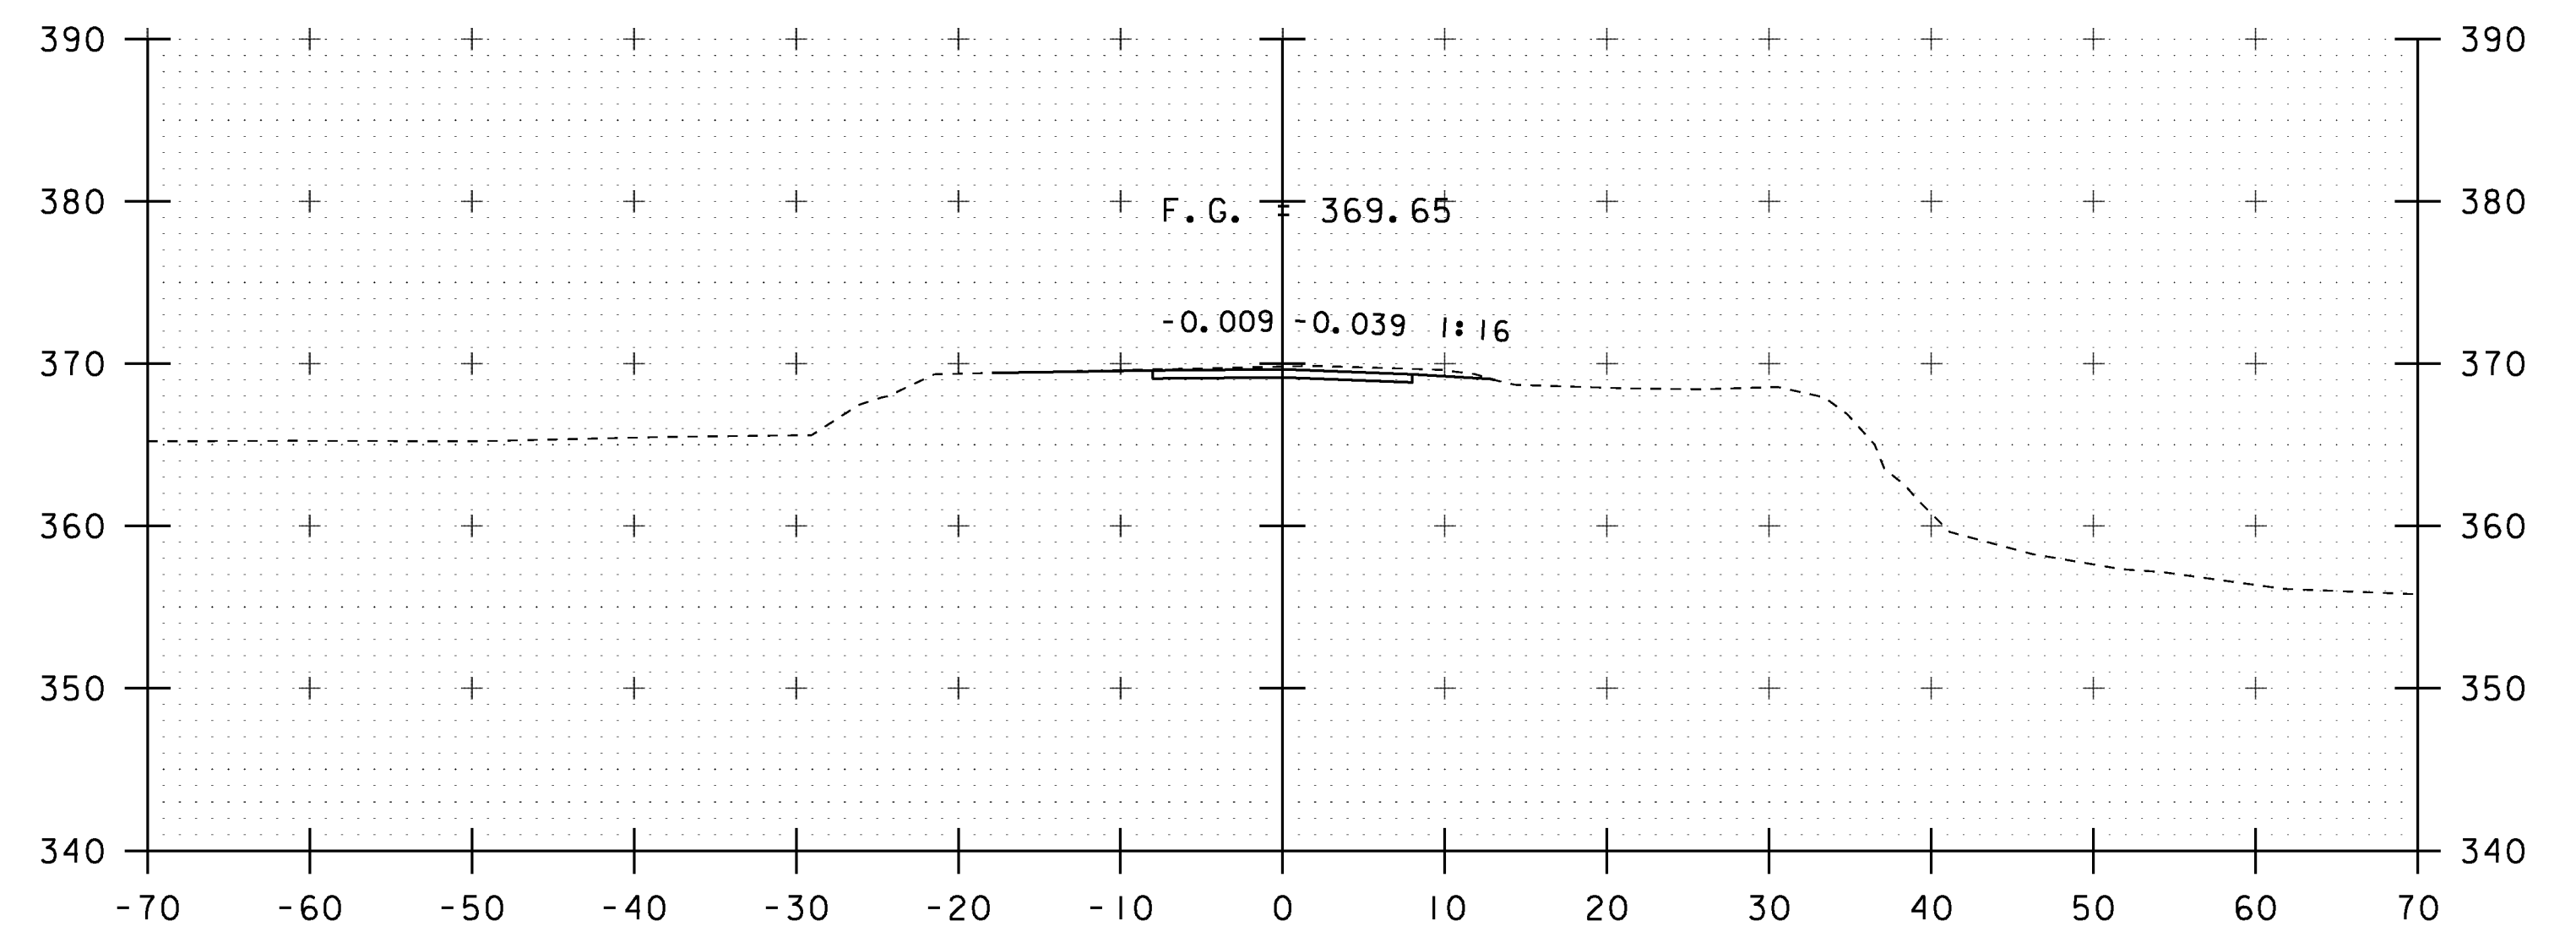


19+00

STA. 18+50 TO STA. 19+25


PROJECT NAME:	FAIRFIELD	PLOT DATE:	18-AUG-2014
PROJECT NUMBER:	BRO 1448(4)	DRAWN BY:	K. FRIEDLAND
FILE NAME:	sl2j170xs.dgn	DESIGNED BY:	R. KLINEFELTER
PROJECT LEADER:	R. YOUNG	CHECKED BY:	J. SALVATORI
MAINLINE SECTIONS		SHEET	64 OF 69

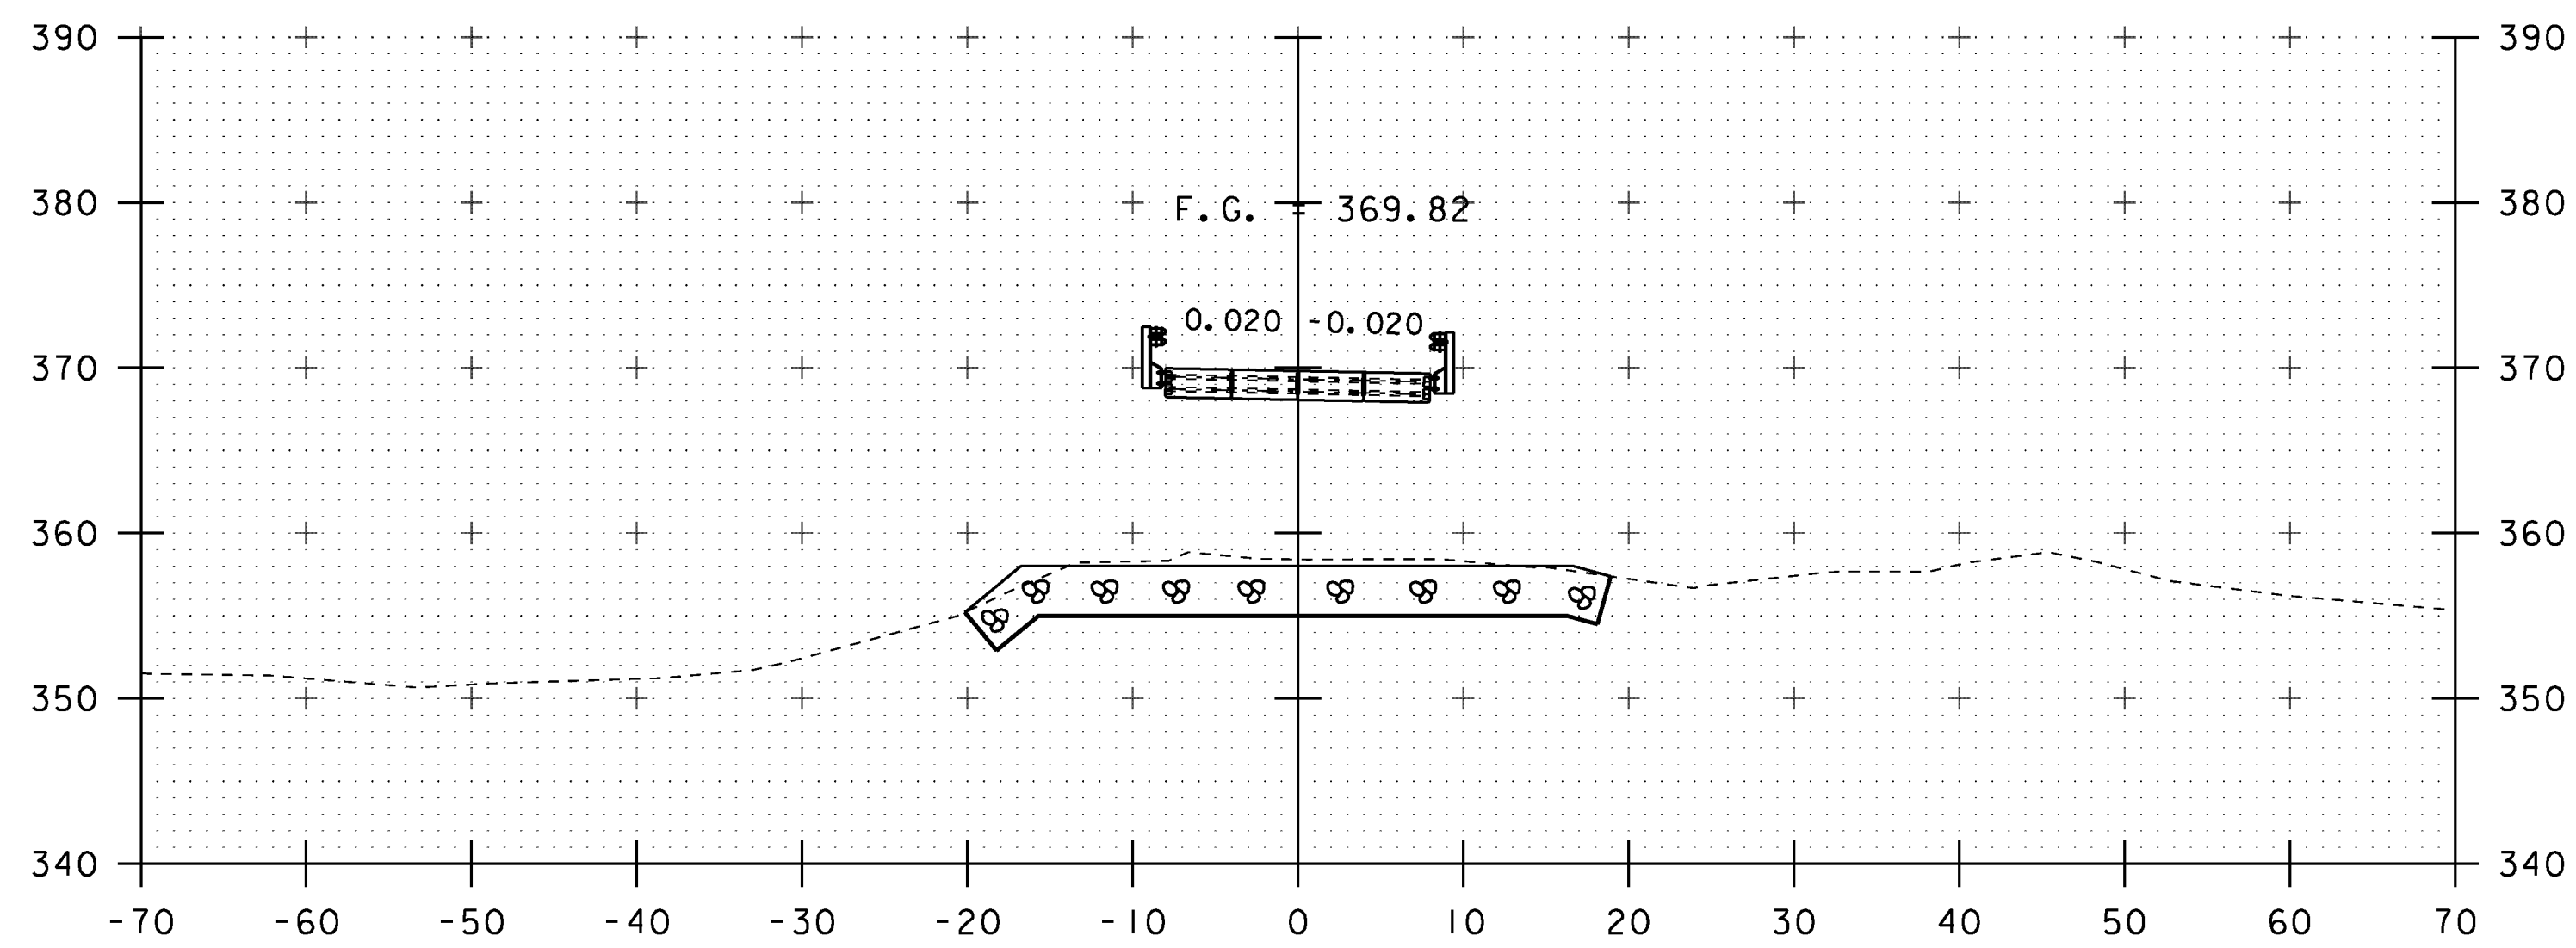


19+75

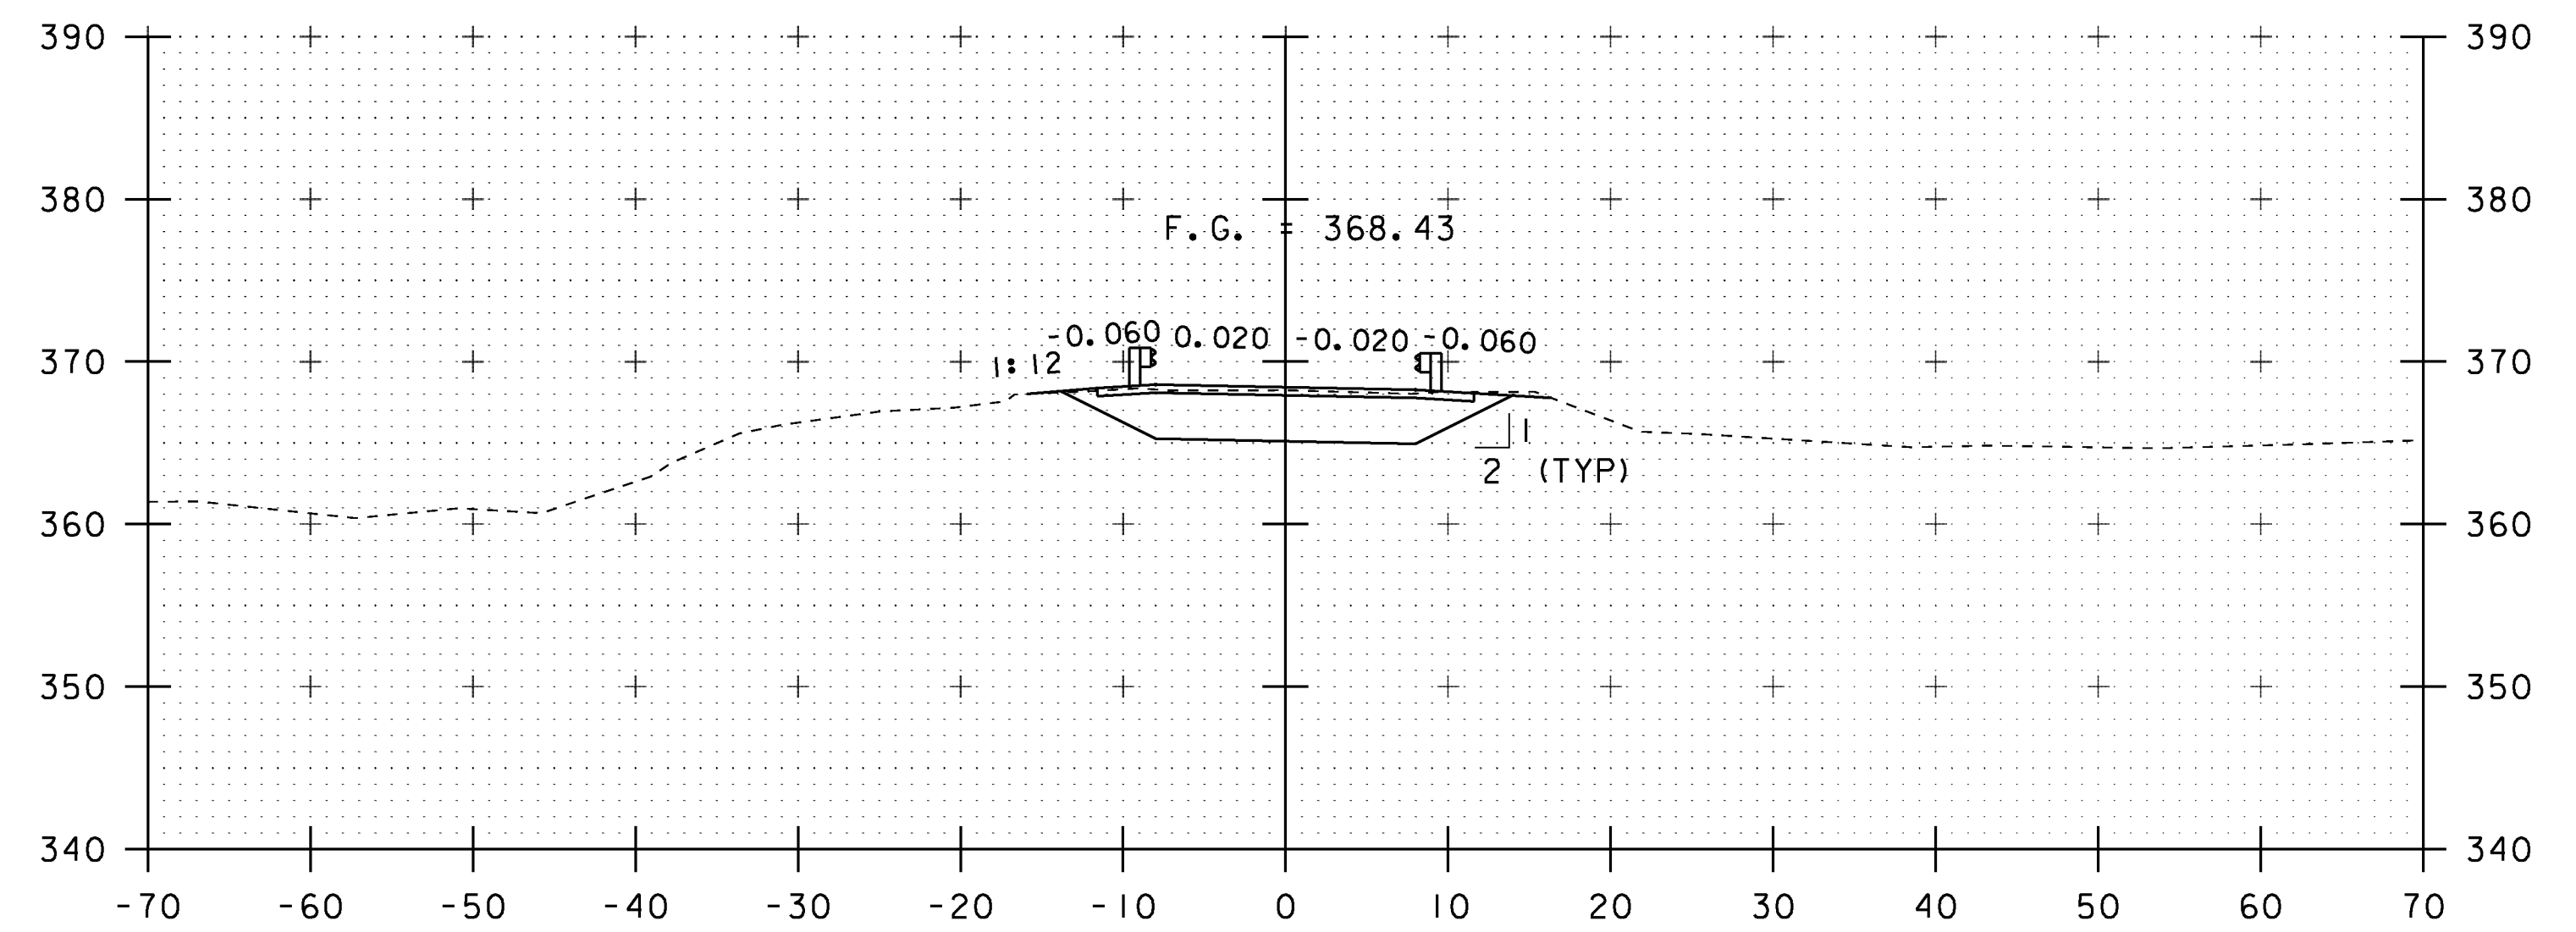

20+25  
END PROJECT

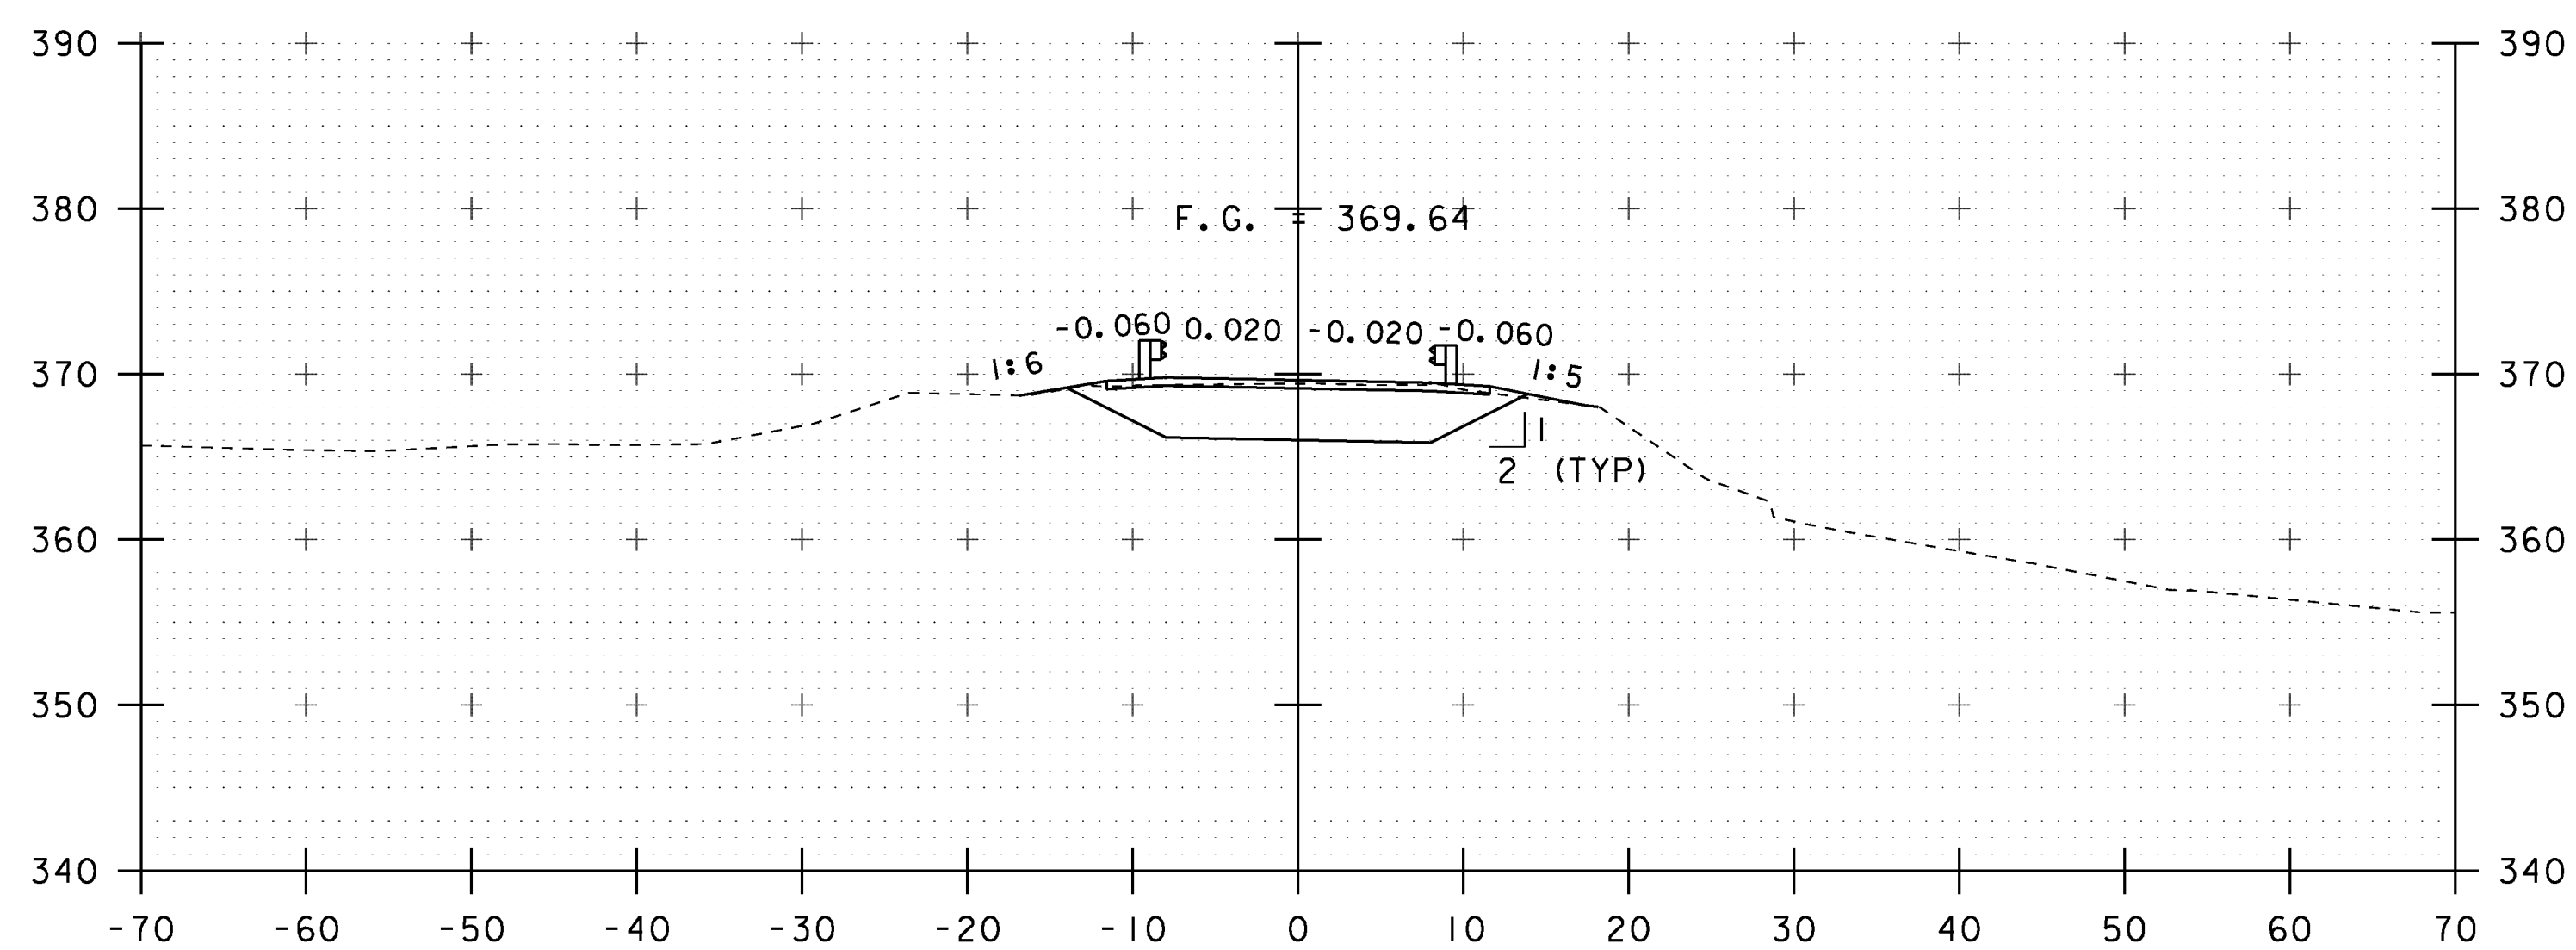


19+50  
BEGIN PROJECT  
BEGIN BRIDGE STA 19+57.50

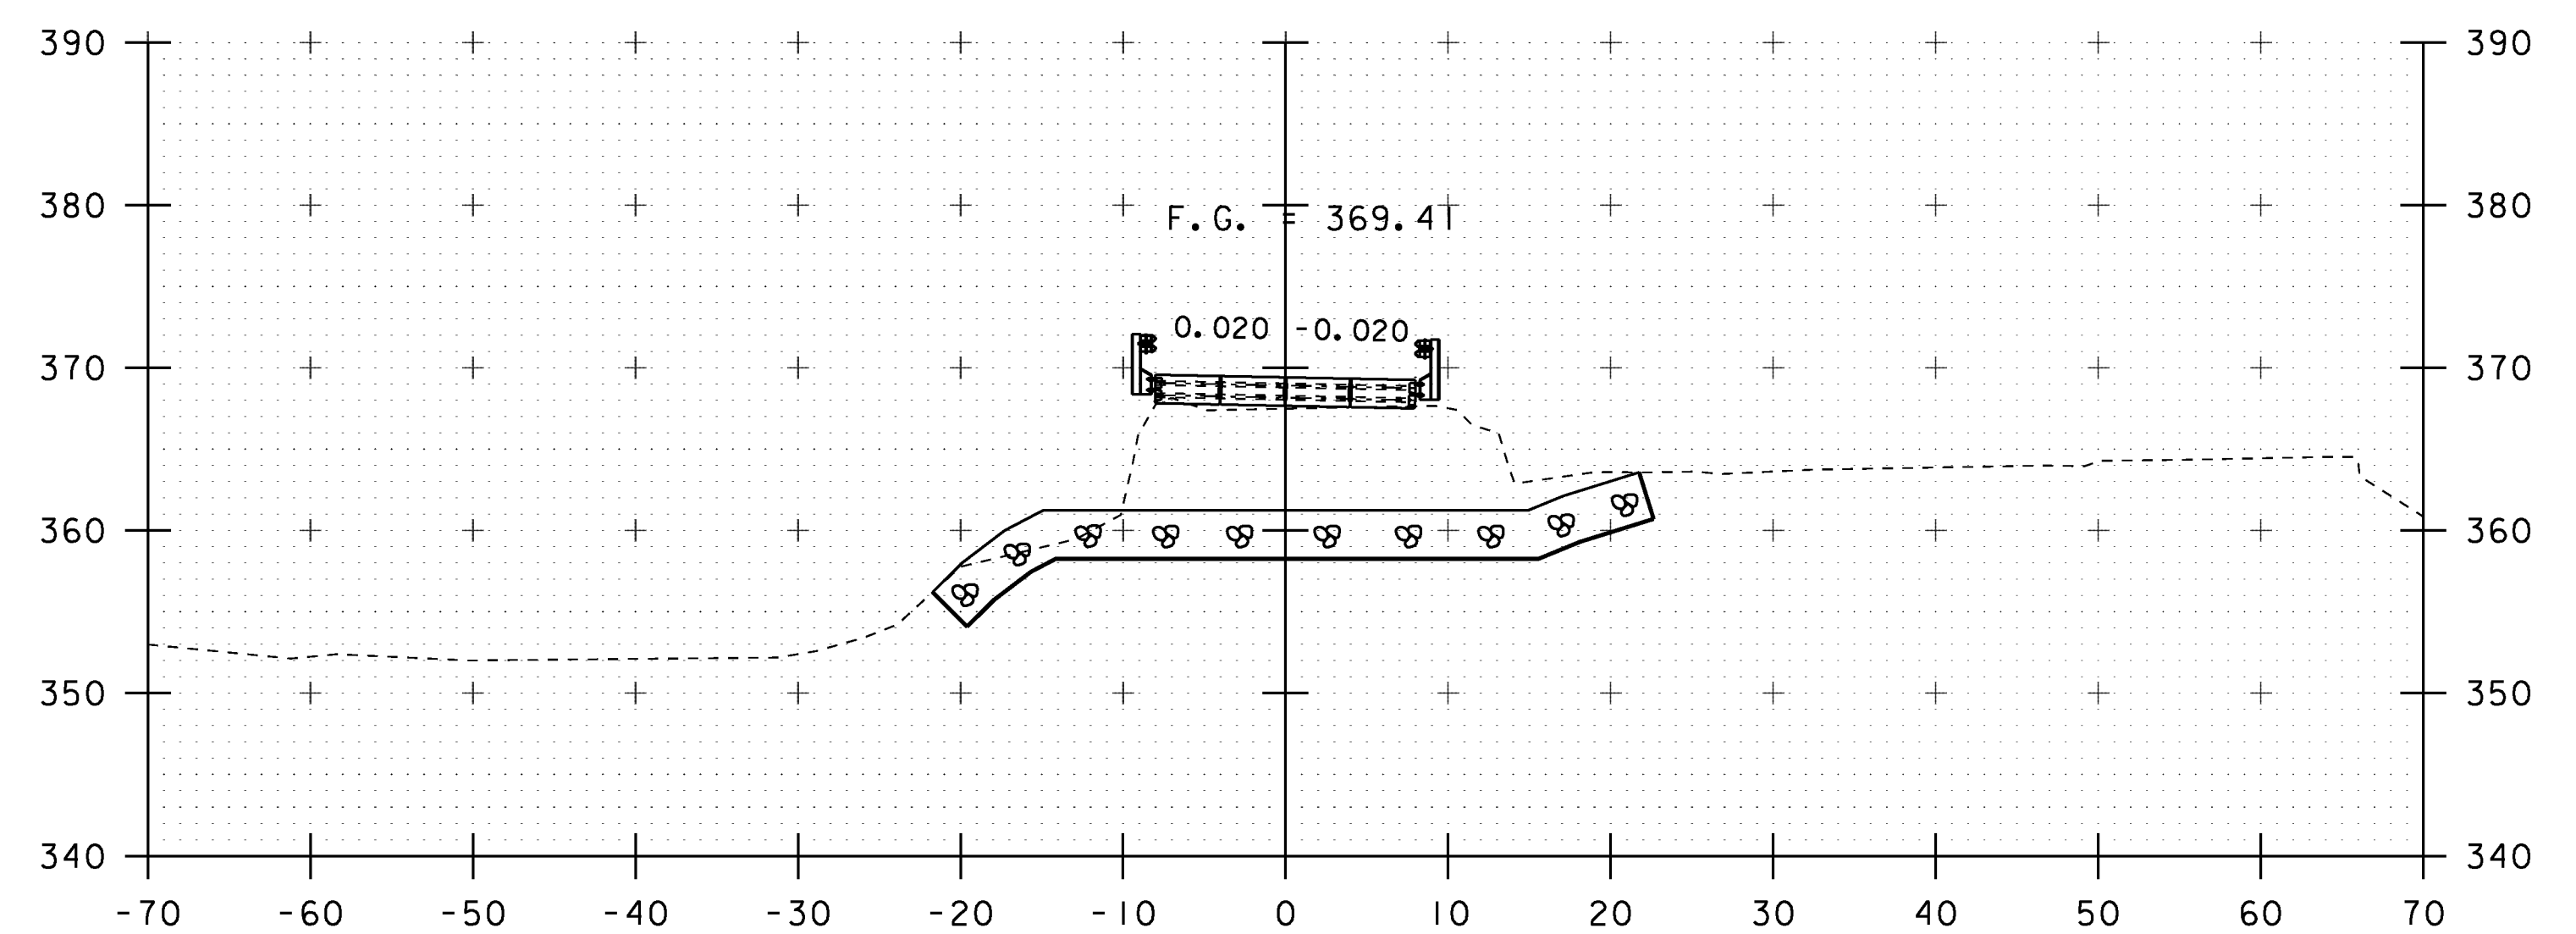


20+00  
END BRIDGE STA 20+11.50

STA. 19+50 TO STA. 20+25


PROJECT NAME: FAIRFIELD	PLOT DATE: 18-AUG-2014
PROJECT NUMBER: BRO 1448(4)	DRAWN BY: K. FRIEDLAND
FILE NAME: sl2j170xs.dgn	CHECKED BY: J. SALVATORI
PROJECT LEADER: R. YOUNG	SHEET 65 OF 69
DESIGNED BY: R. KLINEFELTER	
MAINLINE SECTIONS	

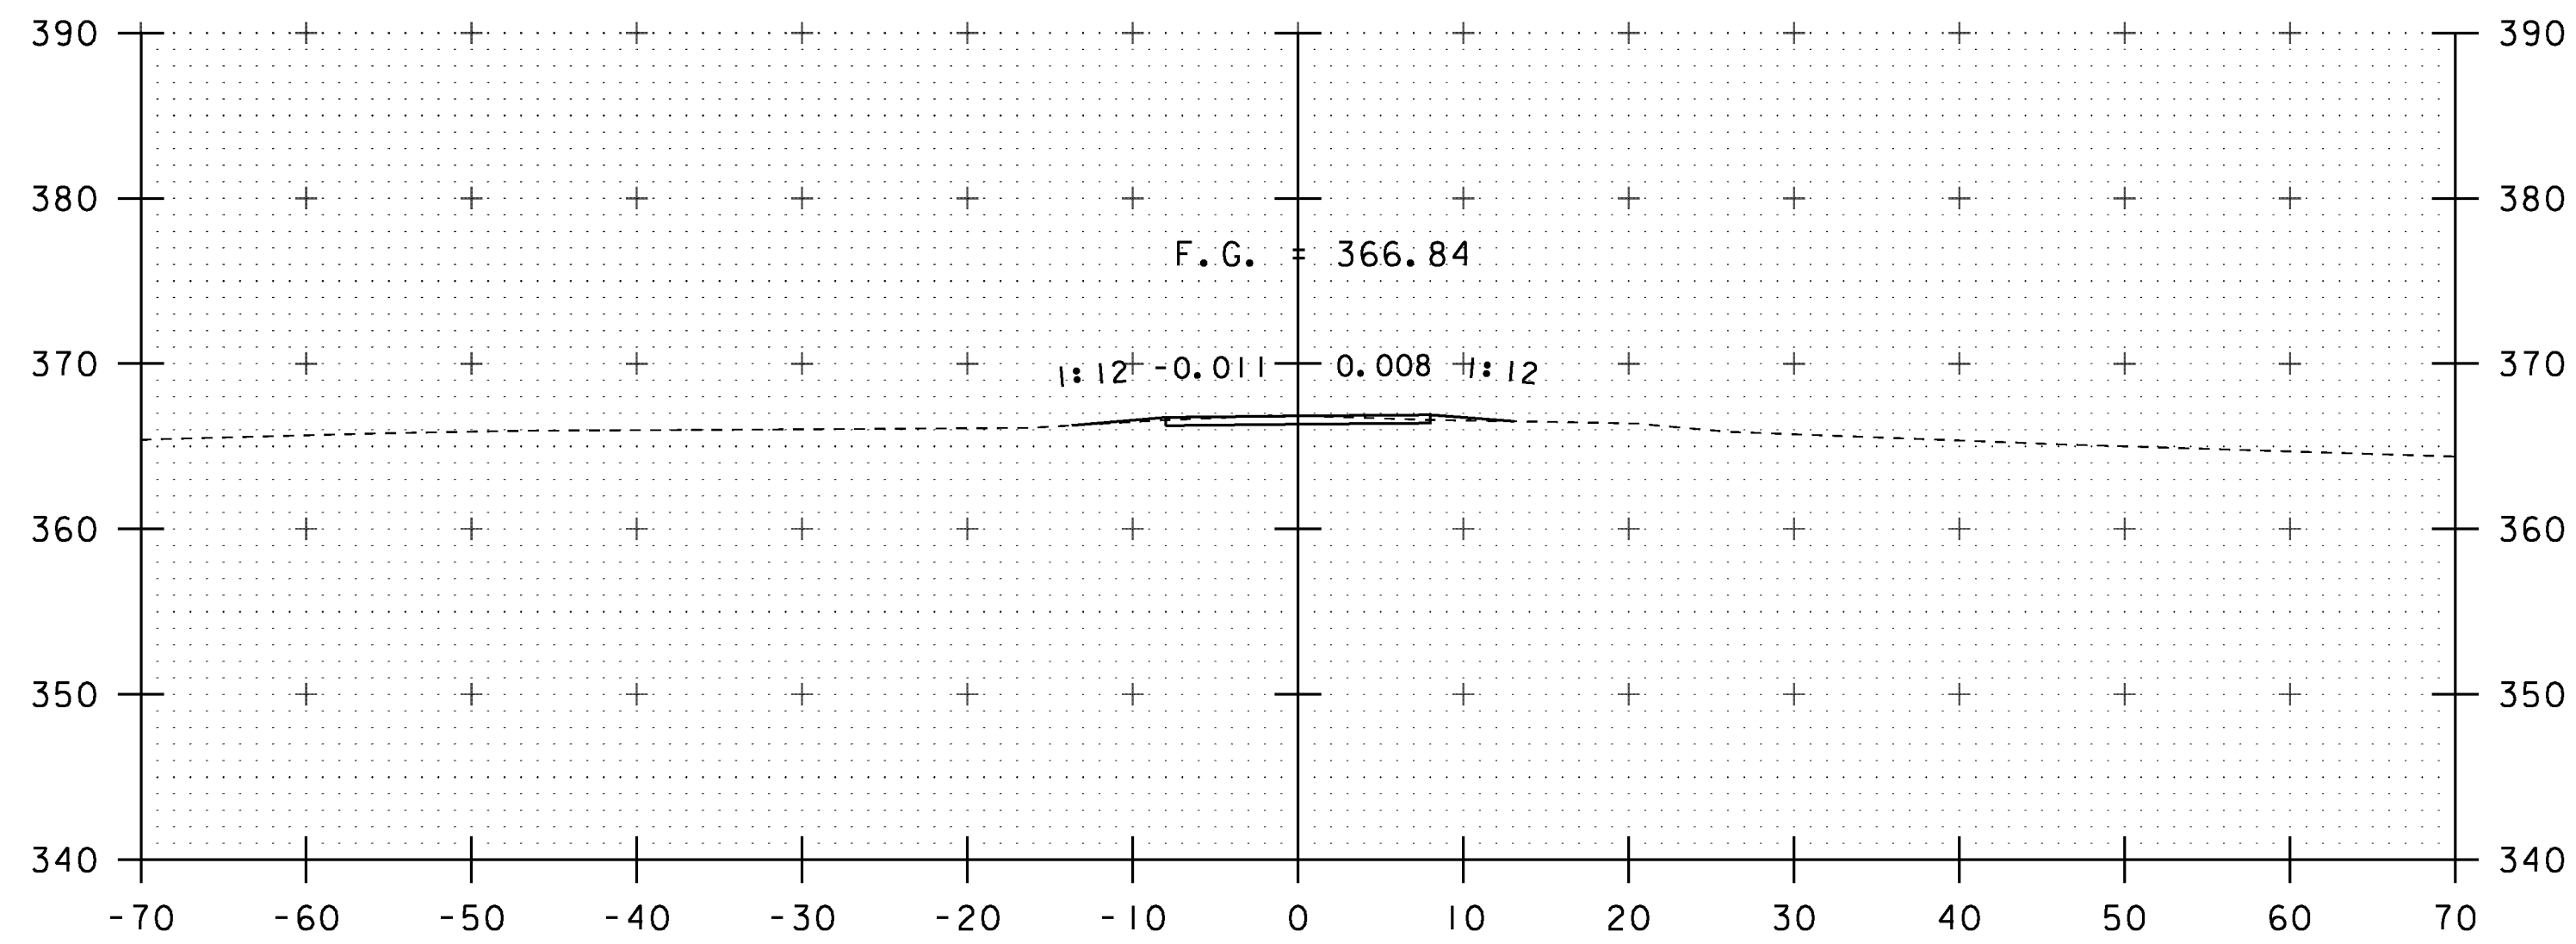


20+75

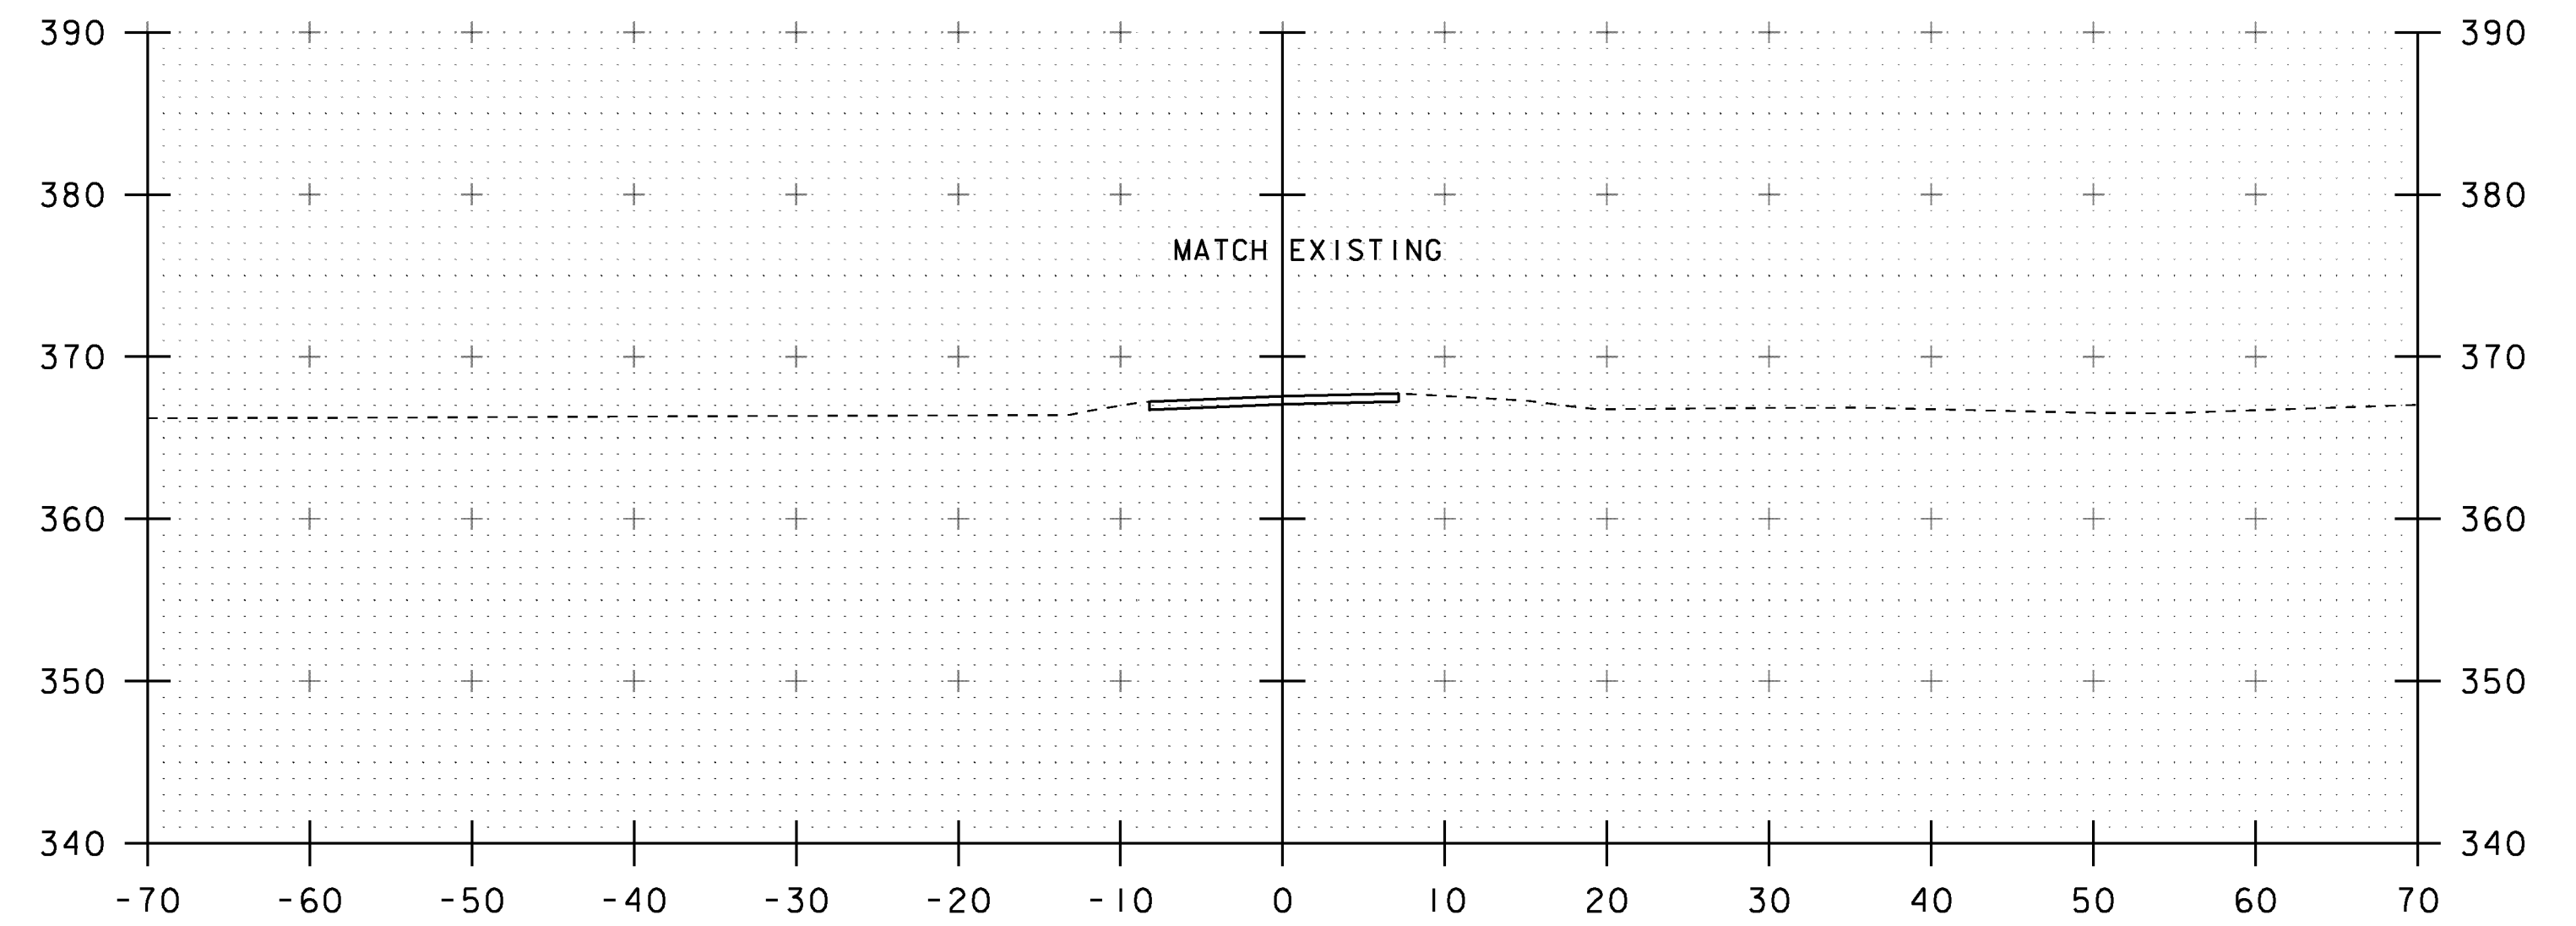

21+25  
END APPROACH

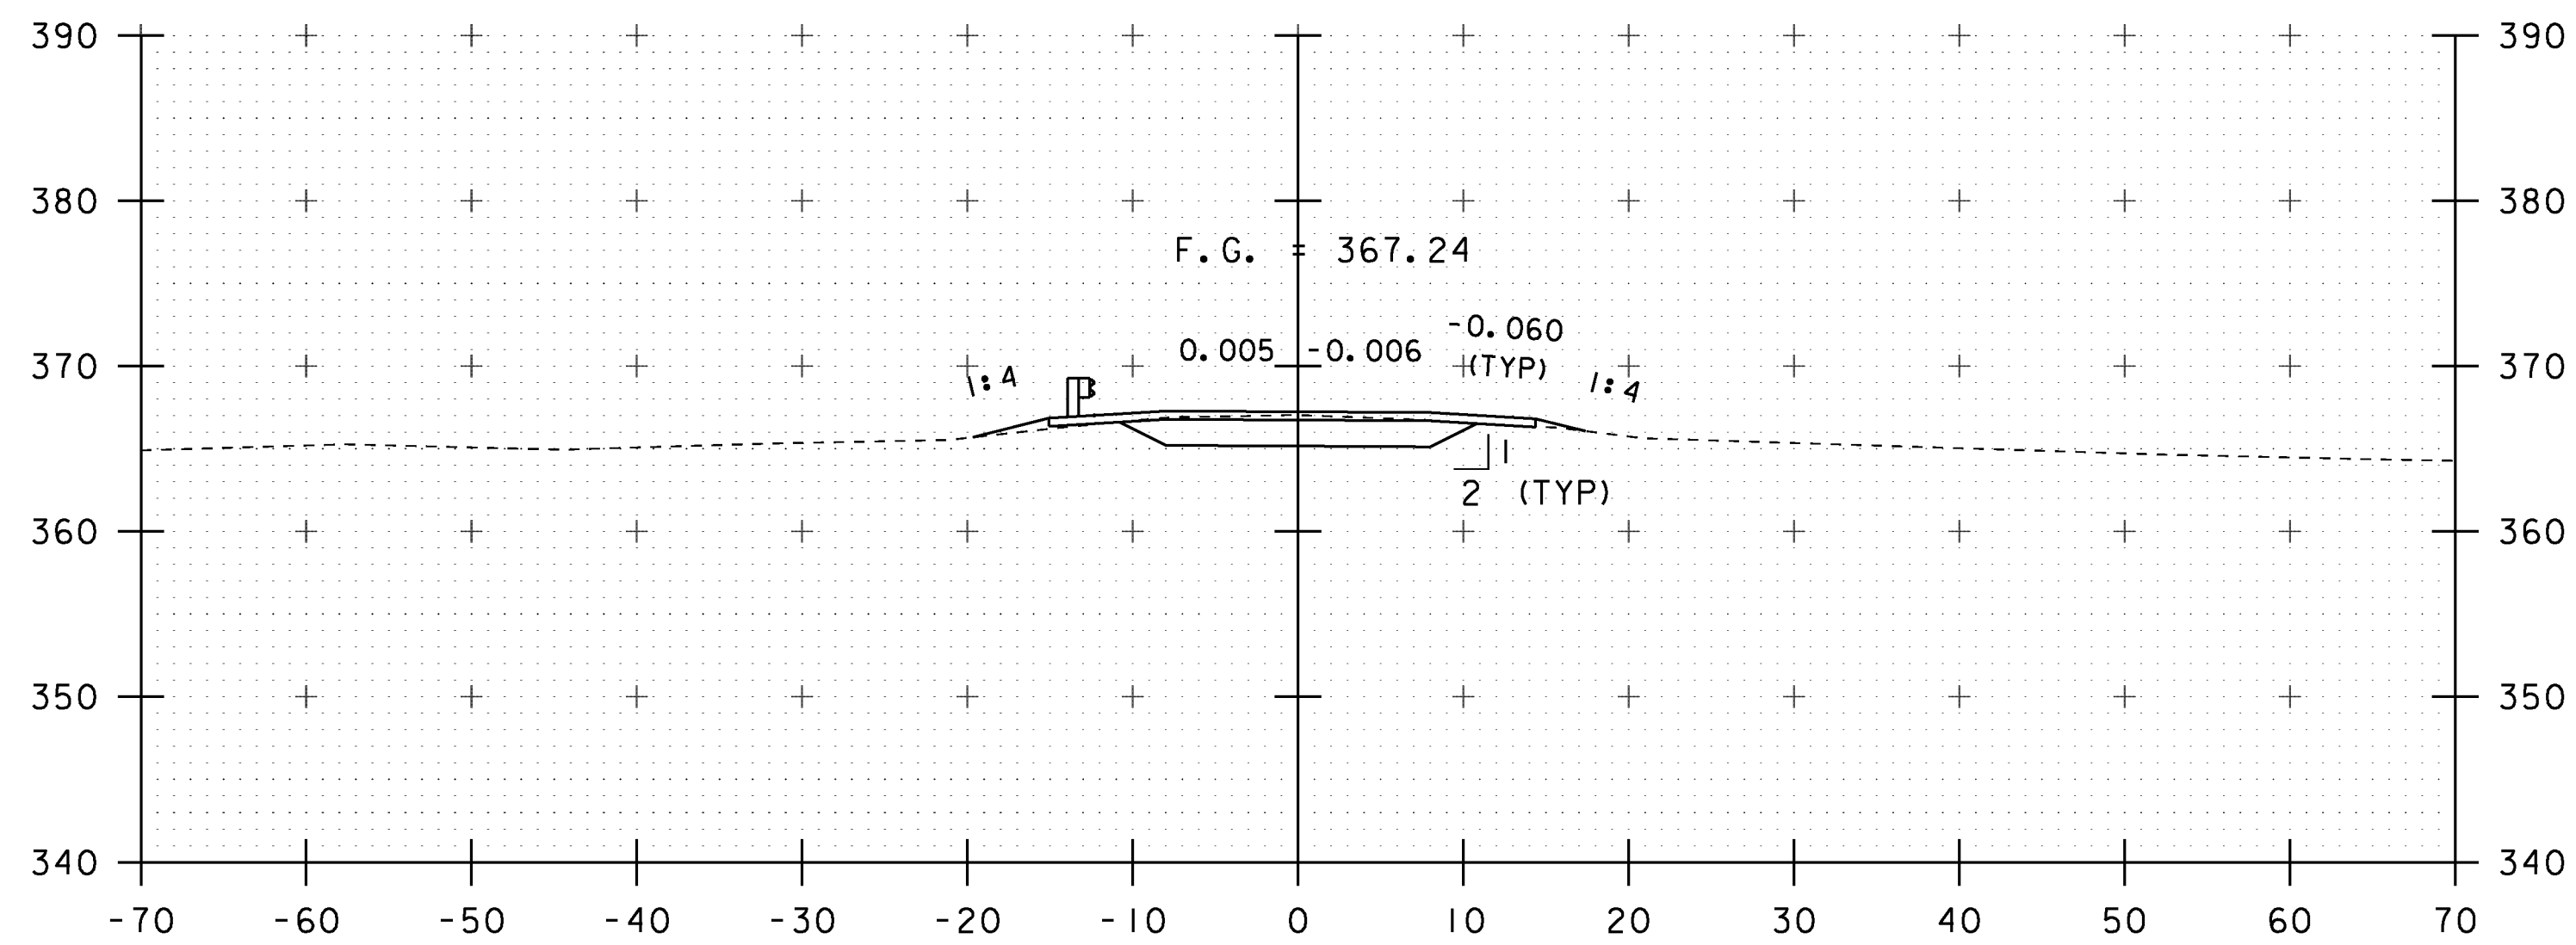


20+50

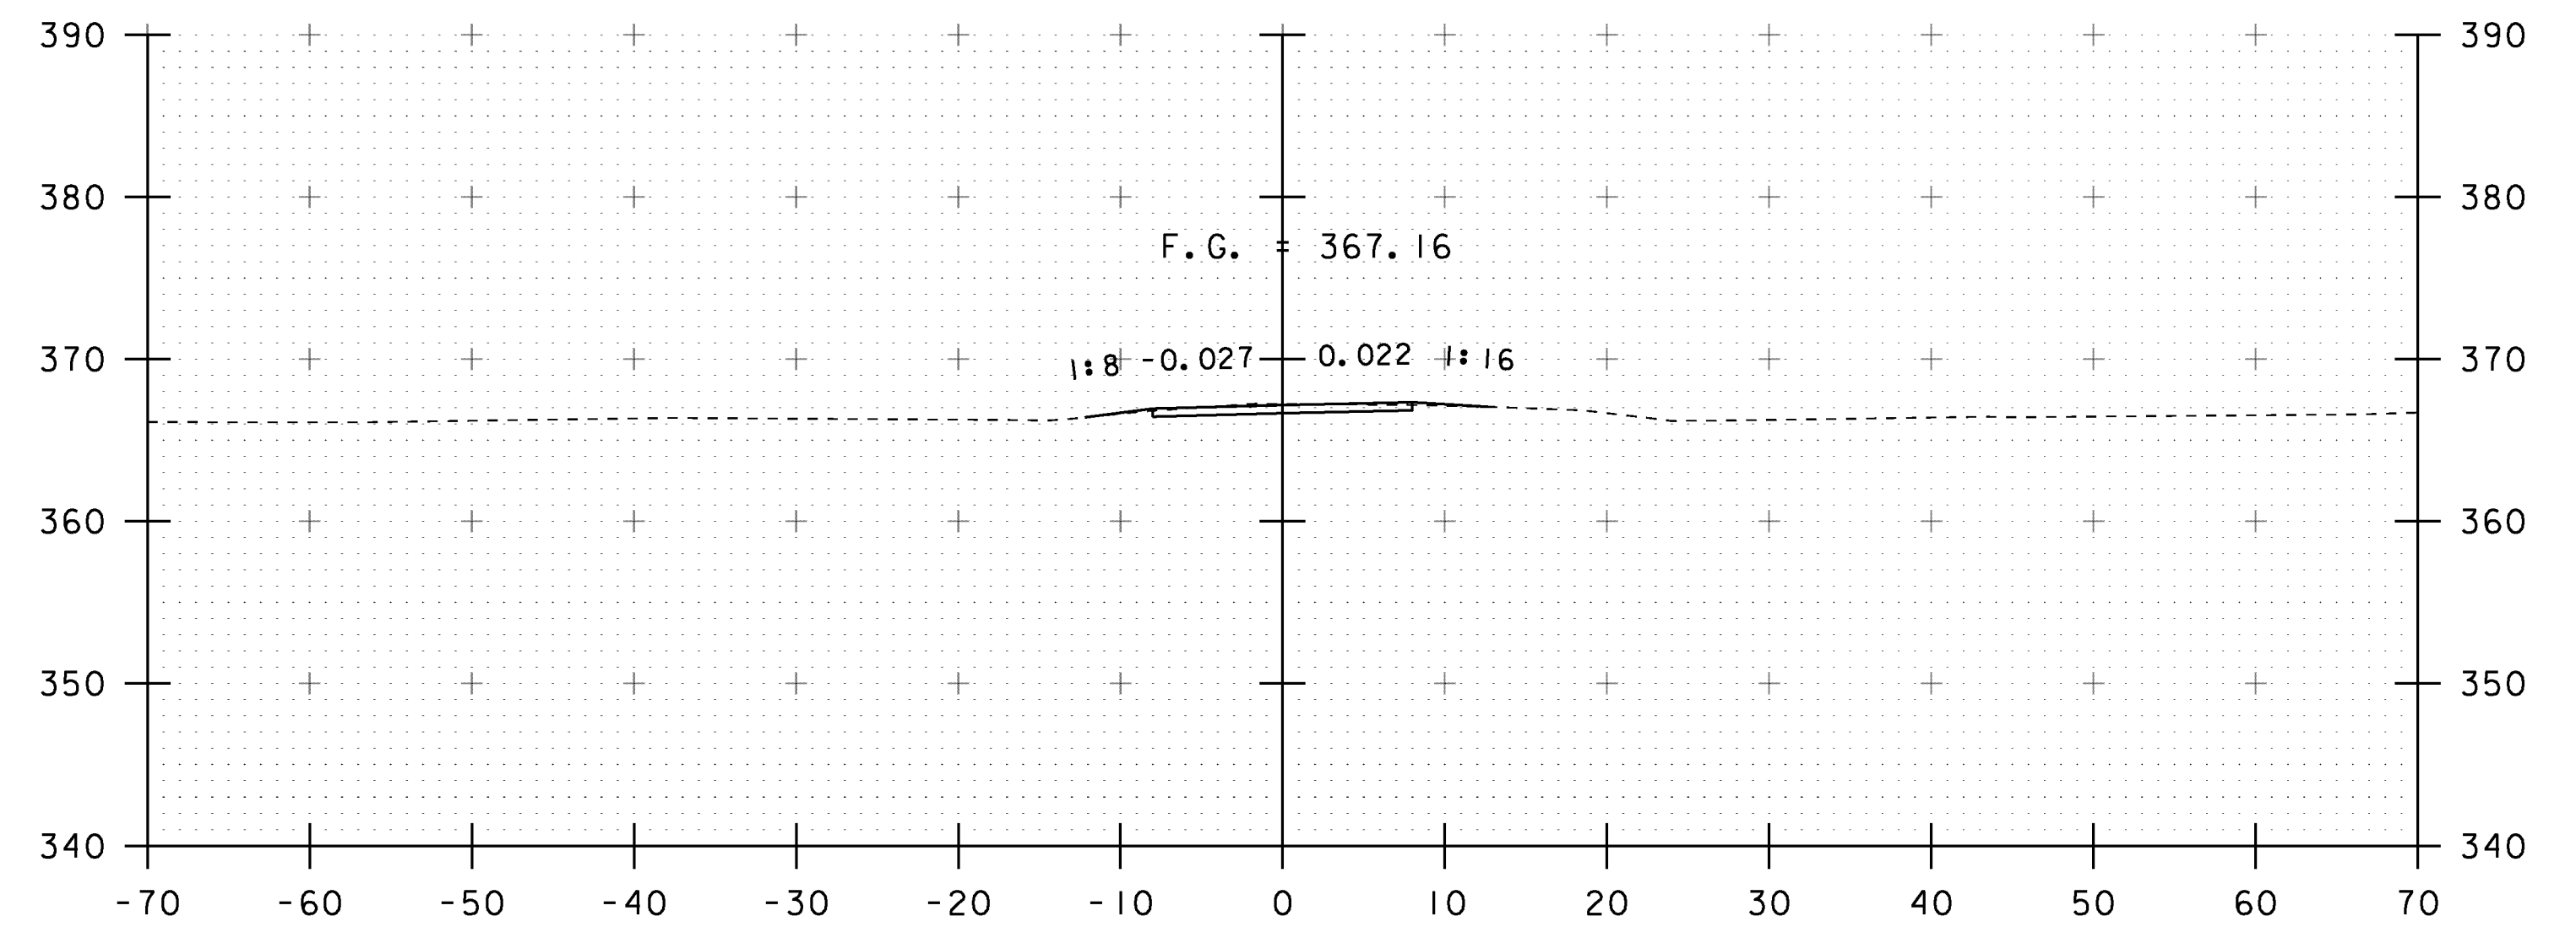


21+00

STA. 20+50 TO STA. 21+25


PROJECT NAME:	FAIRFIELD	PLOT DATE:	18-AUG-2014
PROJECT NUMBER:	BRO 1448(4)	DRAWN BY:	K. FRIEDLAND
FILE NAME:	sl2j170xs.dgn	DESIGNED BY:	R. KLINEFELTER
PROJECT LEADER:	R. YOUNG	CHECKED BY:	J. SALVATORI
DESIGNED BY:	R. KLINEFELTER	MAINLINE SECTIONS	SHEET 66 OF 69

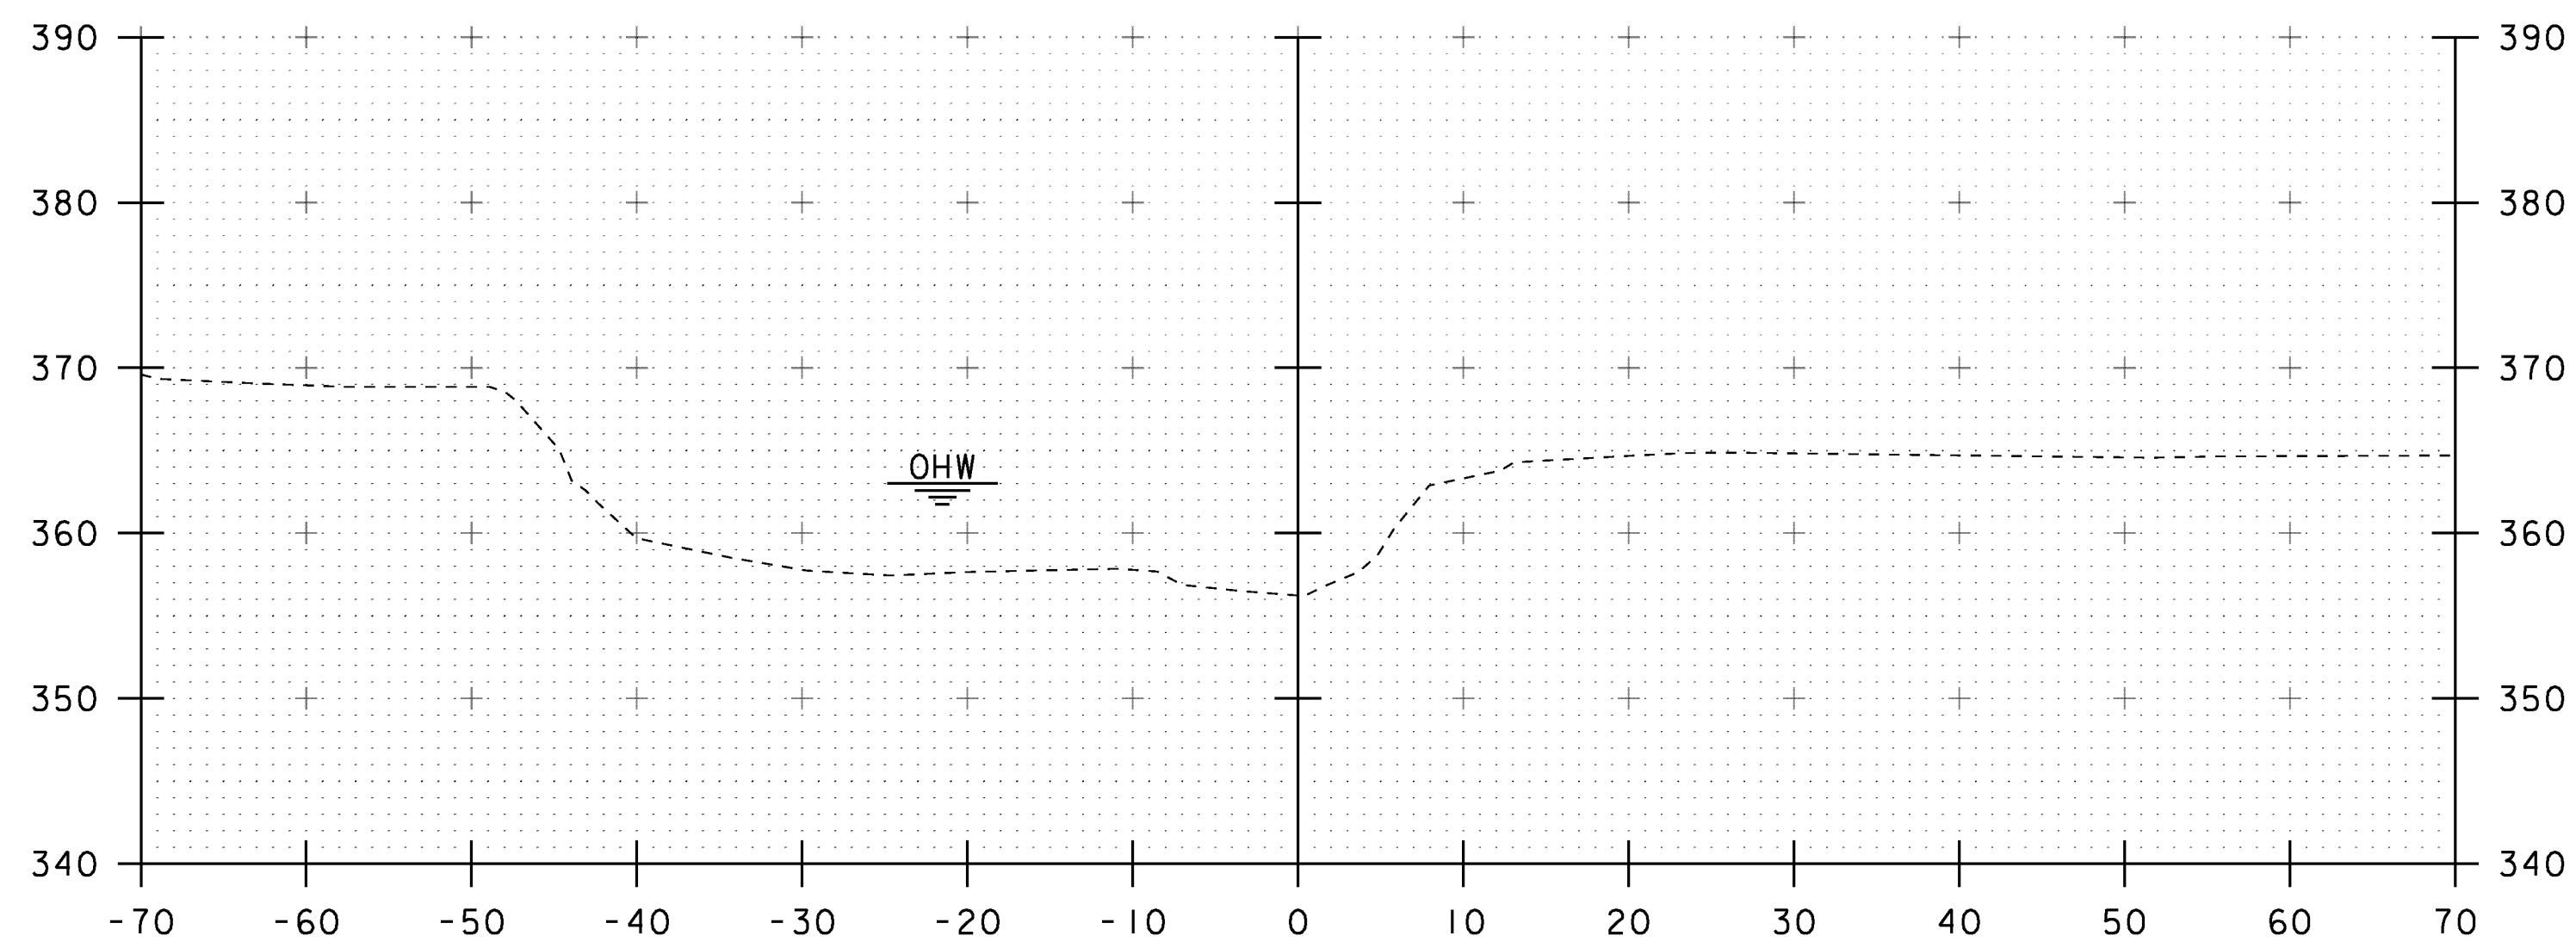

50+25

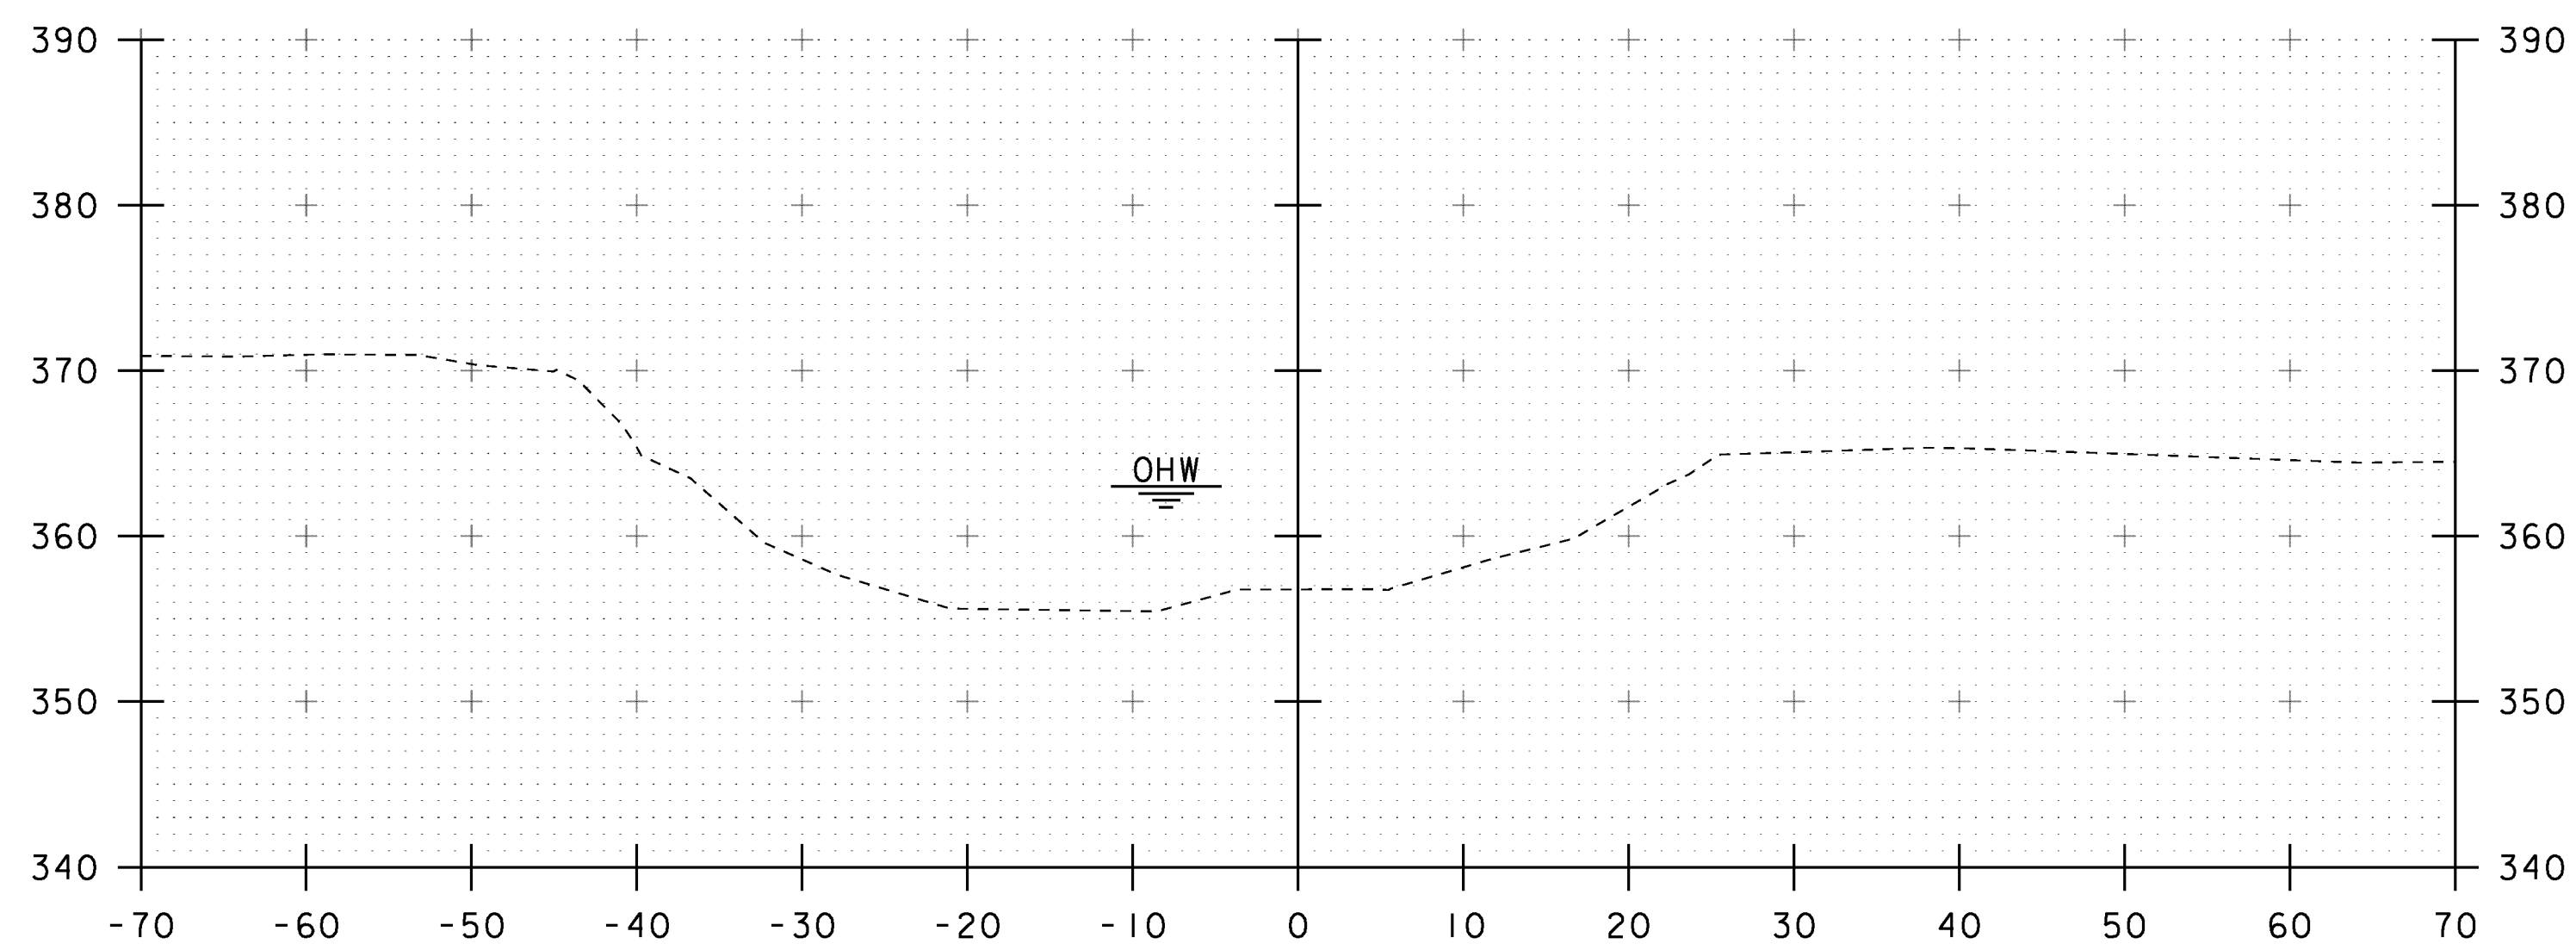

50+00

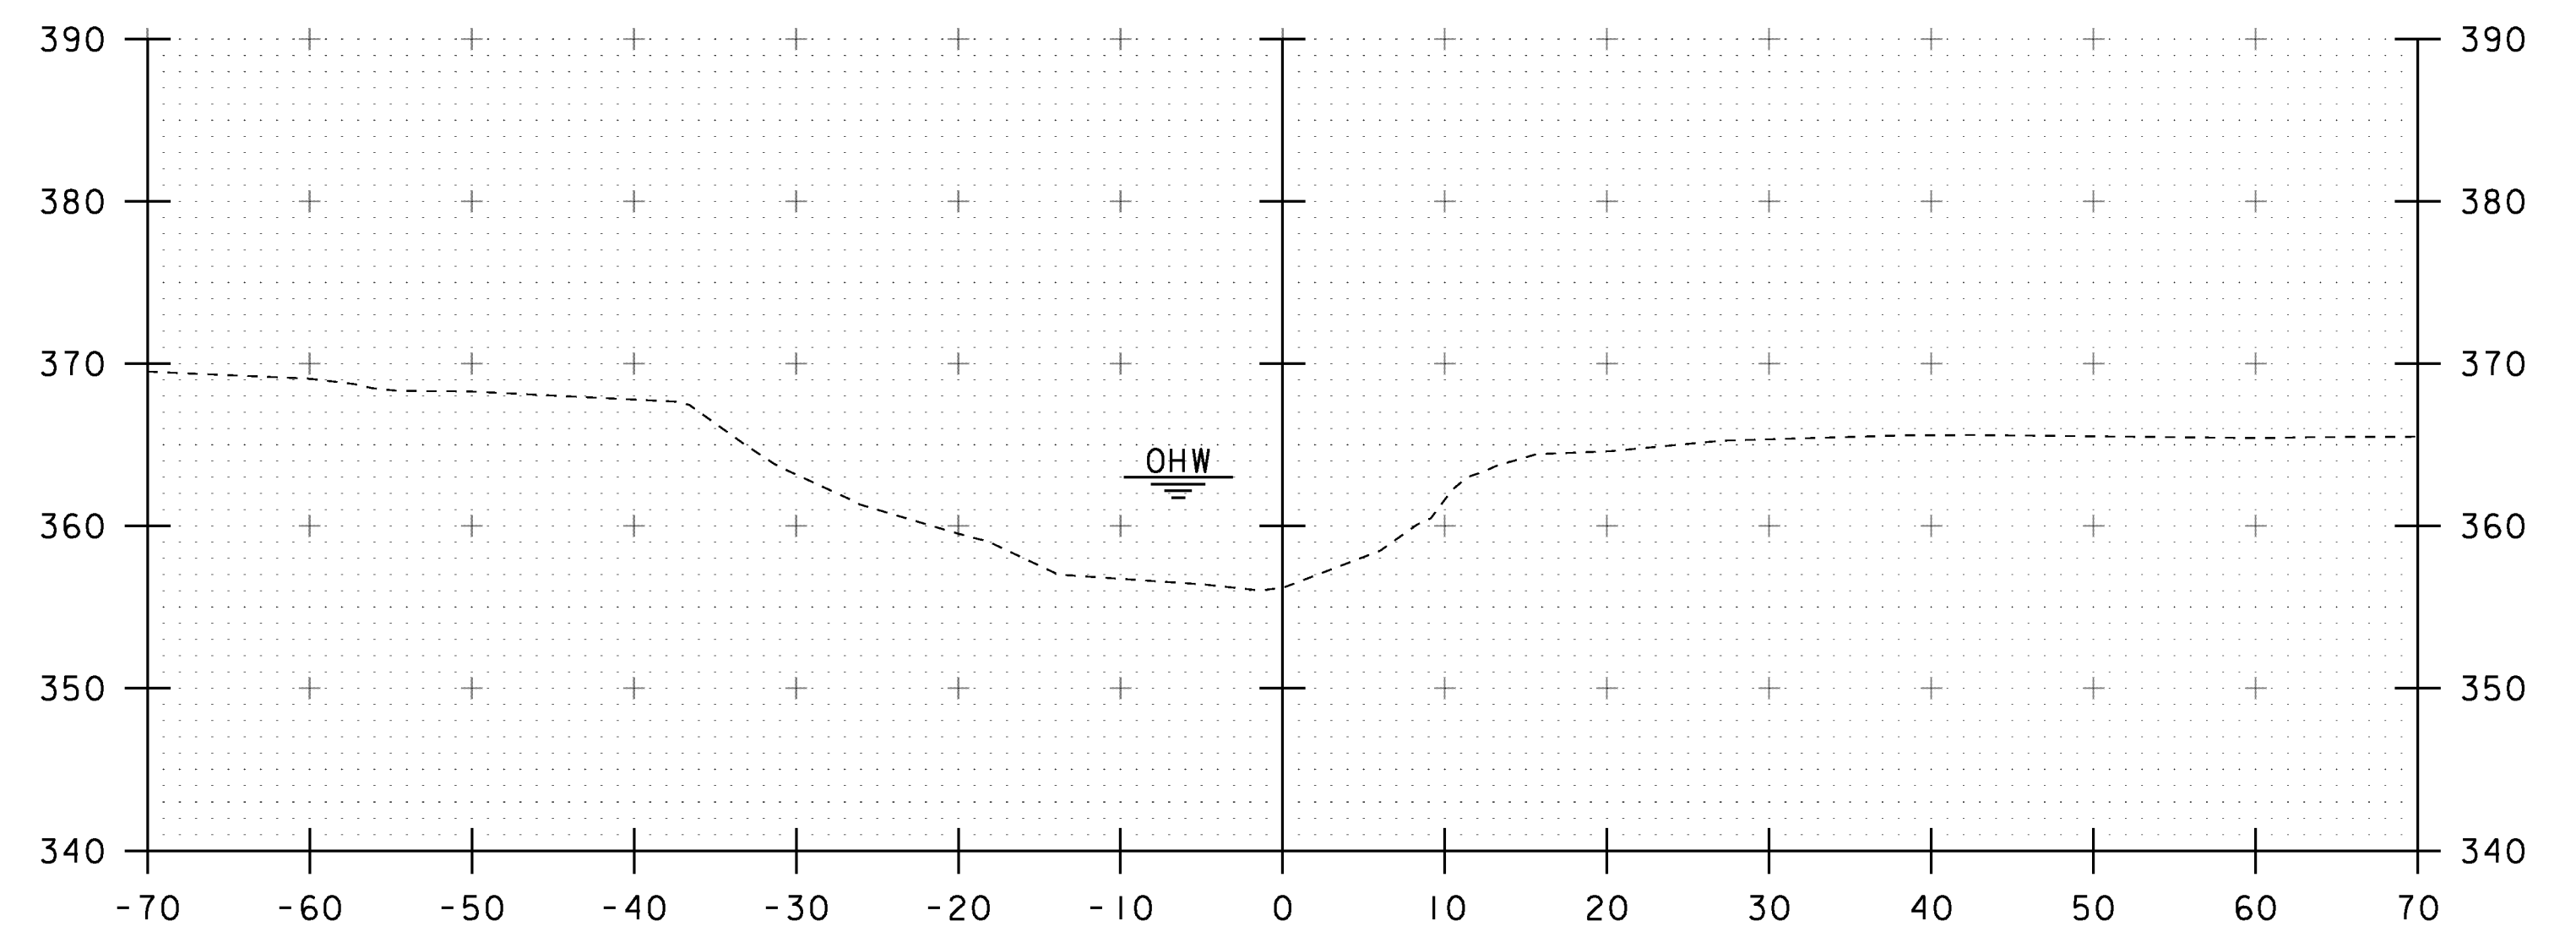


50+50


STA 50+53.00 LT AND RT  
 BEGIN STONE FILL, TYPE III  
 GEOTEXTILE UNDER STONE FILL  
 GRUBBING MATERIAL  
 UNCLASSIFIED CHANNEL EXCAVATION

STA. 50+00 TO STA. 50+50

PROJECT NAME: FAIRFIELD	PLLOT DATE: 18-AUG-2014
PROJECT NUMBER: BRO 1448(4)	DRAWN BY: K. FRIEDLAND
FILE NAME: sl2j170xs.dgn	CHECKED BY: J. SALVATORI
PROJECT LEADER: R. YOUNG	SHEET 67 OF 69
DESIGNED BY: R. KLINEFELTER	
CHANNEL SECTIONS	

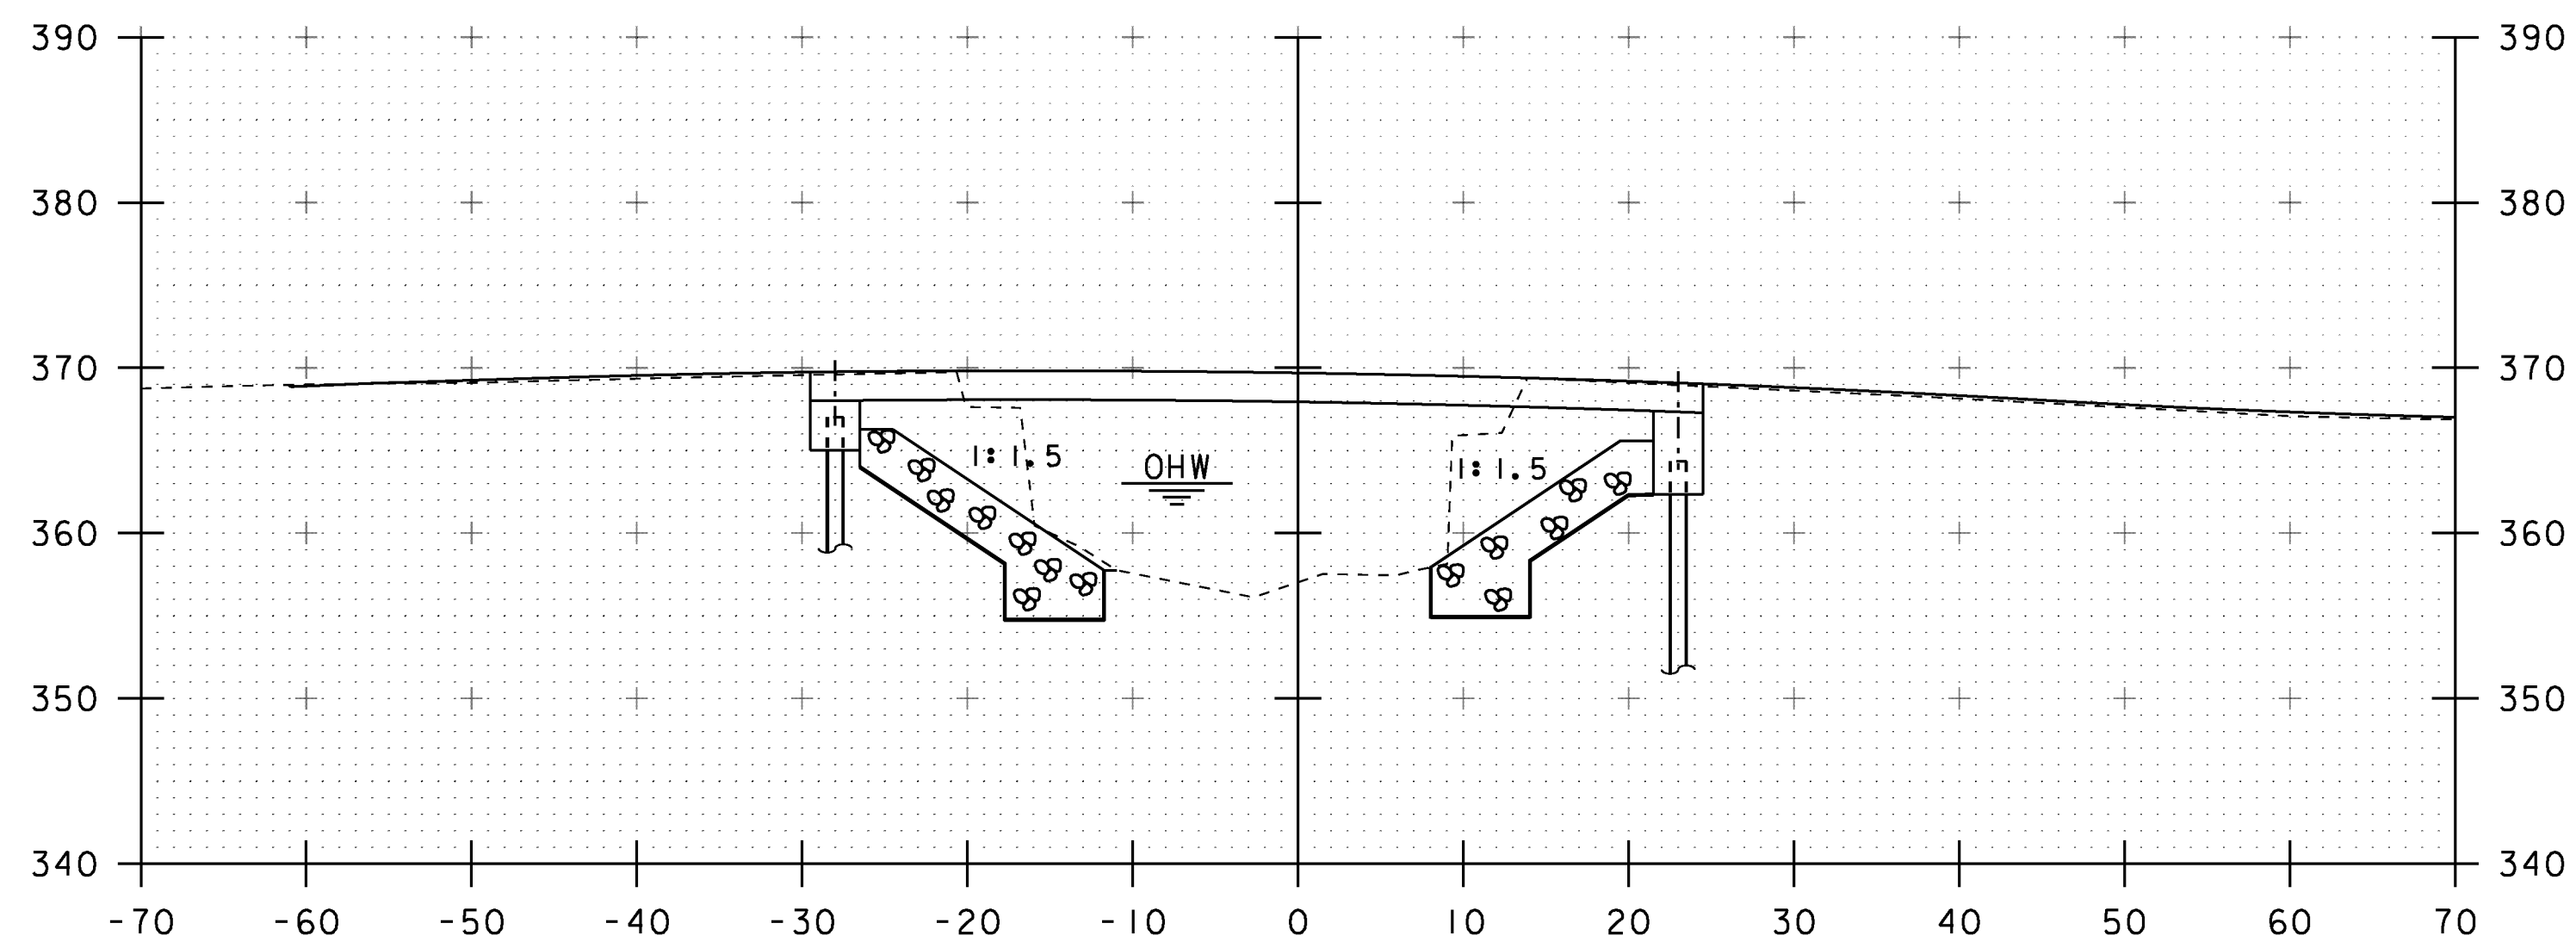


50+75

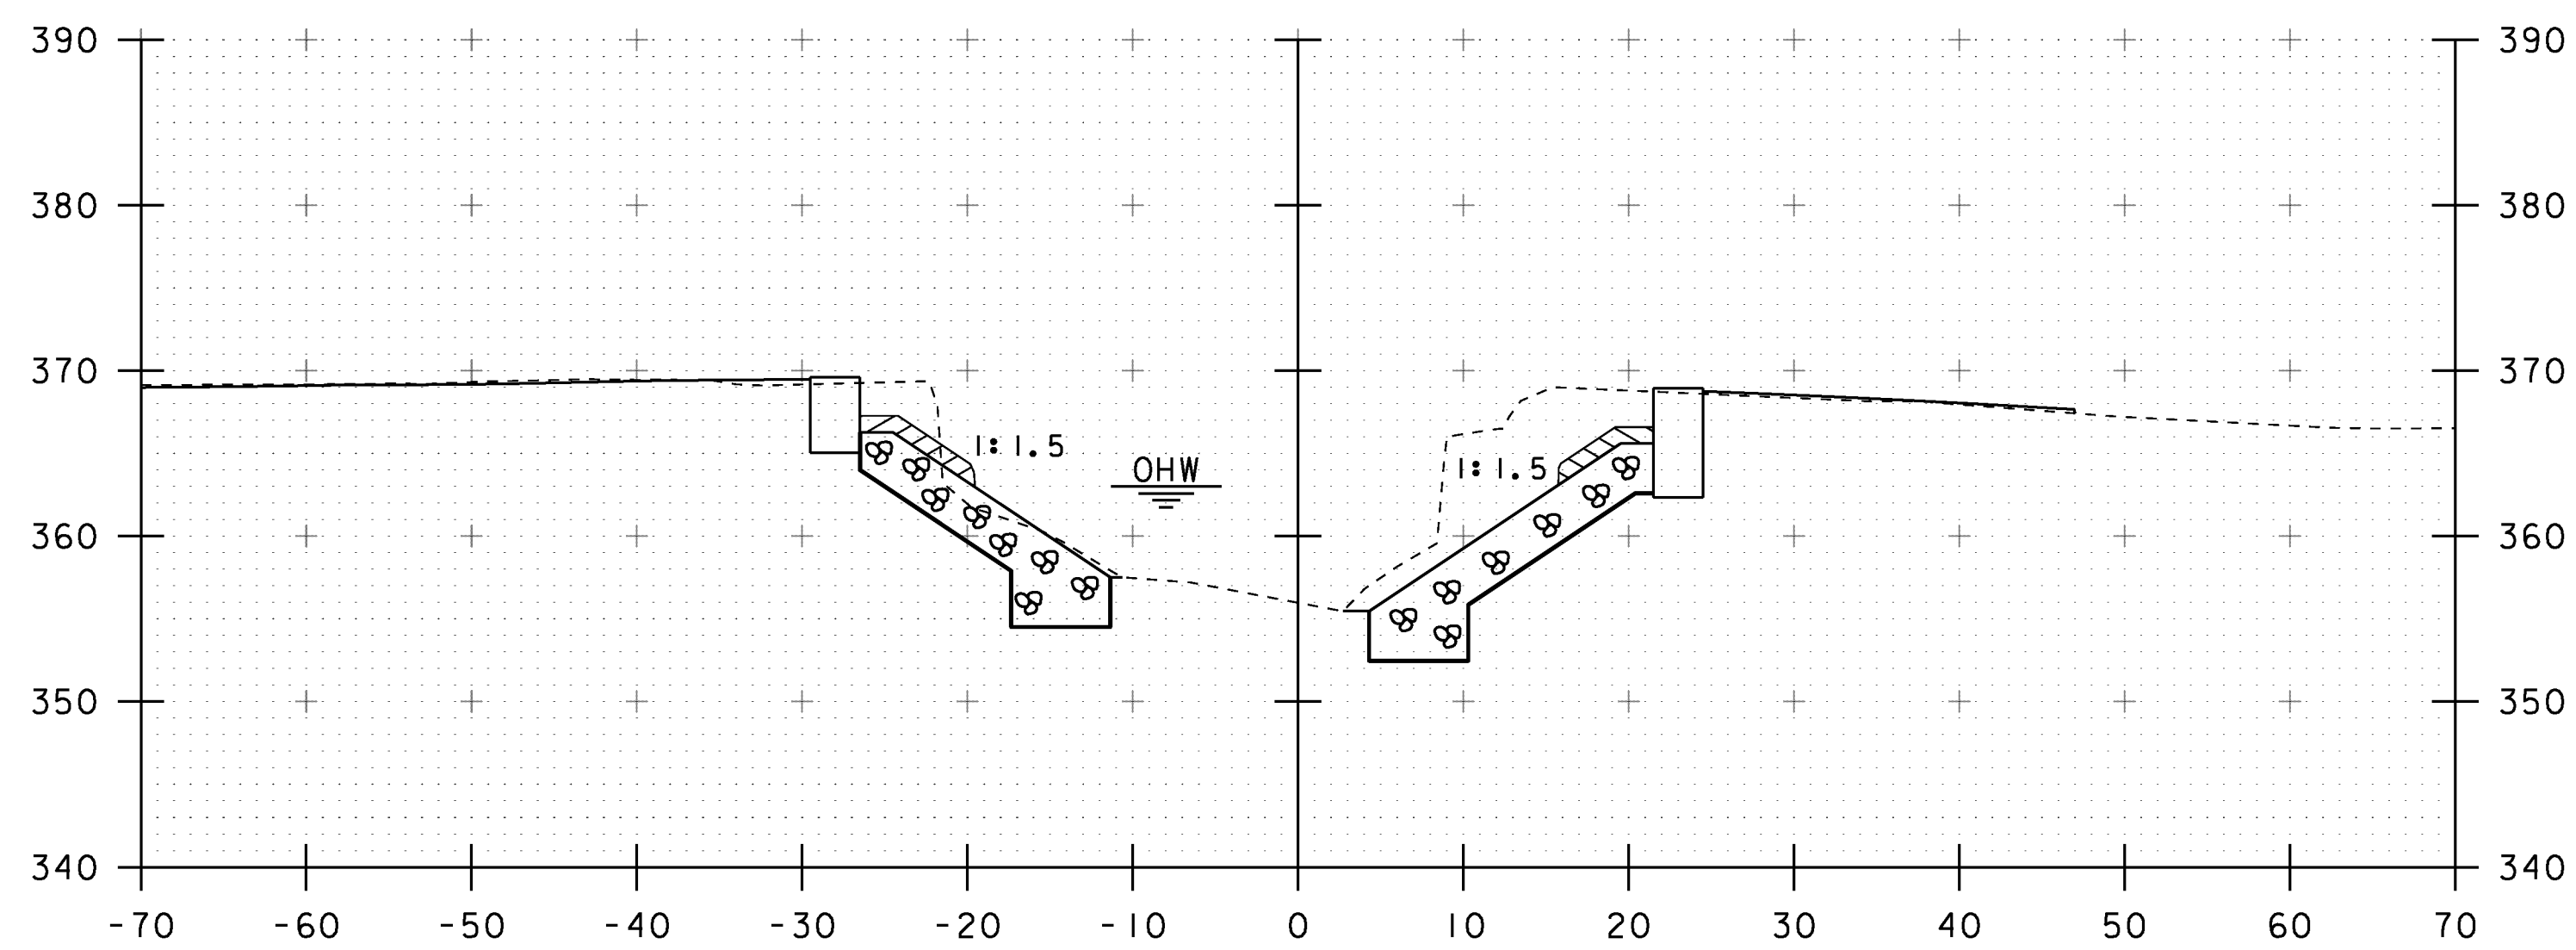

STA 50+67.00 LT AND RT  
END GRUBBING MATERIAL

50+65

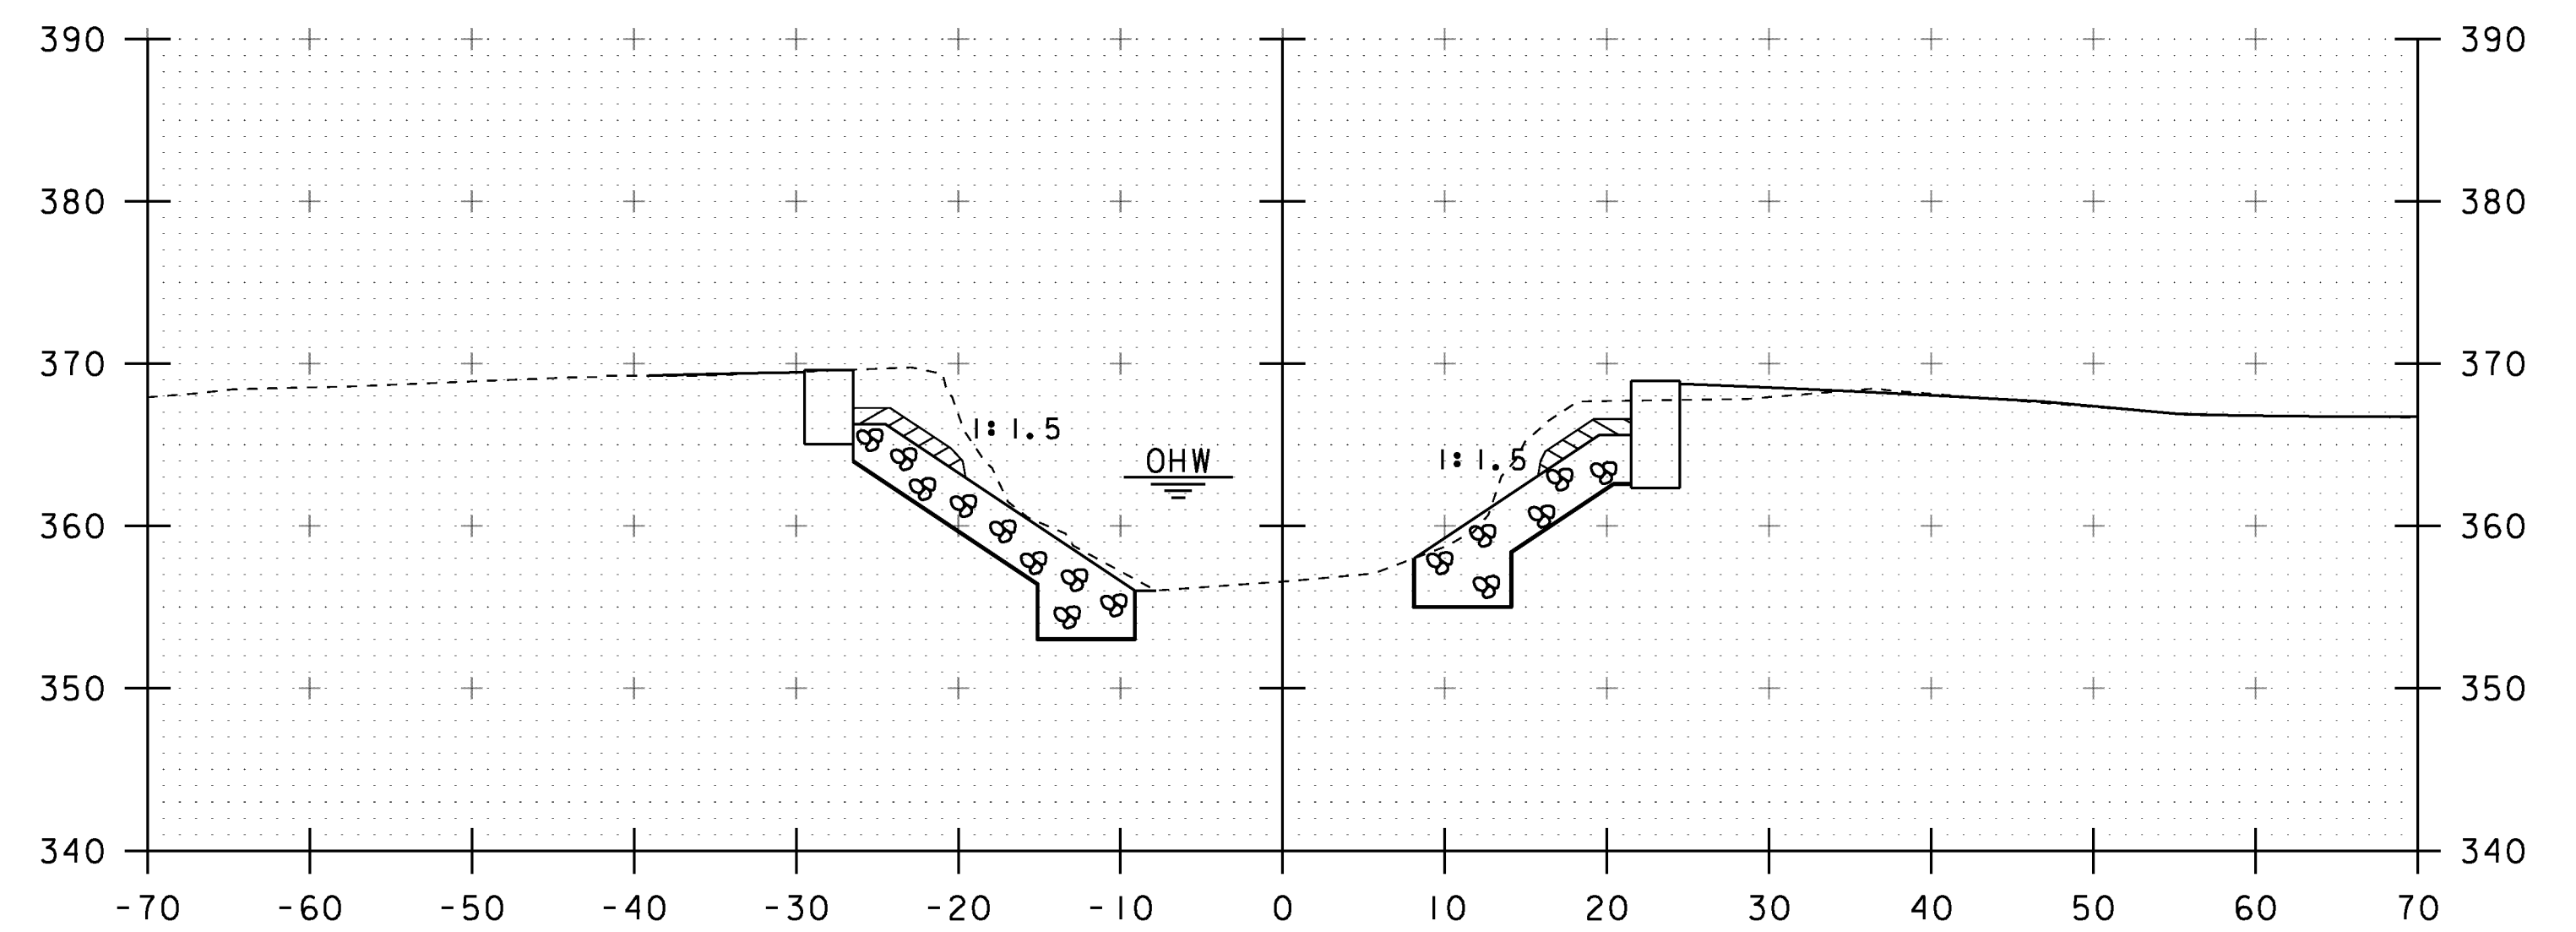

STA 50+83.00 LT AND RT  
BEGIN GRUBBING MATERIAL


50+85

PROJECT NAME: FAIRFIELD  
PROJECT NUMBER: BRO 1448(4)


FILE NAME: sl2j170xs.dgn  
PROJECT LEADER: R. YOUNG  
DESIGNED BY: R. KLINEFELTER  
CHANNEL SECTIONS

PLOT DATE: 18-AUG-2014  
DRAWN BY: K. FRIEDLAND  
CHECKED BY: J. SALVATORI  
SHEET 68 OF 69

STA. 50+65 TO STA. 50+85

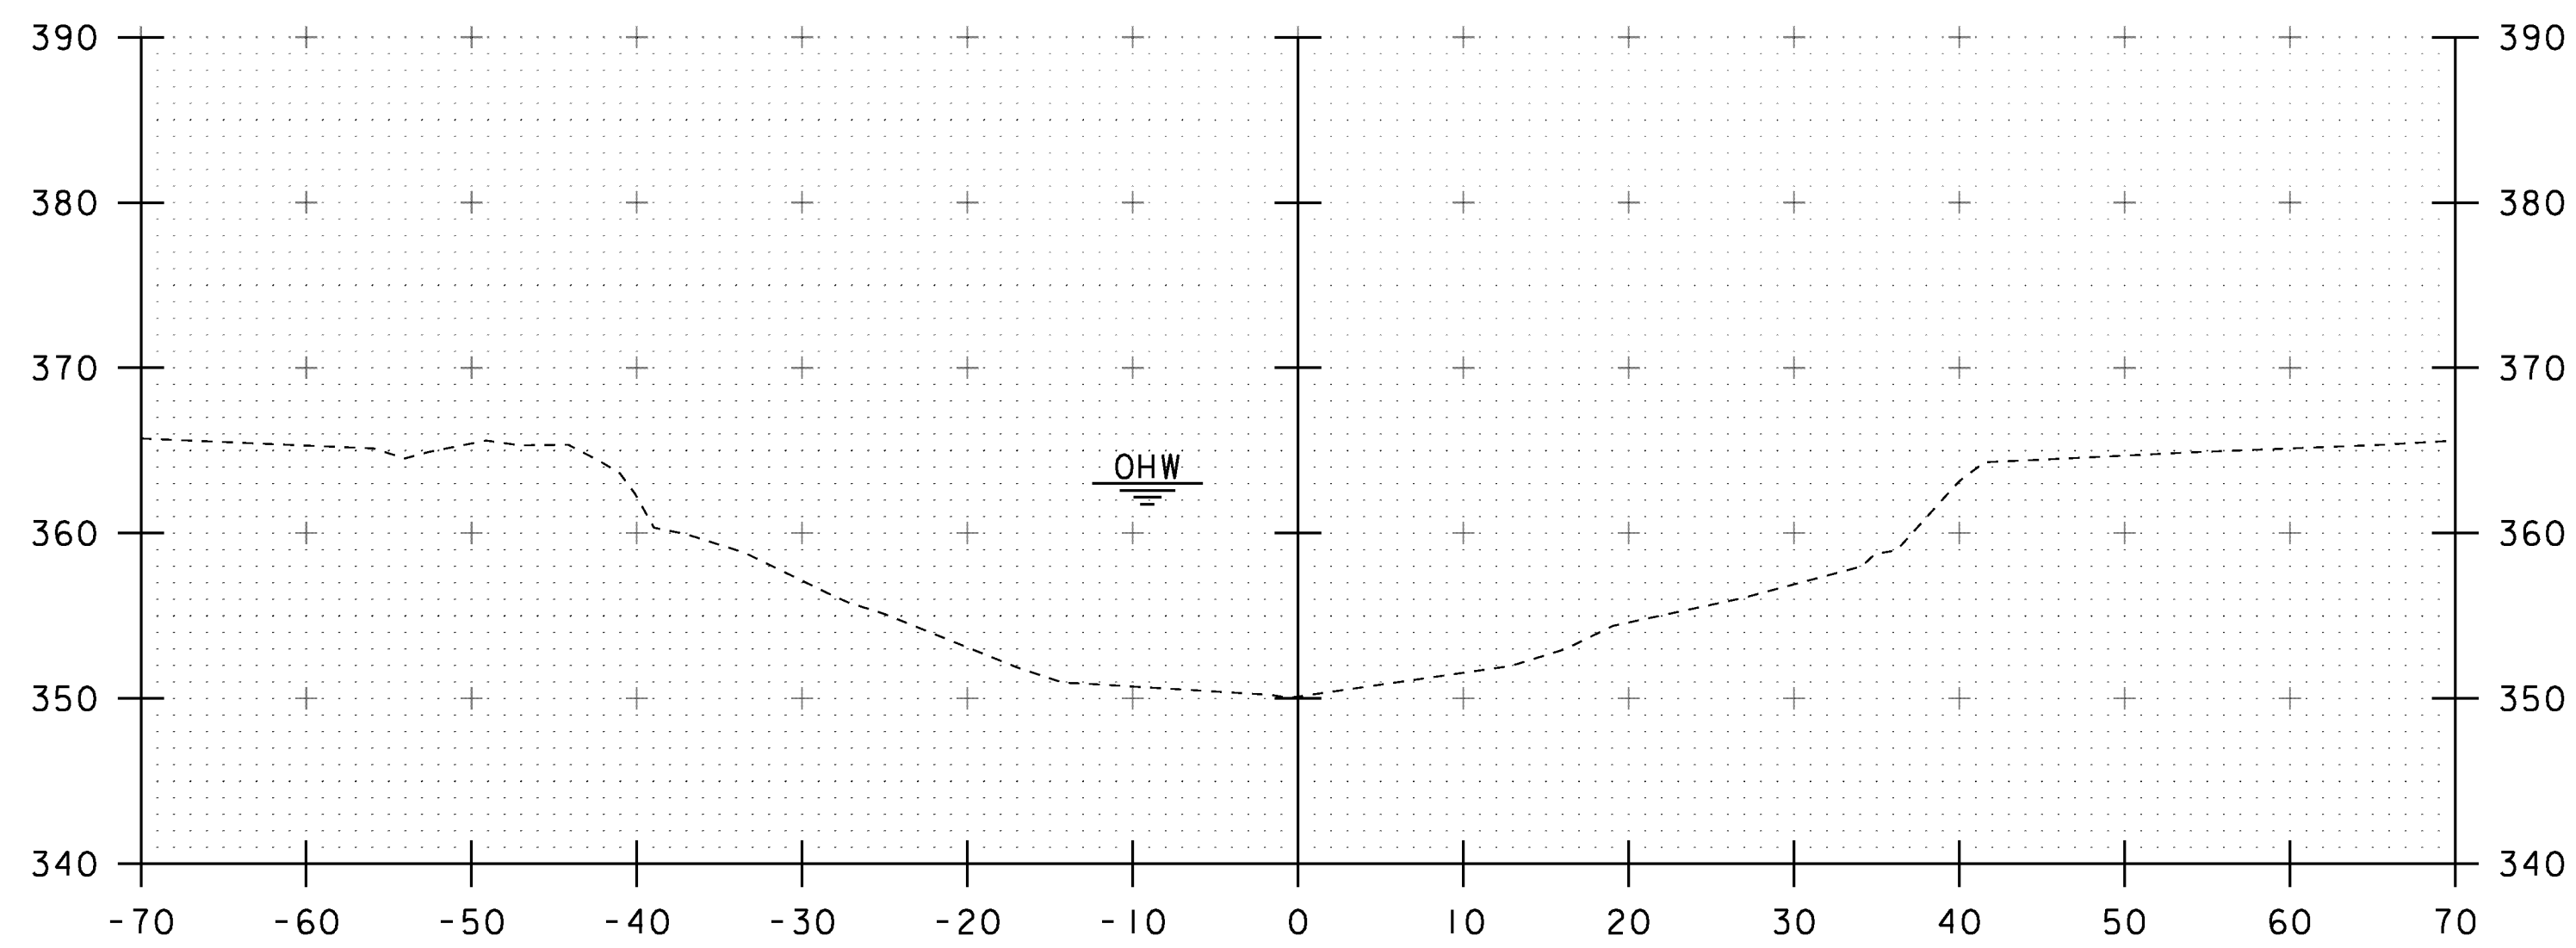


51+25

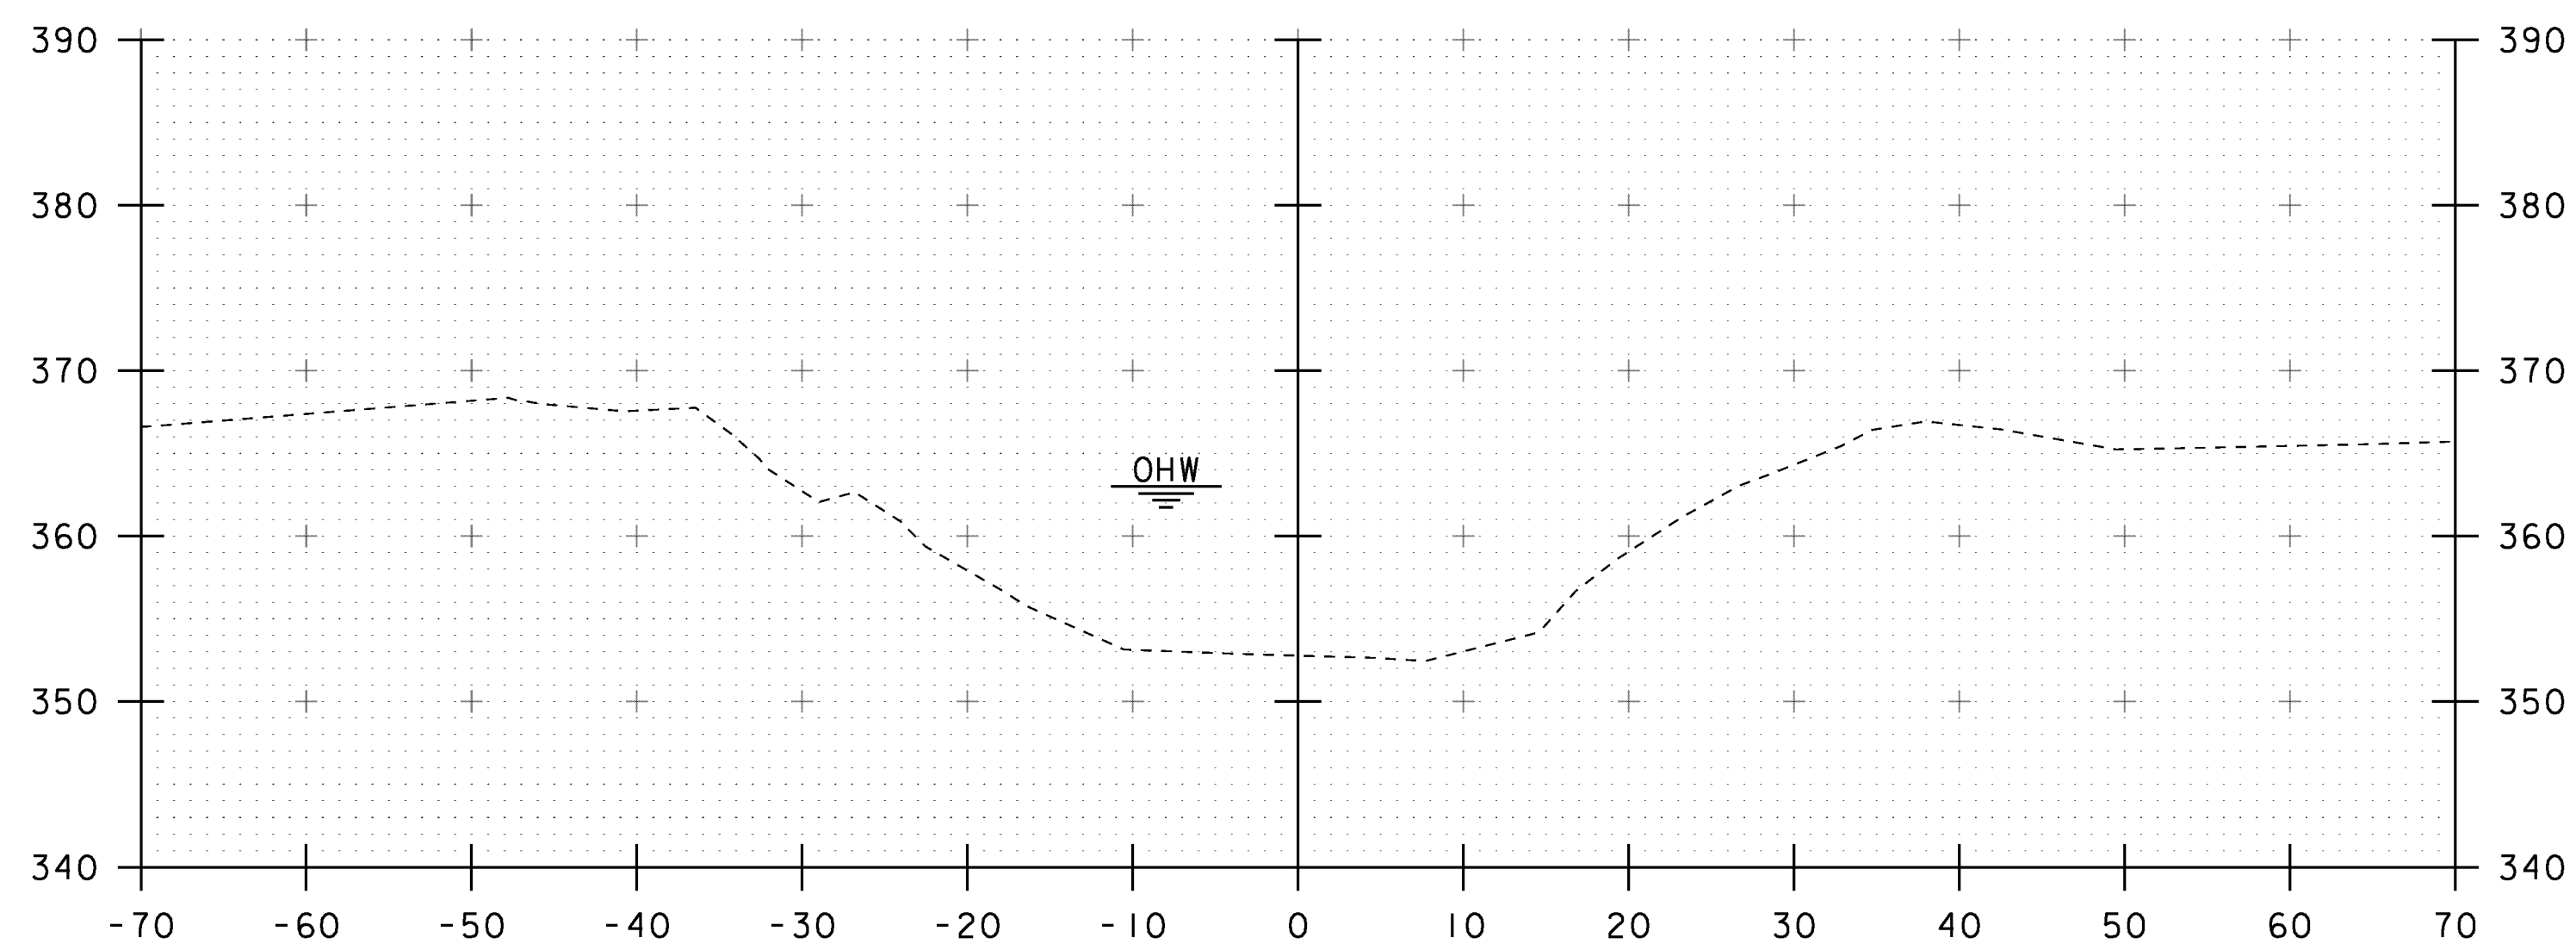

51+00

STA 50+97.00 LT AND RT  
 END STONE FILL, TYPE III  
 GEOTEXTILE UNDER STONE FILL  
 GRUBBING MATERIAL  
 UNCLASSIFIED CHANNEL EXCAVATION

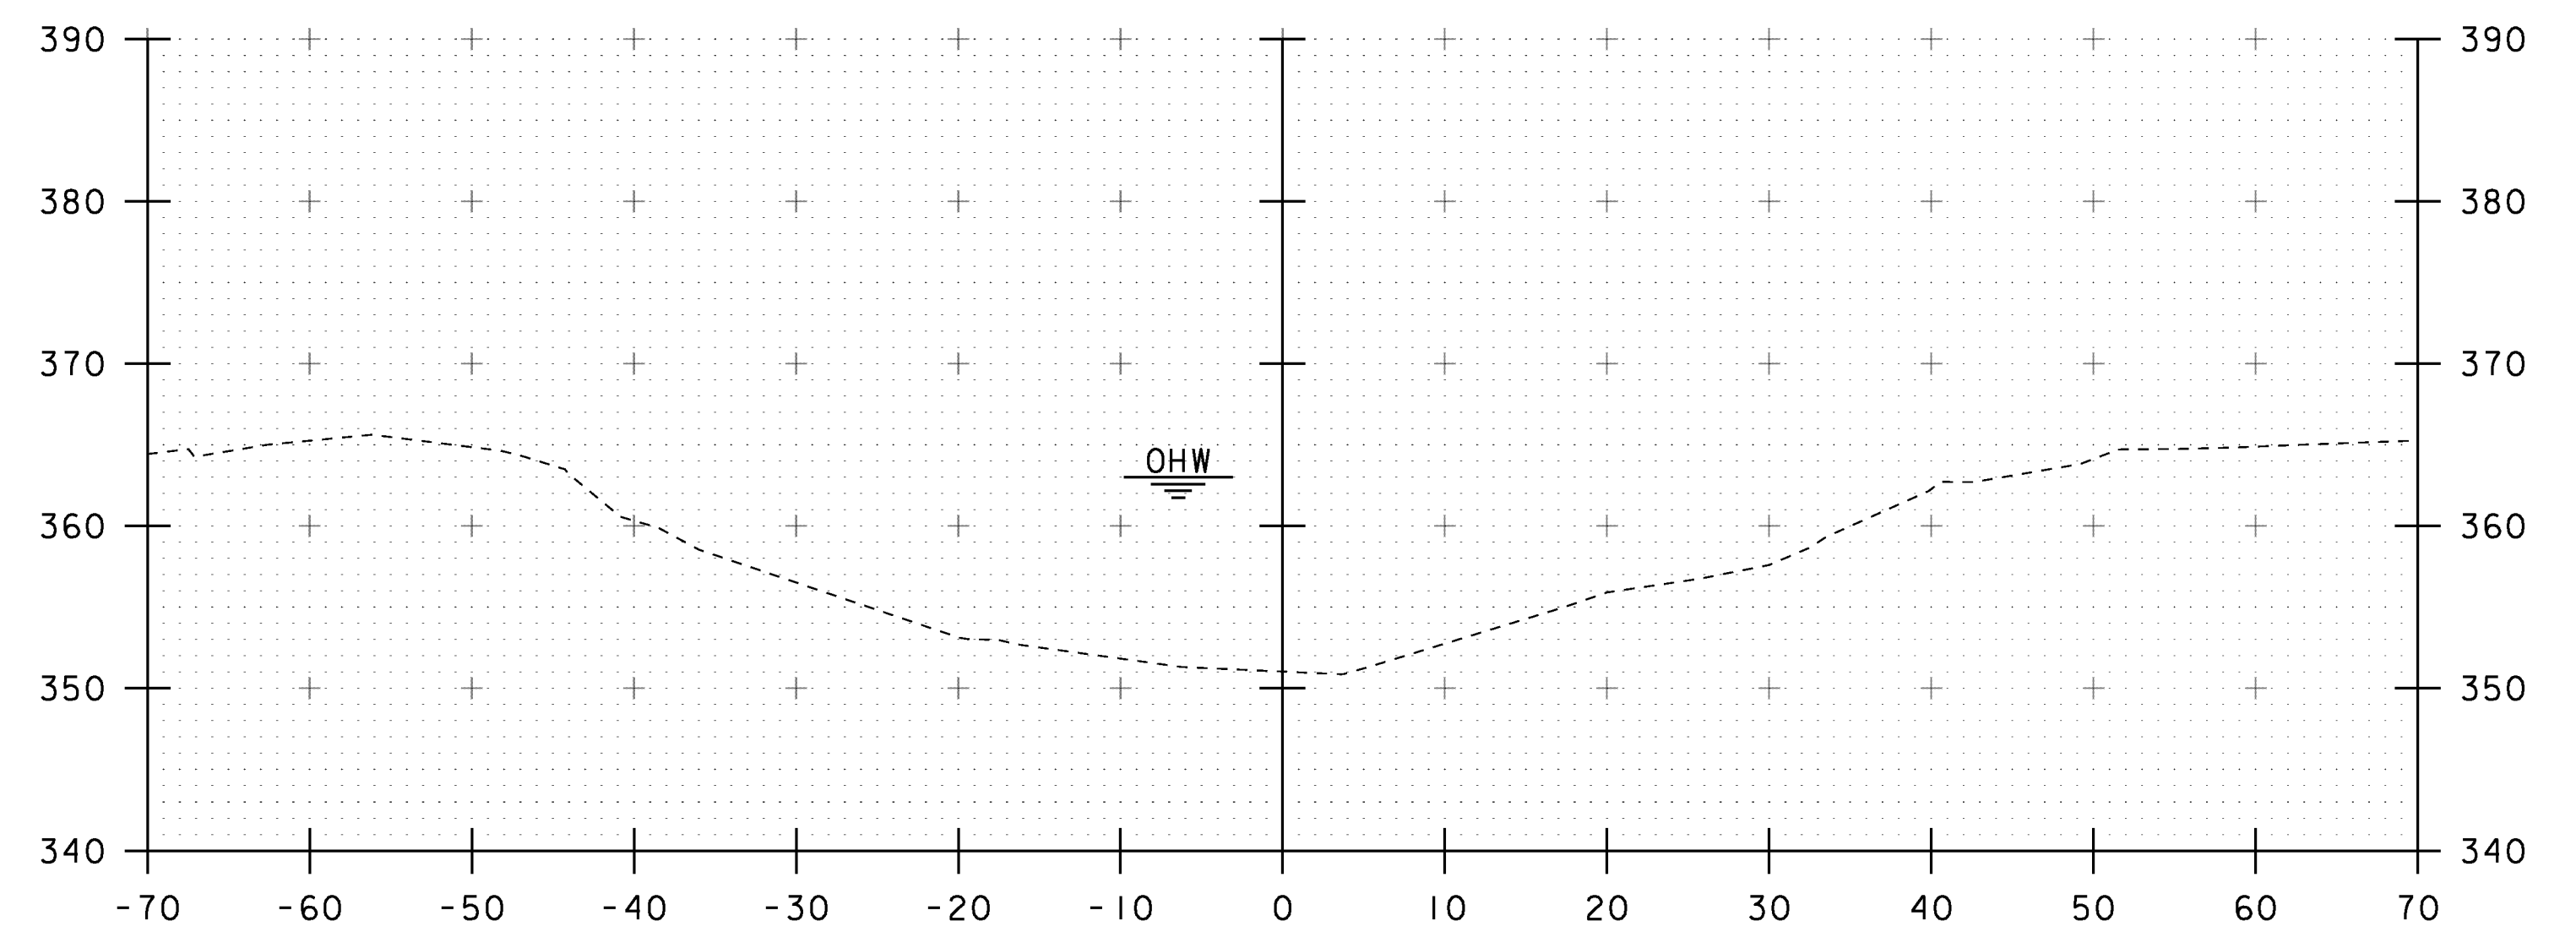

51+50

STA. 51+00 TO STA. 51+50


PROJECT NAME: FAIRFIELD  
 PROJECT NUMBER: BRO 1448(4)

FILE NAME: sl2j170xs.dgn  
 PROJECT LEADER: R. YOUNG  
 DESIGNED BY: R. KLINEFELTER  
 CHANNEL SECTIONS

PLOT DATE: 18-AUG-2014  
 DRAWN BY: K. FRIEDLAND  
 CHECKED BY: J. SALVATORI  
 SHEET 69 OF 69


**CONCRETE GENERAL NOTES**

1. ALL EXPOSED EDGES OF CONCRETE SHALL BE CHAMFERED 1" x 1"
2. REINFORCING STEEL SIZE AND SPACING SHOWN IN THE PLANS IS BASED ON 60 KSI STEEL, UNLESS NOTED OTHERWISE. WITH THE ENGINEER'S PERMISSION, BAR SIZE AND SPACING MAY BE MODIFIED ACCORDING TO THE LATEST AASHTO LRFD BRIDGE DESIGN SPECIFICATION AND STRUCTURES DESIGN MANUAL WHEN USING HIGHER STRENGTH STEEL.

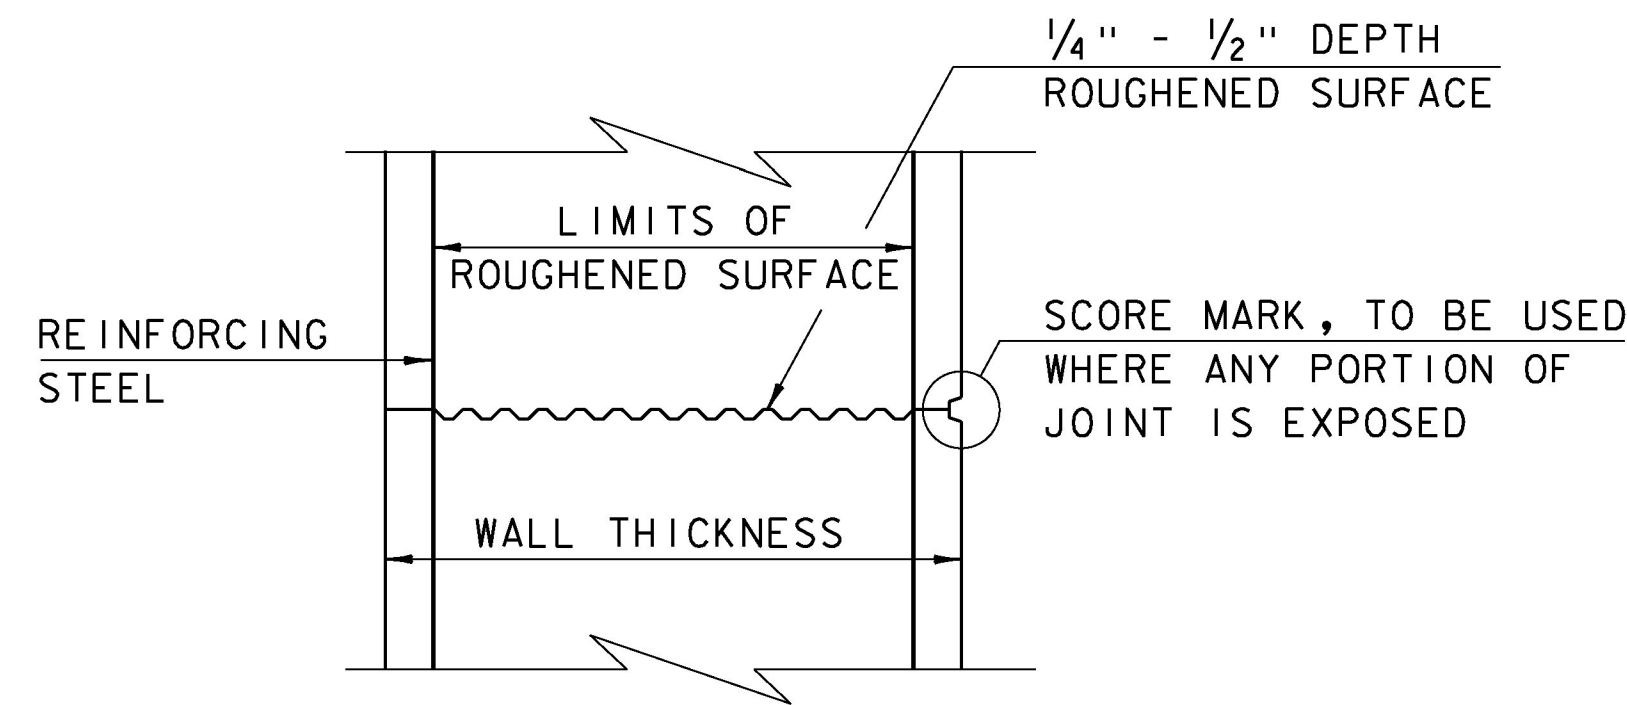


**TYPICAL HORIZONTAL CONSTRUCTION JOINT**  
(NOT TO SCALE)


1. THE SURFACE OF THE CONCRETE CONSTRUCTION JOINTS SHALL BE CLEANED AND FREE OF LAITANCE.
2. IMMEDIATELY BEFORE NEW CONCRETE IS PLACED, ALL CONSTRUCTION JOINTS SHALL BE WETTED AND STANDING WATER REMOVED.

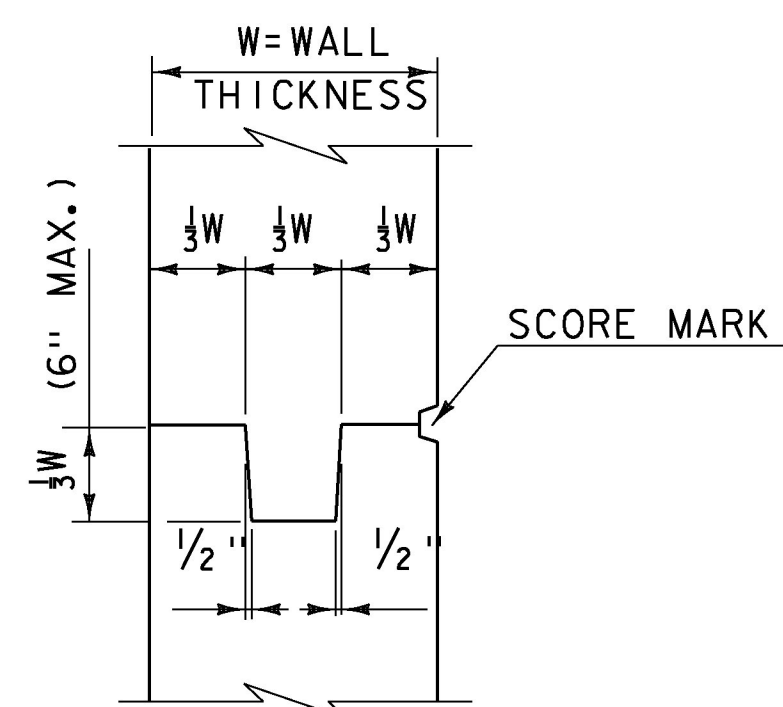


**TYPICAL CONCRETE CONSTRUCTION JOINT**  
(NOT TO SCALE)

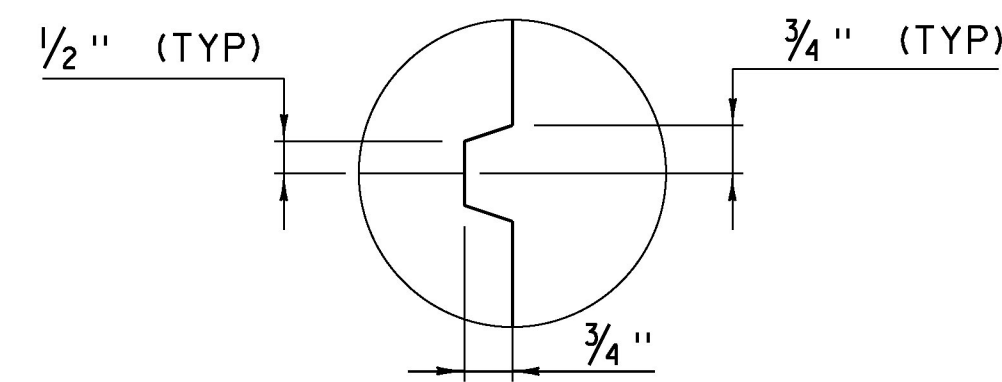


**SCORE MARK DETAIL**  
(NOT TO SCALE)

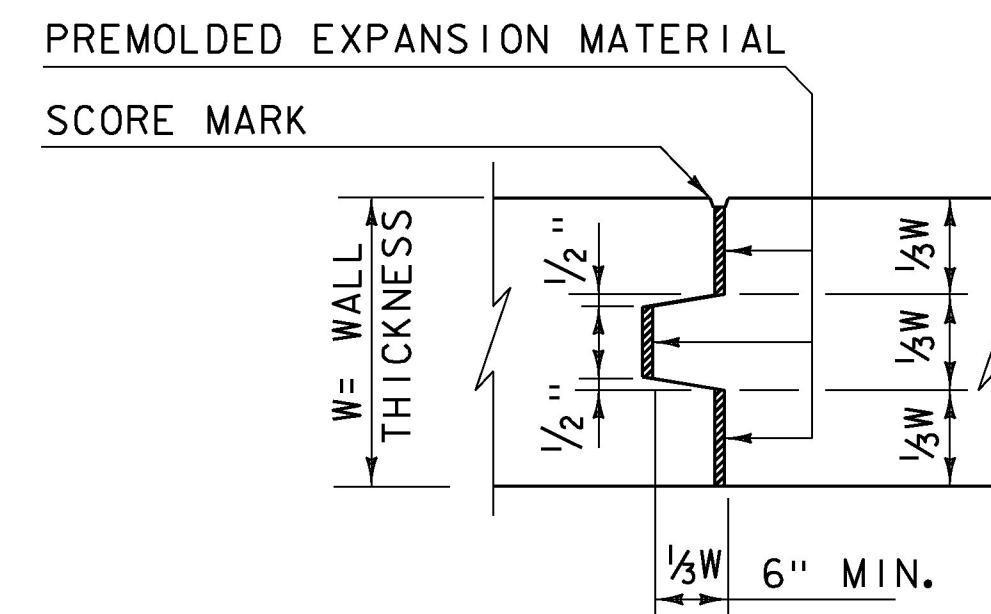

**TYPICAL CONCRETE EXPANSION JOINT**  
(NOT TO SCALE)

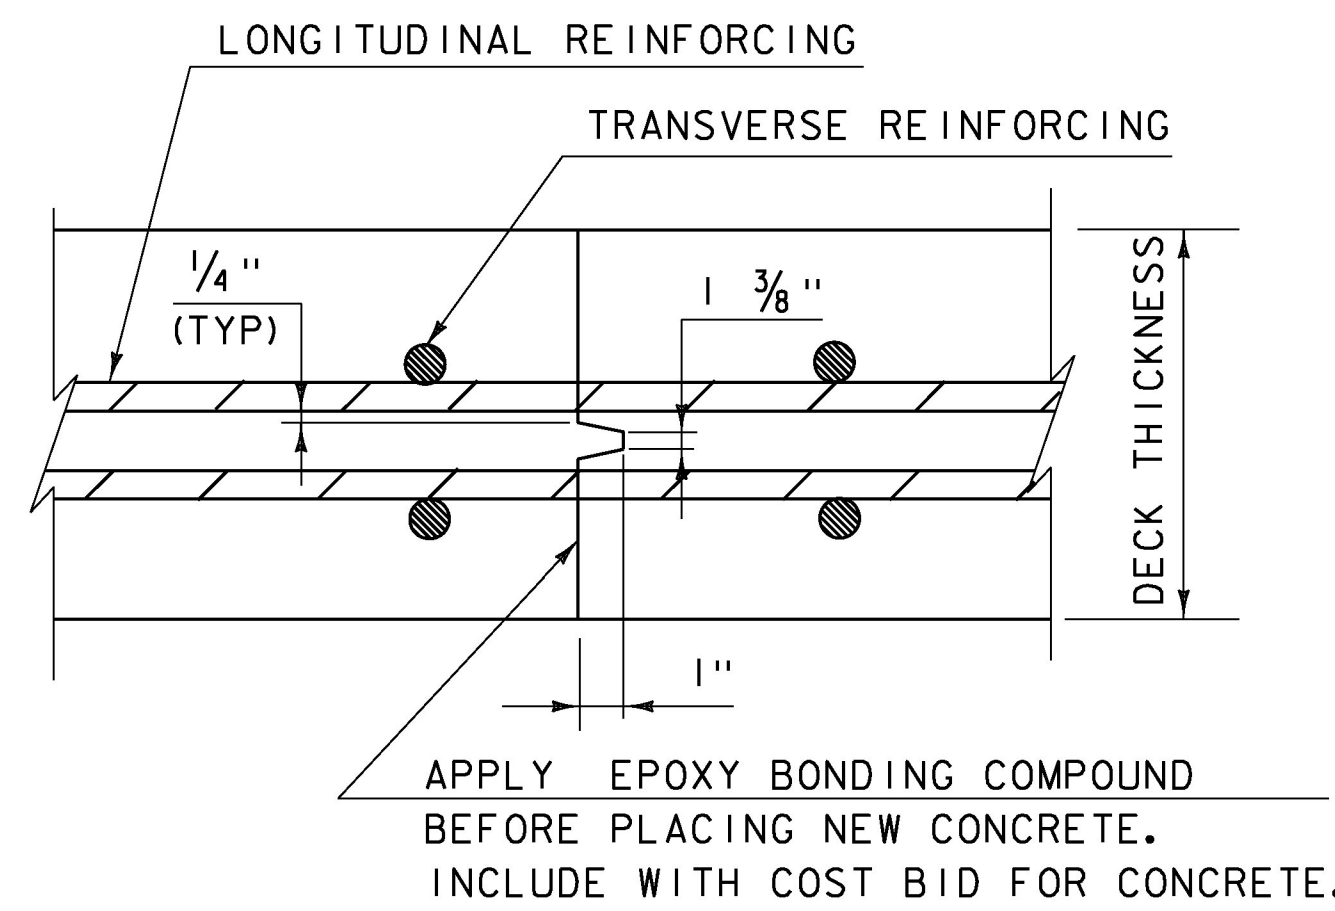


**TRANSVERSE BRIDGE SLAB CONSTRUCTION JOINT DETAILS**  
(NOT TO SCALE)

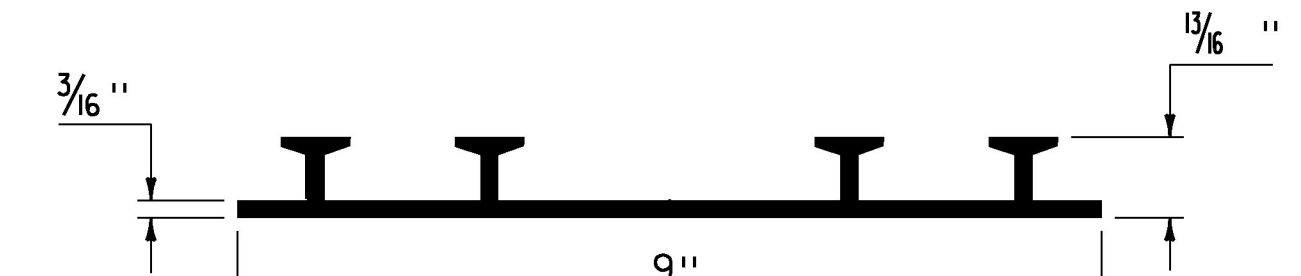

**P.V.C. WATERSTOP FOR CONSTRUCTION JOINTS**  
(NOT TO SCALE)

PAYMENT FOR THE P.V.C. WATERSTOP SHALL BE INCIDENTAL TO THE UNIT BID PRICE FOR THE ADJACENT CONCRETE.


OTHER CONFIGURATIONS OF WATERSTOP MAY BE USED UPON APPROVAL OF THE ENGINEER.

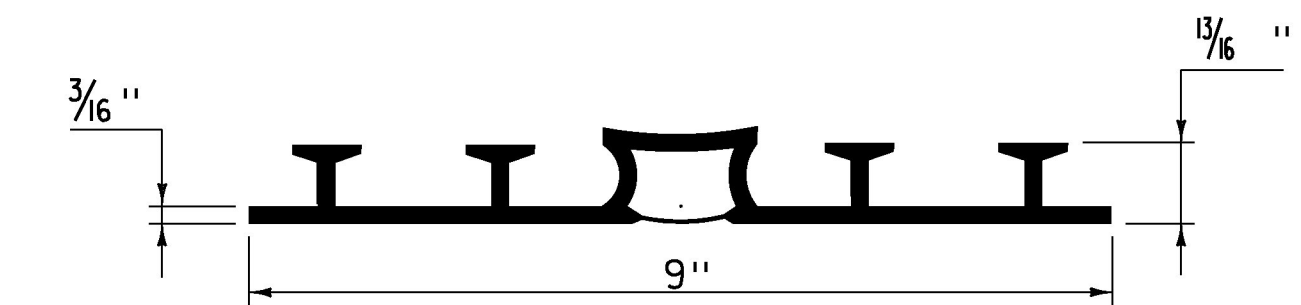

**P.V.C. WATERSTOP FOR EXPANSION JOINTS**  
(NOT TO SCALE)

PAYMENT FOR THE P.V.C. WATERSTOP SHALL BE INCIDENTAL TO THE UNIT BID PRICE FOR THE ADJACENT CONCRETE.

OTHER CONFIGURATIONS OF WATERSTOP MAY BE USED UPON APPROVAL OF THE ENGINEER.

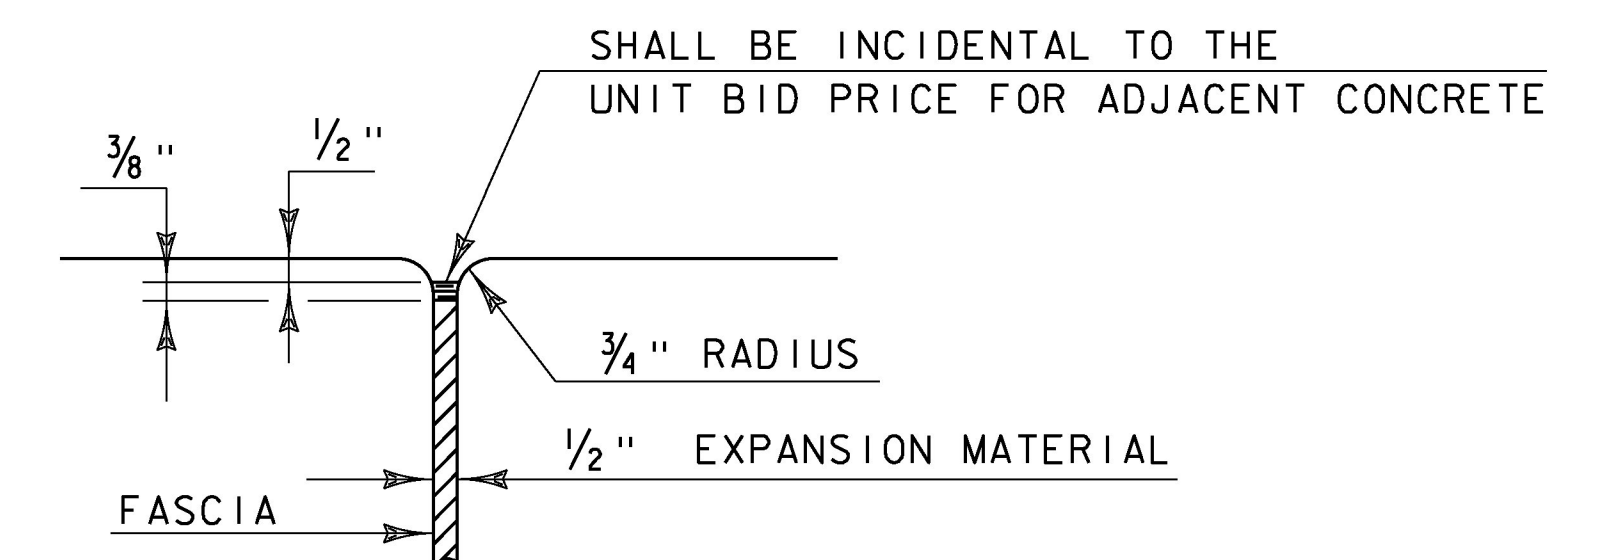


**JOINT BETWEEN FASCIA AND WINGWALL**  
(NOT TO SCALE)


**REVISIONS**

MAY 7, 2010	APPROVED FOR USE BY VAOT STRUCTURES SECTION
FEBRUARY 9, 2012	REBAR SUBSTITUTION ALLOWANCE ADDED TO CONCRETE GENERAL NOTES.


**CONCRETE  
DETAILS AND NOTES**

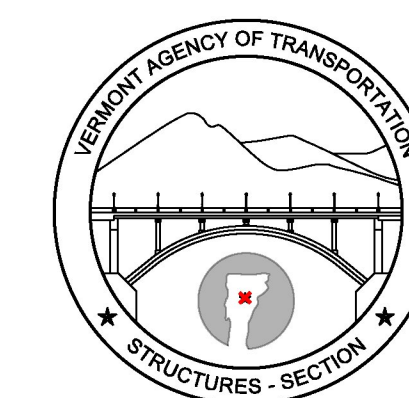

**STRUCTURES  
DETAIL  
SD-501.00**

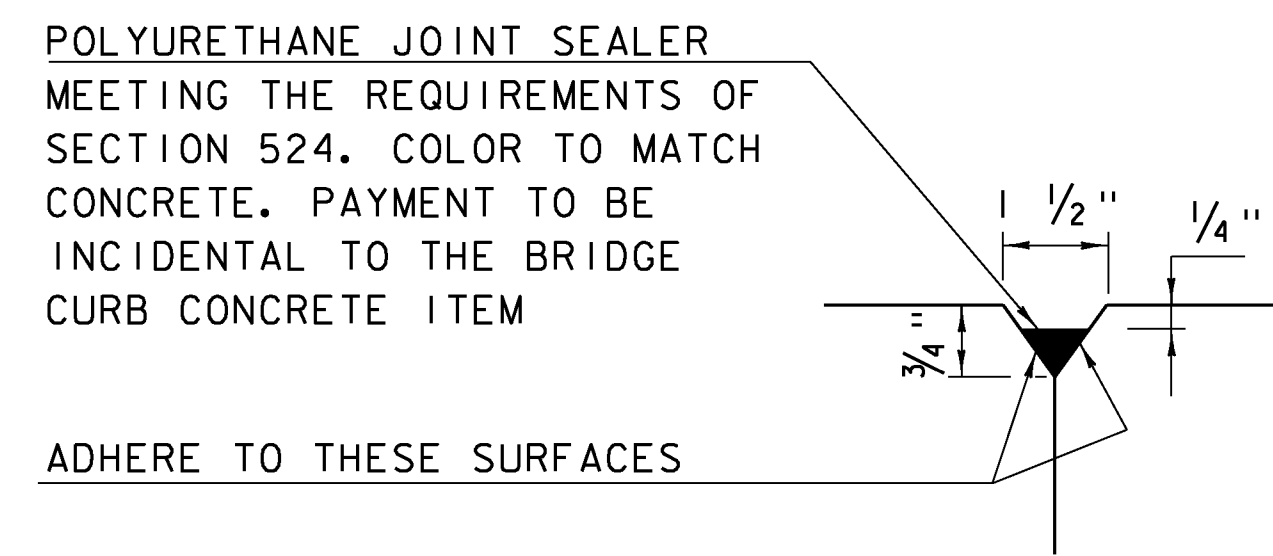


DETAIL "B"  
(NOT TO SCALE)

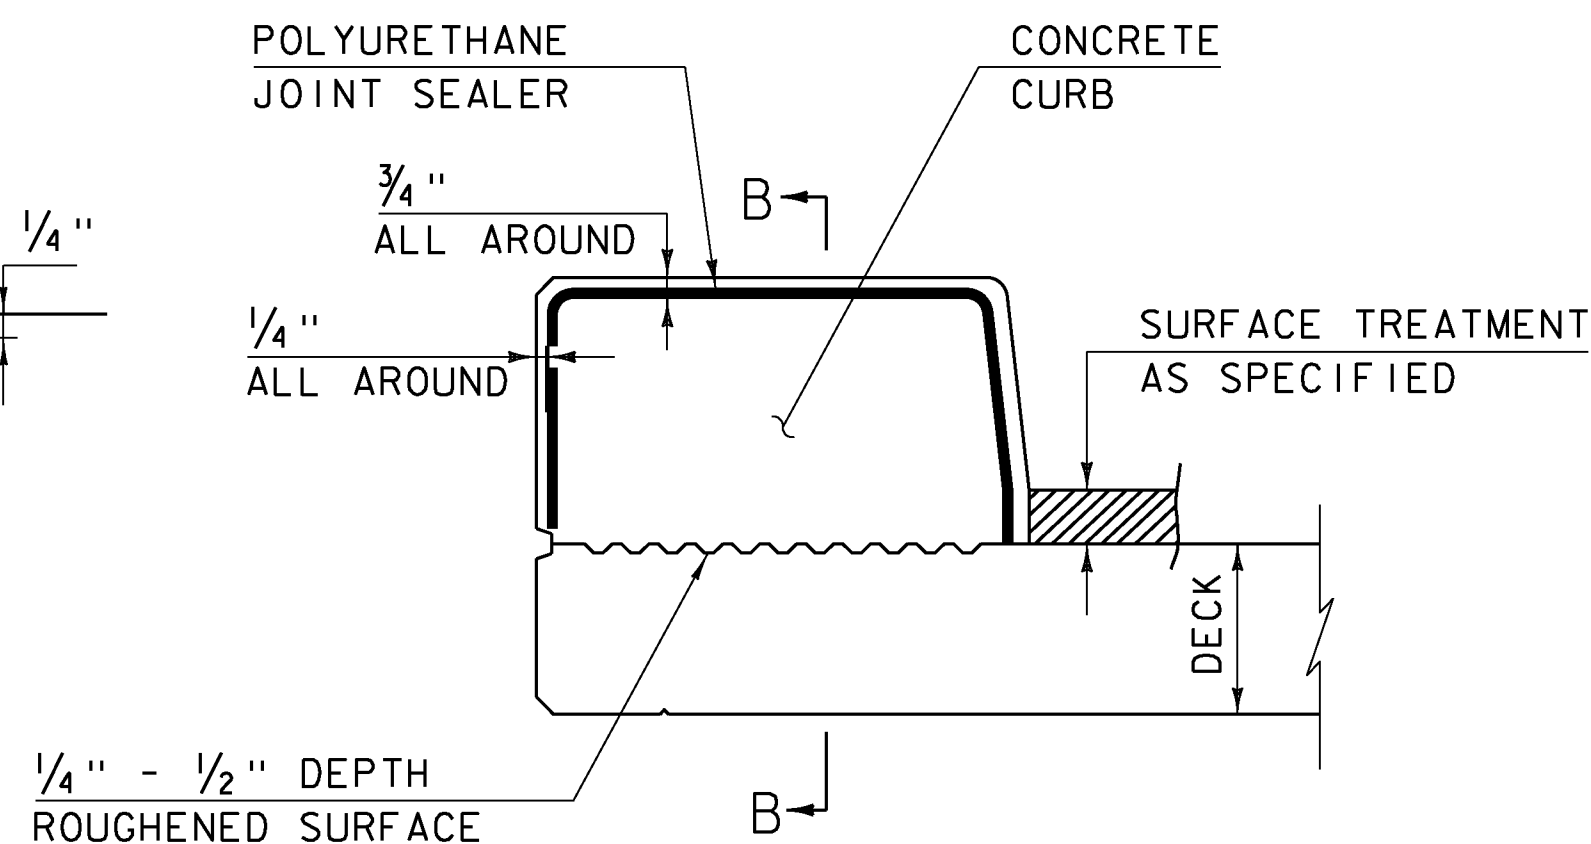


CONCRETE CURB JOINT SECTION  
(NOT TO SCALE)


1. SEE TYPICAL HORIZONTAL CONSTRUCTION JOINT DETAIL FOR ADDITIONAL INFORMATION

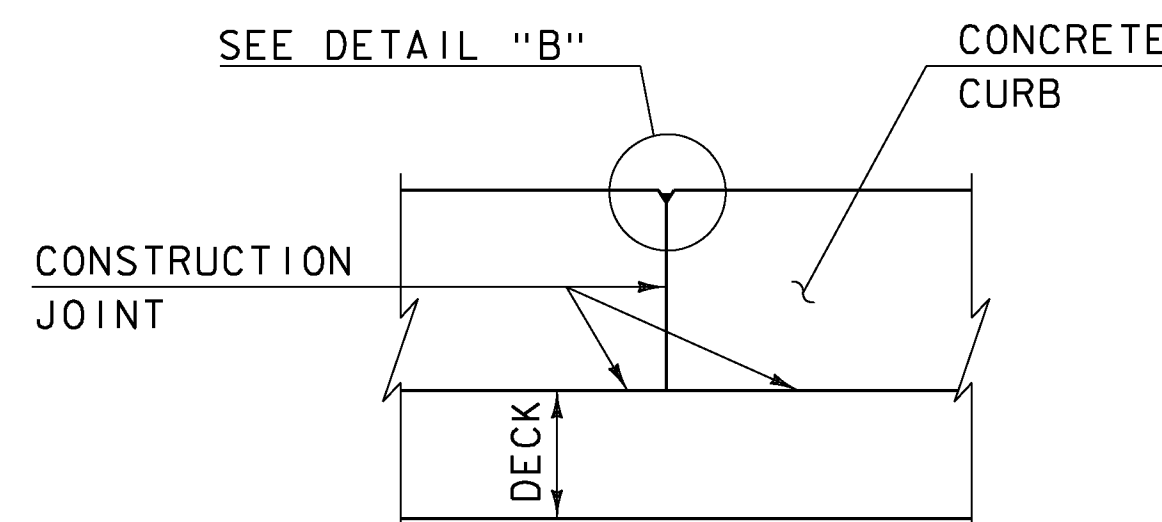


SECTION B - B  
(NOT TO SCALE)

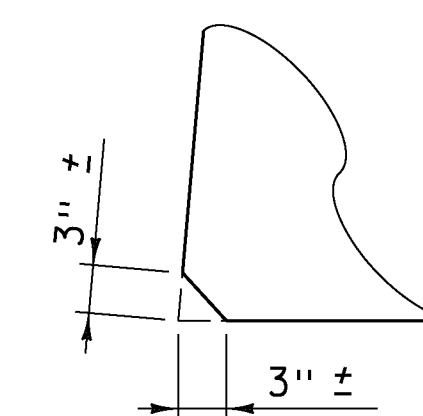

ACUTE ANGLE  
CLIP DETAIL  
(NOT TO SCALE)

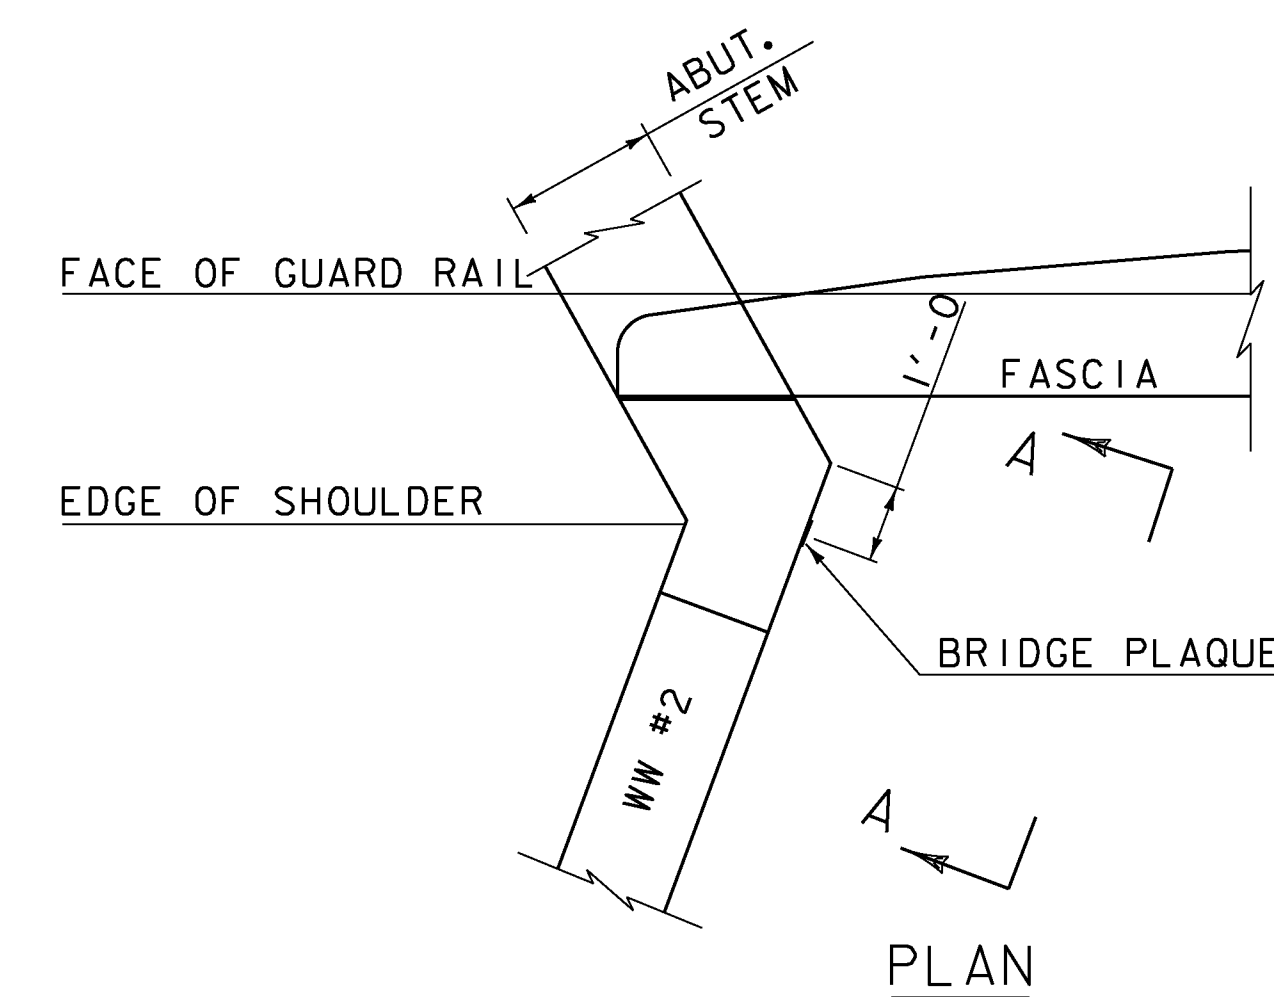

PLAN

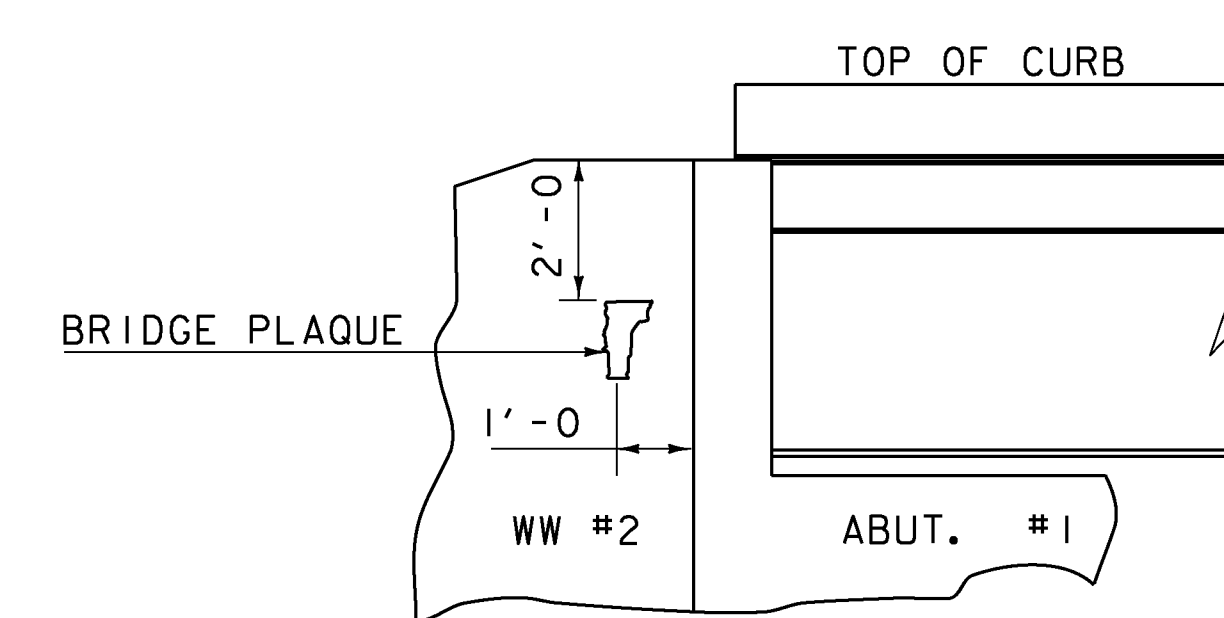

VIEW "A - A"


BRIDGE PLAQUE  
(NOT TO SCALE)

THE BRIDGE PLAQUE WILL BE SUPPLIED BY THE AGENCY OF TRANSPORTATION AND SHALL BE INSTALLED BY THE CONTRACTOR AT ABUTMENT #1 ON THE RIGHT SIDE AS SHOWN OR AS DIRECTED BY THE ENGINEER.


PAYMENT FOR INSTALLATION OF THE BRIDGE PLAQUE SHALL BE INCIDENTAL TO THE ADJACENT CONCRETE.

CONCRETE CURB JOINT NOTES

1. CONCRETE CURBS MAY BE PLACED IN ONE CONTINUOUS OPERATION IF AN APPROVED SHRINKAGE REDUCING ADMIXTURE LISTED IN THE SPECIAL PROVISIONS IS USED WITH THE CONCRETE MIX DESIGN. PAYMENT FOR THE SHRINKAGE REDUCING ADMIXTURE WILL BE INCIDENTAL TO THE BRIDGE CURB CONCRETE ITEM.
2. IF THE CONTRACTOR CHOOSES NOT TO USE AN APPROVED SHRINKAGE REDUCING ADMIXTURE, THE CURBS SHALL BE CONSTRUCTED WITH CONSTRUCTION JOINTS SPACED AT A MAXIMUM OF 15'-0" CENTER TO CENTER AND 2'-0" MINIMUM FROM THE CENTER OF NEAREST BRIDGE RAILING POST.
3. ON MULTI-SPAN CONTINUOUS SUPERSTRUCTURES, REGARDLESS OF WHETHER APPROVED SHRINKAGE REDUCING ADMIXTURE IS USED, CURB JOINTS SHALL BE LOCATED OVER THE CENTERLINE OF PIERS AND 7'-0" EACH SIDE OF THE CENTERLINE OF EACH PIER.
4. WHEN CURB JOINTS ARE USED THE CURBS SHALL BE PLACED IN ALTERNATE SECTIONS WITH A MINIMUM OF 48 HOUR DELAY BETWEEN ADJACENT PLACEMENTS.
5. LONGITUDINAL REINFORCING SHALL BE CONTINUOUS THROUGH CURB CONSTRUCTION JOINTS. CURB STIRRUP BARS SHALL BE TURNED AS NECESSARY TO MAINTAIN COVER IN THE FLARED CURB ENDS.
6. THE JOINT SPACING AND DETAILS SHOWN SHALL APPLY TO SIDEWALKS WHEN SHOWN IN THE PLANS.

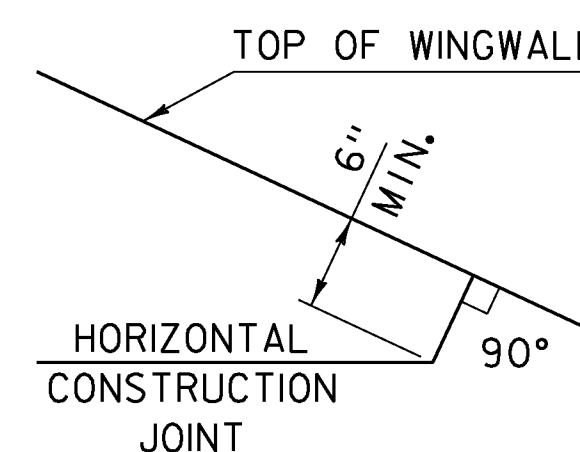


HORIZONTAL WINGWALL  
CONSTRUCTION JOINT  
(NOT TO SCALE)

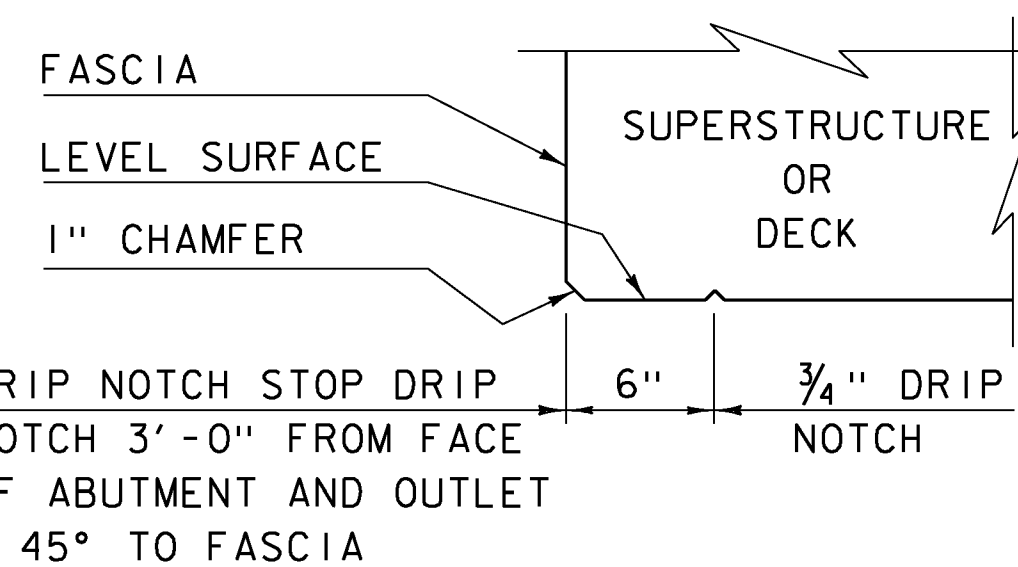


DRIP NOTCH DETAIL  
(NOT TO SCALE)

CONCRETE  
DETAILS AND NOTES

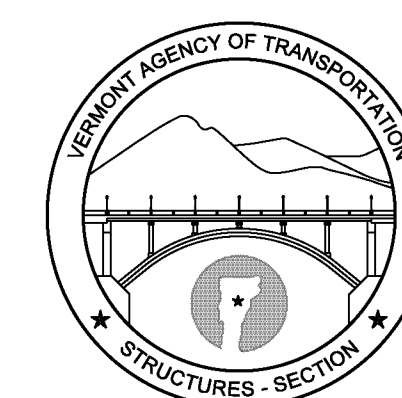

STRUCTURES  
DETAIL  
SD-502.00


REVISIONS	
MAY 7, 2010	APPROVED FOR USE BY VAOT STRUCTURES SECTION
JUNE 4, 2010	MODIFIED AND ADDED TWO DETAILS
OCTOBER 10, 2012	MODIFIED HORZ. JOINT WINGWALL ADD 6" MIN. DIMENSION

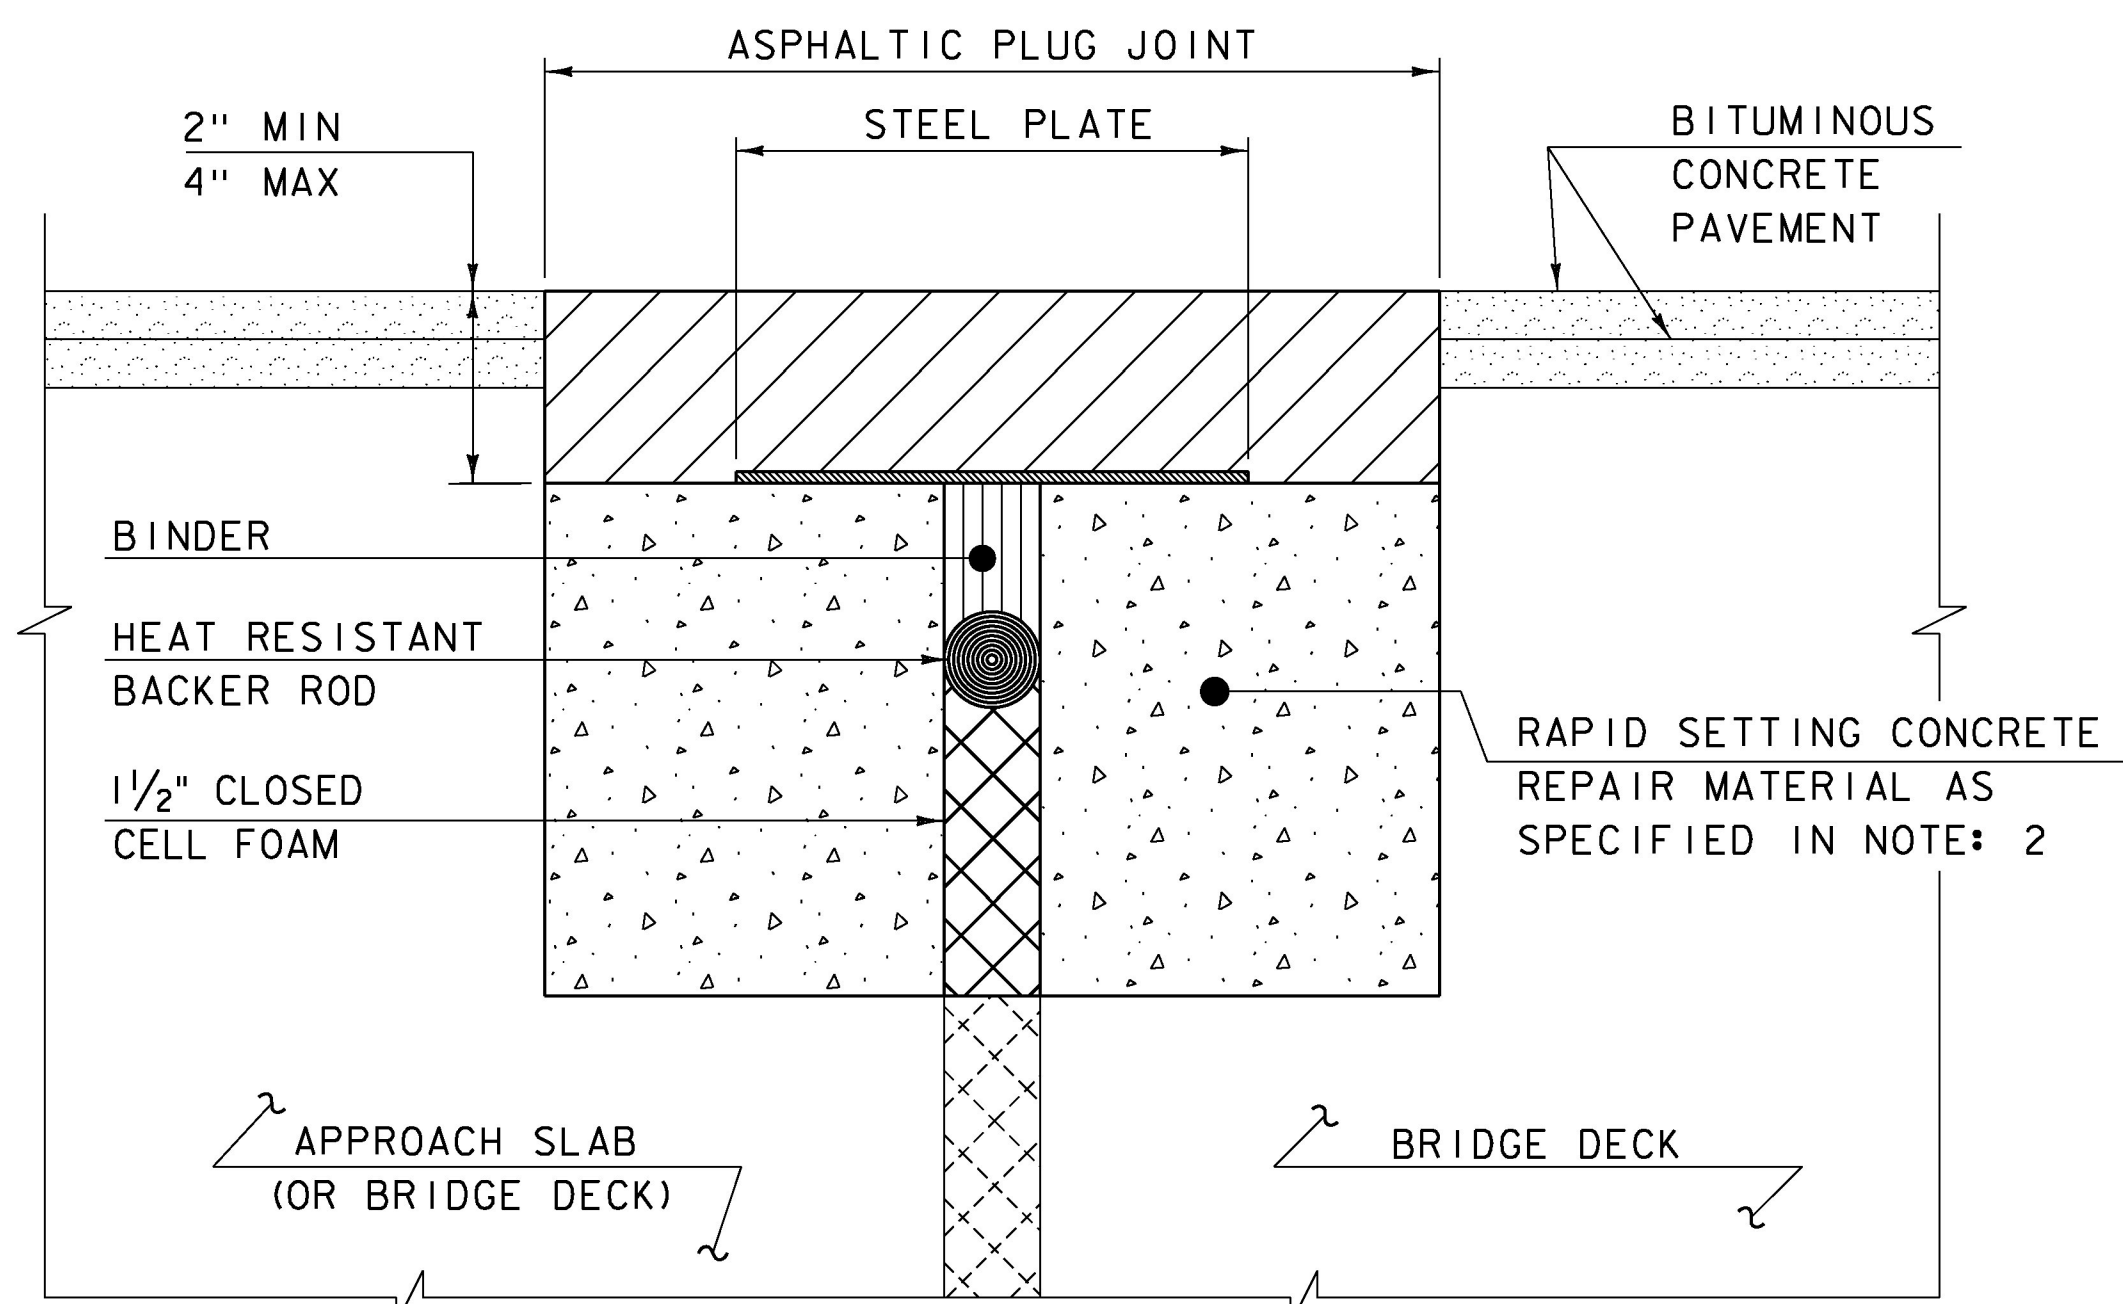

ASPHALTIC PLUG JOINT DETAIL - REHAB

NOTES:


1. THE CONTRACTOR SHALL REMOVE ALL ASPHALTIC PLUG JOINT MATERIAL AND DETERIORATED CONCRETE AS DIRECTED BY THE ENGINEER. REMOVAL OF THE FIRST 4 INCHES OF MATERIAL SHALL BE INCLUDED IN THE BID PRICE FOR ITEM 516.10 BRIDGE EXPANSION JOINT, ASPHALTIC PLUG. ANY REMOVAL OF MATERIAL GREATER THAN 4 INCHES SHALL BE INCLUDED IN THE BID PRICE OF ITEM 580.20 RAPID SETTING CONCRETE REPAIR MATERIAL WITH COARSE AGGREGATE.
2. THE CONTRACTOR SHALL REPLACE REMOVED MATERIAL THAT IS LESS THAN 4" FROM FINISHED GRADE WITH ASPHALTIC PLUG JOINT MATERIAL MEETING THE REQUIREMENTS OF SUBSECTION 707.15. ALL REMOVED MATERIAL THAT IS GREATER THAN 4 INCHES FROM FINISHED GRADE SHALL BE REPLACED WITH RAPID SETTING CONCRETE REPAIR MATERIAL WITH COARSE AGGREGATE MEETING THE REQUIREMENTS OF SUBSECTION 780.04.
3. REINFORCING STEEL NOT SHOWN FOR CLARITY.
4. PLACE 1/4" THICK BY 8" WIDE SECTIONS OF STEEL PLATE OVER THE CENTER OF THE MOVEMENT GAP. SECURE THE PLATES FROM MOVING BY INSERTING LOCATING PINS THROUGH THE PRE-STAMPED HOLES INTO BACKER ROD AND COVER WITH HOT BINDER. THE STEEL PLATES MAY BE OMITTED WHERE THE ENGINEER DETERMINES THAT THE APPROACH SLAB OR BRIDGE DECK WILL PROVIDE INADEQUATE SUPPORT AND WHERE VERTICAL MOVEMENT OF THE PLATES MIGHT OCCUR.

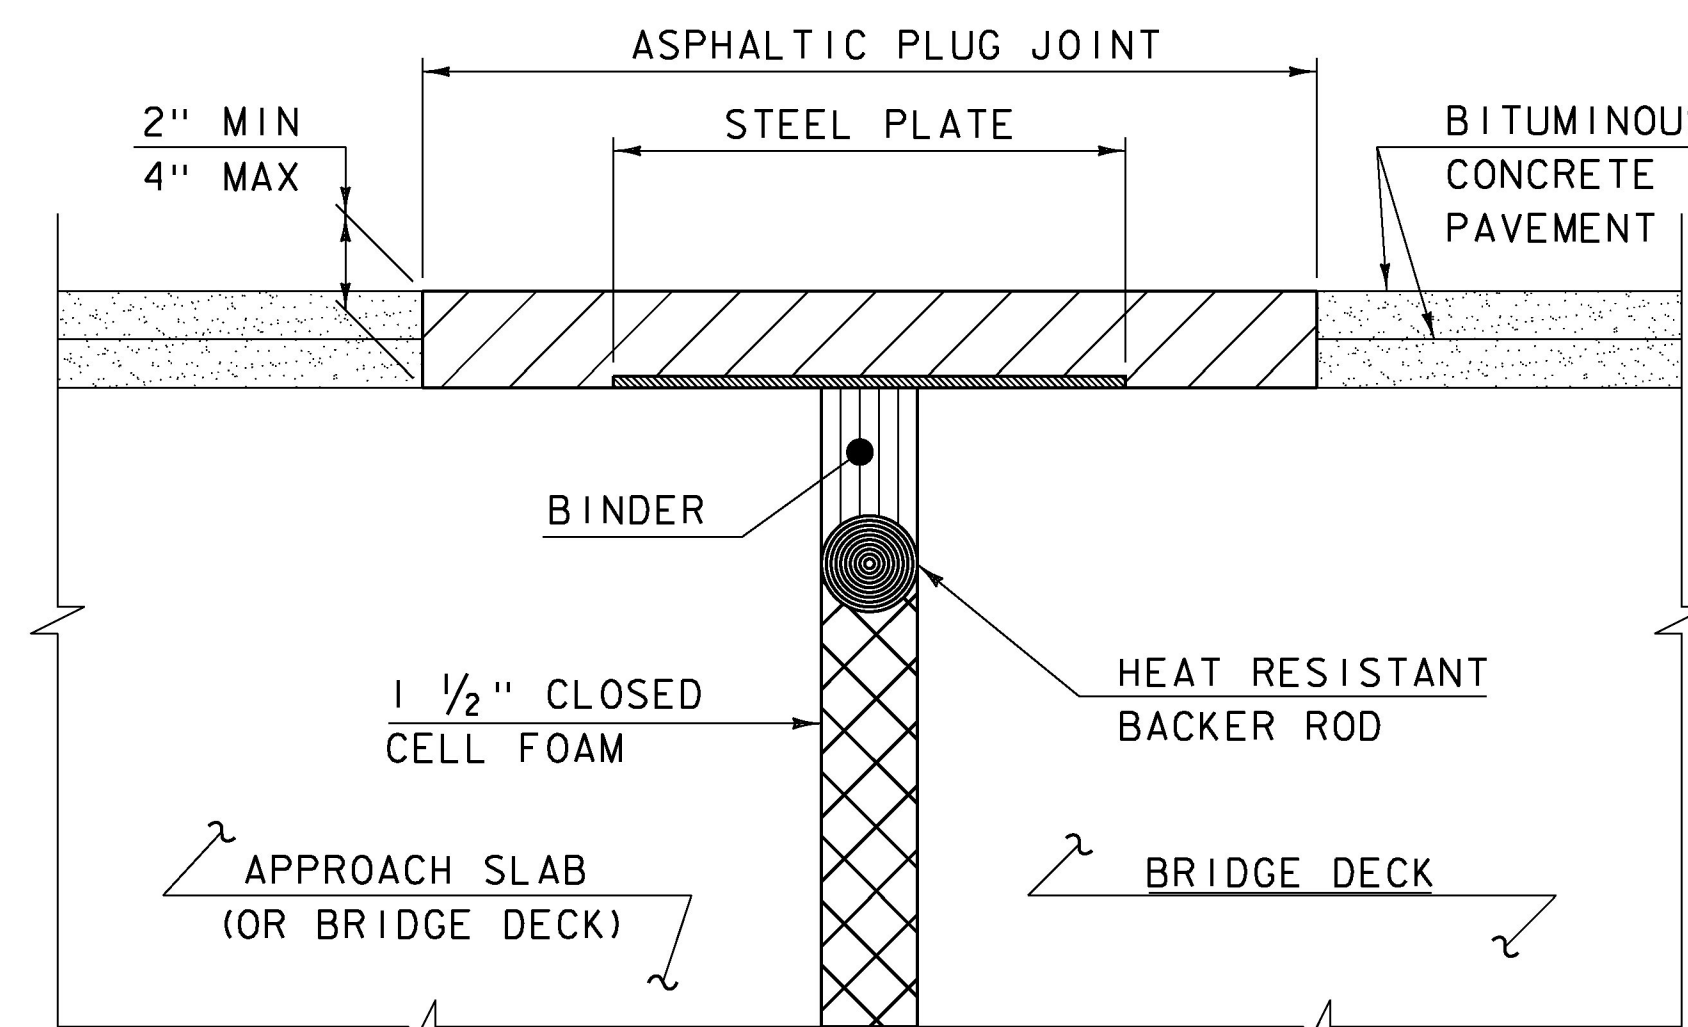

ASPHALTIC PLUG JOINT DETAIL "A" - NEW

NOTE:

PLACE 1/4" THICK BY 8" WIDE SECTIONS OF STEEL PLATE OVER THE CENTER OF THE MOVEMENT GAP. SECURE THE PLATES FROM MOVING BY INSERTING LOCATING PINS THROUGH THE PRE-STAMPED HOLES INTO BACKER ROD AND COVER WITH HOT BINDER.

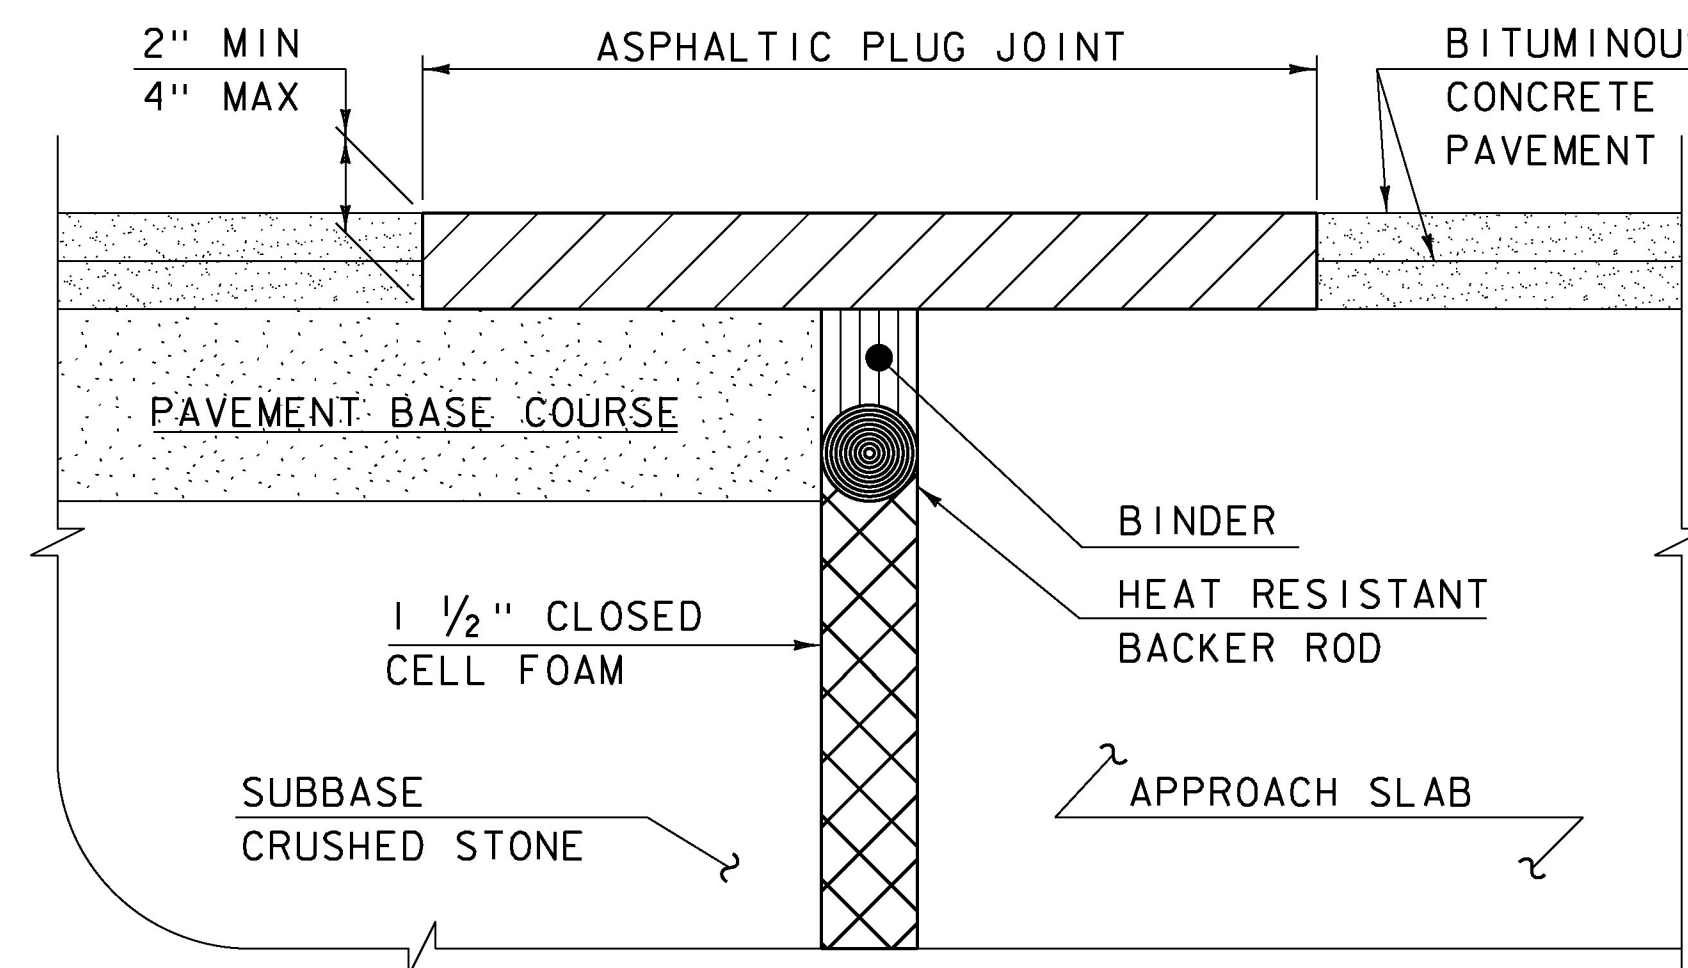

ASPHALTIC PLUG JOINT DETAIL "B" - NEW

ASPHALTIC PLUG JOINT NOTES

INSTALLATION:

1. LOCATE THE JOINT CENTRALLY OVER THE DECK OVERLAY EXPANSION GAP OR FIXED JOINT, MARKED OUT TO THE MANUFACTURER'S RECOMMENDED WIDTH.
2. REMOVE THE BITUMINOUS CONCRETE PAVEMENT FULL DEPTH AS SHOWN ON THE PLANS. THE PAVEMENT SHALL BE DRY AND SAW CUT TO THE LIMITS REQUIRED TO PLACE THE JOINT. A PNEUMATIC HAMMER AND CHISEL MAY BE USED ADJACENT TO THE CURB ONLY WHEN SAW CUTTING IS NOT POSSIBLE.
3. BLAST CLEAN THE JOINT AREA OF DEBRIS, ASPHALT AND SHEET MEMBRANE. THOROUGHLY DRY THE JOINT AREA WITH COMPRESSED AIR PRIOR TO APPLYING BINDER MATERIAL.
4. PLACE PROPERLY SIZED HEAT RESISTANT BACKER ROD IN THE MOVEMENT GAP ALLOWING FOR 1" +/- OF BINDER ABOVE THE ROD.
5. HEAT AND PLACE THE BINDER MATERIAL AS RECOMMENDED BY THE MANUFACTURER.
6. IMMEDIATELY AFTER TOP COATING, CAST AN ANTI-SKID MATERIAL OVER THE JOINT TO REDUCE THE RISK OF TRACKING.

WEATHER LIMITATIONS


APPLY BINDER MATERIAL ONLY WHEN THE FOLLOWING CONDITIONS PREVAIL OR AS RECOMMENDED BY THE MANUFACTURER:

1. THE AMBIENT AIR TEMPERATURE IS AT LEAST 10 DEG C (50 DEG F) AND RISING.
2. THE ROAD SURFACE IS DRY.
3. WEATHER CONDITIONS OR OTHER CONDITIONS ARE FAVORABLE AND ARE EXPECTED TO REMAIN SO FOR THE PERFORMANCE OF SATISFACTORY WORK.

DETAILS ON THIS SHEET ARE NOT TO SCALE.

REVISIONS	
MAY 7, 2010	APPROVED FOR USE BY VAOT STRUCTURES SECTION
AUGUST 29, 2011	ADD DETAIL "B" AND REV. NOTES


BRIDGE JOINT  
ASPHALTIC PLUG

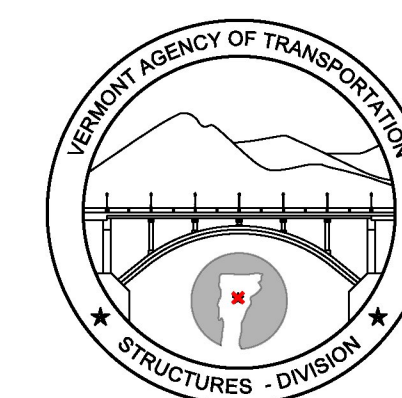


STRUCTURES  
DETAIL  
SD-516.10

**STRUCTURAL STEEL GENERAL NOTES:**

1. ALL FIELD CONNECTIONS SHALL BE MADE WITH 7/8" DIAMETER HIGH-STRENGTH BOLTS IN 15/16" DIAMETER HOLES, PER SUBSECTION 506.I9, UNLESS OTHERWISE SPECIFIED.
2. ALL HOLES IN THE WEBS OF THE FASCIA GIRDERS THAT ARE NOT OTHERWISE FILLED, SHALL BE FILLED WITH EITHER BUTTON HEAD OR HEX HEAD BOLTS. THESE BOLTS SHALL BE TIGHTENED IN ACCORDANCE WITH SUBSECTION 506.I9.
3. ALL WELDING SHALL CONFORM TO THE PROVISIONS OF SUBSECTION 506.I0.
4. ANY CONNECTIONS THAT ARE NOT DETAILED ON THE PLANS SHALL BE DETAILED BY THE FABRICATOR AND SUBMITTED TO THE STRUCTURES ENGINEER FOR APPROVAL.
5. STRUCTURAL STEEL MEMBERS DESIGNATED "CVN" IN THE PLANS SHALL BE CHARPY V-NOTCH TESTED IN ACCORDANCE WITH SUBSECTION 714.01 OF THE STANDARD SPECIFICATIONS.
6. ENDS OF GIRDERS ARE TO BE VERTICAL IN THEIR FINAL POSITION.
7. AFTER SUPERSTRUCTURE STEEL HAS BEEN ERECTED, ELEVATIONS ALONG THE TOP OF THE GIRDERS SHALL BE TAKEN AS DIRECTED BY THE RESIDENT ENGINEER FOR USE IN DETERMINING FINISHED GRADES.

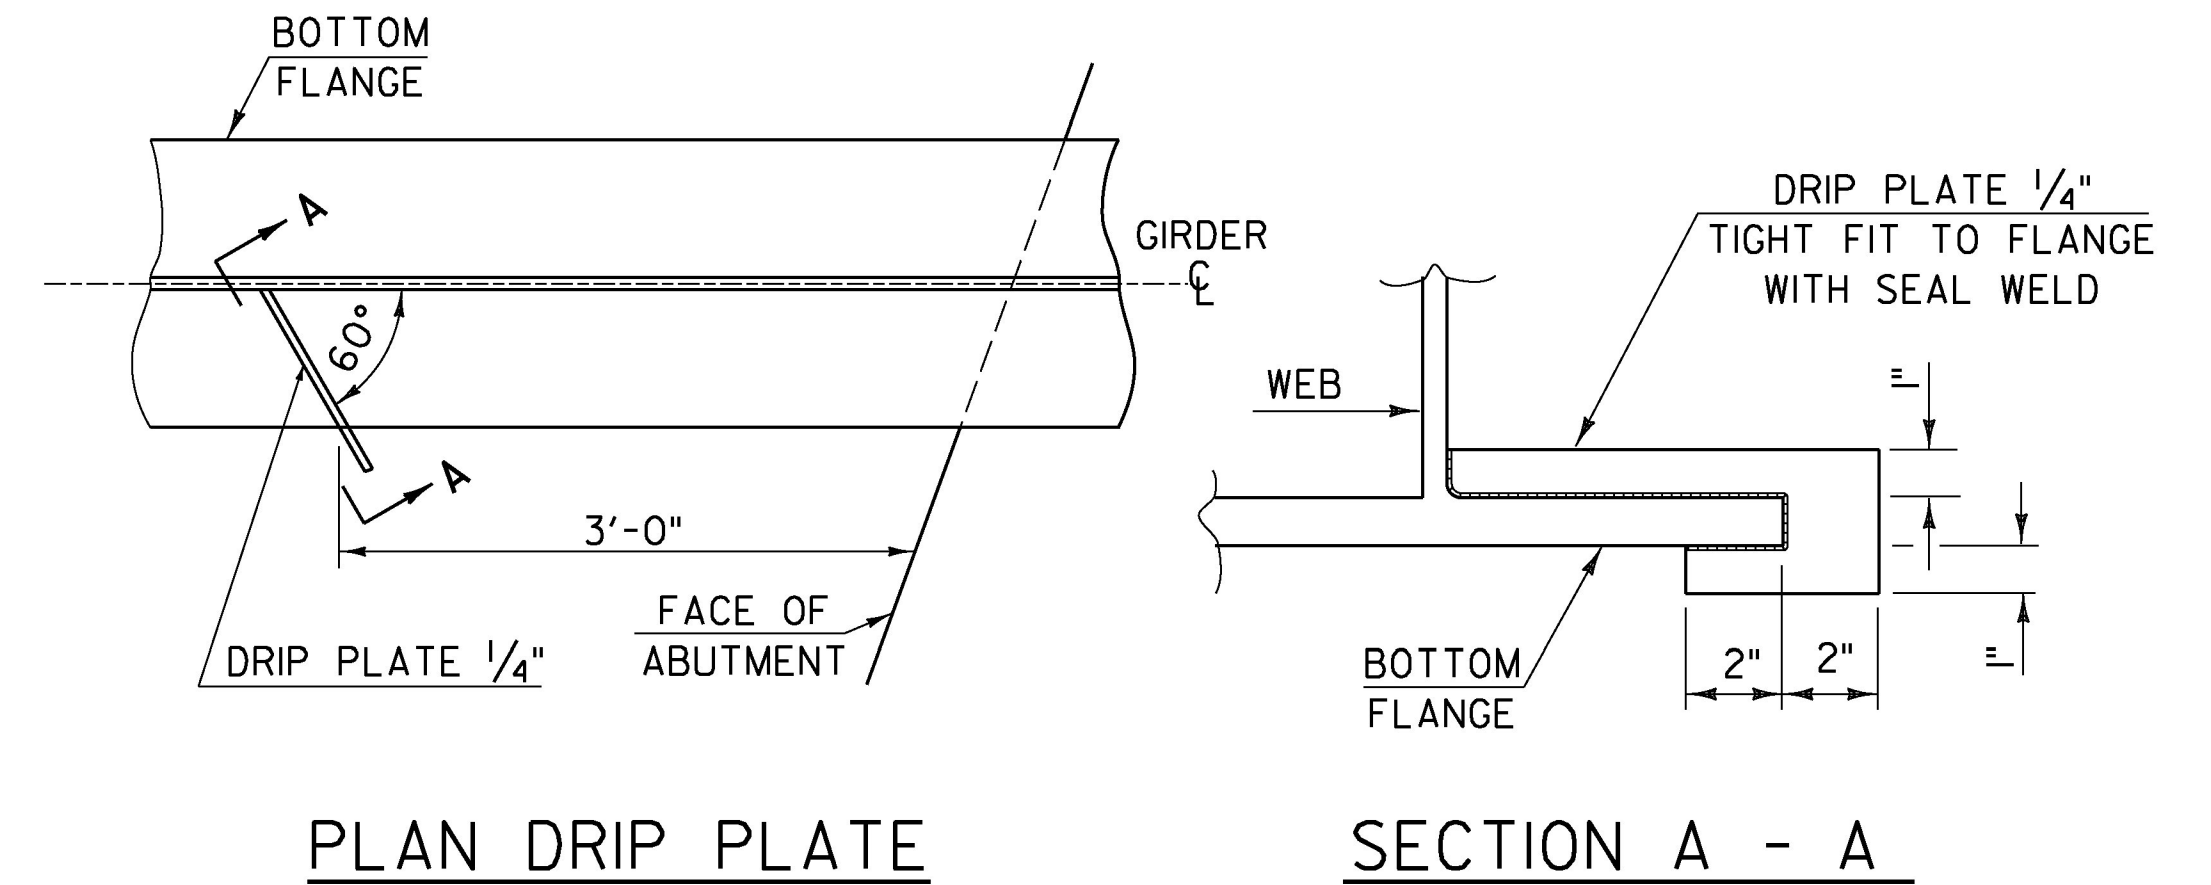


NOTE: DRIP PLATES SHALL BE PLACED ON OUTSIDE EDGE OF FASCIA GIRDERS ON THE HIGH SIDE OF ALL PIERS AND ABUTMENTS OR AS INDICATED ON PROJECT PLANS.

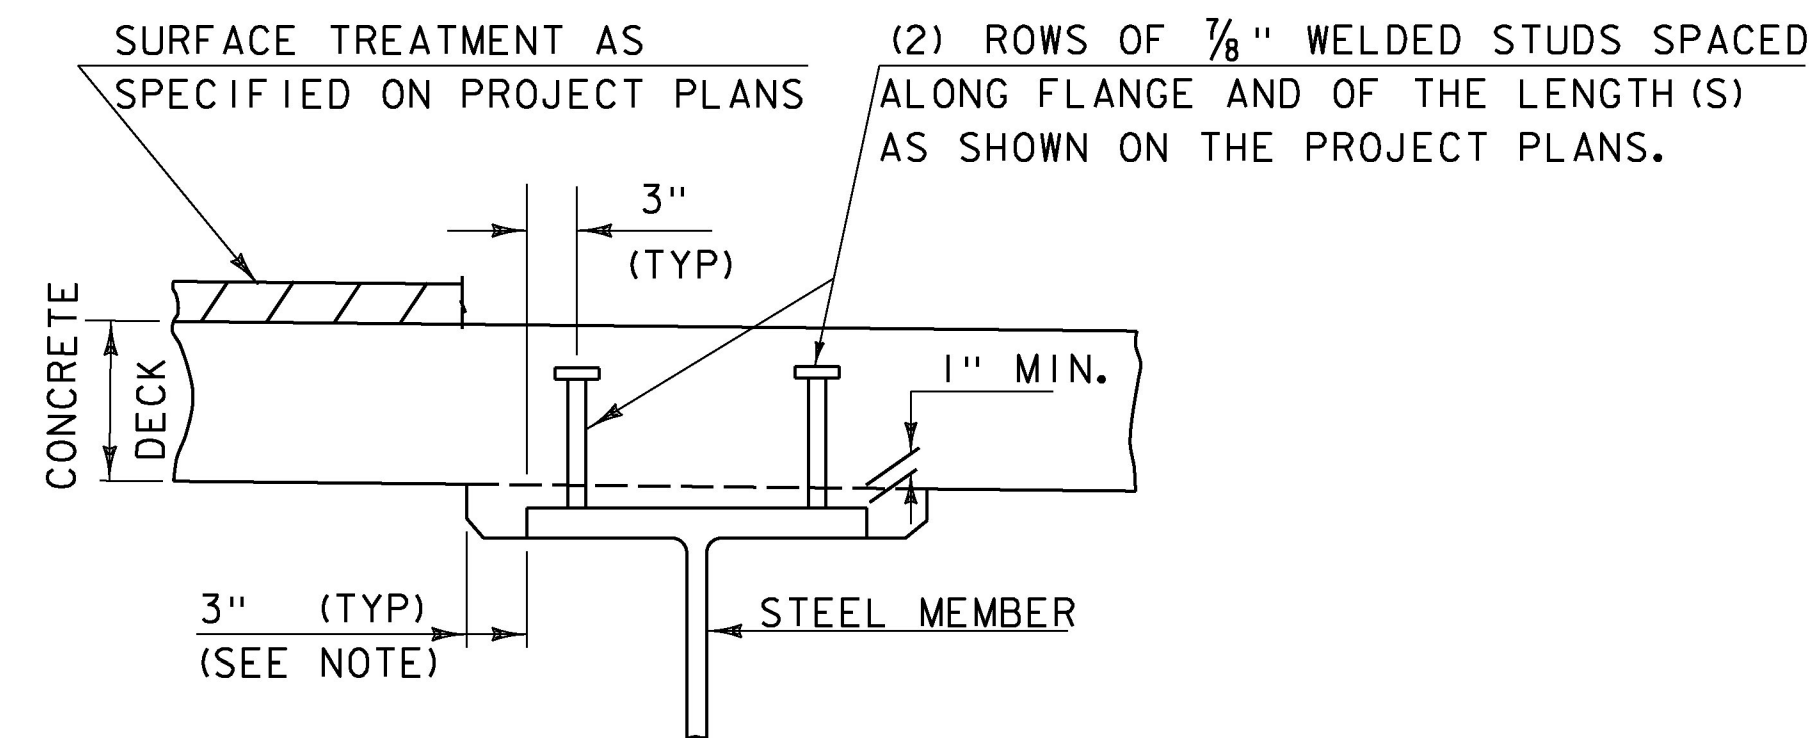

NOTE:  
THE 3" HORIZONTAL SECTION MAY BE ELIMINATED FOR FORMING SYSTEMS DESIGNED FOR THE CONSTRUCTION OF VERTICAL HAUNCHES. ANY VOIDS RESULTING FROM FORMING SYSTEM ELEMENTS SHALL BE FILLED WITH JOINT SEALER, POLYURETHANE MEETING THE REQUIREMENTS OF SECTION 524. THE COST OF THE JOINT SEALER, POLYURETHANE SHALL BE INCIDENTAL TO THE ADJACENT CONCRETE.

HAUNCH AND SHEAR CONNECTOR DETAIL

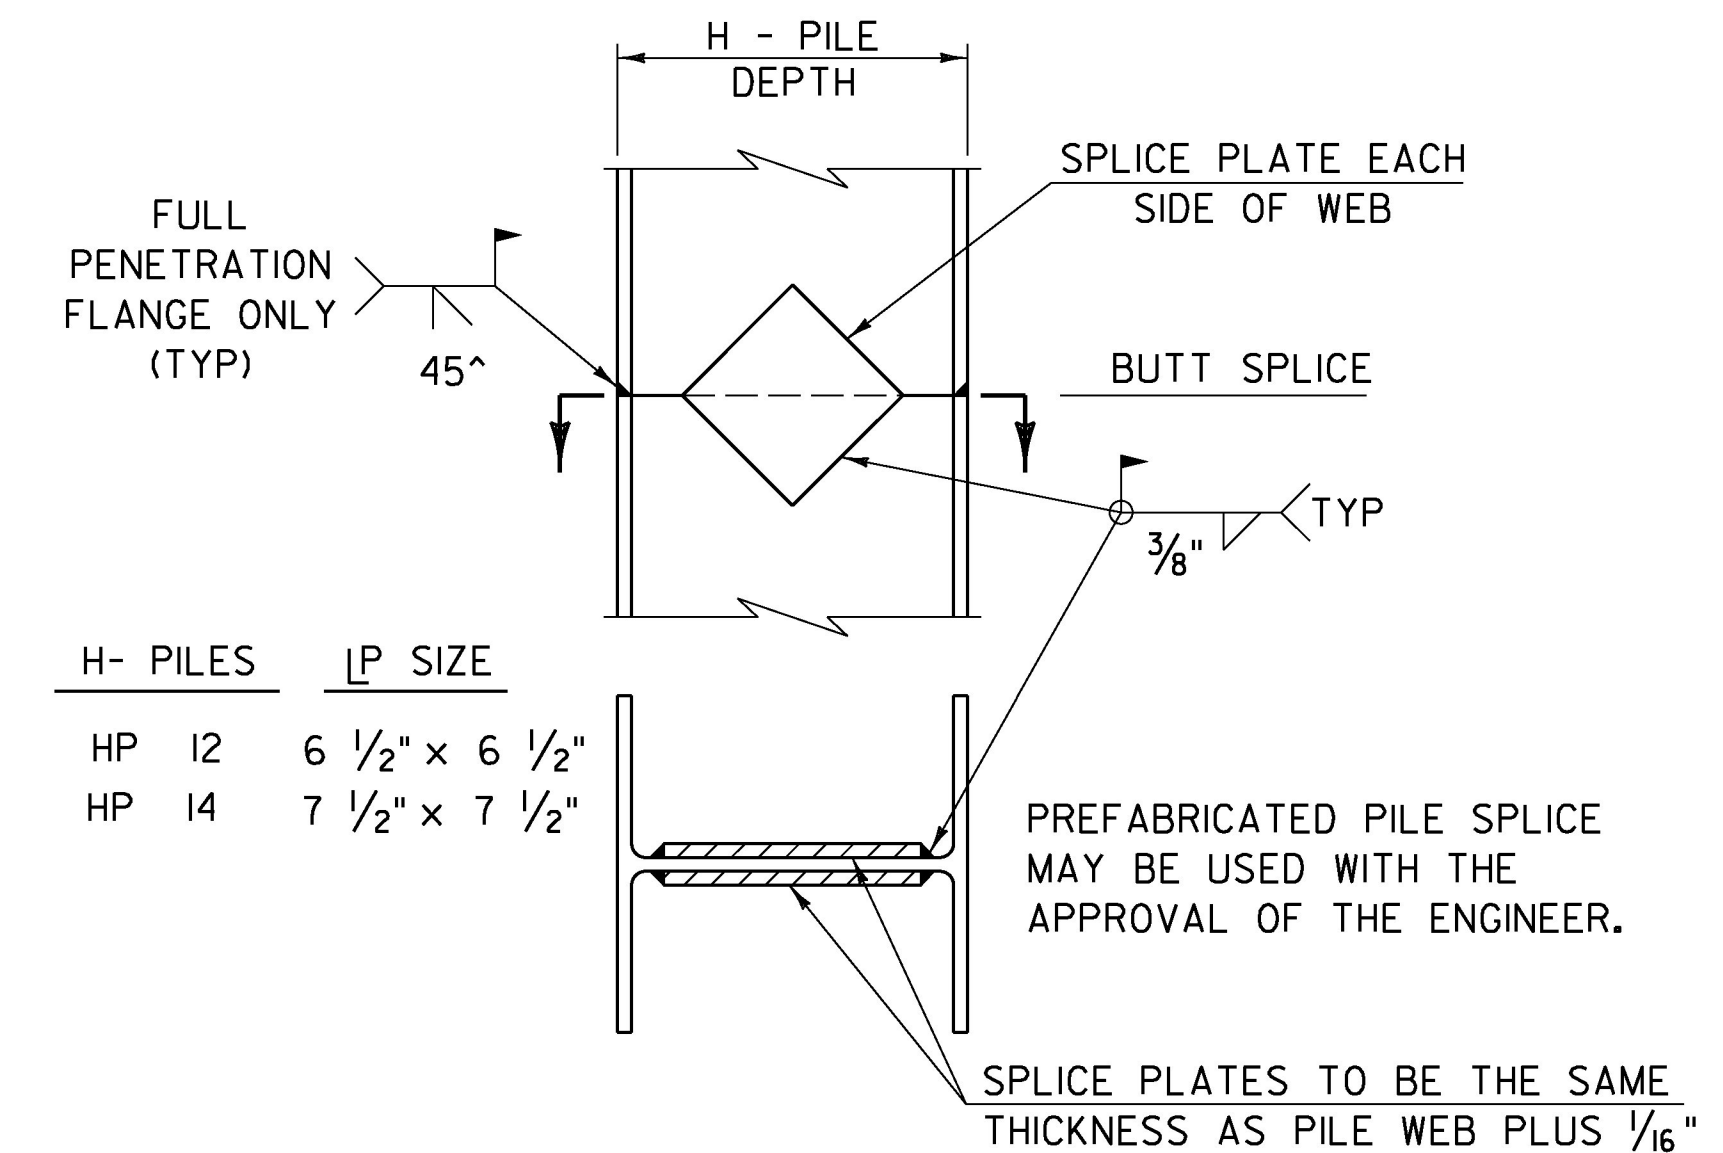


DETAIL OF PILE SPLICE

DETAILS ON THIS SHEET ARE "NOT TO SCALE" UNLESS NOTED OTHERWISE.

**REVISIONS**


MAY 7, 2010	APPROVED FOR USE BY VAOT STRUCTURES SECTION
JUNE 4, 2010	MODIFIED NOTES

**STRUCTURAL STEEL  
DETAILS & NOTES**

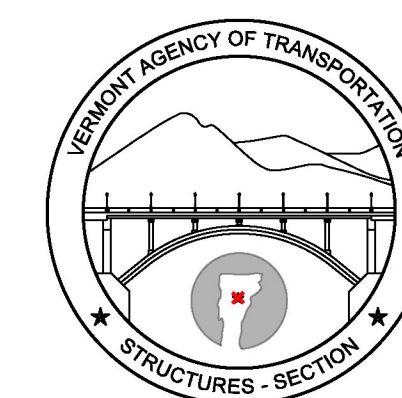


**STRUCTURES  
DETAIL  
SD-601.00**

REVISIONS					
ZONE	REV	DESCRIPTION	REVISED BY	DATE	APPROVED
--	A	PER ENGINEERS MARKS	EG	1/27/15	BF

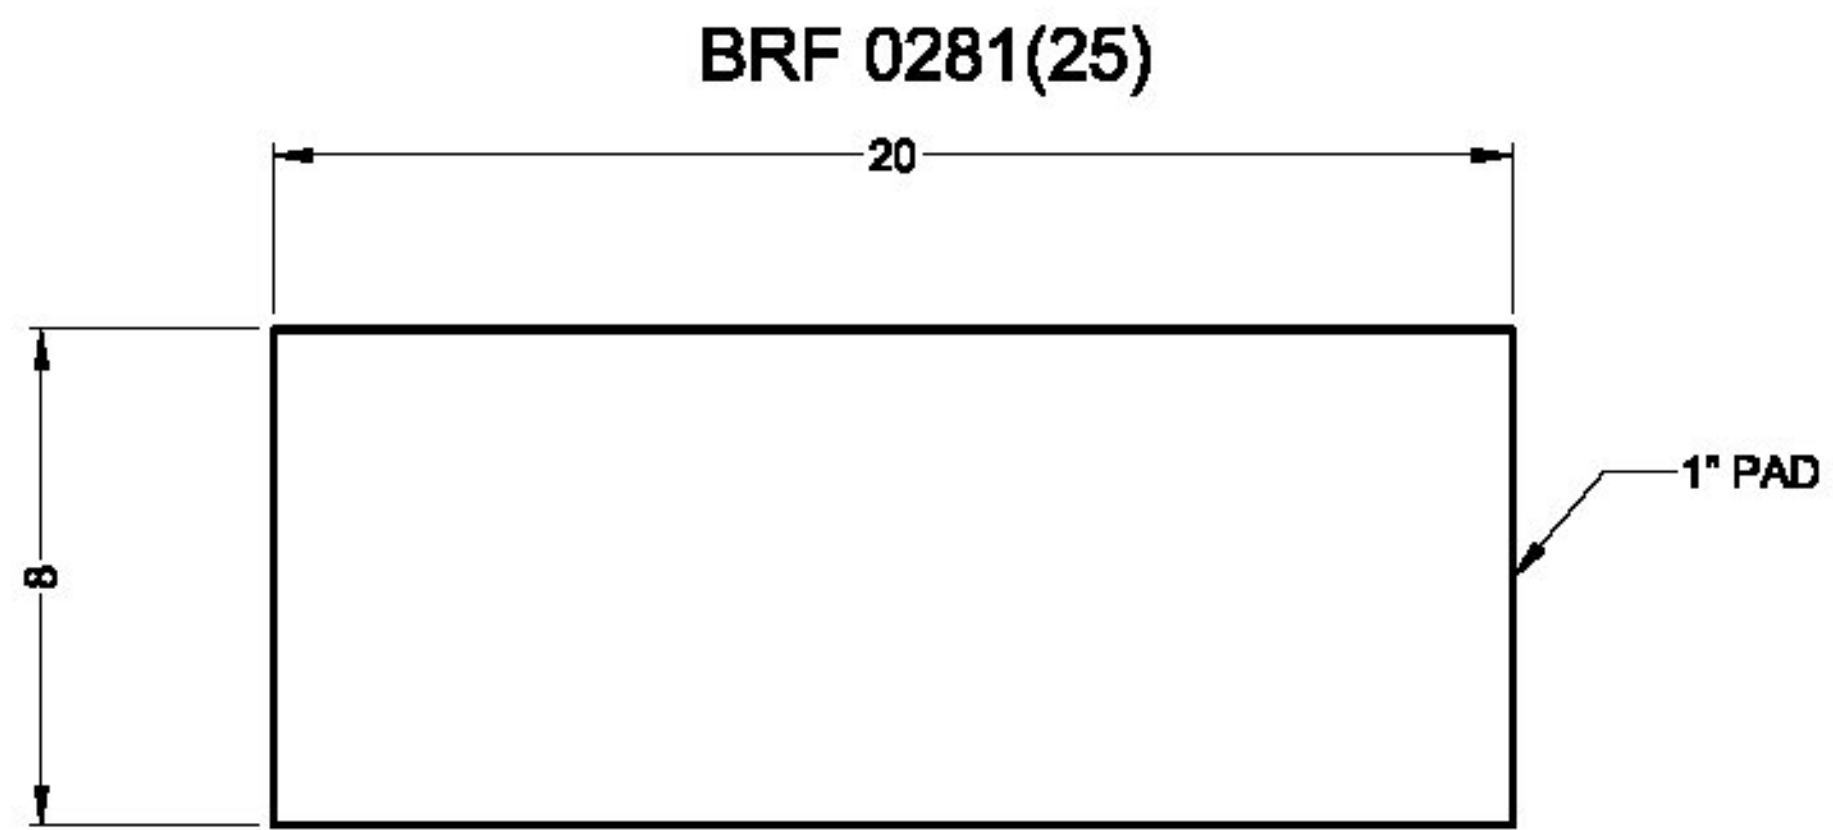

**PLAN PAD  
PLAN VIEW**  
QTY. REQ'D. = 12  
AASHTO GRADE 50 DUROMETER

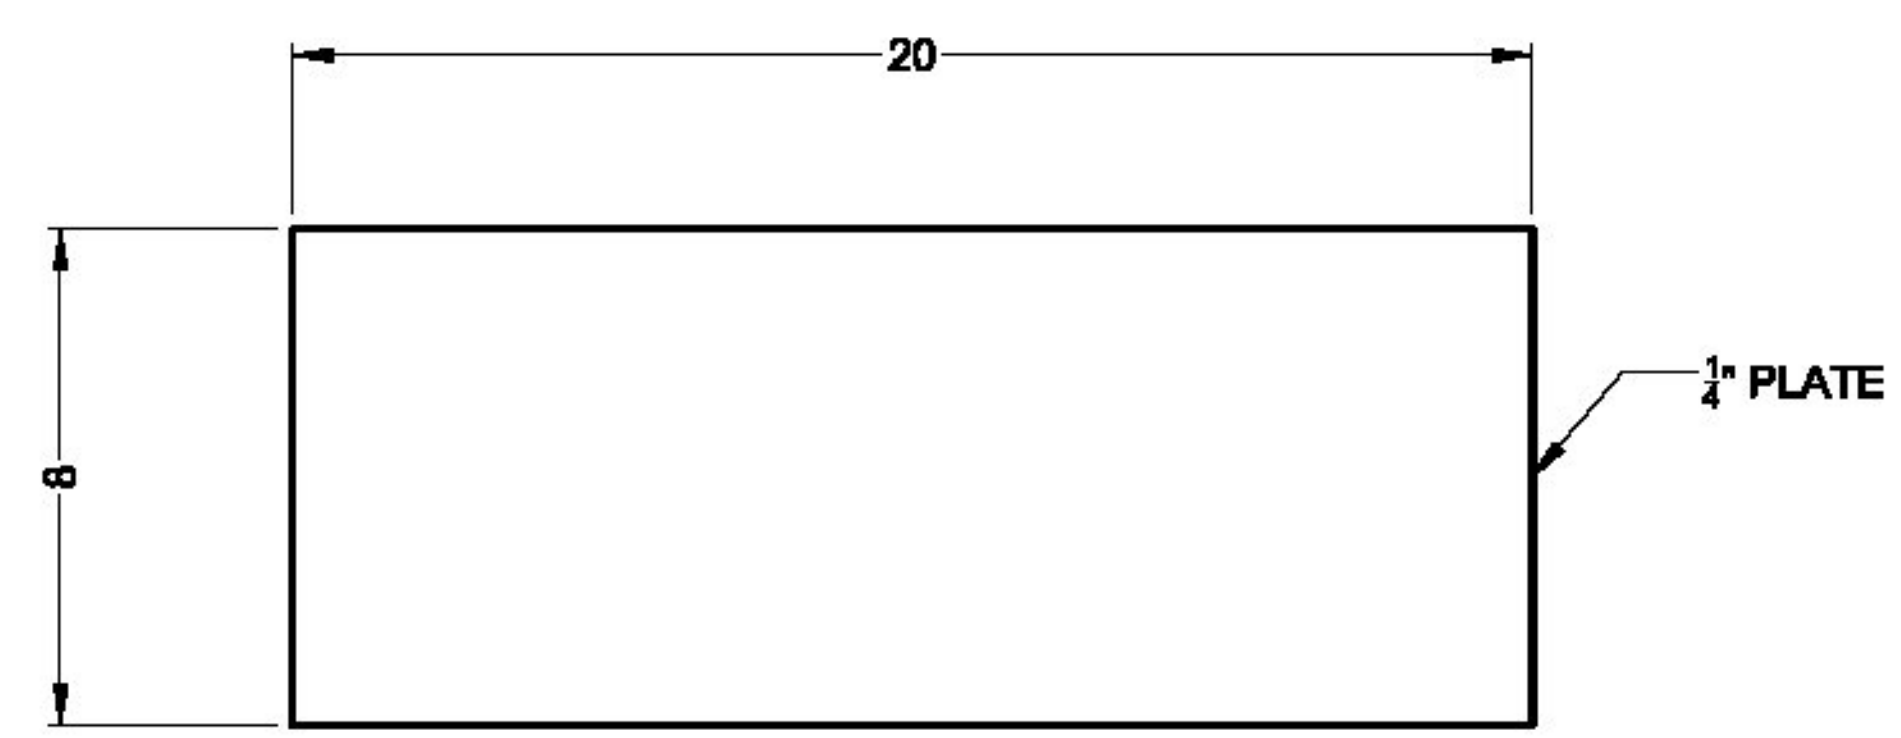


**GALVANIZED SHIM PLATE  
PLAN VIEW**  
QTY. REQ'D. = 12  
ASTM A709 GR50


**NOTES:**

- MANUFACTURING FACILITY LOCATION:  
AMSCOT STRUCTURAL PRODUCTS CORP.  
241 E. BLACKWELL STREET  
DOVER, N.J. 07801  
CONTACT- PETER SOMOGYI  
PH: 973-989-8800  
FAX: 973-989-5851
- ALL BEARING PADS TO BE MANUFACTURED IN ACCORDANCE WITH AASHTO SECTION 18. THE ELASTOMER SHALL BE GRADE 3 NATURAL RUBBER WITH A DUROMETER HARDNESS OF 50 ± 5, WITH A SHEAR MODULUS OF 110 PSI ± 15%.
- ALL DIMENSIONS ARE IN INCHES, UNLESS OTHERWISE NOTED.
- TOLERANCES: THICKNESS -0 +1/8  
PLAN -0 +1/8

<b>Inspection Block</b>
<b>Initial Dim. Check</b> Sign: _____ Date: _____
<b>In Process Dim. Chk.</b> Sign: _____ Date: _____
<b>100% Visual Weld Insp.</b> Sign: _____ Date: _____
<b>Paint Insp.(see form)</b> Sign: _____ Date: _____
<b>Final Inspection</b> Sign: _____ Date: _____

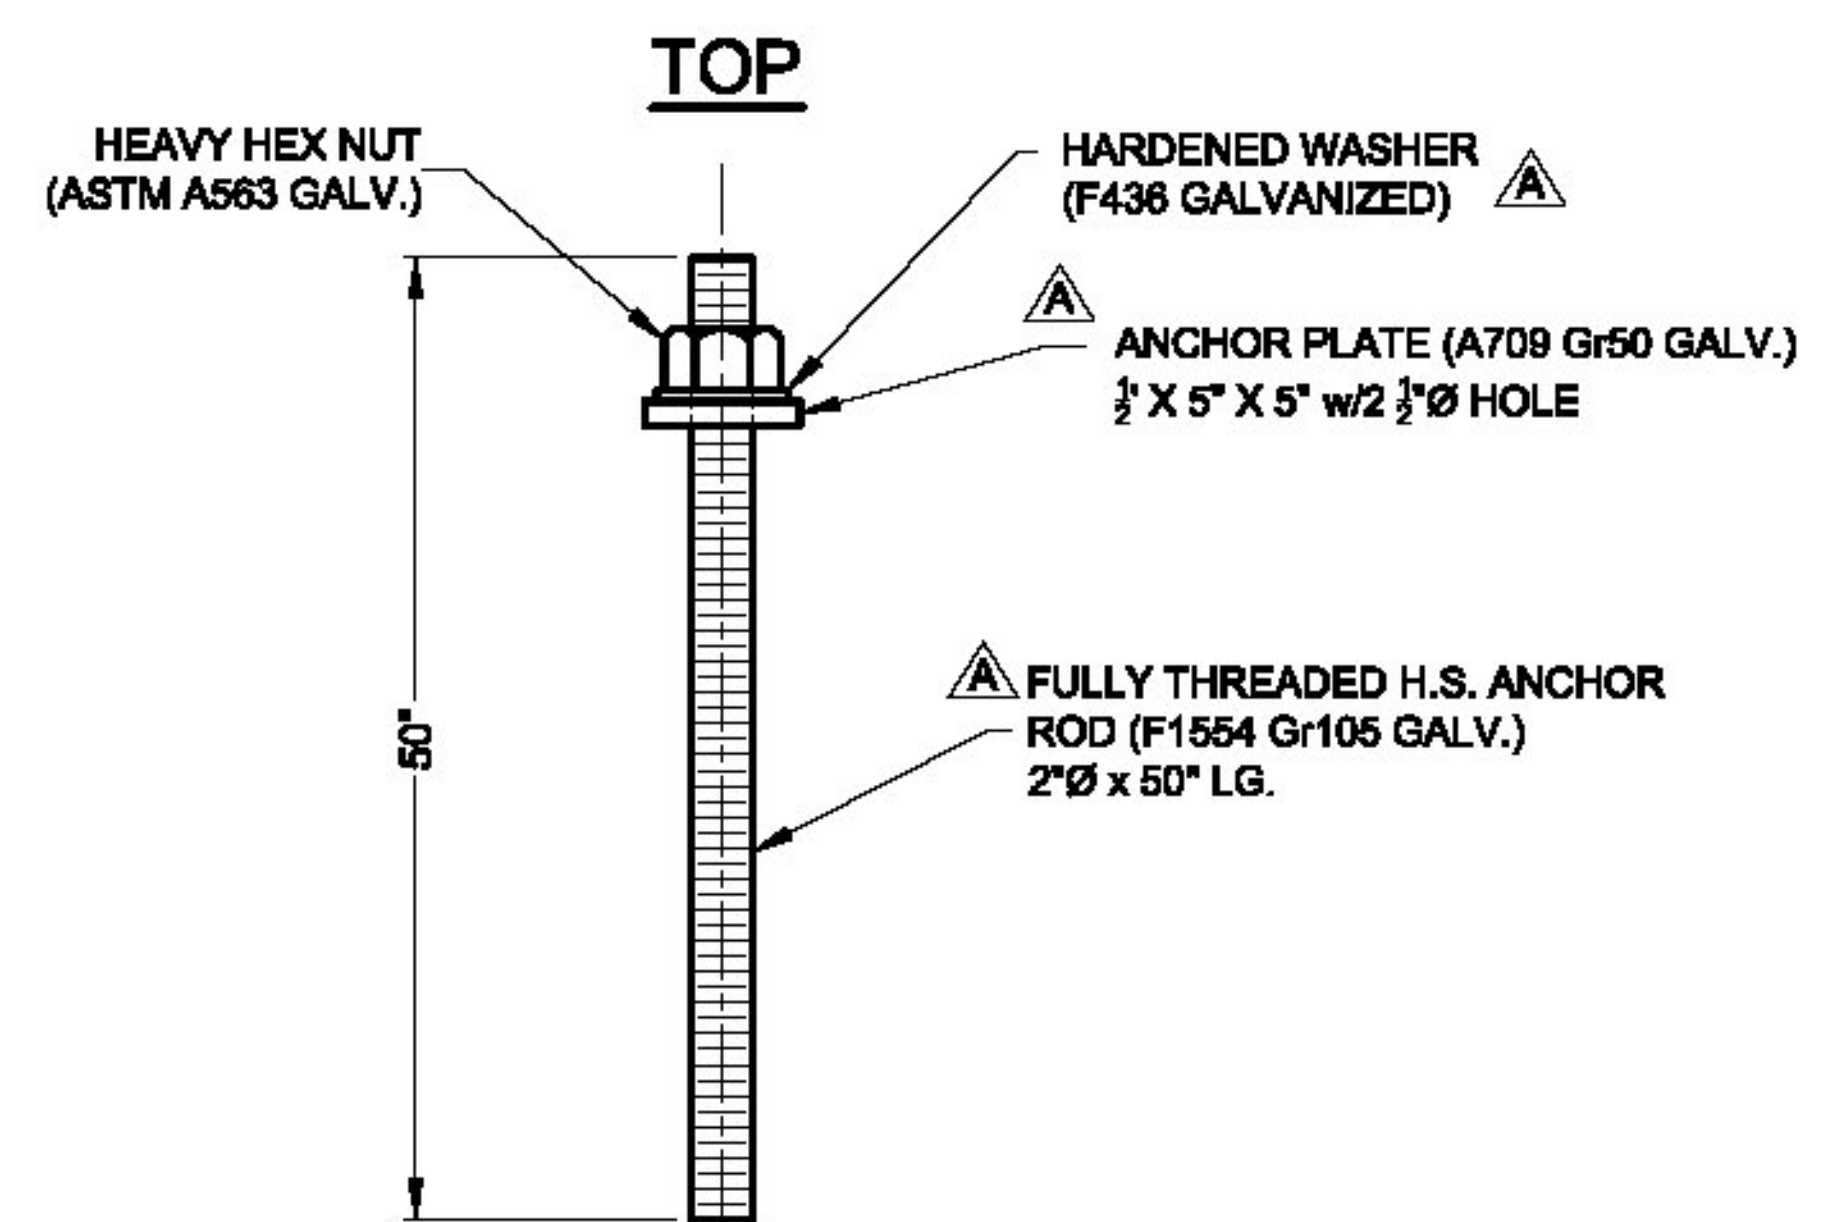


**ANCHOR BOLT DETAIL**  
QTY. REQ'D = 32 ASSY.

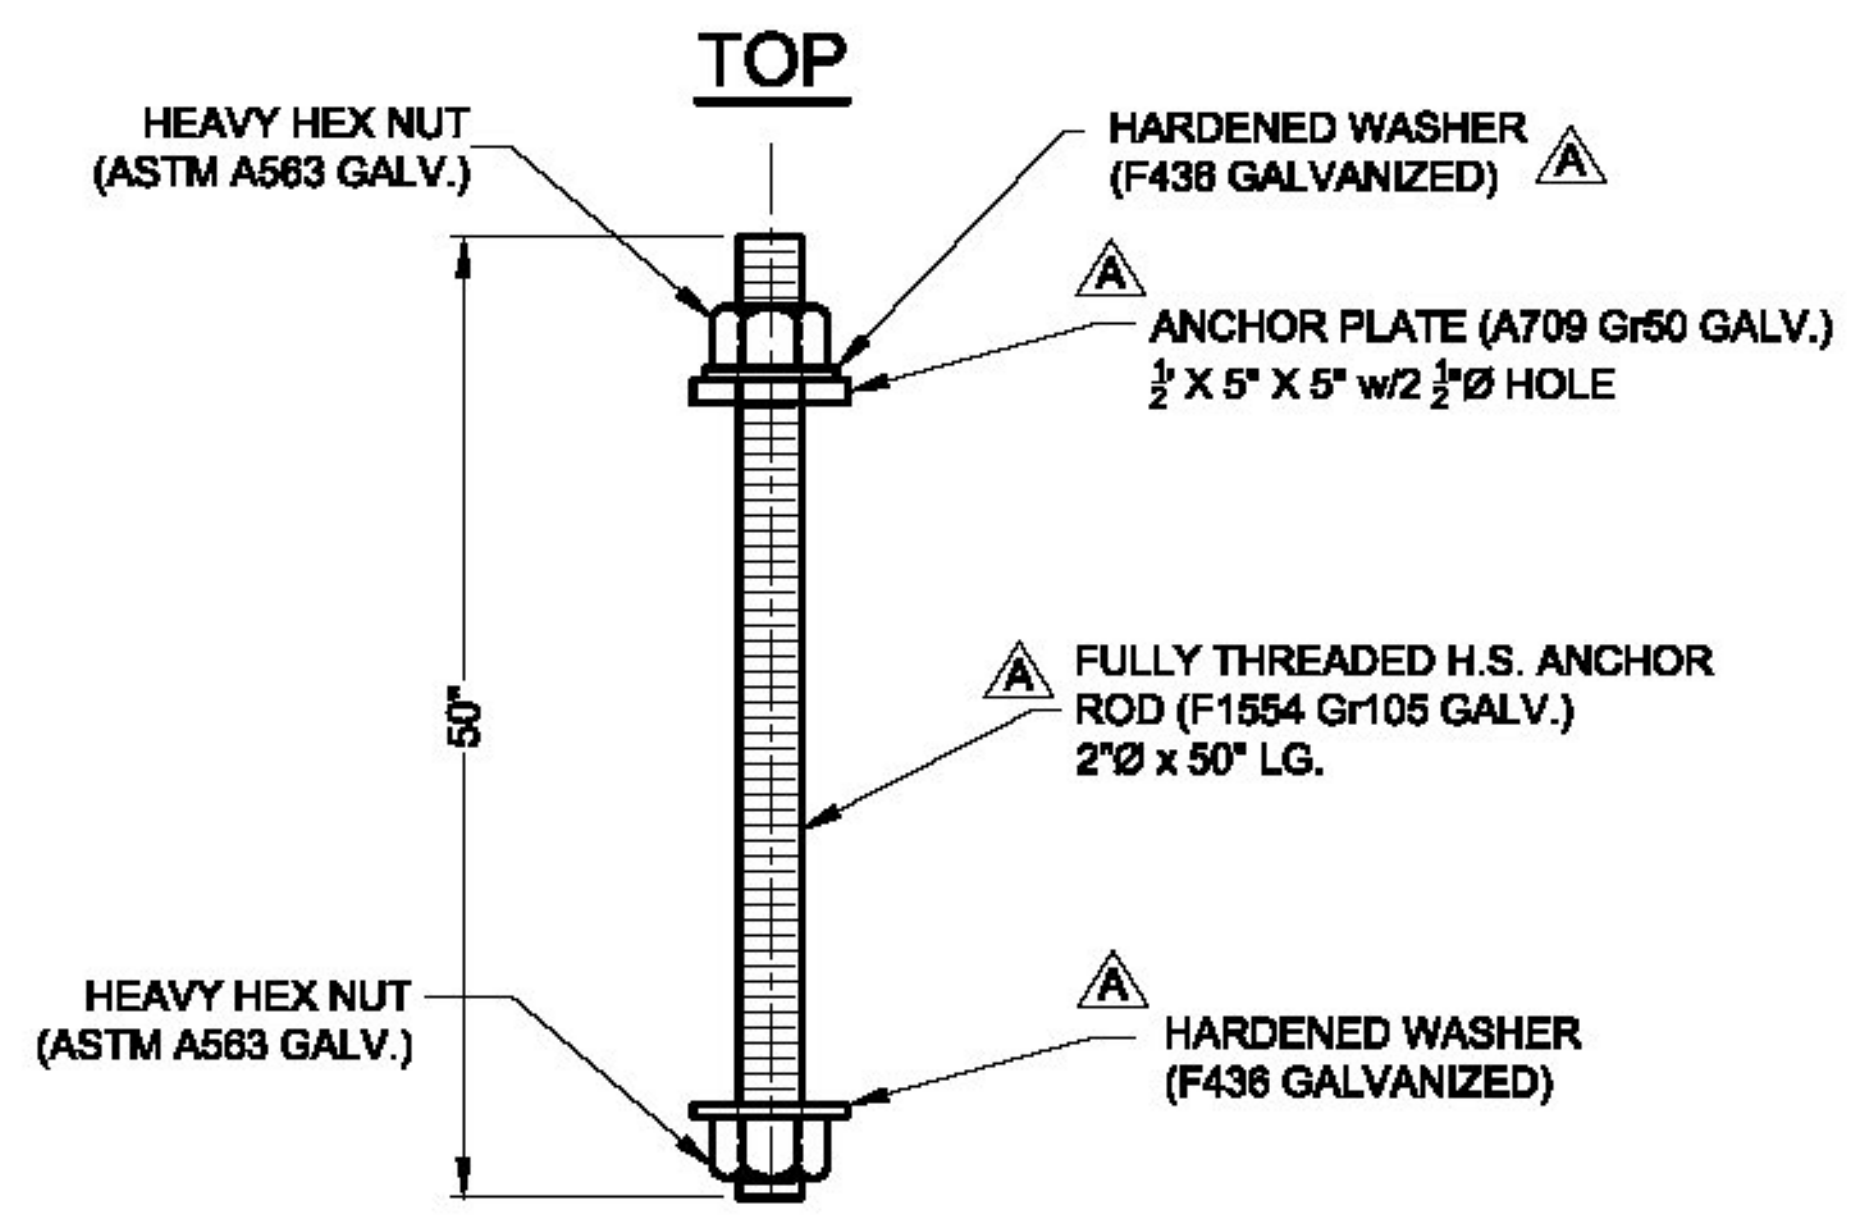

**ANCHOR BOLT DETAIL**  
QTY. REQ'D = 16 ASSY.  
AT PILE CAVITY LOCATIONS ONLY

Vermont Agency of Transportation  
**RECEIVED**  
CK'D BY RK OK'D BY RY  
January 29, 2015  
RESUBMIT No Approved  
BY RY DATE 02/10/2015

FAIRFIELD BRF 0281(25) VERMONT AGENCY OF TRANSPORTATION		
FEDERAL PROJECT NO. :		
CONTRACT NO. :	PIN NO. :	
ELASTOMERIC PAD, SHIM & ANCHOR BOLT DETAILS		
<b>AMSCOT</b> STRUCTURAL PRODUCTS CORP.		
SCALE: N.T.S.	APPRVD:	DRAWN BY: E.J.G.
DATE: 1/13/15	BF	REVISION: A
FOR: AL. ST. ONGE		
DWG NO: AS015A1RA		SHEET 1 OF 2

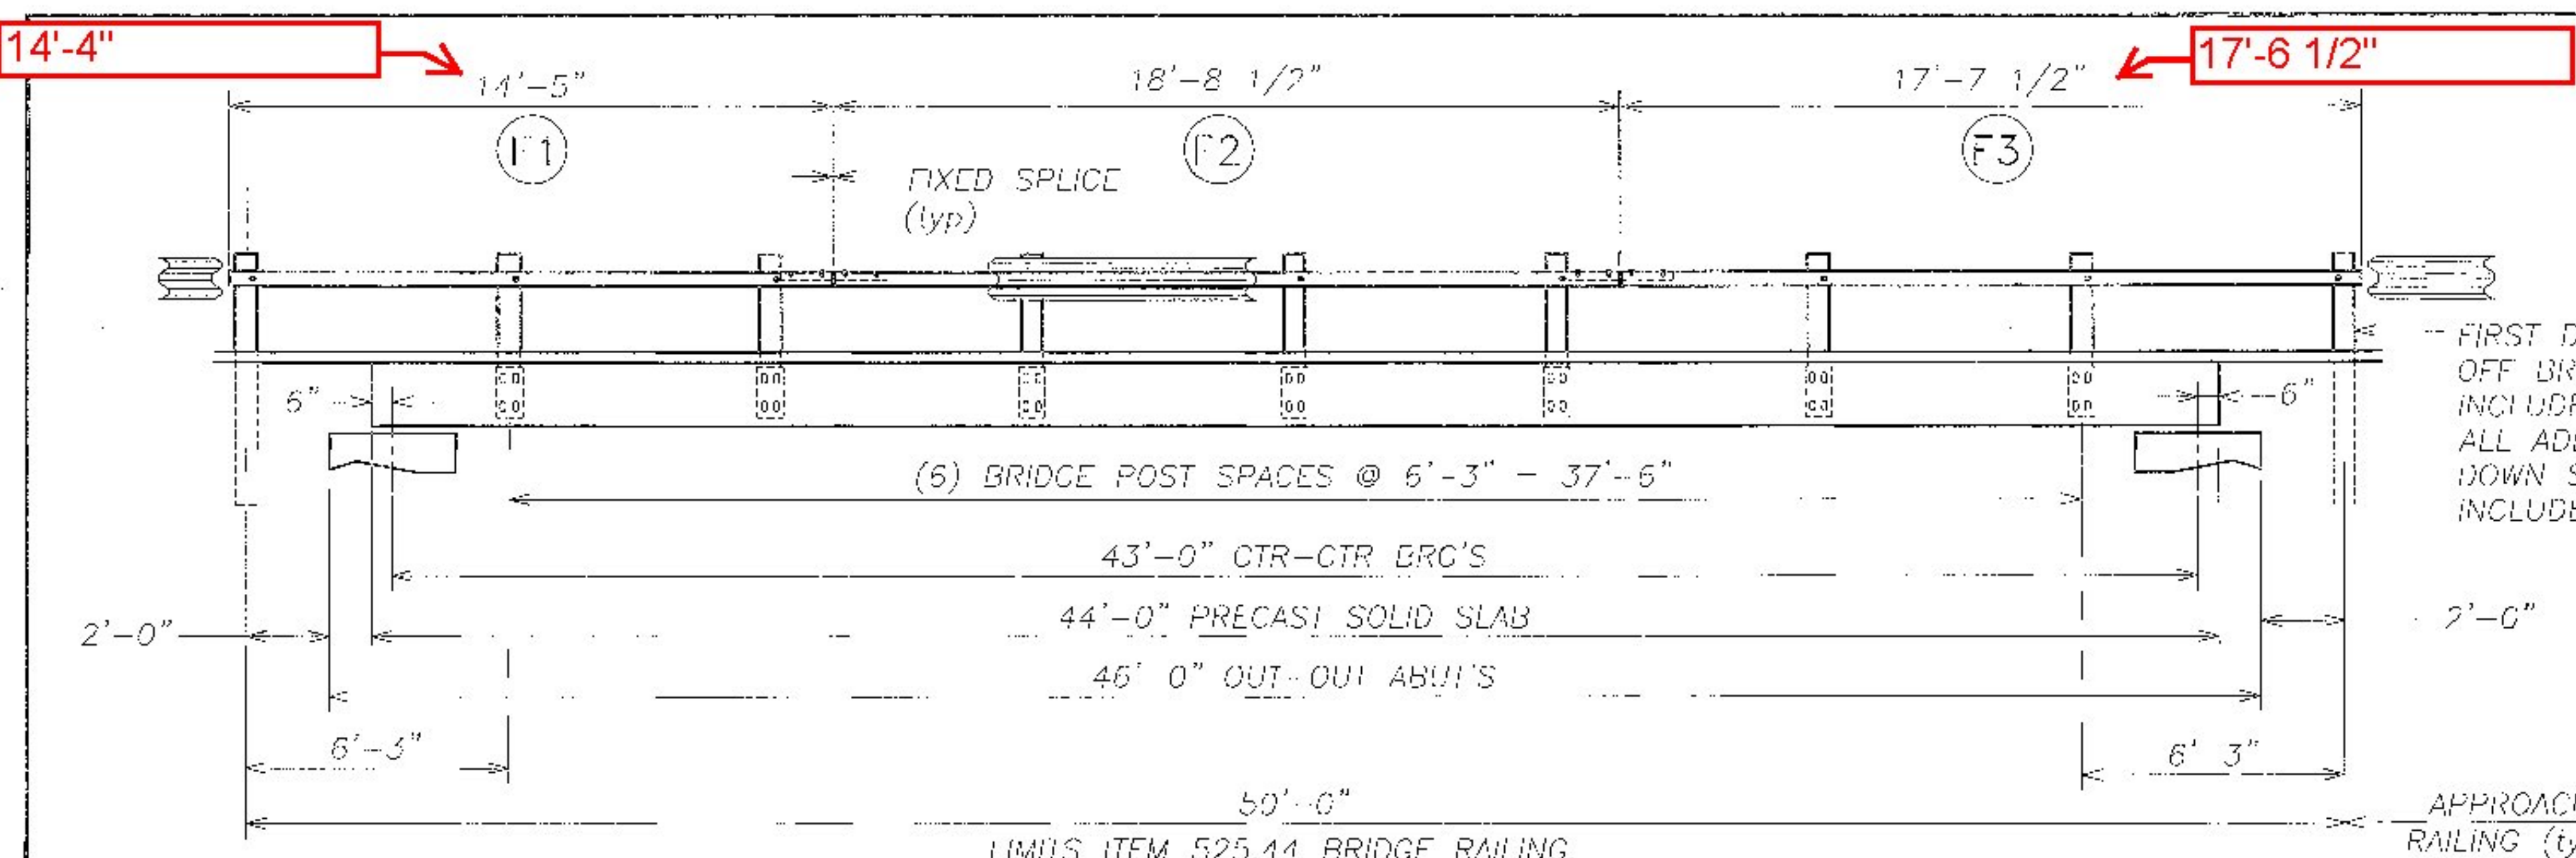


**TYPICAL RAILING ELEVATION  
BRIDGE NO. 14**

LOOKING AT FACE OF RAIL FROM CENTERLINE OF ROAD  
BOTH SIDES SIMILAR  
PORTIONS OF HDSB W-BEAM RAIL AND TUBULAR BLOCKS HAVE BEEN REMOVED FROM THIS VIEW FOR CLARITY

FIRST DRIVEN POST OFF BRIDGE INCLUDED IN ITEM 525.44 ALL ADDITIONAL DOWN STREAM POSTS INCLUDED IN APPROACH ITEM

APPROACH RAILING (typ)

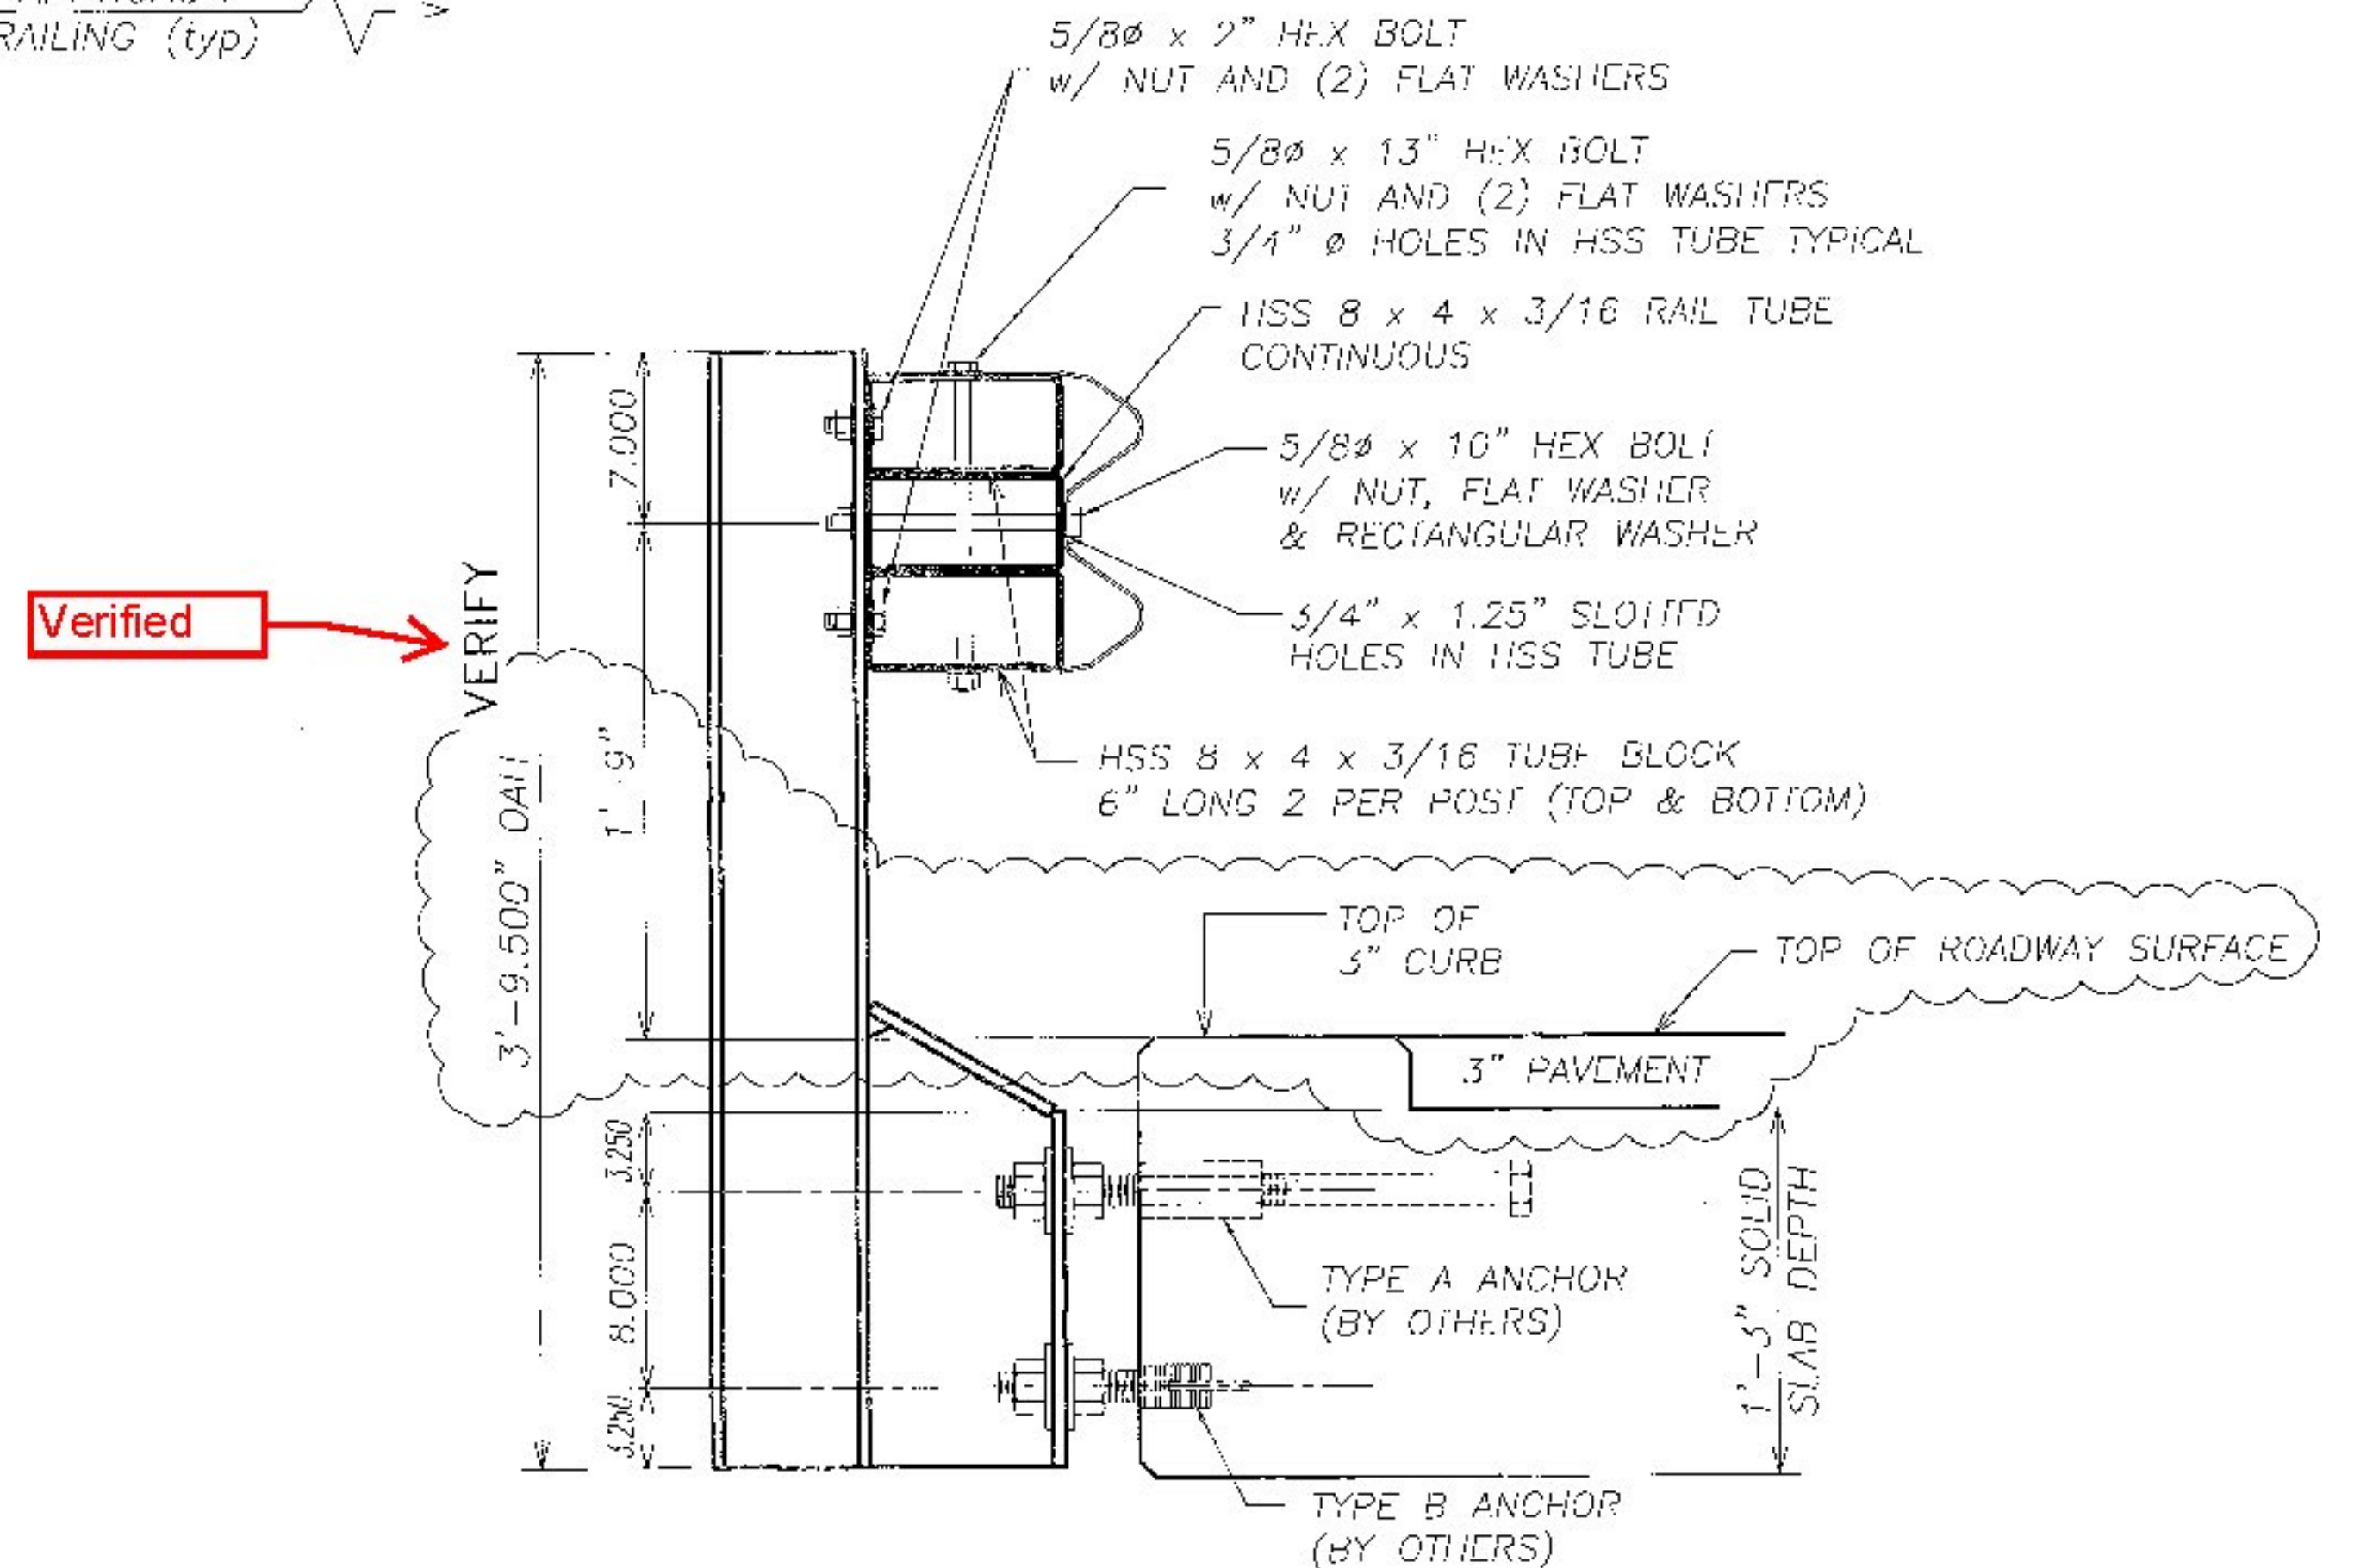

Verified

**SECTION  
THRU RAILING**

**BILL OF MATERIAL**


TOTAL PAY LENGTH ITEM 525.44 (BRIDGE 14) = 100 LF

Qty	mk	Description	Spec.
14		W6x25 FASCIA MOUNTED POST 45.500 OAL w/ WELDED OFFSET PLATES (GLV)	A572 gr 50
14		PL 0.500 x 7.500 x 8.500 (WELDED TO POST)	A572 gr 50
14		PL 0.500 x 7.500 x 14.500 (WELDED TO POST)	A572 gr 50
14		PL 0.500 x 7.500 x 17.937 (WELDED TO POST)	A572 gr 50
4		W6x25 DRIVEN POST #1 x 6 FT LONG (GLV)	A572 gr 50
36		TUBE BLOCK HSS 8 x 4 x 3/16 x 6.000 LG (GLV)	A500 gr B
8		HDSB W-BEAM PANEL 10 GA 12'-6" LG X 6'-3" SP (GALV)	M180 B2
4		SPLICE CHANNEL C7 X 9.8 x 2'-6.500" w/ (4) TACKWELDED HEX NUTS (GALV)	A572 gr 50
2	F1	TUBULAR STEEL RAIL (GLV) HSS 8 x 4 x 3/16 x 14'-4.000" OAL	A500 gr B
2	F2	TUBULAR STEEL RAIL (GLV) HSS 8 x 4 x 3/16 x 18'-8.500" OAL	A500 gr B
2	F3	TUBULAR STEEL RAIL (GLV) HSS 8 x 4 x 3/16 x 16'-6.500" OAL	A500 gr B
18		RECTANGULAR WASHER 0.1875" x 1.75" x 3.00" (GLV)	A572 GR 50
18		HEX HEAD BOLT 5/8" DIA x 13" LG HDG	A325
18		HEX HEAD BOLT 5/8" DIA x 10" LG HDG	A325
52		HEX HEAD BOLT 5/8" DIA x 2" LG HDG	A325
72		HEX NUT 5/8" HDG	A563 DH
142		ROUND WASHER SMALL FLAT 5/8" HDG	F436
64		PANEL SPLICE BOLT 5/8" x 1.25" HDG	A307
64		DOUBLE RECESS. NUT 5/8" HDG	A563 A


No.	Initial	Remarks	Date
0		Initial submittal	
REVISIONS			

Vermont Agency of Transportation  
**RECEIVED**  
CK'D BY RK/JC OK'D BY RY  
February 20, 2015  
RESUBMIT No Approved AsNoted  
BY RY DATE 03/09/2015

**HIGHWAY SAFETY CORP**  
GLASTONBURY, CT  
860-633-9445  
ITEM 525.44 BRIDGE RAILING  
GALVANIZED FASCIA MOUNTED HDSB STEEL TUBE  
BRIDGE NO. 14 SOUTH ROAD BRF 0281(25)  
FAIRFIELD VERMONT  
2030  
1 of 2

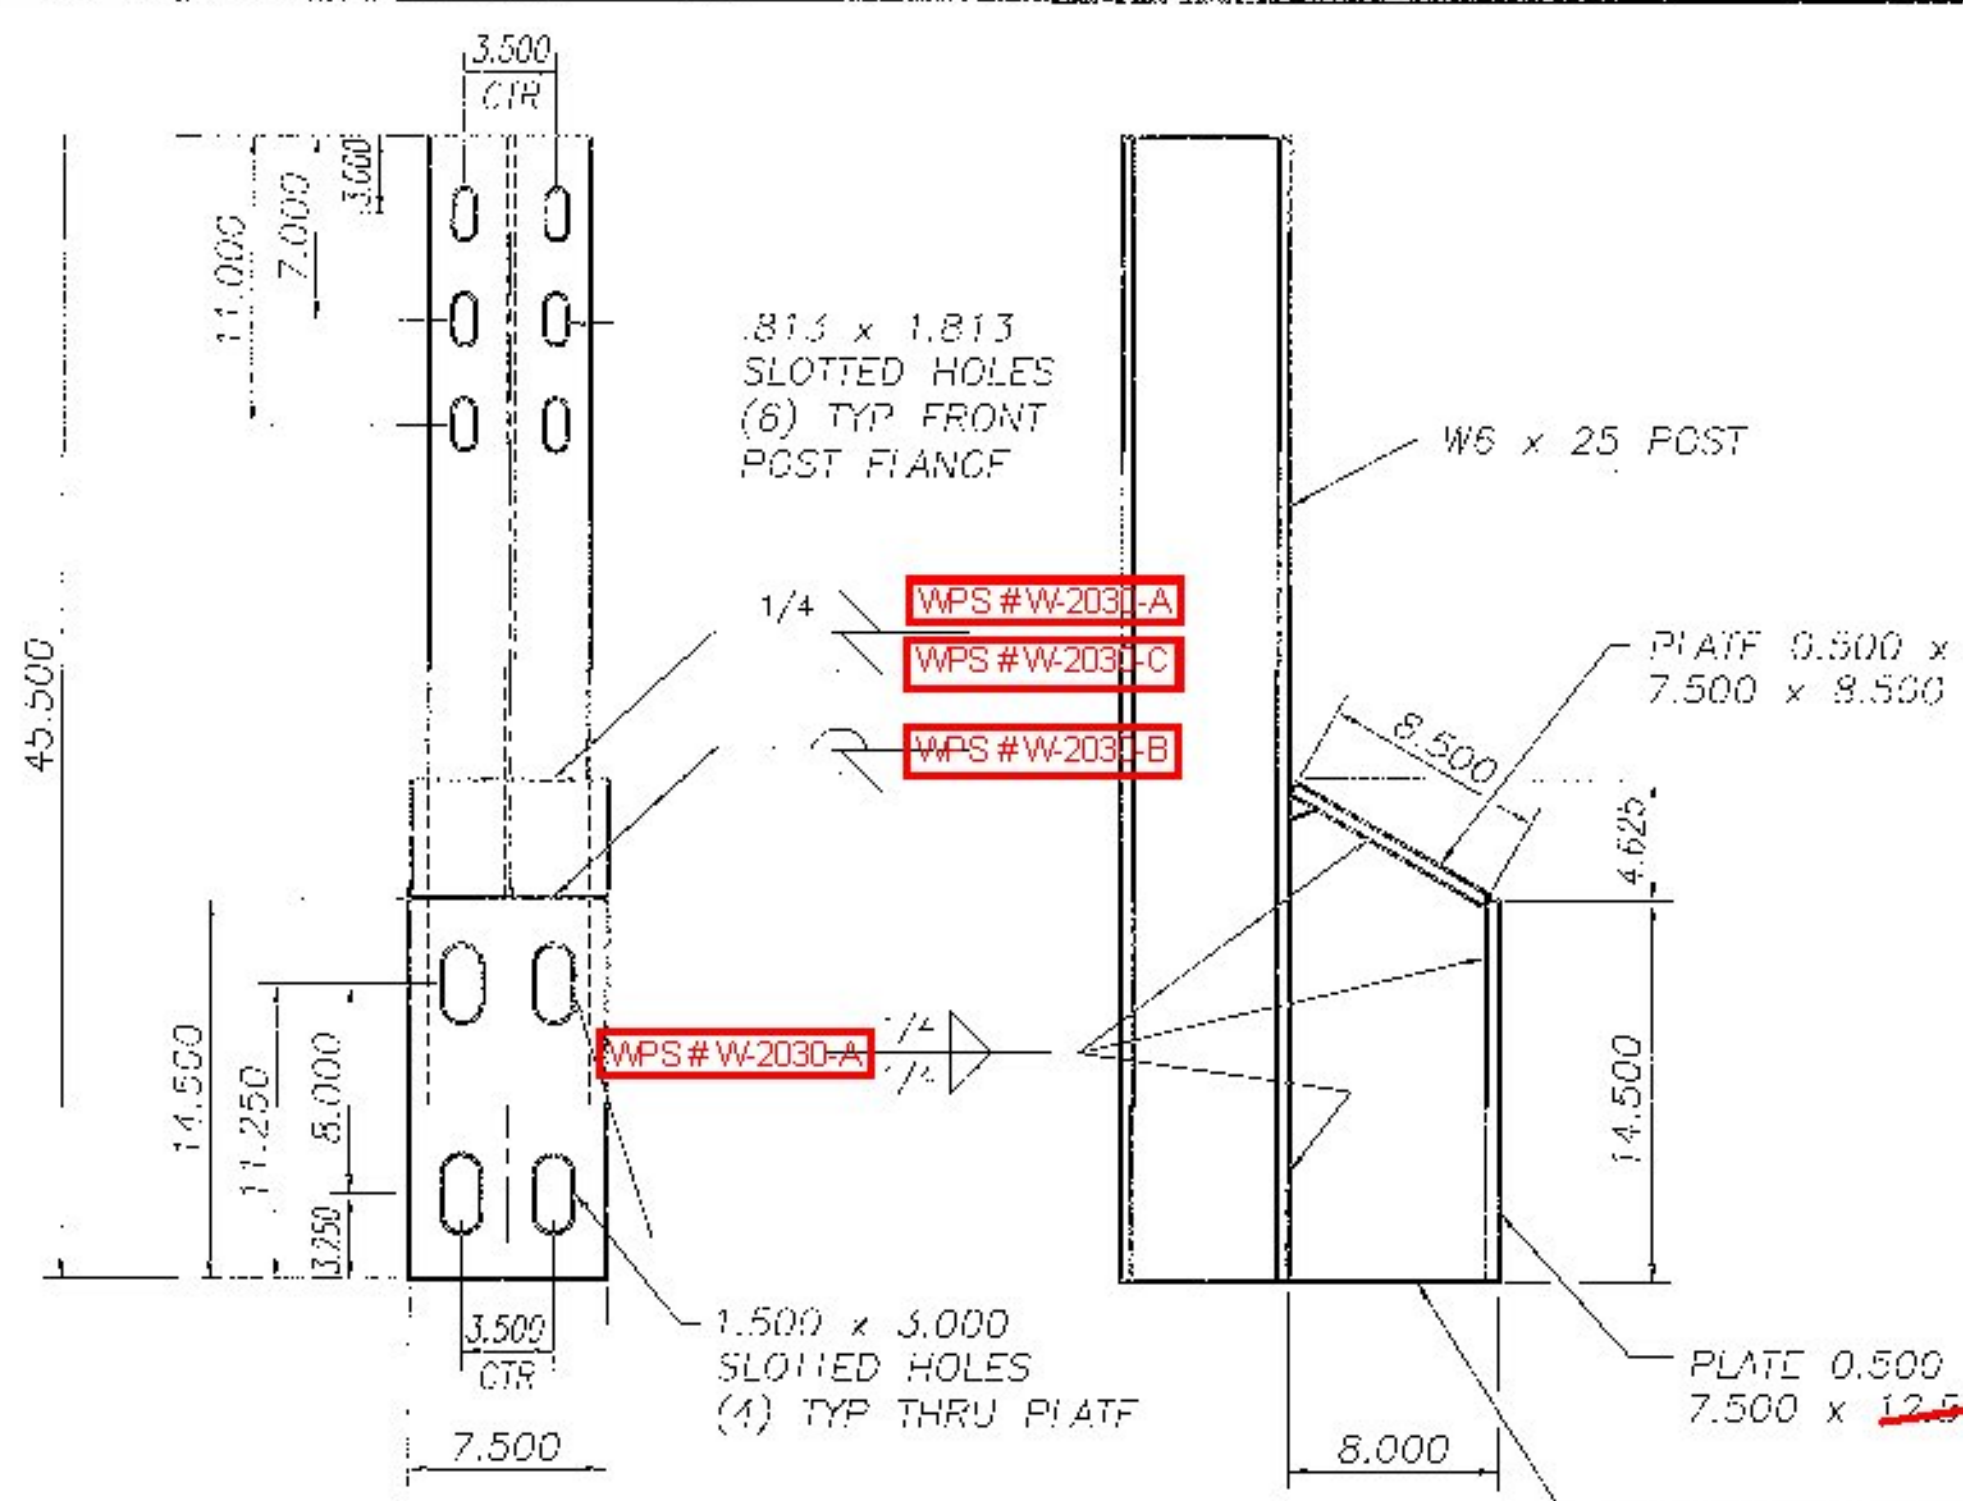


POST DETAIL  
TYPICAL ALL FASCIA POSTS

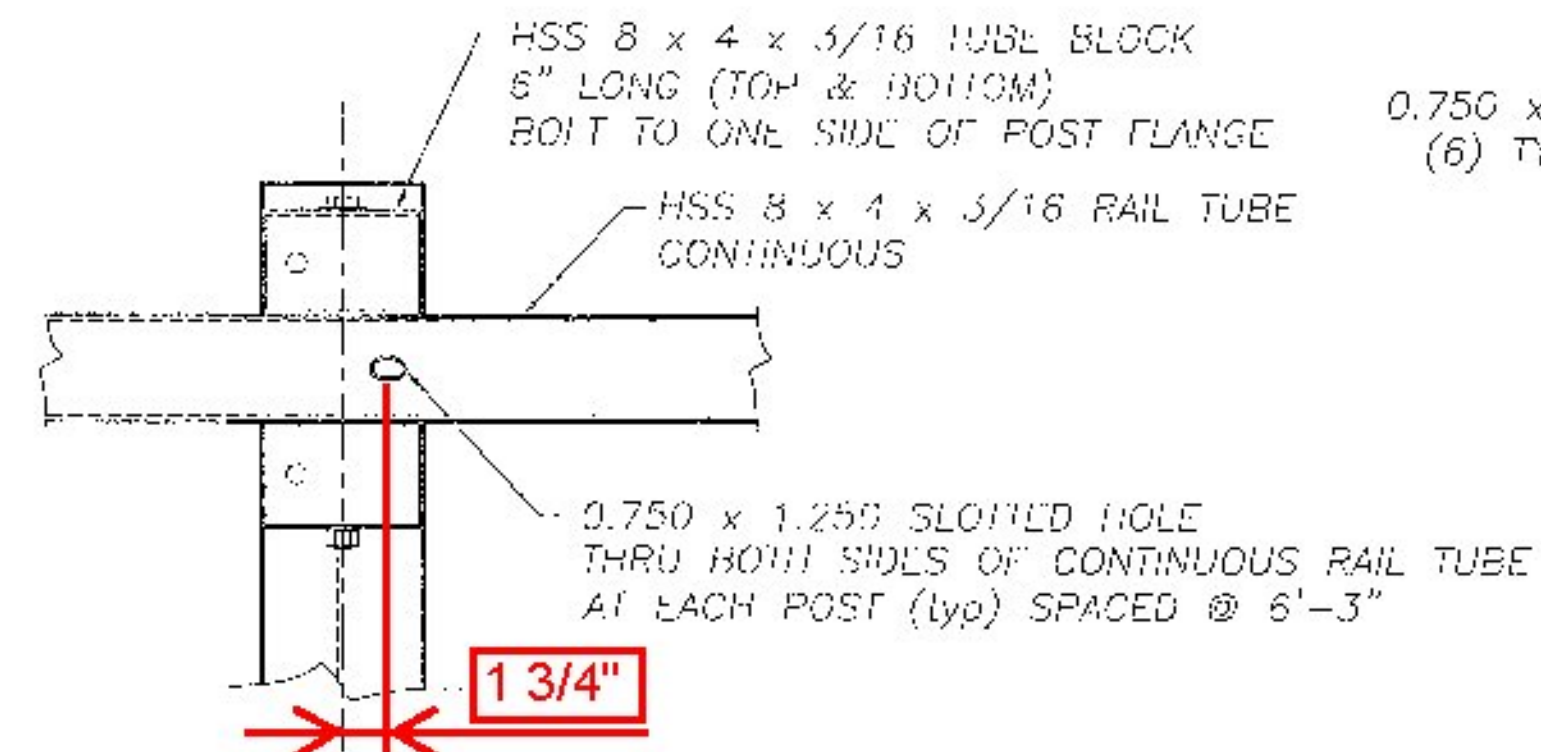


PARTIAL ELEVATION  
SHOWING RAIL AND BLOCK  
ASSEMBLY TO POST  
HSSB RAIL NOT SHOWN FOR CLARITY


0.750 x 2.500 SLOTTED HOLES  
(6) TYP FRONT POST FLANGE

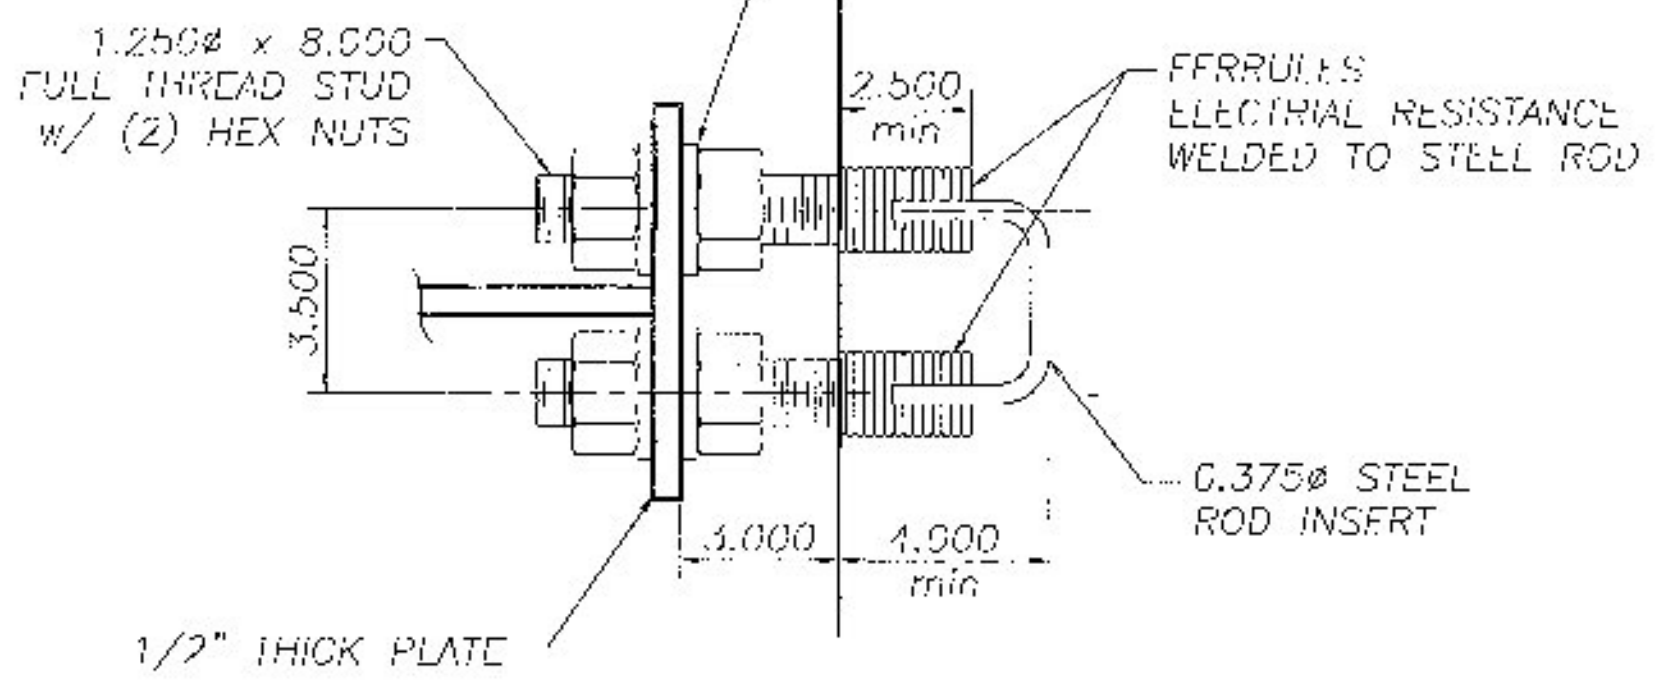

TYPE B ANCHOR ASSEMBLY  
(1) PER POST  
(BY OTHERS)

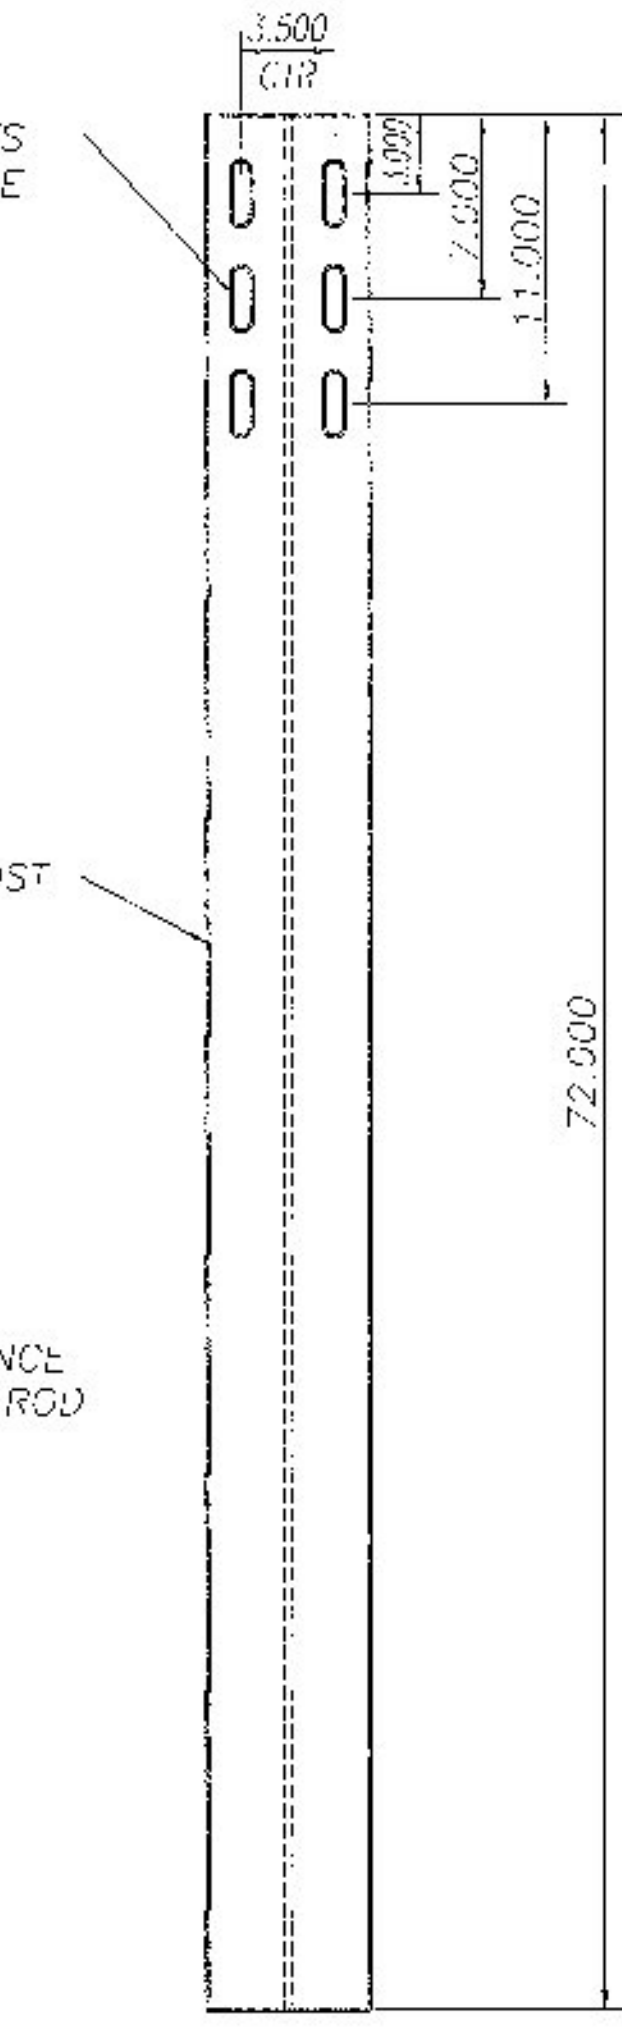


POST ELEVATION  
DRIVEN POST #1

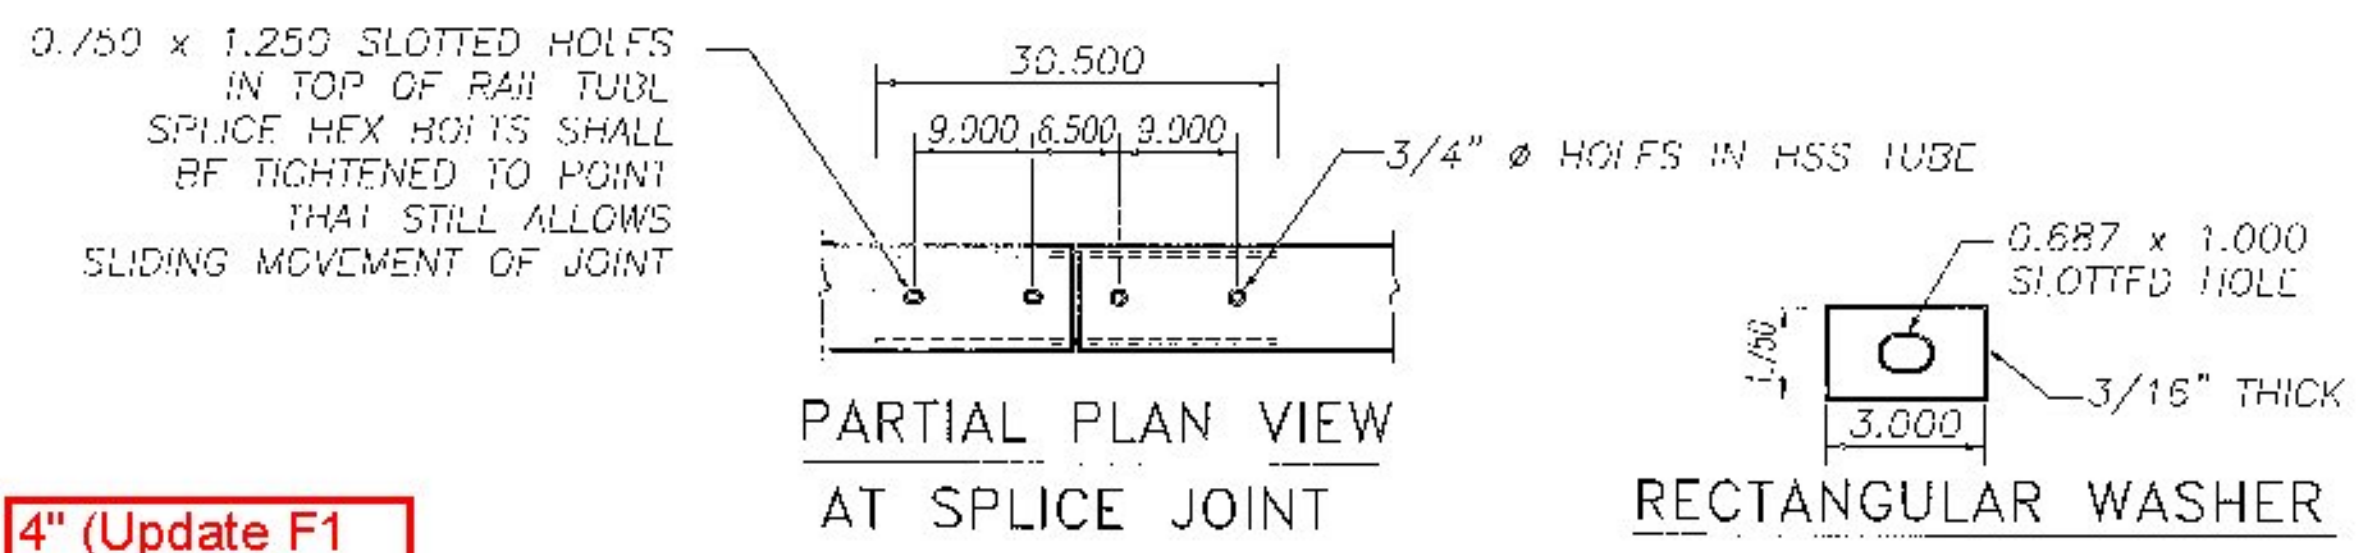


PARTIAL PLAN VIEW  
AT SPLICE JOINT

RECTANGULAR WASHER


4" (Update F1 and F3 lengths accordingly)

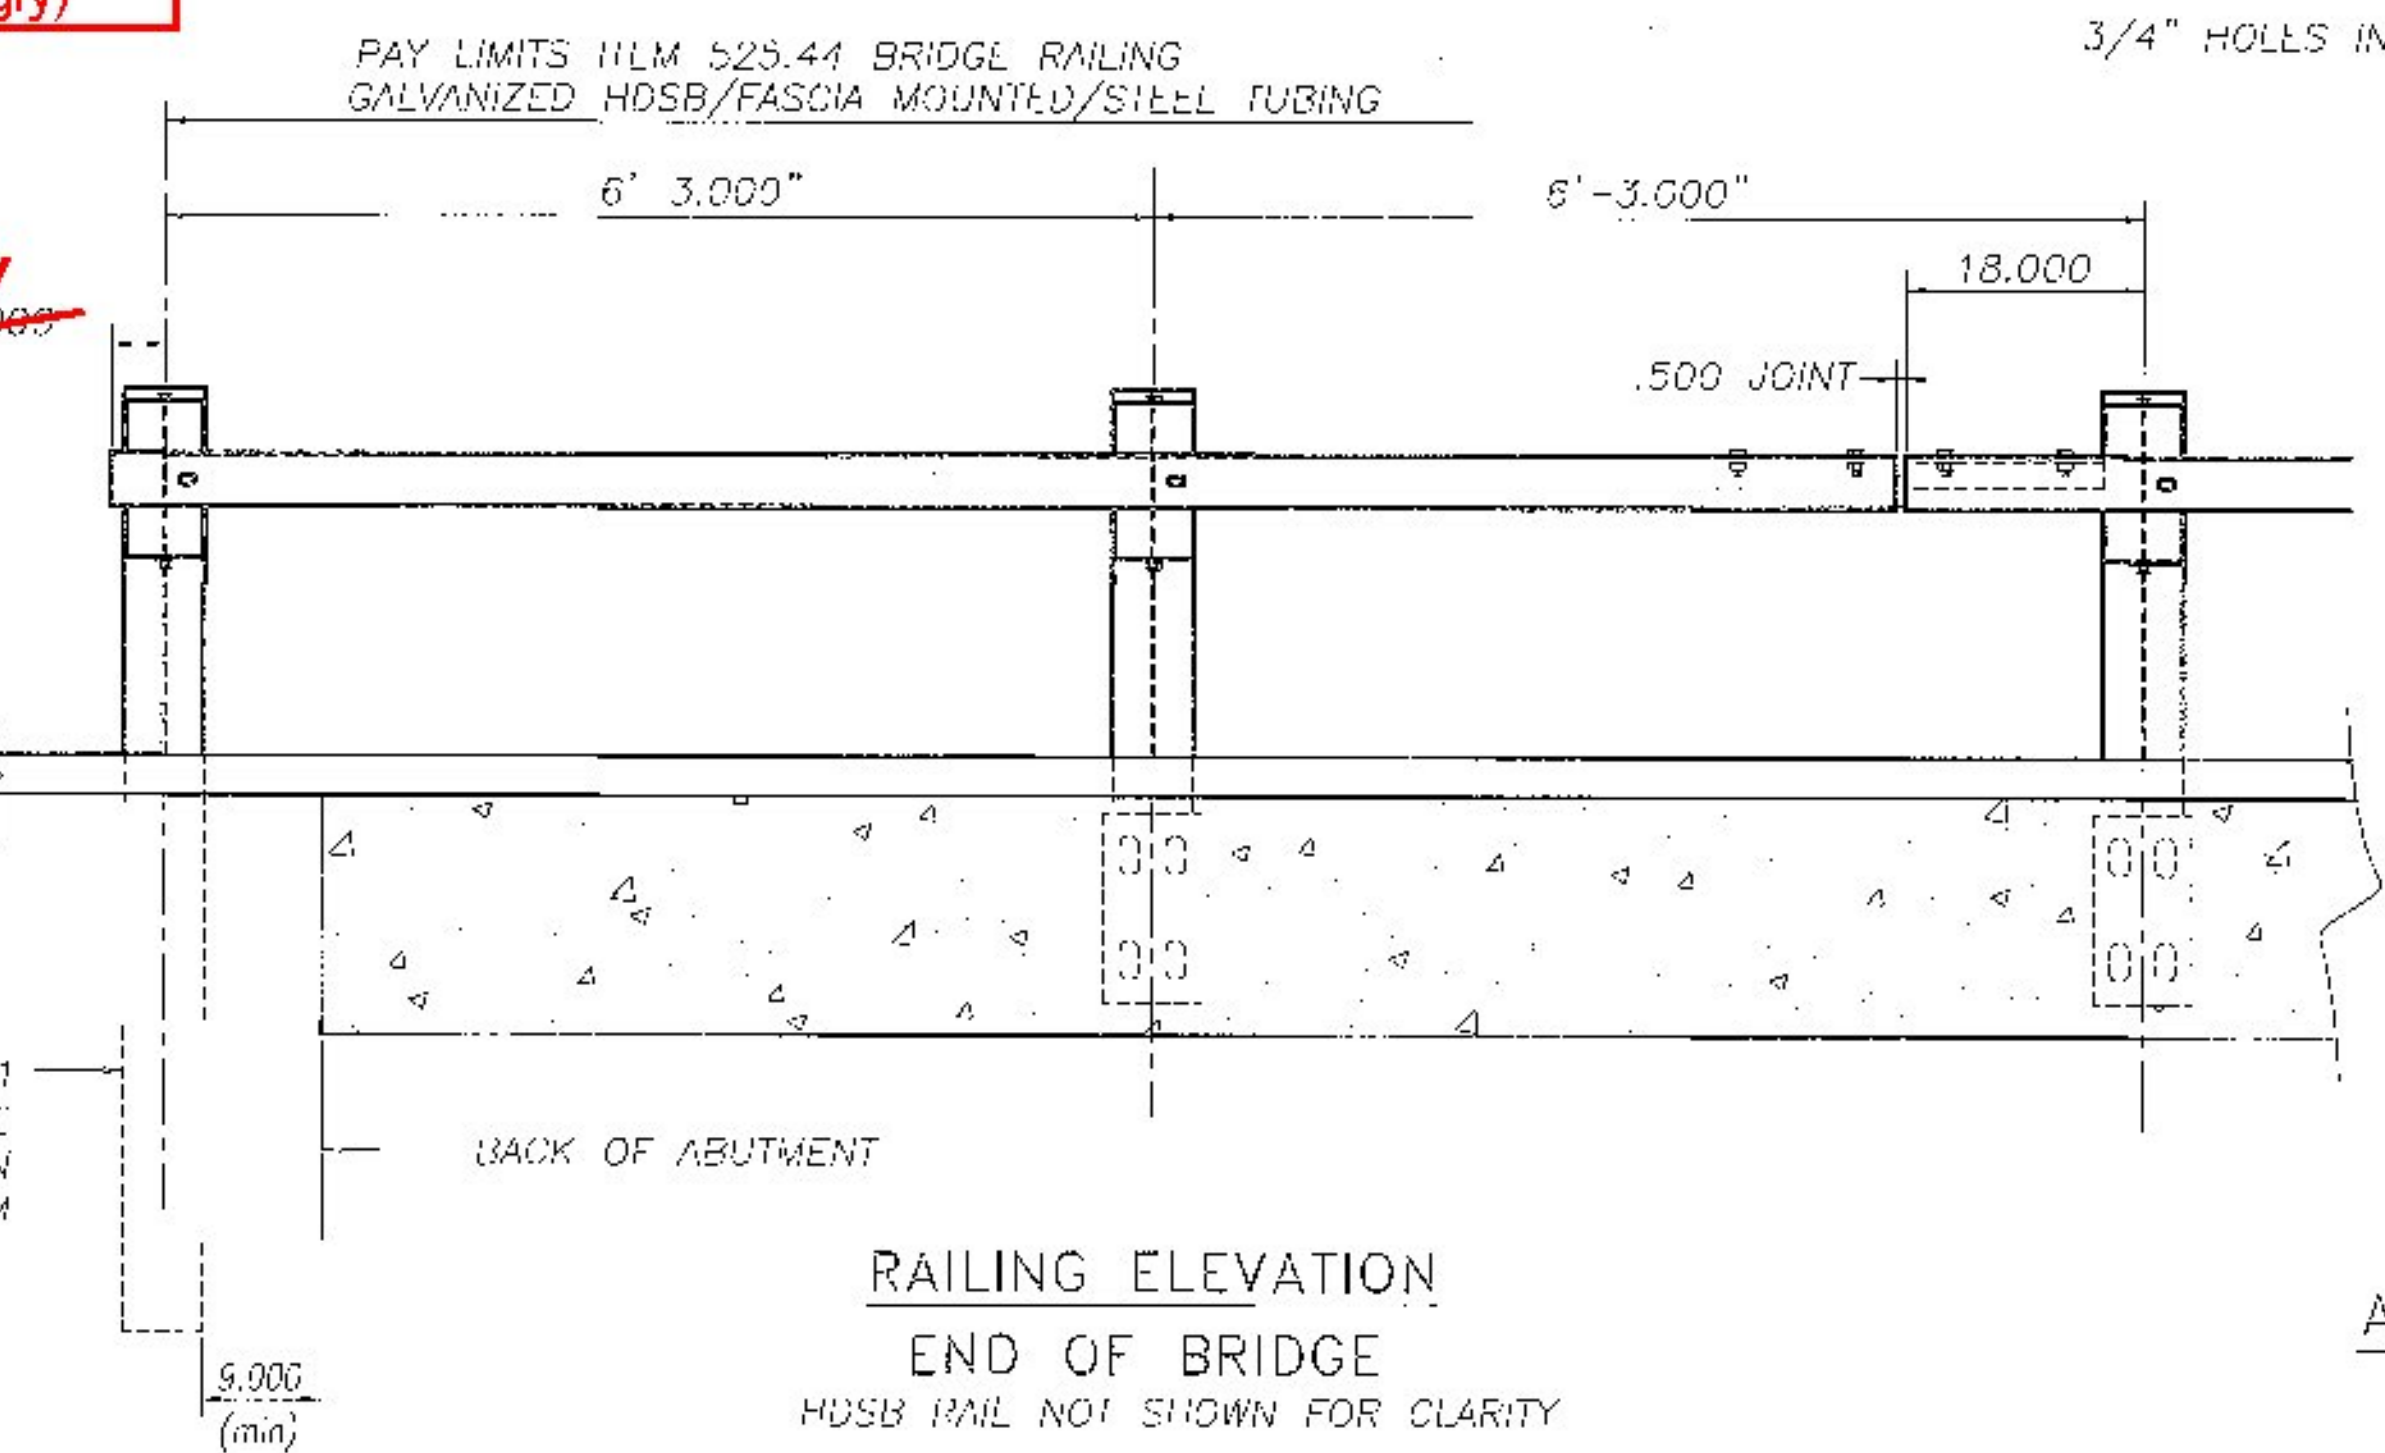


RAILING ELEVATION  
END OF BRIDGE  
HSSB RAIL NOT SHOWN FOR CLARITY

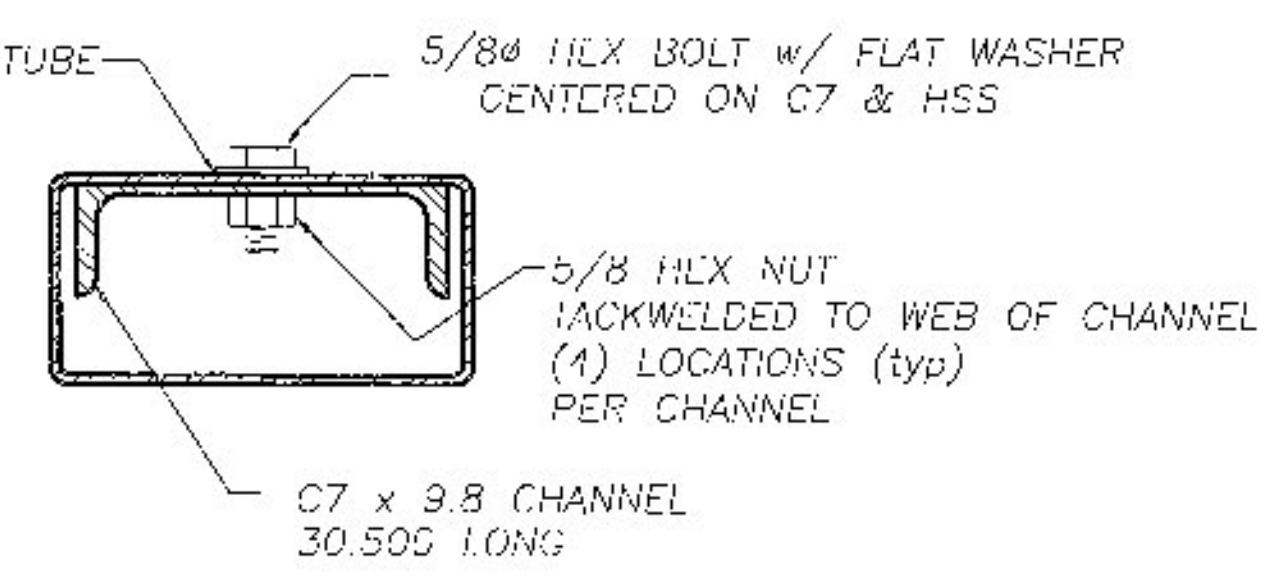

SECTION THRU 8x4 RAIL  
AT SPLICE JOINT

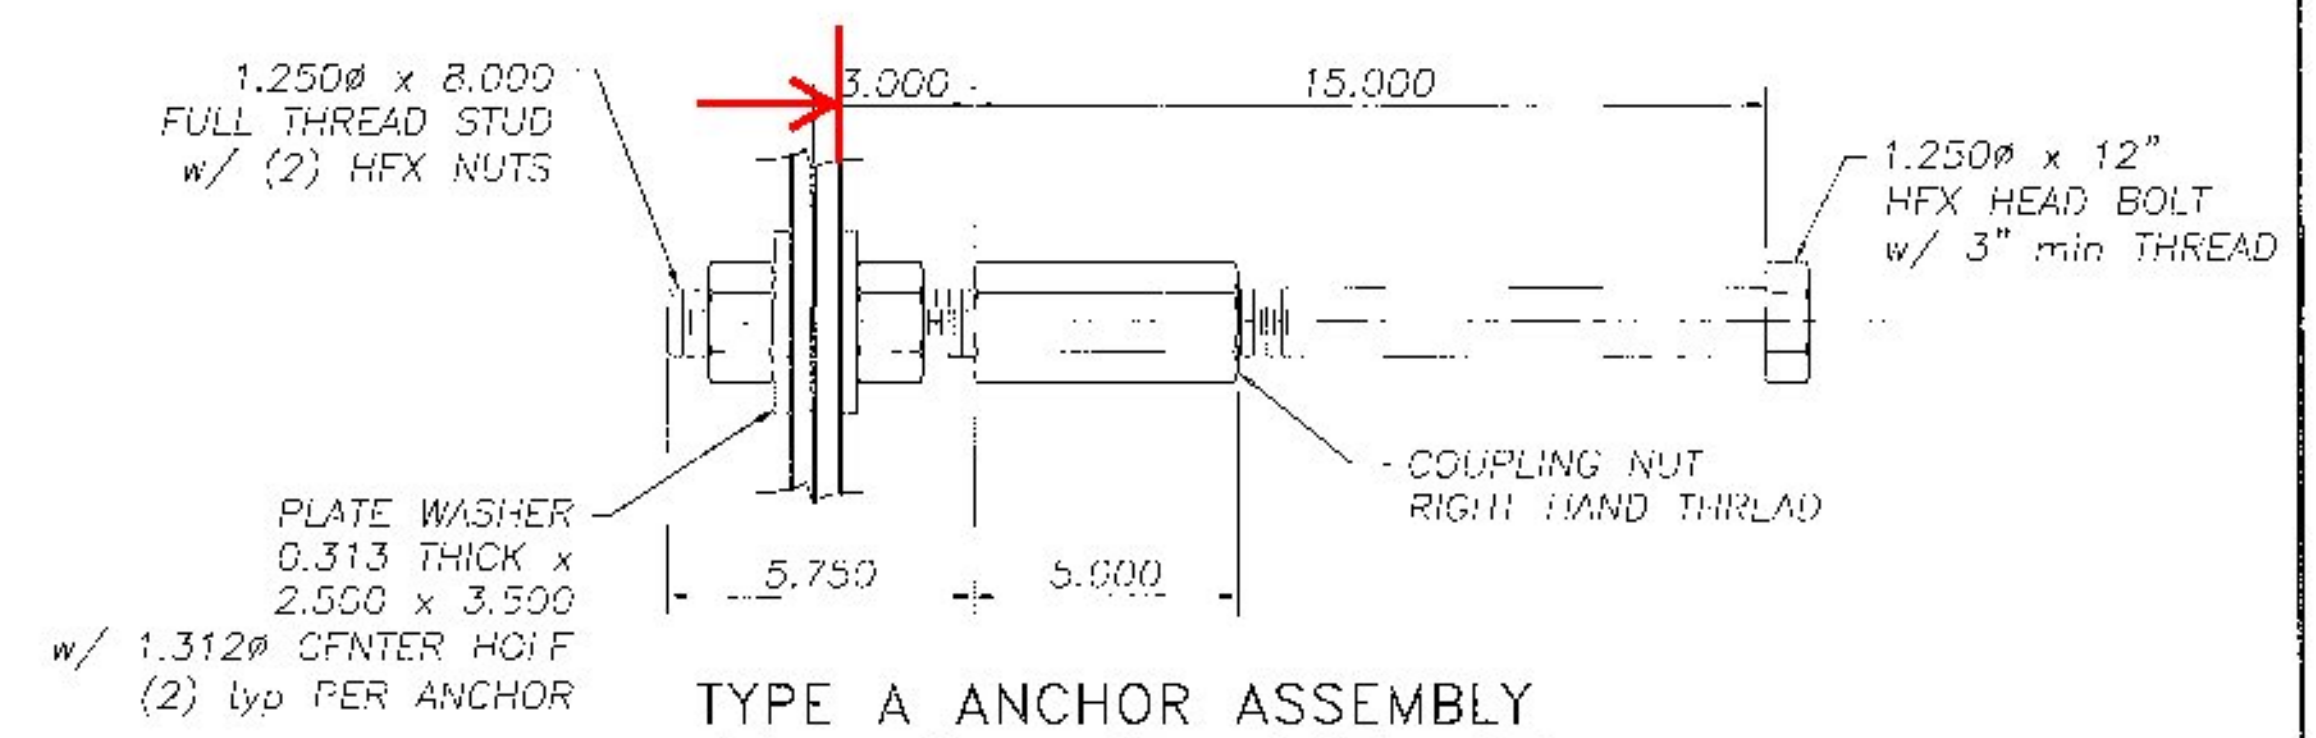

TYPE A ANCHOR ASSEMBLY  
(2) PER POST  
(BY OTHERS)

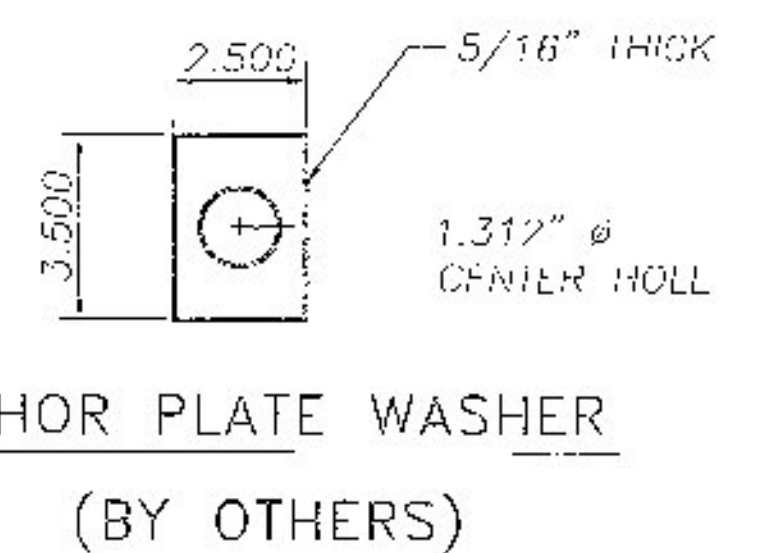

ANCHOR PLATE WASHER  
(BY OTHERS)

NOTES

1. ALL WORK AND MATERIALS SHALL CONFORM TO SECTION 525
2. TYPE B ANCHOR INSERTS OF A DIFFERENT TYPE MAY BE PROVIDED, IF APPROVED BY THE ENGINEER
3. PRIOR TO GALVANIZING THE ASSEMBLED POST, GRIND ALL EDGES TO A MINIMUM 1/16" RADIUS
4. ALL POSTS SHALL BE SET NORMAL TO GRADE
5. SPICES FOR THE STEEL BEAM GUARDRAIL SHALL LAP IN THE DIRECTION OF TRAFFIC
6. A RAILING JOINT SPLICE SHALL BE PROVIDED IN ANY RAIL BAY SPANNING THE END OF AN INTEGRAL ABUTMENT BRIDGE AND AT ALL SUPERSTRUCTURE EXPANSION JOINTS
7. SEE VAOT STANDARD DRAWING C-1 FOR DETAILS OF DEFINATORS. A DEFINATOR SHALL BE INSTALLED AT 30 FT SPACING OR THE NEAREST POST, WHICH IS TO BE INSTALLED ON THE DRIVERS RIGHT. FOR ONE WAY BRIDGES, YELLOW IS TO BE INSTALLED ON THE DRIVERS LEFT. DEFINATORS PROVIDED BY OTHERS.
8. FOR RADII LESS THAN 950 FEET, HSS 8 X 4 TUBES SHALL BE SHOP BENT TO FIT THE APPLICABLE CURVE
9. THE MINIMUM DISTANCE FROM THE LAST POST TO THE END OF SLAB IS 1'-6"
10. FERRULS SHALL BE 12L14 COLD DRAWN CARBON STEEL
11. HOLES IN THE RAIL FOR RAIL TUBE ATTACHMENT MAY BE FIELD DRILLED. FIELD DRILLED HOLES SHALL BE COATED WITH AN APPROVED ZINC RICH PAINT PRIOR TO INSTALLATION
12. THIS RAILING MEETS THE REQUIREMENTS FOR A TL-2 SERVICE LEVEL
13. ALL METAL PARTS SHALL BE HOT DIPPED GALVANIZED.

Vermont Agency of Transportation  
**RECEIVED**  
CK'D BY RK/JC OK'D BY RY  
February 20, 2015  
RESUBMIT No Approved As Noted  
BY RY DATE 03/09/2015

**HIGHWAY SAFETY CORP**  
GLASTONBURY, CT  
860-633-9445

ITEM 525.44 BRIDGE RAILING  
GALVANIZED FASCIA MOUNTED HSSB STEEL TUBE

BRIDGE NO. 14 SOUTH ROAD BR# 0281(25)  
FAIRFIELD VERMONT

CERTIFIED FABRICATOR

ITEM JOB NO. 2030  
SHEET NO. 2 of 2

GENERAL CONTRACTOR  
SUB CONTRACTOR LAFAYETTE  
DRAWN PAR CHECKED DATE 02-17-15 SCALE NTS SIZE D

# Highway Safety Corporation

Glastonbury, CT

## Welding Procedure Specification

Material specification ASTM A709 gr 36/gr 50, ASTM A572 gr.36/gr.50, ASTM A36, A500 gr.B  
 Welding process Gas Metal Arc Welding (GMAW) Spray Transfer  
 Manual, semi-automatic, or automatic Semi-Automatic  
 Position of welding Flat (1F) or Horizontal (2F)  
 Filler metal specification AWS A5.18  
 Filler metal classification ER70S-6  
 Electrode and manufacturer Lincoln Electric Lincoln Weld L-56  
 Flux and manufacturer N/A  
 Shielding gas 86% Argon / 14% CO2 Flow rate 35-45 CFM  
 Single or multiple pass Single  
 Single or multiple arc Single  
 Welding current DCEP  
 Polarity Reverse - electrode positive  
 Welding progression Stringers  
 Root treatment clean base metal  
 Preheat and interpass temperature base metal up to 3/4" (50°F)  
 Postheat treatment None  
 Electrode extension 3/4" ± 1/4"

Vermont Agency of Transportation

**RECEIVED**


CK'D BY RK/JC OK'D BY RY

February 20, 2015

RESUBMIT No Approved

BY RY DATE 03/09/2015

### WELDING PROCEDURE

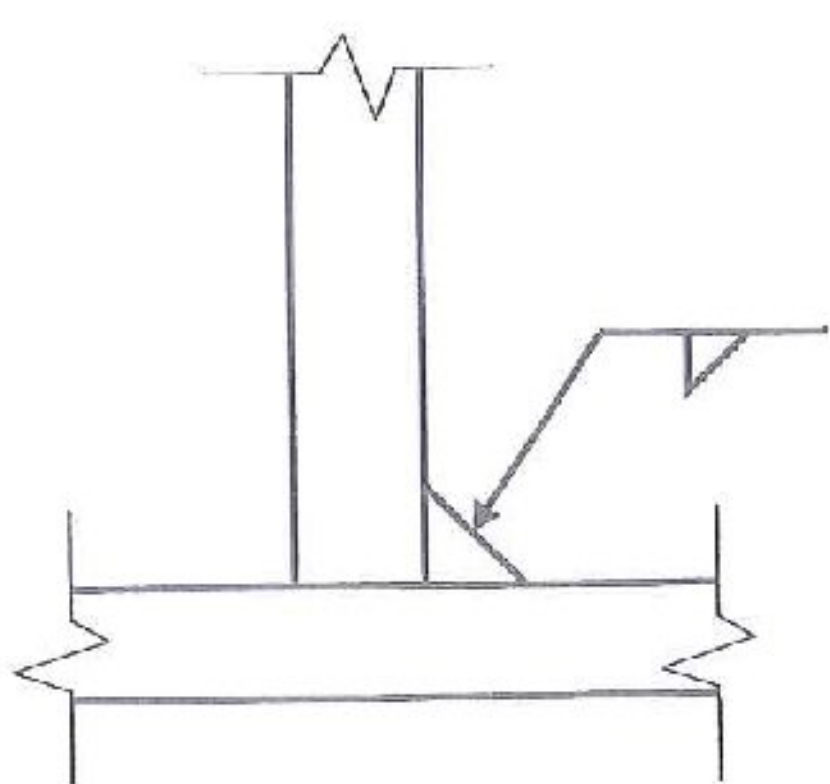Weld size	Pass no.	Electrode size	Welding parameters		Travel speed	Joint detail
			Amperes	Volts		
1/8	1	.063"	300 A ± 30	29 V ± 2	15 ipm ± 2	TYPICAL FILLET WELDS (5/16" MAX) 
3/16	1	.063"	300 A ± 30	29 V ± 2	15 ipm ± 2	
1/4	1	.063"	300 A ± 30	29 V ± 2	15 ipm ± 2	
5/16	1	.063"	300 A ± 30	29 V ± 2	15 ipm ± 2	

This procedure may vary due to fabrication sequence, fit-up, pass size, etc. within the limitation of variables given in section 5 of latest edition AWS D1.1 / D1.5

Paul A Radice  
 CWI 98070221  
 QC1 EXP. 7/1/2016

WPS no. W-2030-A  
 Revision no. 0  
 Supporting PQR no. Pre-Qualified  
 Project Name Fairfield, Vermont

Fabricator Highway Safety Corporation  
 Prepared By: Paul Radice  
 Date 02-18-15  
 Project Number BRF0281 (25) / BRO 1448(41)

# Highway Safety Corporation

Glastonbury, CT

## Welding Procedure Specification

Material specification ASTM A36, A572 gr 50, A709 Gr 36, ASTM A709 Gr 50, A500 gr B, A53 gr B  
 Welding process Gas Metal Arc Welding (GMAW) Spray Transfer  
 Manual, semi-automatic, or automatic Semi-Automatic  
 Position of welding Flat (1F) or Horizontal (2F)  
 Filler metal specification AWS A5.18  
 Filler metal classification ER70S-6  
 Electrode and manufacturer Lincoln Electric Lincoln Weld L-56  
 Flux and manufacturer N/A  
 Shielding gas 86% Argon / 14% CO2 Flow rate 35-45 CFM  
 Single or multiple pass Single  
 Single or multiple arc Single  
 Welding current DCEP  
 Polarity Reverse - electrode positive  
 Welding progression Stringers  
 Root treatment clean base metal  
 Preheat and interpass temperature base metal up to 3/4" (50°F)  
 Postheat treatment None  
 Electrode extension 3/4" ± 1/4"

Vermont Agency of Transportation

**RECEIVED**

CK'D BY RK/JC

OK'D BY RY

February 20, 2015


RESUBMIT No

Approved

BY RY

DATE 03/09/2015

### WELDING PROCEDURE

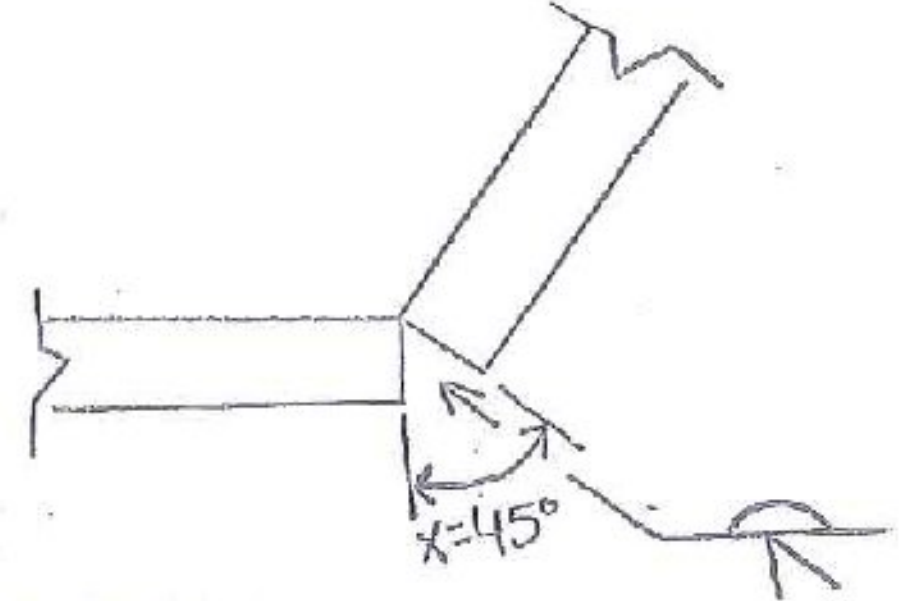Weld size	Pass no.	Electrode size	Welding parameters		Travel speed	Joint detail
			Amperes	Volts		
n/a	1	0.063	300 A	29	15 ipm	<p><u>TC-U4b-GF</u></p>  <p>X = 45 As Fitup: X=+10, -5 All Thicknesses</p>
			+/- 30	+/- 3	+/- 2	

This procedure may vary due to fabrication sequence, fit-up, pass size, etc. within the limitation of variables given section 5 of latest edition AWS D1.1 / D1.5

**AWS**  
 Paul A Radice  
 CWI 98070221  
 QC1 EXP. 7/1/2016

WPS no. W-2030-B Fabricator Highway Safety Corporation  
 Revision no. 0 Prepared By: Paul Radice  
 Supporting PQR no. Pre-Qualified Date 02-18-15  
 Project Name Fairfield, Vermont Project Number BRF0281 (25) / BRO 1448(41)

# Highway Safety Corporation

Glastonbury, CT

## Welding Procedure Specification

Material specification ASTM A36, A572 gr 50, A709 Gr 36, ASTM A709 Gr 50, A500 gr B, A53 gr B  
 Welding process Gas Metal Arc Welding (GMAW) Spray Transfer  
 Manual, semi-automatic, or automatic Semi-Automatic  
 Position of welding Flat (1F) or Horizontal (2F)  
 Filler metal specification AWS A5.18  
 Filler metal classification ER70S-6  
 Electrode and manufacturer Lincoln Electric Lincoln Weld L-56  
 Flux and manufacturer N/A  
 Shielding gas 86% Argon / 14% CO2 Flow rate 35-45 CFM  
 Single or multiple pass Single  
 Single or multiple arc Single  
 Welding current DCEP  
 Polarity Reverse - electrode positive  
 Welding progression Stringers  
 Root treatment clean base metal  
 Preheat and interpass temperature base metal up to 3/4" (50°F)  
 Postheat treatment None  
 Electrode extension 3/4" ± 1/4"

Vermont Agency of Transportation  
**RECEIVED**

CK'D BY RK/JC OK'D BY RY

February 20, 2015

RESUBMIT No Approved

BY RY DATE 03/09/2015

### WELDING PROCEDURE

Weld size	Pass no.	Electrode size	Welding parameters		Travel speed	Joint detail
			Amperes	Volts		
n/a	1	0.063	300 A ± 30	29 ± 3	15 ipm ± 2	

This procedure may vary due to fabrication sequence, fit-up, pass size, etc. within the limitation of variables given in section 5 of latest edition AWS D1.1 / D1.5

 Paul A Radice  
 CWI 98070221  
 QC1 EXP. 7/1/2016

WPS no. W-2030-C Fabricator Highway Safety Corporation  
 Revision no. 0 Prepared By: Paul Radice  
 Supporting PQR no. Pre-Qualified Date 02-18-15  
 Project Name Fairfield, Vermont Project Number BRF0281 (25) / BRO 1448(41)

Fairfield BRF 0231(25) & BRO 1448(41)

**Welding Procedure Specification**

Material specification Grade 50  
 Welding process SMAW  
 Manual or machine manual  
 Position of welding all positions  
 Filler metal specification NR311 AS-1  
 Filler metal classification E-7018  
 Flux N/A  
 Shielding gas N/A Flow rate N/A  
 Single or multiple pass as required  
 Single or multiple arc N/A  
 Welding current P.C  
 Polarity regular  
 Welding progression as required  
 Root treatment none  
 Preheat and interpass temperature 50-175  
 Postheat treatment N/A

**WELDING PROCEDURE**

Pass no.	Electrode size	Welding current		Travel speed	Joint detail
		Amperes	Volts		
As req	5/32	120-240	22-27	As req	<p>3/8 Groove Weld HP 12 x 84</p>

Vermont Agency of Transportation  
**RECEIVED**


CK'D BY _____ OK'D BY JC  
 May 29, 2015  
 RESUBMIT NO Approved  
 BY RY _____ DATE 6-1-2015

This procedure may vary due to fabrication sequence, fit-up, pass size, etc., within the limitation of variables given in Section 5. (of the AASHTO/AWS D1.5 Bridge Welding Code and latest revision)

Procedure no. _____ Contractor AL St. Orge Contractor Inc  
 Revision no. _____ Authorized by Randy St. Orge  
 Welder _____ Date 5/29/15

# HARD-BITE™ – HP-77600-B 30#

## Dimensions

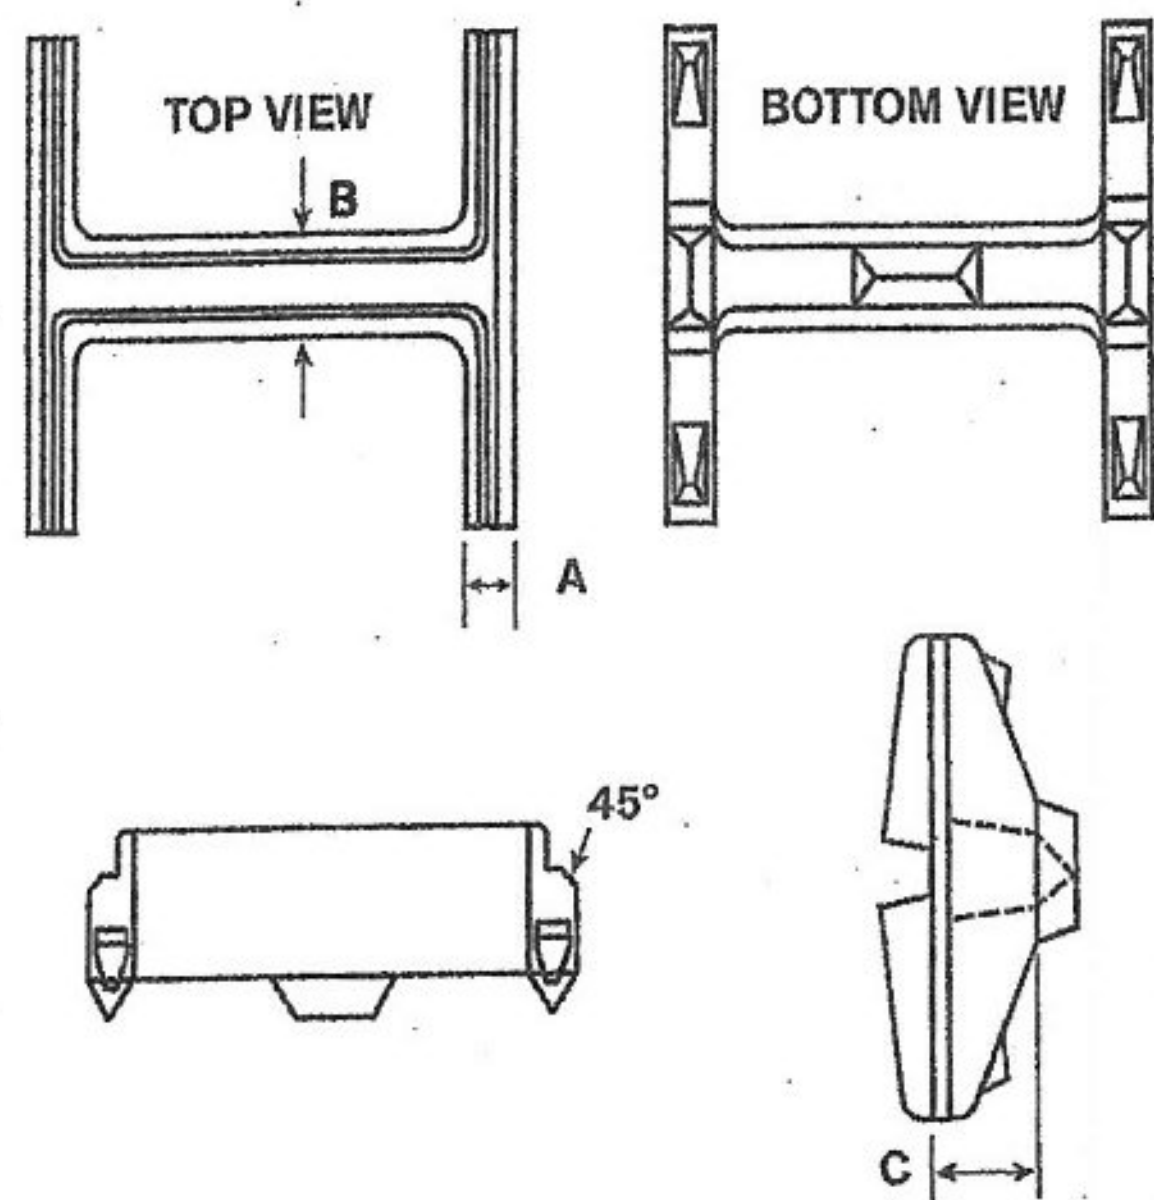


**MATERIAL: CAST STEEL**

ASTM A148 90/60

	12"
A	1"
B	1-5/16"
C	3"
Wt.	31#

## Installation Instructions

1. Fit point onto the end of the square cut pile end.
2. Weld point to the pile in either flat or vertical position using E7018 electrodes.
3. Weld across full width of flange following chart below for minimum size weld.

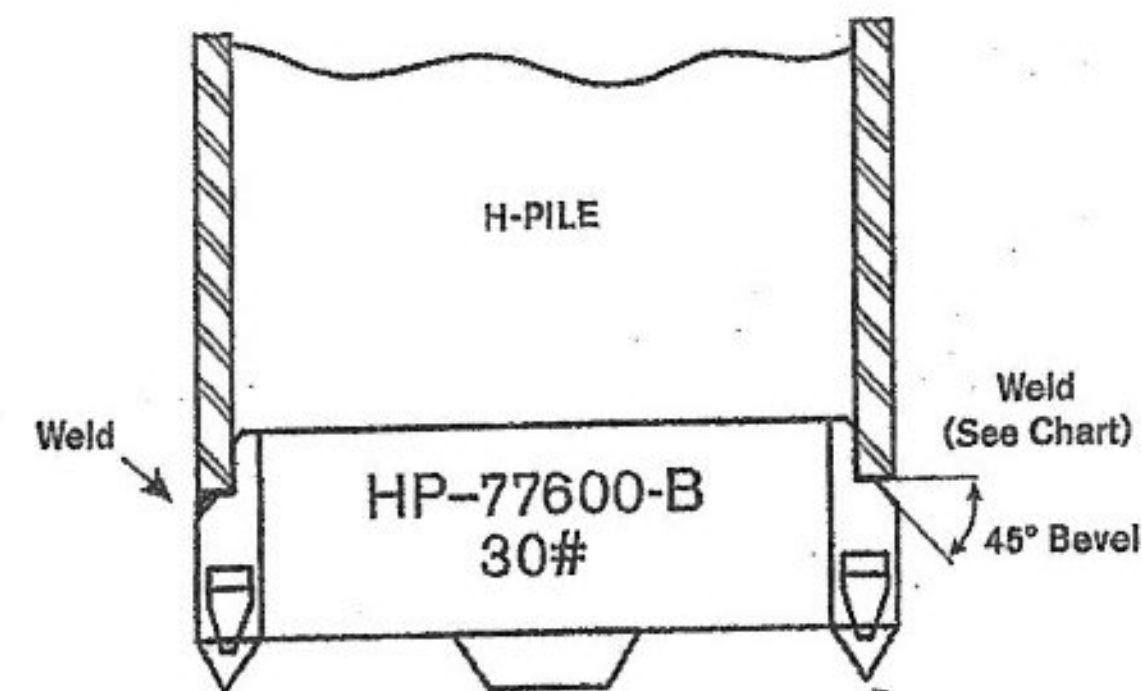

Pile Size	Flange Thickness	Groove Weld
HP 12 x 84	.685	3/8
x 74	.610	3/8
x 63	.515	5/16
x 53	.435	5/16

Vermont Agency of Transportation

**RECEIVED**

CK'D BY _____ OK'D BY JC

May 29, 2015

RESUBMIT NO Approved


BY RY DATE 6-1-2015



**ASSOCIATED PILE & FITTING**

PO Box 5933 Parsippany, NJ 07054-5933  
 Tel: 973-773-8400  
 Fax: 973-428-5146  
 email: apf@associatedpile.com  
 www.associatedpile.com  
 Call Toll Free: 800-526-9047



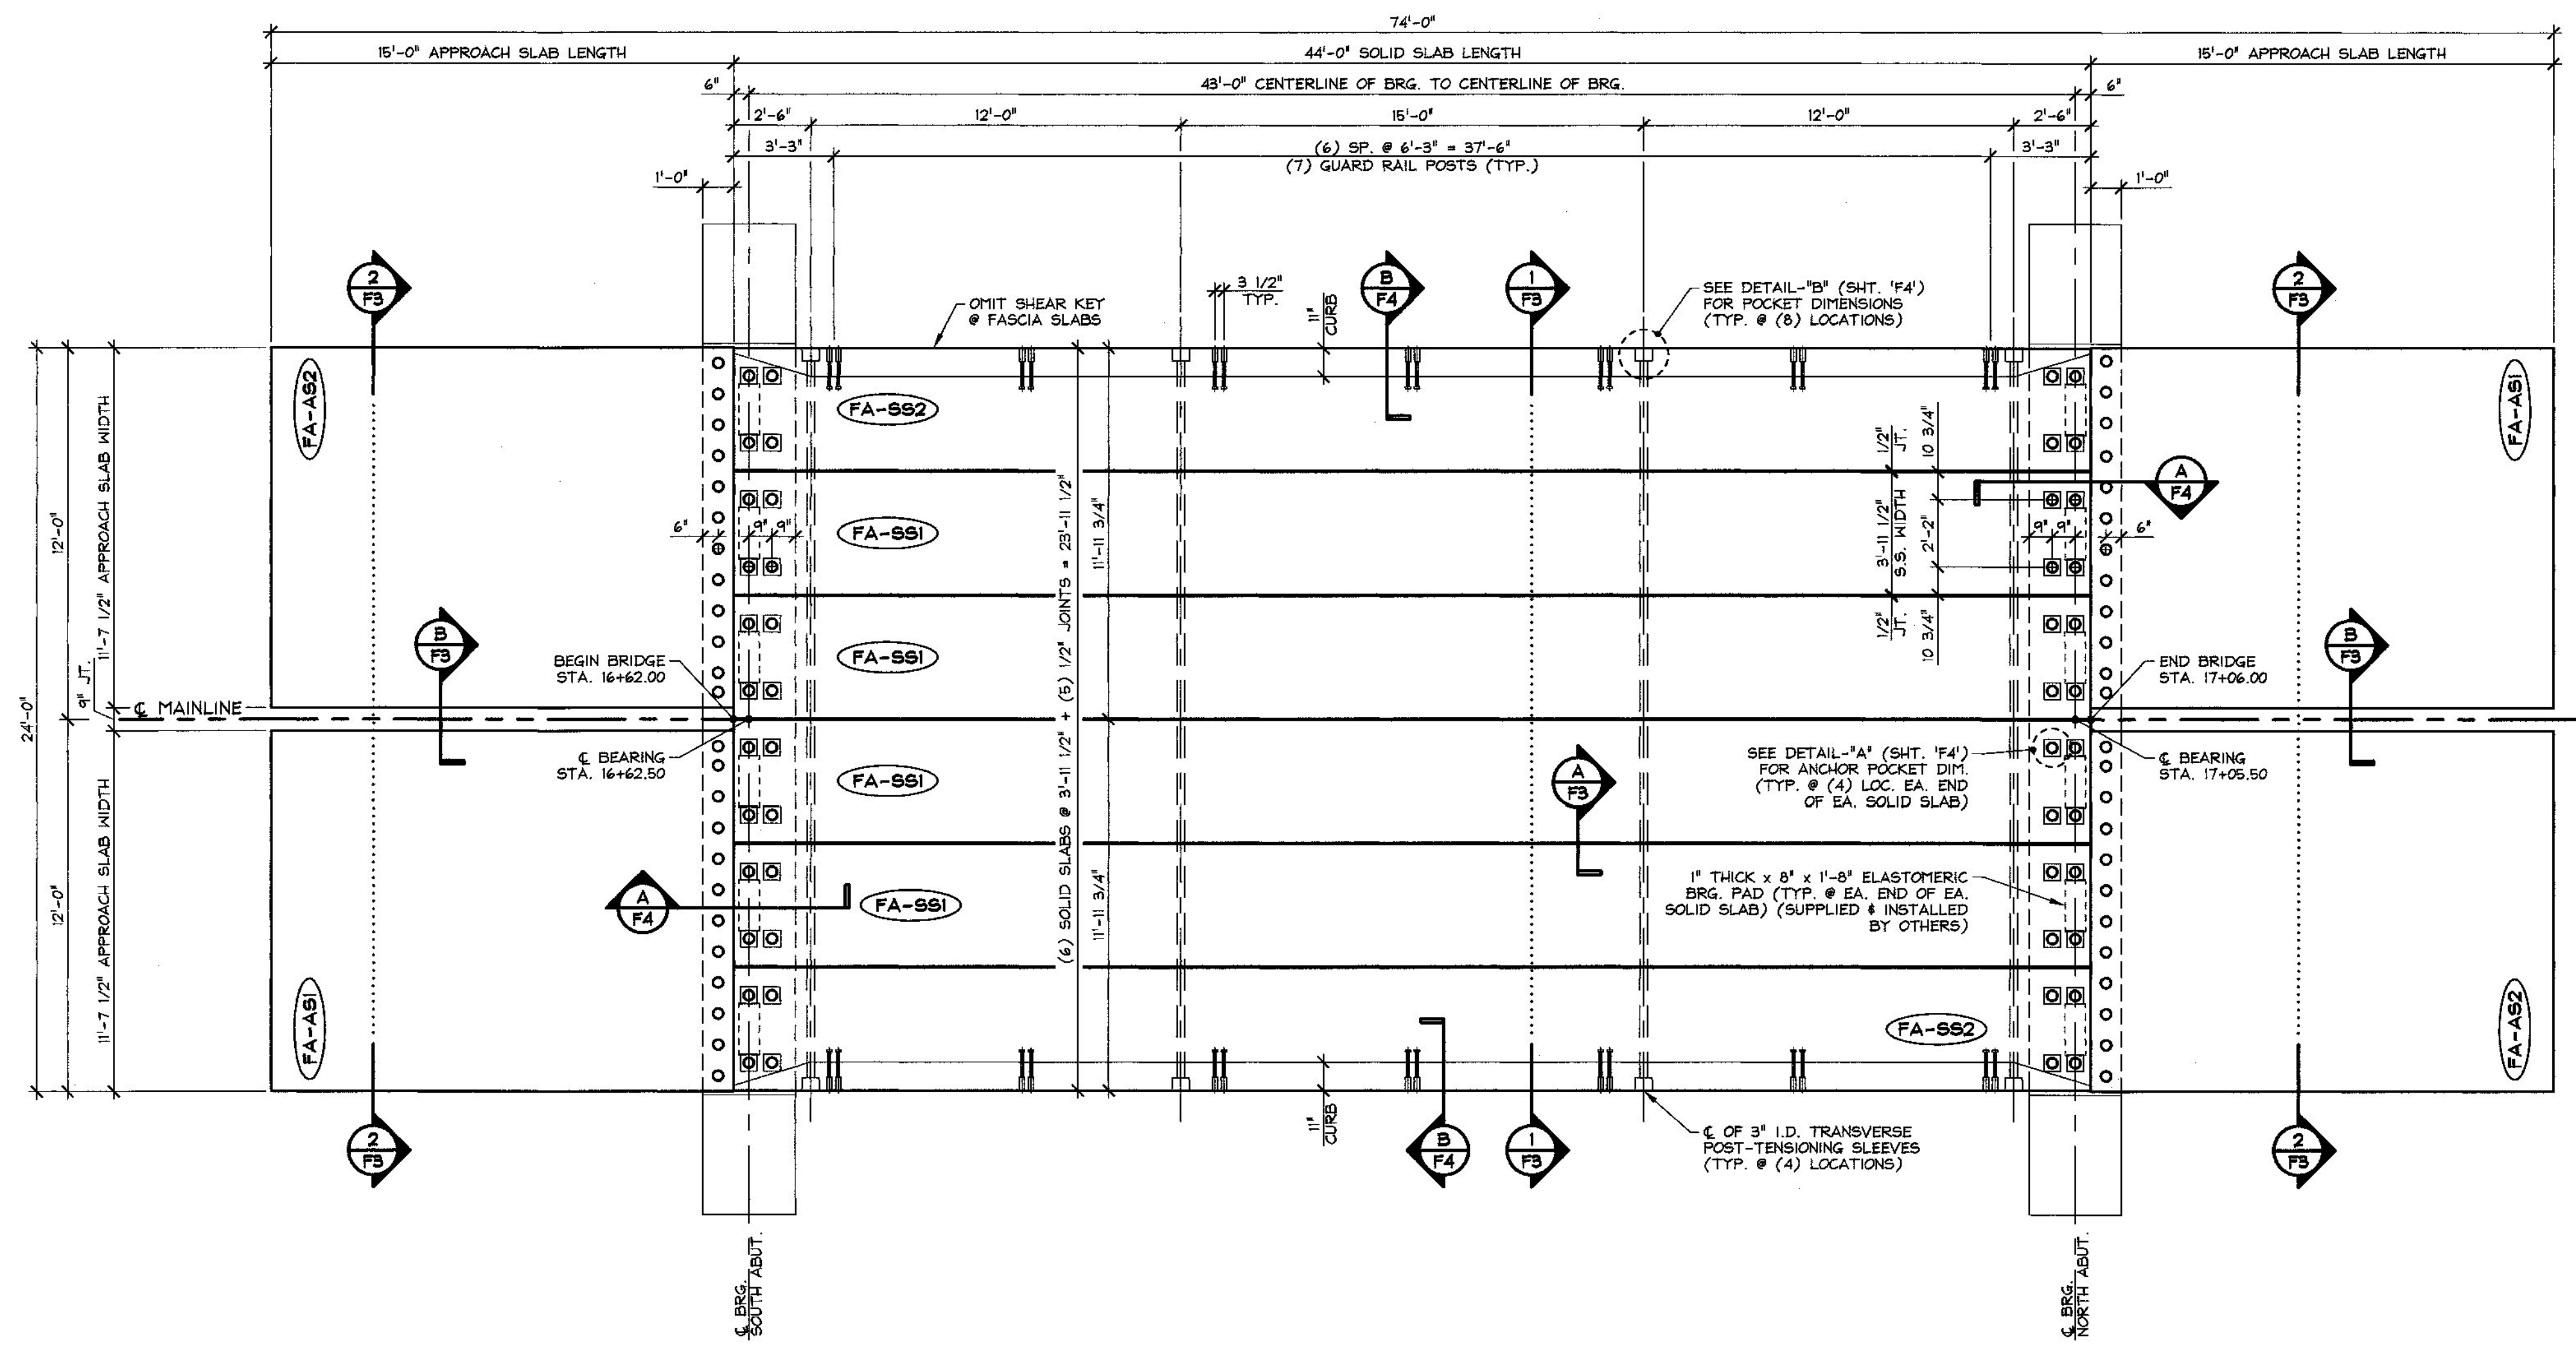


1 PRESTRESSED SOLID SLAB & PRECAST APPROACH SLAB LAYOUT  
 F2 1/4" = 1'-0"




Vermont Agency of Transportation  
**RECEIVED**  
 CK'D BY RK/JW OK'D BY RY  
 February 12, 2015  
 RESUBMIT No Approved  
 BY RY DATE 02/12/2015

2-10-15 REVISED PER VT AOT COMMENTS


APPROVAL STAMP:	<b>J.P. CARRARA &amp; SONS INC.</b> Precast & Prestress Manufacturer 2464 ONE STR., MIDDLEBURY, VERMONT 05753 Phone: (802)388-6361 Fax: (802)388-9010		A.L. ST. ONGE CONTRACTOR MONTGOMERY, VERMONT	
	STATE OF VERMONT AGENCY OF TRANSPORTATION COUNTY OF FRANKLIN		DATE: NOV. 10, 2014	SCALE: NOTED
	TOWN OF FAIRFIELD SOUTH ROAD, FAS 0281 (RURAL MAJOR COLLECTOR) BRIDGE NO.: 14 PROJECT NO.: BRP 0281(25)		CHKD: B.C. DFTM: B.L.	JOB NO: 23446-014
	<b>PRESTRESSED SOLID SLAB &amp; PRECAST APPROACH SLAB LAYOUT</b>		DWG. NO: <b>F2</b>	

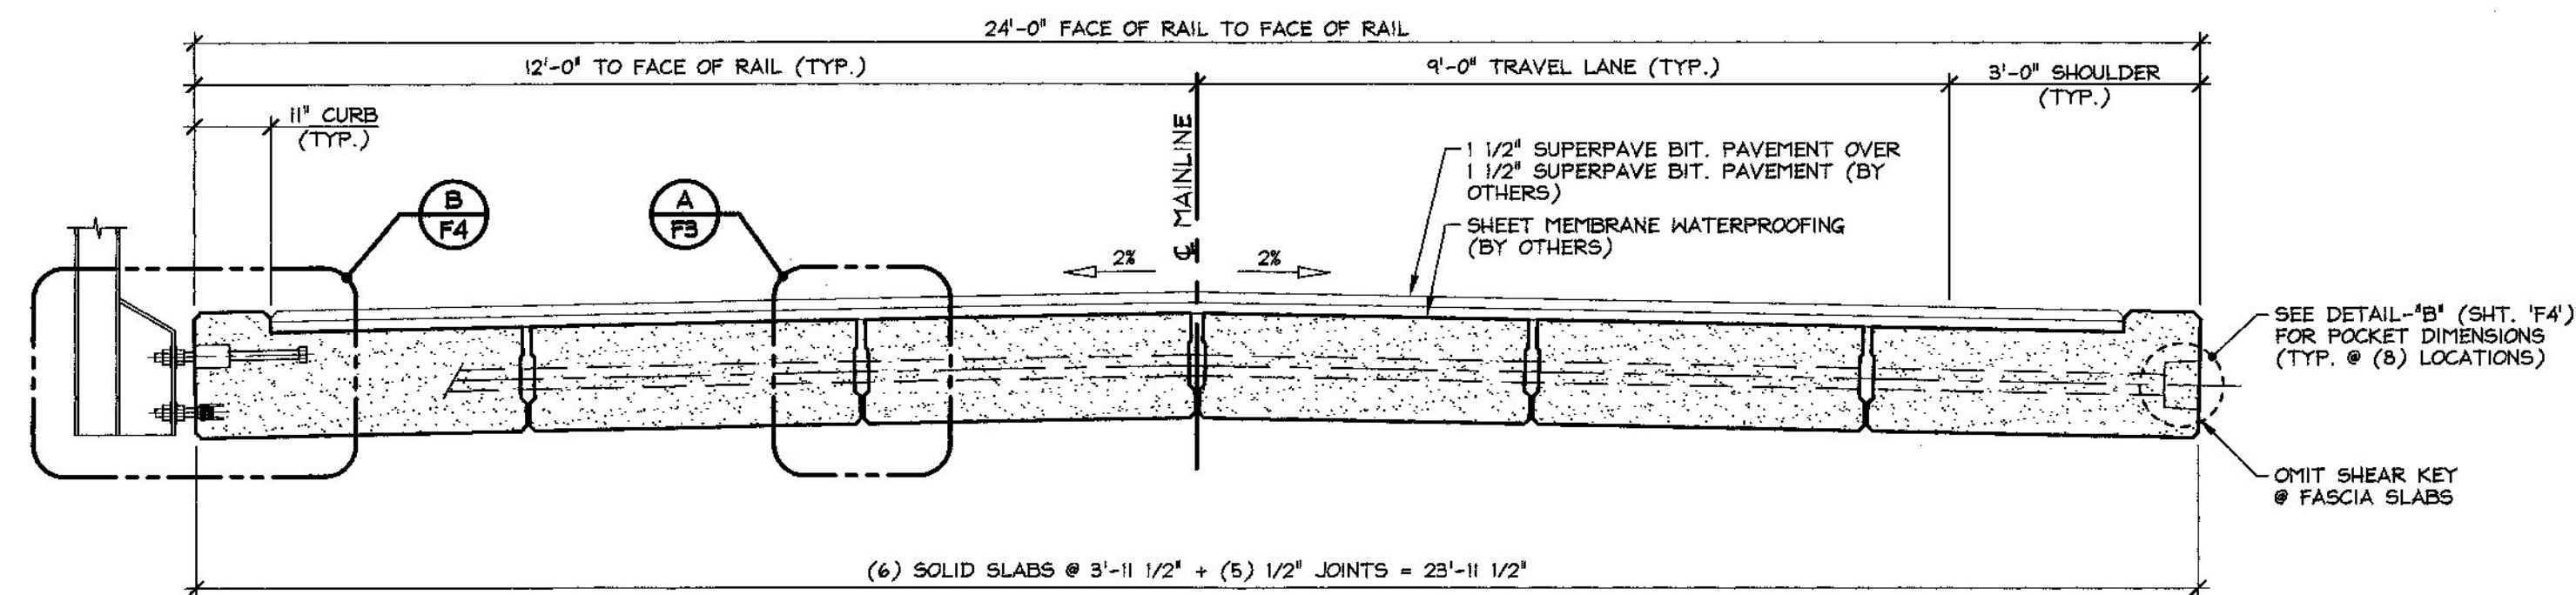


**1**  
F3 PRESTRESSED SOLID SLAB TRANSVERSE SECTION  
1/2" = 1'-0"

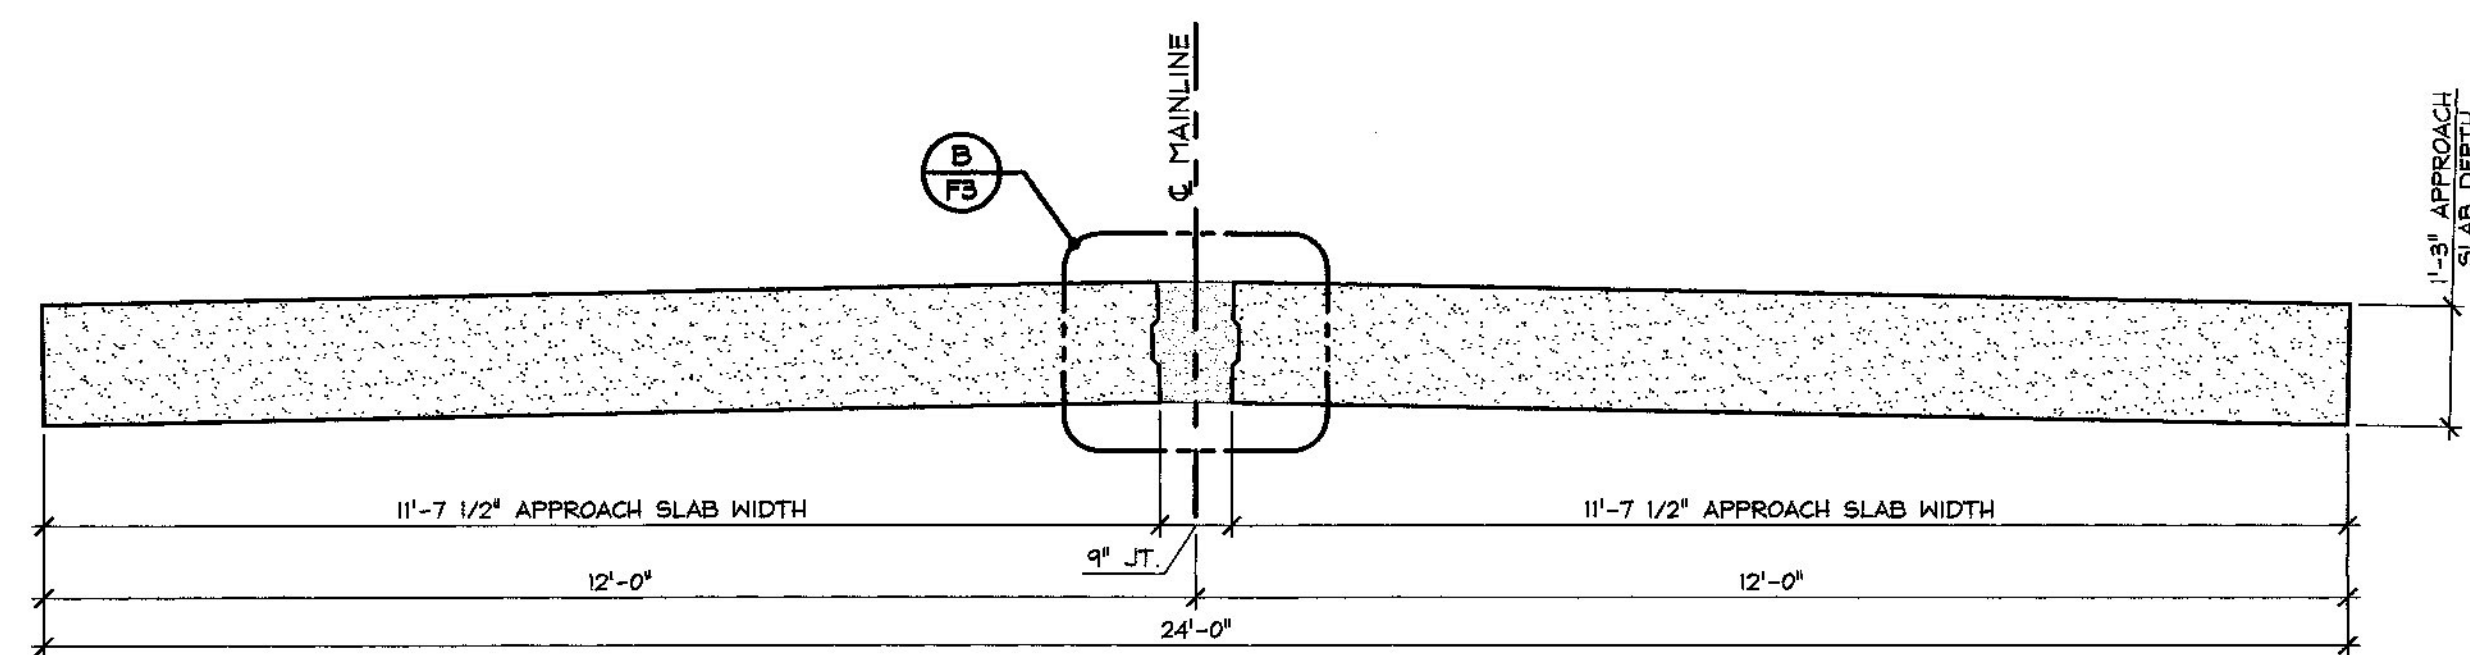

**2**  
F3 PRECAST APPROACH SLAB TRANSVERSE SECTION  
1/2" = 1'-0"

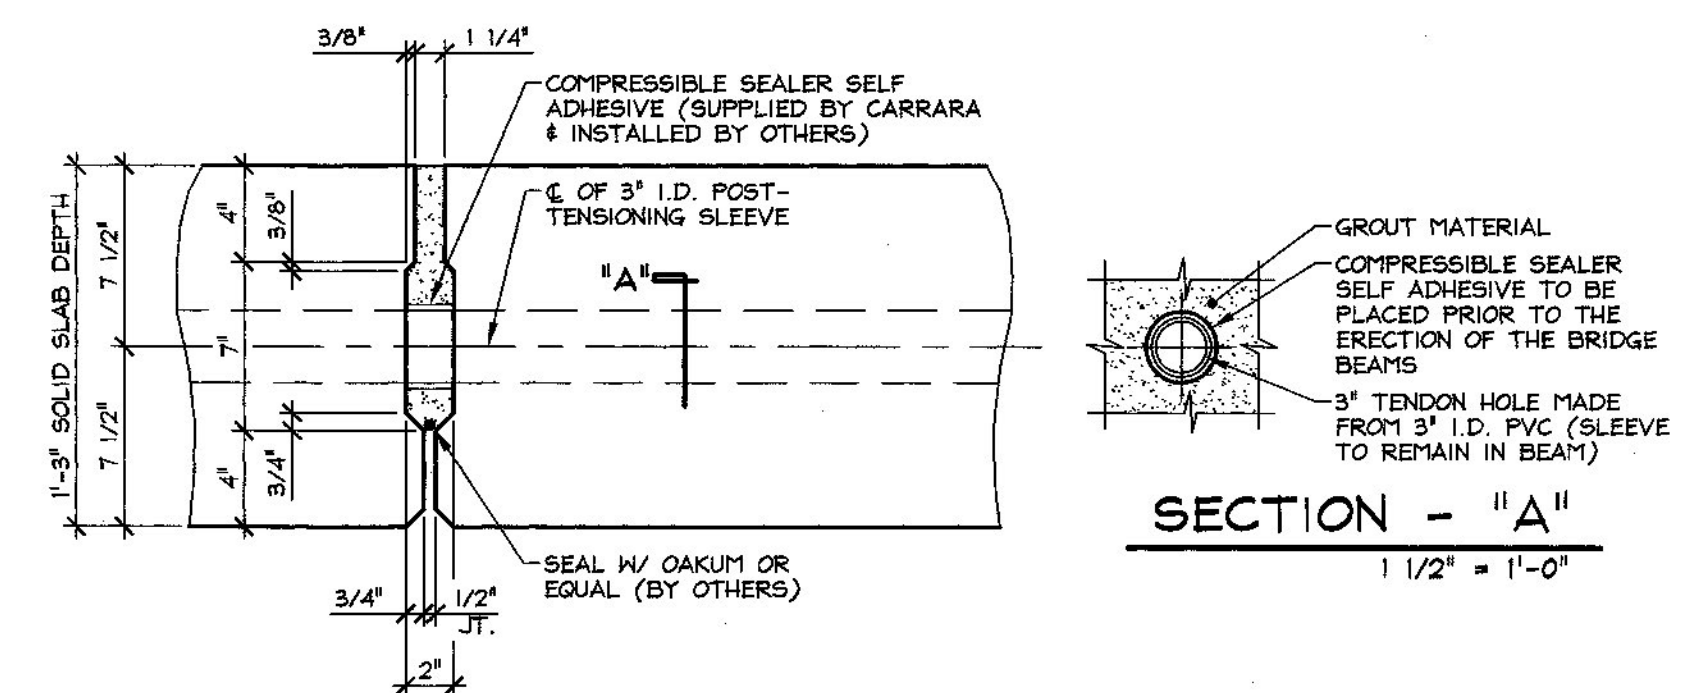

**A**  
F3 SHEAR KEY SECTION @ P.T. SLEEVE  
1/2" = 1'-0"

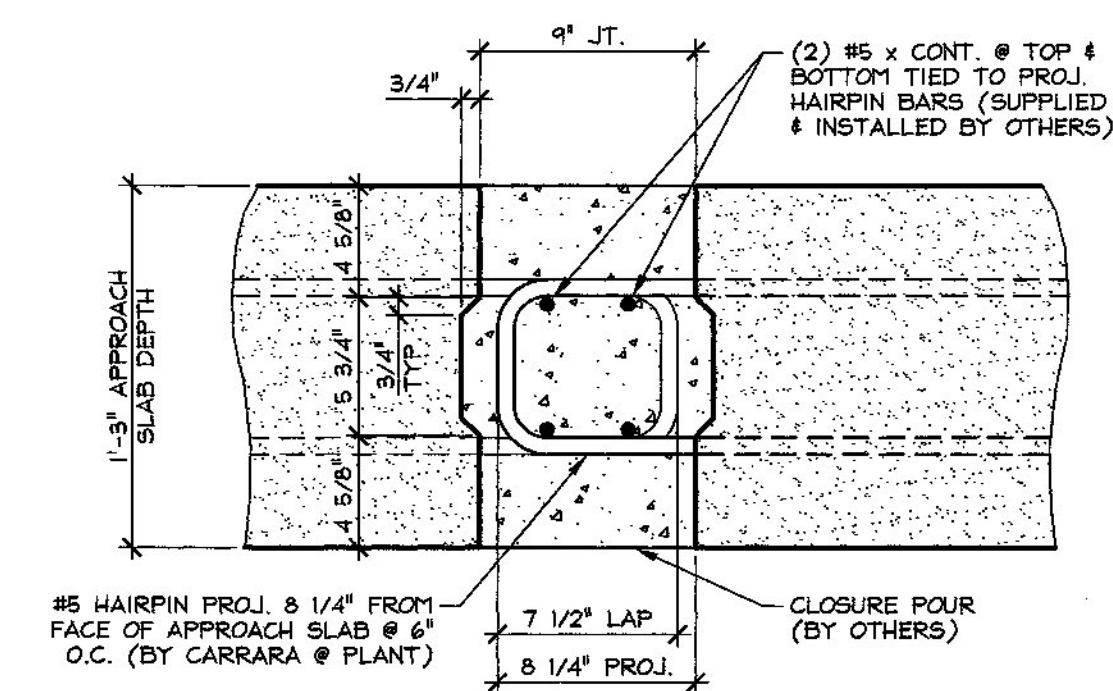

**B**  
F3 SHEAR KEY SECTION @ APPROACH SLABS  
1/2" = 1'-0"


Vermont Agency of Transportation  
**RECEIVED**

CK'D BY RK/JW OK'D BY RY  
February 12, 2015


RESUBMIT No Approved  
BY RY DATE 02/12/2015

2-10-15 REVISED PER VT AOT COMMENTS


APPROVAL STAMP:	<b>J.P. CARRARA &amp; SONS INC.</b> Precast & Prestress Manufacturer <small>2464 GAGE STR., WOODFORD, VERMONT 05753 Phone:(802)388-6361 Fax:(802)388-9010</small>		A.L. St. ONGE CONTRACTOR MONTGOMERY, VERMONT	
	STATE OF VERMONT AGENCY OF TRANSPORTATION COUNTY OF FRANKLIN		DATE: NOV. 10, 2014 SCALE: NOTED	
	TOWN OF FAIRFIELD SOUTH ROAD, FAS 0281 (RURAL MAJOR COLLECTOR) BRIDGE NO.: 14 PROJECT NO.: BRP 0281(25)		CHKD: B.C. DFTM: B.L. JOB NO: 23446-014	
	<b>TRANSVERSE SECTIONS</b>		DWG. NO: <b>F3</b>	

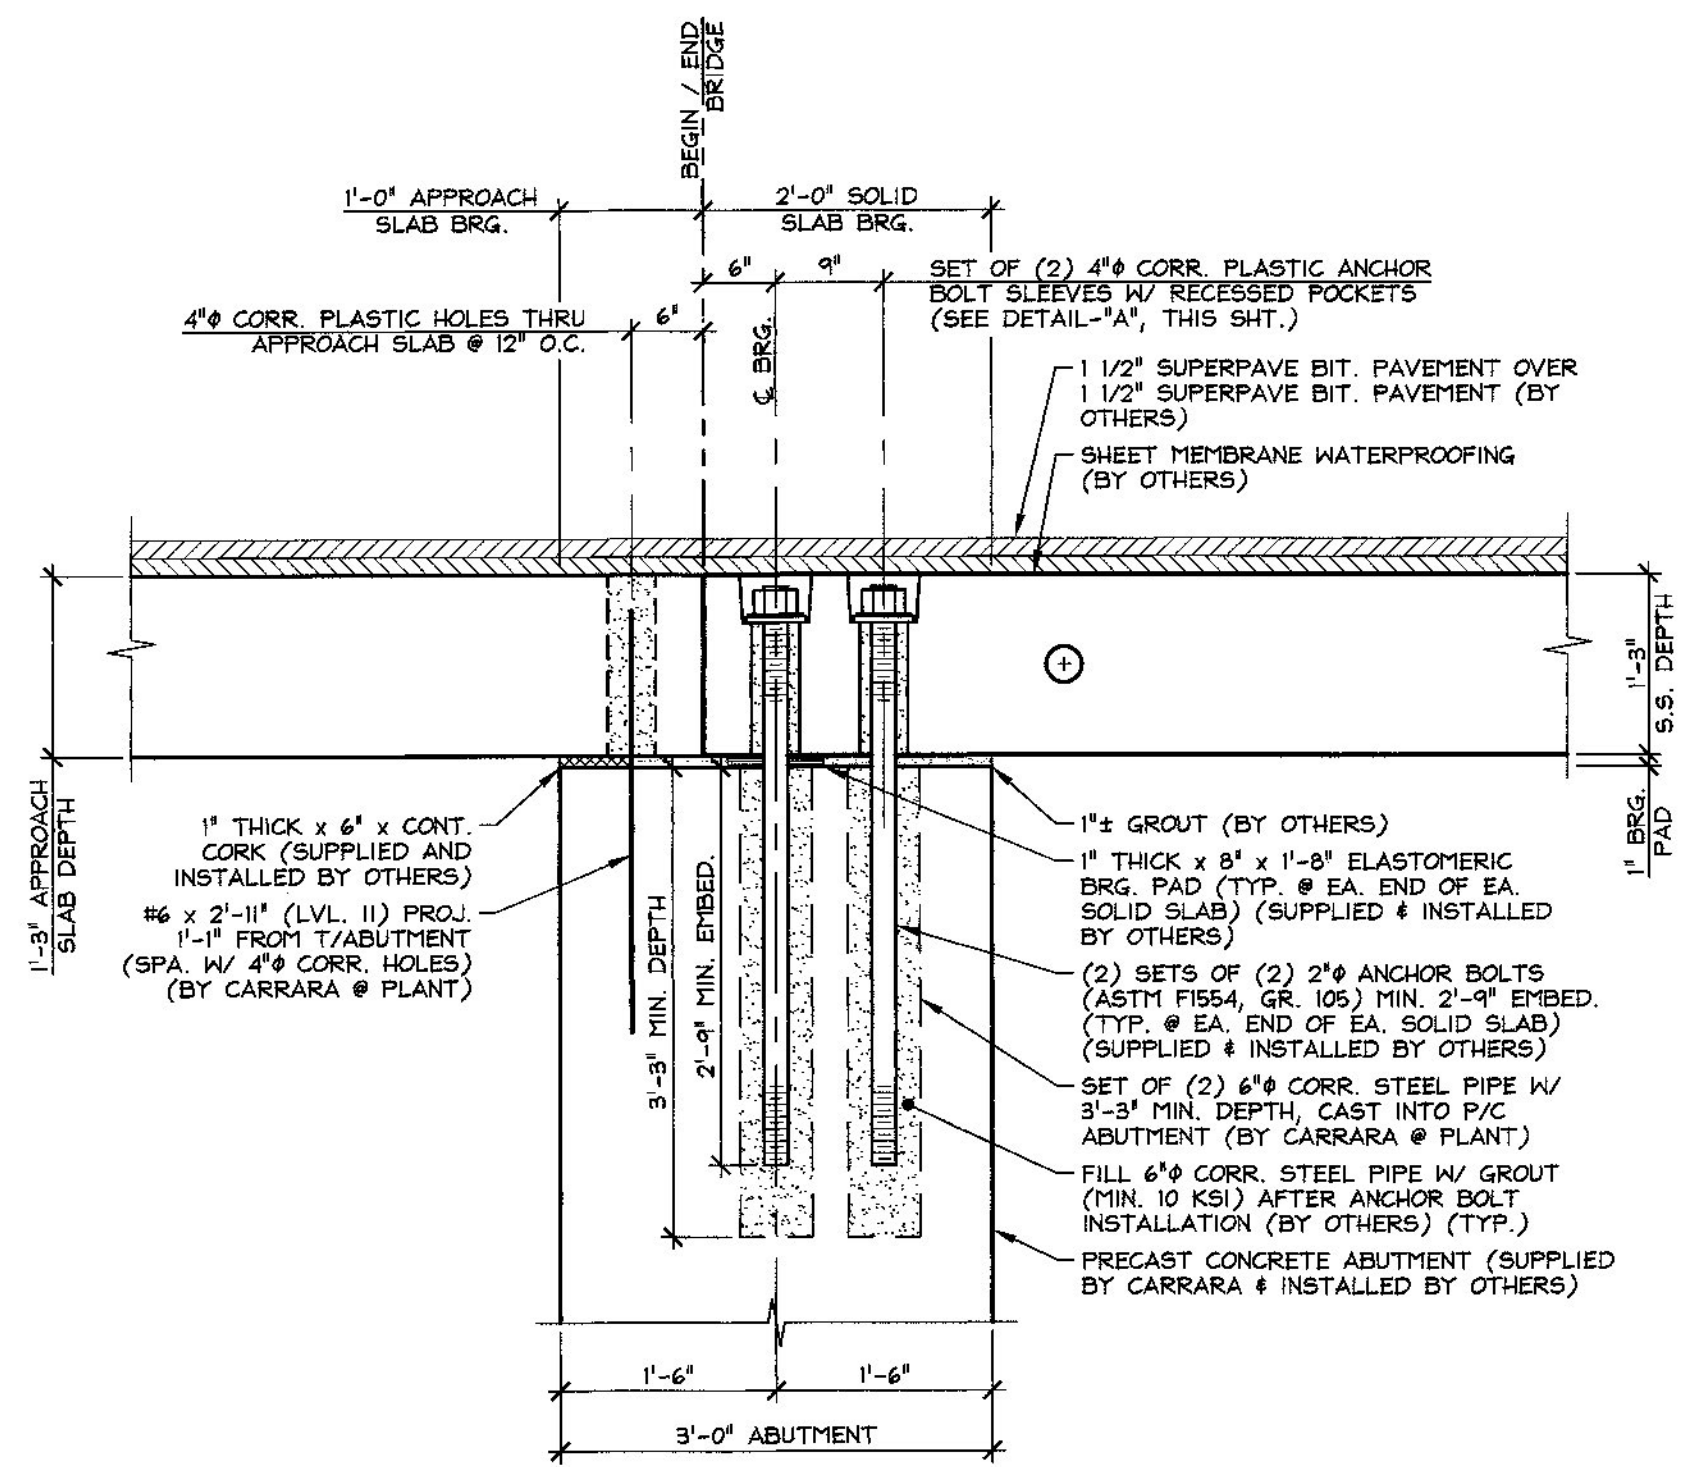

**A BEARING SECTION**  
 F4 3/4" = 1'-0"

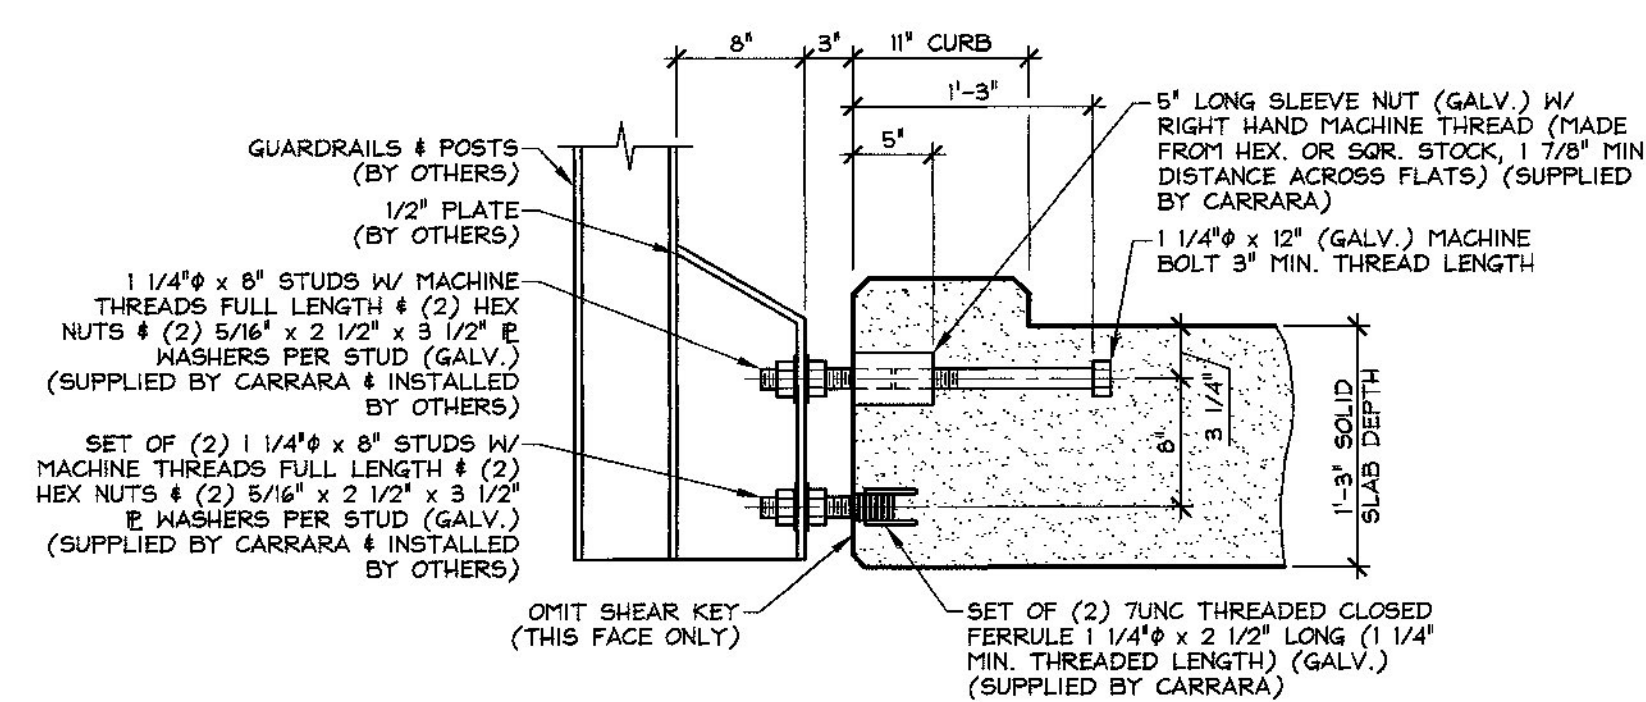


**B GUARDRAIL ANCHORAGE SECTION**  
 F4 1" = 1'-0"

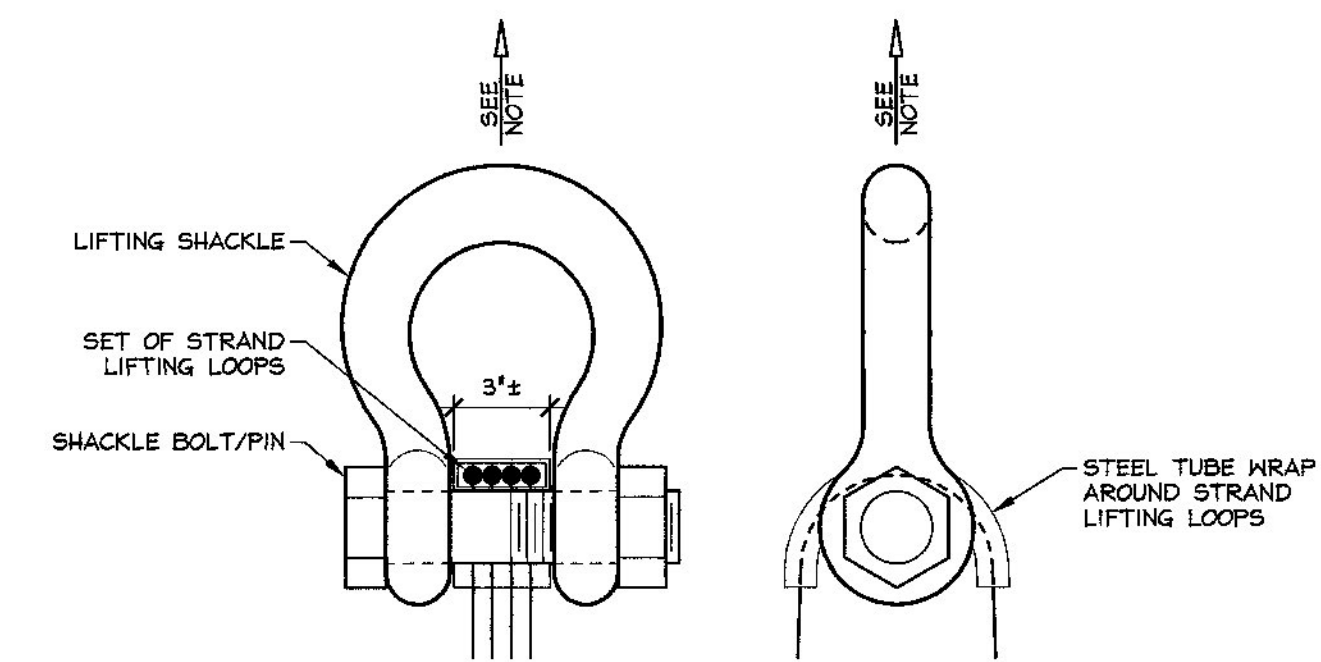


NOTE: ABUTMENTS SHALL BE HANDLED AND ERECTED USING THE LIFTING LOOPS ONLY. RIGGING SHALL BE CONFIGURED SUCH THAT EQUAL FORCES ARE APPLIED TO EACH SET OF LIFTING LOOPS AT EACH END OF THE SLAB. SHACKLE BOLT/PIN SHALL BE PLACED UNDER LIFT LOOPS AS SHOWN. DESIGN AND CONFIGURATION OF RIGGING BY PURCHASER.


**LIFTING SHACKLE DETAILS**  
 N.T.S.

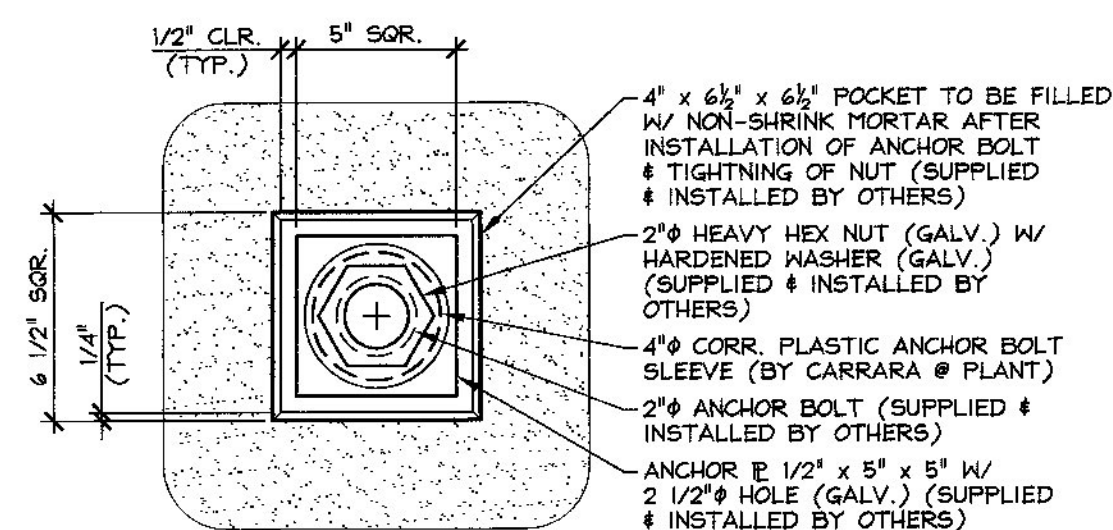


**PLAN VIEW**

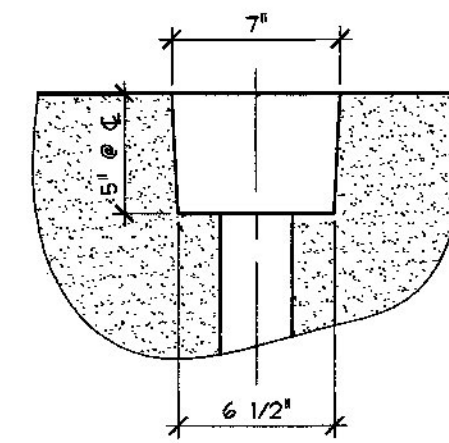

**PLAN OF POCKET**

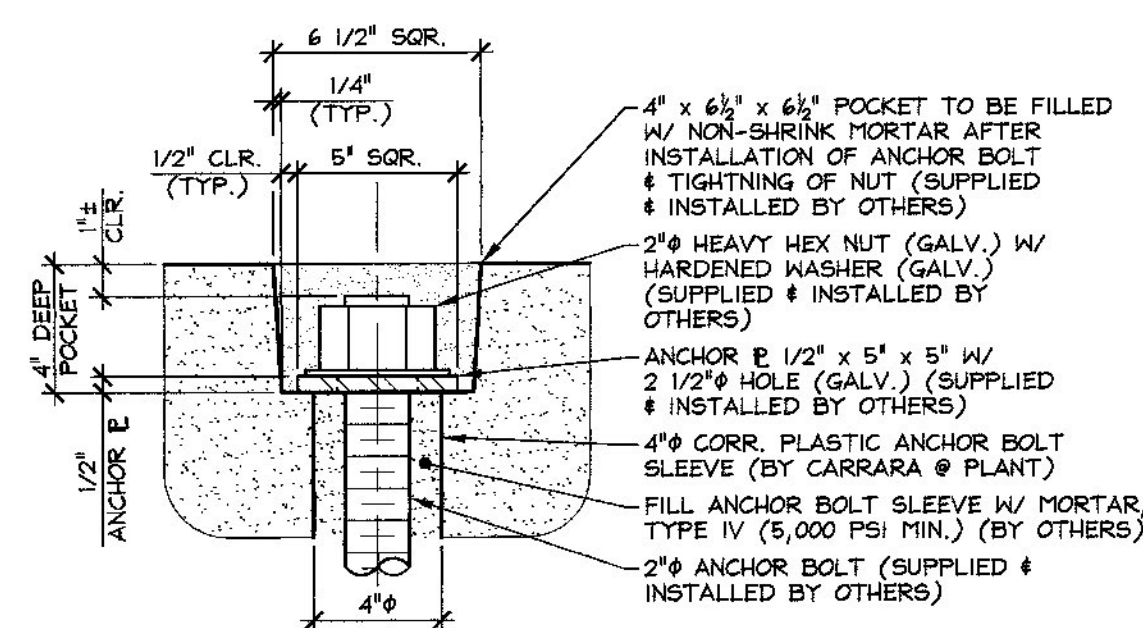

**SECTION**  
**DETAIL - "A"**  
 2" = 1'-0"

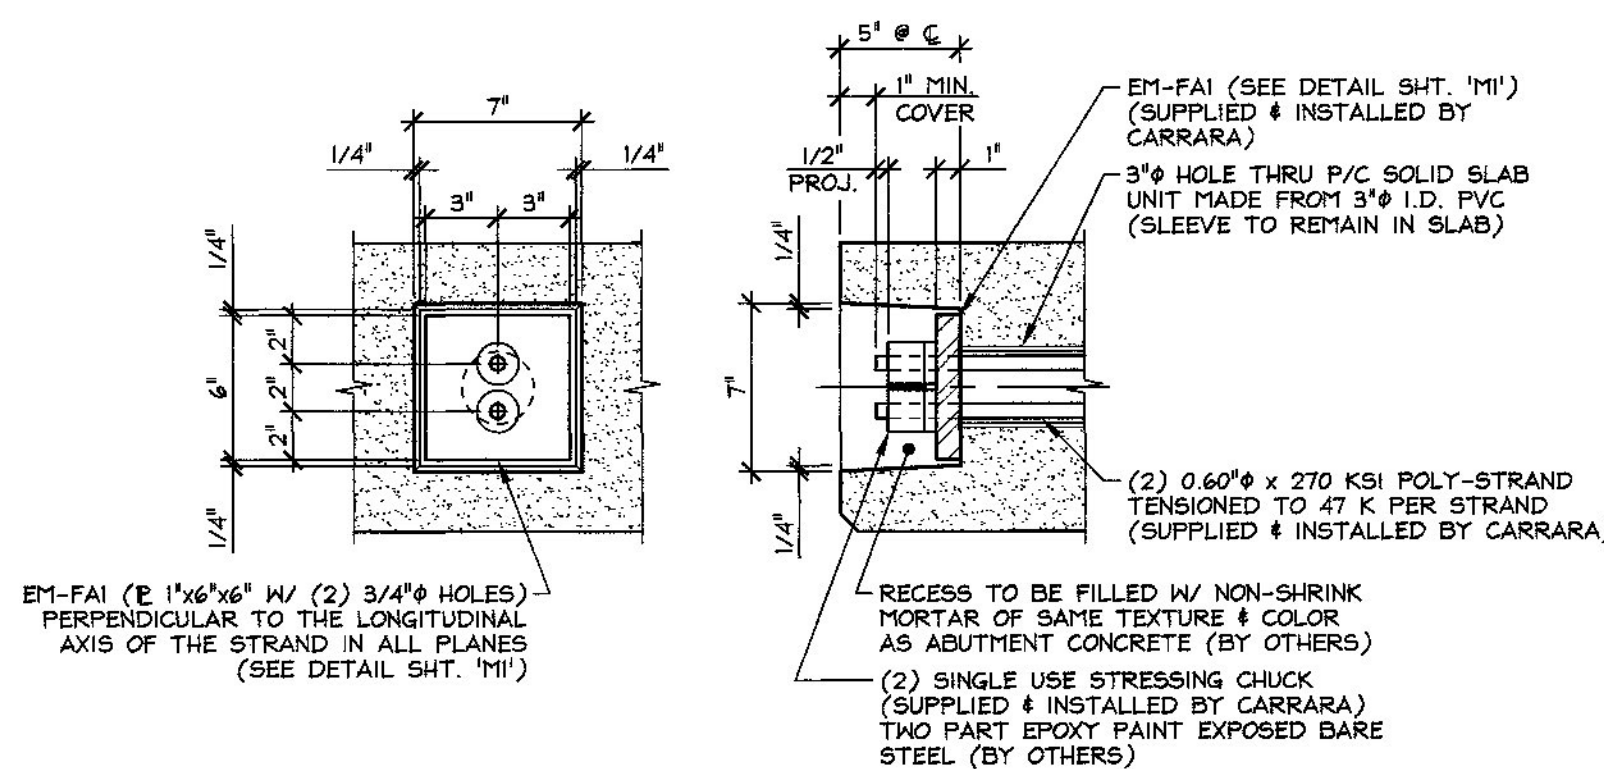





**FASCIA ELEVATION**  
**SECTION AT CENTERLINE**  
**DETAIL - "B"**  
 1 1/2" = 1'-0"

Vermont Agency of Transportation  
**RECEIVED**

CK'D BY RK/JW OK'D BY RY  
 February 12, 2015  
 RESUBMIT No Approved  
 BY RY DATE 02/12/2015

2-10-15 REVISED PER VT AOT COMMENTS

APPROVAL STAMP:	<b>J.P. CARRARA &amp; SONS INC.</b> Precast & Prestress Manufacturer 2404 GAGE ST., MONTPELIER, VERMONT 05753 Phone: (802) 388-6361 Fax: (802) 388-9010		A.L. St. ONGE CONTRACTOR MONTPELIER, VERMONT
	STATE OF VERMONT AGENCY OF TRANSPORTATION COUNTY OF FRANKLIN		DATE: NOV. 10, 2014 SCALE: NOTED
	TOWN OF FAIRFIELD SOUTH ROAD, FAS 0281 (RURAL MAJOR COLLECTOR) BRIDGE NO.: 14 PROJECT NO.: BRF 0281(25)		CHKD: B.C. DFTM: B.L. JOB NO: 23446-014
	<b>SECTIONS &amp; DETAILS</b>		DWG. NO: <b>F4</b>

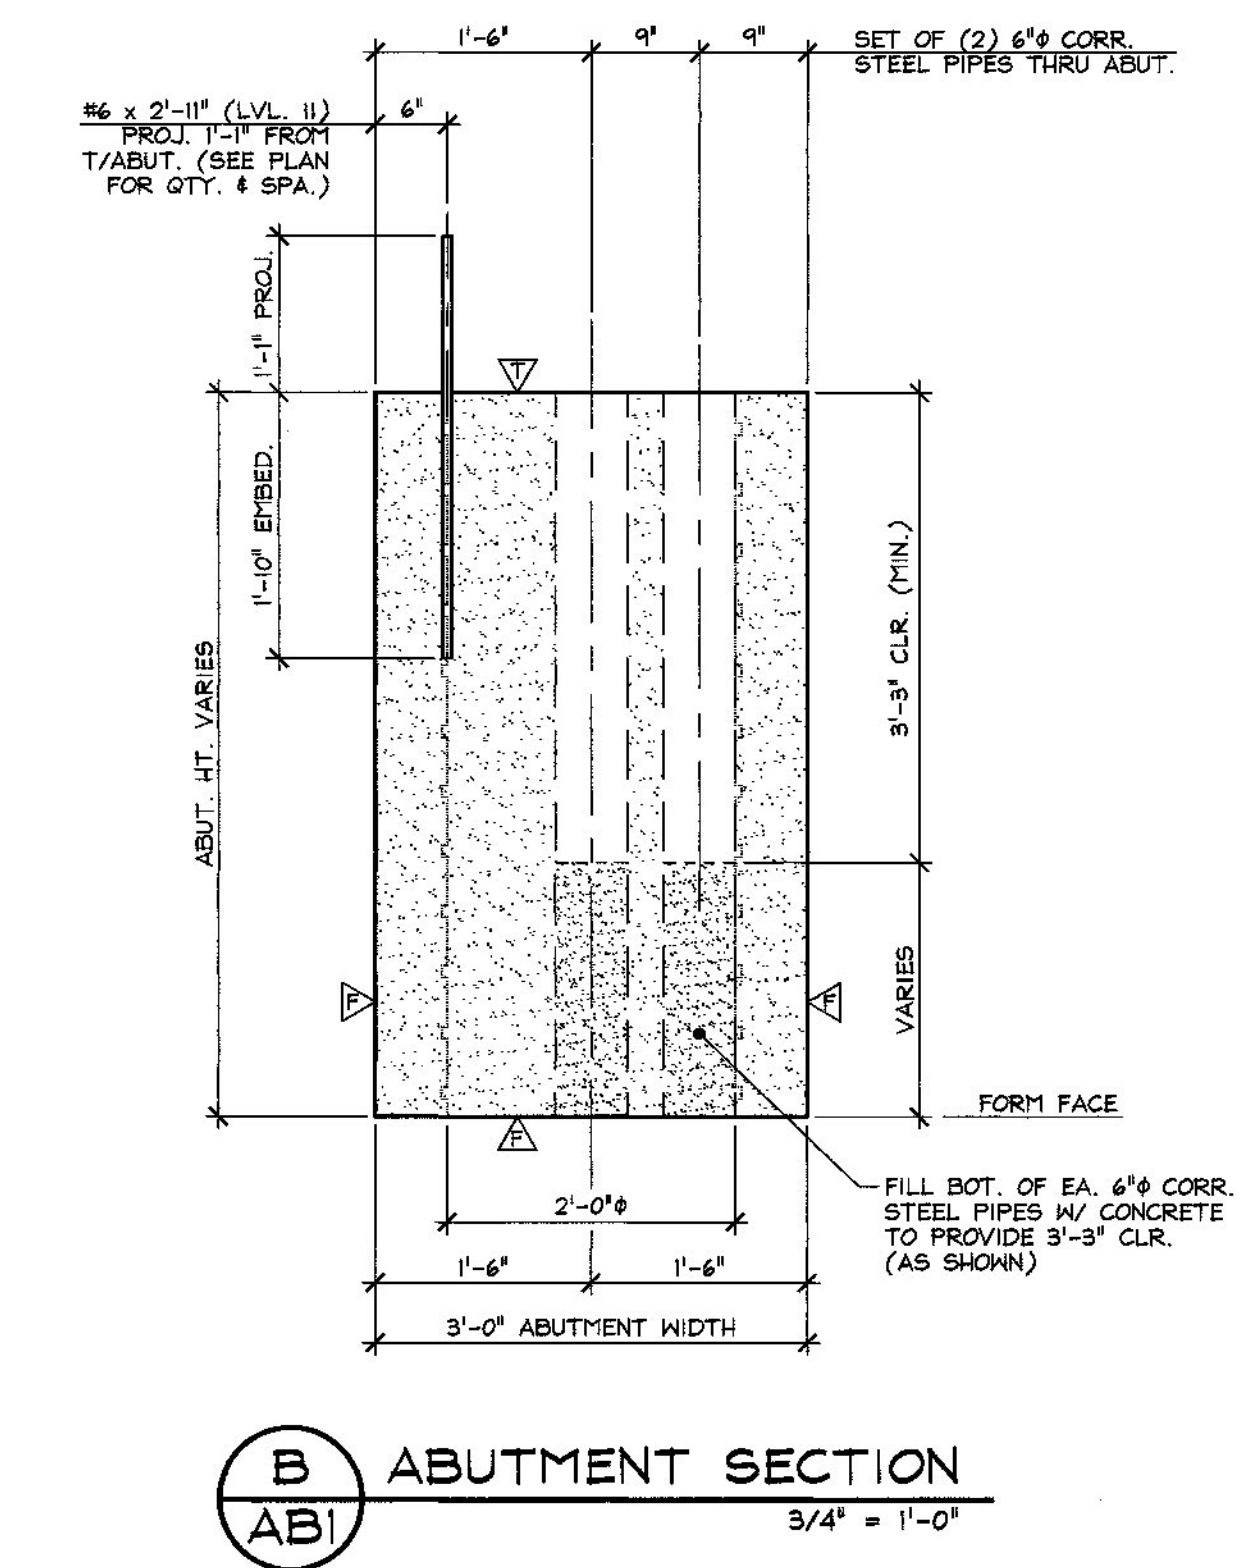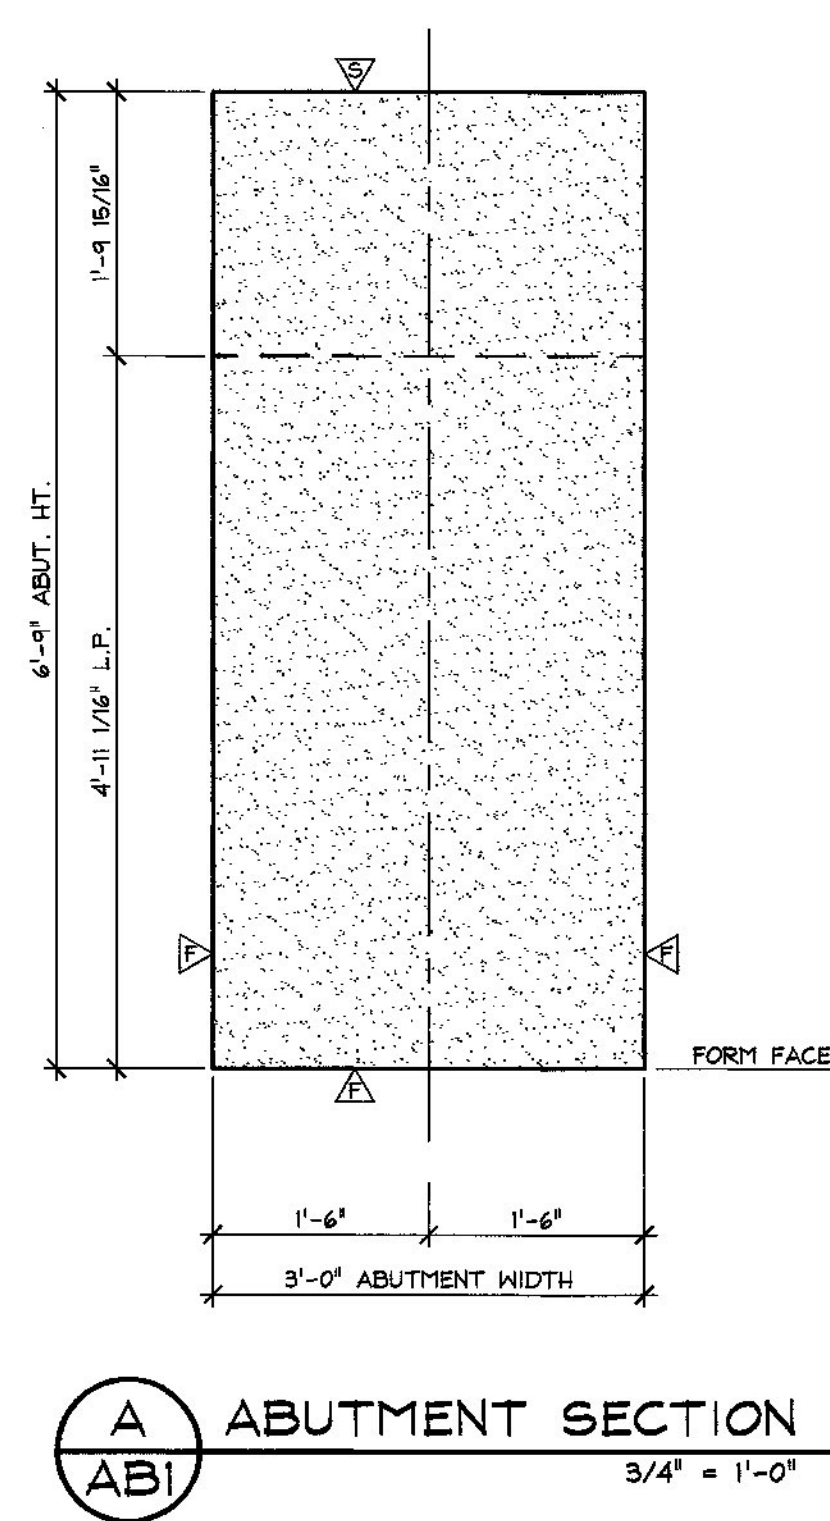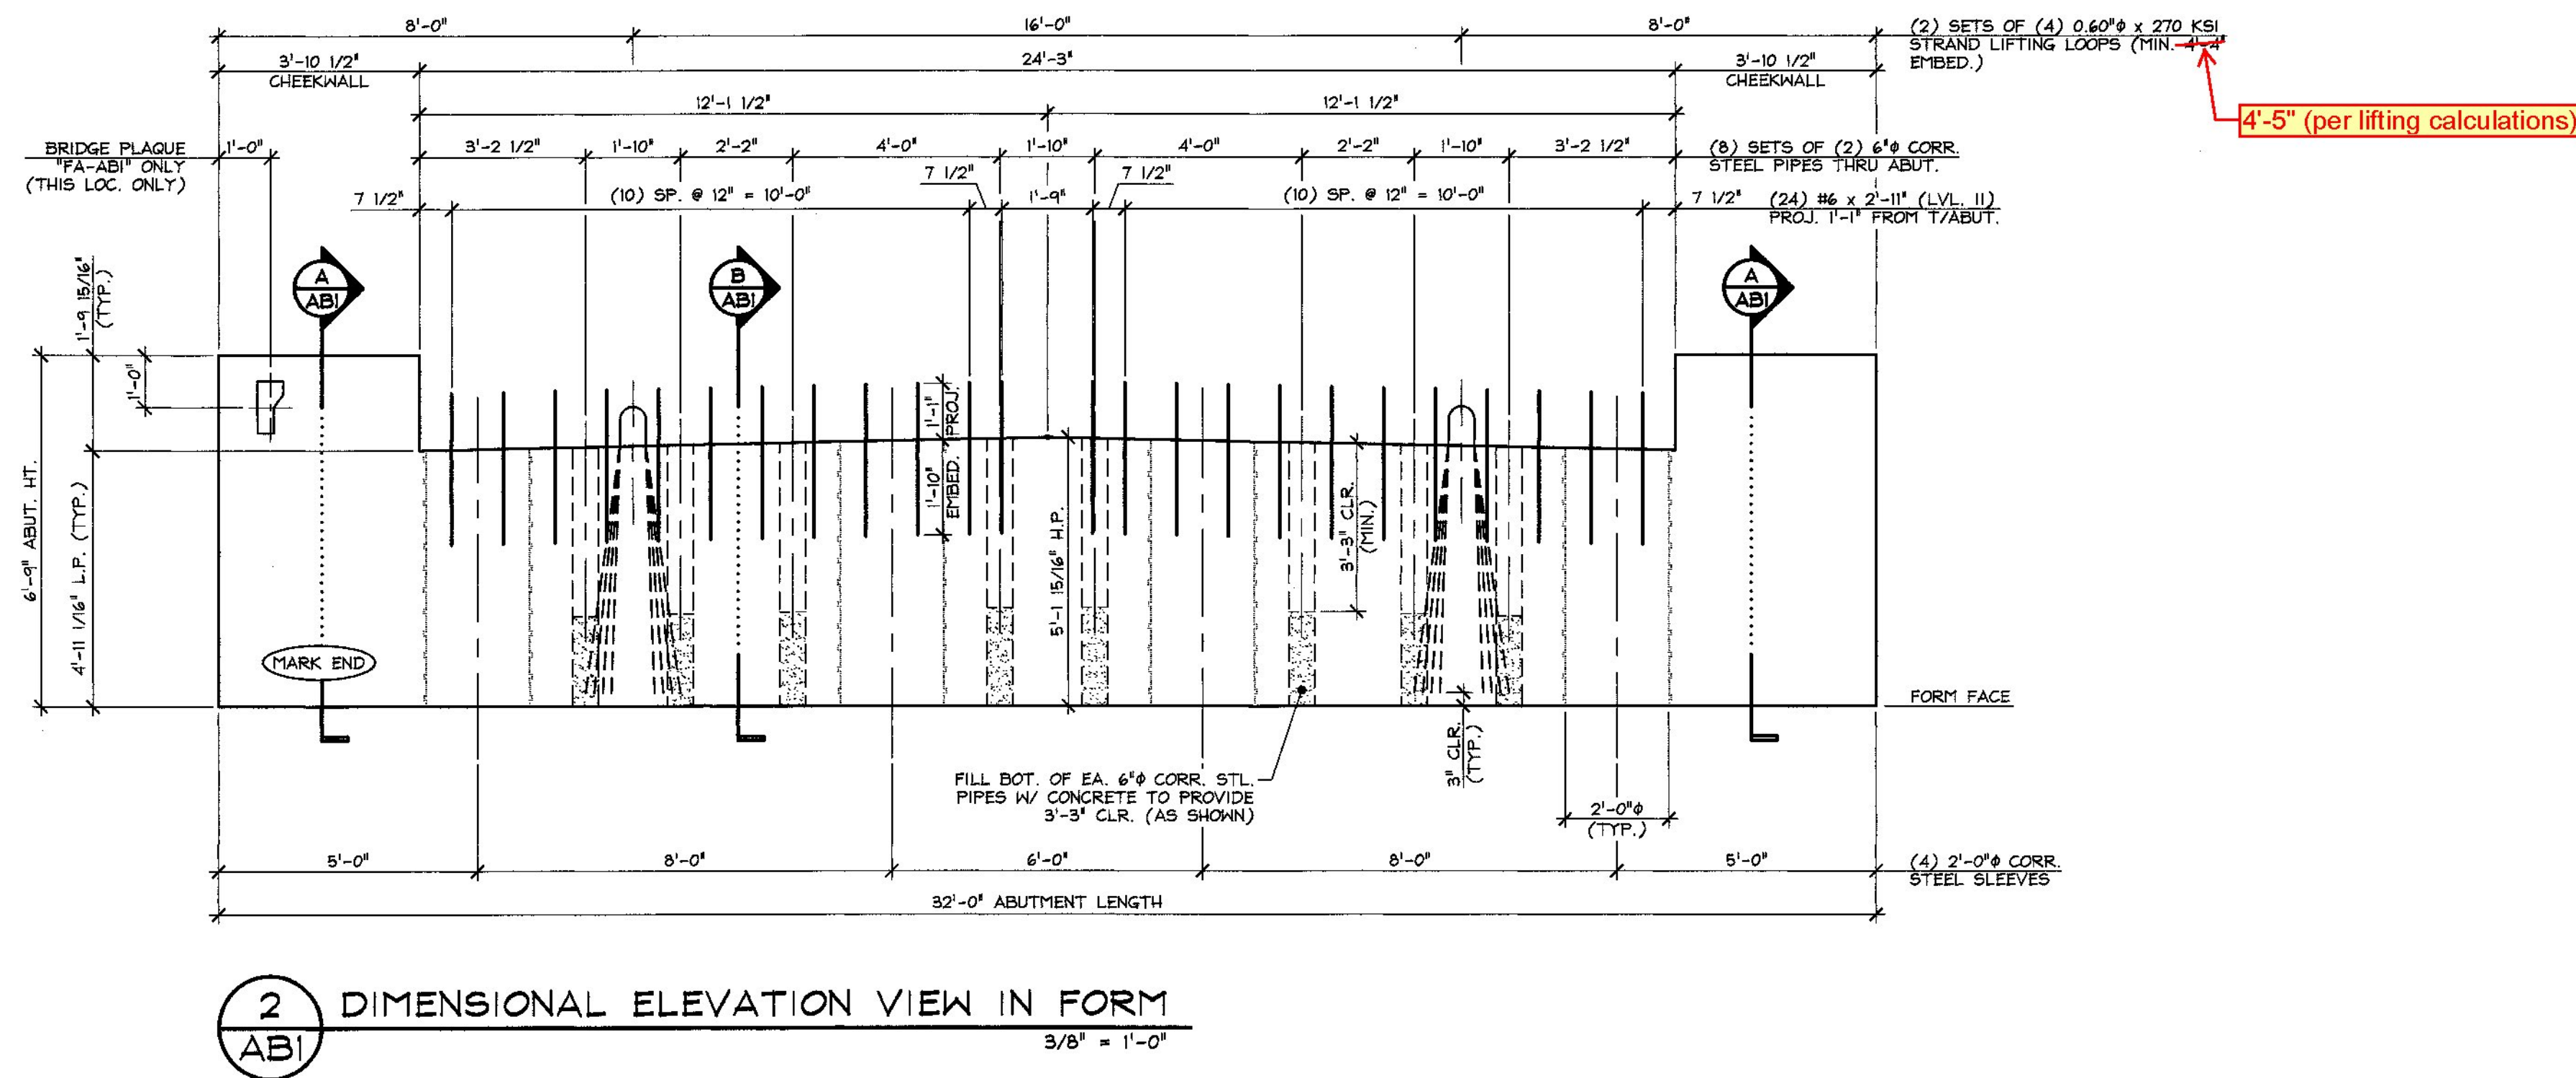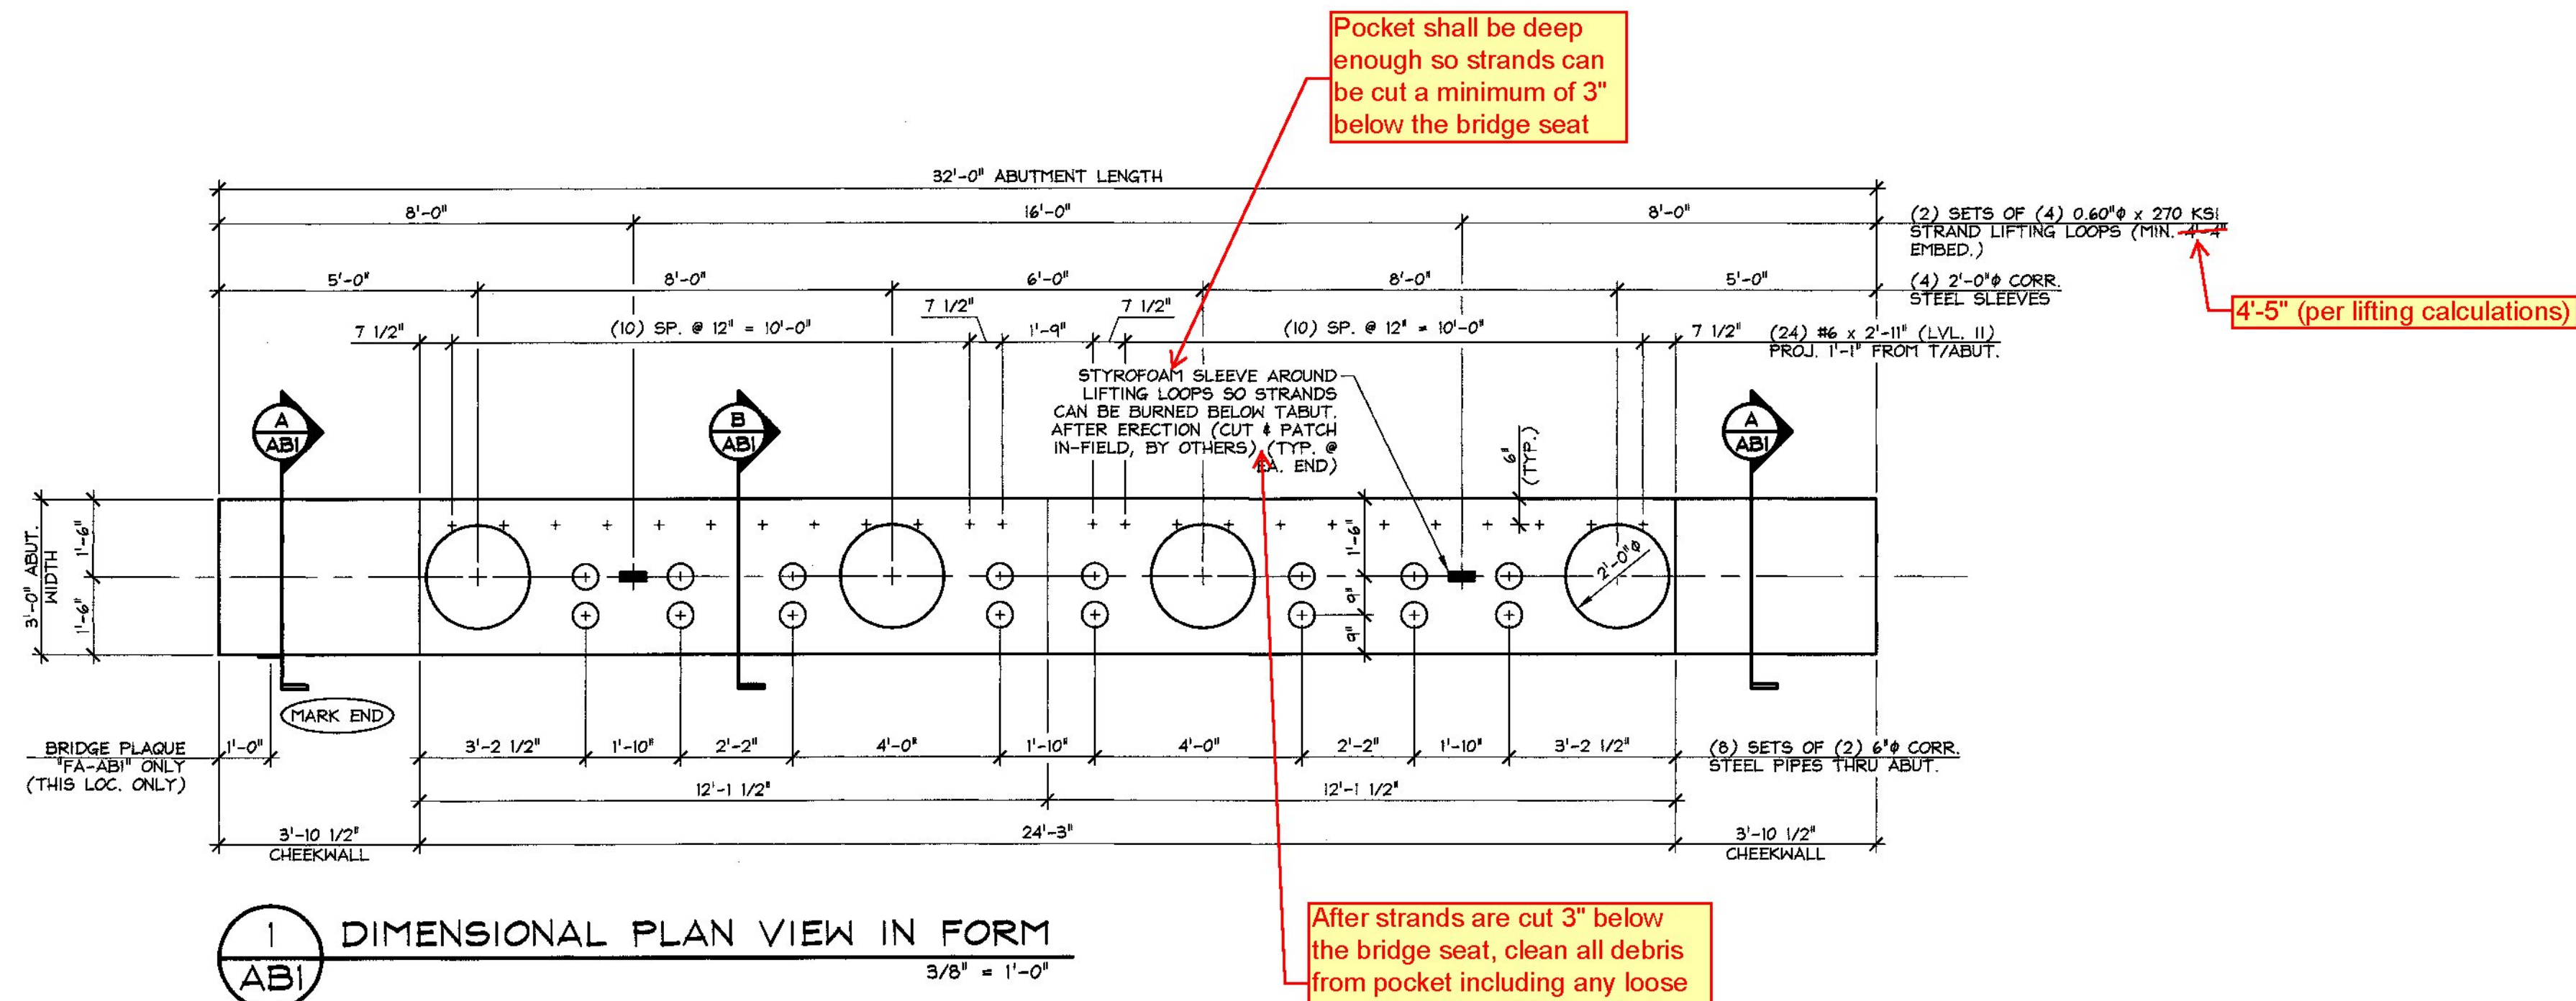


- △ DENOTES FORM FINISH
- △ DENOTES FLOAT FINISH
- △ DENOTES SMOOTH TROWEL FINISH


MARK: FA-AB1	QTY.: 1	WT.: 34.54 T	VOL.: 17.06 cy
MARK: FA-AB2	QTY.: 1	WT.: 34.54 T	VOL.: 17.06 cy
MATERIAL LIST / ABUTMENT			
ITEM	MARK	DESCRIPTION	QTY./ABUT.
1		#6 x 2'-11" (LVL. II, DUAL COATED)	24 24
2			
3			
4			
5			
6		BRIDGE PLAQUE (SUPPLIED BY OTHERS)	1
7		SET OF (4) 0.60" x 270 KSI STRAND LIFTING LOOPS	2 2
8		6" x 5'-1 3/4" (MAX.) CORRUGATED STEEL SLEEVE (GALV.)	16 16
9		2'-0" x 5'-1 1/2" CORRUGATED STEEL SLEEVE (GALV.)	4 4
10			

Vermont Agency of Transportation  
**RECEIVED**  
CK'D BY RK/JW OK'D BY RY  
February 12, 2015  
RESUBMIT No Approved AsNoted  
BY RY DATE 02/12/2015  
△ 2-10-15 REVISED PER VT AOT COMMENTS


APPROVAL STAMP:	<b>J.P. CARRARA &amp; SONS INC.</b> Precast & Prestress Manufacturer 244 ONE STR. MIDDLEBURY, VERMONT 05753 Phone: (802)388-6361 Fax: (802)388-8010	<b>A.L. ST. ONGE</b> CONTRACTOR MONTGOMERY, VERMONT
STATE OF VERMONT AGENCY OF TRANSPORTATION COUNTY OF FRANKLIN		DATE: NOV. 10, 2014
TOWN OF FAIRFIELD SOUTH ROAD, FAS 0281 (RURAL MAJOR COLLECTOR) BRIDGE NO.: 14 PROJECT NO.: BRF 0281(25)		SCALE: NOTED
PRECAST ABUTMENT DIMENSIONAL DETAILS		CHKD: B.C. DFTM: B.L. JOB NO: 23446-014
		DWG. NO: <b>ABI</b>

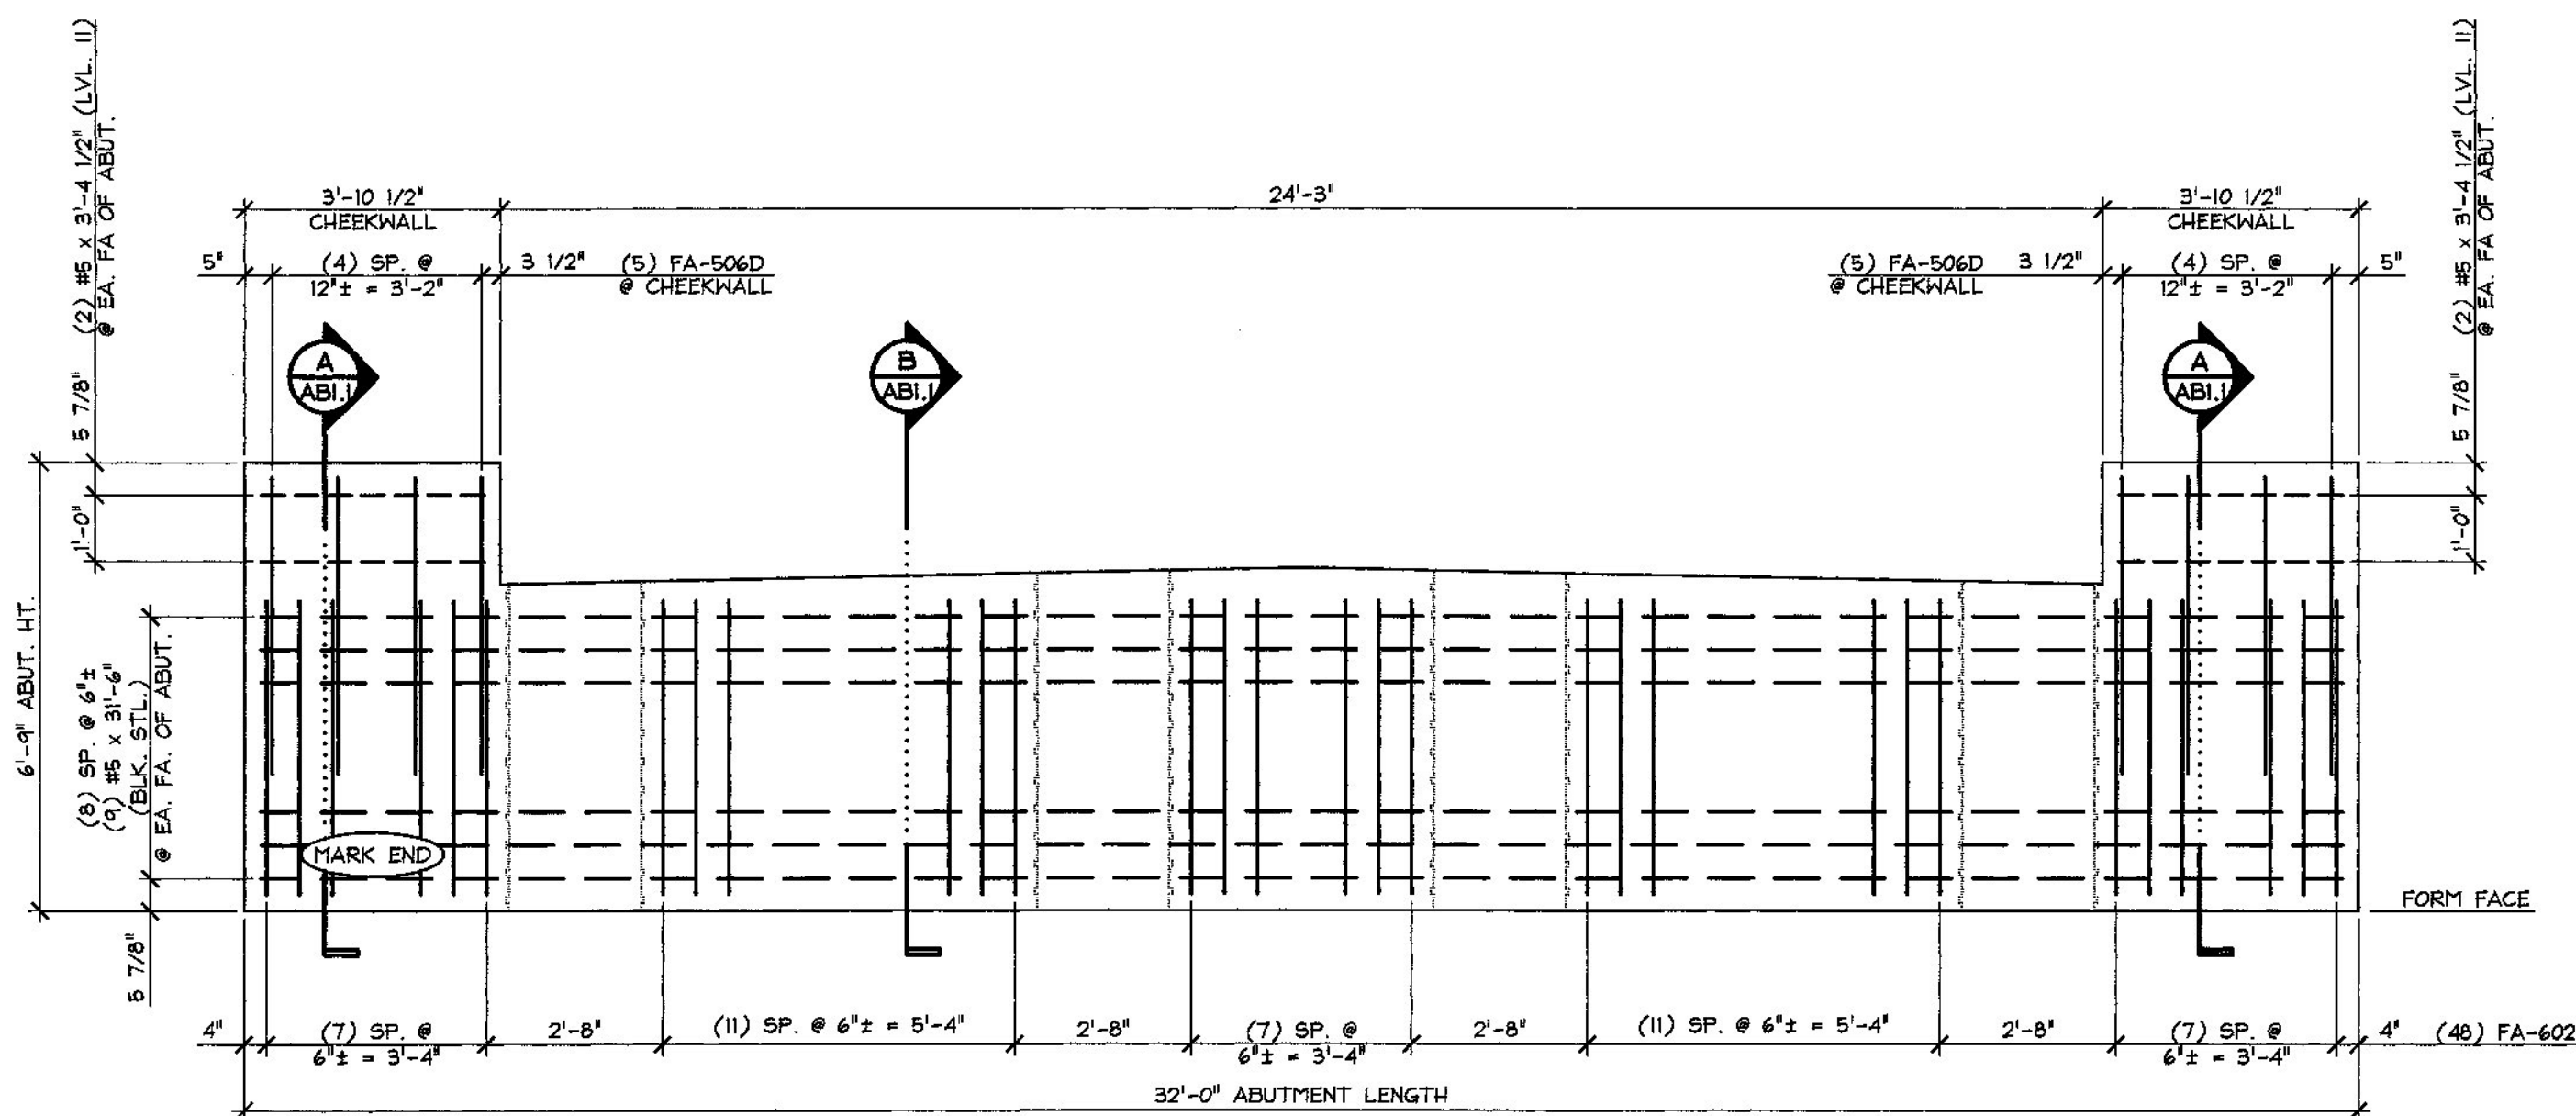

**1** REINFORCING ELEVATION VIEW IN FORM  
ABI.1 3/8" = 1'-0"

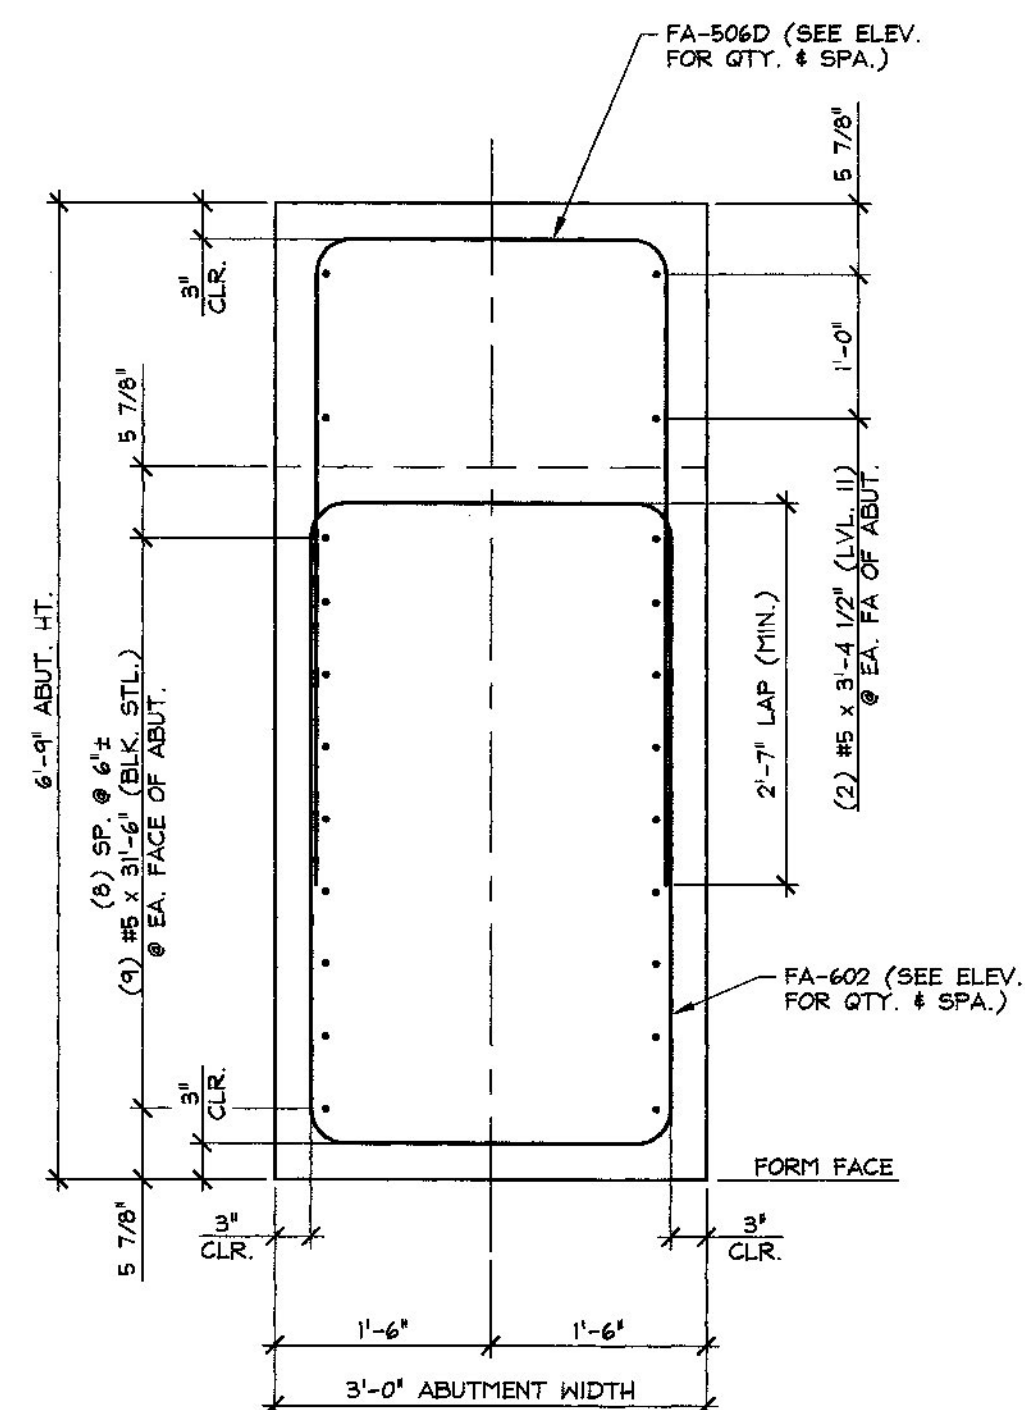

**A** ABUTMENT SECTION  
ABI.1 3/4" = 1'-0"

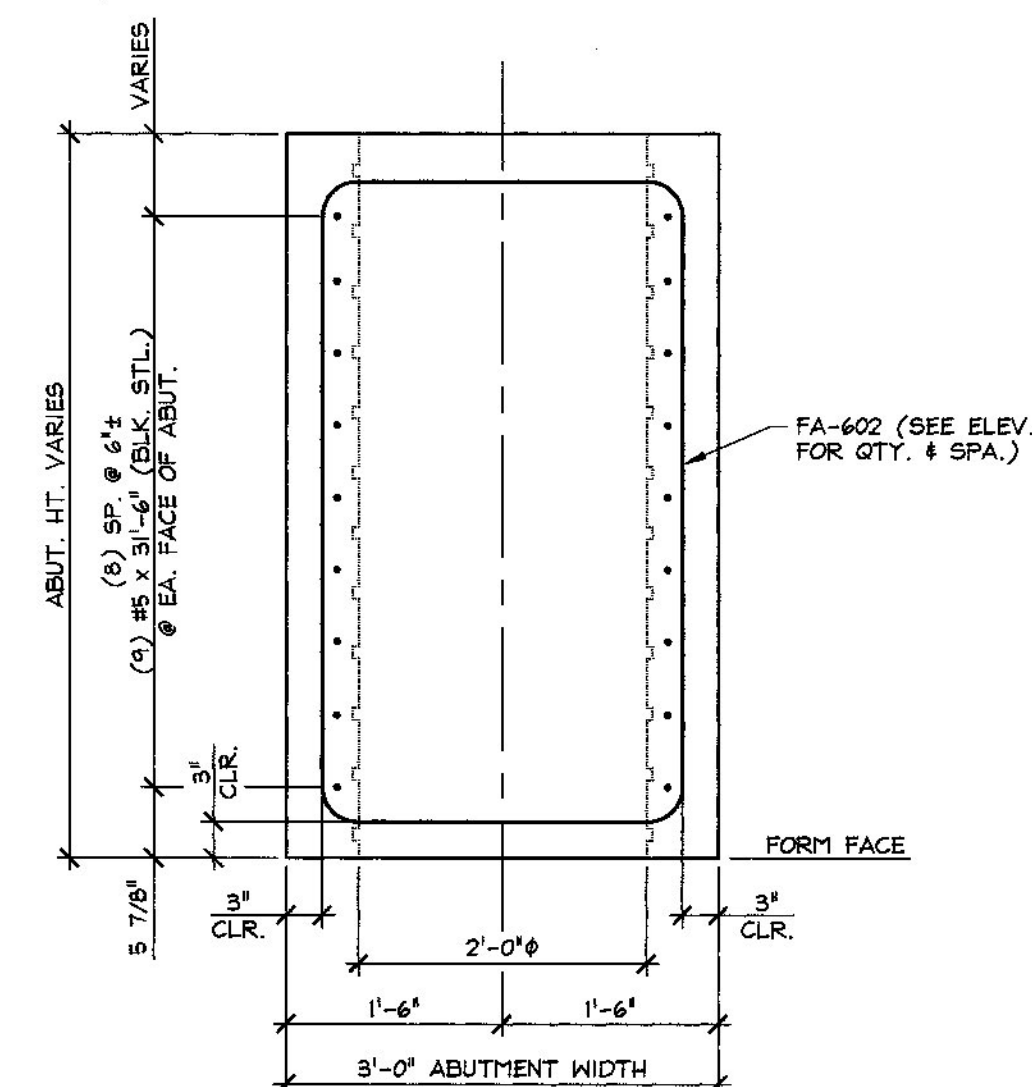

**B** ABUTMENT SECTION  
ABI.1 3/4" = 1'-0"

Vermont Agency of Transportation  
**RECEIVED**

CK'D BY RK/JW OK'D BY RY

February 12, 2015


RESUBMIT No Approved  
BY RY DATE 02/12/2015

2-10-15 REVISED PER VT AOT COMMENTS


MARK: FA-AB1	QTY.: 1
MARK: FA-AB2	QTY.: 1

MATERIAL LIST / ABUTMENT			
ITEM	MARK	DESCRIPTION	QTY.
1		#5 x 3'-6" (LEVEL I, BLACK STEEL)	18
2		#5 x 3'-4 1/2" (LEVEL II, DUAL COATED)	8
3			
4	FA-506D	#5 BENT BAR (LEVEL II, DUAL COATED)	10
5			
6	FA-602	#6 BENT BAR (LEVEL I, BLACK STEEL)	48
7			
8			
9			
10			


APPROVAL STAMP:	<b>J.P. CARRARA &amp; SONS INC.</b> Precast & Prestress Manufacturer 2464 CREEK STR., MIDDLEBURY, VERMONT 05753 Phone:(802)388-6361 Fax:(802)388-9010		A.L. ST. ONGE CONTRACTOR MONTMERY, VERMONT	
	STATE OF VERMONT AGENCY OF TRANSPORTATION COUNTY OF FRANKLIN		DATE: NOV. 10, 2014 SCALE: NOTED	
	TOWN OF FAIRFIELD SOUTH ROAD, FAS 0281 (RURAL MAJOR COLLECTOR) BRIDGE NO.: 14 PROJECT NO.: BRF 0281(25)		CHKD: B.C. DFTM: B.L. JOB NO: 23446-014	
	PRECAST ABUTMENT REINFORCING DETAILS		DWG. NO: AB1.1	

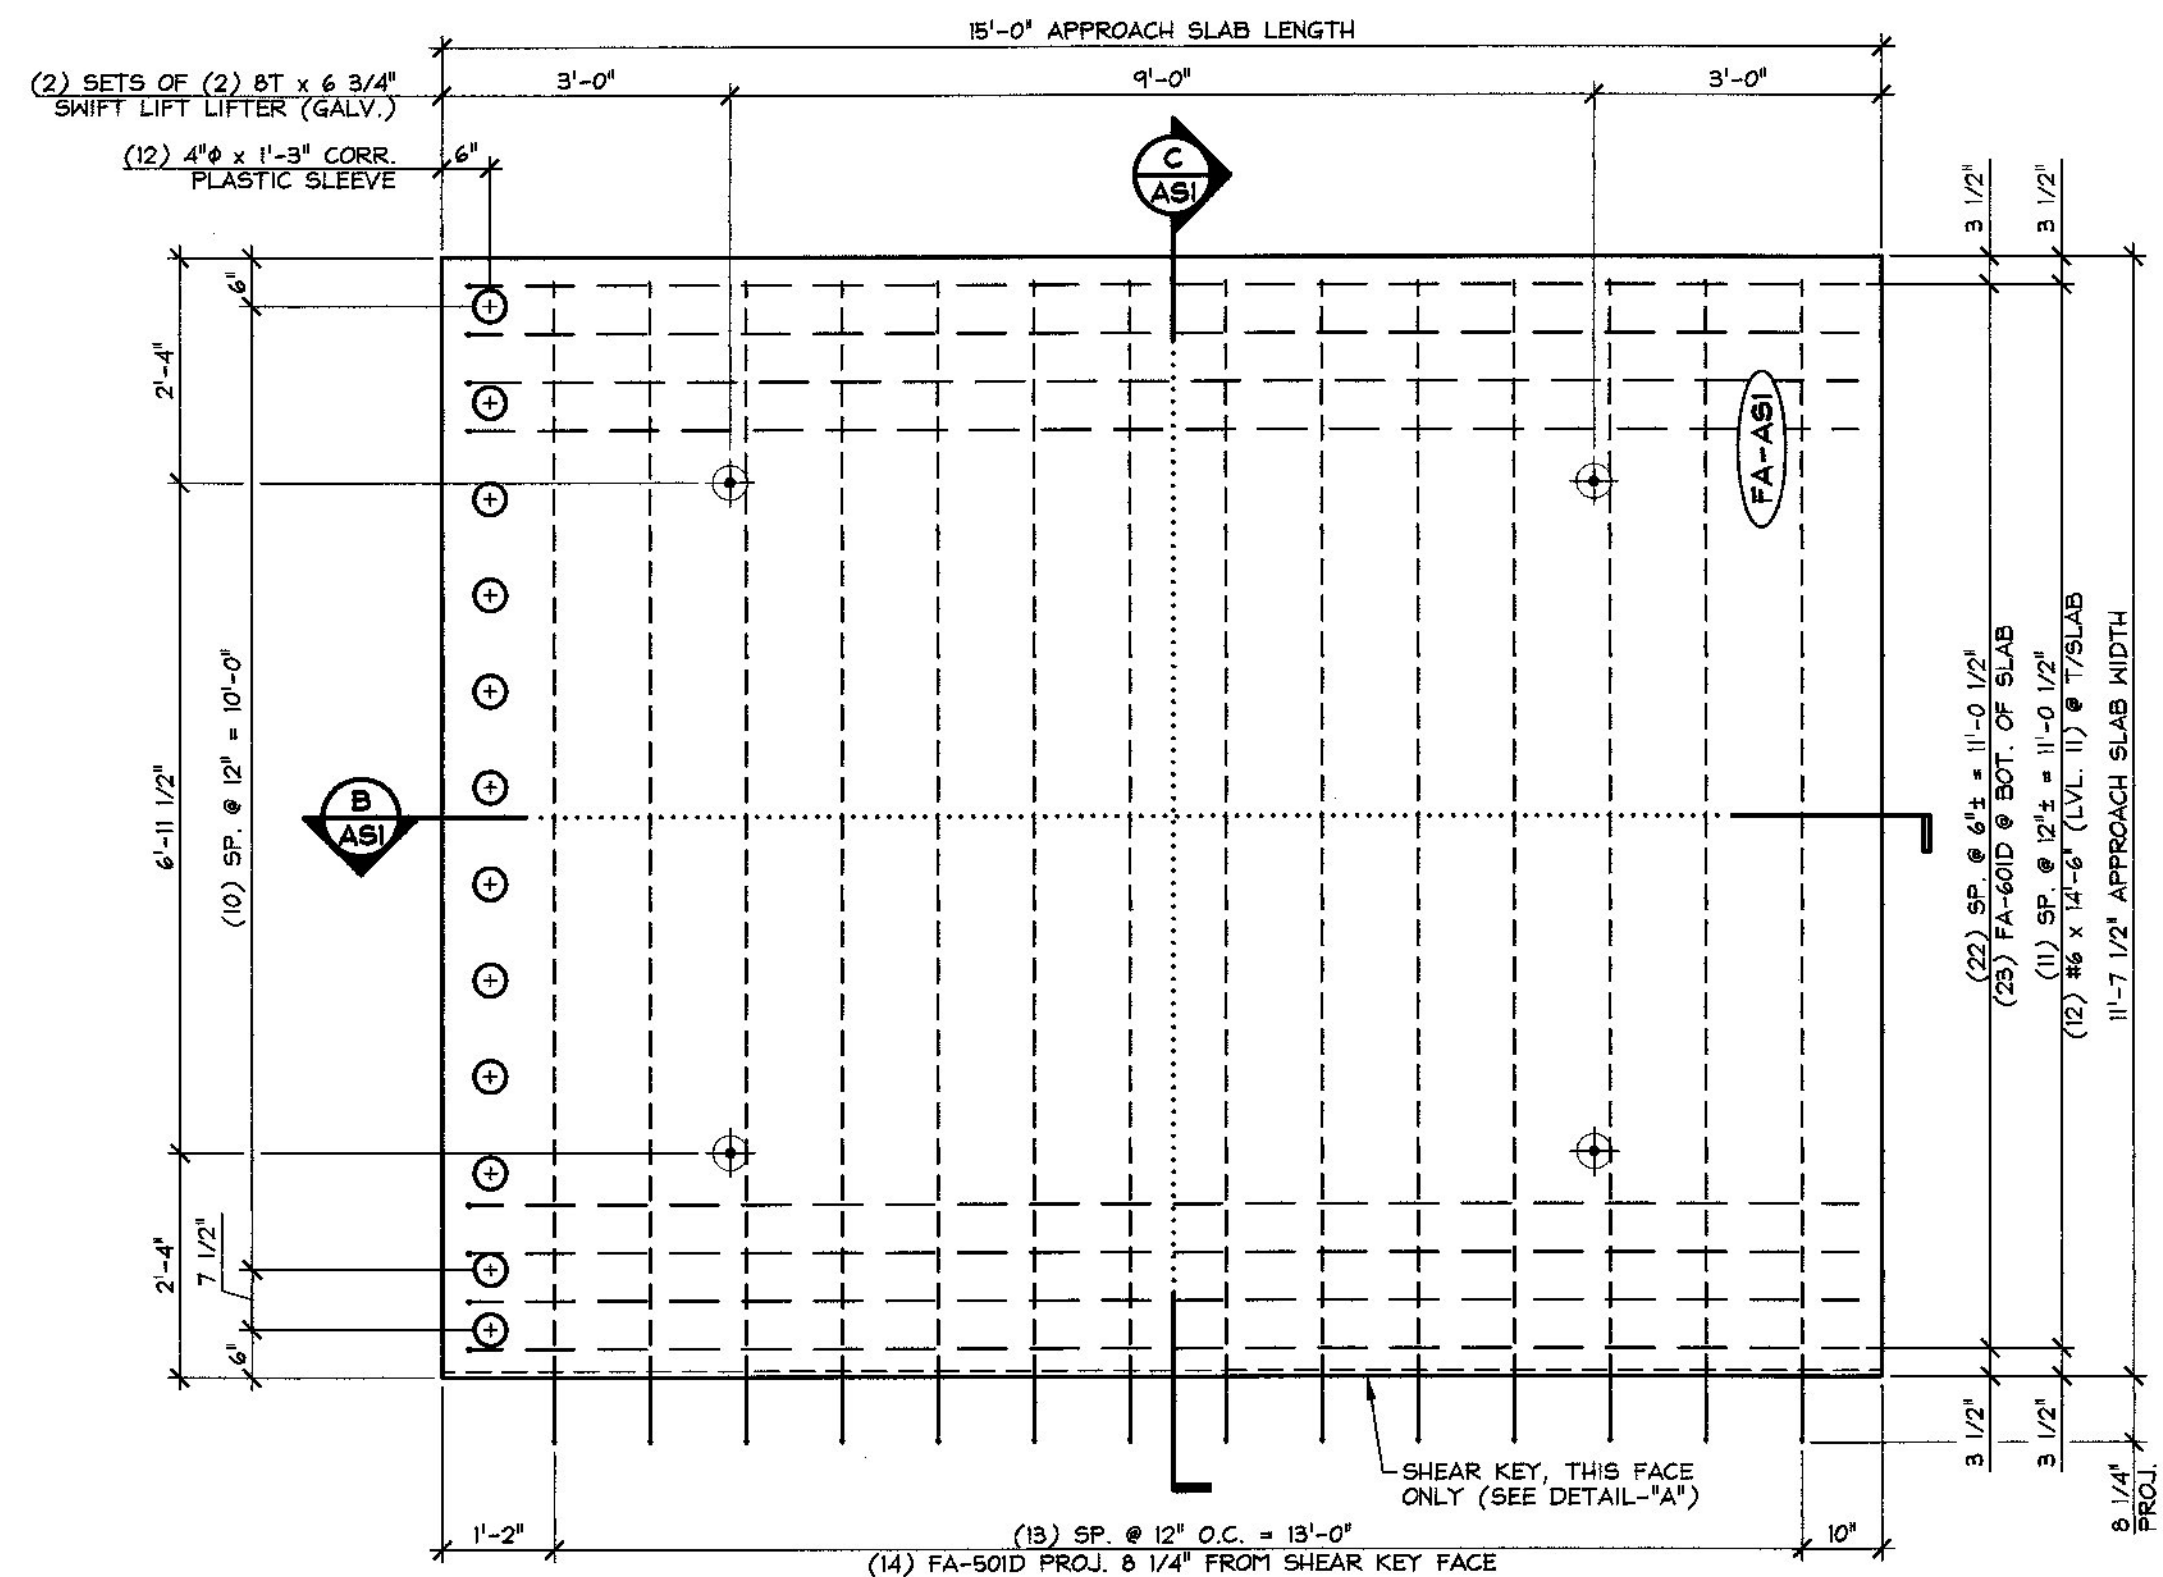


1 DIMENSIONAL PLAN VIEW IN FORM  
ASI  
1/2" = 1'-0"

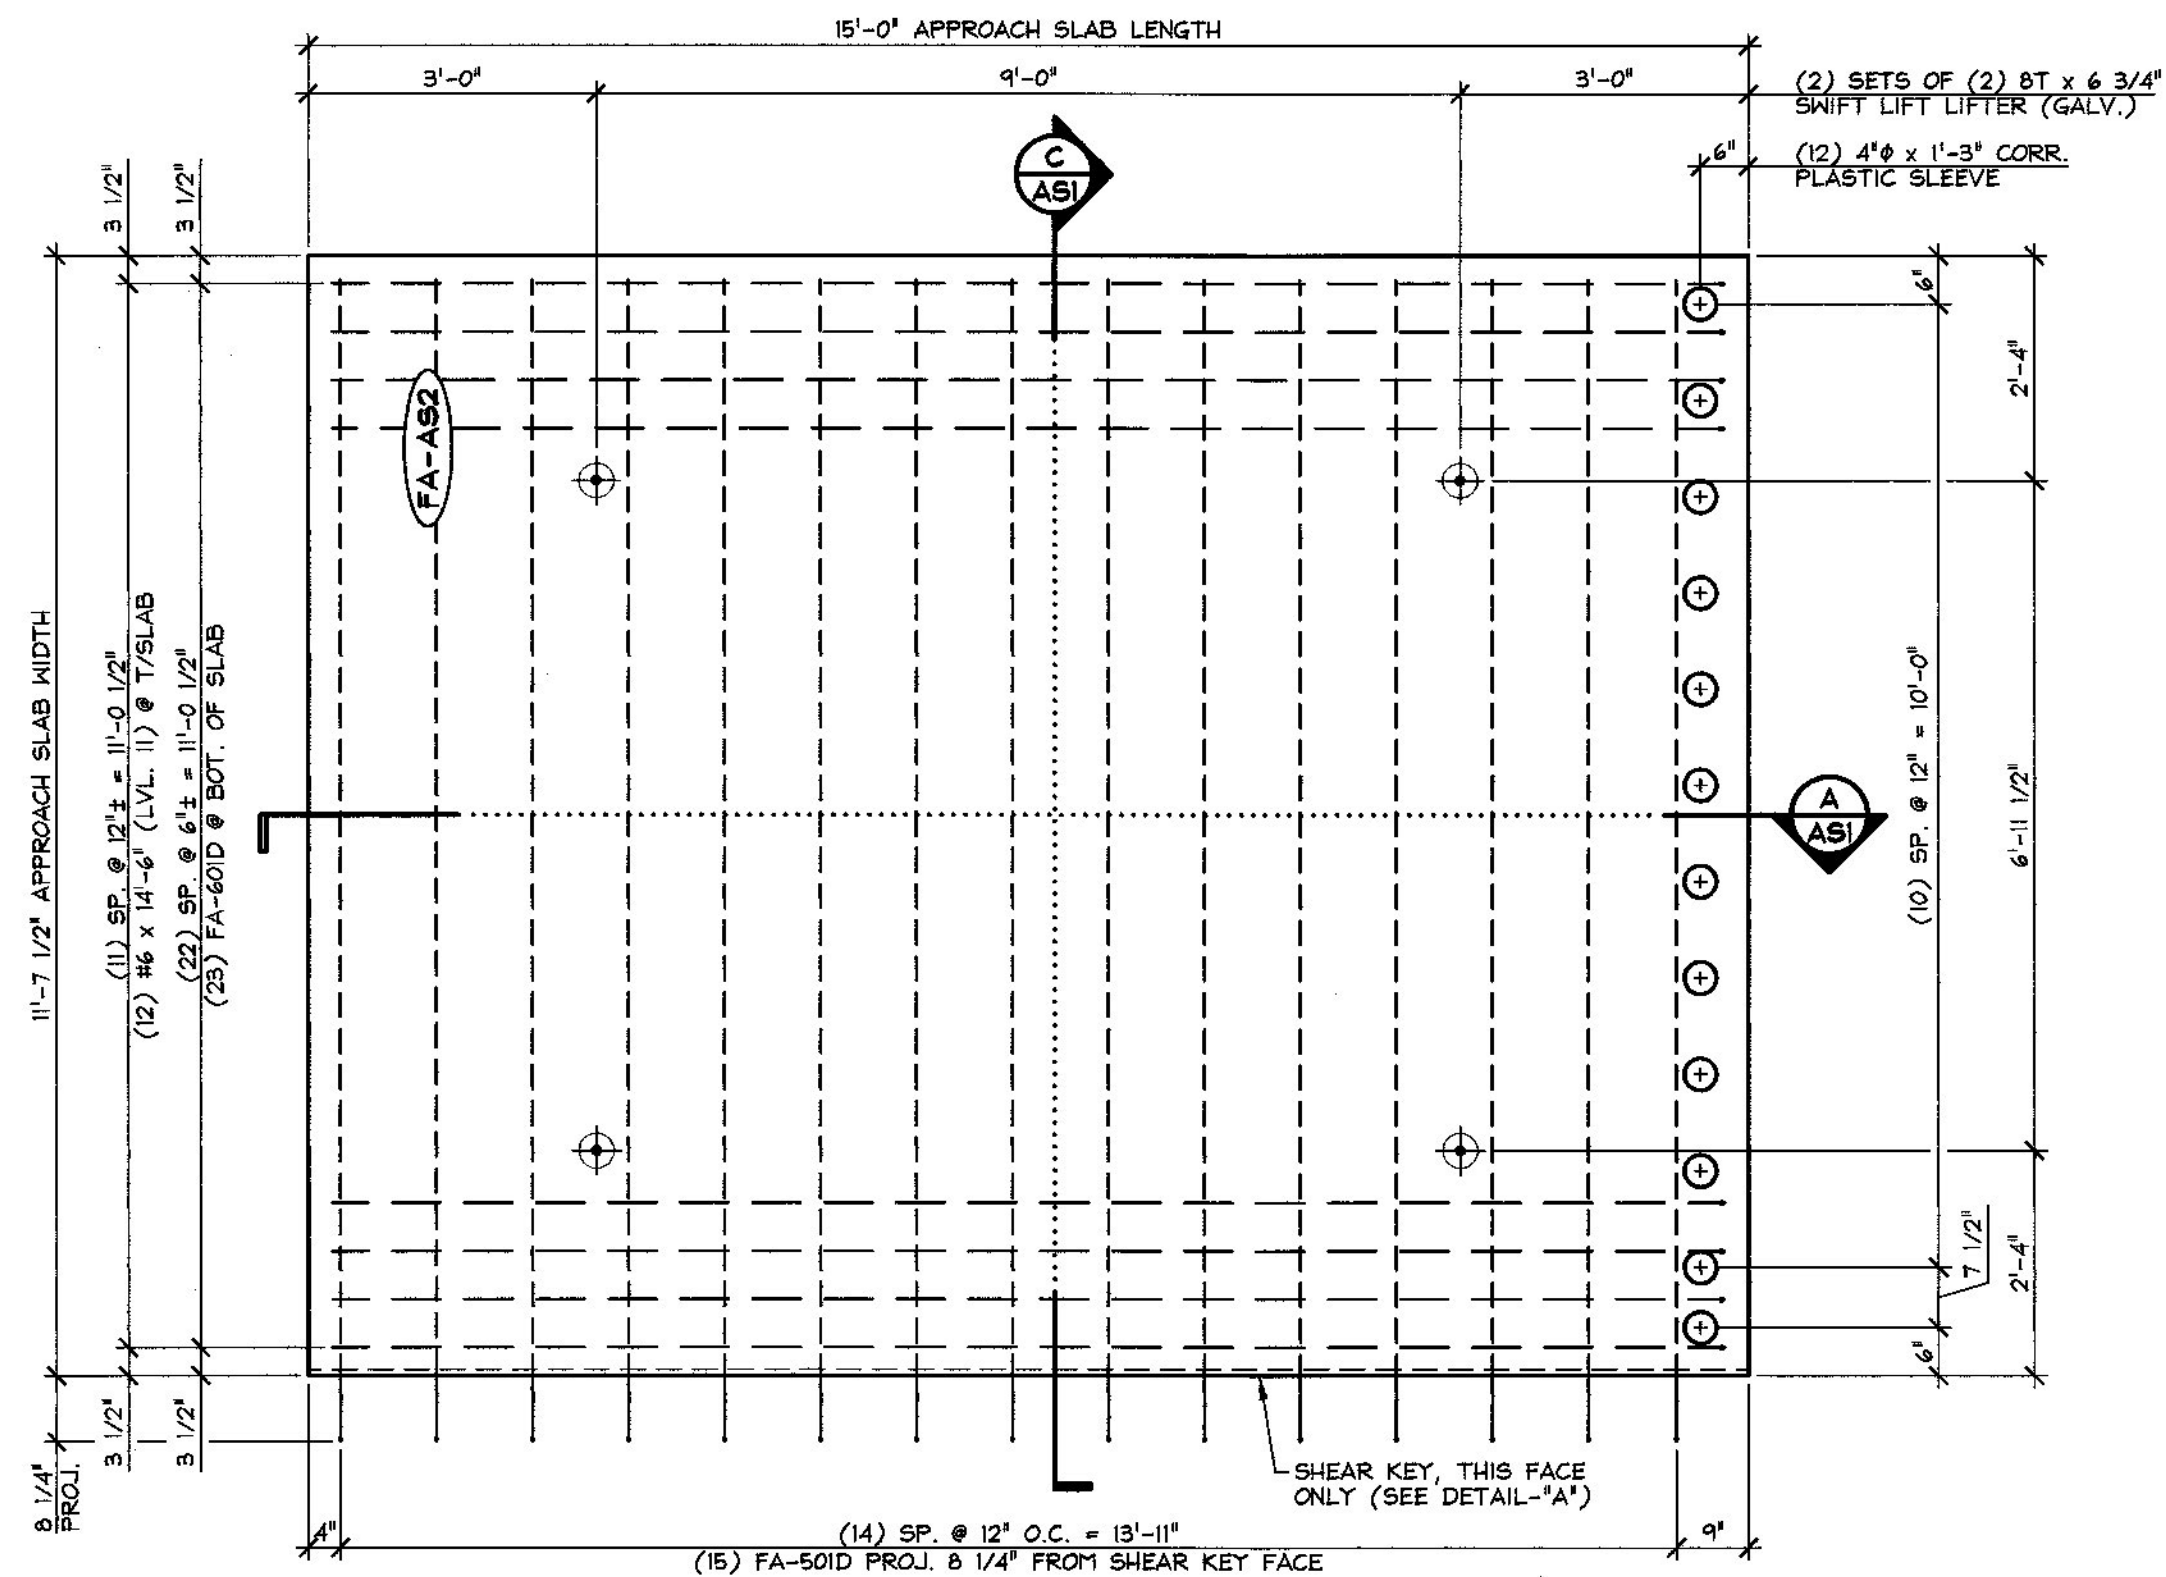


2 DIMENSIONAL PLAN VIEW IN FORM  
ASI  
1/2" = 1'-0"

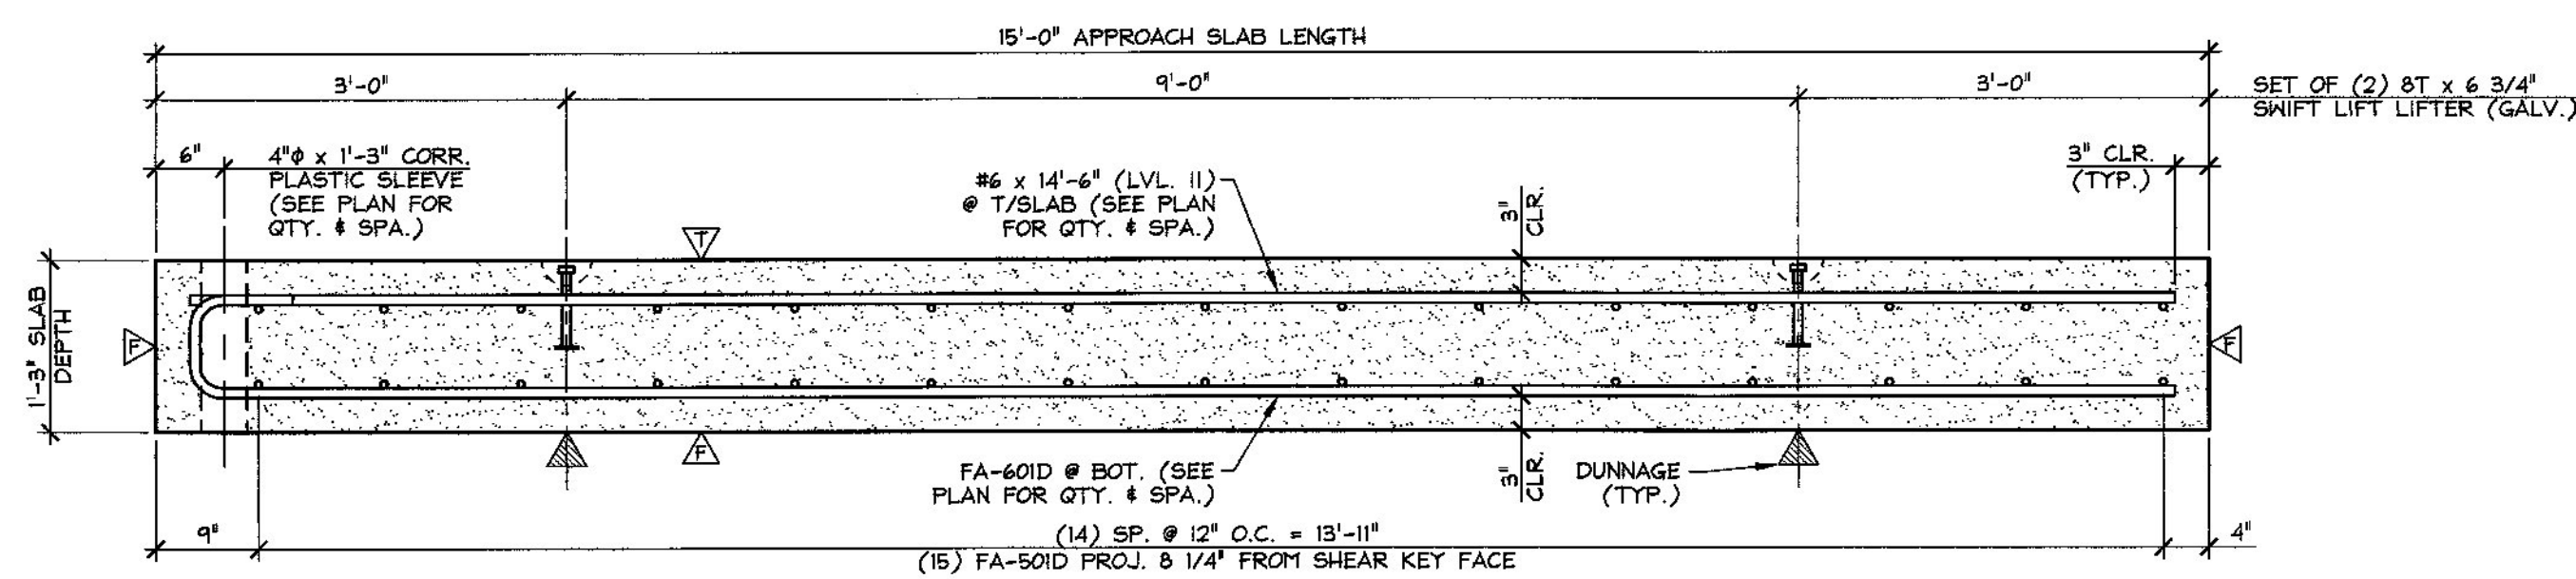


A LONGITUDINAL SECTION  
ASI  
3/4" = 1'-0"

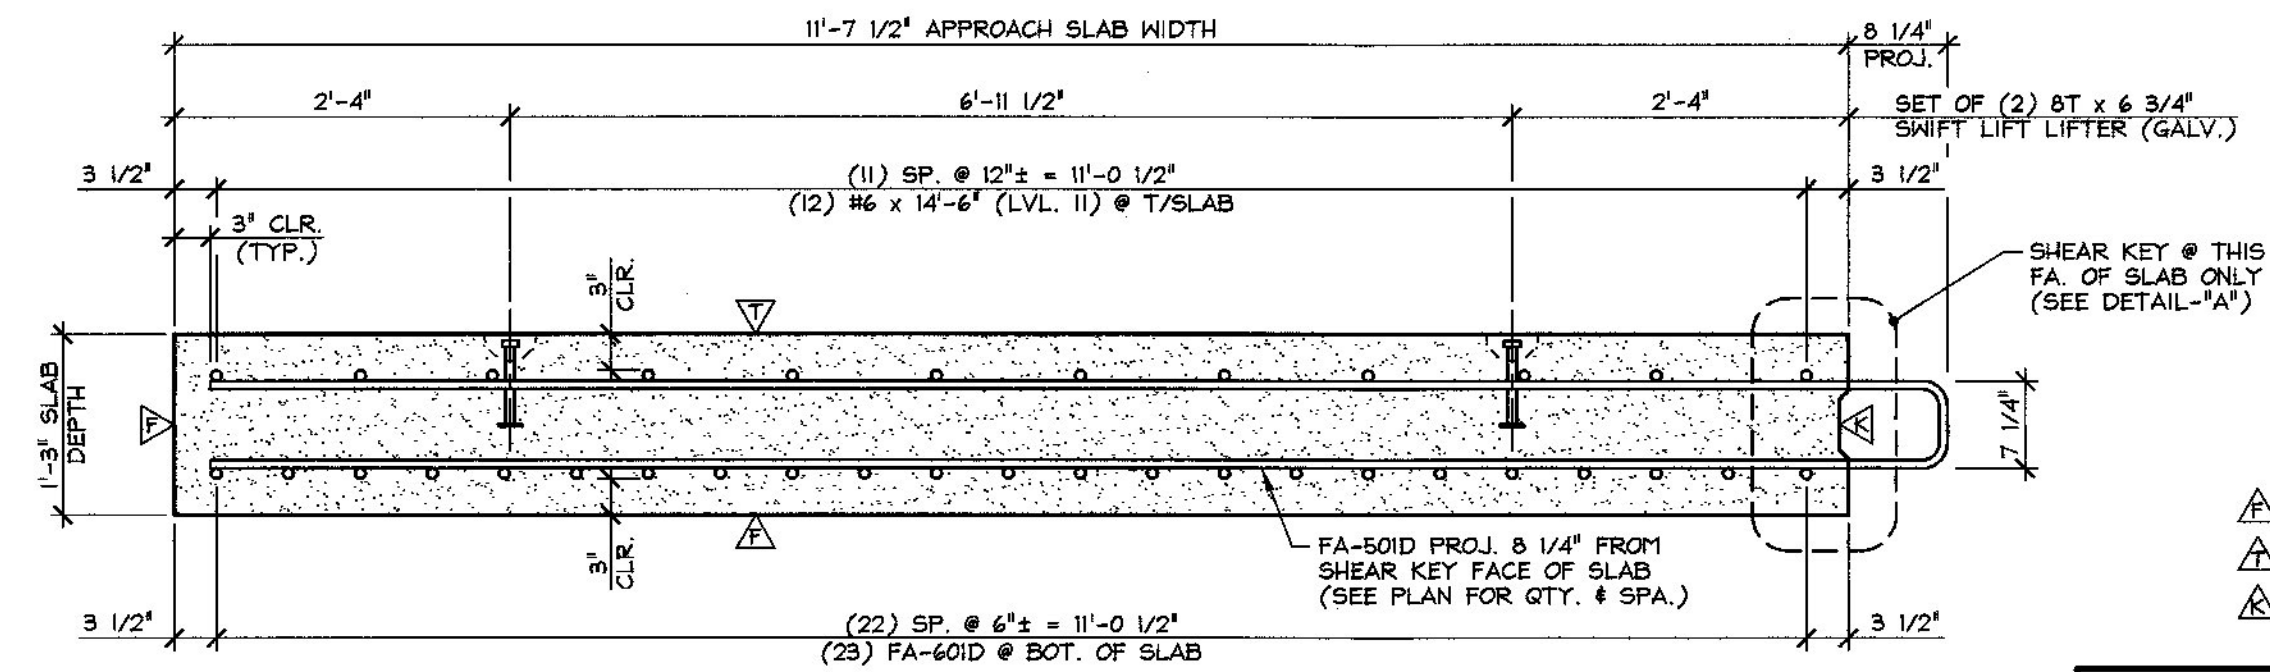

C TRANSVERSE SECTION  
ASI  
3/4" = 1'-0"

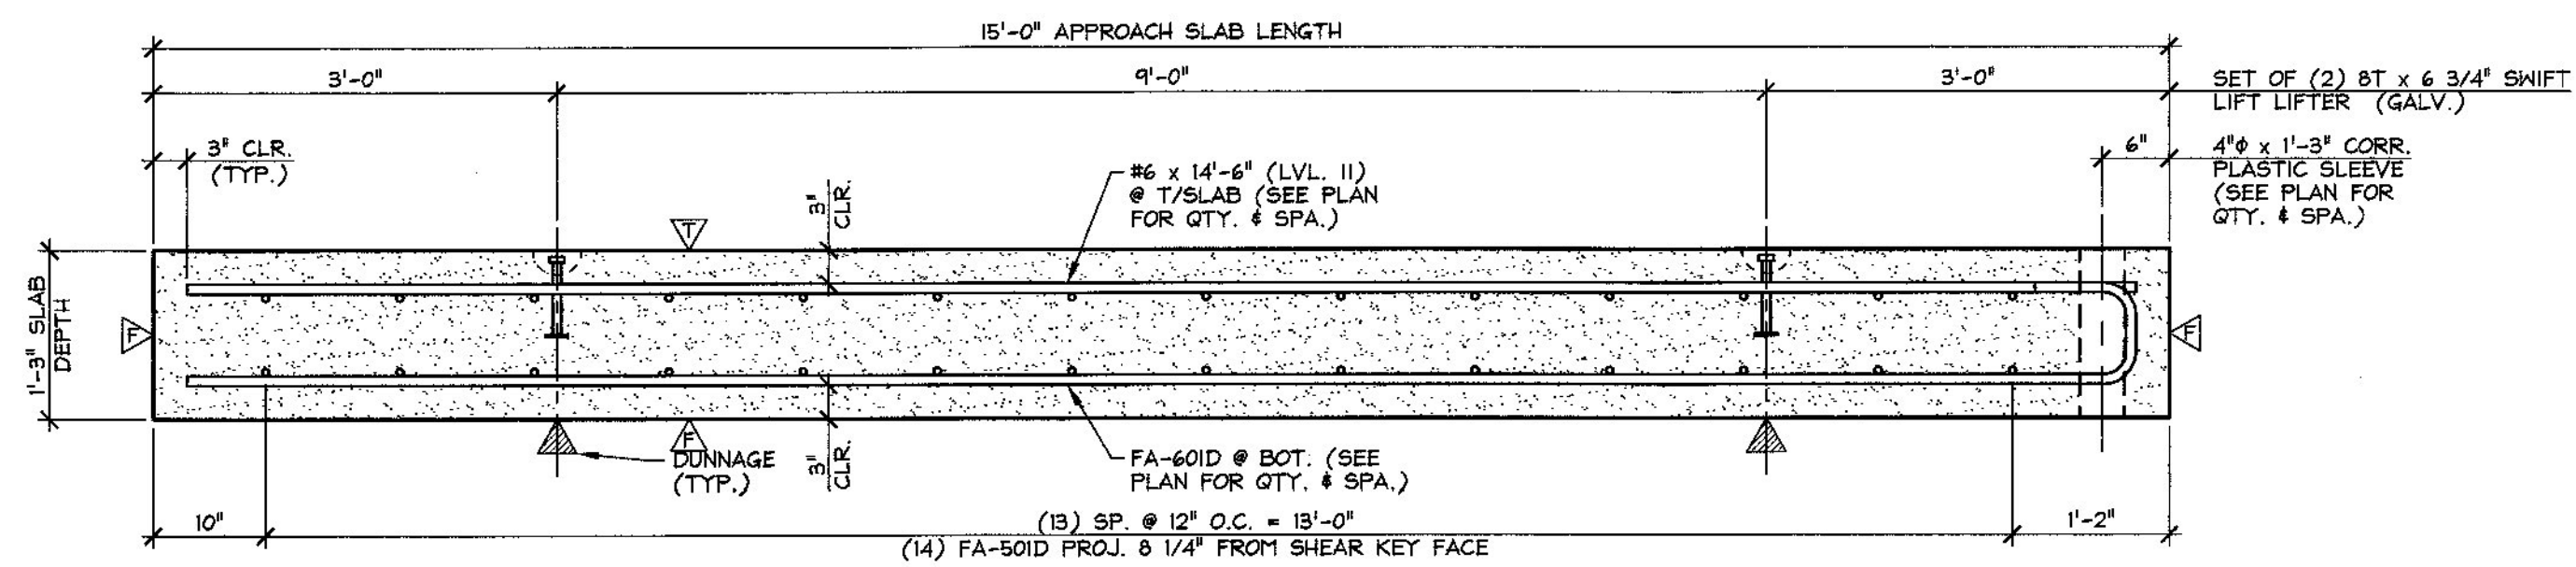

B LONGITUDINAL SECTION  
ASI  
3/4" = 1'-0"

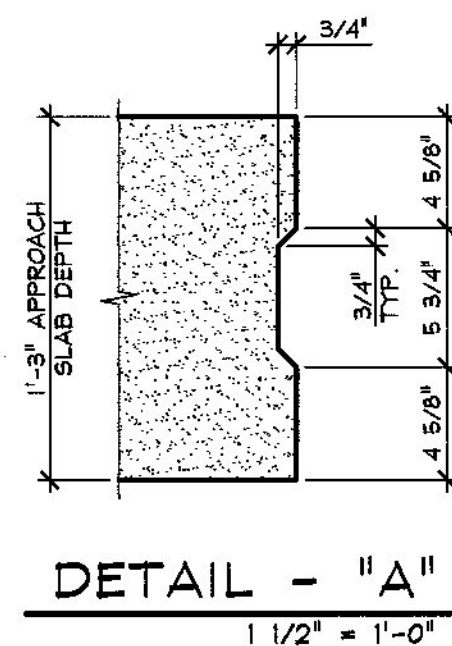

DETAIL - "A"  
1 1/2" = 1'-0"

Vermont Agency of Transportation  
**RECEIVED**

CK'D BY RK/JW OK'D BY RY

February 12, 2015

RESUBMIT No Approved  
BY RY DATE 02/12/2015

- △ DENOTES FORM FINISH
- △ DENOTES FLOAT FINISH
- △ DENOTES ROUGHENED FINISH

MARK: FA-AS1	QTY.: 2	WT.: 16.32 T	VOL.: 8.06 cy
MARK: FA-AS2	QTY.: 2	WT.: 16.32 T	VOL.: 8.06 cy

MATERIAL LIST / APPROACH SLAB				
ITEM	MARK	DESCRIPTION	QTY./SLAB	
			AS1	AS2
1	FA-501D	#5 BENT BAR (LEVEL II, DUAL COATED)	14	15
2				
3	FA-601D	#6 BENT BAR (LEVEL II, DUAL COATED)	23	23
4		#6 x 14'-6" (LEVEL II, DUAL COATED)	12	12
5				
6				
7				
8		4" x 1'-3" CORRUGATED PLASTIC SLEEVE	12	12
9		8T x 6 3/4" SWIFT LIFT LIFTER (GALV.)	4	4
10				

2-10-15 REVISED PER VT AOT COMMENTS

APPROVAL STAMP:

**J.P. CARRARA & SONS INC.**  
Precast & Prestress Manufacturer  
2464 OISE STR., MIDDLEBURY, VERMONT 05753 Phone: (802)388-0361 Fax: (802)388-8010

A.L. ST. ONGE  
CONTRACTOR  
MONTMERY, VERMONT

STATE OF VERMONT AGENCY OF TRANSPORTATION  
COUNTY OF FRANKLIN

DATE: NOV. 10, 2014

SCALE: NOTED






TOWN OF FAIRFIELD  
SOUTH ROAD, FAS 0281 (RURAL MAJOR COLLECTOR)  
BRIDGE NO.: 14 PROJECT NO.: BRF 0281(25)

CHKD: B.C. DFTM: B.L.

JOB NO: 23446-014




PRECAST APPROACH SLAB DETAILS

DWG. NO: ASI

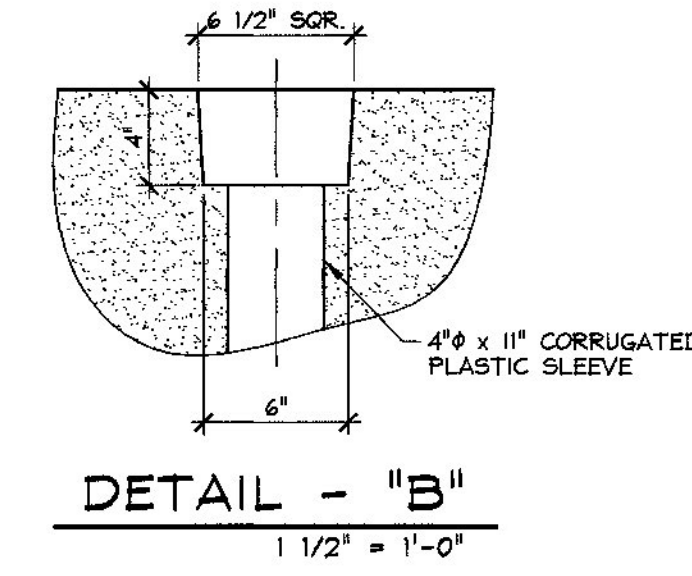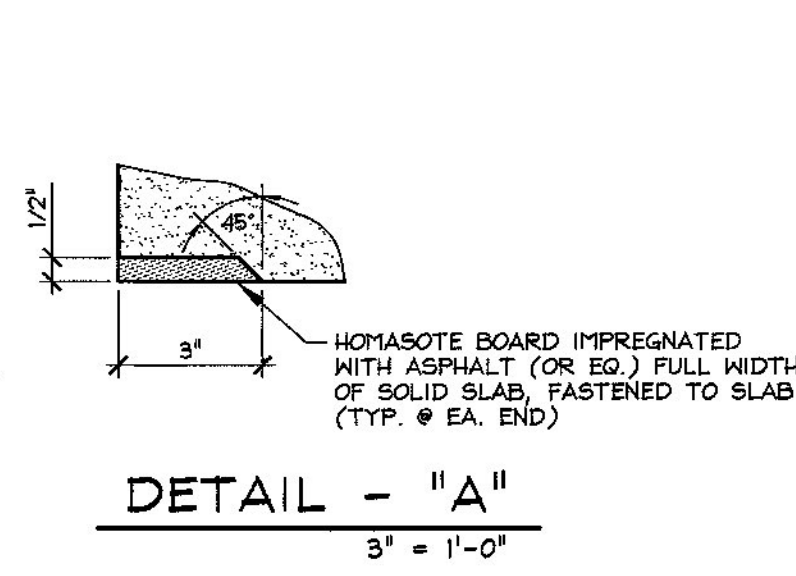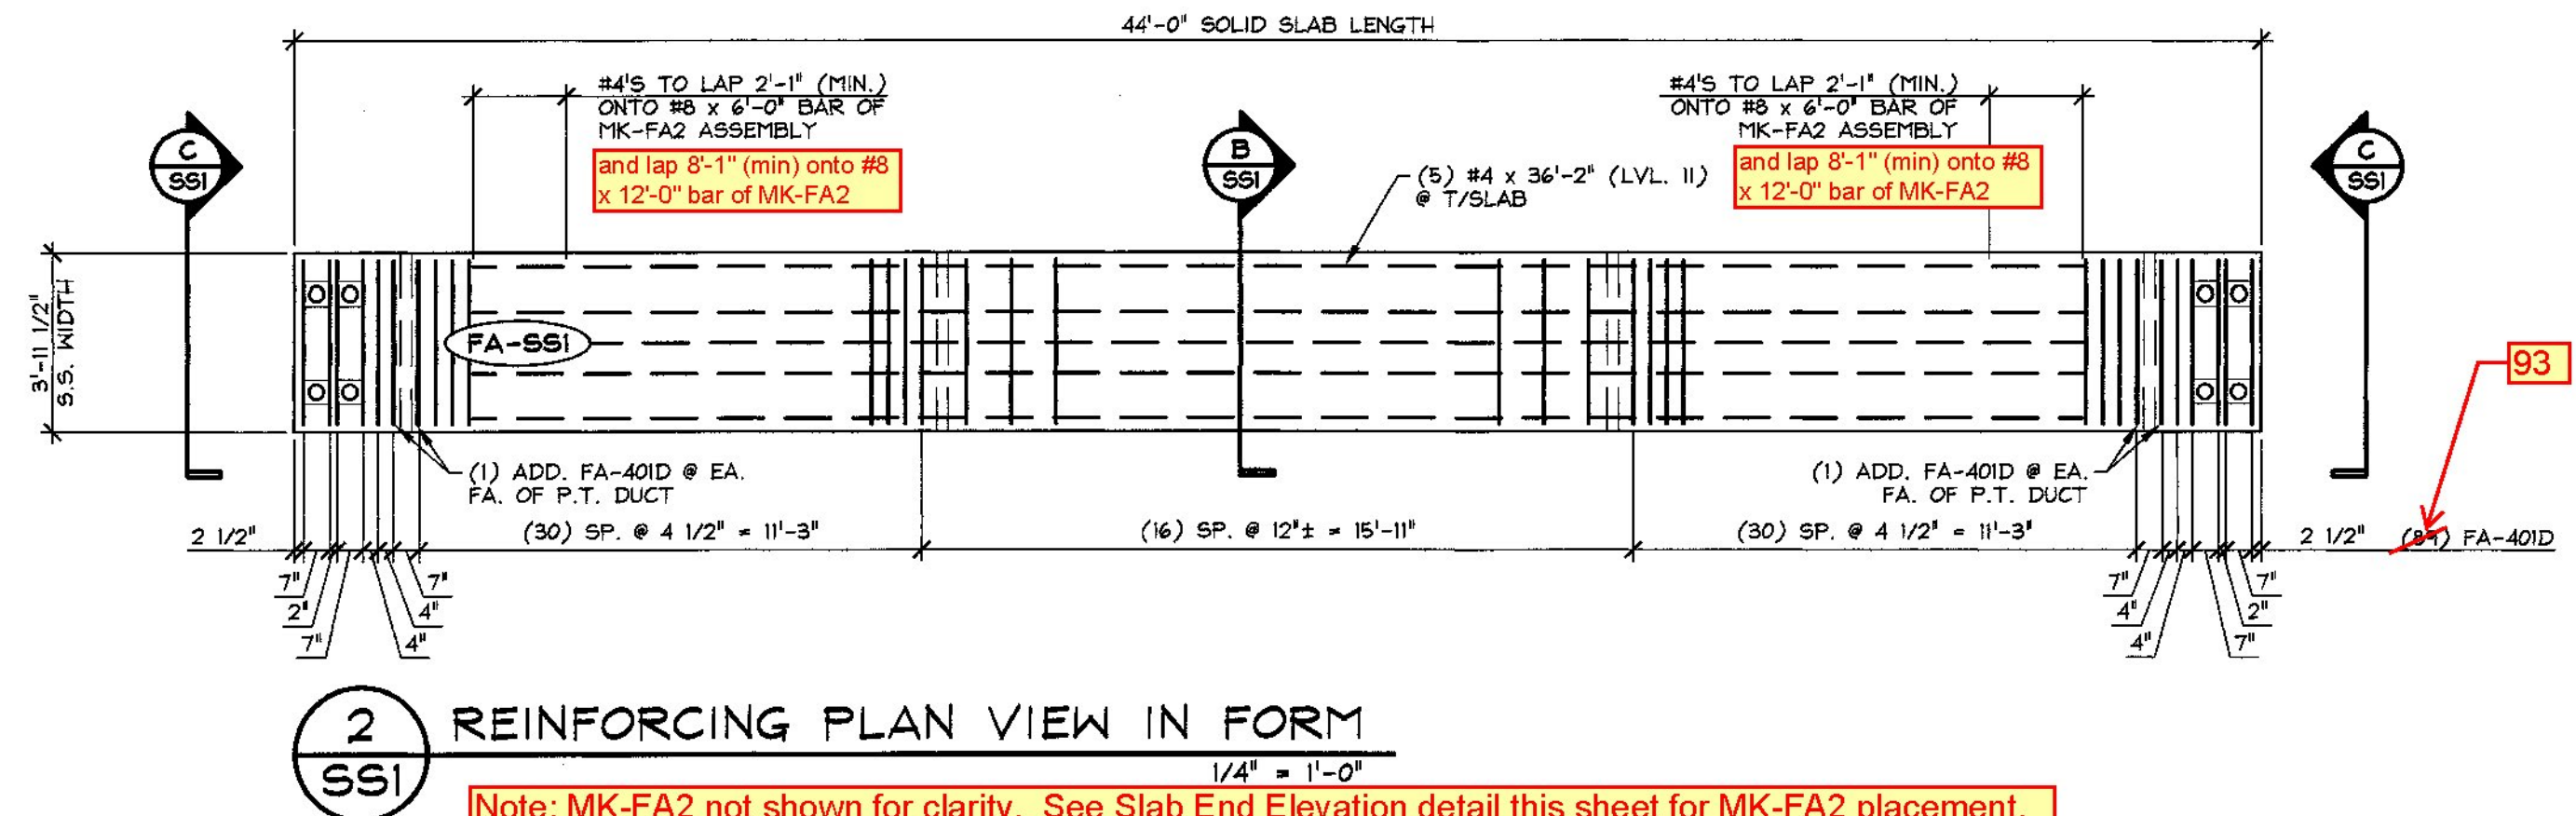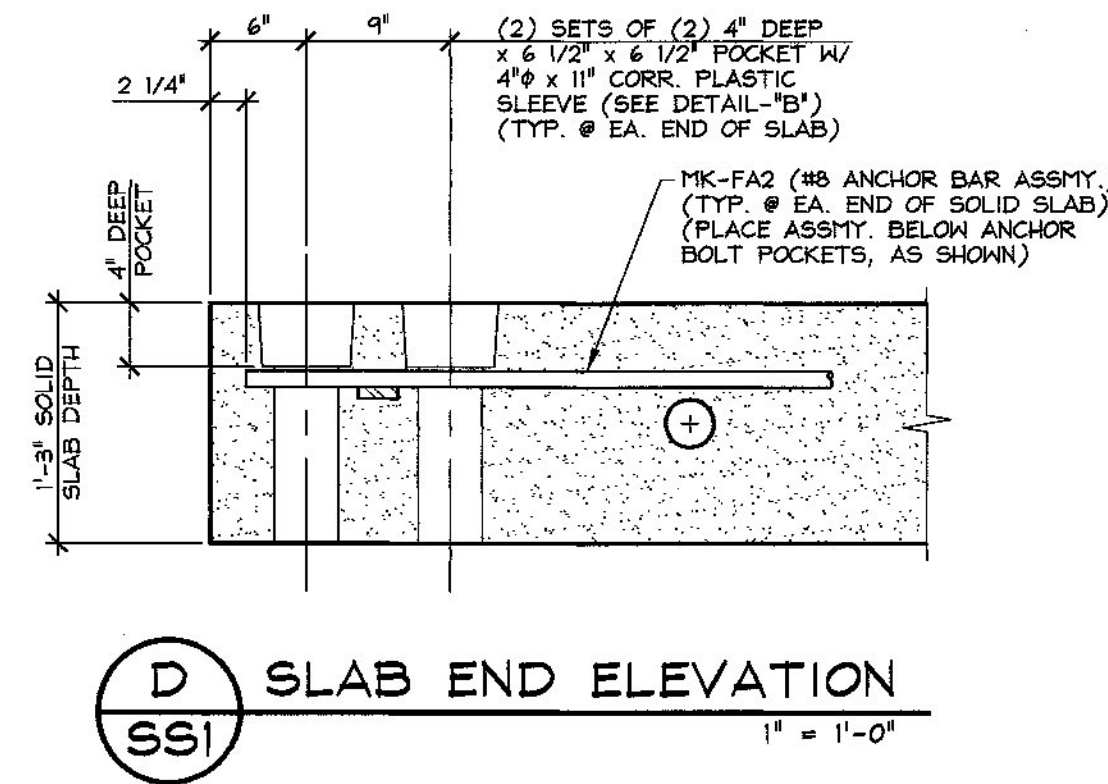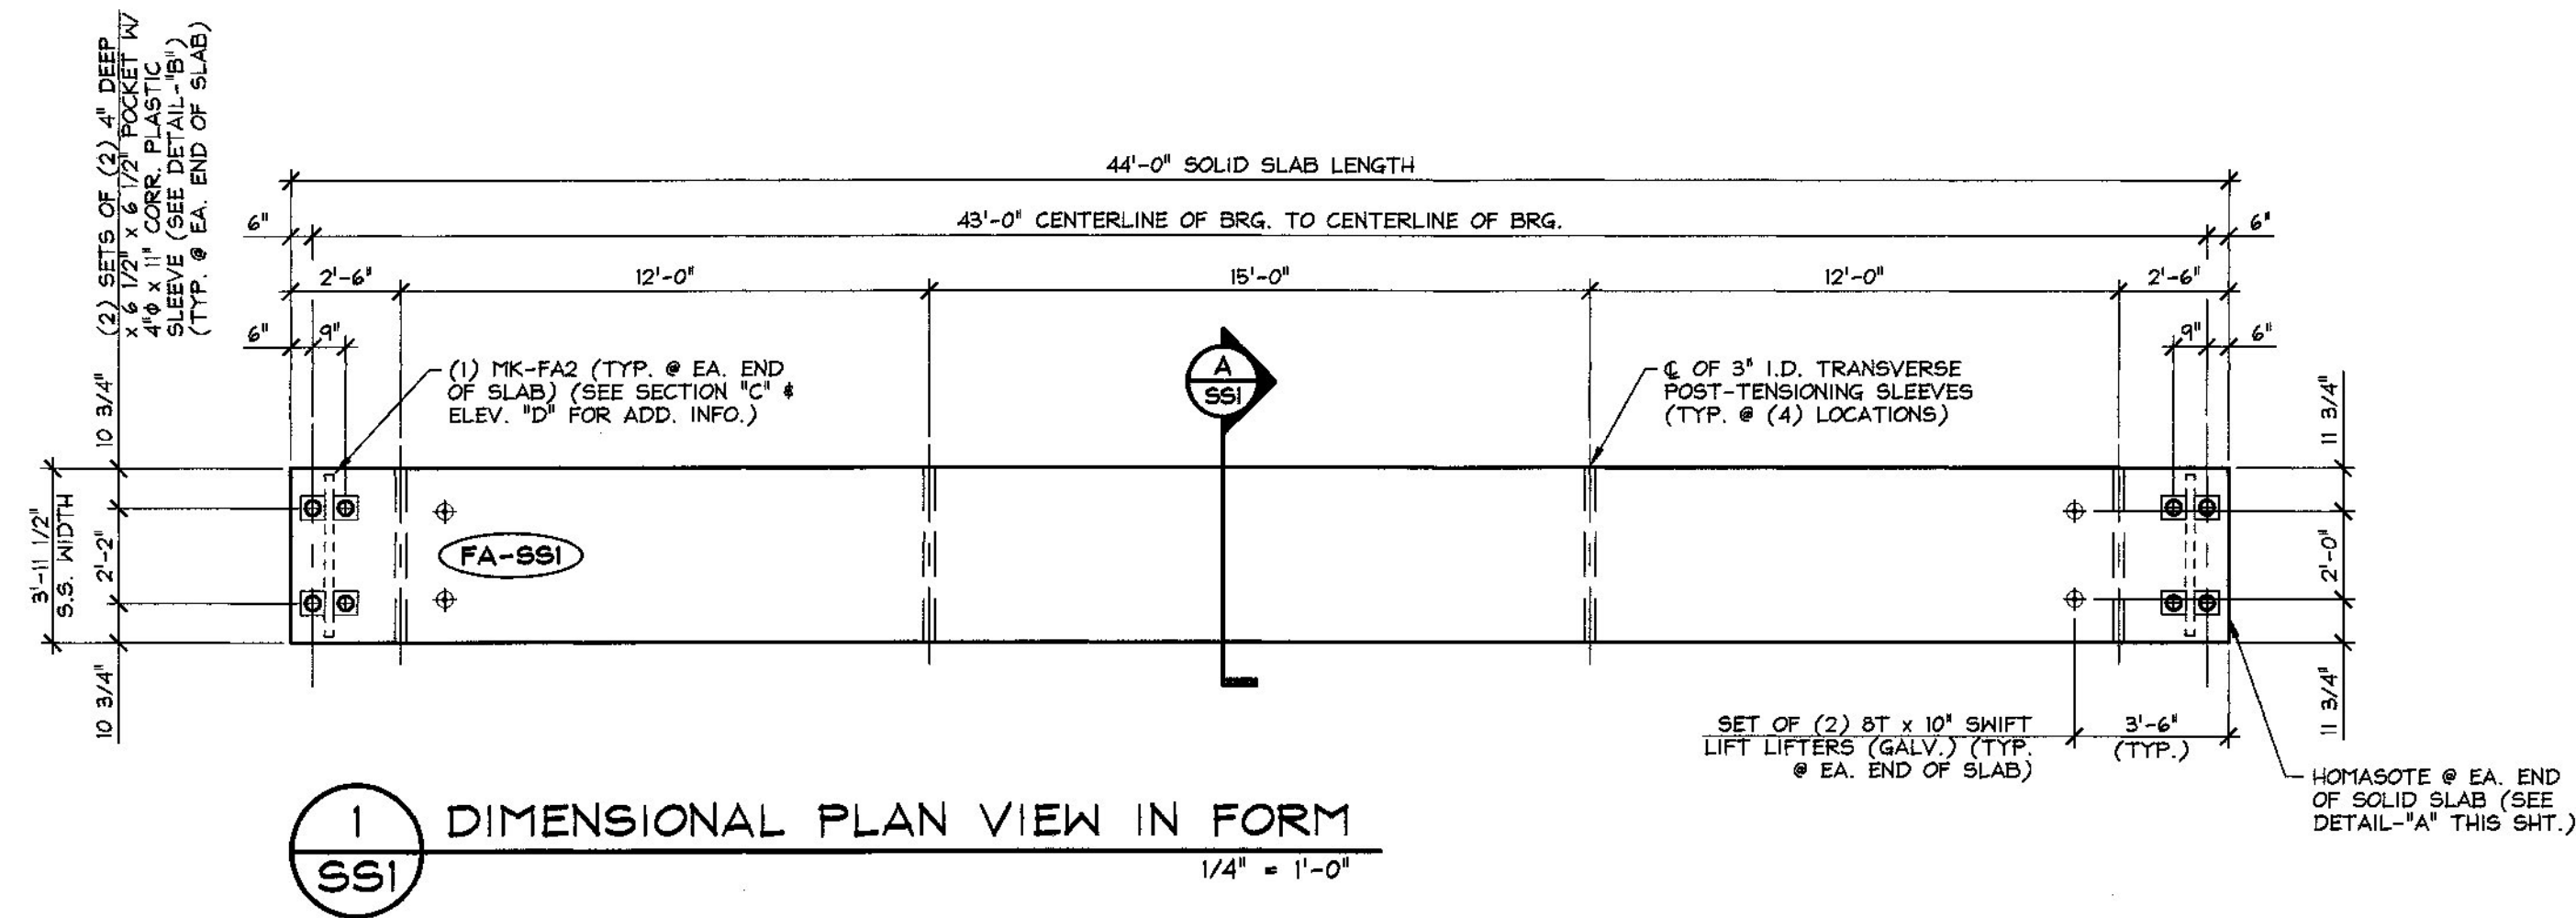

1 3 5 7 9 11 13 15 16 14 12 10 8 6 4 2

DETENSIONING SCHEDULE  
N.T.S.

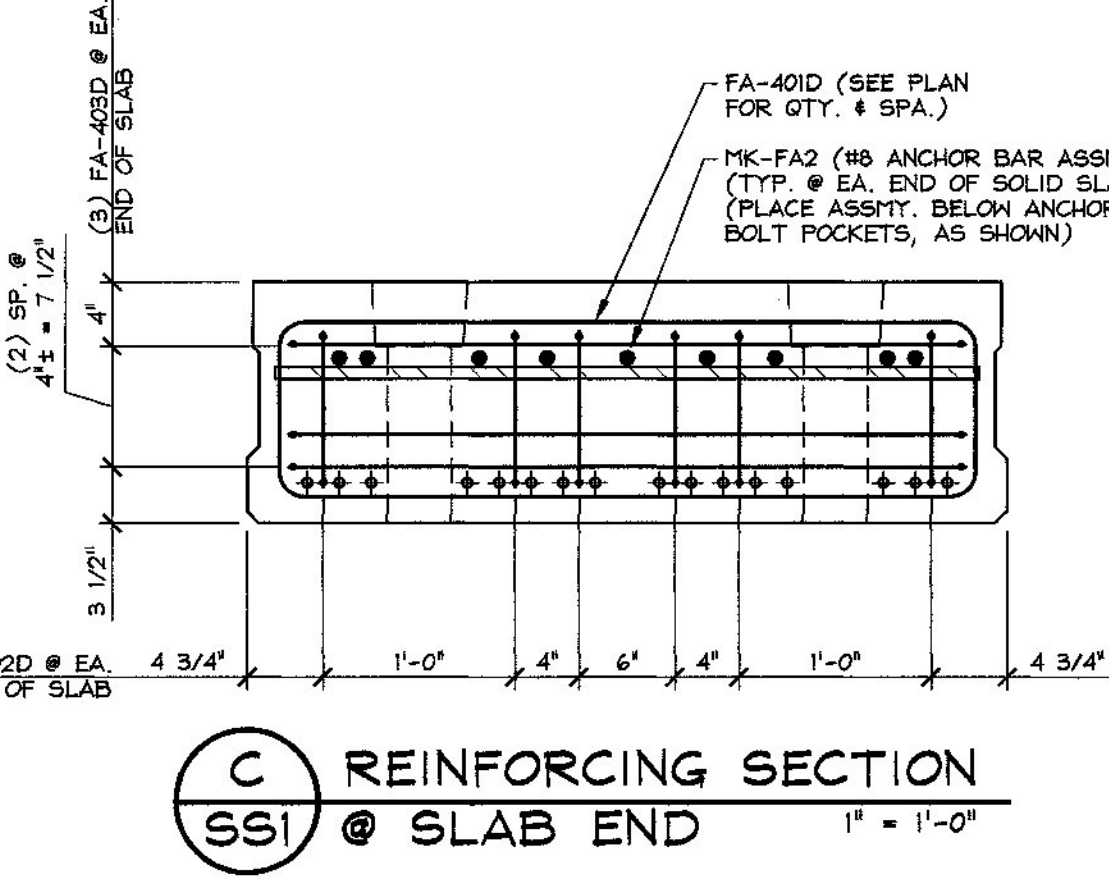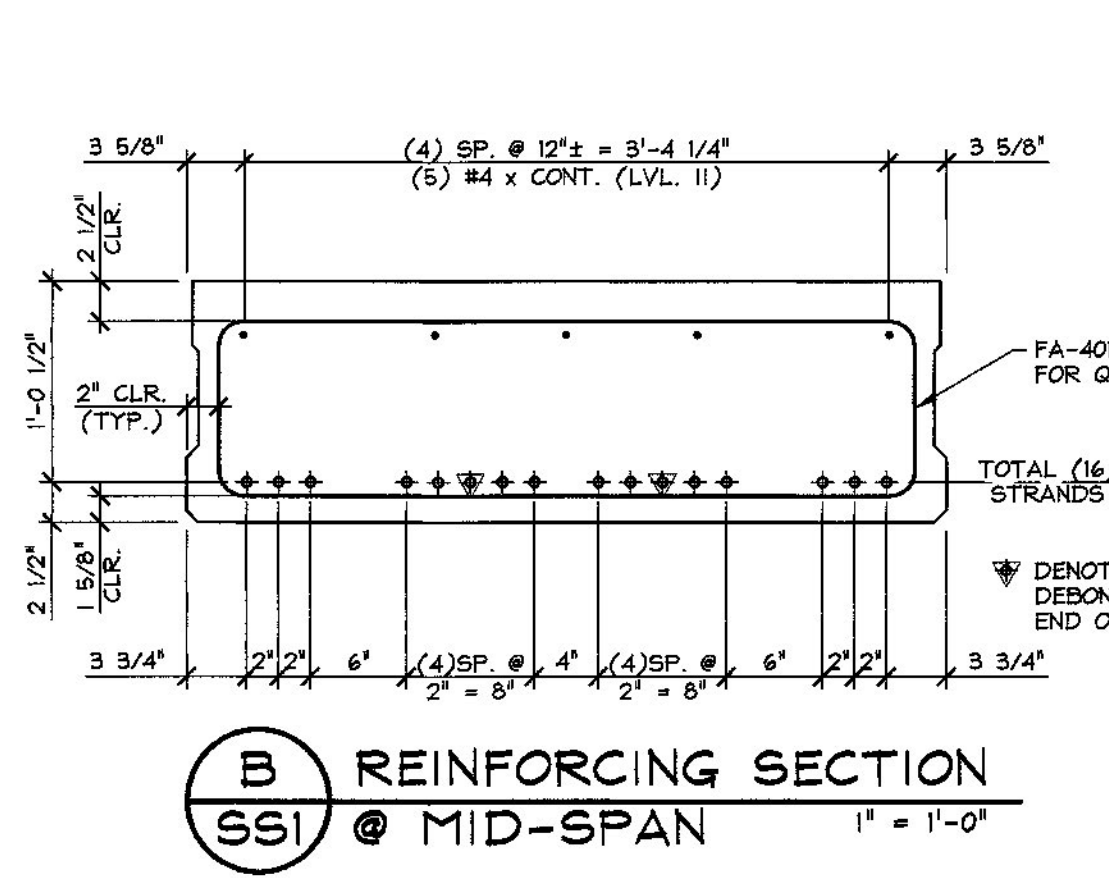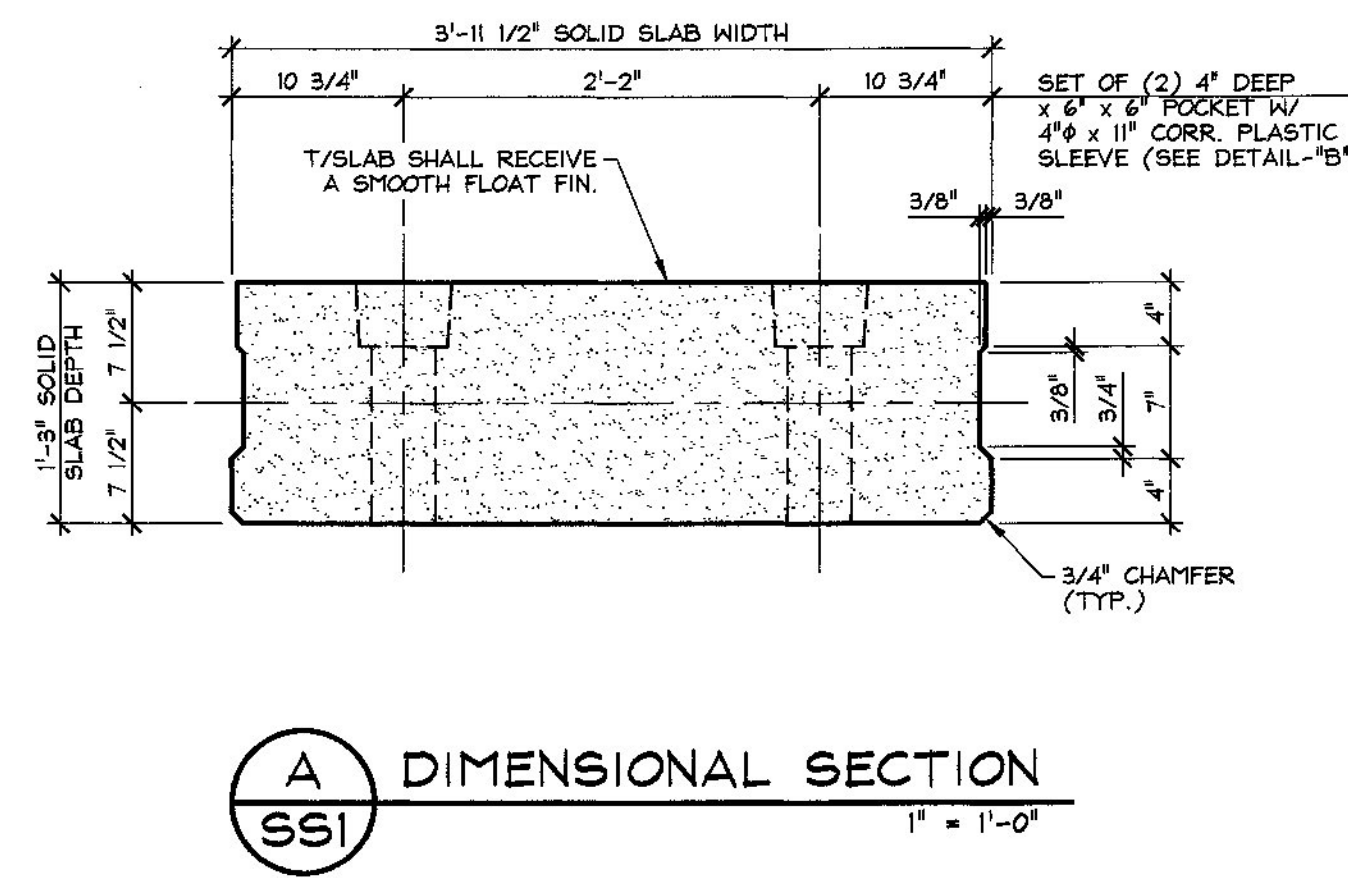

Vermont Agency of Transportation  
**RECEIVED**  
CK'D BY RKJW OK'D BY RY  
February 12, 2015  
RESUBMIT No Approved AsNoted  
BY RY DATE 02/12/2015

2-10-15 REVISED PER VT AOT COMMENTS

MARK: FA-SSI	QTY.: 4	WT.: 16.02 T	VOL.: 7.91 cy
MATERIAL LIST / SOLID SLAB			
ITEM	MARK	DESCRIPTION	QTY.
1	FA-401D	#4 BENT BAR (LEVEL II, DUAL COATED)	93
2	FA-402D	#4 BENT BAR (LEVEL II, DUAL COATED)	12
3	FA-403D	#4 BENT BAR (LEVEL II, DUAL COATED)	6
4		#4 x 36'-2" (LEVEL II, DUAL COATED)	5
5			
6			
7			
8	MK-FA2	ANCHOR BAR 3/4" THICK x 2 1/2" x 3'-8" (ASTM A36) W/ (3) #8 x 12'-0" & (6) #8 x 6'-0" (ASTM A-706) (GALV. ASSMY.)	2
9		8T x 10' SHIFT LIFT LIFTERS (GALV.)	4
10		4" x 11" CORRUGATED PLASTIC SLEEVE	8

APPROVAL STAMP:

**J.P. CARRARA & SONS INC.**  
Precast & Prestress Manufacturer  
2464 OISE ST., MIDDLEBURY, VERMONT 05753 Phone: (802)388-6361 Fax: (802)388-8010








**A.L. ST. ONGE**  
CONTRACTOR  
MONTMERY, VERMONT

STATE OF VERMONT AGENCY OF TRANSPORTATION  
COUNTY OF FRANKLIN

TOWN OF FAIRFIELD  
SOUTH ROAD, FAS 0281 (RURAL MAJOR COLLECTOR)  
BRIDGE NO.: 14 PROJECT NO.: BRF 0281(25)

DATE: NOV. 10, 2014  
SCALE: NOTED  
CHKD: B.C. DFTM: B.L.  
JOB NO: 23446-014

PRESTRESSED SOLID SLAB DETAILS  
DWG. NO: SSI

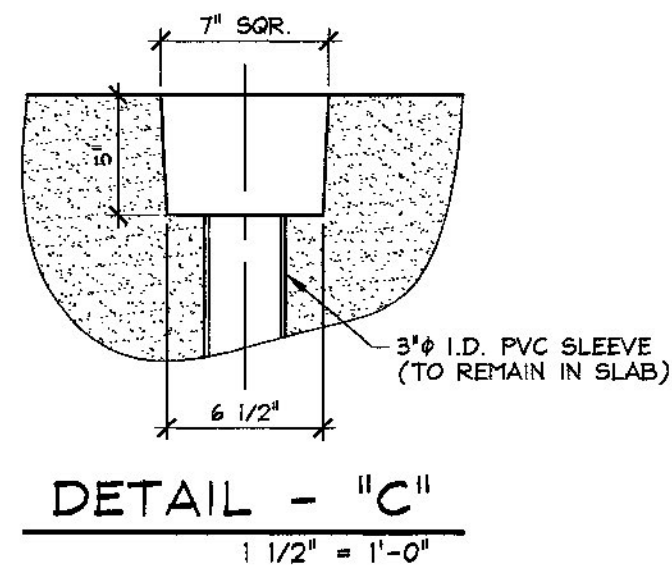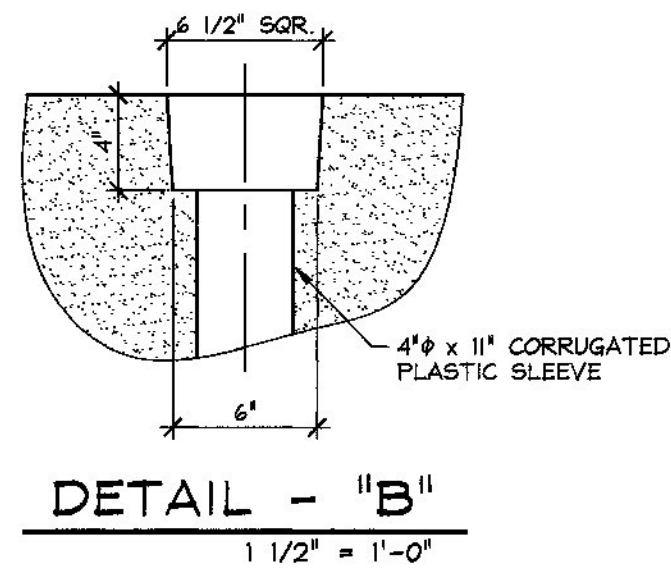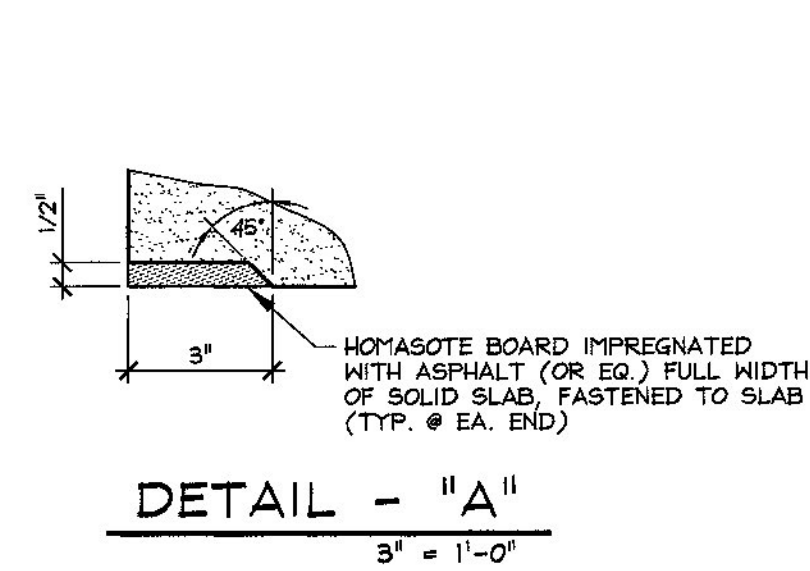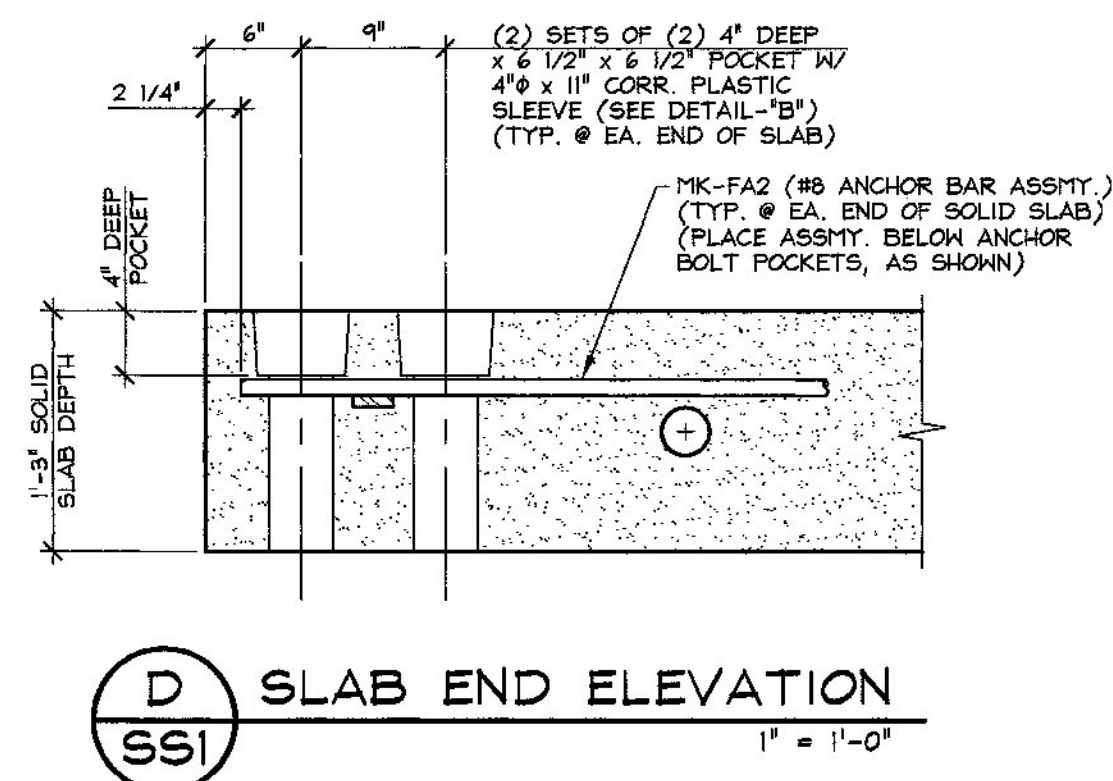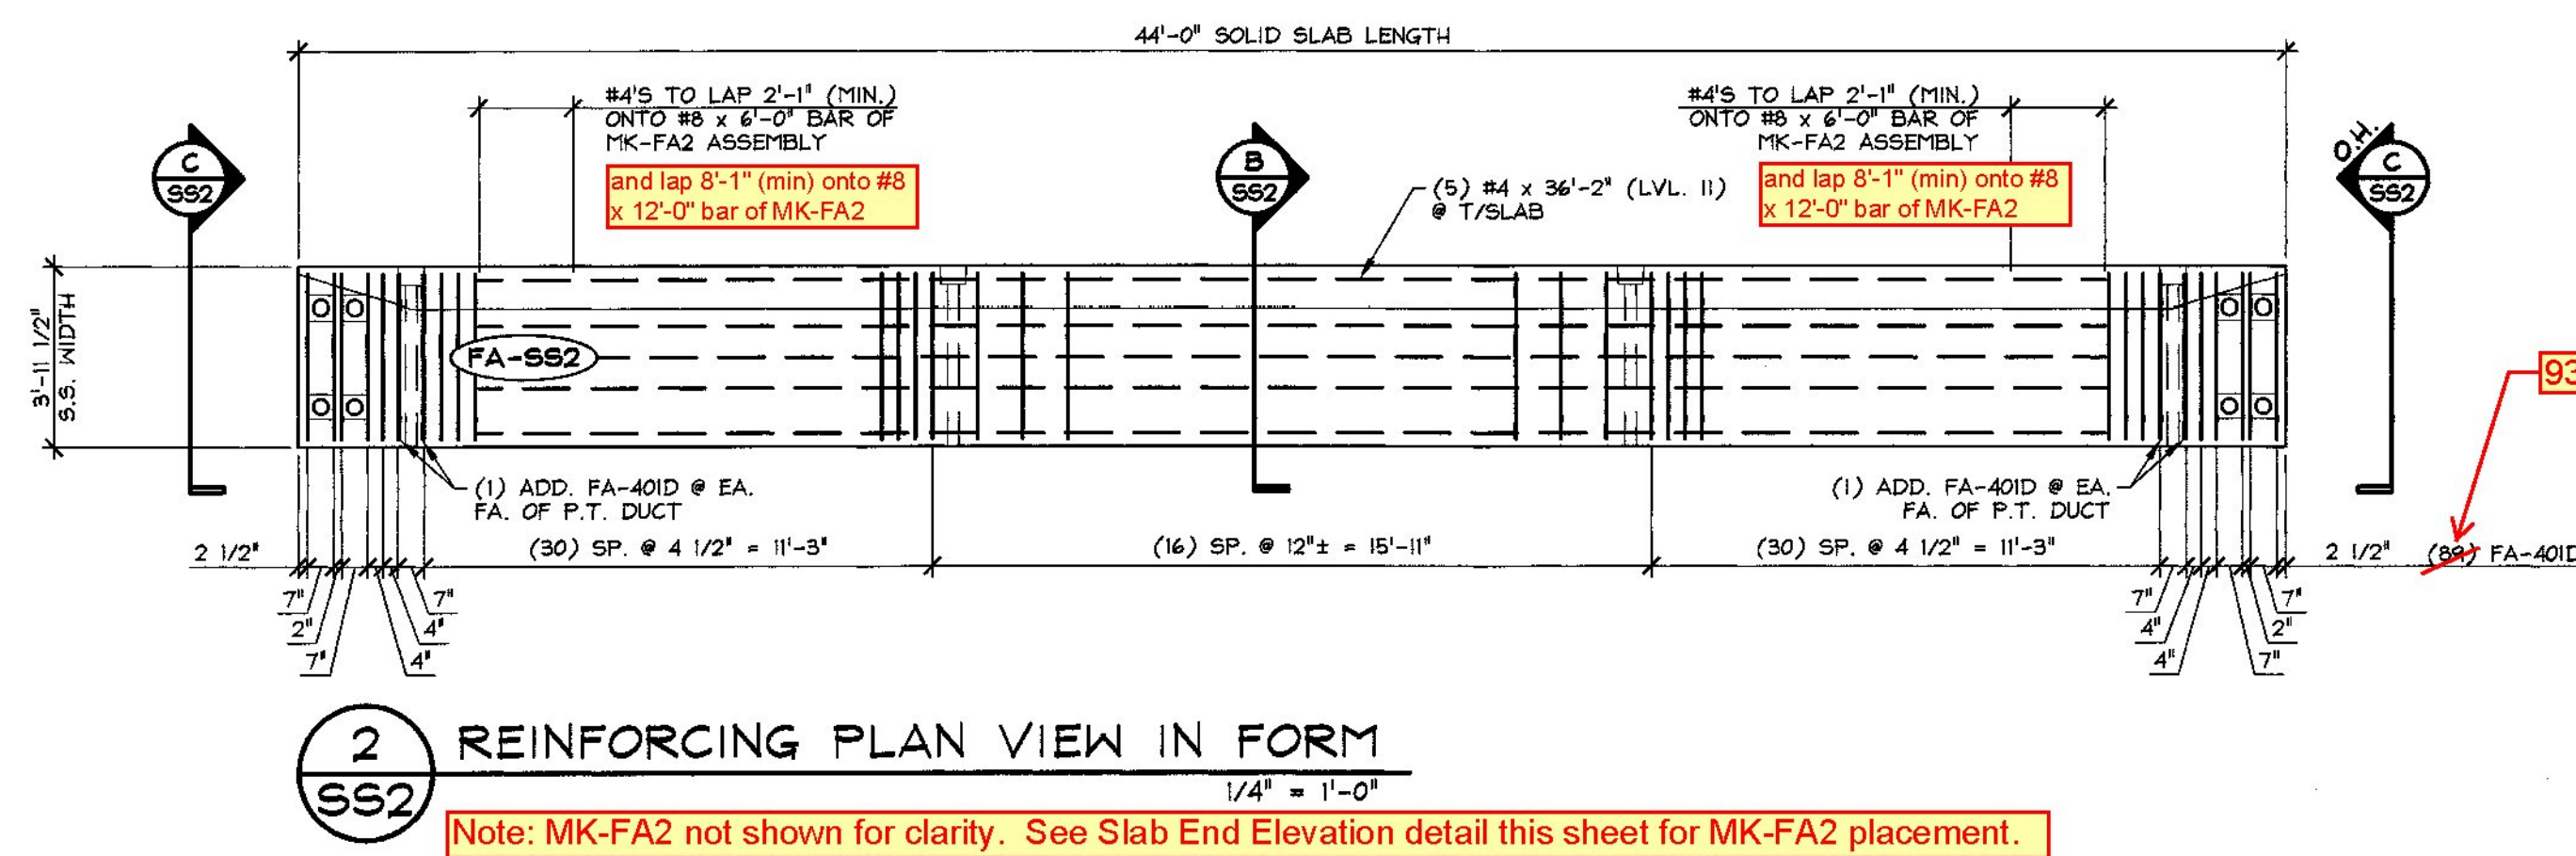
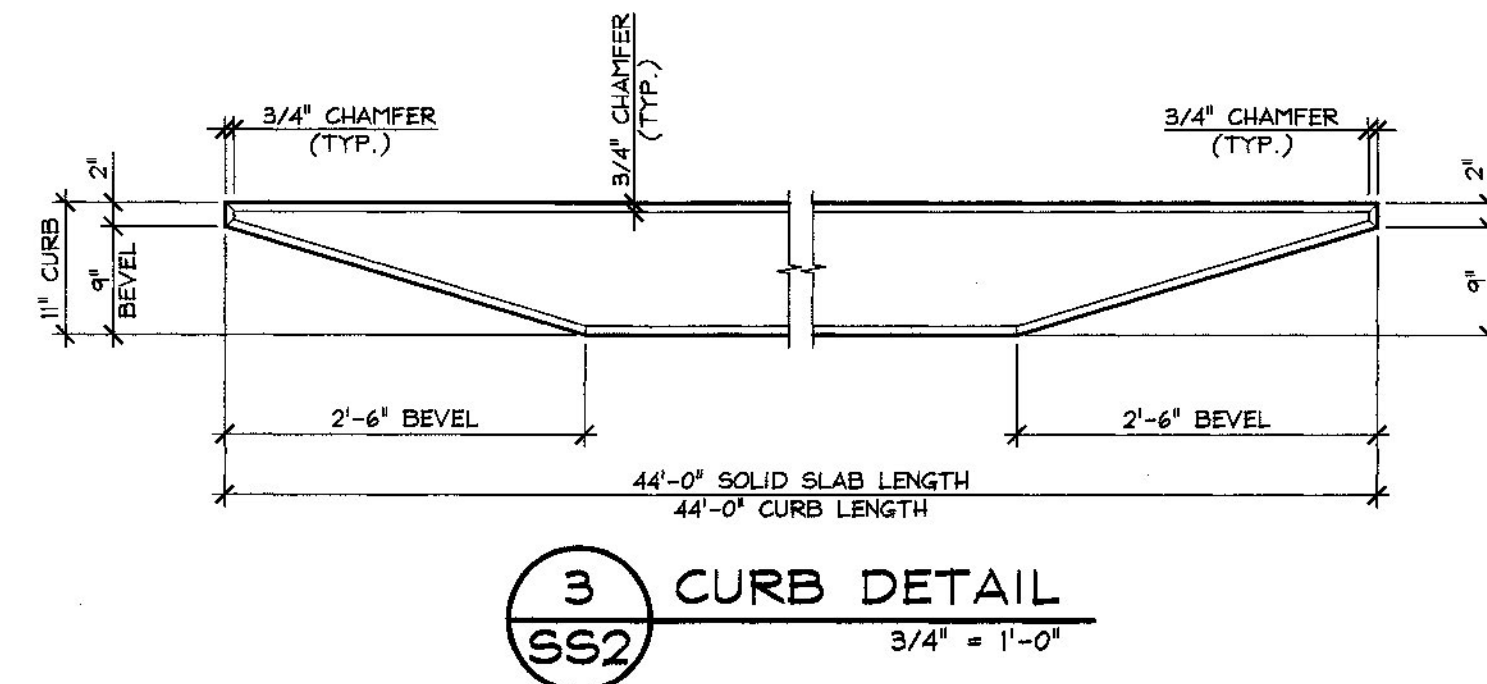
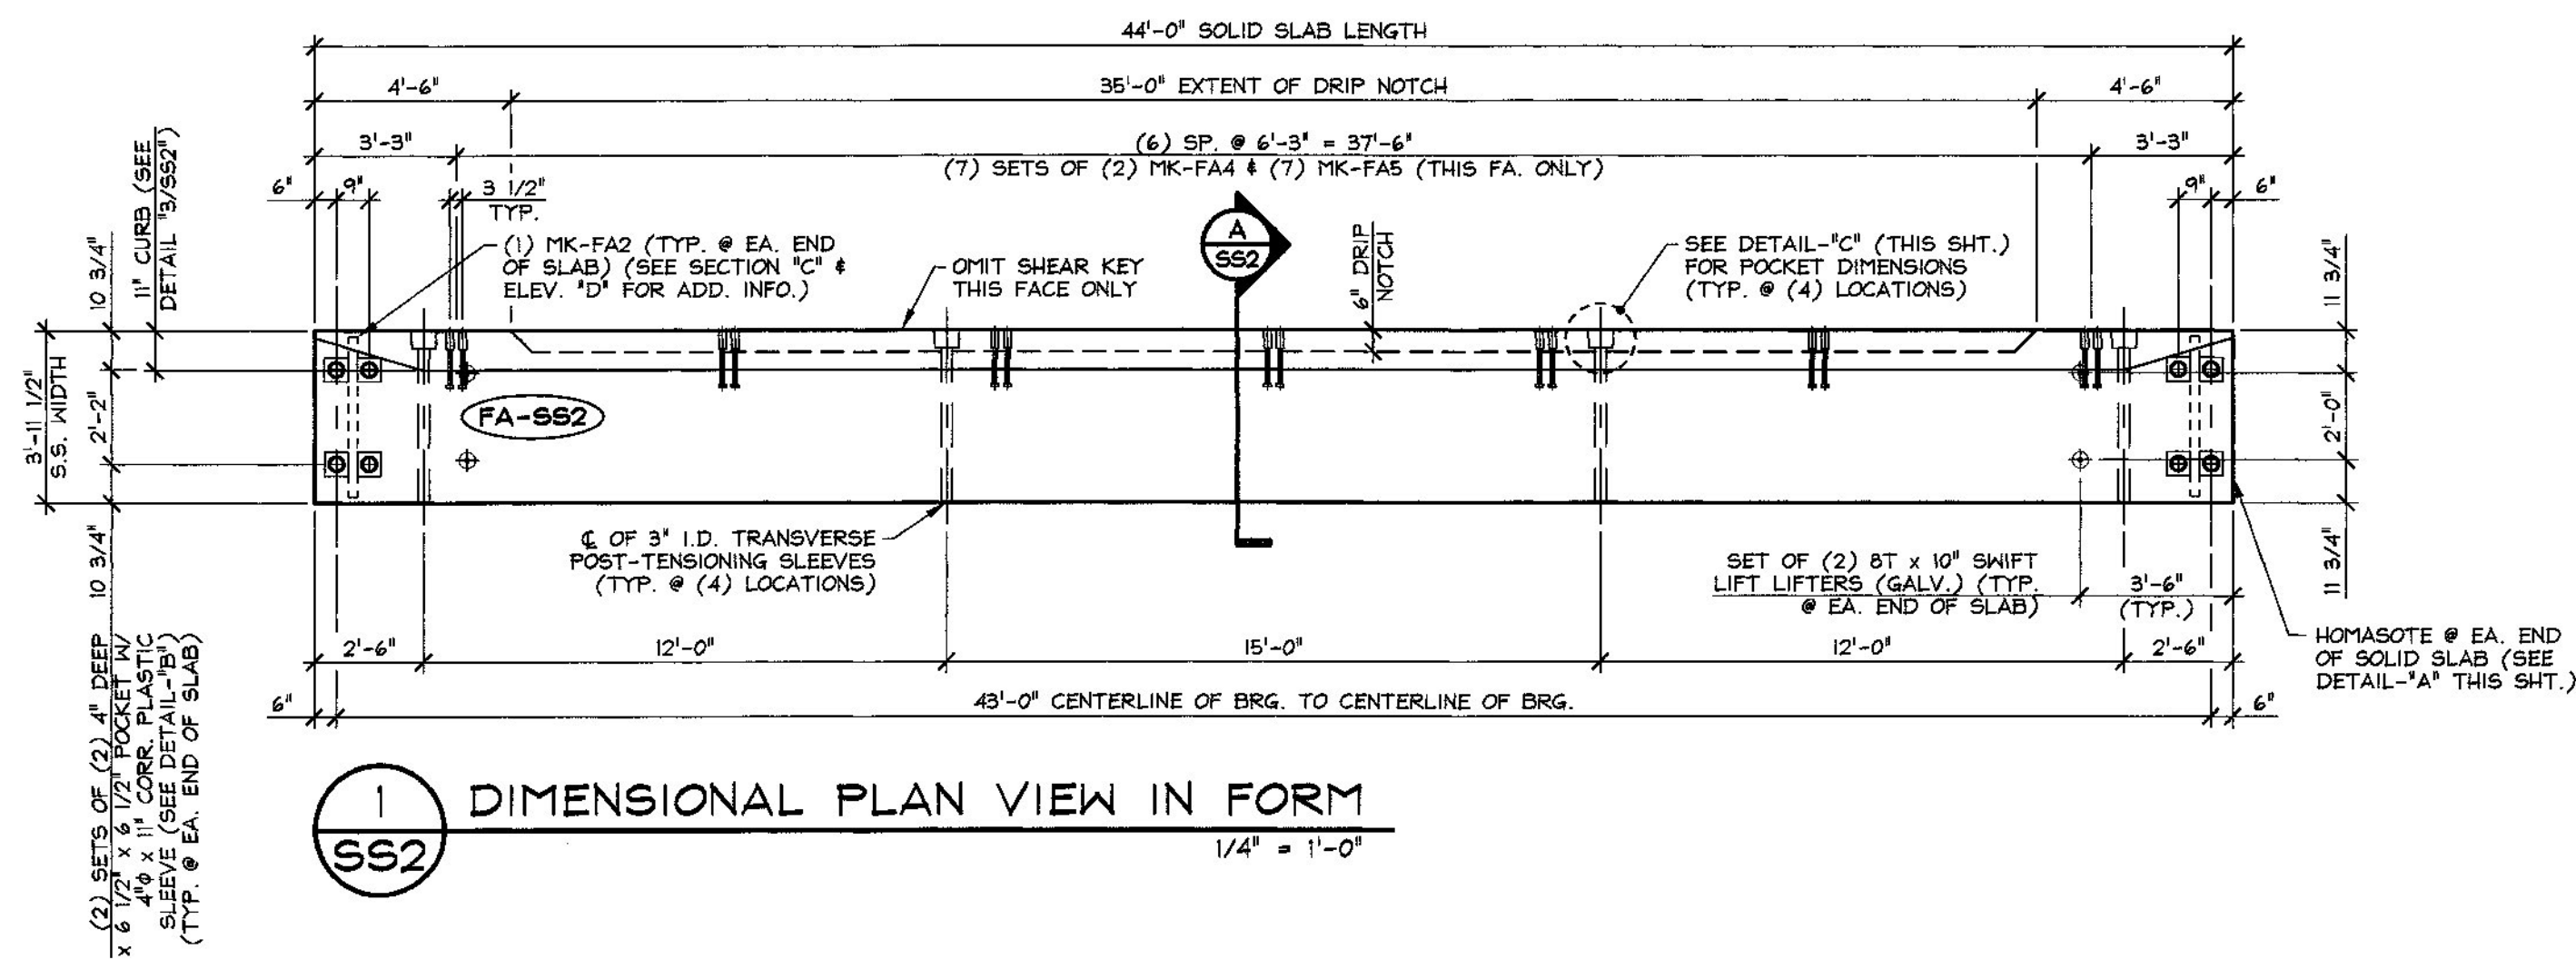


**DETENSIONING SCHEDULE**  
 N.T.S.

1	3	5	7	9	11	13	15	16	14	12	10	8	6	4	2
---	---	---	---	---	----	----	----	----	----	----	----	---	---	---	---


Vermont Agency of Transportation  
**RECEIVED**  
 CK'D BY RK/JW OK'D BY RY  
 February 12, 2015  
 RESUBMIT No Approved AsNoted  
 BY RY DATE 02/12/2015  
 2-10-15 REVISED PER VT AOT COMMENTS

MARK: FA-SS2	QTY.: 2	WT.: 16.90 T	VOL.: 8.35 cy
MATERIAL LIST / SOLID SLAB			
ITEM	MARK	DESCRIPTION	QTY.
1	FA-40ID	#4 BENT BAR (LEVEL II, DUAL COATED)	93
2	FA-402D	#4 BENT BAR (LEVEL II, DUAL COATED)	12
3	FA-403D	#4 BENT BAR (LEVEL II, DUAL COATED)	6
4		#4 x 36'-2" (LEVEL II, DUAL COATED)	5
5			
6	MK-FA2	ANCHOR BAR 3/4" THICK x 2 1/2" x 3'-8" (ASTM A36) W/ 4" x 11" CORR. PLASTIC SLEEVE (SEE DETAIL-"B") (TYP. @ EA. END OF SOLID SLAB)	2
7	MK-FA4	5" LG. SLEEVE NUT (GALV.) # 1 1/4" x 12" MACHINE BOLT (GALV.)	14
8	MK-FA5	2-BOLT FERRULE GUARD RAIL INSERT 1 1/4" x 7-UNC (GALV.)	7
9		8T x 10" SWIFT LIFT LIFTERS (GALV.)	4
10		4" x 11" CORRUGATED PLASTIC SLEEVE	8

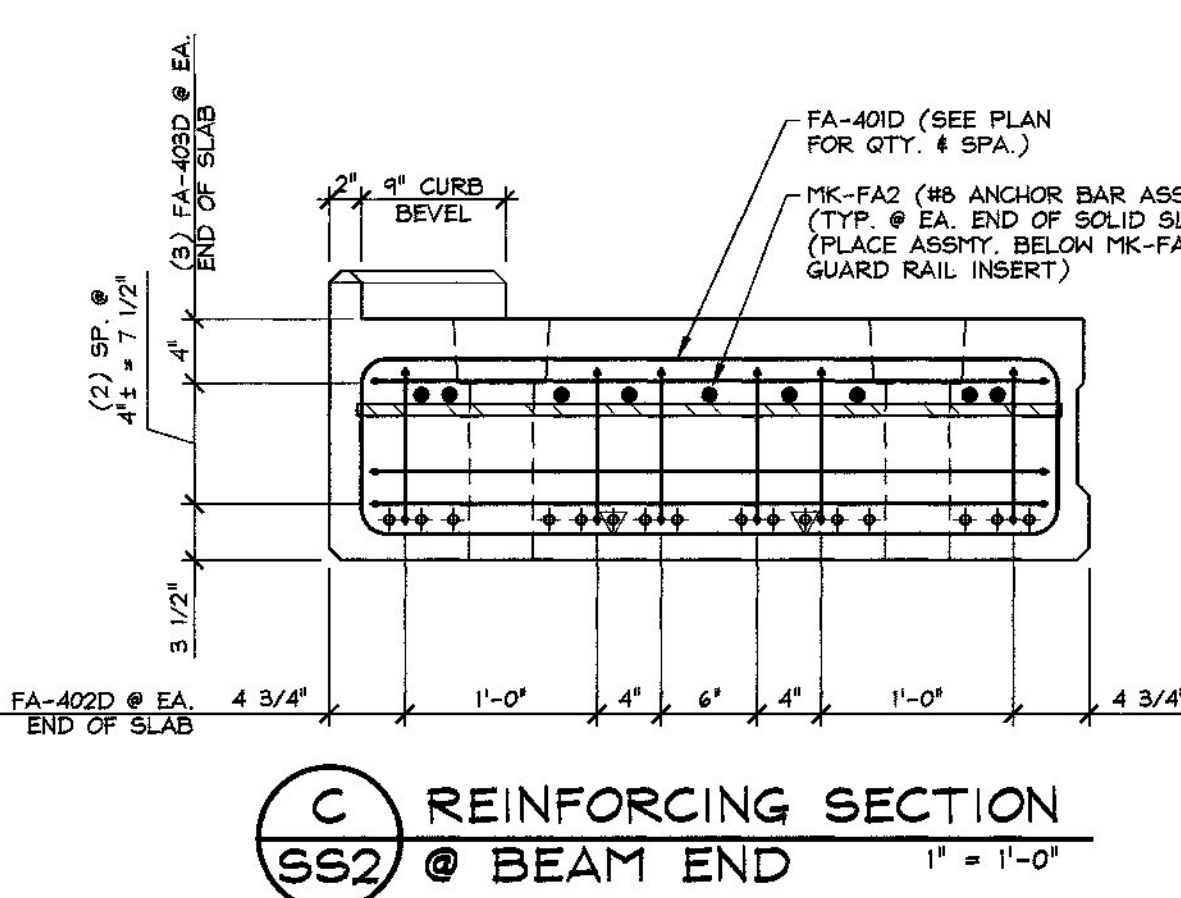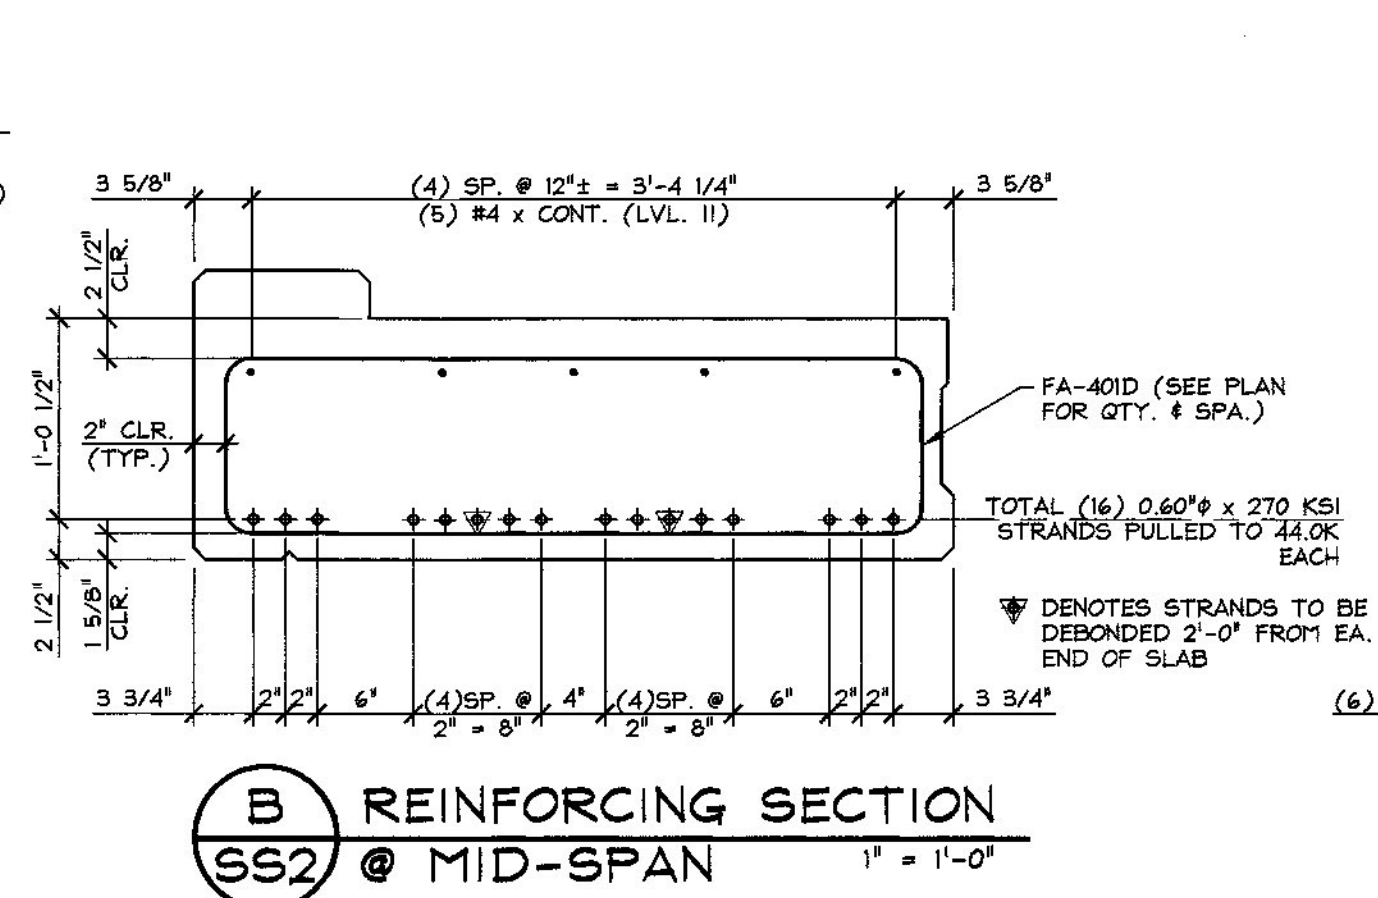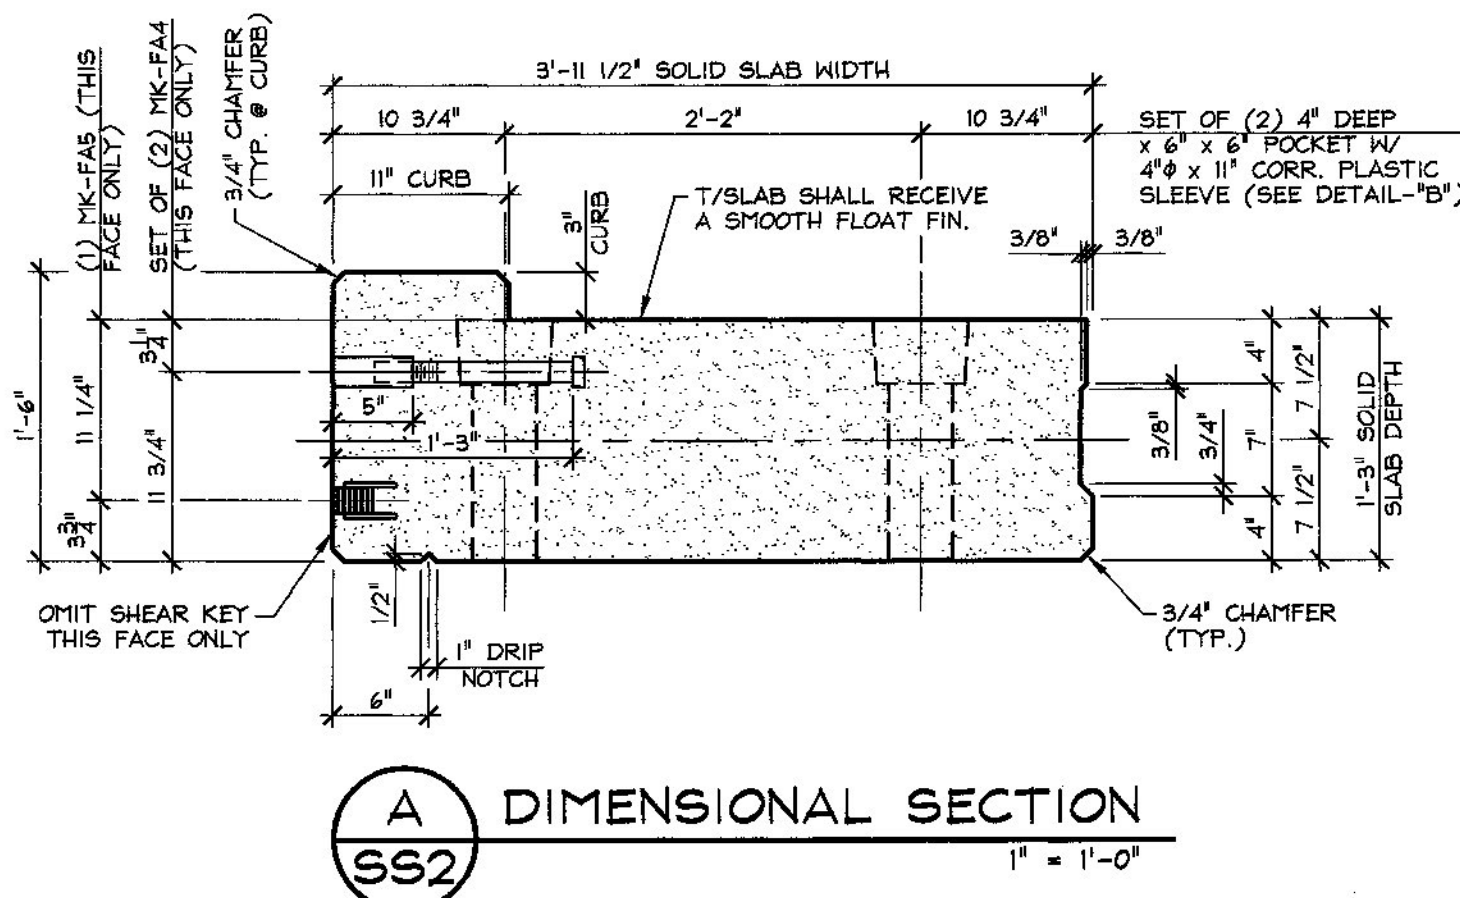

APPROVAL STAMP:  
 J.P. CARRARA & SONS INC.  
 Precast & Prestress Manufacturer  
 284 ONE STR. MONTPELIER, VERMONT 05703 Phone: (802)388-4361 Fax: (802)388-9010  
 STATE OF VERMONT AGENCY OF TRANSPORTATION  
 COUNTY OF FRANKLIN  
 TOWN OF FAIRFIELD  
 SOUTH ROAD, FAS 0281 (RURAL MAJOR COLLECTOR)  
 BRIDGE NO.: 14 PROJECT NO.: BRF 0281(25)  
 PRESTRESSED SOLID SLAB DETAILS

A.L. ST. ONGE  
 CONTRACTOR  
 MONTPELIER, VERMONT  
 DATE: NOV. 10, 2014  
 SCALE: NOTED  
 CHKD: B.C. DFTM: B.L.  
 JOB NO: 23446-014  
 DWG. NO: SS2

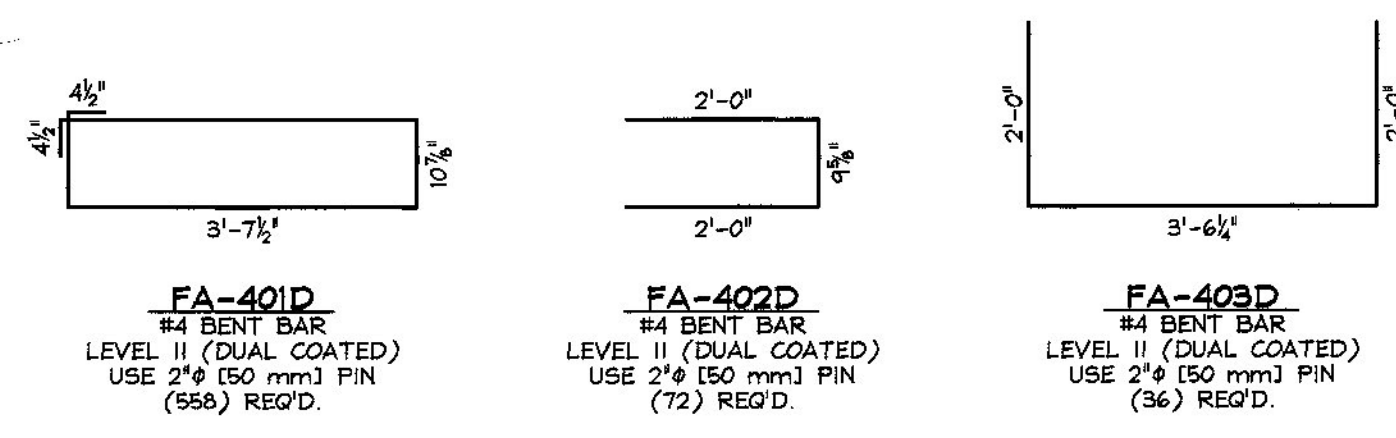


**FA-401D**  
#4 BENT BAR  
LEVEL II (DUAL COATED)  
USE 2 1/2" (64 mm) PIN  
(556) REQ'D.

**FA-402D**  
#4 BENT BAR  
LEVEL II (DUAL COATED)  
USE 2 1/2" (64 mm) PIN  
(72) REQ'D.


**FA-403D**  
#4 BENT BAR  
LEVEL II (DUAL COATED)  
USE 2 1/2" (64 mm) PIN  
(36) REQ'D.

**PRESTRESSED SOLID SLABS**

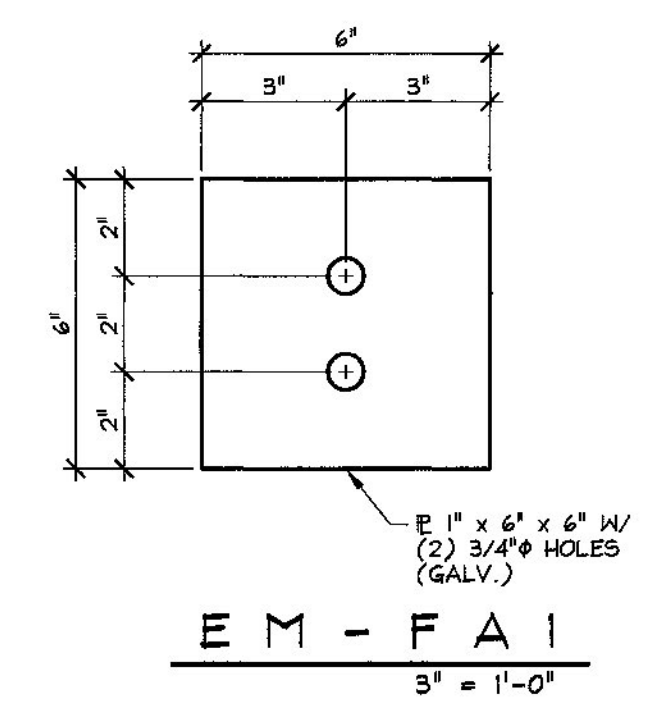

**EM-FA1**  
3' = 1'-0"



Material requirements per note 20, sheet 8/09 of contract plans:  
CORRUGATED POST-TENSIONING DUCTS IN THE  
PRESTRESSED SLABS AND PRECAST APPROACH SLABS FOR  
ANCHOR BOLT AND DOWEL CONNECTIONS SHALL BE  
CONSTRUCTED FROM EITHER POLYETHYLENE OR  
POLYPROPYLENE. THE DUCT SHALL HAVE A MINIMUM  
MATERIAL THICKNESS OF 0.080 IN. +/- 0.010 IN. AND SHALL  
HAVE A WHITE COATING ON THE OUTSIDE OR SHALL BE OF  
WHITE MATERIAL WITH ULTRAVIOLET STABILIZERS ADDED.  
POLYETHYLENE DUCT SHALL BE FABRICATED FROM RESINS  
MEETING OR EXCEEDING THE REQUIREMENTS OF ASTM D  
3350 WITH A CELL CLASSIFICATION OF 345484A. POLY  
PROPYLENE DUCT SHALL BE FABRICATED FROM RESINS  
MEETING OR EXCEEDING THE REQUIREMENTS OF ASTM D  
4101 WITH A CELL CLASSIFICATION RANGE OF PP0340B44544  
TO PP0340B65884.

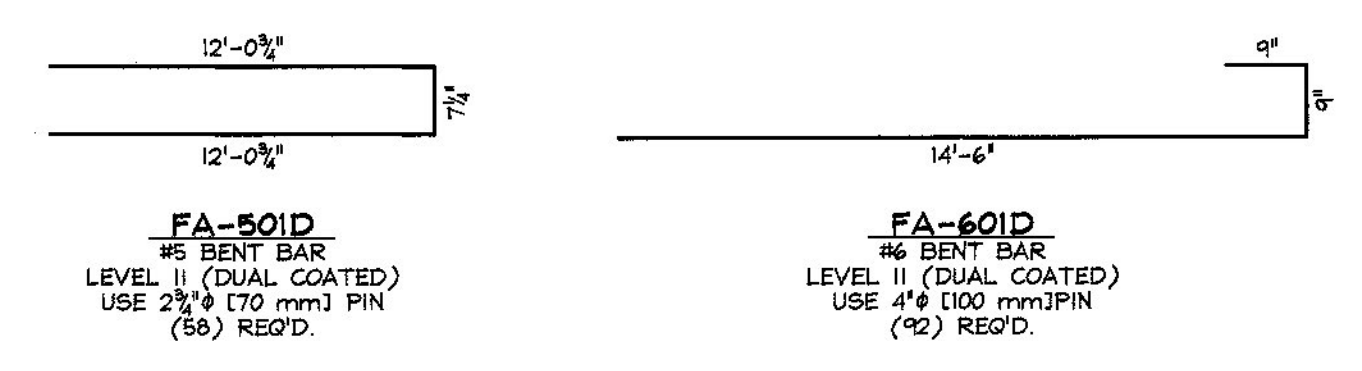

**FA-501D**  
#5 BENT BAR  
LEVEL II (DUAL COATED)  
USE 2 3/4" (70 mm) PIN  
(58) REQ'D.


**FA-601D**  
#6 BENT BAR  
LEVEL II (DUAL COATED)  
USE 4" (100 mm) PIN  
(92) REQ'D.

**PRECAST APPROACH SLABS**

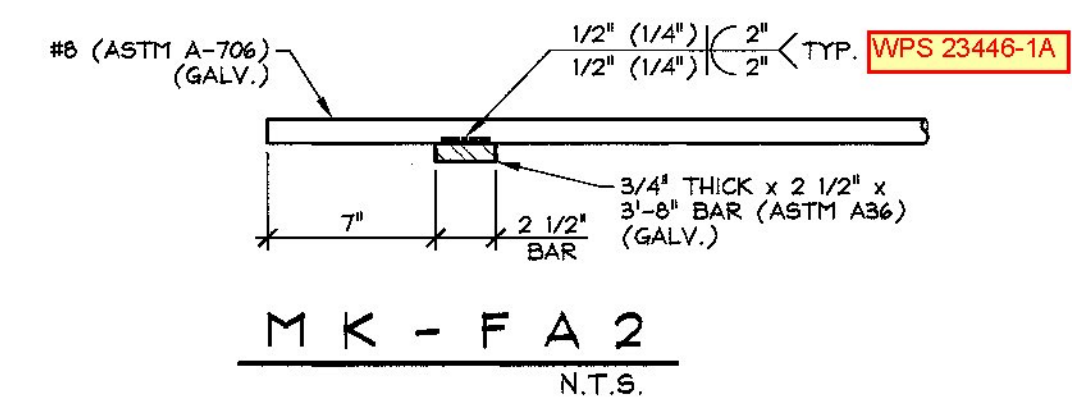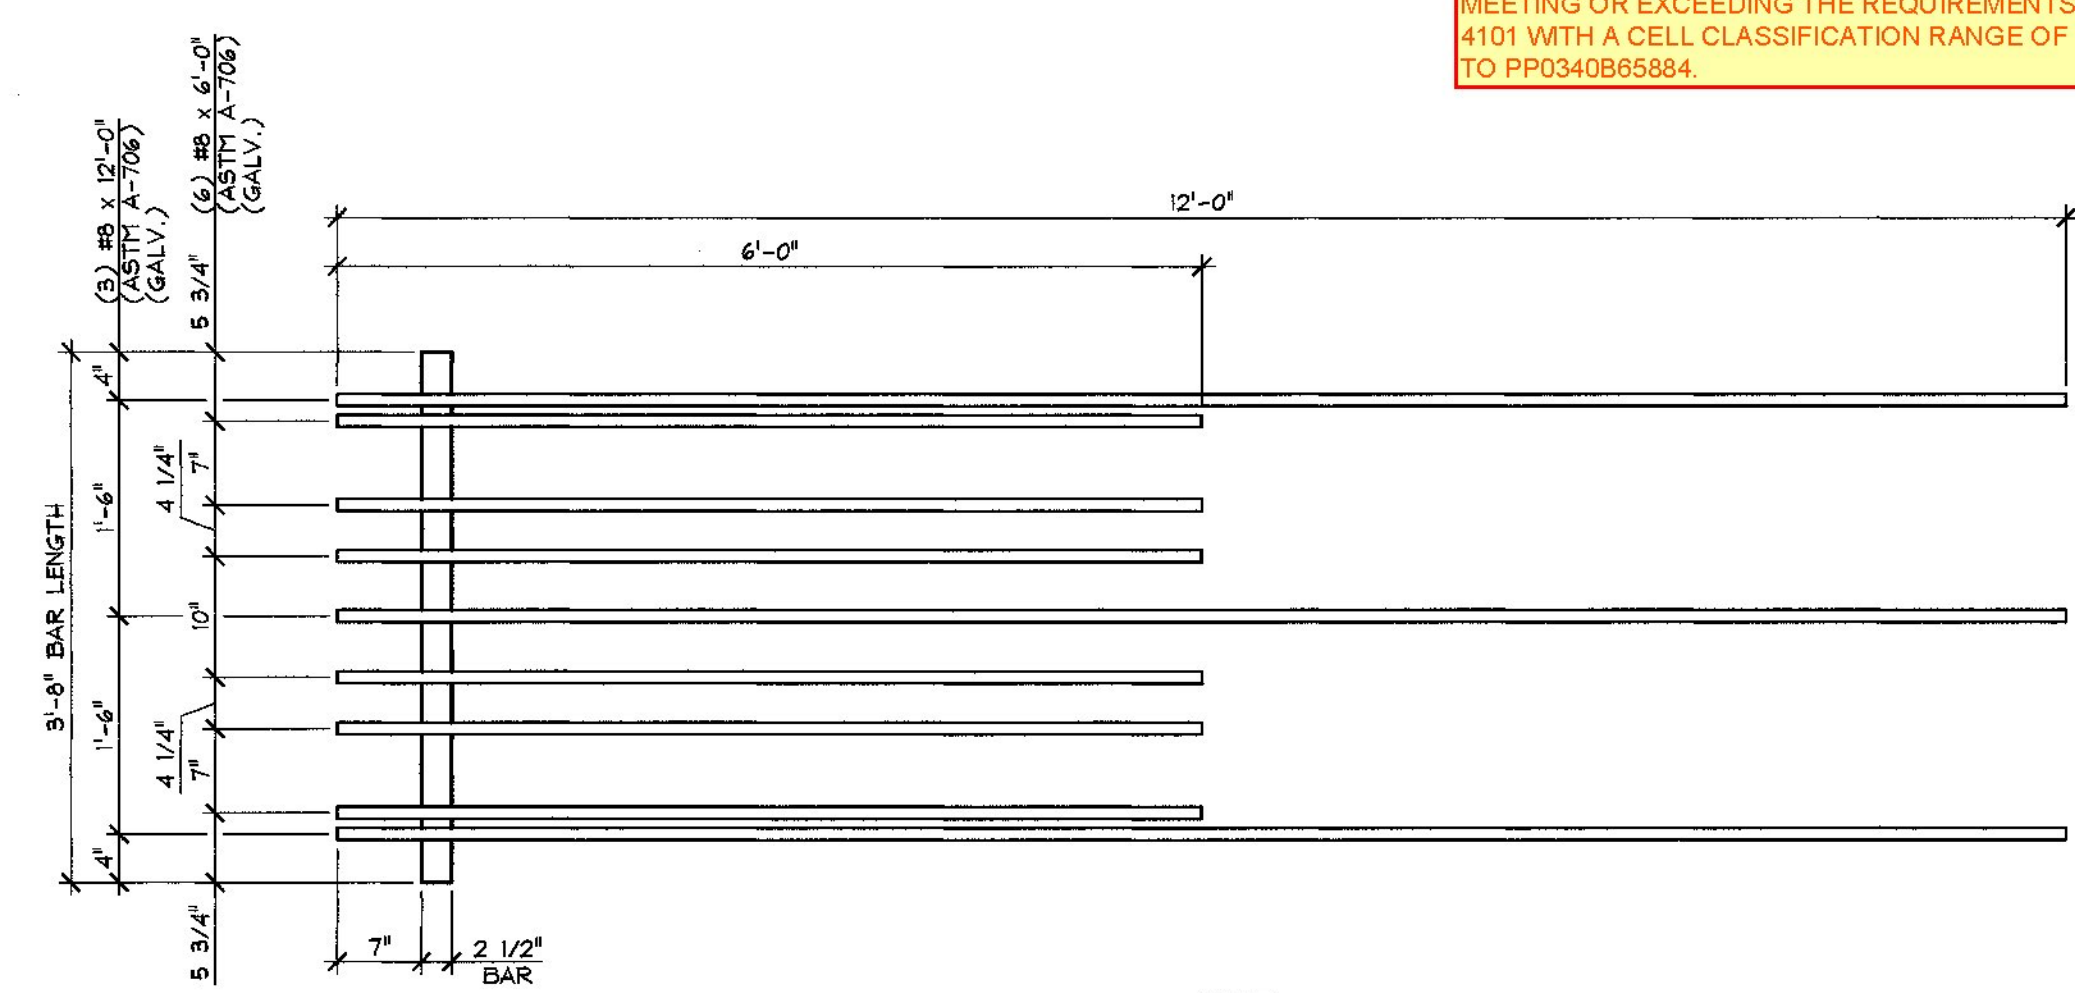

**MK-FA2**  
N.T.S.


NOTE:  
AFTER MK-FA2 ASSEMBLY HAS BEEN GALVANIZED,  
ENTIRE ASSEMBLY SHALL BE COATED WITH TWO  
PART EPOXY REPAIR MATERIAL IN ACCORDANCE  
WITH LEVEL II, DUAL COATED REINFORCING STEEL  
MANUFACTURER INSTRUCTIONS.

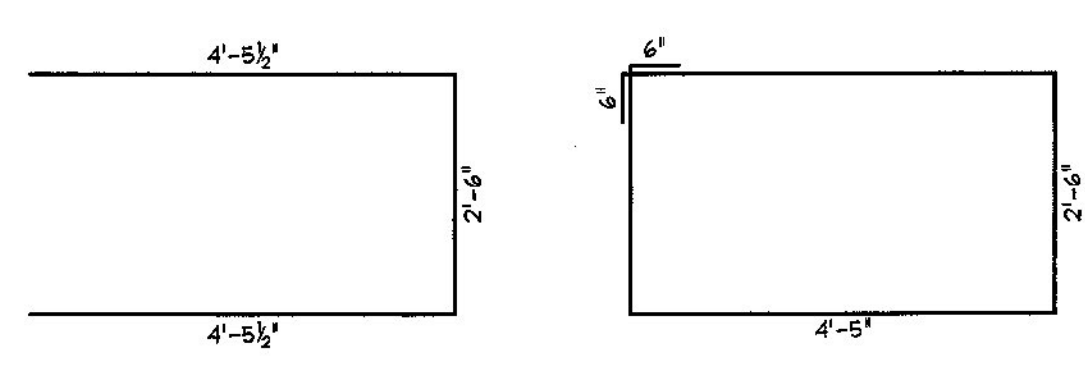


**FA-506D**  
#5 BENT BAR  
LEVEL II (DUAL COATED)  
USE 2 3/4" (70 mm) PIN  
(20) REQ'D.

**FA-602**  
#6 BENT BAR  
LEVEL I (BLACK STEEL)  
USE 4" (100 mm) PIN  
(96) REQ'D.

**PRECAST ABUTMENTS**

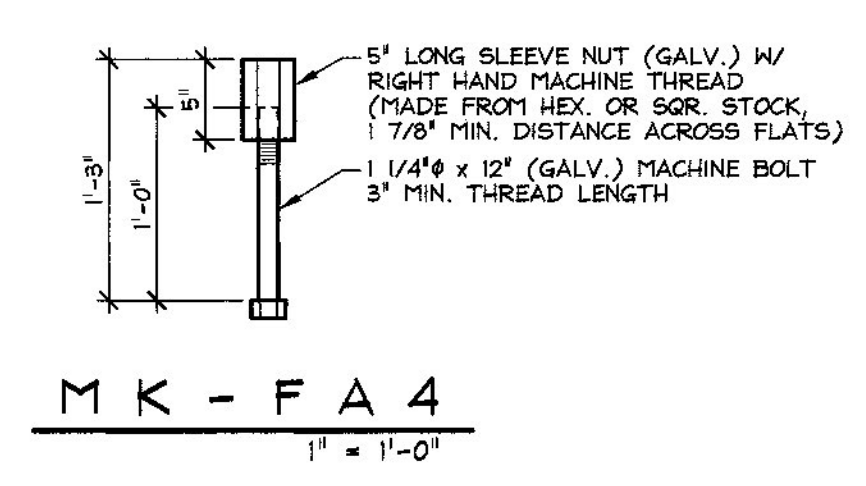

**MK-FA4**  
3' = 1'-0"

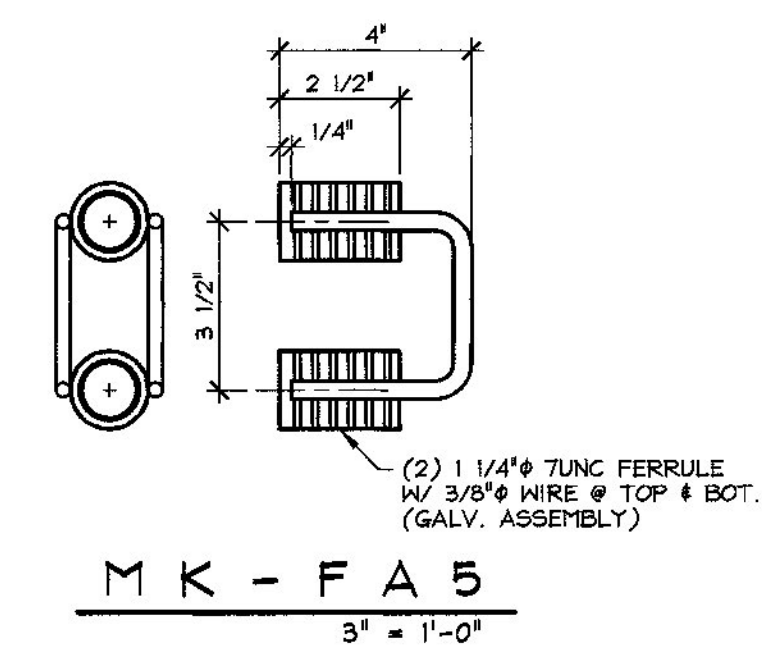

**MK-FA5**  
3' = 1'-0"


MISCELLANEOUS MATERIALS				
ITEM	MARK	QTY.	DESCRIPTION	REMARKS
1	EM-FA1	8	2" x 6" x 6" W/ (2) 3/4" HOLES (GALV.)	FOR ERECTION, SEE DETAIL THIS SHEET
2		8	0.60" x 270 KSI x 26'-0" LONG POLY-STRAND	FOR ERECTION
3		16	0.60" SINGLE USE STRESSING CHUCK	FOR ERECTION
4				
5				
6		30	#4 x 36'-2" (LEVEL II, DUAL COATED)	
7				
8	MK-FA2	12	ANCHOR BAR 3/4" THICK x 2 1/2" x 3'-0" (ASTM A36) W/ (3) #8 x 12'-0" & (6) #8 x 6'-0" (ASTM A-706)	GALVANIZED ASSEMBLY, 4 TWO PART EPOXY COATED (SEE DETAIL THIS SHEET)
9	MK-FA4	28	5" LG. SLEEVE NUT (GALV.) & 1 1/4" x 12" MACHINE BOLT	GALVANIZED, SEE DETAIL THIS SHEET
10	MK-FA5	14	2-BOLT FERRULE GUARD RAIL INSERT 1 1/4" x 7UNC	GALVANIZED, SEE DETAIL THIS SHEET
11		24	8T x 10" SWIFT LIFT LIFTERS	Galvanized
12		48	4" x 11" CORRUGATED PLASTIC SLEEVE	
13				
14		48	#6 x 14'-6" (LEVEL II, DUAL COATED)	
15				
16		16	8T x 6 3/4" SWIFT LIFT LIFTER	GALVANIZED
17				
18		48	4" x 1'-3" CORRUGATED PLASTIC SLEEVE	
19				
20				
21				
22				
23		36	#5 x 31'-6" (LEVEL I, BLACK STEEL)	
24		16	#5 x 3'-4 1/2" (LEVEL II, DUAL COATED)	
25				
26		48	#6 x 2'-11" (LEVEL II, DUAL COATED)	
27				
28		1	BRIDGE PLAQUE	SUPPLIED BY OTHERS
29		32	6" x 5'-1 3/4" (MAX.) CORRUGATED STEEL SLEEVE	GALVANIZED, AASHTO M 36, TYPE I
30		8	2'-0" x 5'-1 1/2" CORRUGATED STEEL SLEEVE	GALVANIZED, AASHTO M 36, TYPE I
31		4	SET OF (4) 0.60" x 270 KSI STRAND LIFTING LOOPS	
32				
33				
34				
35				

Vermont Agency of Transportation  
**RECEIVED**  
CK'D BY RK/JW OK'D BY RY  
February 12, 2015  
RESUBMIT No Approved AsNoted  
BY RY DATE 02/12/2015

2-10-15 REVISED PER VT AOT COMMENTS


APPROVAL STAMP:	<b>J.P. CARRARA &amp; SONS INC.</b> Precast & Prestress Manufacturer 344 GSE STR., MIDDLEBURY, VERMONT 05753 Phone: (802) 388-6361 Fax: (802) 388-9010	<b>A.L. ST. ONGE</b> CONTRACTOR MONTGOMERY, VERMONT
STATE OF VERMONT AGENCY OF TRANSPORTATION COUNTY OF FRANKLIN		DATE: NOV. 10, 2014
TOWN OF FAIRFIELD SOUTH ROAD, FAS 0281 (RURAL MAJOR COLLECTOR) BRIDGE NO.: 14 PROJECT NO.: BRF 0281(25)		SCALE: NOTED
MATERIALS LIST		CHKD: B.C. DFTM: B.L. JOB NO: 23446-014 DWG. NO: M1

REVISIONS					
ZONE	REV	DESCRIPTION	REVISED BY	DATE	APPROVED
--	A	PER ENGINEERS MARKS	EG	1/27/15	BF

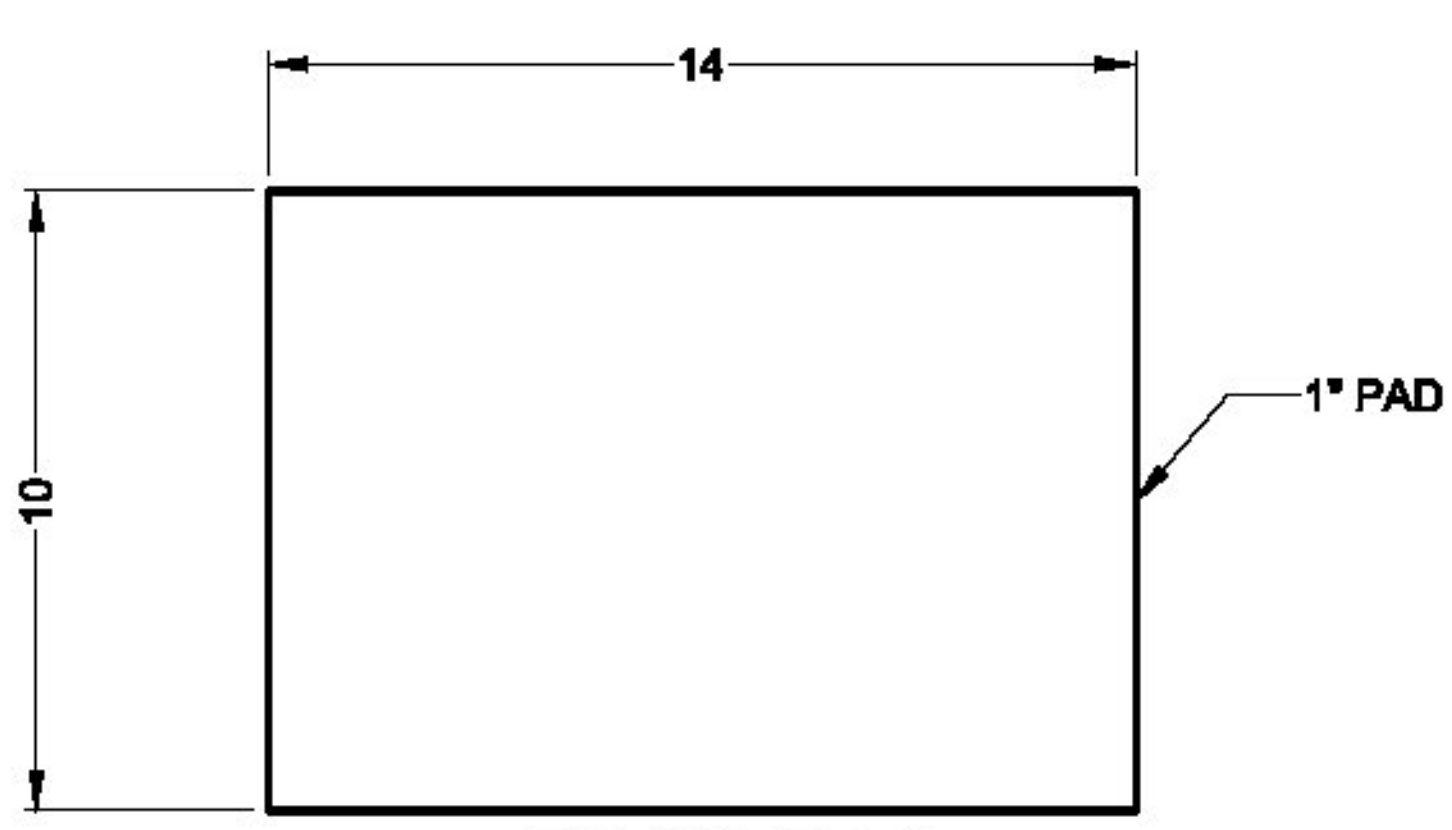

**PLAN PAD  
PLAN VIEW**


QTY. REQ'D. = 16  
AASHTO GRADE 50 DUROMETER

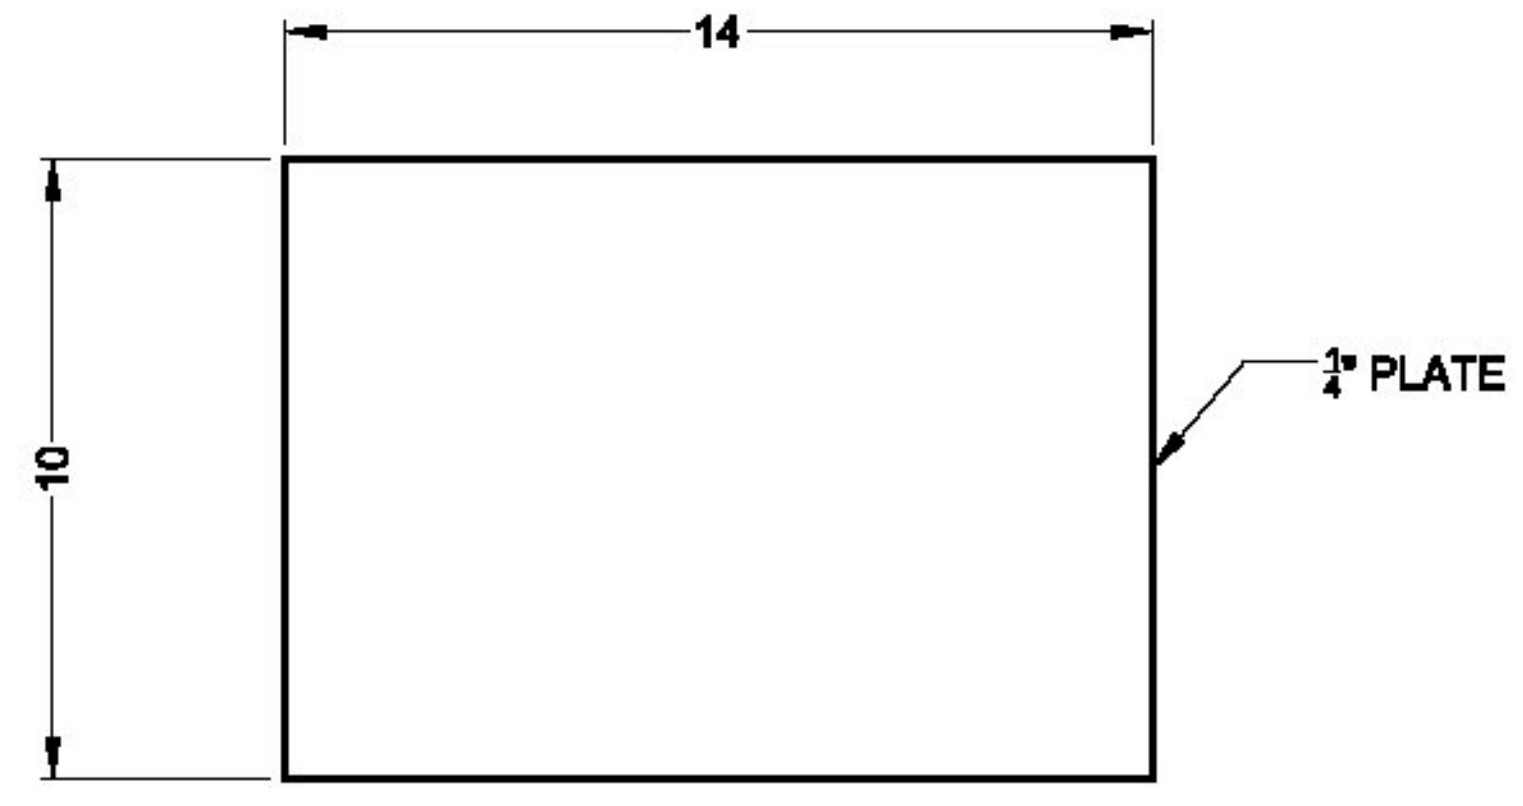

**GALVANIZED SHIM PLATE  
PLAN VIEW**


QTY. REQ'D. = 16  
ASTM A709 GR50

- NOTES:
- MANUFACTURING FACILITY LOCATION:  
AMSCOT STRUCTURAL PRODUCTS CORP.  
241 E. BLACKWELL STREET  
DOVER, N.J. 07801  
CONTACT- PETER SOMOGYI  
PH: 973-989-8800  
FAX: 973-989-5851
  - ALL BEARING PADS TO BE MANUFACTURED IN ACCORDANCE WITH AASHTO SECTION 18. THE ELASTOMER SHALL BE GRADE 3 NATURAL RUBBER WITH A DUROMETER HARDNESS OF 50 ± 5, WITH A SHEAR MODULUS OF 110 PSI ± 15%.
  - ALL DIMENSIONS ARE IN INCHES, UNLESS OTHERWISE NOTED.
  - TOLERANCES: THICKNESS -0 +1/8  
PLAN -0 +1/8

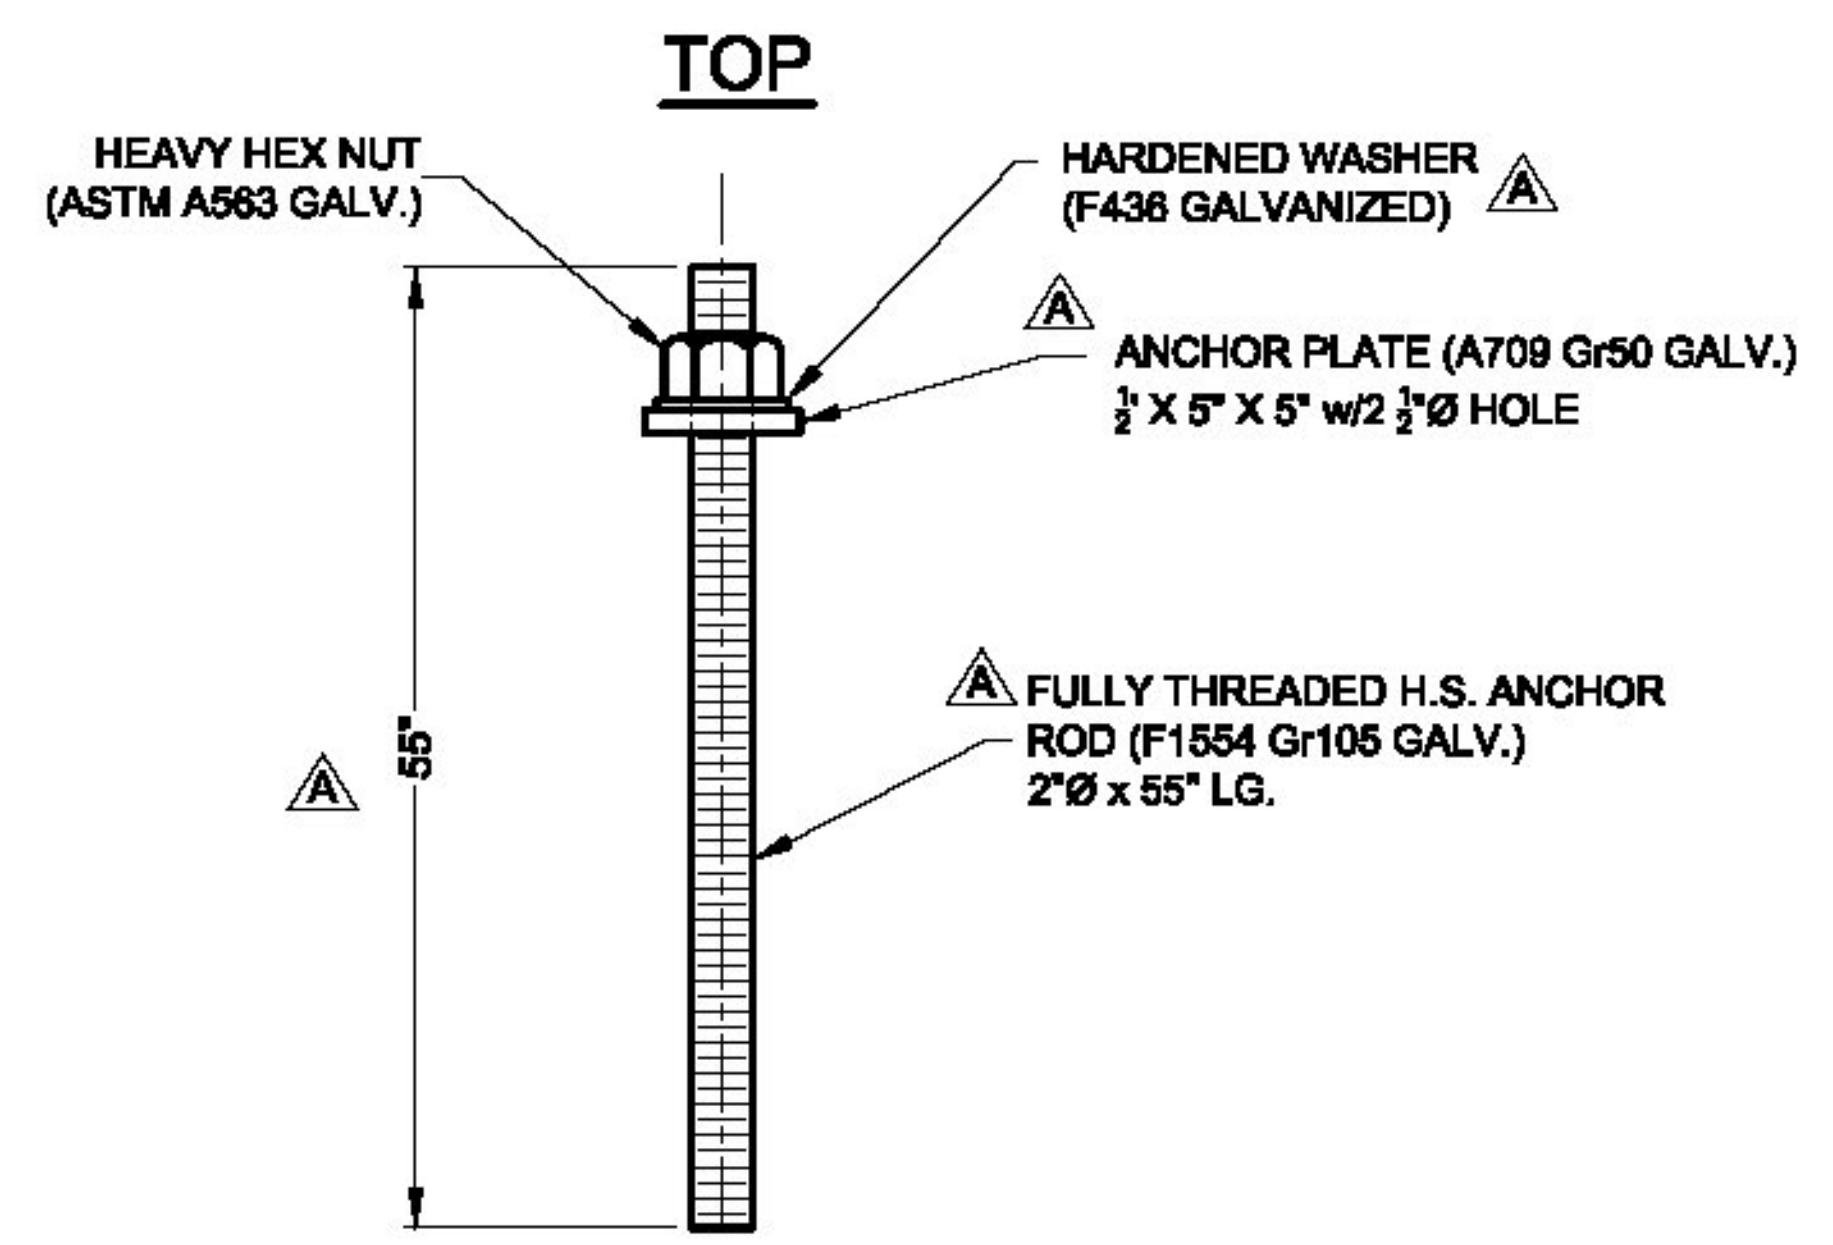

**ANCHOR BOLT DETAIL**

QTY. REQ'D = 16 ASSY.

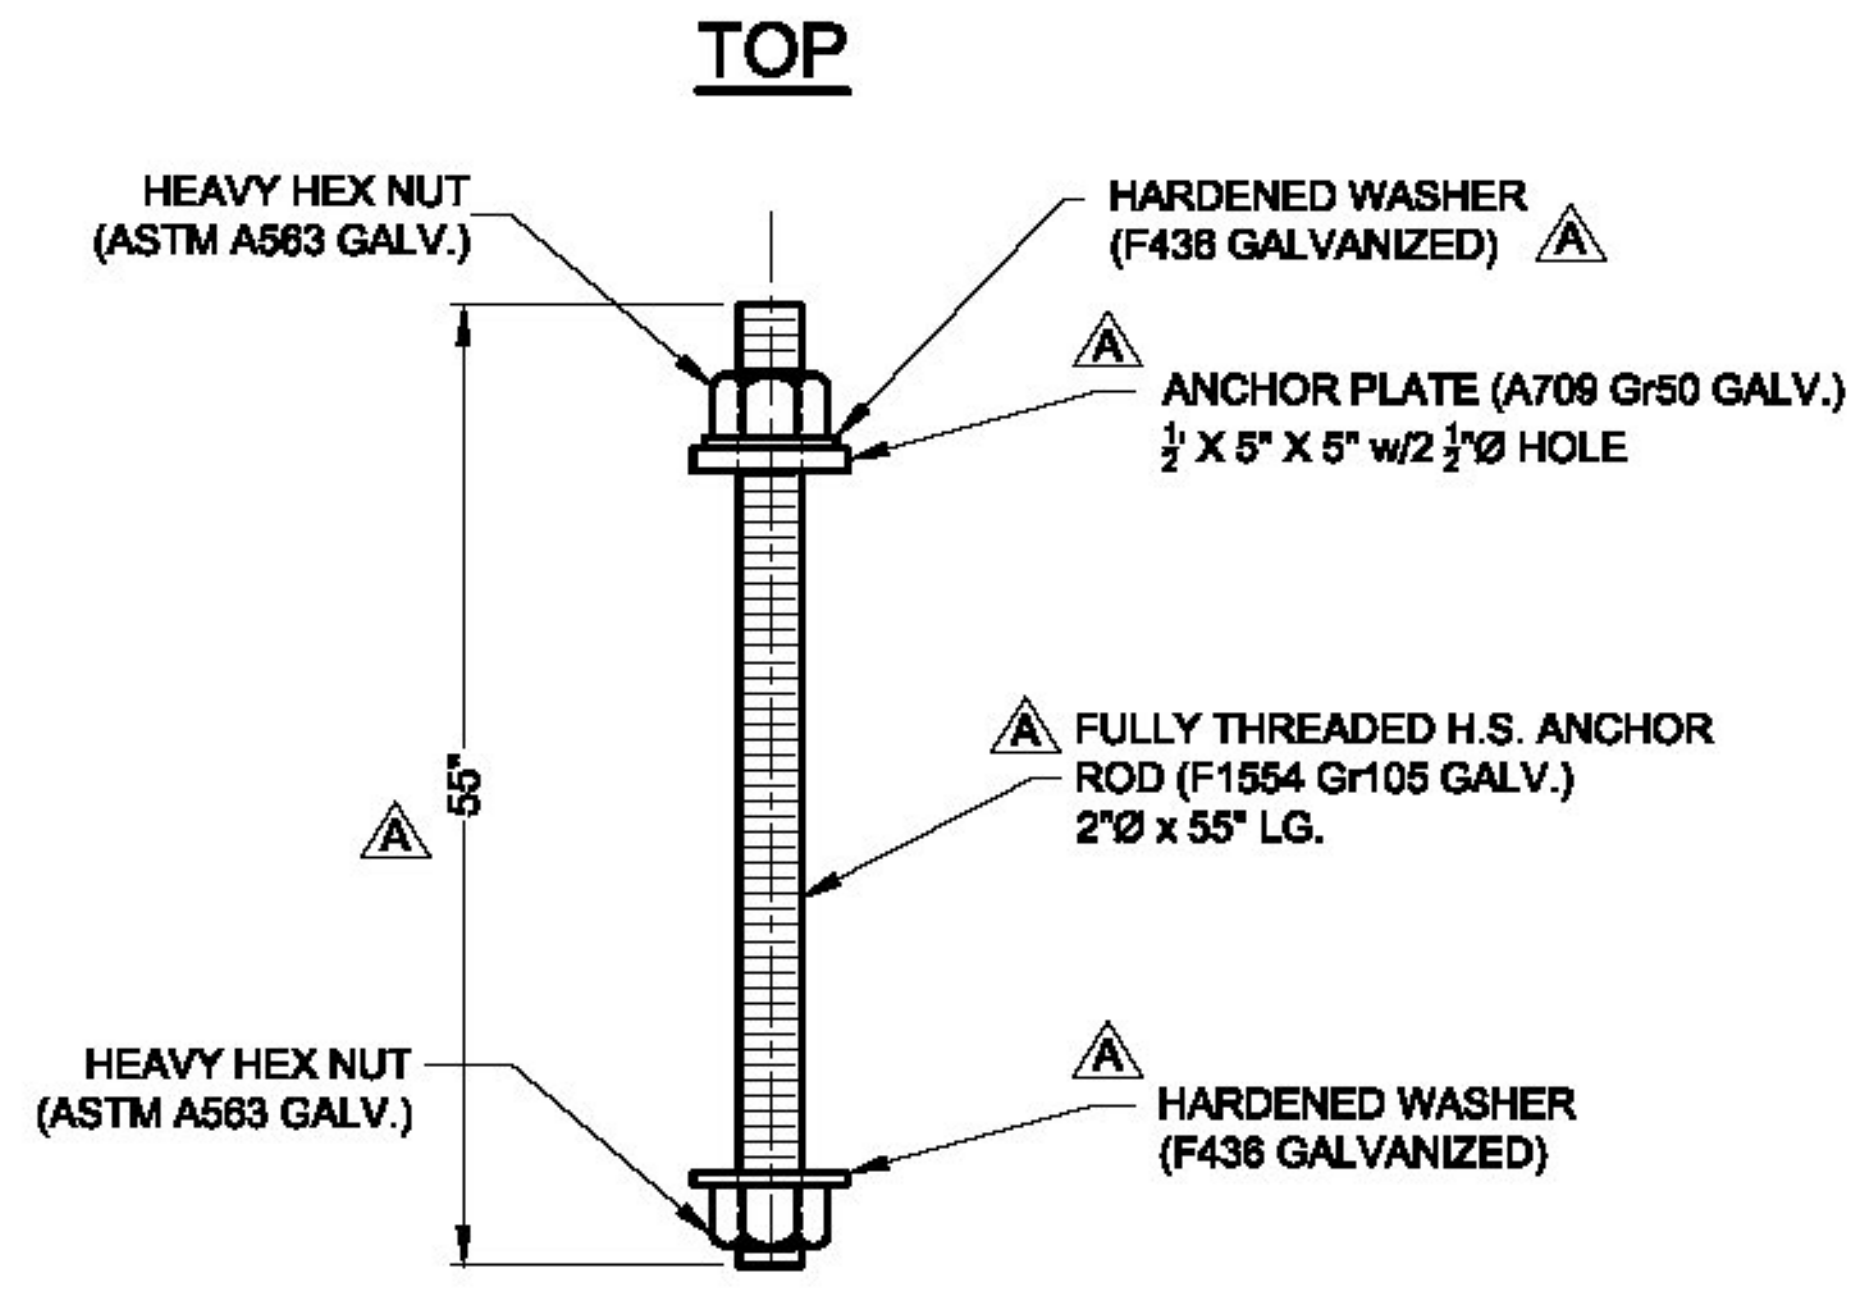

**ANCHOR BOLT DETAIL**

QTY. REQ'D = 16 ASSY.

AT PILE CAVITY LOCATIONS ONLY

<b>Inspection Block</b>
<b>Initial Dim. Check</b> Sign: _____ Date: _____
<b>In Process Dim. Chk.</b> Sign: _____ Date: _____
<b>100% Visual Weld Insp.</b> Sign: _____ Date: _____
<b>Paint Insp.(see form)</b> Sign: _____ Date: _____
<b>Final Inspection</b> Sign: _____ Date: _____

FAIRFIELD BRO 1448(41) VERMONT AGENCY OF TRANSPORTATION		
FEDERAL PROJECT NO. :		
CONTRACT NO. :	PIN NO. :	
ELASTOMERIC PAD, SHIM & ANCHOR BOLT DETAILS		
<b>AMSCOT</b> STRUCTURAL PRODUCTS CORP.		
SCALE: N.T.S.	APPRVD: BF	DRAWN BY: E.J.G.
DATE: 1/13/15	REVISION: O	
FOR: AL. ST. ONGE		
DWG NO: ASO15A2RO		SHEET 2 OF 2


Vermont Agency of Transportation  
**RECEIVED**  
CK'D BY RK OK'D BY RY  
January 29, 2015  
RESUBMIT No Approved  
BY RY DATE 02/10/2015

SIA. 19+59.00  
CL. BRG  
ABUT #1

SIA. 19+63.15  
PT. CURVE #2  
60'R @ CL ROADWAY




PLAN VIEW

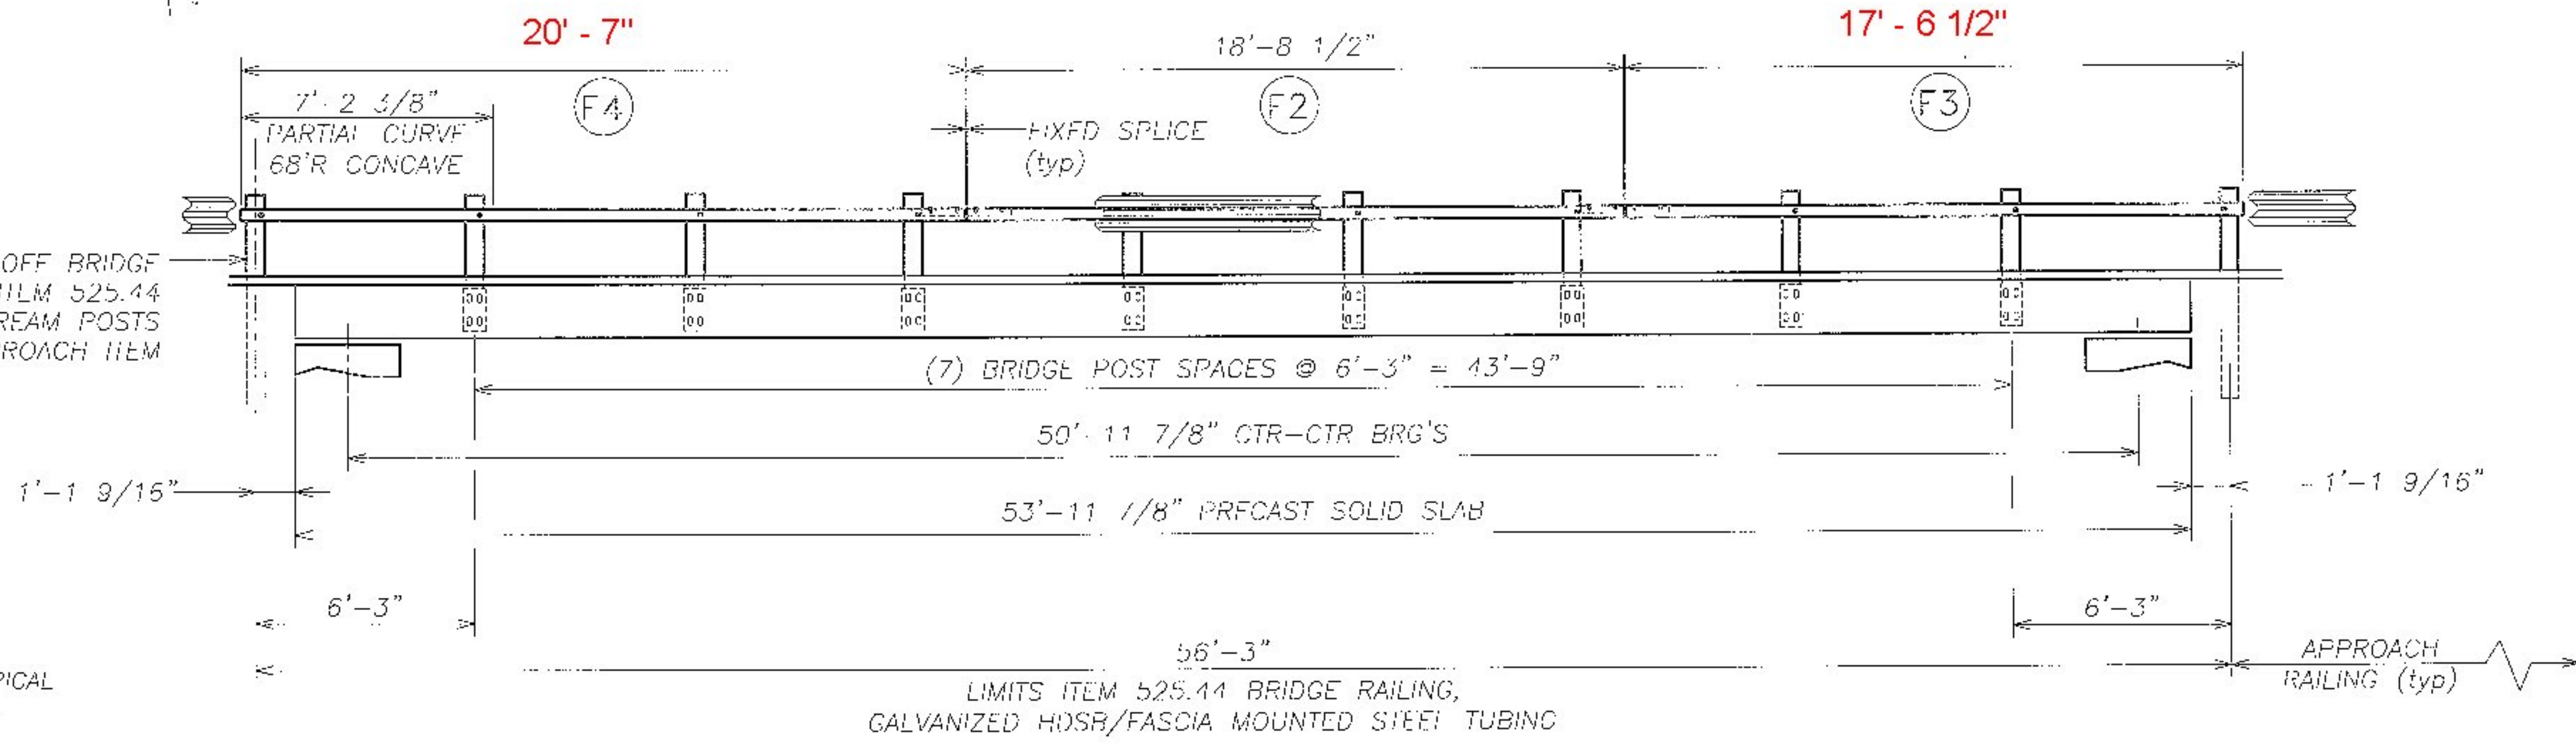

NORTHEAST RAILING ELEVATION  
BRIDGE NO. 46

LOOKING AT FACE OF RAIL FROM CENTERLINE OF ROAD  
PORTIONS OF HDSB W-BEAM RAIL AND TUBULAR BLOCKS HAVE BEEN REMOVED FROM THIS VIEW FOR CLARITY

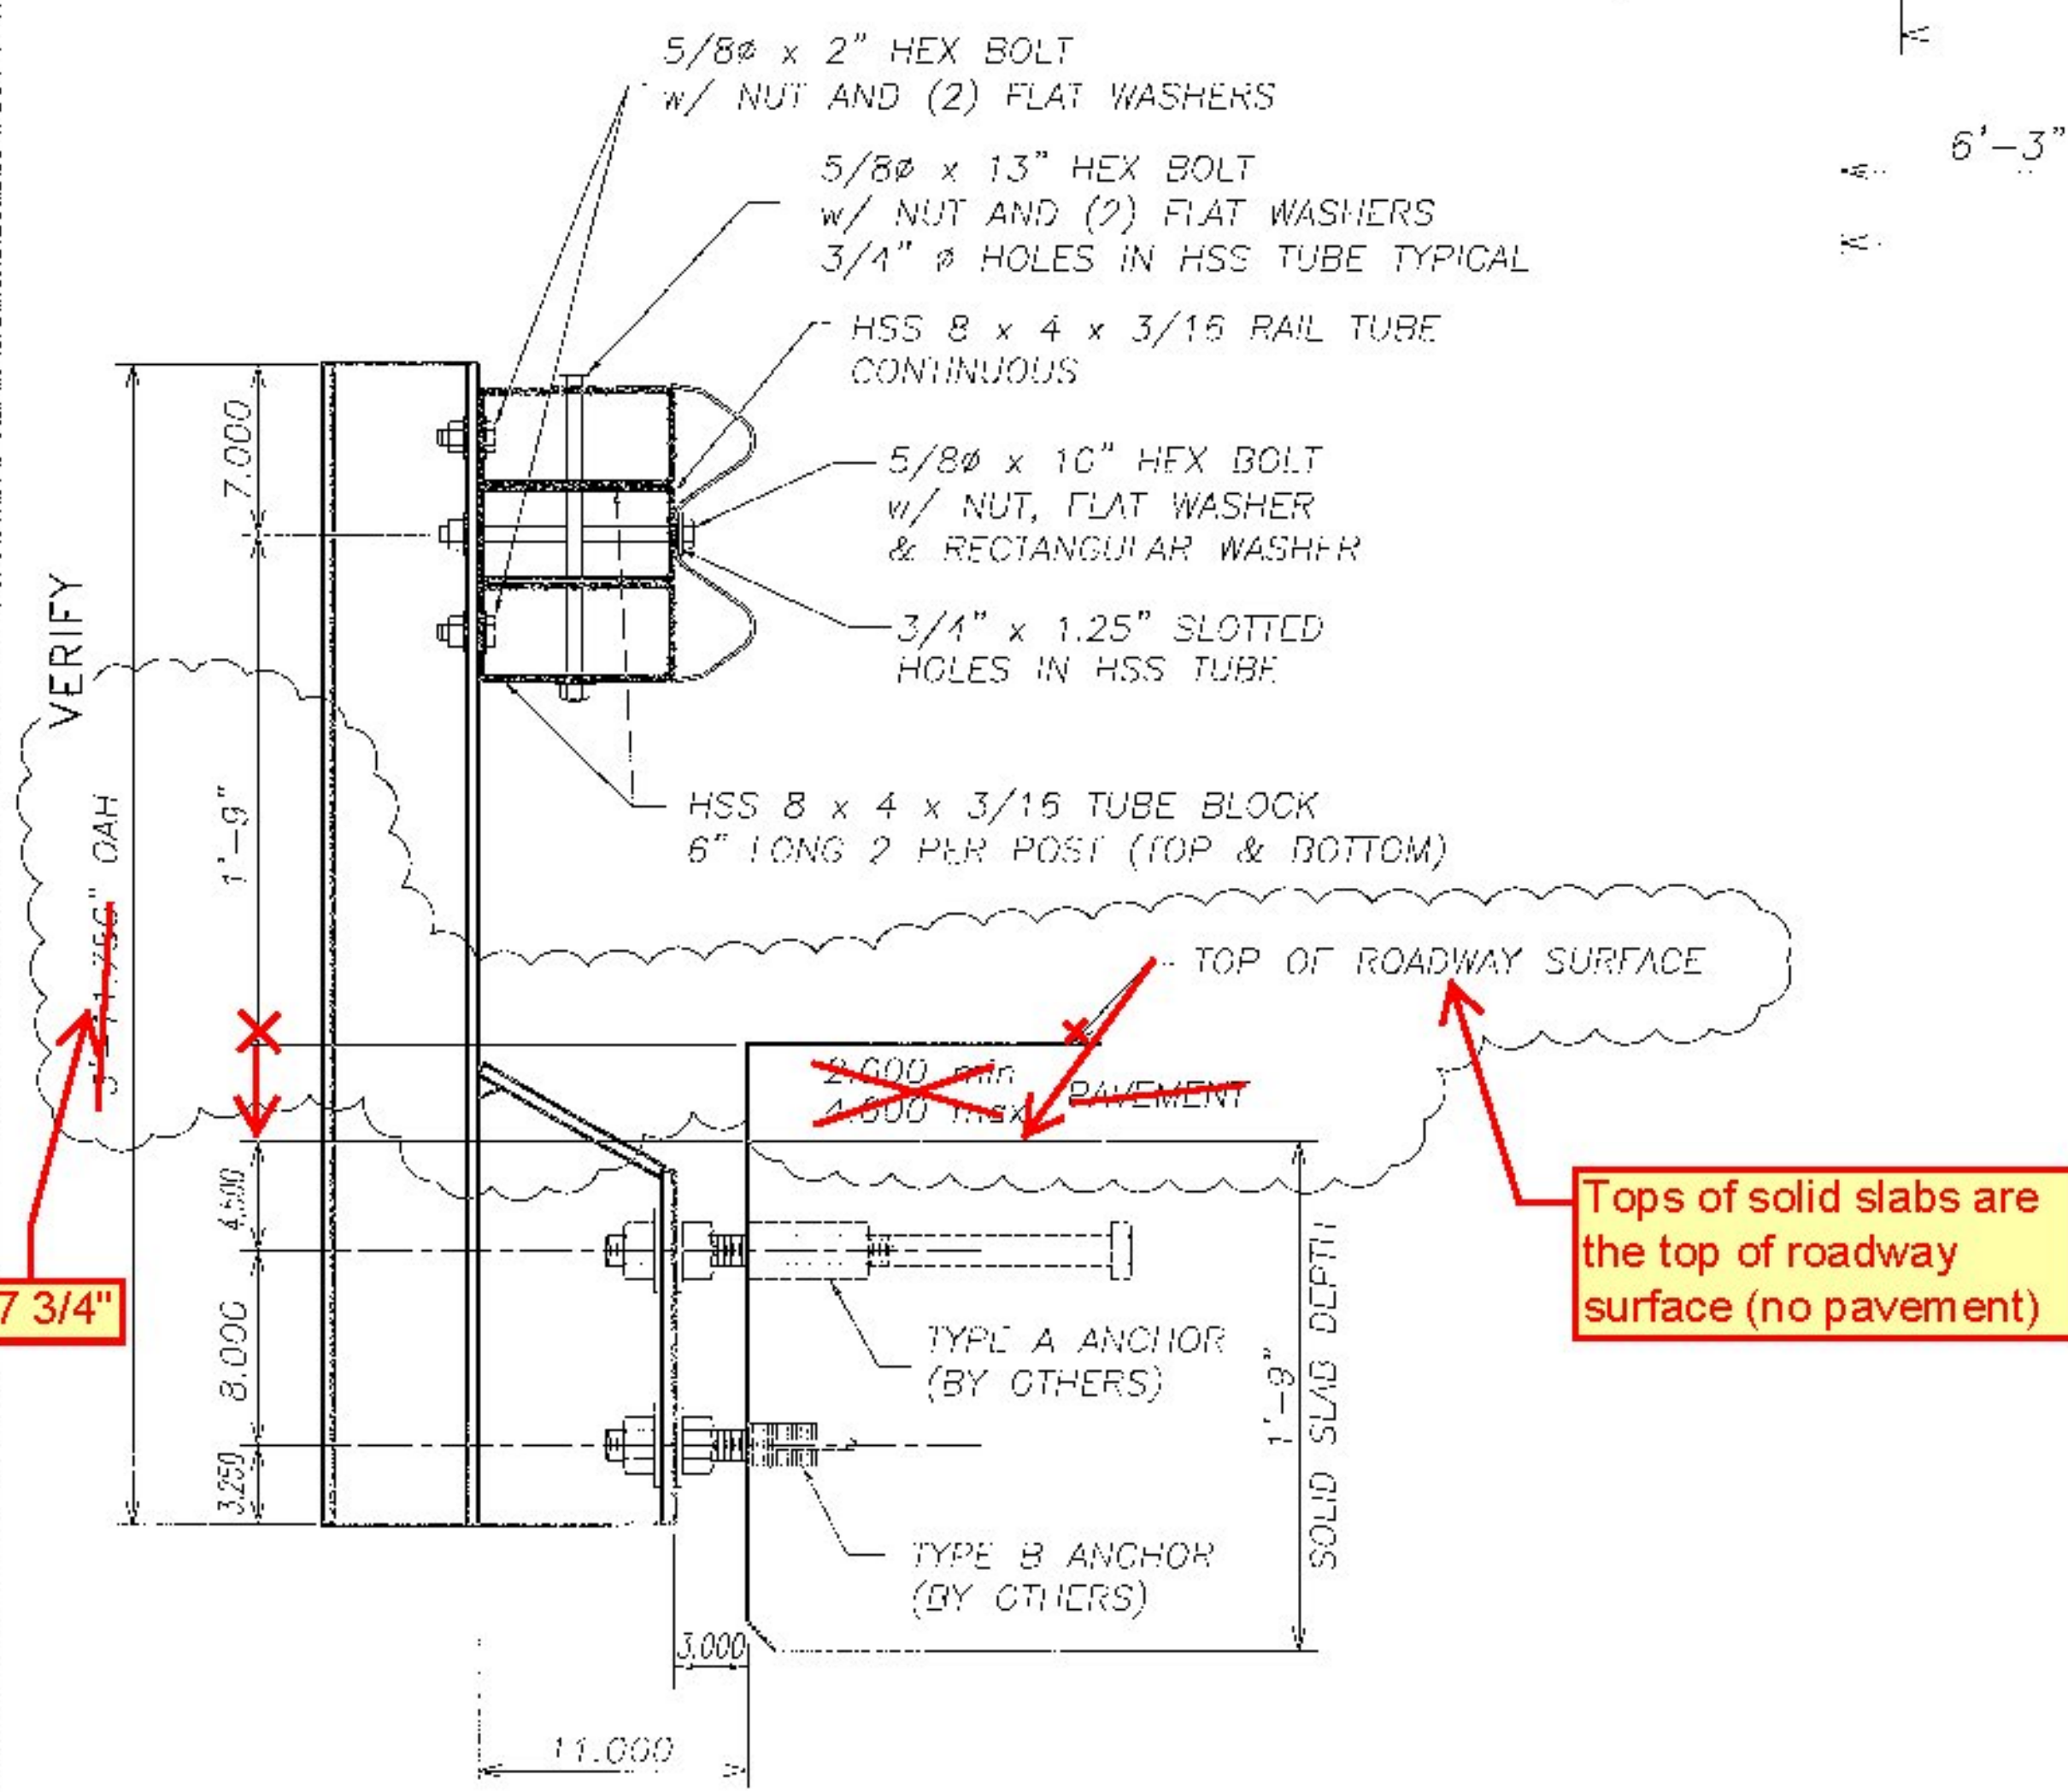


SECTION  
THRU RAILING

No.	Remarks	Date
0	Initial submittal	
REVISIONS		

Vermont Agency of Transportation  
**RECEIVED**  
CK'D BY RK/JC OK'D BY RY  
February 20, 2015  
RESUBMIT No Approved AsNoted  
BY RY DATE 03/09/2015

**HIGHWAY SAFETY CORP**  
GLASTONBURY, CT  
860-633-9445  
ITEM 525.44 BRIDGE RAILING  
GALVANIZED FASCIA MOUNTED HDSB STEEL TUBE  
BRIDGE NO. 46 ELM BROOK TH 47 BRD 1448(4)  
FAIRFIELD VERMONT  
2031  
1 of 3

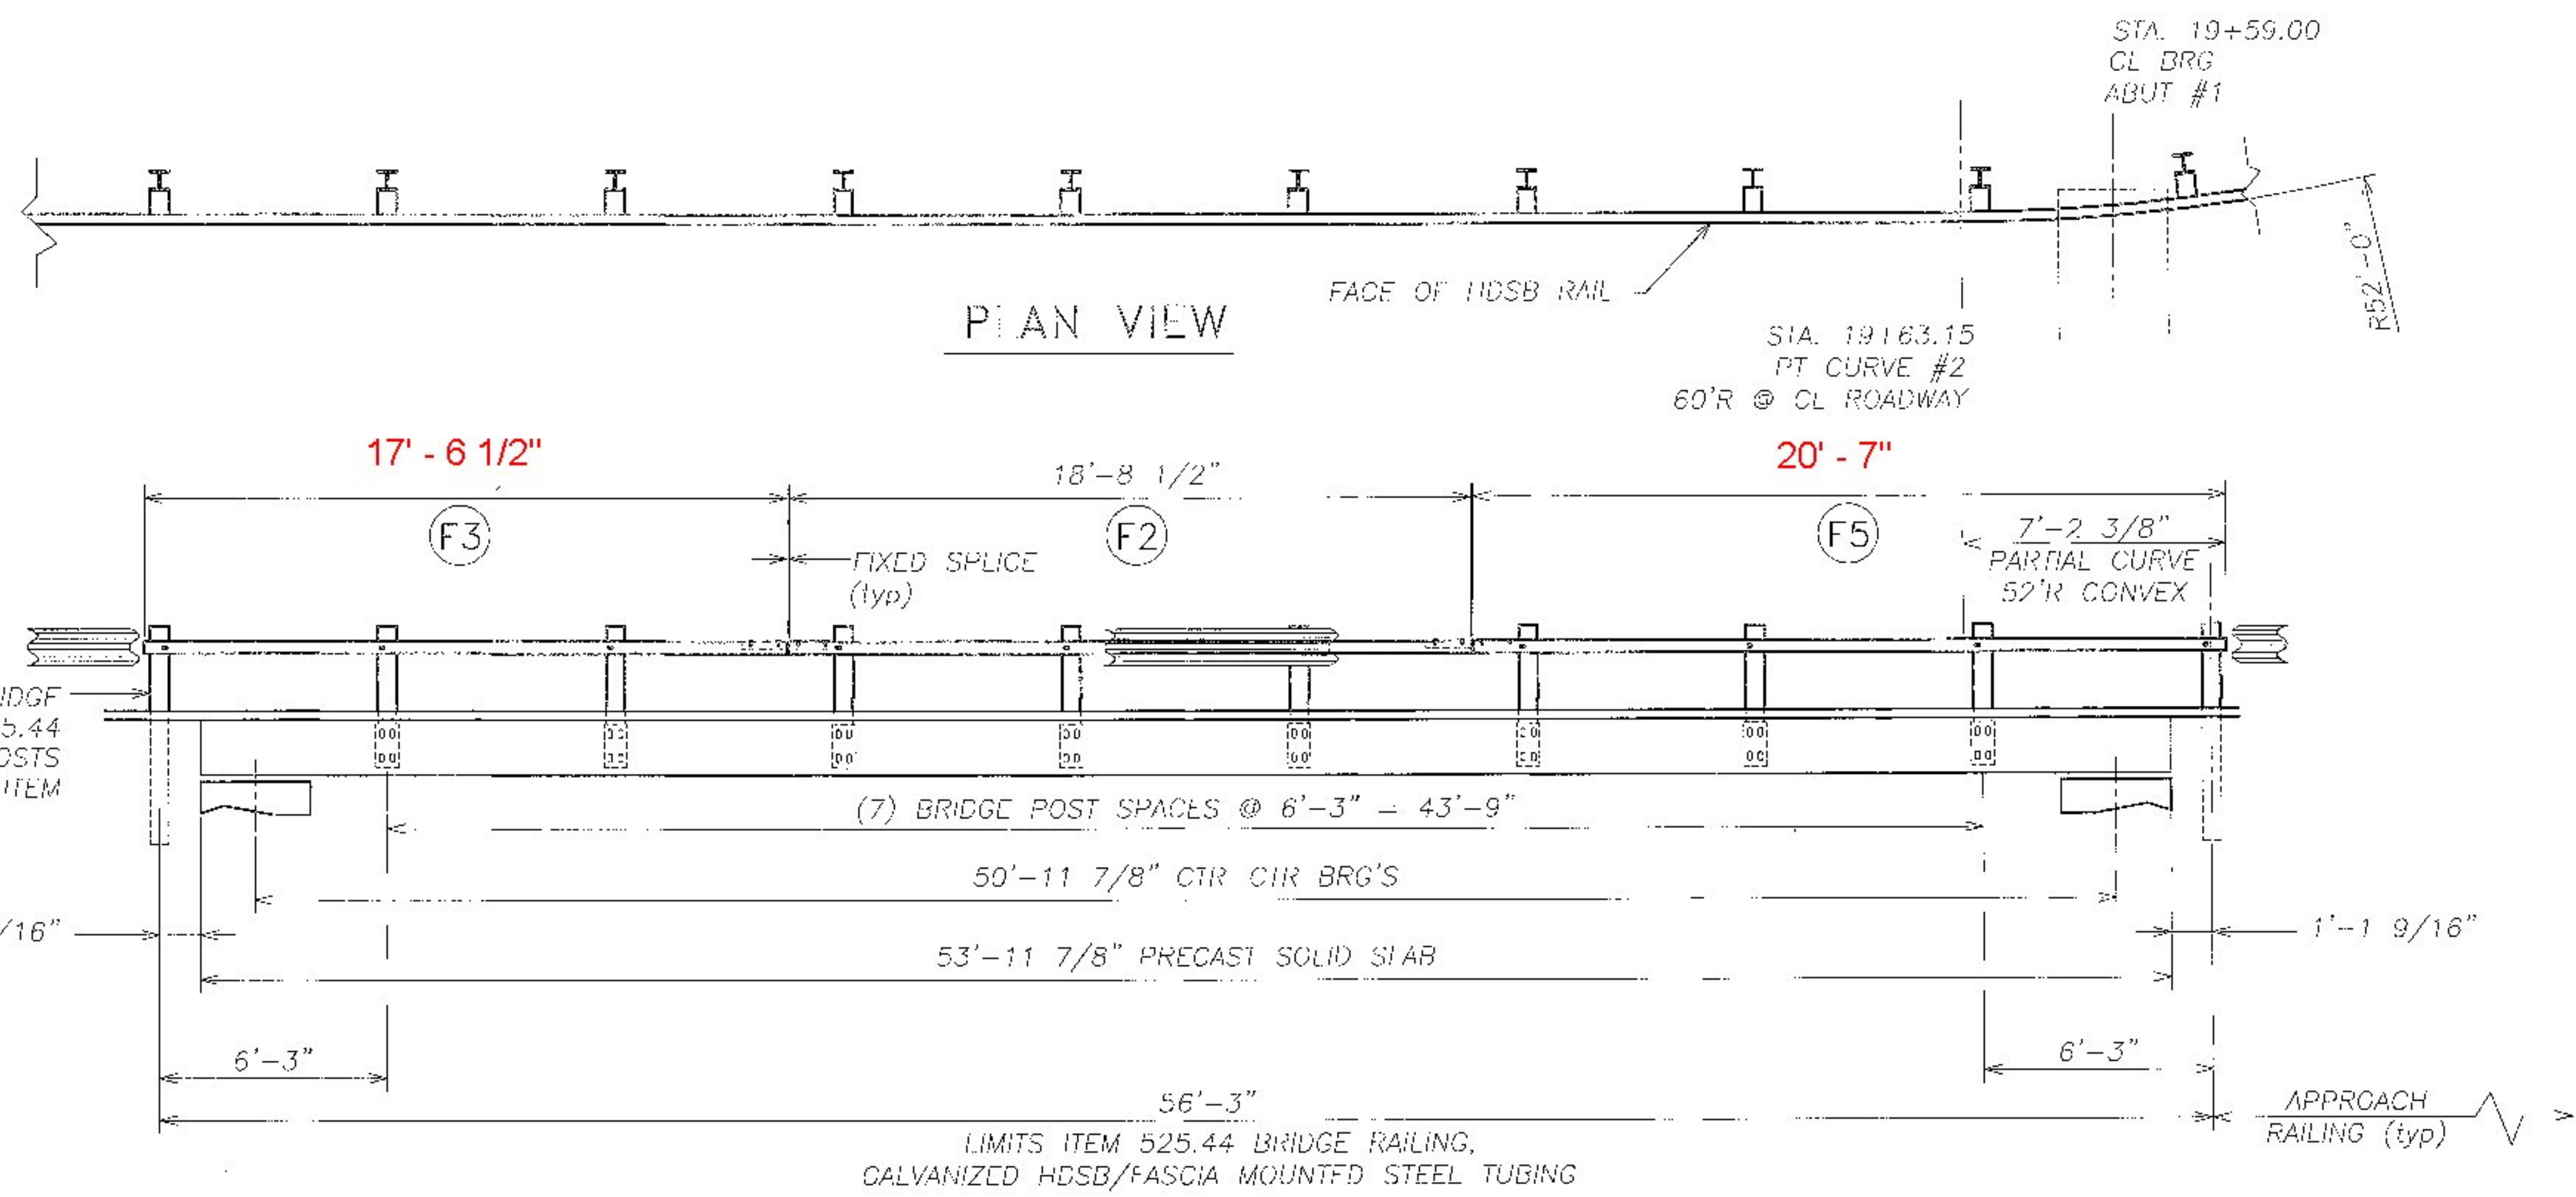

**BILL OF MATERIAL**

CIAL. PAY LENGTH ITEM 525.44 (BRIDGE 46) = 112.5 LF

Qty	mk	Description	Spec.
16		W6x25 FASCIA MOUNTED POST 47.750' OAL w/ WELDED OFFSET PLATES (GLV)	A572 gr 50
16		PL 0.500 x 7.500 x 8.500 (WELDED TO POST)	A572 gr 50
16		PL 0.500 x 7.500 x 14.500 (WELDED TO POST)	A572 gr 50
16		PL 0.500 x 7.500 x 17.937 (WELDED TO POST)	A572 gr 50
4		W6x25 DRIVEN POST #1 x 6 FT LONG (GLV)	A572 gr 50
40		TUBE BLOCK HSS 8 x 4 x 3/16 x 6.000' LG (GLV)	A500 gr B
8		HDSB W-BEAM PANEL 10 GA 12'-8" LG X 6'-3" SP (GALV)	M180 B2
1		HDSB W-BEAM PANEL 10 GA 6'-3" LG X 6'-3" SP (GALV) shop curve 52'R convex	M180 B2
1		HDSB W-BEAM PANEL 10 GA 6'-3" LG X 6'-3" SP (GALV) shop curve 68'R concave	M180 B2
4		SPLICE CHANNEL C7 X 9.8 x 2'-6.500" w/ (4) TACKWELDED HEX NUTS (GALV)	A572 gr 50
2	F2	TUBULAR STEEL RAIL (GLV) HSS 8 x 4 x 3/16 x 18'-8.500" OAL	A500 gr B
2	F3	TUBULAR STEEL RAIL (GLV) HSS 8 x 4 x 3/16 x 17'-6.500" OAL	A500 gr B
1	F4	TUBULAR STEEL RAIL (GLV) HSS 8 x 4 x 3/16 x 20'-7.000" OAL (partial curve 68'R concave)	A500 gr B
1	F5	TUBULAR STEEL RAIL (GLV) HSS 8 x 4 x 3/16 x 20'-7.000" OAL (partial curve 52'R convex)	A500 gr B
20		RECTANGULAR WASHER 0.1875" x 1.75" x 3.00" (GLV)	A572 GR 50
20		HEX HEAD BOLT 5/8" DIA x 13" LG HDG	A325
20		HEX HEAD BOLT 5/8" DIA x 10" LG HDG	A325
56		HEX HEAD BOLT 5/8" DIA x 2" LG HDG	A325
80		HEX NUT 5/8" HDG	A563 DH
156		ROUND WASHER SMALL FLAT 5/8" HDG	F436
80		PANEL SPLICE BOLT 5/8" x 1.25" HDG	A307
80		DOUBLE RECESS. NUT 5/8" HDG	A563 A

**SOUTHWEST RAILING ELEVATION  
BRIDGE NO. 46**

LOOKING AT FACE OF RAIL FROM CENTERLINE OF ROAD

PORTIONS OF HDSB W-BEAM RAIL AND TUBULAR BLOCKS HAVE BEEN REMOVED FROM THIS VIEW FOR CLARITY

Vermont Agency of Transportation  
**RECEIVED**  
CK'D BY RK/JC OK'D BY RY  
February 20, 2015  
RESUBMIT No Approved AsNoted  
BY RY DATE 03/09/2015


**HIGHWAY SAFETY CORP**  
GLASTONBURY, CT  
860-633-9445

ITEM 525.44 BRIDGE RAILING  
GALVANIZED FASCIA MOUNTED HDSB STEEL TUBE


BRIDGE NO. 46 ELM BROOK TH 47 BRO 1448(41)  
FAIRFIELD VERMONT

CERTIFIED FABRICATOR  
2031


GENERAL CONTRACTOR: LAFAYETTE  
DATE: 02-17-15

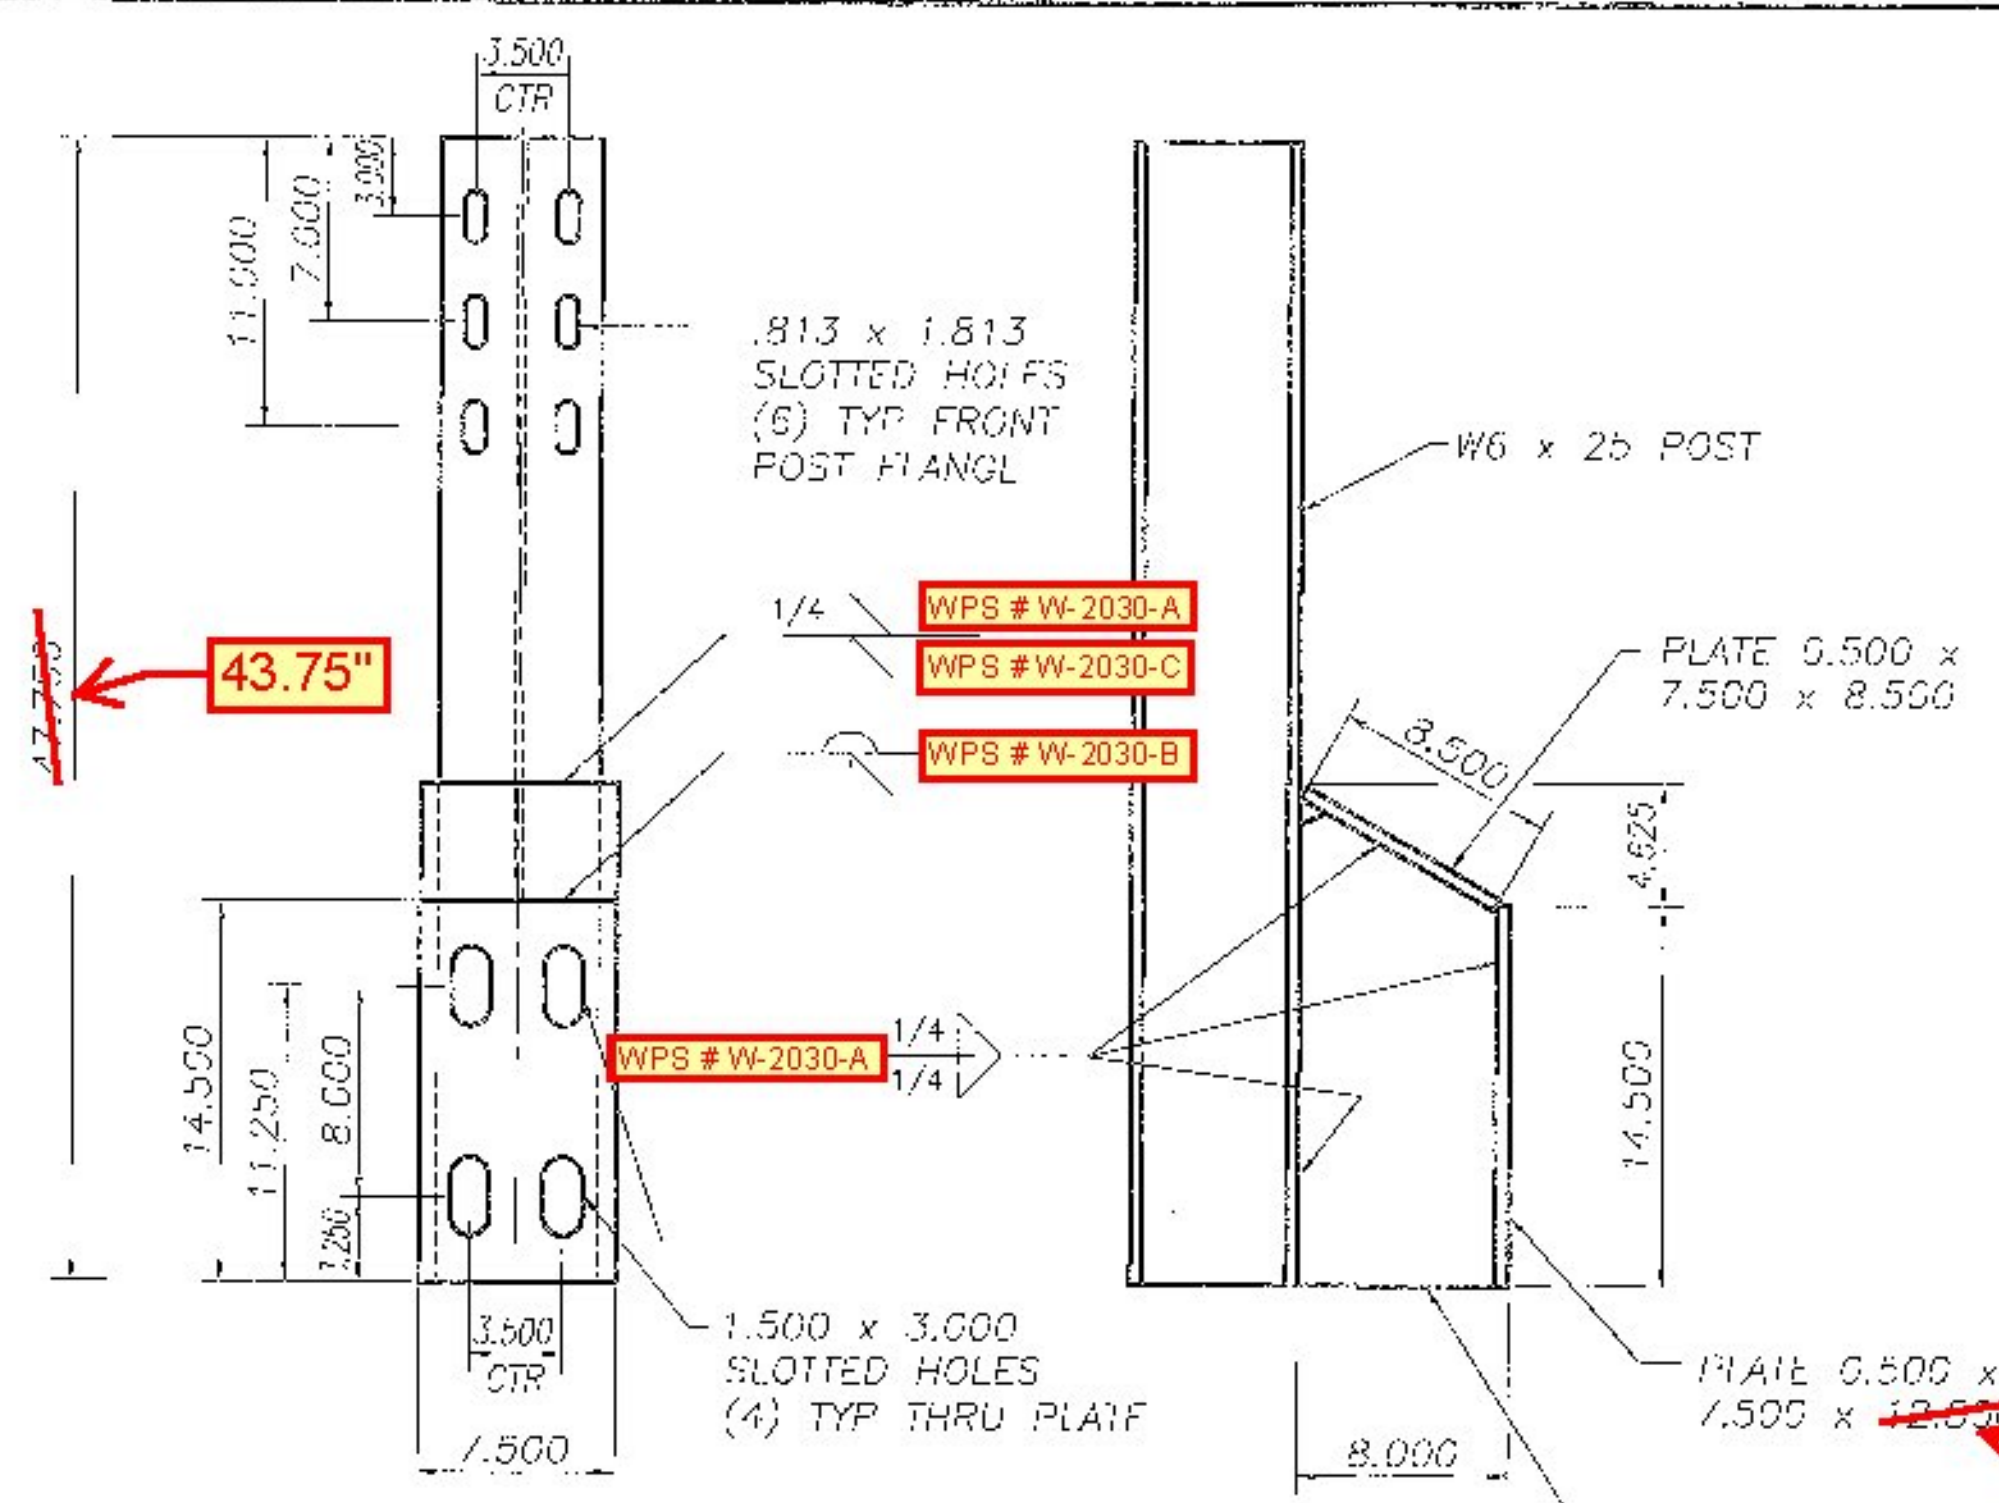


POST DETAIL  
TYPICAL ALL FASCIA POSTS

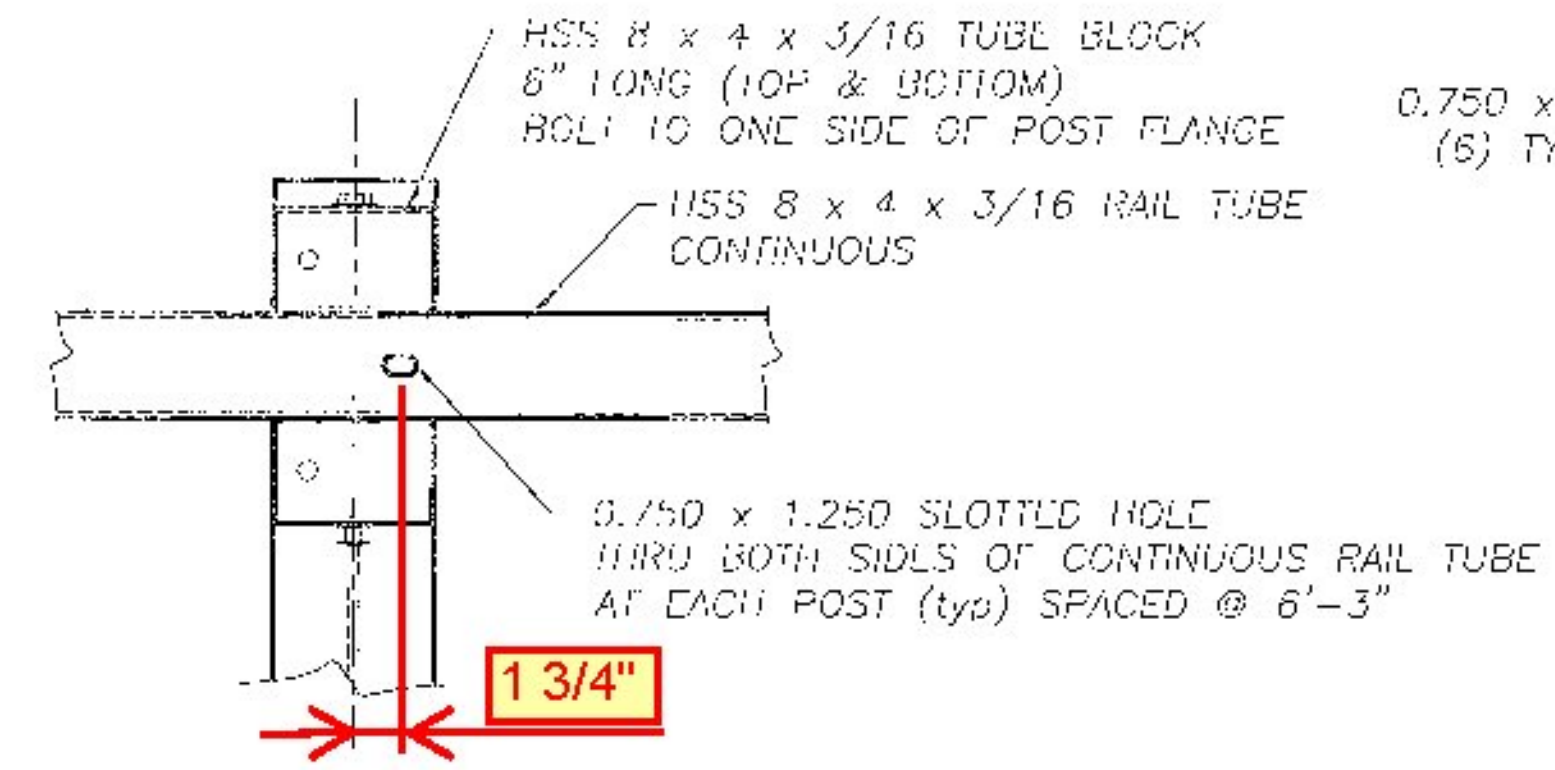

PARTIAL ELEVATION  
SHOWING RAIL AND BLOCK  
ASSEMBLY TO POST  
HSSB RAIL NOT SHOWN FOR CLARITY

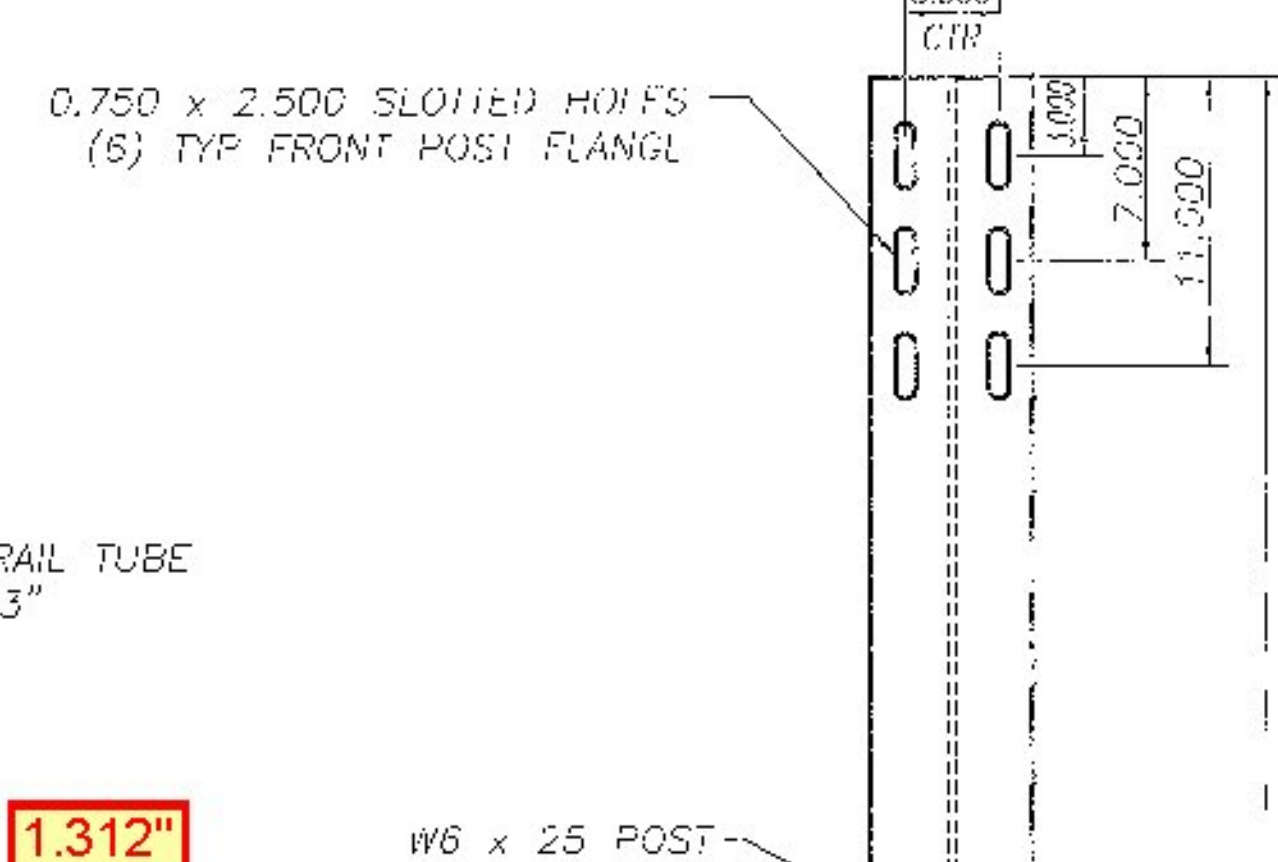


POST ELEVATION  
DRIVEN POST #1

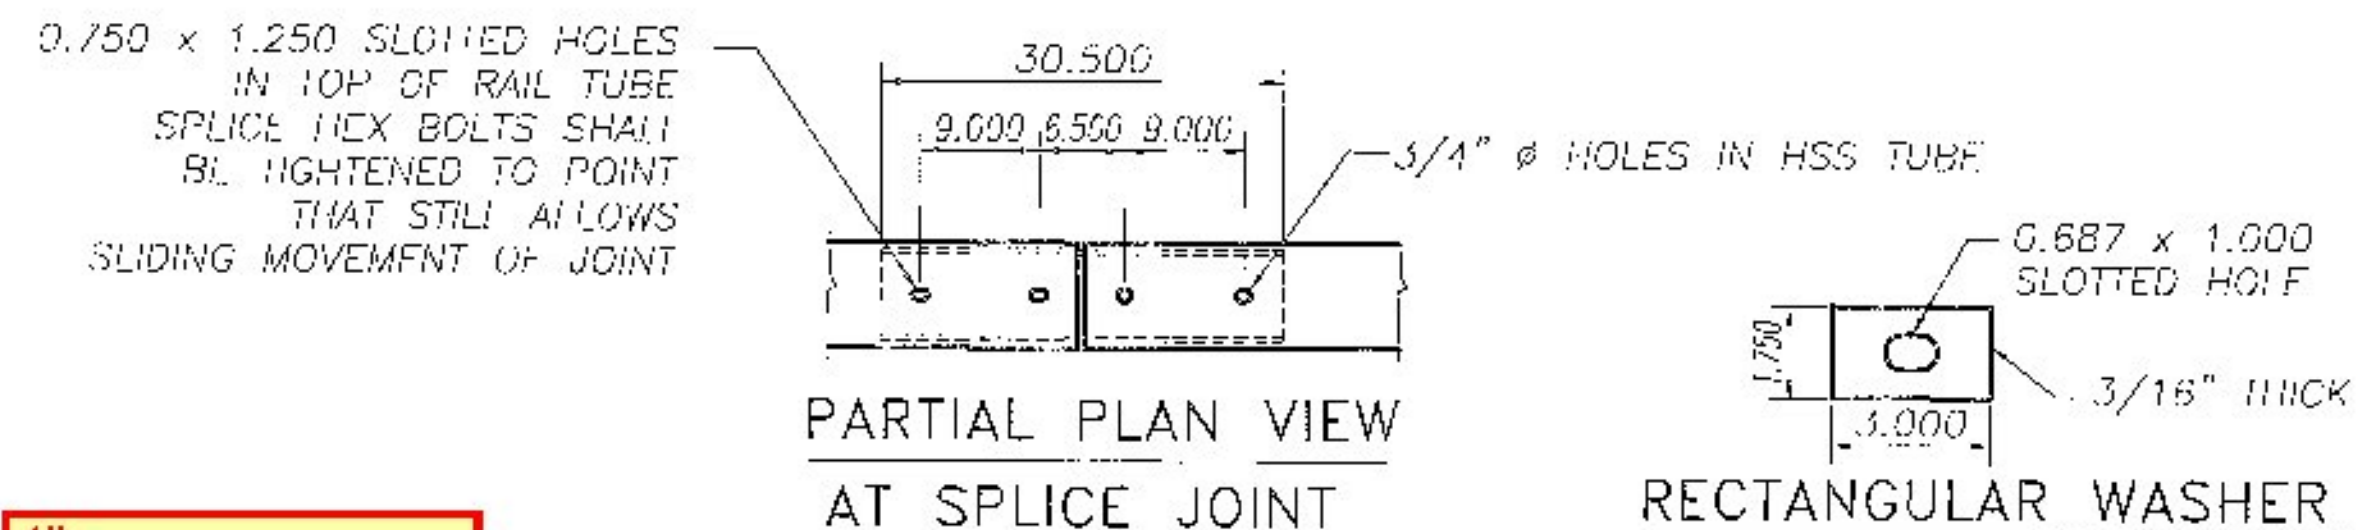


PARTIAL PLAN VIEW  
AT SPLICE JOINT


RECTANGULAR WASHER

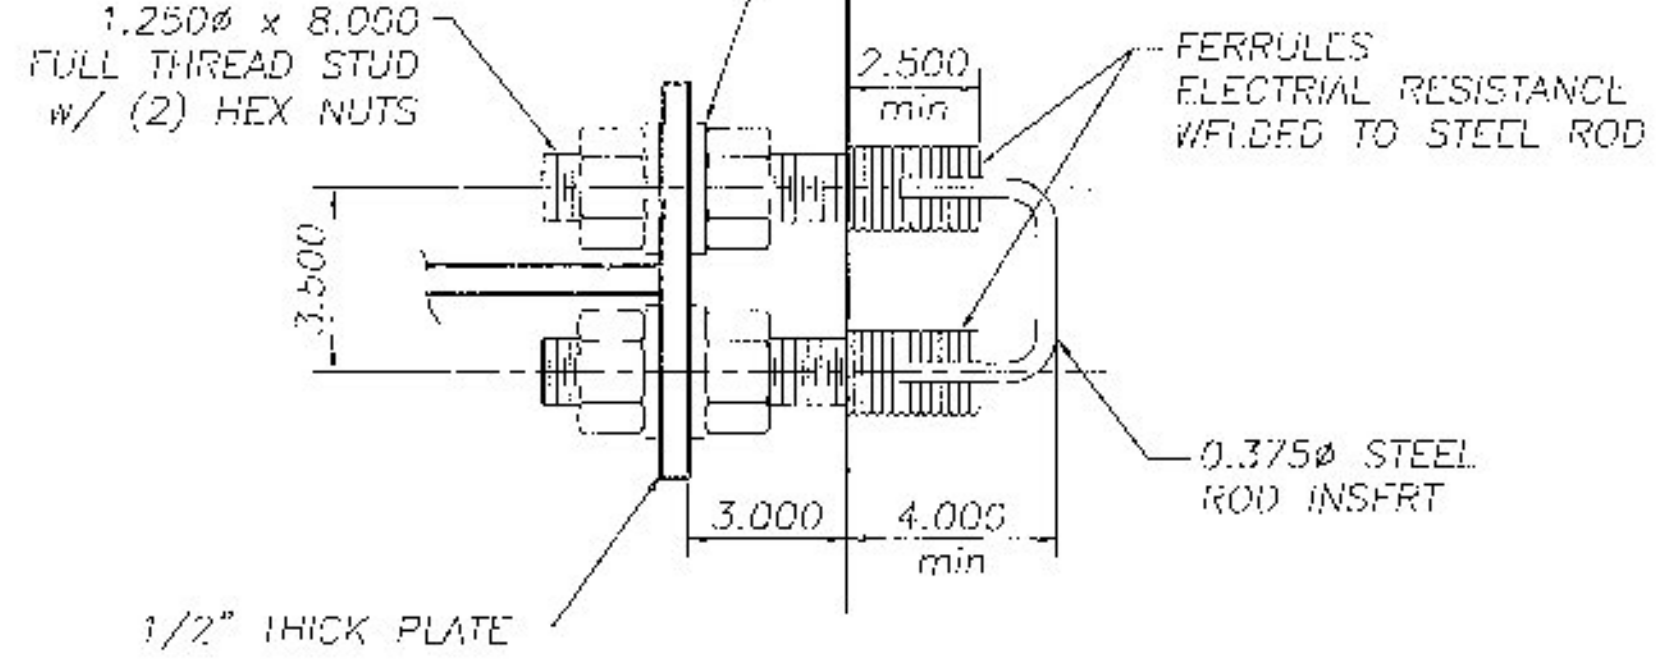


TYPE B ANCHOR ASSEMBLY  
(1) PER POST  
(BY OTHERS)

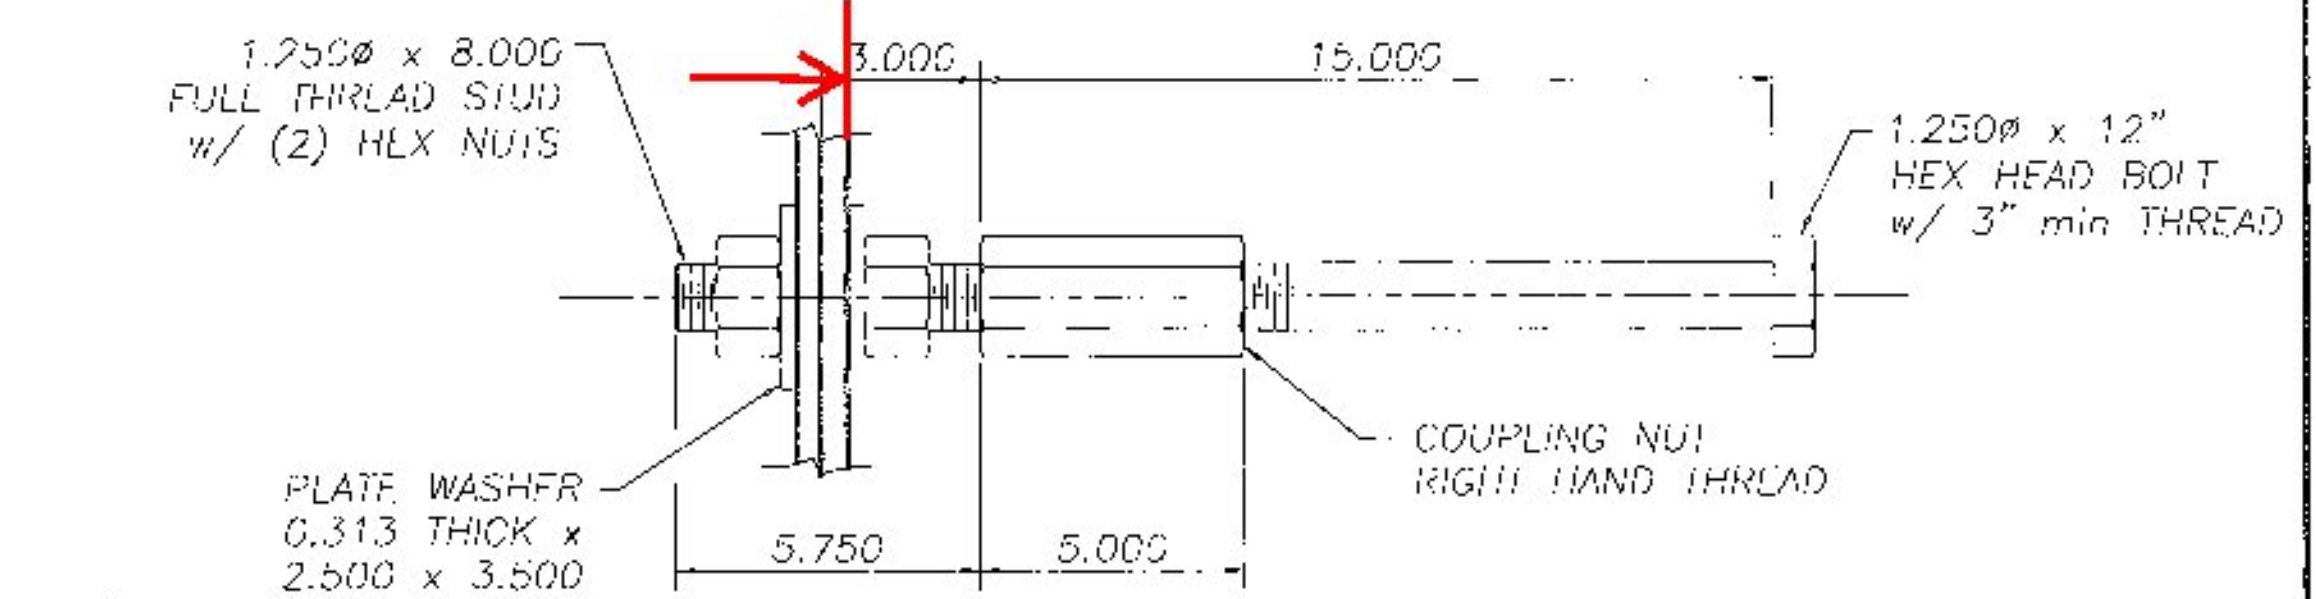


TYPE A ANCHOR ASSEMBLY  
(2) PER POST  
(BY OTHERS)

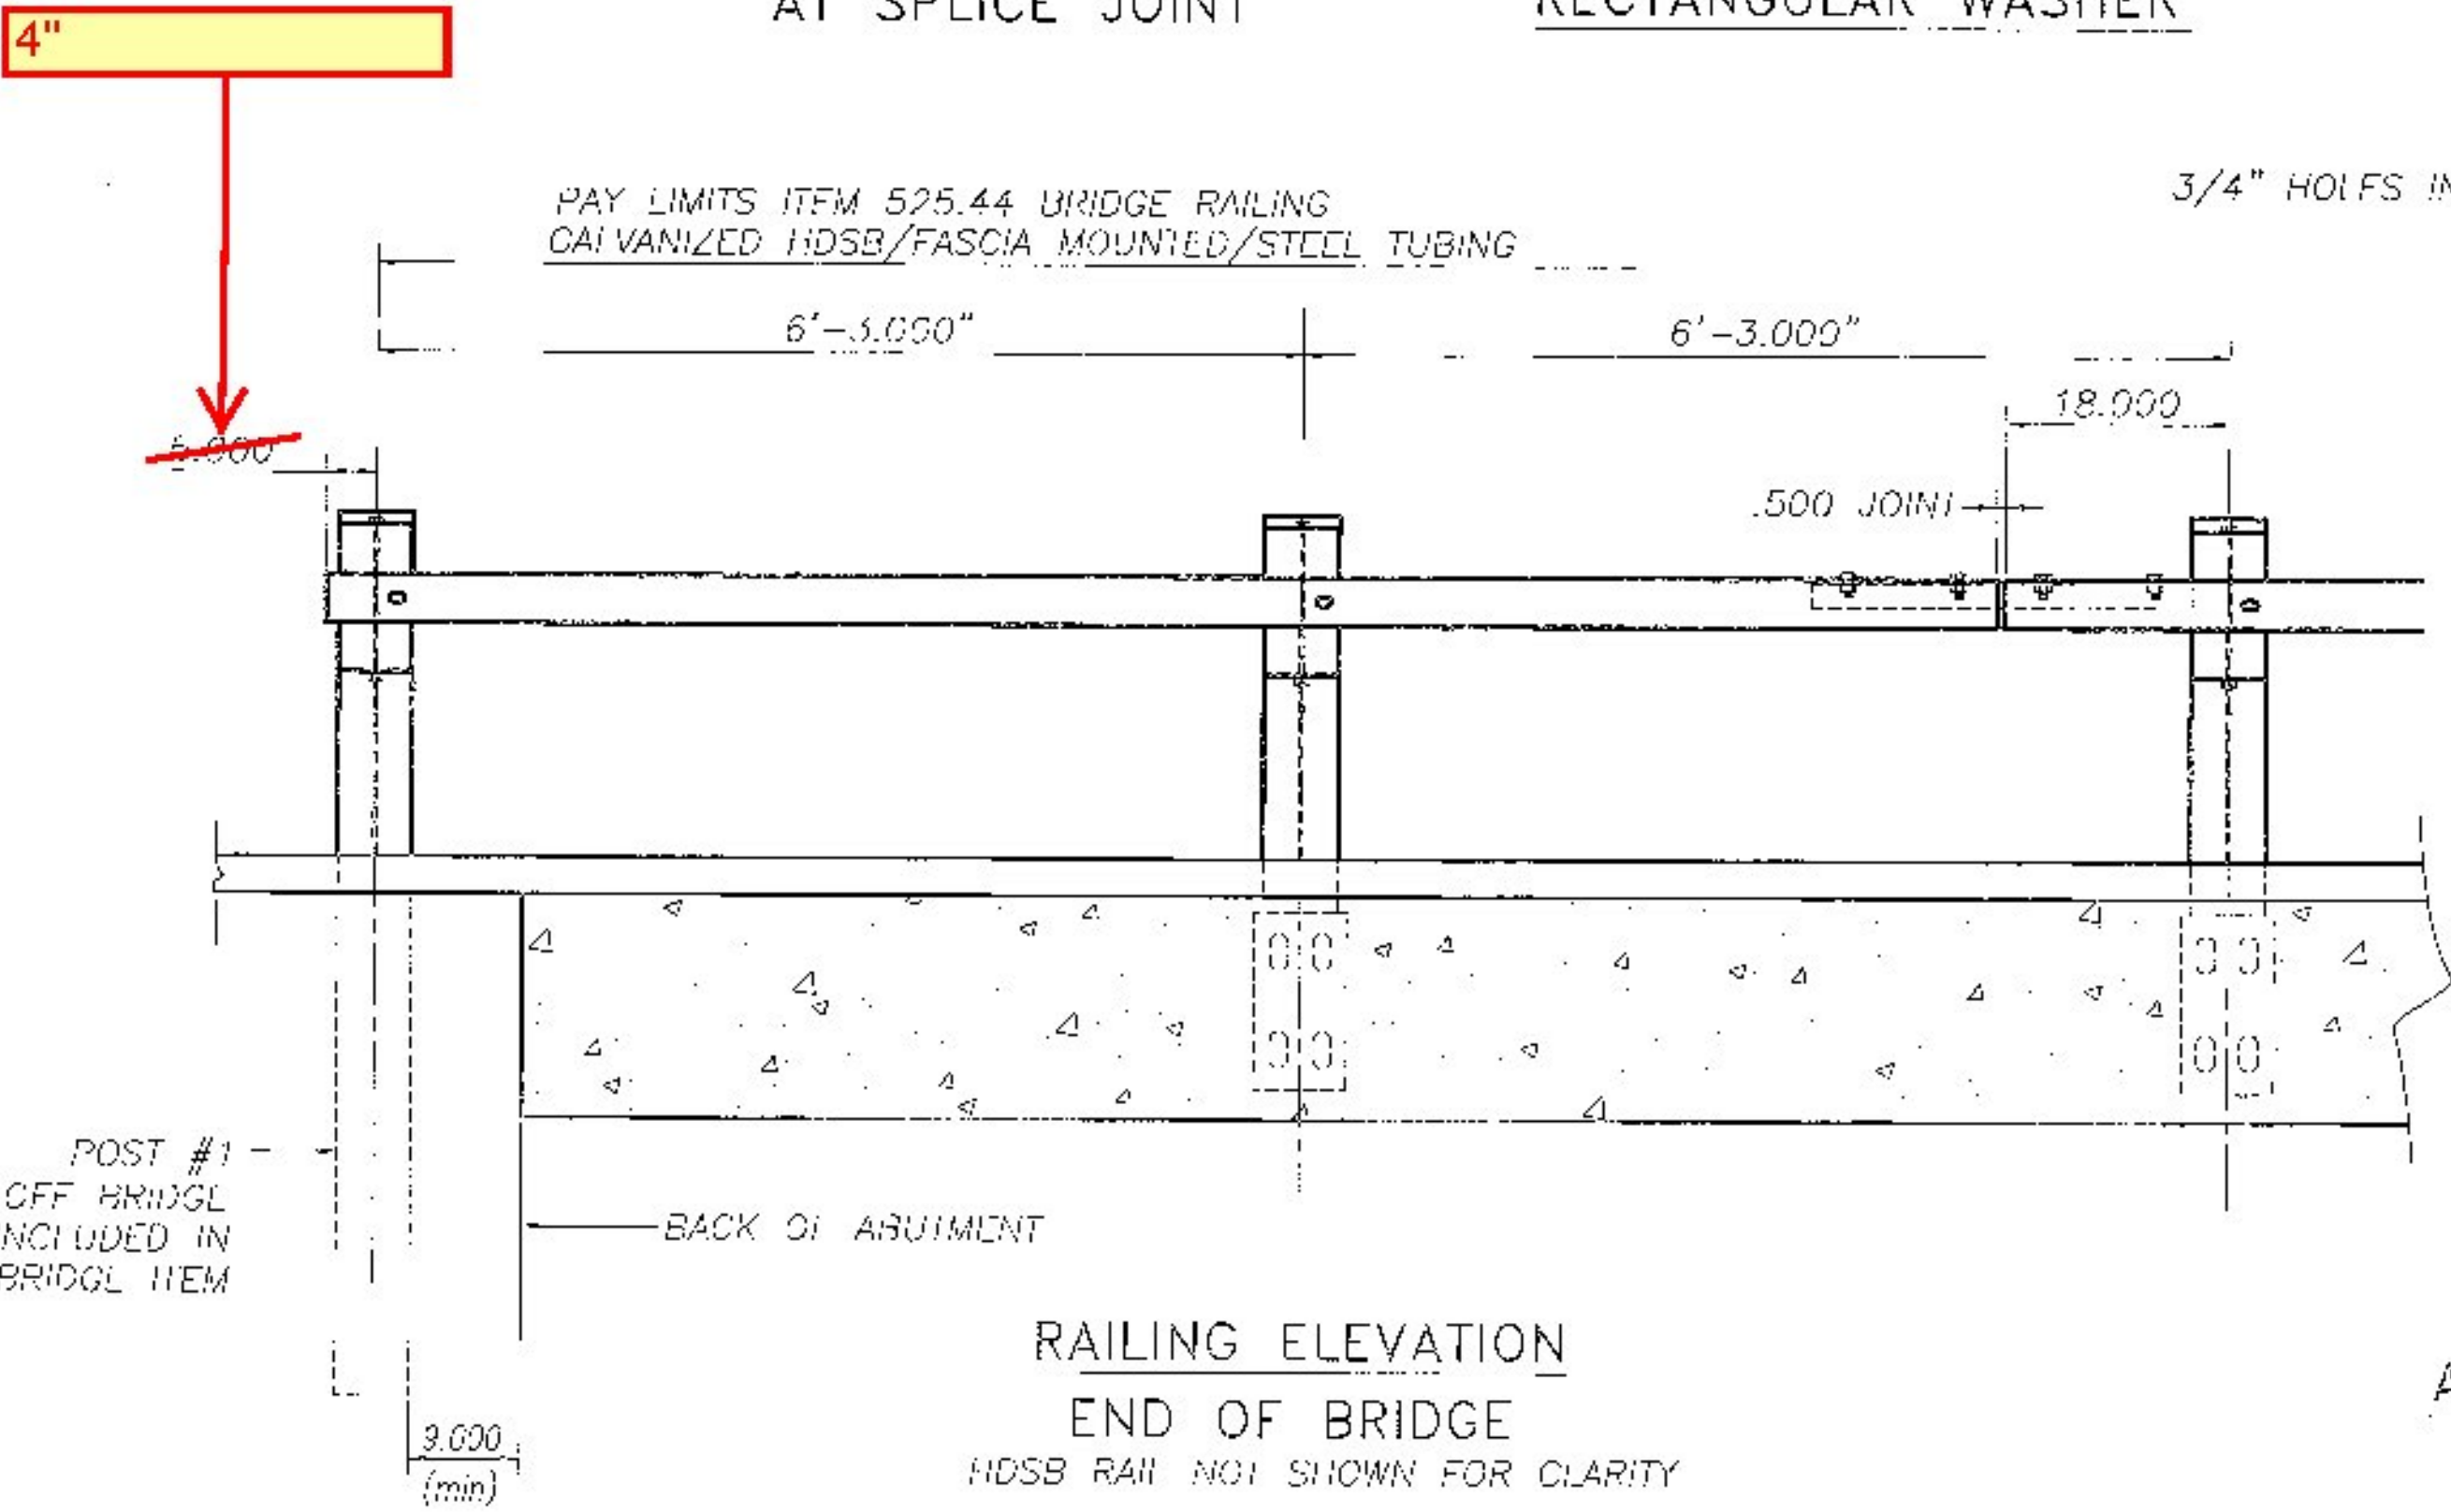

RAILING ELEVATION  
END OF BRIDGE  
HSSB RAIL NOT SHOWN FOR CLARITY

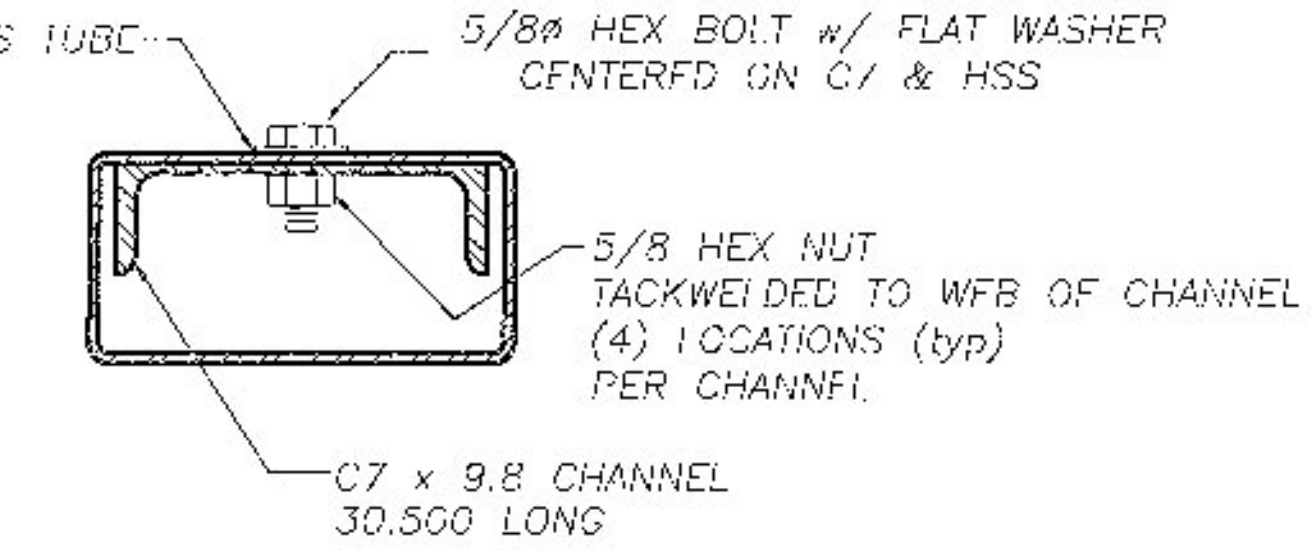

SECTION THRU 8x4 RAIL  
AT SPLICE JOINT

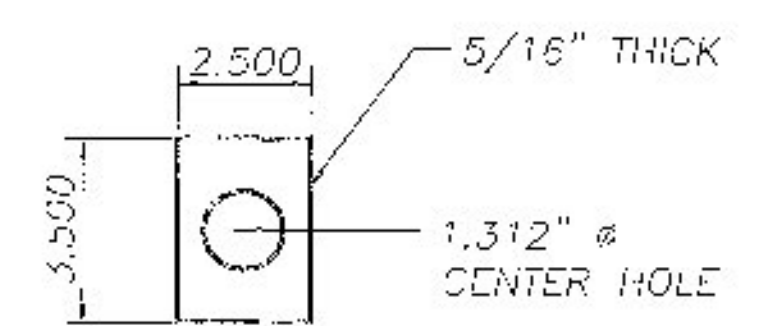

ANCHOR PLATE WASHER  
(BY OTHERS)

- NOTES
1. ALL WORK AND MATERIALS SHALL CONFORM TO SECTION 525
  2. TYPE B ANCHOR INSRTS OF A DIFFERENT TYPE MAY BE PROVIDED, IF APPROVED BY THE ENGINEER
  3. PRIOR TO GALVANIZING THE ASSMBLED POST, GRIND ALL EDGES TO A MINIMUM 1/16" RADIUS
  4. ALL POSTS SHALL BE SET NORMAL TO GRADE
  5. SPLICES FOR THE STEEL BEAM GUARDRAIL SHALL LAP IN THE DIRECTION OF TRAFFIC
  6. A RAILING JOINT SPLICE SHALL BE PROVIDED IN ANY RAIL BAY SPANNING THE END OF AN INTEGRAL ABUTMENT BRIDGE AND AT ALL SUPERSTRUCTURE EXPANSION JOINTS
  7. SEE VDOT STANDARD DRAWING G-1 FOR DETAILS OF DELINEATORS. A DELINEATOR SHALL BE INSTALLED AT 30 FT SPACING OR THE NEAREST POST, WHICH IS TO BE INSTALLED ON THE DRIVERS RIGHT, FOR ONE WAY BRIDGES, YELLOW IS TO BE INSTALLED ON THE DRIVERS LEFT, DELINEATORS PROVIDED BY OTHERS.
  8. FOR RADIUS LESS THAN 950 FEET, HSS 8 X 4 TUBES SHALL BE SHOP BENT TO FIT THE APPLICABLE CURVE
  9. THE MINIMUM DISTANCE FROM THE LAST POST TO THE END OF SLAB IS 1' 6"
  10. FERRULES SHALL BE 12L14 COLD DRAWN CARBON STEEL
  11. HOLES IN THE RAIL FOR RAIL TUBE ATTACHMENT MAY BE FIELD DRILLED. FIELD DRILLED HOLES SHALL BE COATED WITH AN APPROVED ZINC RICH PAINT PRIOR TO INSTALLATION
  12. THIS RAILING MEETS THE REQUIREMENTS FOR A II-2 SERVICE LEVEL.
  13. ALL METAL PARTS SHALL BE HOT DIPPED GALVANIZED.

Vermont Agency of Transportation  
**RECEIVED**  
CK'D BY RK/JC OK'D BY RY  
February 20, 2015  
RESUBMIT No Approved AsNoted  
BY RY DATE 03/09/2015

**HIGHWAY SAFETY CORP**  
GLASTONBURY, CT  
860-633-9445

ITEM 525.44 BRIDGE RAILING  
GALVANIZED FASCIA MOUNTED HSSB STEEL TUBE

BRIDGE NO. 46 ELM BROOK TH 47 BRO 1448(41)  
FAIRFIELD VERMONT

GENERAL CONTRACTOR: LAFAYETTE  
SHEET NO.: 3 of 3

# Highway Safety Corporation

Glastonbury, CT

## Welding Procedure Specification

Material specification ASTM A709 gr 36/gr 50, ASTM A572 gr.36/gr.50, ASTM A36, A500 gr.B  
 Welding process Gas Metal Arc Welding (GMAW) Spray Transfer  
 Manual, semi-automatic, or automatic Semi-Automatic  
 Position of welding Flat (1F) or Horizontal (2F)  
 Filler metal specification AWS A5.18  
 Filler metal classification ER70S-6  
 Electrode and manufacturer Lincoln Electric Lincoln Weld L-56  
 Flux and manufacturer N/A  
 Shielding gas 86% Argon / 14% CO2 Flow rate 35-45 CFM  
 Single or multiple pass Single  
 Single or multiple arc Single  
 Welding current DCEP  
 Polarity Reverse - electrode positive  
 Welding progression Stringers  
 Root treatment clean base metal  
 Preheat and interpass temperature base metal up to 3/4" (50°F)  
 Postheat treatment None  
 Electrode extension 3/4" ± 1/4"

Vermont Agency of Transportation

**RECEIVED**


CK'D BY RK/JC OK'D BY RY

February 20, 2015

RESUBMIT No Approved

BY RY DATE 03/09/2015

### WELDING PROCEDURE

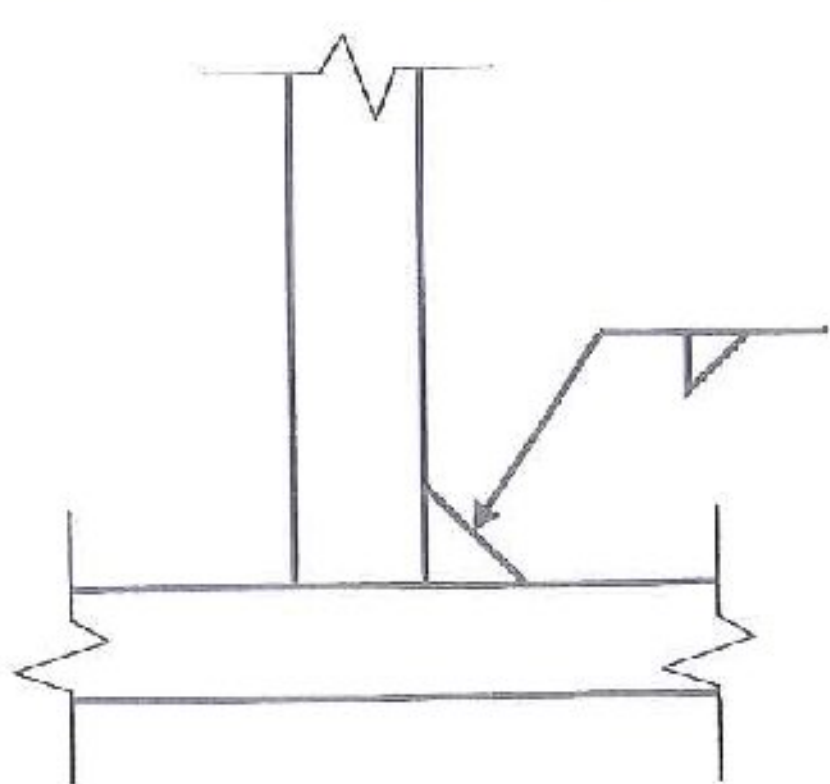Weld size	Pass no.	Electrode size	Welding parameters		Travel speed	Joint detail
			Amperes	Volts		
1/8	1	.063"	300 A ± 30	29 V ± 2	15 ipm ± 2	TYPICAL FILLET WELDS (5/16" MAX) 
3/16	1	.063"	300 A ± 30	29 V ± 2	15 ipm ± 2	
1/4	1	.063"	300 A ± 30	29 V ± 2	15 ipm ± 2	
5/16	1	.063"	300 A ± 30	29 V ± 2	15 ipm ± 2	

This procedure may vary due to fabrication sequence, fit-up, pass size, etc. within the limitation of variables given in section 5 of latest edition AWS D1.1 / D1.5

Paul A Radice  
 CWI 98070221  
 QC1 EXP. 7/1/2016

WPS no. W-2030-A  
 Revision no. 0  
 Supporting PQR no. Pre-Qualified  
 Project Name Fairfield, Vermont

Fabricator Highway Safety Corporation  
 Prepared By: Paul Radice  
 Date 02-18-15  
 Project Number BRF0281 (25) / BRO 1448(41)

# Highway Safety Corporation

Glastonbury, CT

## Welding Procedure Specification

Material specification ASTM A36, A572 gr 50, A709 Gr 36, ASTM A709 Gr 50, A500 gr B, A53 gr B  
 Welding process Gas Metal Arc Welding (GMAW) Spray Transfer  
 Manual, semi-automatic, or automatic Semi-Automatic  
 Position of welding Flat (1F) or Horizontal (2F)  
 Filler metal specification AWS A5.18  
 Filler metal classification ER70S-6  
 Electrode and manufacturer Lincoln Electric Lincoln Weld L-56  
 Flux and manufacturer N/A  
 Shielding gas 86% Argon / 14% CO2 Flow rate 35-45 CFM  
 Single or multiple pass Single  
 Single or multiple arc Single  
 Welding current DCEP  
 Polarity Reverse - electrode positive  
 Welding progression Stringers  
 Root treatment clean base metal  
 Preheat and interpass temperature base metal up to 3/4" (50°F)  
 Postheat treatment None  
 Electrode extension 3/4" ± 1/4"

Vermont Agency of Transportation

**RECEIVED**


CK'D BY RK/JC OK'D BY RY

February 20, 2015

RESUBMIT No Approved

BY RY DATE 03/09/2015

### WELDING PROCEDURE

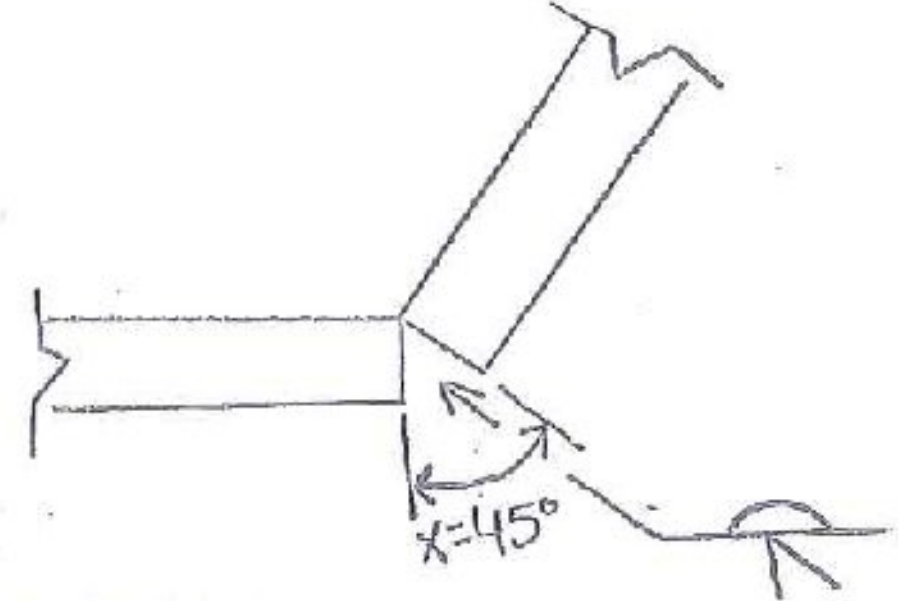Weld size	Pass no.	Electrode size	Welding parameters		Travel speed	Joint detail
			Amperes	Volts		
n/a	1	0.063	300 A	29	15 ipm	<p><u>TC-U4b-GF</u></p>  <p>X = 45 As Fitup: X=+10, -5 All Thicknesses</p>
			+/- 30	+/- 3	+/- 2	

This procedure may vary due to fabrication sequence, fit-up, pass size, etc. within the limitation of variables given in section 5 of latest edition AWS D1.1 / D1.5

**AWS**  
 Paul A Radice  
 CWI 98070221  
 QC1 EXP. 7/1/2016

WPS no. W-2030-B Fabricator Highway Safety Corporation  
 Revision no. 0 Prepared By: Paul Radice  
 Supporting PQR no. Pre-Qualified Date 02-18-15  
 Project Name Fairfield, Vermont Project Number BRF0281 (25) / BRO 1448(41)

# Highway Safety Corporation

Glastonbury, CT

## Welding Procedure Specification

Material specification ASTM A36, A572 gr 50, A709 Gr 36, ASTM A709 Gr 50, A500 gr B, A53 gr B  
 Welding process Gas Metal Arc Welding (GMAW) Spray Transfer  
 Manual, semi-automatic, or automatic Semi-Automatic  
 Position of welding Flat (1F) or Horizontal (2F)  
 Filler metal specification AWS A5.18  
 Filler metal classification ER70S-6  
 Electrode and manufacturer Lincoln Electric Lincoln Weld L-56  
 Flux and manufacturer N/A  
 Shielding gas 86% Argon / 14% CO2 Flow rate 35-45 CFM  
 Single or multiple pass Single  
 Single or multiple arc Single  
 Welding current DCEP  
 Polarity Reverse - electrode positive  
 Welding progression Stringers  
 Root treatment clean base metal  
 Preheat and interpass temperature base metal up to 3/4" (50°F)  
 Postheat treatment None  
 Electrode extension 3/4" ± 1/4"

Vermont Agency of Transportation

**RECEIVED**

CK'D BY RK/JC OK'D BY RY

February 20, 2015

RESUBMIT No Approved

BY RY DATE 03/09/2015

### WELDING PROCEDURE

Weld size	Pass no.	Electrode size	Welding parameters		Travel speed	Joint detail
			Amperes	Volts		
n/a	1	0.063	300 A ± 30	29 ± 3	15 ipm ± 2	<p>BTC-P4-GE S(E)</p> <p>X = 45 As Fitup: X = +10, -5 1/4" min. thk. f = 1/8" As Fitup: f = +1/16 S = E</p>

This procedure may vary due to fabrication sequence, fit-up, pass size, etc. within the limitation of variables given in section 5 of latest edition AWS D1.1 / D1.5

Paul A Radice  
CWI 98070221  
QC1 EXP. 7/1/2016

WPS no. W-2030-C  
 Revision no. 0  
 Supporting PQR no. Pre-Qualified  
 Project Name Fairfield, Vermont  
 Fabricator Highway Safety Corporation  
 Prepared By: Paul Radice  
 Date 02-18-15  
 Project Number BRF0281 (25) / BRO 1448(41)

Fairfield BRF 0231(25) & BRO 1448(41)

**Welding Procedure Specification**

Material specification Grade 50  
 Welding process SMAW  
 Manual or machine manual  
 Position of welding all positions  
 Filler metal specification NR311 AS-1  
 Filler metal classification E-7018  
 Flux N/A  
 Shielding gas N/A Flow rate N/A  
 Single or multiple pass as required  
 Single or multiple arc N/A  
 Welding current P.C  
 Polarity regular  
 Welding progression as required  
 Root treatment none  
 Preheat and interpass temperature 50-175  
 Postheat treatment N/A

**WELDING PROCEDURE**

Pass no.	Electrode size	Welding current		Travel speed	Joint detail
		Amperes	Volts		
As req	5/32	120-240	22-27	As req	<p>3/8 Groove Weld HP 12 x 84</p>

Vermont Agency of Transportation  
**RECEIVED**

CK'D BY _____ OK'D BY JC

May 29, 2015

RESUBMIT NO Approved


BY RY _____ DATE 6-1-2015

This procedure may vary due to fabrication sequence, fit-up, pass size, etc., within the limitation of variables given in Section 5. (of the AASHTO/AWS D1.5 Bridge Welding Code and latest revision)

Procedure no. _____ Contractor AL St. Orge Contractor Inc  
 Revision no. _____ Authorized by Randy St. Orge  
 Welder _____ Date 5/29/15

# HARD-BITE™ – HP-77600-B 30#

## Dimensions

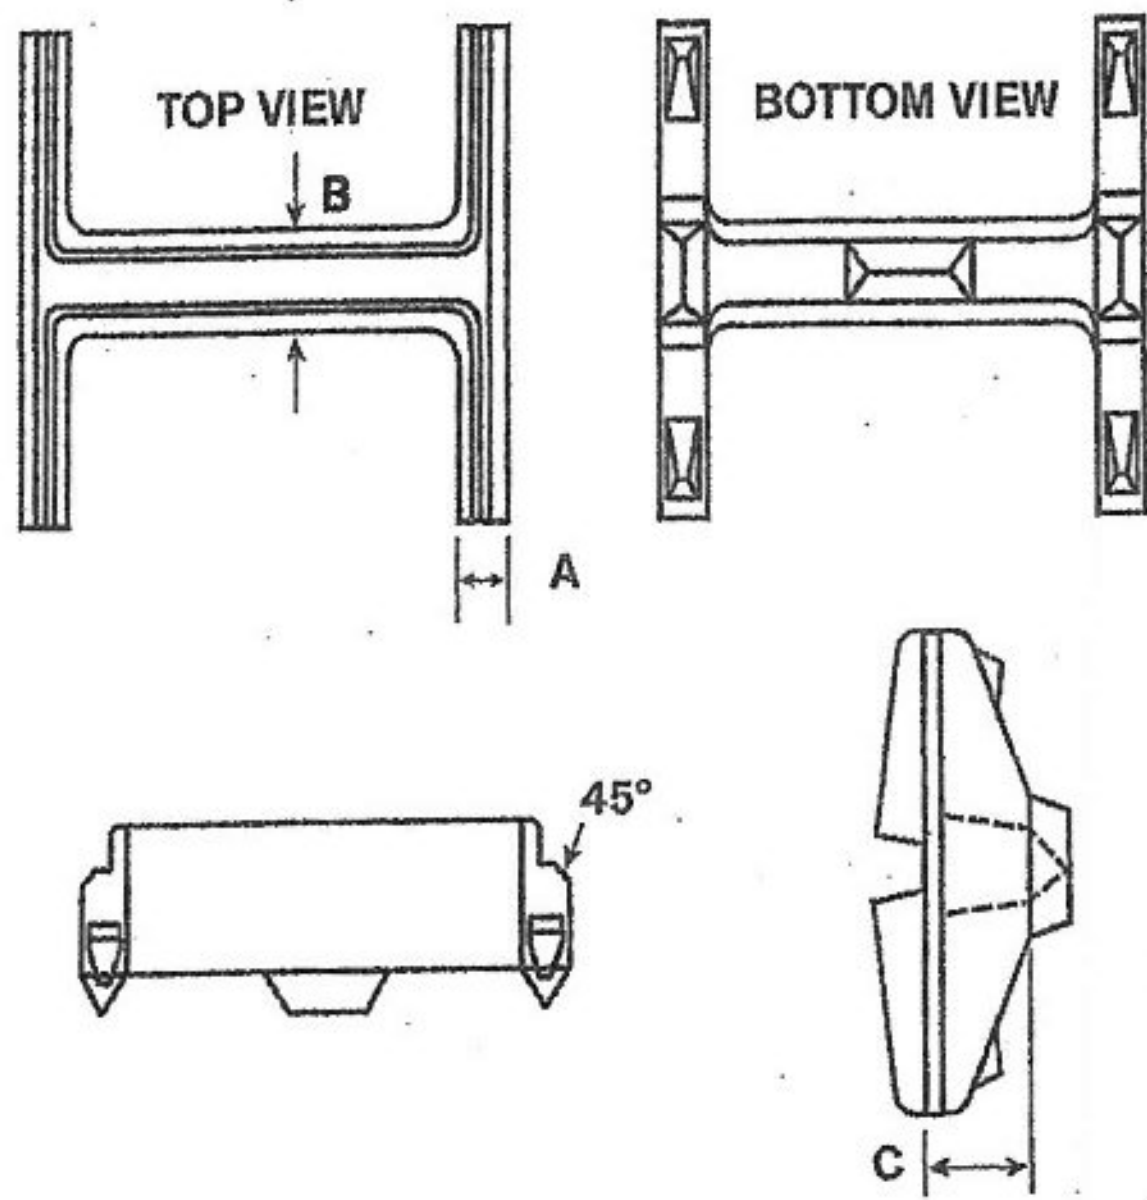


**MATERIAL: CAST STEEL**  
ASTM A148 90/60

	12"
A	1"
B	1-5/16"
C	3"
Wt.	31#

## Installation Instructions

1. Fit point onto the end of the square cut pile end.
2. Weld point to the pile in either flat or vertical position using E7018 electrodes.
3. Weld across full width of flange following chart below for minimum size weld.

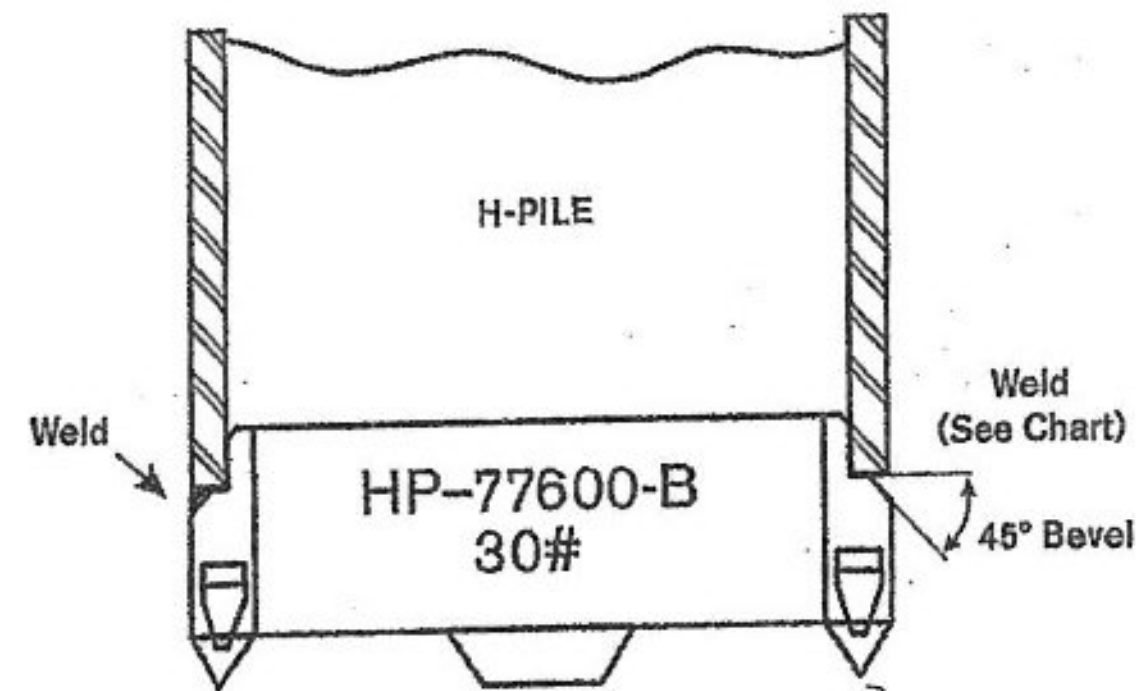

Pile Size	Flange Thickness	Groove Weld
HP 12 x 84	.685	3/8
x 74	.610	3/8
x 63	.515	5/16
x 53	.435	5/16

Vermont Agency of Transportation

**RECEIVED**

CK'D BY _____ OK'D BY JC

May 29, 2015

RESUBMIT NO Approved

BY RY DATE 6-1-2015




**ASSOCIATED PILE & FITTING**


PO Box 5933 Parsippany, NJ 07054-5933  
Tel: 973-773-8400  
Fax: 973-428-5146  
email: apf@associatedpile.com  
www.associatedpile.com  
Call Toll Free: 800-526-9047






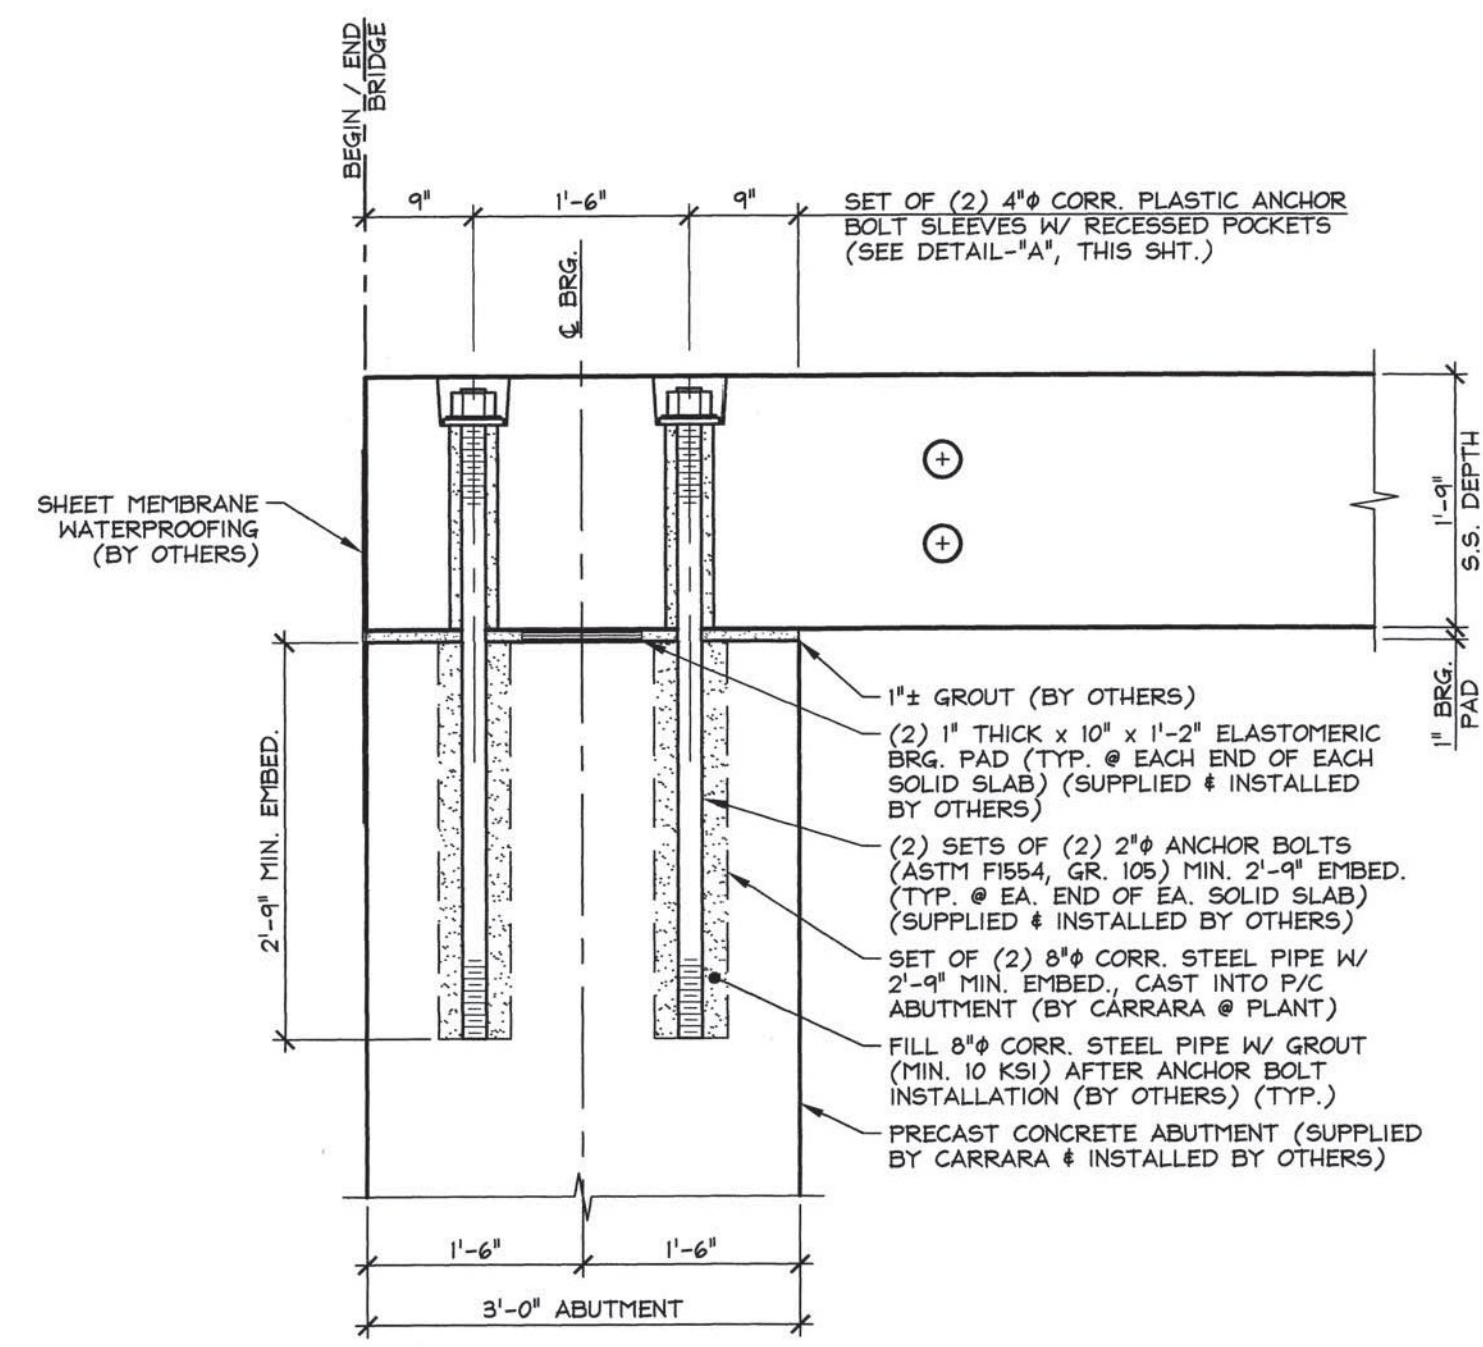


**A BEARING SECTION**  
F7 3/4" = 1'-0"

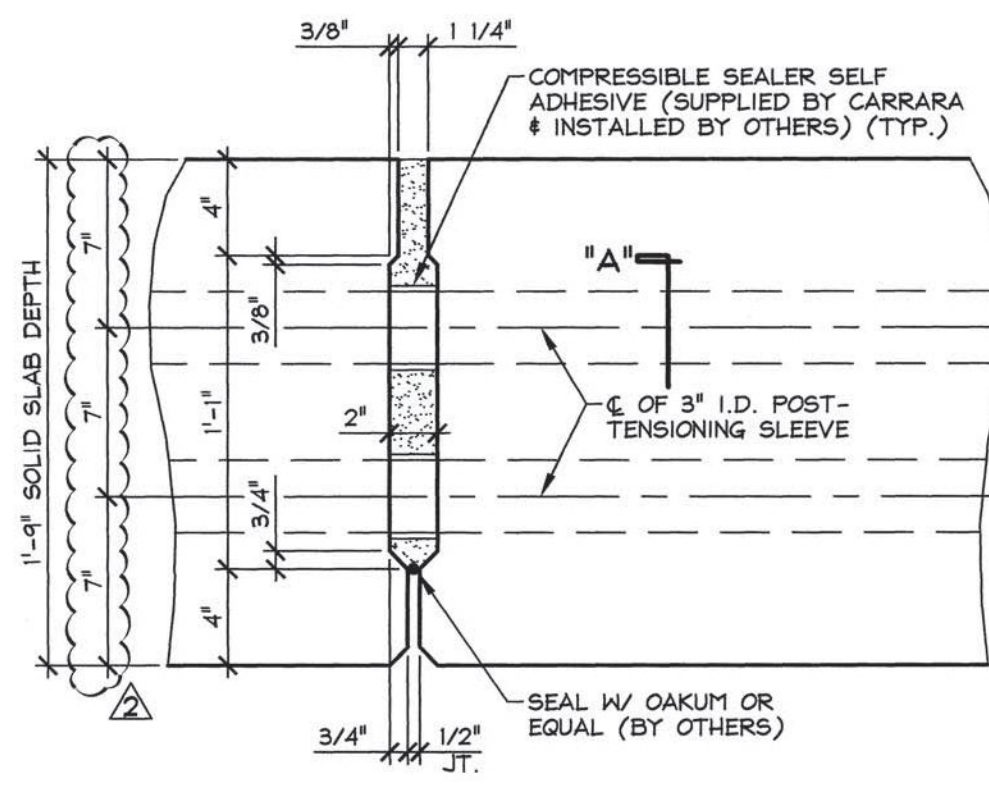


**B SHEAR KEY SECTION @ P.T. SLEEVE**  
F7 1/2" = 1'-0"

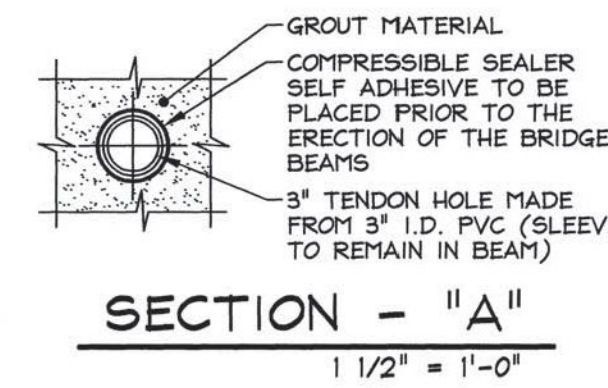


**C GUARDRAIL ANCHORAGE SECTION**  
F7 1" = 1'-0"

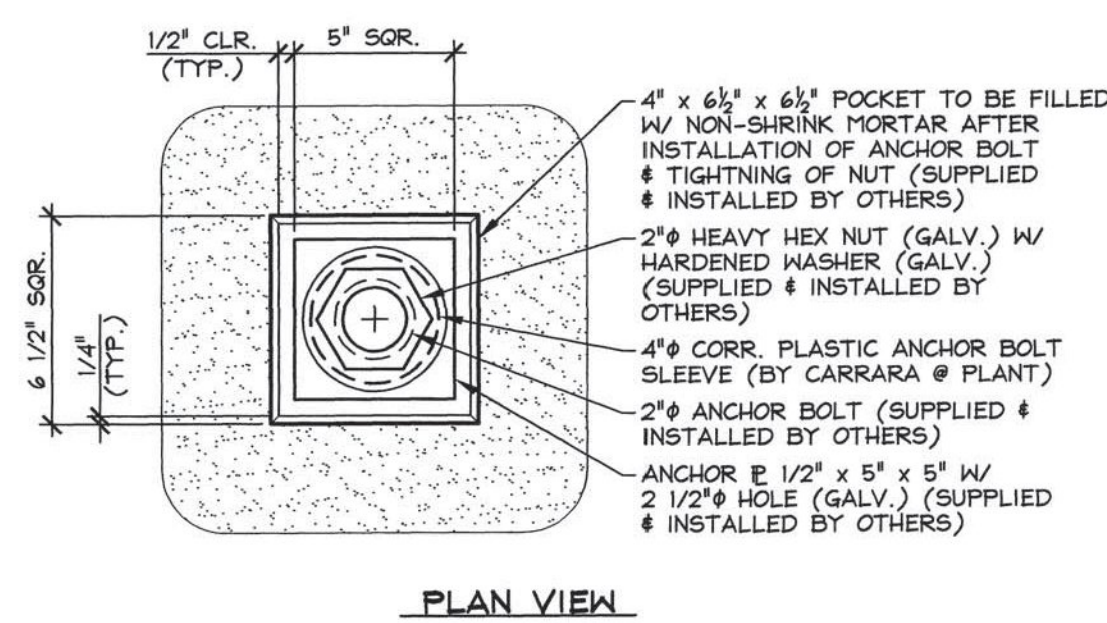


PLAN VIEW

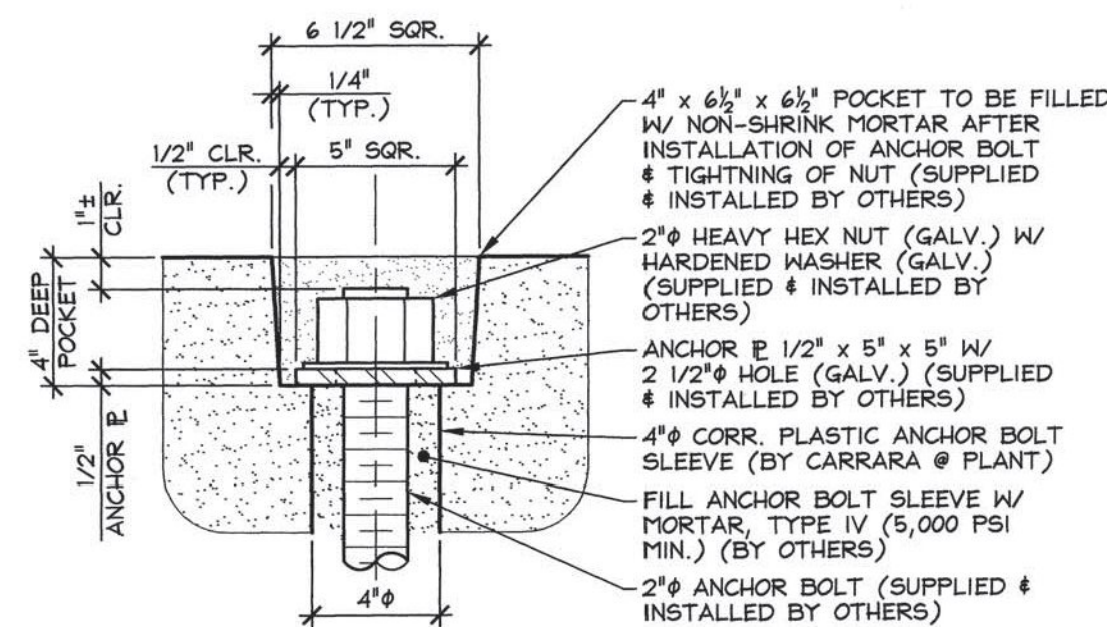

SECTION  
**DETAIL - "A"**  
2" = 1'-0"

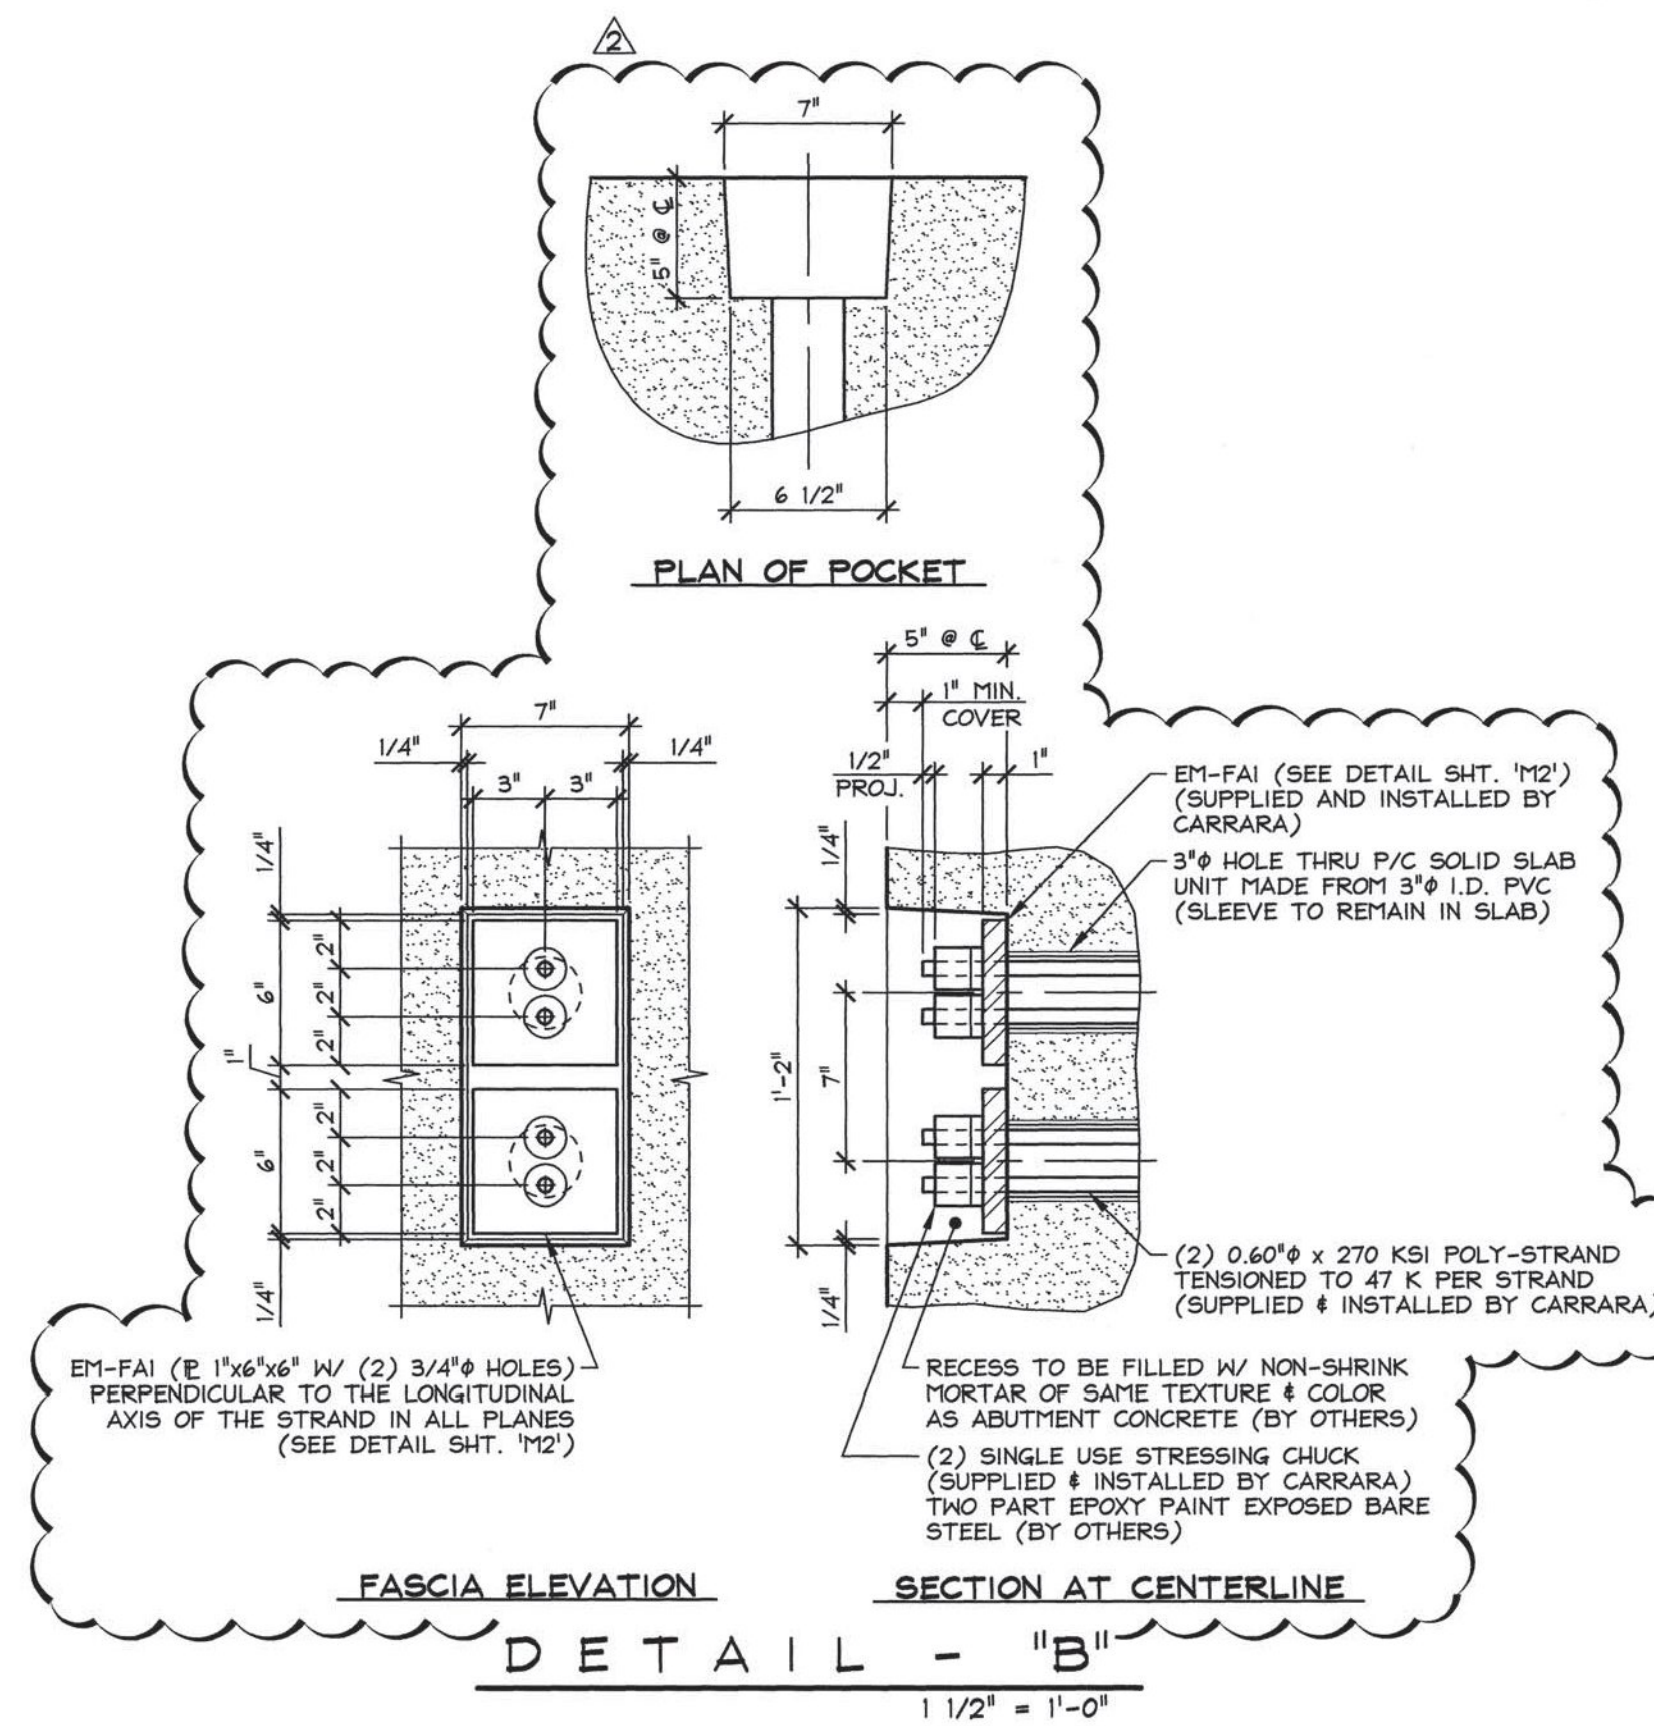

FASCIA ELEVATION  
**DETAIL - "B"**  
1 1/2" = 1'-0"

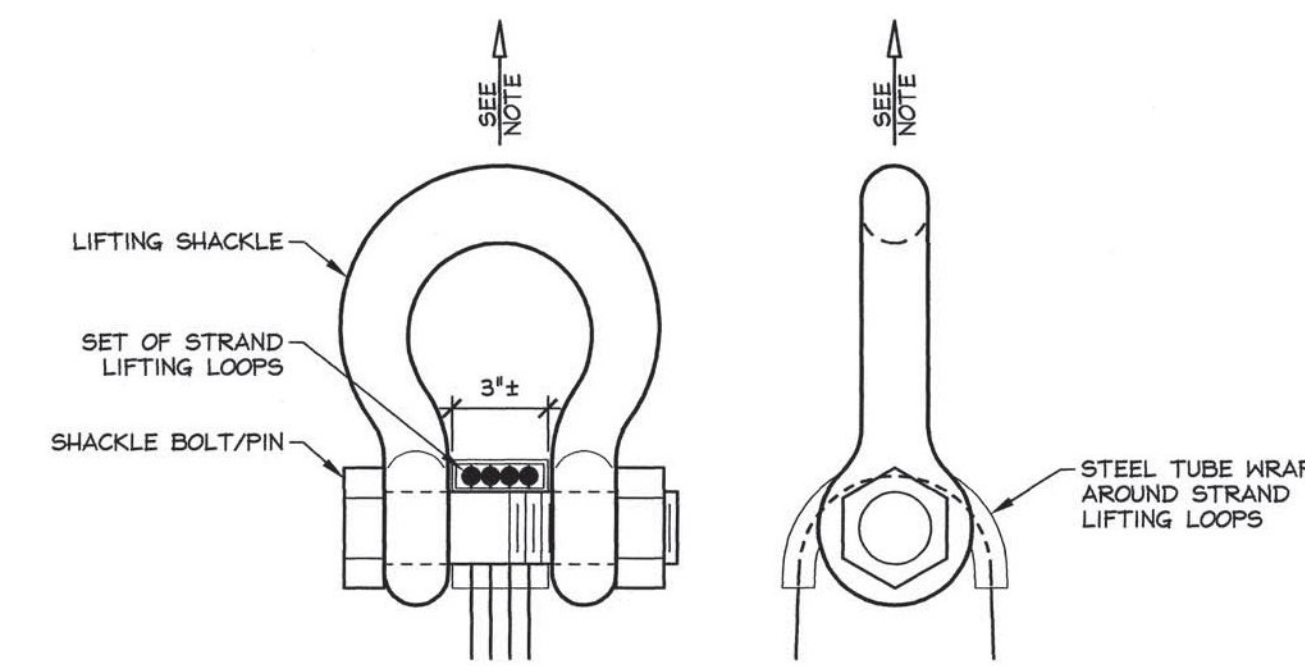


NOTE: ABUTMENTS SHALL BE HANDLED AND ERECTED USING THE LIFTING LOOPS ONLY. RIGGING SHALL BE CONFIGURED SUCH THAT EQUAL FORCES ARE APPLIED TO EACH SET OF LIFTING LOOPS AT EACH END OF THE SLAB. SHACKLE BOLT/PIN SHALL BE PLACED UNDER LIFT LOOPS AS SHOWN. DESIGN AND CONFIGURATION OF RIGGING BY PURCHASER.

**LIFTING SHACKLE DETAILS**  
N.T.S.


Vermont Agency of Transportation  
**RECEIVED**  
CK'D BY RK/JW OK'D BY RY  
February 12, 2015  
RESUBMIT No Approved  
BY RY DATE 02/12/2015

- △ 2-12-15 REVISE POST-TENSIONING POCKETS
- △ 2-10-15 REVISED PER VT AOT COMMENTS

APPROVAL STAMP:	<b>J.P. CARRARA &amp; SONS INC.</b> Precast & Prestress Manufacturer 2444 CASE STR., MIDDLEBURY, VERMONT 05753 Phone:(802)388-6361 Fax:(802)388-9010	A.L. ST. ONGE CONTRACTOR MONTOMERY, VERMONT
STATE OF VERMONT AGENCY OF TRANSPORTATION COUNTY OF FRANKLIN		DATE: NOV. 10, 2014 SCALE: NOTED
TOWN OF FAIRFIELD ELM BROOK ROAD, TOWN HIGHWAY 47 (CLASS 3) BRIDGE NO.: 46 PROJECT NO.: BRO 1448(41)		CHKD: B.C. DFTM: B.L. JOB NO: 23446-014
<b>SECTIONS &amp; DETAILS</b>		DWG. NO: <b>F7</b>

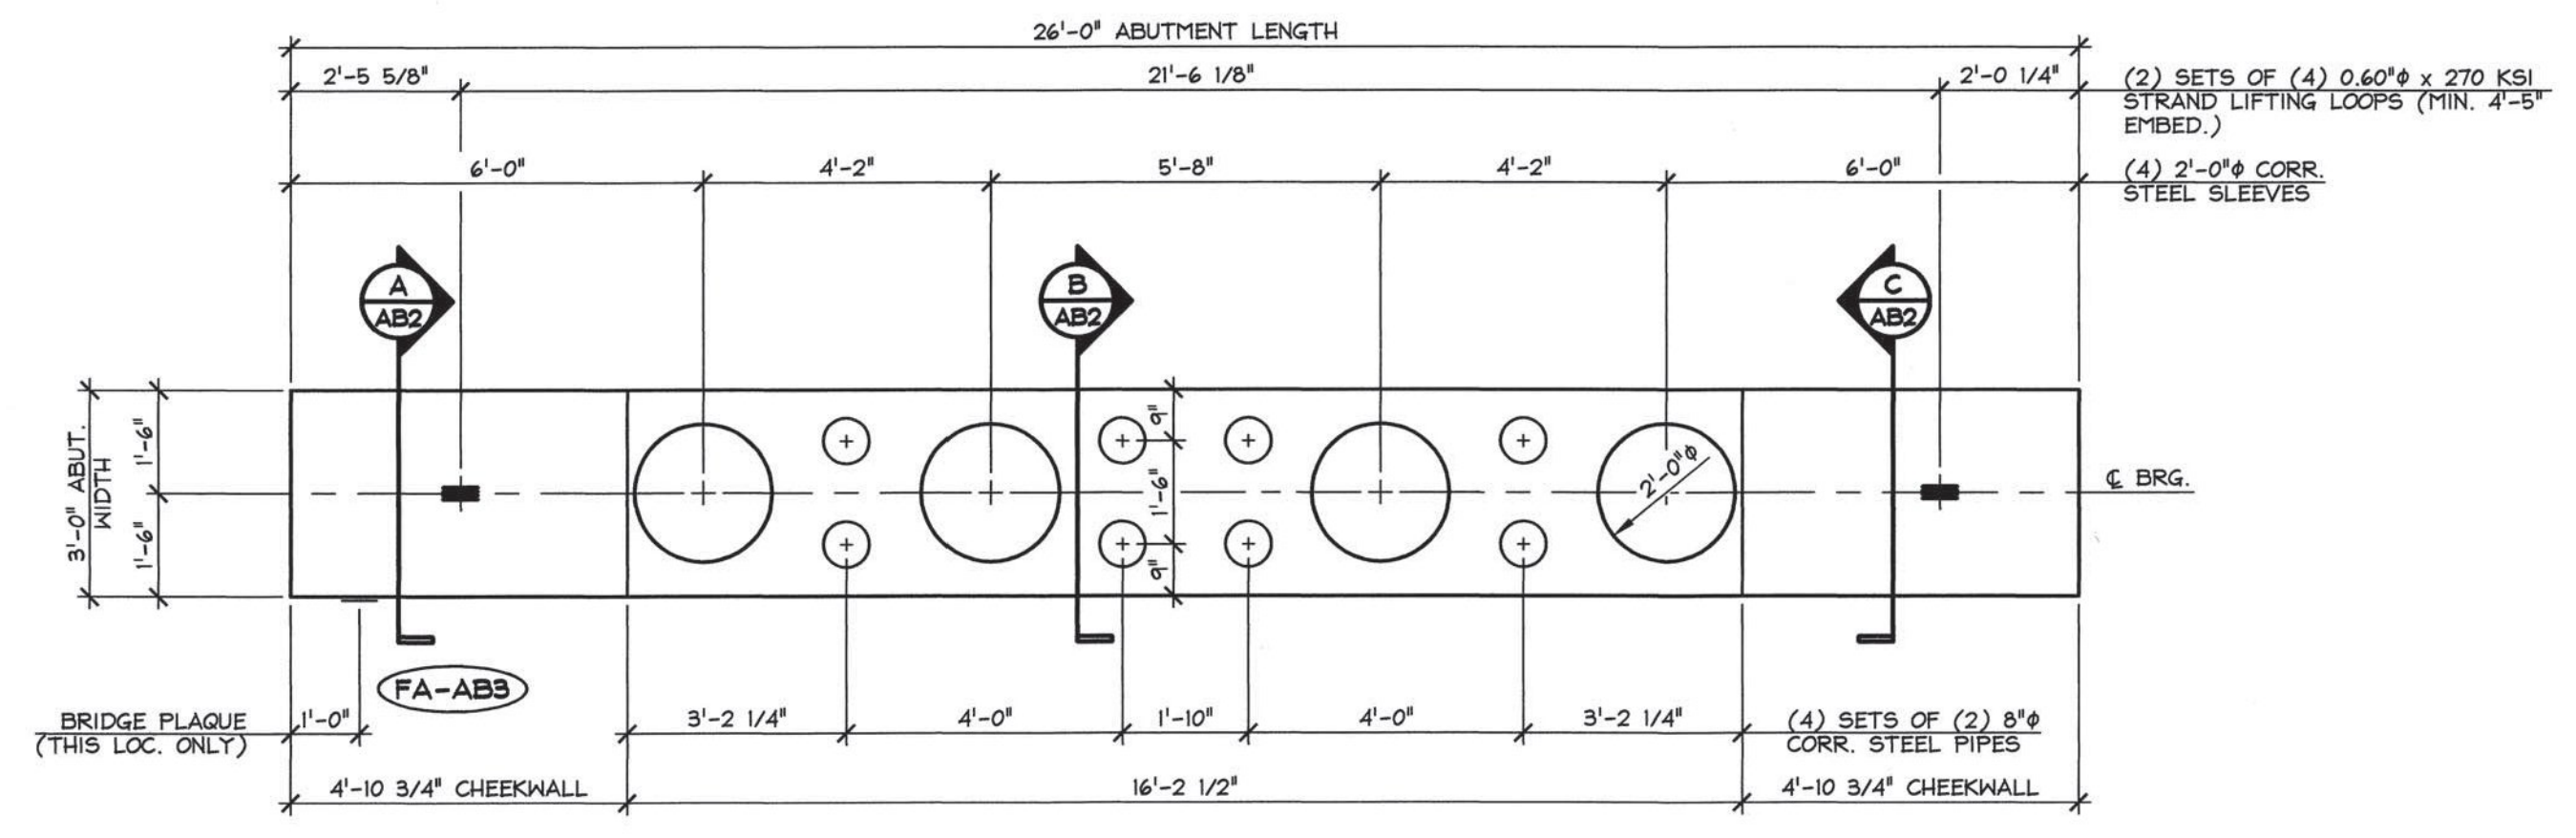


1 DIMENSIONAL PLAN VIEW IN FORM  
AB2 3/8" = 1'-0"

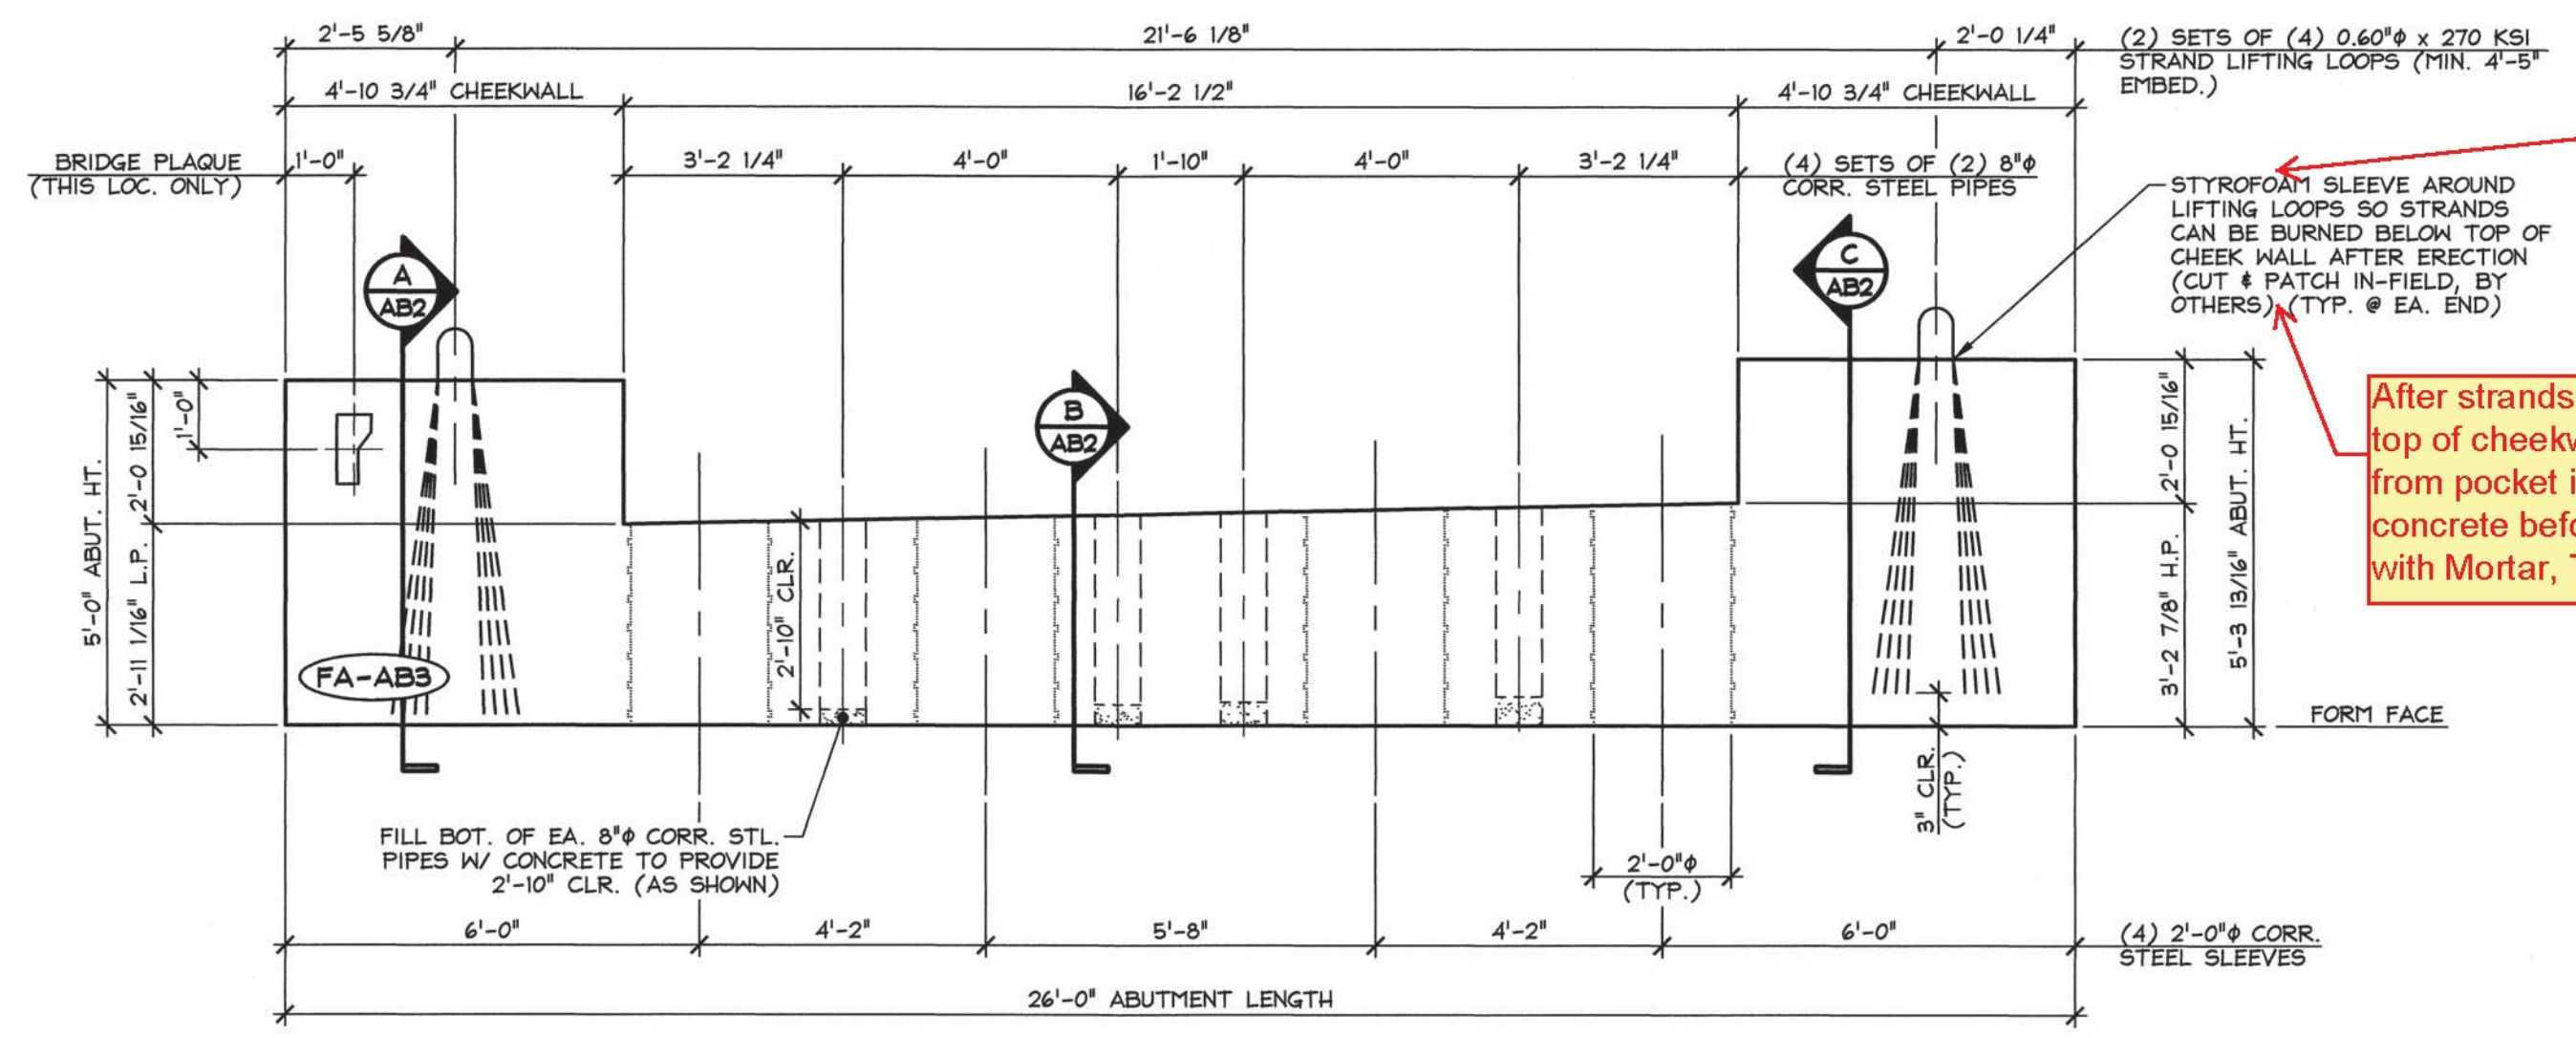


2 DIMENSIONAL ELEVATION VIEW IN FORM  
AB2 3/8" = 1'-0"

Pocket shall be deep enough so strands can be cut a minimum of 3" below top of cheek wall


After strands are cut 3" below top of cheekwall, clean all debris from pocket including any loose concrete before filling pocket with Mortar, Type IV

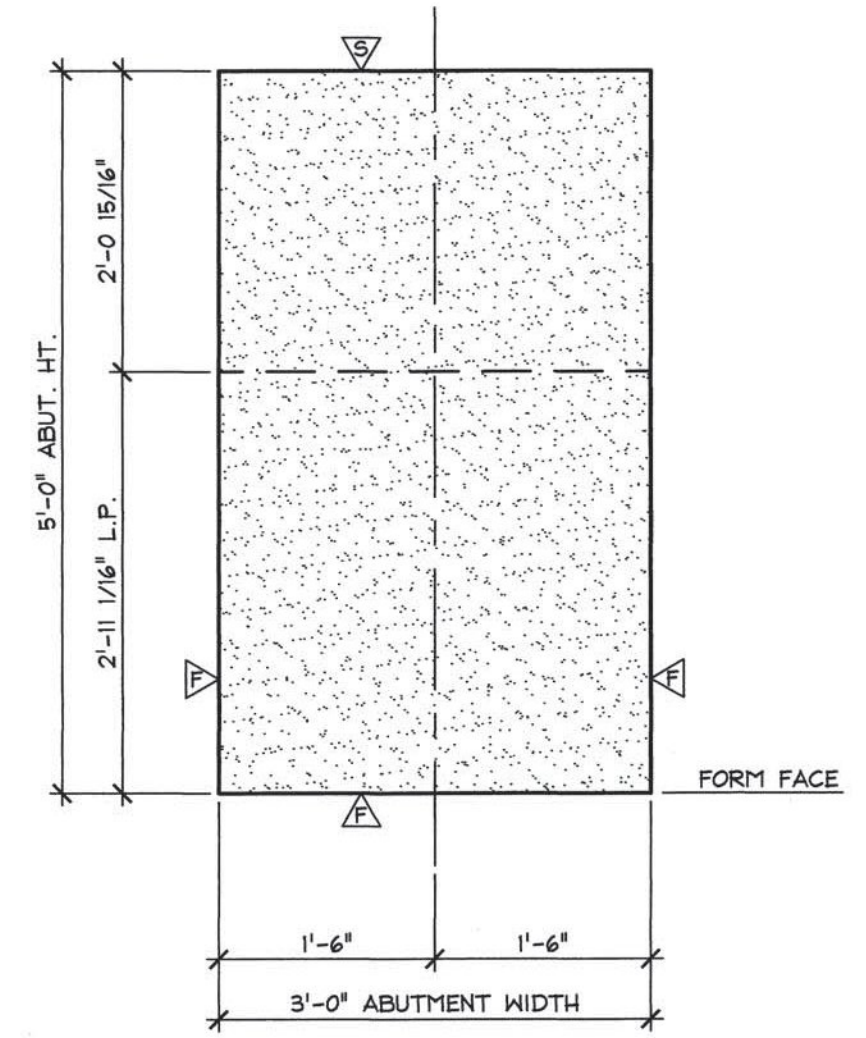

A ABUTMENT SECTION  
AB2 3/4" = 1'-0"

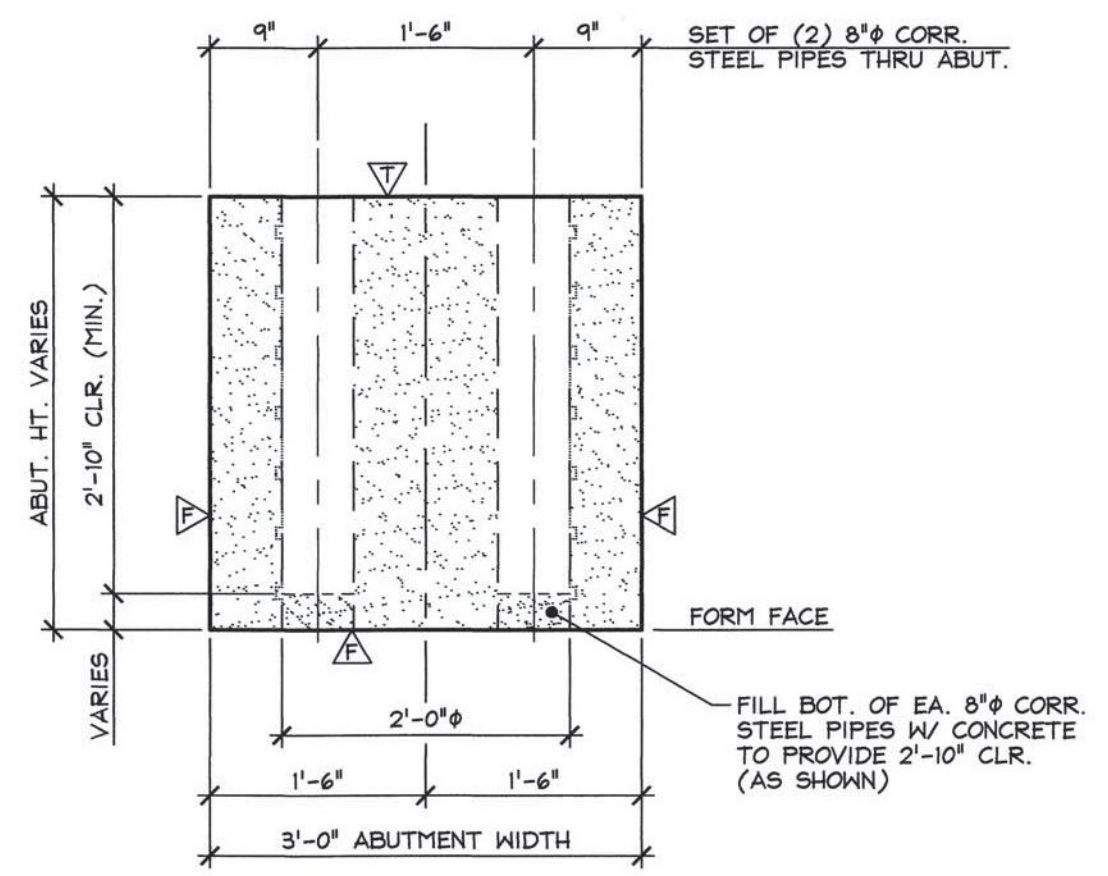

B ABUTMENT SECTION  
AB2 3/4" = 1'-0"

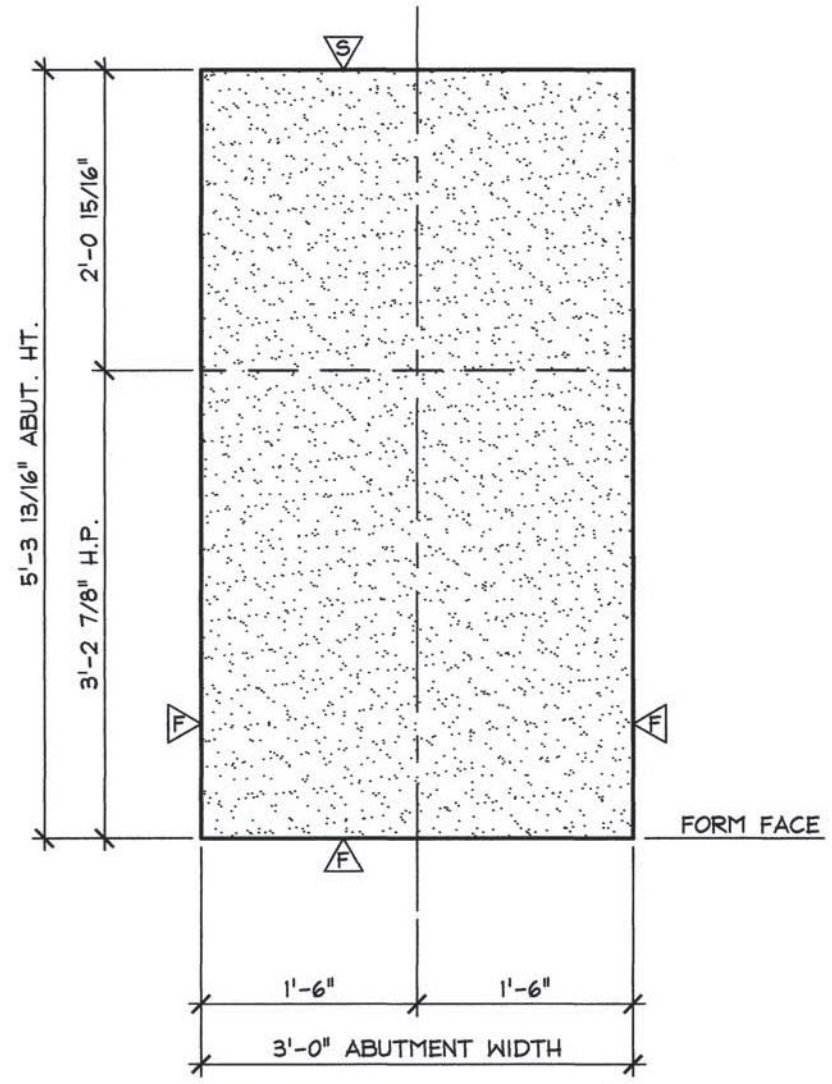

C ABUTMENT SECTION  
AB2 3/4" = 1'-0"


- △ DENOTES FORM FINISH
- △ DENOTES FLOAT FINISH
- △ DENOTES SMOOTH TROCHEL FINISH

Vermont Agency of Transportation  
**RECEIVED**  
CK'D BY RK/JW OK'D BY RY  
February 12, 2015  
RESUBMIT No Approved AsNoted  
BY RY DATE 02/12/2015


MARK: FA-ABS	QTY.: 1	WT.: 19.12 T	VOL.: 9.44 cy
MATERIAL LIST / ABUTMENT			
ITEM	MARK	DESCRIPTION	QTY.
1			
2			
3			
4			
5			
6		BRIDGE PLAQUE (SUPPLIED BY OTHERS)	1
7		SET OF (4) 0.60" x 270 KSI STRAND LIFTING LOOPS	2
8		8" x 3'-2" (MAX.) CORRUGATED STEEL SLEEVE (GALV.)	8
9		2'-0" x 3'-2 3/4" CORRUGATED STEEL SLEEVE (GALV.)	4
10			

△ 2-10-15 REVISED PER VT AOT COMMENTS


APPROVAL STAMP:	J.P. CARRARA & SONS INC. Precast & Prestress Manufacturer 2464 GALE STR., MIDDLEBURY, VERMONT 05753 Phone:(802)388-6361 Fax:(802)388-8010	A.L. St. ONGE CONTRACTOR MONTMERY, VERMONT
STATE OF VERMONT AGENCY OF TRANSPORTATION COUNTY OF FRANKLIN		DATE: NOV. 10, 2014
TOWN OF FAIRFIELD ELM BROOK ROAD, TOWN HIGHWAY 47 (CLASS 3) BRIDGE NO.: 46 PROJECT NO.: BRO 144B(41)		SCALE: NOTED
PRECAST ABUTMENT DIMENSIONAL DETAILS		CHKD: B.C. DFTM: B.L. JOB NO: 23446-014 DWG. NO: AB2

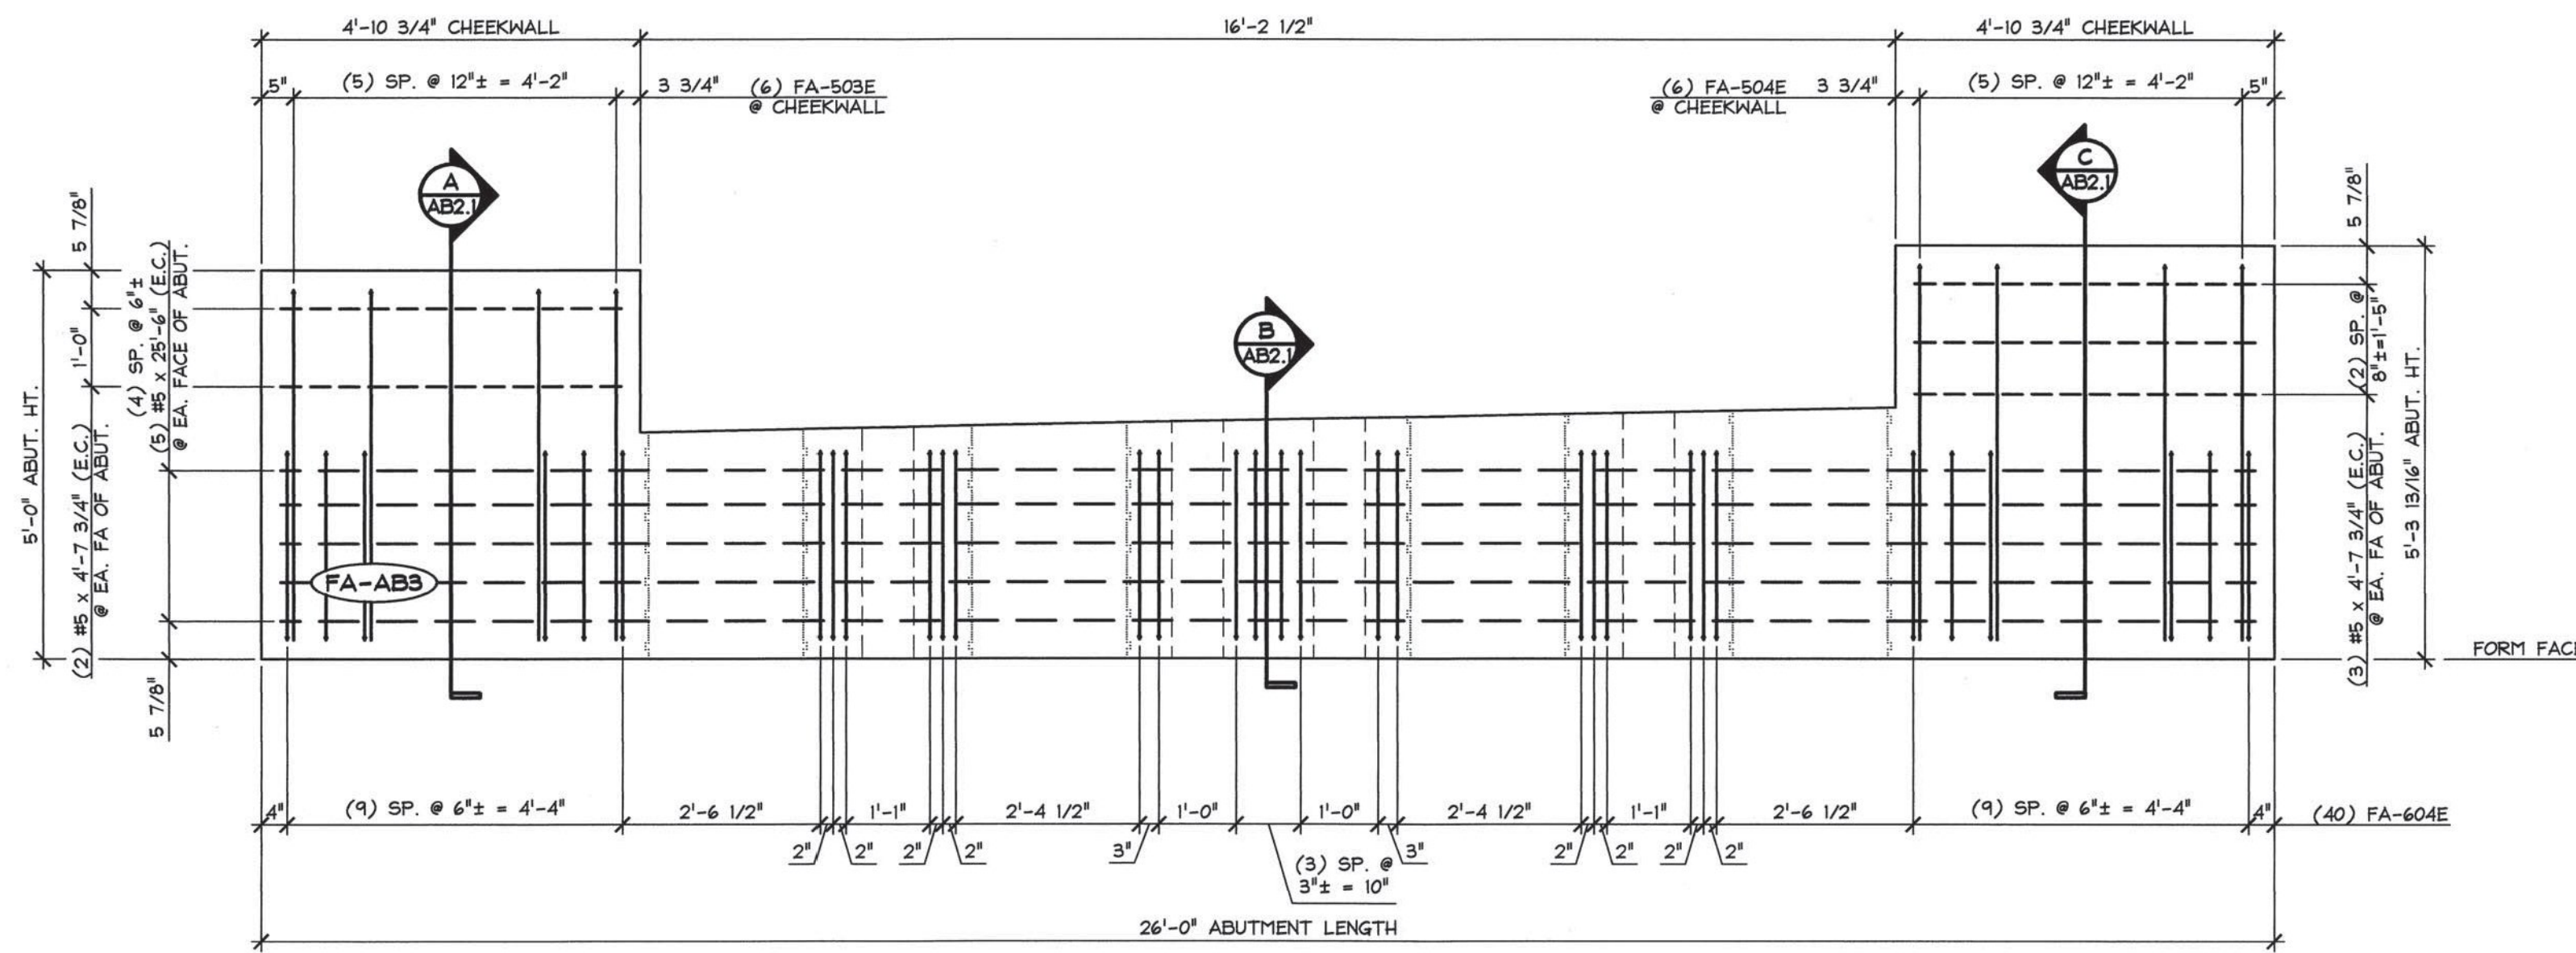


1 REINFORCING ELEVATION VIEW IN FORM  
AB2.1  
1/2" = 1'-0"

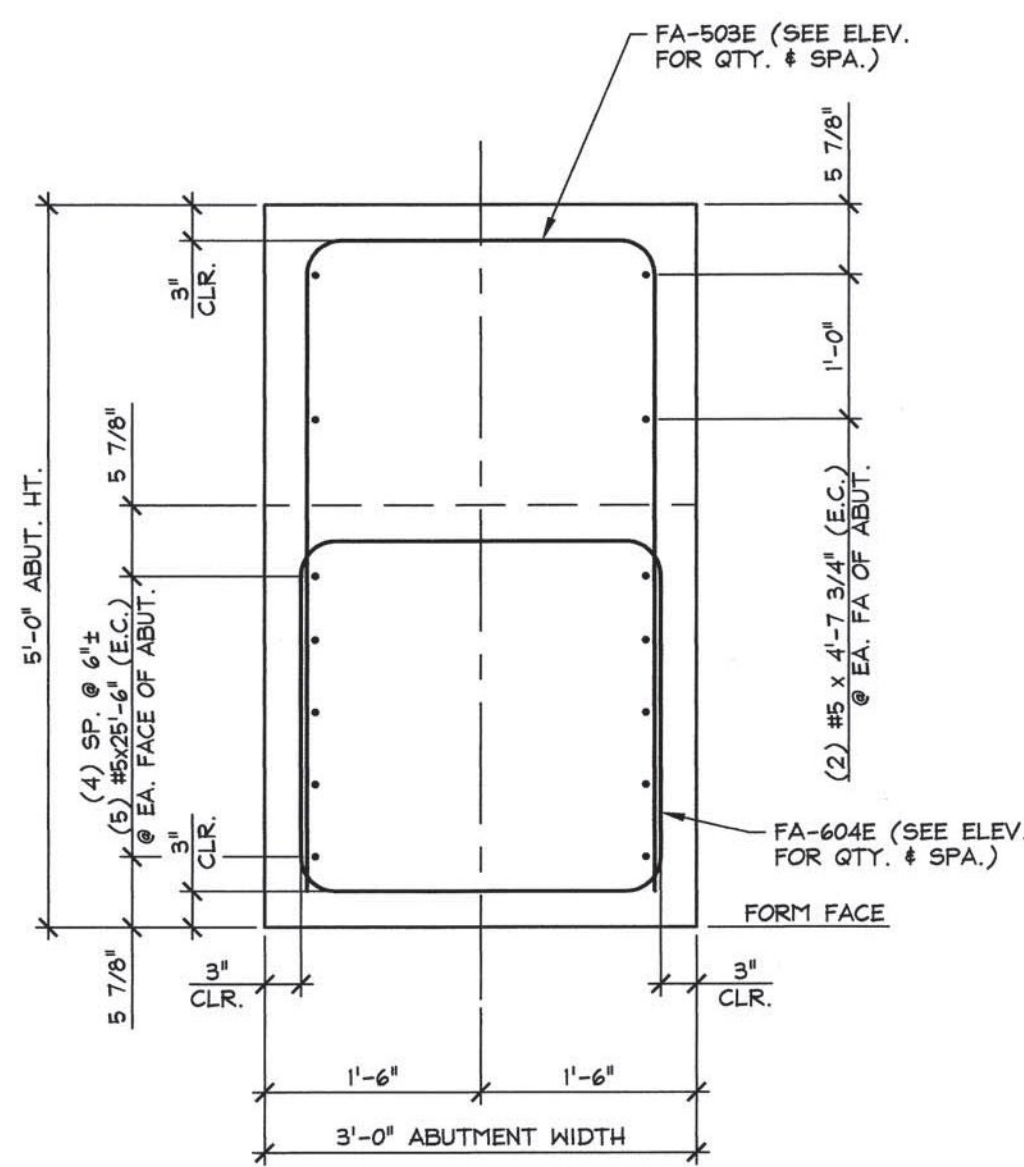

A ABUTMENT SECTION  
AB2.1  
3/4" = 1'-0"

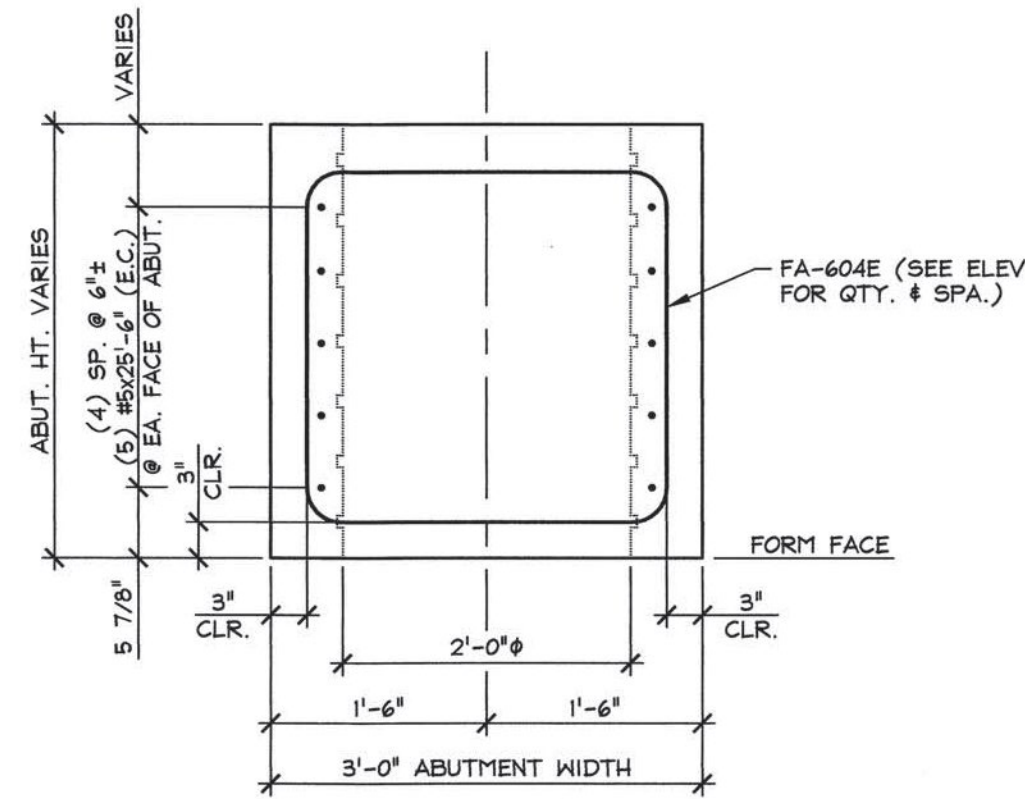

B ABUTMENT SECTION  
AB2.1  
3/4" = 1'-0"

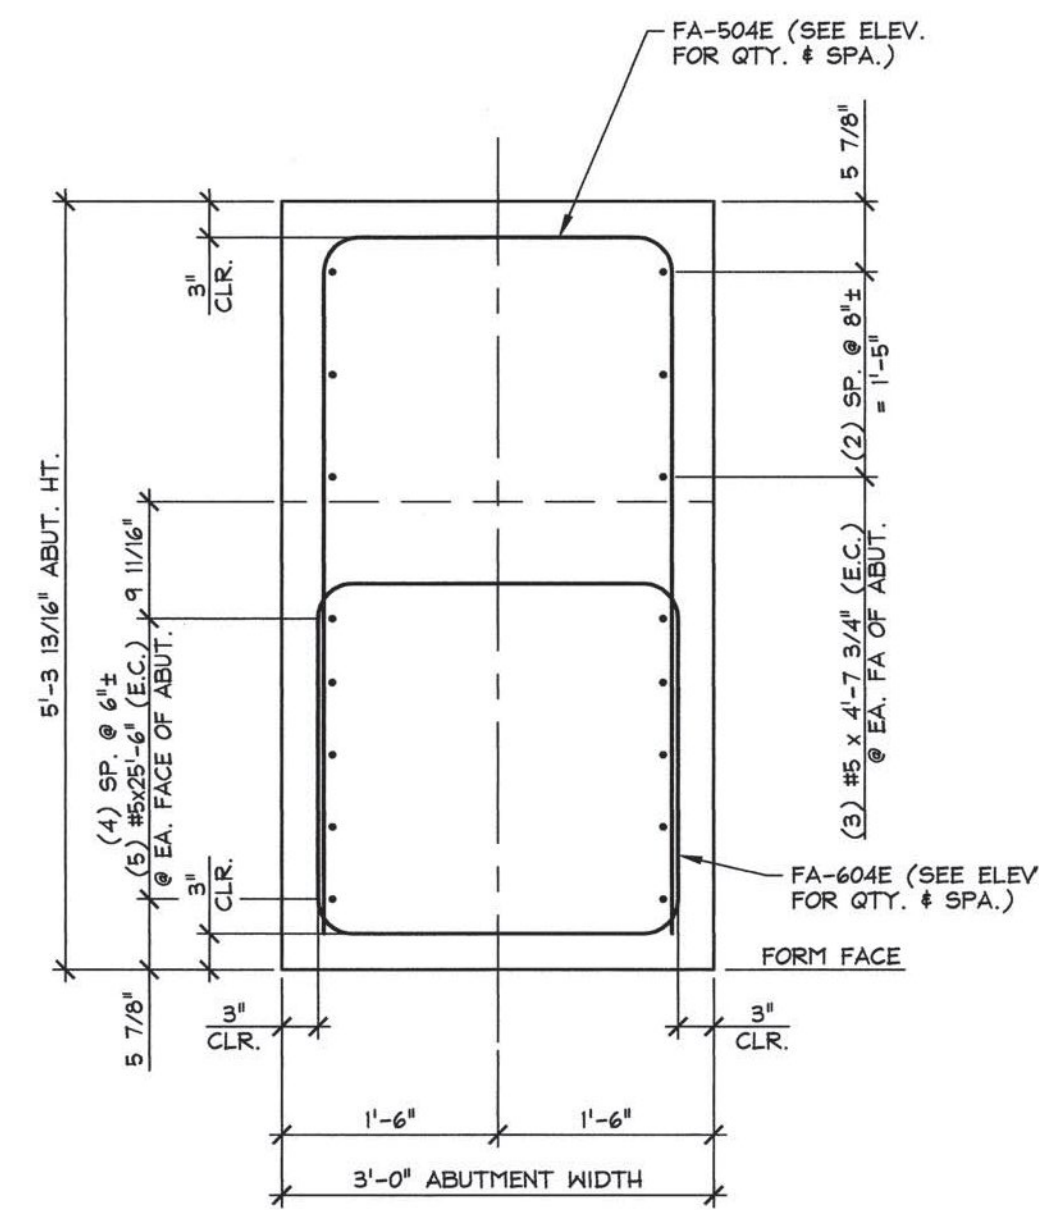

C ABUTMENT SECTION  
AB2.1  
3/4" = 1'-0"

Vermont Agency of Transportation  
**RECEIVED**

CK'D BY RK/JW OK'D BY RY  
February 12, 2015

RESUBMIT No Approved  
BY RY DATE 02/12/2015

2-10-15 REVISED PER VT AOT COMMENTS

MARK: FA-AB3 QTY.: 1			
MATERIAL LIST / ABUTMENT			
ITEM	MARK	DESCRIPTION	QTY.
1	FA-503E	#5 BENT BAR (LEVEL 1, EPOXY COATED)	6
2	FA-504E	#5 BENT BAR (LEVEL 1, EPOXY COATED)	6
3		#5 x 25'-6" (LEVEL 1, EPOXY COATED)	10
4		#5 x 4'-7 3/4" (LEVEL 1, EPOXY COATED)	10
5			
6	FA-604E	#6 BENT BAR (LEVEL 1, EPOXY COATED)	40
7			
8			
9			
10			

APPROVAL STAMP:

J.P. CARRARA & SONS INC.  
Precast & Prestress Manufacturer  
244 CASE ST., MIDDLEBURY, VERMONT 05753 Phone: (802)388-6361 Fax: (802)388-9010

A.L. St. ONGE  
CONTRACTOR  
MONTMERY, VERMONT

STATE OF VERMONT AGENCY OF TRANSPORTATION  
COUNTY OF FRANKLIN

DATE: NOV. 10, 2014

SCALE: NOTED


TOWN OF FAIRFIELD  
ELM BROOK ROAD, TOWN HIGHWAY 47 (CLASS B)  
BRIDGE NO.: 46 PROJECT NO.: BRO 1448(41)

CHKD: B.C. DFTM: B.L.


JOB NO: 23446-014

PRECAST ABUTMENT  
REINFORCING DETAILS

DWG. NO: AB2.1

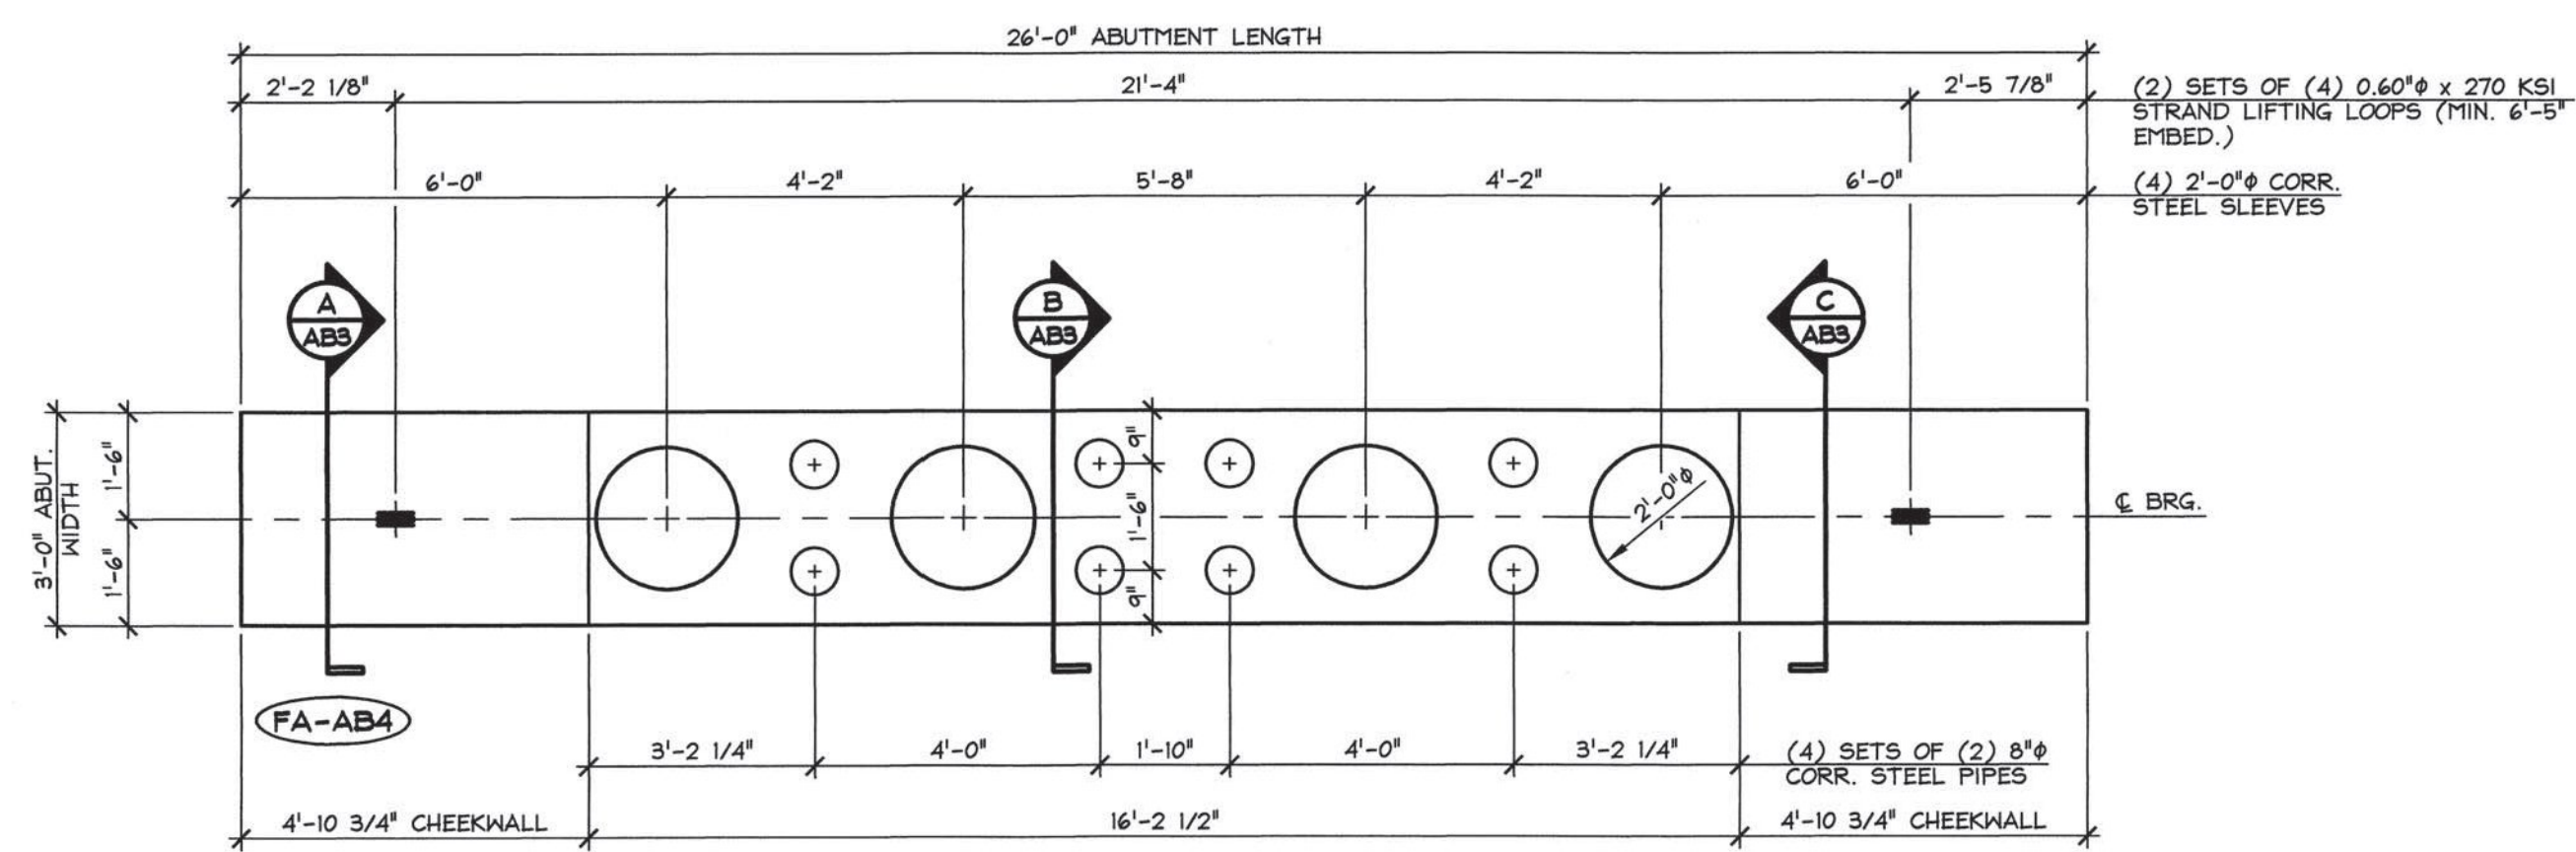


1 DIMENSIONAL PLAN VIEW IN FORM  
AB3 3/8" = 1'-0"

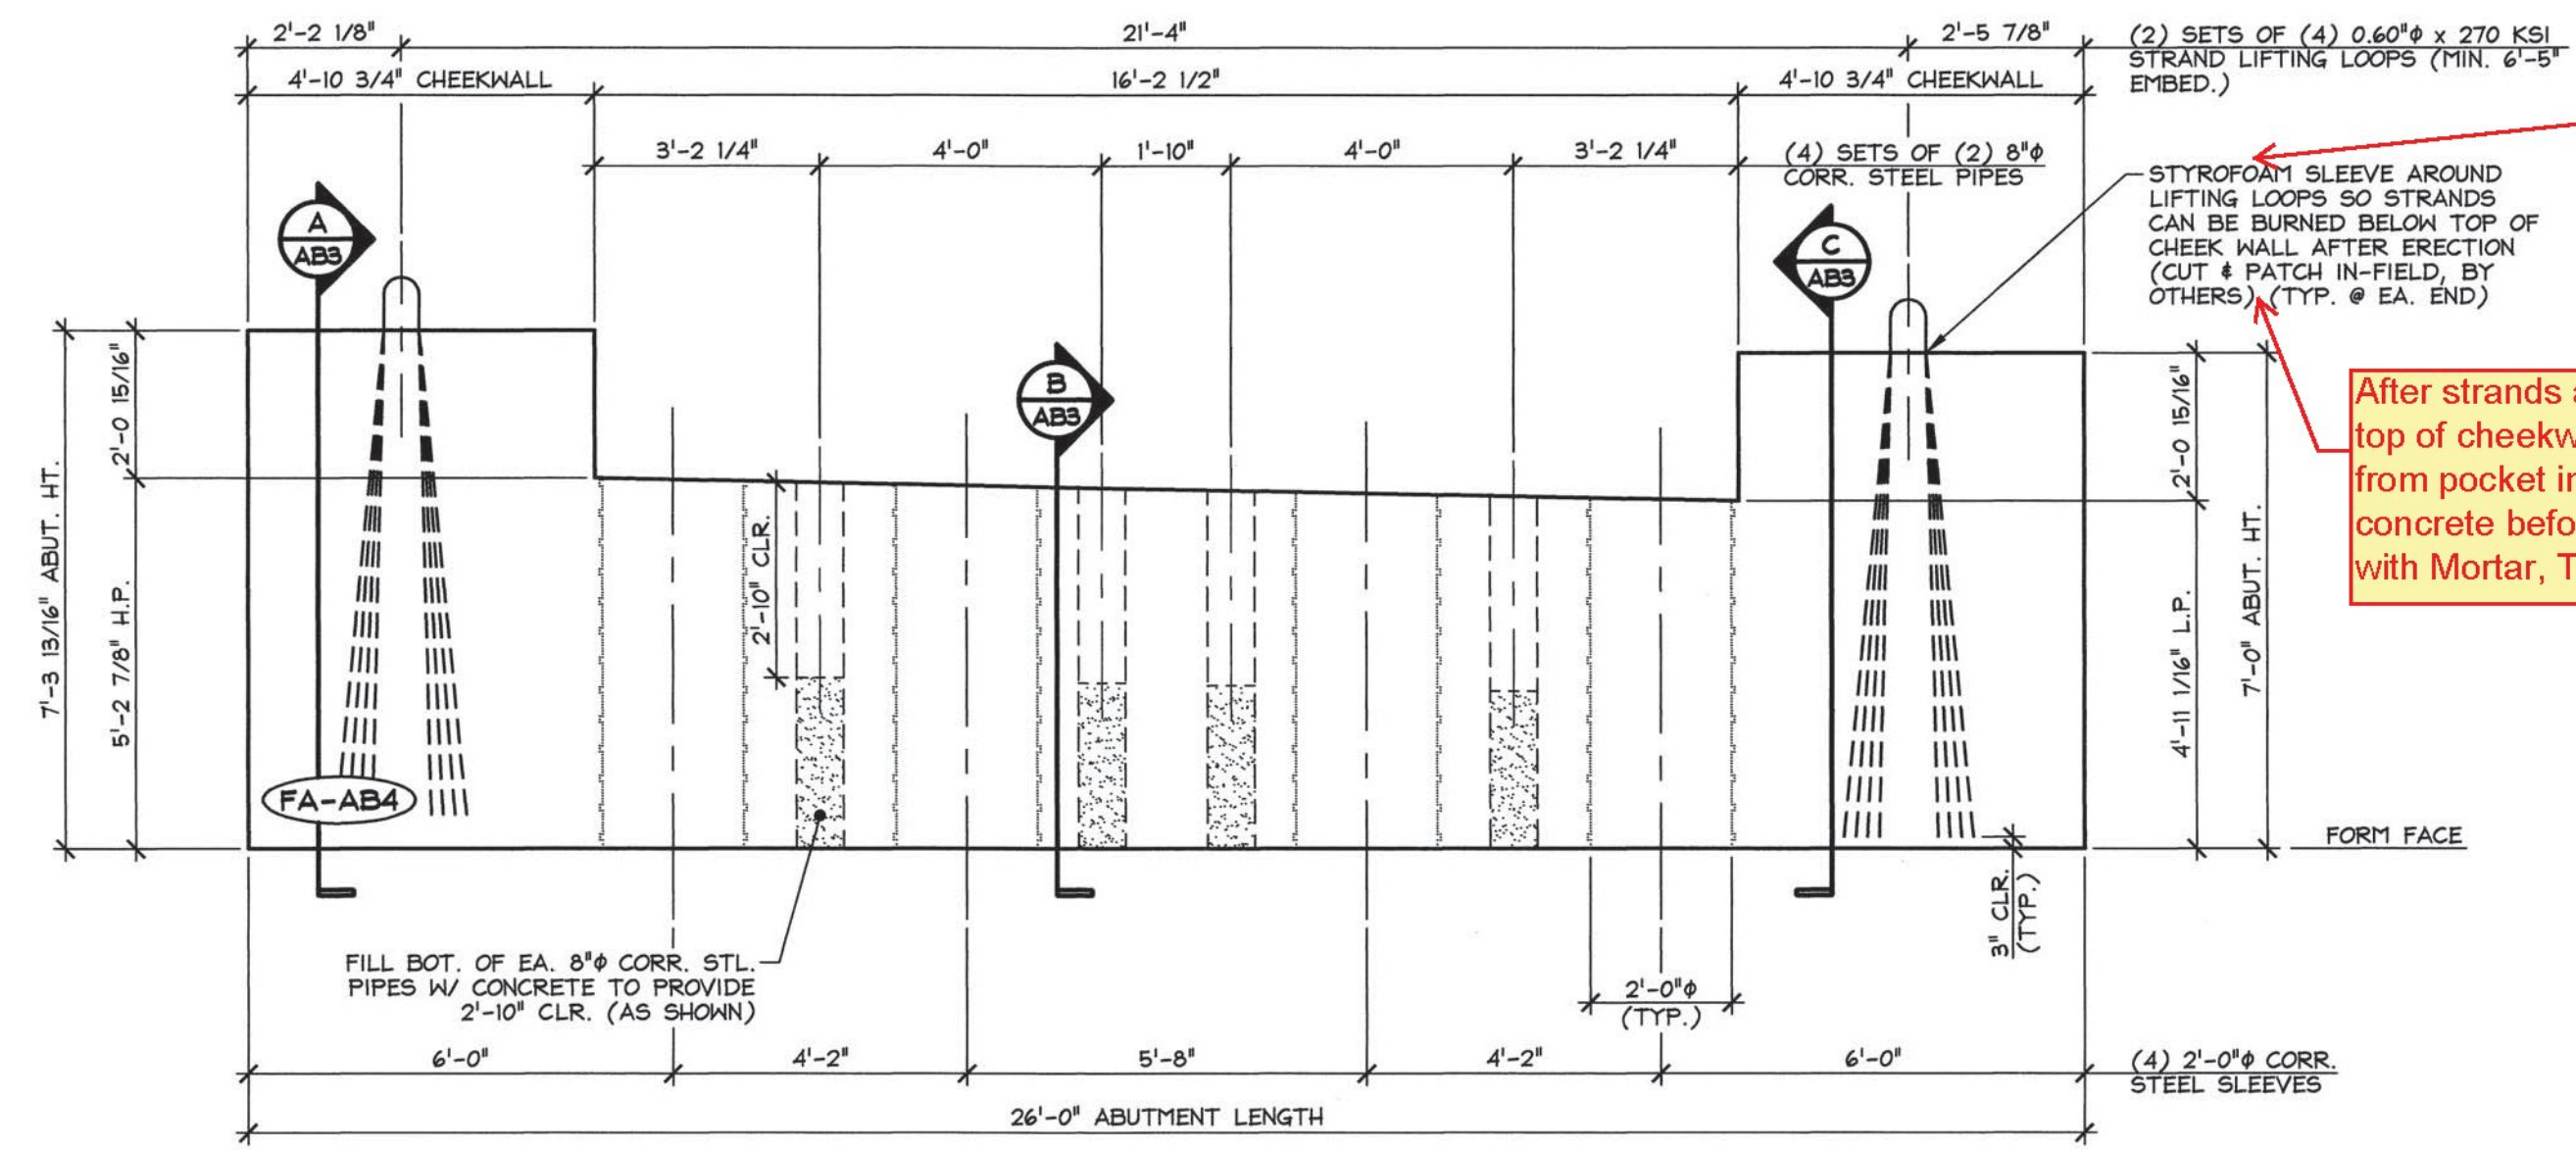


2 DIMENSIONAL ELEVATION VIEW IN FORM  
AB3 3/8" = 1'-0"

Pocket shall be deep enough so strands can be cut a minimum of 3" below top of cheek wall


After strands are cut 3" below top of cheekwall, clean all debris from pocket including any loose concrete before filling pocket with Mortar, Type IV

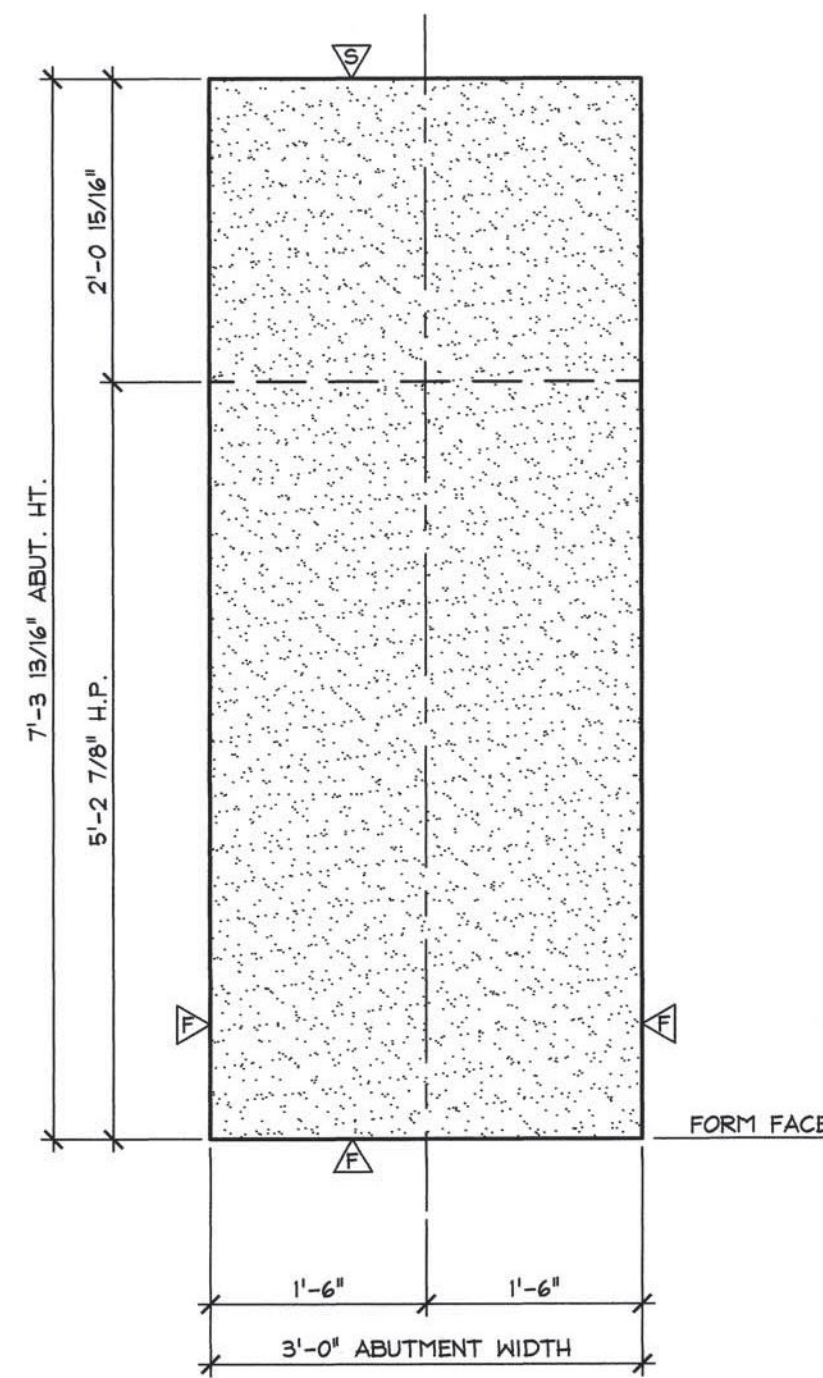

A ABUTMENT SECTION  
AB3 3/4" = 1'-0"

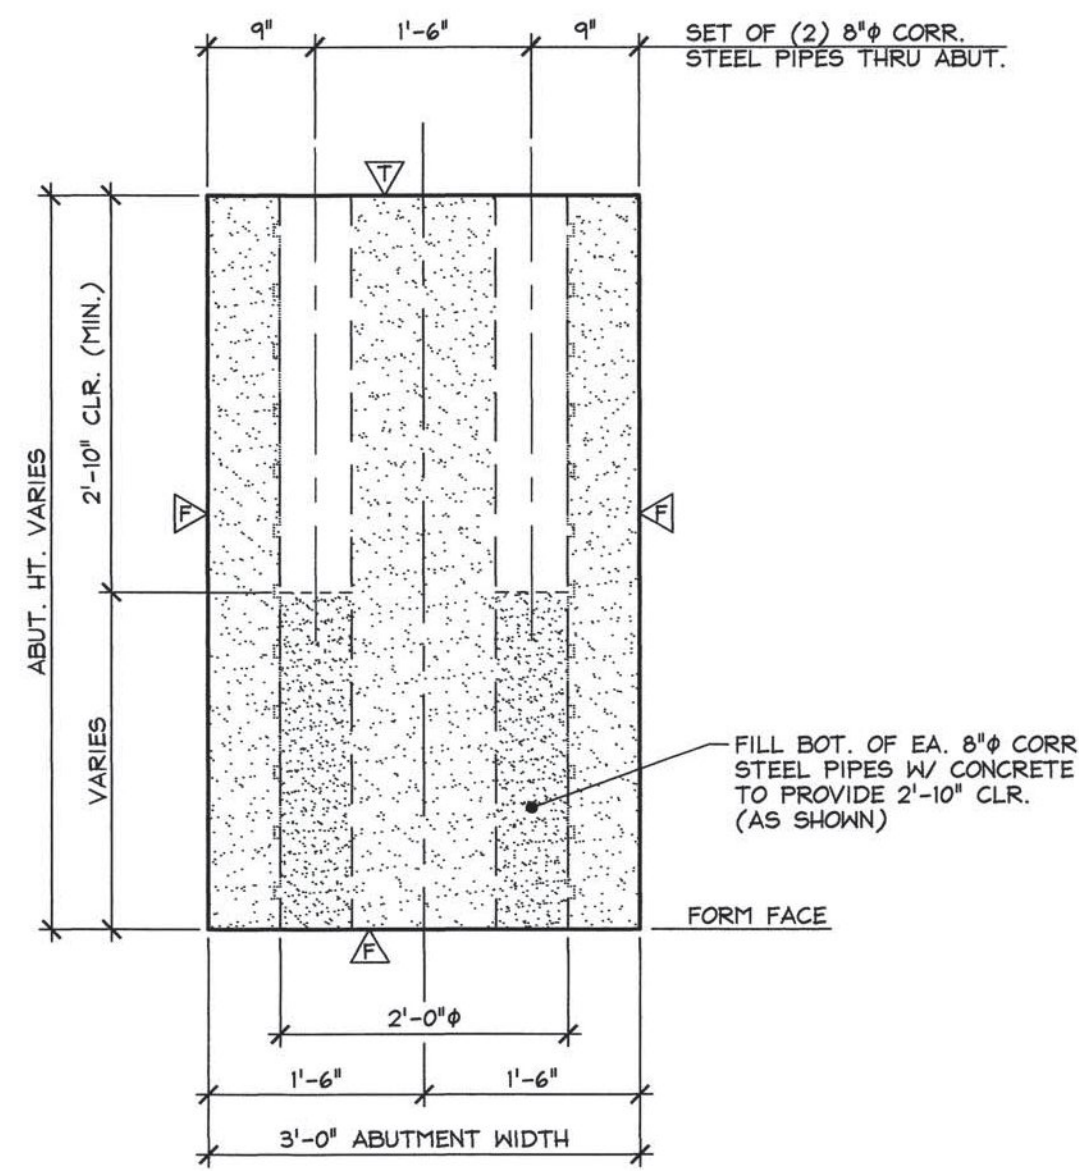

B ABUTMENT SECTION  
AB3 3/4" = 1'-0"

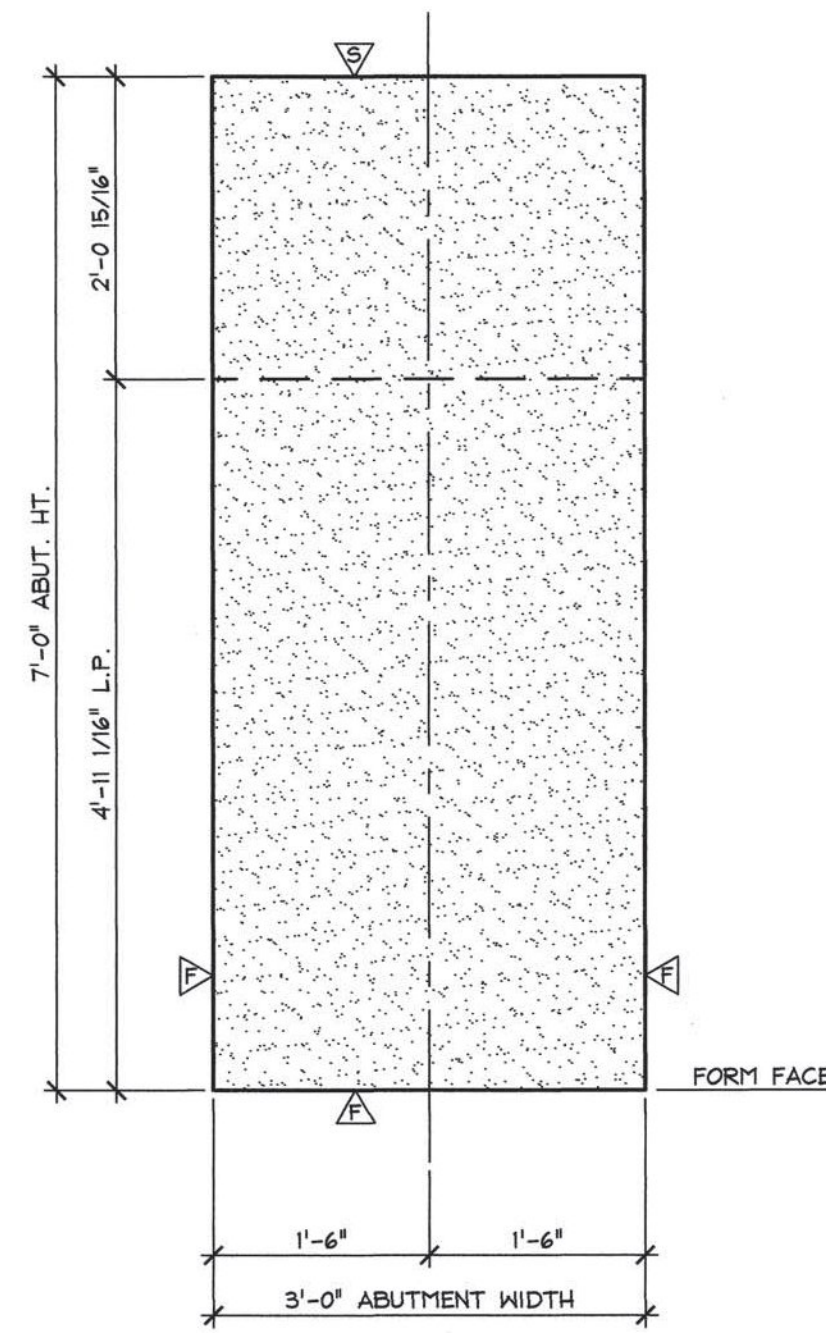


C ABUTMENT SECTION  
AB3 3/4" = 1'-0"

- △ DENOTES FORM FINISH
- △ DENOTES FLOAT FINISH
- △ DENOTES SMOOTH TROWEL FINISH


Vermont Agency of Transportation  
**RECEIVED**  
CK'D BY RK/JW OK'D BY RY  
February 12, 2015  
RESUBMIT No Approved AsNoted  
BY RY DATE 02/12/2015  
2-10-15 REVISED PER VT AOT COMMENTS

MARK: FA-AB4	QTY.: 1	WT.: 28.94 T	VOL.: 14.29 cy
MATERIAL LIST / ABUTMENT			
ITEM	MARK	DESCRIPTION	QTY.
1			
2			
3			
4			
5			
6			
7		SET OF (4) 0.60" x 270 KSI STRAND LIFTING LOOPS	2
8		8" x 5'-2" (MAX.) CORRUGATED STEEL SLEEVE (GALV.)	8
9		2'-0" x 5'-2 3/4" CORRUGATED STEEL SLEEVE (GALV.)	4
10			


APPROVAL STAMP:	<b>J.P. CARRARA &amp; SONS INC.</b> Precast & Prestress Manufacturer 2464 CASE ST., MIDDLEBURY, VERMONT 05753 Phone: (802)388-6361 Fax: (802)388-9010	A.L. St. ONGE CONTRACTOR MONTMERY, VERMONT
STATE OF VERMONT AGENCY OF TRANSPORTATION COUNTY OF FRANKLIN		DATE: NOV. 10, 2014 SCALE: NOTED
TOWN OF FAIRFIELD ELM BROOK ROAD, TOWN HIGHWAY 47 (CLASS 3) BRIDGE NO.: 46 PROJECT NO.: BRO 1448(41)		CHKD: B.C. DFTM: B.L. JOB NO: 23446-014
PRECAST ABUTMENT DIMENSIONAL DETAILS		DWG. NO: AB3

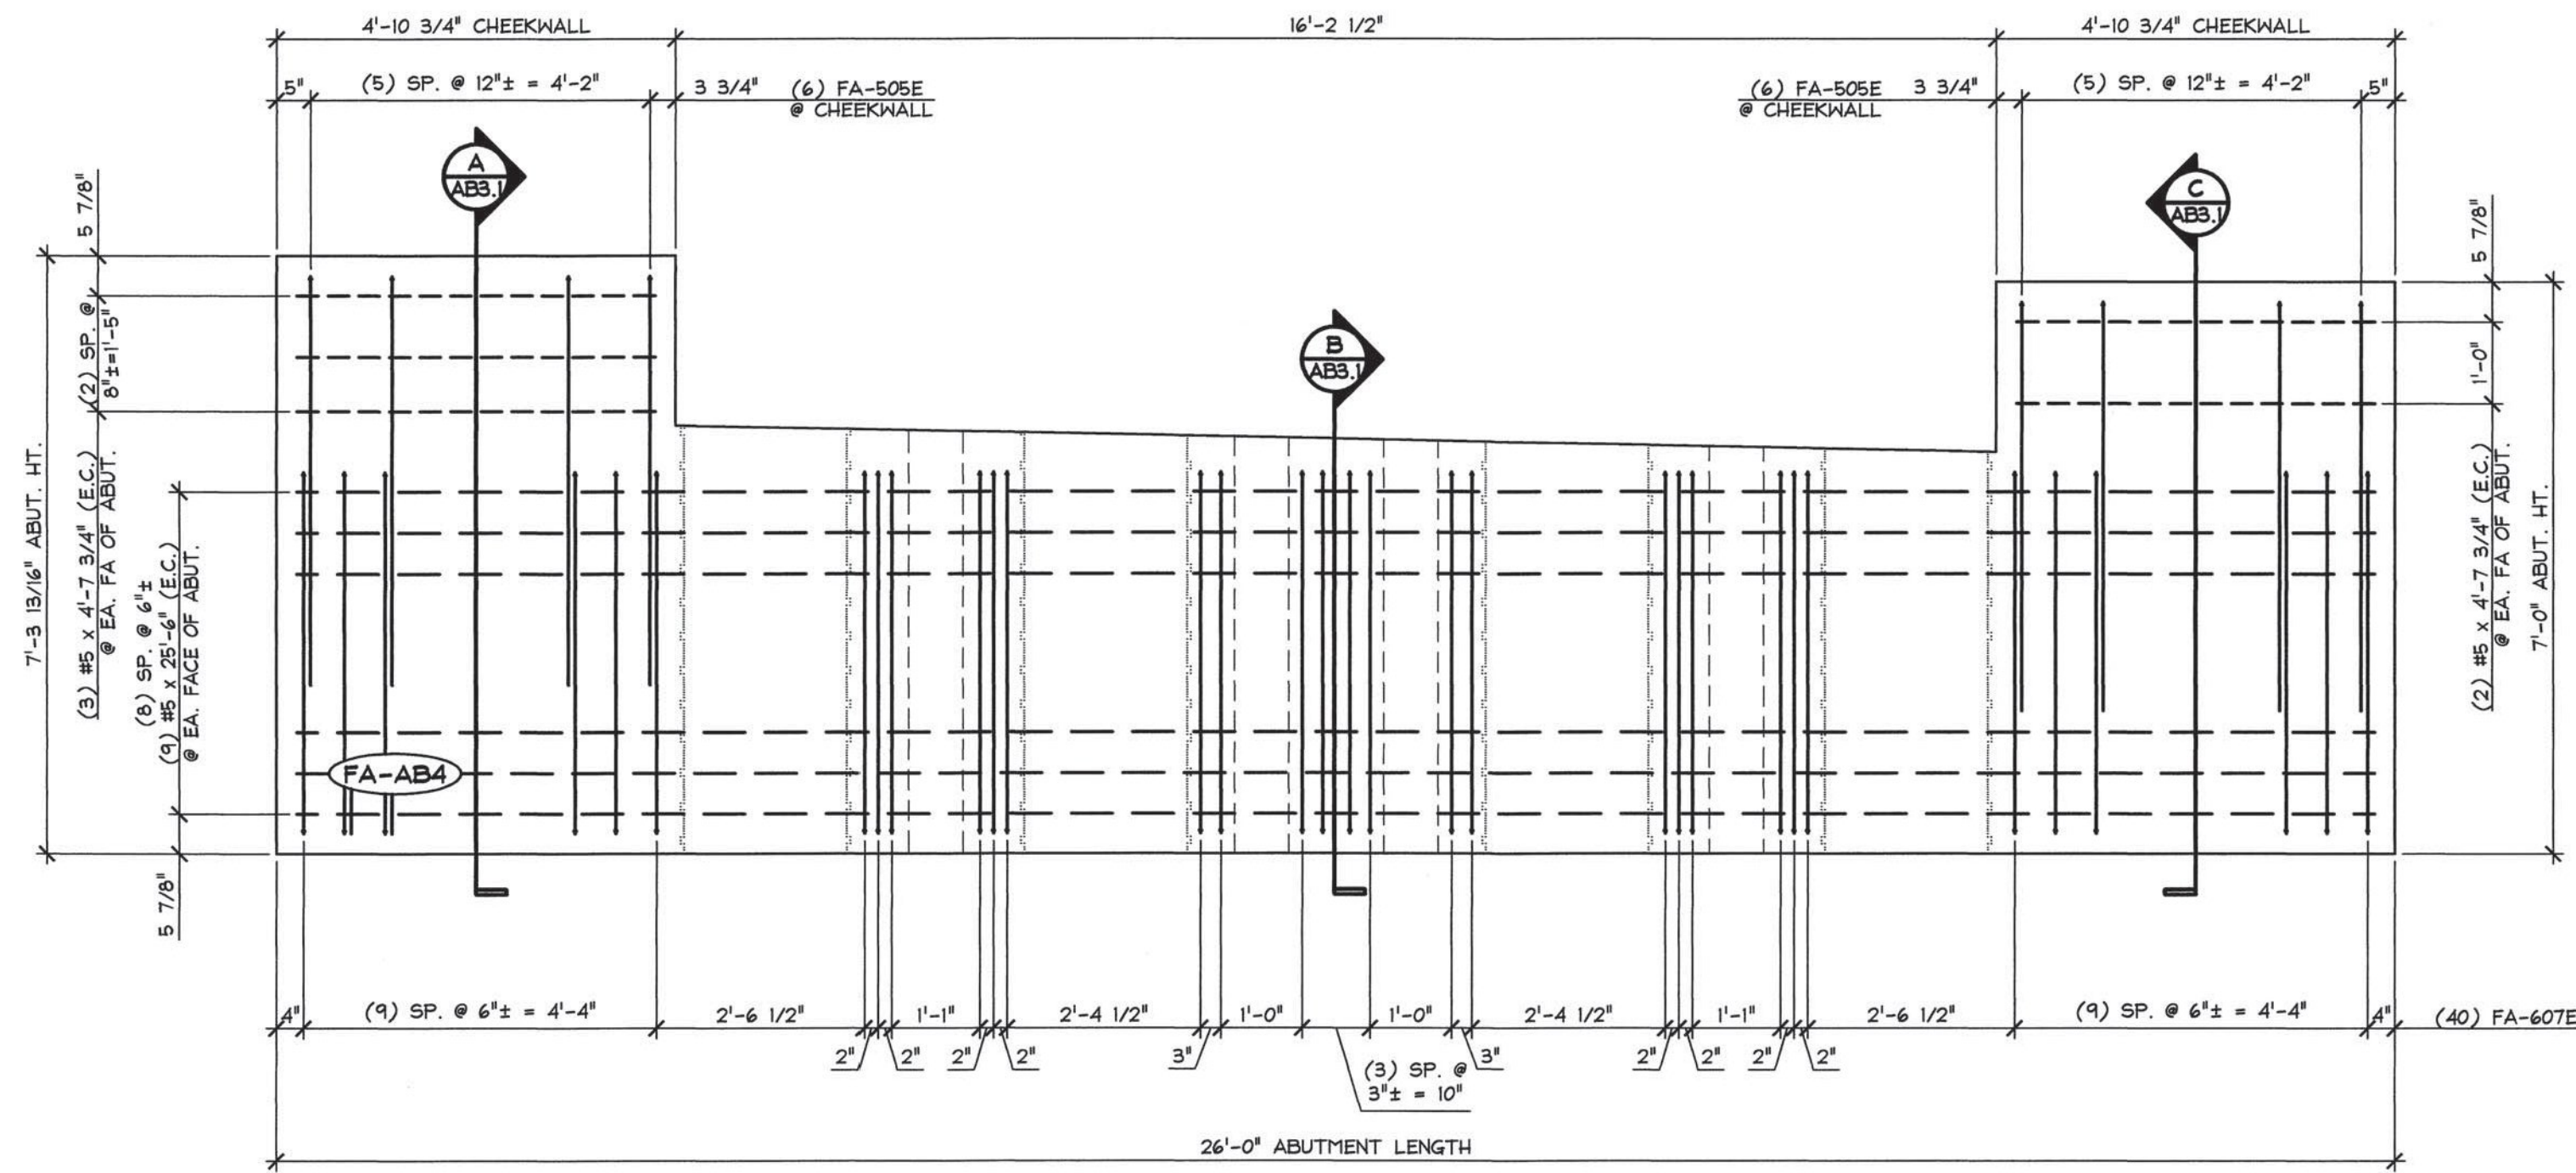


**1 REINFORCING ELEVATION VIEW IN FORM**  
 AB3.1 1/2" = 1'-0"

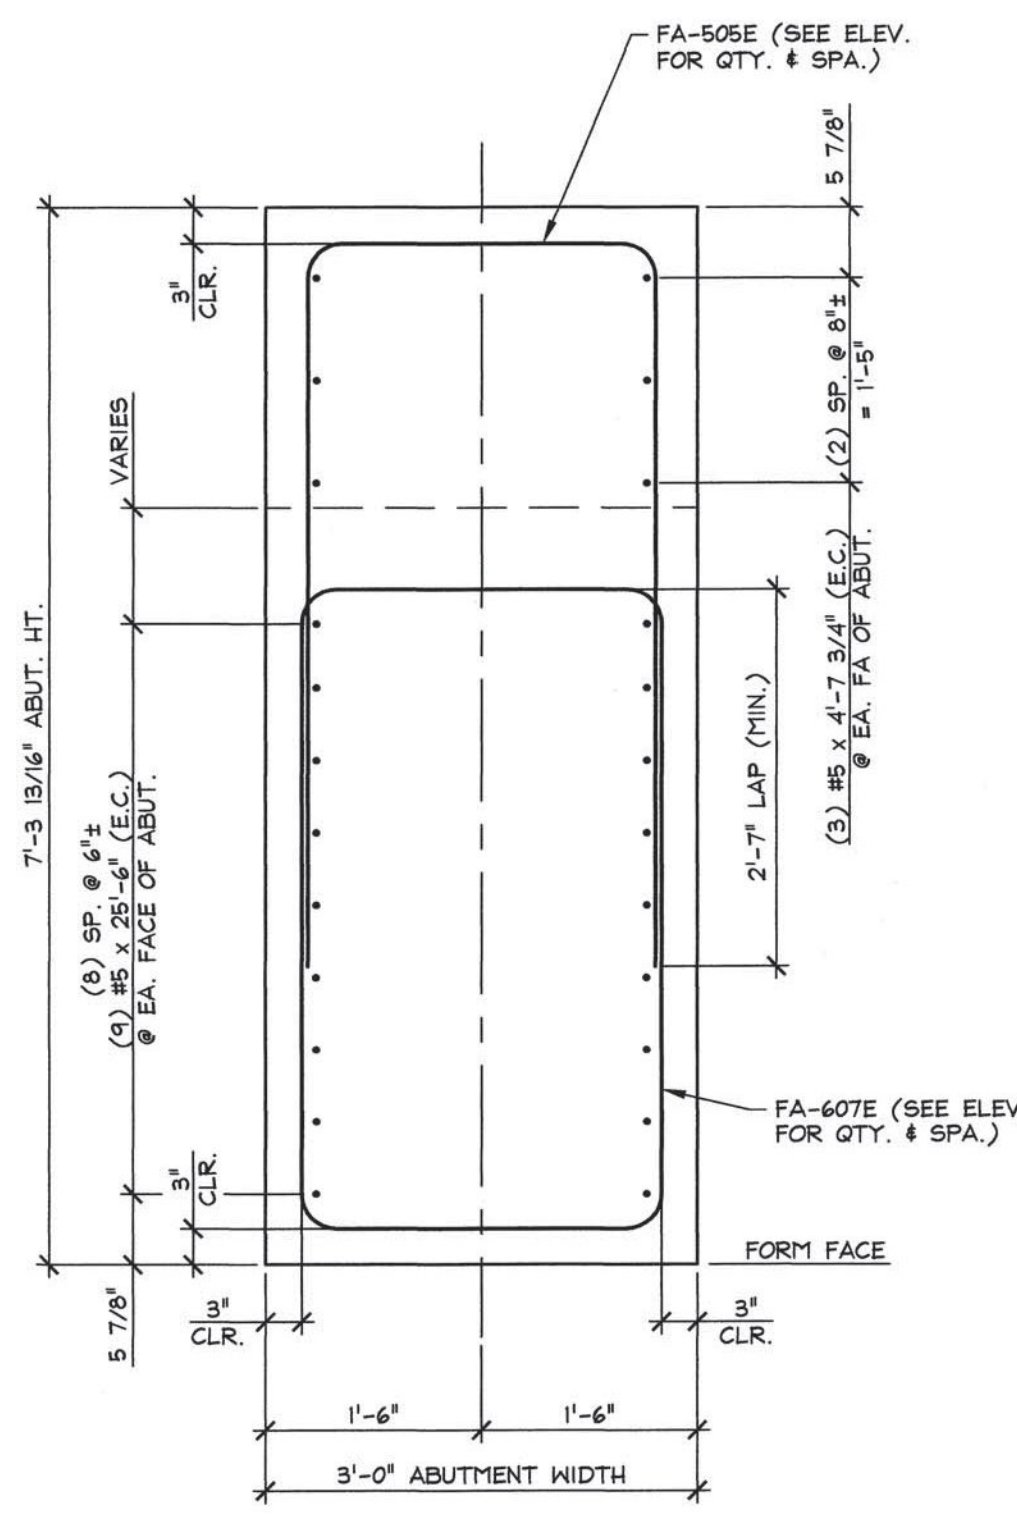

**A ABUTMENT SECTION**  
 AB3.1 3/4" = 1'-0"

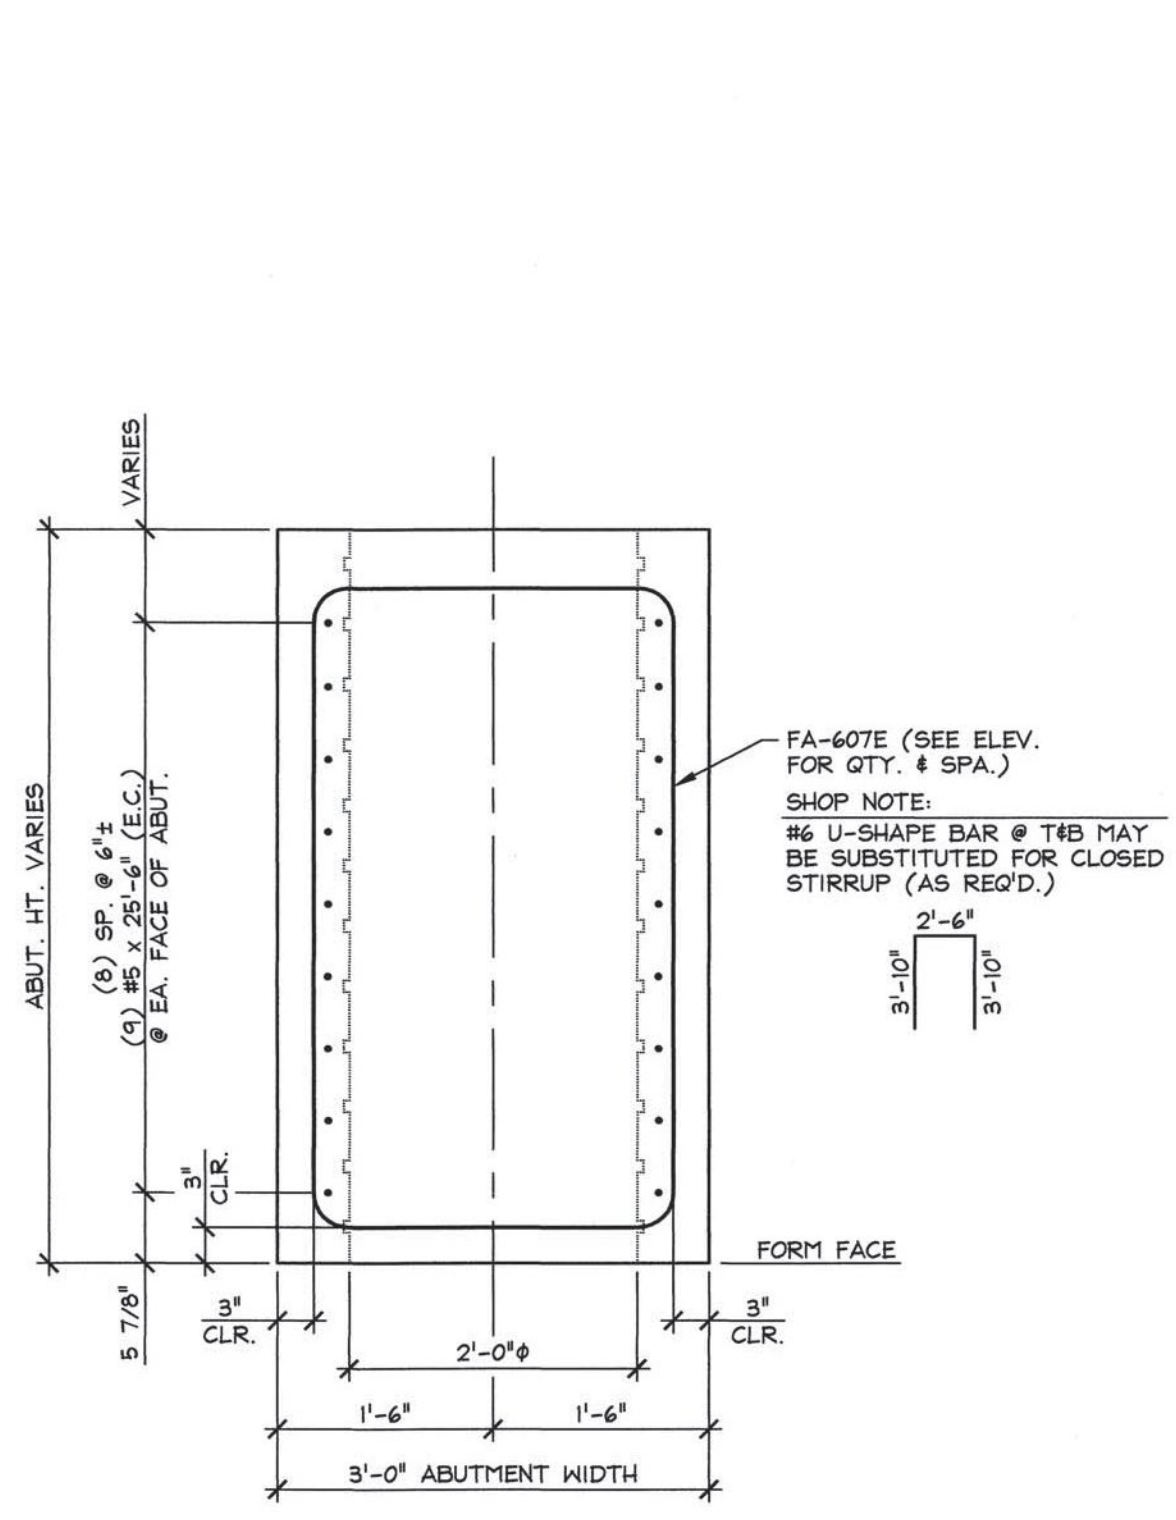

**B ABUTMENT SECTION**  
 AB3.1 3/4" = 1'-0"

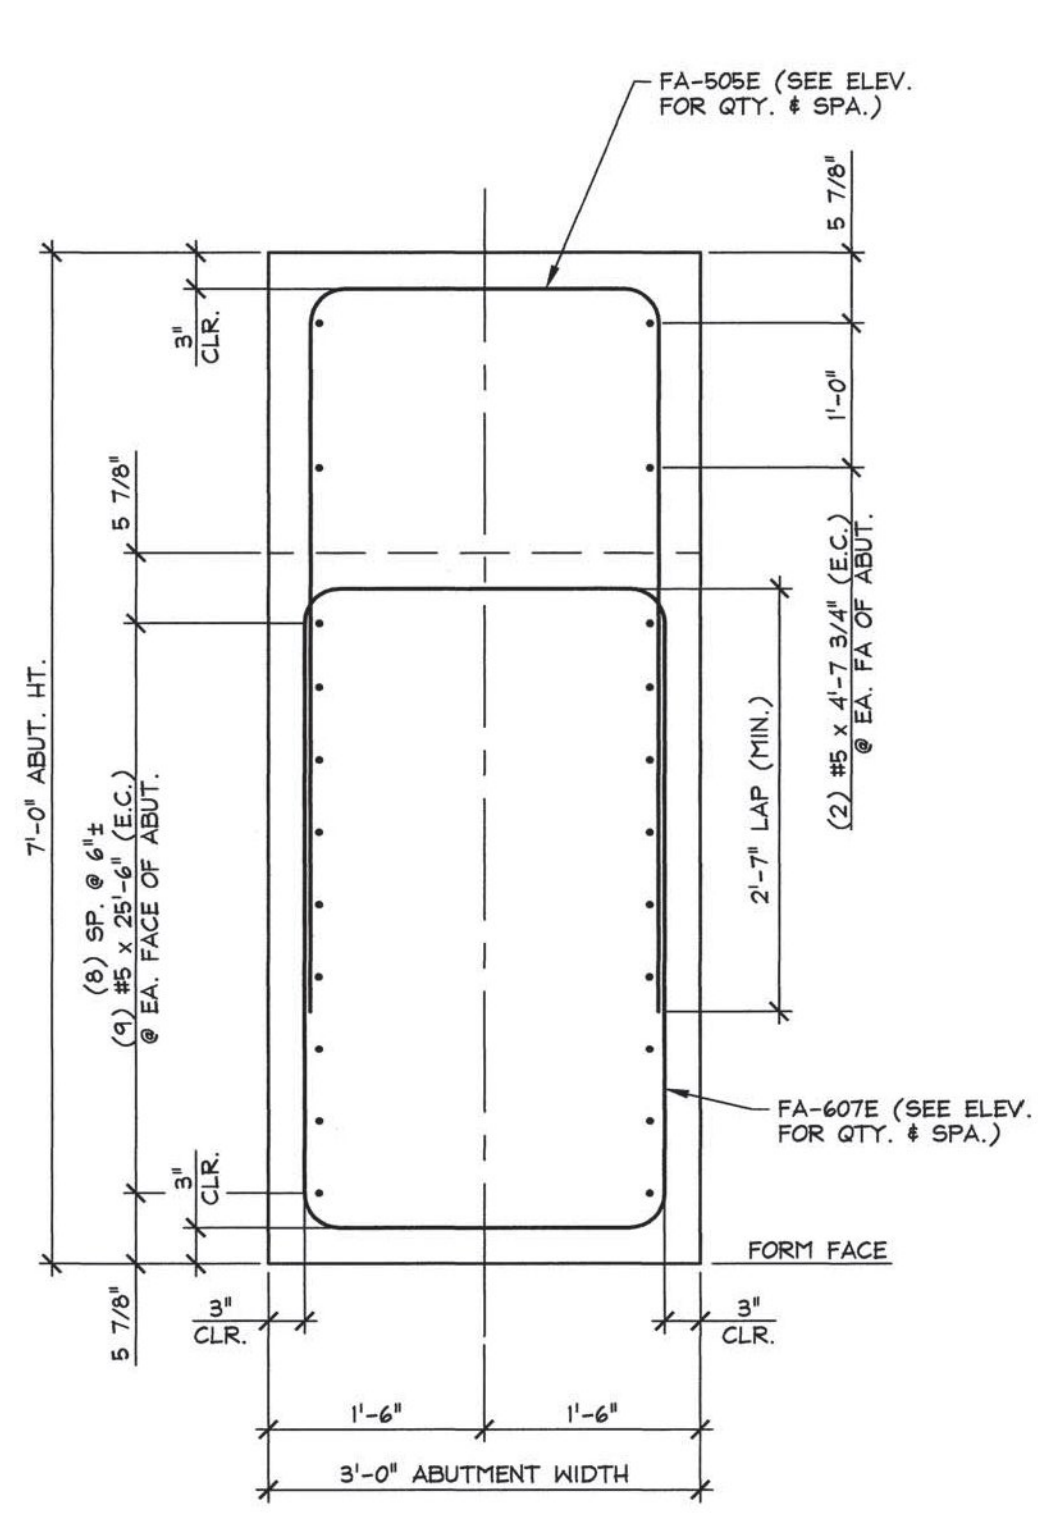


**C ABUTMENT SECTION**  
 AB3.1 3/4" = 1'-0"


Vermont Agency of Transportation  
**RECEIVED**  
 CK'D BY RK/JW OK'D BY RY  
 February 12, 2015  
 RESUBMIT No Approved  
 BY RY DATE 02/12/2015  
 2-10-15 REVISED PER VT AOT COMMENTS

MARK: FA-AB4 QTY.: 1			
MATERIAL LIST / ABUTMENT			
ITEM	MARK	DESCRIPTION	QTY.
1	FA-505E	#5 BENT BAR (LEVEL 1, EPOXY COATED)	12
2		#5 x 25'-6" (LEVEL 1, EPOXY COATED)	18
3		#5 x 4'-7 3/4" (LEVEL 1, EPOXY COATED)	10
4			
5	FA-607E	#6 BENT BAR (LEVEL 1, EPOXY COATED)	40
6			
7			
8			
9			
10			


APPROVAL STAMP:	<b>J.P. CARRARA &amp; SONS INC.</b> Precast & Prestress Manufacturer 244 GAGE ST., MIDDLEBURY, VERMONT 05753 Phone: (802)388-6361 Fax: (802)388-8010	<b>A.L. St. ONGE</b> CONTRACTOR MONTMERY, VERMONT
	STATE OF VERMONT AGENCY OF TRANSPORTATION COUNTY OF FRANKLIN	
	TOWN OF FAIRFIELD ELM BROOK ROAD, TOWN HIGHWAY 47 (CLASS 3) BRIDGE NO.: 46 PROJECT NO.: BRO 1448(41)	
	PRECAST ABUTMENT REINFORCING DETAILS	
	DATE: NOV. 10, 2014	
	SCALE: NOTED	
	CHKD: B.C. DFTM: B.L.	
	JOB NO: 23446-014	
	DWG. NO: AB3.1	

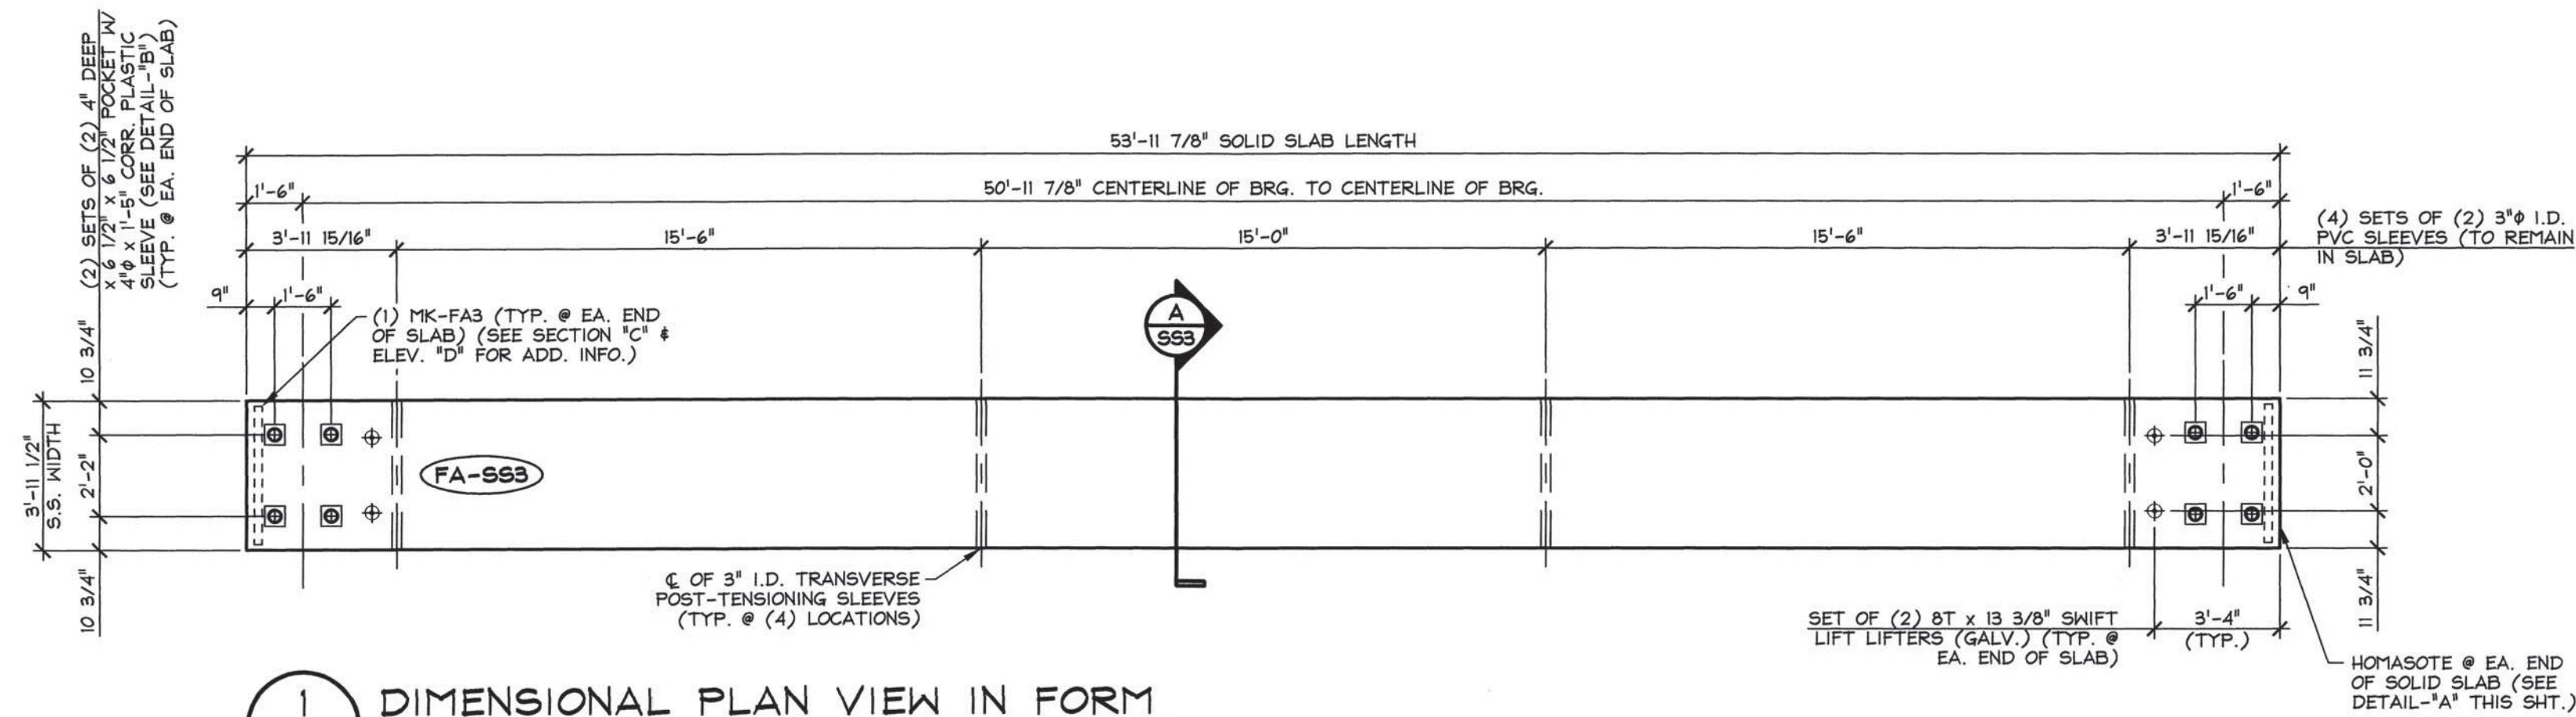

1 DIMENSIONAL PLAN VIEW IN FORM  
S53 1/4" = 1'-0"




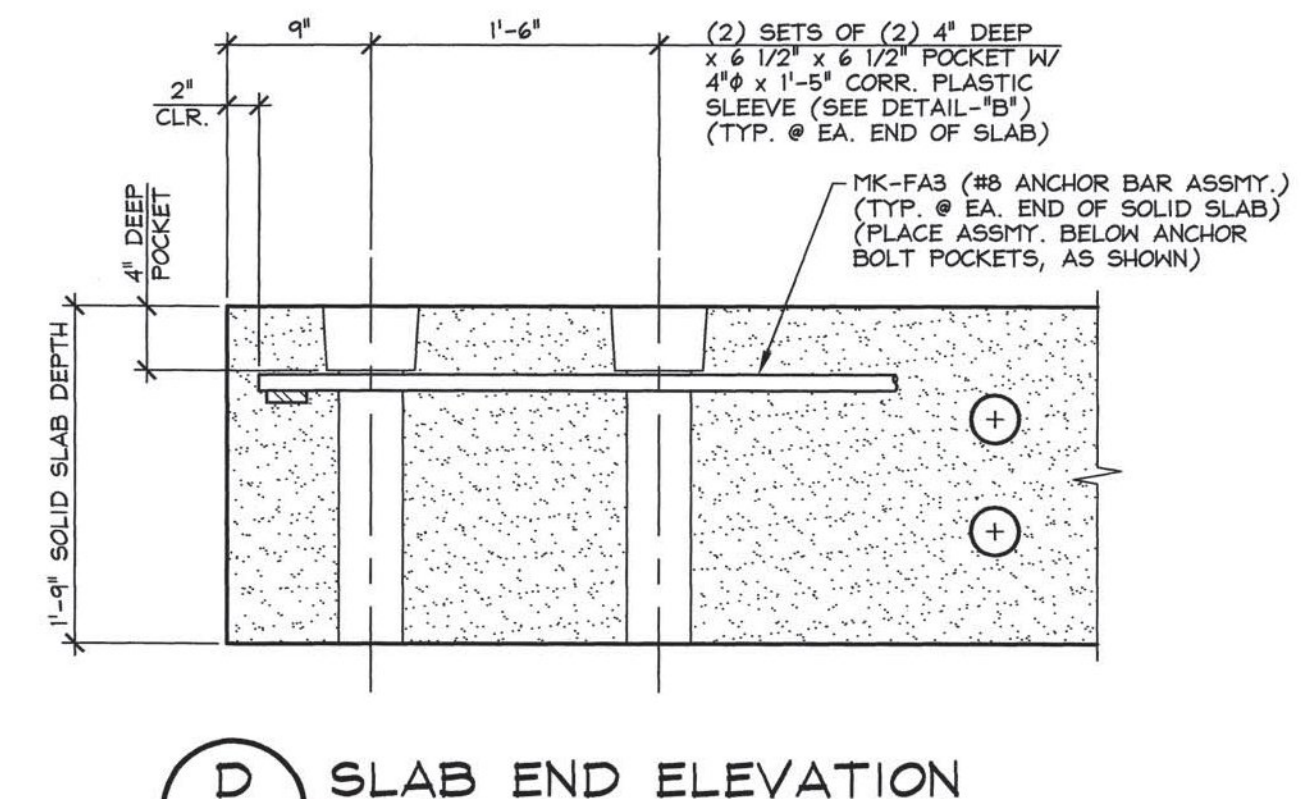


D SLAB END ELEVATION  
S53 1" = 1'-0"

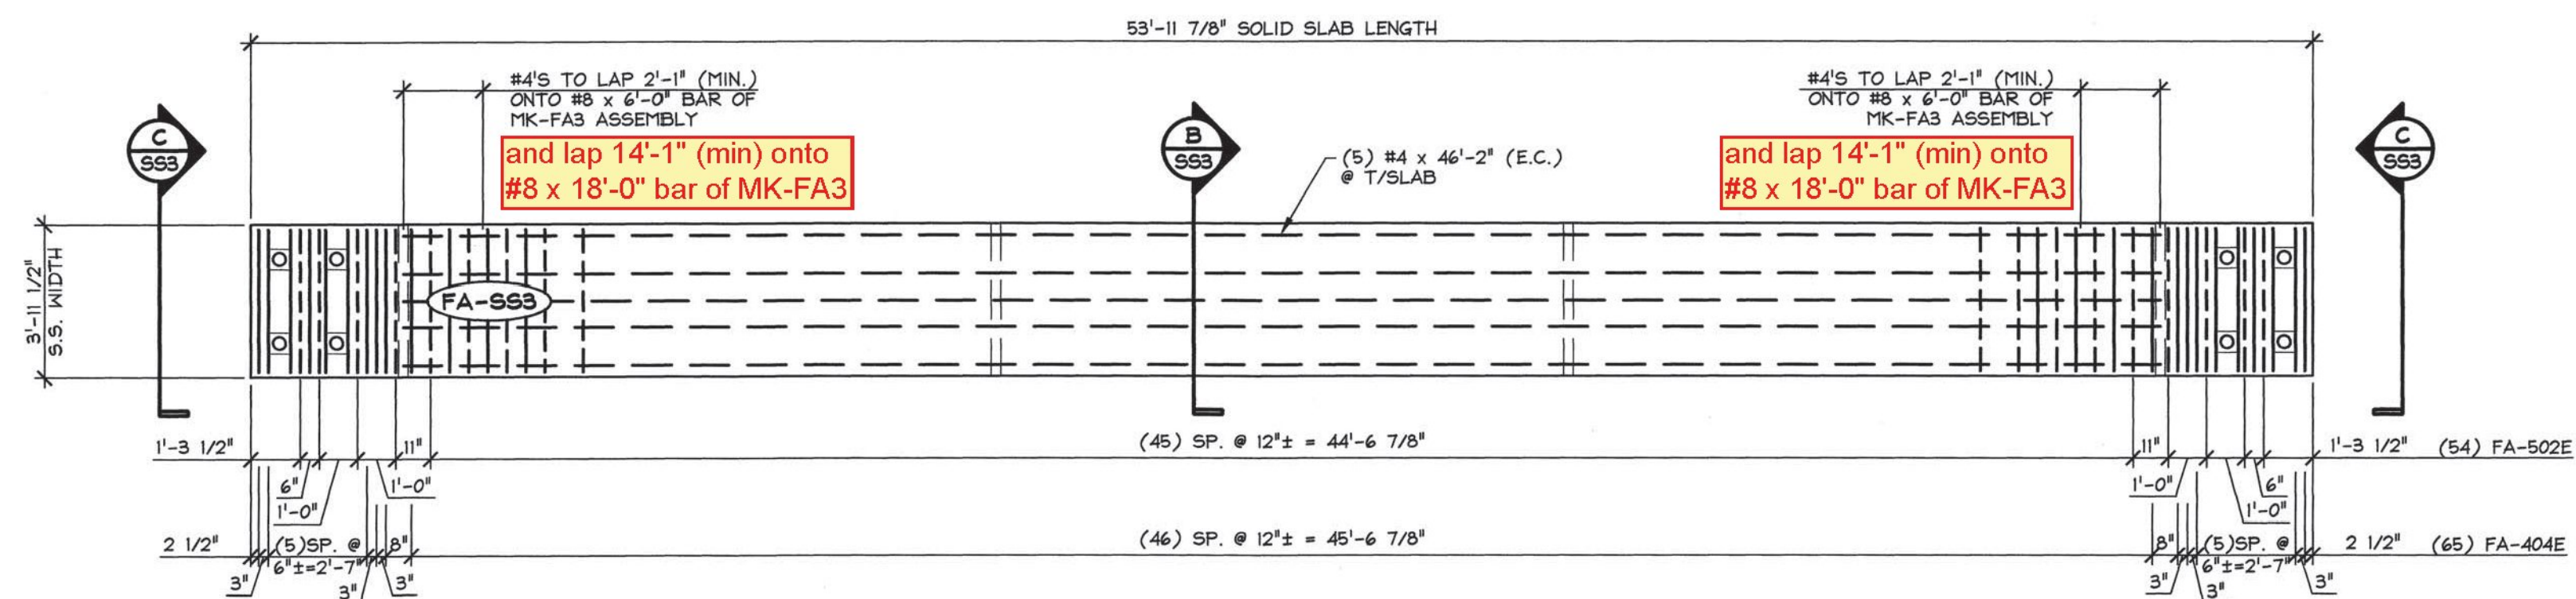


2 REINFORCING PLAN VIEW IN FORM  
S53 1/4" = 1'-0"


Note: MK-FA3 not shown for clarity. See Slab End Elevation detail this sheet for MK-FA3 placement.

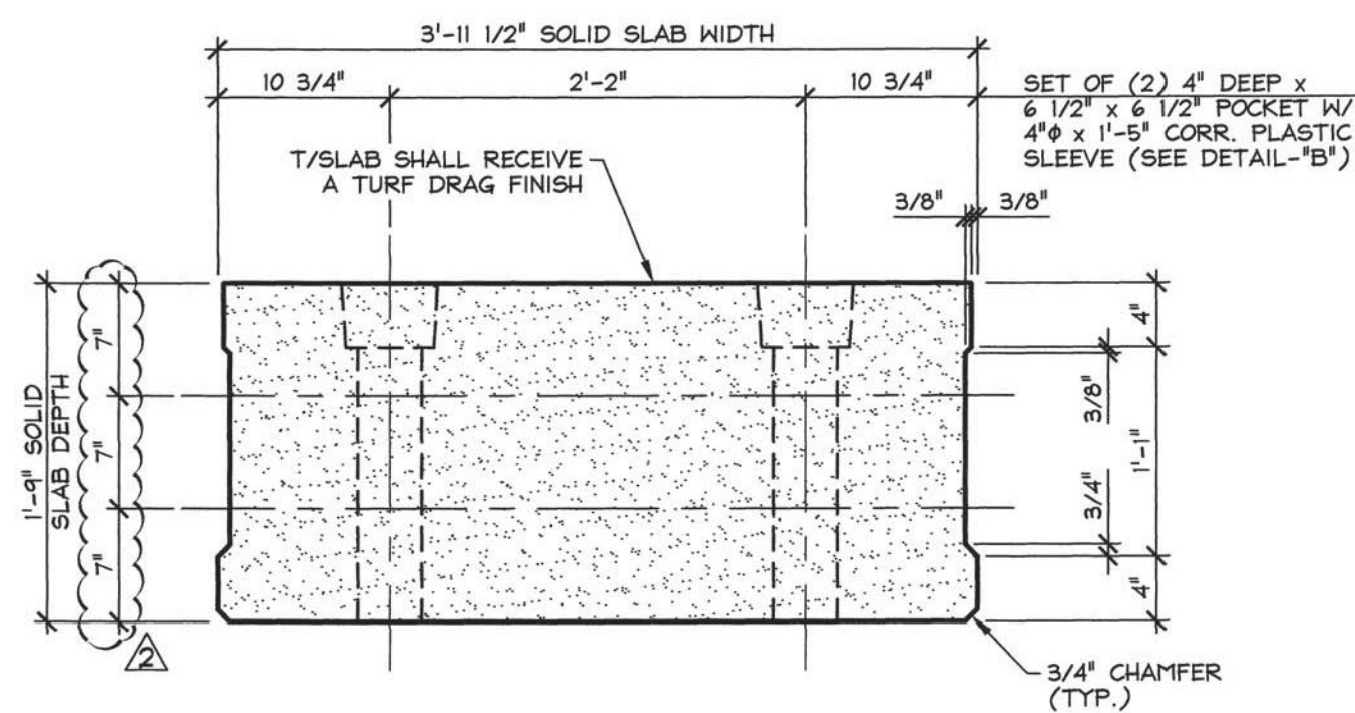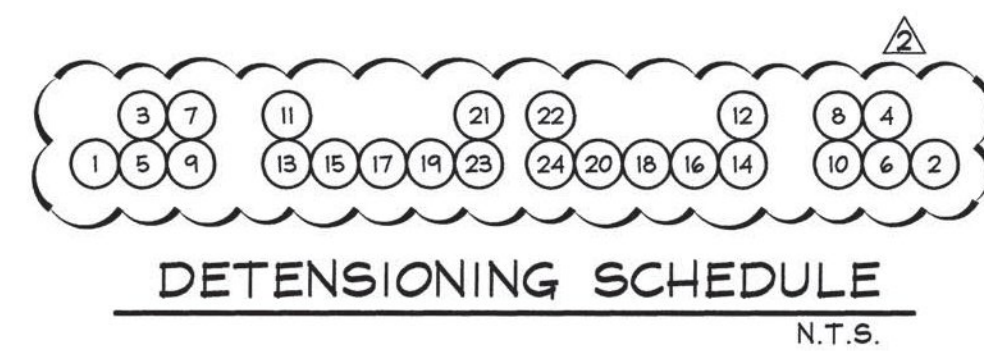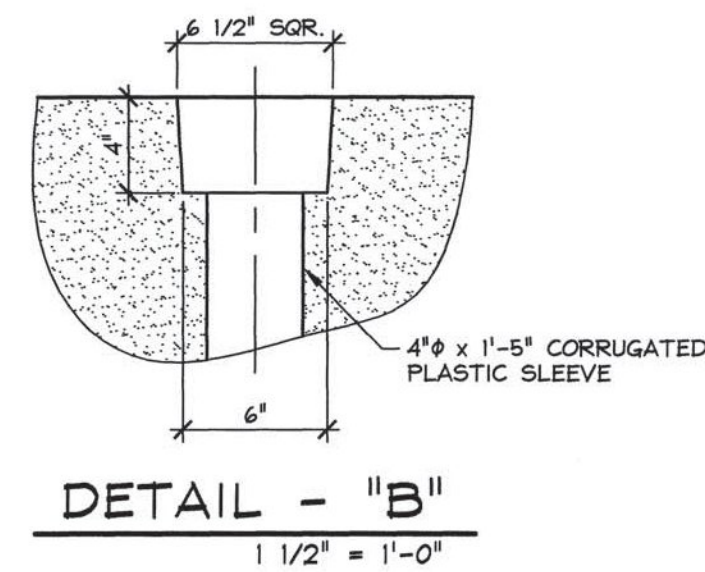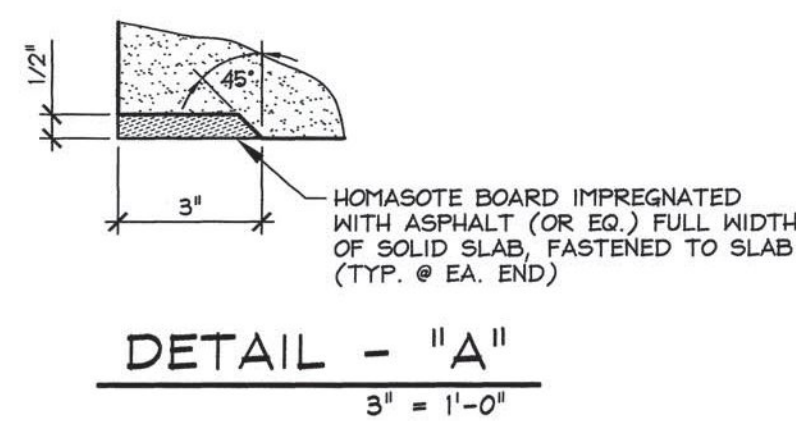

A DIMENSIONAL SECTION  
S53 1" = 1'-0"

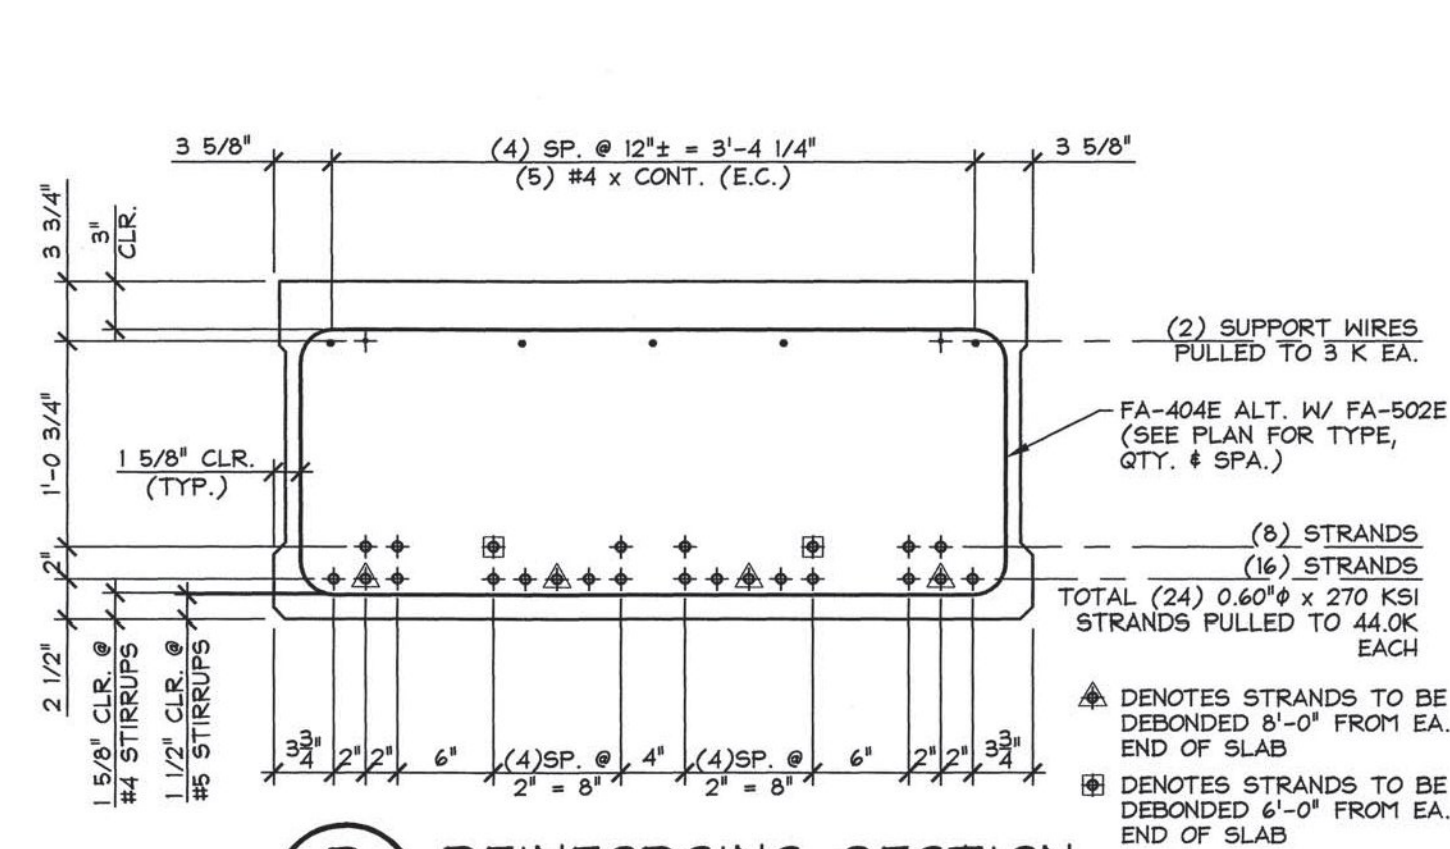

B REINFORCING SECTION  
S53 @ MID-SPAN 1" = 1'-0"

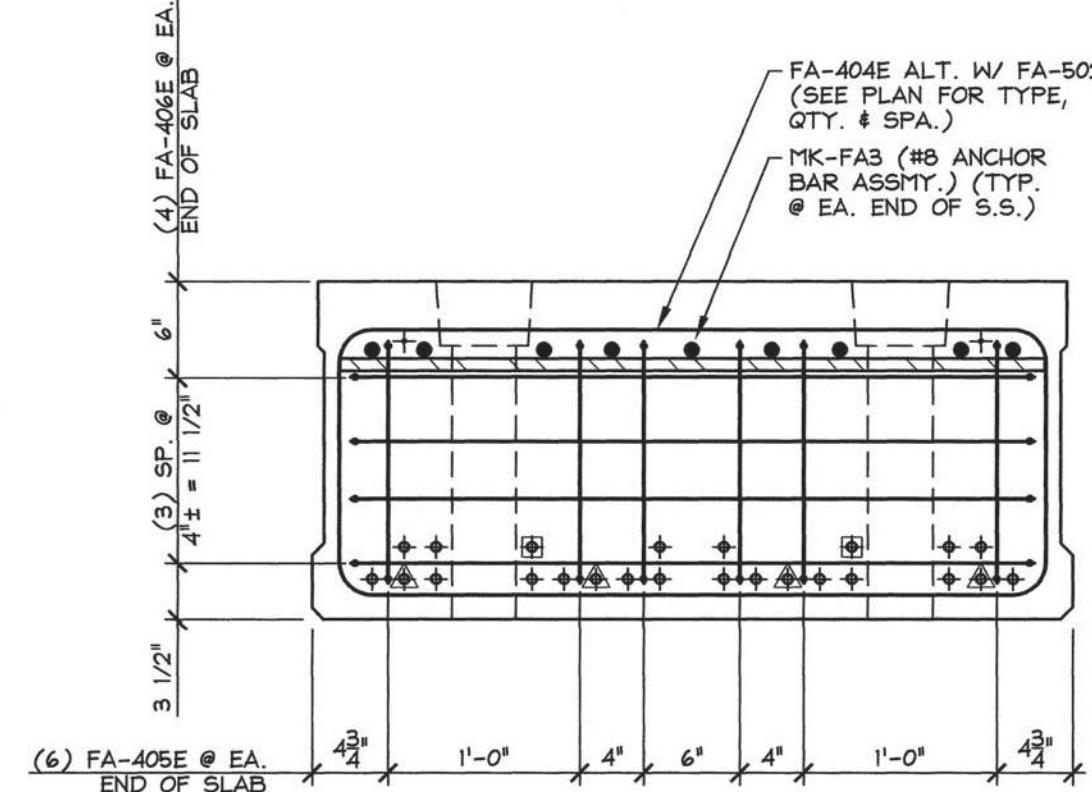



C REINFORCING SECTION  
S53 @ BEAM END 1" = 1'-0"

Vermont Agency of Transportation  
**RECEIVED**  
CK'D BY RK/JW OK'D BY RY  
February 12, 2015  
RESUBMIT No Approved AsNoted  
BY RY DATE 02/12/2015  
2-12-15 REVISE P.T. DUCTS & STRAND PATTERN  
2-10-15 REVISED PER VT AOT COMMENTS


MATERIAL LIST / SOLID SLAB			
ITEM	MARK	DESCRIPTION	QTY.
1	FA-404E	#4 BENT BAR (LEVEL I, EPOXY COATED)	66
2	FA-405E	#4 BENT BAR (LEVEL I, EPOXY COATED)	12
3	FA-406E	#4 BENT BAR (LEVEL I, EPOXY COATED)	8
4		#4 x 46'-2" (LEVEL I, EPOXY COATED)	5
5			
6	FA-502E	#5 BENT BAR (LEVEL I, EPOXY COATED)	54
7			
8	MK-FA3	ANCHOR BAR 3/4" THICK x 2 1/2" x 3'-8" (ASTM A36) W/ (3) #8 x 18'-0" & (6) #8 x 6'-0" (ASTM A-706) (GALV. ASSM'T.)	2
9		8T x 13 3/8" SWIFT LIFT LIFTERS (GALV.)	4
10		4" x 1'-5" CORRUGATED PLASTIC SLEEVE	8

APPROVAL STAMP:	J.P. CARRARA & SONS INC. Precast & Prestress Manufacturer 2464 OSE STR., MIDDLEBURY, VERMONT 05753 Phone:(802)388-6361 Fax:(802)388-9010	A.L. St. ONGE CONTRACTOR MONTOMERY, VERMONT
STATE OF VERMONT AGENCY OF TRANSPORTATION COUNTY OF FRANKLIN		DATE: NOV. 10, 2014 SCALE: NOTED
TOWN OF FAIRFIELD ELM BROOK ROAD, TOWN HIGHWAY 47 (CLASS 3) BRIDGE NO.: 46 PROJECT NO.: BRO 1448(41)		CHKD: B.C. DFTM: B.L. JOB NO: 23446-014
PRESTRESSED SOLID SLAB DETAILS		DWG. NO: S53








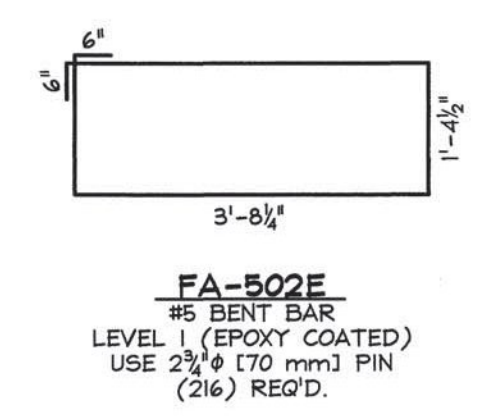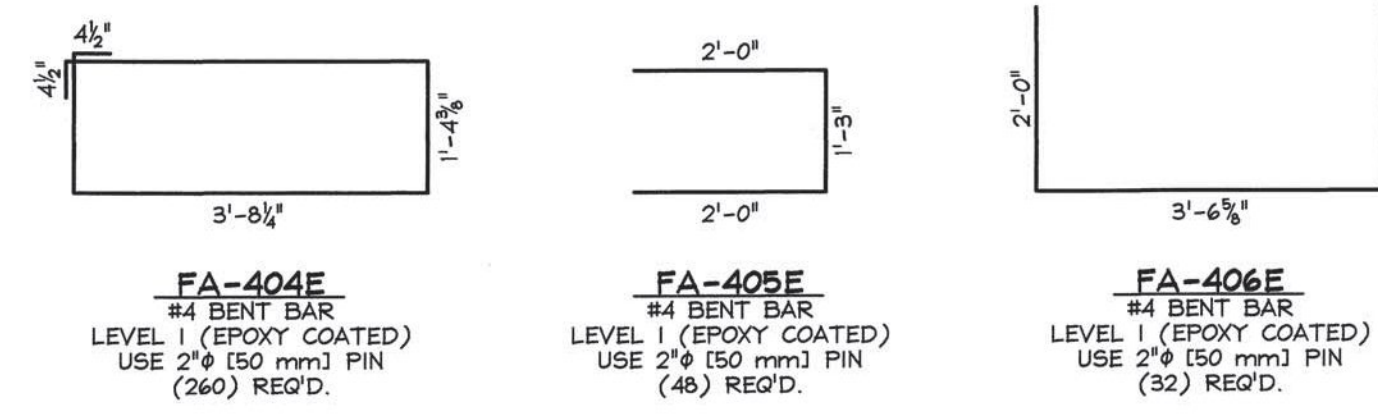

**PRESTRESSED SOLID SLABS**

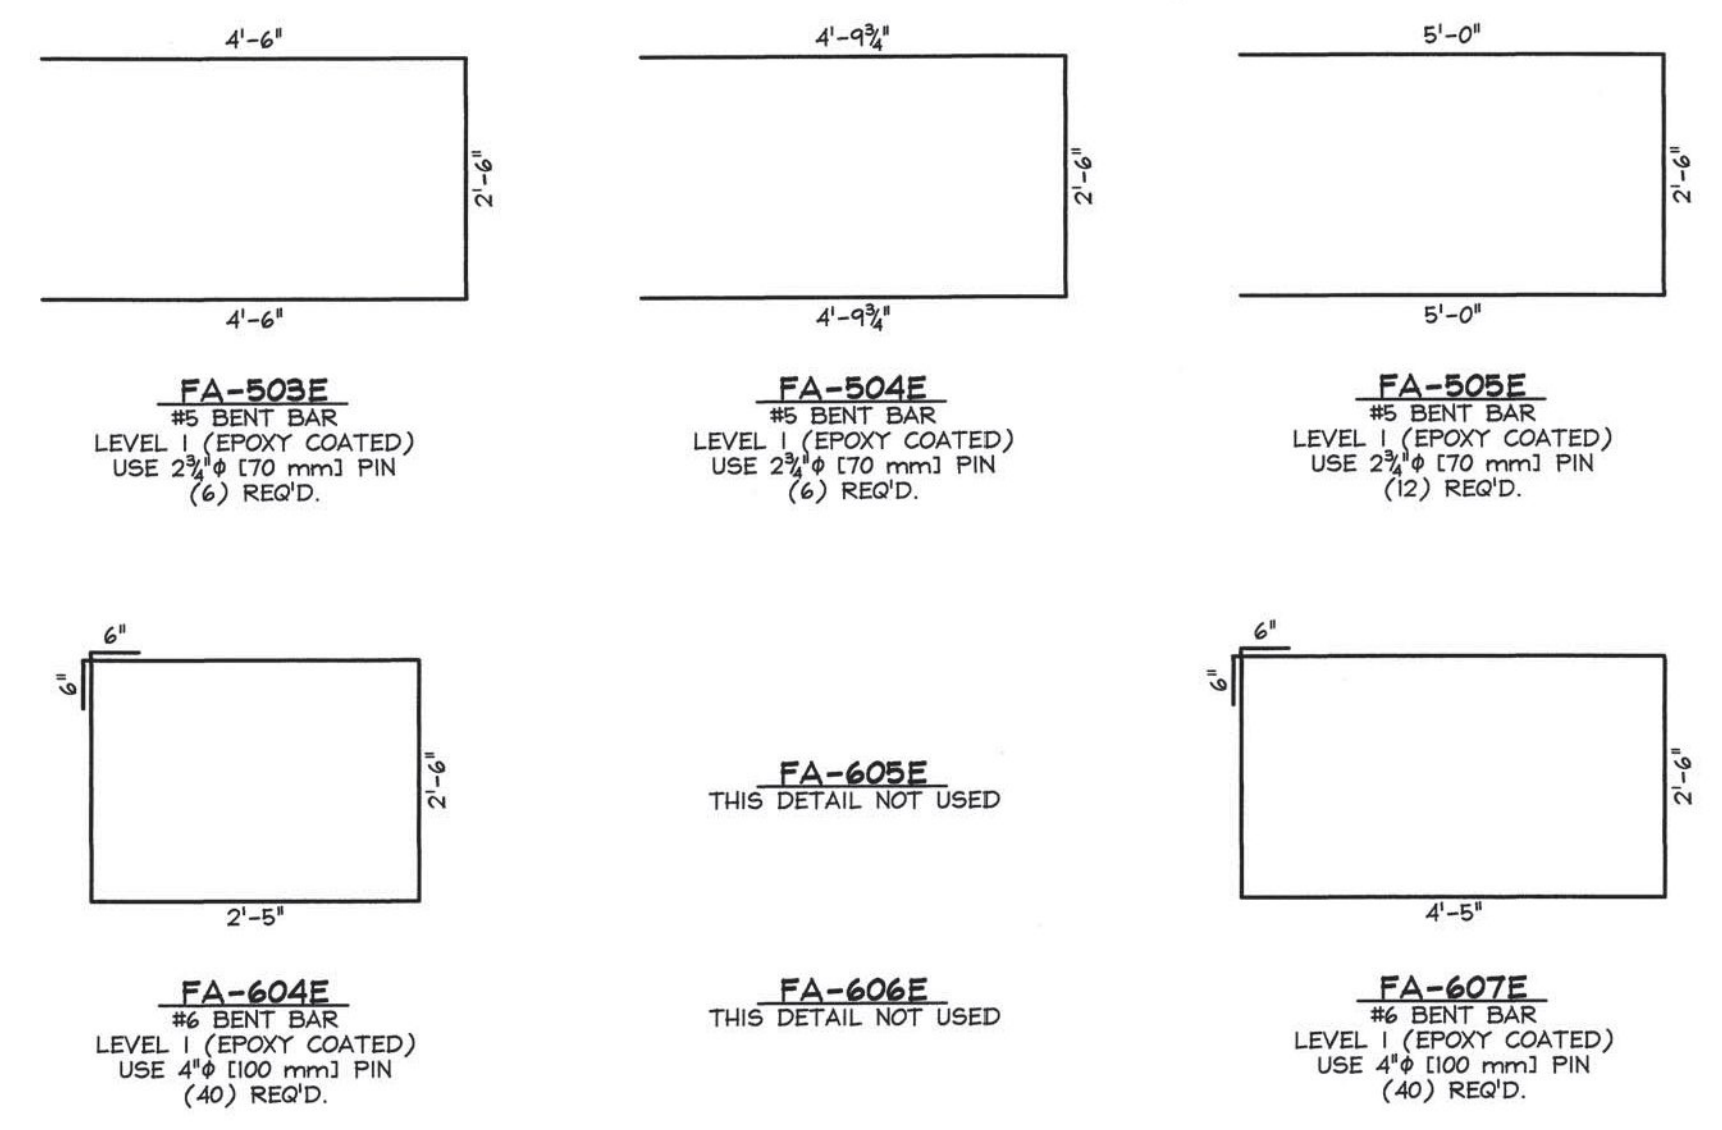

**PRECAST ABUTMENTS**

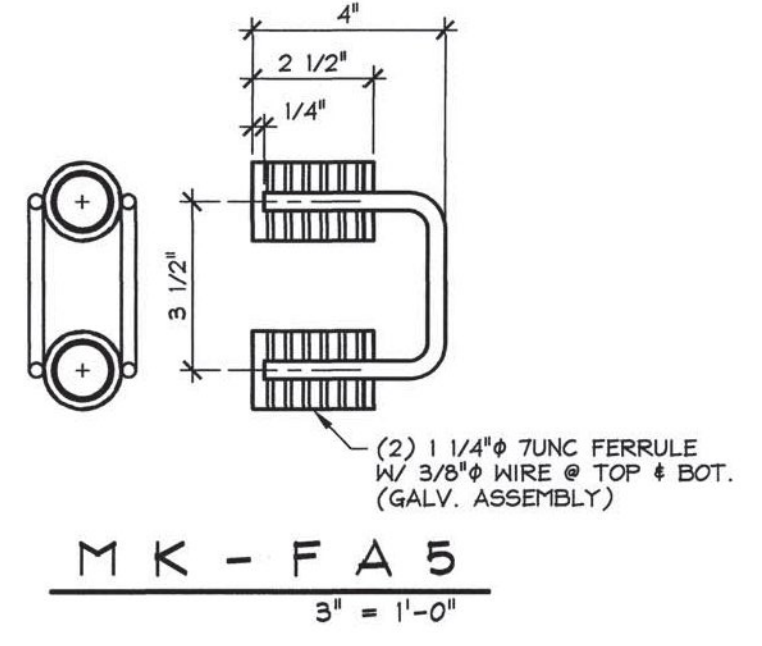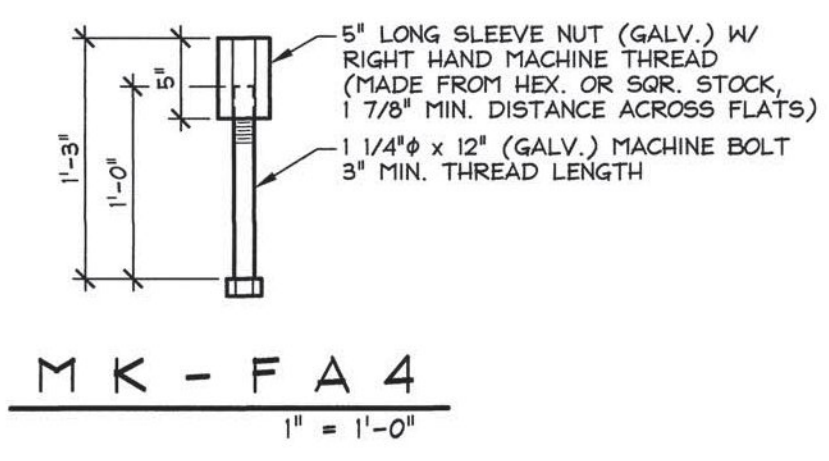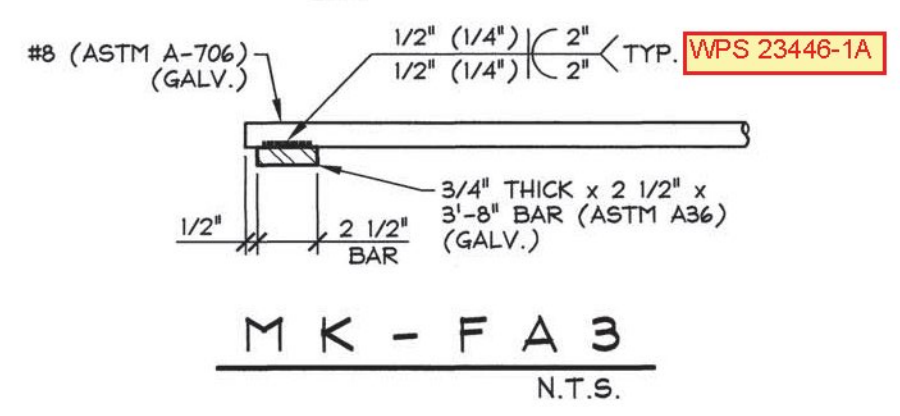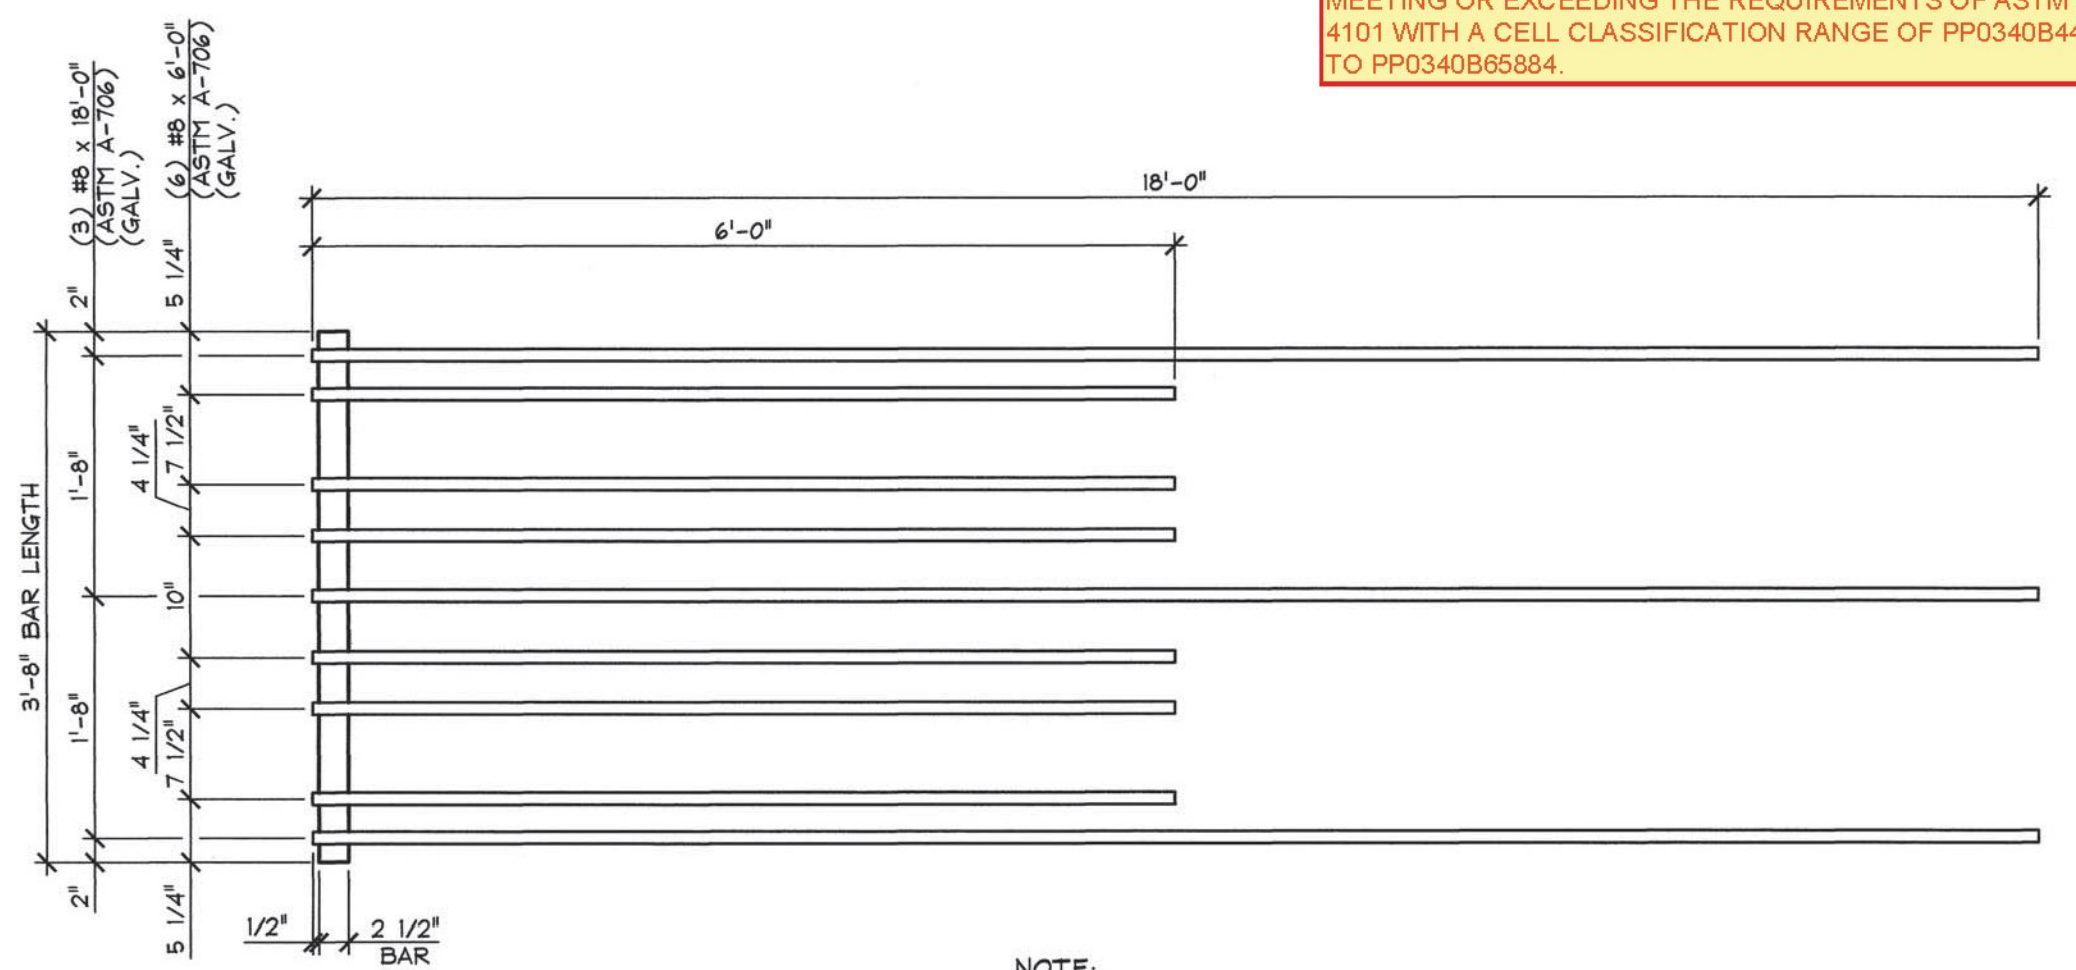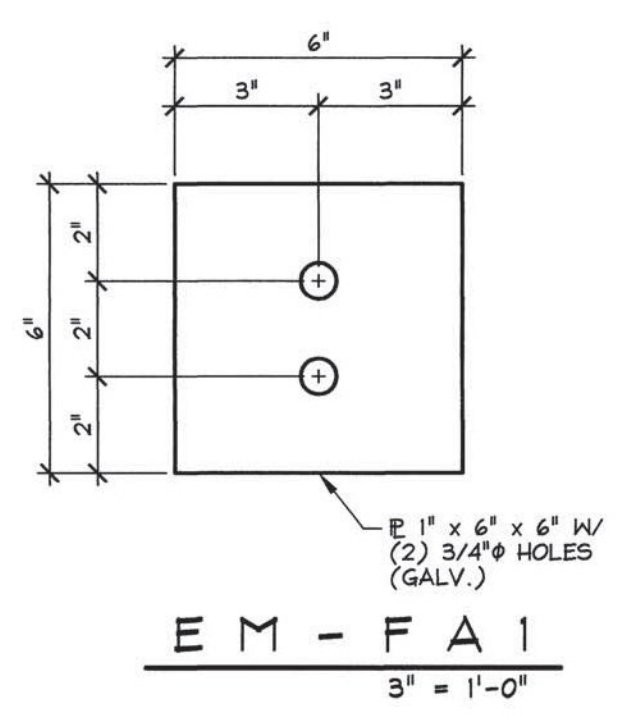

Material requirements per note 20 sheet 40/69 of contract plans: CORRUGATED POST-TENSIONING DUCTS IN THE PRESTRESSED SLABS FOR ANCHOR BOLT CONNECTIONS SHALL BE CONSTRUCTED FROM EITHER POLYETHYLENE OR POLYPROPYLENE. THE DUCT SHALL HAVE A MINIMUM MATERIAL THICKNESS OF 0.080 IN. +/- 0.010 IN. AND SHALL HAVE A WHITE COATING ON THE OUTSIDE OR SHALL BE OF WHITE MATERIAL WITH ULTRAVIOLET STABILIZERS ADDED. POLYETHYLENE DUCT SHALL BE FABRICATED FROM RESINS MEETING OR EXCEEDING THE REQUIREMENTS OF ASTM D 3350 WITH A CELL CLASSIFICATION OF 345464A. POLYPROPYLENE DUCT SHALL BE FABRICATED FROM RESINS MEETING OR EXCEEDING THE REQUIREMENTS OF ASTM D 4101 WITH A CELL CLASSIFICATION RANGE OF PP0340B44544 TO PP0340B65884.

NOTE: AFTER MK-FA3 ASSEMBLY HAS BEEN GALVANIZED, ENTIRE ASSEMBLY SHALL BE COATED WITH TWO PART EPOXY REPAIR MATERIAL IN ACCORDANCE WITH LEVEL II, DUAL COATED REINFORCING STEEL MANUFACTURER INSTRUCTIONS.

MISCELLANEOUS MATERIALS				
ITEM	MARK	QTY.	DESCRIPTION	REMARKS
1	EM-FA1	16	6' x 6' x 6' W/ (2) 3/4" HOLES (GALV.)	FOR ERECTION; SEE DETAIL THIS SHEET
2		16	0.60" x 270 KSI x 18'-9" LONG POLY-STRAND	FOR ERECTION
3		32	0.60" SINGLE USE STRESSING CHUCK	FOR ERECTION
4				
5				
6		20	#4 x 46'-2" (LEVEL I, EPOXY COATED)	
7				
8				
9	MK-FA3	8	ANCHOR BAR 3/4" THICK x 2 1/2" x 3'-8" (ASTM A36) W/ (3) #8 x 18'-0" (ASTM A-706) (GALV.)	GALVANIZED ASSEMBLY, SEE DETAIL THIS SHEET
10	MK-FA4	32	5" LG. SLEEVE NUT (GALV.) # 1 1/4" x 12" MACHINE BOLT	GALVANIZED, SEE DETAIL THIS SHEET
11	MK-FA5	16	2-BOLT FERRULE GUARD RAIL INSERT 1 1/4" TUNC	GALVANIZED, SEE DETAIL THIS SHEET
12		16	8T x 13 3/8" SHIFT LIFT LIFTER	GALVANIZED
13		32	4" x 1'-5" CORRUGATED PLASTIC ANCHOR DOWEL SLEEVE	
14				
15				
16		28	#5 x 25'-6" (LEVEL I, EPOXY COATED)	
17		20	#5 x 4'-7 3/4" (LEVEL I, EPOXY COATED)	
18				
19		1	BRIDGE PLAQUE	SUPPLIED BY OTHERS
20		8	8" x 3'-2" (MAX.) CORRUGATED STEEL SLEEVE	GALVANIZED, AASHTO M 36, TYPE 1
21		8	8" x 5'-2" (MAX.) CORRUGATED STEEL SLEEVE	GALVANIZED, AASHTO M 36, TYPE 1
22		4	2'-0" x 3'-2 3/4" CORRUGATED STEEL SLEEVE	GALVANIZED, AASHTO M 36, TYPE 1
23		4	2'-0" x 5'-2 3/4" CORRUGATED STEEL SLEEVE	GALVANIZED, AASHTO M 36, TYPE 1
24		4	SET OF (4) 0.60" x 270 KSI STRAND LIFTING LOOPS	
25				

Vermont Agency of Transportation  
**RECEIVED**  
 CK'D BY RK/JW OK'D BY RY  
 February 12, 2015  
 RESUBMIT No Approved AsNoted  
 BY RY DATE 02/12/2015

APPROVAL STAMP:	J.P. CARRARA & SONS INC. Precast & Prestress Manufacturer 244 GSE STR. MIDDLEBURY, VERMONT 05753 Phone:(802)388-6361 Fax:(802)388-9010	A.L. ST. ONGE CONTRACTOR MONTMERY, VERMONT
STATE OF VERMONT AGENCY OF TRANSPORTATION COUNTY OF FRANKLIN		DATE: NOV. 10, 2014
TOWN OF FAIRFIELD ELM BROOK ROAD, TOWN HIGHWAY 47 (CLASS 3) BRIDGE NO.: 46 PROJECT NO.: BRO 1448(41)		SCALE: NOTED
MATERIALS LIST		CHKD: B.C. DFTM: B.L. JOB NO: 23446-014
		DWG. NO: M2