




1 REINFORCING ELEVATION VIEW IN FORM
AB3.1 1/2" = 1'-0"

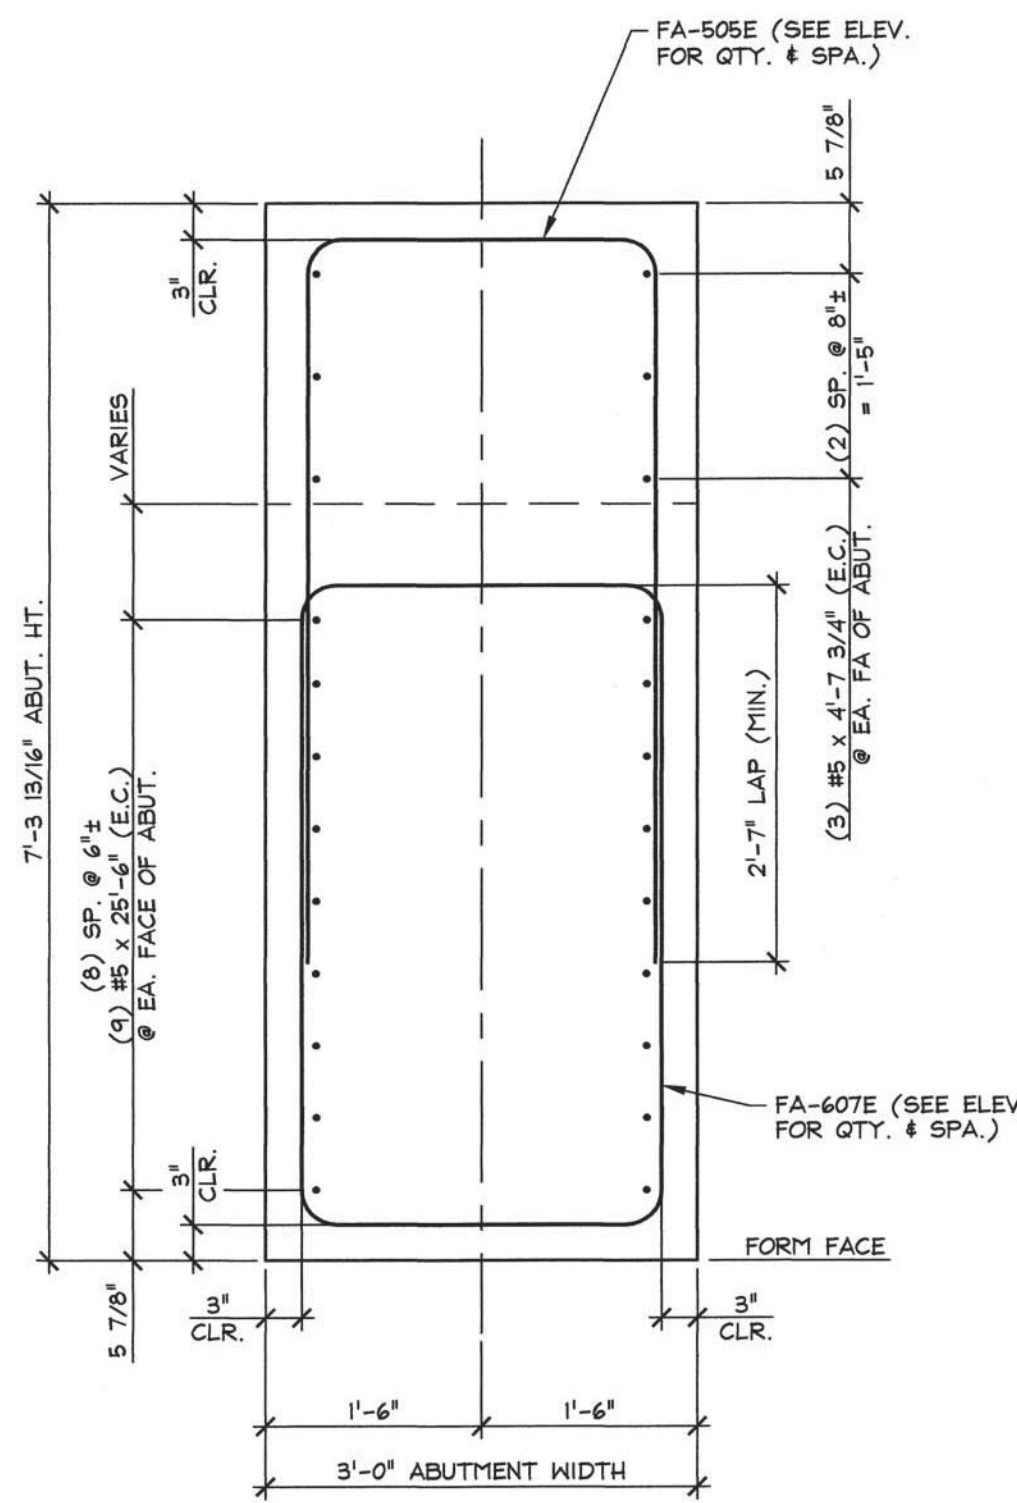

A ABUTMENT SECTION
AB3.1 3/4" = 1'-0"

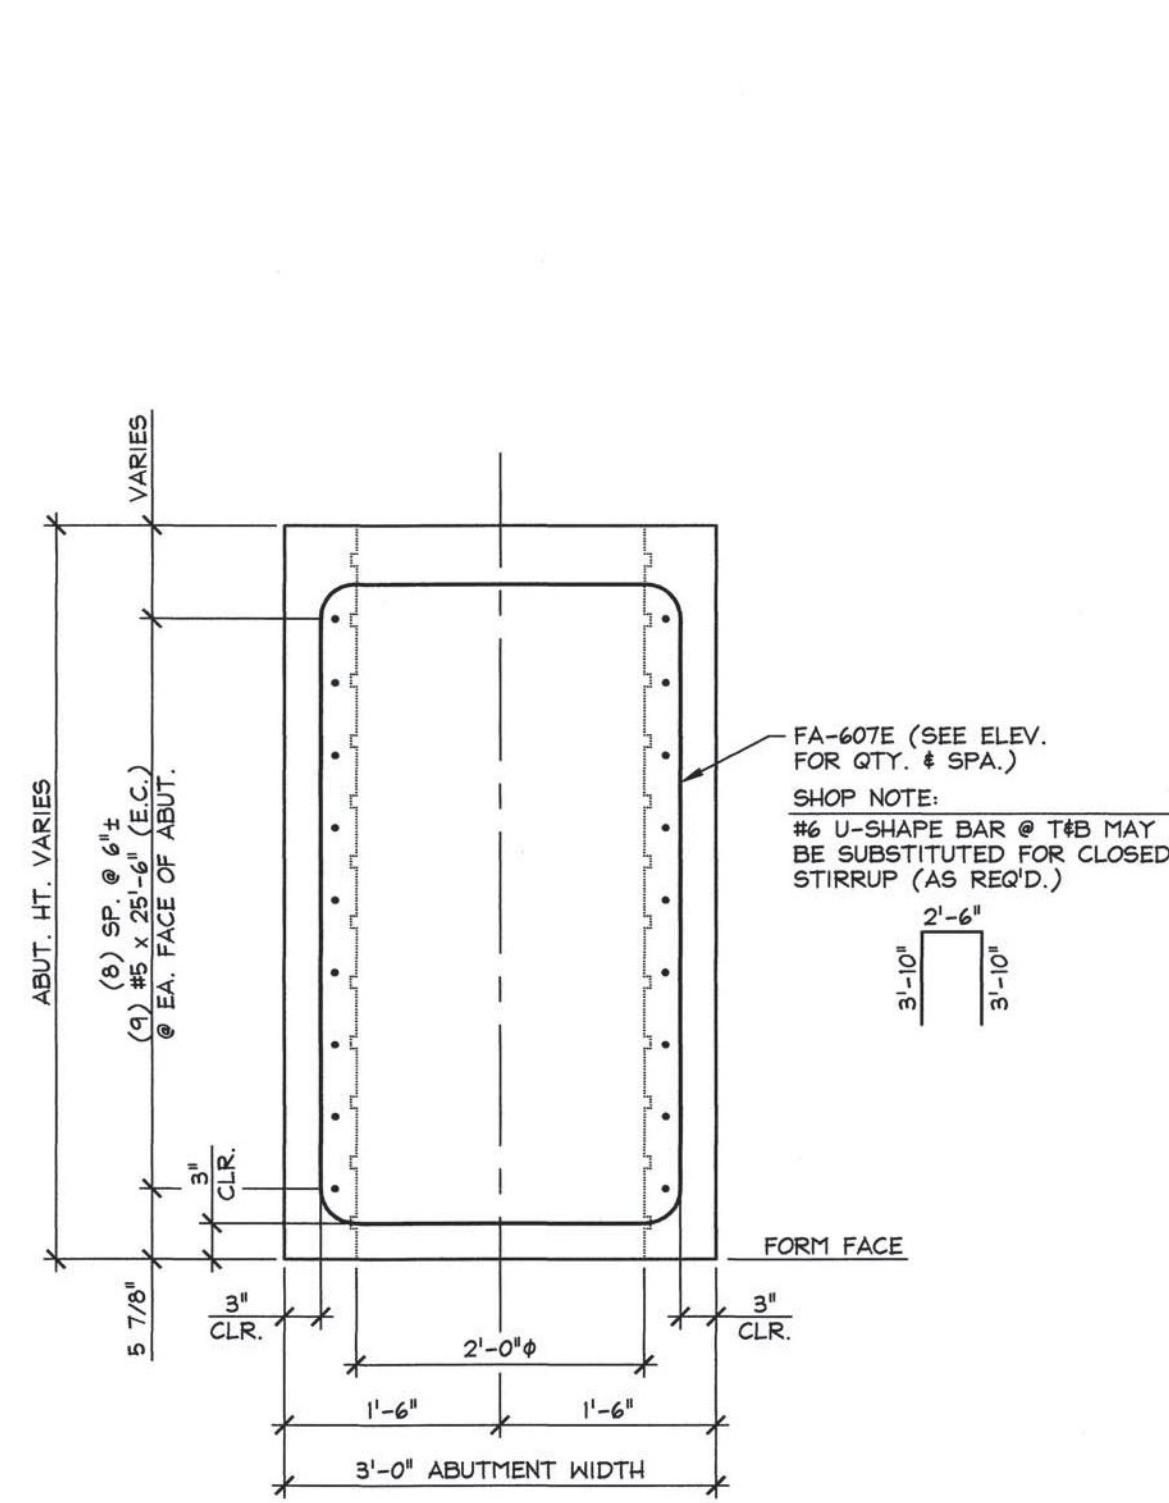

B ABUTMENT SECTION
AB3.1 3/4" = 1'-0"

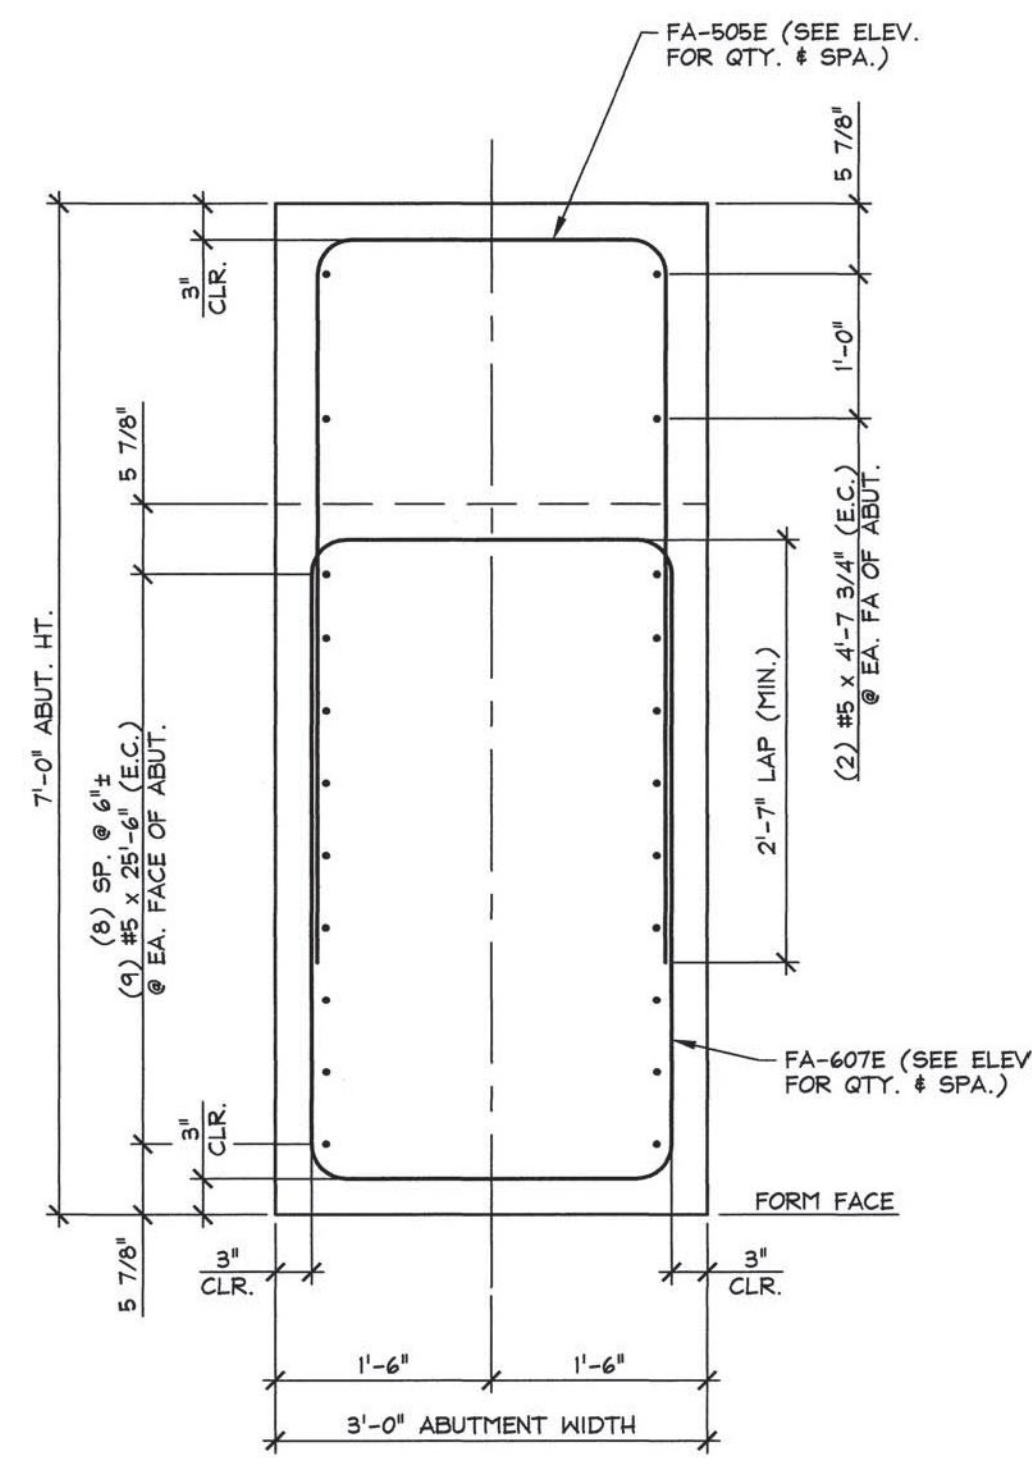

C ABUTMENT SECTION
AB3.1 3/4" = 1'-0"

Vermont Agency of Transportation
RECEIVED
CK'D BY RK/JW OK'D BY RY
February 12, 2015
RESUBMIT No Approved
BY RY DATE 02/12/2015
2-10-15 REVISED PER VT AOT COMMENTS

MARK: FA-AB4		QTY.: 1	
MATERIAL LIST / ABUTMENT			
ITEM	MARK	DESCRIPTION	QTY.
1	FA-505E	#5 BENT BAR (LEVEL 1, EPOXY COATED)	12
2		#5 x 25'-6" (LEVEL 1, EPOXY COATED)	18
3		#5 x 4'-7 3/4" (LEVEL 1, EPOXY COATED)	10
4			
5	FA-607E	#6 BENT BAR (LEVEL 1, EPOXY COATED)	40
6			
7			
8			
9			
10			

APPROVAL STAMP:	J.P. CARRARA & SONS INC. Precast & Prestress Manufacturer 244 GAGE ST., MIDDLEBURY, VERMONT 05753 Phone: (802)388-6361 Fax: (802)388-8010		A.L. St. ONGE CONTRACTOR MONTMERY, VERMONT	
	STATE OF VERMONT AGENCY OF TRANSPORTATION COUNTY OF FRANKLIN		DATE: NOV. 10, 2014 SCALE: NOTED	
	TOWN OF FAIRFIELD ELM BROOK ROAD, TOWN HIGHWAY 47 (CLASS 3) BRIDGE NO.: 46 PROJECT NO.: BRO 1448(41)		CHKD: B.C. DFTM: B.L. JOB NO: 23446-014	
	PRECAST ABUTMENT REINFORCING DETAILS		DWG. NO: AB3.1	