


STATE OF VERMONT AGENCY OF TRANSPORTATION

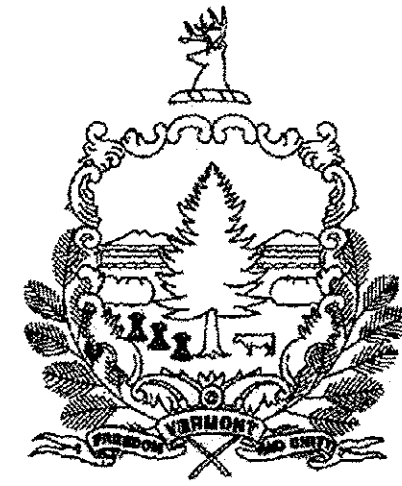


PROPOSED IMPROVEMENT BRIDGE PROJECT TOWN OF RICHFORD COUNTY OF FRANKLIN


ROUTE NO : TH 3 (FAS 0302)(RURAL MAJOR COLLECTOR) BRIDGE NO : 6
PROJECT LOCATION : BEGINNING AT A POINT ON TH 3, APPROXIMATELY 1.2 MILES WEST OF THE JUNCTION
WITH TH 1.

PROJECT DESCRIPTION : REPLACEMENT OF THE EXISTING BRIDGE WITH A CONCRETE ARCH AND RELATED ROADWAY AND CHANNEL WORK.

| | |
|-----------------------|--------------|
| LENGTH OF STRUCTURE : | 28.00 FEET. |
| LENGTH OF ROADWAY : | 147.00 FEET. |
| LENGTH OF PROJECT : | 175.00 FEET. |

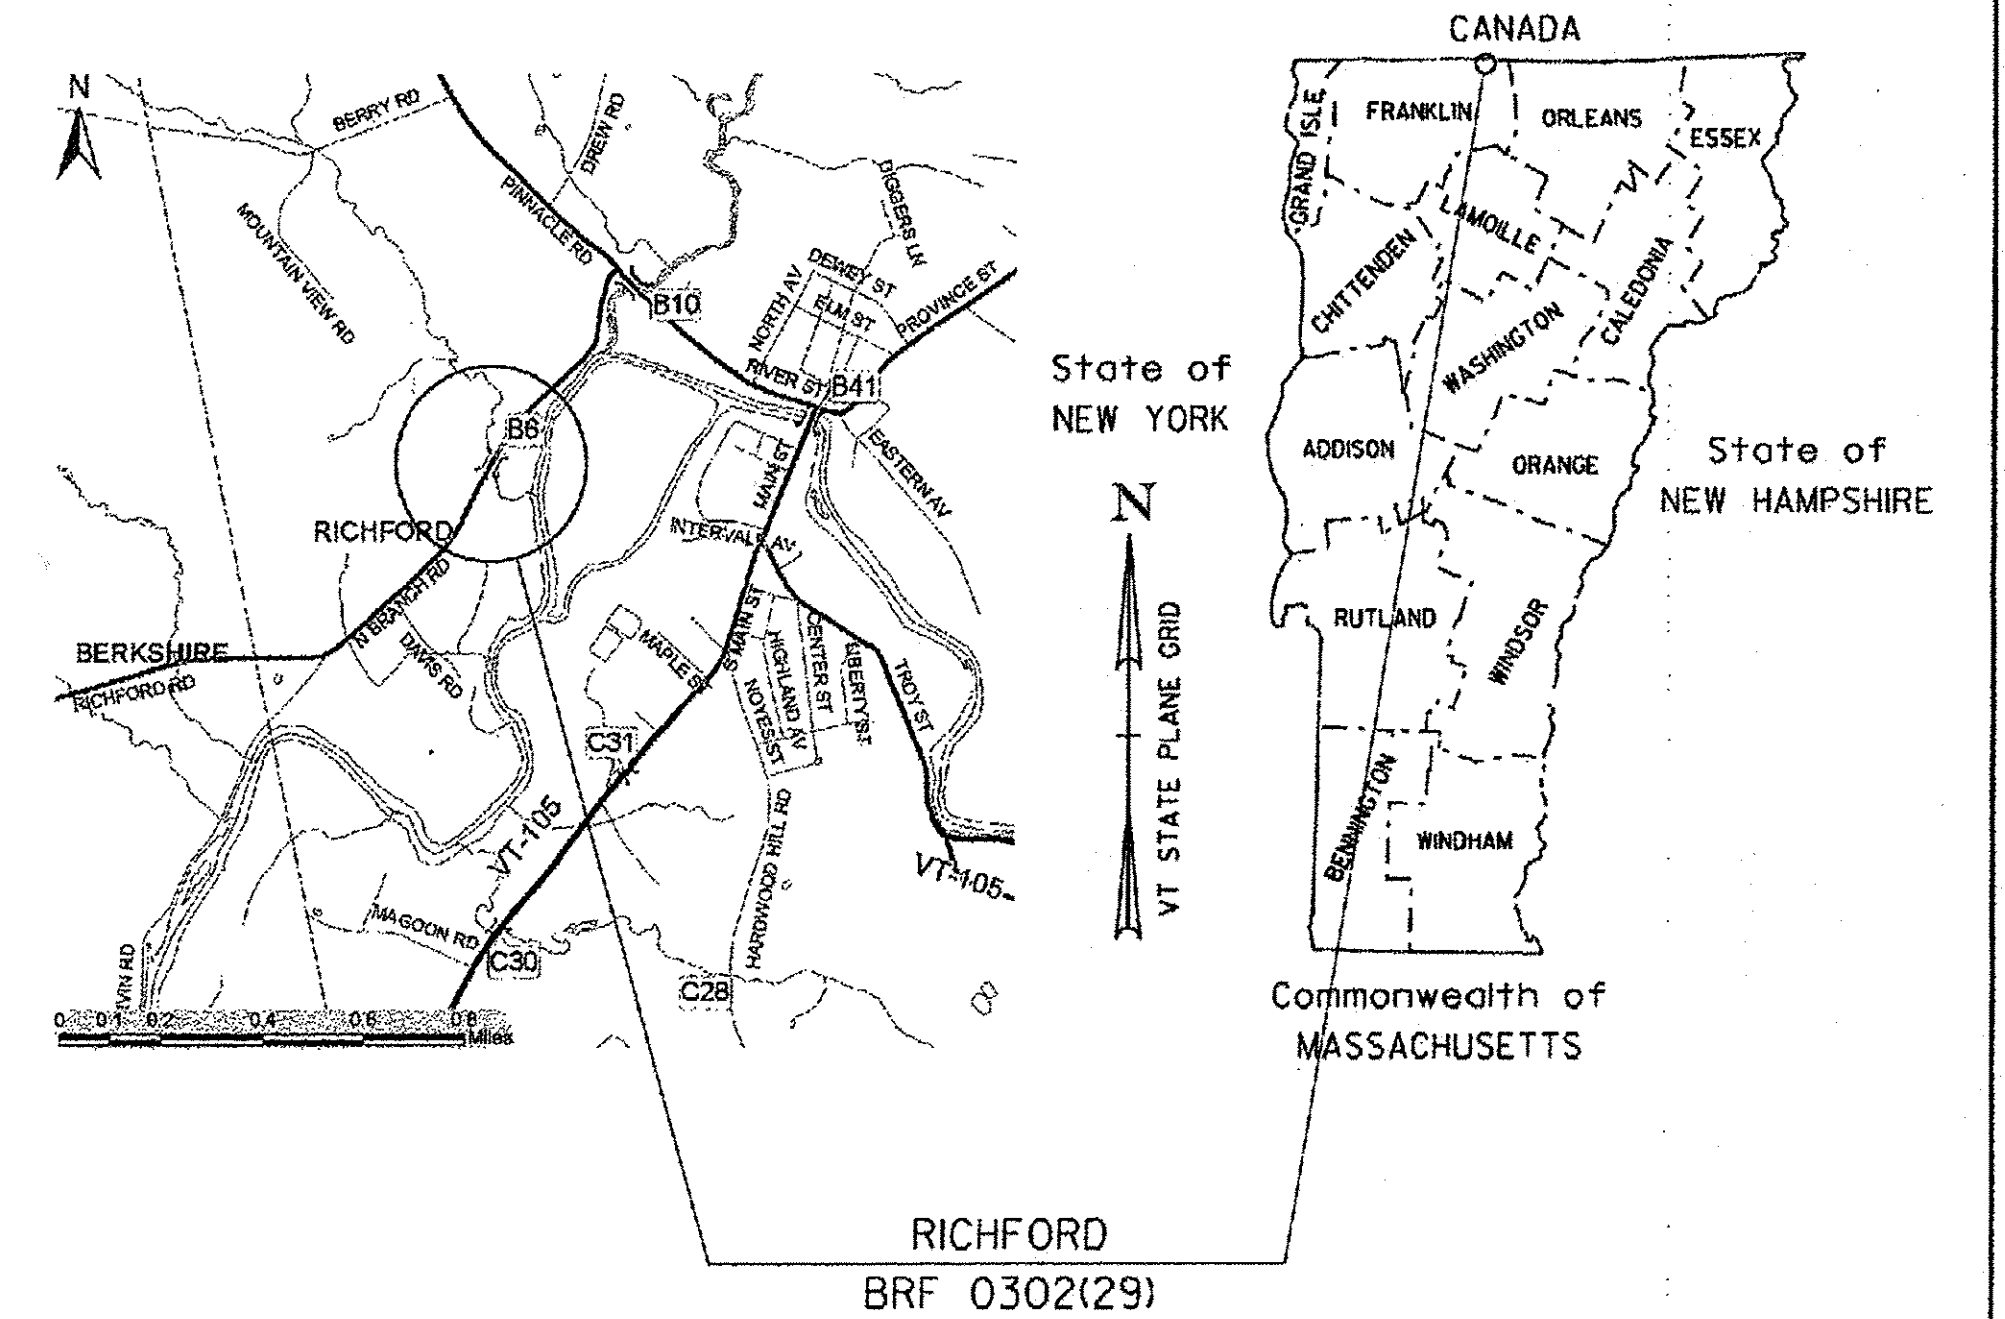

| RECORD PLANS | |
|--|---|
| CONTRACTOR: | G. W. TATRO CONSTRUCTION - JEFFERSONVILLE, VT |
| RESIDENT ENGINEER: | SCOTT WHEATLEY |
| CONSTRUCTION BEGAN: | JULY 30, 2015 |
| CONSTRUCTION COMPLETE: | AUGUST 27, 2015 |
| RECORD PLANS BY: | SCOTT WHEATLEY & AARON JAMES |
| I HEREBY CERTIFY THAT ALL THE CONSTRUCTION REQUIRED BY THIS SET OF DRAWINGS HAS BEEN ACCOMPLISHED AS INDICATED HEREIN. | |
| BY | RESIDENT ENGINEER |
| DATE | July 29, 2016 |
| NOTE: Any further information concerning final quantities, amounts or other details relative to this project may be found at Central Files in the electronic archives. | |

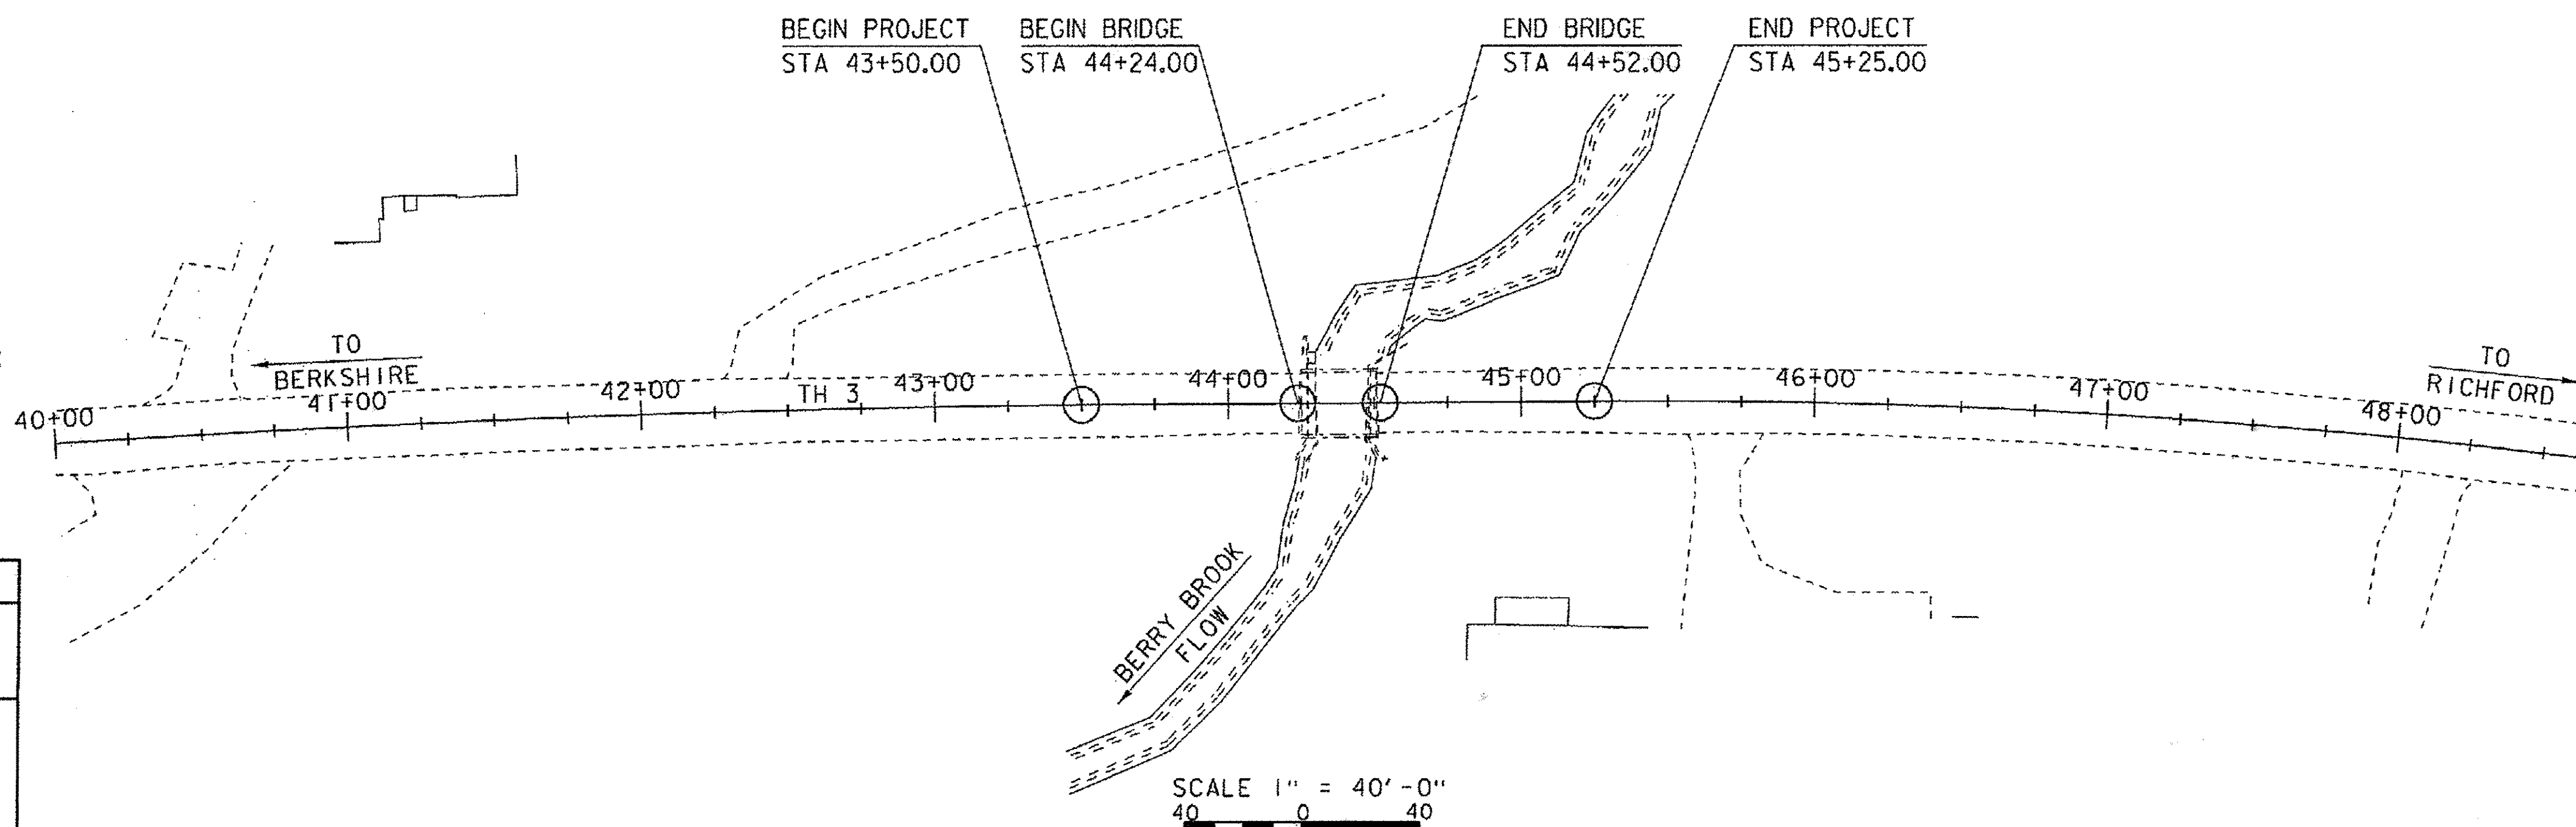

CONSTRUCTION IS TO BE CARRIED ON IN ACCORDANCE WITH THESE PLANS AND THE STANDARD SPECIFICATIONS FOR CONSTRUCTION DATED 2011, AS APPROVED BY THE FEDERAL HIGHWAY ADMINISTRATION ON JULY 20, 2011 FOR USE ON THIS PROJECT, INCLUDING ALL SUBSEQUENT REVISIONS AND SUCH REVISED SPECIFICATIONS AND SPECIAL PROVISIONS AS ARE INCORPORATED IN THESE PLANS.

| | |
|-------------------------------------|---------------|
| QUALITY ASSURANCE PROGRAM : LEVEL 2 | |
| SURVEYED BY : | L. ORVIS |
| SURVEYED DATE : | 4/9/2012 |
| DATUM | |
| VERTICAL | NAVD88 |
| HORIZONTAL | NAD (83) 1996 |

| | |
|---|-----------------|
| DIRECTOR OF PROJECT DELIVERY | |
| APPROVED | DATE 12/12/2014 |
| PROJECT MANAGER : CAROLYN CARLSON, P.E. | |
| PROJECT NAME : | RICHFORD |
| PROJECT NUMBER : | BRF 0302 (29) |
| SHEET 1 OF 36 SHEETS | |