


TH3 PROFILE

SCALE: HORIZONTAL 1"=20'-0"
VERTICAL 1"=10'-0"


NOTE:
GRADES SHOWN TO THE NEAREST TENTH ARE EXISTING GROUND ALONG ϕ
GRADES SHOWN TO THE NEAREST HUNDREDTH ARE FINISH GRADE ALONG ϕ

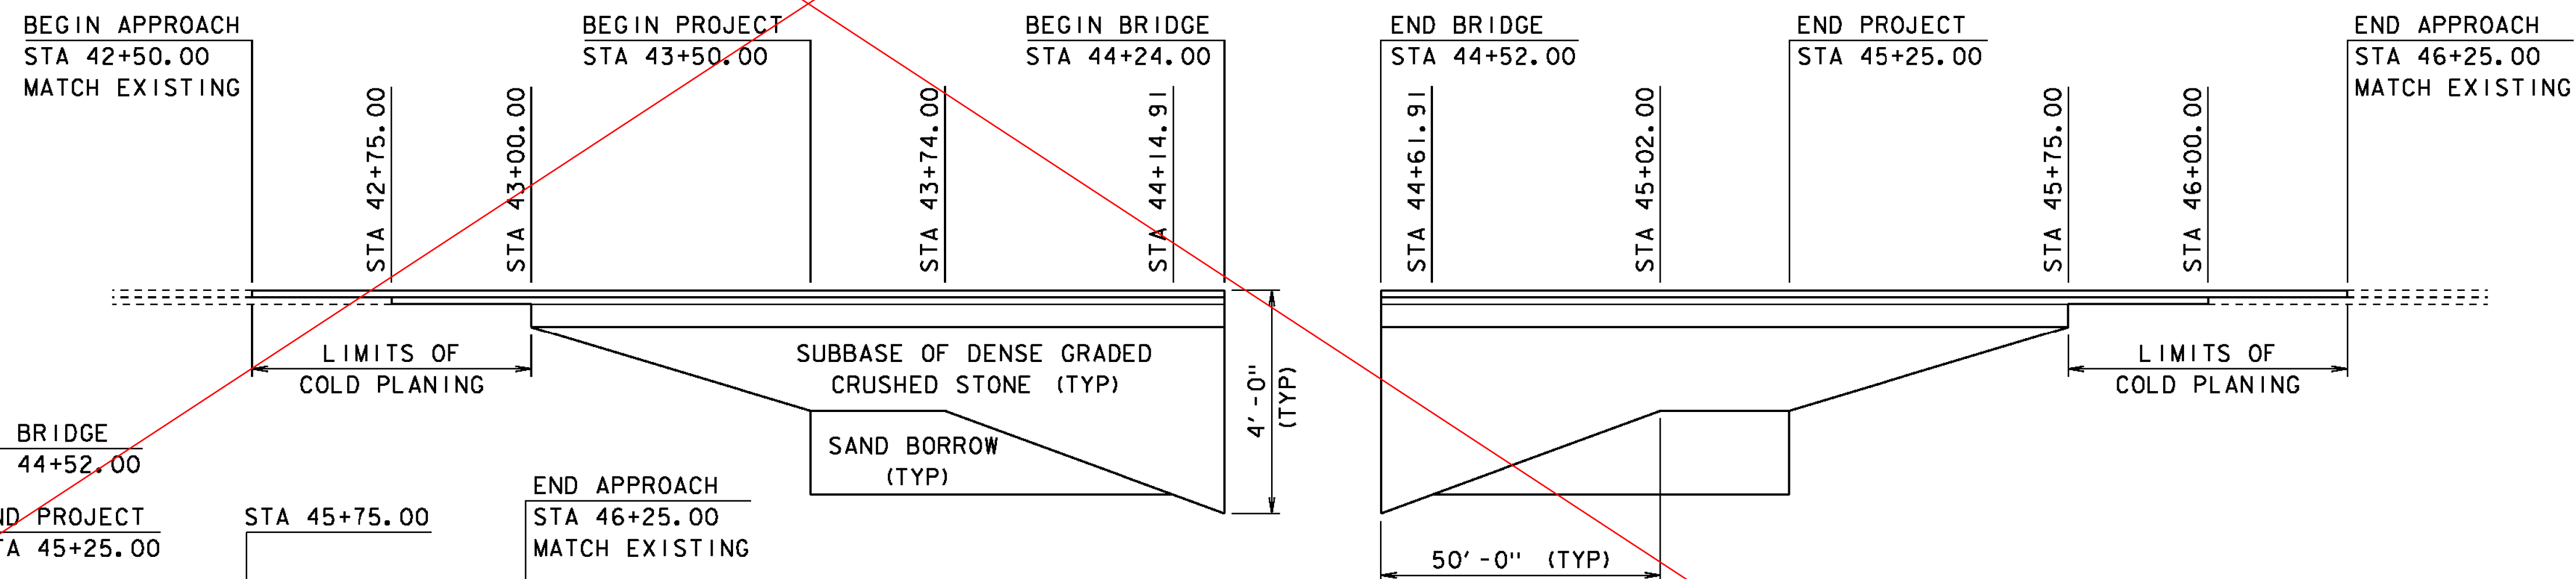

MATERIAL TRANSITION DIAGRAM

HOR. SCALE 1" = 20'-0"
NO VERT. SCALE

NOTE:
SEE ROADWAY TYPICAL SECTION FOR THICKNESSES OF:
BITUMINOUS CONCRETE PAVEMENT,
SUBBASE OF DENSE GRADED CRUSHED STONE
& SAND BORROW

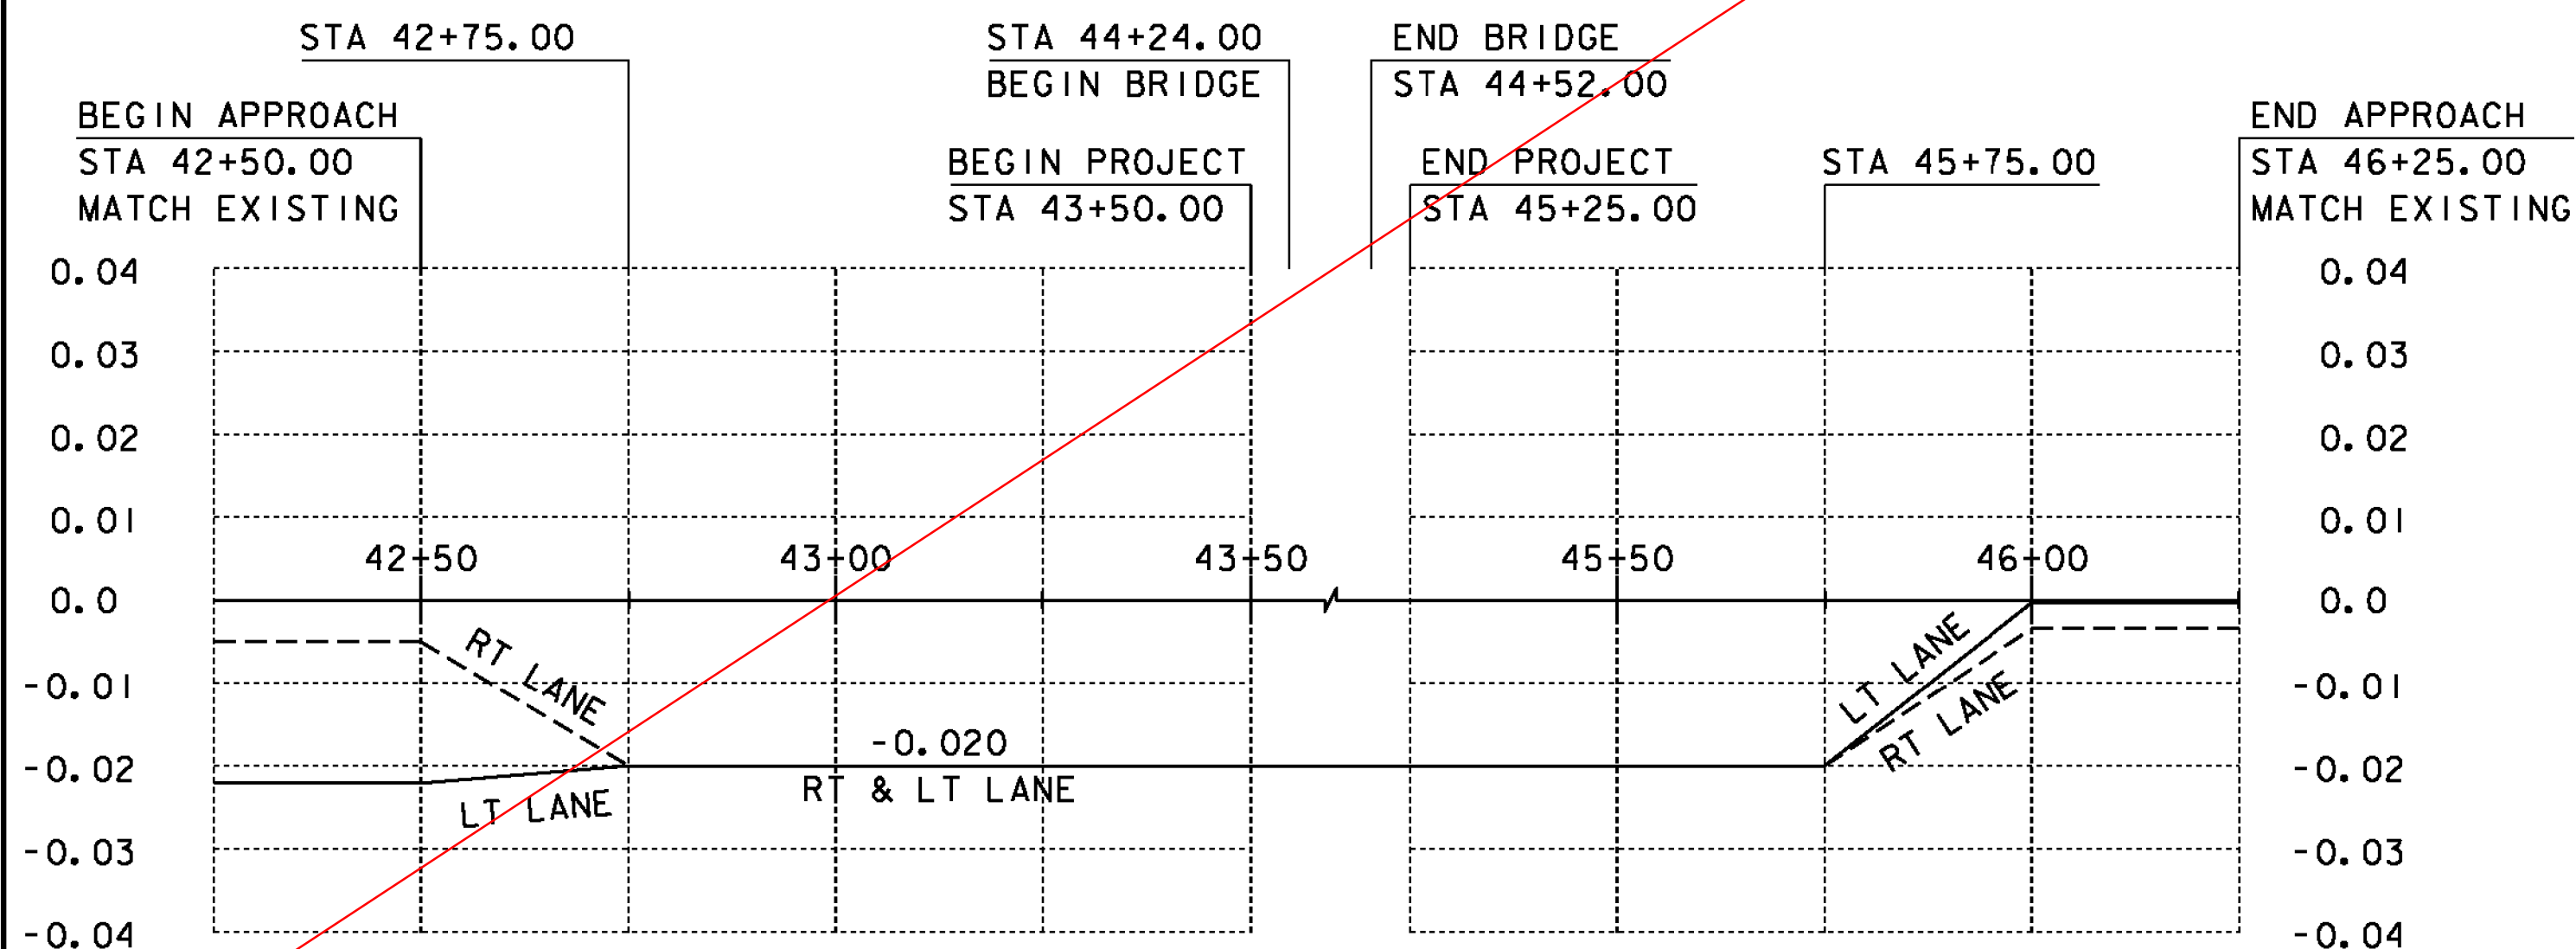

BANKING DIAGRAM

HOR. SCALE 1" = 20'-0"
NO VERT. SCALE

PROJECT NAME: RICHFORD
PROJECT NUMBER: BRF 0302(29)

FILE NAME: sl2j58pro.dgn
PROJECT LEADER: C. CARLSON
DESIGNED BY: H. SALLS
TH 3 PROFILE AND TRANSITION DIAGRAMS

PLOT DATE: 11-DEC-2014
DRAWN BY: R. PELLETT
CHECKED BY: H. SALLS
SHEET 11 OF 36

SEE PAGE IIR FOR REVISED TH3 PROFILE