



BRIDGE LAYOUT
SCALE 1/4" = 1'-0"

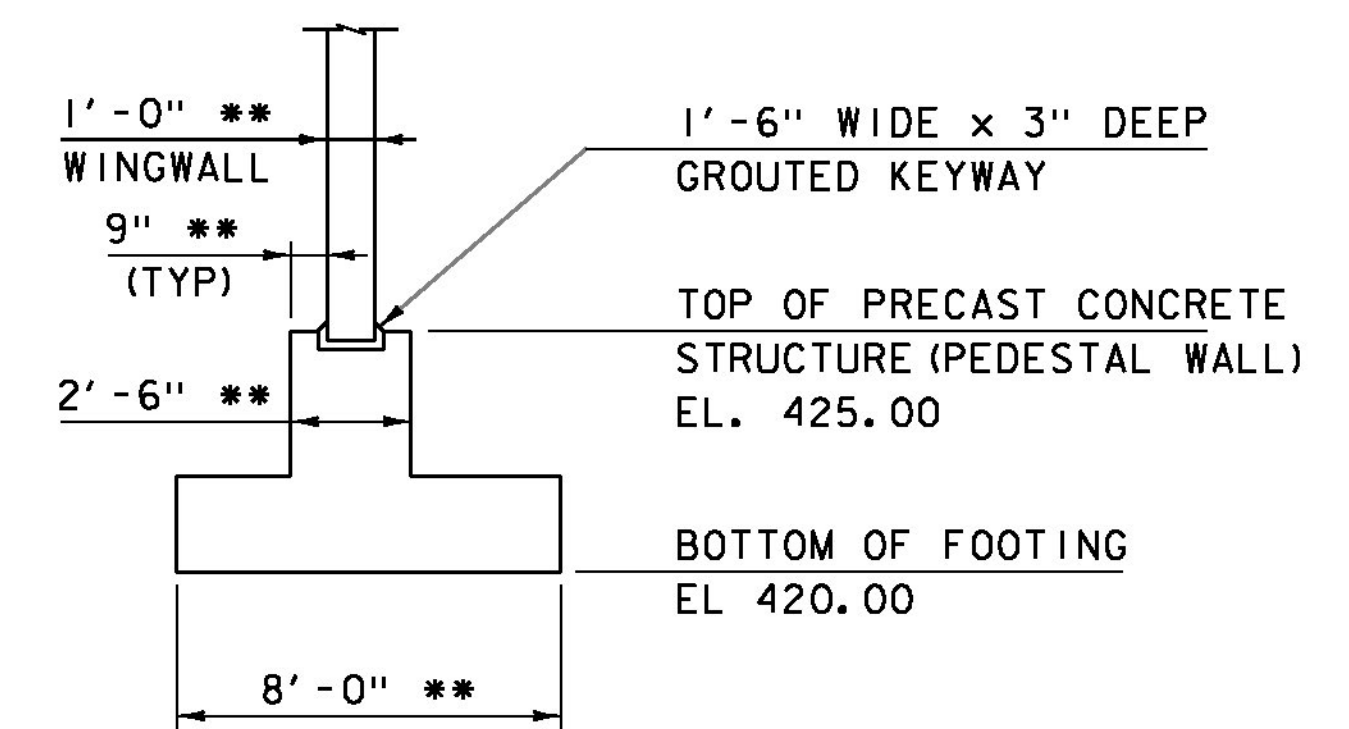

WINGWALL SECTION
SCALE 1/4" = 1'-0"

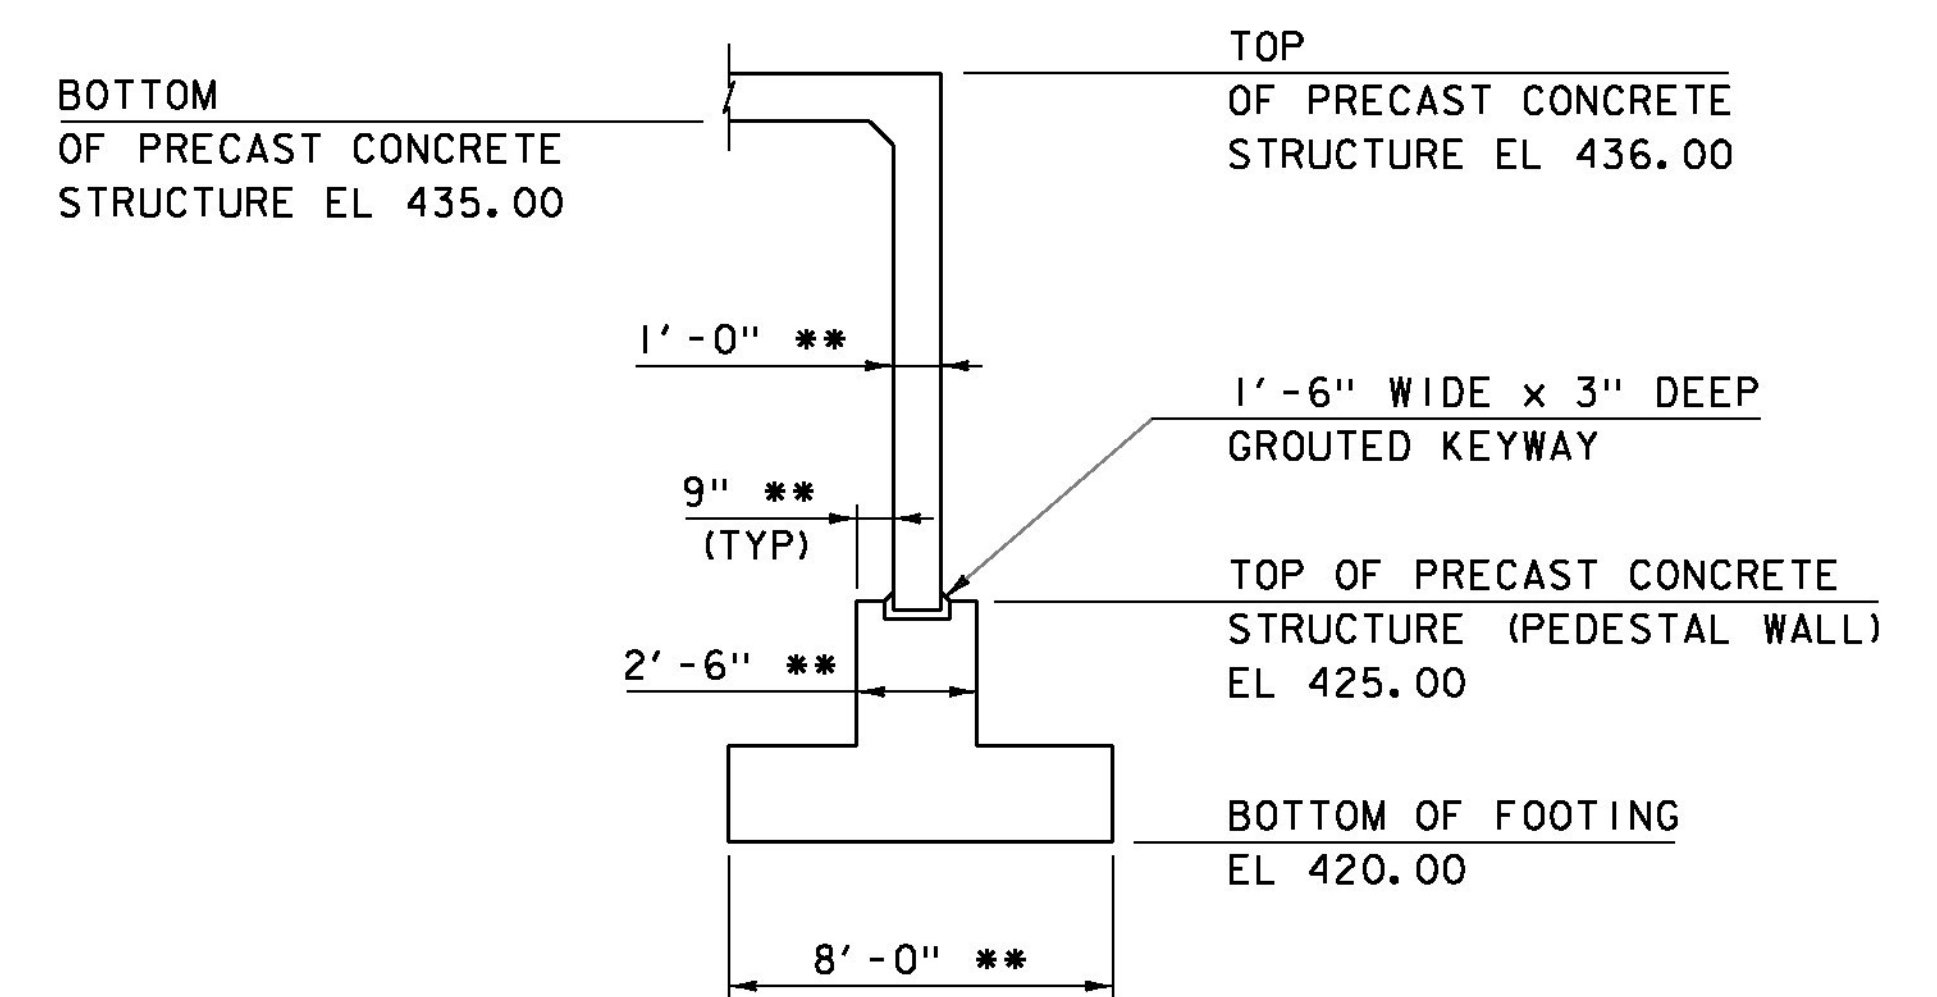

PEDESTAL WALL SECTION
SCALE 1/4" = 1'-0"

** DIMENSION SHOWN FOR ESTIMATING PURPOSES ONLY.
ACTUAL DIMENSIONS TO BE DETERMINED BY THE
FABRICATOR.

PROJECT NAME:	RICHFORD	PLOT DATE:	11-DEC-2014
PROJECT NUMBER:	BRF 0302(29)	DRAWN BY:	R. PELLETT
FILE NAME:	sl2j158sub.dgn	DESIGNED BY:	H. SALLS
PROJECT LEADER:	C. CARLSON	CHECKED BY:	H. SALLS
BRIDGE LAYOUT AND WALL SECTIONS		SHEET 23 OF 36	