




42+75

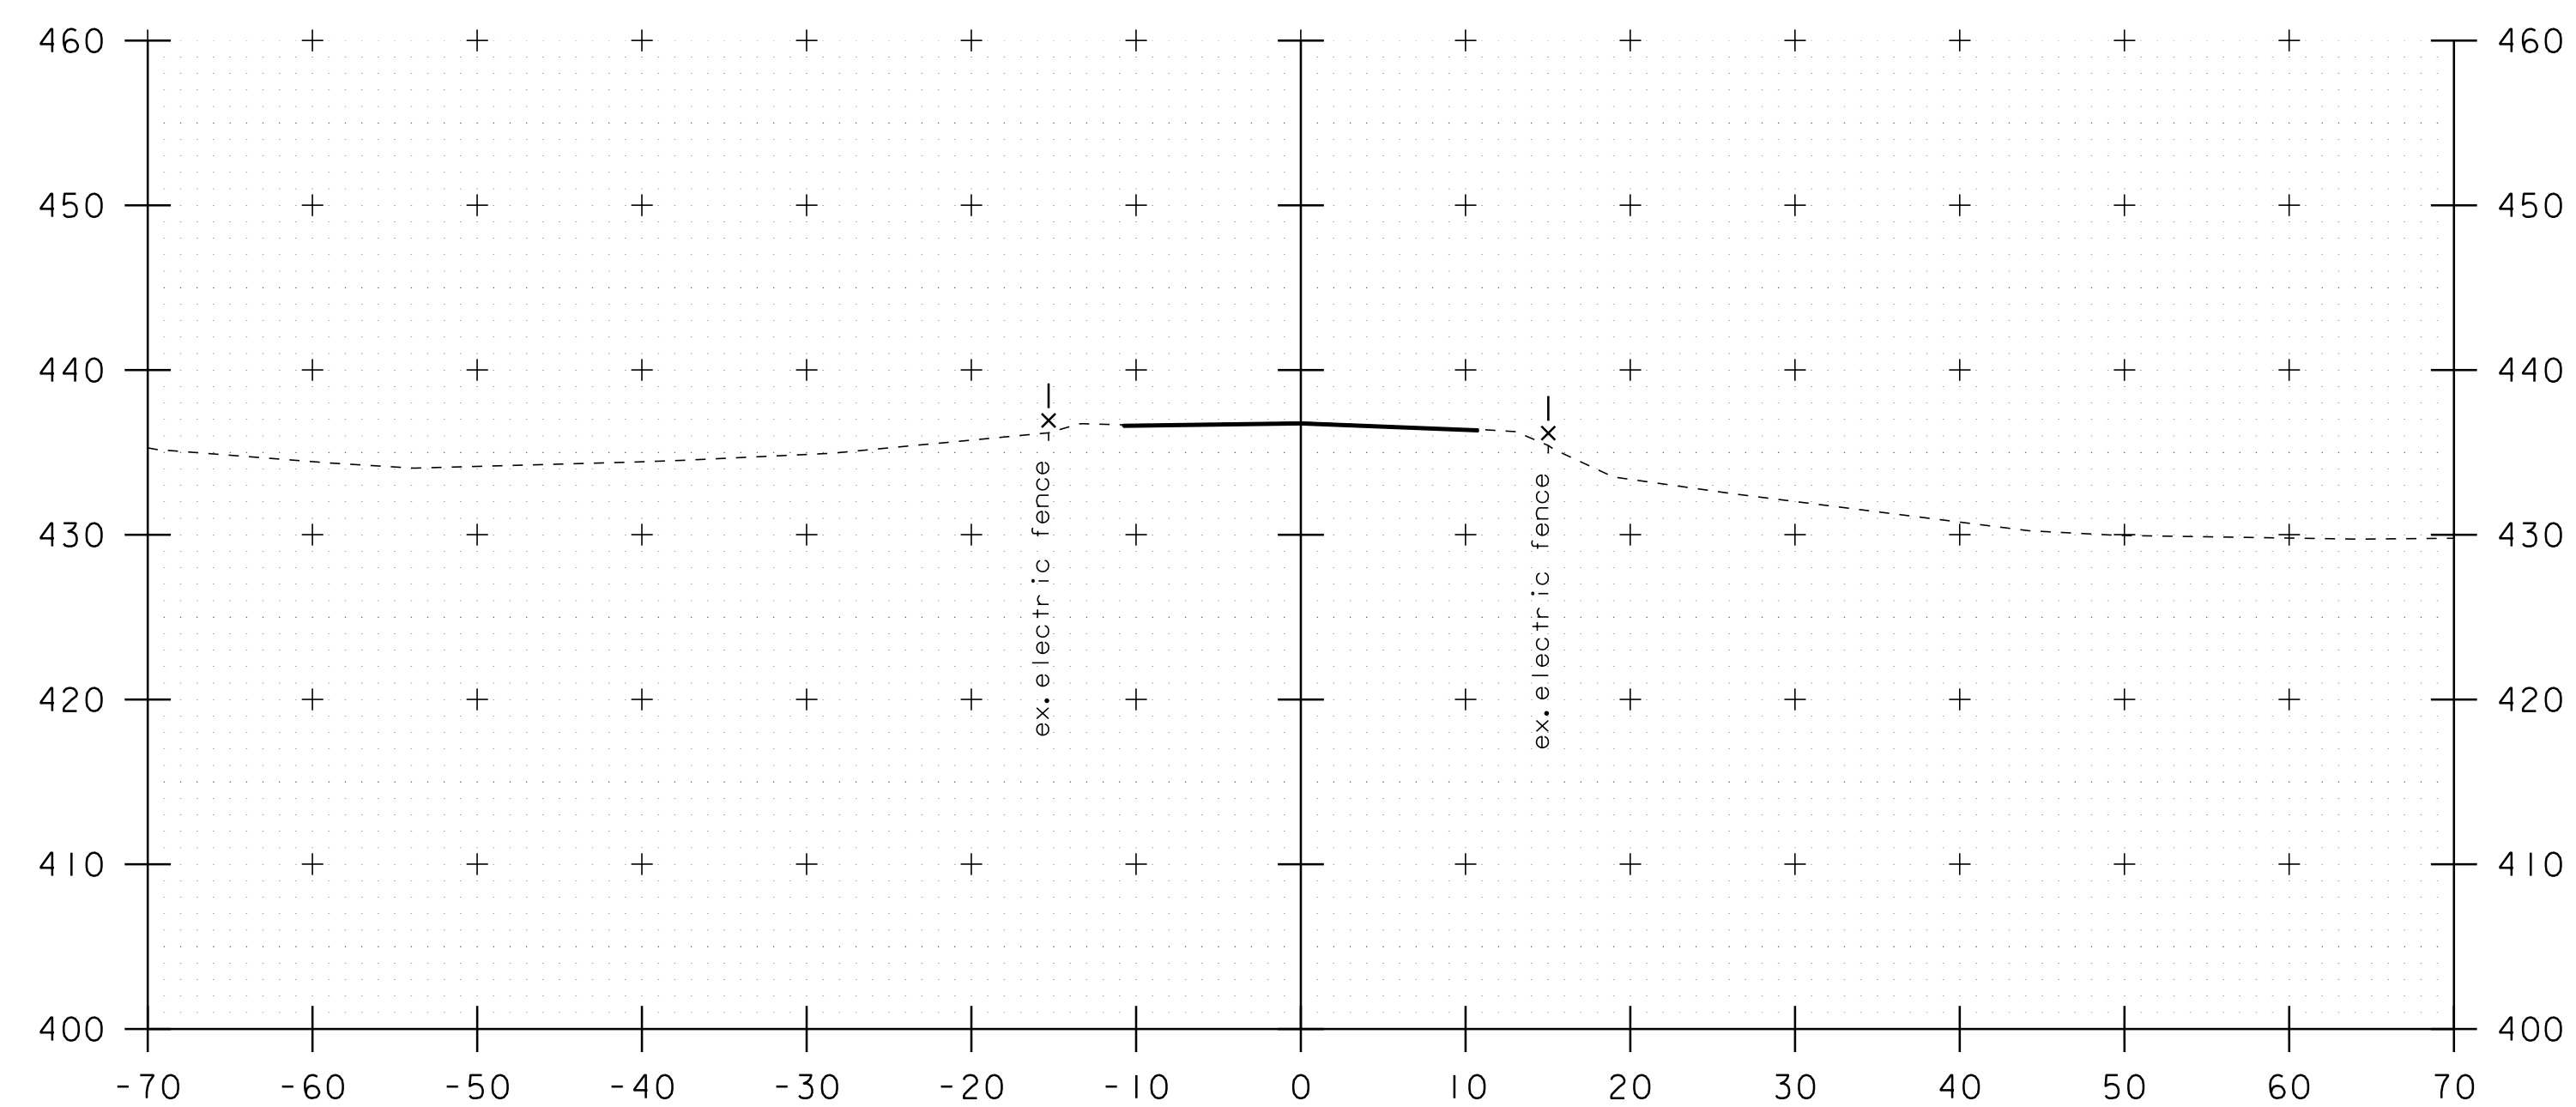

42+50
BEGIN APPROACH
MATCH EXISTING

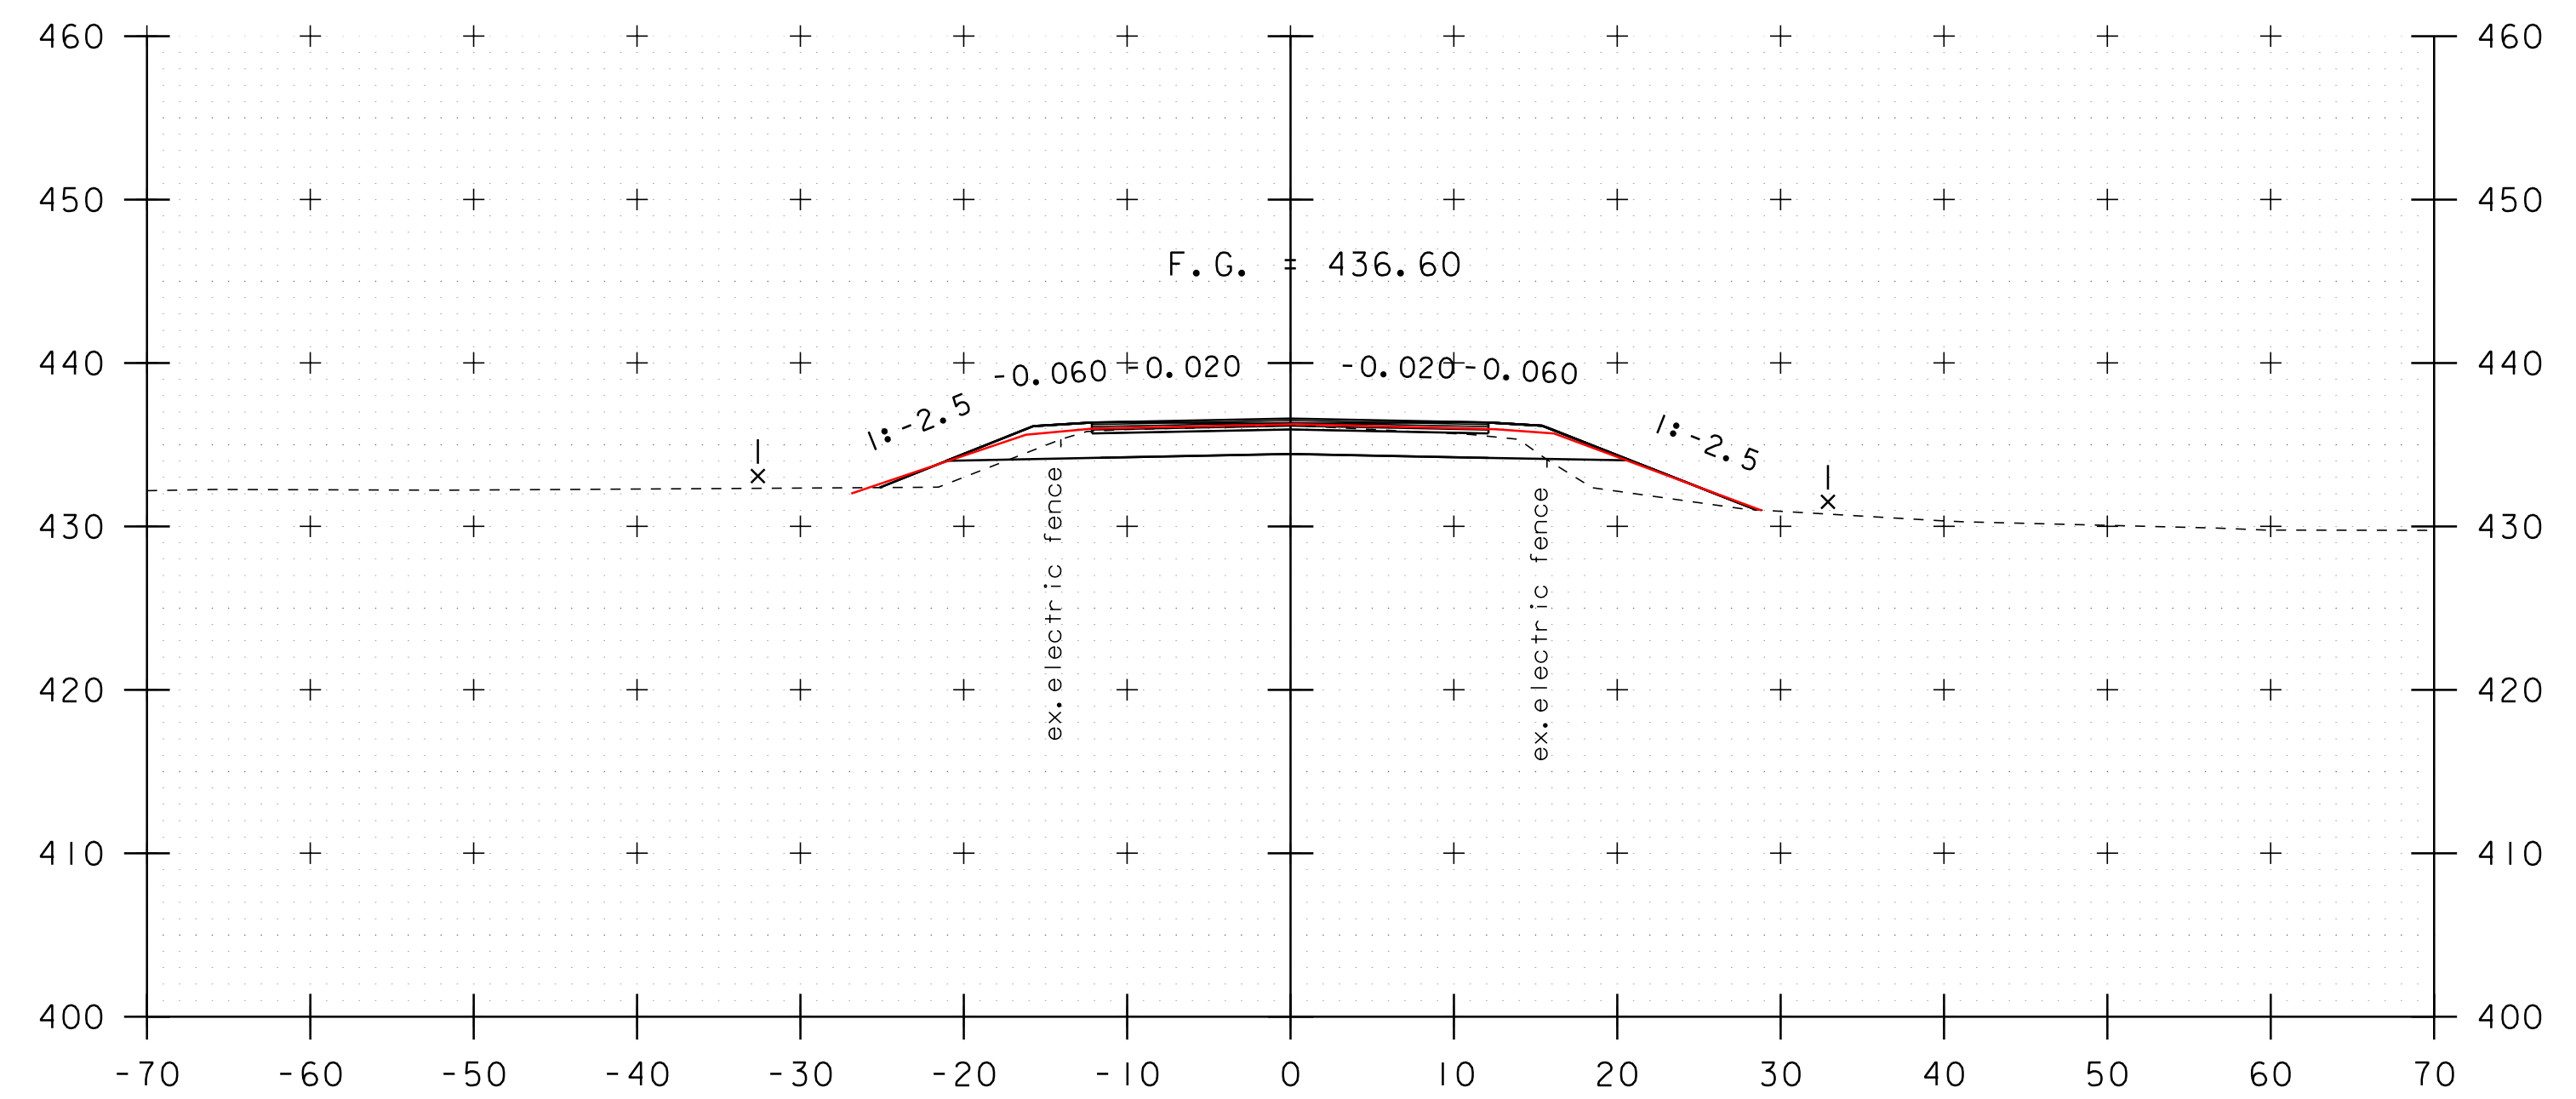

43+25

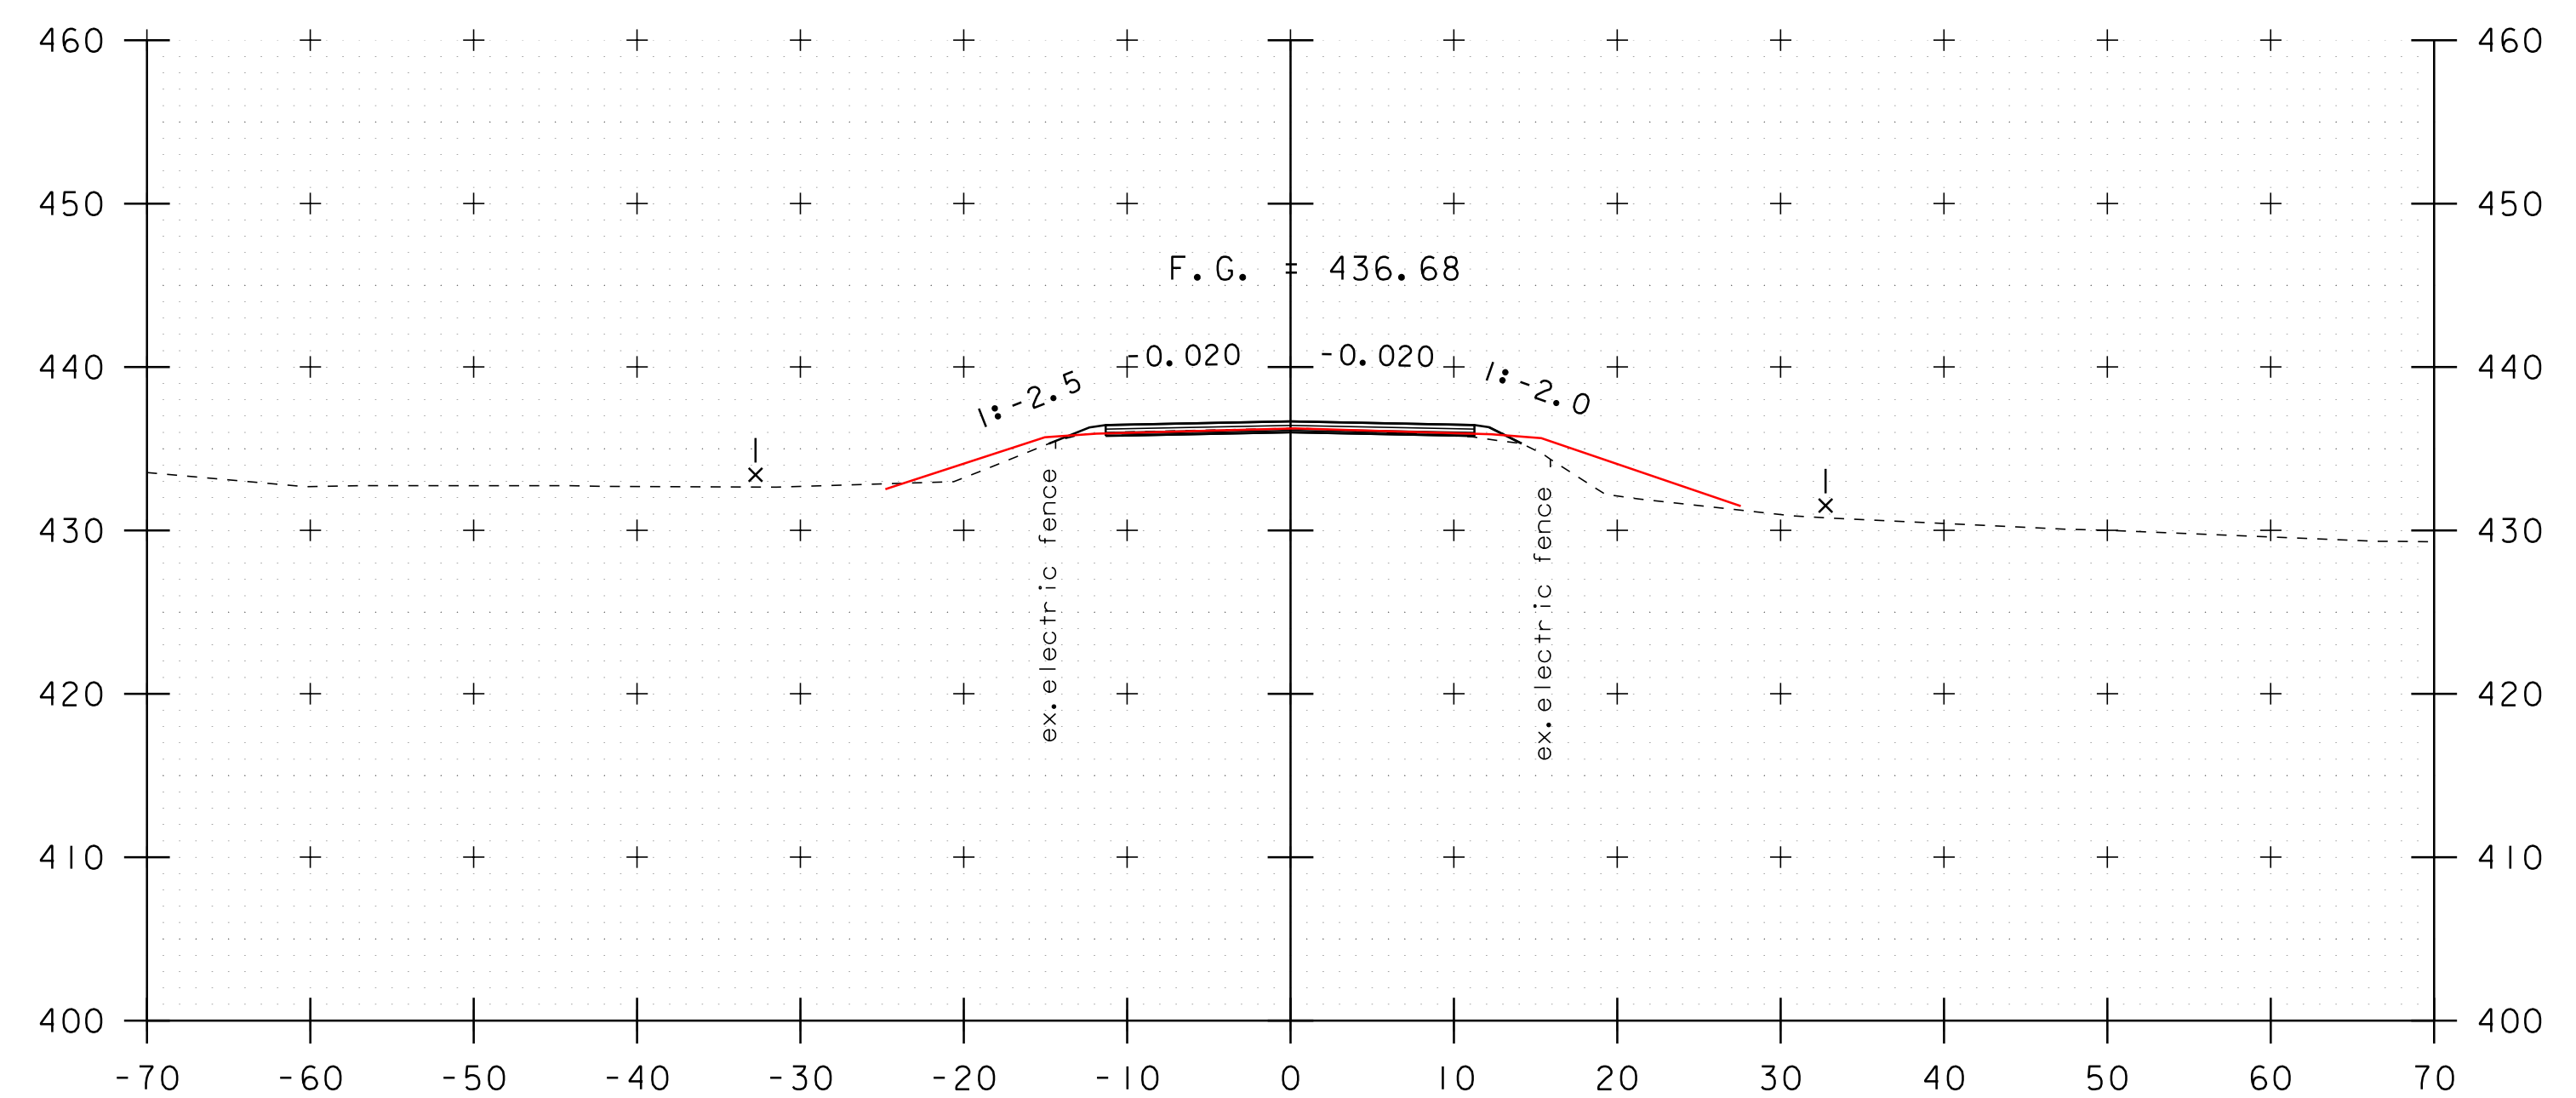

43+00

STA. 42+50 TO STA. 43+25

PROJECT NAME: RICHFORD	
PROJECT NUMBER: BRF 0302(29)	
FILE NAME: si2j58xs.dgn	PLOT DATE: 09-AUG-2016 09:57
PROJECT LEADER: C. CARLSON	DRAWN BY: R. PELLETT
DESIGNED BY: H. SALLS	CHECKED BY: H. SALLS
MAINLINE CROSS SECTIONS 1	SHEET 24 OF 64