




43+75

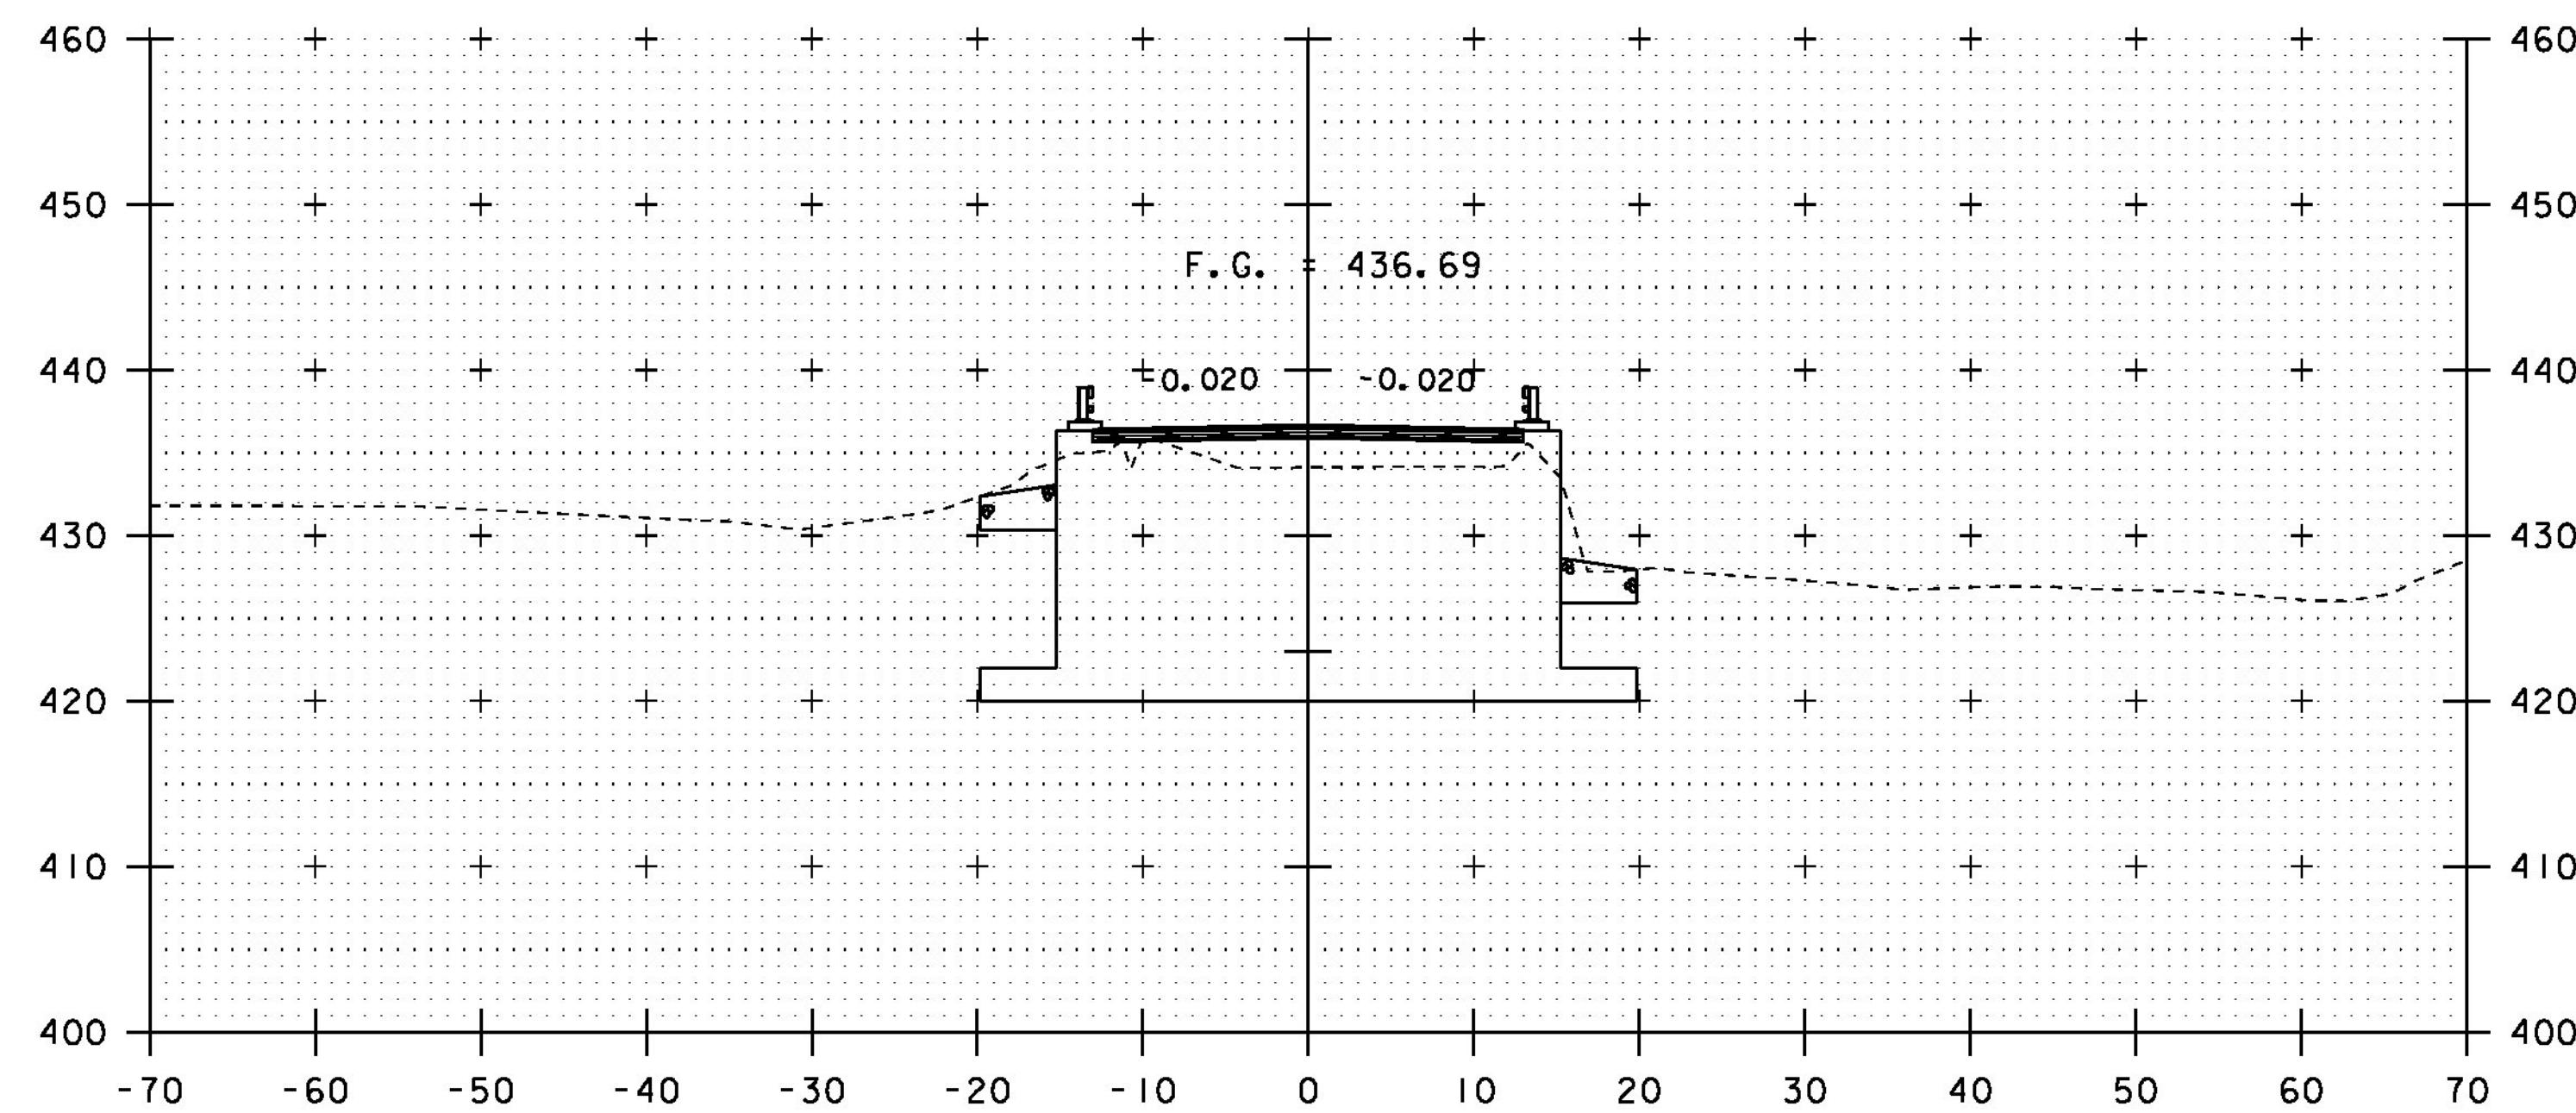

44+25
STA 44+24 BEGIN BRIDGE

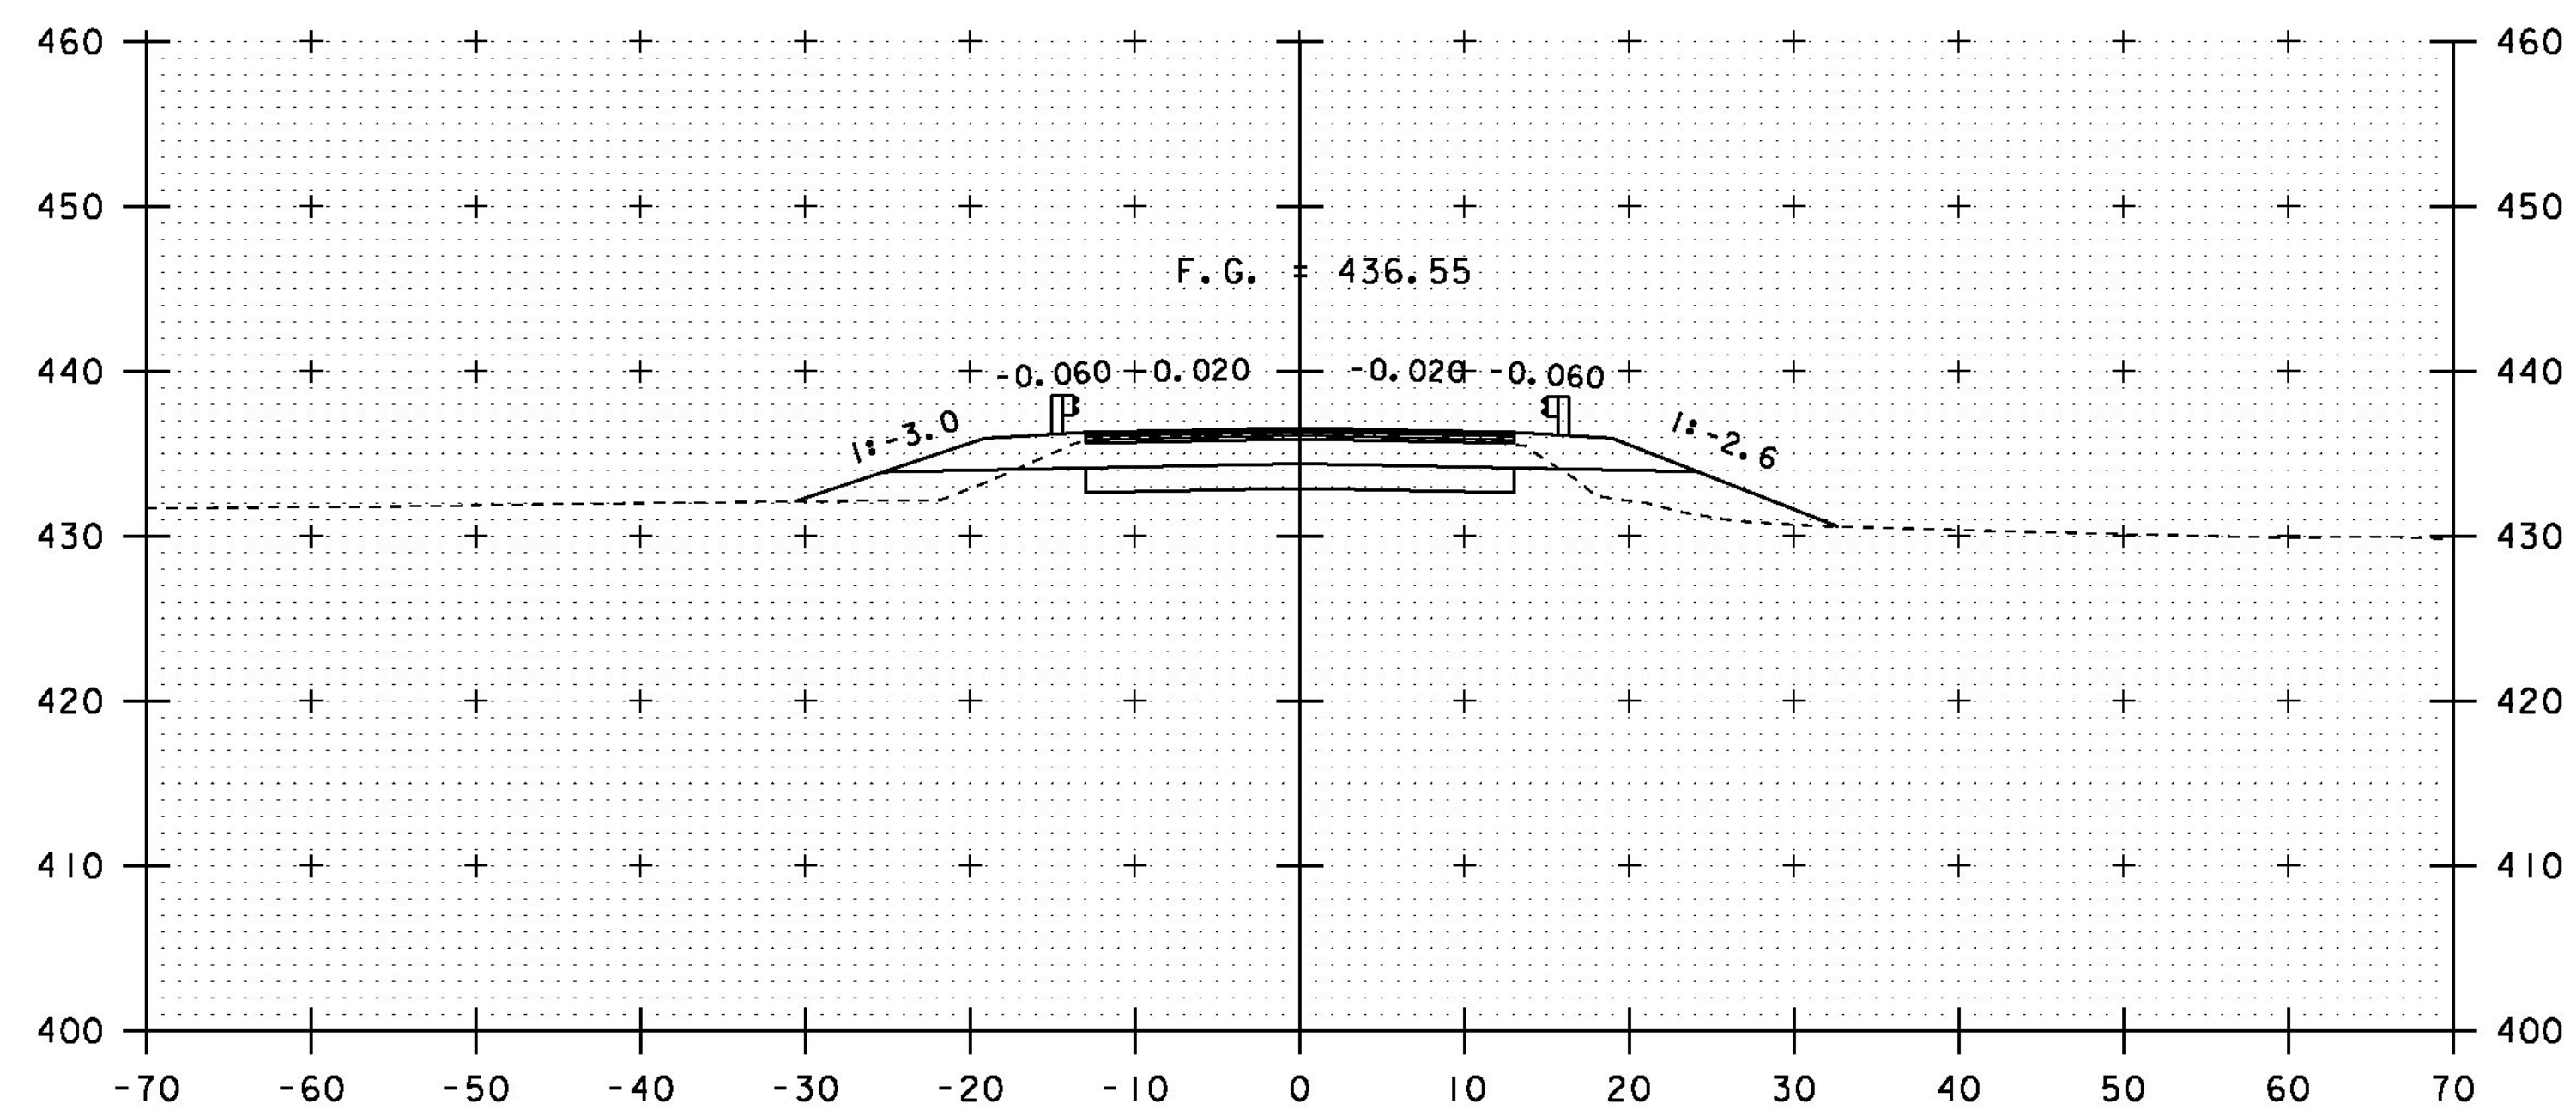

43+50
BEGIN PROJECT

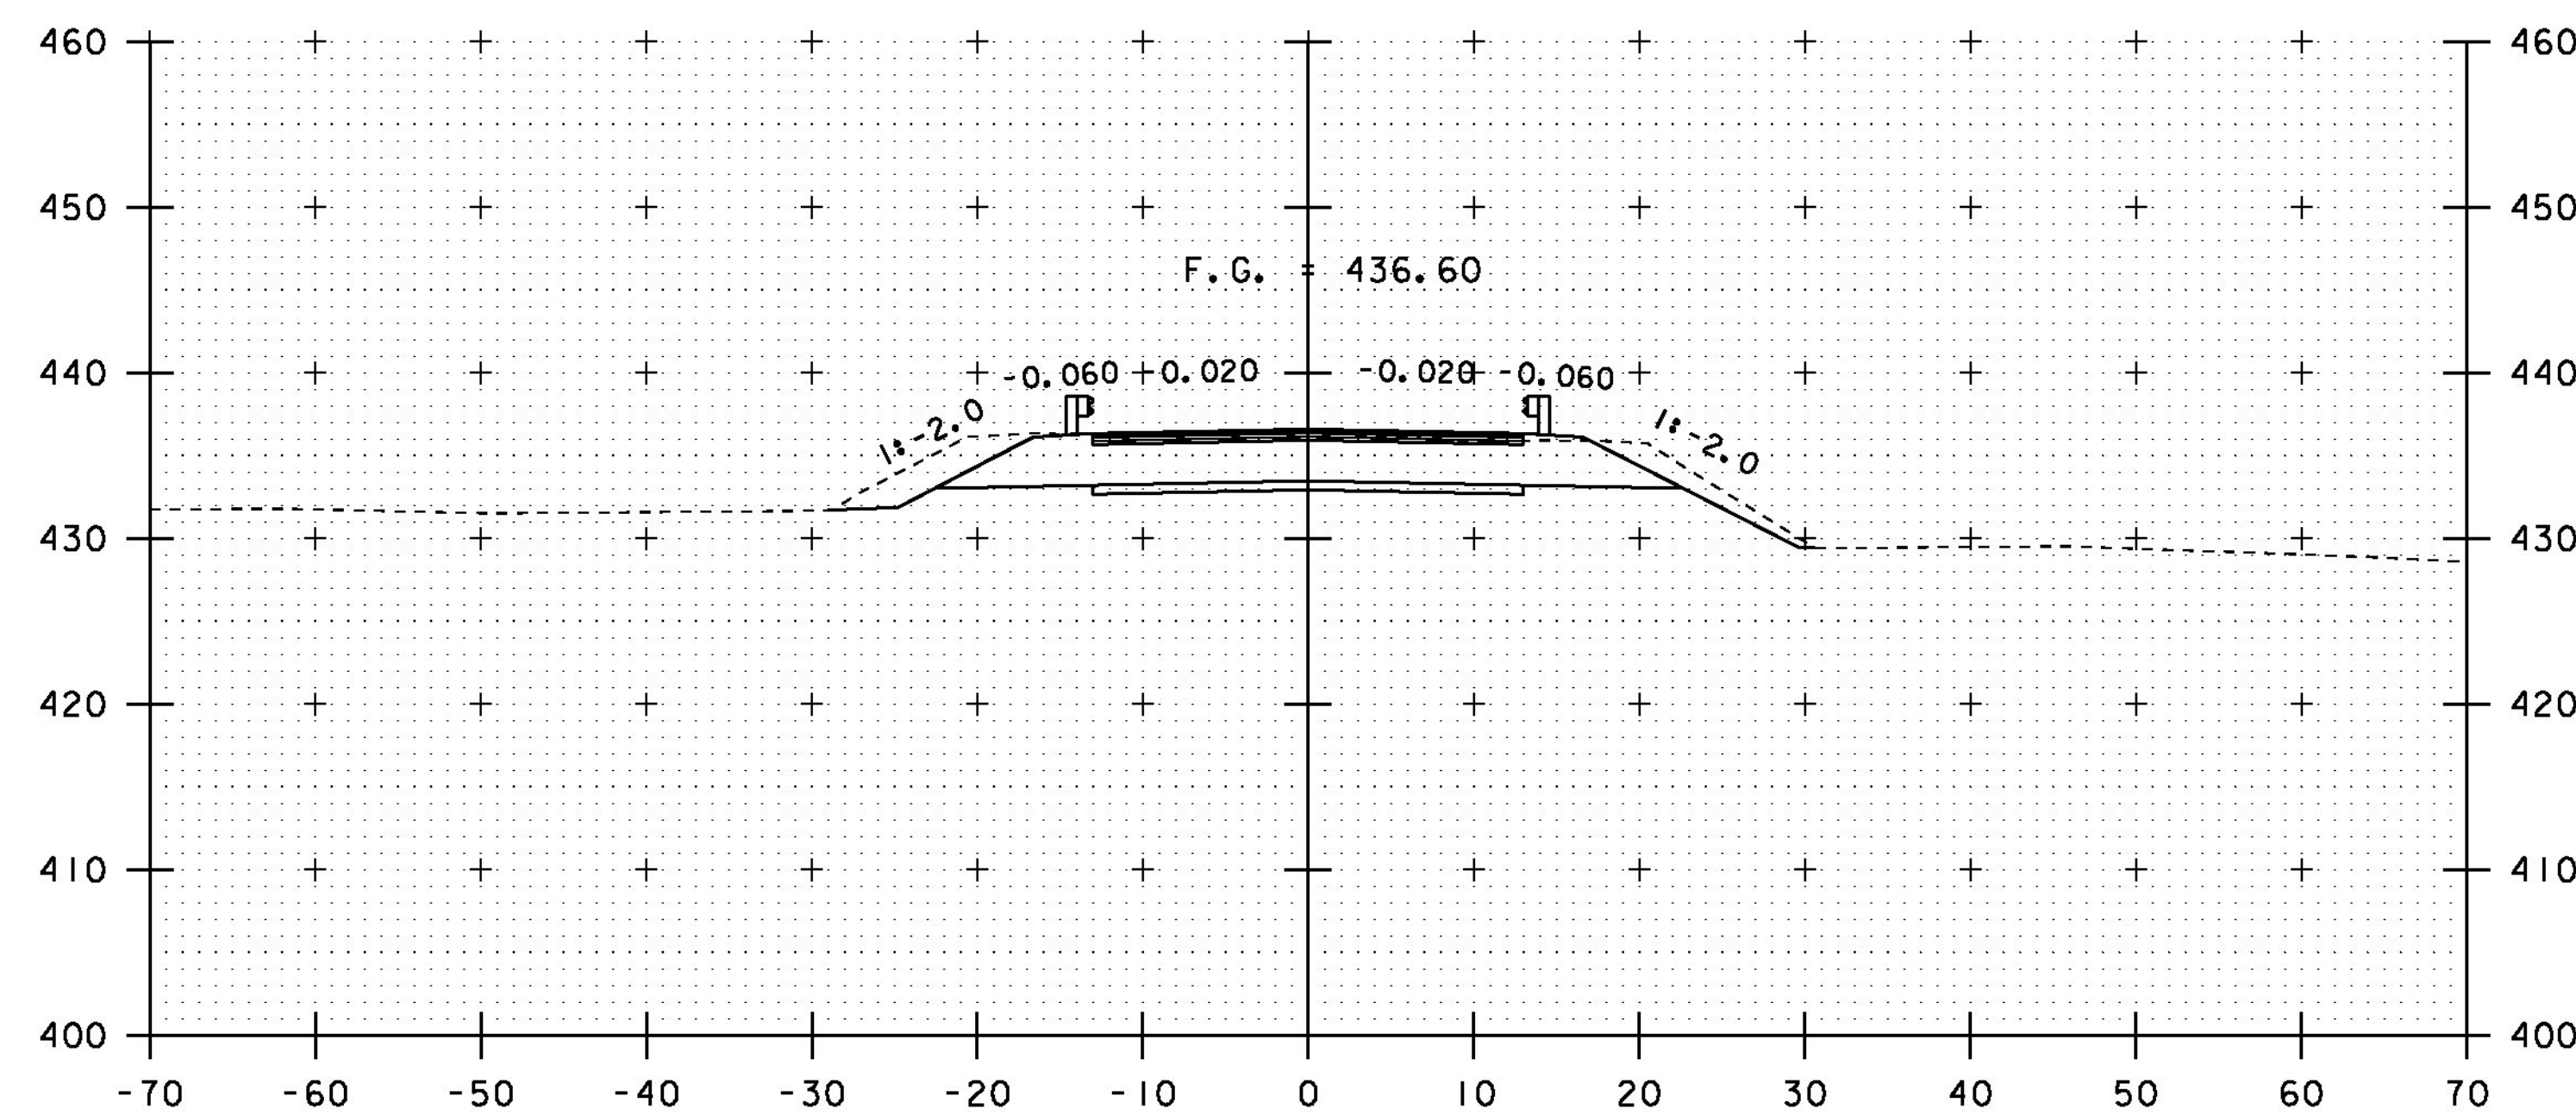

44+00

PROJECT NAME:	RICHFORD	PLOT DATE:	11-DEC-2014
PROJECT NUMBER:	BRF 0302(29)	DRAWN BY:	R. PELLETT
FILE NAME:	st2j158xs.dgn	DESIGNED BY:	H. SALLS
PROJECT LEADER:	C. CARLSON	CHECKED BY:	H. SALLS
MAINLINE CROSS SECTIONS 2			SHEET 26 OF 36

STA. 43+50 TO STA. 44+25