


STATE OF VERMONT AGENCY OF TRANSPORTATION

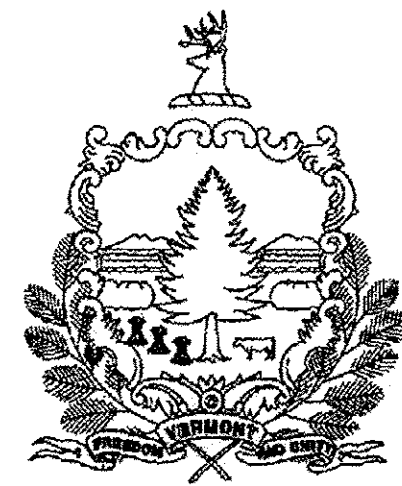


PROPOSED IMPROVEMENT BRIDGE PROJECT TOWN OF RICHFORD COUNTY OF FRANKLIN


ROUTE NO : TH 3 (FAS 0302)(RURAL MAJOR COLLECTOR) BRIDGE NO : 6
PROJECT LOCATION : BEGINNING AT A POINT ON TH 3, APPROXIMATELY 1.2 MILES WEST OF THE JUNCTION
WITH TH 1.

PROJECT DESCRIPTION : REPLACEMENT OF THE EXISTING BRIDGE WITH A CONCRETE ARCH AND RELATED ROADWAY AND CHANNEL WORK.

LENGTH OF STRUCTURE :	28.00 FEET.
LENGTH OF ROADWAY :	147.00 FEET.
LENGTH OF PROJECT :	175.00 FEET.

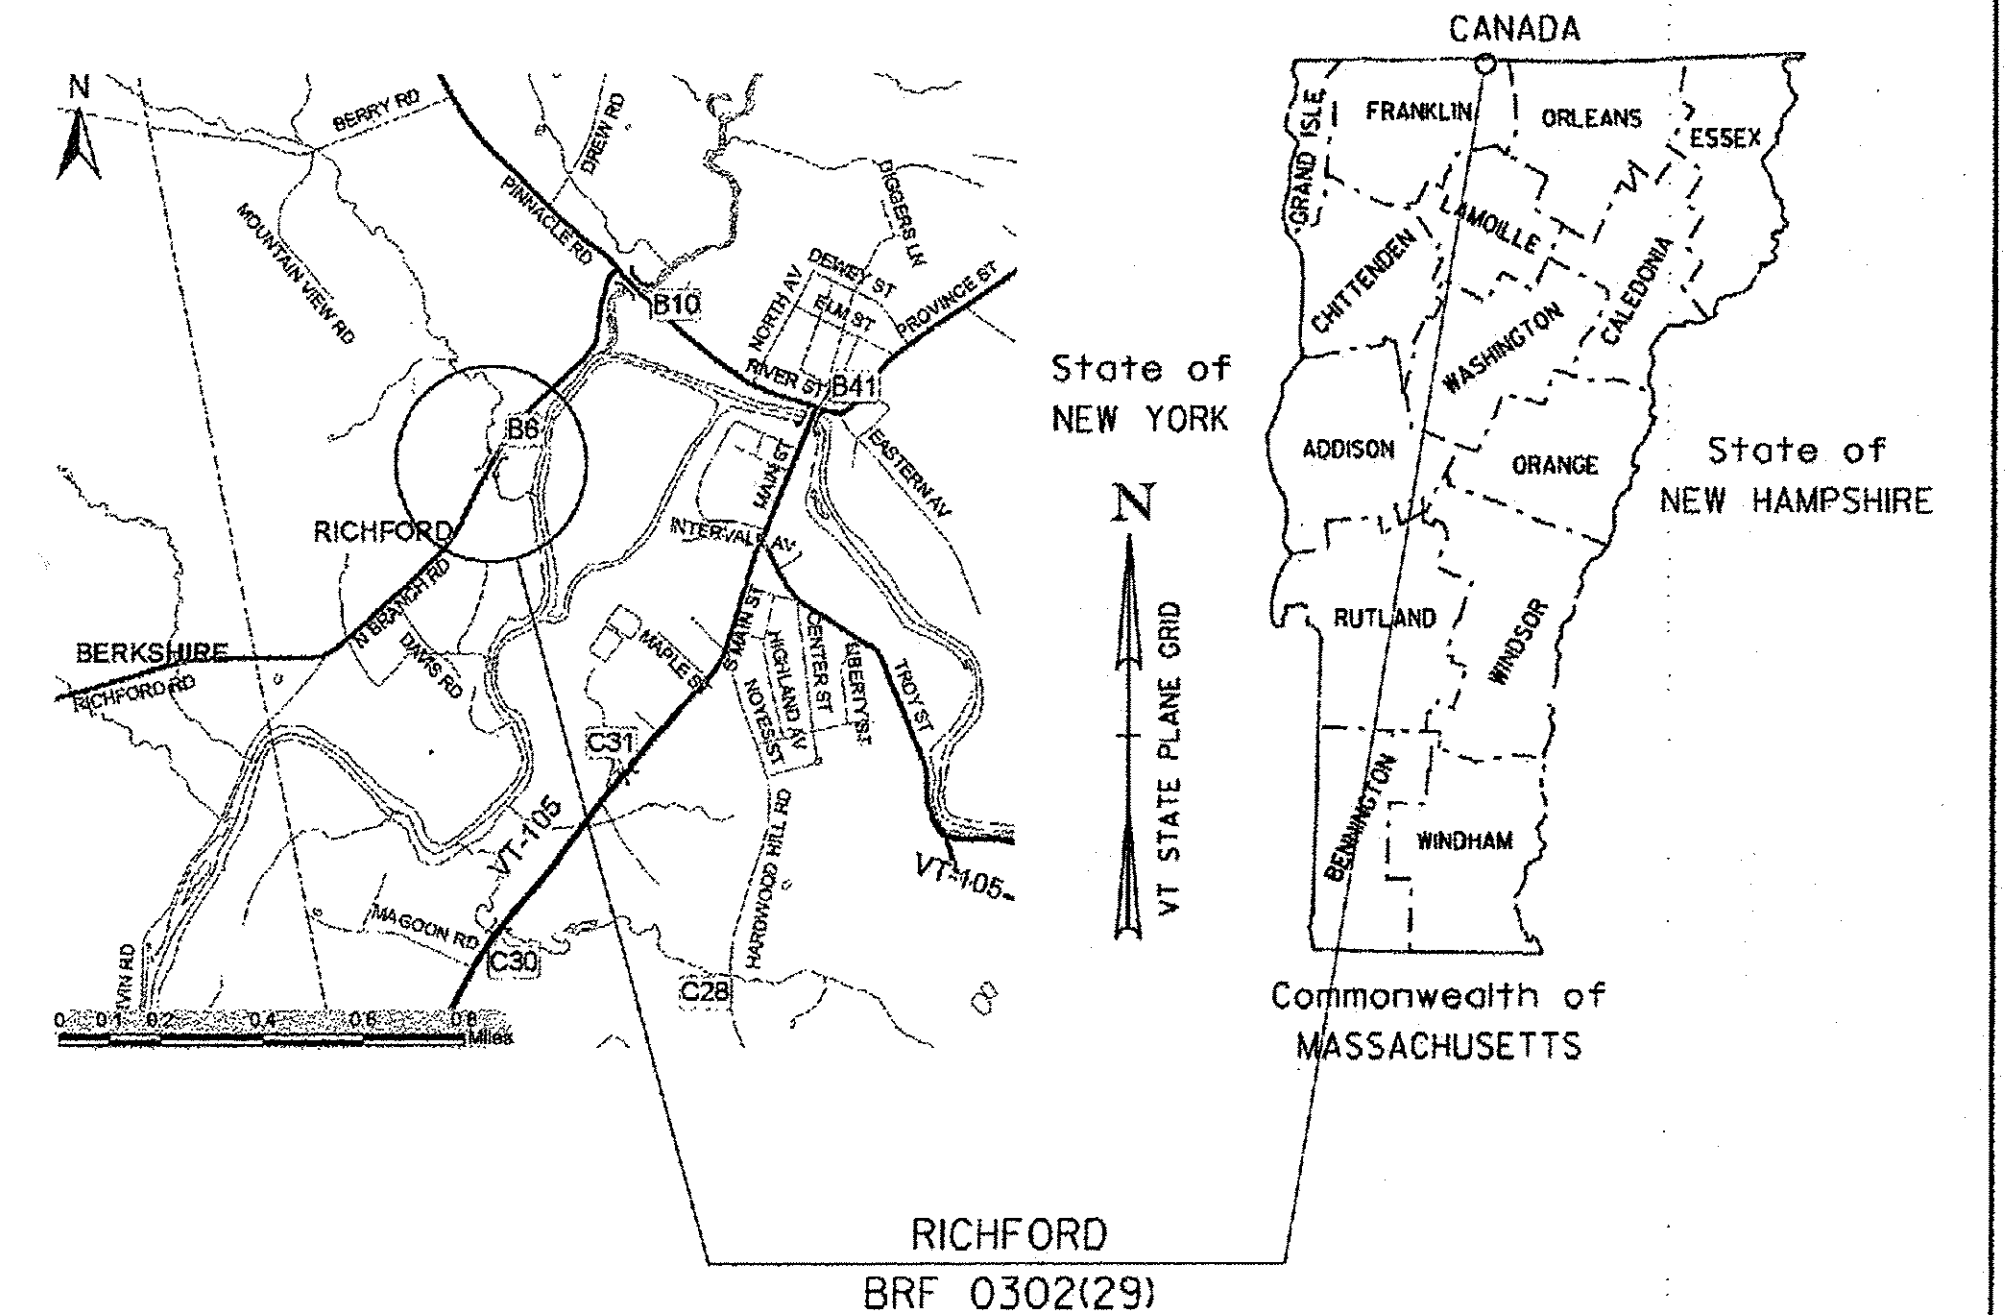


RECORD PLANS	
CONTRACTOR:	G. W. TATRO CONSTRUCTION - JEFFERSONVILLE, VT
RESIDENT ENGINEER:	SCOTT WHEATLEY
CONSTRUCTION BEGAN:	JULY 30, 2015
CONSTRUCTION COMPLETE:	AUGUST 27, 2015
RECORD PLANS BY:	SCOTT WHEATLEY & AARON JAMES
I HEREBY CERTIFY THAT ALL THE CONSTRUCTION REQUIRED BY THIS SET OF DRAWINGS HAS BEEN ACCOMPLISHED AS INDICATED HEREIN.	
BY	RESIDENT ENGINEER
DATE	July 29, 2016
NOTE: Any further information concerning final quantities, amounts or other details relative to this project may be found at Central Files in the electronic archives.	

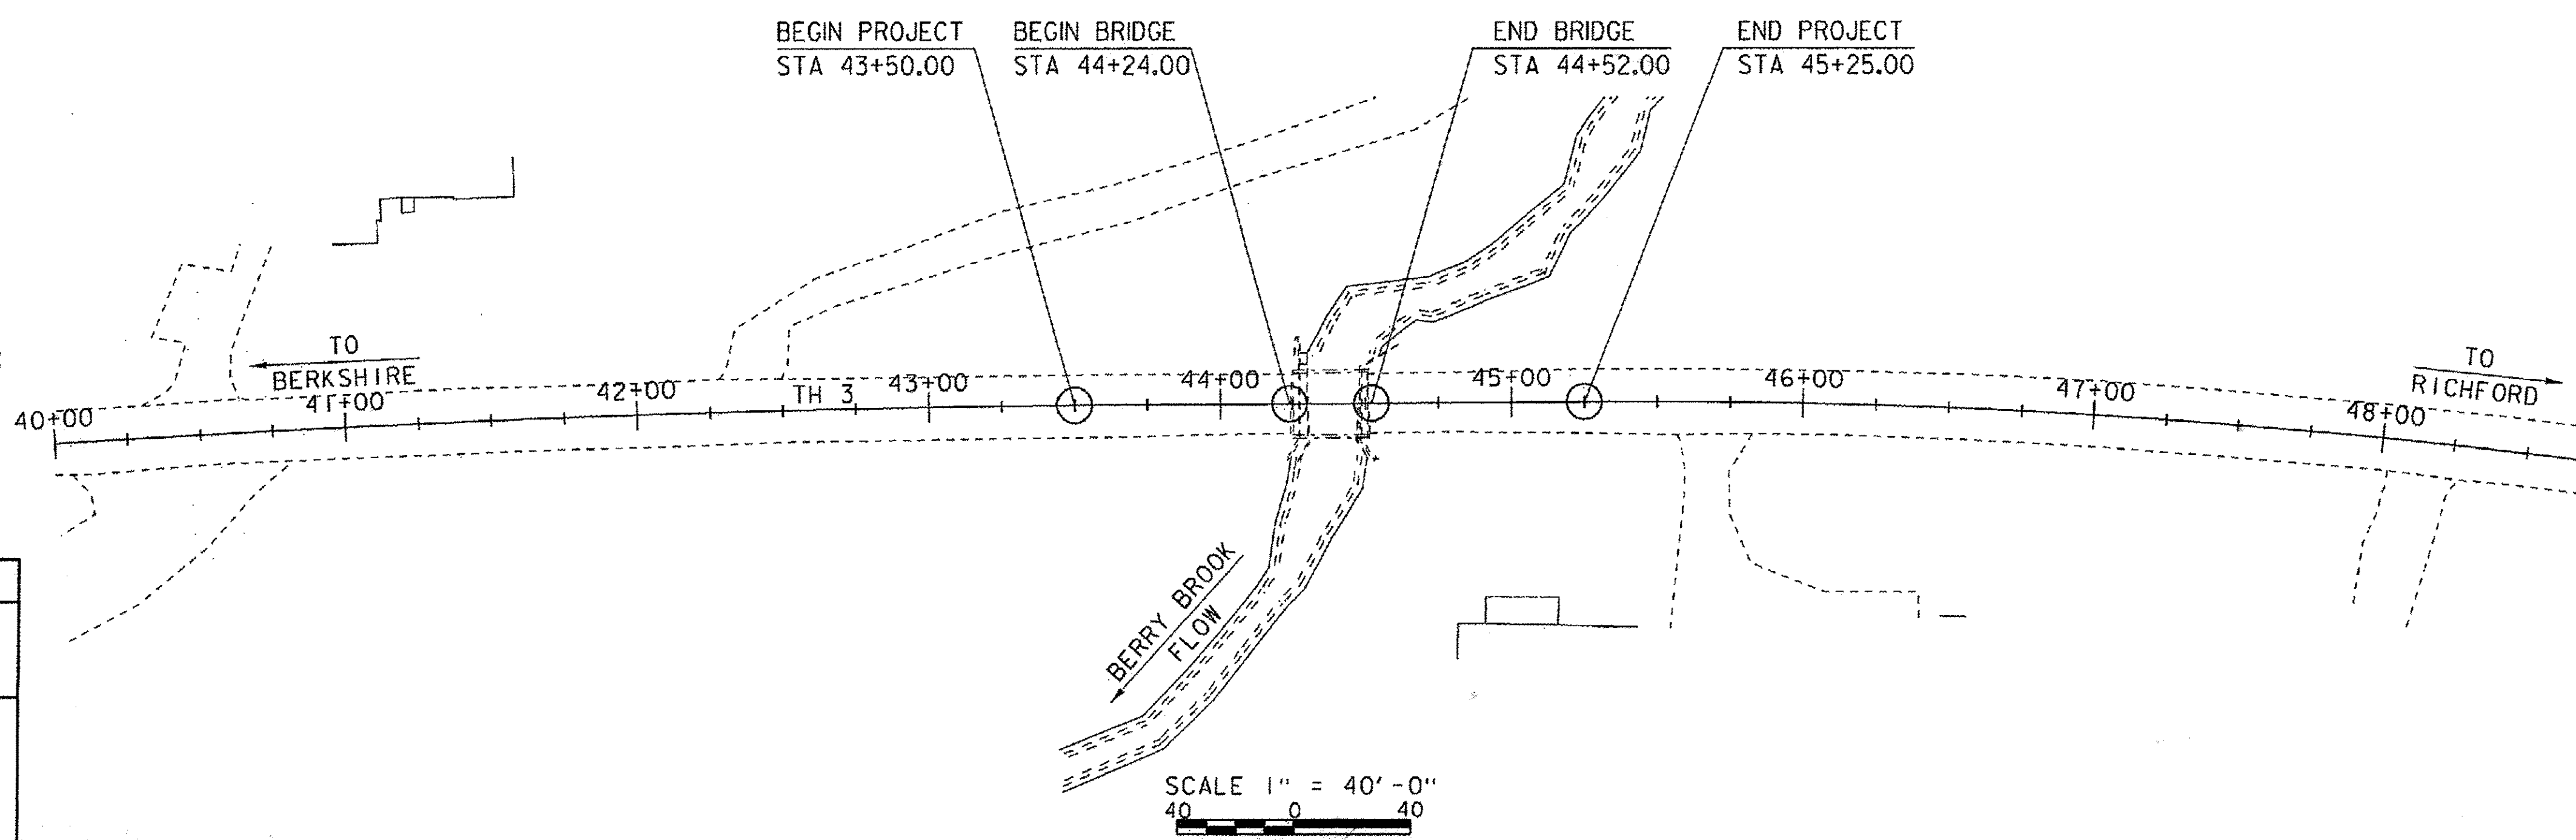

CONSTRUCTION IS TO BE CARRIED ON IN ACCORDANCE WITH THESE PLANS AND THE STANDARD SPECIFICATIONS FOR CONSTRUCTION DATED 2011, AS APPROVED BY THE FEDERAL HIGHWAY ADMINISTRATION ON JULY 20, 2011 FOR USE ON THIS PROJECT, INCLUDING ALL SUBSEQUENT REVISIONS AND SUCH REVISED SPECIFICATIONS AND SPECIAL PROVISIONS AS ARE INCORPORATED IN THESE PLANS.

QUALITY ASSURANCE PROGRAM : LEVEL 2	
SURVEYED BY :	L. ORVIS
SURVEYED DATE :	4/9/2012
DATUM	
VERTICAL	NAVD88
HORIZONTAL	NAD (83) 1996

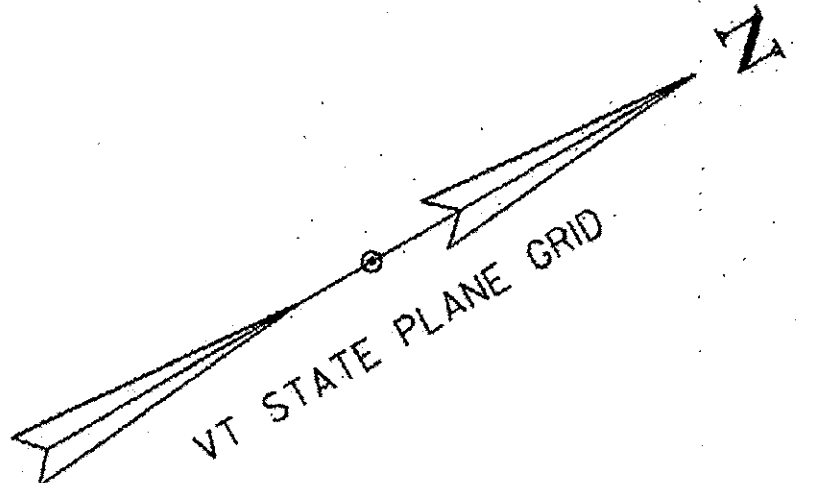

DIRECTOR OF PROJECT DELIVERY	
APPROVED	DATE 12/12/2014
PROJECT MANAGER : CAROLYN CARLSON, P.E.	
PROJECT NAME :	RICHFORD
PROJECT NUMBER :	BRF 0302 (29)
SHEET 1 OF 36 SHEETS	

PRELIMINARY INFORMATION SHEET (BRIDGE)

INDEX OF SHEETS

FINAL HYDRAULIC REPORT

PLAN SHEETS

1	TITLE
2	PRELIMINARY INFORMATION
3	TYPICAL SECTIONS
4	PROJECT NOTES
5 - 6	QUANTITY 1 & 2
7	BRIDGE QUANTITY
8	CONVENTIONAL SYMBOLOLOGY LEGEND
9	TIE
10	LAYOUT
11	TH 3 PROFILE AND TRANSITION DIAGRAMS
12	UTILITY LAYOUT
13	SIGNS & PAVEMENT MARKING LAYOUT
14	BORING INFORMATION
15 - 21	BORING LOGS 1 - 7
22	PLAN AND ELEVATION
23	BRIDGE LAYOUT AND WALL SECTIONS
24	BRIDGE ELEVATIONS
25 - 28	MAINLINE CROSS SECTIONS
29 - 30	CHANNEL CROSS SECTIONS
31	EPSC NARRATIVE
32	EPSC EXISTING CONDITIONS
33	EPSC DURING CONSTRUCTION
34	EPSC FINAL CONDITIONS
35 - 36	EPSC DETAILS

STANDARDS LIST

E-193	PAVEMENT MARKING DETAILS	08-18-1995
G-1	STEEL BEAM GUARDRAIL DETAILS (POST, DELINEATOR, TYPICALS)	02-10-2014
G-1D	STEEL BEAM GUARDRAIL DETAILS (END TERMINAL, ANCHOR, MEDIAN)	02-10-2014
G-19	GENERIC GRADING PLANS FOR GUARDRAIL END TERMINALS	11-15-2002
S-360A	BRIDGE RAILING, GALVANIZED 2 RAIL BOX BEAM	04-23-2012
S-360B	GUARDRAIL APPROACH SECTION, GALVANIZED 2 RAIL BOX BEAM	04-23-2012
S-363	THREE BEAM TO STANDARD STEEL BEAM TRANSITION SECTION	04-23-2012
T-1	TRAFFIC CONTROL GENERAL NOTES	08-06-2012
T-10	CONVENTIONAL ROADS CONSTRUCTION APPROACH SIGNING	08-06-2012
T-17	TRAFFIC CONTROL MISCELLANEOUS DETAILS	08-06-2012
T-28	CONSTRUCTION SIGN DETAILS	08-06-2012
T-30	CONSTRUCTION SIGN DETAILS	08-06-2012
T-31	CONSTRUCTION SIGN DETAILS	08-06-2012
T-42	BRIDGE NUMBER PLAQUE	04-09-2014
T-45	SQUARE TUBE SIGN POST AND ANCHOR	01-02-2013

STRUCTURES DETAIL SHEETS

SD-501.00	CONCRETE DETAILS AND NOTES	5/7/2010
SD-502.00	CONCRETE DETAILS AND NOTES	5/7/2010

HYDROLOGIC DATA

Date: February 2014

DRAINAGE AREA : 4.7 sq. mi.
 CHARACTER OF TERRAIN : Hilly, mixture of open and forested land cover
 STREAM CHARACTERISTICS : Sinuous, alluvial with low banks to floodplain relief
 NATURE OF STREAMBED : Mostly sand, gravel and silt with some cobbles

PEAK FLOW DATA

Q 2.33 =	250 cfs	Q 50 =	800 cfs
Q 10 =	500 cfs	Q 100 =	950 cfs
Q 25 =	650 cfs	Q 500 =	1330 cfs

DATE OF FLOOD OF RECORD : Unknown
 ESTIMATED DISCHARGE : Unknown
 WATER SURFACE ELEV. : Unknown
 NATURAL STREAM VELOCITY : @ Q50 = 8.0 fps
 ICE CONDITIONS : Light to moderate
 DEBRIS : Light to moderate
 DOES THE STREAM REACH MAXIMUM HIGHWATER ELEV. RAPIDLY? No
 IS ORDINARY RISE RAPID? No
 IS STAGE AFFECTED BY UPSTREAM OR DOWNSTREAM CONDITIONS? Yes
 IF YES, DESCRIBE : Flood flows on the Missisquoi River may back up through this site.
 That was not considered in this final hydraulics. Water elevations may be higher than shown.

WATERSHED STORAGE : < 1% HEADWATERS :
 UNIFORM : X
 IMMEDIATELY ABOVE SITE :

EXISTING STRUCTURE INFORMATION

STRUCTURE TYPE : Single span concrete T-beam bridge
 YEAR BUILT : 1900
 CLEAR SPAN(NORMAL TO STREAM) : 21'
 VERTICAL CLEARANCE ABOVE STREAMBED : 5'
 WATERWAY OF FULL OPENING : 125 sq. ft.
 DISPOSITION OF STRUCTURE : Remove and replace with new structure
 TYPE OF MATERIAL UNDER SUBSTRUCTURE : See boring logs

WATER SURFACE ELEVATIONS AT:

Q2.33 =	429.9'	VELOCITY =	5.9 fps
Q10 =	431.3'	"	7.5 fps
Q25 =	431.9'	"	7.6 fps
Q50 =	433.4'	"	8.0 fps
Q100 =	433.9'	"	9.1 fps

LONG TERM STREAMBED CHANGES : Scour through bridge area.

IS THE ROADWAY OVERTOPPED BELOW Q100 : No
 FREQUENCY : Above Q100
 RELIEF ELEVATION : 436.2'
 DISCHARGE OVER ROAD @Q100 : 0 cfs

UPSTREAM STRUCTURE

TOWN : Richford DISTANCE : 4,500'
 HIGHWAY # : TH 8 STRUCTURE # : 26
 CLEAR SPAN : Not available CLEAR HEIGHT : NA
 YEAR BUILT : Not available FULL WATERWAY : NA
 STRUCTURE TYPE : Not available

DOWNSTREAM STRUCTURE

TOWN : Richford DISTANCE : 800'
 HIGHWAY # : Confluence Missisquoi River STRUCTURE # :
 CLEAR SPAN : CLEAR HEIGHT :
 YEAR BUILT : FULL WATERWAY :
 STRUCTURE TYPE :

LRFR LOAD RATING FACTORS

LOADING LEVELS	TRUCK						
	H-20	HL-93	3S2	6 AXLE	3A, STR.	4A, STR.	5A, SEM
TONNAGE	20	36	36	66	30	34.5	38
INVENTORY							
POSTING							
OPERATING							
COMMENTS:							

AS BUILT "REBAR" DETAIL

LEVEL I			LEVEL II			LEVEL III		
TYPE:	GRADE:		TYPE:	GRADE:		TYPE:	GRADE:	

TRAFFIC DATA

YEAR	ADT	DHV	% D	% T	ADTT	20 year ESAL for flexible pavement from 2015 to 2035 : 882,000
2015	830	120	56	13.9	120	40 year ESAL for flexible pavement from 2015 to 2055 : 1,946,000
2035	880	120	56	17.5	160	Design Speed : 50 mph

PROPOSED STRUCTURE

STRUCTURE TYPE : Single span precast concrete structure

CLEAR SPAN(NORMAL TO STREAM) : 26'
 VERTICAL CLEARANCE ABOVE STREAMBED : 6'
 WATERWAY OF FULL OPENING : 175 sq. ft.

WATER SURFACE ELEVATIONS AT:

Q2.33 =	429.8'	VELOCITY =	5.9 fps
Q10 =	431.0'	"	7.5 fps
Q25 =	431.4'	"	7.6 fps
Q50 =	431.7'	"	8.0 fps
Q100 =	431.9'	"	8.4 fps

IS THE ROADWAY OVERTOPPED BELOW Q100 : No
 FREQUENCY : Above Q100
 RELIEF ELEVATION : 436.6'
 DISCHARGE OVER ROAD @Q100 : 0 cfs

AVERAGE LOW ELEVATION OF SUPERSTRUCTURE : 433.6'
 VERTICAL CLEARANCE : @ Q50 = 1.9'

SCOUR : Contraction scour = 3' at Q100 and 4' at Q200.

REQUIRED CHANNEL PROTECTION : Stone Fill, Type II

PERMIT INFORMATION

AVERAGE DAILY FLOW : 10 cfs DEPTH OR ELEVATION :
 ORDINARY LOW WATER : 5 cfs Depth = 0.5'
 ORDINARY HIGH WATER : 110 cfs Depth = 2.0'

TEMPORARY BRIDGE REQUIREMENTS

STRUCTURE TYPE : No temporary bridge required.
 CLEAR SPAN (NORMAL TO STREAM) :
 VERTICAL CLEARANCE ABOVE STREAMBED :
 WATERWAY AREA OF FULL OPENING :

ADDITIONAL INFORMATION

TRAFFIC MAINTENANCE NOTES

1. MAINTAIN TRAFFIC ON AN OFF SITE DETOUR.
2. TRAFFIC SIGNALS ARE NOT NECESSARY.
3. SIDEWALKS ARE NOT NECESSARY

DESIGN VALUES





1. DESIGN LIVE LOAD	HL-93
2. FUTURE PAVEMENT	d _p : 0.0 INCH
3. DESIGN SPAN	L: 26.00 FT
4. MIN. MID-SPAN POS. CAMBER @ RELEASE (PRESTRESSED UNITS)	Δ: ---
5. PRESTRESSING STRAND	f _y : ---
6. PRESTRESSED CONCRETE STRENGTH	f'c: ---
7. PRESTRESSED CONCRETE RELEASE STRENGTH	f'ci: ---
8. CONCRETE, HIGH PERFORMANCE CLASS AA	f'c: ---
9. CONCRETE, HIGH PERFORMANCE CLASS A	f'c: ---
10. CONCRETE, HIGH PERFORMANCE CLASS B	f'c: ---
11. CONCRETE, CLASS C	f'c: 3.0 KSI
12. REINFORCING STEEL	f _y : 60 KSI
13. STRUCTURAL STEEL AASHTO M270	f _y : ---
SEE PROJECT NOTES SHEET FOR INFORMATION -- 0.14 KCF	
14. NOMINAL BEARING RESISTANCE OF SOIL	q _n : ---
15. SOIL BEARING RESISTANCE FACTOR (REFER TO AASHTO LRFD)	φ: 0.45
16. NOMINAL BEARING RESISTANCE OF ROCK	q _n : ---
17. ROCK BEARING RESISTANCE FACTOR (REFER TO AASHTO LRFD)	φ: ---

18. PILE RESISTANCE FACTOR	φ: ---
19. LATERAL PILE DEFLECTION	Δ: ---
20. BASIC WIND SPEED	V _{3s} : ---
21. MINIMUM GROUND SNOW LOAD	p _g : ---
22. SEISMIC DATA	PGA: 0 S _s : --- S ₁ : ---


23. ---
 24. ---
 25. ---
 26. ---

PROJECT NAME : RICHFORD
 PROJECT NUMBER : BRF 0302(29)

FILE NAME : s12j158pi.xls PLOT DATE : 1/6/2015
 PROJECT LEADER : C. CARLSON DRAWN BY : R. PELLET
 DESIGNED BY : H. SALLS CHECKED BY : H. SALLS
 PRELIMINARY INFORMATION SHEET 2 OF 36

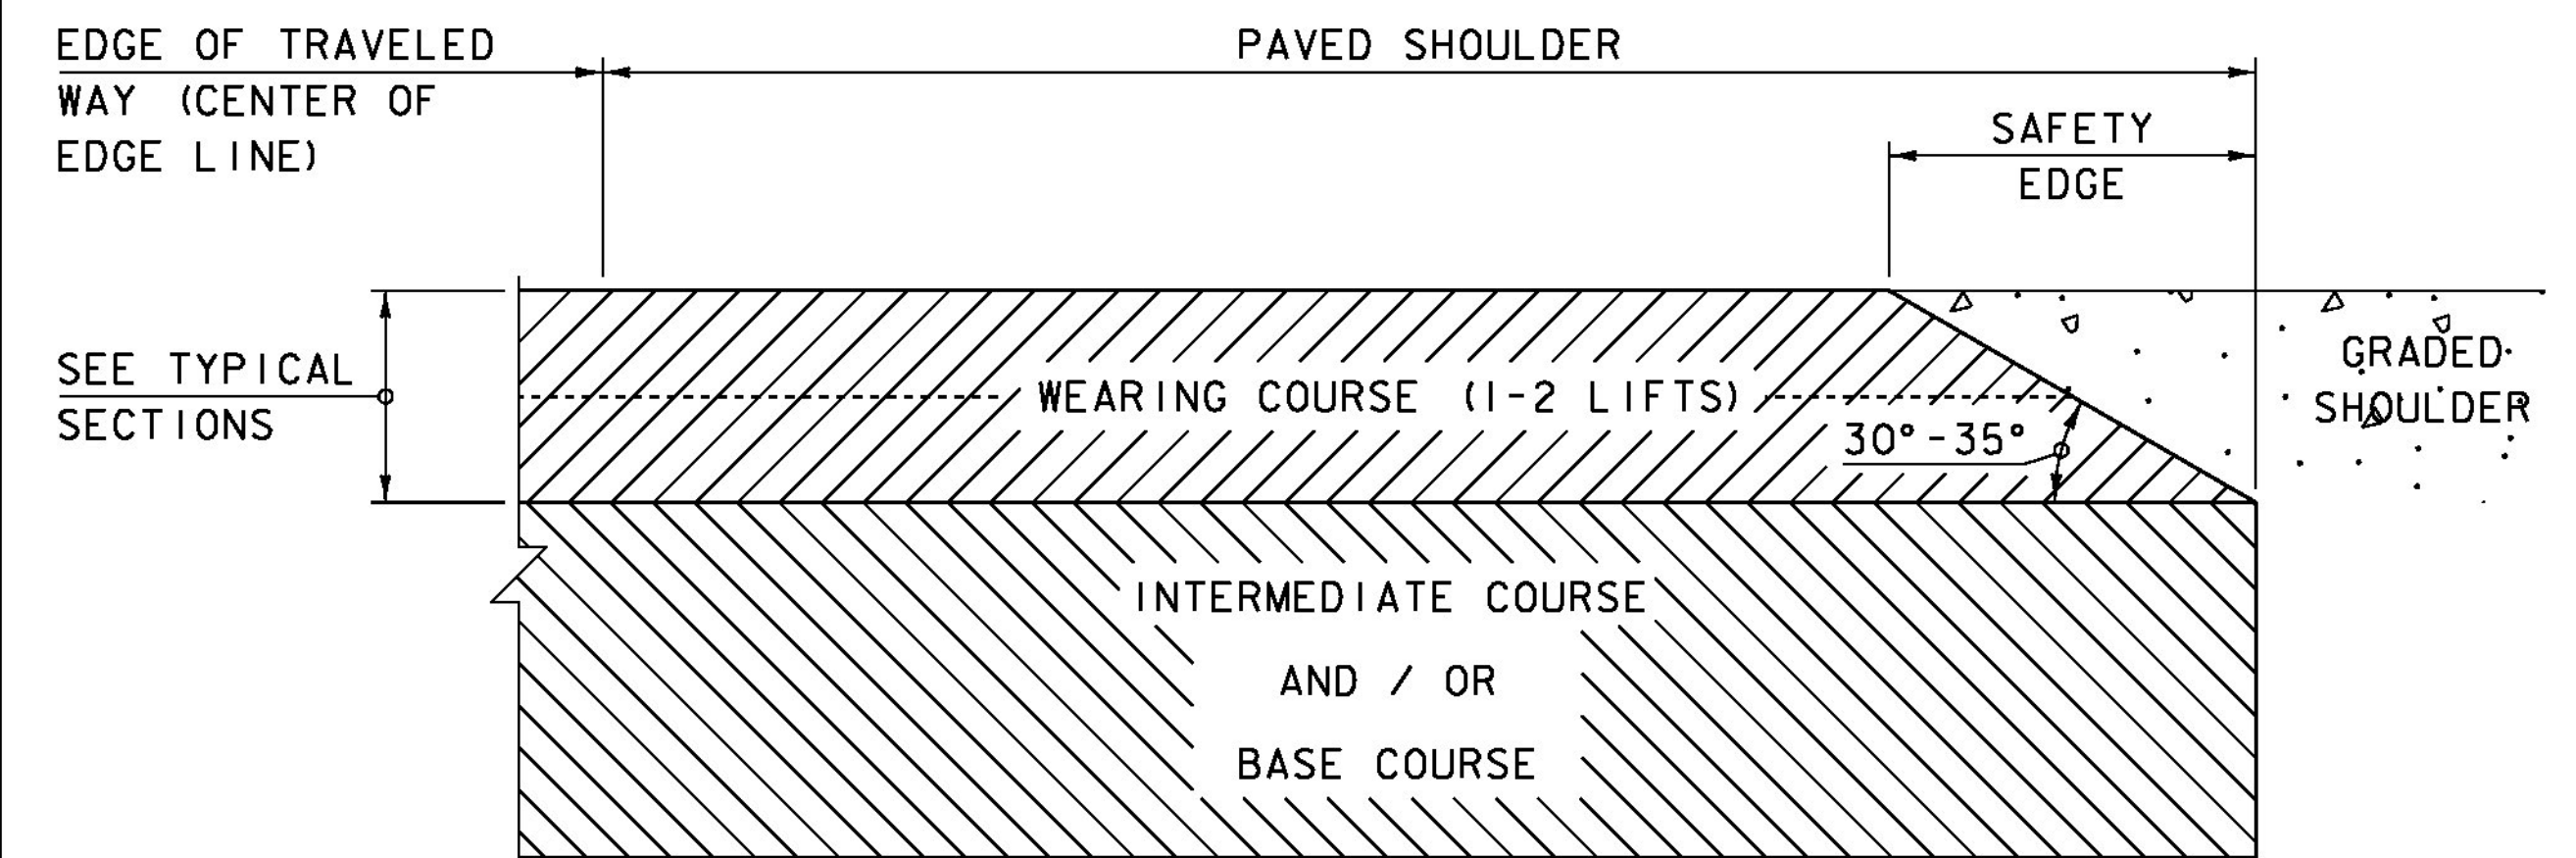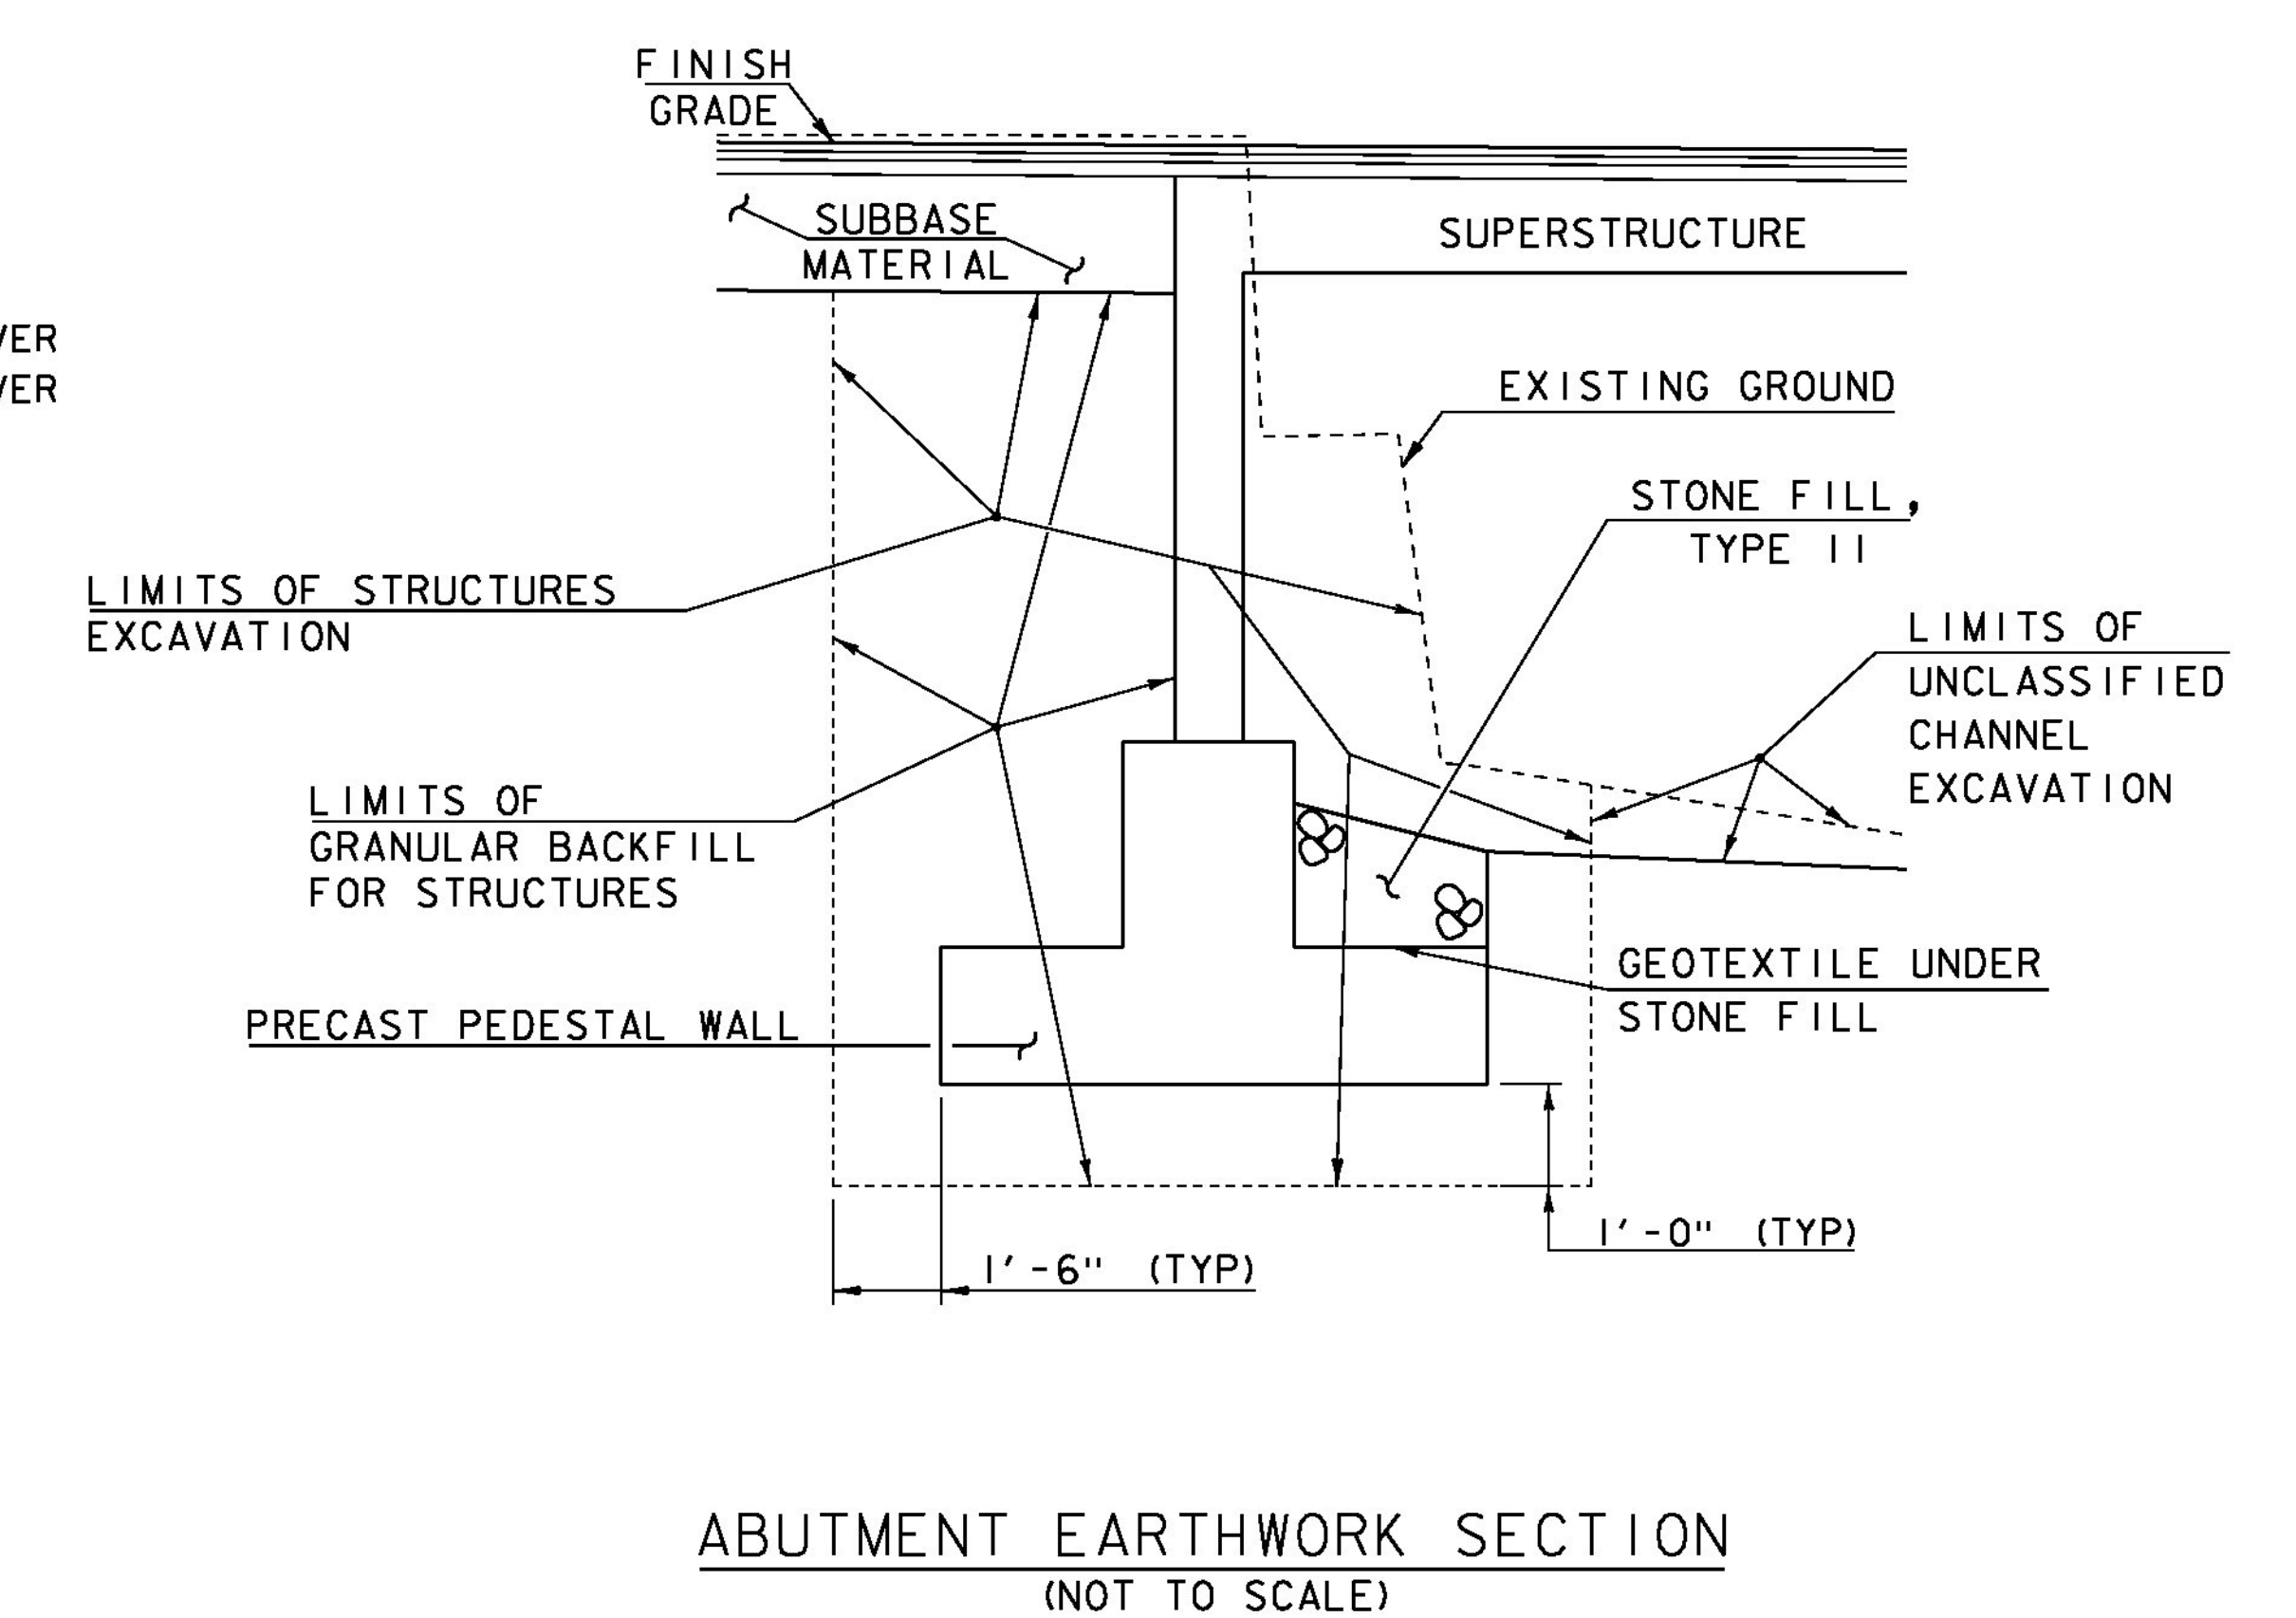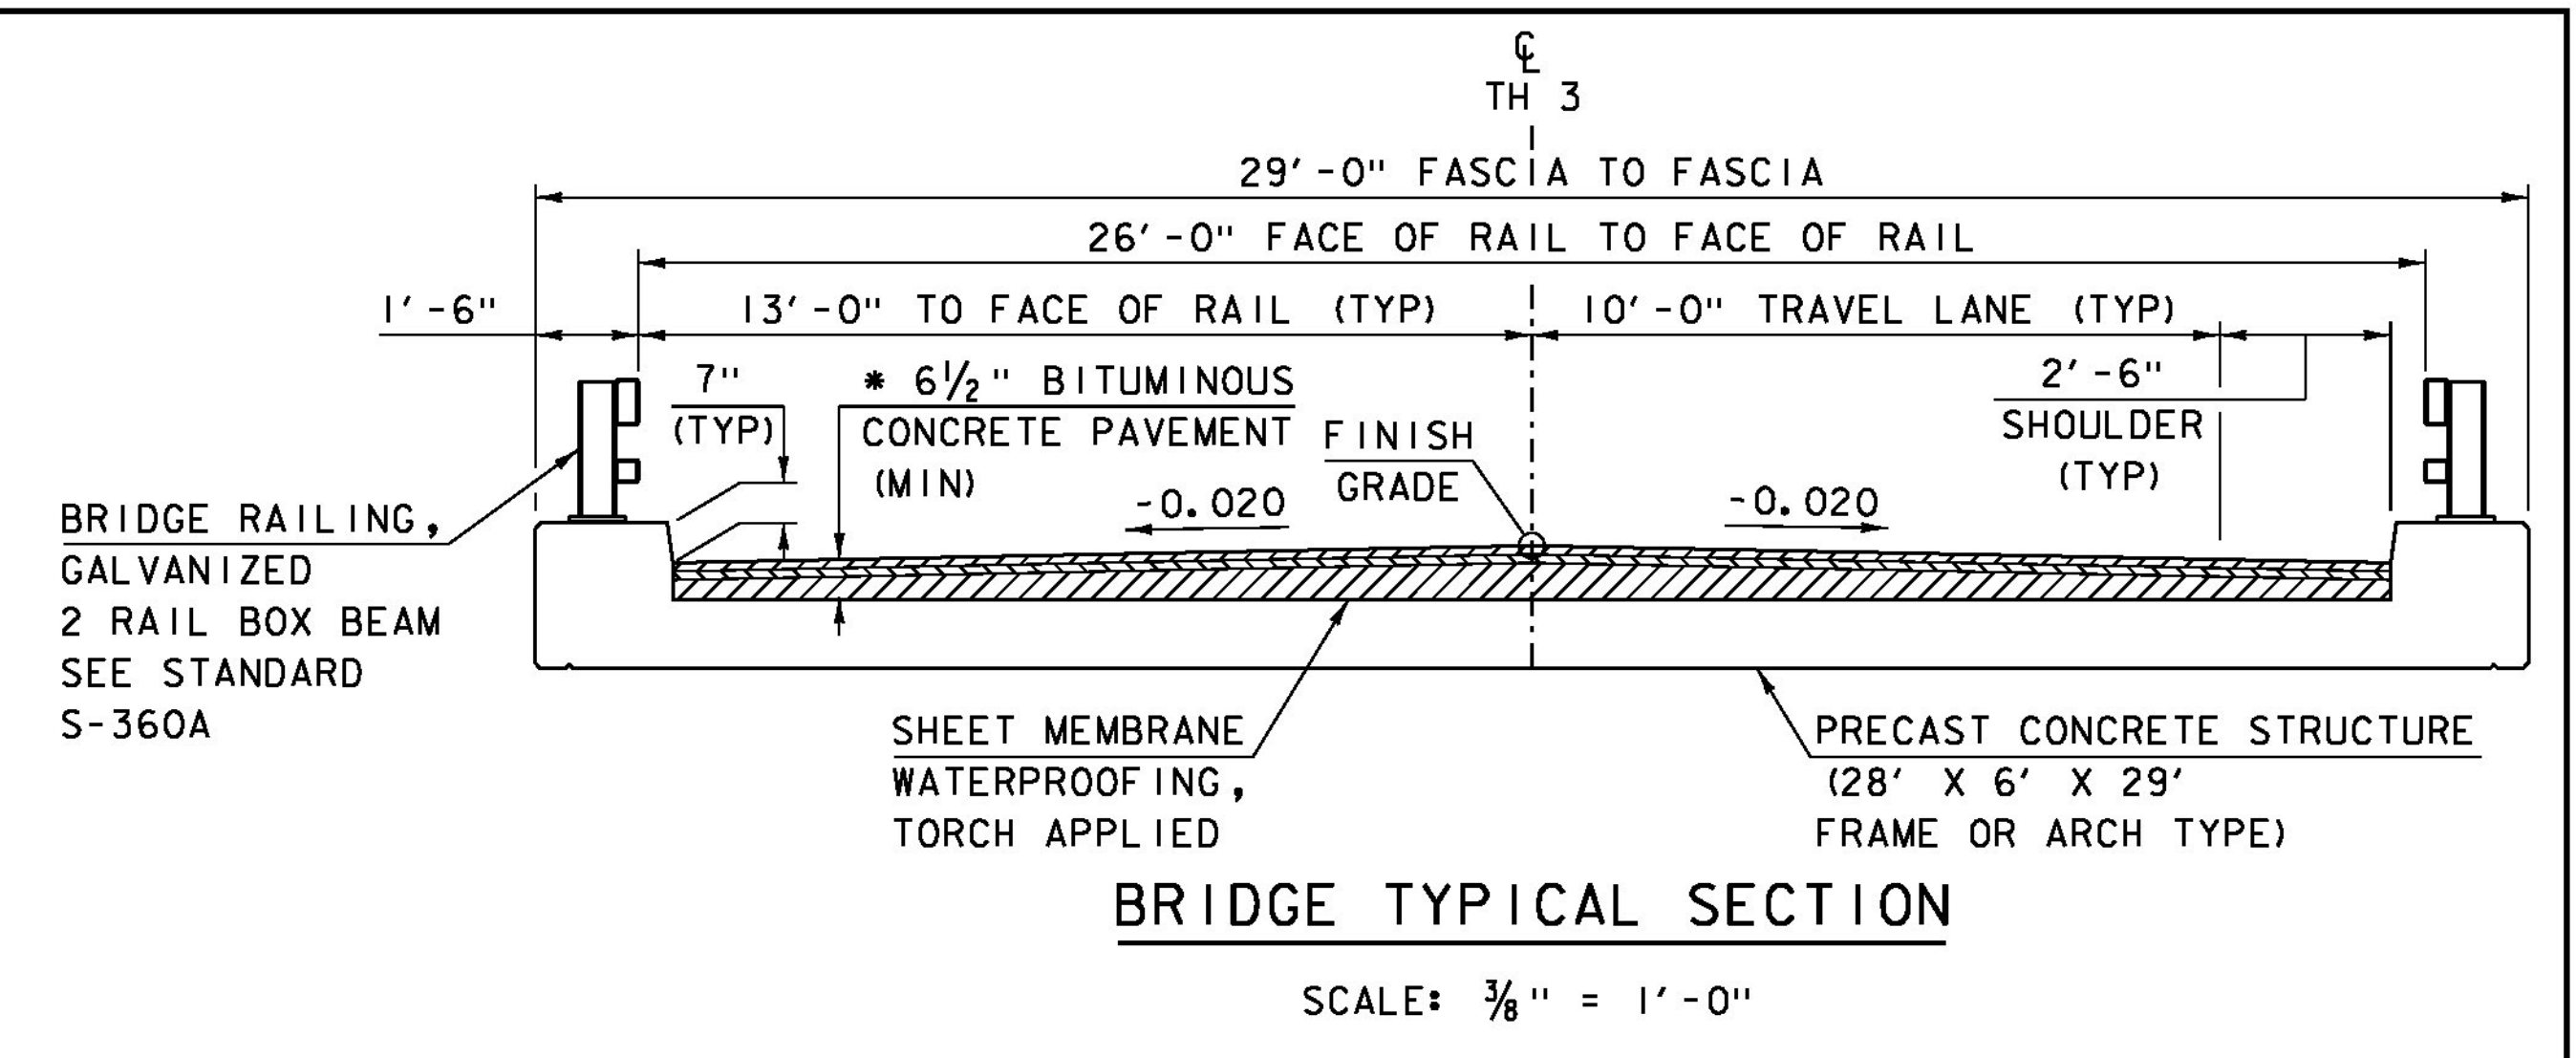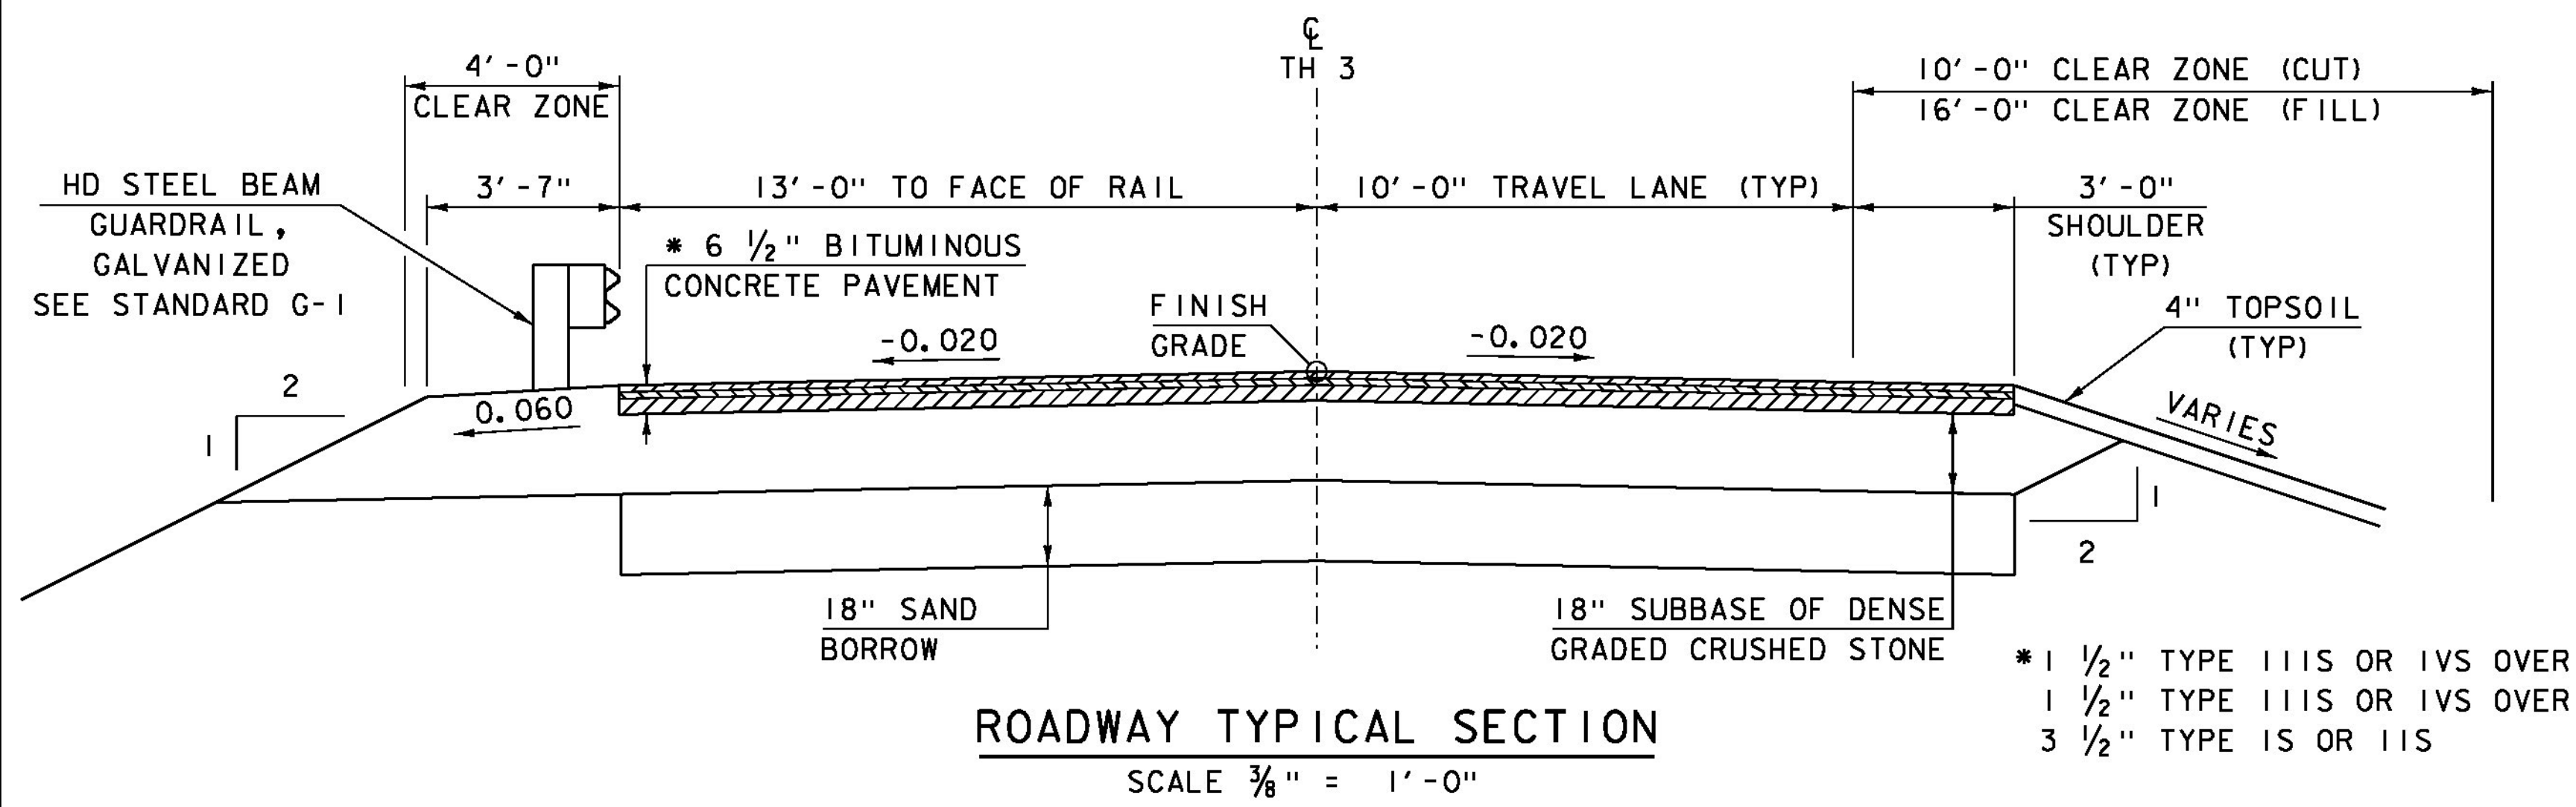

1. THE EDGE OF PAVEMENT SHALL BE FORMED IN SUCH A WAY THAT THE BITUMINOUS CONCRETE PAVEMENT IS EXTRUDED OR COMPRESSED TO FORM THE 30 TO 35 DEGREE ANGLE. DEVICES THAT SIMPLY STRIKE-OFF THE MIX WITHOUT PROVIDING ANY COMPACTIVE EFFORT WILL NOT BE ALLOWED.
2. THE PAVED SHOULDER EXTENDS FROM THE EDGE OF TRAVELED WAY TO THE EDGE OF THE WEARING COURSE, INCLUDING THE "SAFETY EDGE".

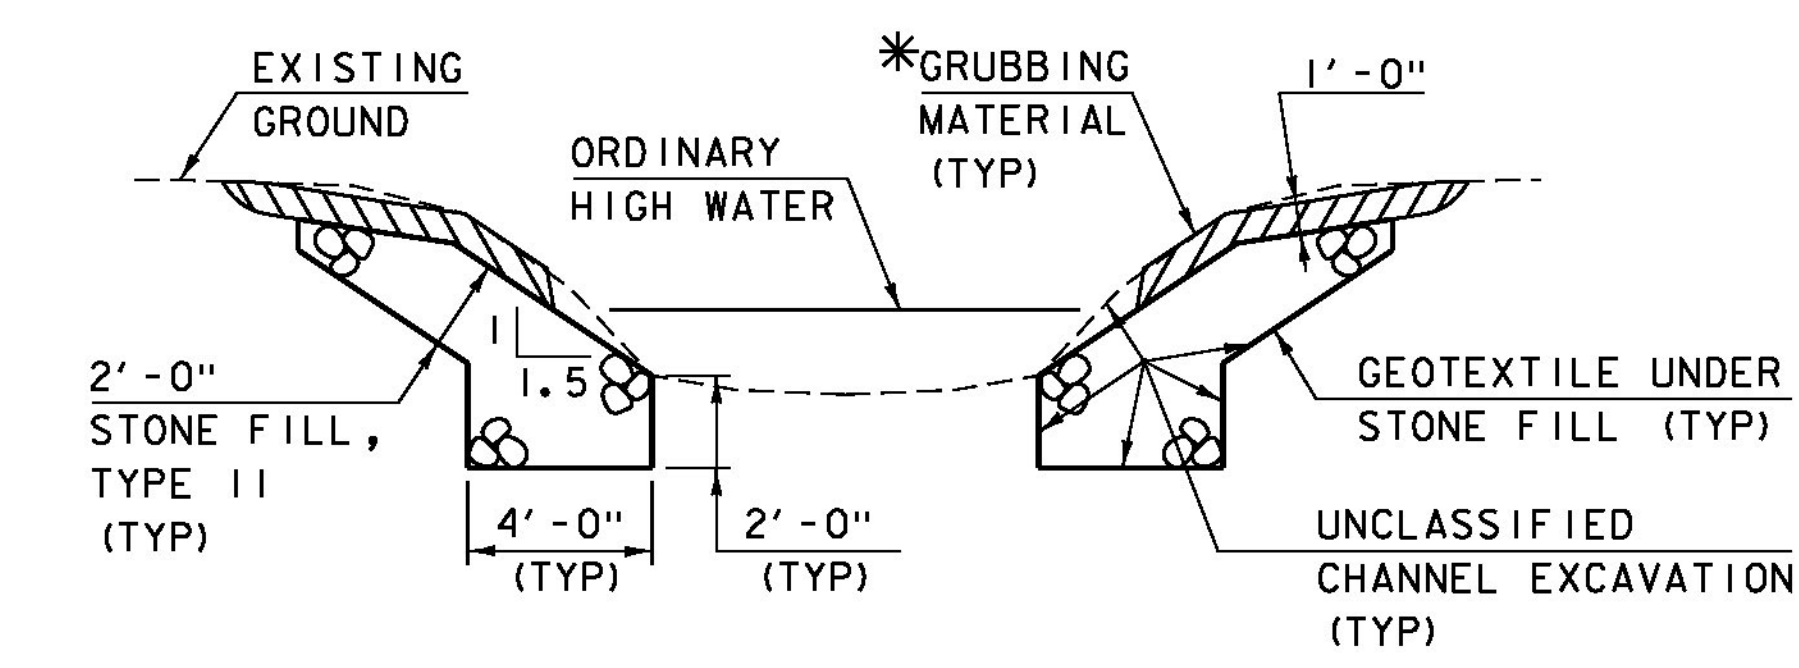

MATERIAL TOLERANCES (IF USED ON PROJECT)	
SURFACE	
- PAVEMENT (TOTAL THICKNESS)	+/- 1/4"
- AGGREGATE SURFACE COURSE	+/- 1/2"
SUBBASE	+/- 1"
SAND BORROW	+/- 1"

*WHENEVER CHANNEL SLOPE INTERSECTS ROADWAY SUBBASE, GRUBBING MATERIAL SHALL BEGIN AT THE BOTTOM OF SUBBASE.

PROJECT NAME:	RICHFORD	PLOT DATE:	11-DEC-2014
PROJECT NUMBER:	BRF 0302(29)	DRAWN BY:	R. PELLETT
FILE NAME:	sl2j158+yp.dgn	DESIGNED BY:	H. SALLS
TYPICAL SECTIONS		CHECKED BY:	H. SALLS
			SHEET 3 OF 36

GENERAL

1. THE CONTRACTOR WILL BE ALLOWED TO CLOSE THE ROAD TO TRAFFIC FOR INSTALLATION OF THE NEW STRUCTURE. SEE THE SPECIAL PROVISIONS FOR ADDITIONAL INFORMATION AND REQUIREMENTS.
2. ALL MATERIALS AND CONSTRUCTION SHALL CONFORM TO THE STATE OF VERMONT AGENCY OF TRANSPORTATION STANDARD SPECIFICATIONS FOR CONSTRUCTION DATED 2011, AND ITS LATEST REVISIONS, THE AASHTO LRFD BRIDGE DESIGN SPECIFICATIONS 2012, AND ITS LATEST REVISIONS, AND THE VTRANS STRUCTURES DESIGN MANUAL.
3. ALL PRECAST CONCRETE COMPONENTS INCLUDING THE FOOTINGS, PEDESTAL WALLS, RIGID FRAME OR ARCH, HEADWALLS, WINGWALLS AND ALL CONNECTIONS BETWEEN THESE COMPONENTS SHALL BE DESIGNED BY THE PRECAST FABRICATOR. THE DESIGN CRITERIA USED FOR THIS PROJECT IS INDICATED BELOW.
4. DESIGN CRITERIA:

DESIGN LIVE LOAD: FILL OVER THE STRUCTURE:	HL - 93 6 INCHES MINIMUM
FOUNDATION SOIL PARAMETERS UNIT WEIGHT: FRICTION ANGLE:	125 PCF 36 DEGREES
COEFFICIENT OF FRICTION FORMED CONCRETE AGAINST SOIL:	0.35
RETAINED SOIL PARAMETERS UNIT WEIGHT: FRICTION ANGLE:	140 PCF 35 DEGREES
COEFFICIENT OF FRICTION CONCRETE CAST AGAINST SOIL: FORMED AGAINST SOIL:	0.55 0.45
NOMINAL BEARING RESISTANCE:	10 KSF FOR FOOTING WIDTHS > 6 FT
5. ALL DIMENSIONS SHOWN IN THE PLANS ARE HORIZONTAL OR VERTICAL AND ARE GIVEN AT 68 DEGREES FAHRENHEIT, UNLESS NOTED OTHERWISE.
6. ITEM 529.15 "REMOVAL OF STRUCTURE" SHALL INCLUDE THE REMOVAL OF THE EXISTING SUPERSTRUCTURE AND ANY PORTION OF THE EXISTING ABUTMENTS NOT REMOVED UNDER STRUCTURE EXCAVATION OR UNCLASSIFIED CHANNEL EXCAVATION.
7. THE DESIGN SHALL INCLUDE THE EFFECTS OF ALL LOADS, INCLUDING BUT NOT LIMITED TO LIVE LOAD, EARTH SURCHARGE AND HYDROSTATIC PRESSURE.
8. THE FABRICATOR SHALL BE RESPONSIBLE FOR SUPPLYING THE STATE WITH THE LRFR LOAD RATING FACTORS TO COMPLETE THE CHART SHOWN ON THE PRELIMINARY INFORMATION SHEET.
9. THE RIGID FRAME OR ARCH, HEADWALLS AND WINGWALLS SHALL BE PRECAST CONCRETE CONFORMING TO SECTION 540 AND WILL BE PAID FOR UNDER THE APPROPRIATE 540 CONTRACT ITEM.
10. ALL ELEMENTS OF THE PRECAST STRUCTURE(S) SHALL BE DESIGNED BY THE PRECAST SUPPLIER, INCLUDING THE ANCHORAGE AND CONNECTIONS BETWEEN ELEMENTS. ALL ELEMENTS SHALL BE INSTALLED IN ACCORDANCE WITH THE FABRICATOR'S RECOMMENDATIONS. THE CONTRACTOR SHALL SUBMIT FABRICATION DRAWINGS FOR THE PRECAST RIGID FRAME OR ARCH IN ACCORDANCE WITH SECTION 105. IN ADDITION TO FABRICATION DRAWINGS, THE FABRICATOR SHALL PROVIDE A LOAD RATING AND SUPPORTING CALCULATIONS IN ACCORDANCE WITH THE AASHTO SPECIFICATIONS REFERENCED IN GENERAL NOTE 1 AND THE VTRANS STRUCTURES DESIGN MANUAL, 2010. THE RATING AND SUPPORTING CALCULATIONS SHALL BE SIGNED, STAMPED AND DATED BY A PROFESSIONAL ENGINEER LICENSED TO PRACTICE ENGINEERING IN THE STATE OF VERMONT. NOTE THAT THE FABRICATOR ASSUMES ALL LIABILITY FOR THE ADEQUACY AND ACCURACY OF THE RIGID FRAME OR ARCH DESIGN AND LOAD RATING.
11. WATER REPELLENT, SILANE SHALL BE FURNISHED IN ACCORDANCE WITH SECTION 514 AND SHALL BE SHOP APPLIED TO ALL EXPOSED CONCRETE SURFACES, EXCEPT THE UNDERSIDE OF THE STRUCTURE BETWEEN THE DRIP NOTCHES. ALL WORK IS INCIDENTAL TO THE APPROPRIATE 540 CONTRACT ITEM.
12. ALL EXPOSED EDGES OF CONCRETE SHALL BE CHAMFERED 1" x 1".
13. REINFORCING STEEL PLACEMENT TOLERANCES SHALL BE:
SPACING: +/- 1 INCH
CLEARANCE: +/- 1/4 INCH
14. PRECAST TOLERANCES:
HEIGHT/WIDTH: +/- 1/4 INCH
LENGTH: +/- 1/2 INCH
15. ALL REINFORCING STEEL IN THE PRECAST PEDESTAL WALLS AND FOOTINGS SHALL MEET THE REQUIREMENTS OF SECTION 507 FOR LEVEL I REINFORCING.
16. ALL REINFORCING STEEL IN THE PRECAST RIGID FRAME OR ARCH, WINGWALLS AND HEADWALLS SHALL MEET THE REQUIREMENTS OF SECTION 507 FOR LEVEL II REINFORCING.
17. PAYMENT FOR REINFORCING STEEL WILL BE INCLUDED IN THE UNIT BID PRICE FOR THE APPROPRIATE SECTION 540 CONTRACT ITEM.
18. THE PROPOSED STRUCTURE SHALL BE A THREE-SIDED RIGID FRAME OR ARCH WITH A MINIMUM CLEAR SPAN OF 26'. THE LUMP SUM COST FOR ITEM 540.10 "PRECAST CONCRETE STRUCTURE (28'-0" x 6'-0" x 29'-0" FRAME OR ARCH TYPE) SHALL INCLUDE THE PRECAST RIGID FRAME OR ARCH AND MECHANICAL CONNECTIONS.
19. THE PRECAST STRUCTURE DETAILS ARE SHOWN FOR REFERENCE ONLY. THE ACTUAL DIMENSIONS AND CONFIGURATION WILL BE DEPENDENT ON THE FABRICATOR. THE INSIDE CLEAR DIMENSION SHALL BE 26' - 0" AND THE RISE SHALL BE 6' - 0".
20. NO HOLES SHALL BE DRILLED IN THE RIGID FRAME OR ARCH WITHOUT THE APPROVAL OF THE FABRICATOR AND VTRANS.
21. THE USE OF EQUIPMENT AND THE METHOD OF BACKFILLING AROUND THE BURIED STRUCTURE SHALL BE IN ACCORDANCE WITH THE MANUFACTURER'S RECOMMENDATION. CARE SHALL BE TAKEN WHEN BACKFILLING AGAINST JOINT SEALING MATERIALS.
22. JOINTS BETWEEN ALL ABUTTING PRECAST UNITS SHALL BE WATERTIGHT AND MECHANICALLY CONNECTED.

TRAFFIC CONTROL

23. THE CONTRACTOR SHALL BE RESPONSIBLE FOR THE DESIGN AND INSTALLATION OF A SITE SPECIFIC TRAFFIC CONTROL PLAN FOR ALL STAGES OF CONSTRUCTION. THE CONTRACTOR SHALL SUBMIT DETAILED TRAFFIC CONTROL PLANS TO THE RESIDENT ENGINEER FOR APPROVAL PER SUBSECTION 105.03. ALL COSTS SHALL BE INCLUDED IN ITEM 900.645 SPECIAL PROVISION (TRAFFIC CONTROL, ALL-INCLUSIVE).
24. THE TOWN SHALL BE RESPONSIBLE FOR SIGNING THE DETOUR; THE CONTRACTOR SHALL GIVE THE TOWN 21 DAYS NOTICE PRIOR TO ANY ROAD CLOSURE.
25. FOR MORE INFORMATION SEE THE SPECIAL PROVISIONS.

CONCRETE AND REINFORCING STEEL

9. THE RIGID FRAME OR ARCH, HEADWALLS AND WINGWALLS SHALL BE PRECAST CONCRETE CONFORMING TO SECTION 540 AND WILL BE PAID FOR UNDER THE APPROPRIATE 540 CONTRACT ITEM.
10. ALL ELEMENTS OF THE PRECAST STRUCTURE(S) SHALL BE DESIGNED BY THE PRECAST SUPPLIER, INCLUDING THE ANCHORAGE AND CONNECTIONS BETWEEN ELEMENTS. ALL ELEMENTS SHALL BE INSTALLED IN ACCORDANCE WITH THE FABRICATOR'S RECOMMENDATIONS. THE CONTRACTOR SHALL SUBMIT FABRICATION DRAWINGS FOR THE PRECAST RIGID FRAME OR ARCH IN ACCORDANCE WITH SECTION 105. IN ADDITION TO FABRICATION DRAWINGS, THE FABRICATOR SHALL PROVIDE A LOAD RATING AND SUPPORTING CALCULATIONS IN ACCORDANCE WITH THE AASHTO SPECIFICATIONS REFERENCED IN GENERAL NOTE 1 AND THE VTRANS STRUCTURES DESIGN MANUAL, 2010. THE RATING AND SUPPORTING CALCULATIONS SHALL BE SIGNED, STAMPED AND DATED BY A PROFESSIONAL ENGINEER LICENSED TO PRACTICE ENGINEERING IN THE STATE OF VERMONT. NOTE THAT THE FABRICATOR ASSUMES ALL LIABILITY FOR THE ADEQUACY AND ACCURACY OF THE RIGID FRAME OR ARCH DESIGN AND LOAD RATING.
11. WATER REPELLENT, SILANE SHALL BE FURNISHED IN ACCORDANCE WITH SECTION 514 AND SHALL BE SHOP APPLIED TO ALL EXPOSED CONCRETE SURFACES, EXCEPT THE UNDERSIDE OF THE STRUCTURE BETWEEN THE DRIP NOTCHES. ALL WORK IS INCIDENTAL TO THE APPROPRIATE 540 CONTRACT ITEM.

PROJECT NAME:	RICHFORD
PROJECT NUMBER:	BRF 0302(29)
FILE NAME:	s12j158pnote.dgn
PROJECT LEADER:	C. CARLSON
DESIGNED BY:	H. SALLS
PROJECT NOTES	
PLOT DATE:	12-JAN-2015
DRAWN BY:	R. PELLETT
CHECKED BY:	H. SALLS
SHEET	4 OF 36

QUANTITY SHEET 1

SUMMARY OF ESTIMATED QUANTITIES										TOTALS		DESCRIPTIONS				DETAILED SUMMARY OF QUANTITIES			
							ROADWAY	EROSION CONTROL	BRIDGE	FULL C.E. ITEMS	GRAND TOTAL	FINAL	UNIT	ITEMS	ITEM NUMBER	ROUND	QUANTITIES	UNIT	ITEMS
							1				1		LS	CLEARING AND GRUBBING, INCLUDING INDIVIDUAL TREES AND STUMPS	201.10				EARTHWORKS SUMMARY
							670				670		CY	COMMON EXCAVATION	203.15				FILL AVAILABLE
									50		50		CY	UNCLASSIFIED CHANNEL EXCAVATION	203.27				670 CY COMMON EXCAVATION (670 x 1.0)
							160				160		CY	SAND BORROW	203.31				15 CY UNCLASSIFIED CHANNEL EXCAVATION (50 x 0.3)
							80				80		CY	GRANULAR BORROW	203.32				228 CY STRUCTURE EXCAVATION (760 x 0.3)
							1				1		CY	TRENCH EXCAVATION OF EARTH, EXPLORATORY (N.A.B.I.)	204.22				2 CY ROUNDING
									760		760		CY	STRUCTURE EXCAVATION	204.25				915 CY TOTAL FILL AVAILABLE
									280		280		CY	GRANULAR BACKFILL FOR STRUCTURES	204.30				FILL REQUIRED
							250				250		SY	COLD PLANING, BITUMINOUS PAVEMENT	210.10				92 CY FACTORED FILL (80 x 1.15)
							450				450		CY	SUBBASE OF DENSE GRADED CRUSHED STONE	301.35				3 CY ROUNDING
							7				7		CWT	EMULSIFIED ASPHALT	404.65				95 CY TOTAL FILL REQUIRED
							1				1		LU	PRICE ADJUSTMENT, ASPHALT CEMENT (N.A.B.I.)	406.50				820 CY TOTAL WASTE
									78		78		SY	SHEET MEMBRANE WATERPROOFING, TORCH APPLIED	519.20				N.A.B.I. = NOT A BID ITEM
							56				56		LF	JOINT SEALER, HOT POURED	524.11				
									56		56		LF	BRIDGE RAILING, GALVANIZED 2 RAIL BOX BEAM	525.33				
									1		1		EACH	REMOVAL OF STRUCTURE (600 SF - EST.)	529.15				
									1		1		LS	PRECAST CONCRETE STRUCTURE (28' X 6' X 29' FRAME OR ARCH TYPE)	540.10				
									1		1		LS	PRECAST CONCRETE STRUCTURE (PEDESTAL WALL ABUTMENT #1)	540.10				
									1		1		LS	PRECAST CONCRETE STRUCTURE (PEDESTAL WALL ABUTMENT #2)	540.10				
									1		1		LS	PRECAST CONCRETE STRUCTURE (WINGWALL #1)	540.10				
									1		1		LS	PRECAST CONCRETE STRUCTURE (WINGWALL #2)	540.10				
									1		1		LS	PRECAST CONCRETE STRUCTURE (WINGWALL #3)	540.10				
									1		1		LS	PRECAST CONCRETE STRUCTURE (WINGWALL #4)	540.10				
									90		90		CY	STONE FILL, TYPE II	613.11				
							160				160		LF	CAST-IN-PLACE CONCRETE CURB, TYPE B	616.28				
							555				555		LF	REMOVING AND RESETTING FENCE	620.50				
							208				208		LF	HD STEEL BEAM GUARDRAIL, GALVANIZED	621.21				
							4				4		EACH	ANCHOR FOR STEEL BEAM RAIL	621.60				
							4				4		EACH	GUARDRAIL APPROACH SECTION, GALVANIZED 2 RAIL BOX BEAM	621.72				
							109				109		LF	REMOVAL AND DISPOSAL OF GUARDRAIL	621.80				
							25				25		HR	UNIFORMED TRAFFIC OFFICERS	630.10				
							400				400		HR	FLAGGERS	630.15				
										1	1		LS	FIELD OFFICE, ENGINEERS	631.10				
										1	1		LS	TESTING EQUIPMENT, CONCRETE	631.16				
										1	1		LS	TESTING EQUIPMENT, BITUMINOUS	631.17				
										3000	3000		DL	FIELD OFFICE TELEPHONE (N.A.B.I.)	631.26				
							1				1		LS	MOBILIZATION/DEMOBILIZATION	635.11				
							750				750		LF	4 INCH YELLOW LINE	646.21				
									170		170		SY	GEOTEXTILE UNDER STONE FILL	649.31				
								55			55		SY	GEOTEXTILE FOR SILT FENCE, WOVEN WIRE REINFORCED	649.515				

PROJECT NAME: RICHFORD
PROJECT NUMBER: BRF 0302(29)
FILE NAME: st2j158qs.dgn PLOT DATE: 06-JAN-2015
PROJECT LEADER: C. CARLSON DRAWN BY: R. PELLETT
DESIGNED BY: H. SALLS CHECKED BY: H. SALLS
QUANTITY 1 SHEET 5 OF 36

QUANTITY SHEET 2

SUMMARY OF ESTIMATED QUANTITIES										TOTALS		DESCRIPTIONS				DETAILED SUMMARY OF QUANTITIES			
							ROADWAY	EROSION CONTROL	BRIDGE	FULL C.E. ITEMS	GRAND TOTAL	FINAL	UNIT	ITEMS	ITEM NUMBER	ROUND	QUANTITIES	UNIT	ITEMS
								55			55		SY	GEOTEXTILE FOR FILTER CURTAIN	649.61				N.A.B.I. = NOT A BID ITEM
								10			10		LB	SEED	651.15				
								10			10		LB	SEED, WINTER RYE	651.17				
								100			100		LB	FERTILIZER	651.18				
								0.25			0.25		TON	AGRICULTURAL LIMESTONE	651.20				
								0.25			0.25		TON	HAY MULCH	651.25				
							30				30		CY	TOPSOIL	651.35				
							240		640		880		SY	GRUBBING MATERIAL	651.40				
								1			1		LS	EPSC PLAN	652.10				
								10			10		HR	MONITORING EPSC PLAN	652.20				
								1			1		LU	MAINTENANCE OF EPSC PLAN (N.A.B.I.)	652.30				
								470			470		SY	TEMPORARY EROSION MATTING	653.20				
								30			30		CY	VEHICLE TRACKING PAD	653.35				
								200			200		LF	BARRIER FENCE	653.50				
								160			160		LF	PROJECT DEMARCATION FENCE	653.55				
							6				6		EACH	REMOVING SIGNS	675.50				
							1				1		LS	SPECIAL PROVISION (CPM SCHEDULE)	900.645				
							1				1		LS	SPECIAL PROVISION (TEMPORARY RELOCATION OF STREAM)	900.645				
							1				1		LS	SPECIAL PROVISION (TRAFFIC CONTROL, ALL-INCLUSIVE)	900.645				
							1				1		LU	SPECIAL PROVISION (INCENTIVE/DISINCENTIVE)(N.A.B.I.)	900.650				
							1				1		LU	SPECIAL PROVISION (MAT DENSITY PAY ADJUSTMENT, SMALL QUANTITY)(N.A.B.I.)	900.650				
							1				1		LU	SPECIAL PROVISION (MIXTURE PAY ADJUSTMENT)(N.A.B.I.)	900.650				
							270				270		TON	SPECIAL PROVISION (BITUMINOUS CONCRETE PAVEMENT, SMALL QUANTITY)	900.680				

PROJECT NAME: RICHFORD
 PROJECT NUMBER: BRF 0302(29)
 FILE NAME: s12j158qs.dgn PLOT DATE: 06-JAN-2015
 PROJECT LEADER: C. CARLSON DRAWN BY: R. PELLETT
 DESIGNED BY: H. SALLS CHECKED BY: H. SALLS
 QUANTITY 2 SHEET 6 OF 36

BRIDGE QUANTITY SHEET 1

SUMMARY OF BRIDGE QUANTITIES										TOTALS		DESCRIPTIONS			DETAILED SUMMARY OF QUANTITIES				
					DECK	APPROACH SLAB 1	APPROACH SLAB 2	ABUTMENT 1	ABUTMENT 2	CHANNEL	BRIDGE TOTAL		UNIT	ITEMS	ITEM NUMBER		QUANTITIES	UNIT	ITEMS
								15	35		50		CY	UNCLASSIFIED CHANNEL EXCAVATION	203.27				
								373	387		760		CY	STRUCTURE EXCAVATION	204.25				
								141	139		280		CY	GRANULAR BACKFILL FOR STRUCTURES	204.30				
					78						78		SY	SHEET MEMBRANE WATERPROOFING, TORCH APPLIED	519.20				
					56						56		LF	BRIDGE RAILING, GALVANIZED 2 RAIL BOX BEAM	525.33				
					1						1		EACH	REMOVAL OF STRUCTURE (600 SF - EST.)	529.15				
					1						1		LS	PRECAST CONCRETE STRUCTURE (28' X 6' X 29' FRAME OR ARCH TYPE)	540.10				
								1			1		LS	PRECAST CONCRETE STRUCTURE (PEDESTAL WALL ABUTMENT #1)	540.10				
									1		1		LS	PRECAST CONCRETE STRUCTURE (PEDESTAL WALL ABUTMENT #2)	540.10				
								1			1		LS	PRECAST CONCRETE STRUCTURE (WINGWALL #1)	540.10				
								1			1		LS	PRECAST CONCRETE STRUCTURE (WINGWALL #2)	540.10				
									1		1		LS	PRECAST CONCRETE STRUCTURE (WINGWALL #3)	540.10				
									1		1		LS	PRECAST CONCRETE STRUCTURE (WINGWALL #4)	540.10				
								62	28		90		CY	STONE FILL, TYPE II	613.11				
								72	98		170		SY	GEOTEXTILE UNDER STONE FILL	649.31				
								320	320		640		SY	GRUBBING MATERIAL	651.40				

PROJECT NAME:	RICHFORD	PLOT DATE:	06-JAN-2015
PROJECT NUMBER:	BRF 0302(29)	DRAWN BY:	R. PELLETT
FILE NAME:	st2j158qs.dgn	CHECKED BY:	H. SALLS
PROJECT LEADER:	C. CARLSON	DESIGNED BY:	H. SALLS
BRIDGE QUANTITY		SHEET	7 OF 36

GENERAL INFORMATION

SYMBOLGY LEGEND NOTE

THE SYMBOLGY ON THIS SHEET IS INTENDED TO COVER STANDARD CONVENTIONAL SYMBOLGY. THE SYMBOLGY IS USED FOR EXISTING & PROPOSED FEATURES WITH HEAVIER LINEWEIGHT, IN COMBINATION WITH PROJECT ANNOTATION, AS NOTED ON PROJECT PLAN SHEETS. THIS LEGEND SHEET COVERS THE BASICS. SYMBOLGY ON PLANS MAY VARY, PLAN ANNOTATIONS AND NOTES SHOULD BE USED TO CLARIFY AS NEEDED.

R.O.W. ABBREVIATIONS (CODES) & SYMBOLS

POINT CODE	DESCRIPTION
CH	CHANNEL EASEMENT
CONST	CONSTRUCTION EASEMENT
CUL	CULVERT EASEMENT
D&C	DISCONNECT & CONNECT
DIT	DITCH EASEMENT
DR	DRAINAGE EASEMENT
DRIVE	DRIVEWAY EASEMENT
EC	EROSION CONTROL
HWY	HIGHWAY EASEMENT
I&M	INSTALL & MAINTAIN EASEMENT
LAND	LANDSCAPE EASEMENT
R&RES	REMOVE & RESET
R&REP	REMOVE & REPLACE
SR	SLOPE RIGHT
UE	UTILITY EASEMENT
(P)	PERMANENT EASEMENT
(T)	TEMPORARY EASEMENT
■	BNDNS BOUND SET
▣	BNDNS BOUND TO BE SET
●	IPNS IRON PIN SET
◎	IPNS IRON PIN TO BE SET
⊠	CALC EXISTING ROW POINT
○	PROW PROPOSED ROW POINT
[LENGTH]	LENGTH CARRIED ON NEXT SHEET

COMMON TOPOGRAPHIC POINT SYMBOLS

POINT CODE	DESCRIPTION
⊕	APL BOUND APPARENT LOCATION
◦	BM BENCHMARK
▣	BND BOUND
▣	CB CATCH BASIN
⊕	COMB COMBINATION POLE
▣	DITHR DROP INLET THROATED DNC
⊕	EL ELECTRIC POWER POLE
◦	FPOLE FLAGPOLE
○	GASFIL GAS FILLER
○	GP GUIDE POST
×	GSO GAS SHUT OFF
◦	GUY GUY POLE
◦	GUYW GUY WIRE
×	GV GATE VALUE
⊕	H TREE HARDWOOD
△	HCTRL CONTROL HORIZONTAL
△	HVCTRL CONTROL HORIZ. & VERTICAL
◇	HYD HYDRANT
◦	IP IRON PIN
◦	IPIPE IRON PIPE
⊕	LI LIGHT - STREET OR YARD
⊕	MB MAILBOX
○	MH MANHOLE (MH)
▣	MM MILE MARKER
◦	PM PARKING METER
▣	PMK PROJECT MARKER
◦	POST POST STONE/WOOD
⊕	RRSIG RAILROAD SIGNAL
⊕	RRSL RAILROAD SWITCH LEVER
⊕	S TREE SOFTWOOD
⊕	SAT SATELLITE DISH
⊕	SHRUB SHRUB
⊕	SIGN SIGN
⊕	STUMP STUMP
⊕	TEL TELEPHONE POLE
◦	TIE TIE
⊕	TSIGN SIGN W/DOUBLE POST
⊕	VCTRL CONTROL VERTICAL
◦	WELL WELL
×	WSO WATER SHUT OFF

THESE ARE COMMON VAOT SURVEY POINT SYMBOLS FOR EXISTING FEATURES, ALSO USED FOR PROPOSED FEATURES WITH HEAVIER LINEWEIGHT, IN COMBINATION WITH PROPOSED ANNOTATION.

PROPOSED GEOMETRY CODES

CODE	DESCRIPTION
PC	POINT OF CURVATURE
PI	POINT OF INTERSECTION
CC	CENTER OF CURVE
PT	POINT OF TANGENCY
PCC	POINT OF COMPOUND CURVE
PRC	POINT OF REVERSE CURVE
POB	POINT OF BEGINNING
POE	POINT OF ENDING
STA	STATION PREFIX
AH	AHEAD STATION SUFFIX
BK	BACK STATION SUFFIX
D	CURVE DEGREE OF (100FT)
R	CURVE RADUIS OF
T	CURVE TANGENT LENGTH
L	CURVE LENGTH OF
E	CURVE EXTERNAL DISTANCE

UTILITY SYMBOLGY

UNDERGROUND UTILITIES	
— UGU —	UTILITY (GENERIC-UNKNOWN)
— UT —	TELEPHONE
— UE —	ELECTRIC
— UC —	CABLE (TV)
— UEC —	ELECTRIC+CABLE
— UET —	ELECTRIC+TELEPHONE
— UCT —	CABLE+TELEPHONE
— UECT —	ELECTRIC+CABLE+TELEP.
— G —	GAS LINE
— W —	WATER LINE
— S —	SANITARY SEWER (SEPTIC)

ABOVE GROUND UTILITIES (AERIAL)	
— AGU —	UTILITY (GENERIC-UNKNOWN)
— T —	TELEPHONE
— E —	ELECTRIC
— C —	CABLE (TV)
— EC —	ELECTRIC+CABLE
— ET —	ELECTRIC+TELEPHONE
— AER E&T —	ELECTRIC+TELEPHONE
— CT —	CABLE+TELEPHONE
— ECT —	ELECTRIC+CABLE+TELEP.
—	UTILITY POLE GUY WIRE

PROJECT CONSTRUCTION SYMBOLGY	
— — — — — CZ — — — — —	CLEAR ZONE
— — — — —	PLAN LAYOUT MATCHLINE

PROJECT CONSTRUCTION FEATURES	
▲ — — — — — ▲	TOP OF CUT SLOPE
● — — — — — ●	TOE OF FILL SLOPE
⊕ ⊕ ⊕ ⊕ ⊕ ⊕	STONE FILL
— — — — —	BOTTOM OF DITCH
— — — — —	CULVERT PROPOSED
— — — — —	STRUCTURE SUBSURFACE
PDF — — — — — PDF	PROJECT DEMARCATION FENCE
BF — — — — — BF	BARRIER FENCE
XXXXXXXXXXXXXXXXXXXX	TREE PROTECTION ZONE (TPZ)
//// //// //// ////	STRIPING LINE REMOVAL
~~~~ ~~~~ ~~~~ ~~~~	SHEET PILES

CONVENTIONAL BOUNDARY SYMBOLGY	
— — — — —	TOWN BOUNDARY LINE
— — — — —	COUNTY BOUNDARY LINE
— — — — —	STATE BOUNDARY LINE
— — — — —	PROPOSED STATE R.O.W. (LIMITED ACCESS)
— — — — —	PROPOSED STATE R.O.W.
— — — — —	STATE ROW (LIMITED ACCESS)
— — — — —	STATE ROW
— — — — —	TOWN ROW
— — — — —	PERMANENT EASEMENT LINE (P)
— — — — —	TEMPORARY EASEMENT LINE (T)
— — — — —	SURVEY LINE
P — — — — — P	PROPERTY LINE (P/L)
SR — — — — — SR	SLOPE RIGHTS
6f — — — — — 6f	6F PROPERTY BOUNDARY
4f — — — — — 4f	4F PROPERTY BOUNDARY
HAZ — — — — — HAZ	HAZARDOUS WASTE

**EPSC LAYOUT PLAN SYMBOLGY**

EPSC MEASURES	
ONNOONNOONNO	FILTER CURTAIN
— — — — —	SILT FENCE
— — — — —	SILT FENCE WOVEN WIRE
— — — — —	CHECK DAM
— — — — —	DISTURBED AREAS REQUIRING RE-VEGETATION
— — — — —	EROSION MATTING

ENVIRONMENTAL RESOURCES	
— — — — —	WETLAND BOUNDARY
— — — — —	RIPARIAN BUFFER ZONE
— — — — —	WETLAND BUFFER ZONE
— — — — —	SOIL TYPE BOUNDARY
— — — — —	THREATENED & ENDANGERED SPECIES
HAZ — — — — — HAZ	HAZARDOUS WASTE AREA
AG — — — — —	AGRICULTURAL LAND
HABITAT — — — — —	FISH & WILDLIFE HABITAT
FLOOD PLAIN — — — — —	FLOOD PLAIN
OHW — — — — —	ORDINARY HIGH WATER (OHW)
— — — — —	STORM WATER
— — — — —	USDA FOREST SERVICE LANDS
— — — — —	WILDLIFE HABITAT SUIT/CONN

ARCHEOLOGICAL & HISTORIC	
— — — — —	ARCHEOLOGICAL BOUNDARY
— — — — —	HISTORIC DISTRICT BOUNDARY
— — — — —	HISTORIC AREA
(H)	HISTORIC STRUCTURE

CONVENTIONAL TOPOGRAPHIC SYMBOLGY	
— — — — —	EXISTING FEATURES
— — — — —	ROAD EDGE PAVEMENT
— — — — —	ROAD EDGE GRAVEL
— — — — —	DRIVEWAY EDGE
— — — — —	DITCH
— — — — —	FOUNDATION
x — — — — — x	FENCE (EXISTING)
□ — — — — — □	FENCE WOOD POST
○ — — — — — ○	FENCE STEEL POST
— — — — —	GARDEN
— — — — —	ROAD GUARDRAIL
— — — — —	RAILROAD TRACKS
— — — — —	CULVERT (EXISTING)
— — — — —	STONE WALL
— — — — —	WALL
— — — — —	WOOD LINE
— — — — —	BRUSH LINE
— — — — —	HEDGE
— — — — —	BODY OF WATER EDGE
— — — — —	LEDGE EXPOSED

PROJECT NAME: RICHFORD  
 PROJECT NUMBER: BRF 0302(29)  
 FILE NAME: s12j158legend.dgn PLOT DATE: 11-DEC-2014  
 PROJECT LEADER: C. CARLSON DRAWN BY: M.LONGSTREET  
 DESIGNED BY: AOT CHECKED BY: H. SALLS  
 CONVENTIONAL SYMBOLGY LEGEND SHEET 8 OF 36

GPS CONTROL POINTS






--- HVCTRL #1 ---  
 5600 VOLTS  
 NORTH = 905682.149  
 EAST = 1595379.726  
 ELEV. = 485.449

STATION MARK IS A VERTICAL CONTROL DISK WITH SETTING: STAINLESS STEEL ROD W/O SLEEVE (10 FT.+) DISK FROM: NGS THE MARK IS STAMPED: U 49 1978 SATELLITE; THE SITE IS SUITABLE FOR GPS OBSERVATIONS PGI387' RECOVERED IN GOOD CONDITION, IT IS 0.8 M (2.6 FT) NORTHWEST OF A PGI387' STEEL WITNESS POST.

--- HVCTRL #2 ---  
 U 49  
 NORTH = 906242.748  
 EAST = 1593803.722  
 ELEV. = 446.210

GENERAL LOCATION, RICHFORD, VT. TO REACH FROM THE INTERSECTION OF VT ROUTE 105 AND VT ROUTE 139 IN RICHFORD VILLAGE GO SOUTHEAST ALONG VT ROUTE 105 FOR 0.2 MI (0.3 KM) TO THE INTERSECTION OF NOYES STREET LEFT, TURN LEFT AND GO SOUTH ALONG NOYES STREET FOR 0.4 MI (0.6 KM) TO THE INTERSECTION OF A PAVED DRIVE LEADING TO STAIRS UNLIMITED INC. CONTINUE STRAIGHT AHEAD AND GO SOUTHWEST ALONG NOYES STREET FOR ABOUT 20 M (65.6 FT) TO THE SITE OF THE MARK ON THE RIGHT. THE MARK IS SET FLUSH WITH GROUND SURFACE IN THE TOP OF A 30 CM DIAMETER CONCRETE MONUMENT POURED 1.3 M (4.3 FT) DEEP. THE MARK IS 6.9 M (22.6 FT) NORTHWEST OF AND ABOUT 1.0 M (3.3 FT) LOWER THAN THE CENTERLINE OF NOYES STREET, 15.2 M (49.9 FT) WEST NORTHWEST OF AN UNNUMBERED POLE, 18.1 M (59.4 FT) WEST OF A CAST IRON GATE POST WITH AN ATTACHED MAILBOX, 46.3 M (151.9 FT) WEST SOUTHWEST OF THE WEST CORNER OF AN ELL ON THE STAIRS UNLIMITED INC. BUILDING, AND 1.2 M (3.9 FT) SOUTHEAST OF A 5600 VOLT ELECTRIC FENCE AND A FIBERGLASS WITNESS POST.

TRAVERSE TIES

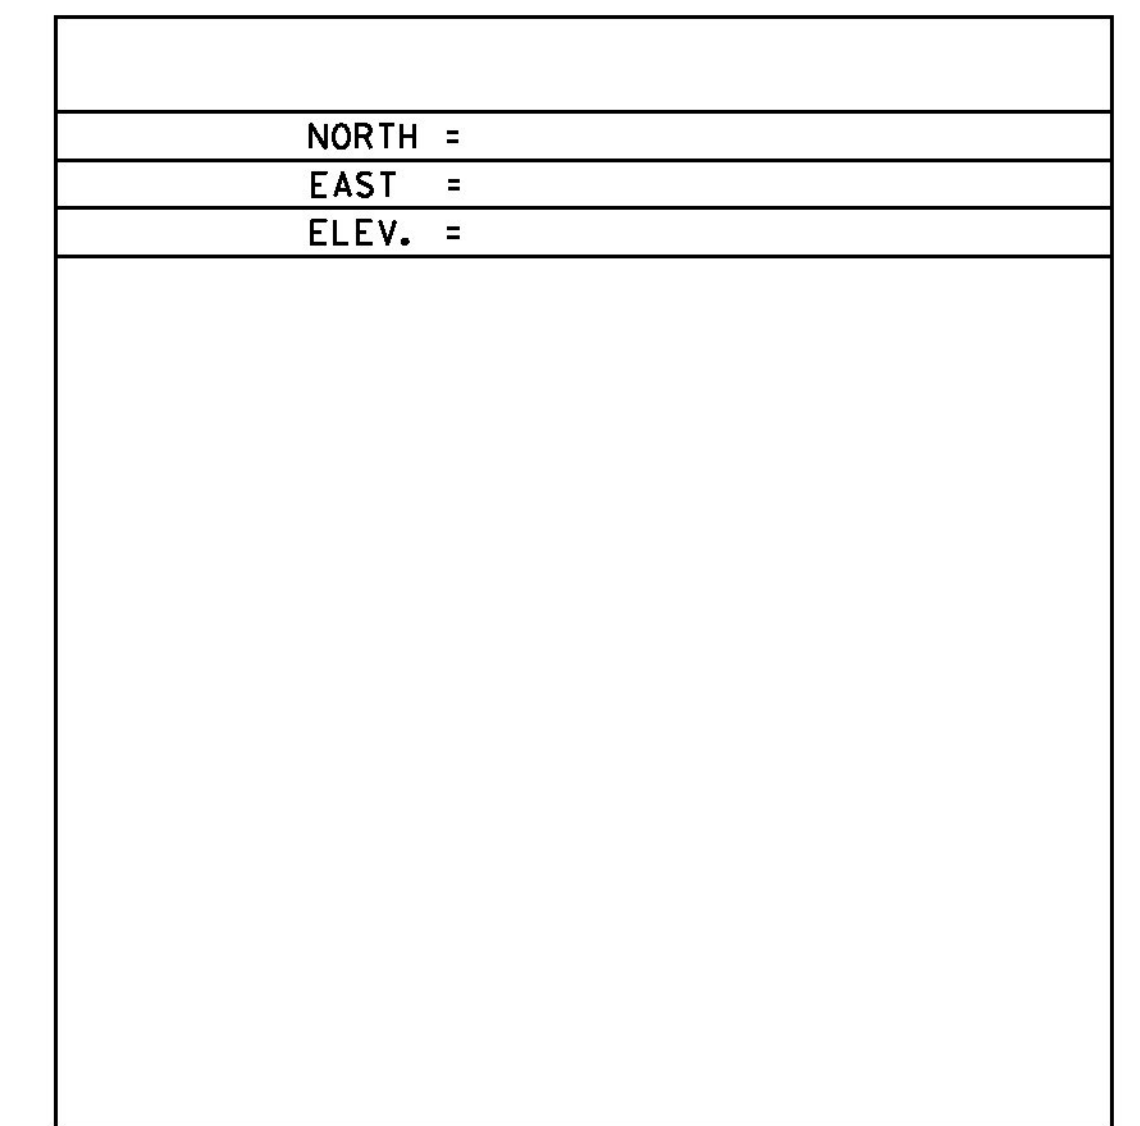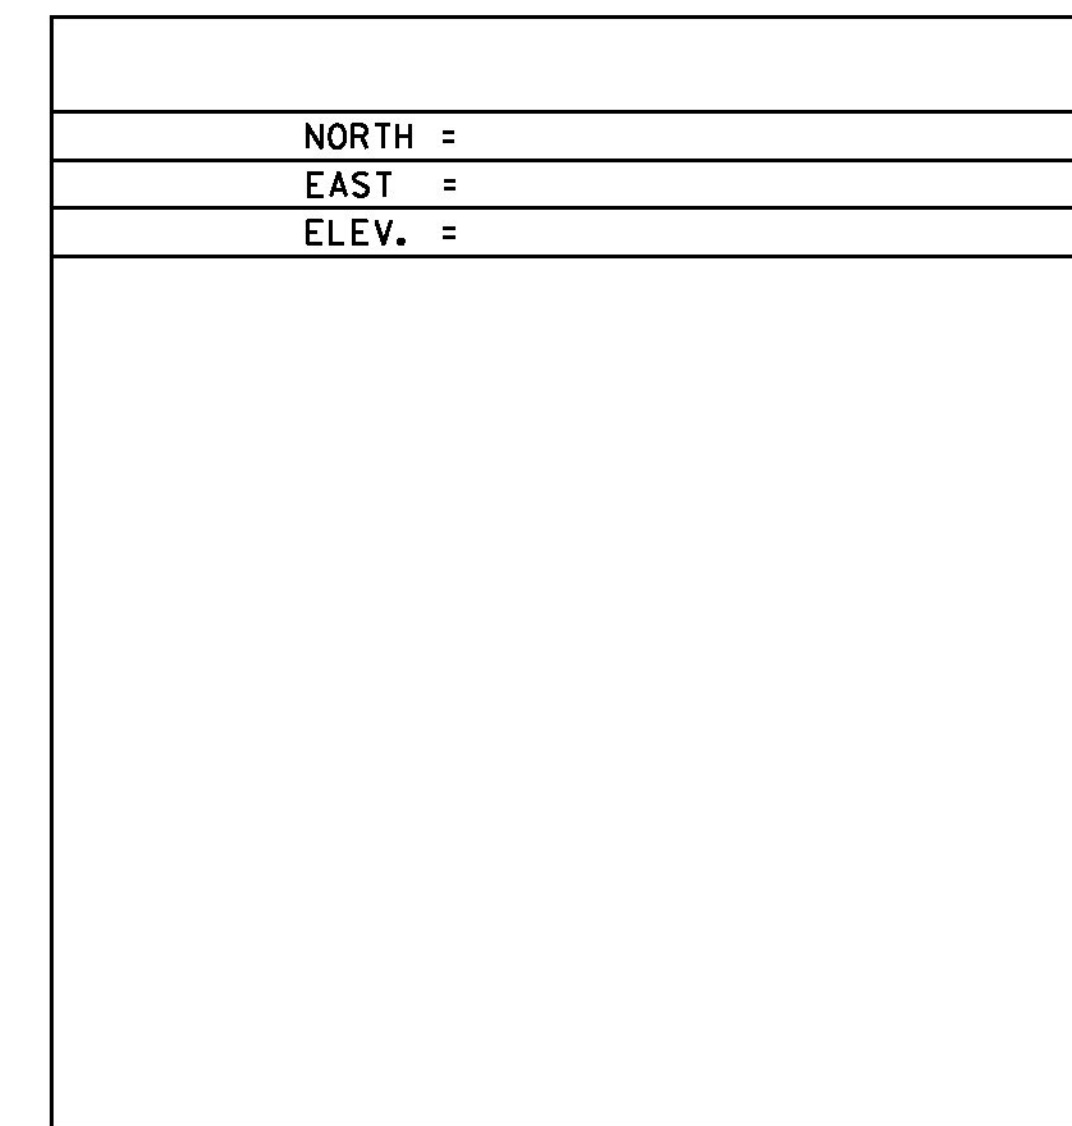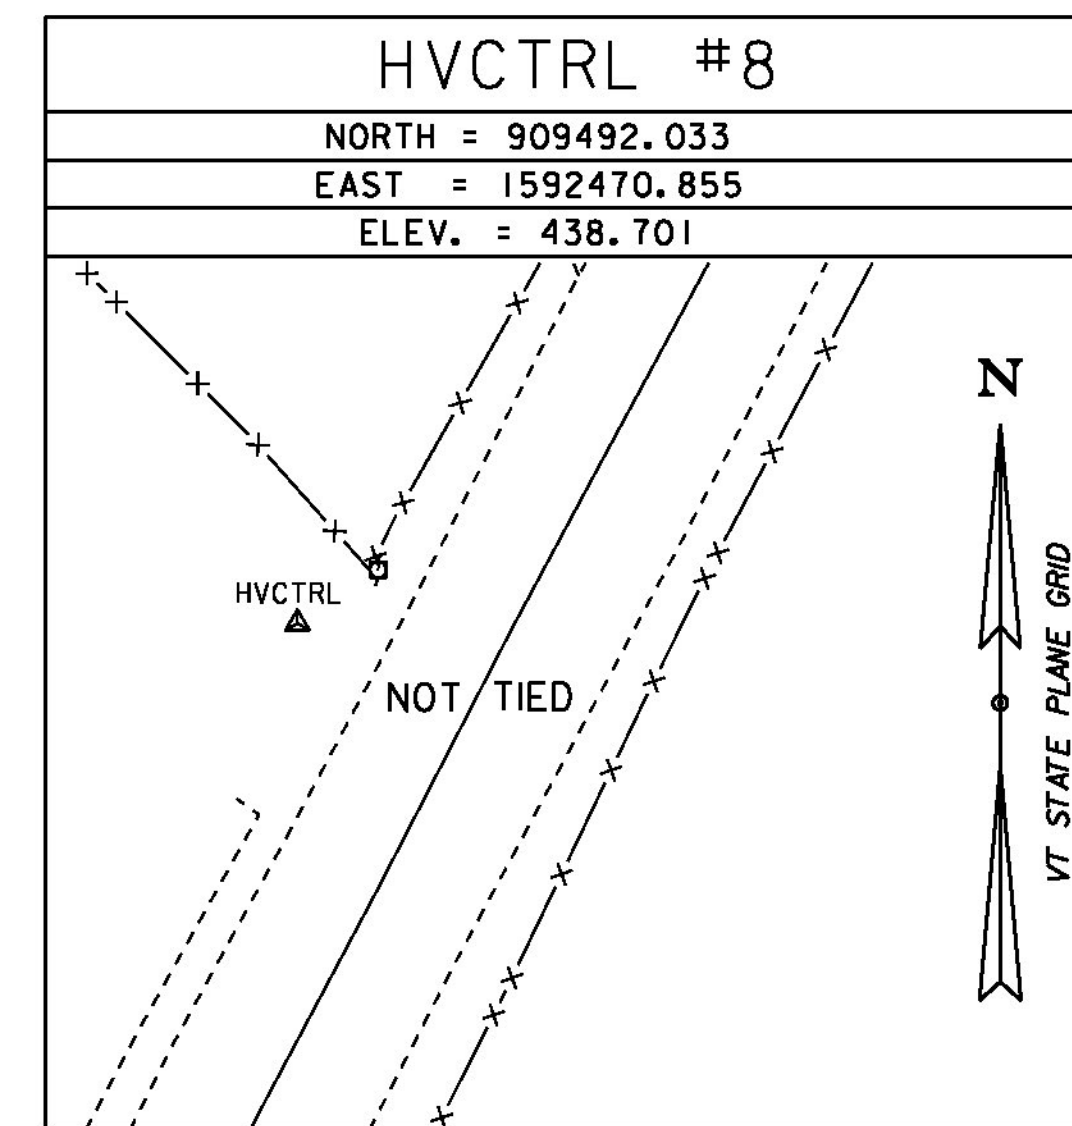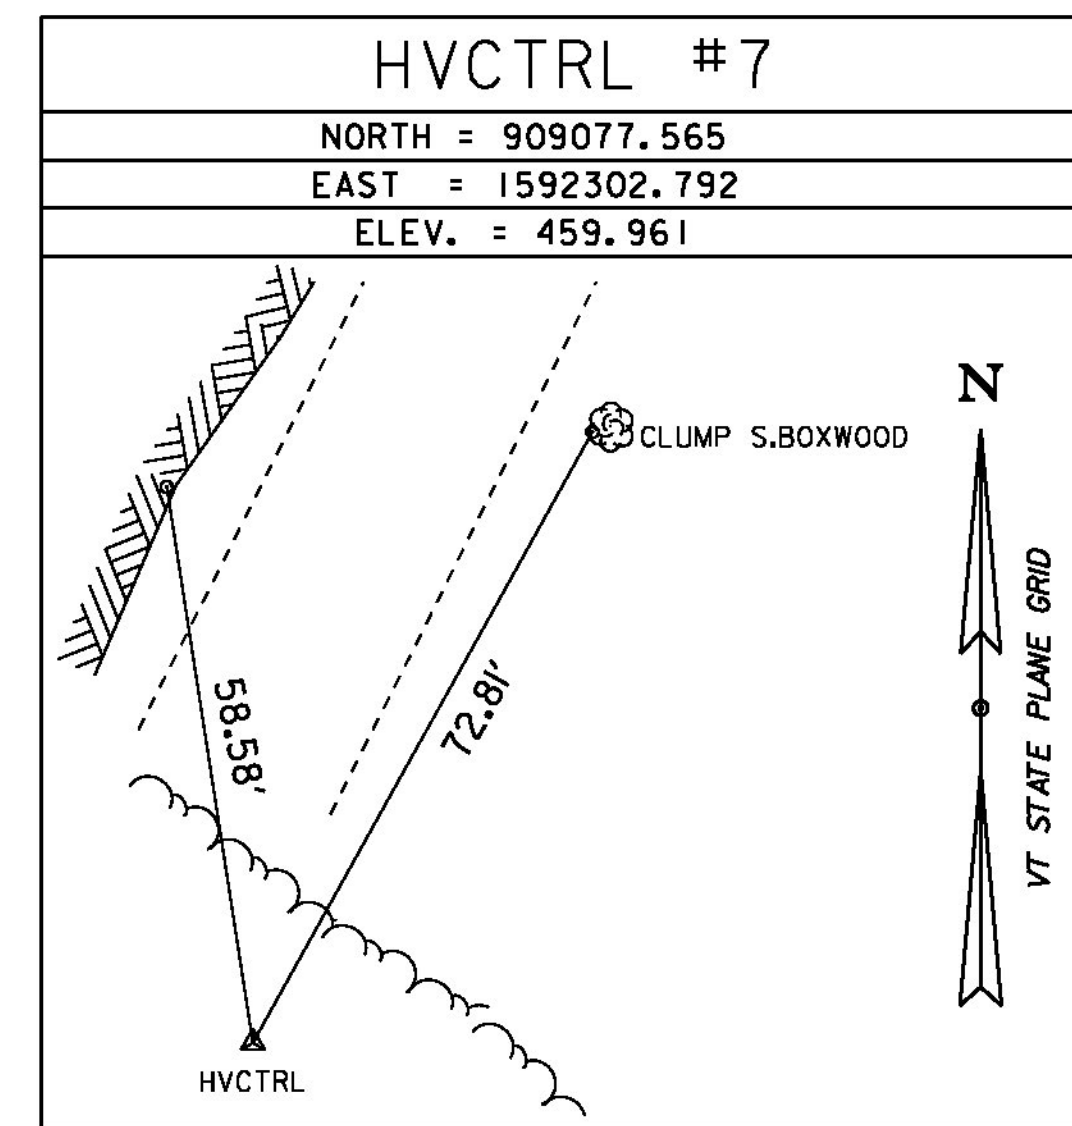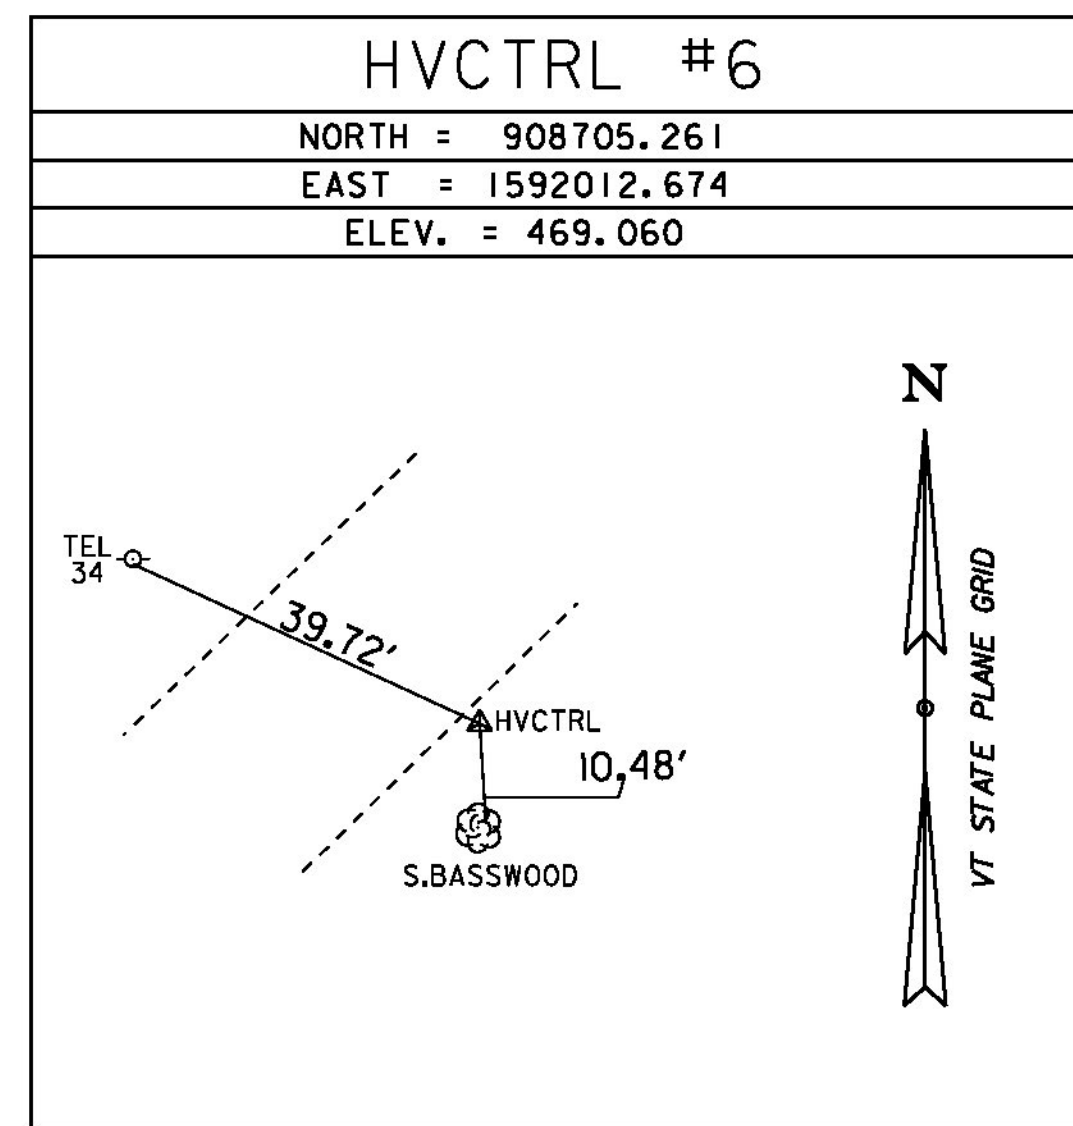

* Main Traverse Completed 4/17/09 by R. Bulllock P.C. & R. Bockus

ALIGNMENT TIES

TOWN HIGHWAY 3			
	STATION	NORTHING	EASTING
	PC 40+00.00	909322.5958	1592404.8065
	PI 41+86.52	909490.0381	1592486.9783
	Radius:	6500.00	
	Delta:	3°17'14.35" Right	
	Degree of Curvature(Arc):	0°52'53.30"	
	Length:	372.93	
	Tangent:	186.52	
	Chord:	372.88	
	Middle Ordinate:	2.67	
	External:	2.68	
	PT 43+72.93		
	PC 45+24.77		
	PI 47+35.93		
	Radius:	2600.00	
	Delta:	9°17'10.58" Right	
	Degree of Curvature(Arc):	2°12'13.26"	
	Length:	421.40	
	Tangent:	211.16	
	Chord:	420.94	
	Middle Ordinate:	8.53	
	External:	8.56	
	PT 49+35.62		
	POE 49+46.16		

DATUM	
VERTICAL	NAVD 88
HORIZONTAL	NAD 83 (1996)
ADJUSTMENT	TRAVERSE

PROJECT NAME:	RICHFORD	PLOT DATE:	11-DEC-2014
PROJECT NUMBER:	BRF 0302(29)	DRAWN BY:	S. DONOVAN
FILE NAME:	s12j158+1e.dgn	CHECKED BY:	H. SALLS
PROJECT LEADER:	C. CARLSON	TIE	SHEET 9 OF 36

**HD STEEL BEAM GUARDRAIL, GALVANIZED**  
 STA 43+44.92 LT - STA 43+88.67 LT  
 STA 43+44.92 RT - STA 43+88.67 RT  
 STA 44+87.33 LT - STA 45+31.08 LT  
 STA 44+87.33 RT - STA 45+31.08 RT

**REMOVING AND RESETTING FENCE ***  
 STA 42+50.00 LT - STA 44+17.00 LT  
 STA 42+50.00 RT - STA 44+23.00 RT  
 STA 44+51.00 RT - STA 44+75.00 RT  
 STA 44+52.00 LT - STA 46+25.00 LT

**REMOVAL AND DISPOSAL OF GUARDRAIL**  
 STA 43+98.79 LT - STA 44+78.62 LT  
 STA 43+98.45 RT - STA 44+77.92 RT

**CAST-IN-PLACE CONCRETE CURB, TYPE B**  
 STA 43+83.58 LT - STA 44+24.00 LT  
 STA 44+52.00 LT - STA 44+92.00 LT  
 STA 43+83.58 RT - STA 44+24.00 RT  
 STA 44+52.00 RT - STA 44+92.00 RT

**GUARDRAIL APPROACH SECTION,  
 GALVANIZED 2 RAIL BOX BEAM**  
 STA 43+88.67 LT - STA 44+24.00 LT  
 STA 43+88.67 RT - STA 44+24.00 RT  
 STA 44+52.00 LT - STA 44+87.33 LT  
 STA 44+52.00 RT - STA 44+87.33 RT

*** FENCING WILL BE RESET AT A LOCATION  
 AGREED UPON W/ THE PROPERTY OWNER  
 AND ENGINEER IN THE FIELD**



**CONSTRUCT 5' PAVED APRON**  
 STA 45+59.00 RT - STA 45+77.00 RT

**ANCHOR FOR STEEL BEAM RAIL**  
 STA 43+50.98 LT & RT  
 STA 45+23.80 LT & RT

**BRIDGE RAILING, GALVANIZED  
 2 RAIL BOX BEAM**  
 STA 44+24.00 LT - STA 44+52.00 LT  
 STA 44+24.00 RT - STA 44+52.00 RT

**CURVE (1)**  
 DELTA = 3° 14' 56"  
 D = 0° 52' 53"  
 R = 6500.00'  
 T = 184.34'  
 L = 368.57'  
 E = 2.61'


**CURVE (2)**  
 DELTA = 9° 03' 14"  
 D = 2° 12' 13"  
 R = 2600.00'  
 T = 205.85'  
 L = 410.85'  
 E = 8.14'

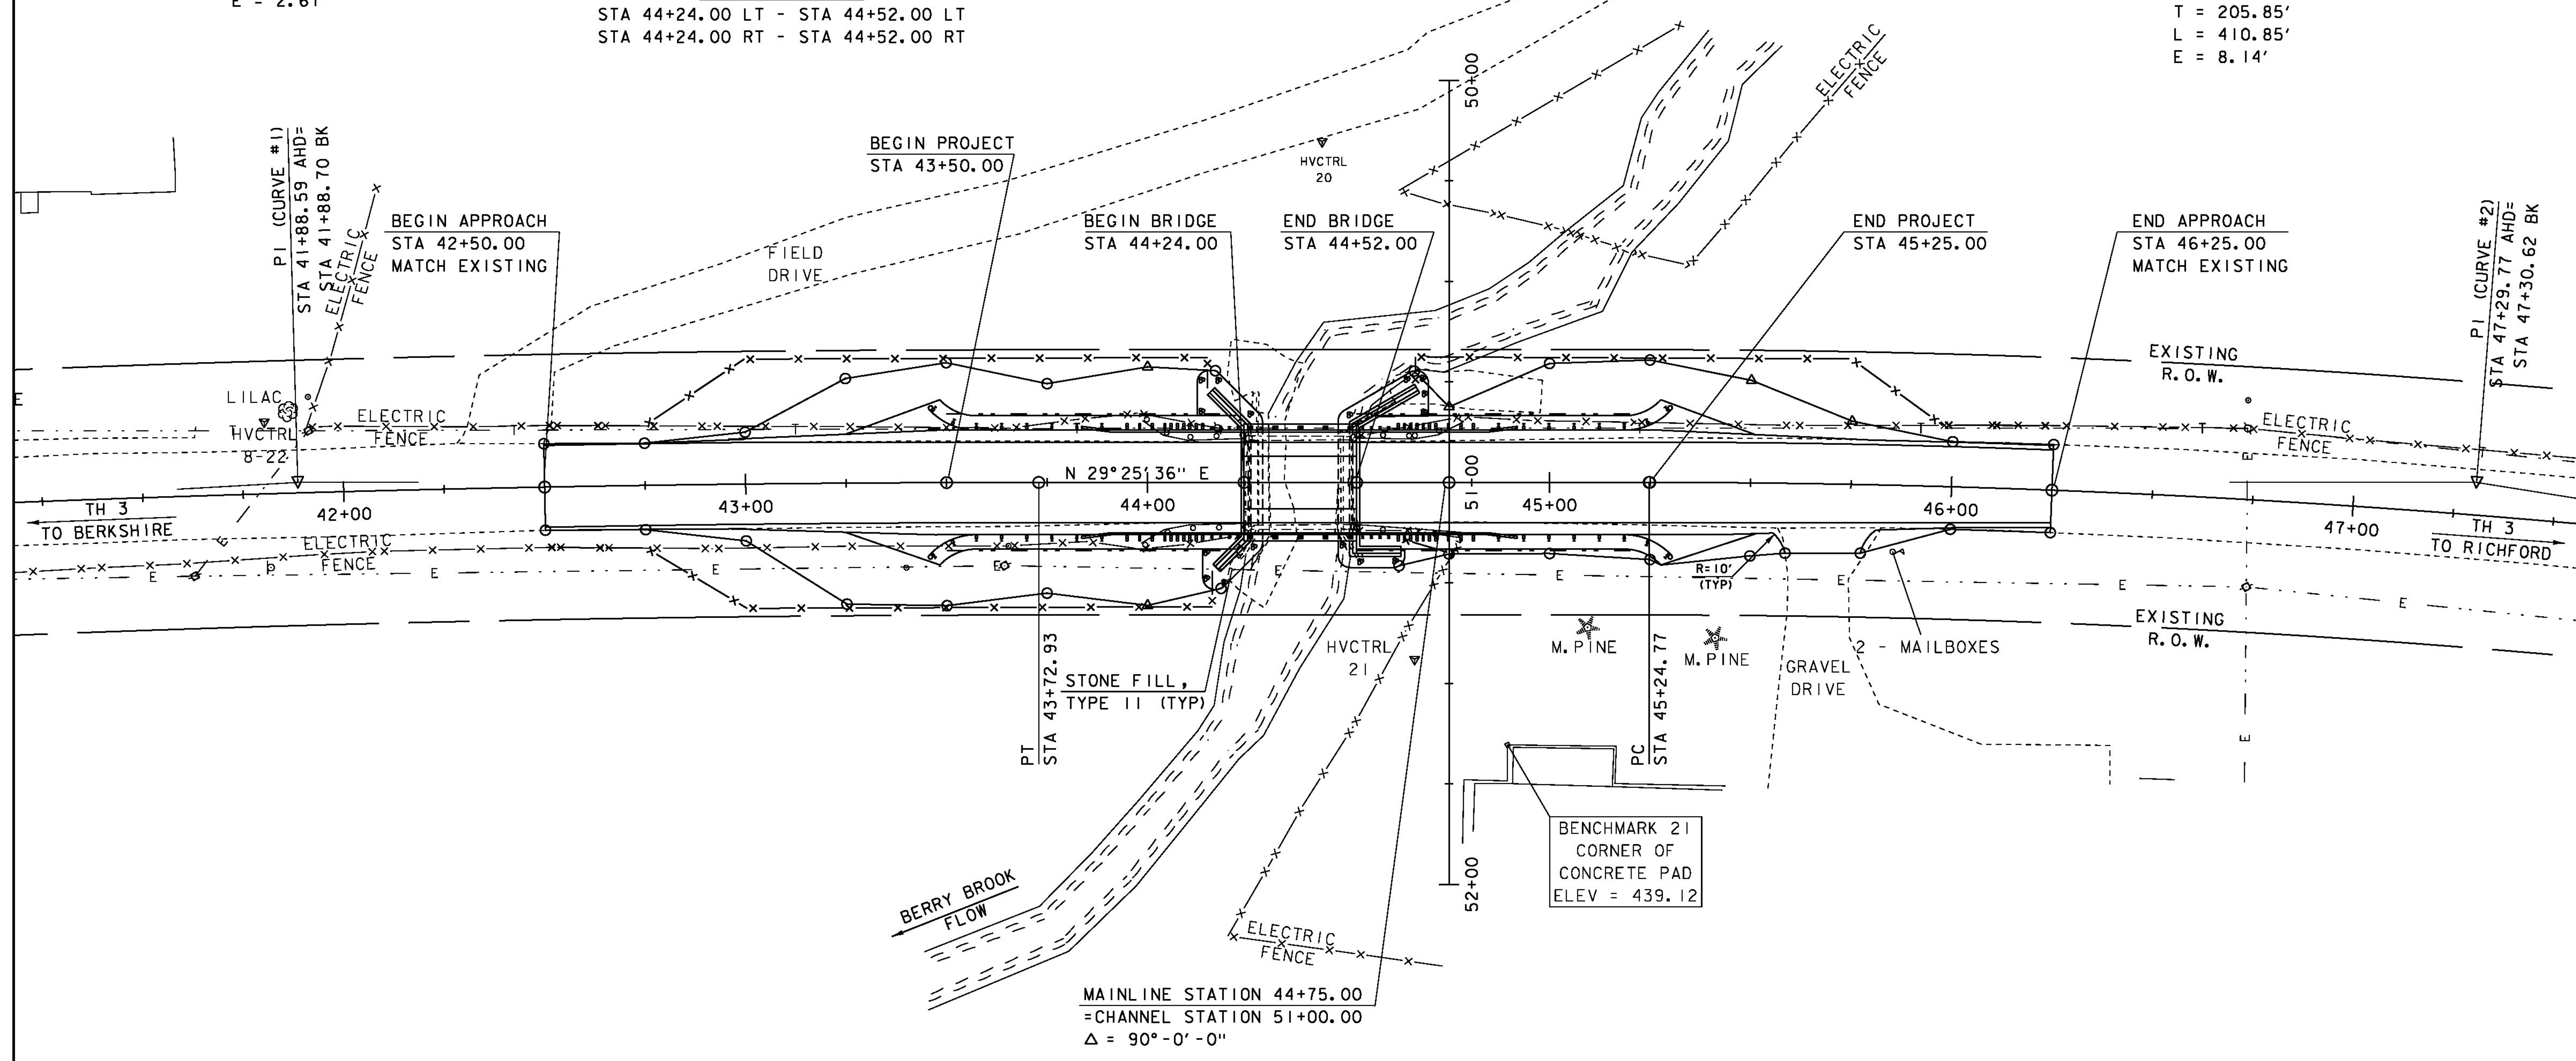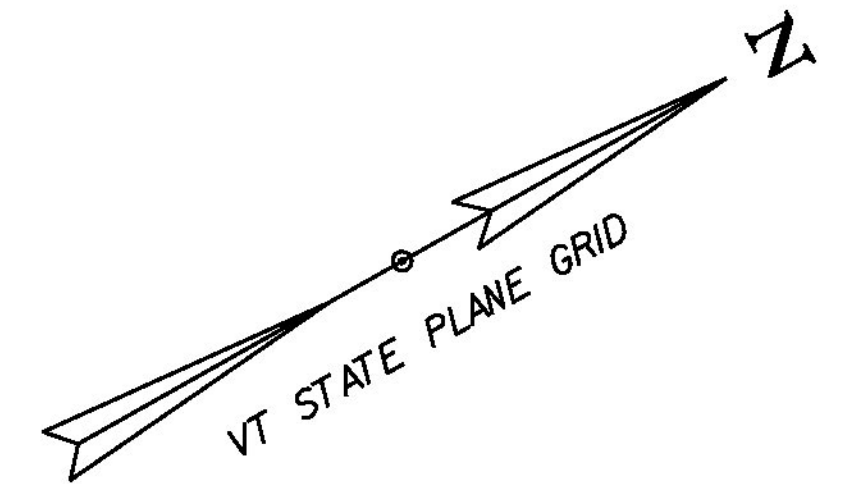

**EXISTING BRIDGE DATA**  
 SINGLE SPAN CONCRETE T-BEAM  
 BRIDGE BUILT IN 1900  
 BRIDGE LENGTH = 24 FT.  
 WATERWAY AREA = 125 SF

SCALE 1" = 20' - 0"  
 20 0 20


PROJECT NAME: RICHFORD	PLOT DATE: 11-DEC-2014
PROJECT NUMBER: BRF 0302(29)	DRAWN BY: R. PELLETT
FILE NAME: st2j158bdr.dgn	CHECKED BY: H. SALLS
PROJECT LEADER: C. CARLSON	SHEET 10 OF 36
DESIGNED BY: H. SALLS	
LAYOUT	

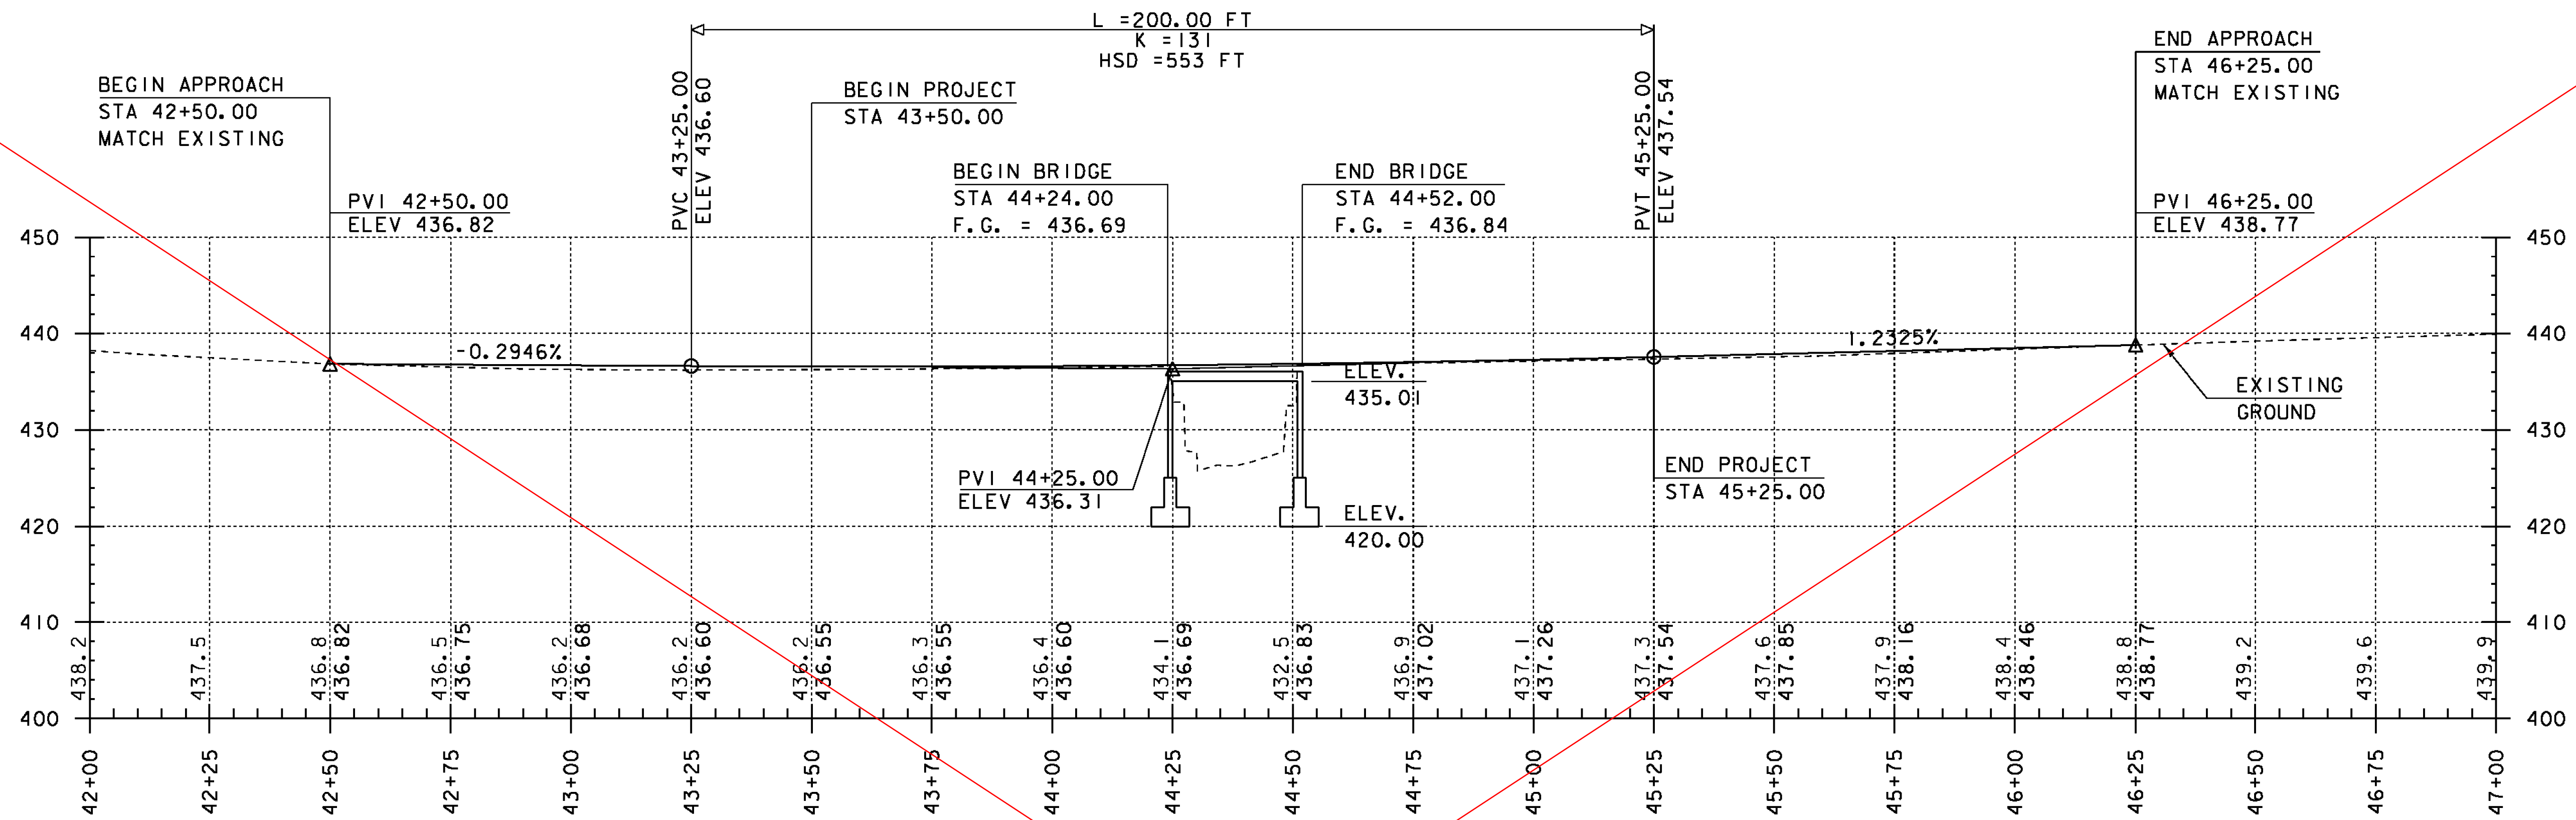

**TH3 PROFILE**

SCALE: HORIZONTAL 1"=20'-0"  
VERTICAL 1"=10'-0"


NOTE:  
GRADES SHOWN TO THE NEAREST TENTH ARE EXISTING GROUND ALONG  $\phi$   
GRADES SHOWN TO THE NEAREST HUNDREDTH ARE FINISH GRADE ALONG  $\phi$

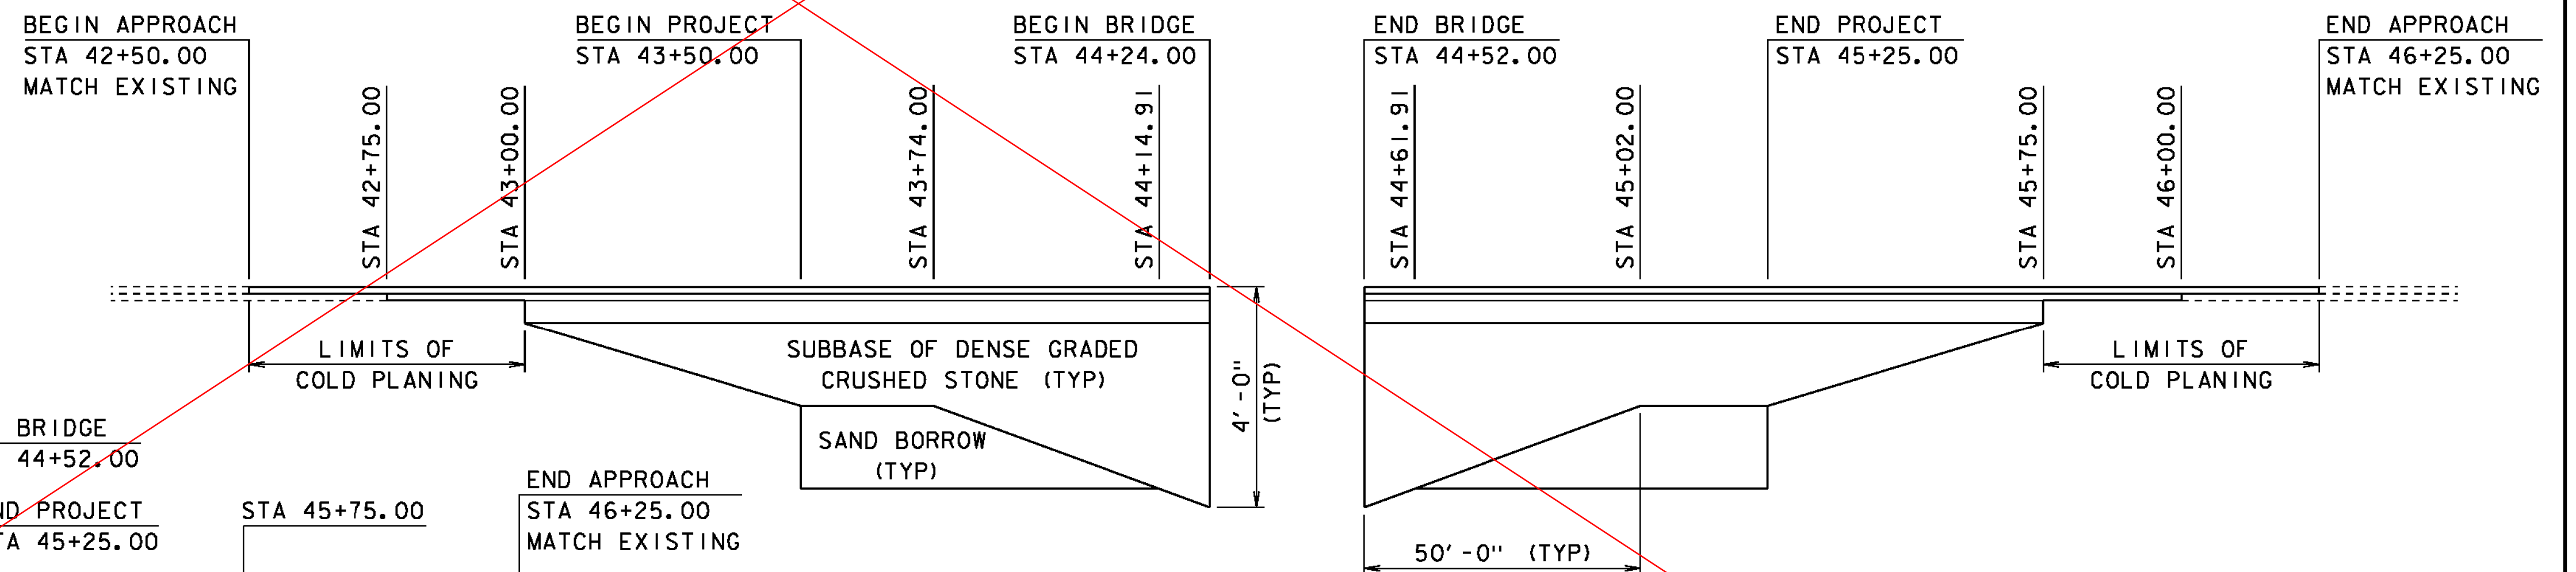

**MATERIAL TRANSITION DIAGRAM**

HOR. SCALE 1" = 20'-0"  
NO VERT. SCALE

NOTE:  
SEE ROADWAY TYPICAL SECTION FOR THICKNESSES OF:  
BITUMINOUS CONCRETE PAVEMENT,  
SUBBASE OF DENSE GRADED CRUSHED STONE  
& SAND BORROW

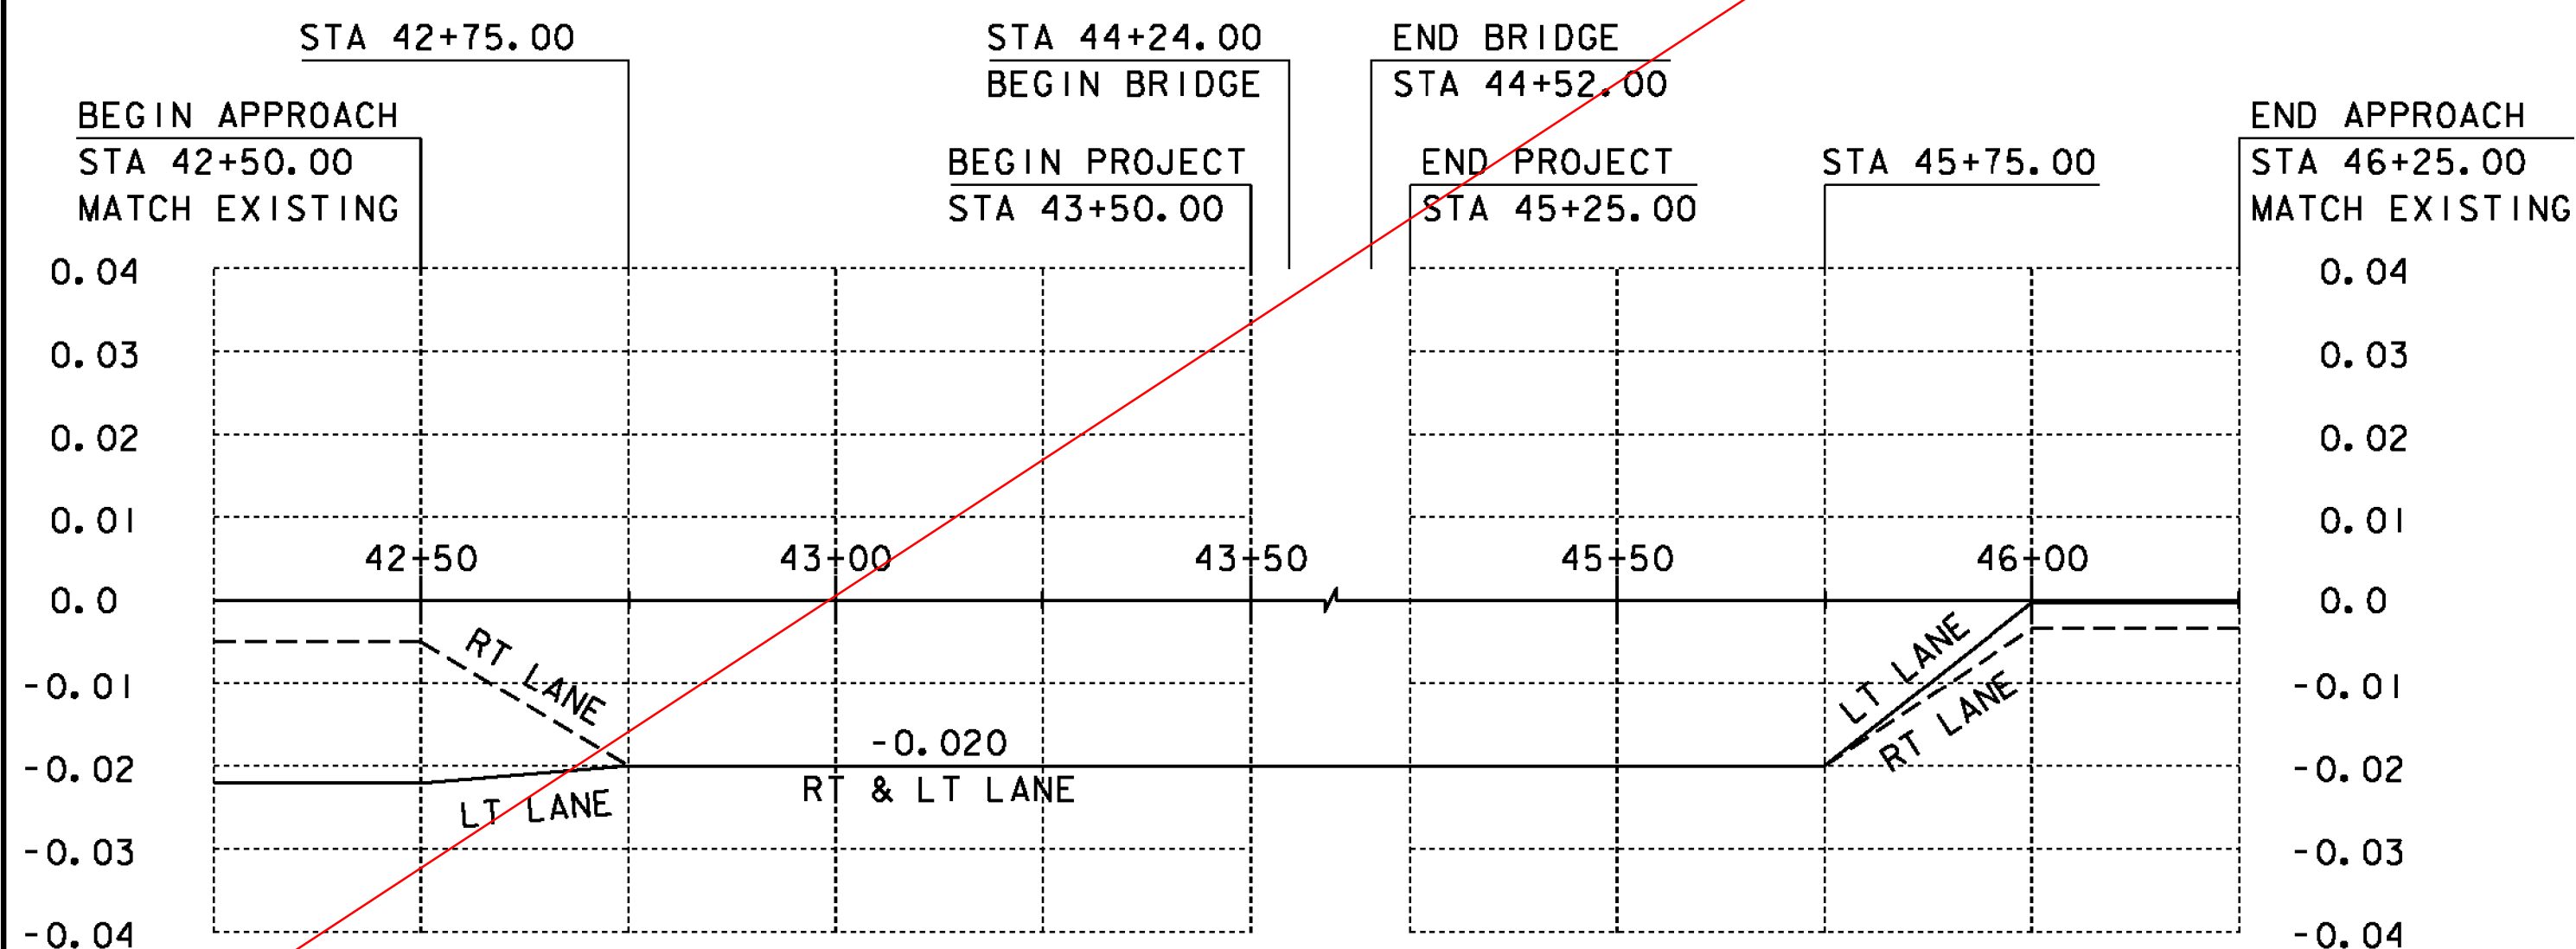

**BANKING DIAGRAM**


HOR. SCALE 1" = 20'-0"  
NO VERT. SCALE

PROJECT NAME: RICHFORD  
PROJECT NUMBER: BRF 0302(29)

FILE NAME: sl2j58pro.dgn  
PROJECT LEADER: C. CARLSON  
DESIGNED BY: H. SALLS  
TH 3 PROFILE AND TRANSITION DIAGRAMS

PLOT DATE: 11-DEC-2014  
DRAWN BY: R. PELLETT  
CHECKED BY: H. SALLS  
SHEET 11 OF 36


SEE PAGE IIR FOR REVISED TH3 PROFILE

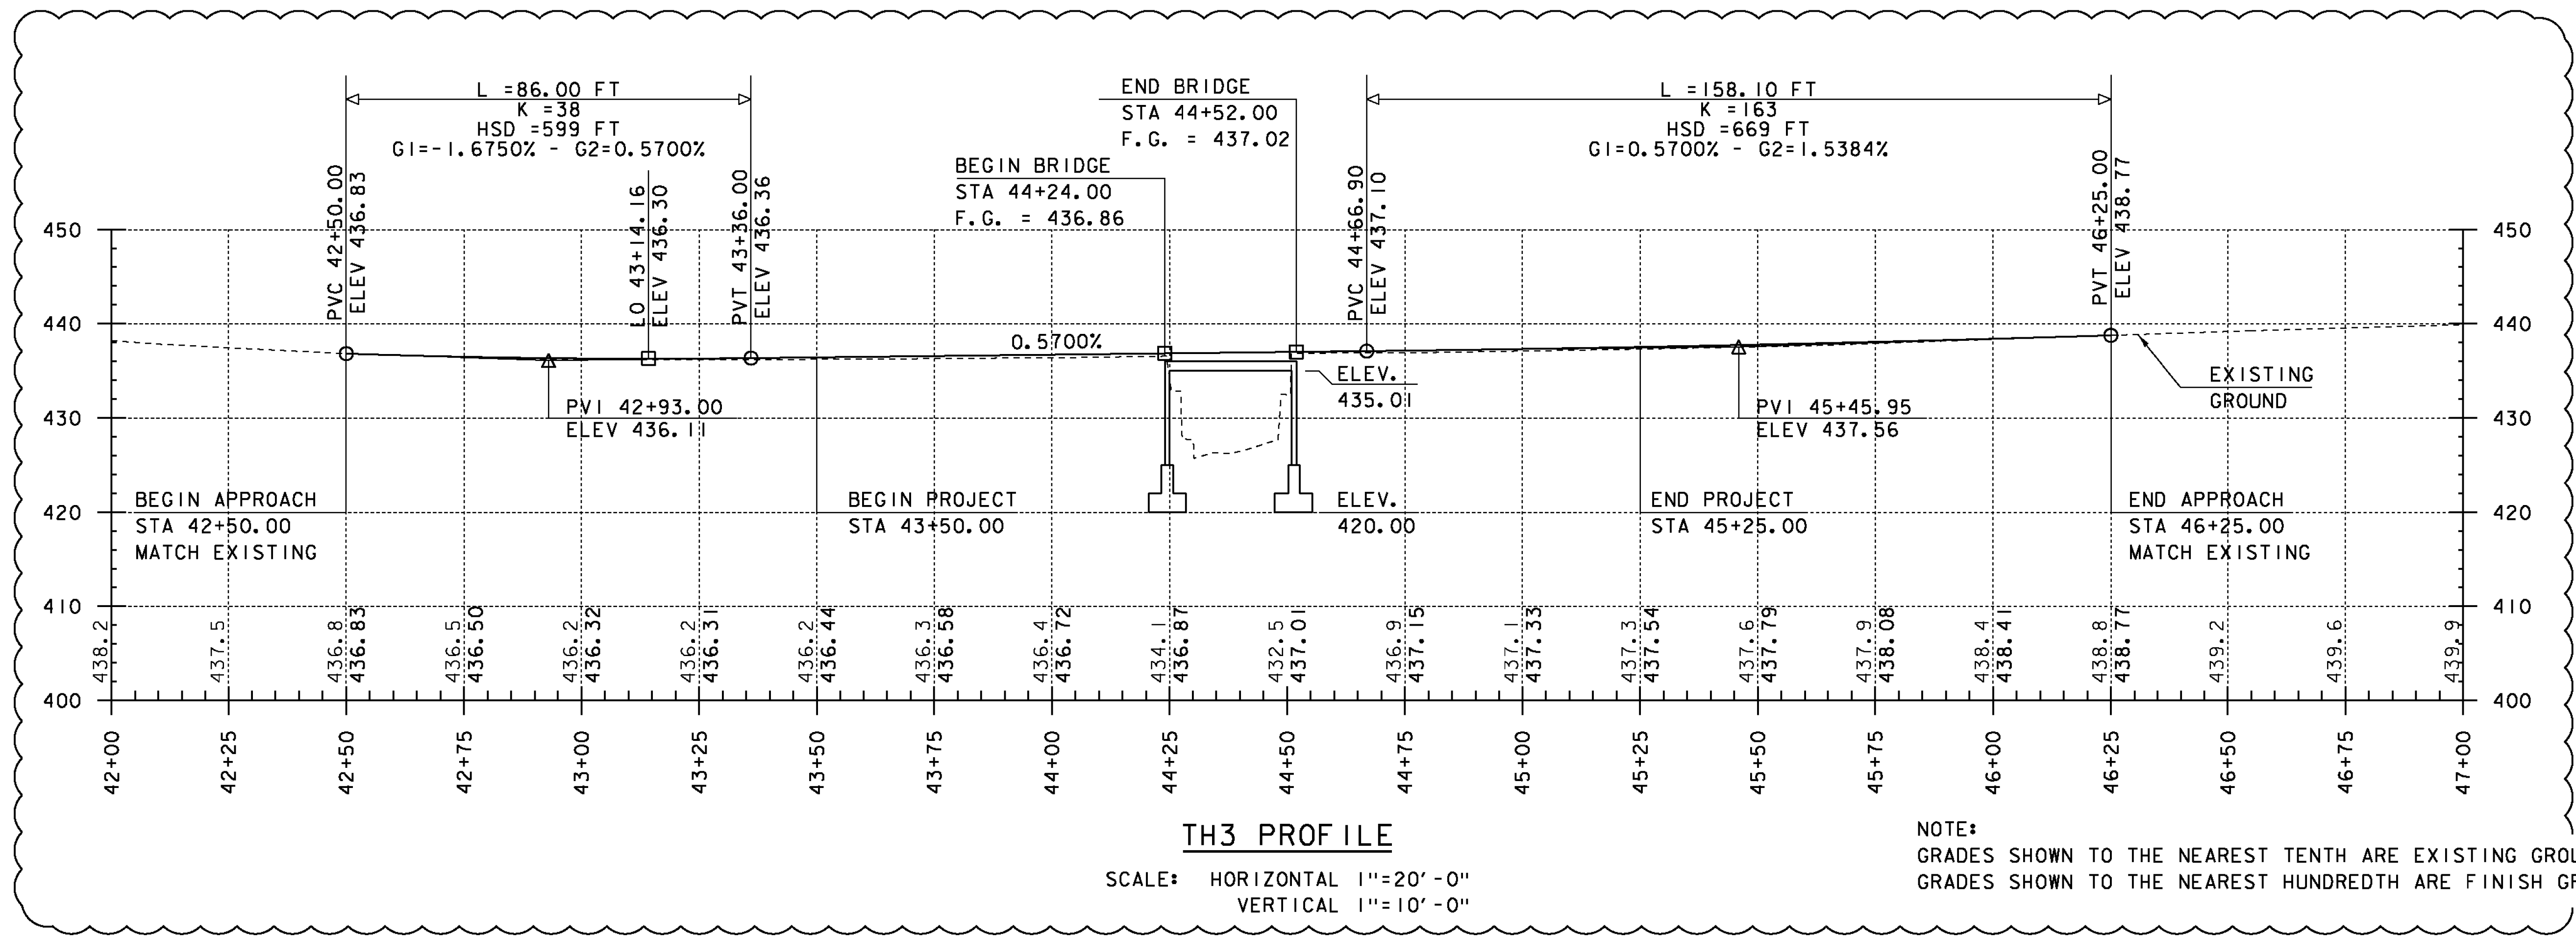

**TH3 PROFILE**

SCALE: HORIZONTAL 1"=20'-0"  
VERTICAL 1"=10'-0"


NOTE:  
GRADES SHOWN TO THE NEAREST TENTH ARE EXISTING GROUND ALONG L  
GRADES SHOWN TO THE NEAREST HUNDREDTH ARE FINISH GRADE ALONG L

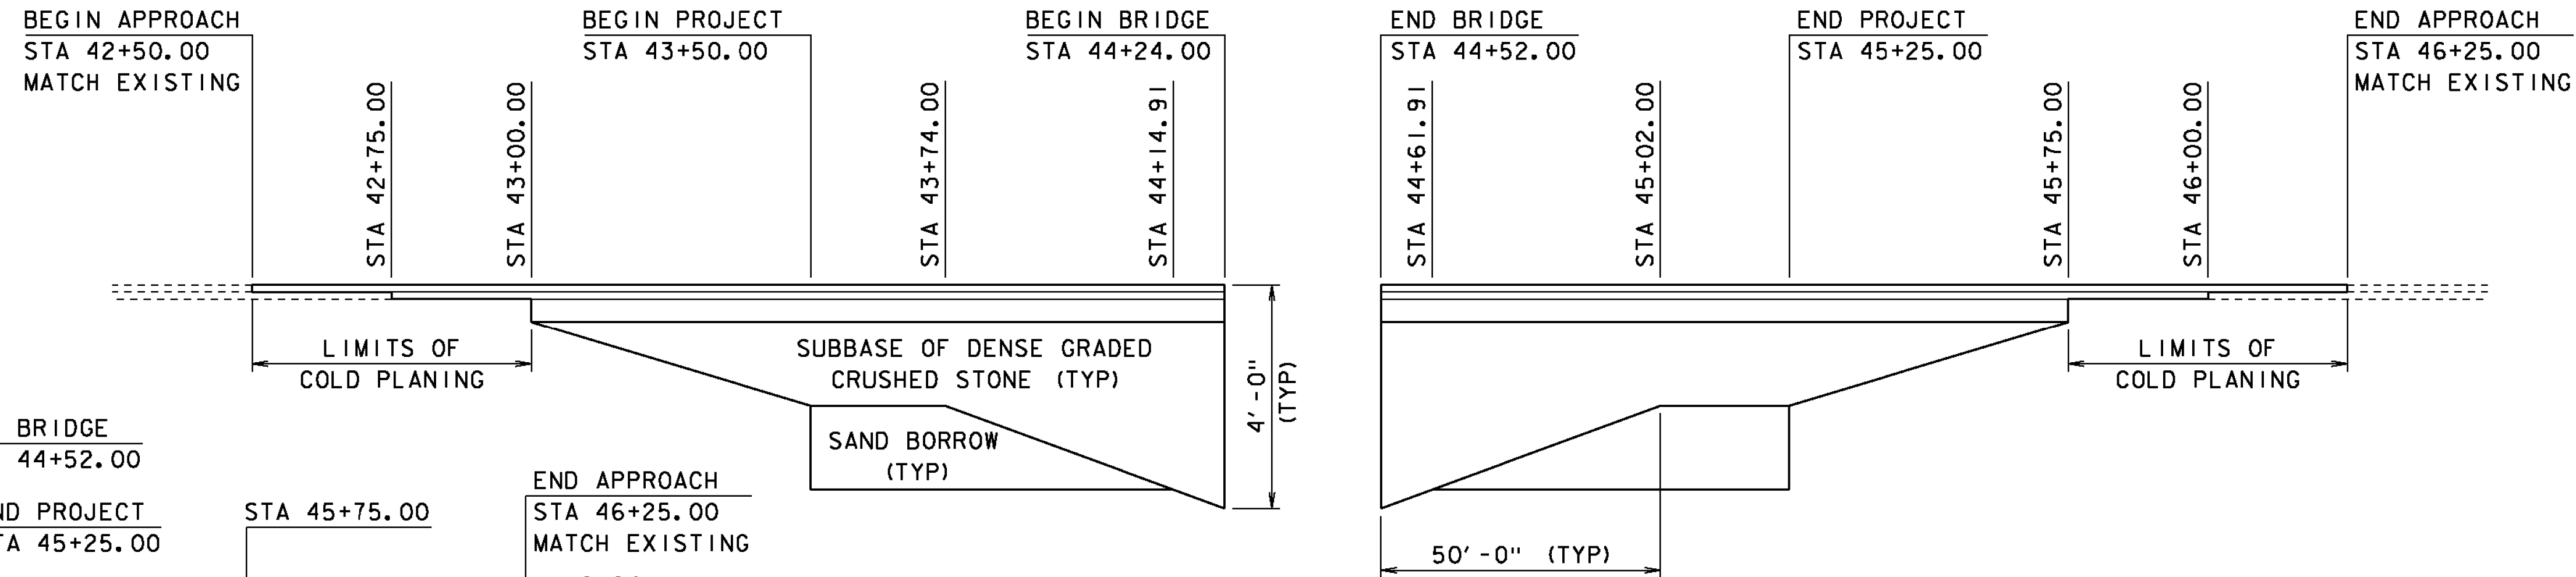

**MATERIAL TRANSITION DIAGRAM**

HOR. SCALE 1" = 20'-0"  
NO VERT. SCALE

NOTE:  
SEE ROADWAY TYPICAL SECTION FOR THICKNESSES OF:  
BITUMINOUS CONCRETE PAVEMENT,  
SUBBASE OF DENSE GRADED CRUSHED STONE  
& SAND BORROW

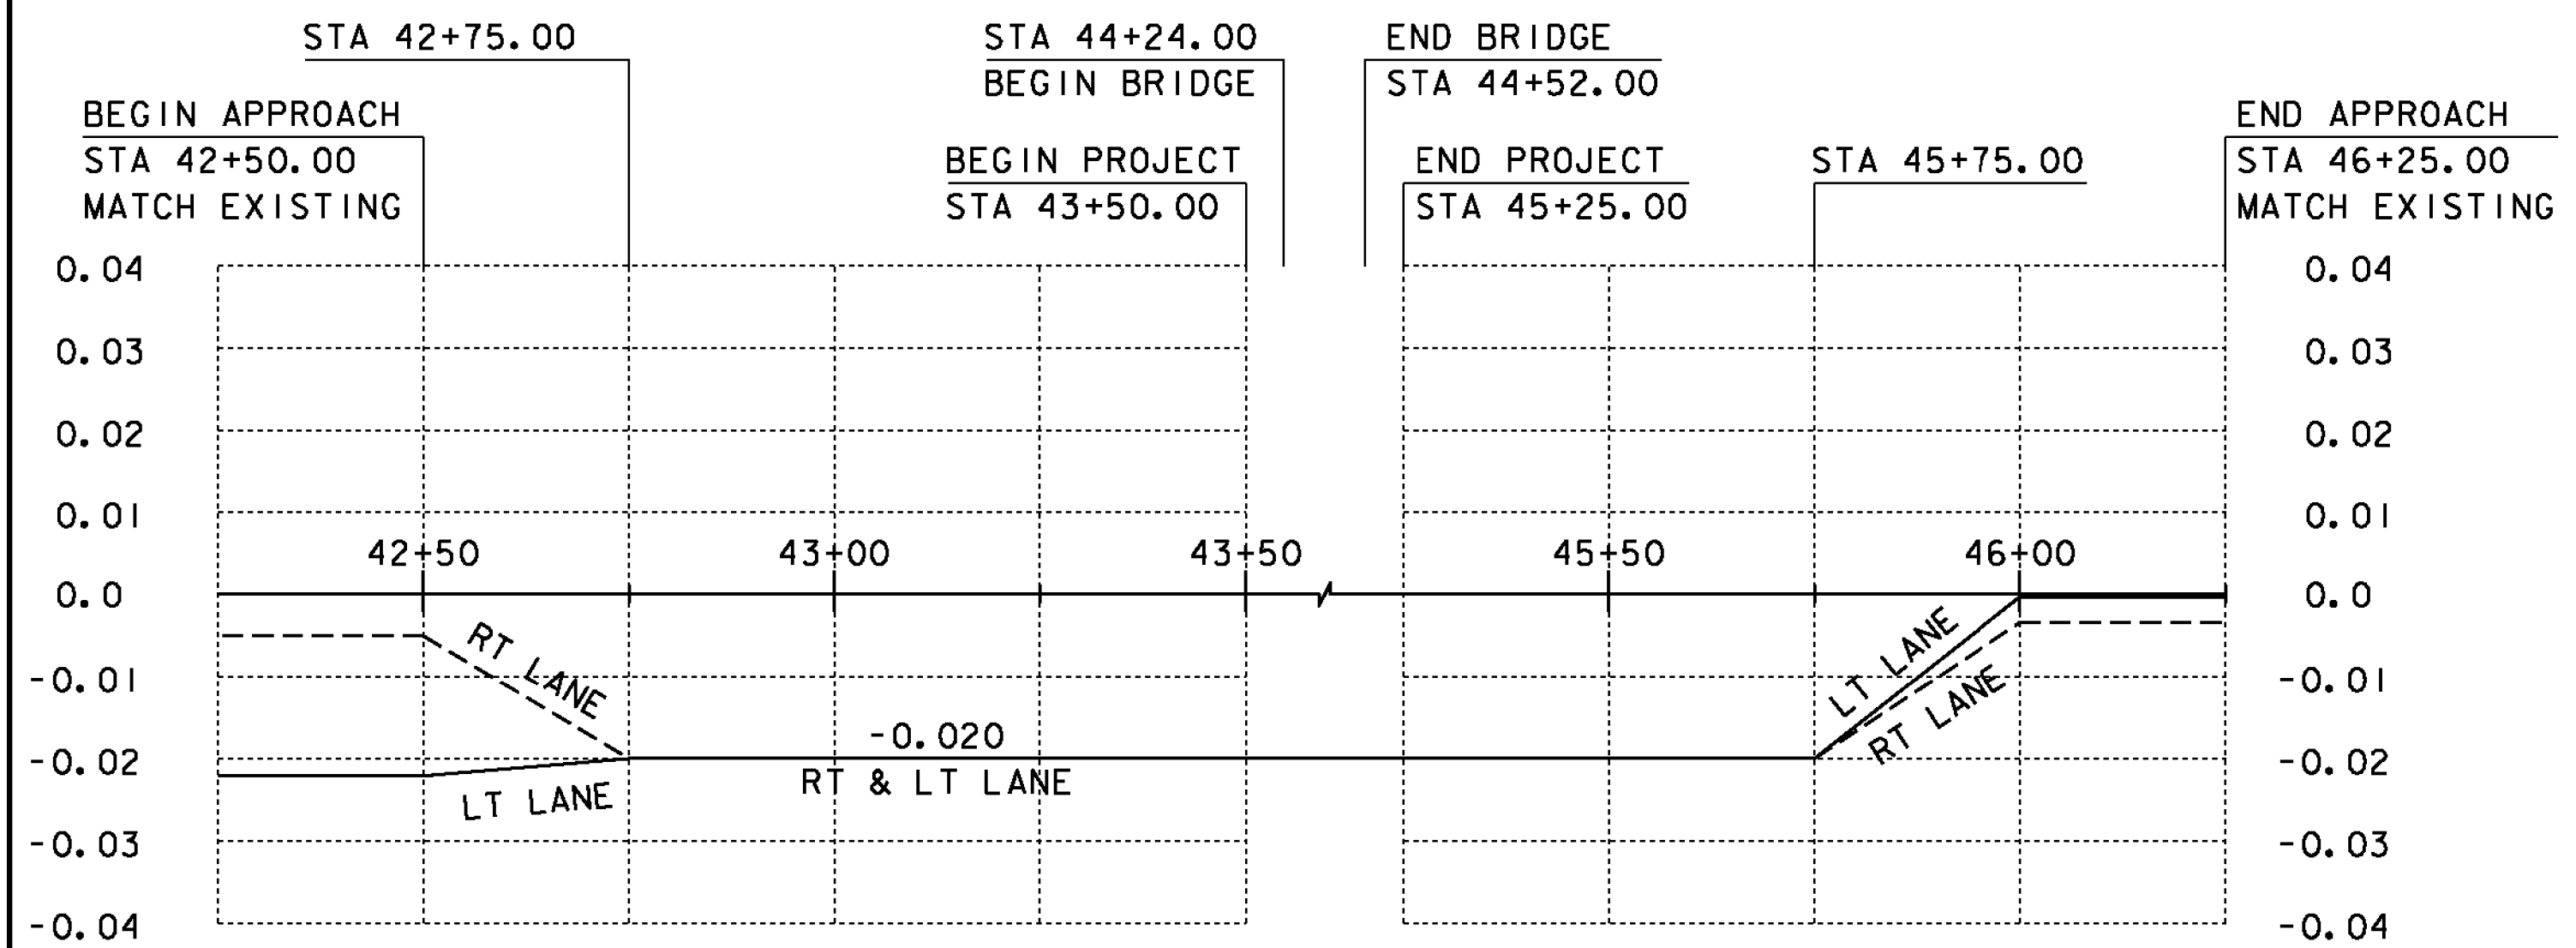



**BANKING DIAGRAM**

HOR. SCALE 1" = 20'-0"  
NO VERT. SCALE

REVISION	DATE	DESCRIPTION	BY
1	06-03-2015	RAISED THE GRADE 2' OVER BRIDGE SAG CURVE REMOVED TANGENT ADDED	MCL


PROJECT NAME: RICHFORD  
PROJECT NUMBER: BRF 0302(29)


FILE NAME: sl2j58pro.dgn PLOT DATE: 03-JUN-2015  
PROJECT LEADER: C. CARLSON DRAWN BY: R. PELLETT  
DESIGNED BY: H. SALLS CHECKED BY: H. SALLS  
TH 3 PROFILE AND TRANSITION DIAGRAMS SHEET 11 OF 36

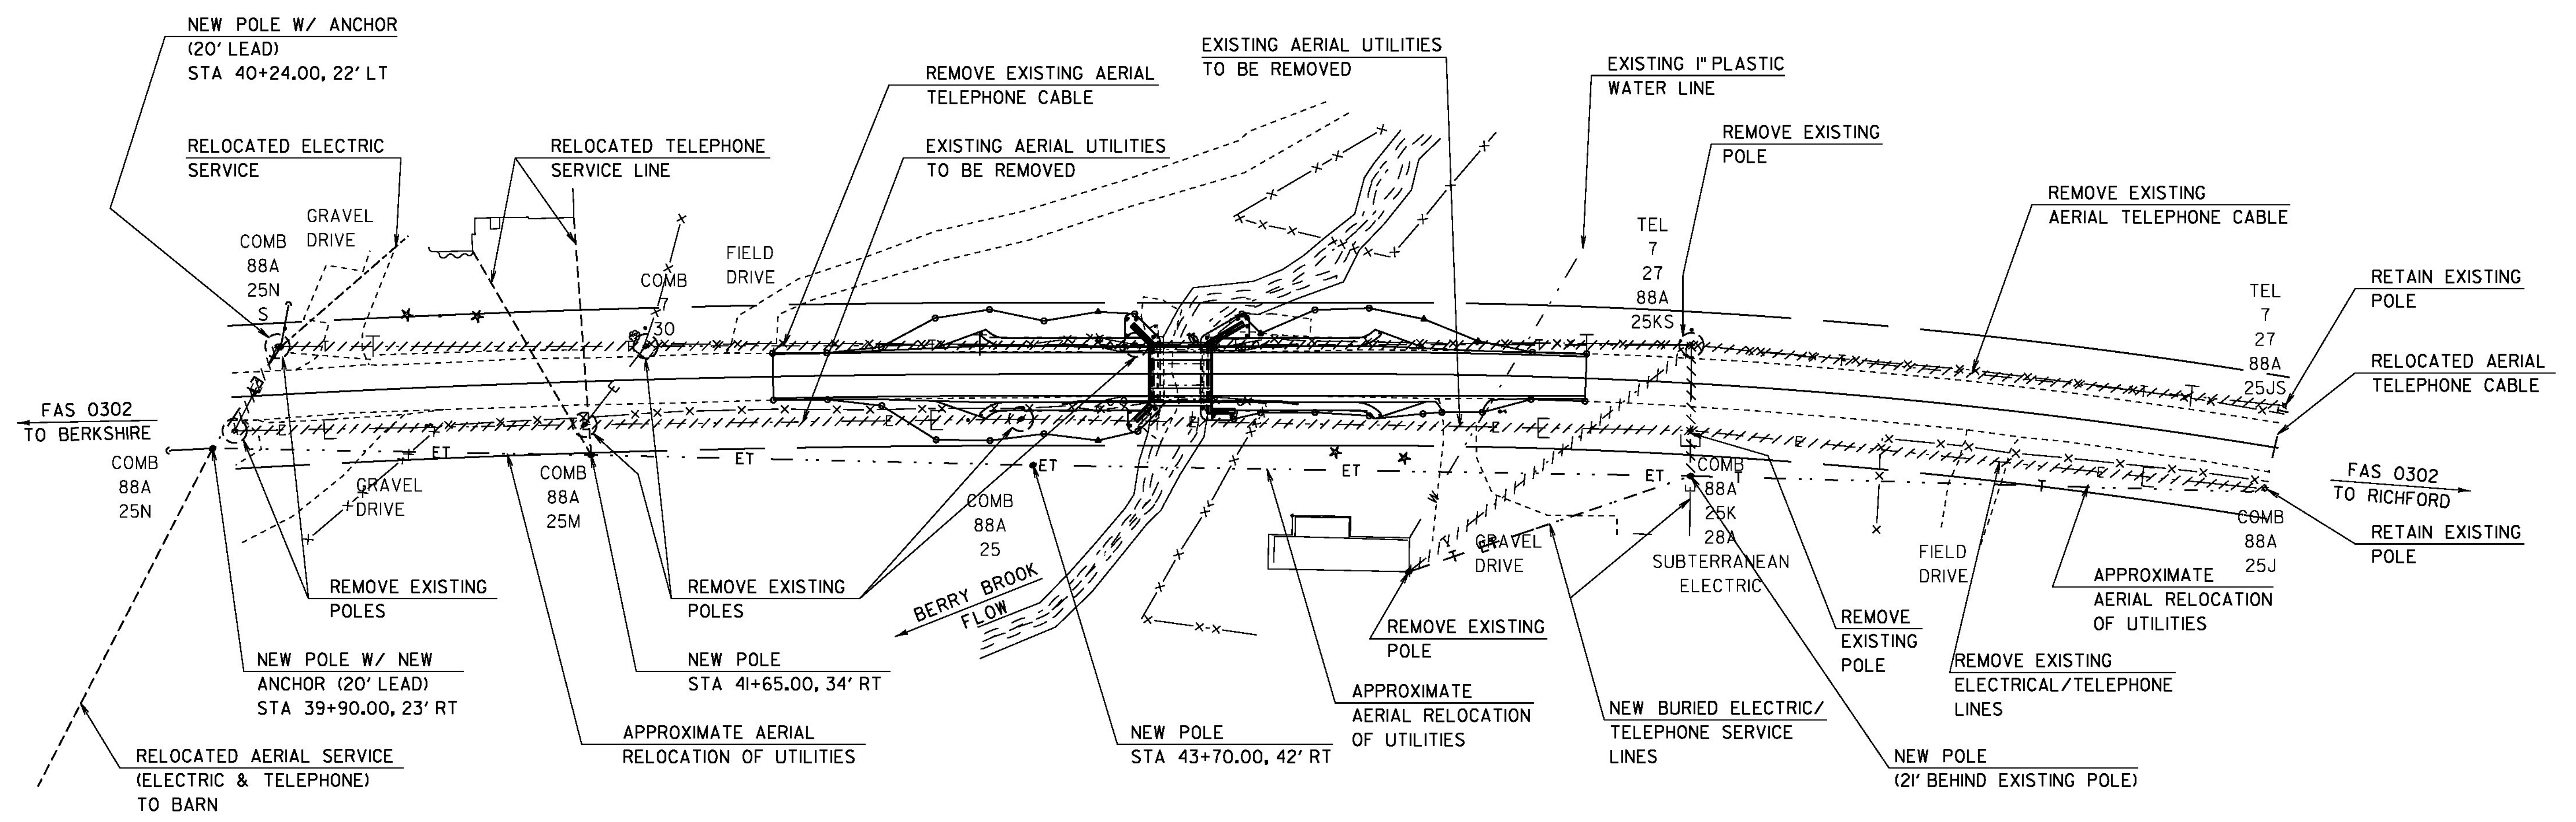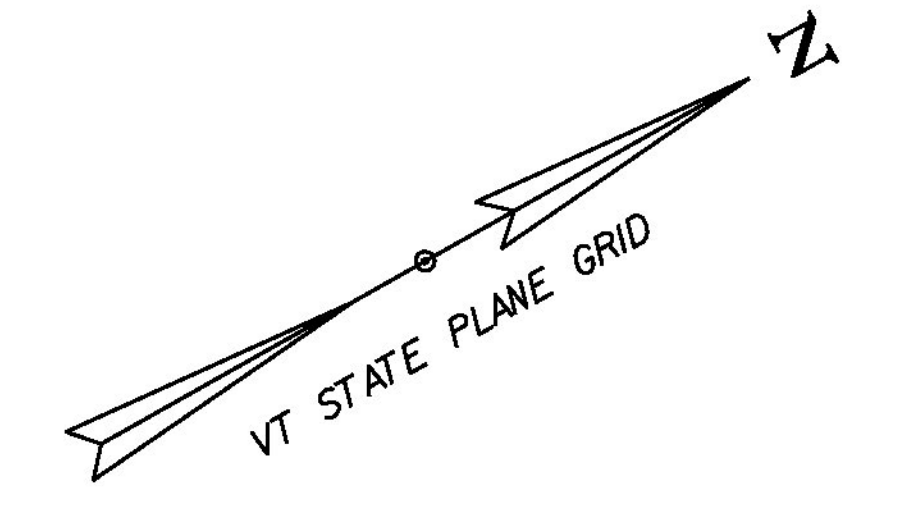

**NOTE:**  
 1. ALL UTILITY RELOCATION, REMOVAL AND NEW LINES AND POLES SHALL BE PERFORMED/INSTALLED BY THE UTILITY COMPANY OR A CONTRACTOR CONTRACTED BY THE UTILITY COMPANY TO PERFORM THE REQUIRED WORK. SEE THE UTILITY SPECIAL PROVISIONS FOR ADDITIONAL INFORMATION AND REQUIREMENTS.


PROJECT NAME:	RICHFORD
PROJECT NUMBER:	BRF 0302(29)
FILE NAME:	s12j158bdrutil.dgn
PROJECT LEADER:	C. CARLSON
DESIGNED BY:	H. SALLS
UTILITY LAYOUT	
PLOT DATE:	11-DEC-2014
DRAWN BY:	M. LONGSTREET
CHECKED BY:	L. WHEELER
SHEET	12 OF 36

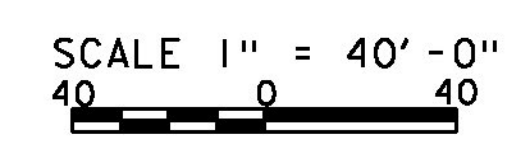

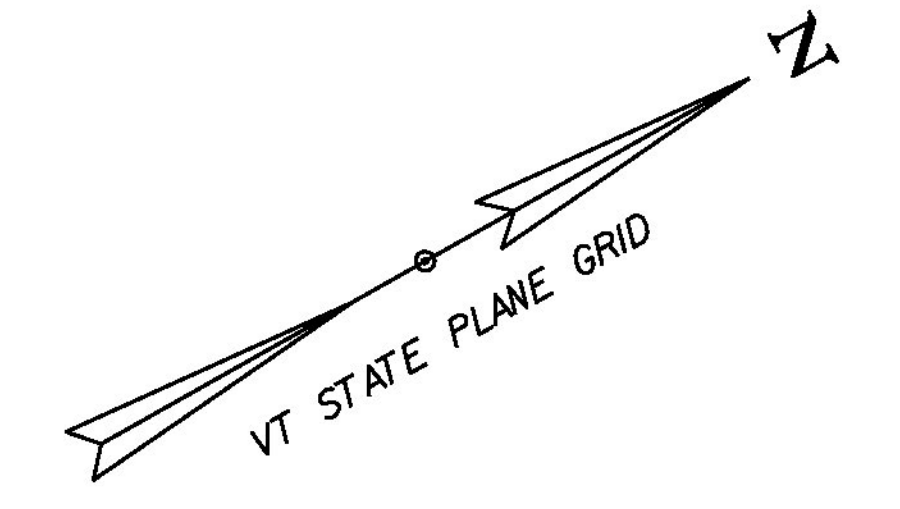

**REMOVING SIGNS**  
 STA 41+80.52 RT  
 STA 44+24.38 RT & LT  
 STA 44+52.03 RT & LT  
 STA 49+17.22 LT

**4 INCH YELLOW LINE**  
 STA 42+50.00 - 46+25.00 CL

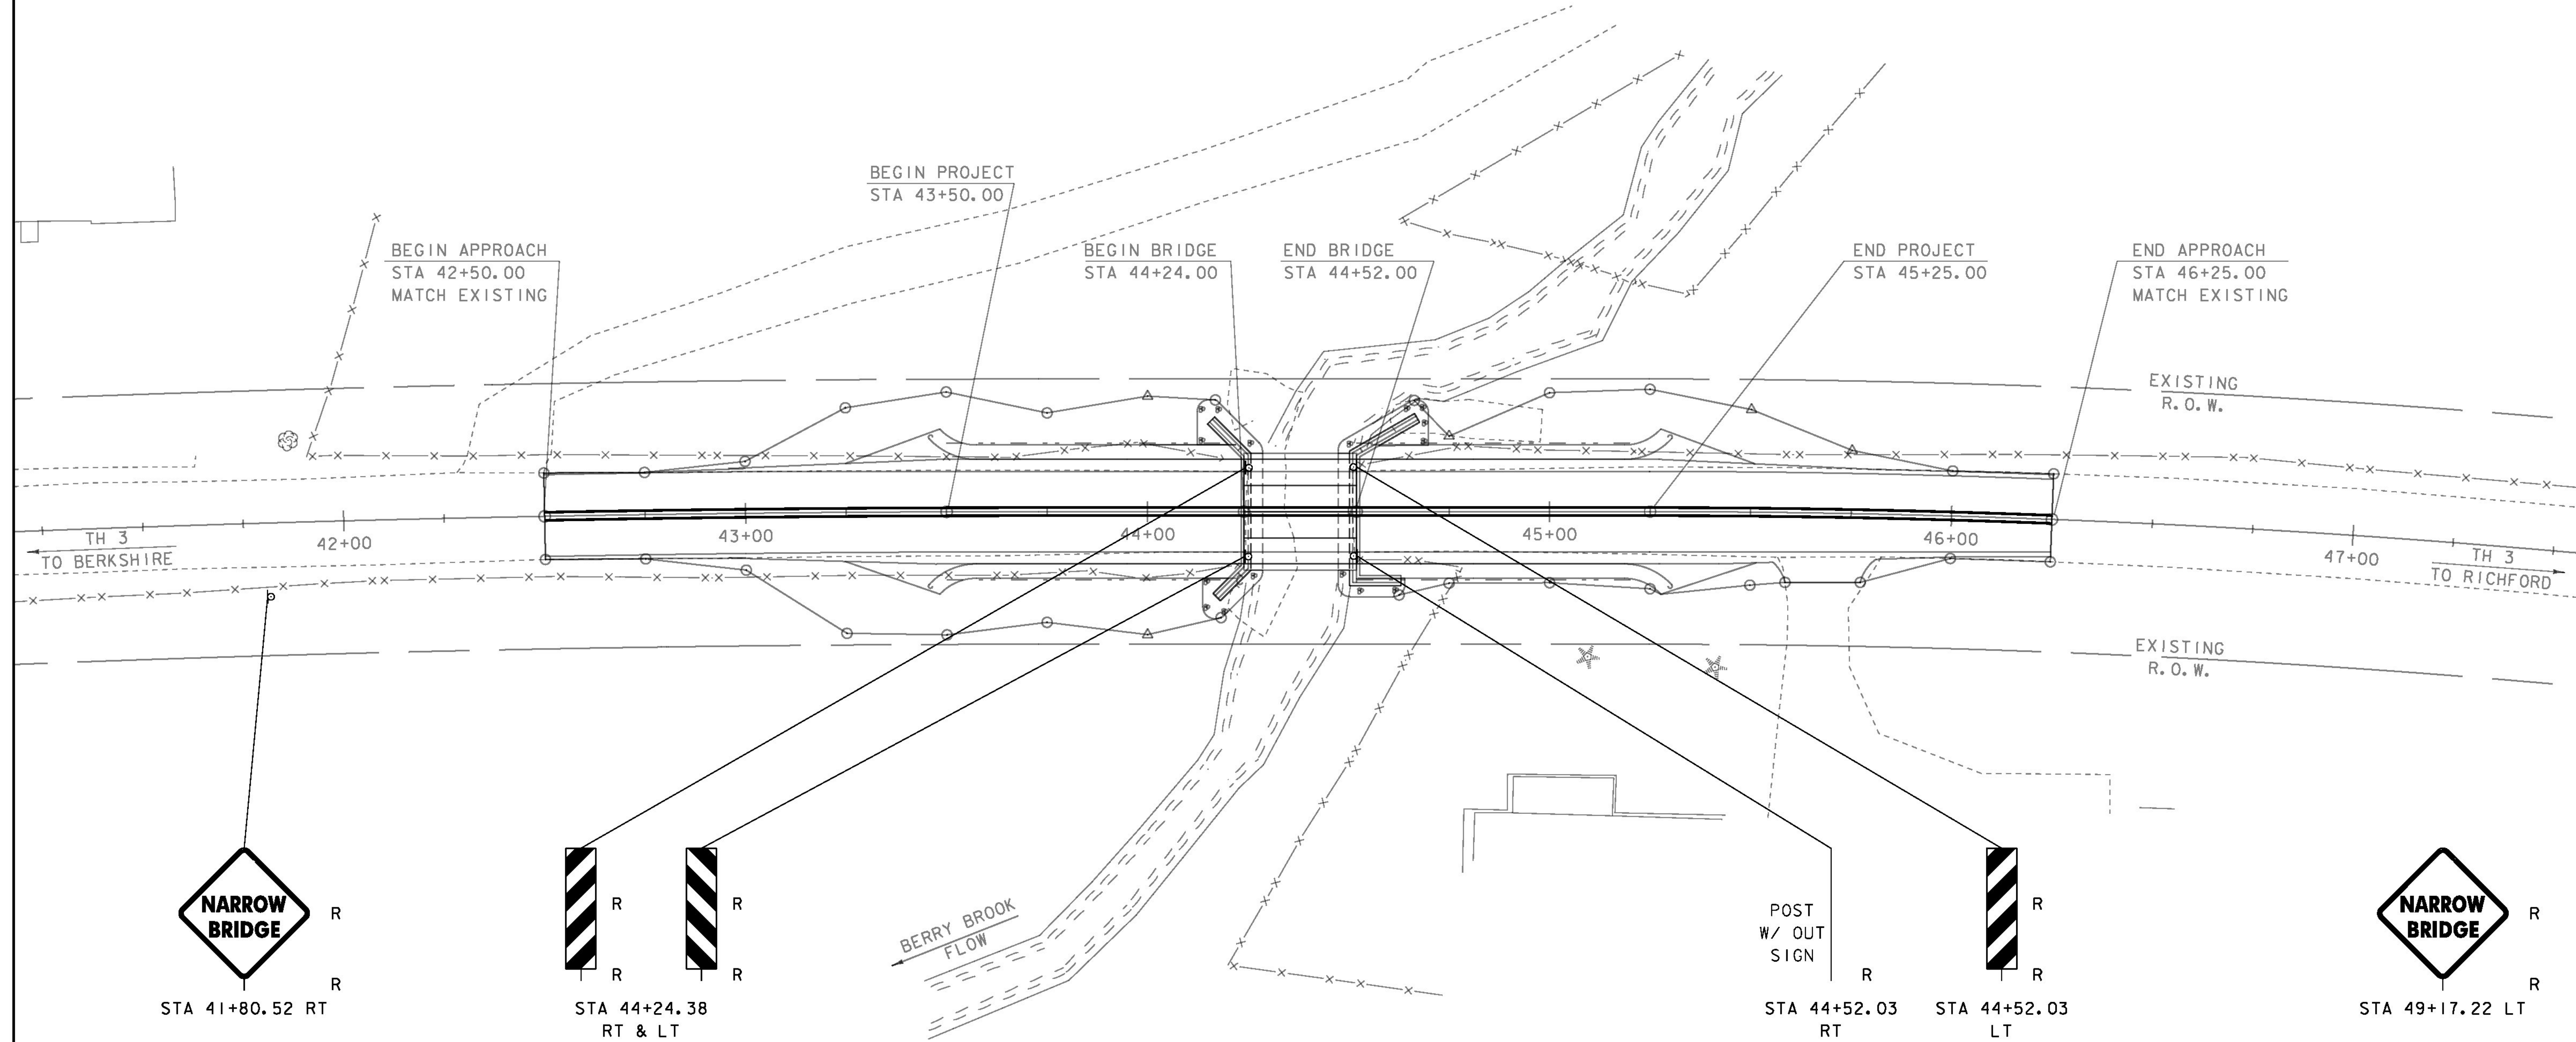

**NARROW BRIDGE**  
 STA 41+80.52 RT

**R R**  
 STA 44+24.38 RT & LT

POST W/ OUT SIGN  
 STA 44+52.03 RT

**R R**  
 STA 44+52.03 LT

**NARROW BRIDGE**  
 STA 49+17.22 LT

**LEGEND**  
 R - REMOVE

SCALE 1" = 20' - 0"  
 20 0 20

PROJECT NAME: RICHFORD	PLOT DATE: 06-JAN-2015
PROJECT NUMBER: BRF 0302(29)	DRAWN BY: R. PELLETT
FILE NAME: s12j158bdrstgn.dgn	CHECKED BY: H. SALLS
PROJECT LEADER: C. CARLSON	SHEET 13 OF 36
DESIGNED BY: H. SALLS	
SIGNS & PAVEMENT MARKING LAYOUT	

**SOIL CLASSIFICATION**

**AASHTO**

A1	Gravel and Sand
A3	Fine Sand
A2	Silty or Clayey Gravel and Sand
A4	Silty Soil - Low Compressibility
A5	Silty Soil - Highly Compressible
A6	Clayey Soil - Low Compressibility
A7	Clayey Soil - Highly Compressible

**ROCK QUALITY DESIGNATION**

R.Q.D. (%)	ROCK DESCRIPTION
<25	Very Poor
25 to 50	Poor
51 to 75	Fair
76 to 90	Good
>90	Excellent

**SHEAR STRENGTH**

UNDRAINED SHEAR STRENGTH IN P.S.F.	CONSISTENCY
<250	Very Soft
250-500	Soft
500-1000	Med. Stiff
1000-2000	Stiff
2000-4000	Very Stiff
>4000	Hard

**CORRELATION GUIDE OF "N" TO DENSITY/CONSISTENCY**



DENSITY (GRANULAR SOILS)		CONSISTENCY (COHESIVE SOILS)	
N	DESCRIPTIVE TERM	N	DESCRIPTIVE TERM
<5	Very Loose	<2	Very Soft
5-10	Loose	2-4	Soft
11-24	Med. Dense	5-8	Med. Stiff
25-50	Dense	9-15	Stiff
>50	Very Dense	16-30	Very Stiff
		31-60	Hard
		>60	Very Hard

**COMMONLY USED SYMBOLS**

- ▼ Water Elevation
- ⊕ Standard Penetration Boring
- ⊕ Auger Boring
- ⊕ Rod Sounding
- S Sample
- N Standard Penetration Test Blow Count Per Foot For: 2" O.D. Sampler 1 3/8" I.D. Sampler Hammer Weight Of 140 Lbs. Hammer Fall Of 30"
- VS Field Vane Shear Test
- US Undisturbed Soil Sample
- B Blast
- DC Diamond Core
- MD Mud Drill
- WA Wash Ahead
- HSA Hollow Stem Auger
- AX Core Size 1 1/8"
- BX Core Size 1 3/8"
- NX Core Size 2 1/8"
- M Double Tube Core Barrel Used
- LL Liquid Limit
- PL Plastic Limit
- PI Plasticity Index
- NP Non Plastic
- w Moisture Content (Dry Wgt. Basis)
- D Dry
- M Moist
- MTW Moist To Wet
- W Wet
- Sat Saturated
- Bo Boulder
- Gr Gravel
- Sa Sand
- Si Silt
- Cl Clay
- HP Hardpan
- Le Ledge
- NLTD No Ledge To Depth
- CNPF Can Not Penetrate Further
- TLOB Top of Ledge Or Boulder
- NR No Recovery
- Rec. Recovery
- 1/2 Rec. Percent Recovery
- ROD Rock Quality Designation
- CBR California Bearing Ratio
- < Less Than
- > Greater Than
- R Refusal (N > 100)
- VTSPG NAD83 - See Note 7

**COLOR**

blk	Black	pnk	Pink
bl	Blue	pu	Purple
brn	Brown	rd	Red
dk	Dark	tn	Tan
gry	Gray	wh	White
gn	Green	yel	Yellow
lt	Light	mltc	Multicolored
or	Orange		

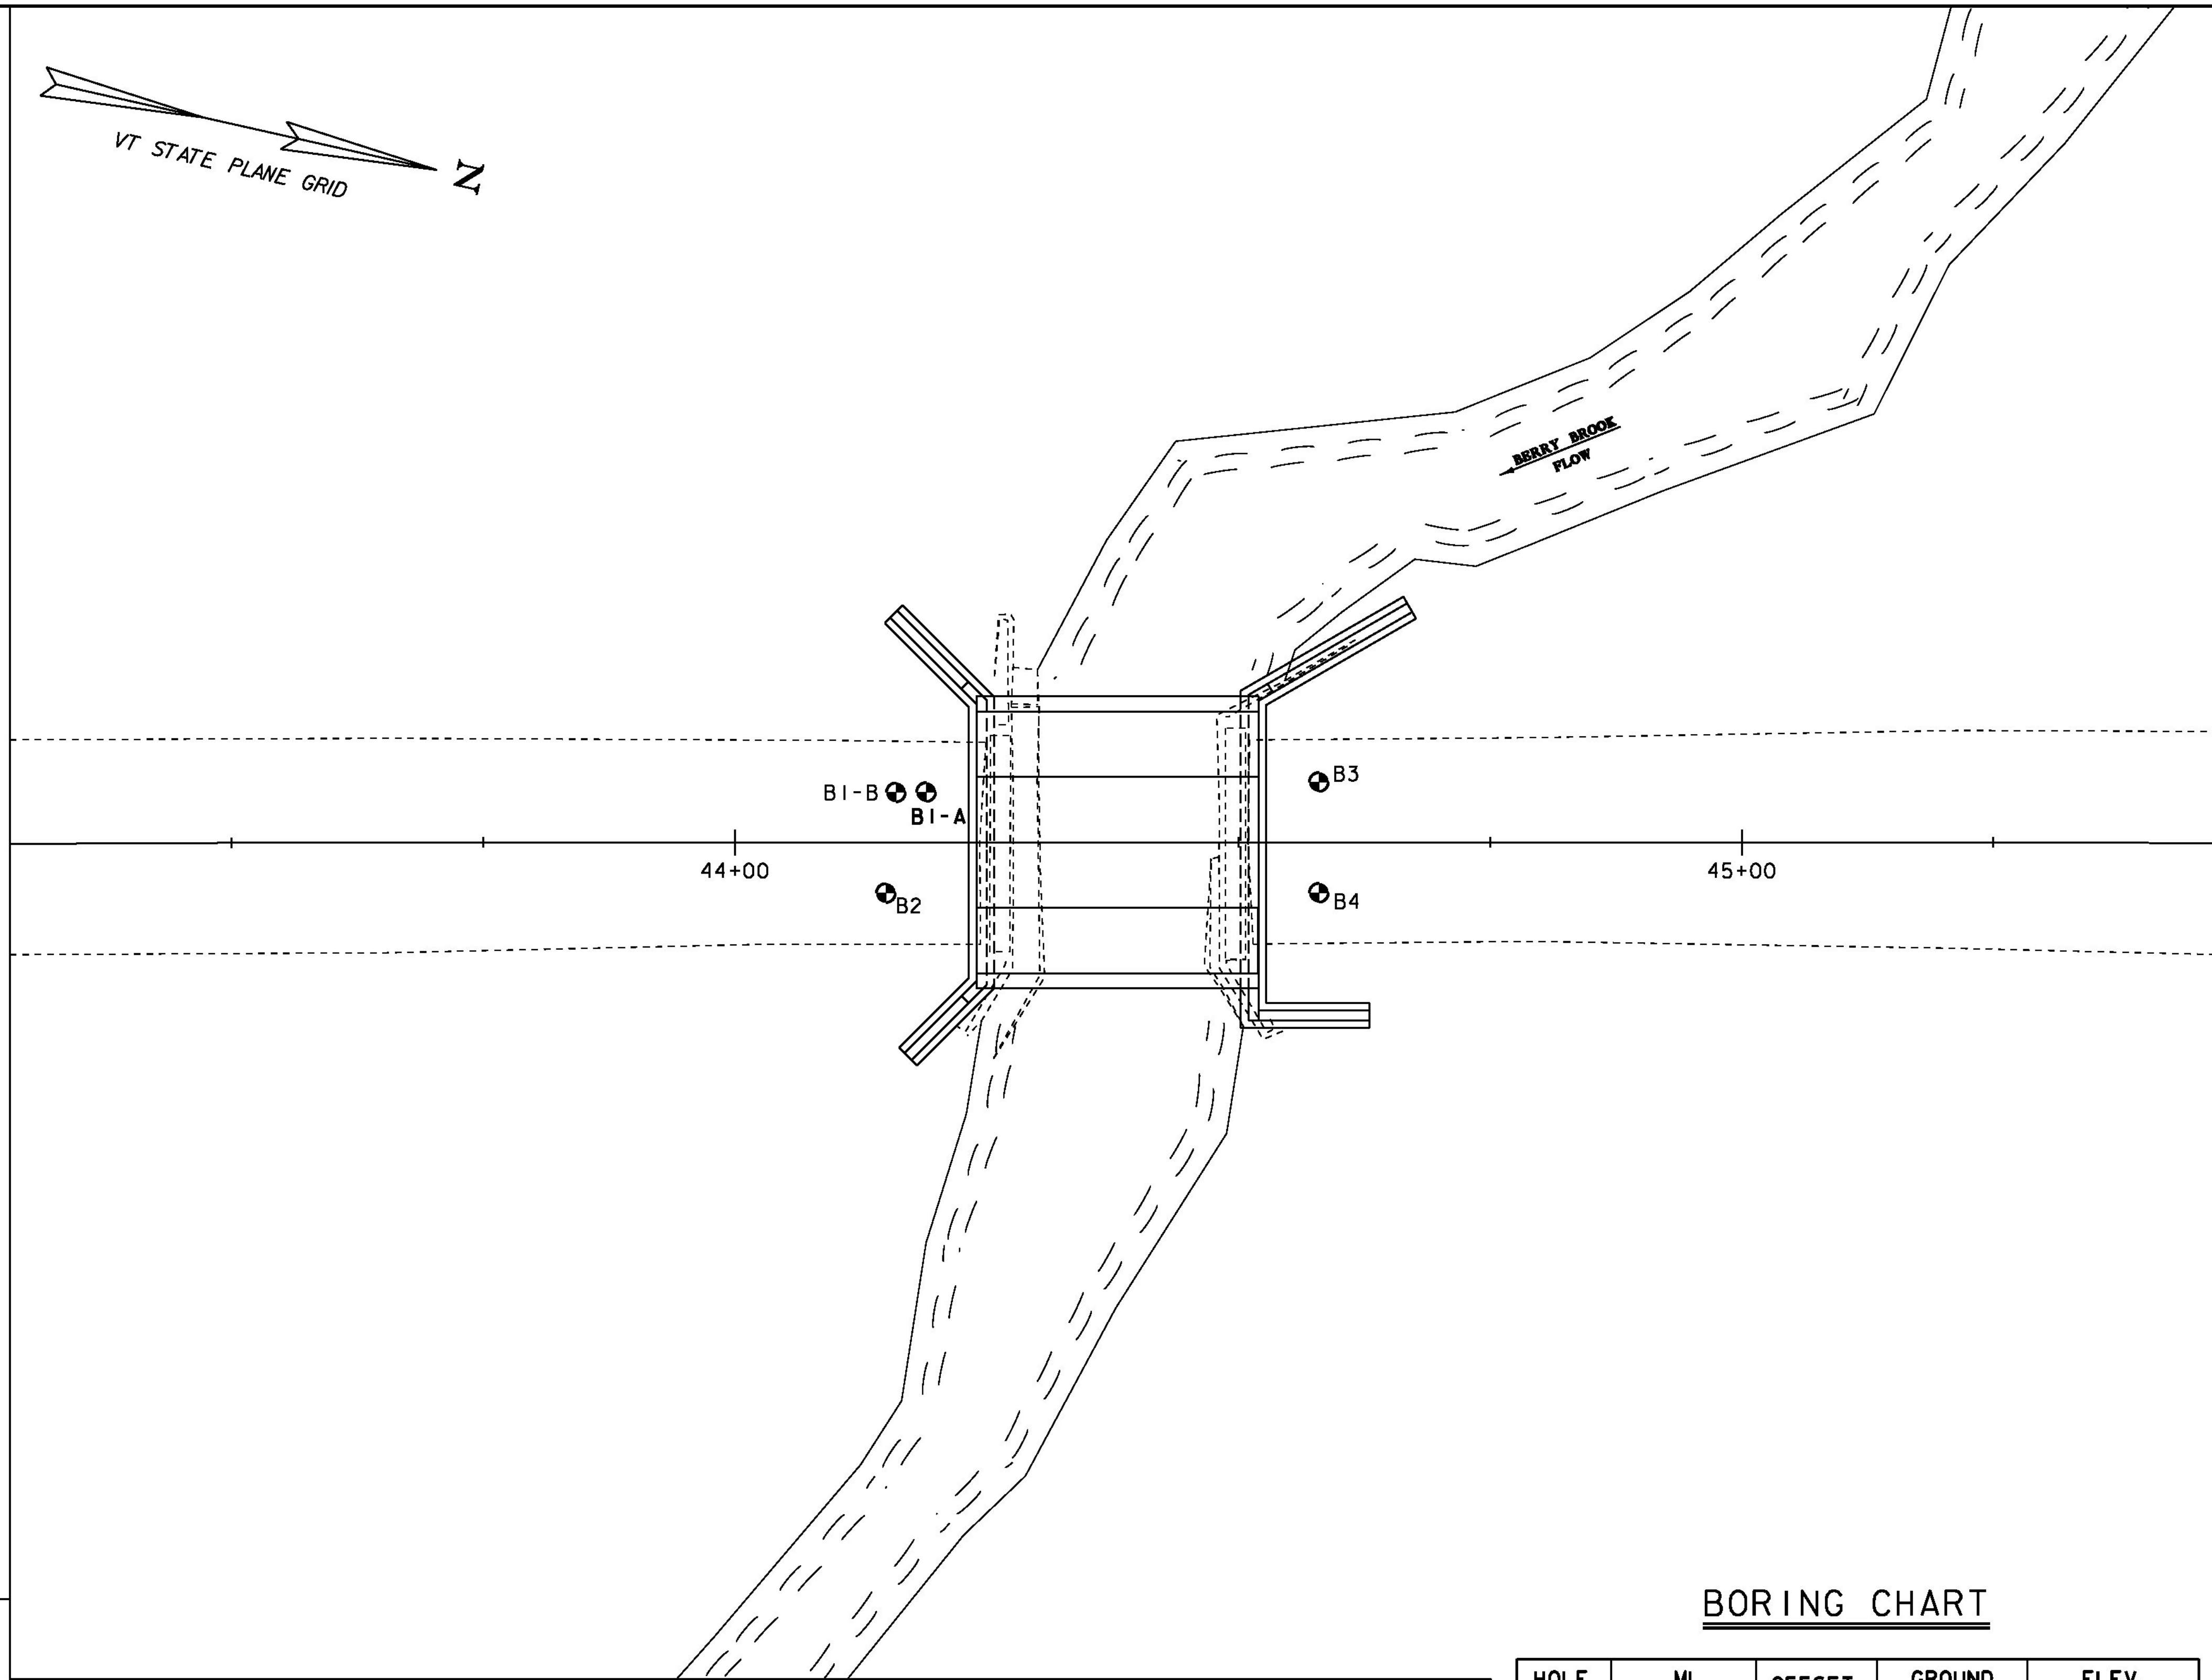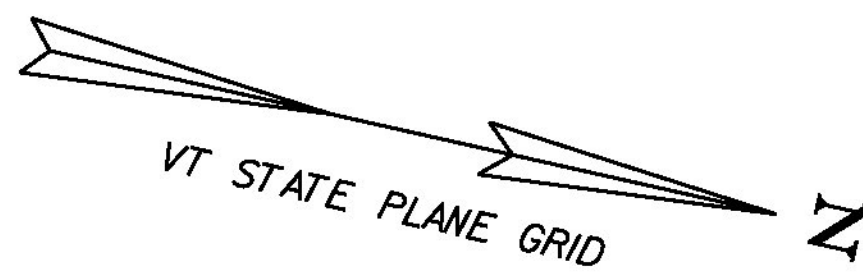

**BORING CHART**

HOLE NO.	ML STATION	OFFSET	GROUND ELEV.	ELEV. TLOB
B1-A	44+19.00	5' LT	436.50	395.50
B1-B	44+16.00	5' LT	436.50	395.50
B2	44+15.00	5' RT	436.50	396.50
B3	44+58.00	6' LT	437.00	392.00
B4	44+58.00	5' RT	437.00	388.00

PROJECT NAME:	RICHFORD
PROJECT NUMBER:	BRF 0302(29)
FILE NAME:	st2j158bor.dgn
PROJECT LEADER:	C. CARLSON
DESIGNED BY:	H. SALLS
BORING INFORMATION	
PLOT DATE:	11-DEC-2014
DRAWN BY:	R. PELLETT
CHECKED BY:	H. SALLS
SHEET	14 OF 36

**DEFINITIONS (AASHTO)**

- BEDROCK (LEDGE)** - Rock in its native location of indefinite thickness.
- BOULDER** - A rock fragment with an average dimension > 12 inches.
- COBBLE** - Rock fragments with an average dimension between 3 and 12 inches.
- GRAVEL** - Rounded particles of rock < 3" and > 0.075" (#10 sieve).
- SAND** - Particles of rock < 0.075" (#10 sieve) and > 0.0029" (#200 sieve).
- SILT** - Soil < 0.0029" (#200 sieve), non or slightly plastic and exhibits no strength when air-dried.
- CLAY** - Fine grained soil, exhibits plasticity when moist and considerable strength when air-dried.
- VARVED** - Alternate layers of silt and clay.
- HARDPAN** - Extremely dense soil, cemented layer, not softened when wet.
- MUCK** - Soft organic soil (containing > 10% organic material).
- MOISTURE CONTENT** - Weight of water divided by dry weight of soil.
- FLOWING SAND** - Granular soil so saturated (loose) that it flows into drill casing during extraction of wash rod.
- STRIKE** - Angle from magnetic north to line of intersection of bed with a horizontal plane.
- DIP** - Inclination of bed with a horizontal plane.

**GENERAL NOTES**

- The subsurface explorations shown herein were made between 09/04/2013 and 09/09/2013 by the Agency.
- Soil and rock classifications, properties and descriptions are based on engineering interpretation from available subsurface information by the Agency and may not necessarily reflect actual variations in subsurface conditions that may be encountered between individual boring or sample locations.
- Observed water levels and/or conditions indicated are as recorded at the time of exploration and may vary according to the prevailing rainfall, methods of exploration and other factors.
- Engineering Judgment was exercised in preparing the subsurface information presented herein. Analysis and interpretation of subsurface data was performed and interpreted for Agency design and estimating purposes. Presentation of the information in the Contract is intended to provide the Contractor access to the same data available to the Agency. The subsurface information is presented in good faith and is not intended as a substitute for personal investigation, independent interpretation, independent analysis or judgment by the Contractor.
- Pictorial structure details shown on the boring plan layout or soils profile are for illustrative purposes only and may not accurately portray final contract details.
- Terminology used on boring logs to describe the hardness, degree of weathering, and spacing of fractures, joints and other discontinuities in the bedrock is defined in the AASHTO Manual on Subsurface Investigations, 1988.
- Northing and Easting coordinates are shown in Vermont State Plane Grid North American Datum 1983 in meters and survey feet.

VT Trans		STATE OF VERMONT AGENCY OF TRANSPORTATION MATERIALS & RESEARCH SECTION SUBSURFACE INFORMATION		BORING LOG		Boring No.: <b>B-1A/B</b>							
				Richford BRF 0302(29) Richford, VT GeoDesign # 750-09.13		Page No.: 1 of 3 Pin No.: 12 158 Checked By: JFW							
Boring Crew: J. Leonhardt (TransTech), A. Baribault (GeoDesign)		Casing Type: FJ		Sampler Type: SS		Groundwater Observations ⁽³⁾							
Date Started: 9/04/13 Date Finished: 9/05/13		I.D.: 4 in		Date: 09/04/13		Depth (ft):							
VTSPG NAD83: N 909695.07 ft E 1592596.89 ft		Hammer Wt: 140 lb		Blows/6" (N Value) ⁽²⁾		Notes: See Note 3.							
Station: 44+19 Offset: 5' L		Hammer Fall: 30 in		Moisture Content %									
Ground Elevation: 436.5 ft		Hammer/Rod Type: Auto/NWJ		Gravel %									
		Rig: CME 550X ATV		Sand %									
		C _E = ~1.5		Fines %									
				LL %									
				PI %									
Depth (ft)	Strat ⁽¹⁾	CLASSIFICATION OF MATERIALS (Description)		Run (Dip deg.)	Cone Rec. % (RQD %)	Drill Rate minutes/ft	Blows/6" (N Value) ⁽²⁾	Moisture Content %	Gravel %	Sand %	Fines %	LL %	PI %
0		6" Asphalt											
0.5		S1 (0.5' to 2'): Medium dense, brown-gray fine to coarse SAND, little fine Gravel, little Silt, slightly moist. (Fill) Rec. = 1.0 ft (AASHTO M145 Classification: A-1-b.)					16-9-8 (17)	4.2	35.4	49.5	15.1	NP	NP
2		S2 (2' to 4'): Medium dense, brown-gray fine to coarse SAND, some fine to coarse Gravel, little Silt, slightly moist. (Fill) Rec. = 1.42 ft (AASHTO M145 Classification: A-1-b.)					4-6-11-11 (17)	7.1	41.4	43.3	15.3	NP	NP
4		S3 (4' to 6'): Medium dense, brown fine to coarse SAND and fine to coarse GRAVEL, little Silt, very moist to wet. (Fill) Rec. = 1.17 ft (AASHTO M145 Classification: A-1-b.)					10-9-6-5 (15)	10.2	49.5	35.6	14.9	NP	NP
6		S4 (6' to 8'): Loose, brown fine to coarse SAND, some Silt, little fine Gravel, very moist. (Possible Fill) Rec. = 0.83 ft (AASHTO M145 Classification: A-2-4.)					4-5-4-5 (9)	15.7	21.6	49.9	28.5	NP	NP
9		S5 (9' to 11'): Loose, no recovery. Rec. = 0.0 ft					7-4-5-7 (9)						
11		S6 (11' to 13'): Medium dense; S6A (Upper 5'): Brown fine to coarse SAND and SILT, trace fine Gravel (concentrated at top of sample), wet. S6B (Lower 3'): Gray SILT, trace fine Sand, wet. (Sand/Silt) Rec. = 0.67 ft (AASHTO M145 Classification: A-4.)		C1			7-6-6-6 (12)	28.7	2.3	97.7		NP	NP
13		C1 (13' to 13.7'): Hard, slightly weathered, gray with white QUARTZITE BOULDER.					16-18-20-24 (38)	10.5	48.1	17.5	34.4	NP	NP
14		S7 (14' to 16'): Dense, greenish-gray fine to coarse GRAVEL and SILT, some fine to coarse Sand, moist. (Glacial Till) Rec. = 0.5 ft (AASHTO M145 Classification: A-2-4.)					9-19-19-16 (38)	10.4	39.0	31.5	29.5	NP	NP
16		S8 (16' to 18'): Dense, gray fine to coarse SAND, some Silt, some fine Gravel, moist to wet. (Glacial Till) Rec. = 1.17 ft (AASHTO M145 Classification: A-2-4.)					80/3" (R)	8.5	38.4	23.4	38.2	NP	NP
19		S9 (19' to 19.3'): Refusal, gray SILT, some fine to coarse Sand, some fine to coarse Gravel (fractured), wet. (Glacial Till) Rec. = 0.25 ft (AASHTO M145 Classification: A-4.)					80/2" (R)	7.5	63.1	20.0	16.9	NP	NP
21		S10 (21' to 21.2'): Refusal, gray fine to coarse GRAVEL, some fine to coarse Sand, little Silt, wet. (Glacial Till) Rec. = 0.17 ft (AASHTO M145 Classification: A-1-b.)					100/6" (R)	8.5	14.9	31.7	53.4	NP	NP
24		S11 (24' to 24.5'): Refusal, gray SILT and fine to coarse SAND, trace fine Gravel, moist. (Glacial Till) Rec. = 0.5 ft (AASHTO M145 Classification: A-4.)					100/6" (R)	9.0	18.1	29.9	52.0	NP	NP
29		S12 (29' to 29.5'): Refusal, gray SILT and fine to coarse SAND, little fine Gravel, moist. (Glacial Till) Rec. = 0.5 ft											

BOTTOM OF FOOTING  
ELEV 420.00

GEODESIGN BORING LOG 750-09.13 RICHFORD VTRANS.GPJ VERMONT AOT.GDT 10/9/13

Notes:

1. Stratification lines represent approximate boundary between material types. Transition may be gradual.
2. N Values have not been corrected for hammer energy. C_e is the hammer energy correction factor.
3. Water level readings have been made at times and under conditions stated. Fluctuations of groundwater may occur due to other factors than those present at the time measurements were made.

VT Trans		STATE OF VERMONT AGENCY OF TRANSPORTATION MATERIALS & RESEARCH SECTION SUBSURFACE INFORMATION		BORING LOG		Boring No.: <b>B-1A/B</b>							
				Richford BRF 0302(29) Richford, VT GeoDesign # 750-09.13		Page No.: 2 of 3 Pin No.: 12 158 Checked By: JFW							
Boring Crew: J. Leonhardt (TransTech), A. Baribault (GeoDesign)		Casing Type: FJ		Sampler Type: SS		Groundwater Observations ⁽³⁾							
Date Started: 9/04/13 Date Finished: 9/05/13		I.D.: 4 in		Date: 09/04/13		Depth (ft):							
VTSPG NAD83: N 909695.07 ft E 1592596.89 ft		Hammer Wt: 140 lb		Blows/6" (N Value) ⁽²⁾		Notes: See Note 3.							
Station: 44+19 Offset: 5' L		Hammer Fall: 30 in		Moisture Content %									
Ground Elevation: 436.5 ft		Hammer/Rod Type: Auto/NWJ		Gravel %									
		Rig: CME 550X ATV		Sand %									
		C _E = ~1.5		Fines %									
				LL %									
				PI %									
Depth (ft)	Strat ⁽¹⁾	CLASSIFICATION OF MATERIALS (Description)		Run (Dip deg.)	Cone Rec. % (RQD %)	Drill Rate minutes/ft	Blows/6" (N Value) ⁽²⁾	Moisture Content %	Gravel %	Sand %	Fines %	LL %	PI %
0		(AASHTO M145 Classification: A-4.)											
35		S13 (34' to 35'): Refusal, gray fine to coarse SAND and SILT, little fine Gravel, wet. (Glacial Till) Rec. = 0.83 ft (AASHTO M145 Classification: A-4.)					58-100/5.5" (R)	12.2	18.0	46.3	35.7	NP	NP
40		S14 (39' to 39.4'): Refusal, gray and greenish gray fine to coarse SAND and SILT, some fine Gravel, wet. Approximately 2" in spoon shoe of possible weathered bedrock. (Glacial Till) Rec. = 0.42 ft (AASHTO M145 Classification: A-2-4.)					100/5" (R)	11.8	35.2	30.4	34.4	NP	NP
41		Inferred Weathered Bedrock											
42		C2 (41' to 46'): Poor quality, gray-greenish gray, moderately hard, fine grained, moderately weathered PHYLLITE interbedded with Quartz, fracture angle approximately 45 to 90 degrees.		C2	93 (48)	3.5							
44		Top of Bedrock @ 41.0 ft				5							
45						4							
46						5.5							
47						6.5							
48													
49													
GEODESIGN BORING LOG 750-09.13 RICHFORD VTRANS.GPJ VERMONT AOT.GDT 10/9/13

Notes:

1. Stratification lines represent approximate boundary between material types. Transition may be gradual.
2. N Values have not been corrected for hammer energy. C_e is the hammer energy correction factor.
3. Water level readings have been made at times and under conditions stated. Fluctuations of groundwater may occur due to other factors than those present at the time measurements were made.

PROJECT NAME:	RICHFORD	PLOT DATE:	11-DEC-2014
PROJECT NUMBER:	BRF 0302(29)	DRAWN BY:	R. PELLET
FILE NAME:	st2j158bor.dgn	DESIGNED BY:	H. SALLS
PROJECT LEADER:	C. CARLSON	CHECKED BY:	H. SALLS
BORING LOGS I		SHEET	15 OF 36



STATE OF VERMONT  
AGENCY OF TRANSPORTATION  
MATERIALS & RESEARCH SECTION  
SUBSURFACE INFORMATION

**BORING LOG**

**Richford BRF 0302(29)**  
**Richford, VT**  
**GeoDesign # 750-09.13**

Boring No.: **B-1A/B**

Page No.: **3 of 3**

Pin No.: **12j158**

Checked By: **JFW**

Boring Crew: **J. Leonhardt (TransTech), A. Baribault (GeoDesign)**  
Date Started: **9/04/13** Date Finished: **9/05/13**  
VTSPG NAD83: **N 909695.07 ft E 1592596.89 ft**  
Station: **44+19** Offset: **5' L**  
Ground Elevation: **436.5 ft**

Casing		Sampler		Groundwater Observations ⁽³⁾		
Type:	I.D.:			Date	Depth (ft)	Notes
FJ	4 in	SS	2 in	09/04/13		See Note 3.
Hammer Wt:	140 lb.	140 lb.				
Hammer Fall:	30 in.	30 in.				
Hammer/Rod Type:	Auto/NWJ					
Rig:	CME 550X ATV	C _E = ~1.5				

Depth (ft)	Strata ⁽¹⁾	CLASSIFICATION OF MATERIALS (Description)	Run (Dip deg.)	Core Rec. % (RQD %)	Drill Rate minutes/ft	Blows/ft* (N Value) ⁽²⁾	Moisture Content %	Gravel %	Sand %	Fines %	LL %	PI %
65		5) Advanced casing in B-1B to 14' deep prior to continuing with soil sampling. 6) Noted occasional roller bit grinding/chatter below 18' deep, on inferred gravel. 7) Encountered inferred weathered bedrock at approximately 39.2' deep based on split spoon resistance. Roller bit penetration slowed to approximately 1 inch in 5 minutes at approximately 41' deep on inferred top of competent rock. Began rock core at 41' deep. 8) Used reduced drilling RPM and pressure for entire rock core. Encountered oscillations of drill string below 48' deep, most pronounced from 50' to 51' deep, where driller had to pause every 10 to 30 seconds to correct. 9) Grouted borehole with 1 bag portland cement, 1/2 bag bentonite powder, and 40 gallons water. Topped off borehole with approximately 3 inches of cold patch asphalt at the ground surface. 10) All visual descriptions are per the Burmister classification system. All lab gradations are per the AASHTO M 145 classification system.										
70												
75												
80												
85												

GEODESIGN BORING LOG 750-09.13 RICHFORD VTRANS.GPJ VERMONT AOT.GDT 10/9/13

Notes:  
1. Stratification lines represent approximate boundary between material types. Transition may be gradual.  
2. N Values have not been corrected for hammer energy. C_E is the hammer energy correction factor.  
3. Water level readings have been made at times and under conditions stated. Fluctuations of groundwater may occur due to other factors than those present at the time measurements were made.

PROJECT NAME:	RICHFORD
PROJECT NUMBER:	BRF 0302(29)
FILE NAME:	st2j158bor.dgn
PROJECT LEADER:	C. CARLSON
DESIGNED BY:	H. SALLS
BORING LOGS 2	
PLOT DATE:	11-DEC-2014
DRAWN BY:	R. PELLETT
CHECKED BY:	H. SALLS
SHEET	16 OF 36

VTTrans		STATE OF VERMONT AGENCY OF TRANSPORTATION MATERIALS & RESEARCH SECTION SUBSURFACE INFORMATION		BORING LOG		Boring No.: <u>B-2</u>						
				Richford BRF 0302(29) Richford, VT GeoDesign # 750-09.13		Page No.: <u>1 of 2</u>						
						Pin No.: <u>12j158</u>						
						Checked By: <u>JFW</u>						
Boring Crew: J. Leonhardt (TransTech), A. Baribault (GeoDesign)		Casing		Sampler		Groundwater Observations ⁽³⁾						
Date Started: <u>9/09/13</u> Date Finished: <u>9/09/13</u>		Type: <u>FJ</u>		SS		Date Depth Notes						
VTSPG NAD83: <u>N 909686.67 ft E 1592603.64 ft</u>		I.D.: <u>4 in</u>		<u>2 in</u>		09/09/13 Not recorded.						
Station: <u>44+15</u> Offset: <u>5' R</u>		Hammer Wt: <u>140 lb.</u>		<u>140 lb.</u>								
Ground Elevation: <u>436.5 ft</u>		Hammer Fall: <u>30 in.</u>		<u>30 in.</u>								
		Hammer/Rod Type: <u>Auto/NWJ</u>										
		Rig: <u>CME 550X ATV</u>		<u>C_E = ~1.5</u>								
Depth (ft)	Strata ⁽¹⁾	CLASSIFICATION OF MATERIALS (Description)	Run (Dip deg.)	Cone Rec. % (RQD %)	Drill Rate minutes/ft	Blows/6" (N Value) ⁽²⁾	Moisture Content %	Gravel %	Sand %	Fines %	LL %	PI %
0		6" Asphalt										
0-5	X X X X	Inferred Fill										
5-9	X X X X	Inferred Boulder / Cobble										
9-10	X X X X	Inferred Fill										
10-13	X X X X	S1 (9' to 11'): Medium dense, brown fine to coarse SAND and fine to coarse GRAVEL, little Silt, wet. Rec. = 0.83 ft (AASHTO M145 Classification: A-1-b.)				4-9-16-14	11.3	50.1	32.3	17.6	NP	NP
13-15	X X X X	Inferred Possible Fill										
15-17	X X X X	Inferred Silt / Sand										
17-20	X X X X	Inferred Glacial Till										
Notes: 1. Stratification lines represent approximate boundary between material types. Transition may be gradual. 2. N Values have not been corrected for hammer energy. C _E is the hammer energy correction factor. 3. Water level readings have been made at times and under conditions stated. Fluctuations of groundwater may occur due to other factors than those present at the time measurements were made.												

BOTTOM OF FOOTING  
ELEV 420.00

GEODESIGN BORING LOG 750-09.13 RICHFORD VTRANS.GPJ VERMONT AOT.GDT 10/9/13

VTTrans		STATE OF VERMONT AGENCY OF TRANSPORTATION MATERIALS & RESEARCH SECTION SUBSURFACE INFORMATION		BORING LOG		Boring No.: <u>B-2</u>						
				Richford BRF 0302(29) Richford, VT GeoDesign # 750-09.13		Page No.: <u>2 of 2</u>						
						Pin No.: <u>12j158</u>						
						Checked By: <u>JFW</u>						
Boring Crew: J. Leonhardt (TransTech), A. Baribault (GeoDesign)		Casing		Sampler		Groundwater Observations ⁽³⁾						
Date Started: <u>9/09/13</u> Date Finished: <u>9/09/13</u>		Type: <u>FJ</u>		SS		Date Depth Notes						
VTSPG NAD83: <u>N 909686.67 ft E 1592603.64 ft</u>		I.D.: <u>4 in</u>		<u>2 in</u>		09/09/13 Not recorded.						
Station: <u>44+15</u> Offset: <u>5' R</u>		Hammer Wt: <u>140 lb.</u>		<u>140 lb.</u>								
Ground Elevation: <u>436.5 ft</u>		Hammer Fall: <u>30 in.</u>		<u>30 in.</u>								
		Hammer/Rod Type: <u>Auto/NWJ</u>										
		Rig: <u>CME 550X ATV</u>		<u>C_E = ~1.5</u>								
Depth (ft)	Strata ⁽¹⁾	CLASSIFICATION OF MATERIALS (Description)	Run (Dip deg.)	Cone Rec. % (RQD %)	Drill Rate minutes/ft	Blows/6" (N Value) ⁽²⁾	Moisture Content %	Gravel %	Sand %	Fines %	LL %	PI %
0		6" Asphalt										
0-5	X X X X	Inferred Fill										
5-9	X X X X	Inferred Boulder / Cobble										
9-10	X X X X	Inferred Fill										
10-13	X X X X	S1 (9' to 11'): Medium dense, brown fine to coarse SAND and fine to coarse GRAVEL, little Silt, wet. Rec. = 0.83 ft (AASHTO M145 Classification: A-1-b.)				4-9-16-14	11.3	50.1	32.3	17.6	NP	NP
13-15	X X X X	Inferred Possible Fill										
15-17	X X X X	Inferred Silt / Sand										
17-20	X X X X	Inferred Glacial Till										
40-43.5	C1	C1 (40' to 43.5'): Poor quality, moderately hard, silver-gray-green PHYLLITE. Fractures at approximately 60 to 90 degrees.		67 (33)	2.3							
43.5-45		Hole stopped @ 43.5 ft										
Remarks: 1) Hammer efficiency correction factor is assumed. Strata breaks and composition are inferred from roller bit and casing resistance observed during borehole advance and soil samples collected in nearby Borings B-1 and B-4. Elevation, station and offset are estimated by GeoDesign from site plans provided by VTTrans and taped measurements from existing features made in the field by GeoDesign personnel. They should be considered accurate only to the degree implied by the method of location used. 2) Drove casing to near refusal at approximately 7' deep and cleaned out with roller bit. Return water brown, except gray/greenish-gray from 7' to 7.5' deep. Casing drove at approximately 100 to 200 blows per inch from 7' to 7.3' deep. 3) Inferred gravel fill to 5' deep. Infer elevated gravel content from 5' to 9' deep based on roller bit grinding. Inferred cobble/boulder at 7' to 7.5' deep. 4) Infer strata change between 13' and 15' deep due to decrease in resistance and grinding during casing and roller bit advance from 13' to 14' deep and a change in wash water color to gray between 14' and 15' deep. 5) Infer strata change to glacial till at 17' deep based on increased roller bit resistance. Note quartz gravel in the return water. 6) Encountered inferred gravel within the soil matrix based on roller bit resistance at 26', 27.5', 28.5', 30', 33', 34', 35', and 37.5' deep. Encountered roller bit refusal at 40' deep on inferred competent bedrock. 7) Lowered drilling RPM while coring at 42.5' deep due to rig oscillations. Water hose burst while advancing core barrel at 43.5' deep. Terminated boring at 43.5' deep. 8) Borehole backfilled with winter sand mix and topped with approximately 3 inches of cold patch asphalt at the ground surface. 9) All visual descriptions are per the Burmister classification system. All lab gradations are per the AASHTO M 145 classification system.												
Notes: 1. Stratification lines represent approximate boundary between material types. Transition may be gradual. 2. N Values have not been corrected for hammer energy. C _E is the hammer energy correction factor. 3. Water level readings have been made at times and under conditions stated. Fluctuations of groundwater may occur due to other factors than those present at the time measurements were made.												

GEODESIGN BORING LOG 750-09.13 RICHFORD VTRANS.GPJ VERMONT AOT.GDT 10/9/13

PROJECT NAME:	RICHFORD
PROJECT NUMBER:	BRF 0302(29)
FILE NAME:	s12j158bor.dgn
PROJECT LEADER:	C. CARLSON
DESIGNED BY:	H. SALLS
BORING LOGS	3
PLOT DATE:	11-DEC-2014
DRAWN BY:	R. PELLETT
CHECKED BY:	H. SALLS
SHEET	17 OF 36

VT Trans		STATE OF VERMONT AGENCY OF TRANSPORTATION MATERIALS & RESEARCH SECTION SUBSURFACE INFORMATION		BORING LOG		Boring No.: <u>B-3</u>					
				Richford BRF 0302(29) Richford, VT GeoDesign # 750-09.13		Page No.: <u>1 of 3</u>					
						Pin No.: <u>12j158</u>					
						Checked By: <u>JFW</u>					
Boring Crew: J. Leonhardt (TransTech), A. Baribault (GeoDesign)		Casing		Sampler		Groundwater Observations ⁽³⁾					
Date Started: <u>9/05/13</u> Date Finished: <u>9/06/13</u>		Type: <u>FJ</u>		N.A.		Date					
VTSPG NAD83: <u>N 909729.53 ft E 1592615.18 ft</u>		I.D.: <u>4 in</u>		<u>2 in</u>		Depth (ft)					
Station: <u>44+58</u> Offset: <u>6' L</u>		Hammer Wt: <u>140 lb.</u>		<u>N.A.</u>		Notes					
Ground Elevation: <u>437 ft</u>		Hammer Fall: <u>30 in.</u>		<u>N.A.</u>		09/06/13 9.7 In casing (15 hrs.)					
		Hammer/Rod Type: <u>Auto/NWJ</u>									
		Rig: <u>CME 550X ATV</u>		<u>C_E = -1.5</u>							
Depth (ft)	Strata ⁽¹⁾	CLASSIFICATION OF MATERIALS (Description)		Run (Dip deg.)	Core Rec. % (RQD %)	Drill Rate minutes/ft	Blows/6" (N Value) ⁽²⁾	Moisture Content %	Gravel %	Sand %	Fines %
0		6" Asphalt									
0-5	X X X X	Inferred Fill									
5-10	X X X X	Inferred Silt/Sand									
10-20	X X X X	Inferred Glacial Till									
20-50	X X X X	Inferred Glacial Till									
50		Hole stopped @ 50.0 ft									
55		Remarks: 1) Hammer efficiency correction factor is assumed. Strata breaks and composition are inferred from roller bit and casing resistance observed during borehole advance and soil samples collected in nearby Borings B-1 and B-4. Elevation, station and offset are estimated by GeoDesign from site plans provided by VTrans and taped measurements from existing features made in the field by GeoDesign personnel. They should be considered accurate only to the degree implied by the method of location used. 2) Casing driven to 8' deep. Note advancement rate slowed considerably at approximately 7.7' deep. 3) Wash water observed to be grayish-brown in color from surface to 12' deep before turning gray below 12' deep. 4) Noted grinding of roller bit from approximately 7.5' to 8.5' deep on inferred gravel. 5) Infer strata change to Silt / Sand at 8.5' deep due to significant increase in bit advancement rate. 6) Infer strata change to glacial till due to decrease in bit advancement rate at 17' deep. 7) Note decrease in advancement rate at 22' deep through inferred dense glacial till soils. Consistent, slow rate from 22' to 41.5' deep, with an increase from 41.5' to 43.5' deep									
Notes: 1. Stratification lines represent approximate boundary between material types. Transition may be gradual. 2. N Values have not been corrected for hammer energy. C _e is the hammer energy correction factor. 3. Water level readings have been made at times and under conditions stated. Fluctuations of groundwater may occur due to other factors than those present at the time measurements were made.											


BOTTOM OF FOOTING  
ELEV 420.00

GEODESIGN BORING LOG 750-09.13 RICHFORD VTRANS.GPJ VERMONT AOT.GDT 10/9/13

VT Trans		STATE OF VERMONT AGENCY OF TRANSPORTATION MATERIALS & RESEARCH SECTION SUBSURFACE INFORMATION		BORING LOG		Boring No.: <u>B-3</u>					
				Richford BRF 0302(29) Richford, VT GeoDesign # 750-09.13		Page No.: <u>2 of 3</u>					
						Pin No.: <u>12j158</u>					
						Checked By: <u>JFW</u>					
Boring Crew: J. Leonhardt (TransTech), A. Baribault (GeoDesign)		Casing		Sampler		Groundwater Observations ⁽³⁾					
Date Started: <u>9/05/13</u> Date Finished: <u>9/06/13</u>		Type: <u>FJ</u>		N.A.		Date					
VTSPG NAD83: <u>N 909729.53 ft E 1592615.18 ft</u>		I.D.: <u>4 in</u>		<u>2 in</u>		Depth (ft)					
Station: <u>44+58</u> Offset: <u>6' L</u>		Hammer Wt: <u>140 lb.</u>		<u>N.A.</u>		Notes					
Ground Elevation: <u>437 ft</u>		Hammer Fall: <u>30 in.</u>		<u>N.A.</u>		09/06/13 9.7 In casing (15 hrs.)					
		Hammer/Rod Type: <u>Auto/NWJ</u>									
		Rig: <u>CME 550X ATV</u>		<u>C_E = -1.5</u>							
Depth (ft)	Strata ⁽¹⁾	CLASSIFICATION OF MATERIALS (Description)		Run (Dip deg.)	Core Rec. % (RQD %)	Drill Rate minutes/ft	Blows/6" (N Value) ⁽²⁾	Moisture Content %	Gravel %	Sand %	Fines %
0		6" Asphalt									
0-5	X X X X	Inferred Fill									
5-10	X X X X	Inferred Silt/Sand									
10-20	X X X X	Inferred Glacial Till									
20-45	X X X X	Inferred Glacial Till									
45-50	X X X X	C1 (45' to 50'): Poor quality, moderately hard, fine grained, silvery gray-green with white GNEISS. With occasional Quartz bedding. Fractures between 30 and 70 degrees from horizontal.		C1	72 (38)	2.25					
50		Hole stopped @ 50.0 ft									
55		Remarks: 1) Hammer efficiency correction factor is assumed. Strata breaks and composition are inferred from roller bit and casing resistance observed during borehole advance and soil samples collected in nearby Borings B-1 and B-4. Elevation, station and offset are estimated by GeoDesign from site plans provided by VTrans and taped measurements from existing features made in the field by GeoDesign personnel. They should be considered accurate only to the degree implied by the method of location used. 2) Casing driven to 8' deep. Note advancement rate slowed considerably at approximately 7.7' deep. 3) Wash water observed to be grayish-brown in color from surface to 12' deep before turning gray below 12' deep. 4) Noted grinding of roller bit from approximately 7.5' to 8.5' deep on inferred gravel. 5) Infer strata change to Silt / Sand at 8.5' deep due to significant increase in bit advancement rate. 6) Infer strata change to glacial till due to decrease in bit advancement rate at 17' deep. 7) Note decrease in advancement rate at 22' deep through inferred dense glacial till soils. Consistent, slow rate from 22' to 41.5' deep, with an increase from 41.5' to 43.5' deep									
Notes: 1. Stratification lines represent approximate boundary between material types. Transition may be gradual. 2. N Values have not been corrected for hammer energy. C _e is the hammer energy correction factor. 3. Water level readings have been made at times and under conditions stated. Fluctuations of groundwater may occur due to other factors than those present at the time measurements were made.											

GEODESIGN BORING LOG 750-09.13 RICHFORD VTRANS.GPJ VERMONT AOT.GDT 10/9/13

PROJECT NAME:	RICHFORD	PLOT DATE:	11-DEC-2014
PROJECT NUMBER:	BRF 0302(29)	DRAWN BY:	R. PELLET
FILE NAME:	st2j158bor.dgn	CHECKED BY:	H. SALLS
PROJECT LEADER:	C. CARLSON	SHEET	18 OF 36
DESIGNED BY:	H. SALLS		
BORING LOGS 4			

 STATE OF VERMONT AGENCY OF TRANSPORTATION MATERIALS & RESEARCH SECTION SUBSURFACE INFORMATION		<b>BORING LOG</b>		Boring No.: <b>B-3</b>						
		<b>Richford BRF 0302(29)</b> <b>Richford, VT</b> <b>GeoDesign # 750-09.13</b>		Page No.: <b>3 of 3</b>						
Boring Crew: J. Leonhardt (TransTech), A. Baribault (GeoDesign) Date Started: 9/05/13 Date Finished: 9/06/13 VTSPG NAD83: N 909729.53 ft E 1592615.18 ft Station: 44+58 Offset: 6' L Ground Elevation: 437 ft		Casing Type: FJ I.D.: 4 in Sampler Type: N.A. I.D.: 2 in Hammer Wt: 140 lb Hammer Fall: 30 in Hammer/Rod Type: Auto/NWJ Rig: CME 550X ATV $C_E = \sim 1.5$	Groundwater Observations ⁽³⁾ Date: 09/06/13 Depth (ft): 9.7 Notes: In casing (15 hrs.)							
Depth (ft)	Strata ⁽¹⁾	CLASSIFICATION OF MATERIALS (Description)	Run (Dip deg)	Core Rec. % (RCD %)	Drill Rate minutes/ft	Blows/6" (N Value) ⁽²⁾	Moisture Content %	Gravel %	Sand %	Fines %
65		8) Inferred gravelly zones within the glacial till matrix based on drilling resistance / behavior from 31' to 31.5' deep, 38' to 38.5' deep, and 43.5' to 44' deep. 9) Borehole backfilled with winter sand mix and topped with approximately 3 inches of cold patch asphalt at the ground surface. 10) All visual descriptions are per the Burmister classification system.								
70										
75										
80										
85										
Notes: 1. Stratification lines represent approximate boundary between material types. Transition may be gradual. 2. N Values have not been corrected for hammer energy. $C_E$ is the hammer energy correction factor. 3. Water level readings have been made at times and under conditions stated. Fluctuations of groundwater may occur due to other factors than those present at the time measurements were made.										

GEODESIGN BORING LOG 750-09.13 RICHFORD VTRANS.GPJ VERMONT AOT.GDT 10/9/13

PROJECT NAME:	RICHFORD
PROJECT NUMBER:	BRF 0302(29)
FILE NAME:	st2j158bor.dgn
PROJECT LEADER:	C. CARLSON
DESIGNED BY:	H. SALLS
BORING LOGS	5
PLOT DATE:	11-DEC-2014
DRAWN BY:	R. PELLETT
CHECKED BY:	H. SALLS
SHEET	19 OF 36

VT		STATE OF VERMONT AGENCY OF TRANSPORTATION MATERIALS & RESEARCH SECTION SUBSURFACE INFORMATION		BORING LOG		Boring No.: <u>B-4</u>						
		Richford BRF 0302(29) Richford, VT GeoDesign # 750-09.13		Page No.: <u>1 of 3</u>		Pin No.: <u>12j158</u>						
		Checked By: <u>JFW</u>		Groundwater Observations ⁽³⁾								
Boring Crew: J. Leonhardt (TransTech), A. Baribault (GeoDesign)		Type: <u>FJ</u>		Casing		Sampler						
Date Started: <u>9/03/13</u> Date Finished: <u>9/04/13</u>		I.D.: <u>4 in</u>		<u>4 in</u>		<u>SS</u>						
VTSPG NAD83: <u>N 909724.13 ft E 1592624.76 ft</u>		Hammer Wt: <u>140 lb.</u>		<u>140 lb.</u>		Date						
Station: <u>44+58</u> Offset: <u>5' R</u>		Hammer Fall: <u>30 in.</u>		<u>30 in.</u>		Depth (ft)						
Ground Elevation: <u>437 ft</u>		Hammer/Rod Type: <u>Auto/NWJ</u>		<u>Auto/NWJ</u>		Notes						
		Rig: <u>CME 550X ATV</u>		<u>C_E = ~1.5</u>								
Depth (ft)	Strata (1)	CLASSIFICATION OF MATERIALS (Description)	Run (Dip deg.)	Cone Rec. % (RQD %)	Drill Rate minutes/ft	Blows/6" (N Value) ⁽²⁾	Moisture Content %	Gravel %	Sand %	Fines %	LL %	PI %
		6" Asphalt										
5		S1 (0.5' to 2'): Medium dense, tan fine to coarse SAND, little fine Gravel, little Silt, slightly moist. (Roadbase Fill) Rec. = 1.08 ft (AASHTO M145 Classification: A-1-b.)				8-15-14 (29)	4.7	29.3	51.9	18.8	NP	NP
		S2 (2' to 4'): Medium dense, brown fine to coarse SAND, some fine to coarse Gravel, some Silt, moist. (Subbase Fill) Rec. = 1.0 ft (AASHTO M145 Classification: A-1-b.)				11-9-7-6 (16)	8.0	42.5	35.7	21.8	NP	NP
		S3 (4' to 6'): Loose, brown fine to coarse SAND, some Silt, little fine Gravel, moist. (Possible Fill) Rec. = 0.67 ft (AASHTO M145 Classification: A-2-4.)				3-2-3-2 (5)	16.0	26.1	52.5	21.4	NP	NP
		S4 (6' to 8'): Loose, brown and gray fine to coarse SAND, some Silt, trace fine Gravel, very moist. (Possible Fill) Rec. = 1.08 ft (AASHTO M145 Classification: A-2-4.)				4-3-1-3 (4)	23.2	8.5	59.4	32.1	NP	NP
10		S5 (9' to 11'): Loose, gray SILT, little fine to coarse Sand, trace fine Gravel (concentrated in top of sample), wet. (Silt / Sand) Rec. = 1.17 ft (AASHTO M145 Classification: A-4.)				3-3-2-4 (5)	25.1	9.6	4.2	86.2	22	1
		S6 (11' to 13'): Medium dense, gray SILT, some Clayey Silt, trace fine Sand, wet. (Silt / Sand) Rec. = 1.67 ft (AASHTO M145 Classification: A-4.)				4-6-5-6 (11)	27.9		1.3	98.7	25	6
15		S7 (14' to 16'): Loose, gray SILT and Clayey SILT (laminated), trace fine Sand, wet. (Silt / Sand) Rec. = 1.67 ft (AASHTO M145 Classification: A-4.)				3-4-3-3 (7)	28.9		1.0	99.0	24	5
		S8A (16' to 17') - Upper 8" of S8: Medium dense, gray SILT, trace Clayey Silt, trace fine Sand, wet. (Silt / Sand) Rec. = 1.0 ft (AASHTO M145 Classification: A-4.)				3-2-8-10 (10)	27.4		2.7	97.3	22	2
		S8B (17' to 18') - Lower 4" of S8: Medium dense, gray fine to coarse SAND, some Silt, some fine Gravel, wet. (Glacial Till) (AASHTO M145 Classification: A-2-4.)					9.9	41.0	30.6	28.4	NP	NP
20		S9 (19' to 21'): Dense, gray fine to coarse SAND, some fine to coarse Gravel, some Silt, moist to wet. (Glacial Till) Rec. = 1.33 ft (AASHTO M145 Classification: A-2-4.)				9-16-20-26 (36)	9.3	35.3	34.2	30.5	NP	NP
		S10 (21' to 23'): Very dense, gray/green fine to coarse SAND and SILT, some fine Gravel, moist to wet. (Glacial Till) Rec. = 1.25 ft (AASHTO M145 Classification: A-2-4.)				24-29-27-28 (56)	10.0	32.7	32.0	35.3	NP	NP
25		S11 (24' to 24.4'): Refusal, gray SILT and fine to coarse SAND, some fine to coarse Gravel, moist to wet. (Glacial Till) Rec. = 0.42 ft (AASHTO M145 Classification: A-4.)				80/5.5" (R)	9.1	29.7	32.5	37.8	NP	NP
		S12 (29' to 29.4'): Refusal, gray SILT and fine to coarse Sand, trace fine Gravel, moist. (Glacial Till) Rec. = 0.42 ft				80/5.5" (R)	9.7	14.4	33.8	51.8	NP	NP

Notes:  
1. Stratification lines represent approximate boundary between material types. Transition may be gradual.  
2. N Values have not been corrected for hammer energy. C_E is the hammer energy correction factor.  
3. Water level readings have been made at times and under conditions stated. Fluctuations of groundwater may occur due to other factors than those present at the time measurements were made.

BOTTOM OF FOOTING  
ELEV 420.00

GEODESIGN BORING LOG 750-09.13 RICHFORD VTRANS.GPJ VERMONT AOT.GDT 10/09/13

VT		STATE OF VERMONT AGENCY OF TRANSPORTATION MATERIALS & RESEARCH SECTION SUBSURFACE INFORMATION		BORING LOG		Boring No.: <u>B-4</u>						
		Richford BRF 0302(29) Richford, VT GeoDesign # 750-09.13		Page No.: <u>2 of 3</u>		Pin No.: <u>12j158</u>						
		Checked By: <u>JFW</u>		Groundwater Observations								
Boring Crew: J. Leonhardt (TransTech), A. Baribault (GeoDesign)		Type: <u>FJ</u>		Casing		Sampler						
Date Started: <u>9/03/13</u> Date Finished: <u>9/04/13</u>		I.D.: <u>4 in</u>		<u>4 in</u>		<u>SS</u>						
VTSPG NAD83: <u>N 909724.13 ft E 1592624.76 ft</u>		Hammer Wt: <u>140 lb.</u>		<u>140 lb.</u>		Date						
Station: <u>44+58</u> Offset: <u>5' R</u>		Hammer Fall: <u>30 in.</u>		<u>30 in.</u>		Depth (ft)						
Ground Elevation: <u>437.0 ft</u>		Hammer/Rod Type: <u>Auto/NWJ</u>		<u>Auto/NWJ</u>		Notes						
		Rig: <u>CME 550X ATV</u>		<u>C_E = ~1.5</u>								
Depth (ft)	Strata (1)	CLASSIFICATION OF MATERIALS (Description)	Run (Dip deg.)	Cone Rec. % (RQD %)	Drill Rate minutes/ft	Blows/6" (N Value) ⁽²⁾	Moisture Content %	Gravel %	Sand %	Fines %	LL %	PI %
		(AASHTO M145 Classification: A-4.)										
35		S13 (34' to 34.3'): Refusal, gray SILT, some fine to coarse Sand, some fine to coarse Gravel (fractured, platelike), moist. (Glacial Till) Rec. = 0.33 ft (AASHTO M145 Classification: A-4.)				80/4" (R)	9.3	29.0	26.9	44.1	NP	NP
40		S14 (39' to 39.2'): Refusal, gray and white SILT, some fine to coarse Gravel, some fine to coarse Sand, moist. (Glacial Till) Rec. = 0.25 ft (AASHTO M145 Classification: A-4.)				100/3" (R)	8.9	36.5	24.0	39.5	NP	NP
45		S15 (44' to 44.2'): Refusal, gray WEATHERED PHYLLITE. C1 (44' to 49'): Very poor quality, gray to greenish-gray, fine-grained weathered to extremely weathered (majority of core washed away) PHYLLITE, fracture angle estimated at 70 to 90 degrees.	C1	25 (0)	2.5	100/2" (R)						
					4.3							
					3							
					3							
					2							
50		S16 (49' to 49.1'): Refusal, gray WEATHERED PHYLLITE with highly weathered zones. C2 (49' to 54'): Fair quality, greenish-gray fine grained, slightly to moderately weathered PHYLLITE, fracture angle approximately 45 to 70 degrees.	C2	78 (50)	3.5	100/1" (R)						
					2							
					3.8							
					3.5							
					4							
55		C3 (54' to 59'): Poor quality, greenish-gray fine grained, moderately weathered PHYLLITE, fracturing approximately 70 to 90 degrees.	C3	80 (25)	3							
					3.5							
					5							
					7							
					6							
		Hole stopped @ 59.0 ft										

Notes:  
1. Stratification lines represent approximate boundary between material types. Transition may be gradual.  
2. N Values have not been corrected for hammer energy. C_E is the hammer energy correction factor.  
3. Water level readings have been made at times and under conditions stated. Fluctuations of groundwater may occur due to other factors than those present at the time measurements were made.

BORING LOG 750-09.13 RICHFORD VTRANS.GPJ VERMONT AOT.GDT 11/15/13

PROJECT NAME:	RICHFORD
PROJECT NUMBER:	BRF 0302(29)
FILE NAME:	s12j158bor.dgn
PROJECT LEADER:	C. CARLSON
DESIGNED BY:	H. SALLS
BORING LOGS 6	
PLOT DATE:	11-DEC-2014
DRAWN BY:	R. PELLETT
CHECKED BY:	H. SALLS
SHEET	20 OF 36



STATE OF VERMONT  
 AGENCY OF TRANSPORTATION  
 MATERIALS & RESEARCH SECTION  
 SUBSURFACE INFORMATION

**BORING LOG**

**Richford BRF 0302(29)**  
**Richford, VT**  
**GeoDesign # 750-09.13**

Boring No.: **B-4**  
 Page No.: **3 of 3**  
 Pin No.: **12j158**  
 Checked By: **JFW**


Boring Crew: J. Leonhardt (TransTech), A. Baribault (GeoDesign)		Casing Type: FJ	Sampler: SS	Groundwater Observations ⁽³⁾		
Date Started: 9/03/13	Date Finished: 9/04/13	I.D.: 4 in	2 in	Date	Depth (ft)	Notes
VTSPG NAD83: N 909724.13 ft E 1592624.76 ft		Hammer Wt: 140 lb.	140 lb.	09/03/13	10.0	Wet sample
Station: 44+58	Offset: 5' R	Hammer Fall: 30 in.	30 in.	09/04/13	9.5	In Casing
Ground Elevation: 437 ft		Hammer/Rod Type: Auto/NWJ				
		Rig: CME 550X ATV	C _E = ~1.5			

Depth (ft)	Strata ⁽¹⁾	CLASSIFICATION OF MATERIALS (Description)	Run (Dip deg.)	Cone Rec. % (RQD %)	Drill Rate minutes/ft	Blows/ft ⁽²⁾ (N Value ⁽²⁾ )	Moisture Content %	Gravel %	Sand %	Fines %	LL %	PI %
65		Remarks: 1) Hammer efficiency correction factor is assumed. Elevation, station and offset are estimated by GeoDesign from site plans provided by VTrans and taped measurements from existing features made in the field by GeoDesign personnel. They should be considered accurate only to the degree implied by the method of location used. 2) Samples S2 and S4 were not performed in accordance with ASTM D1586, (samples taken immediately after preceding split spoon sample without first clearing the borehole with the roller bit). 3) Soil moisture descriptions may not accurately depict actual conditions due to wash and drive drilling methods. Observe brown return water to approximately 10' deep, then turning gray. 4) Drove casing to 10' deep prior to advancing borehole open hole with the roller bit to 17' deep. At 17' deep encountered gravelly soils resulting in loss of water. Drive casing to 21 feet deep (prior to sampling S10) and advance the remainder of the borehole open hole with the roller bit until beginning coring at 44' deep. 5) Encountered weathered rock in sample S15 at 44' deep. Attempted core from 44' to 49' deep with low recovery / RQD sample obtained. Cleaned hole with roller bit to 49 feet and attempted split spoon. 6) Return water light gray during rock core. Coring times inflated due to drill string oscillation leading to driller using a lower RPM drilling speed and having stop approximately 1 to 4 times per minute to correct, particularly for C2 and C3. 7) Borehole grouted with 1 bag portland cement, 1/2 bag bentonite powder, and 40 gallons water. Topped off borehole with approximately 3 inches of cold patch asphalt at the ground surface. 8) All visual descriptions are per the Burmister classification system. All lab gradations are per the AASHTO M 145 classification system.										
70												
75												
80												
85												


GEODESIGN BORING LOG 750-09.13 RICHFORD VTRANS.GPJ VERMONT AOT.GDT 10/9/13

Notes:  
 1. Stratification lines represent approximate boundary between material types. Transition may be gradual.  
 2. N Values have not been corrected for hammer energy. C_E is the hammer energy correction factor.  
 3. Water level readings have been made at times and under conditions stated. Fluctuations of groundwater may occur due to other factors than those present at the time measurements were made.

PROJECT NAME:	RICHFORD
PROJECT NUMBER:	BRF 0302(29)
FILE NAME:	st2j158bor.dgn
PROJECT LEADER:	C. CARLSON
DESIGNED BY:	H. SALLS
BORING LOGS	7
PLOT DATE:	11-DEC-2014
DRAWN BY:	R. PELLETT
CHECKED BY:	H. SALLS
SHEET	21 OF 36

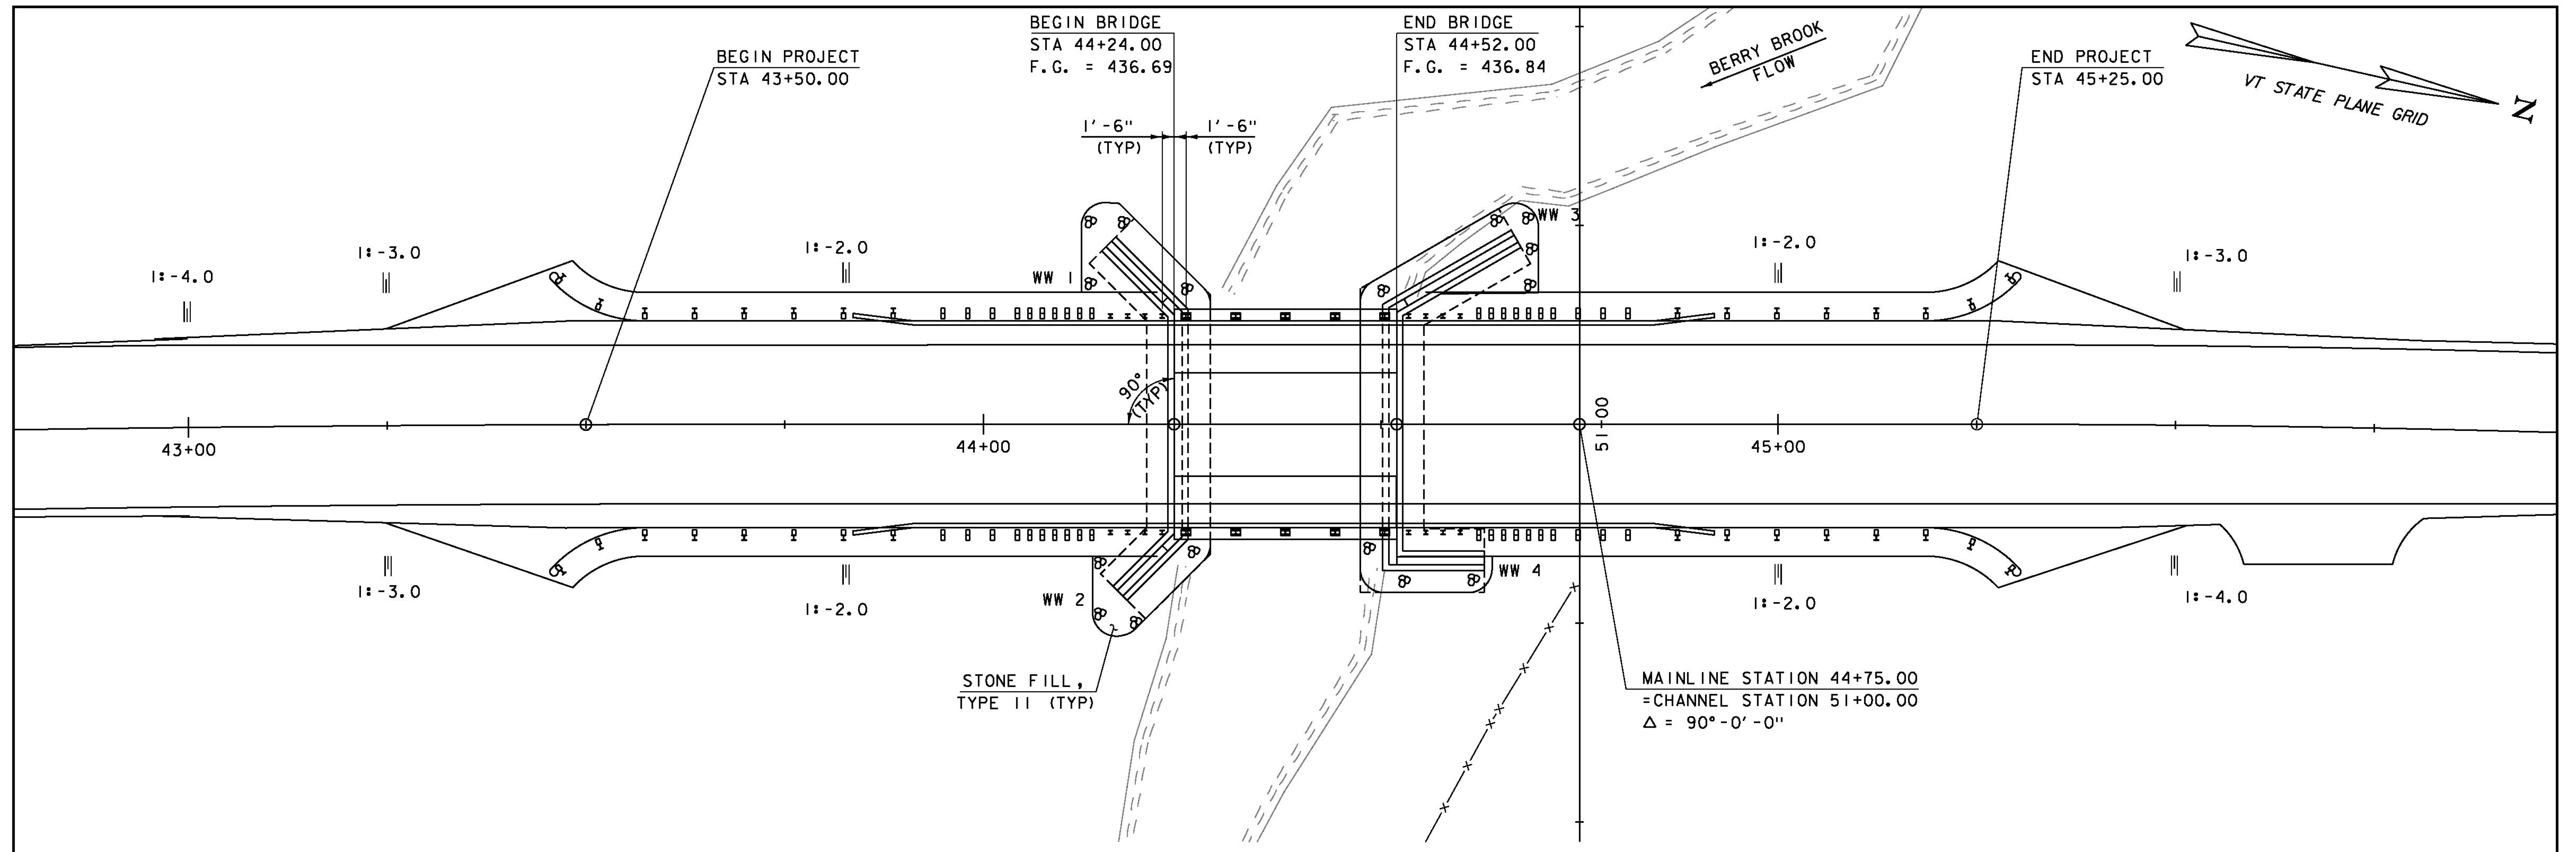

**PLAN**

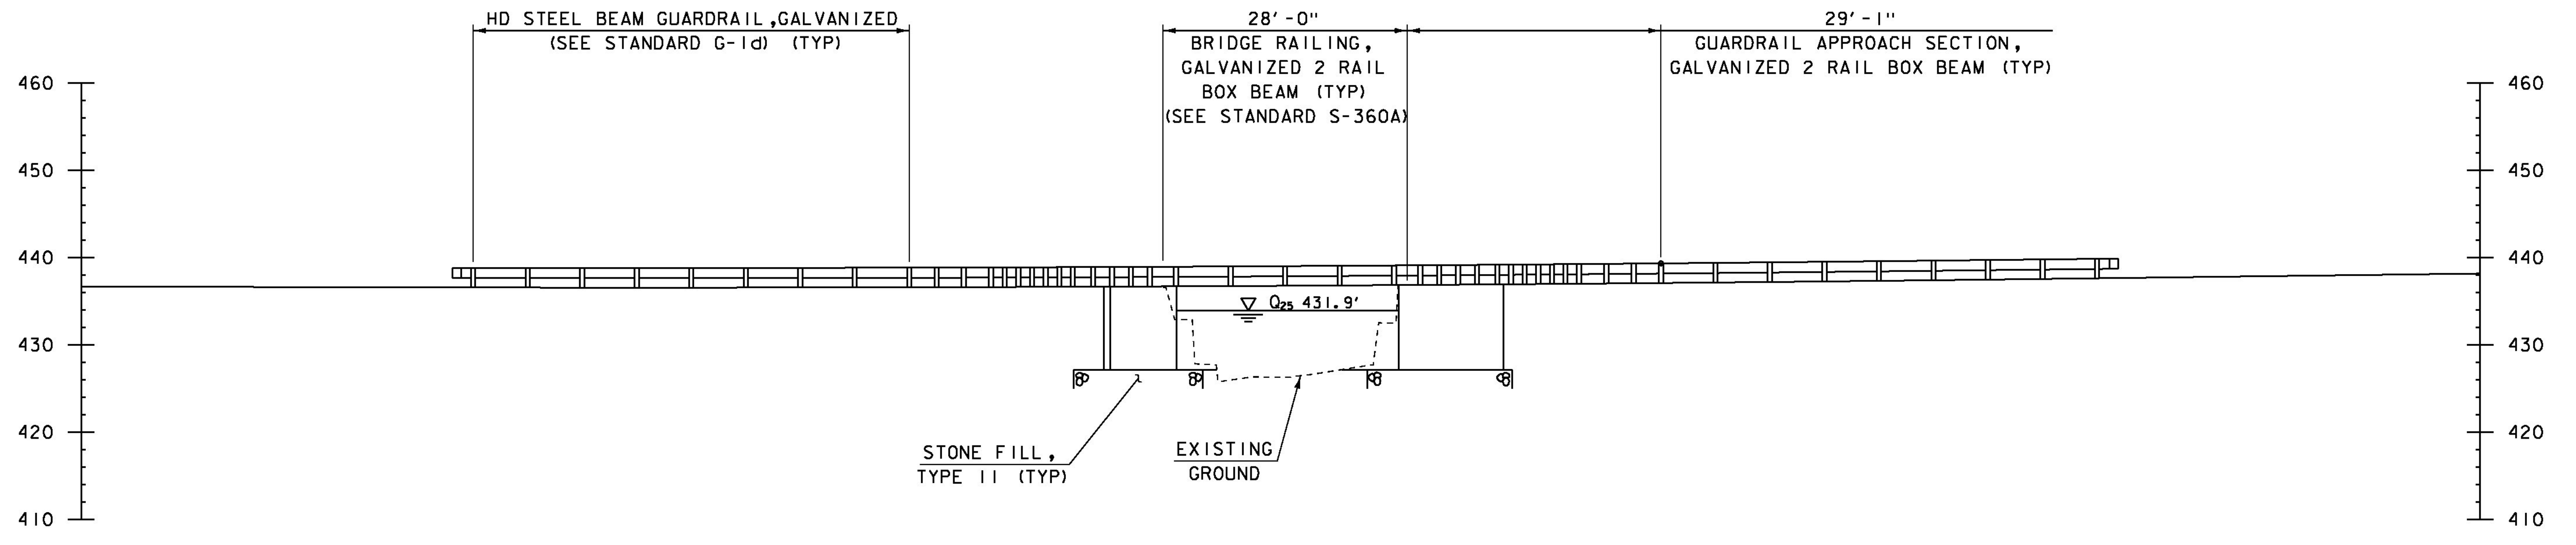


**ELEVATION**

SCALE 1" = 10'-0"  
 10 0 10


PROJECT NAME: RICHFORD	PLOT DATE: 11-DEC-2014
PROJECT NUMBER: BRF 0302(29)	DRAWN BY: R. PELLETT
FILE NAME: s12j158pe.dgn	CHECKED BY: H. SALLS
PROJECT LEADER: C. CARLSON	SHEET 22 OF 36
DESIGNED BY: H. SALLS	
PLAN AND ELEVATION	



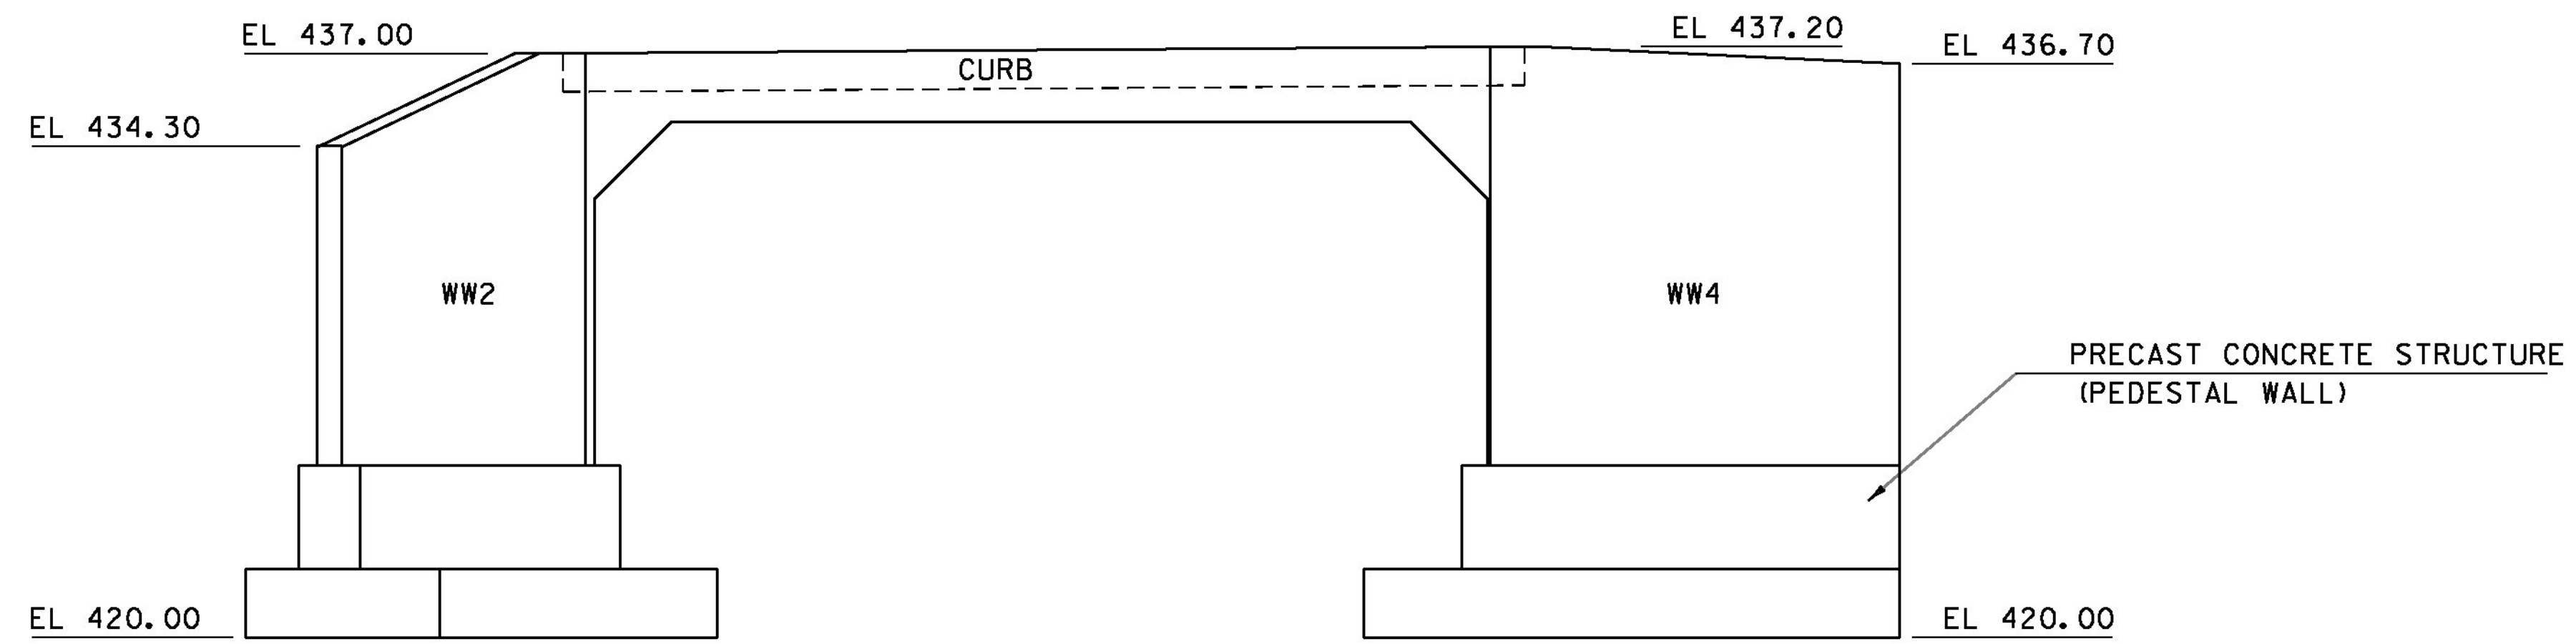

DOWNSTREAM ELEVATION LOOKING UPSTREAM


SCALE 1/4" = 1'-0"

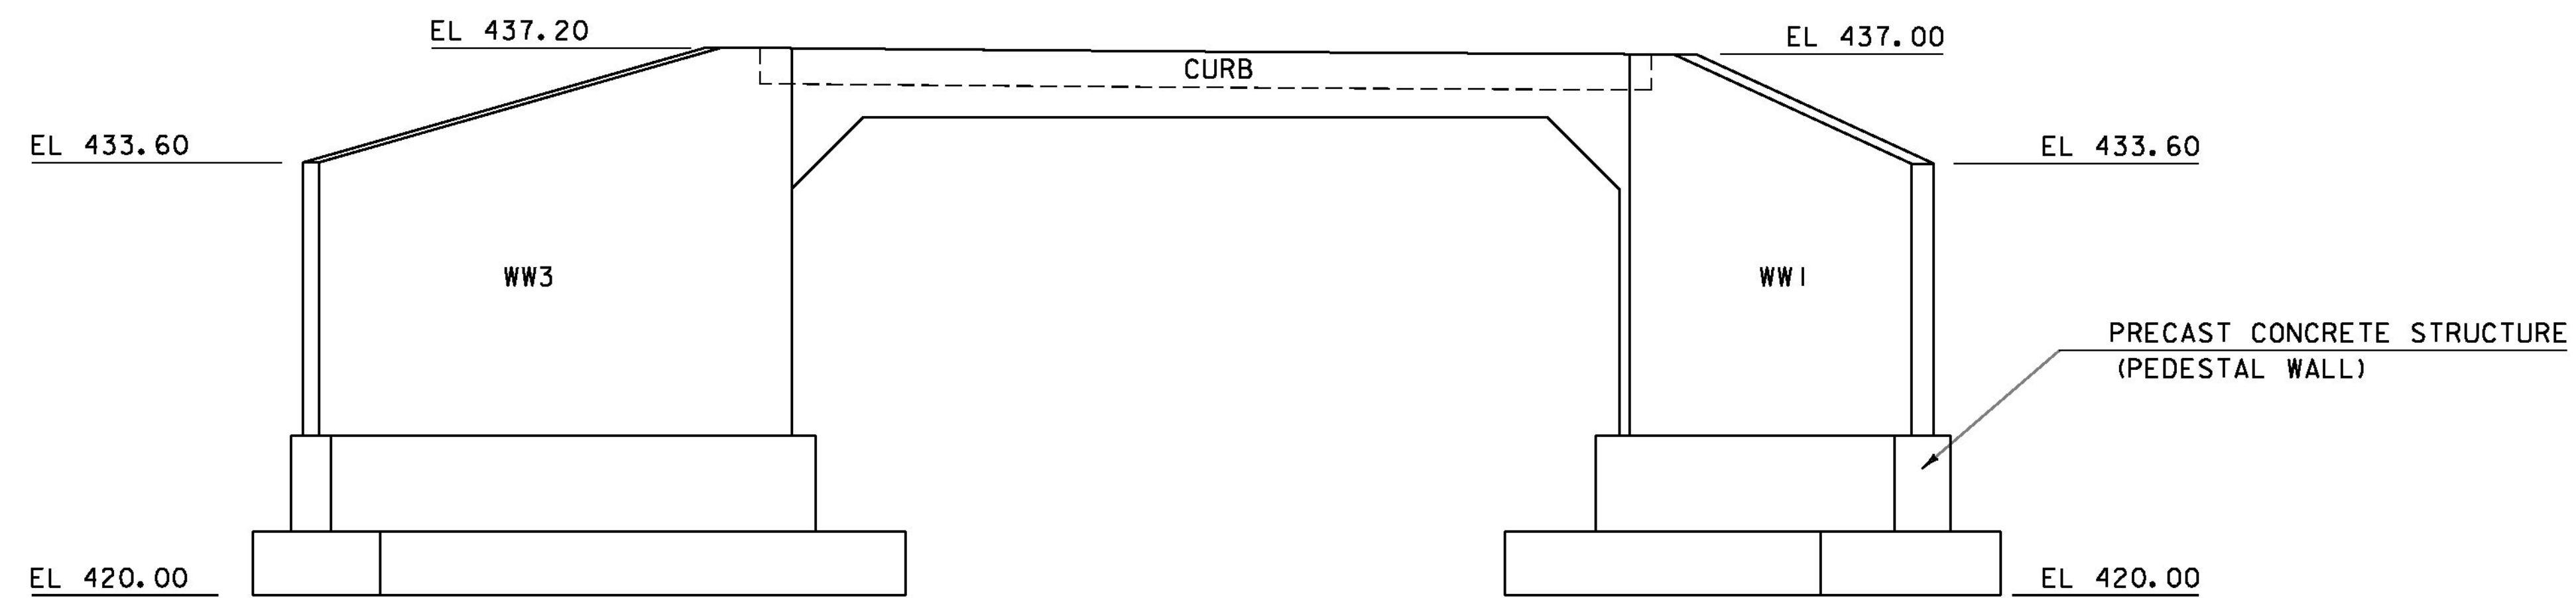


UPSTREAM ELEVATION LOOKING DOWNSTREAM

SCALE 1/4" = 1'-0"


PROJECT NAME:	RICHFORD	PLOT DATE:	11-DEC-2014
PROJECT NUMBER:	BRF 0302(29)	DRAWN BY:	R. PELLETT
FILE NAME:	st2j158sub.dgn	DESIGNED BY:	H. SALLS
PROJECT LEADER:	C. CARLSON	CHECKED BY:	H. SALLS
BRIDGE ELEVATIONS		SHEET	24 OF 36

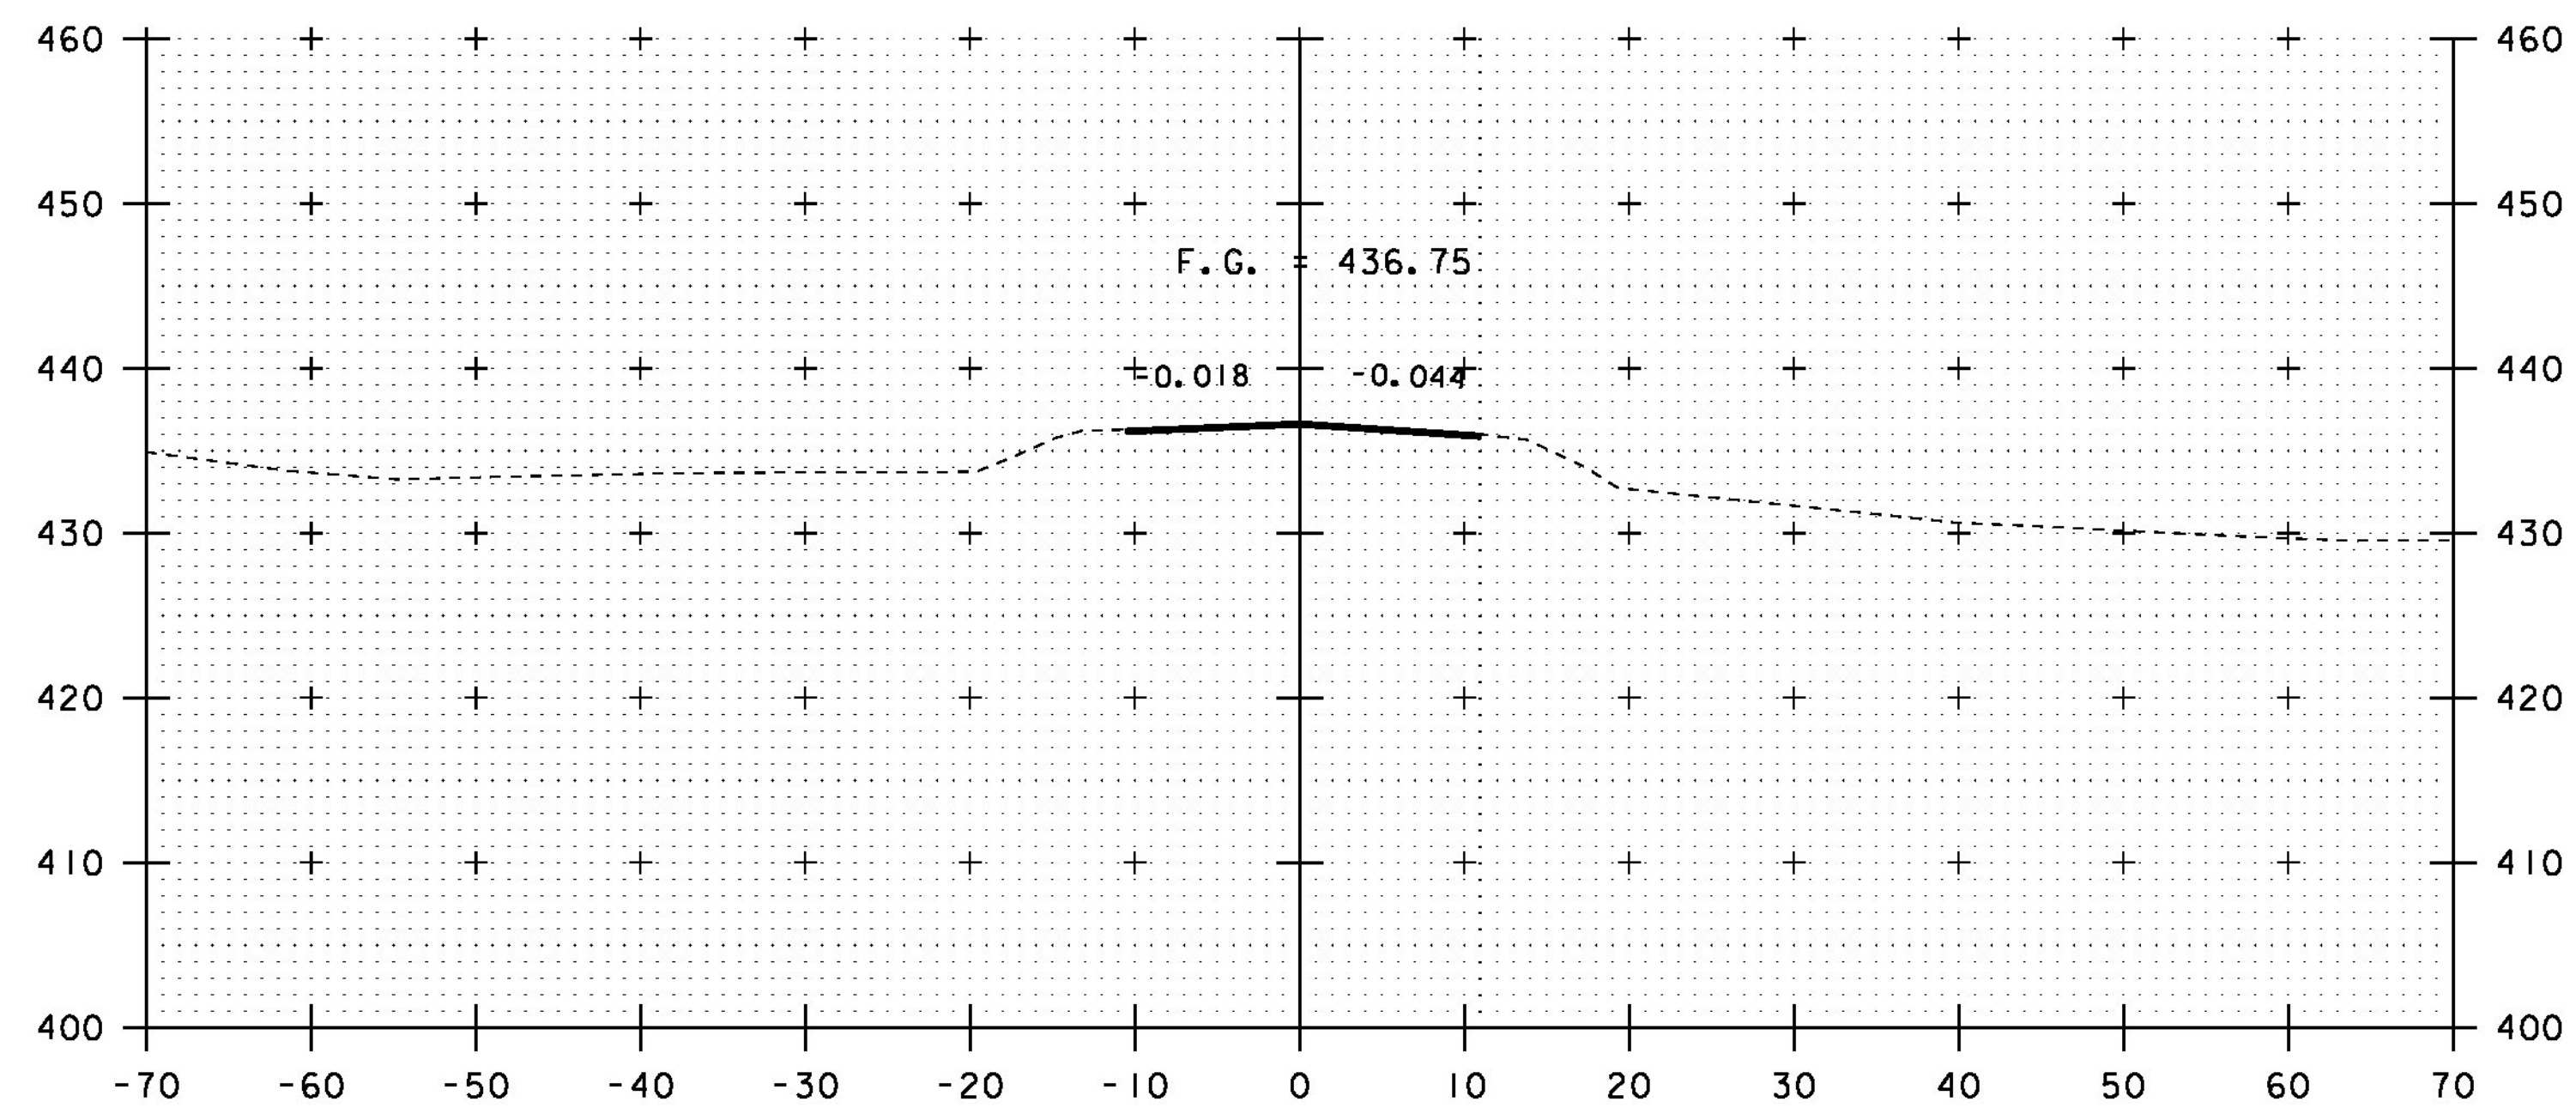


42+75

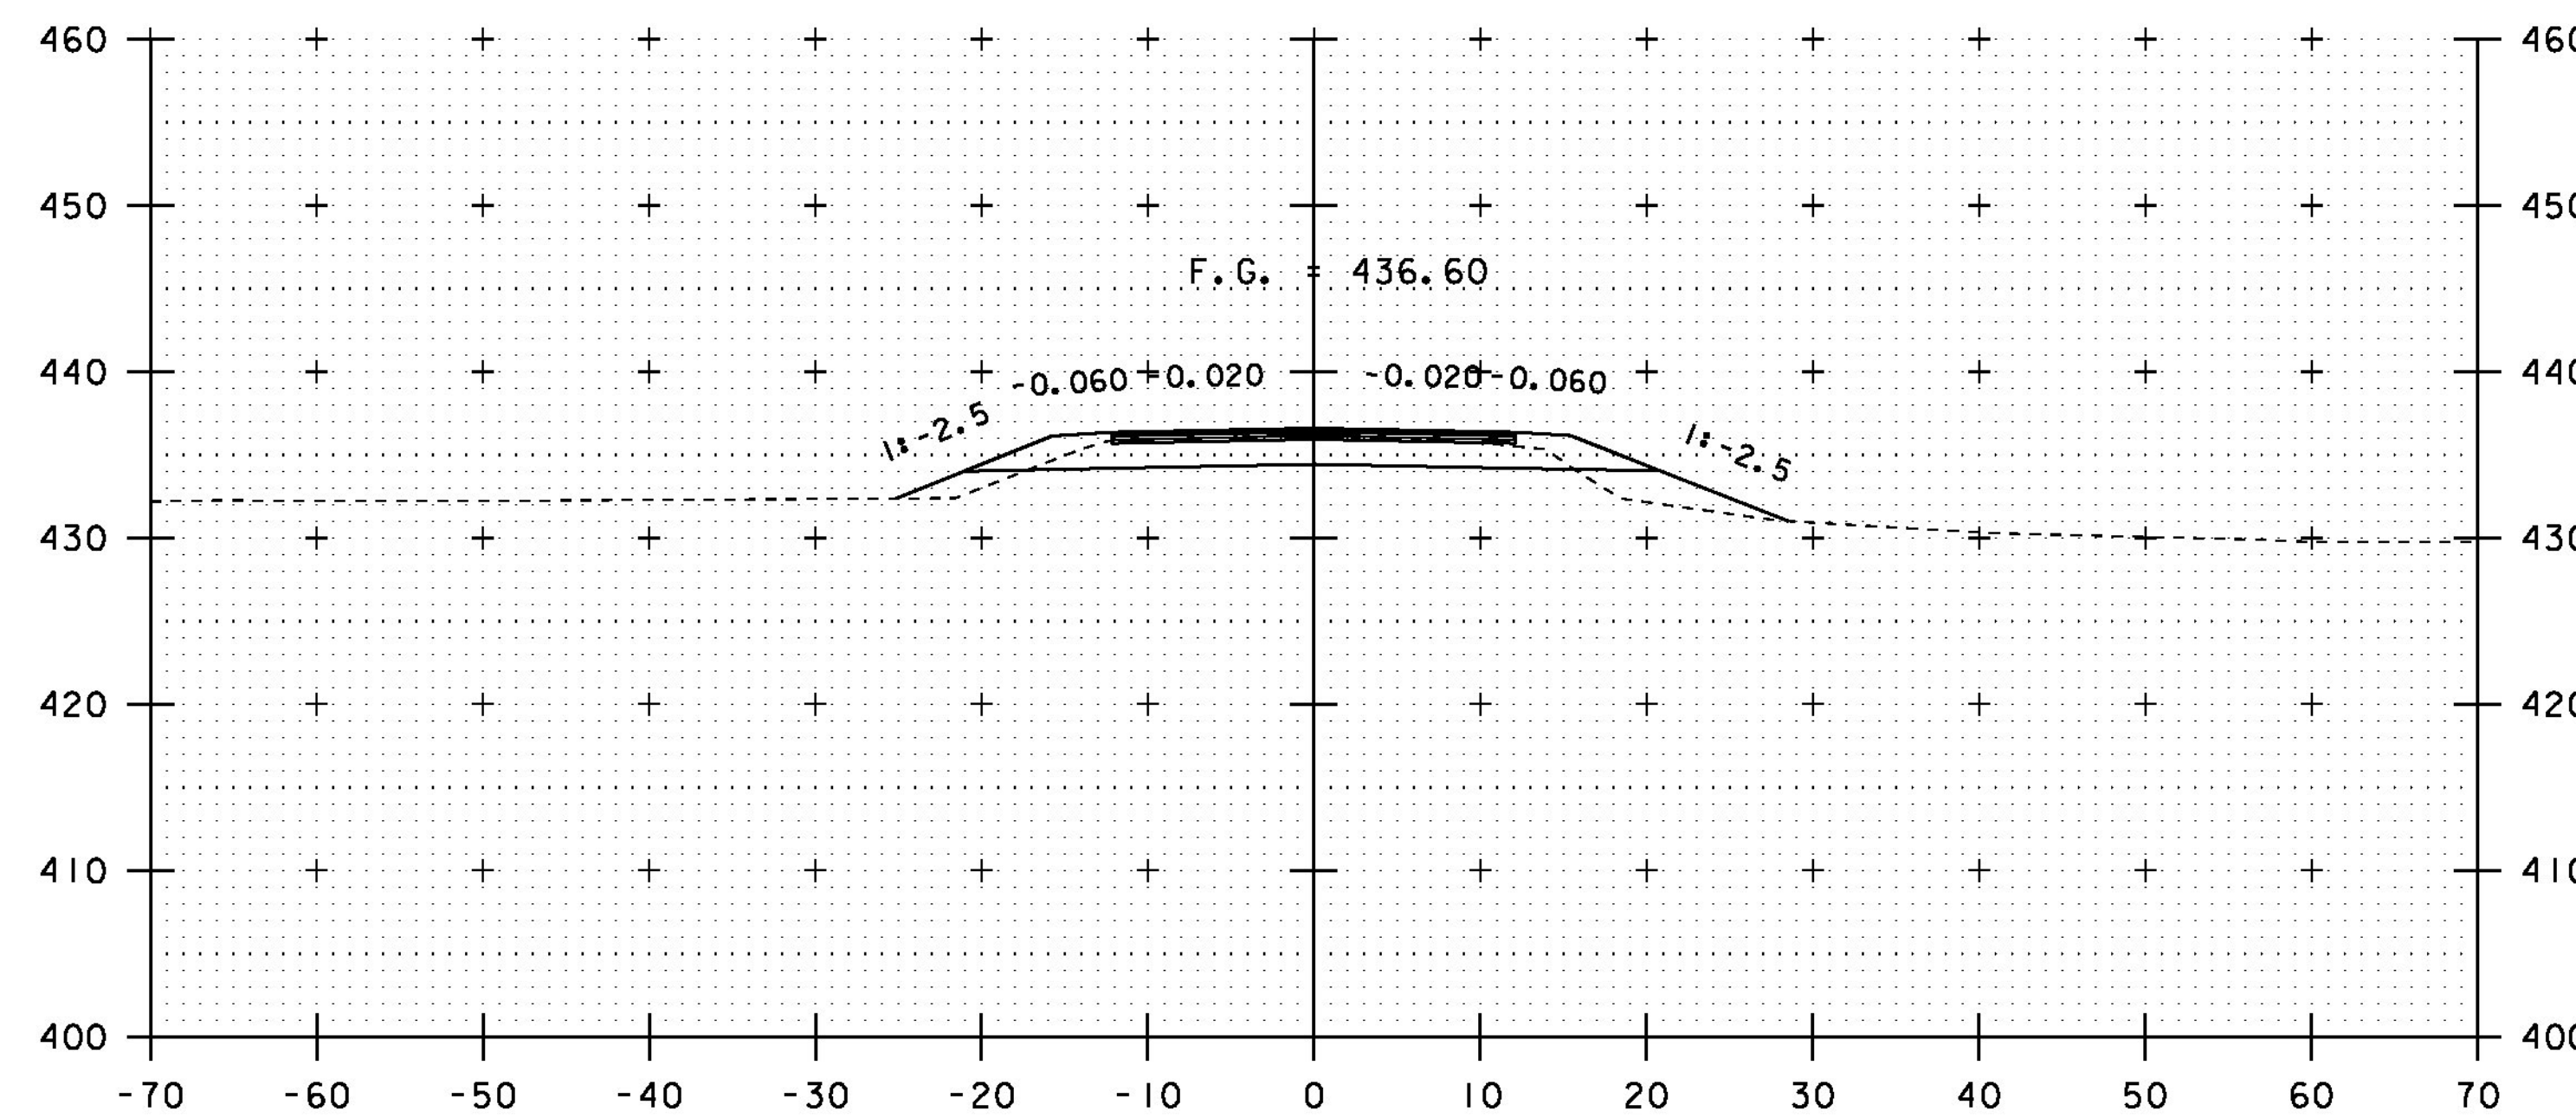

43+25

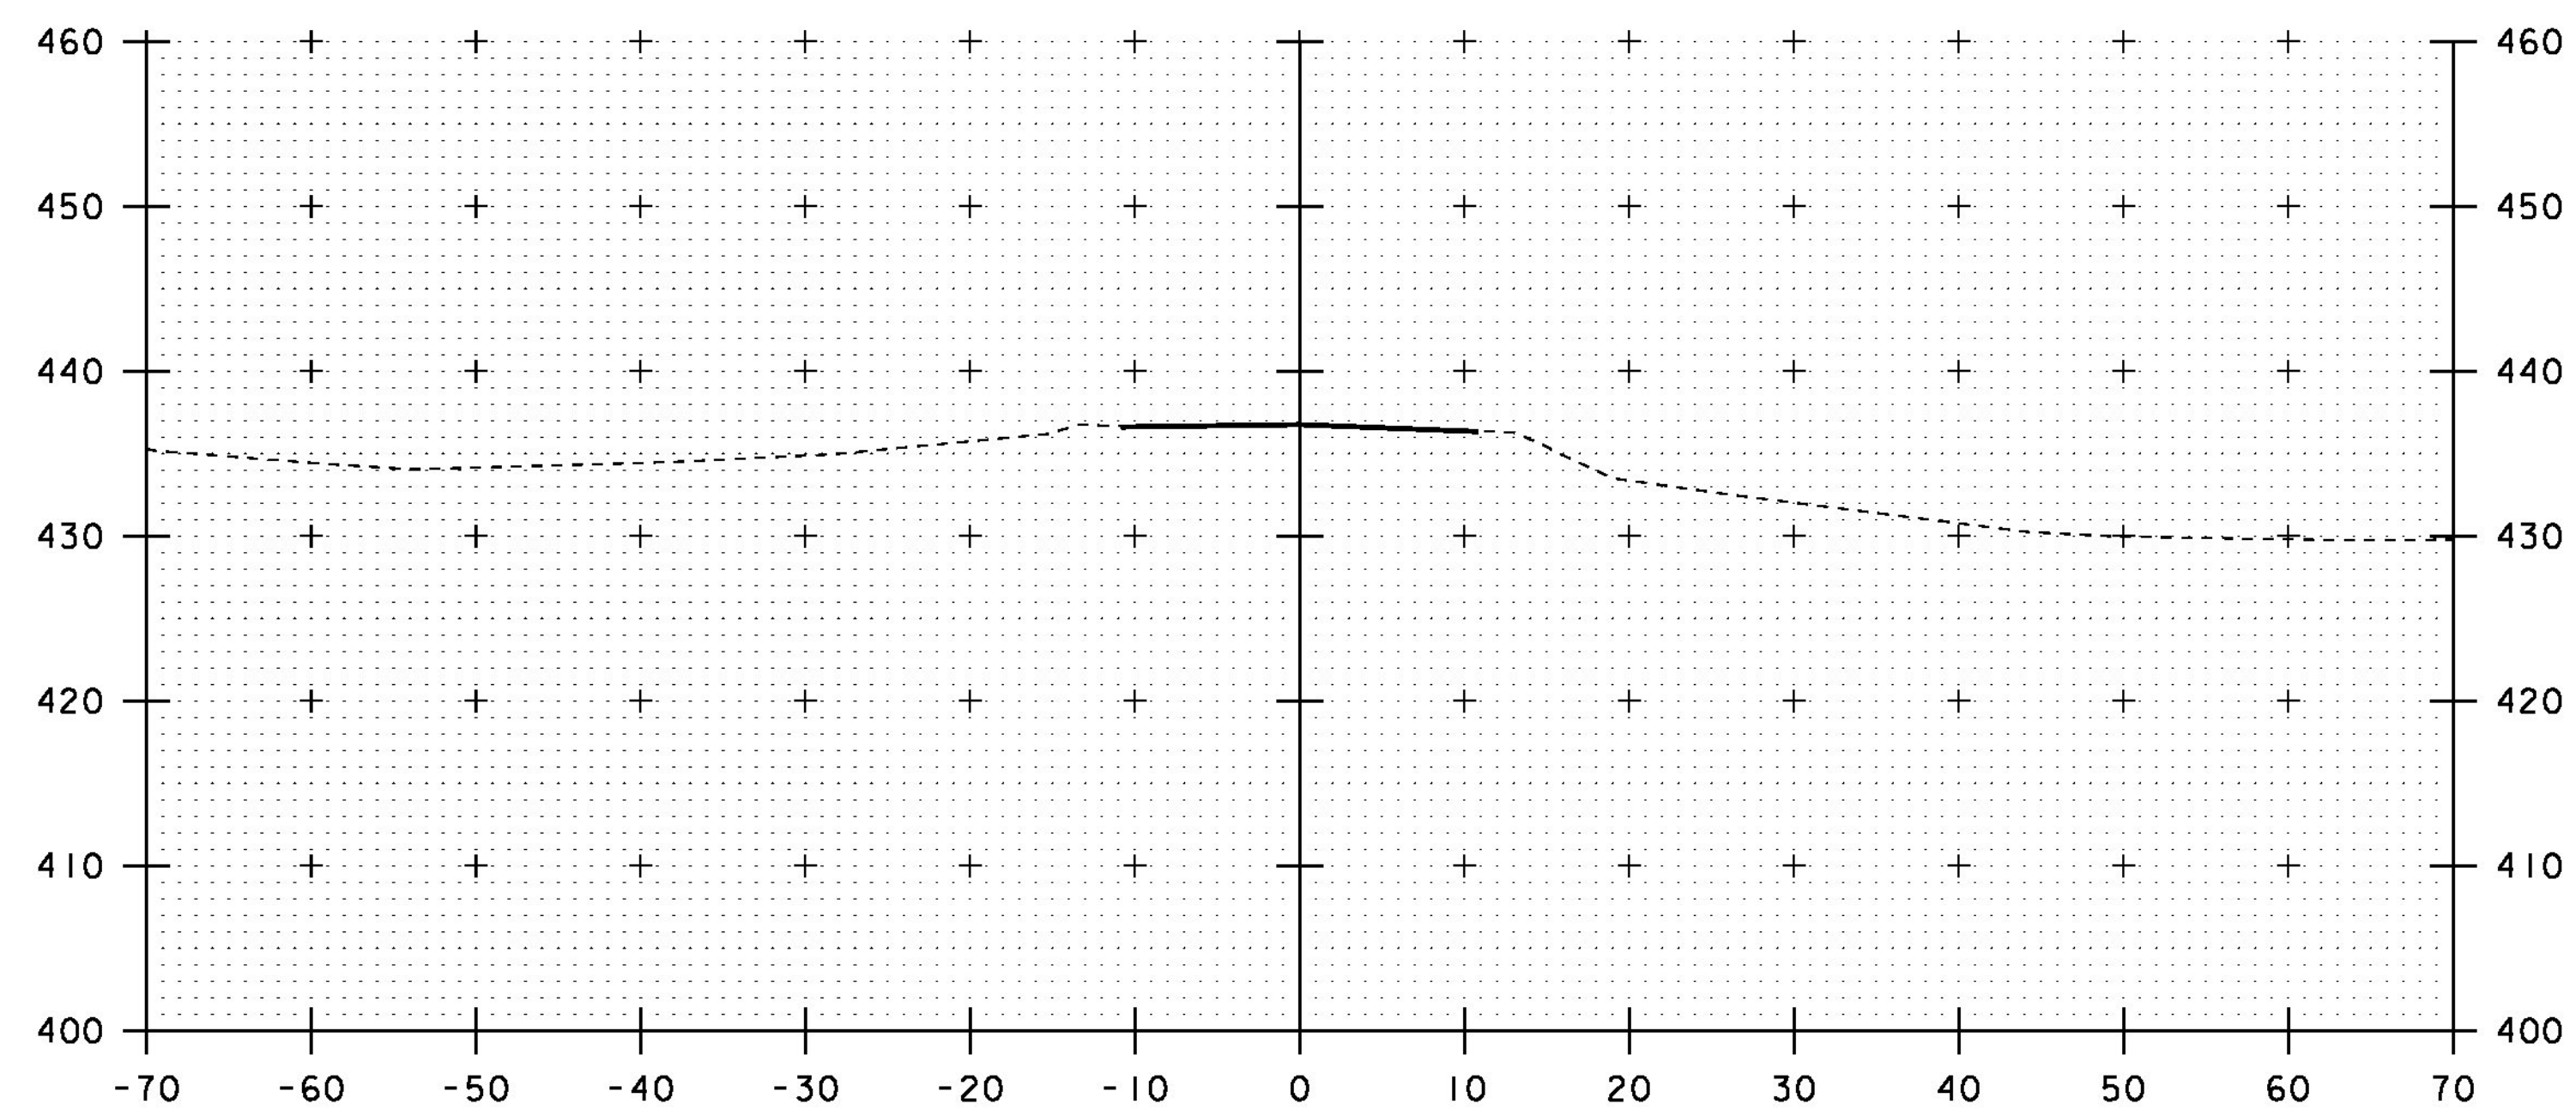


42+50  
BEGIN APPROACH  
MATCH EXISTING

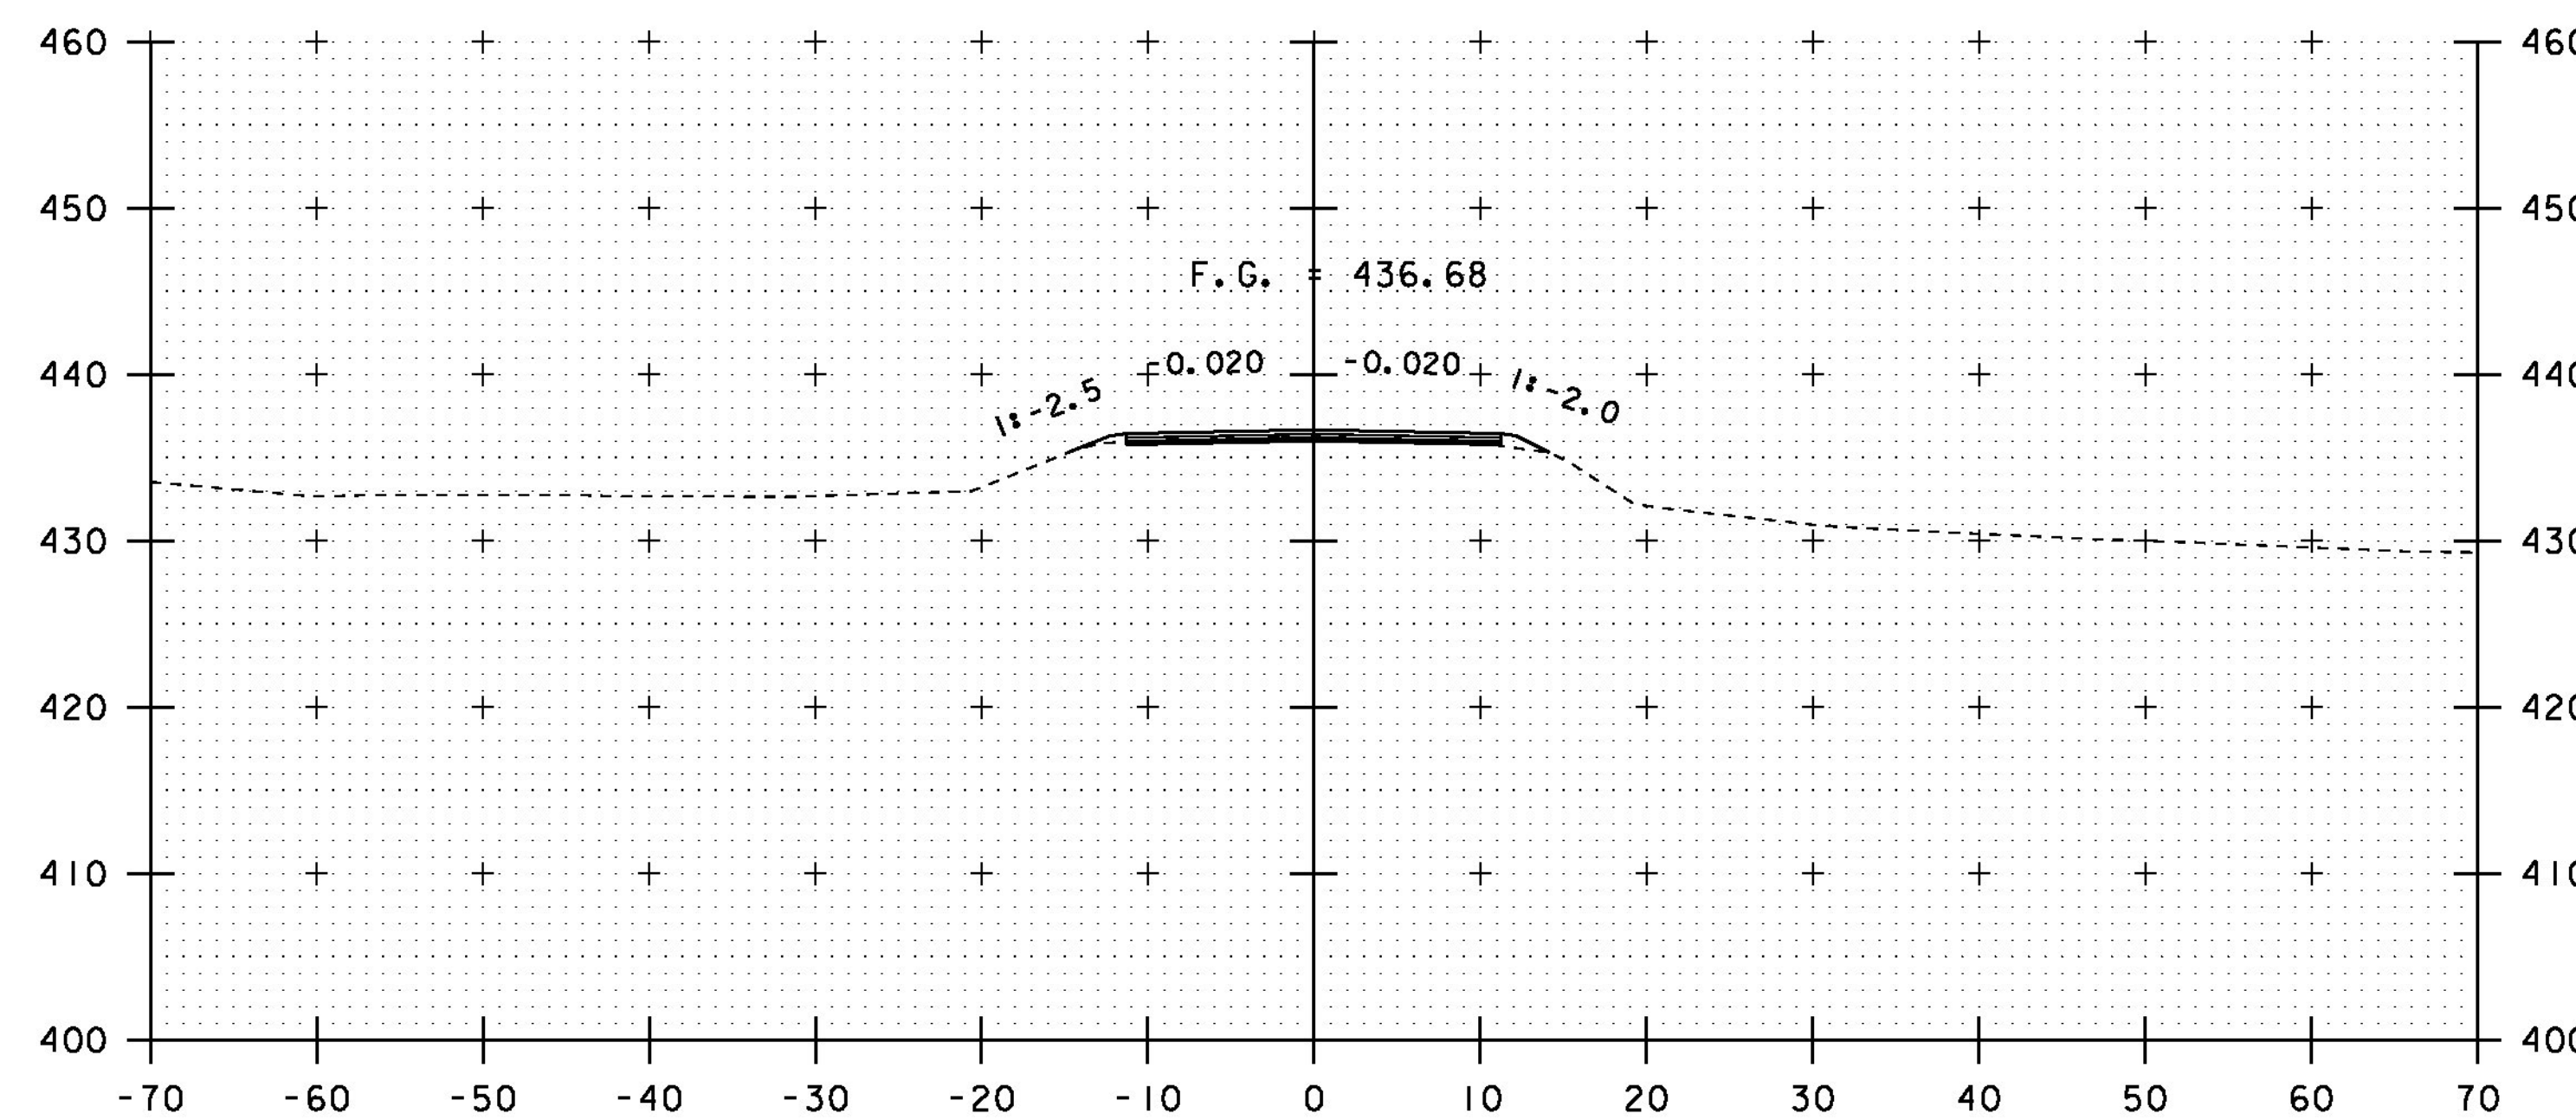


43+00

PROJECT NAME:	RICHFORD	PLOT DATE:	11-DEC-2014
PROJECT NUMBER:	BRF 0302(29)	DRAWN BY:	R. PELLET
FILE NAME:	st2j158xs.dgn	DESIGNED BY:	H. SALLS
PROJECT LEADER:	C. CARLSON	CHECKED BY:	H. SALLS
MAINLINE CROSS SECTIONS 1			SHEET 25 OF 36


STA. 42+50 TO STA. 43+25

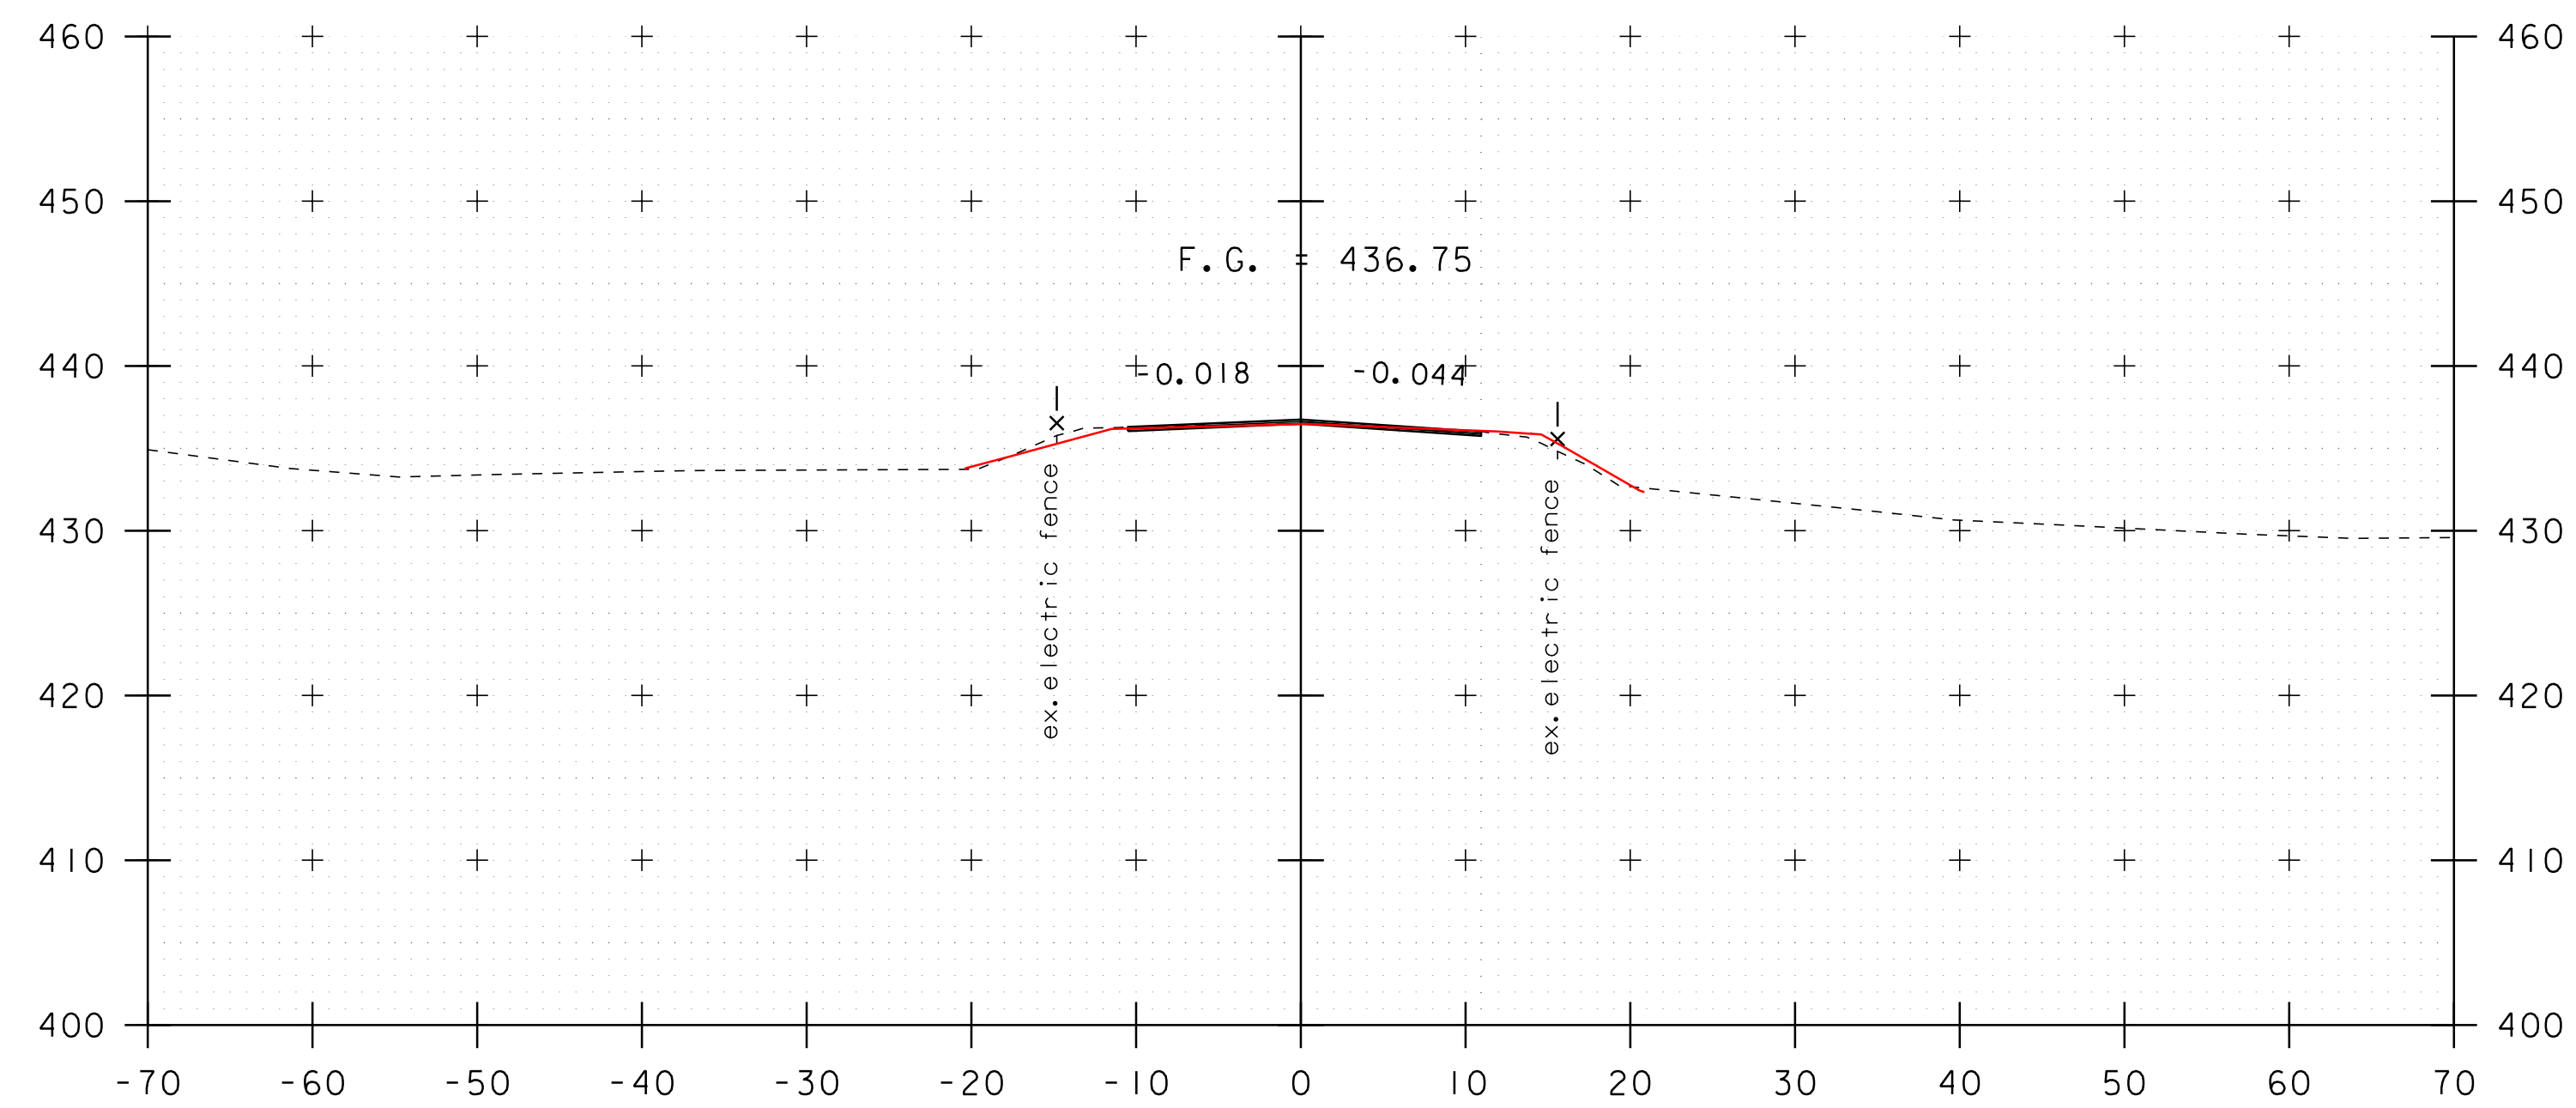


42+75

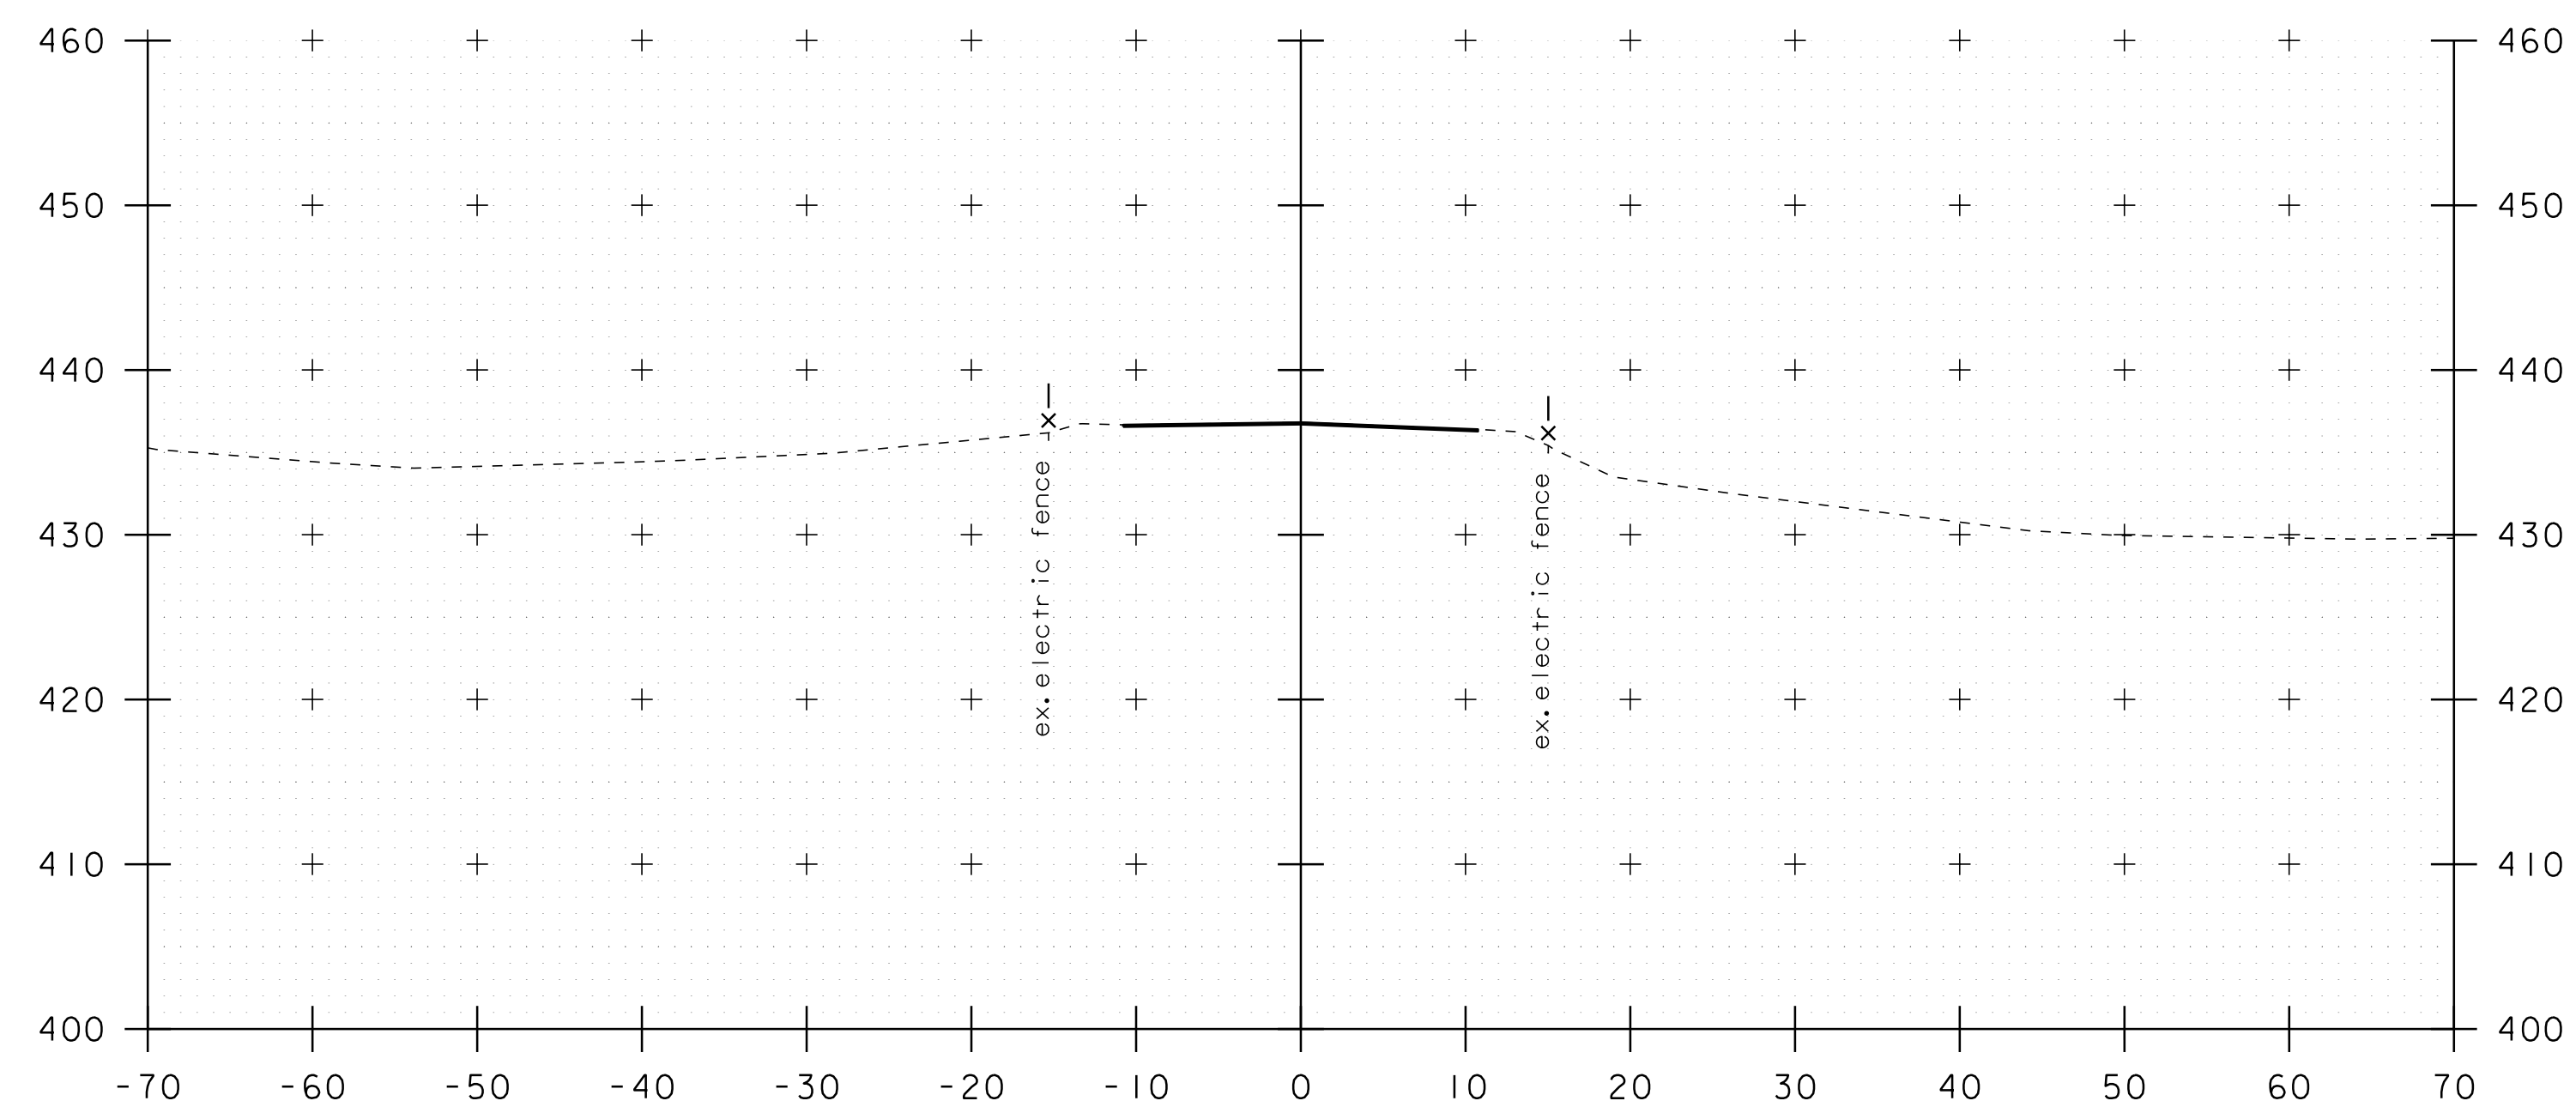

42+50  
BEGIN APPROACH  
MATCH EXISTING

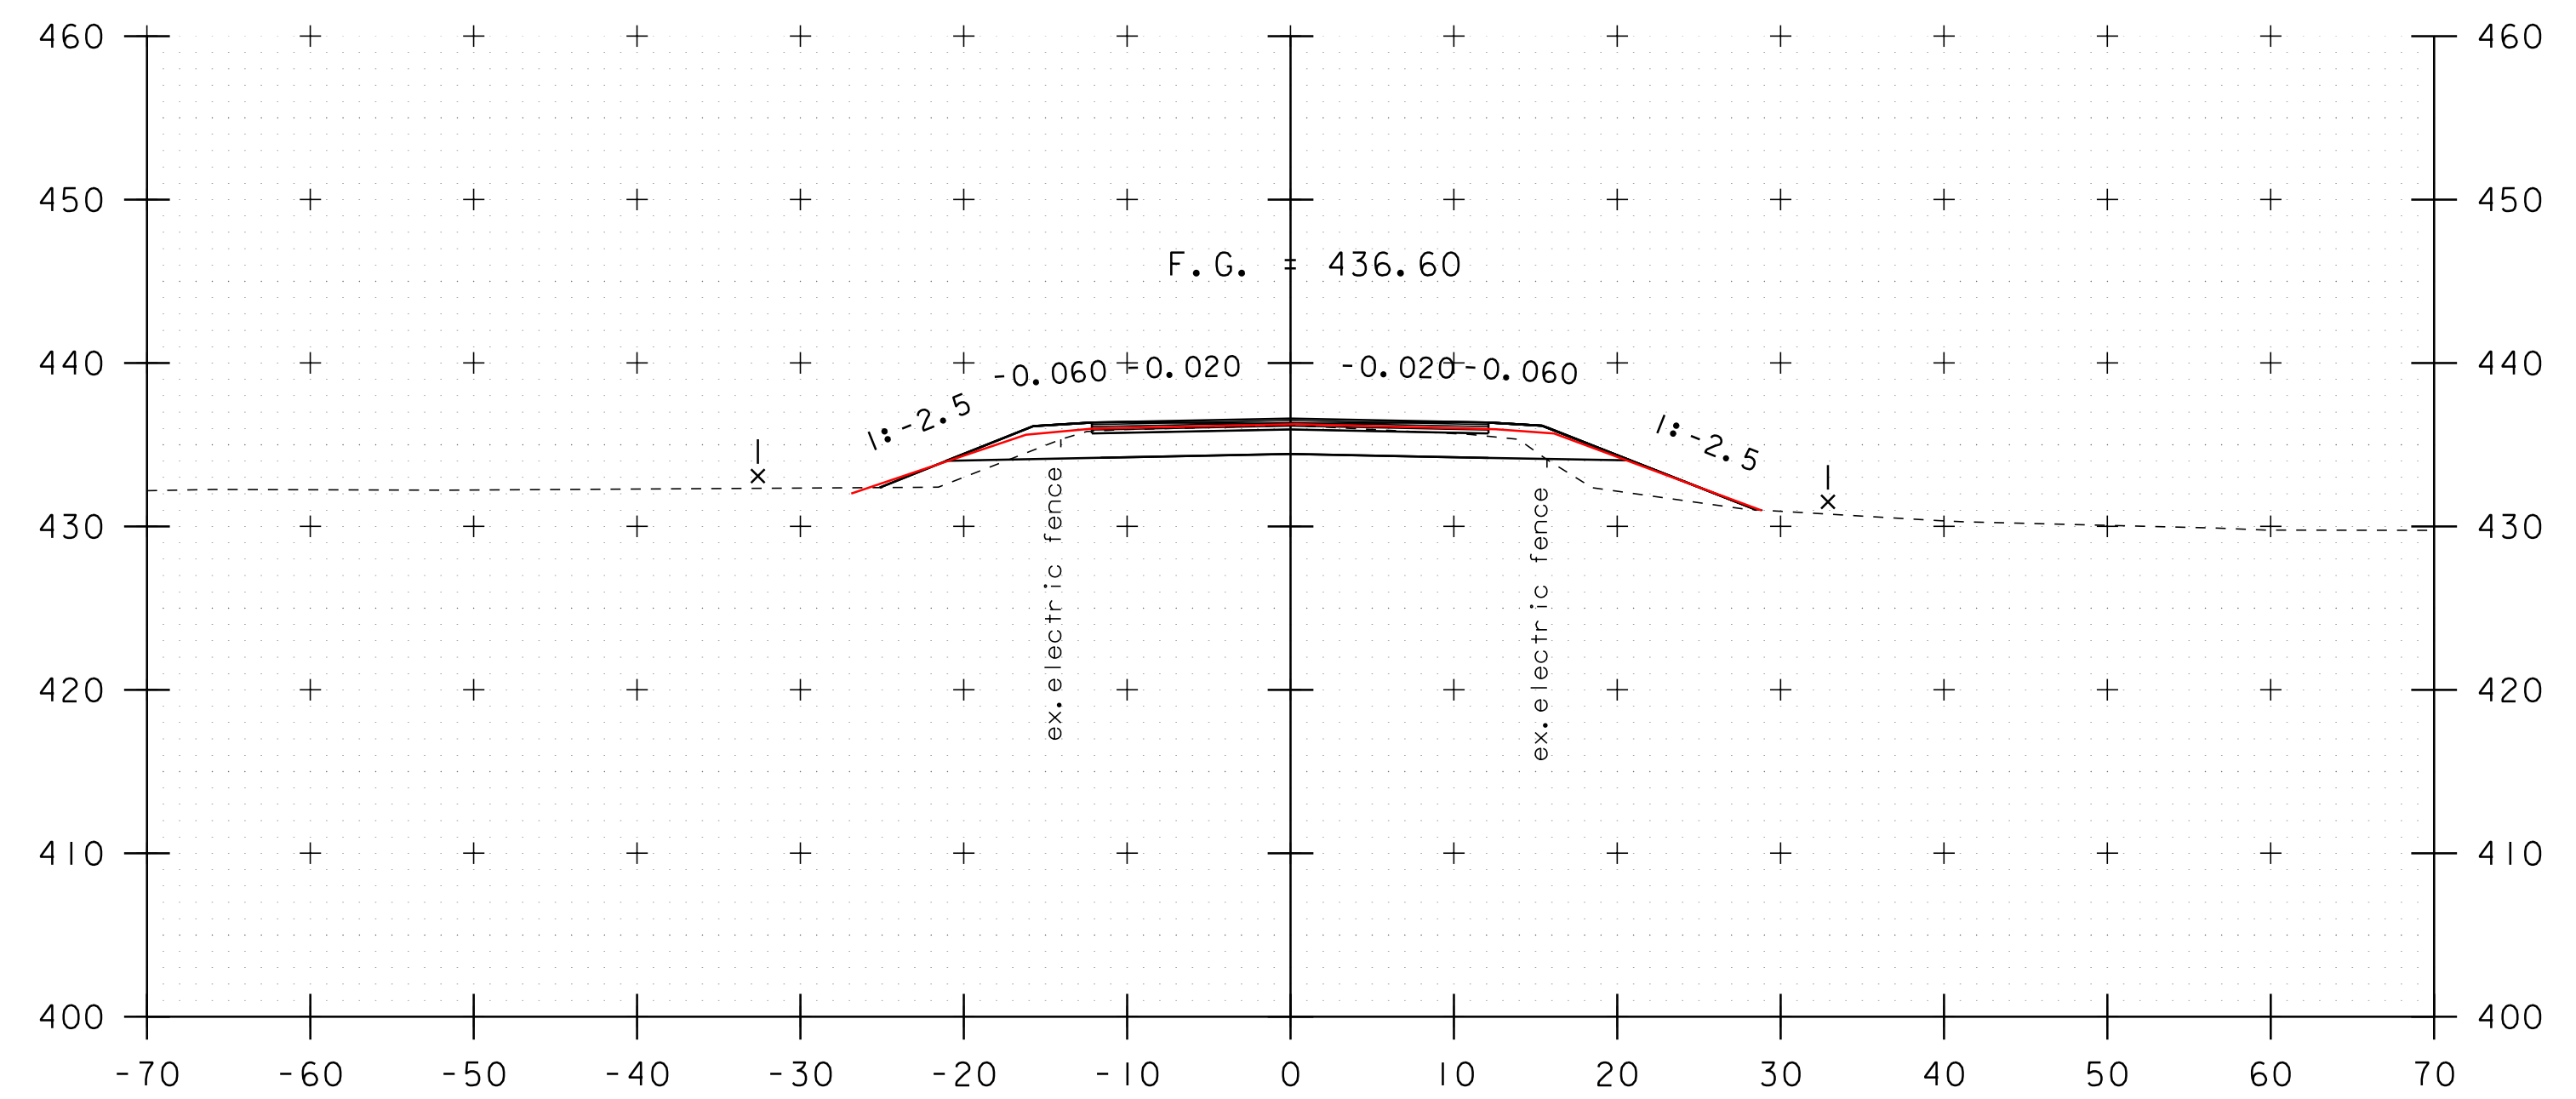


43+25

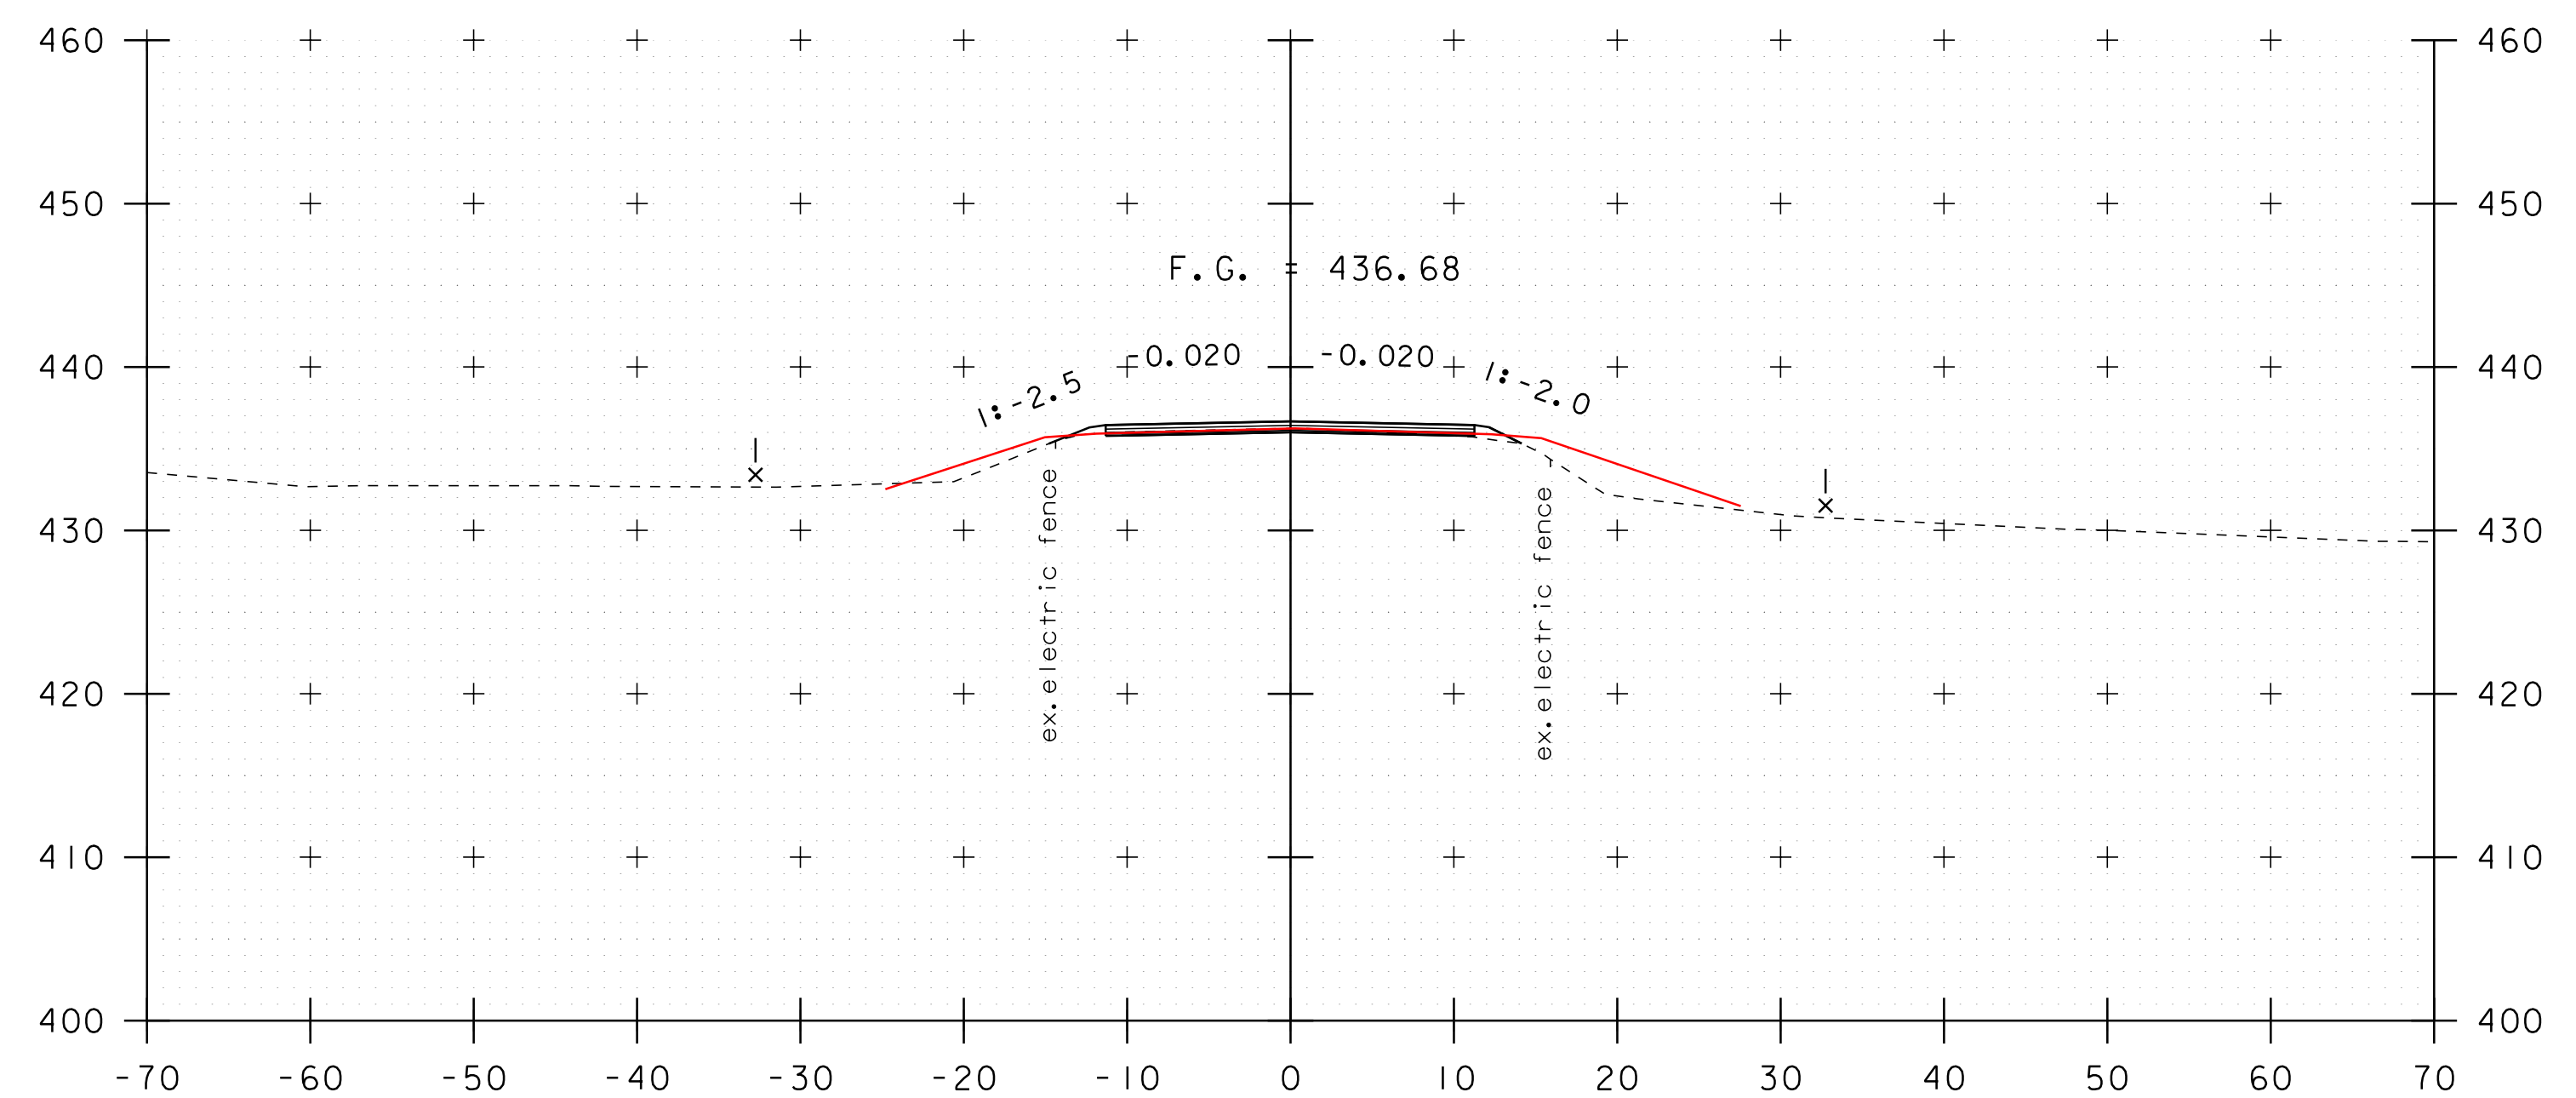


43+00

STA. 42+50 TO STA. 43+25


PROJECT NAME: RICHFORD	
PROJECT NUMBER: BRF 0302(29)	
FILE NAME: s12j158xs.dgn	PLOT DATE: 09-AUG-2016 09:57
PROJECT LEADER: C. CARLSON	DRAWN BY: R. PELLETT
DESIGNED BY: H. SALLS	CHECKED BY: H. SALLS
MAINLINE CROSS SECTIONS 1	SHEET <del>24</del> OF <del>64</del>

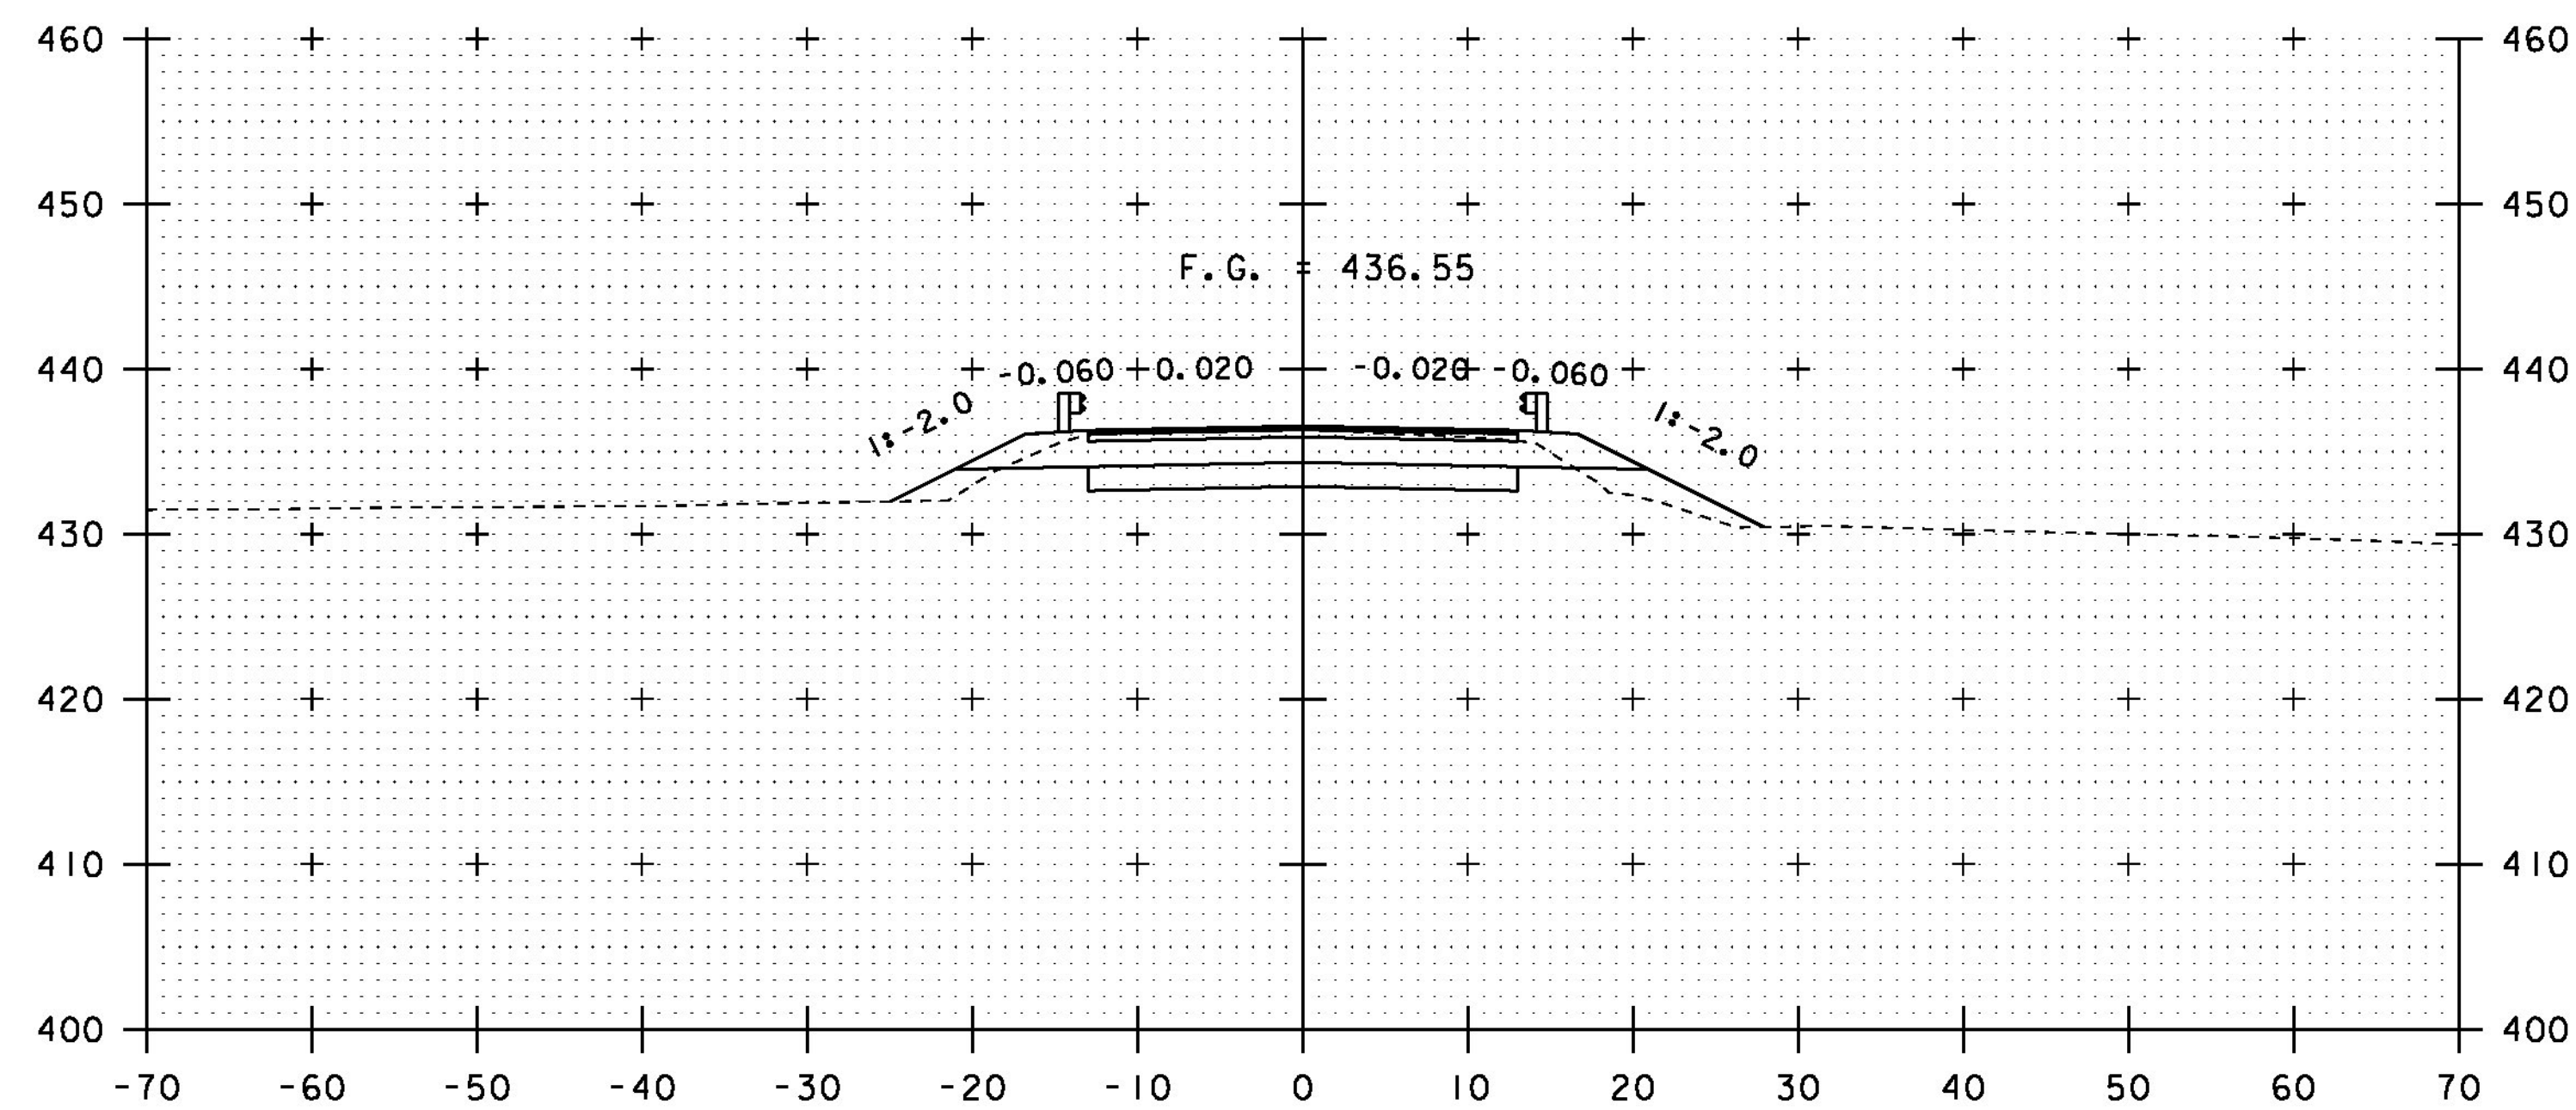


43+75

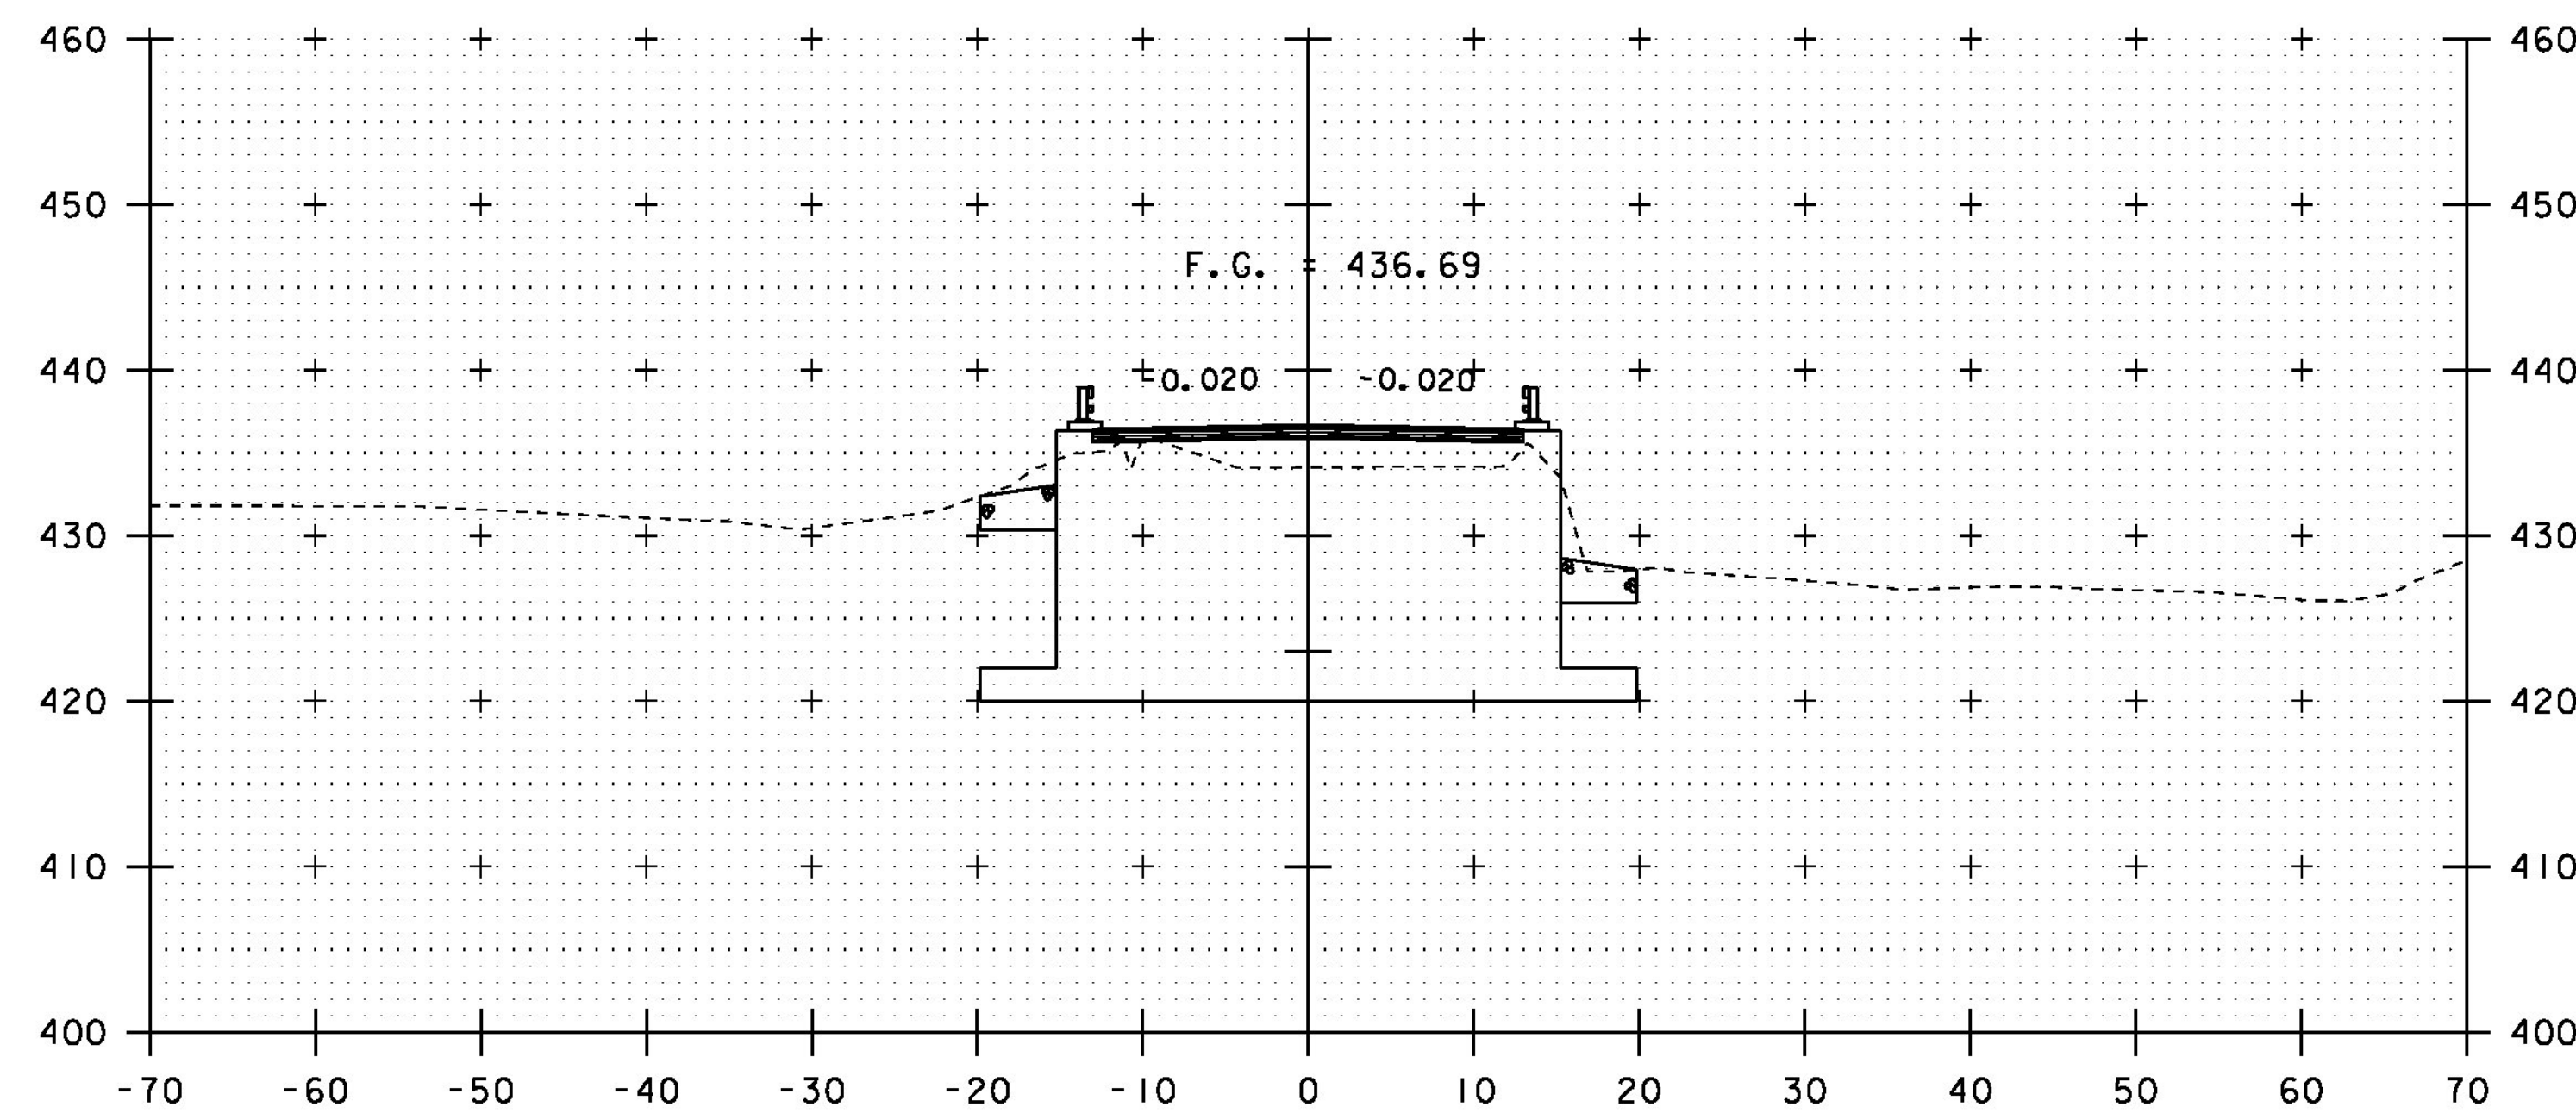

44+25  
STA 44+24 BEGIN BRIDGE

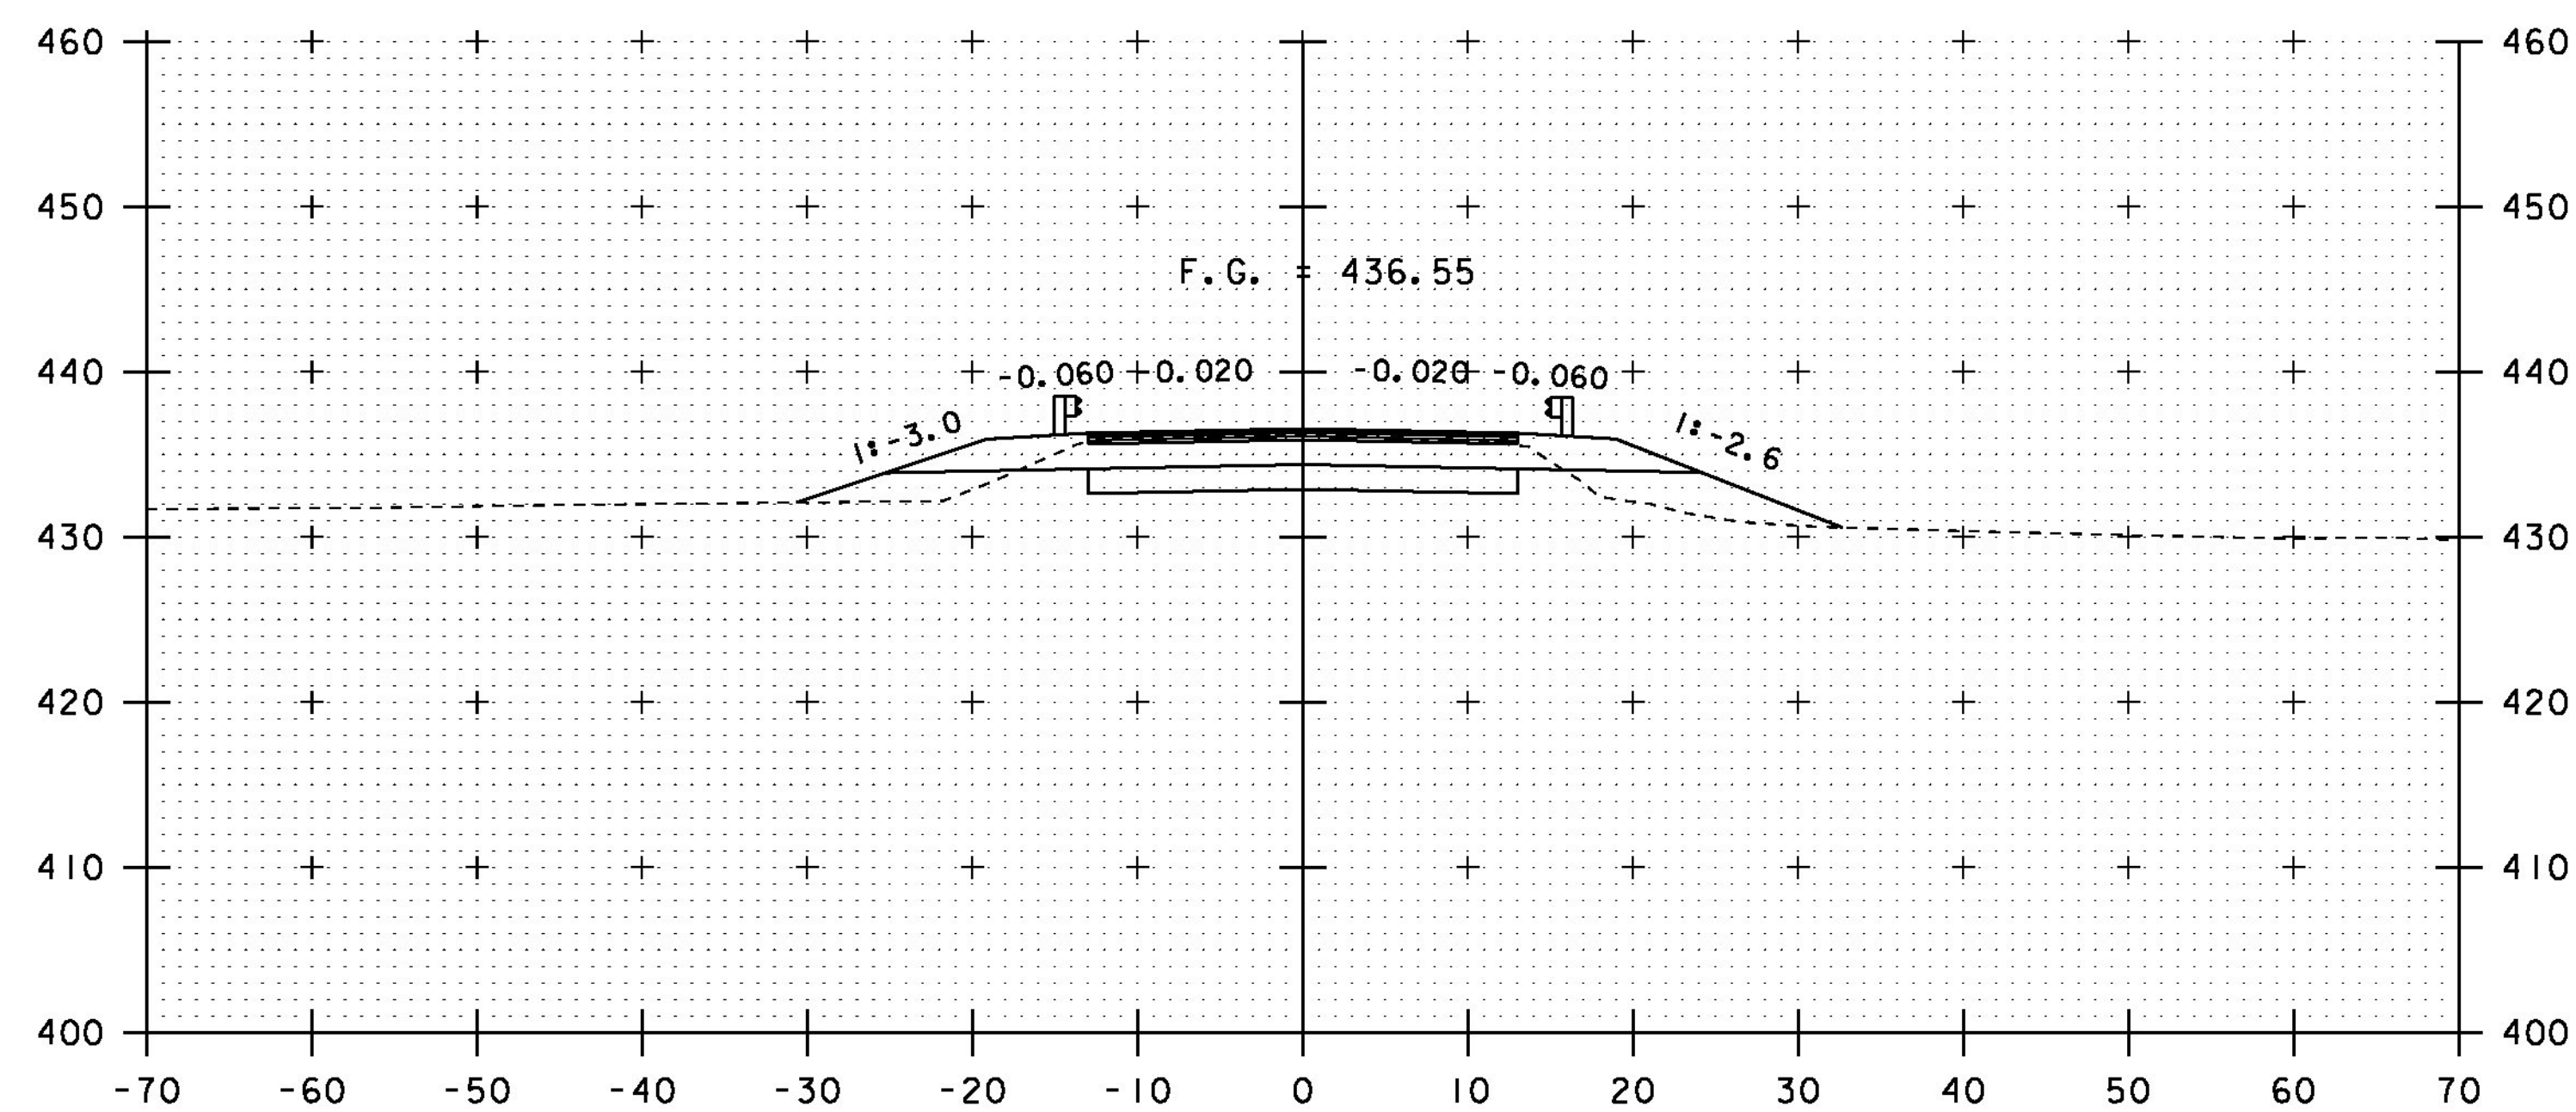

43+50  
BEGIN PROJECT


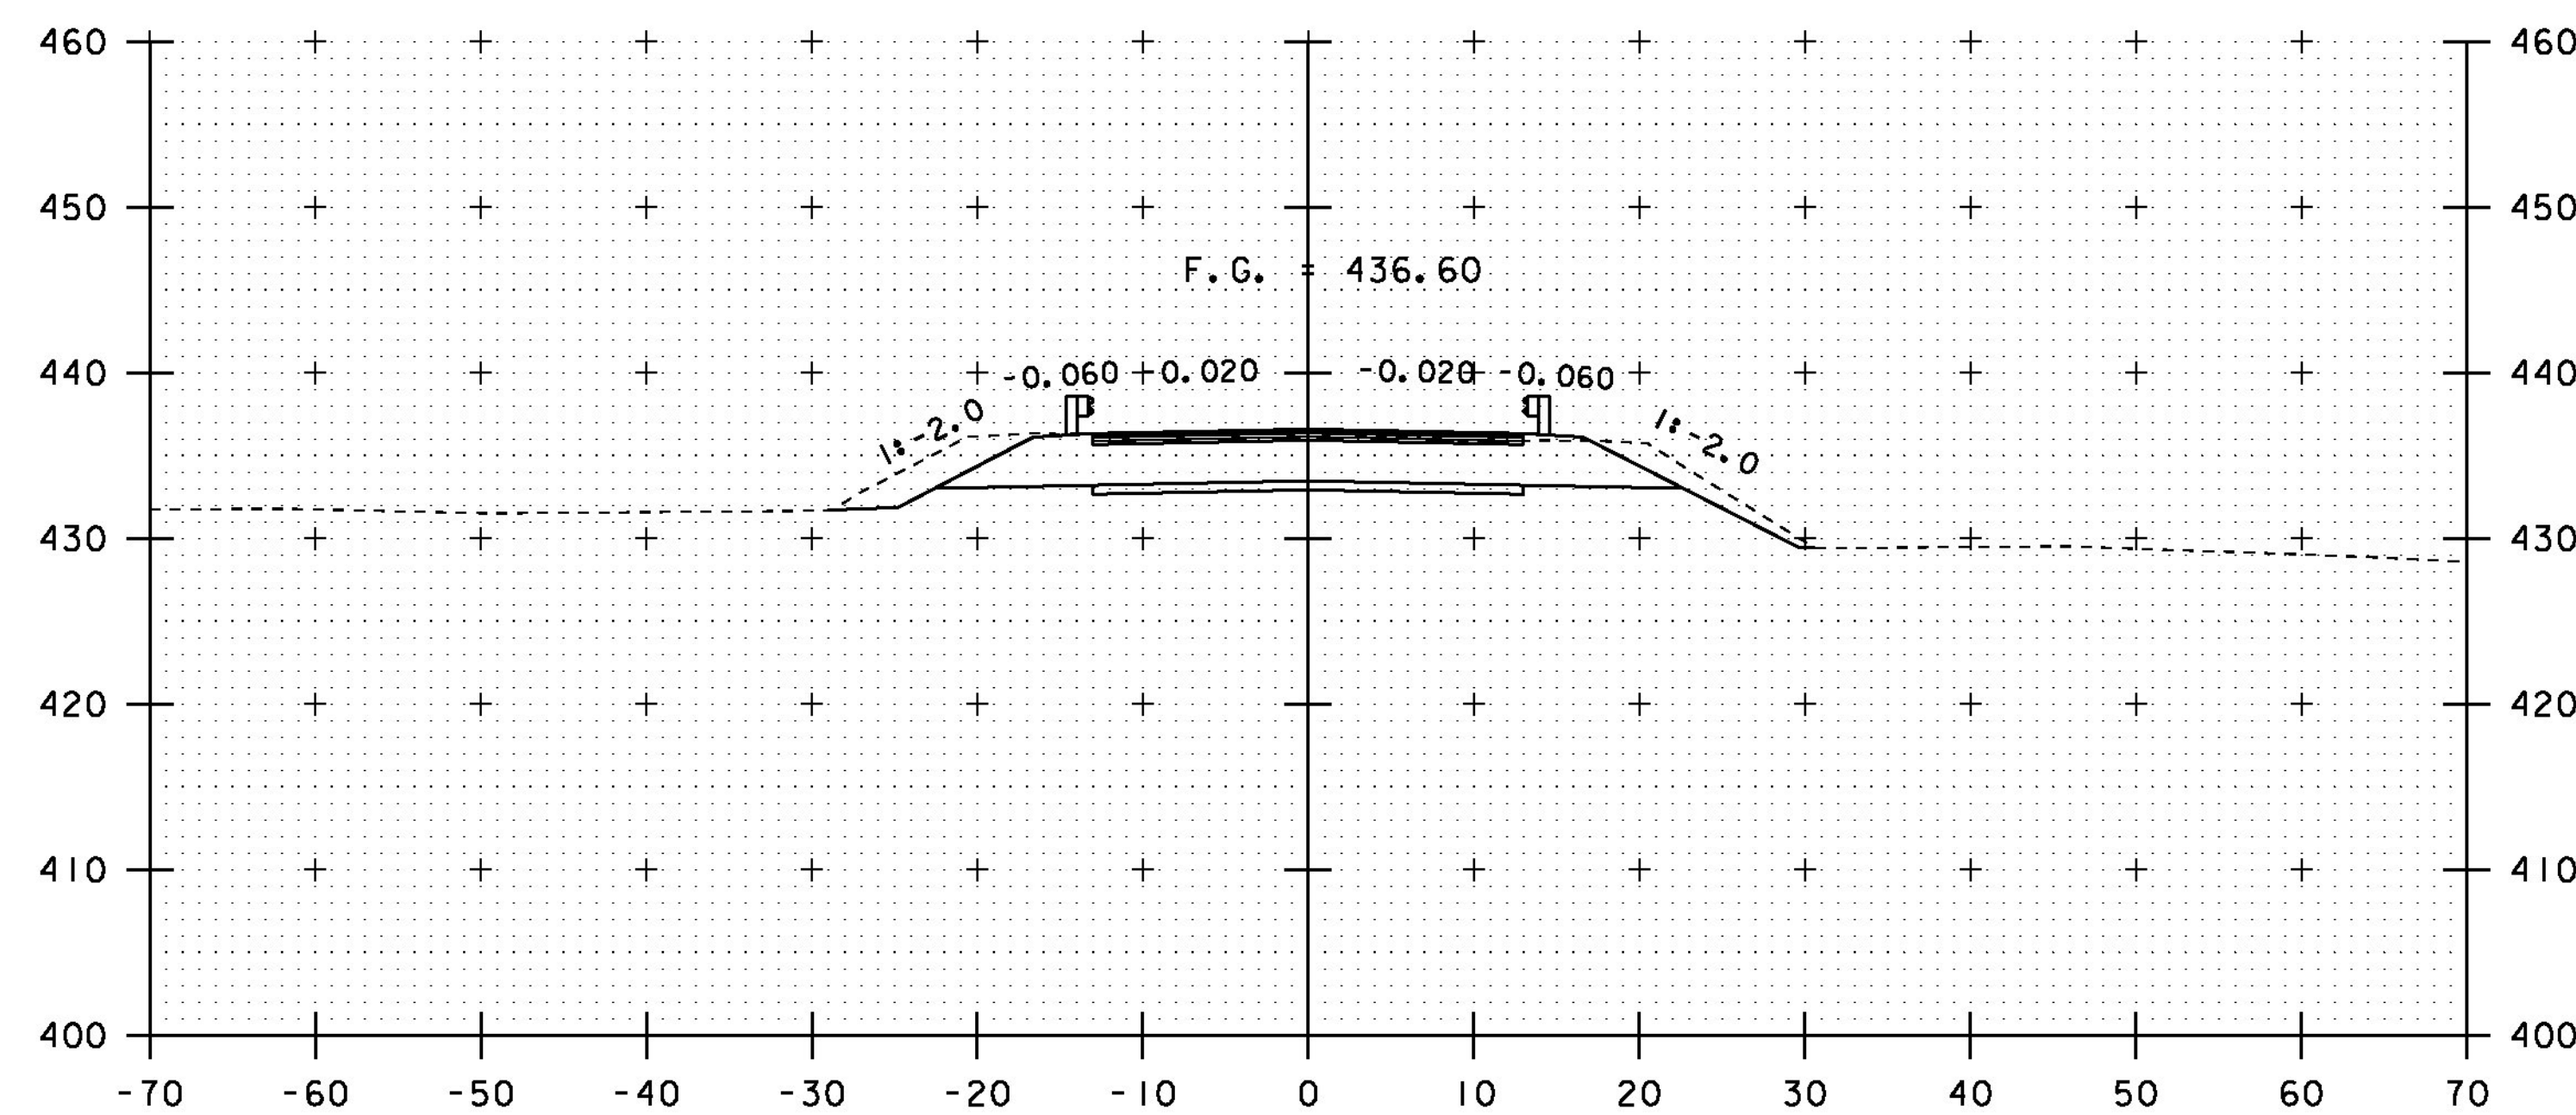


44+00

PROJECT NAME:	RICHFORD	PLOT DATE:	11-DEC-2014
PROJECT NUMBER:	BRF 0302(29)	DRAWN BY:	R. PELLETT
FILE NAME:	st2j158xs.dgn	DESIGNED BY:	H. SALLS
PROJECT LEADER:	C. CARLSON	CHECKED BY:	H. SALLS
MAINLINE CROSS SECTIONS 2		SHEET	26 OF 36



STA. 43+50 TO STA. 44+25



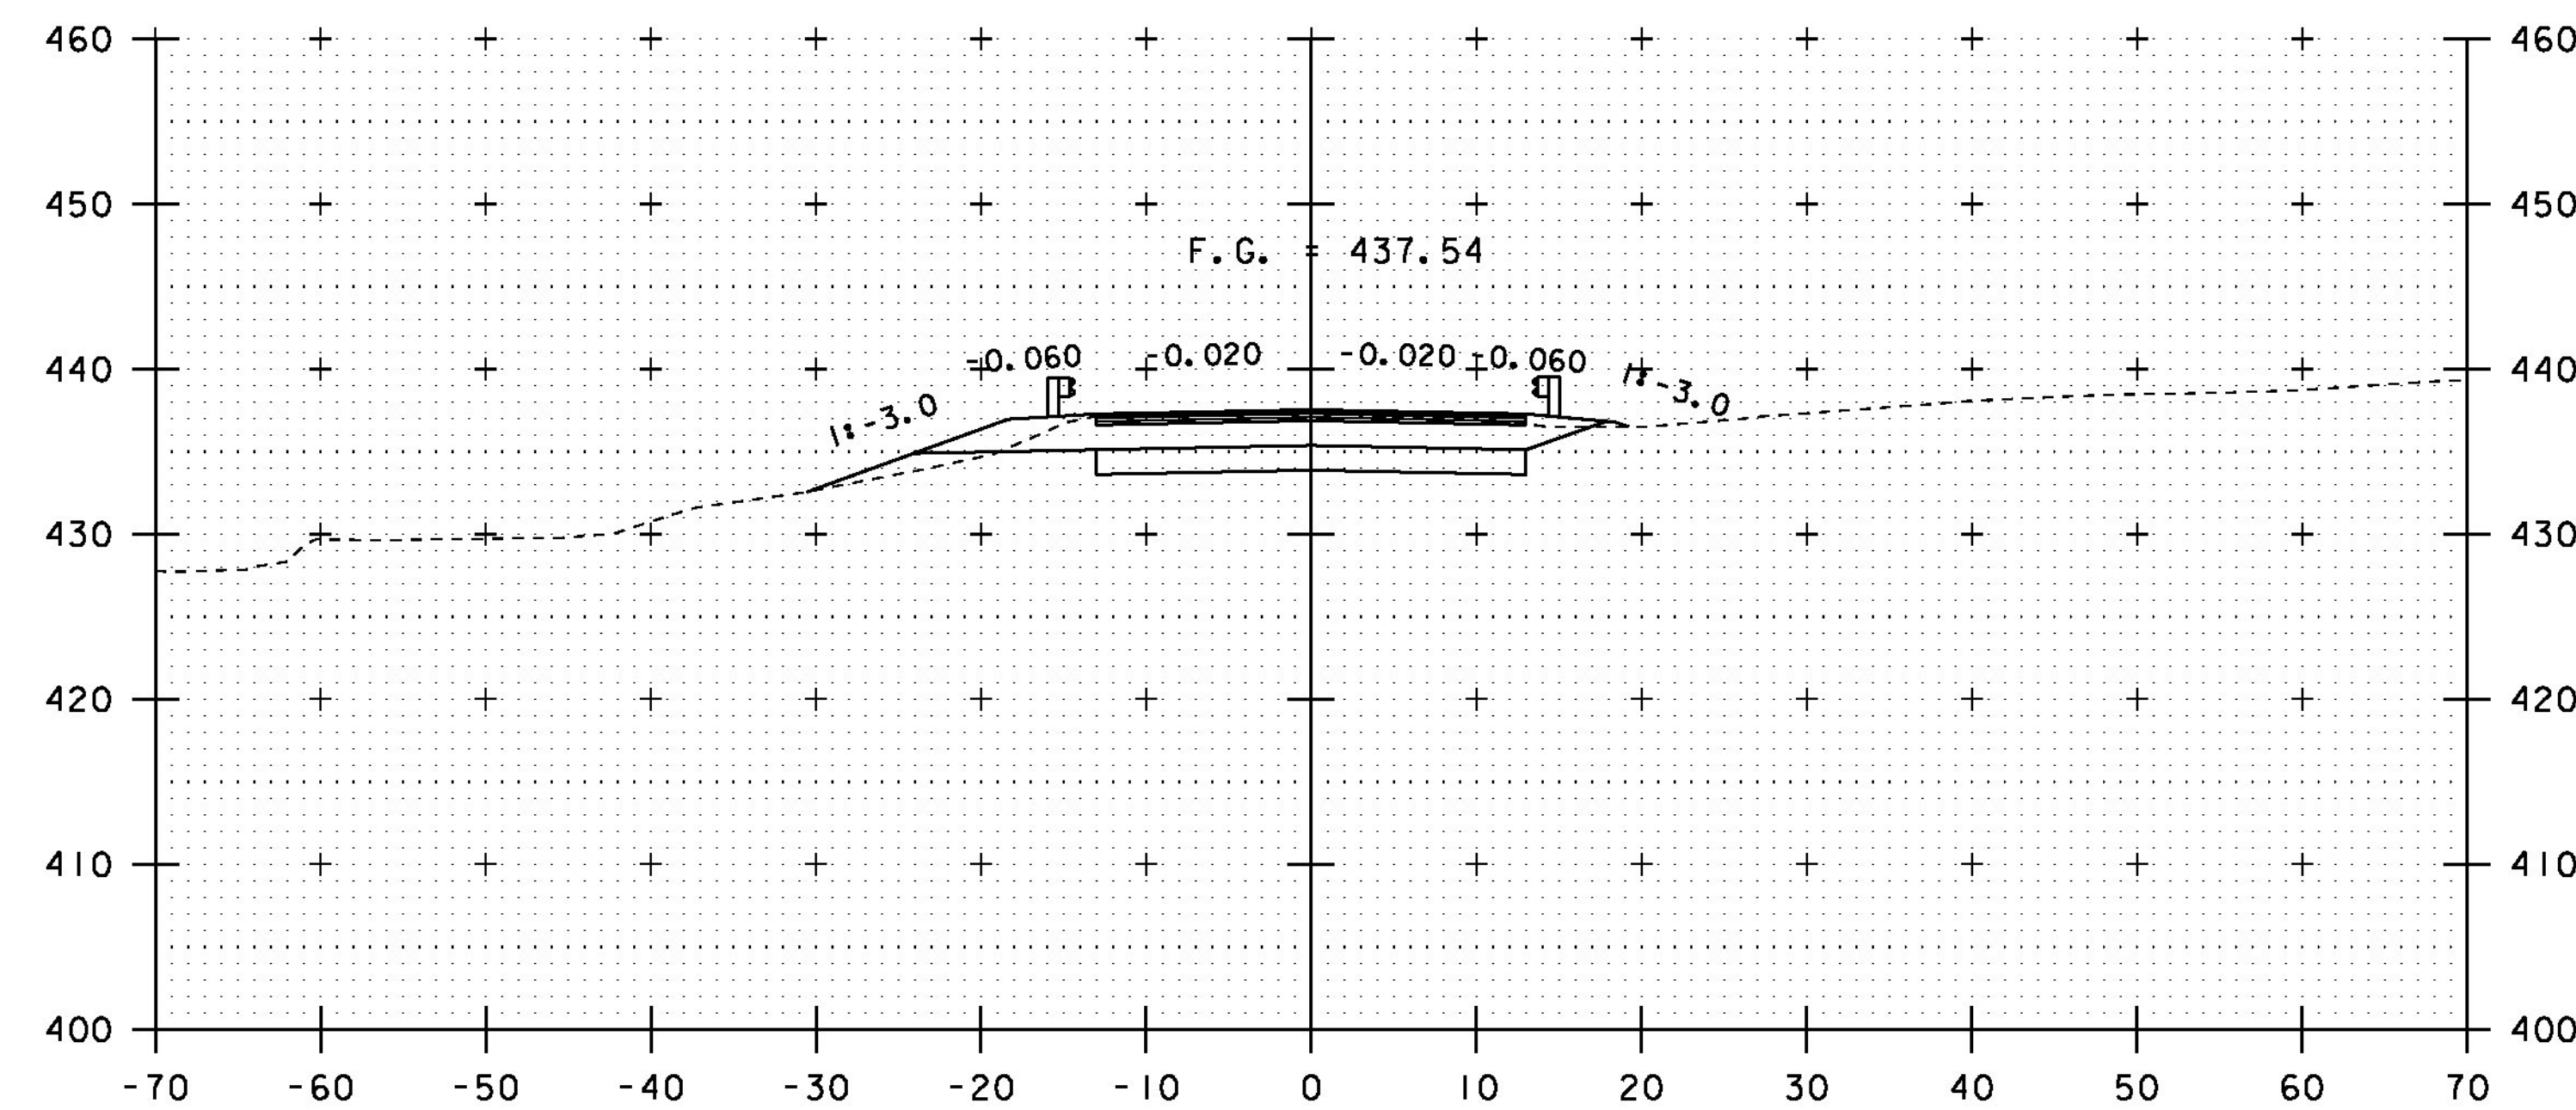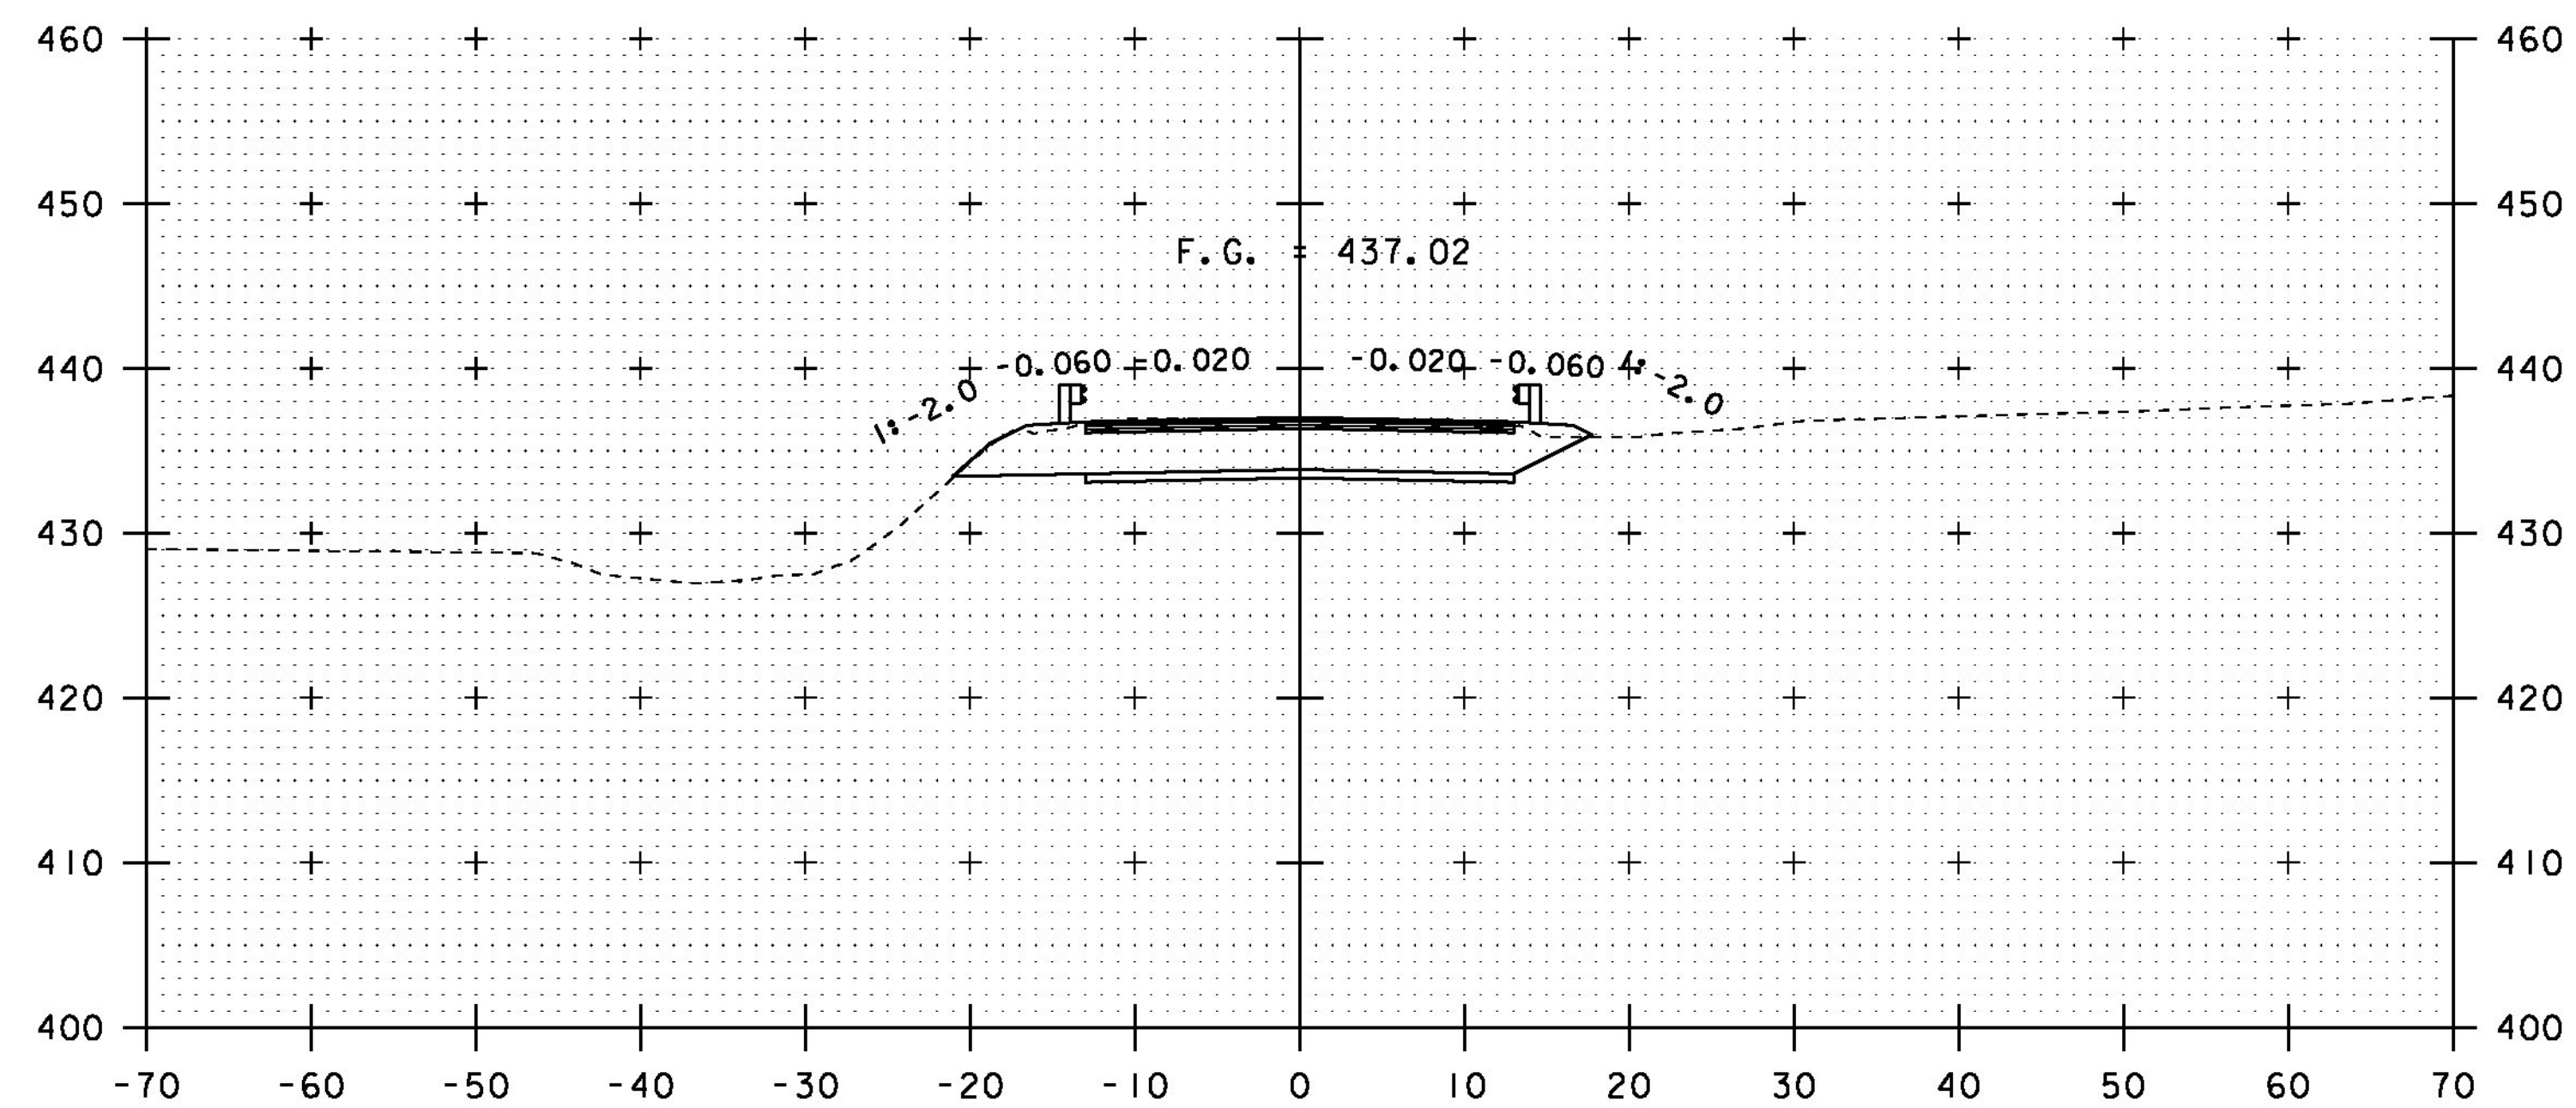

44+75  
STA 44+52 END BRIDGE

45+25  
END PROJECT



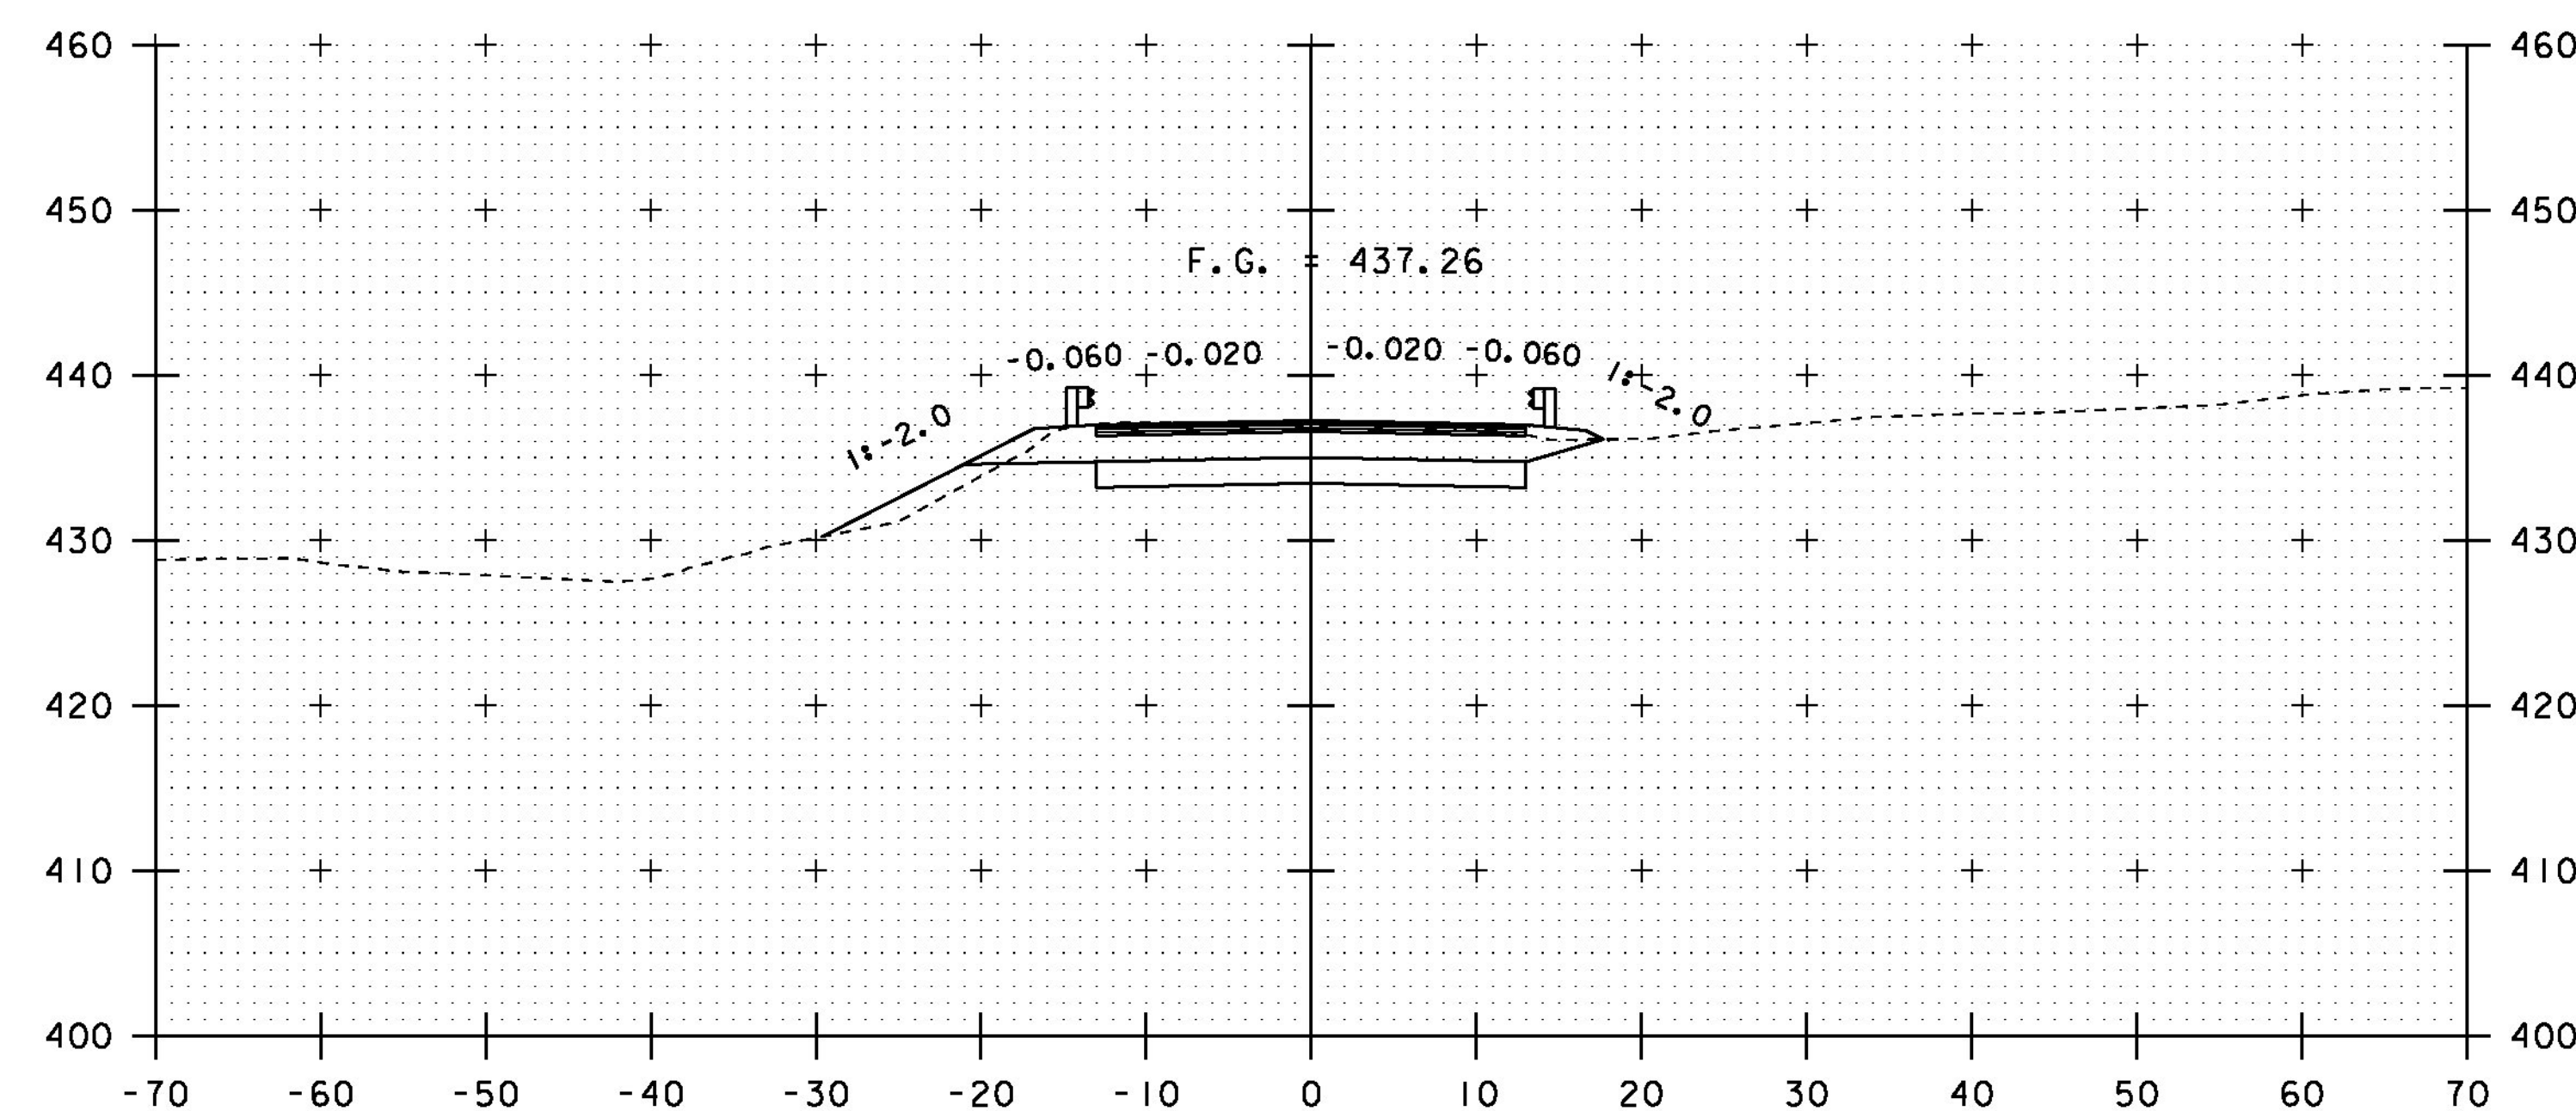
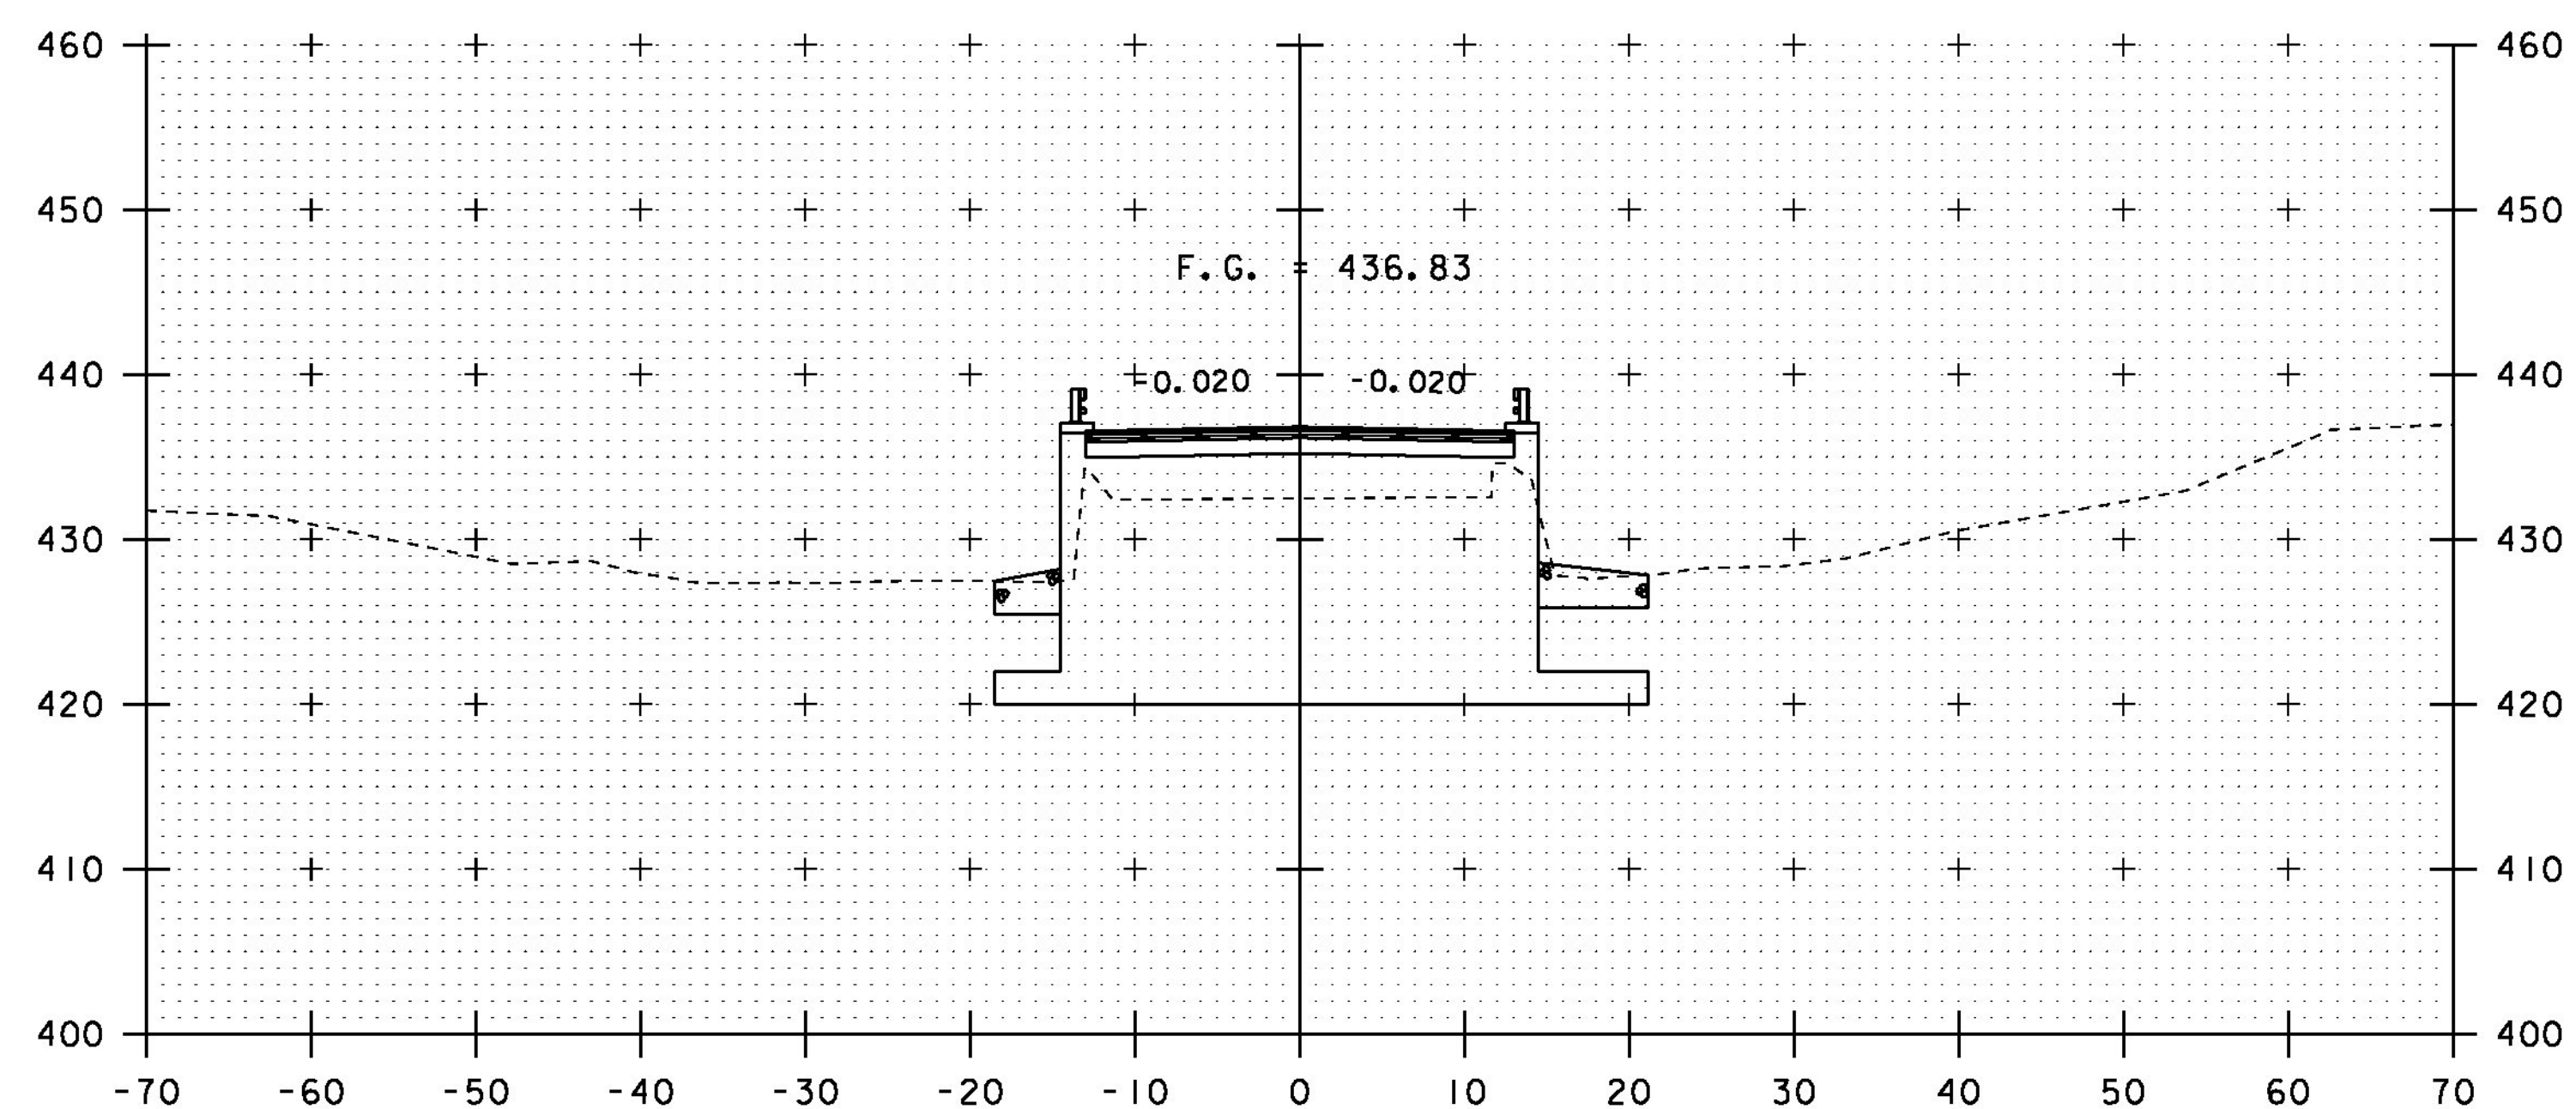


44+50

45+00

PROJECT NAME:	RICHFORD	PLOT DATE:	11-DEC-2014
PROJECT NUMBER:	BRF 0302(29)	DRAWN BY:	R. PELLETT
FILE NAME:	st2j158xs.dgn	DESIGNED BY:	H. SALLS
PROJECT LEADER:	C. CARLSON	CHECKED BY:	H. SALLS
DESIGNED BY:	H. SALLS		
MAINLINE CROSS SECTIONS 3			SHEET 27 OF 36

STA. 44+50 TO STA. 45+25

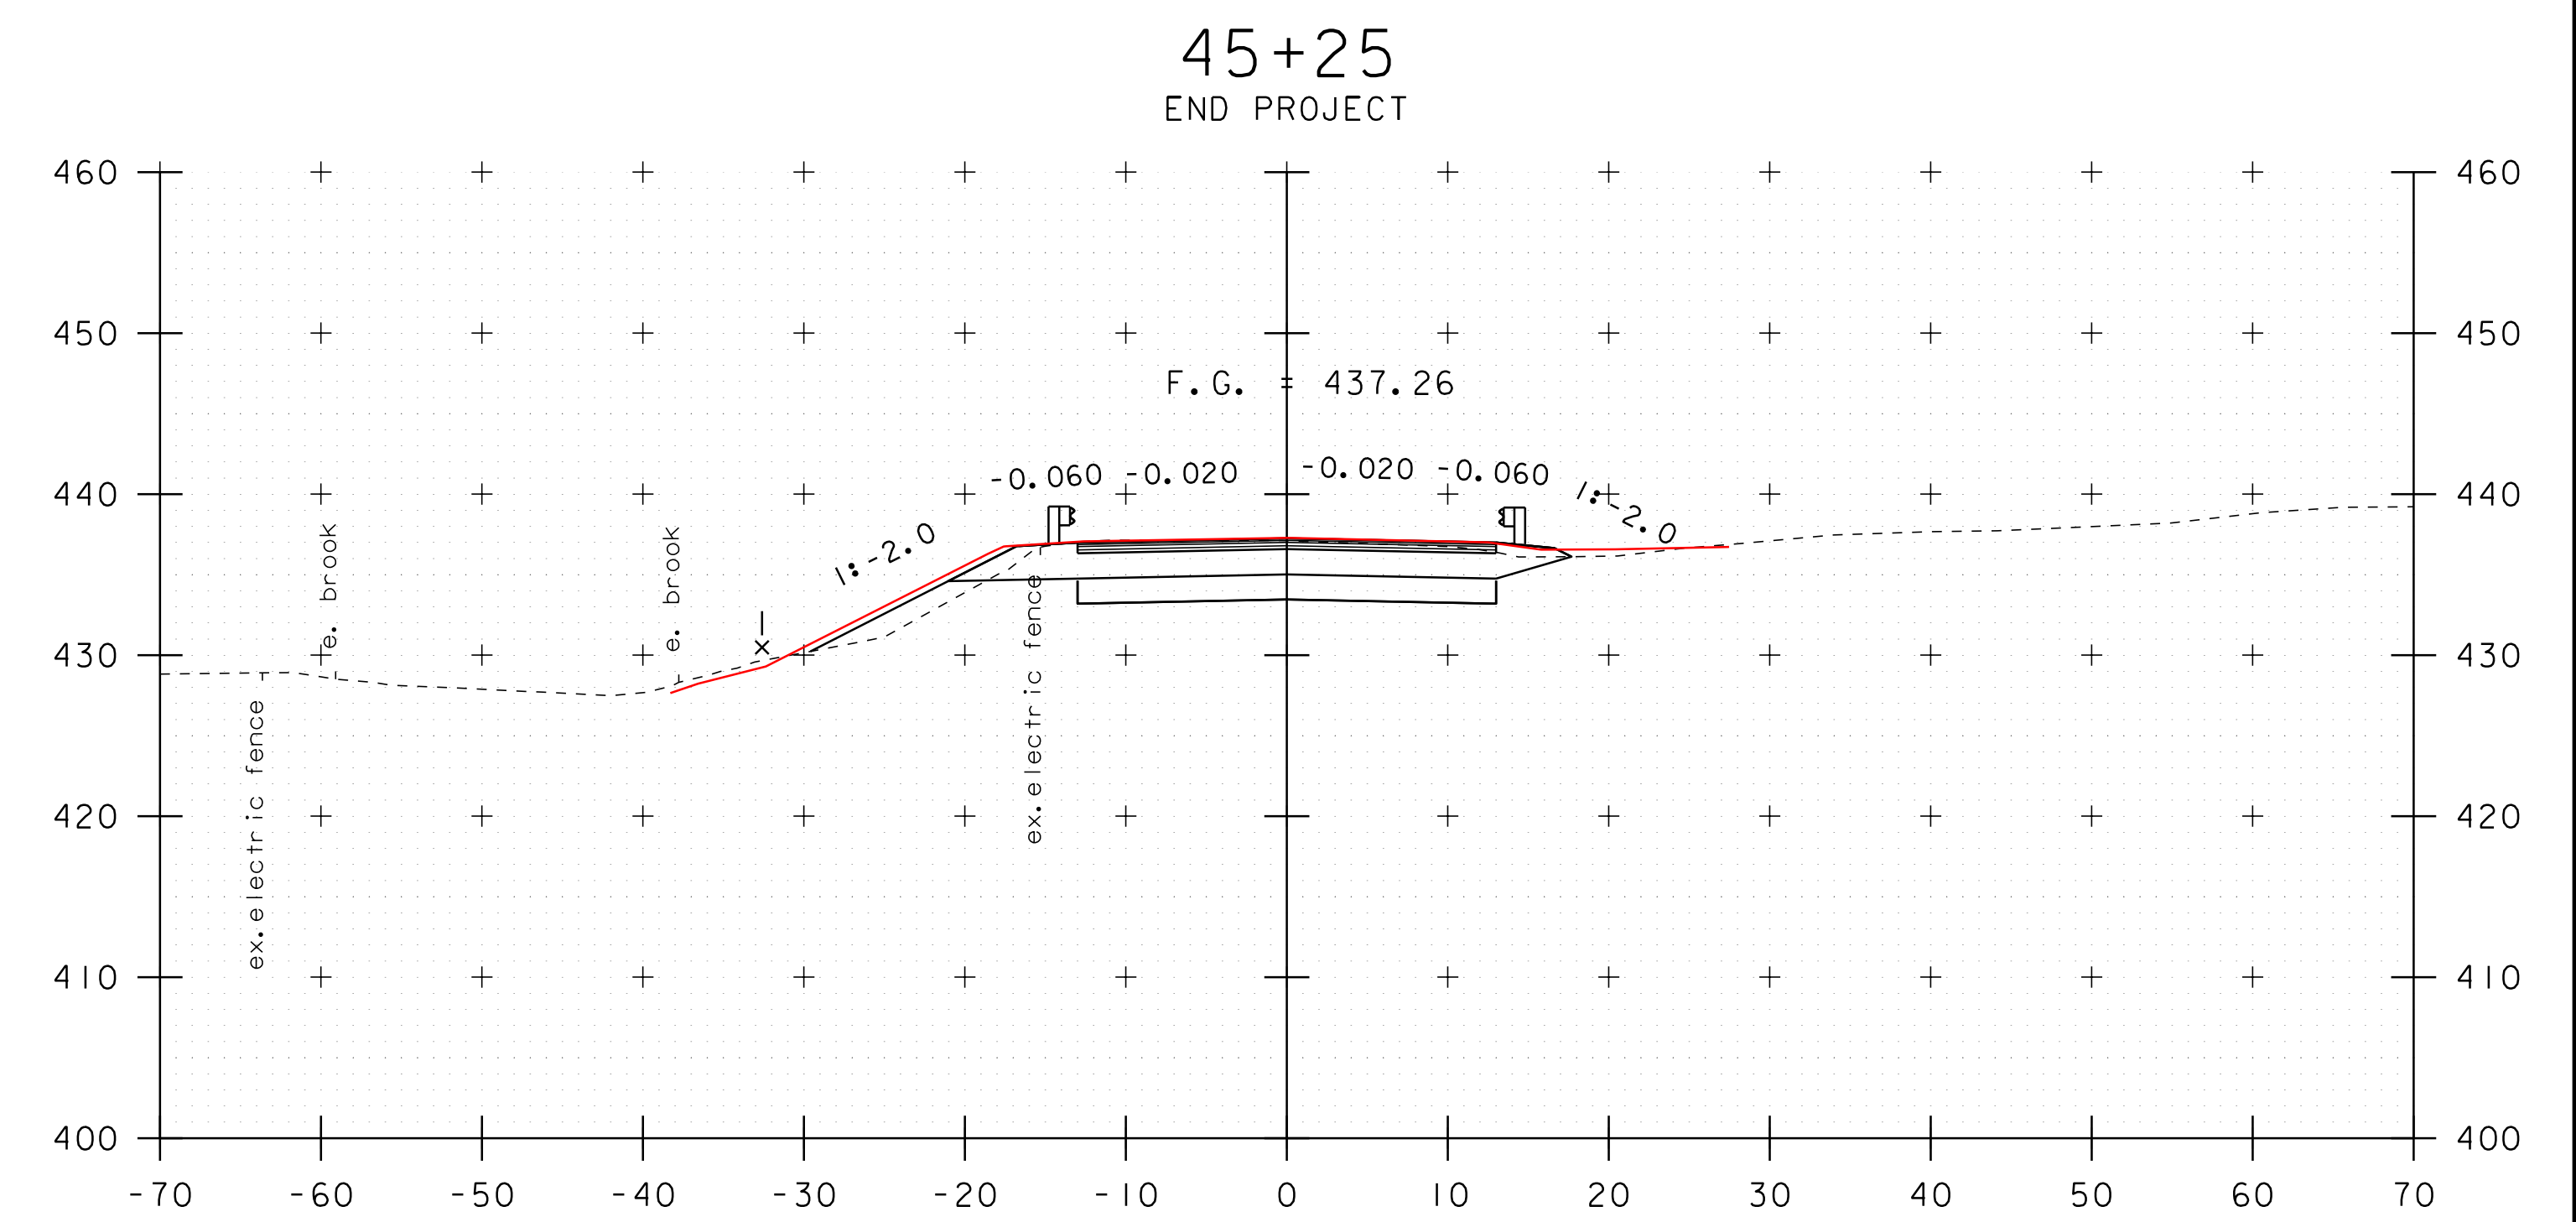
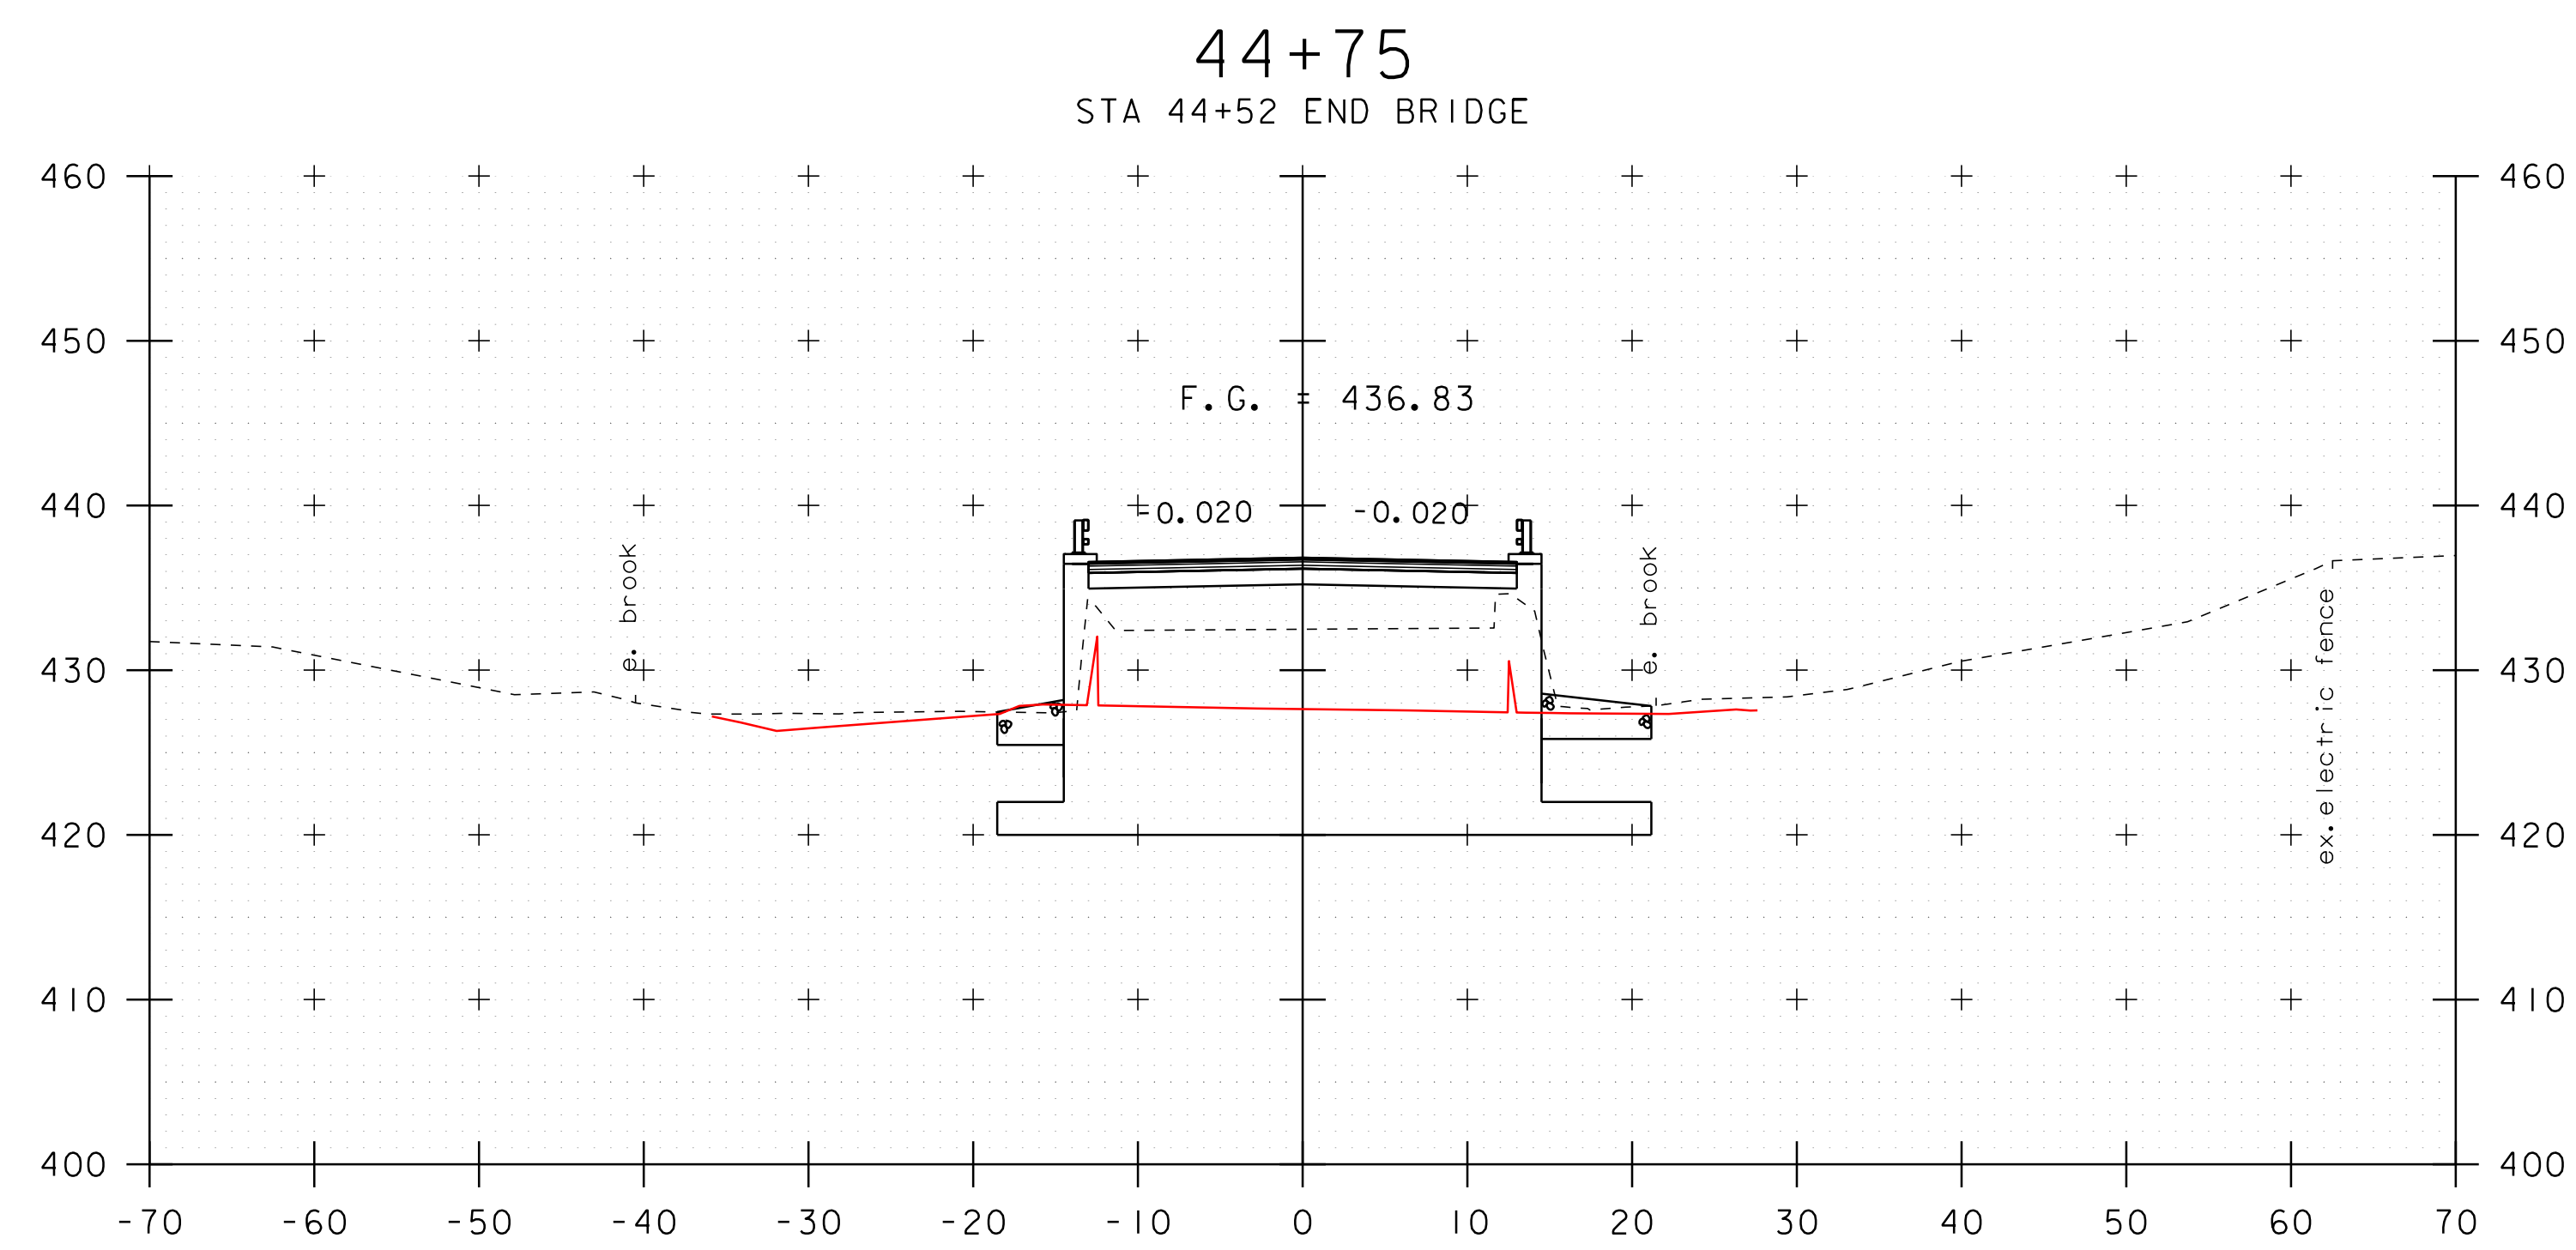
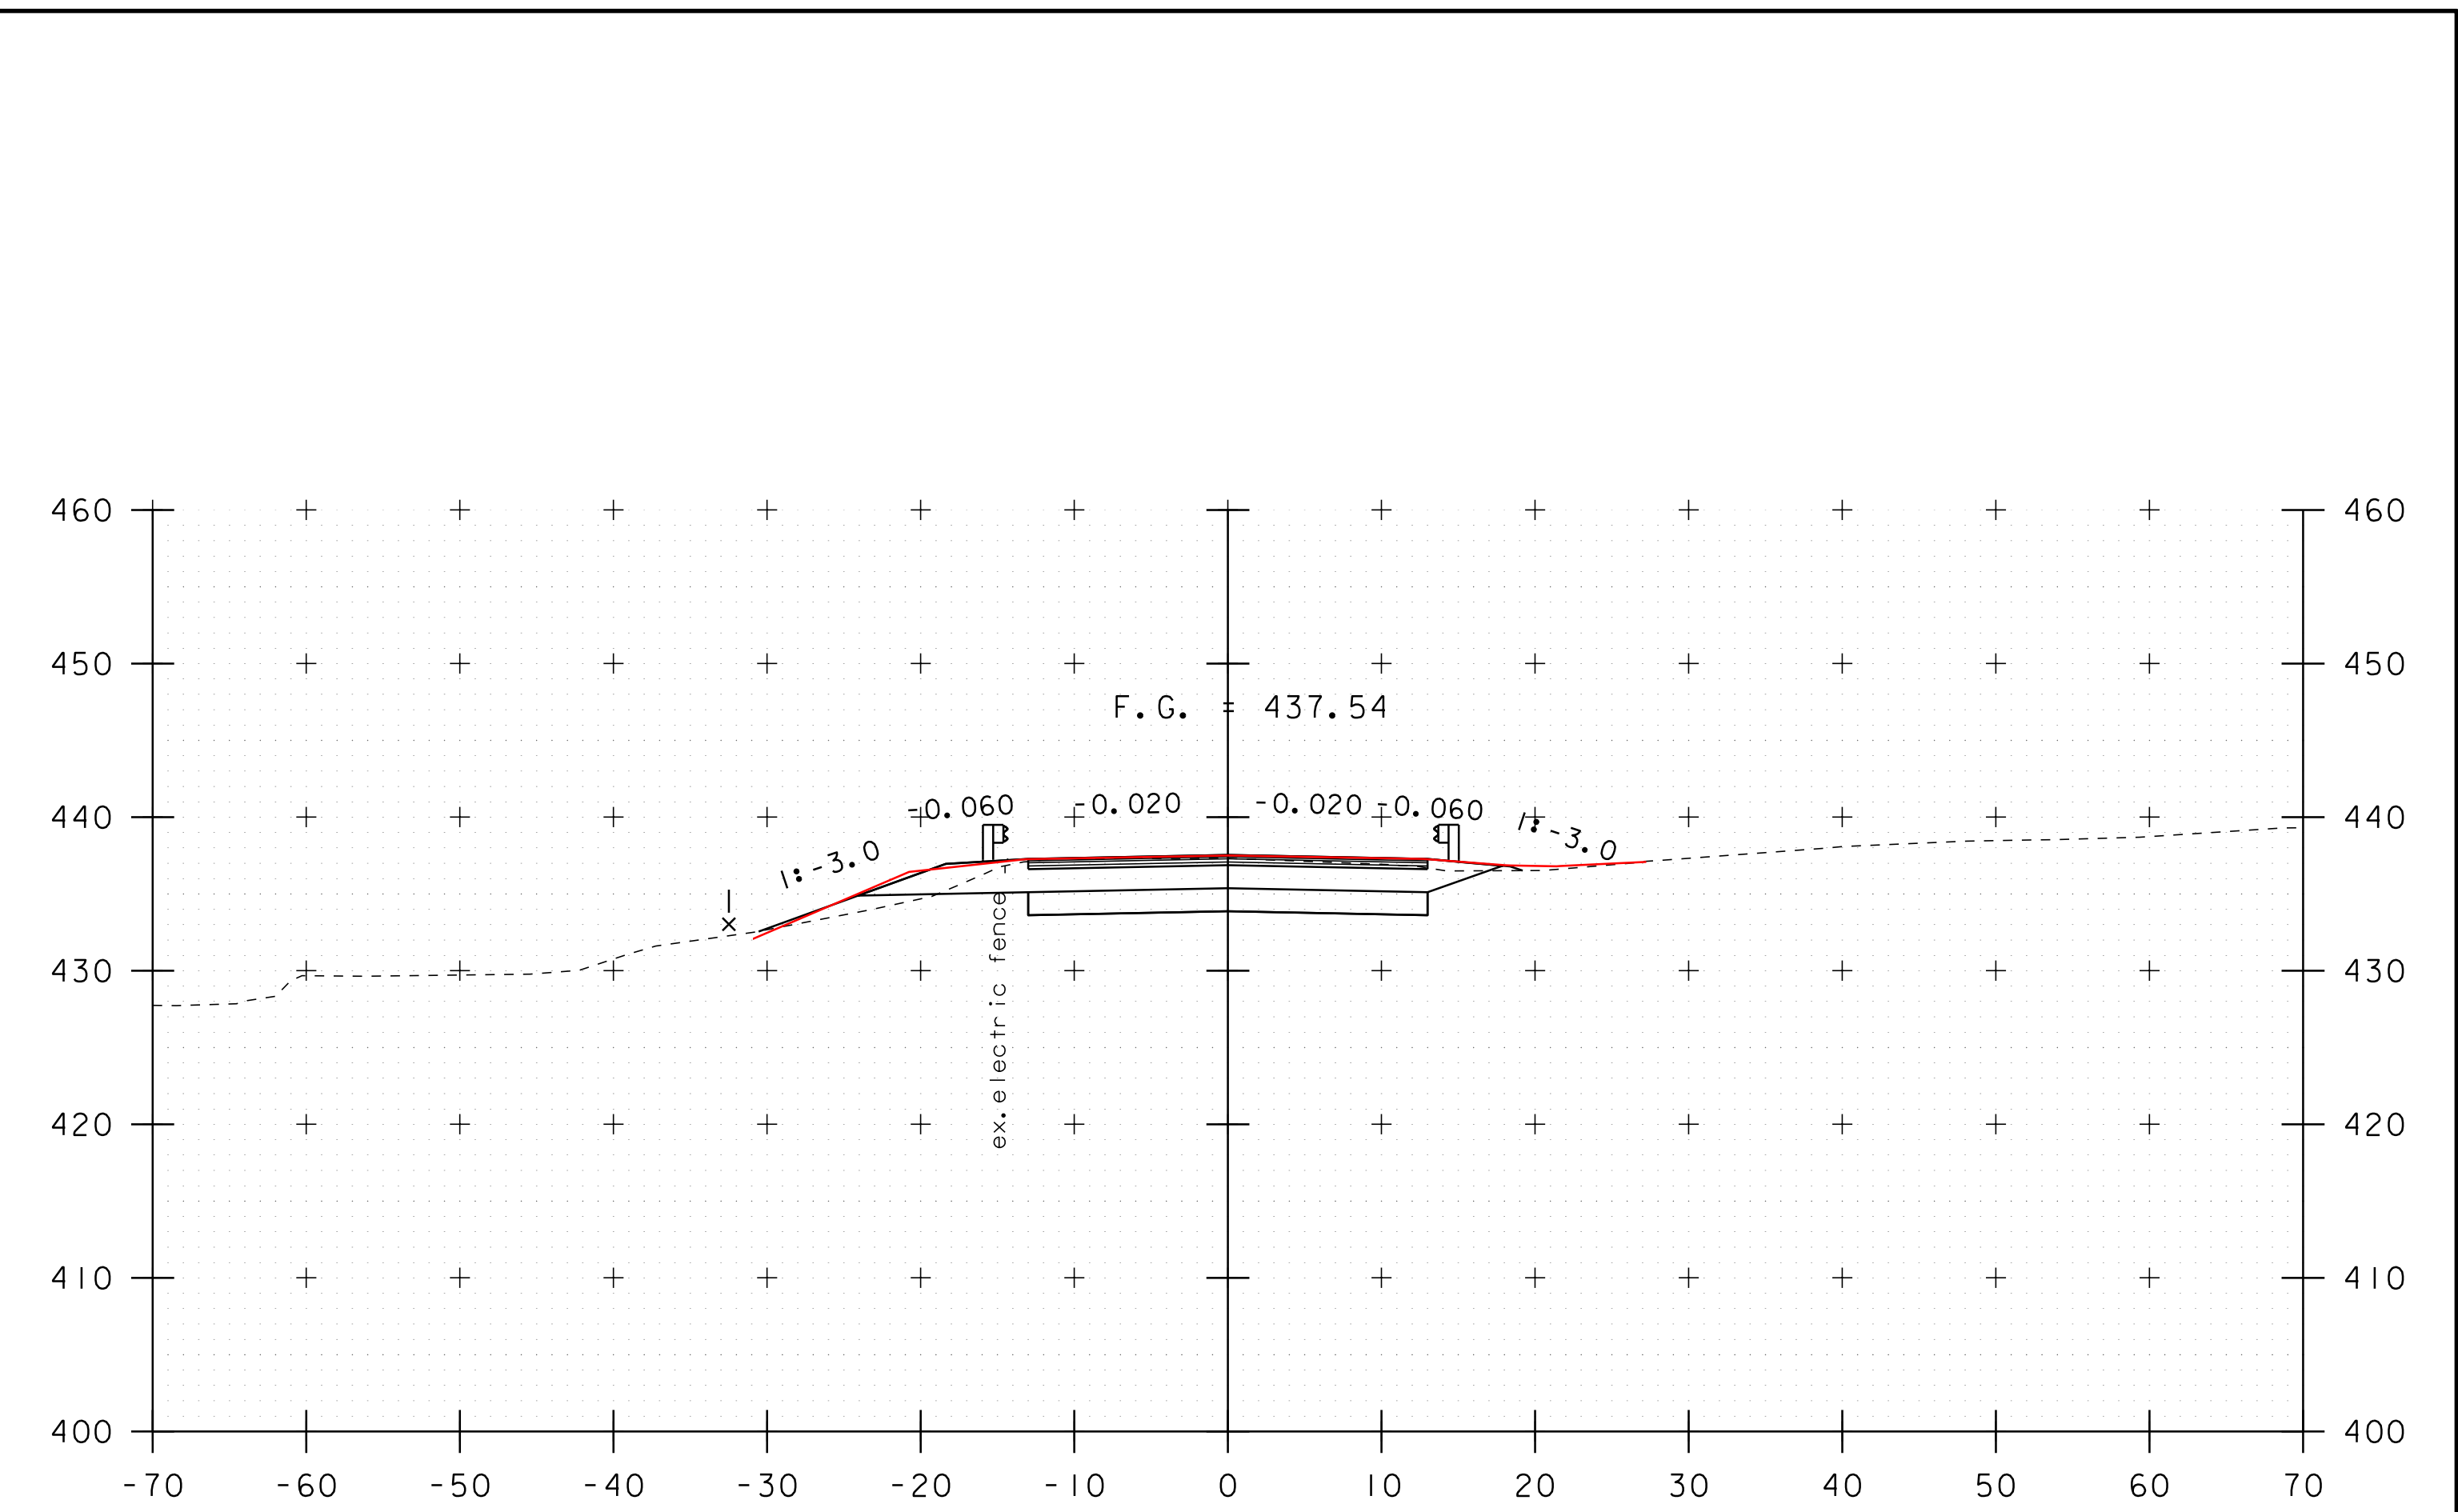
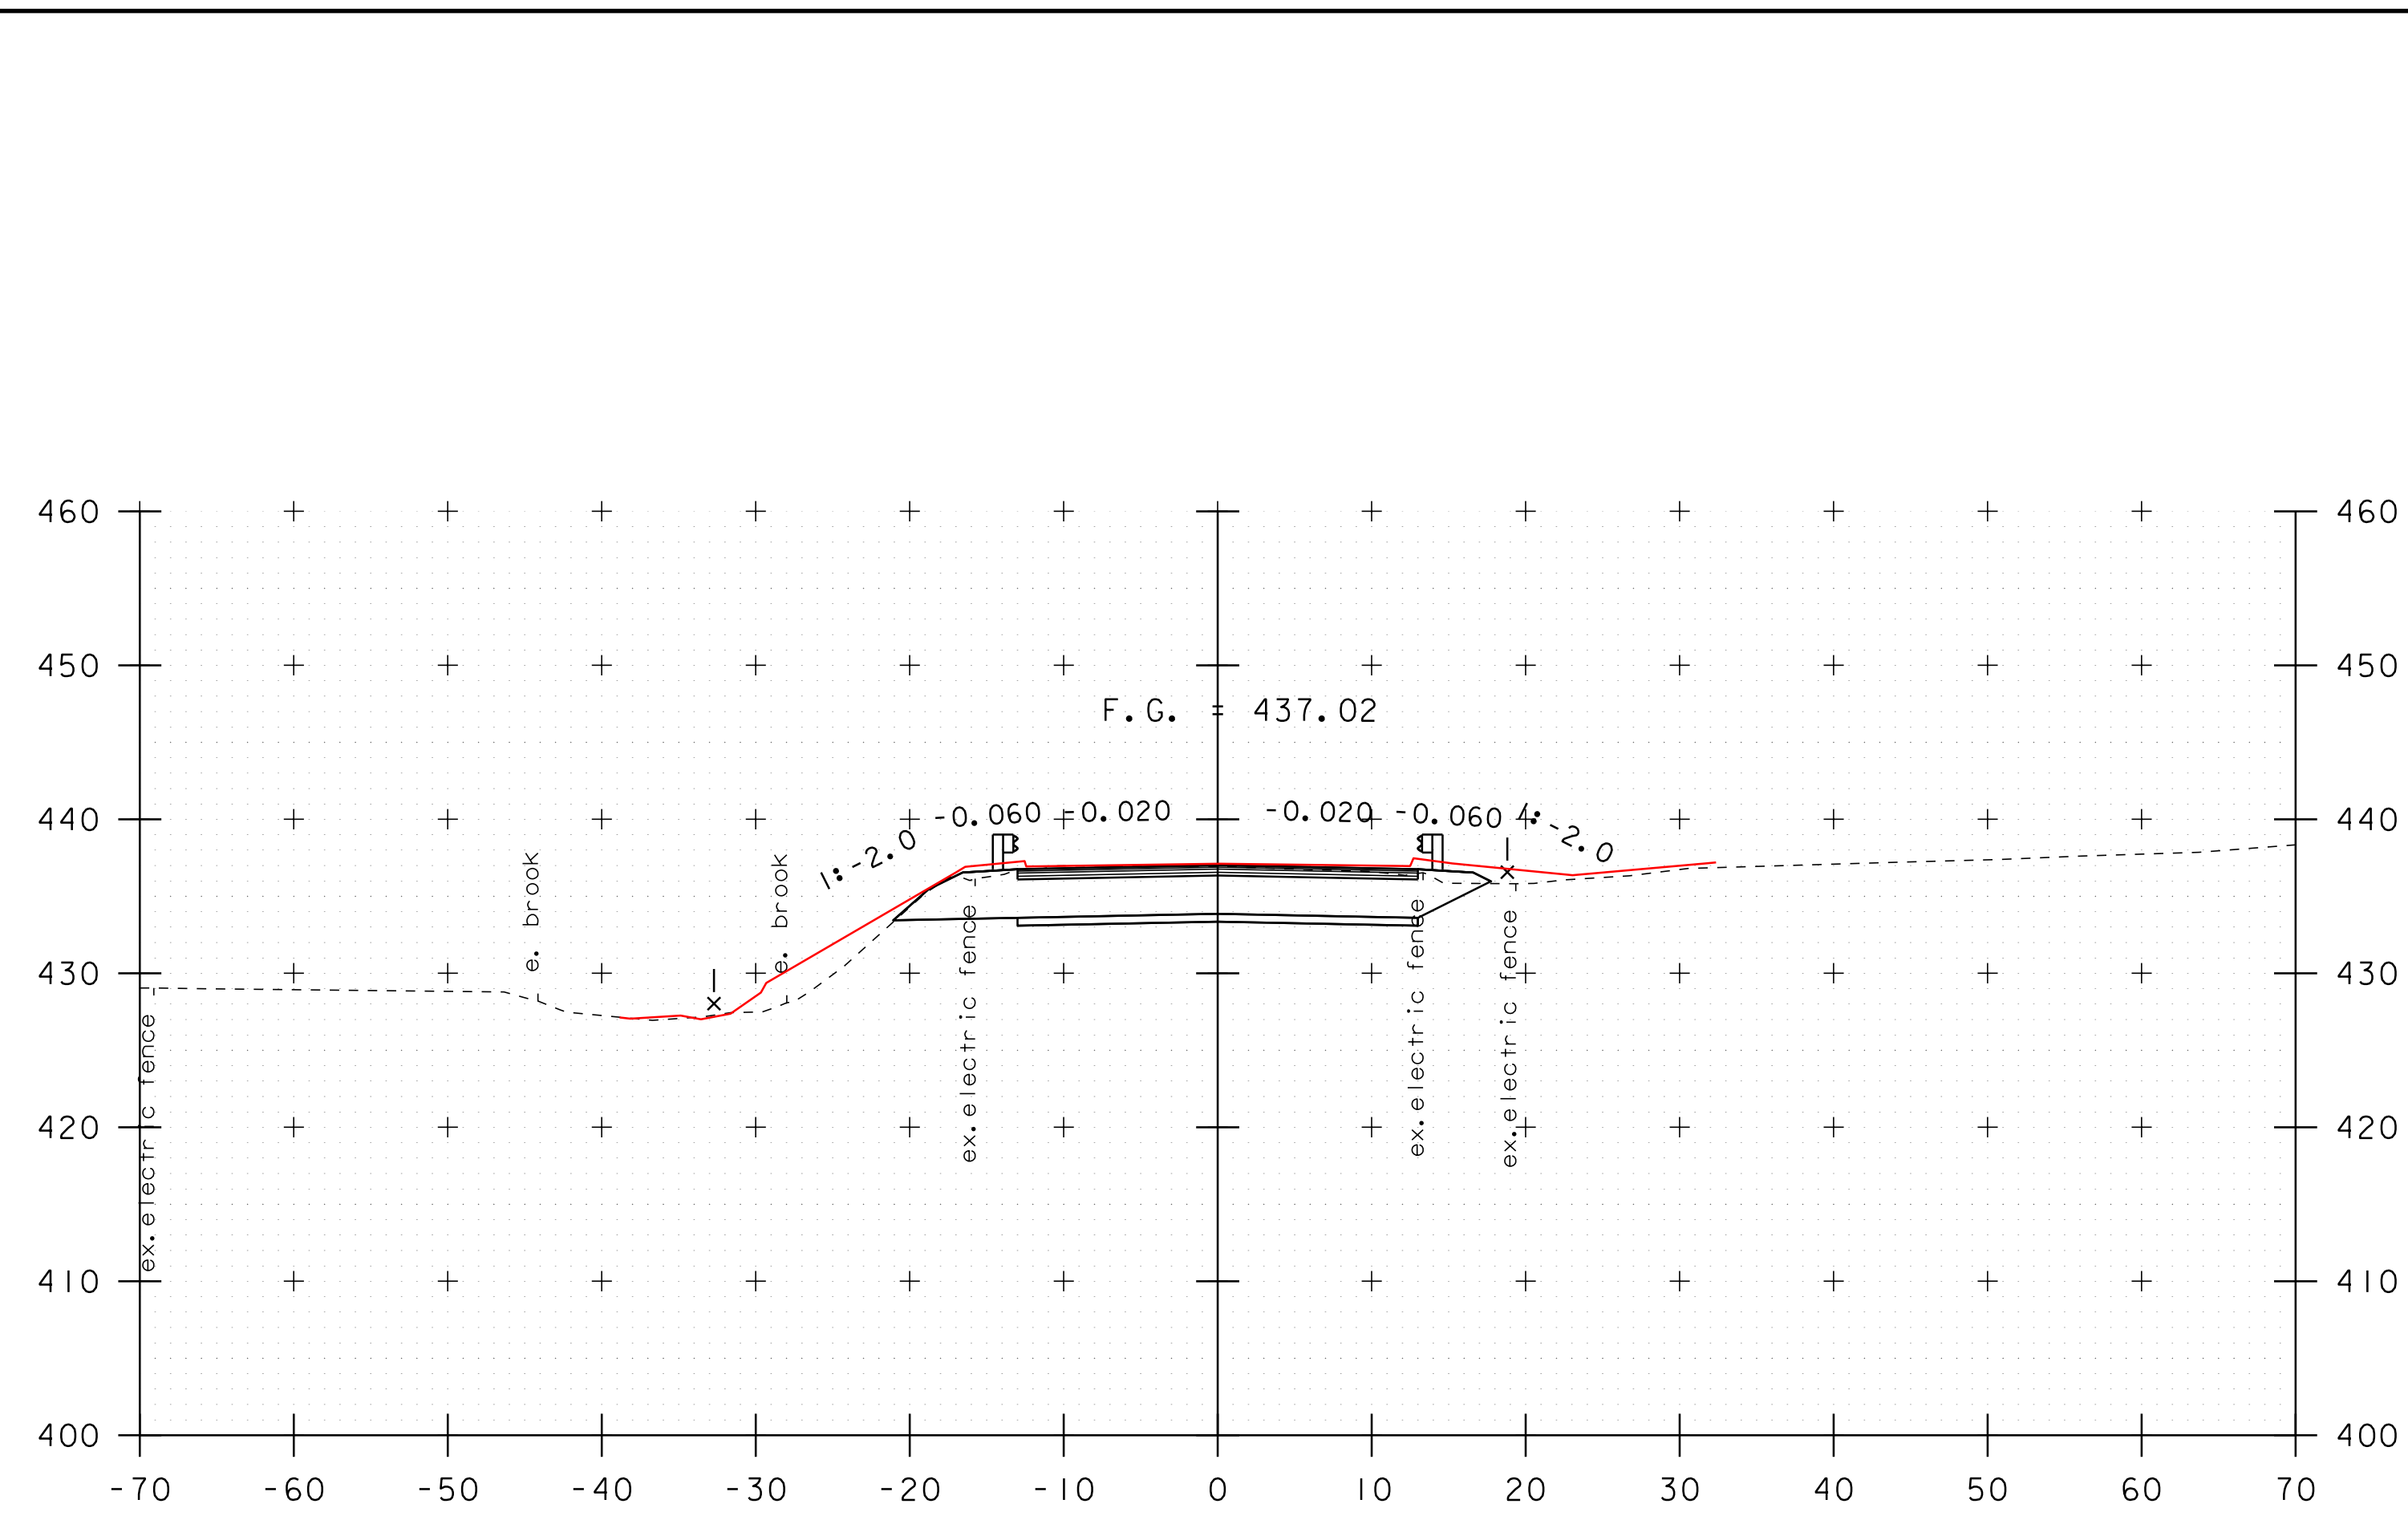


44+50

45+00

STA. 44+50 TO STA. 45+25

PROJECT NAME:	RICHFORD	PLOT DATE:	09-AUG-2016 09:57
PROJECT NUMBER:	BRF 0302(29)	DRAWN BY:	R. PELLETT
FILE NAME:	sl2j158xs.dgn	CHECKED BY:	H. SALLS
PROJECT LEADER:	C. CARLSON	SHEET	31 OF 64
DESIGNED BY:	H. SALLS		
MAINLINE CROSS SECTIONS	3		

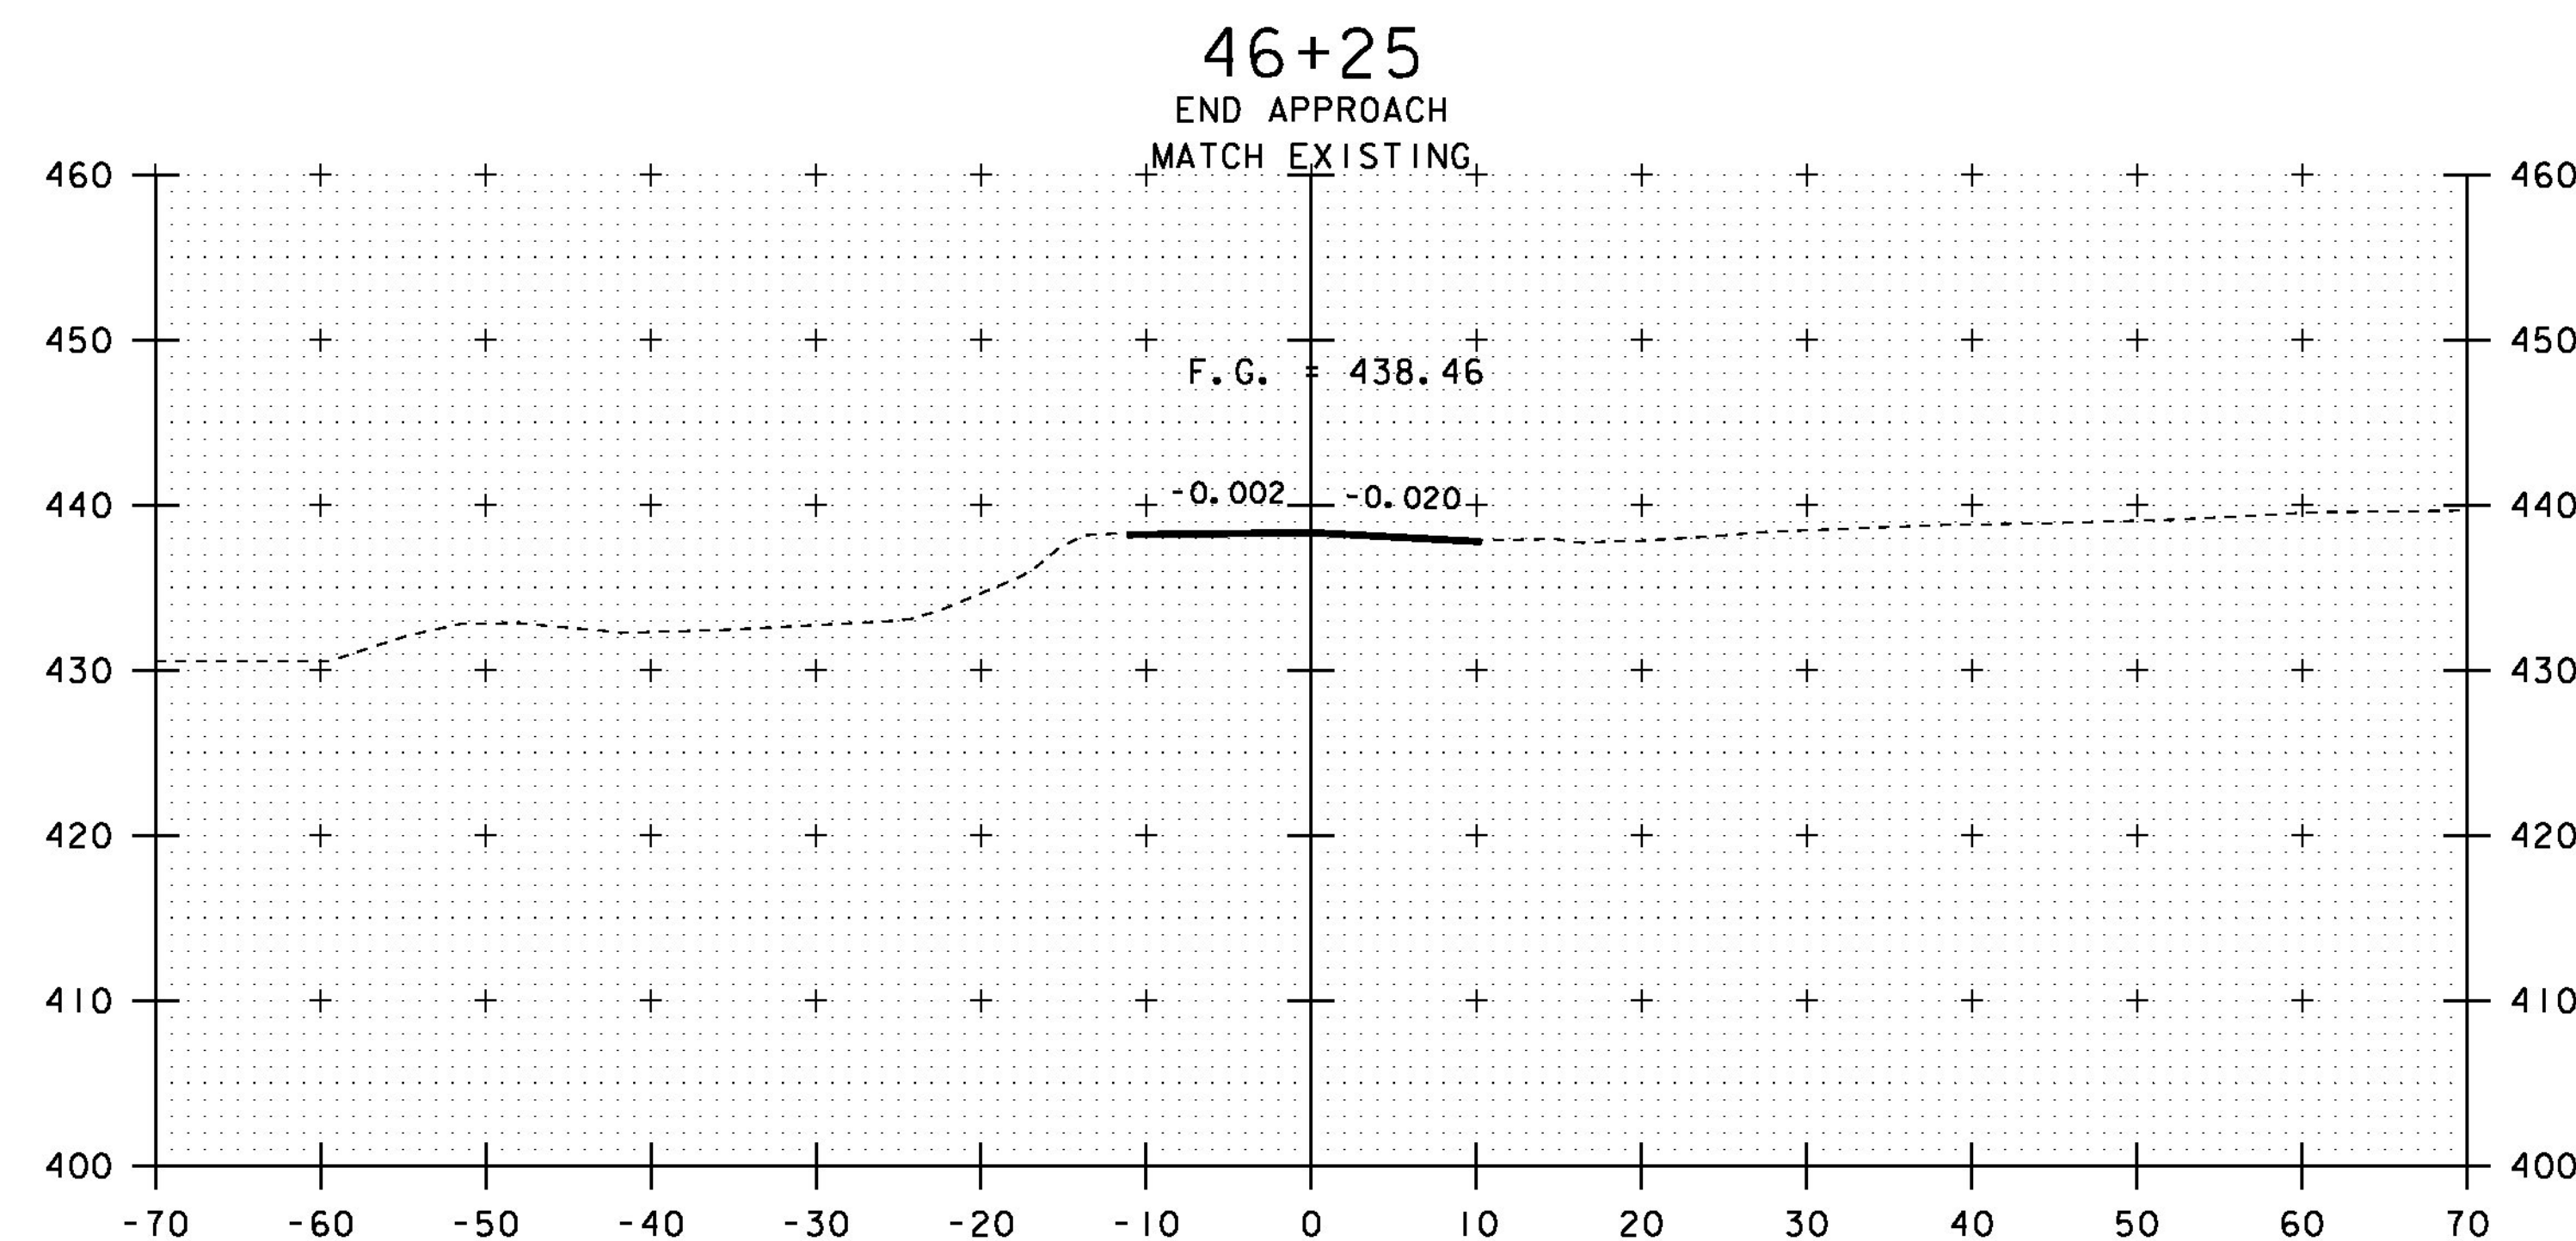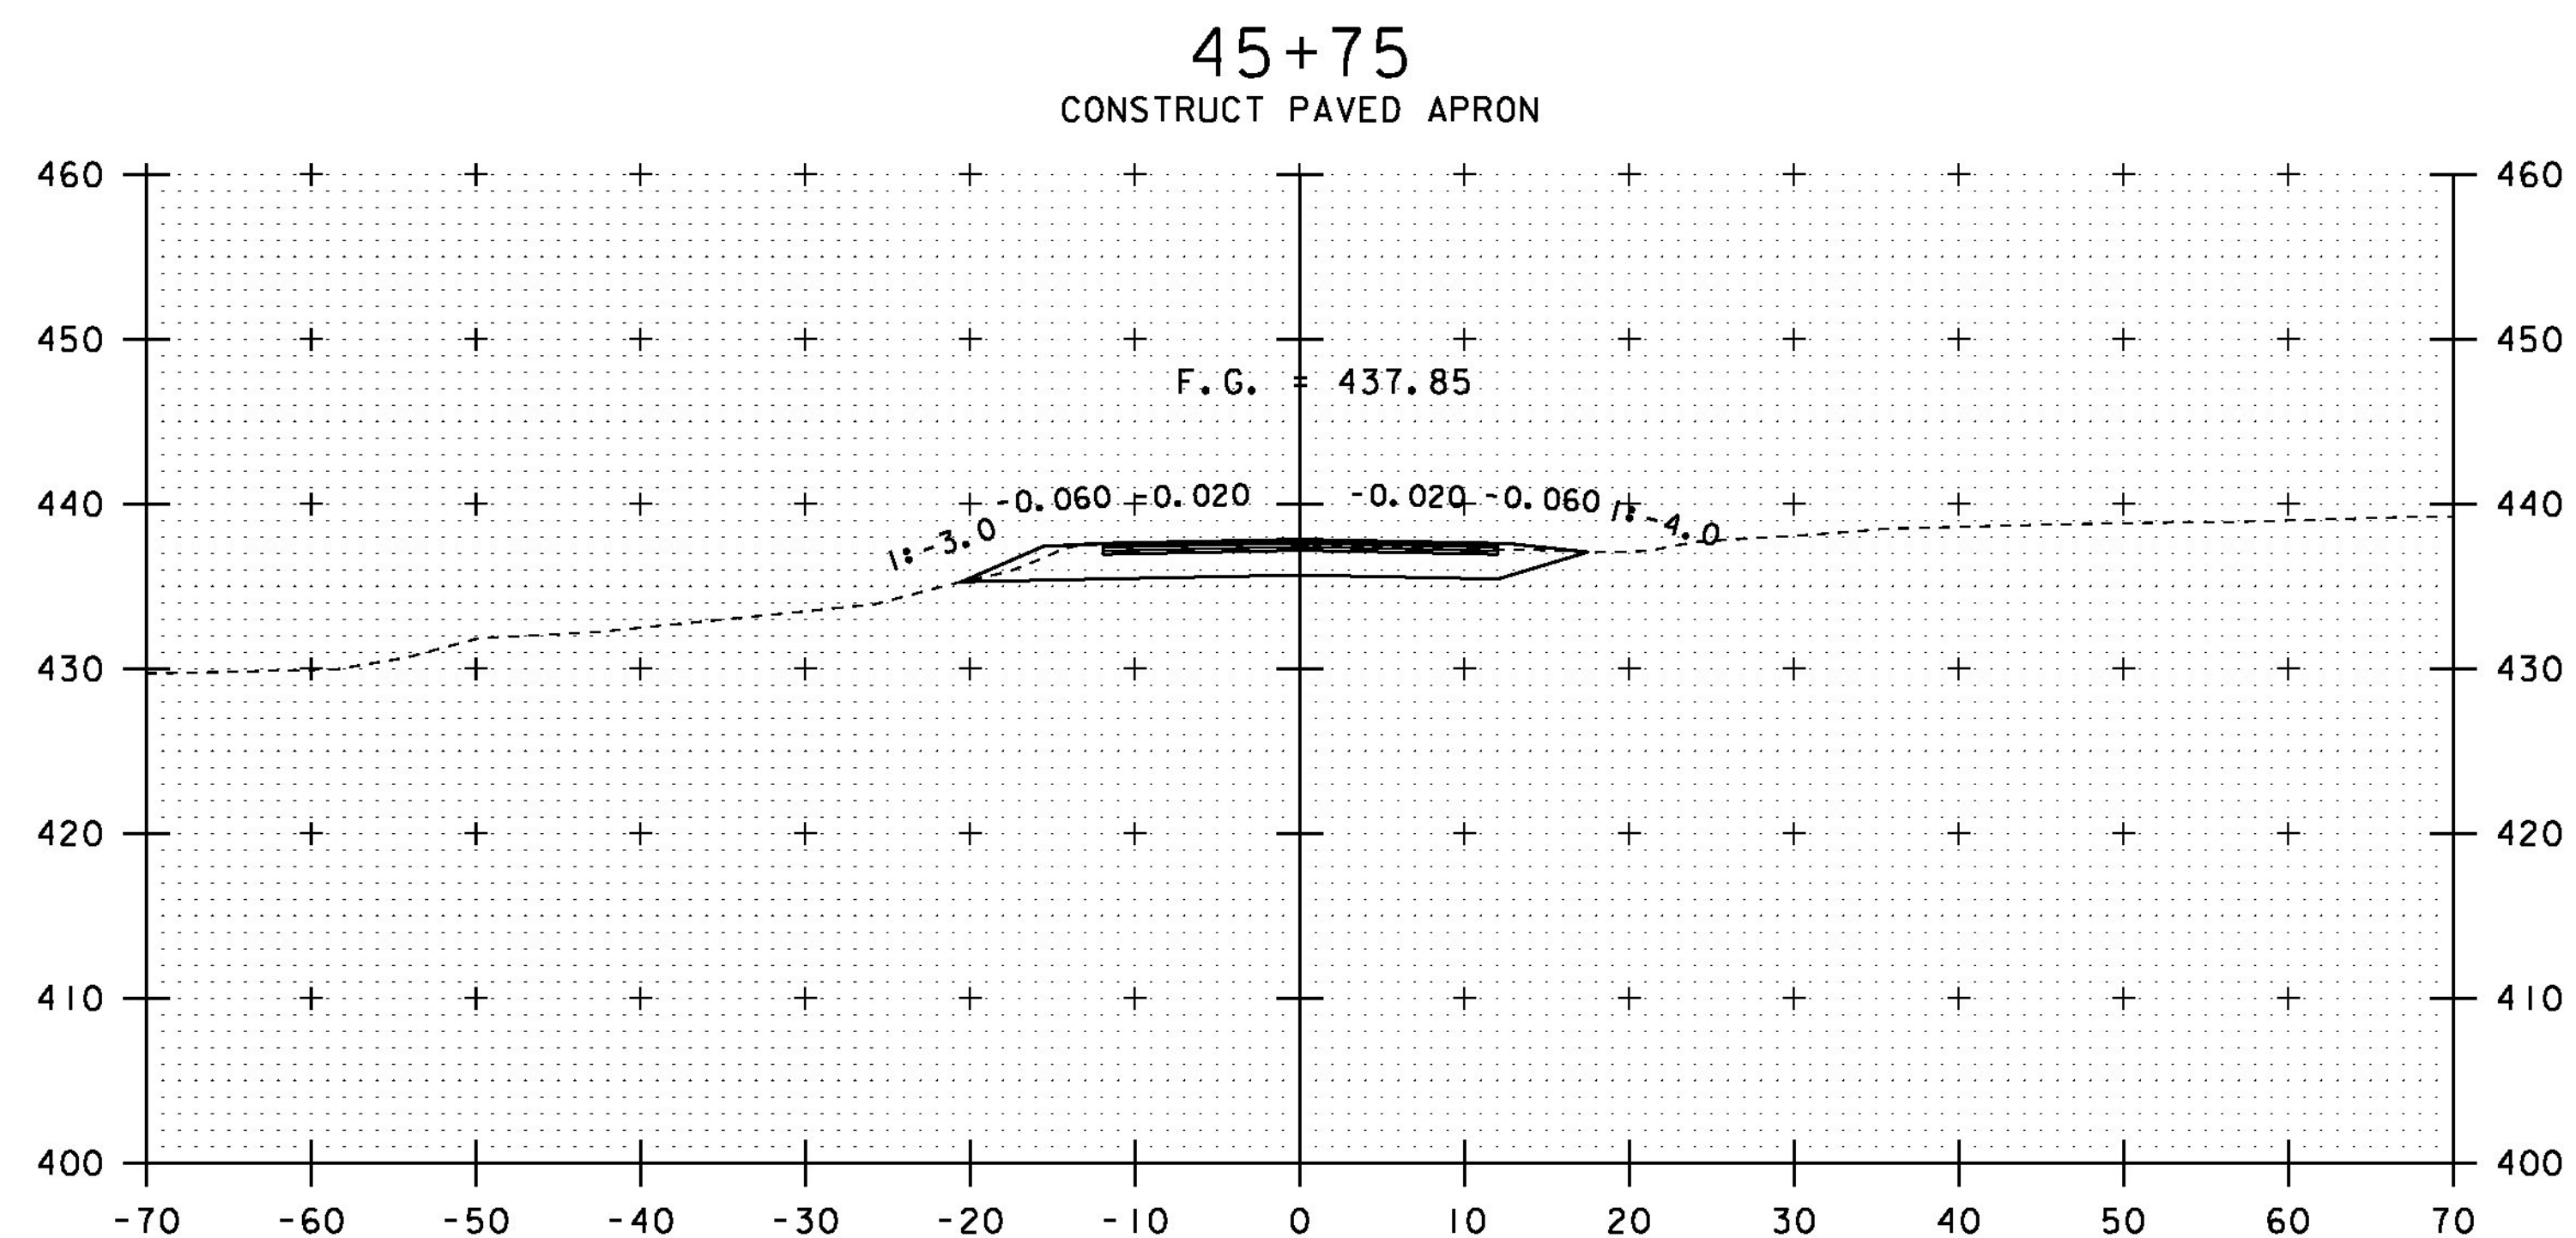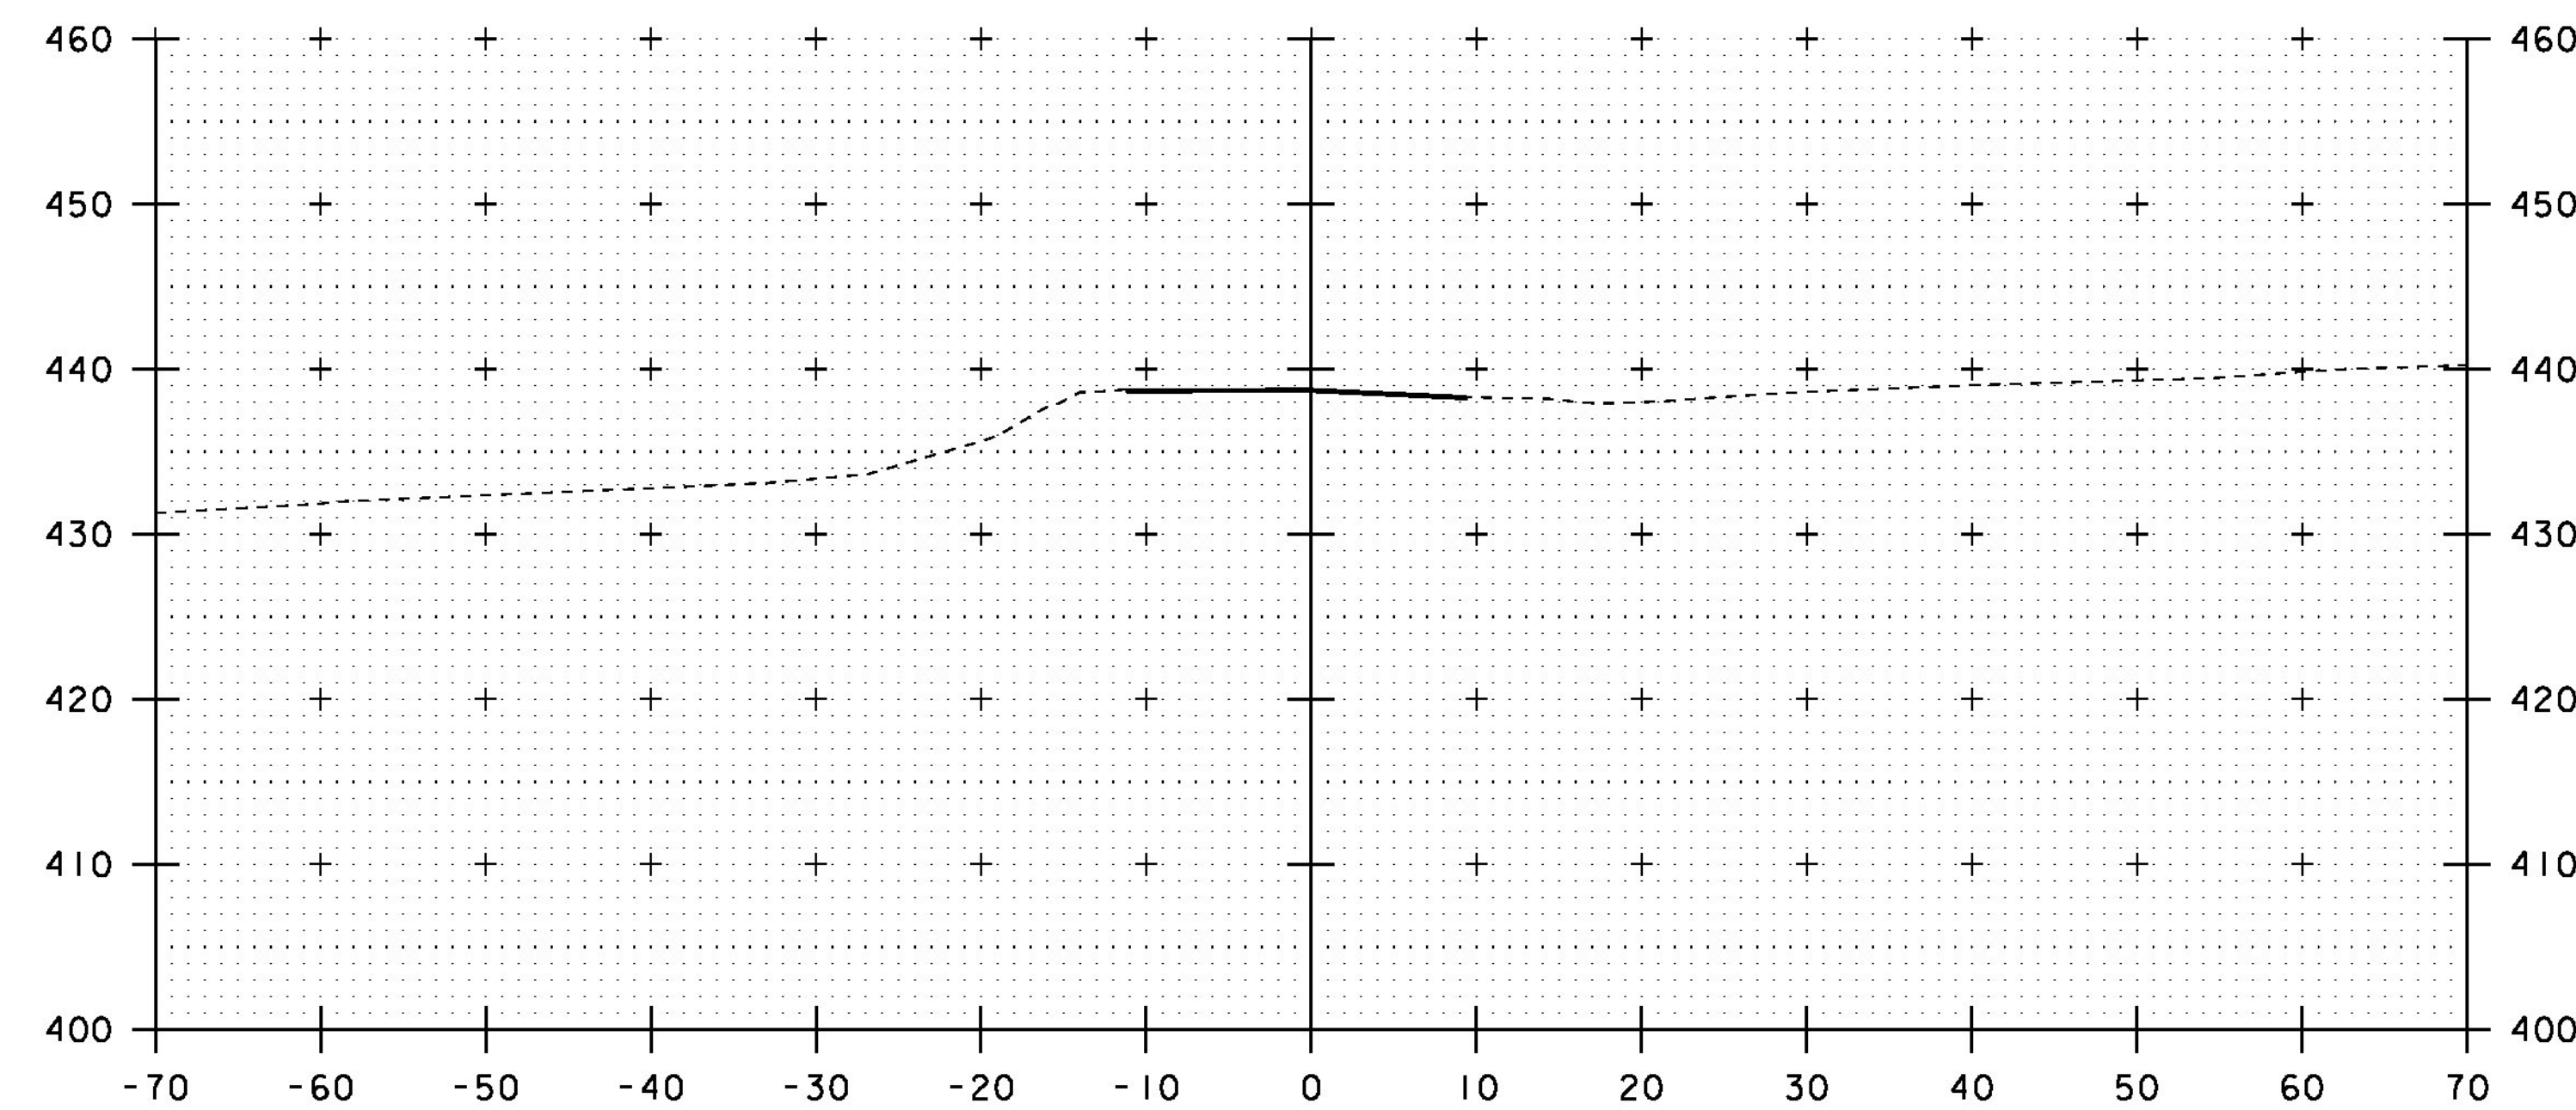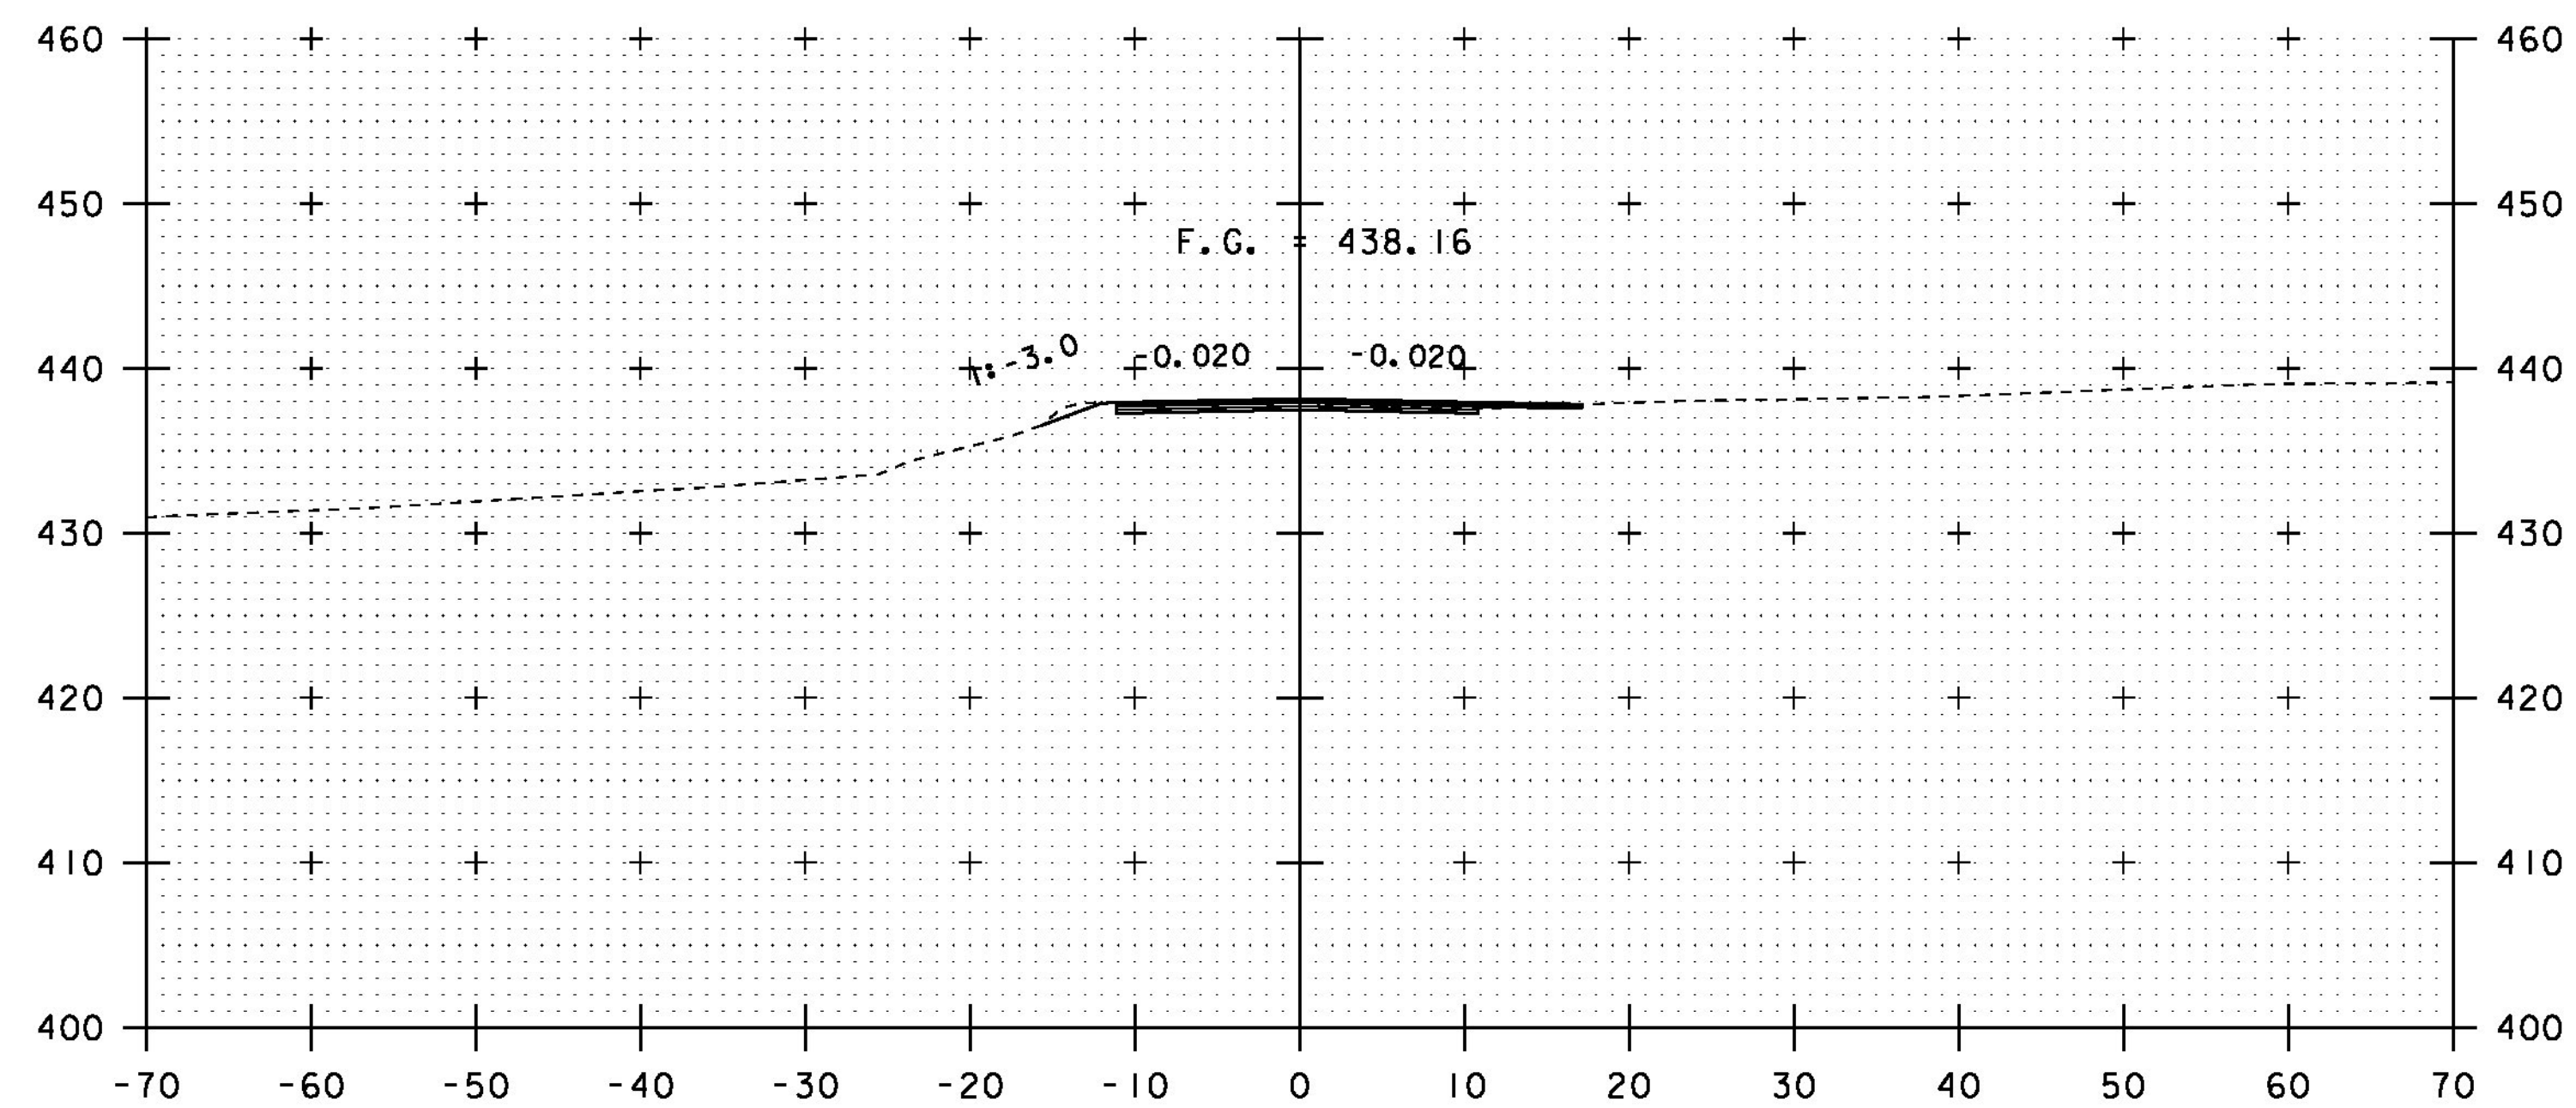

45+75  
 CONSTRUCT PAVED APRON


46+25  
 END APPROACH  
 MATCH EXISTING

45+50


46+00

STA. 45+50 TO STA. 46+25


PROJECT NAME:	RICHFORD	PLOT DATE:	11-DEC-2014
PROJECT NUMBER:	BRF 0302(29)	DRAWN BY:	R. PELLETT
FILE NAME:	st2j158xs.dgn	DESIGNED BY:	H. SALLS
PROJECT LEADER:	C. CARLSON	CHECKED BY:	H. SALLS
MAINLINE CROSS SECTIONS	4	SHEET	28 OF 36

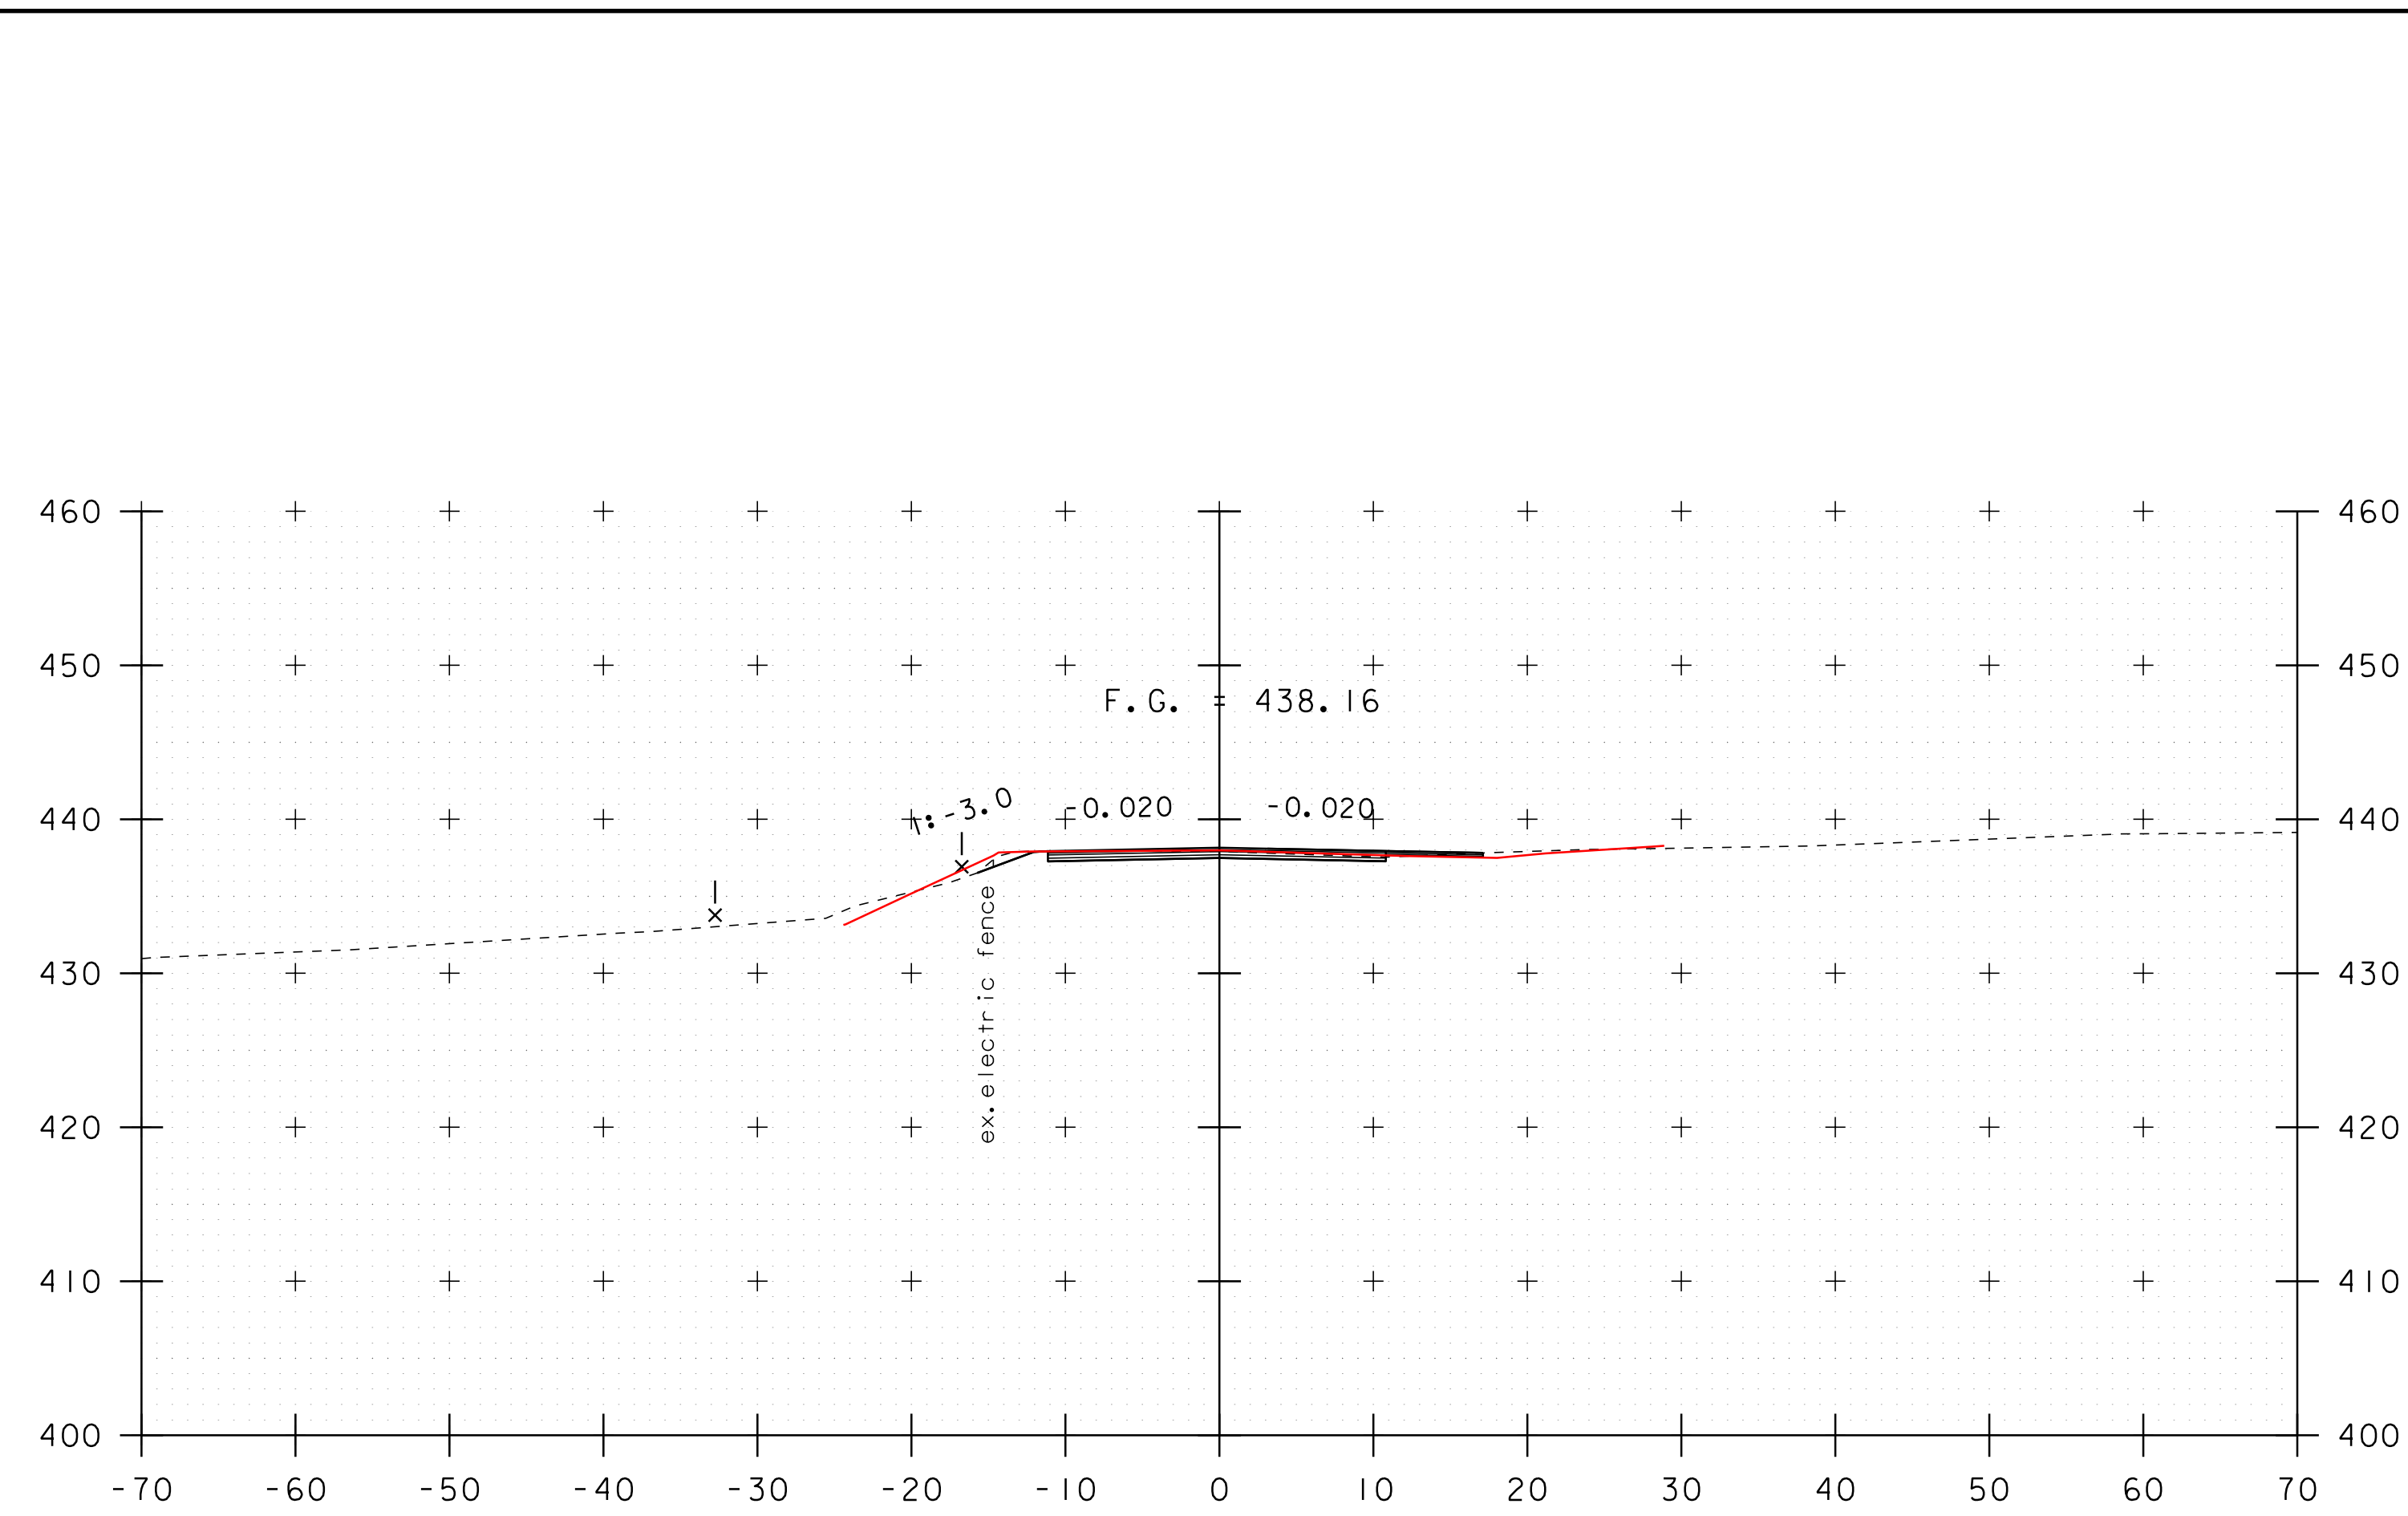


45+75  
CONSTRUCT PAVED APRON

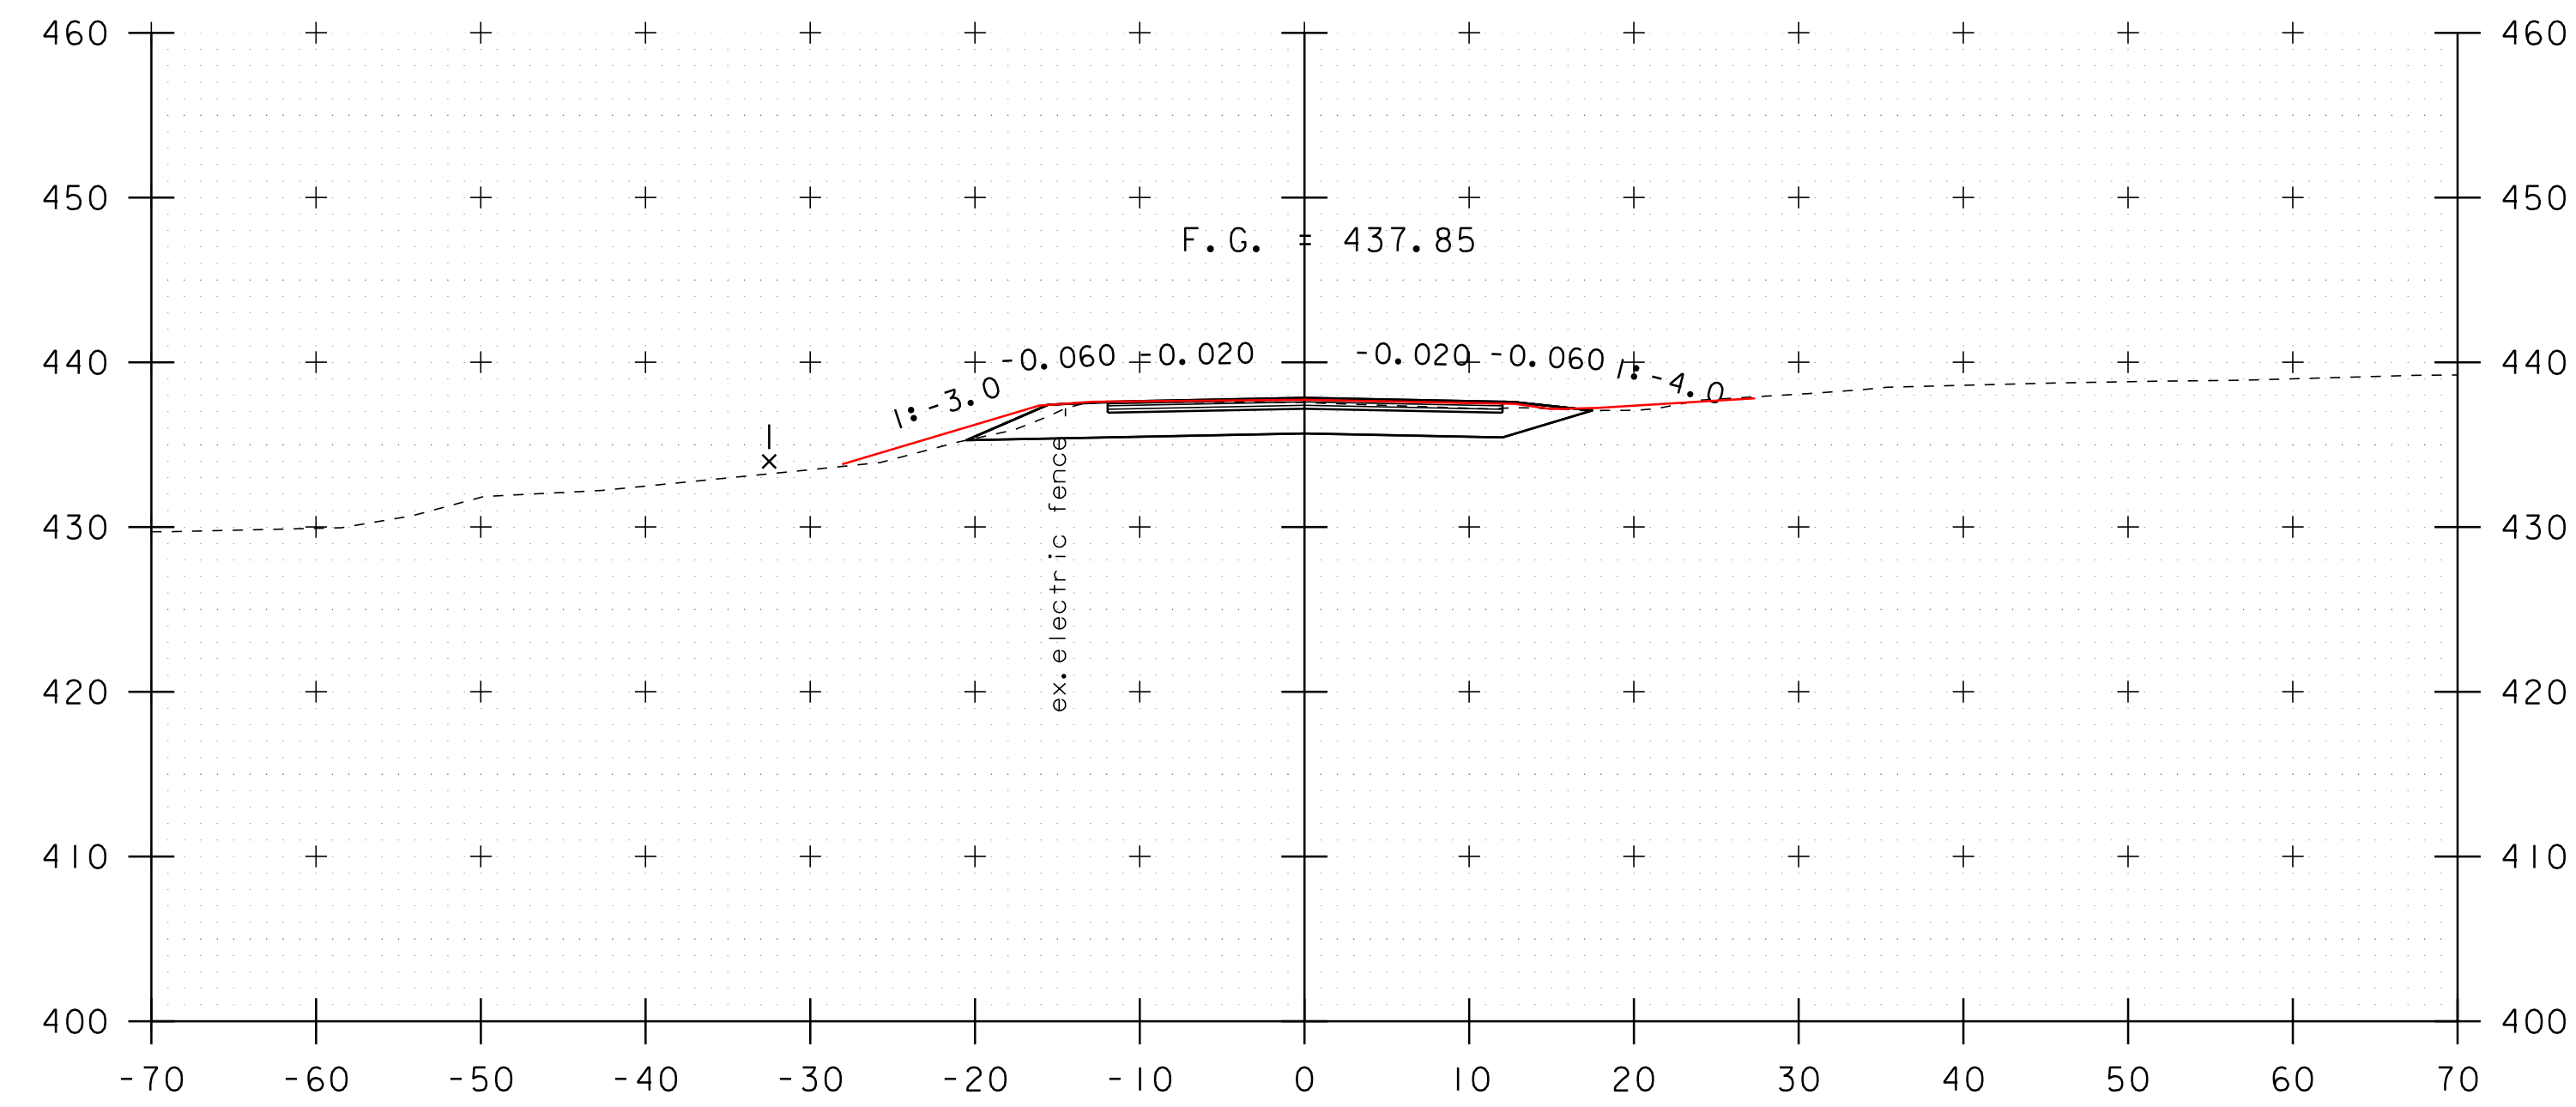

45+50

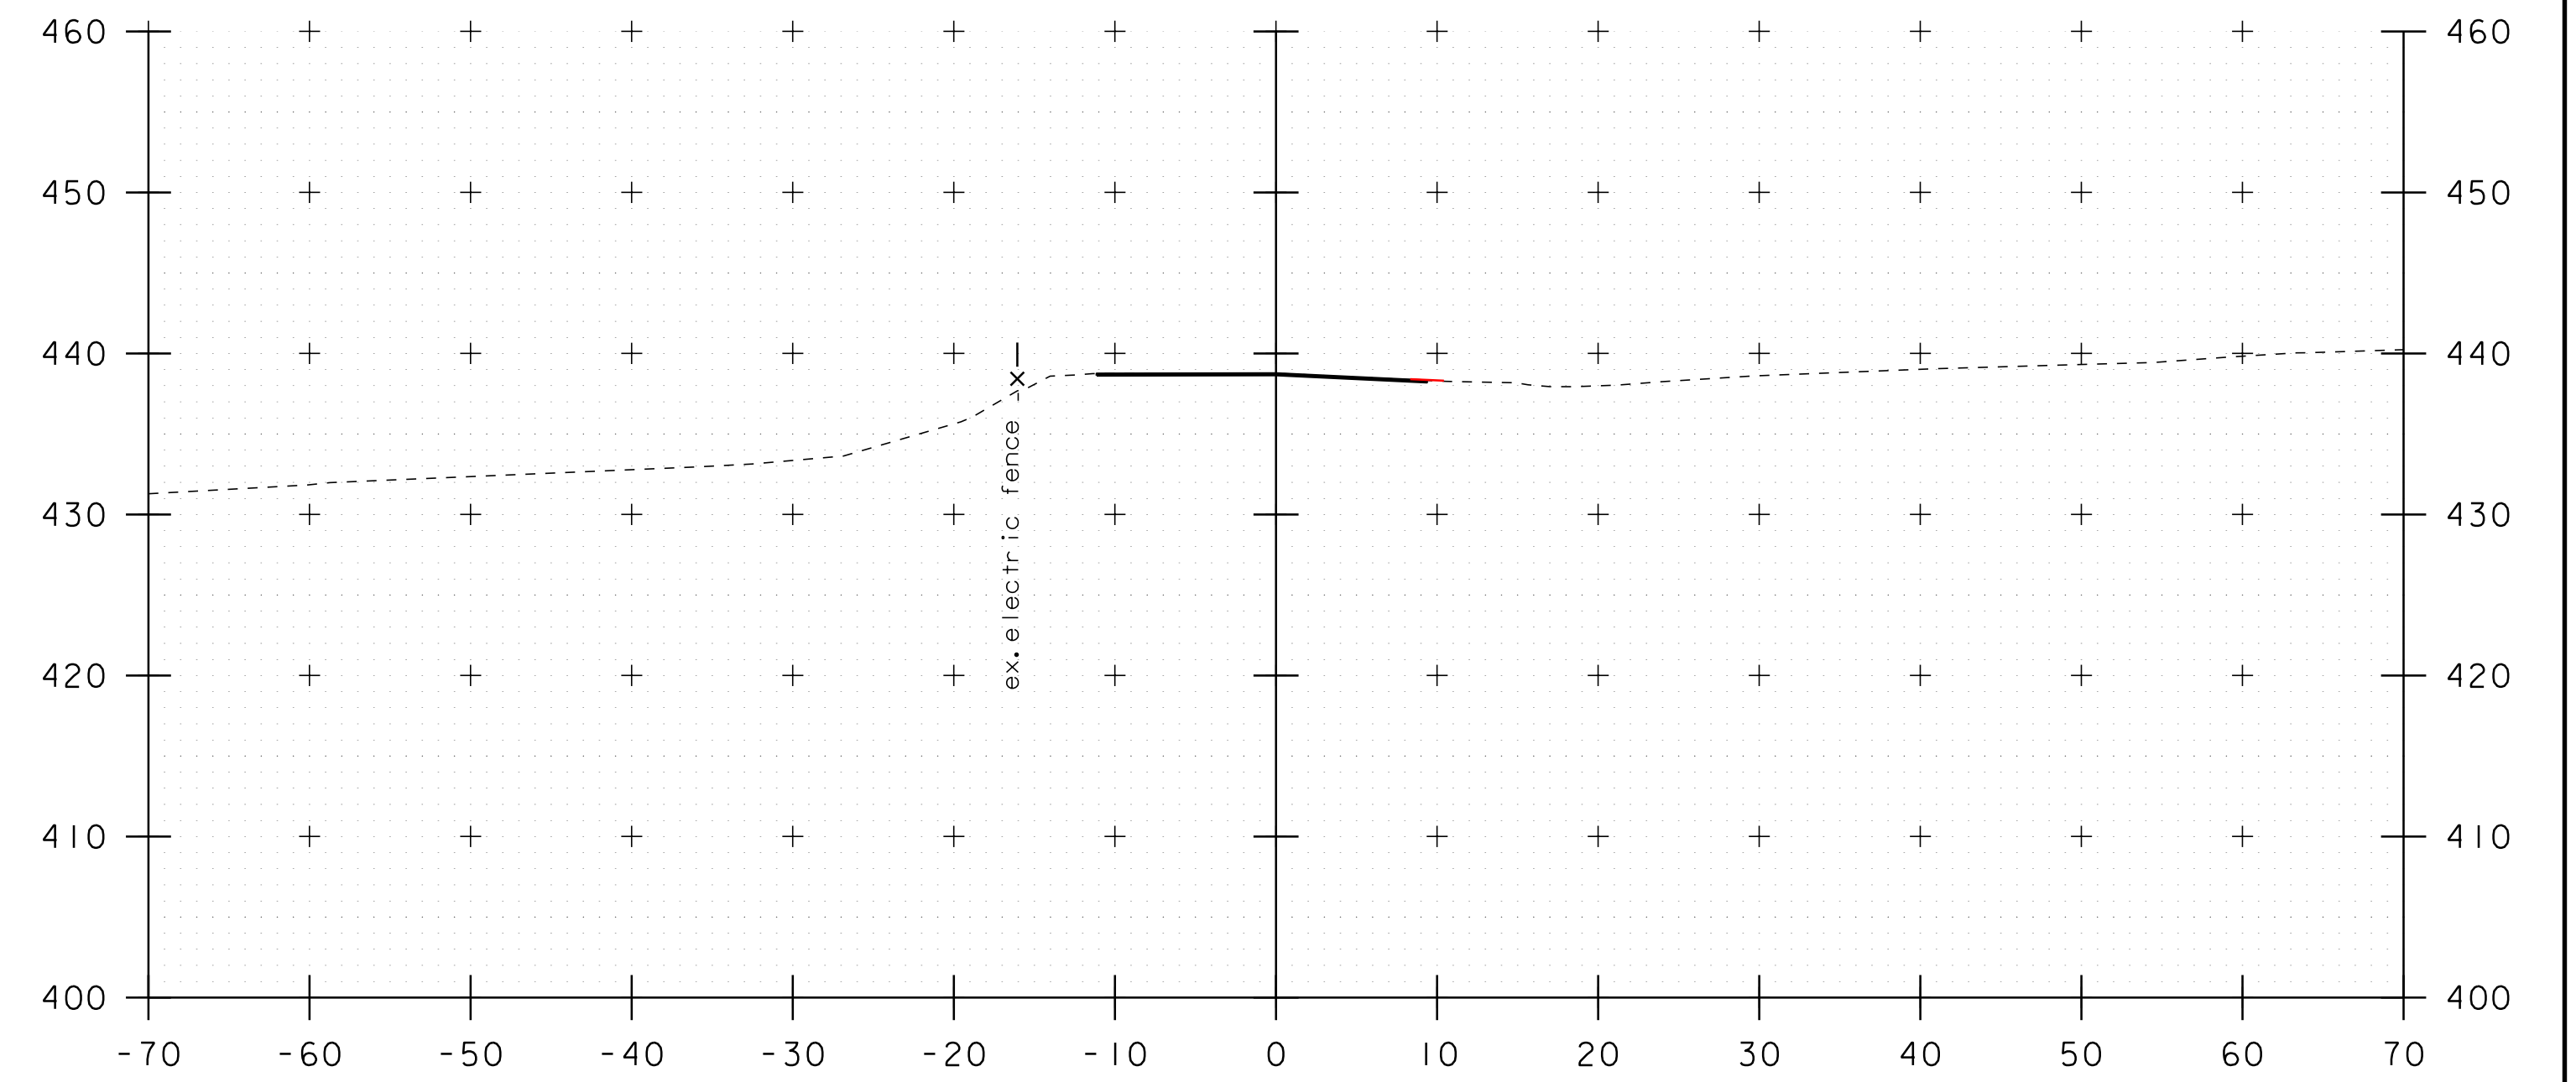


46+25  
END APPROACH  
MATCH EXISTING

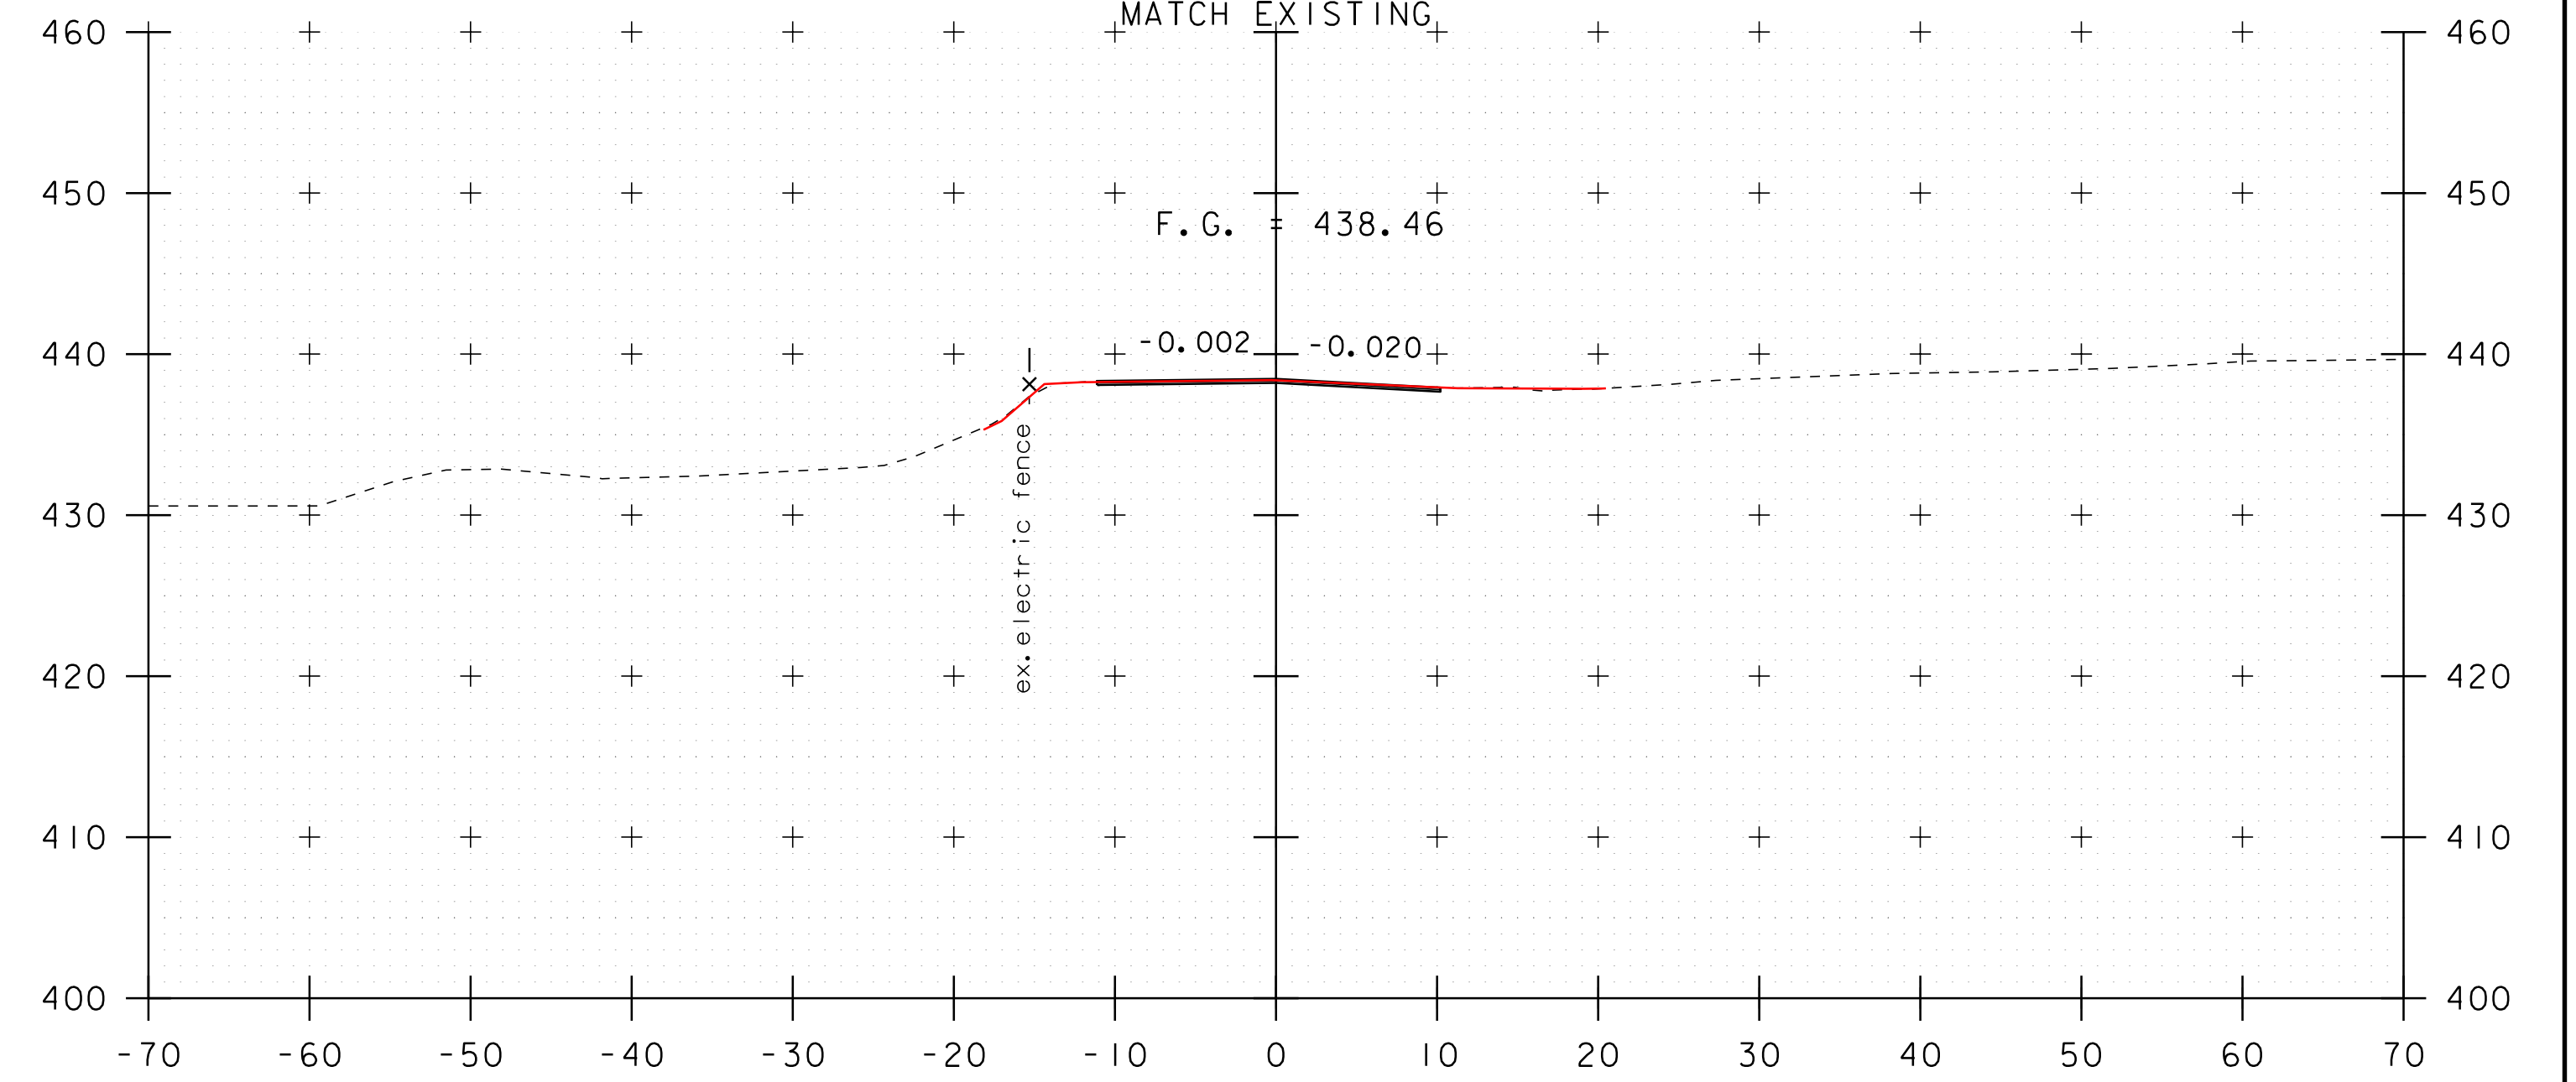

46+00


STA. 45+50 TO STA. 46+25

PROJECT NAME:	RICHFORD	PLOT DATE:	09-AUG-2016 09:57
PROJECT NUMBER:	BRF 0302(29)	DRAWN BY:	R. PELLETT
FILE NAME:	sl2j158xs.dgn	DESIGNED BY:	H. SALLS
PROJECT LEADER:	C. CARLSON	CHECKED BY:	H. SALLS
MAINLINE CROSS SECTIONS 4		SHEET	23 OF 24

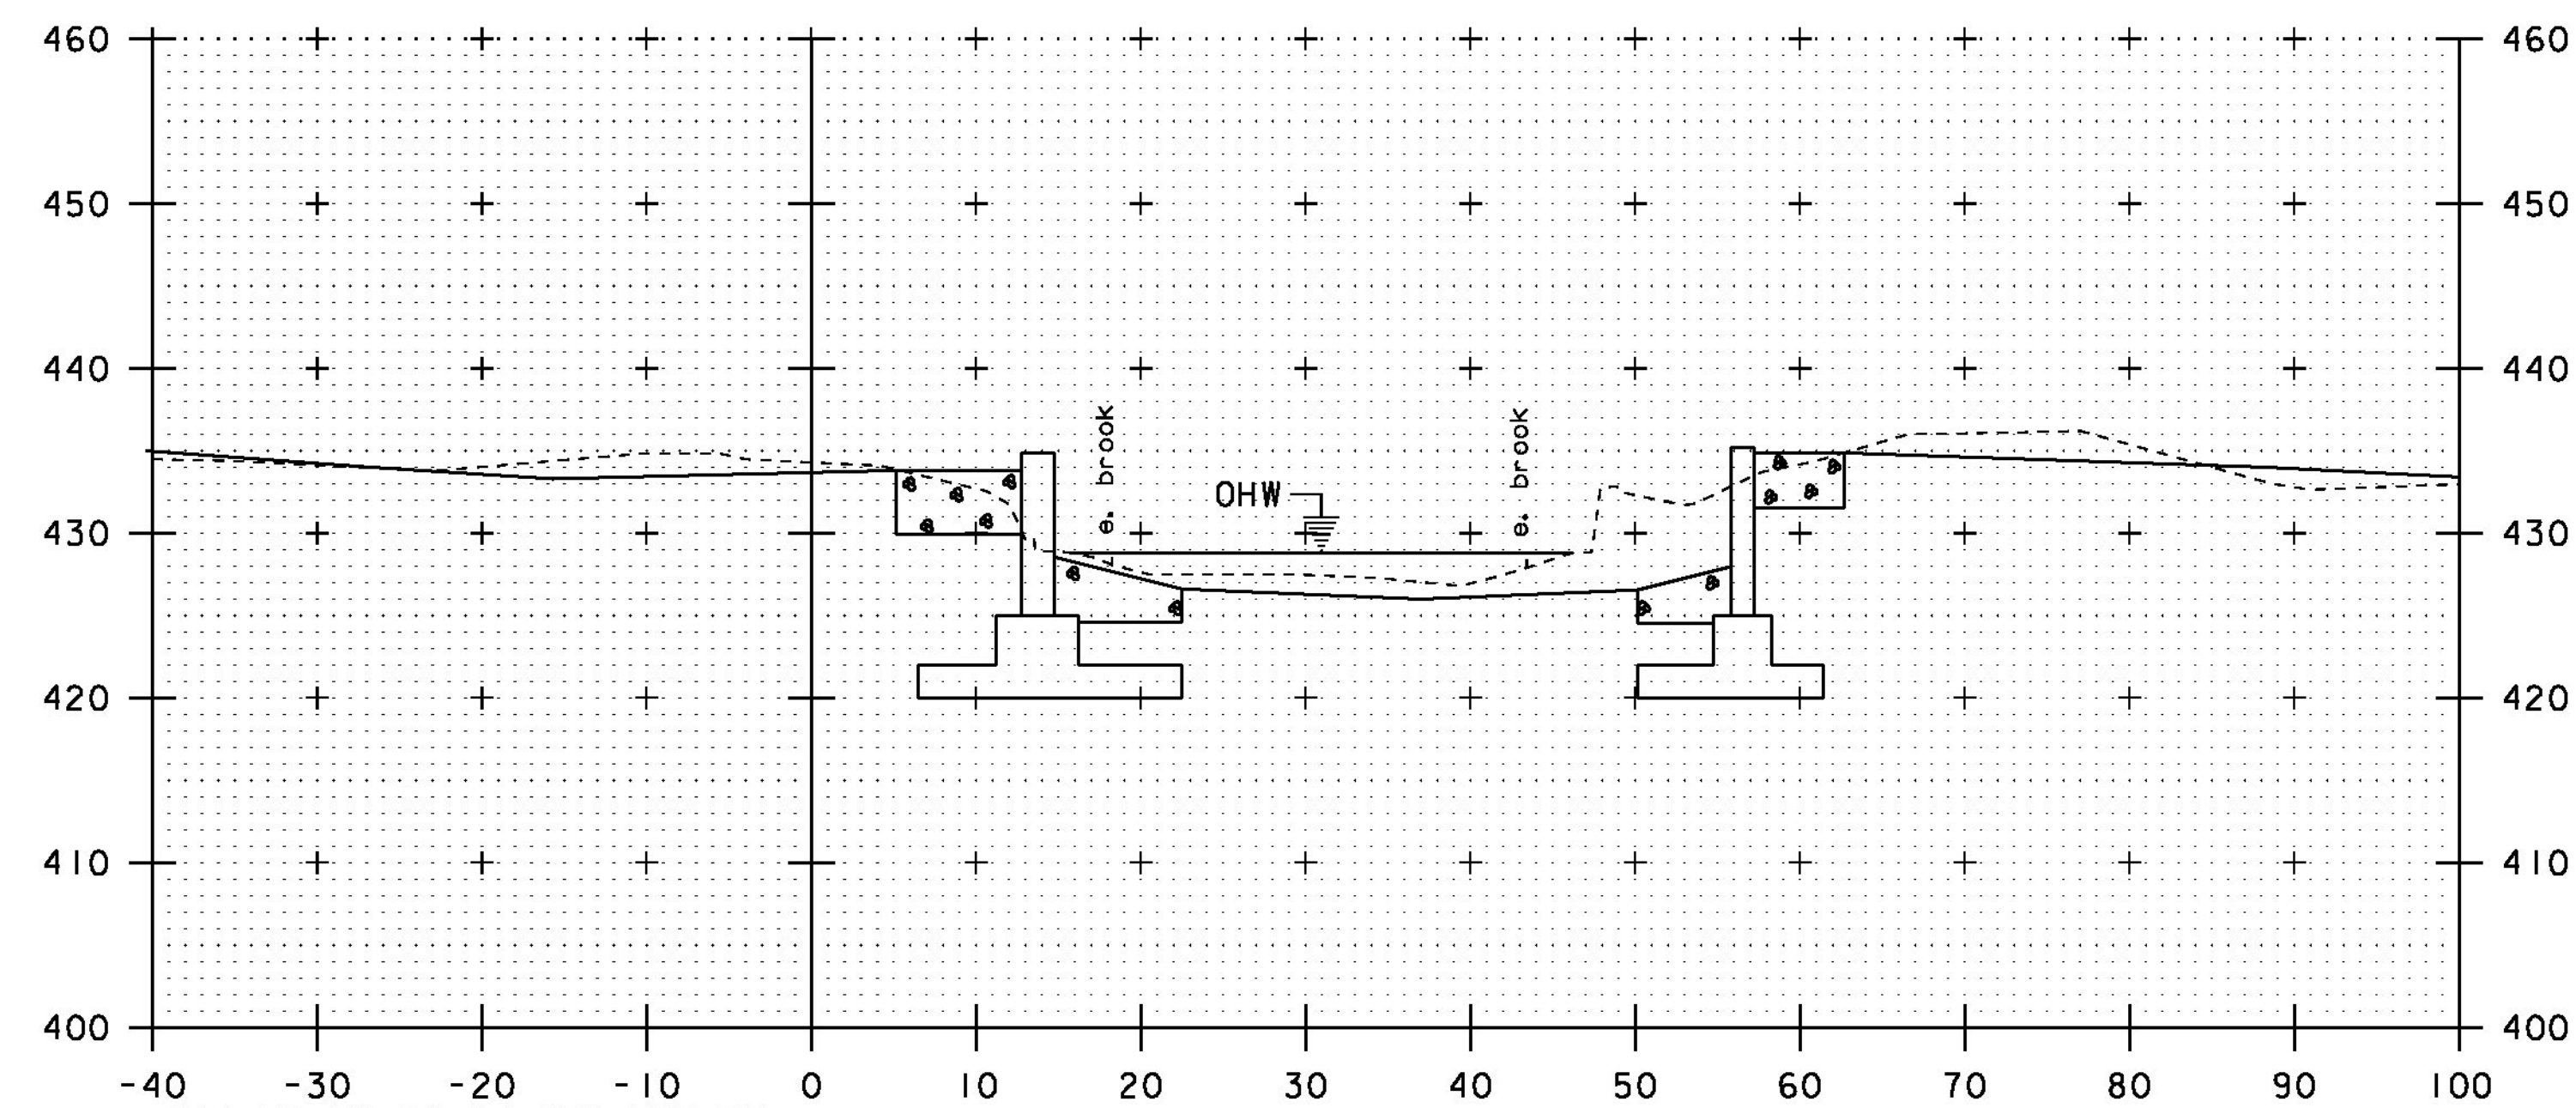


STA 50+72.00 RT AND FAR RT  
 BEGIN UNCLASSIFIED CHANNEL EXCAVATION  
 GEOTEXTILE UNDER STONE FILL  
 STONE FILL, TYPE II  
 GRUBBING MATERIAL


50+80

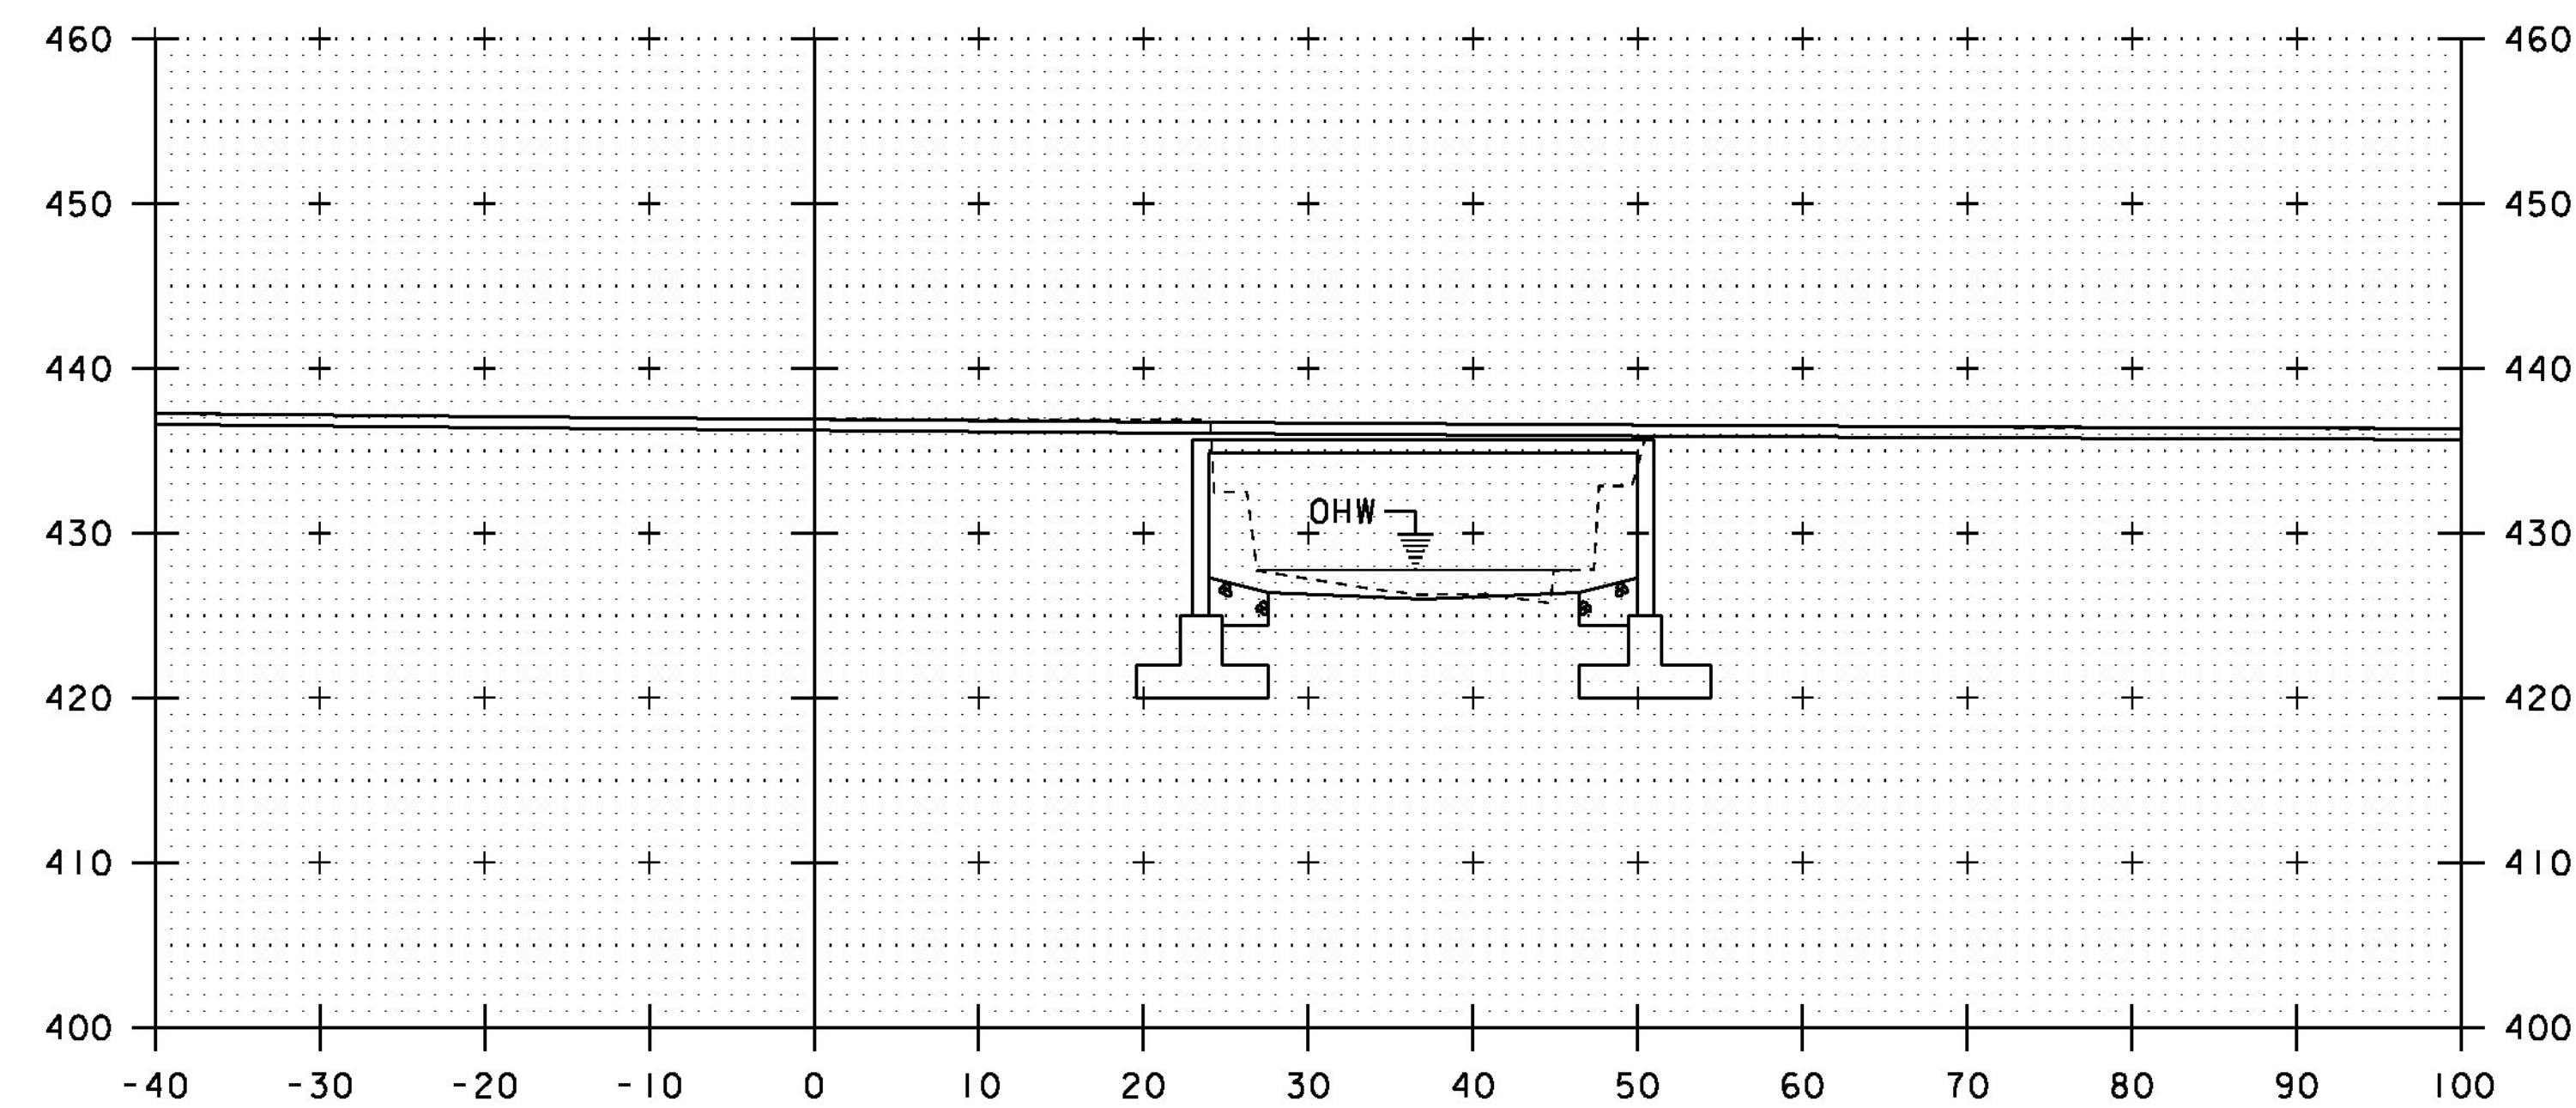

51+00

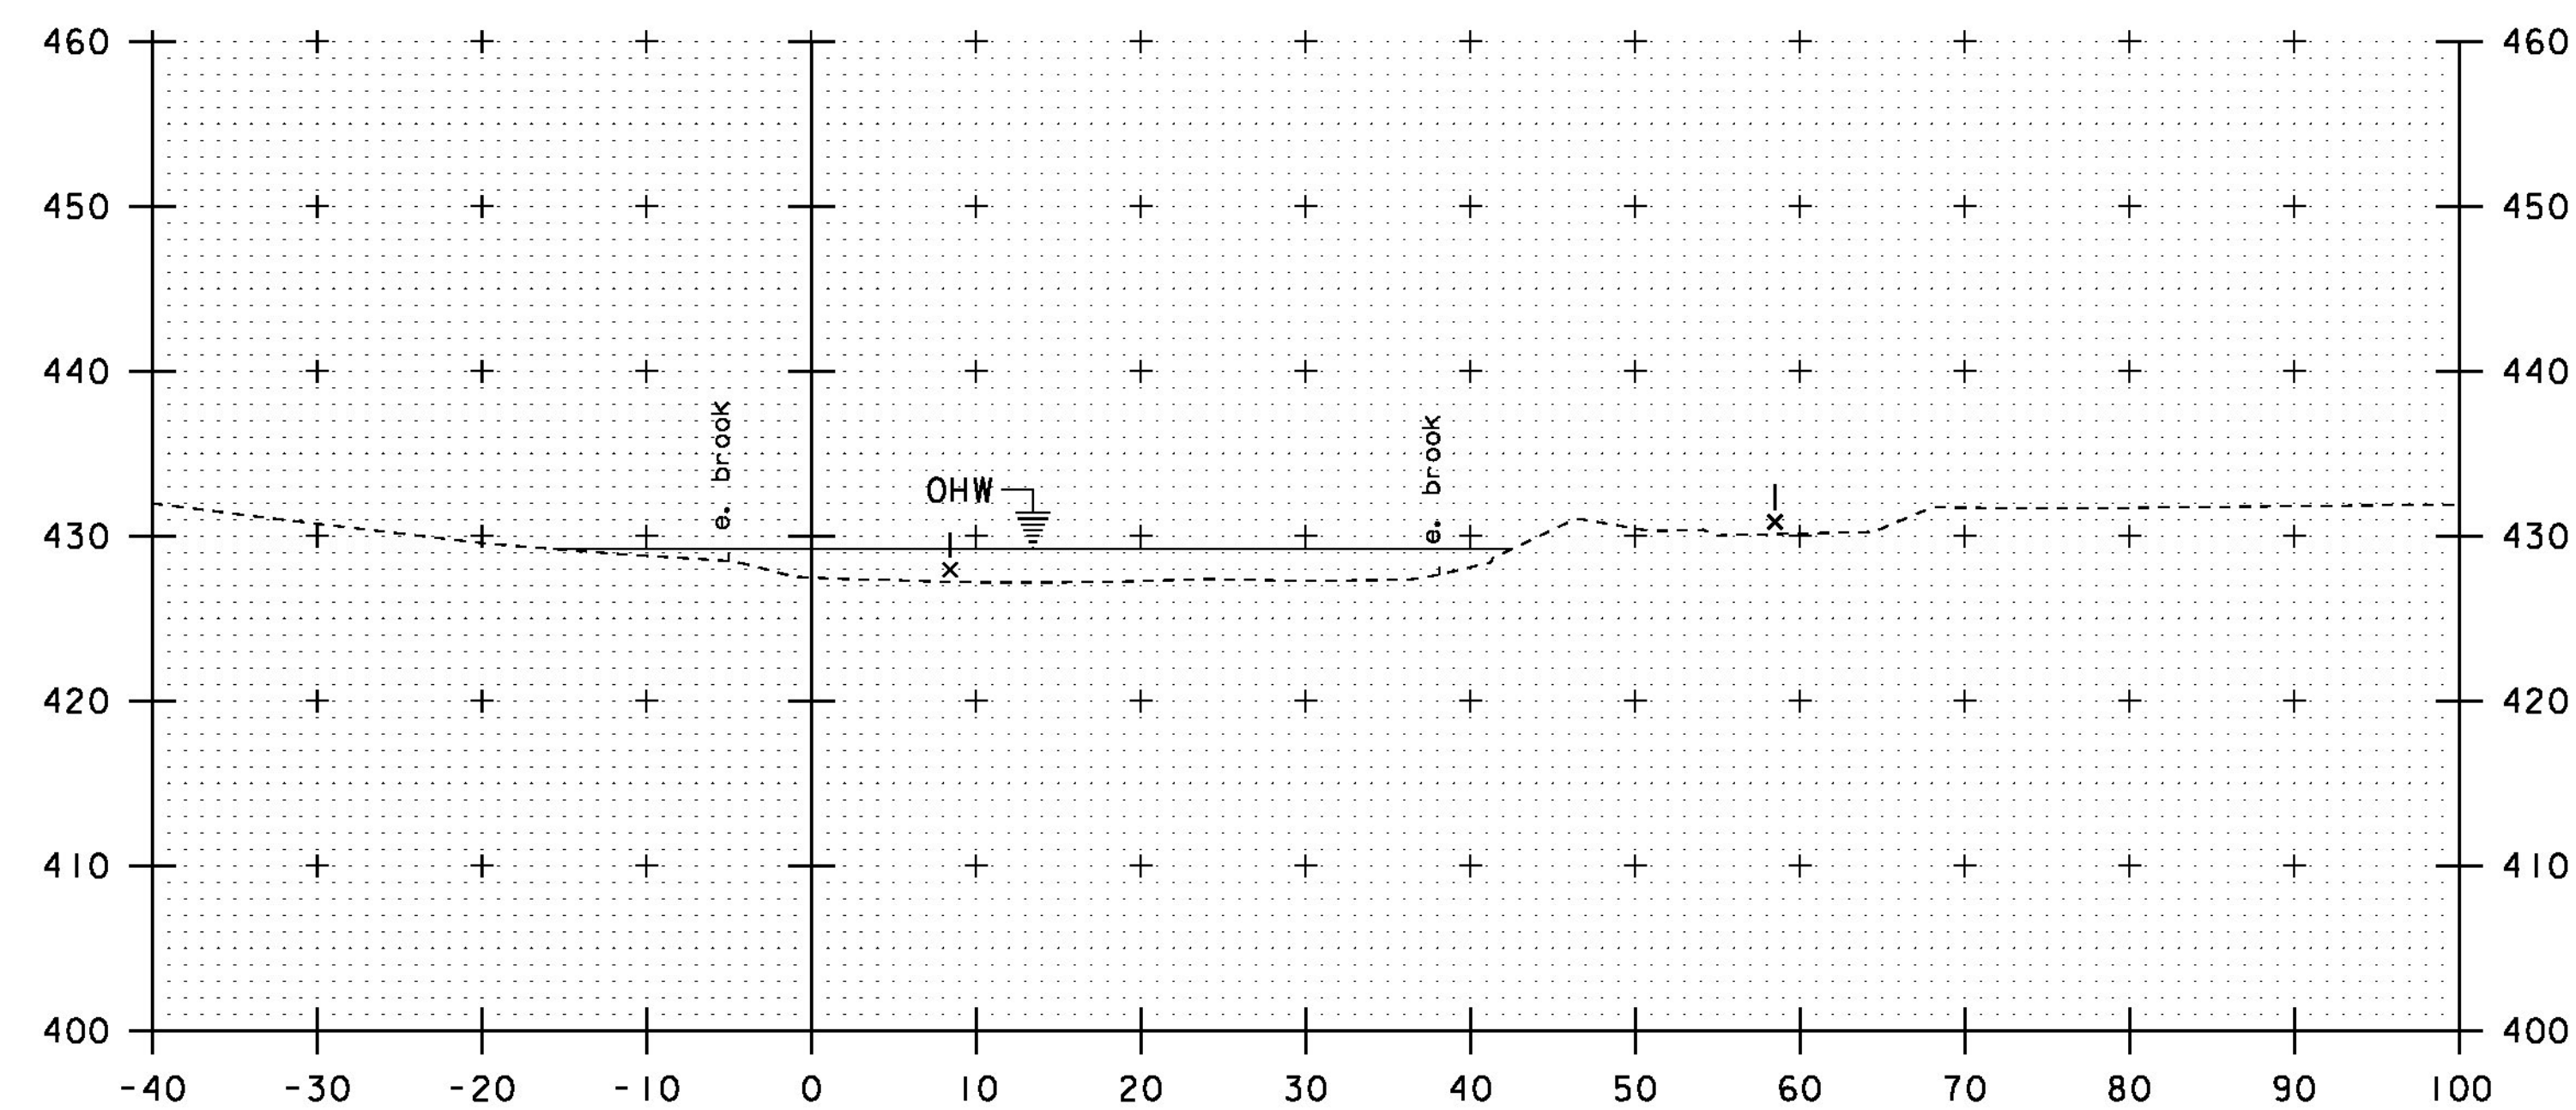

50+70

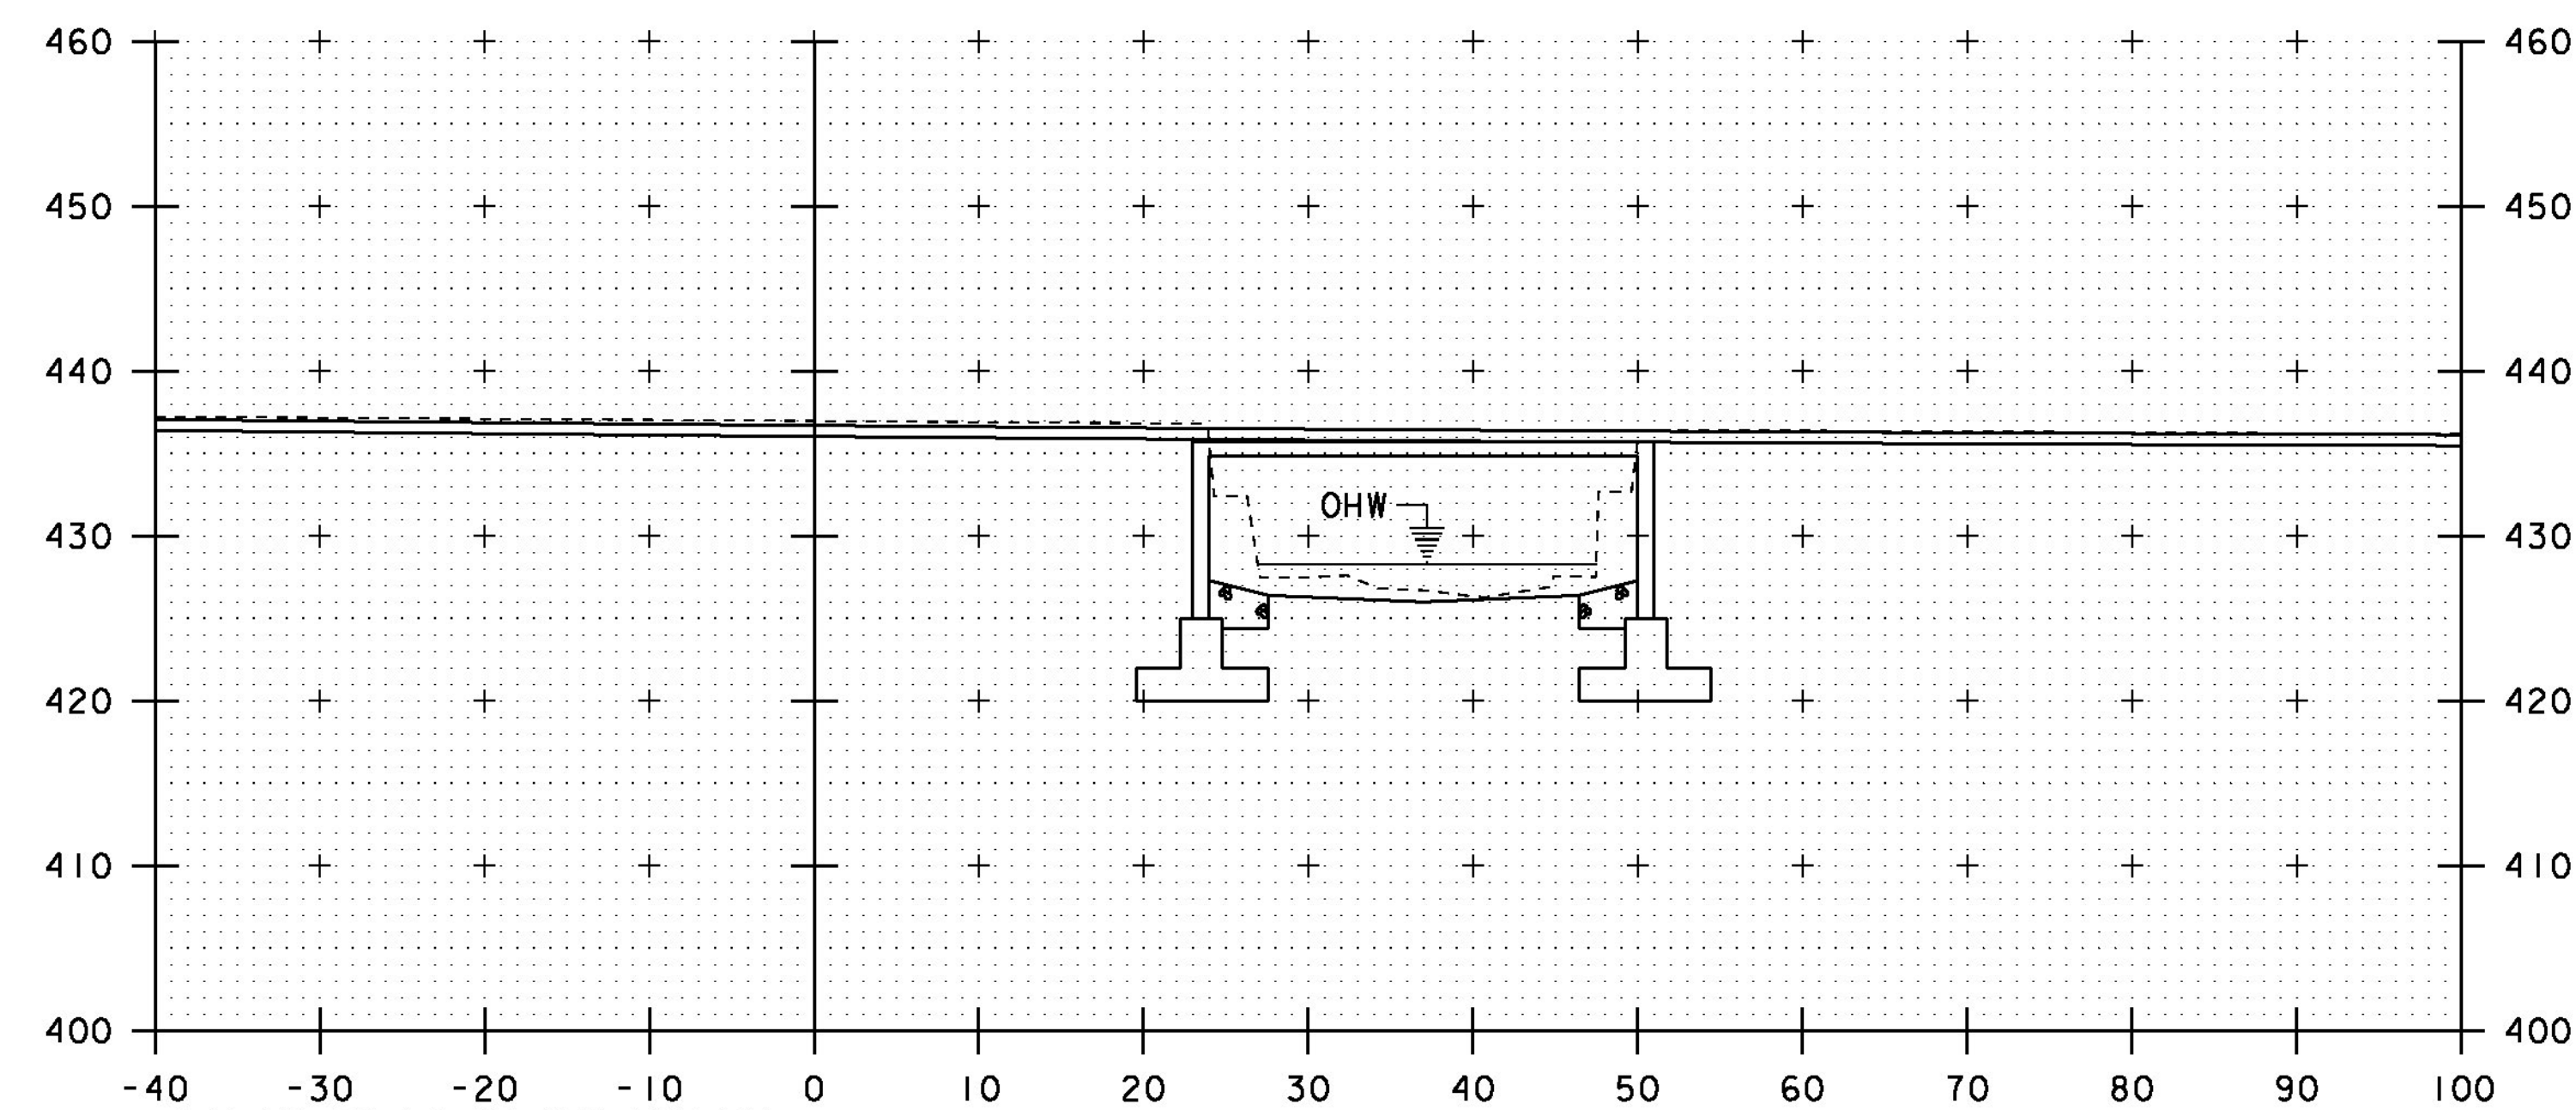


50+90

STA 50+85.50 RT AND FAR RT  
 STOP GRUBBING MATERIAL


STA. 50+70 TO STA. 51+00

PROJECT NAME:	RICHFORD	PLOT DATE:	11-DEC-2014
PROJECT NUMBER:	BRF 0302(29)	DRAWN BY:	R. PELLETT
FILE NAME:	s12j158xs.dgn	DESIGNED BY:	H. SALLS
PROJECT LEADER:	C. CARLSON	CHECKED BY:	H. SALLS
CHANNEL CROSS SECTIONS I			SHEET 29 OF 36

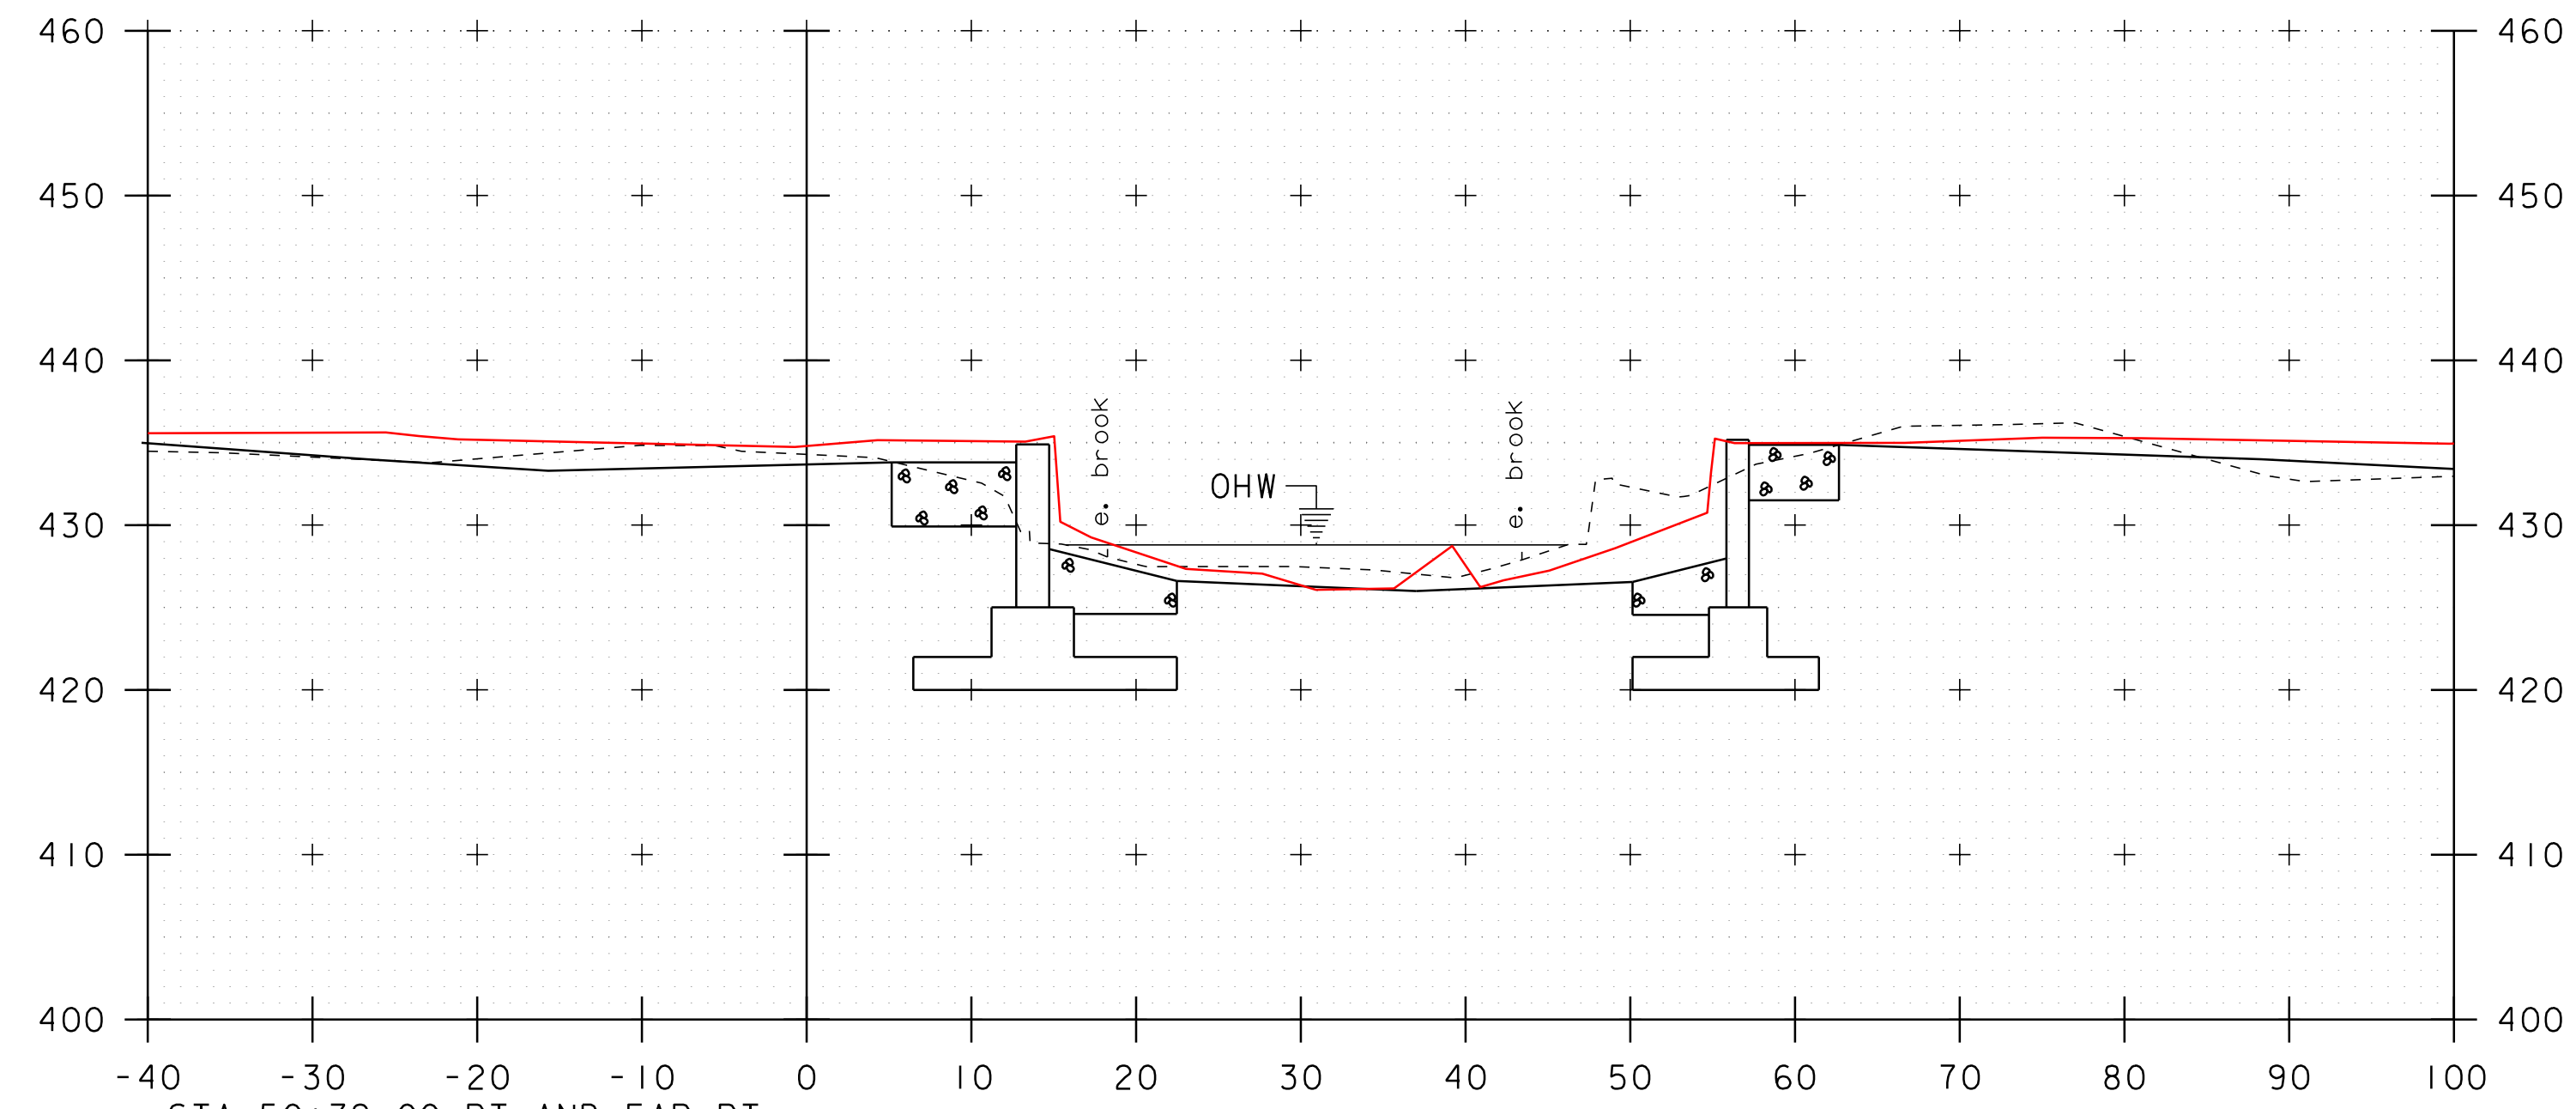


STA 50+72.00 RT AND FAR RT  
 BEGIN UNCLASSIFIED CHANNEL EXCAVATION  
 GEOTEXTILE UNDER STONE FILL  
 STONE FILL, TYPE II  
 GRUBBING MATERIAL


50+80

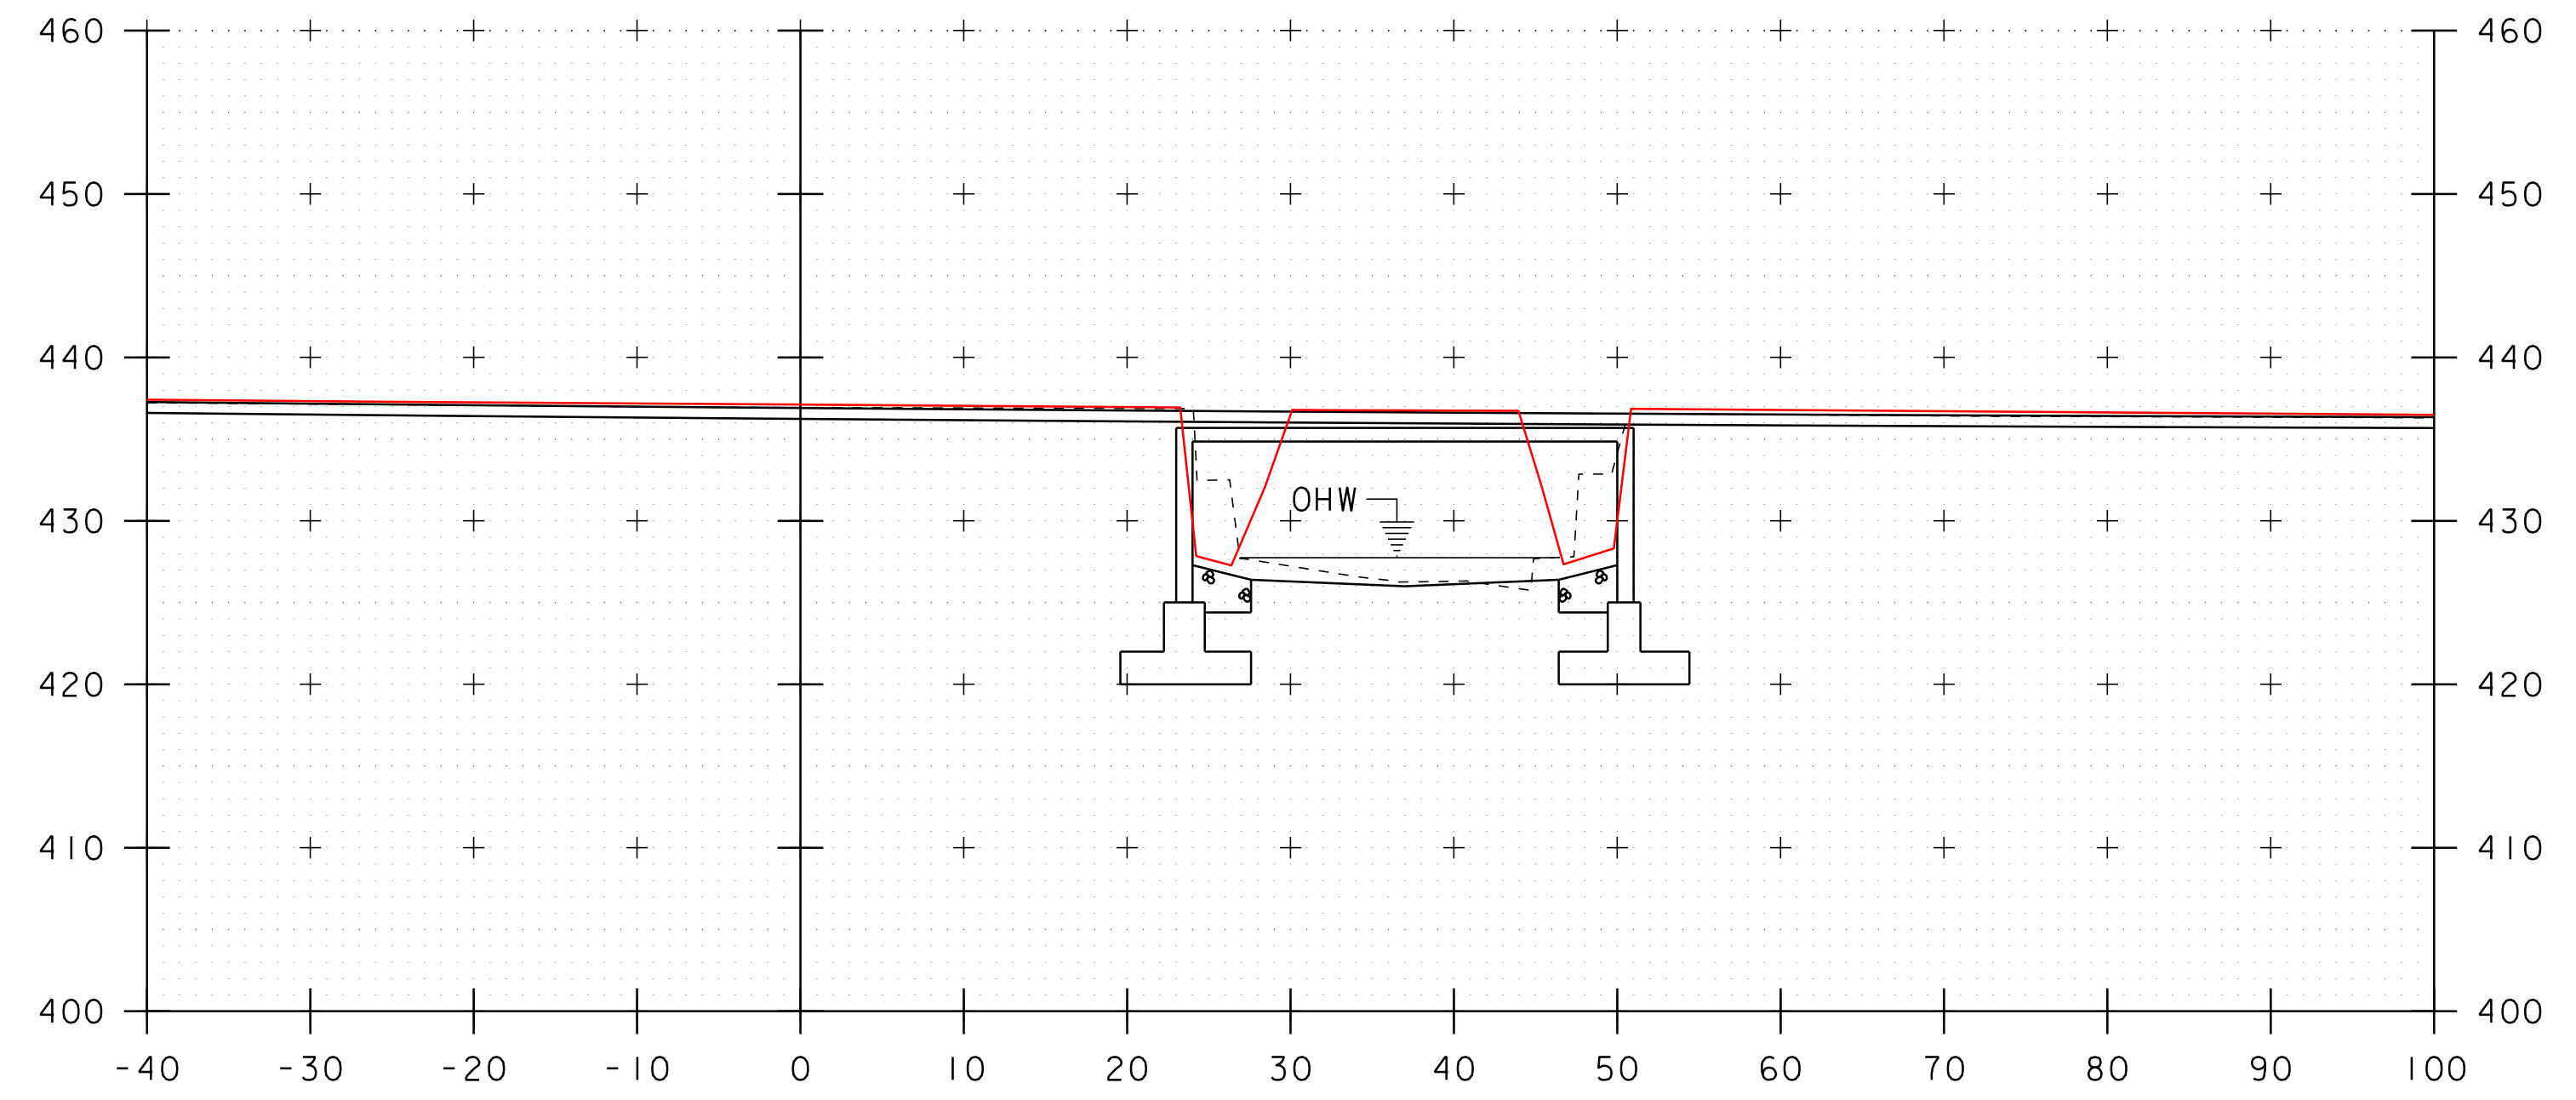

51+00

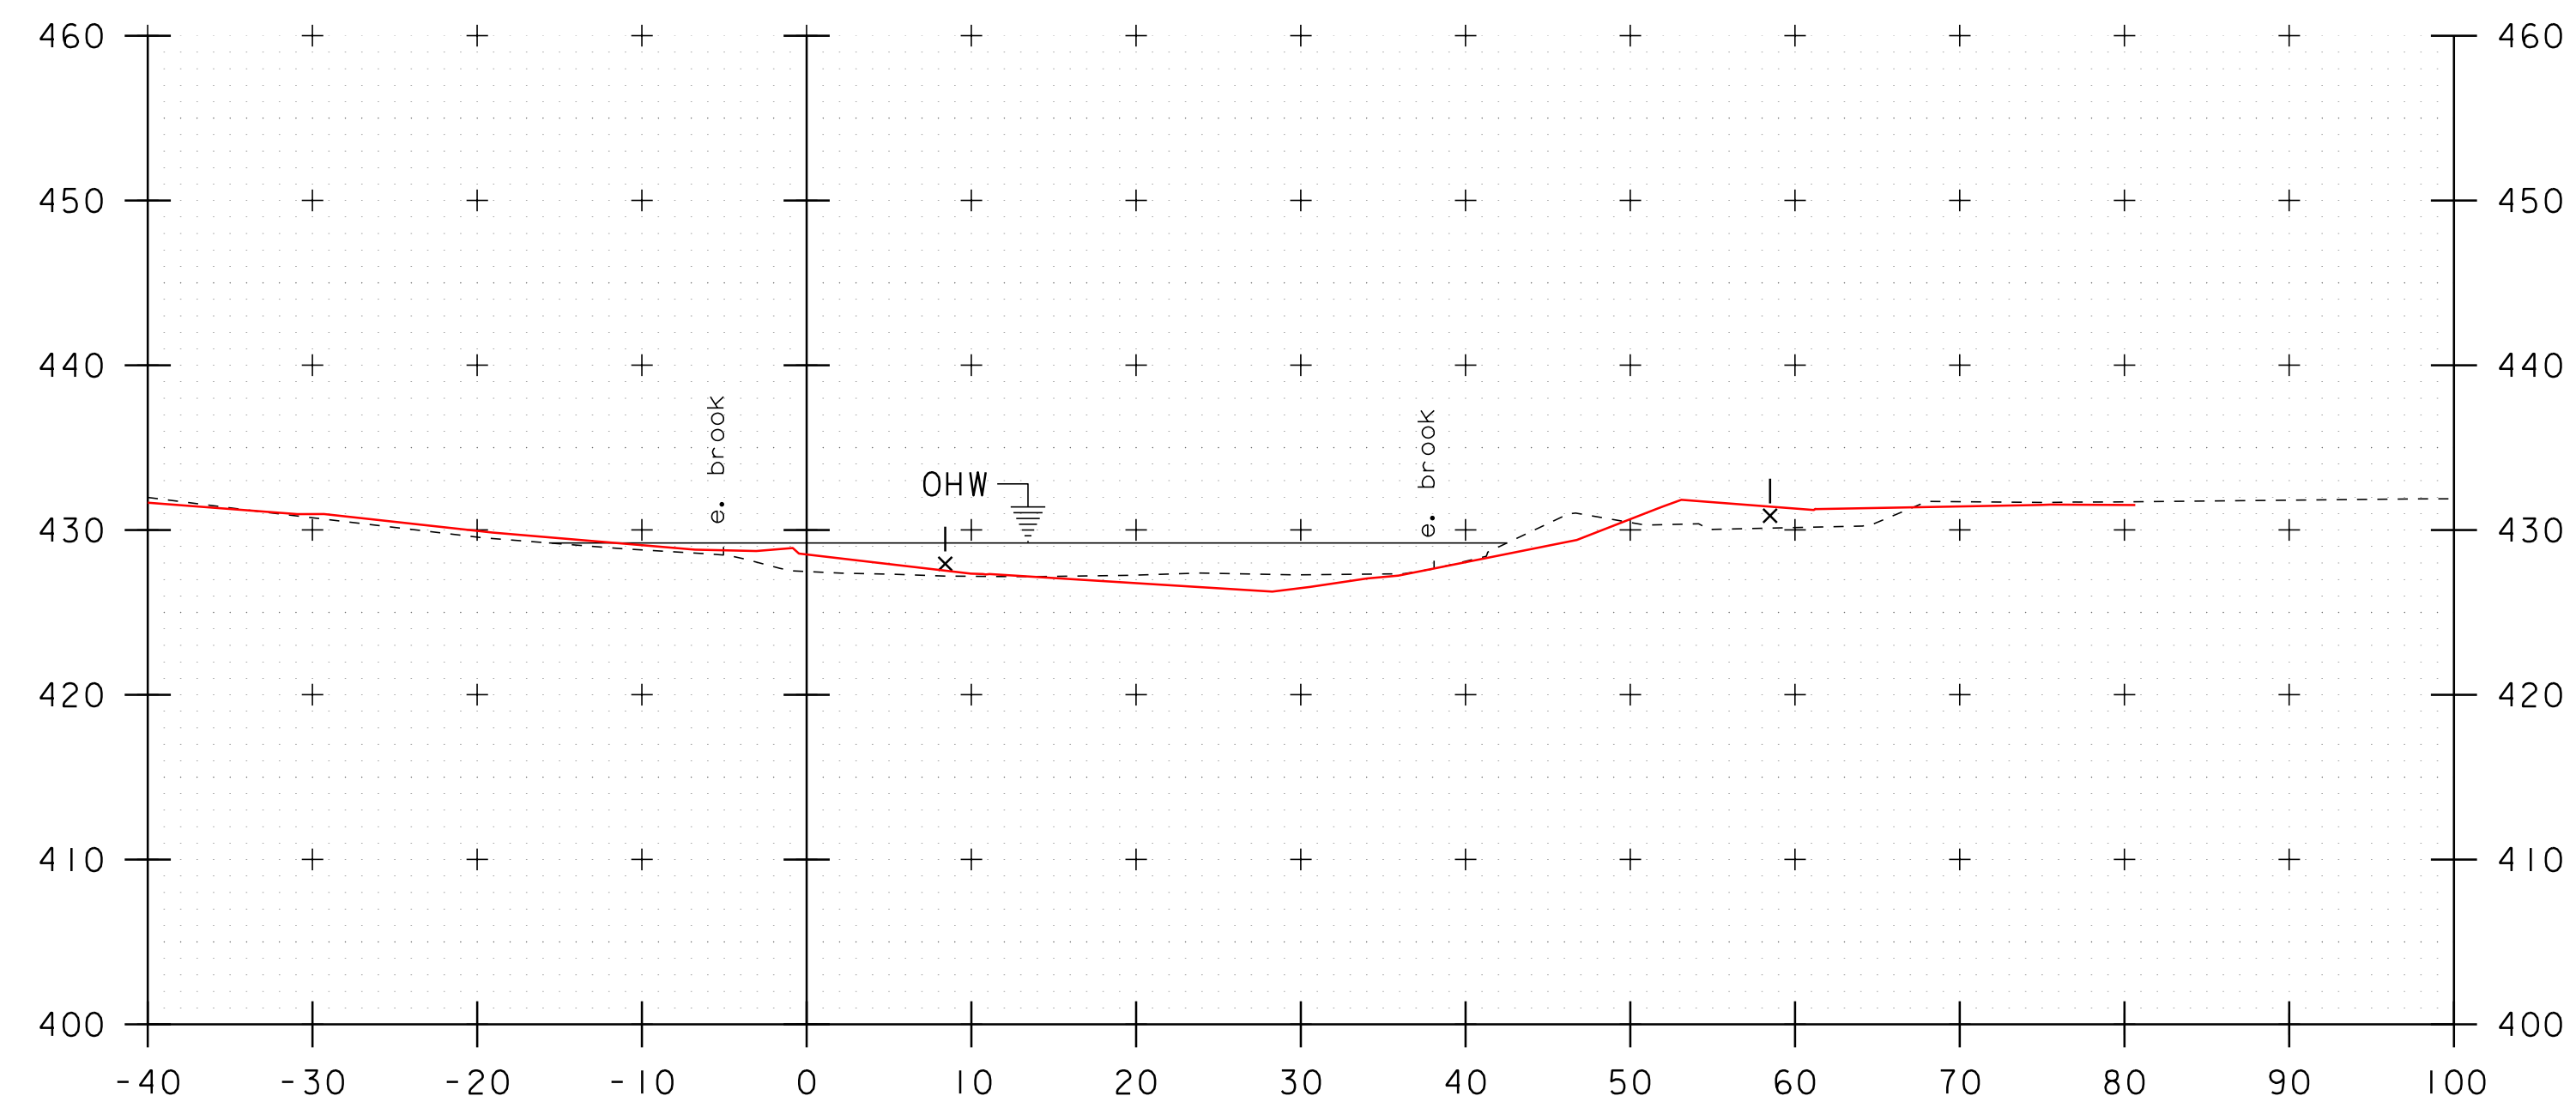

50+70

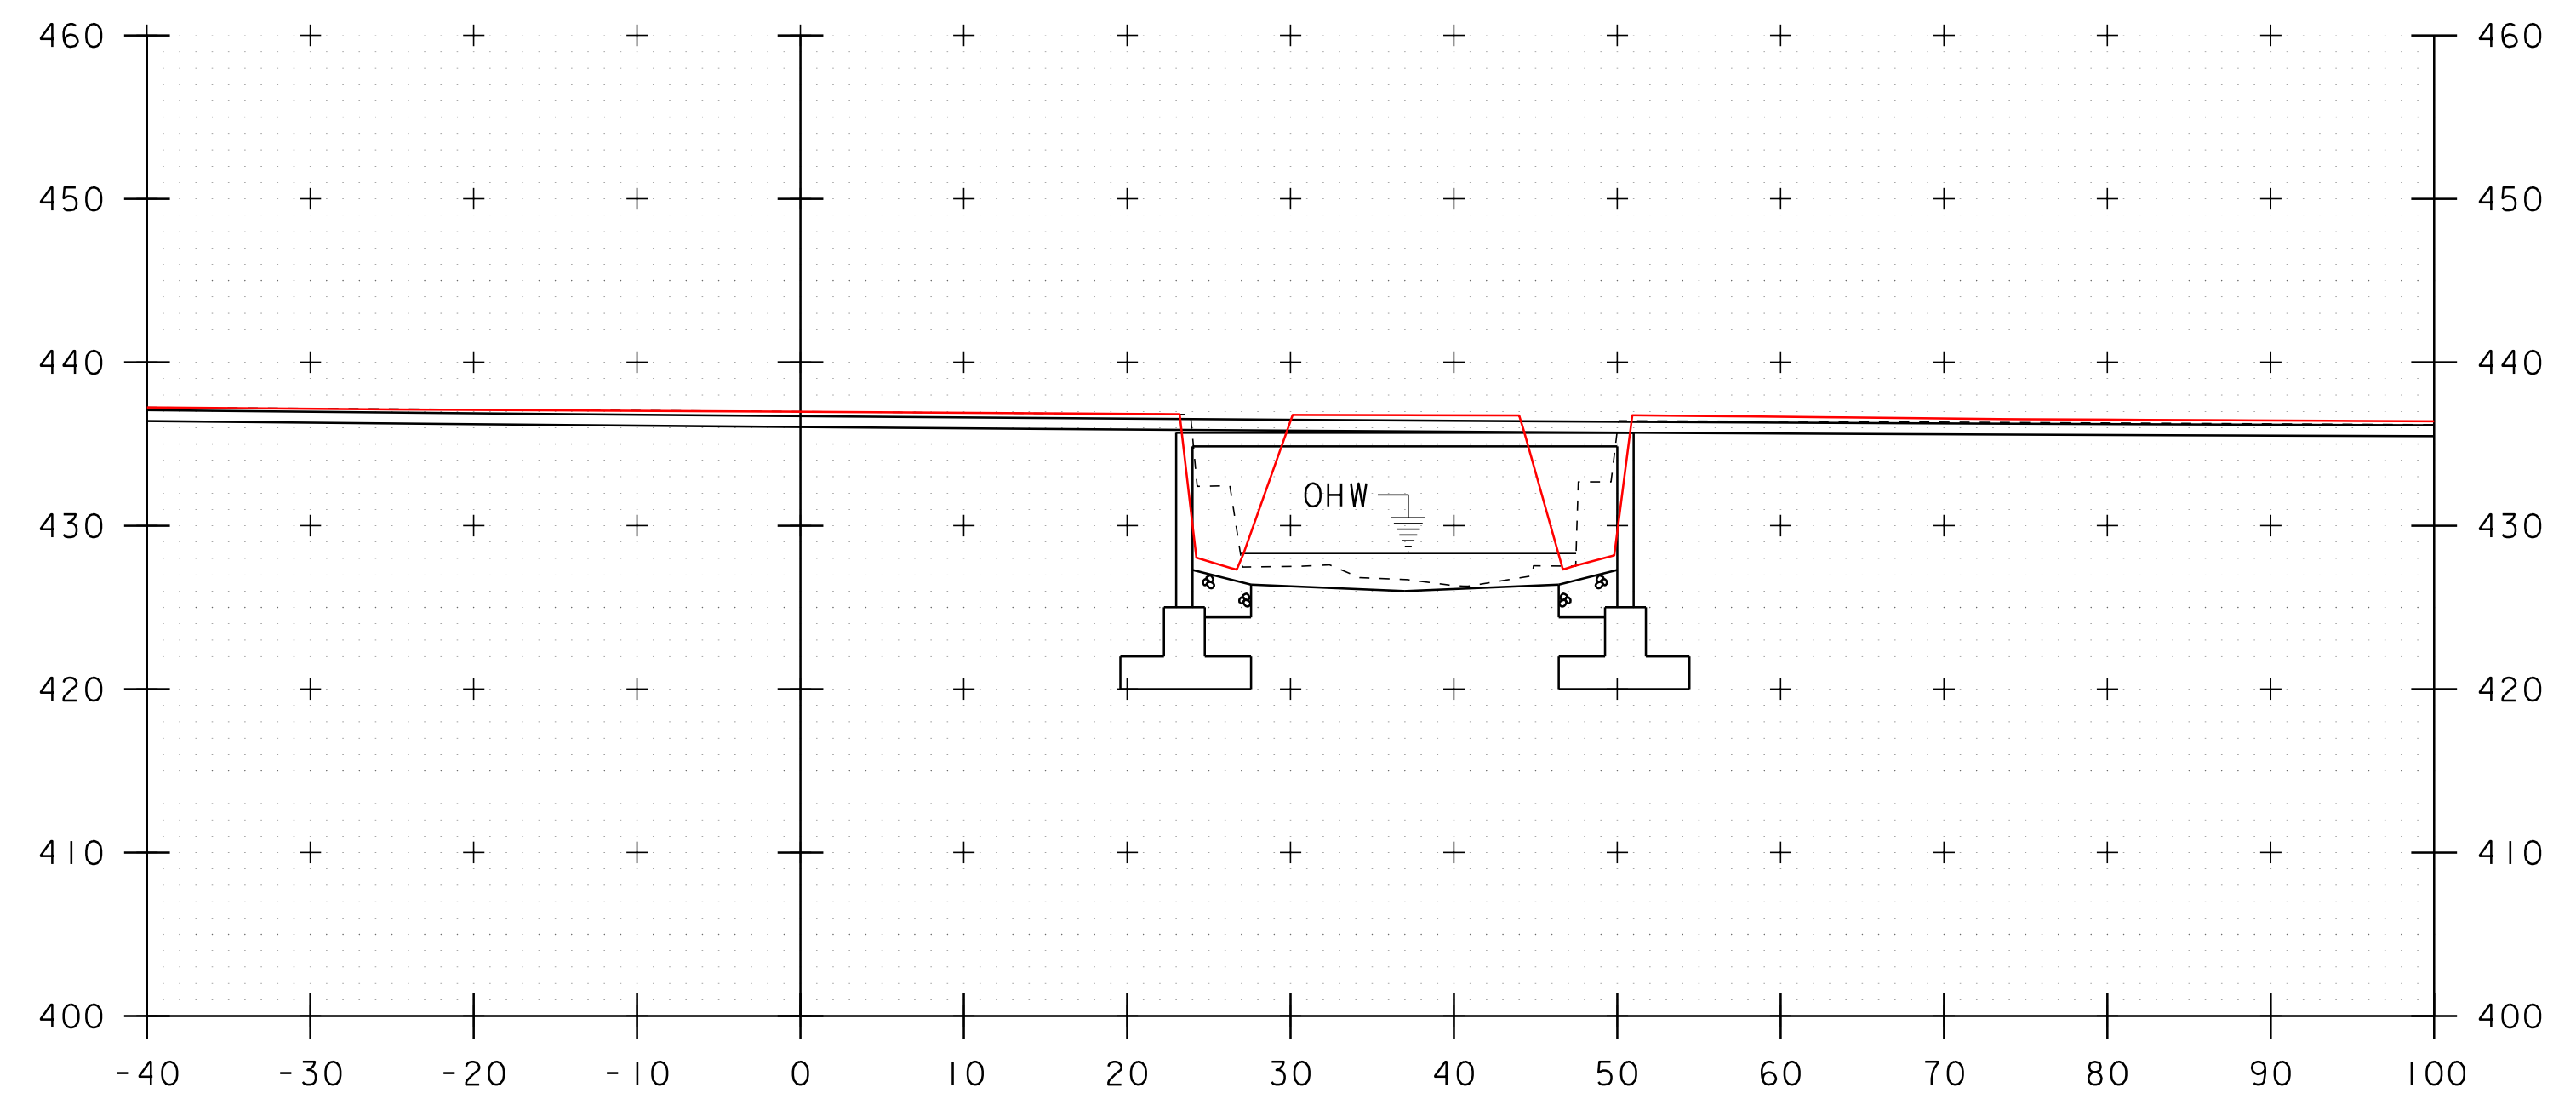


50+90

STA 50+85.50 RT AND FAR RT  
 STOP GRUBBING MATERIAL

PROJECT NAME:	RICHFORD	PLOT DATE:	09-AUG-2016 09:57
PROJECT NUMBER:	BRF 0302(29)	DRAWN BY:	R. PELLETT
FILE NAME:	s12j158xs.dgn	DESIGNED BY:	H. SALLS
PROJECT LEADER:	C. CARLSON	CHECKED BY:	H. SALLS
CHANNEL CROSS SECTIONS I		SHEET	<del>35</del> OF <del>64</del>


STA. 50+70 TO STA. 51+00

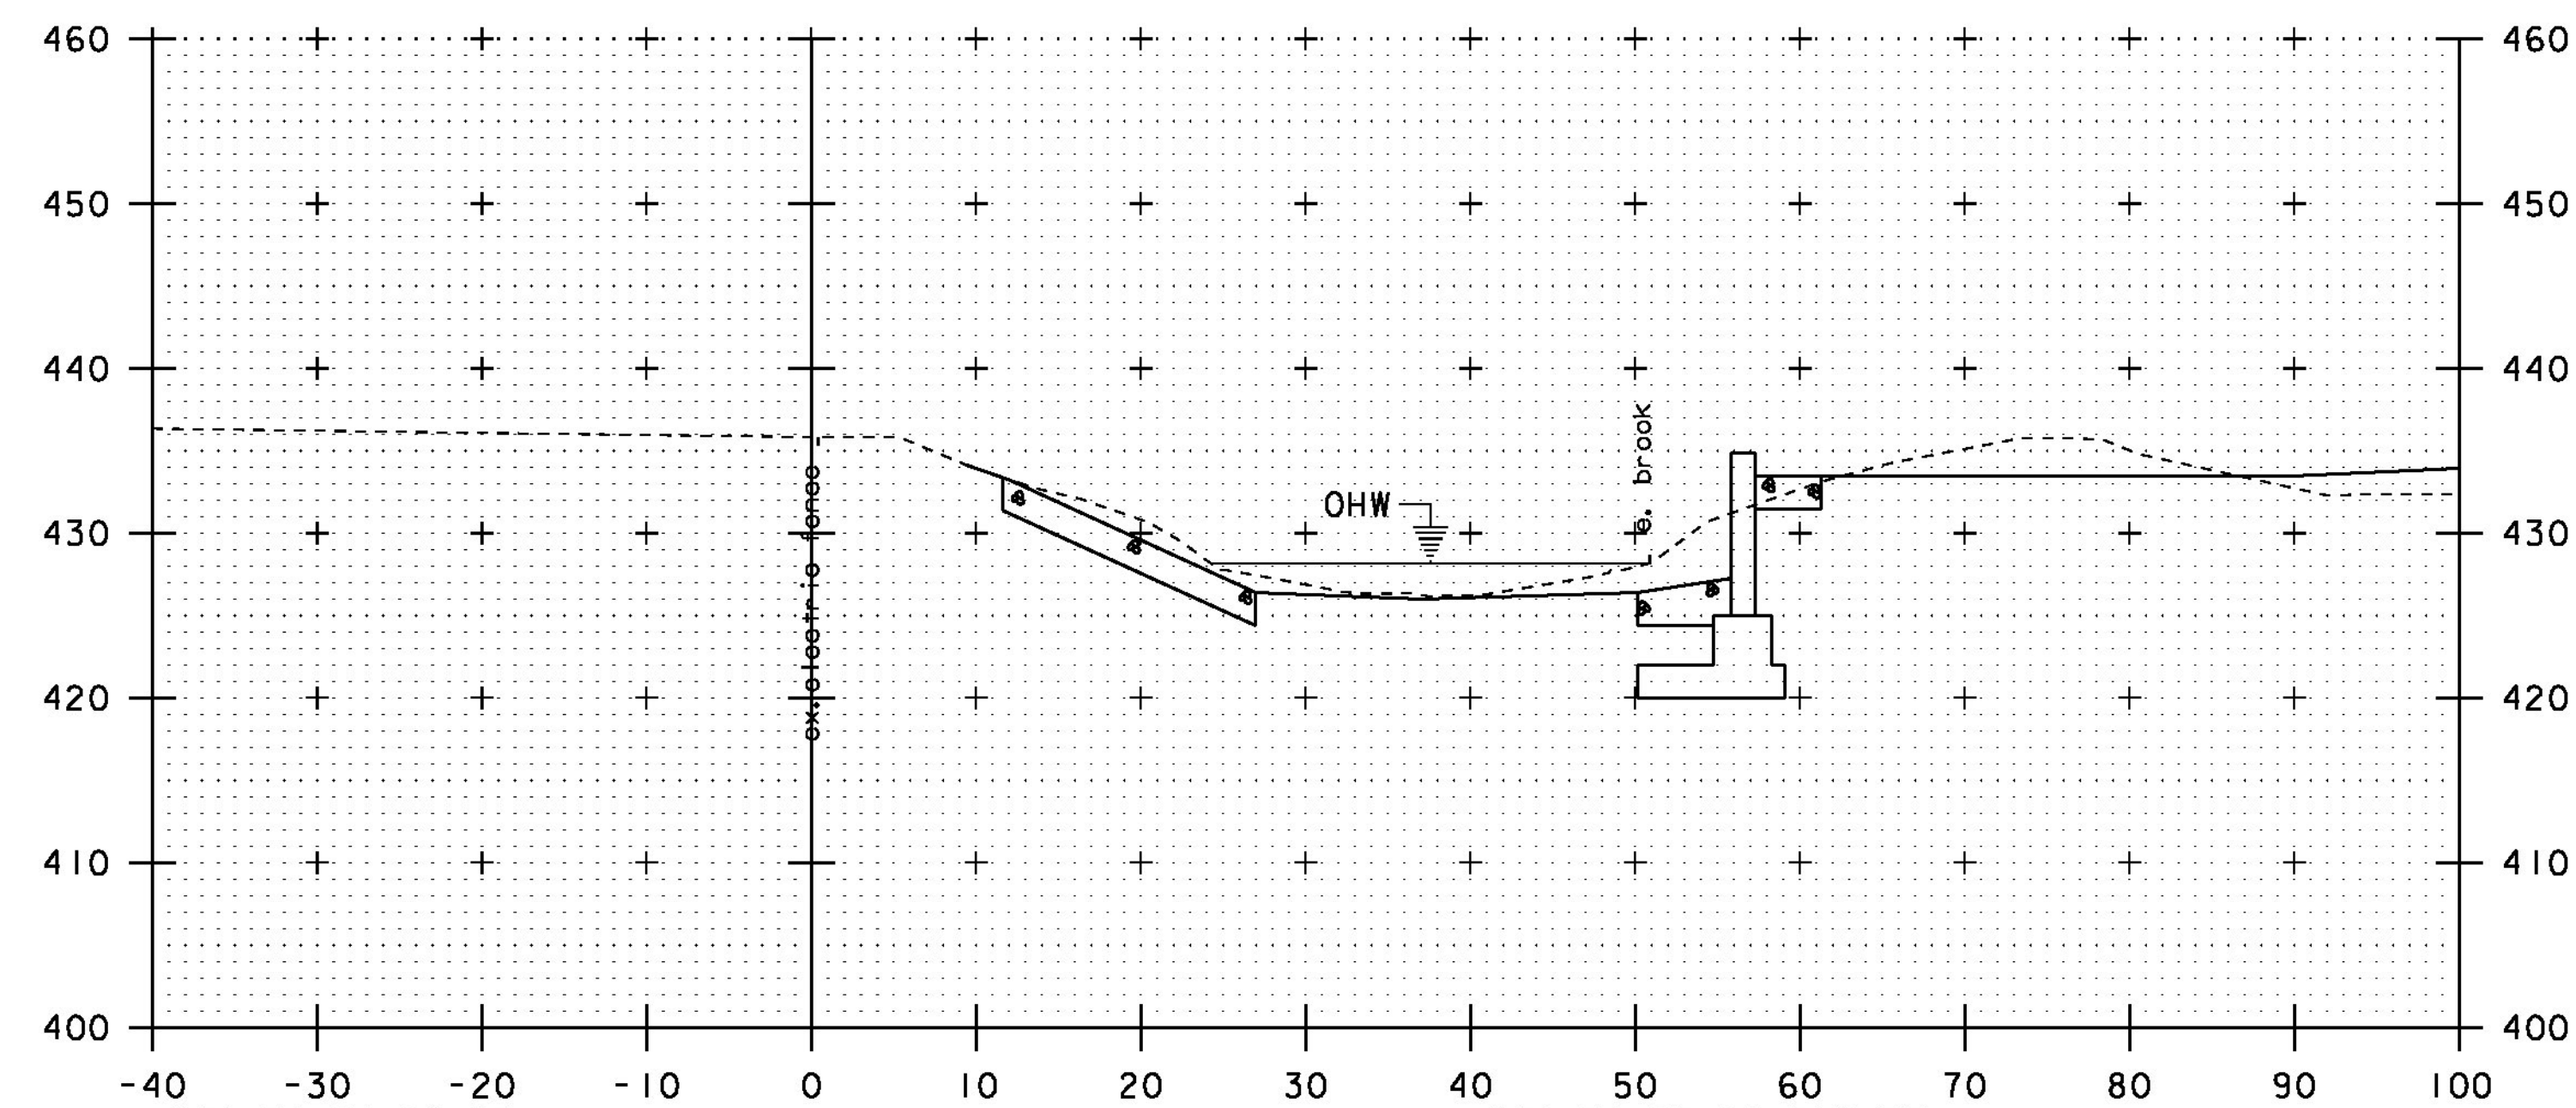


STA 51+21.00 RT  
 END UNCLASSIFIED CHANNEL EXCAVATION  
 GEOTEXTILE UNDER STONE FILL  
 STONE FILL, TYPE II  
 GRUBBING MATERIAL  
 STA 51+14.50 RT  
 RESUME GRUBBING MATERIAL

**51+20**


STA 51+27.00 FAR RT  
 END UNCLASSIFIED CHANNEL EXCAVATION  
 GEOTEXTILE UNDER STONE FILL  
 STONE FILL, TYPE II  
 GRUBBING MATERIAL  
 STA 51+14.50 FAR RT  
 RESUME GRUBBING MATERIAL

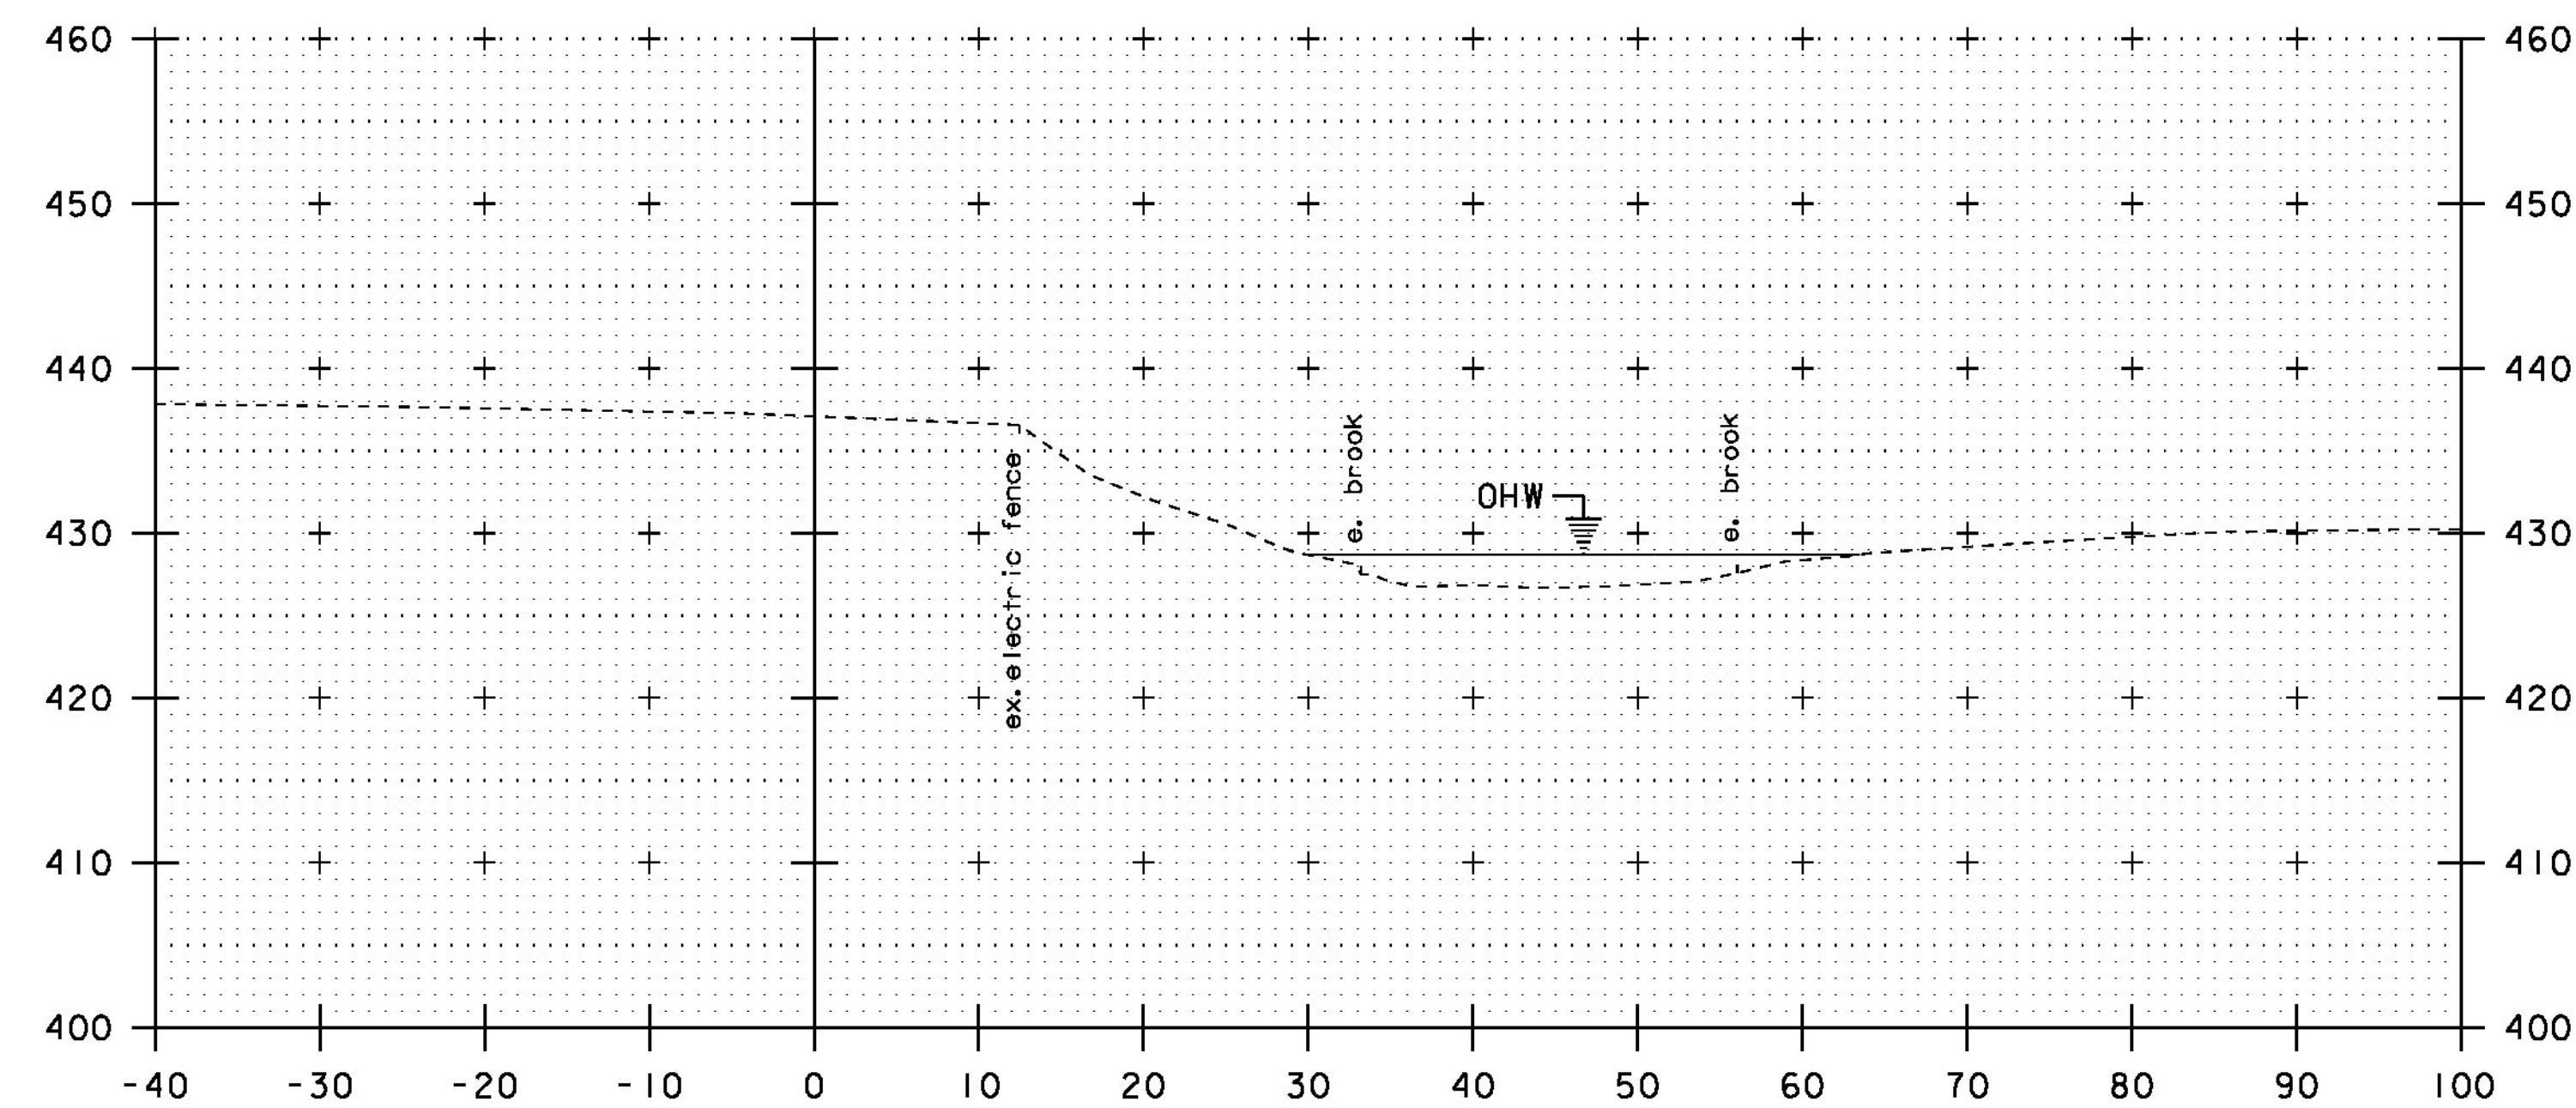

**51+40**

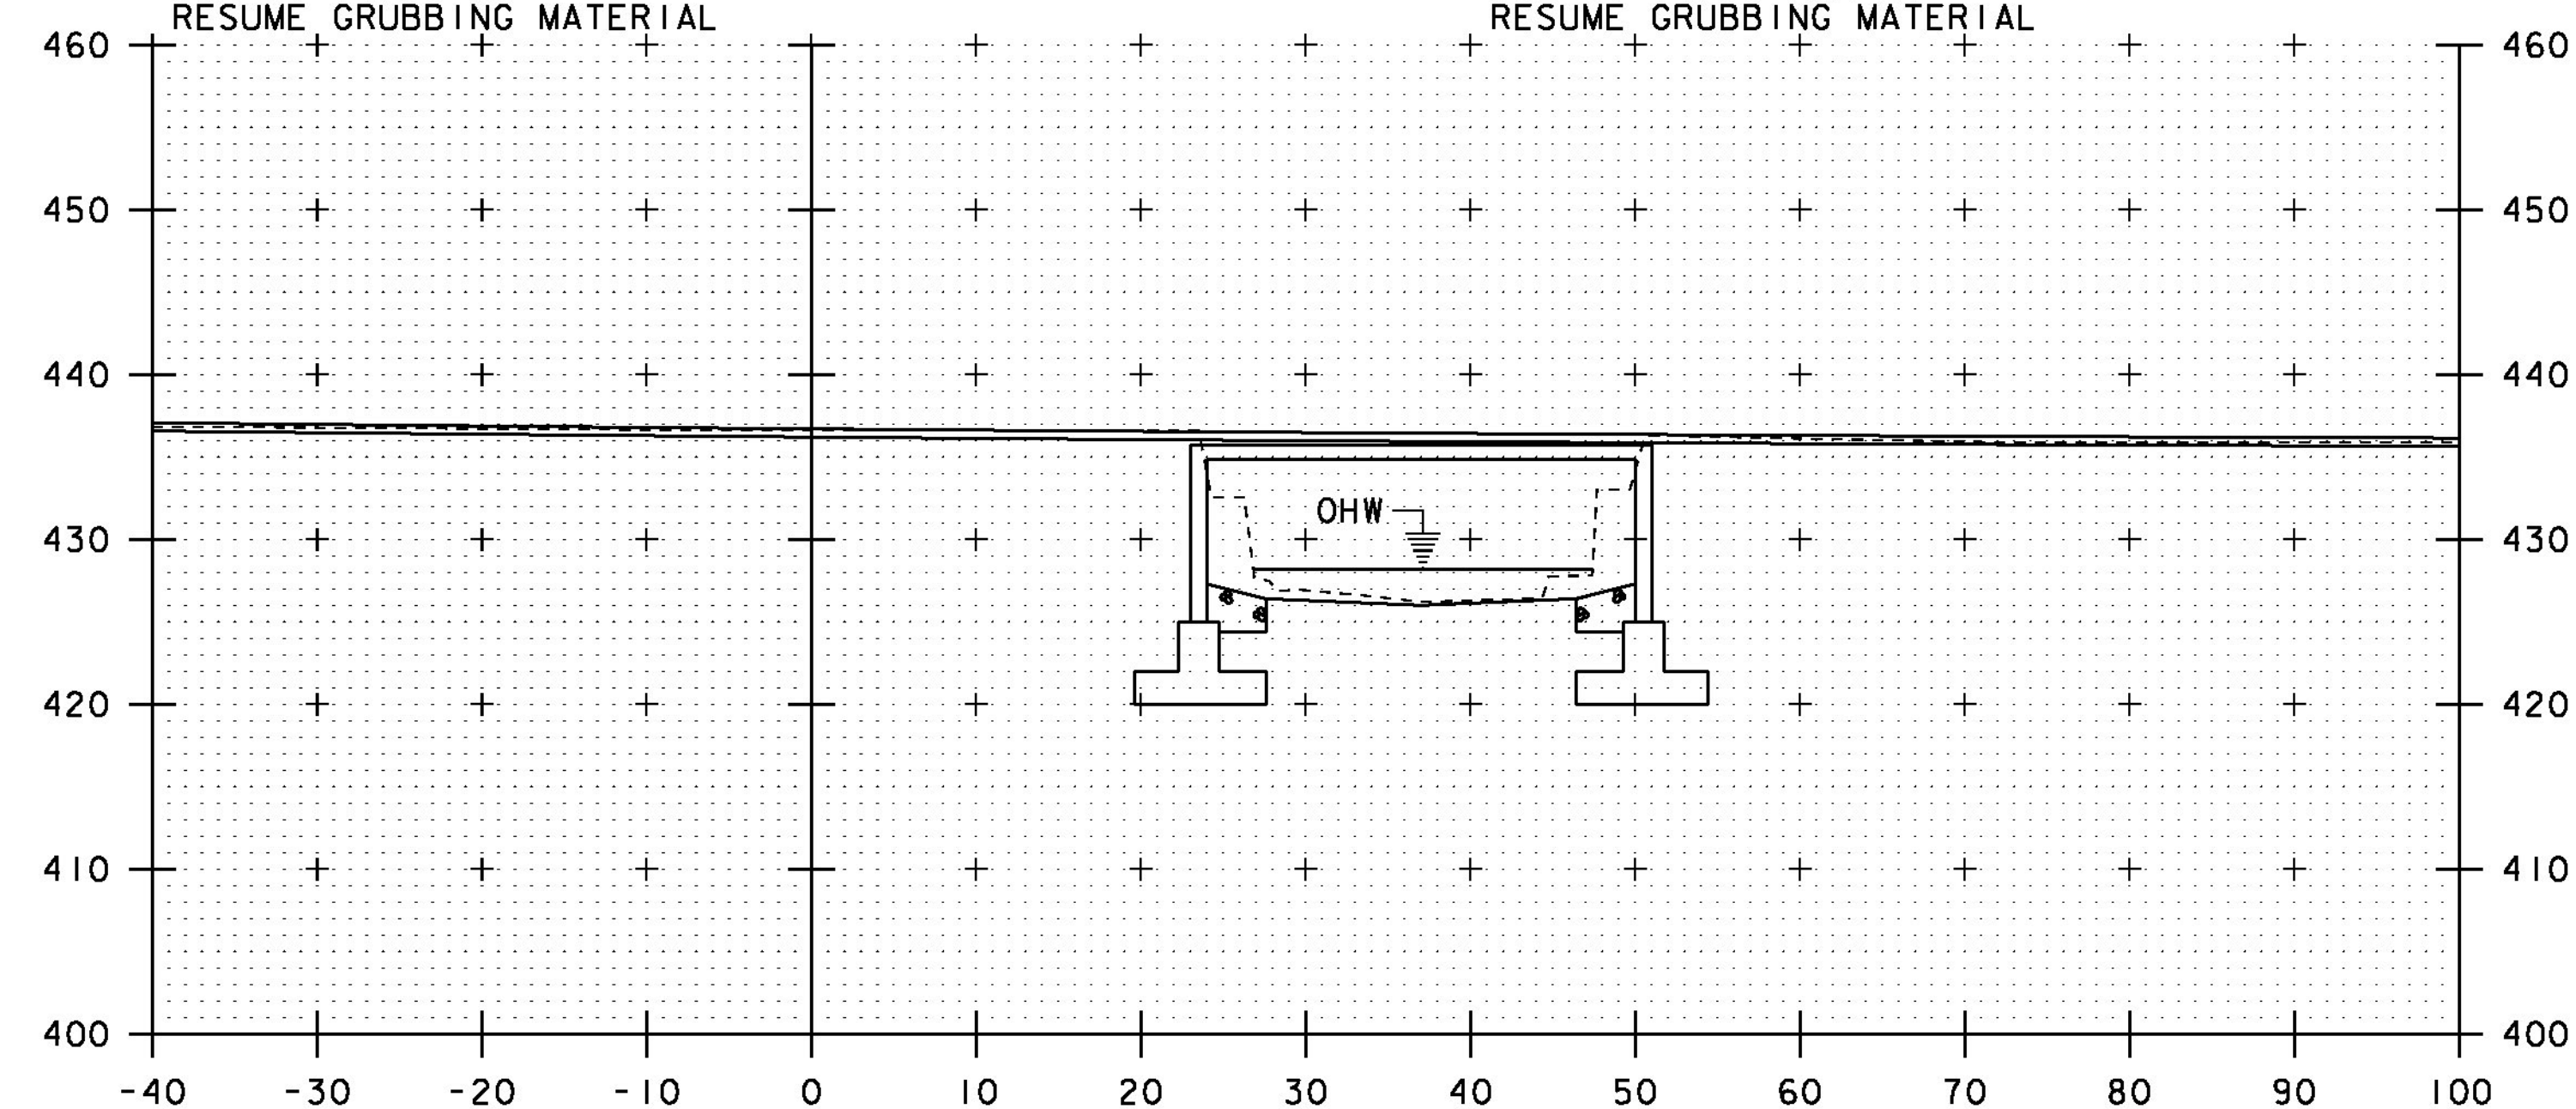





**51+10**

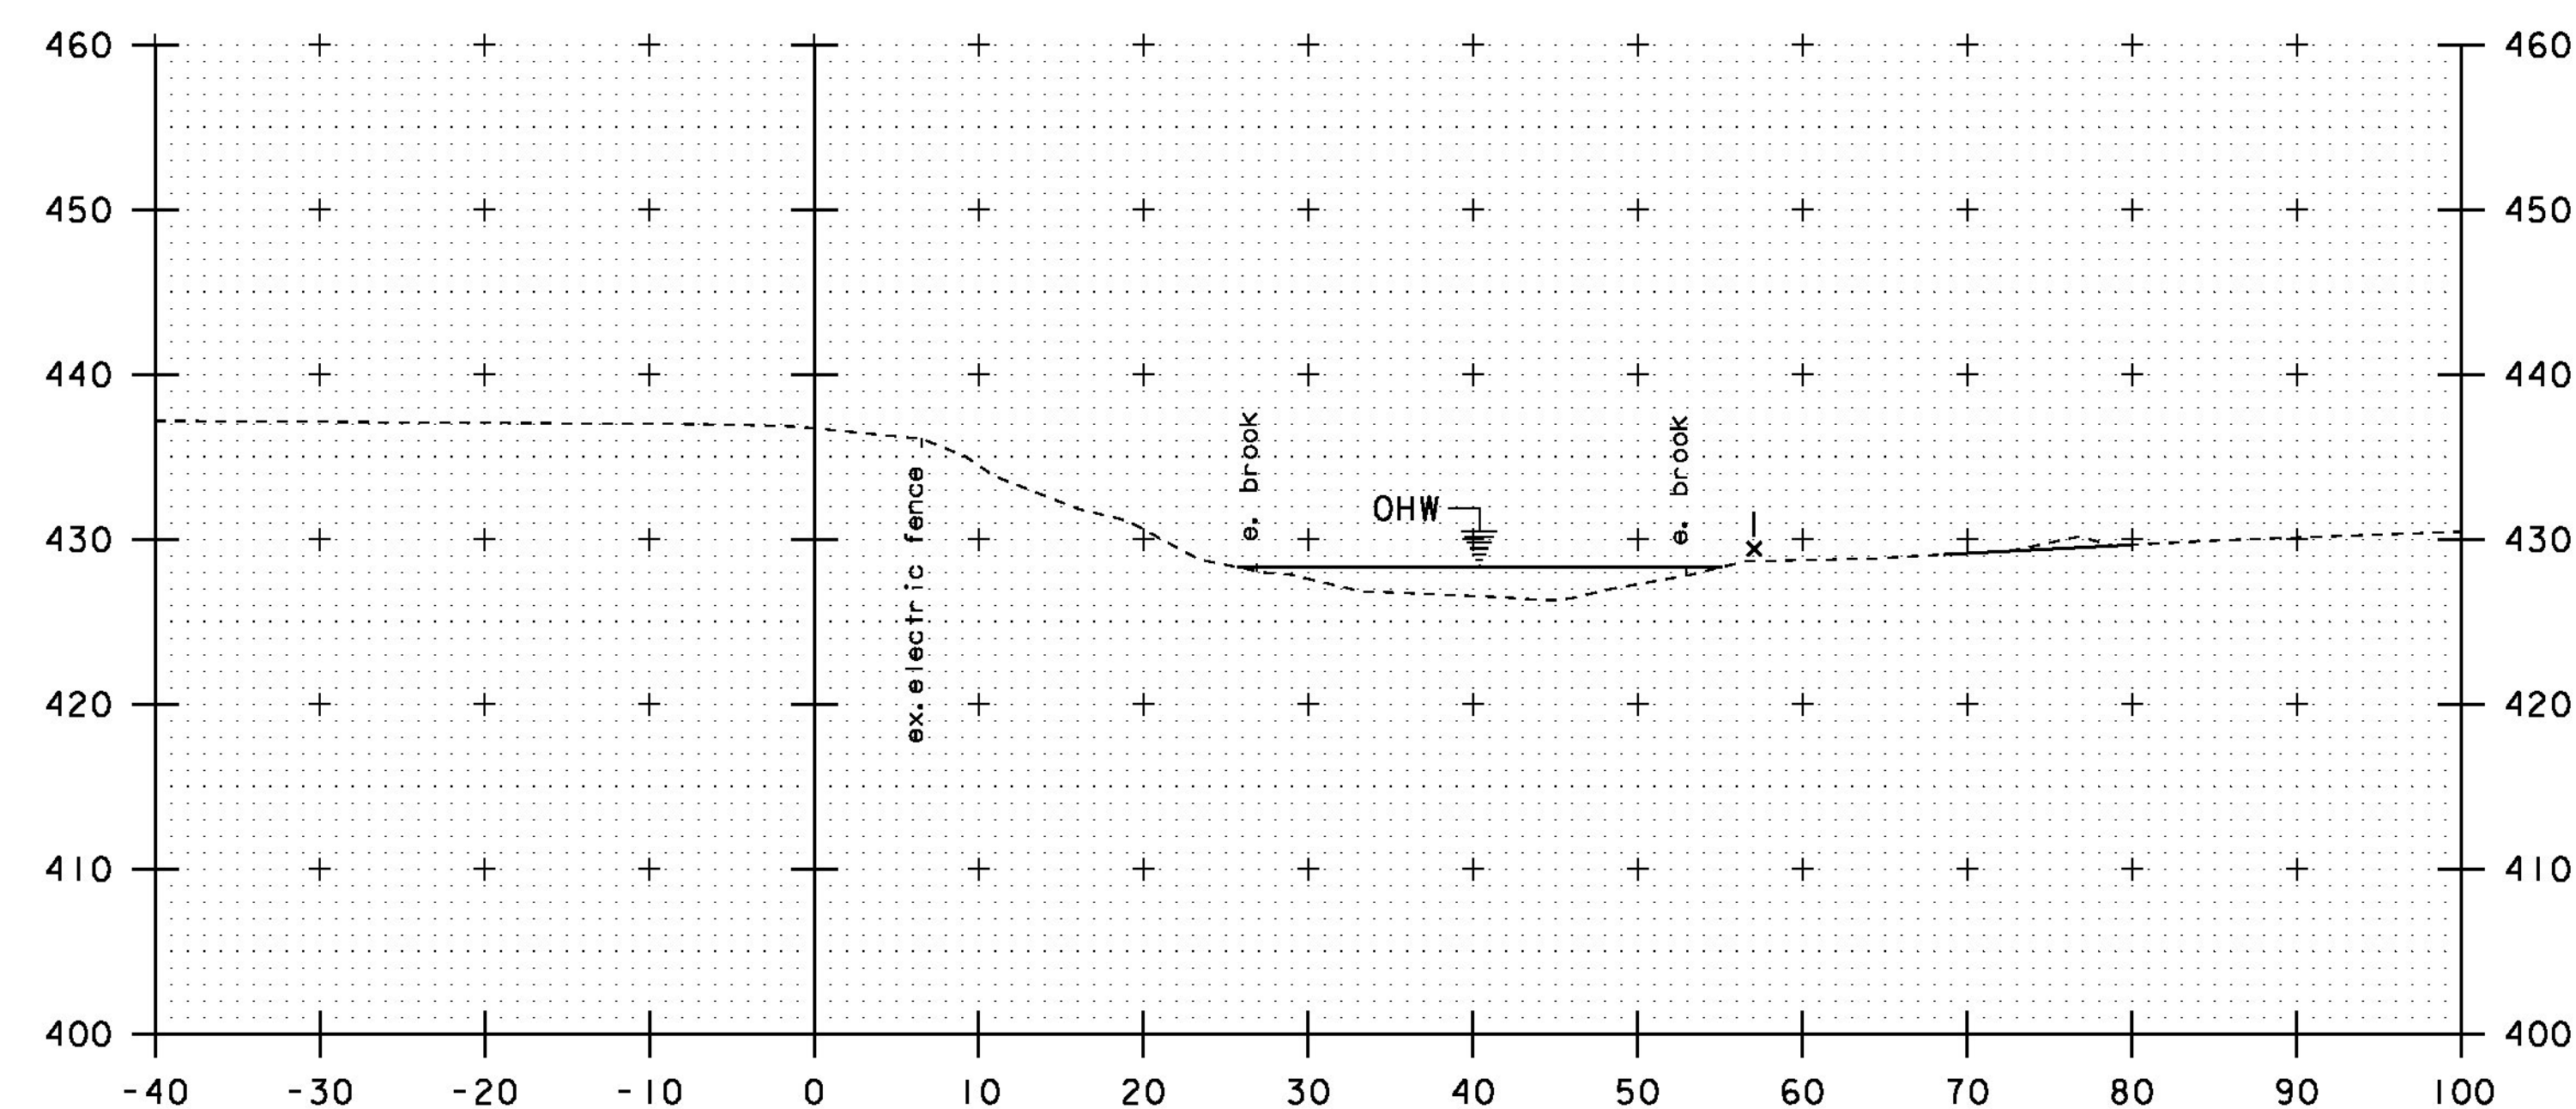

**51+30**

PROJECT NAME: RICHFORD	PLOT DATE: 11-DEC-2014
PROJECT NUMBER: BRF 0302(29)	DRAWN BY: R. PELLETT
FILE NAME: s12j158xs.dgn	DESIGNED BY: H. SALLS
PROJECT LEADER: C. CARLSON	CHECKED BY: H. SALLS
CHANNEL CROSS SECTIONS 2	SHEET 30 OF 36

STA. 51+10 TO STA. 51+40

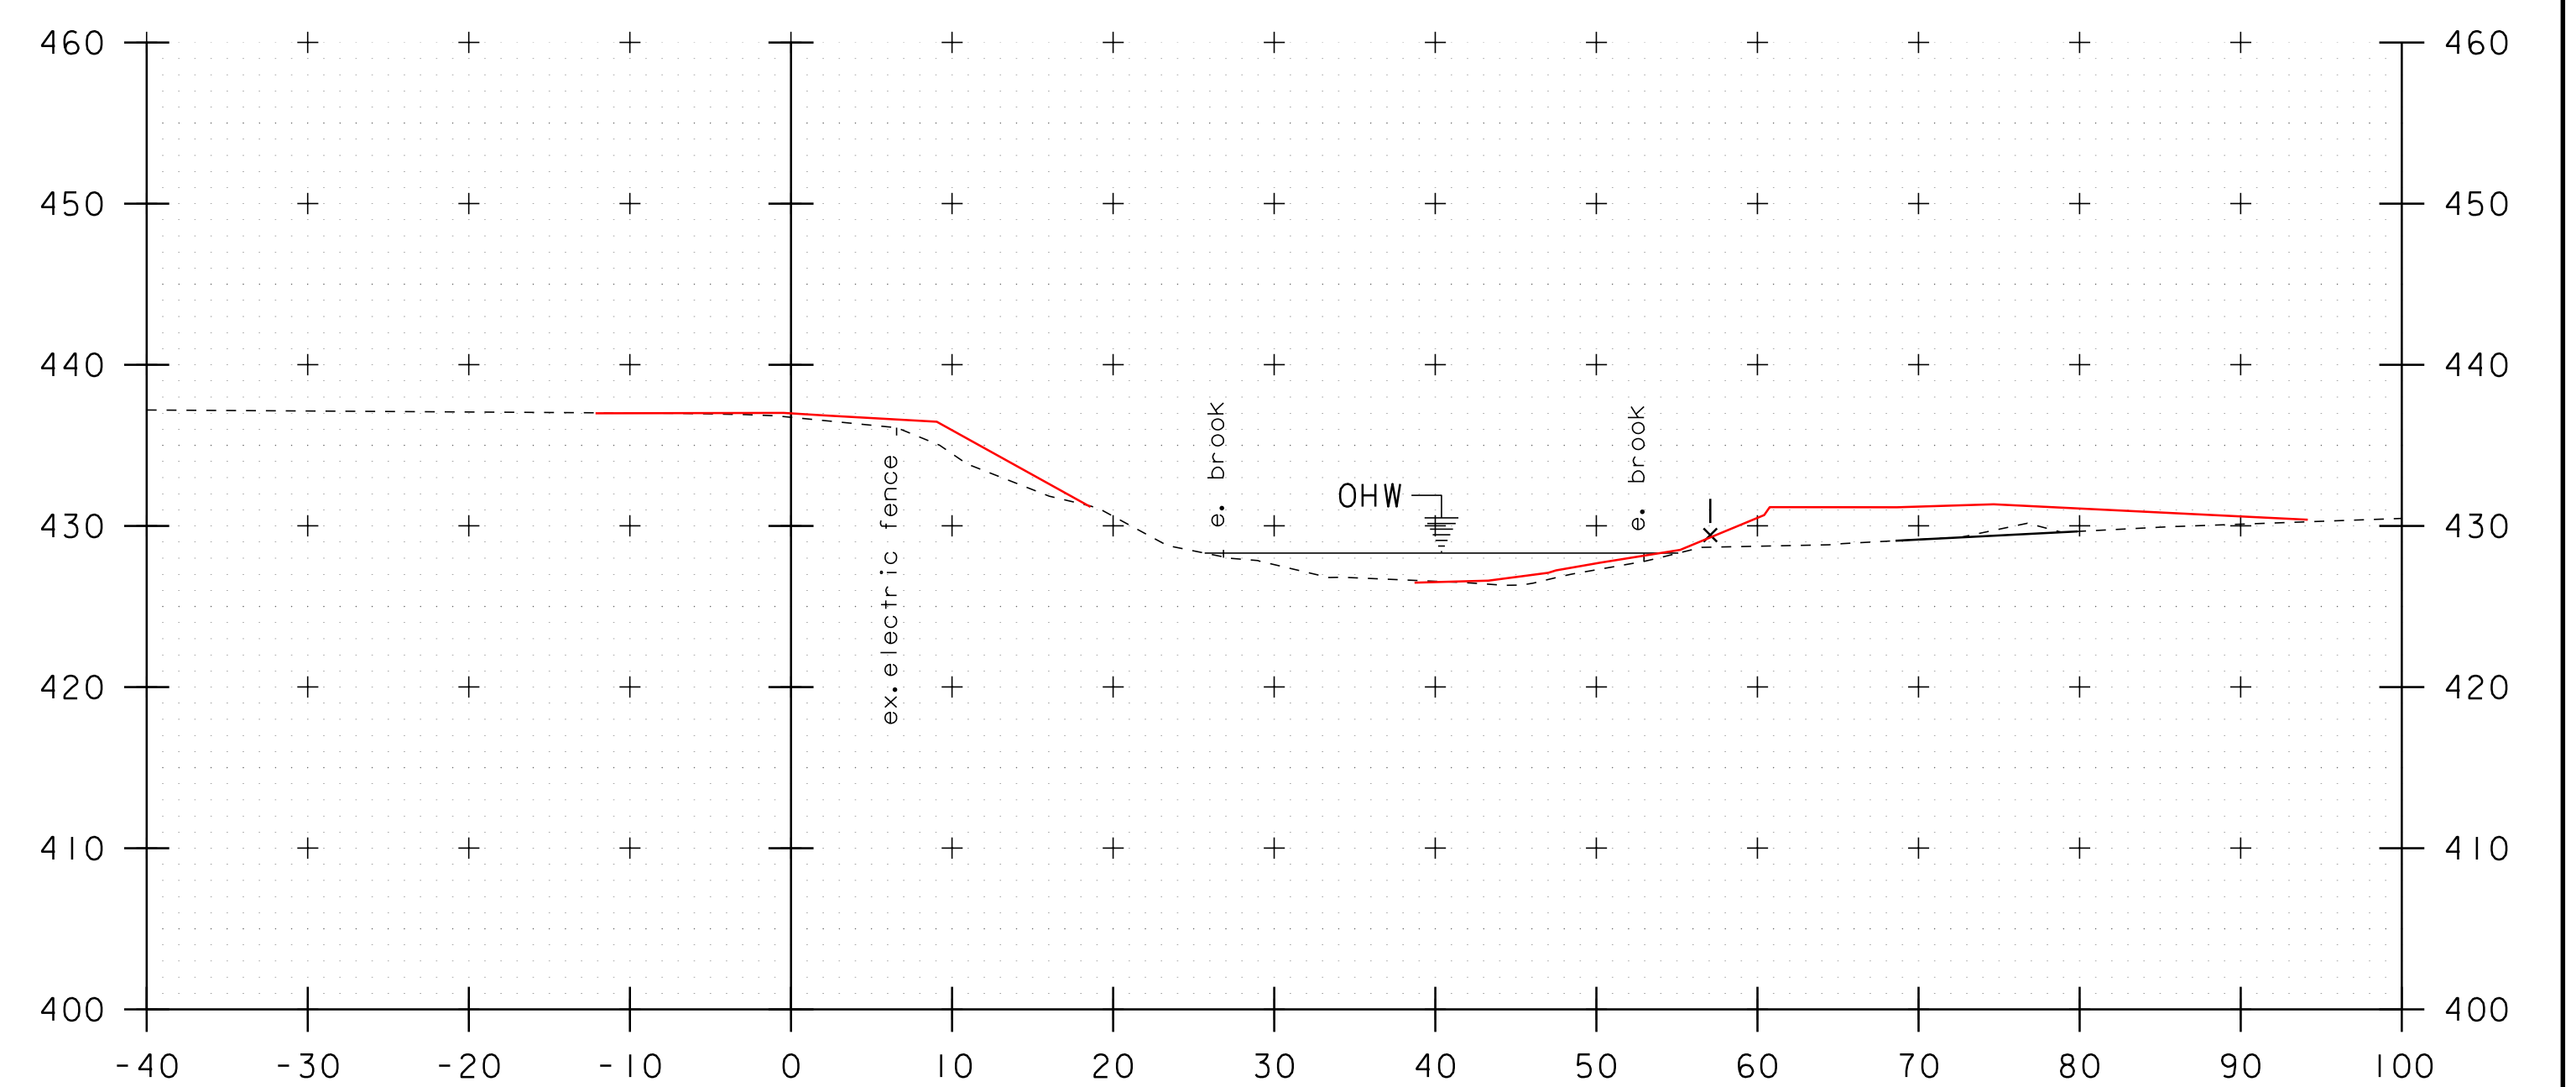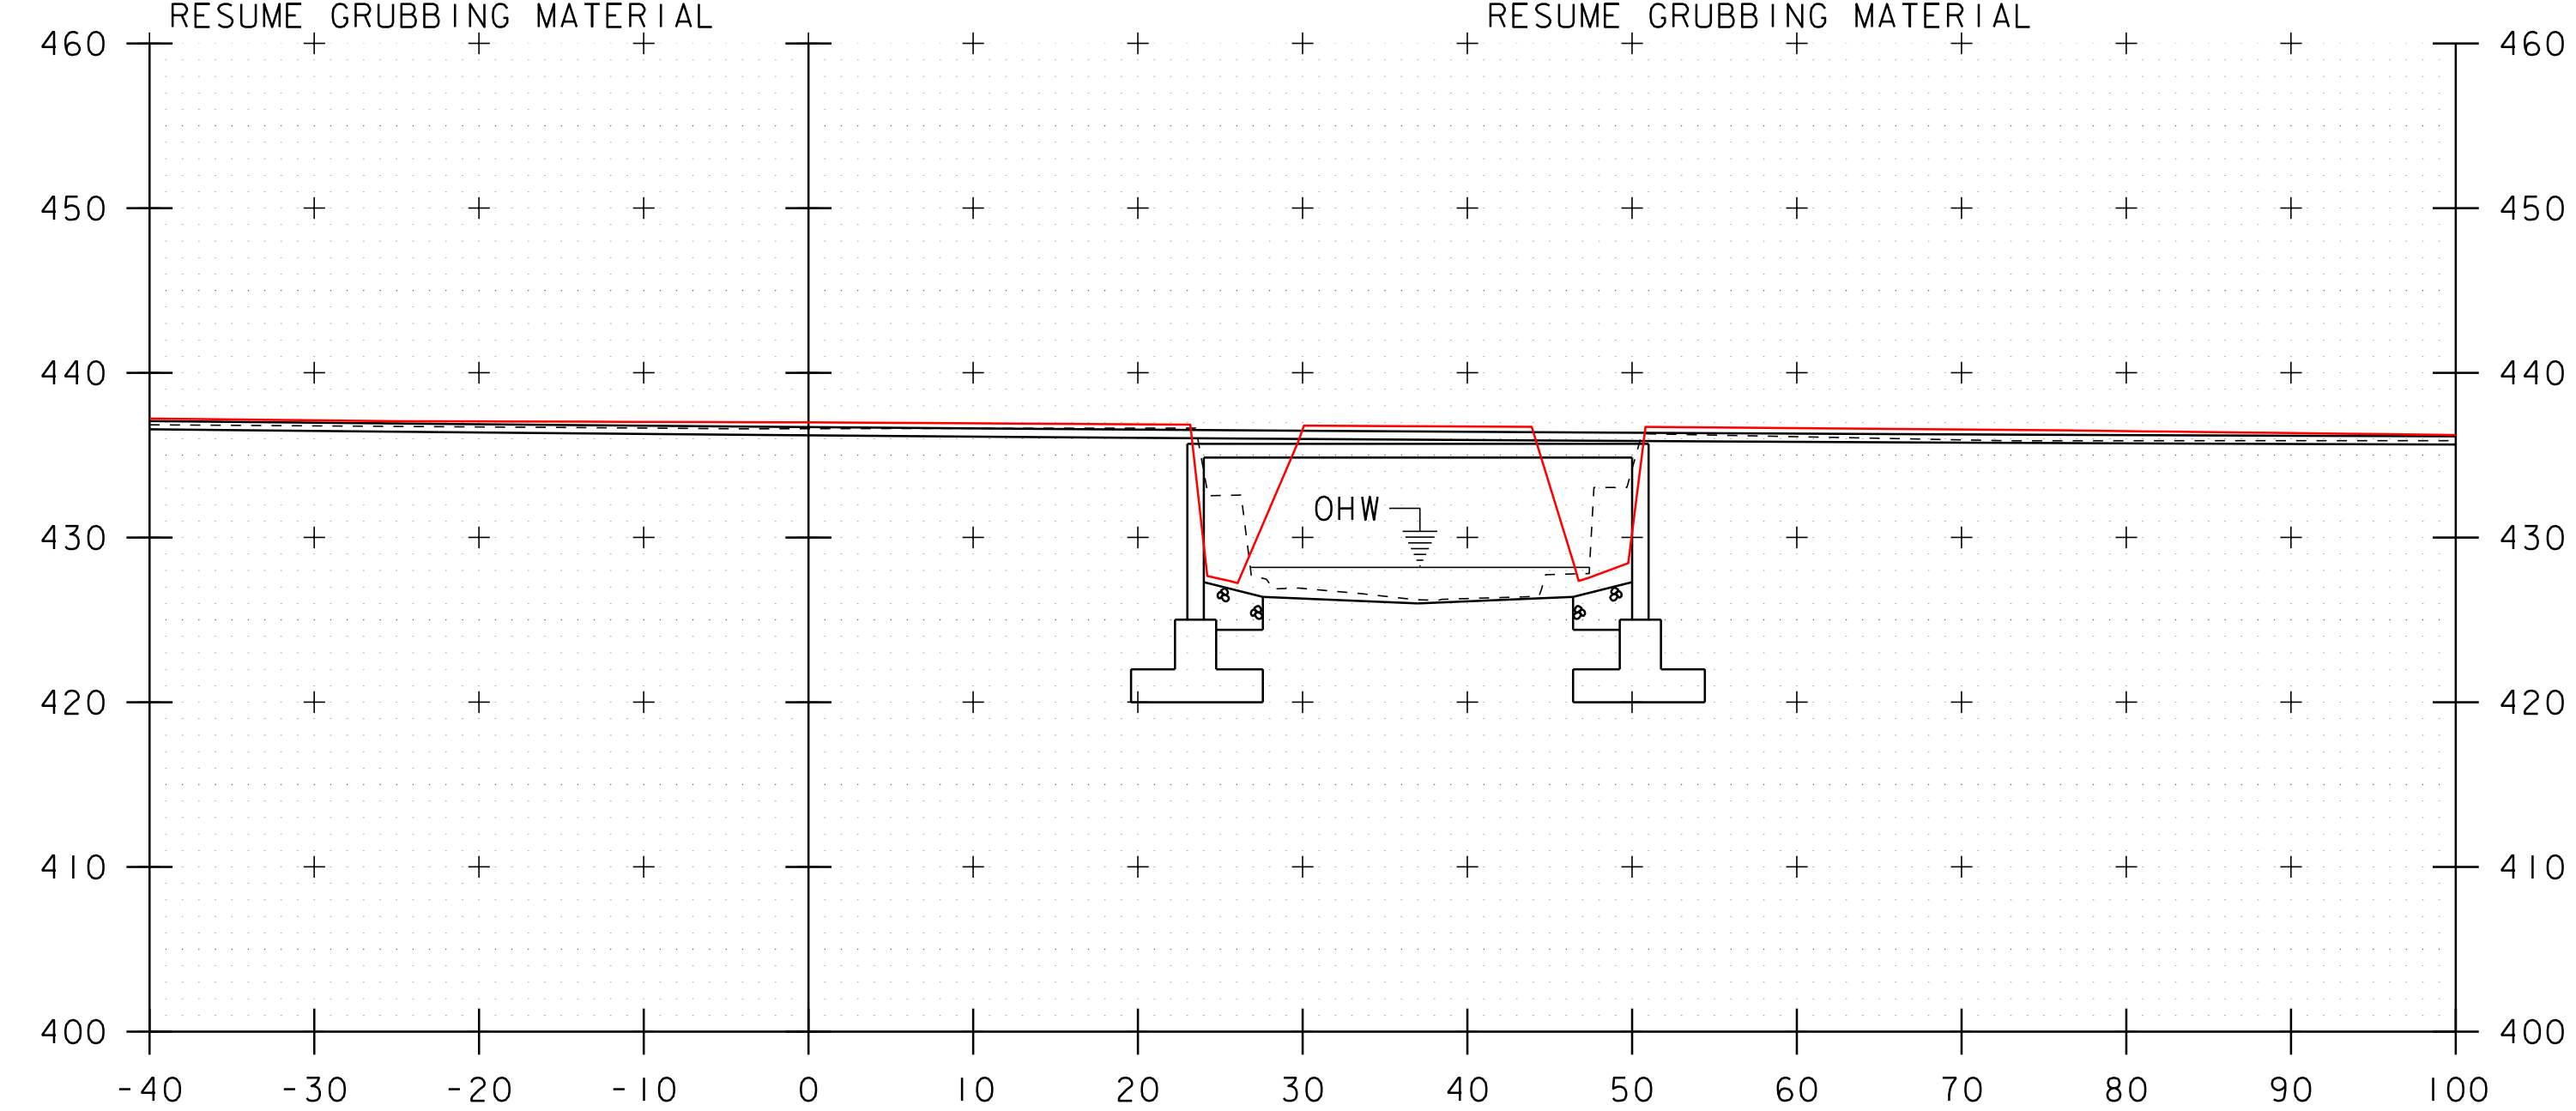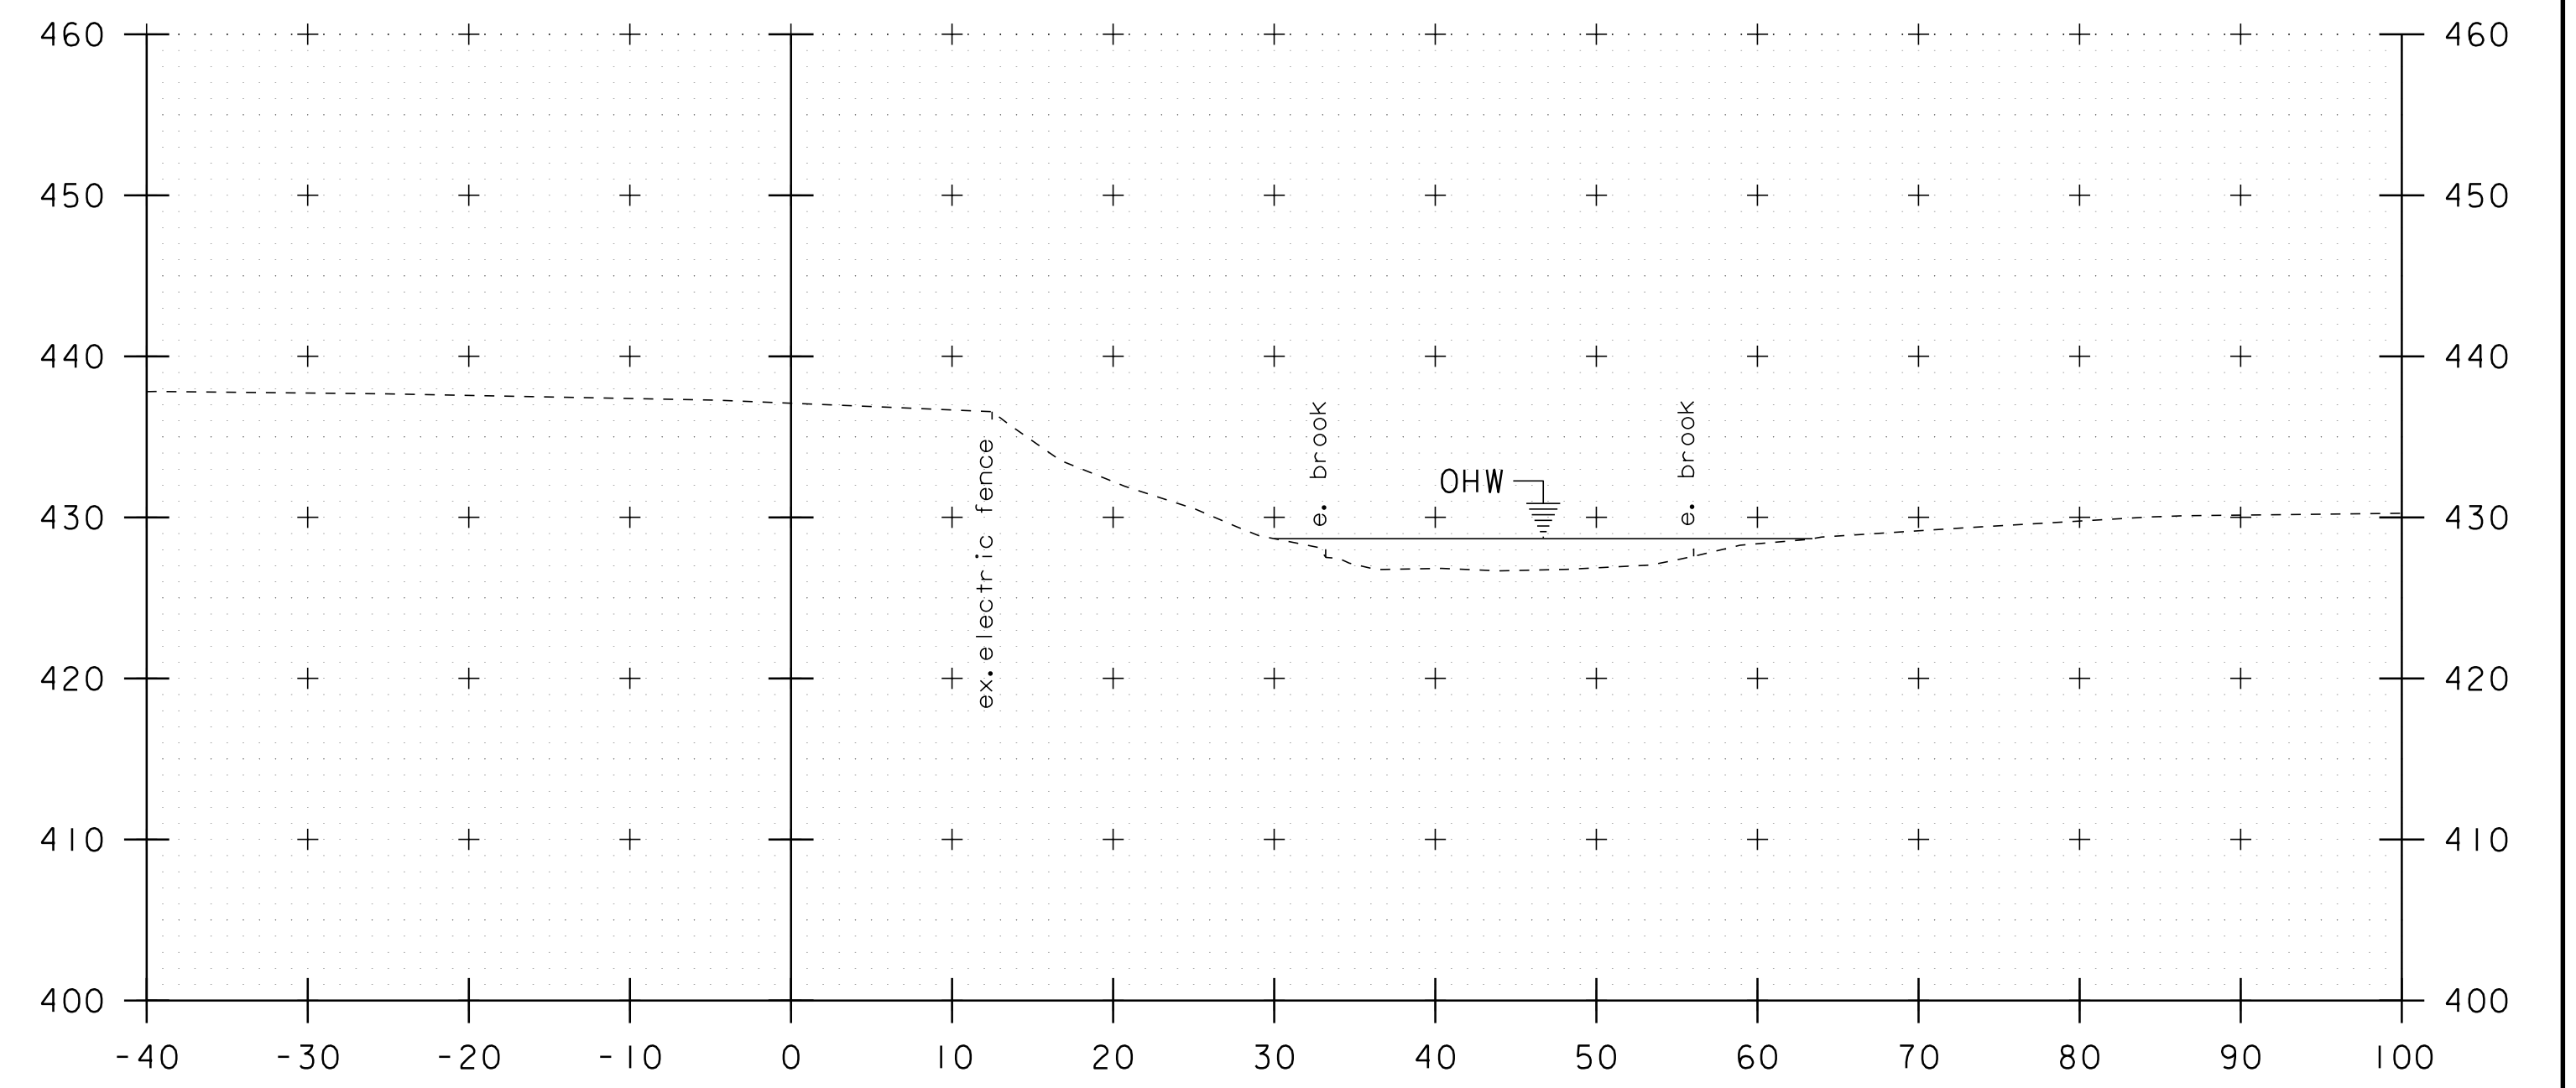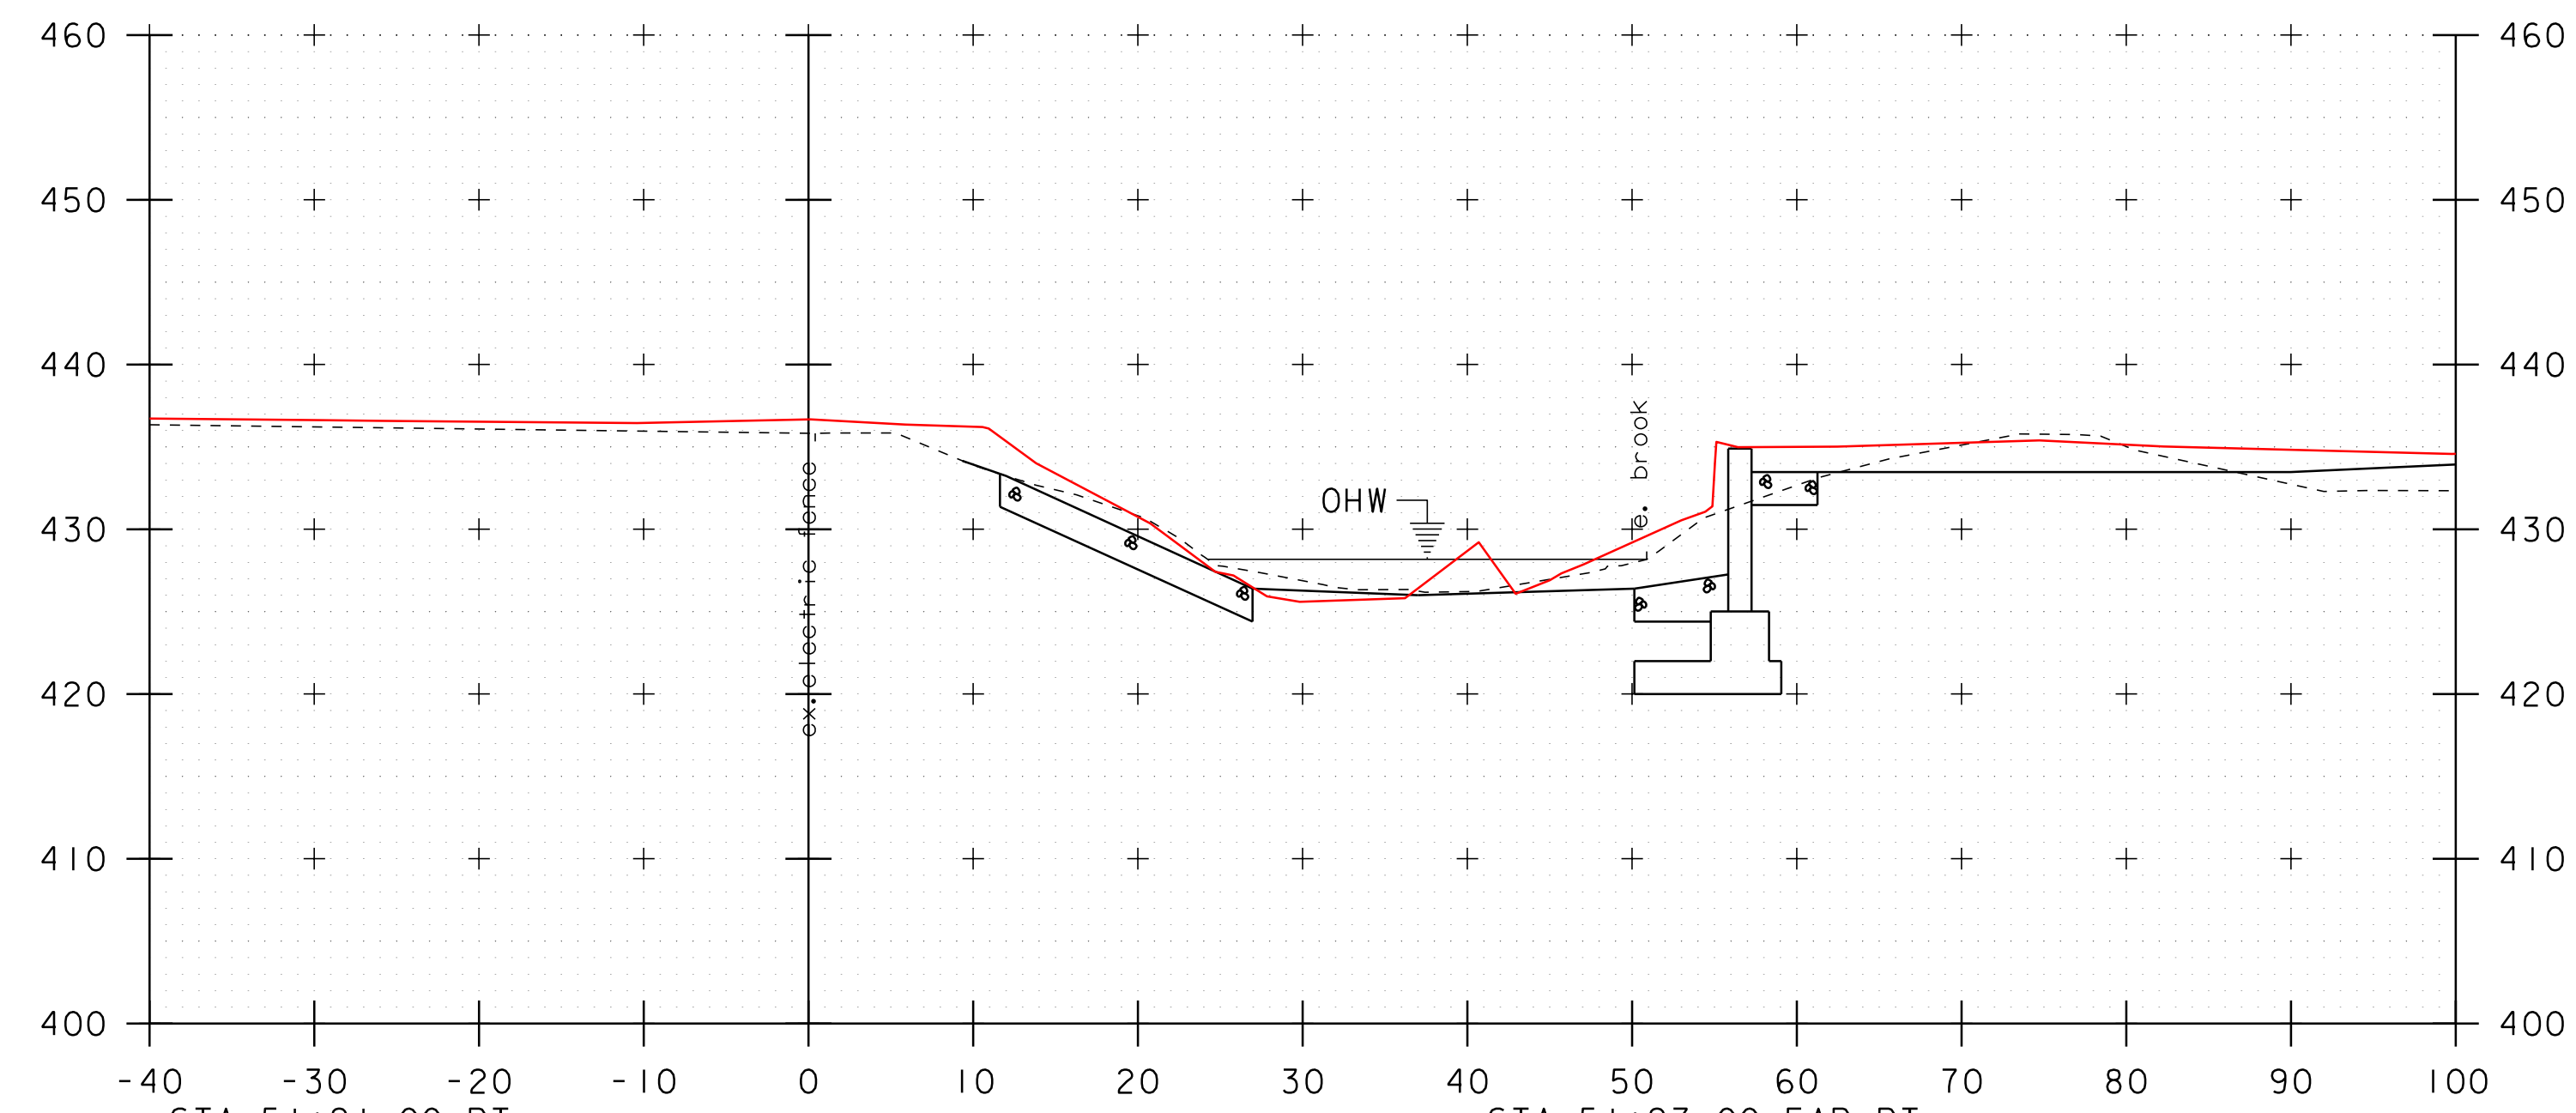

STA. 51+10 TO STA. 51+40

PROJECT NAME:	RICHFORD	PLOT DATE:	09-AUG-2016 09:57
PROJECT NUMBER:	BRF 0302(29)	DRAWN BY:	R. PELLETT
FILE NAME:	s12j158xs.dgn	DESIGNED BY:	H. SALLS
PROJECT LEADER:	C. CARLSON	CHECKED BY:	H. SALLS
CHANNEL CROSS SECTIONS 2		SHEET	<del>30</del> OF <del>64</del>

## EPSC PLAN NARRATIVE

### 1.1 PROJECT DESCRIPTION

THIS PROJECT INVOLVES THE REPLACEMENT OF BRIDGE 6 AND APPROACH ROADWAY AND CHANNEL WORK. EXISTING CONCRETE T-BEAM WILL BE REPLACED WITH A PRECAST CONCRETE 3-SIDED FRAME OR ARCH, SPANNING 28 FEET OVER BERRY BROOK. BRIDGE 6 IS LOCATED IN THE TOWN OF RICHFORD, ON TH 3 1.2 MILES WEST OF JUNCTION WITH TH 1.

NOTE: AREA OF DISTURBANCE INCLUDES LIMITS OF EARTH DISTURBANCE WITHIN THE PROJECT AREA, AS WELL AS WASTE, BORROW AND STAGING AREAS, AND OTHER EARTH DISTURBING ACTIVITIES WITHIN OR DIRECTLY ADJACENT TO THE PROJECT LIMITS AS SHOWN ON THE ATTACHED EPSC PLAN.

TOTAL AREA OF DISTURBANCE AS SHOWN ON THE ATTACHED EPSC PLAN IS APPROXIMATELY 0.35 ACRE.

IT IS ANTICIPATED THAT THIS PROJECT WILL LAST ONE CONSTRUCTION SEASON.

### 1.2 SITE INVENTORY

#### 1.2.1 TOPOGRAPHY

THE TOPOGRAPHY OF THE AREA IS HILLY, WITH A MIXTURE OF OPEN AND FORESTED LAND COVER. TOWN HIGHWAY 3, FIELD DRIVE AND GRAVEL DRIVEWAY ARE WITHIN THE PROJECT LIMITS. THERE IS A RESIDENCE ON THE EAST SIDE OF THE PROJECT.

#### 1.2.2 DRAINAGE, WATERWAYS, BODIES OF WATER, AND PROXIMITY TO NATURAL OR MAN-MADE WATER FEATURES

THE BERRY BROOK IS THE ONLY WATER SOURCE WITHIN THE PROJECT LIMITS. THE BROOK IS CLASSIFIED AS STEEP, SINUOUS, ALUVIAL WITH LOW BANKS TO FLOODPLAIN RELIEF. STREAM BED CONSISTS OF MOSTLY SAND, GRAVEL AND SILT WITH SOME COBBLES. DUE TO THE NATURE OF THE SURROUNDING TERRAIN THE PROJECT SITE COULD RECEIVE FLOOD WATER FROM THE MISSISQUOI RIVER AS IT MAY BACK UP THROUGH THE SITE.

#### 1.2.3 VEGETATION

THE VEGETATION IN THE PROJECT AREA CONSISTS OF PASTURE LAND. THE IMPACT TO VEGETATION WILL BE LIMITED TO THAT WHICH IS DIRECTLY AFFECTED BY REPLACEMENT OF THE EXISTING BRIDGE. UPON PROJECT COMPLETION, THE CHANNEL WILL BE ARMORED WITH STONE FILL TYPE II AS SPECIFIED ON THE PLANS. DISTURBED VEGETATION WILL BE REESTABLISHED WITH STANDARD SEED AND MULCH PRACTICES.

#### 1.2.4 SOILS

ALL SOIL DATA CAME FROM THE U.S. DEPARTMENT OF AGRICULTURE SOIL CONSERVATION SERVICE FOR THE COUNTY OF FRANKLIN, VERMONT. SOIL ON THE PROJECT SITE IS PEACHAM STONY SOILS, <1%, "K FACTOR" = 0.28. THE SOIL IS CONSIDERED MODERATELY ERODIBLE DUE TO SLOPES.

NOTE: K-VALUES GENERALLY INDICATE THE FOLLOWING:  
0.0-0.23 = LOW EROSION POTENTIAL  
0.24-0.36 = MODERATE EROSION POTENTIAL  
0.37 AND HIGHER = HIGH EROSION POTENTIAL

#### 1.2.5 SENSITIVE RESOURCE AREAS

CRITICAL HABITATS: NO  
HISTORICAL OR ARCHEOLOGICAL AREAS: NO  
PRIME AGRICULTURAL LAND: NO  
THREATENED AND ENDANGERED SPECIES: NO  
WATER RESOURCE: BERRY BROOK  
WETLANDS: YES

### 1.3 RISK EVALUATION

THIS PROJECT DOES NOT FALL UNDER THE JURISDICTION OF GENERAL PERMIT 3-9020 FOR STORMWATER RUNOFF FROM CONSTRUCTION SITES. SHOULD CHANGES PRIOR TO OR DURING CONSTRUCTION RESULT IN ONE OR MORE ACRES OF EARTH DISTURBANCE OR SHOULD THE PROJECT BECOME PART OF A LARGER PLAN OF DEVELOPMENT, THE CONTRACTOR WILL BE RESPONSIBLE FOR ANY ADDITIONAL PERMITTING.

### 1.4 EROSION PREVENTION AND SEDIMENT CONTROL

THE EROSION CONTROL PLANS ARE MEANT AS A GUIDELINE FOR PREVENTING EROSION AND CONTROLLING SEDIMENT TRANSPORT. THE PRINCIPLES OUTLINED IN THIS NARRATIVE CONSIST OF APPLYING MEASURES THROUGHOUT CONSTRUCTION OF THE PROJECT IN ORDER TO MINIMIZE SEDIMENT TRANSPORT TO THE RECEIVING WATERS. THE MEASURES INCLUDE STABILIZATION AND STRUCTURAL PRACTICES, STORM WATER CONTROLS AND OTHER POLLUTION PREVENTION PRACTICES. THEY HAVE BEEN PROPOSED BY THE DESIGNER AS A BASIS FOR PROTECTING RESOURCES AND WILL NEED TO BE BUILT UPON BASED ON THE SPECIFIC MEANS AND METHODS OF THE CONTRACTOR. REFER TO THE LOW RISK SITE HANDBOOK AND APPROPRIATE DETAIL SHEETS FOR SPECIFIC GUIDANCE AND CONSTRUCTION DETAILING.

ALL MEASURES SHALL BE REGULARLY MAINTAINED AND SHALL BE CHECKED FOR SEDIMENT BUILD-UP. SEDIMENT SHALL BE DISPOSED OF AT AN APPROVED SITE WHERE IT WILL NOT BE SUBJECT TO EROSION.

#### 1.4.1 MARK SITE BOUNDARIES

SITE BOUNDARIES AND AREAS CONSTRUCTION EQUIPMENT CAN ACCESS SHALL BE DELINEATED.

PROJECT DEMARCATION FENCING (PDF) AND BARRIER FENCE SHALL BE USED TO PHYSICALLY MARK SITE BOUNDARIES.

#### 1.4.2 LIMIT DISTURBANCE AREA

PREVENTING INITIAL SOIL EROSION BY MINIMIZING THE EXPOSED AREA IS MUCH MORE EFFECTIVE THAN TREATING ERODED SEDIMENT. EARTH DISTURBANCE CAN BE MINIMIZED THROUGH CONSTRUCTION PHASING BY ONLY OPENING UP EARTH AS NECESSARY. THIS CAN LIMIT THE AREA THAT WILL BE DISTURBED AND EXPOSED TO EROSION. EMPLOY TEMPORARY CONSTRUCTION STABILIZATION PRACTICES IN INCREMENTAL STAGES AS PHASES CHANGE. FOR PROJECTS WHICH FALL UNDER THE CONSTRUCTION GENERAL PERMIT, ONLY THE ACREAGE LISTED ON THE PERMIT AUTHORIZATION MAY BE EXPOSED AT ANY GIVEN TIME.

MAINTAINING VEGETATED BUFFERS ALONG STREAM BANKS, WETLANDS OR OTHER SENSITIVE AREAS IS A CRUCIAL EROSION AND SEDIMENT CONTROL MEASURE THAT SHOULD BE ESTABLISHED WHEREVER POSSIBLE.

#### 1.4.3 SITE ENTRANCE/EXIT STABILIZATION

TRACKING OF SEDIMENT ONTO PUBLIC HIGHWAYS SHALL BE MINIMIZED TO REDUCE THE POTENTIAL FOR RUNOFF ENTERING RECEIVING WATERS. INSTALLATION SHALL COINCIDE WITH THE CONTRACTOR'S PROGRESS SCHEDULE.

STABILIZED CONSTRUCTION ENTRANCES SHALL BE INSTALLED AS PROPOSED ON THE EPSC PLAN AND ANYWHERE EQUIPMENT WILL BE GOING FROM AREAS OF EXPOSED SOILS TO PAVED SURFACES.

#### 1.4.4 INSTALL SEDIMENT BARRIERS

SEDIMENT BARRIERS SHALL BE UTILIZED TO INTERCEPT RUNOFF AND ALLOW SUSPENDED SEDIMENT TO SETTLE OUT. THEY SHALL BE INSTALLED PRIOR TO ANY UP SLOPE WORK.

SILT FENCE AND TURBIDITY CURTAIN WILL BE INSTALLED AS PROPOSED ON THE EPSC PLAN.

#### 1.4.5 DIVERT UPLAND RUNOFF

DIVERSIONARY MEASURES SHALL BE USED TO INTERCEPT RUNOFF FROM ABOVE THE CONSTRUCTION AND DIRECT IT AROUND THE DISTURBED AREA SO THAT CLEAN WATER DOES NOT BECOME MUDDIED WHILE TRAVELING OVER EXPOSED SOILS ON THE CONSTRUCTION SITE.

THE PROJECT AREA IS RELATIVELY FLAT. THEREFORE IT IS NOT ANTICIPATED THAT DIVERSION MEASURES WILL BE NECESSARY.

#### 1.4.6 SLOW DOWN CHANNELIZED RUNOFF

NONE ANTICIPATED

#### 1.4.7 CONSTRUCT PERMANENT CONTROLS

NONE ANTICIPATED

#### 1.4.8 STABILIZE EXPOSED SOILS DURING CONSTRUCTION

ALL AREAS OF DISTURBANCE MUST HAVE TEMPORARY STABILIZATION IN PLACE WITHIN 48 HOURS OF DISTURBANCE OR IN ACCORDANCE WITH THE CONSTRUCTION GENERAL PERMIT 3-9020 AUTHORIZATION.

THE FORECAST OF RAINFALL EVENTS SHALL TRIGGER IMMEDIATE PROTECTION OF EXPOSED SOILS.

#### 1.4.9 WINTER STABILIZATION

VARIOUS MEASURES SPECIFIC TO WINTER MAY BE NECESSARY SHOULD THE PROJECT EXTEND INTO WINTER (OCTOBER 15 THROUGH APRIL 15). REFER TO THE LOW RISK SITE HANDBOOK FOR GUIDANCE.

#### 1.4.10 STABILIZE SOIL AT FINAL GRADE

EXPOSED SOIL MUST BE STABILIZED WITHIN 48 HOURS OF REACHING FINAL GRADE.

#### 1.4.11 DE-WATERING ACTIVITIES

DISCHARGE FROM DEWATERING ACTIVITIES THAT FLOWS OFF OF THE CONSTRUCTION SITE MUST NOT CAUSE OR CONTRIBUTE TO A VIOLATION OF THE VERMONT WATER QUALITY STANDARDS.

#### 1.4.12 INSPECT YOUR SITE

INSPECT THE PROJECT SITE BASED ON SPECIAL PROVISION REQUIREMENTS OR CONSTRUCTION GENERAL PERMIT AUTHORIZATION STIPULATIONS.

### 1.5 SEQUENCE AND STAGING



THIS SECTION WILL BE DEVELOPED BY THE CONTRACTOR USING THE GUIDANCE OUTLINED IN THE VTRANS EPSC PLAN CONTRACTOR CHECKLIST.

#### 1.5.2 OFF-SITE ACTIVITIES

IN ADDITION TO THE CONTRACTOR CHECKLIST ANY ACTIVITIES OUTSIDE THE CONSTRUCTION LIMITS SHALL FOLLOW SUBSECTIONS 105.25- 105.29 OF THE STANDARD SPECIFICATIONS FOR CONSTRUCTION.


PROJECT NAME:	RICHFORD
PROJECT NUMBER:	BRF 0302(29)
FILE NAME: s12j158epsc.narrative.dgn	PLOT DATE: 11-DEC-2014
PROJECT LEADER: C. CARLSON	DRAWN BY: R. PELLETT
DESIGNED BY: H. SALLS	CHECKED BY: H. SALLS
EPSC NARRATIVE	SHEET 31 OF 36



SOIL INFORMATION  
 PEACHAM STONY SOILS  
 <1% SLOPES  
 MODERATE EROSION POTENTIAL  
 K=0.28

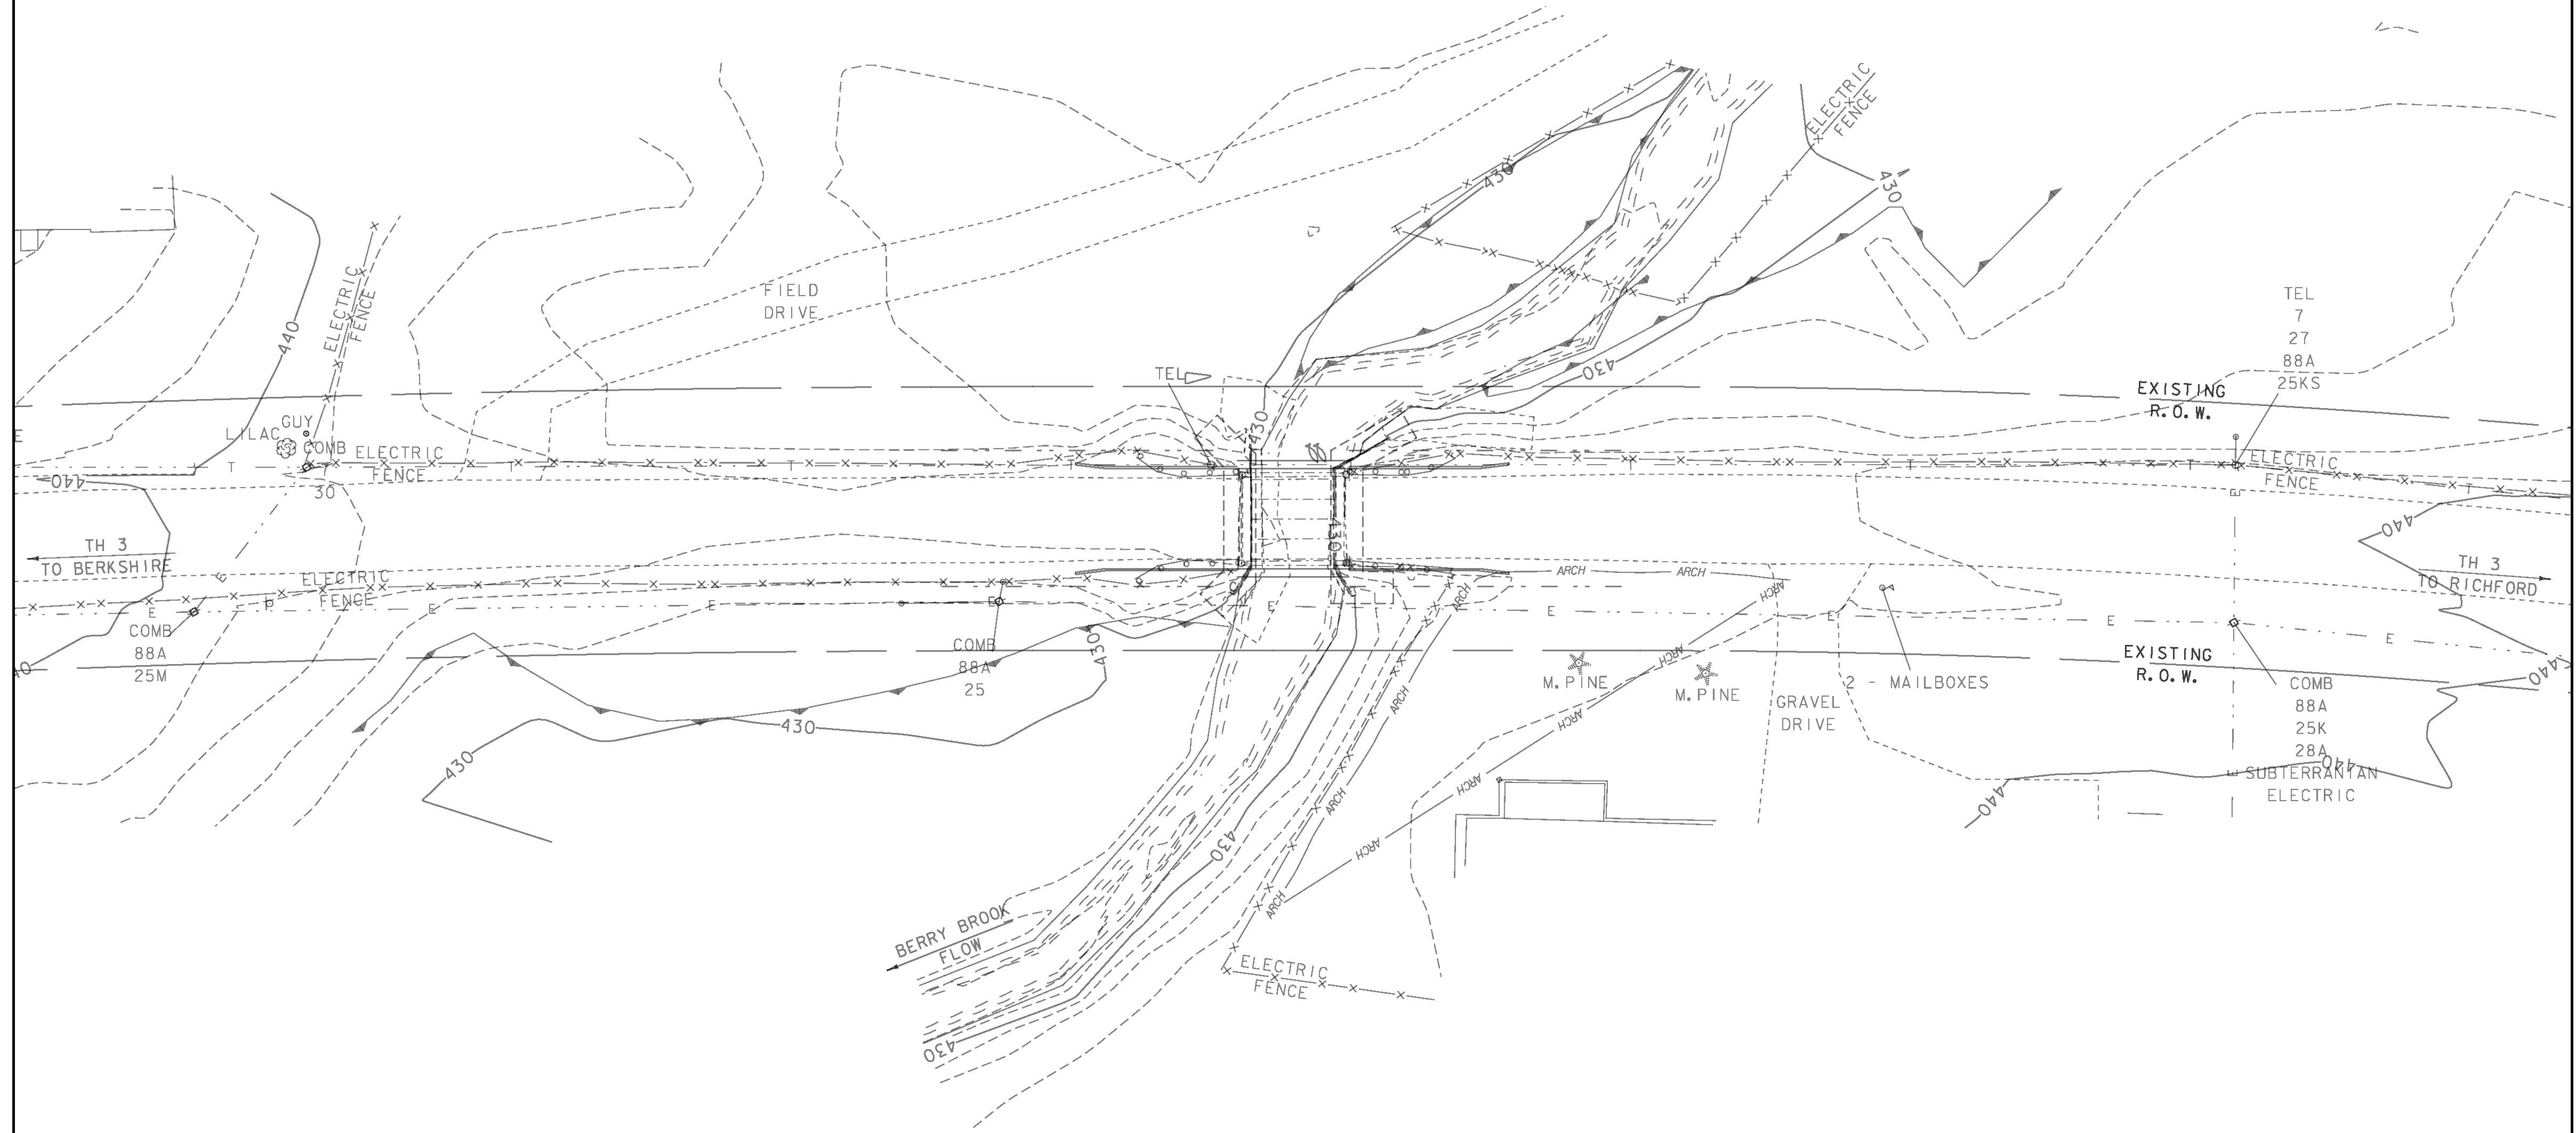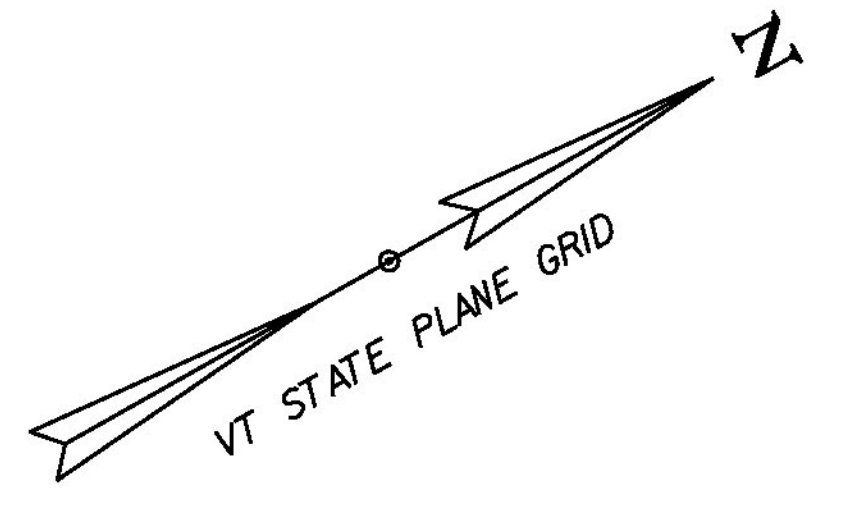

NOTE: SEE SHEET 8 FOR SYMBOLOGY LEGEND

PROJECT NAME:	RICHFORD	PLOT DATE:	11-DEC-2014
PROJECT NUMBER:	BRF 0302(29)	DRAWN BY:	R. PELLETT
FILE NAME:	st2j158bdrero.dgn	DESIGNED BY:	H. SALLS
PROJECT LEADER:	C. CARLSON	CHECKED BY:	H. SALLS
EPSC EXISTING CONDITIONS			SHEET 32 OF 36


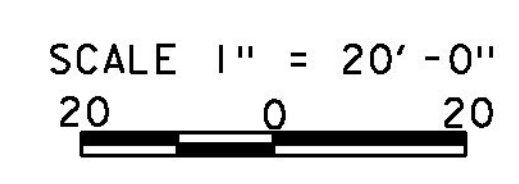


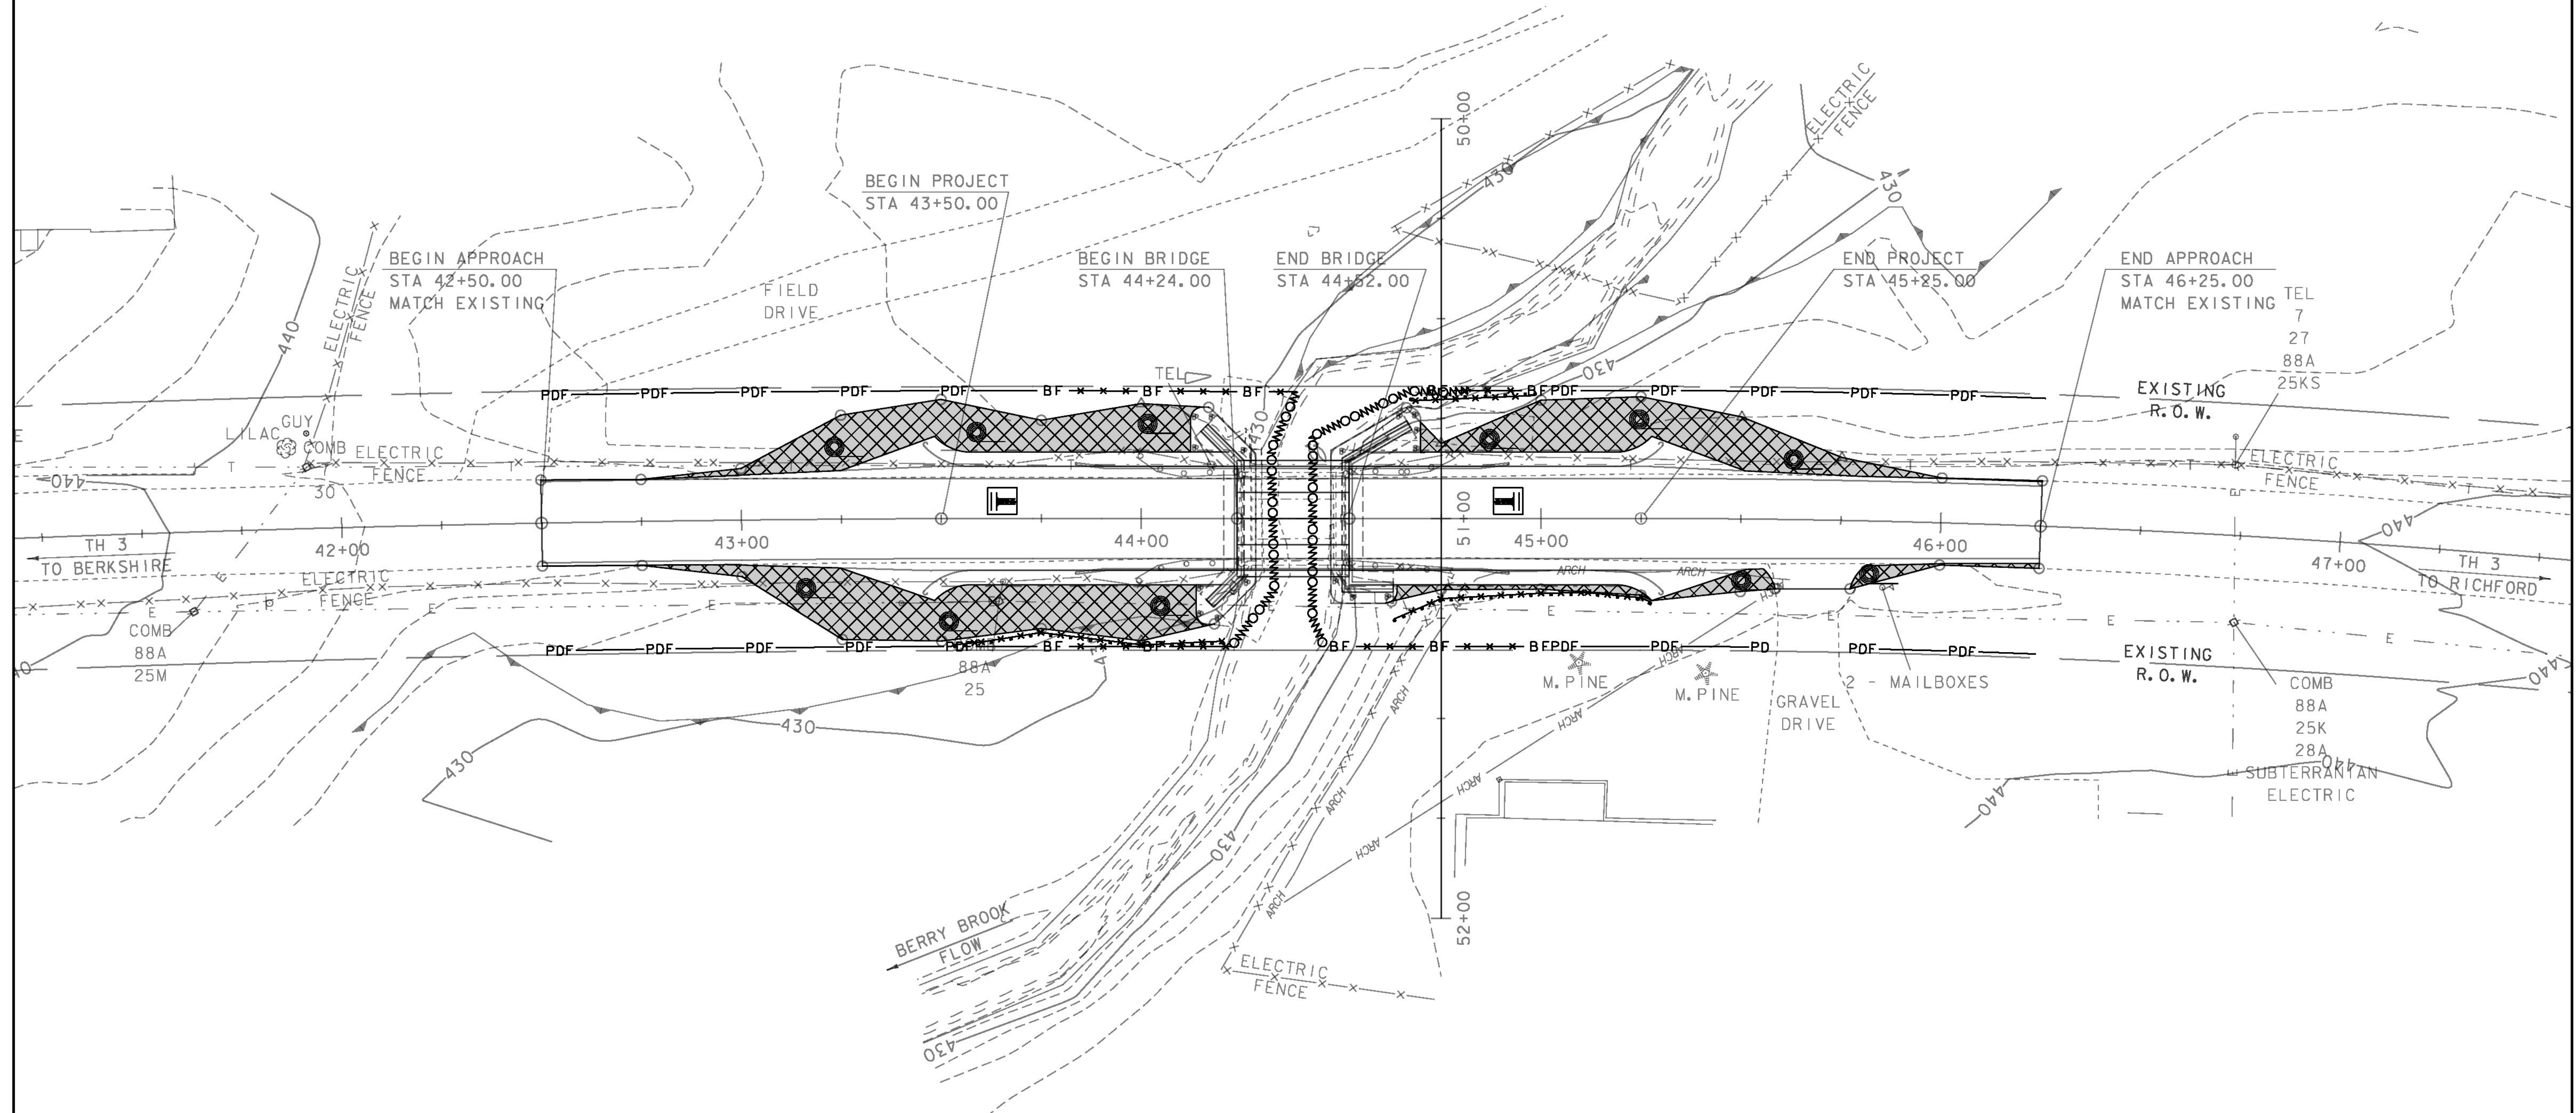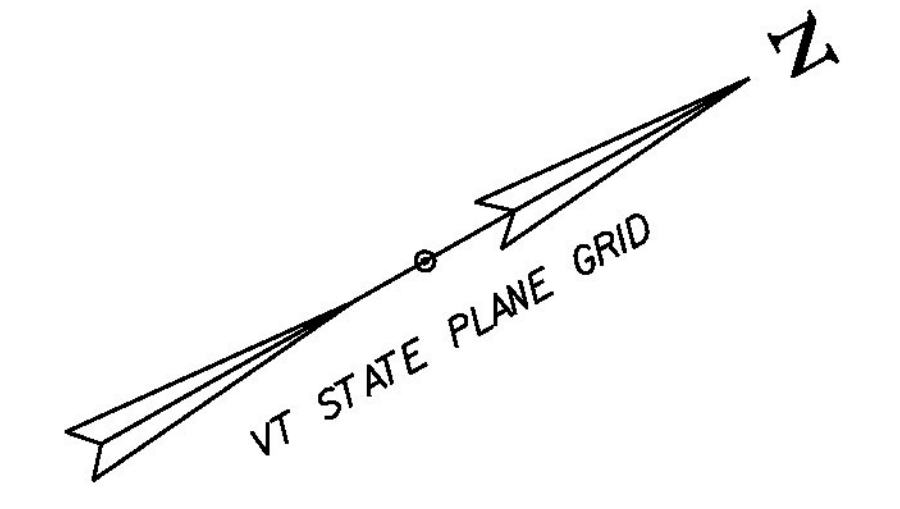

= STABILIZED CONSTRUCTION ENTRANCE  
 NOTE: SEE SHEET 8 FOR SYMBOLOGY LEGEND


PROJECT NAME:	RICHFORD	PLOT DATE:	06-JAN-2015
PROJECT NUMBER:	BRF 0302(29)	DRAWN BY:	R. PELLETT
FILE NAME:	st2j158bdrero.dgn	DESIGNED BY:	H. SALLS
PROJECT LEADER:	C. CARLSON	CHECKED BY:	H. SALLS
EPSC DURING CONSTRUCTION			SHEET 33 OF 36


SCALE 1" = 20'-0"

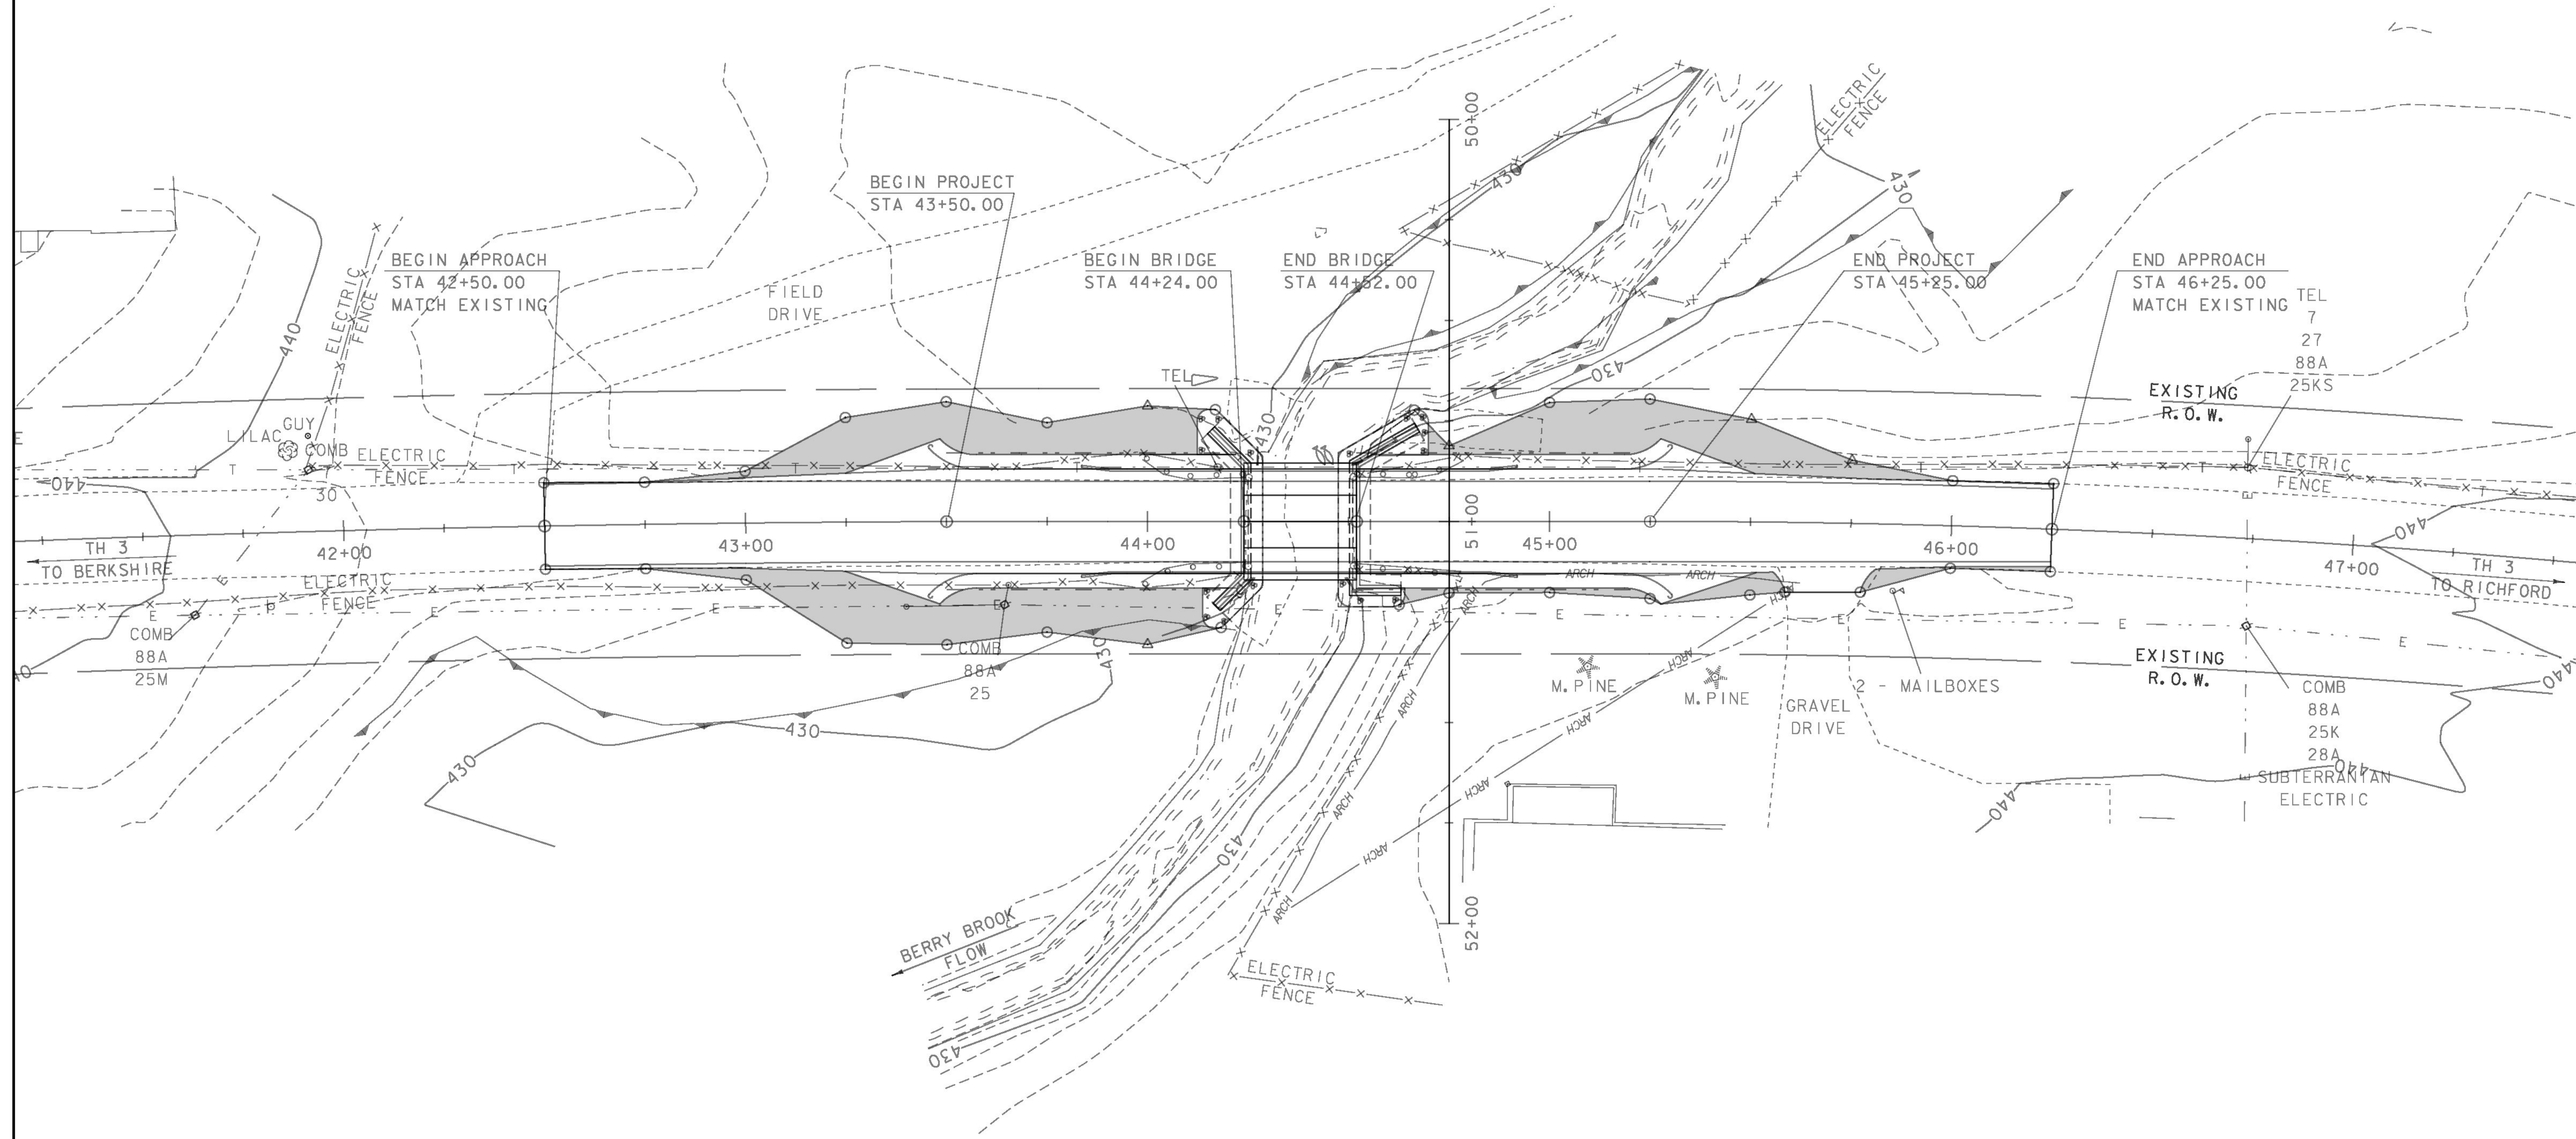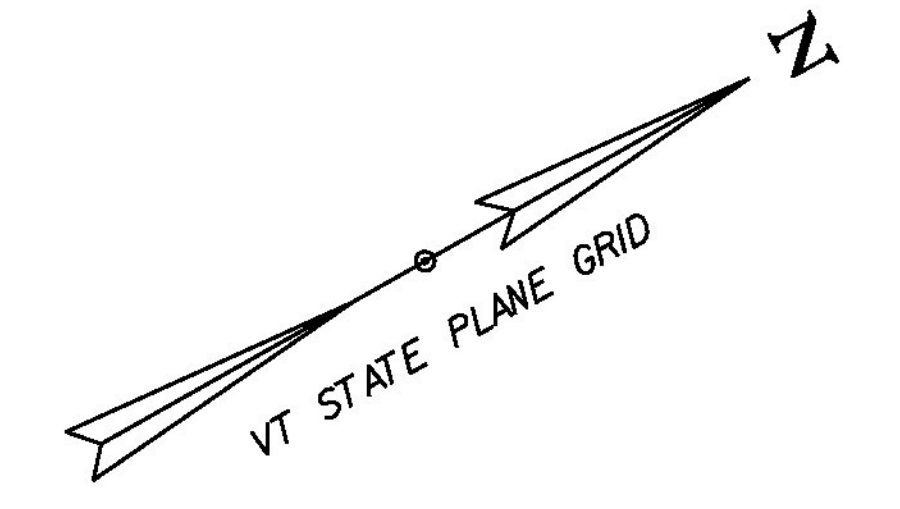

NOTE: SEE SHEET 8 FOR SYMBOLOGY LEGEND

PROJECT NAME:	RICHFORD	PLOT DATE:	11-DEC-2014
PROJECT NUMBER:	BRF 0302(29)	DRAWN BY:	R. PELLETT
FILE NAME:	st2j158bdrero.dgn	DESIGNED BY:	H. SALLS
PROJECT LEADER:	C. CARLSON	CHECKED BY:	H. SALLS
EPSC FINAL CONDITIONS			SHEET 34 OF 36

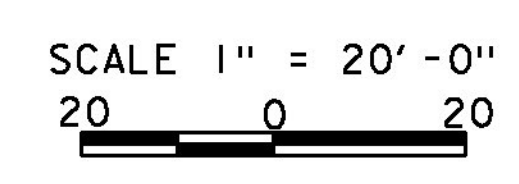

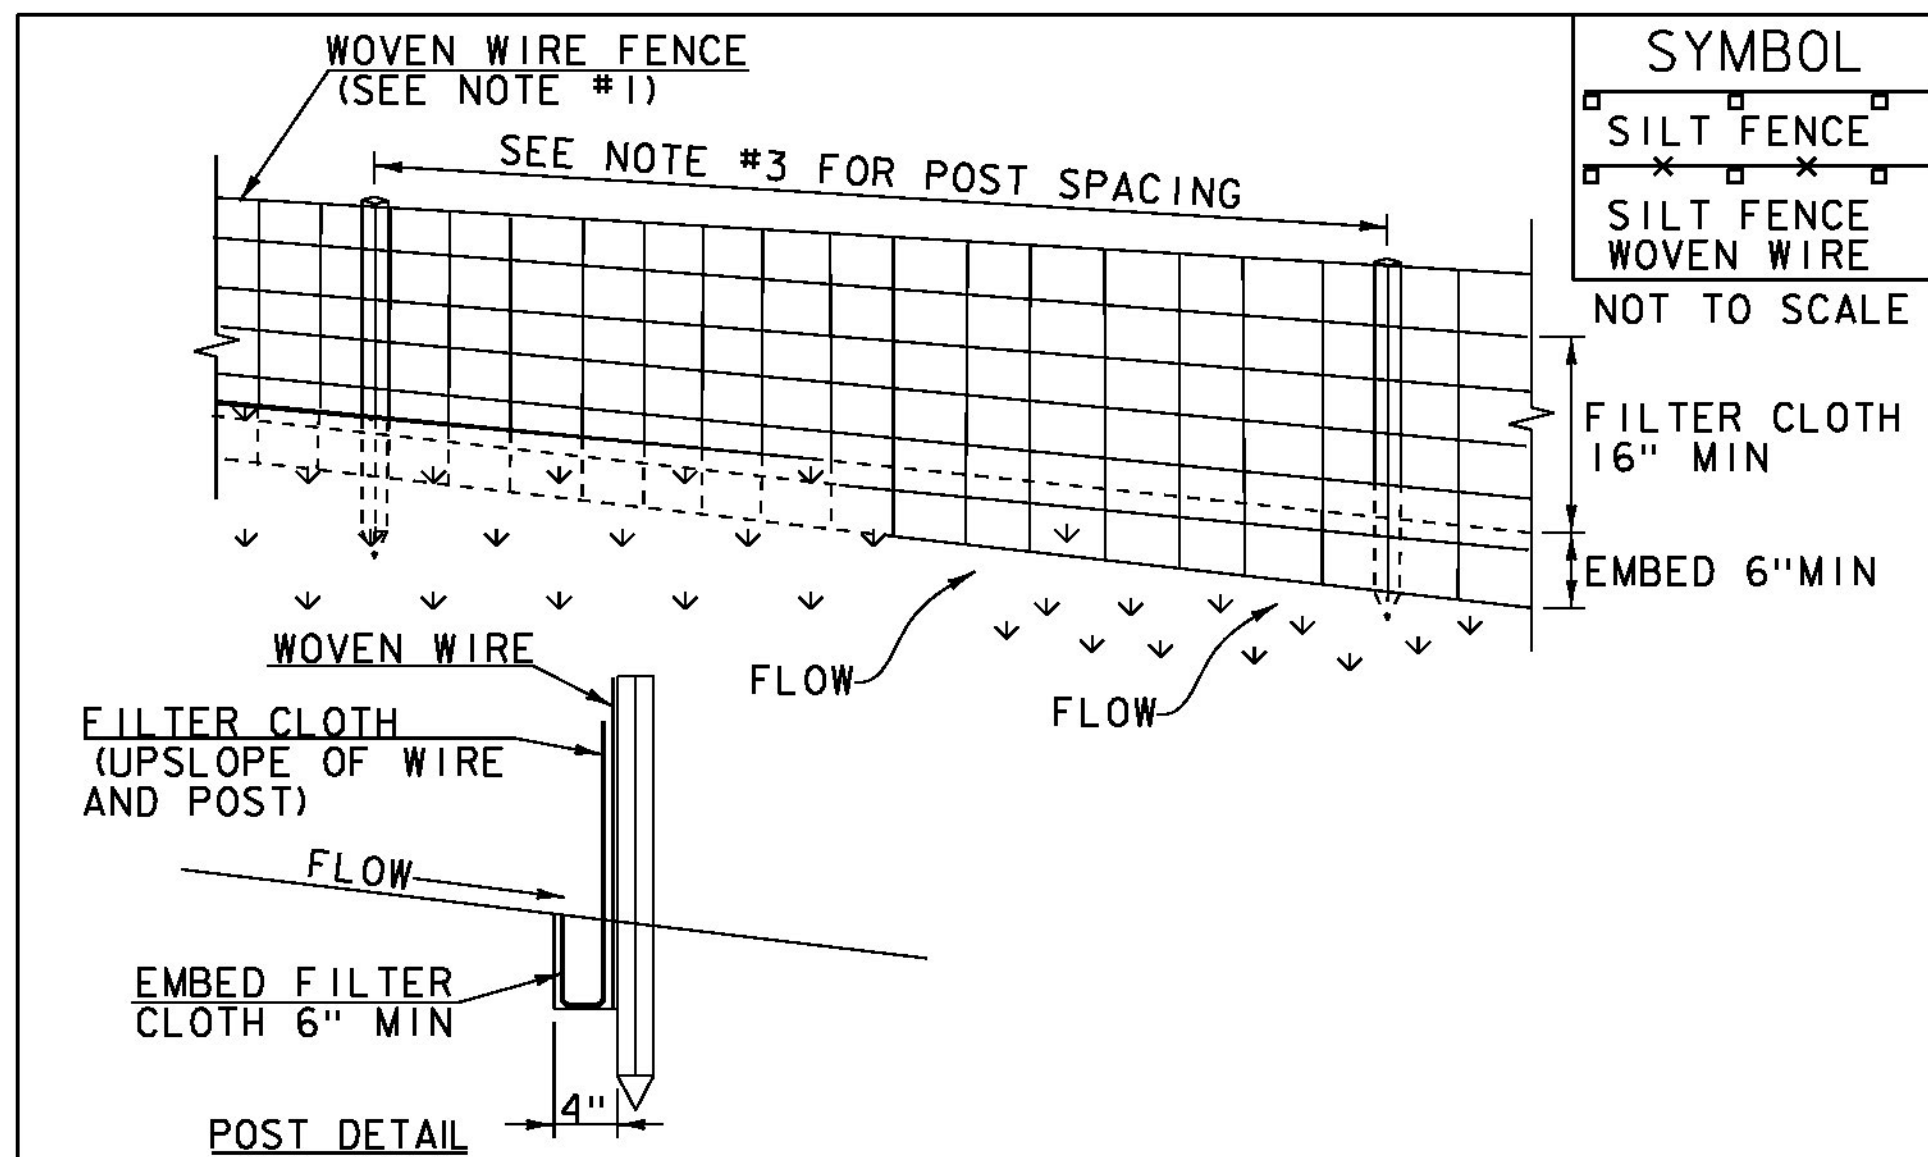

**CONSTRUCTION SPECIFICATIONS**

1. WOVEN WIRE REINFORCED FENCE IS REQUIRED WITHIN 100' UPSLOPE OF RECEIVING WATERS WHEN THE PROJECT FALLS UNDER A CONSTRUCTION STORMWATER PERMIT. WOVEN WIRE SHALL BE A MIN. 14 GAUGE WITH A 6" MAX. MESH OPENING.
2. FILTER CLOTH SHALL BE EITHER FILTER X, MIRAF1100X, STABILINKA T140N OR APPROVED EQUIVALENT.
3. POST SPACING FOR WIRE-BACKED FENCE SHALL BE 10' MAXIMUM. FOR FILTER-CLOTH FENCE, WHEN ELONGATION IS >50%, POST SPACING SHALL NOT EXCEED 4' AND WHEN ELONGATION IS <50%, POST SPACING SHALL NOT EXCEED 6'.
4. WOVEN WIRE FENCE IS TO BE FASTENED SECURELY TO FENCE POSTS WITH WIRE TIES. FILTER CLOTH IS TO BE FASTENED SECURELY TO WOVEN WIRE FENCE WITH TIES SPACED EVERY 24" AT TOP AND MID SECTION.
5. WHEN TWO SECTIONS OF FILTER CLOTH ADJOIN EACH OTHER THEY SHALL BE OVER-LAPPED BY 6" AND FOLDED.
6. MAINTENANCE SHALL BE PERFORMED AS NEEDED AND MATERIAL REMOVED WHEN SEDIMENT REACHES HALF OF FABRIC HEIGHT.


ADAPTED FROM DETAILS PROVIDED BY: NEW YORK STATE DEC  
ORIGINALLY DEVELOPED BY USDA-NRCS  
VERMONT DEPARTMENT OF ENVIRONMENTAL CONSERVATION

**SILT FENCE**

NOTES:  
REFER TO "THE VERMONT STANDARDS & SPECIFICATIONS FOR EROSION PREVENTION & SEDIMENT CONTROL -2006- " FROM THE VT AGENCY OF NATURAL RESOURCES FOR ADDITIONAL GUIDANCE.

THIS WORK SHALL BE PERFORMED IN ACCORDANCE WITH SECTION 649 AND AS SHOWN IN THE PLANS FOR GEOTEXTILE FOR SILT FENCE (PAY ITEM 649.54) OR GEOTEXTILE FOR SILT FENCE, WOVEN WIRE REINFORCED (PAY ITEM 649.515).

REVISIONS		
MARCH 21, 2008	WHF	
DECEMBER 11, 2008	WHF	
JANUARY 13, 2009	WHF	

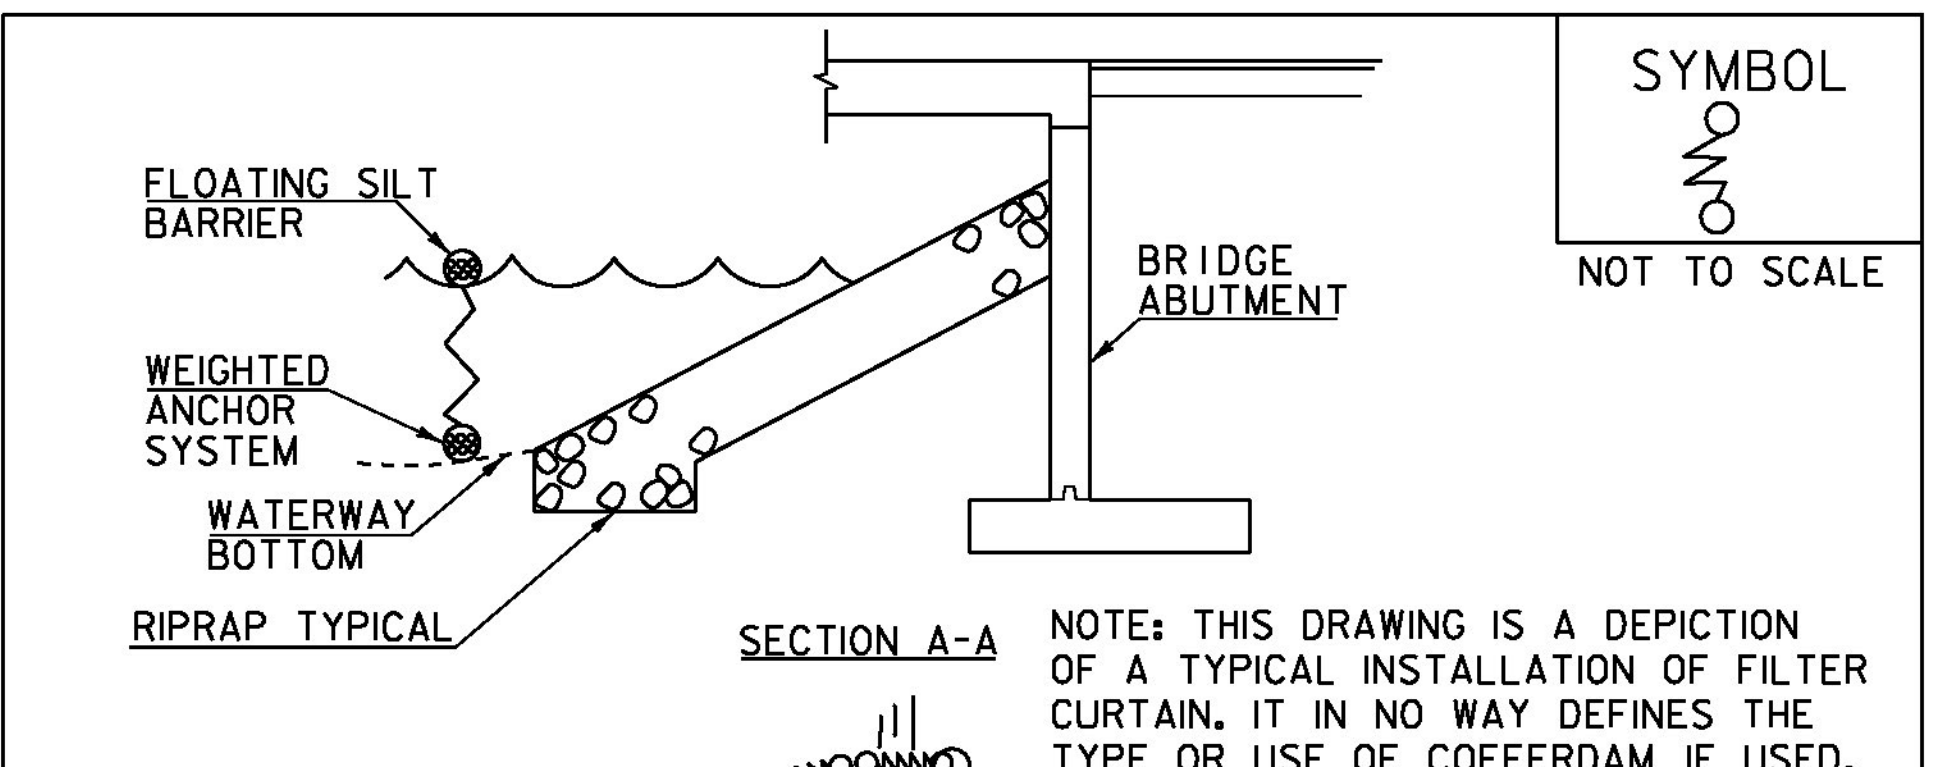

**CONSTRUCTION SPECIFICATIONS**


1. FILTER CURTAIN SHALL NOT BE PLACED ACROSS A FLOWING WATERWAY, OR IN A WATERWAY WITH STREAM VELOCITIES GREATER THAN 1.5 FEET/SECOND.
2. MAXIMUM 100' LENGTH BETWEEN ANCHORS.
3. LAST SECTION SHALL TERMINATE A MINIMUM OF 10' BEYOND LIMIT OF DISTURBANCE.
4. THE WEIGHTED ANCHOR SYSTEM SHALL BE A TYPE WHICH ALLOWS THE CURTAIN TO CONFORM TO THE BOTTOM OF THE WATERWAY.
5. THE CURTAIN SHALL BE REMOVED BY SLOWLY PULLING TOWARD THE SHORE MINIMIZING THE ESCAPE OF SEDIMENTS INTO WATERWAY.

ADAPTED FROM DETAILS PROVIDED BY: NEW YORK STATE DEC  
ORIGINALLY DEVELOPED BY USDA-NRCS  
VERMONT DEPARTMENT OF ENVIRONMENTAL CONSERVATION

**FILTER CURTAIN**

THIS WORK SHALL BE PERFORMED IN ACCORDANCE WITH SECTION 649 FOR GEOTEXTILE FOR FILTER CURTAIN (PAY ITEM 649.61).

REVISIONS		
APRIL 1, 2008	WHF	
JANUARY 13, 2009	WHF	
SEPTEMBER 4, 2009	WHF	

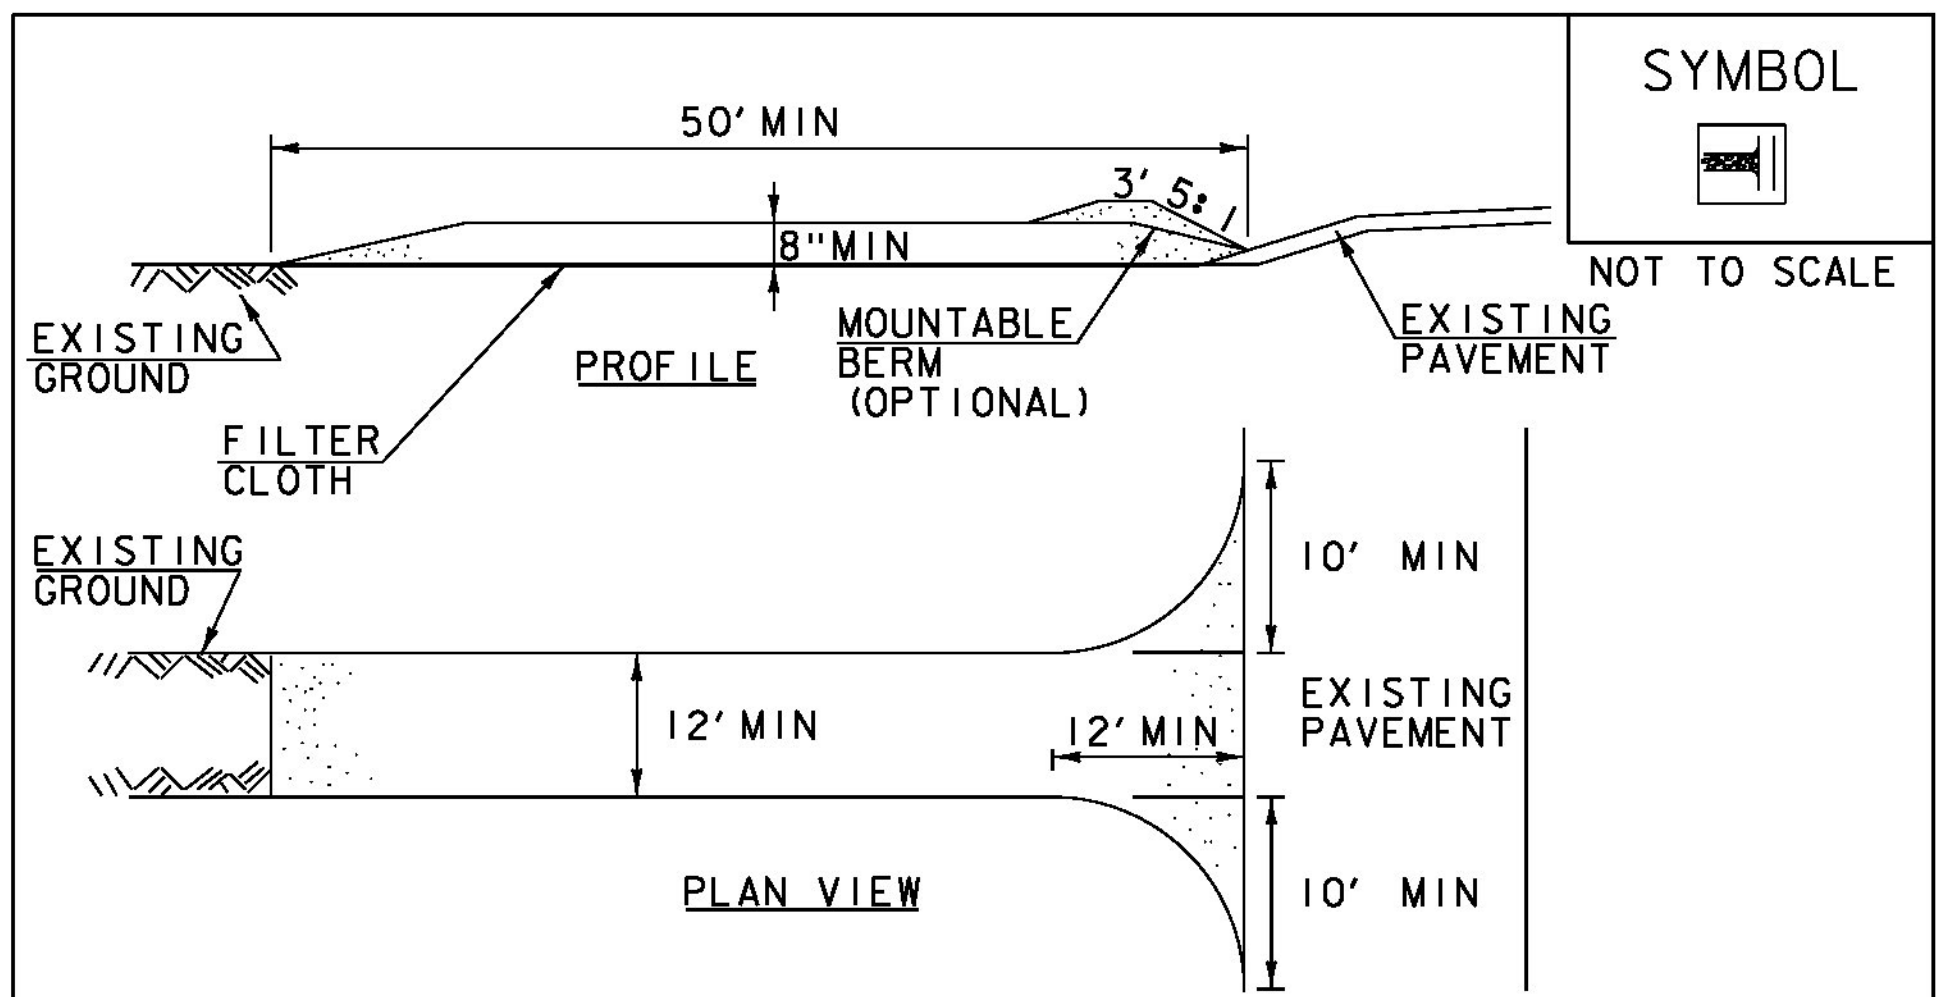

**CONSTRUCTION SPECIFICATIONS**

1. STONE SIZE- USE 1-4" STONE, RECLAIMED OR RECYCLED CONCRETE EQUIVALENT.
2. LENGTH- NOT LESS THAN 50' (EXCEPT ON A SINGLE RESIDENCE LOT WHERE A 30' MINIMUM LENGTH APPLIES).
3. THICKNESS- NOT LESS THAN 8".
4. WIDTH- 12' MINIMUM, BUT NOT LESS THAN THE FULL WIDTH AT POINTS WHERE INGRESS OR EGRESS OCCURS. 24' IF SINGLE ENTRANCE TO SITE.
5. GEOTEXTILE MUST BE PLACED OVER THE ENTIRE AREA PRIOR TO PLACING STONE.
6. SURFACE WATER- ALL SURFACE WATER FLOWING OR DIVERTED TOWARD CONSTRUCTION ENTRANCES SHALL BE PIPED BENEATH THE ENTRANCE. IF PIPING IS IMPRACTICAL, A MOUNTABLE BERM WITH 5:1 SLOPES WILL BE PERMITTED.
7. MAINTENANCE- THE ENTRANCE SHALL BE MAINTAINED IN A CONDITION WHICH WILL PREVENT TRACKING OR FLOWING OF SEDIMENT ONTO PUBLIC RIGHTS-OF-WAY, ALL SEDIMENT SPILLED, DROPPED, WASHED OR TRACKED ONTO PUBLIC RIGHTS-OF-WAY MUST BE REMOVED IMMEDIATELY.
8. WHEN WASHING IS REQUIRED, IT SHALL BE DONE ON AN AREA STABILIZED WITH STONE AND WHICH DRAINS INTO AN APPROVED SEDIMENT TRAPPING DEVICE.
9. PERIODIC INSPECTION AND NEEDED MAINTENANCE SHALL BE PROVIDED ACCORDING TO PERMIT REQUIREMENTS.

ADAPTED FROM DETAILS PROVIDED BY: NEW YORK STATE DEC  
ORIGINALLY DEVELOPED BY USDA-NRCS  
VERMONT DEPARTMENT OF ENVIRONMENTAL CONSERVATION


**STABILIZED CONSTRUCTION ENTRANCE**

NOTES:  
REFER TO "THE VERMONT STANDARDS & SPECIFICATIONS FOR EROSION PREVENTION & SEDIMENT CONTROL -2006- " FROM THE VT AGENCY OF NATURAL RESOURCES FOR ADDITIONAL GUIDANCE.

THIS WORK SHALL BE PERFORMED IN ACCORDANCE WITH SECTION 653 FOR VEHICLE TRACKING PAD (PAY ITEM 653.35) OR AS SPECIFIED IN THE CONTRACT.

REVISIONS		
MARCH 24, 2008	WHF	
JANUARY 13, 2009	WHF	

PROJECT NAME: RICHFORD	PLOT DATE: 11-DEC-2014
PROJECT NUMBER: BRF 0302(29)	DRAWN BY: R. PELLETT
FILE NAME: s12j158erodet.dgn	CHECKED BY: H. SALLS
PROJECT LEADER: C. CARLSON	SHEET 35 OF 36
DESIGNED BY: H. SALLS	
EPSC DETAILS 1	

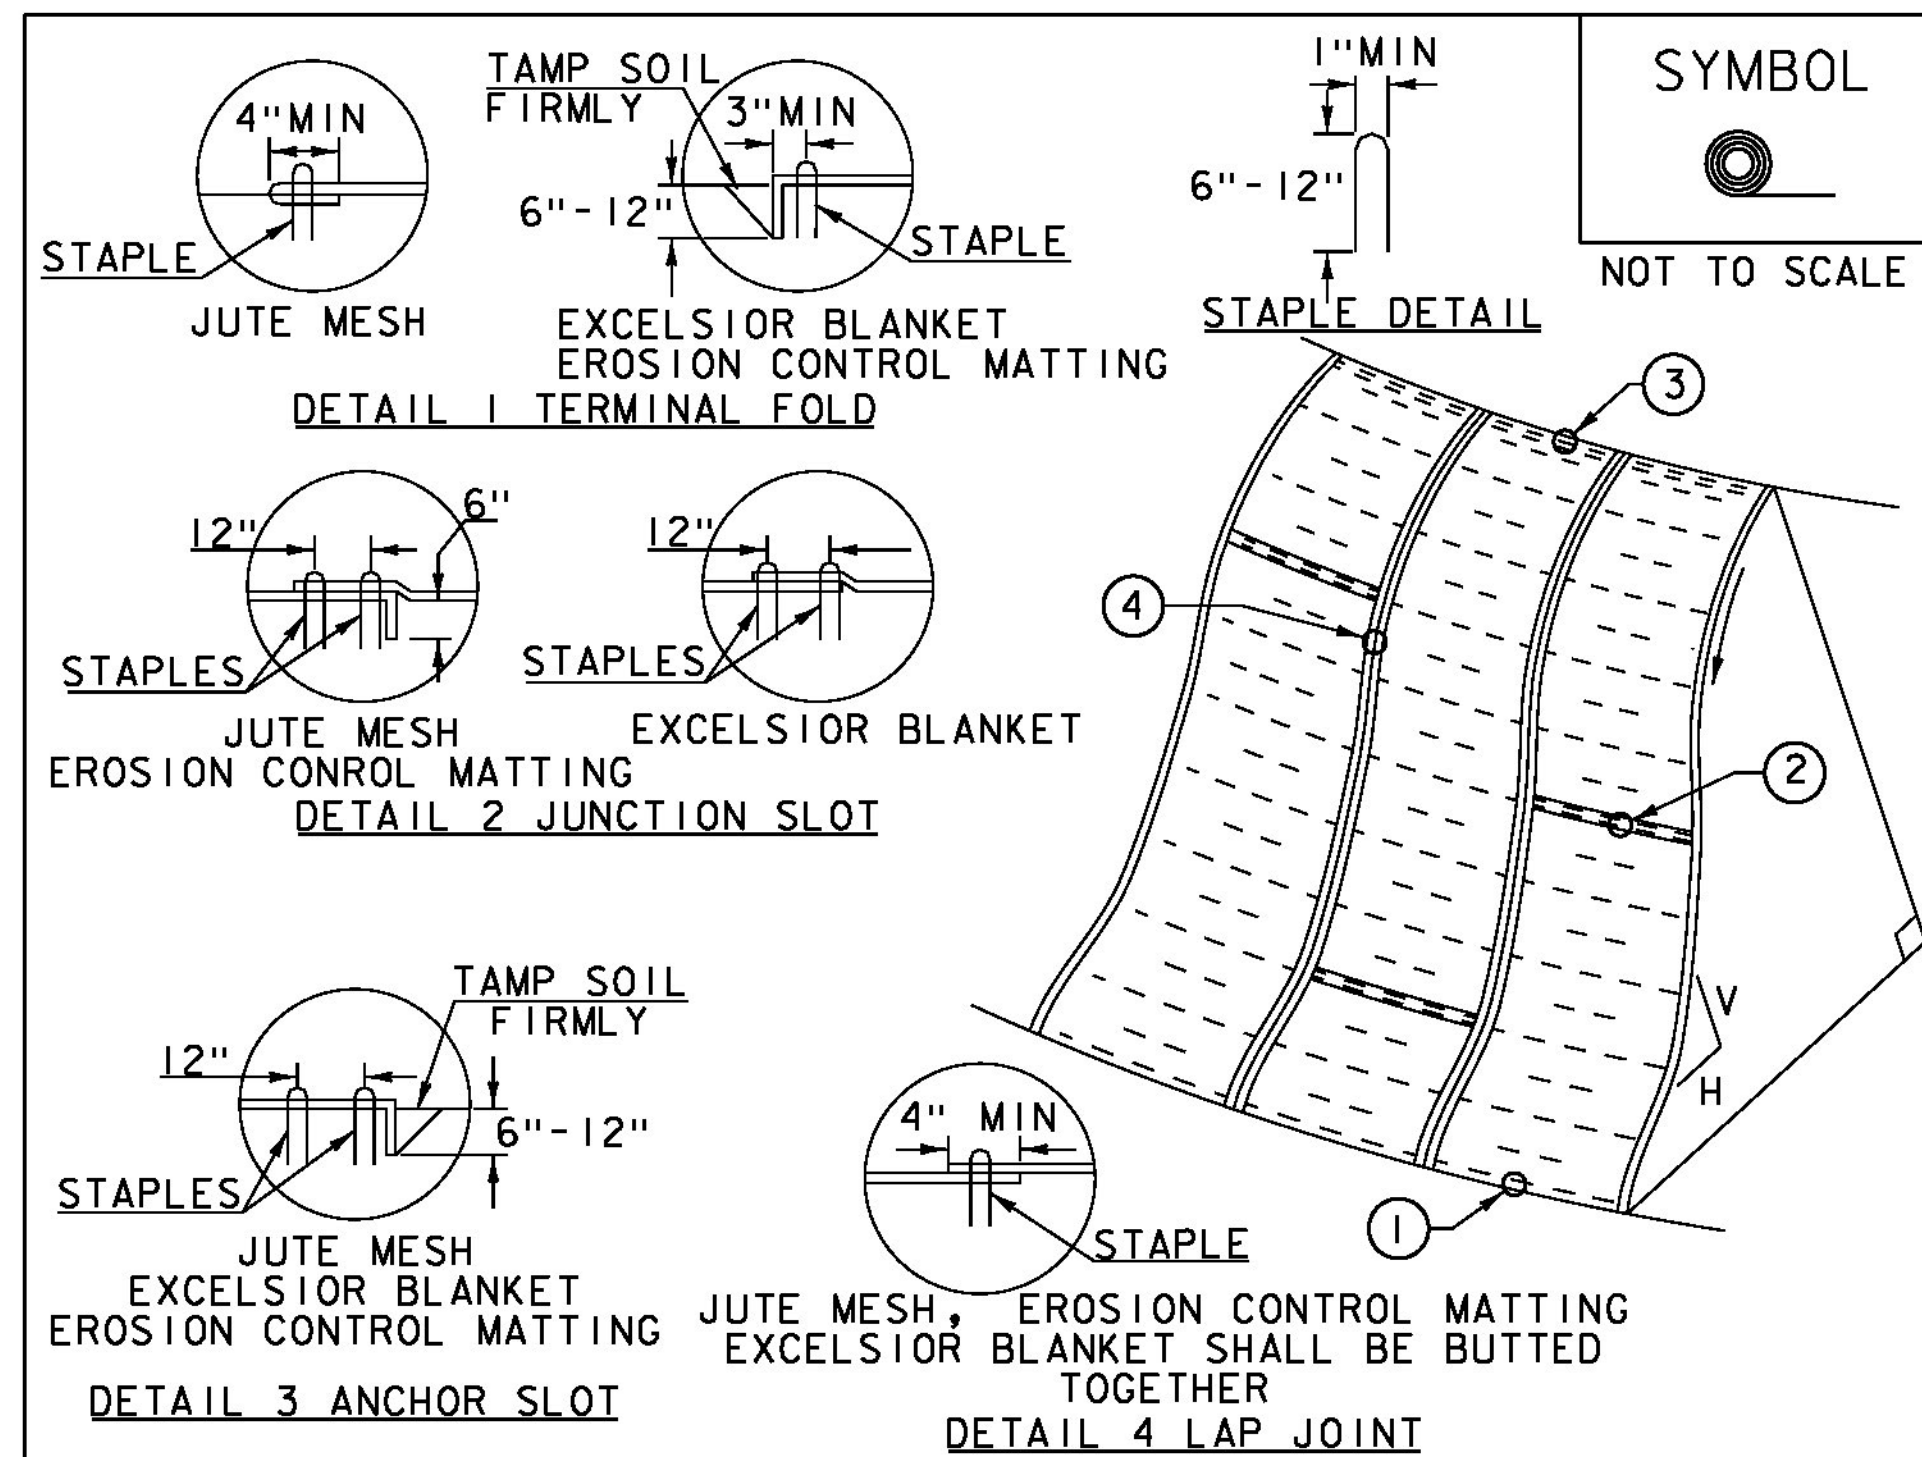

**CONSTRUCTION SPECIFICATIONS**


1. APPLY TO SLOPES GREATER THAN 3H: IV OR WHERE NECESSARY TO AID IN ESTABLISHING VEGETATION.
2. APPLY FERTILIZER, LIME SEED PRIOR TO PLACING MATTING.
3. STAPLES ARE TO BE PLACED ALTERNATELY, IN COLUMNS APPROXIMATELY 2' APART AND IN ROWS APPROXIMATELY 3' APART. APPROXIMATELY 175 STAPLES ARE REQUIRED PER 4' X 225' ROLL OF MATERIAL AND 125 STAPLES ARE REQUIRED PER 4' X 150' ROLL OF MATERIAL.
4. DISTURBED AREAS SHALL BE SMOOTHLY GRADED. EROSION CONTROL MATERIAL SHALL BE PLACED LOOSELY OVER GROUND SURFACE. DO NOT STRETCH.
5. ALL TERMINAL ENDS AND TRANSVERSE LAPS SHALL BE STAPLED AT APPROXIMATELY 12" INTERVALS.

ADAPTED FROM DETAILS PROVIDED BY: NEW YORK STATE DEC  
ORIGINALLY DEVELOPED BY USDA-NRCS  
VERMONT DEPARTMENT OF ENVIRONMENTAL CONSERVATION


**ROLLED EROSION CONTROL PRODUCT (RECP) SIDE SLOPE**

NOTES:  
REFER TO "THE VERMONT STANDARDS & SPECIFICATIONS FOR EROSION PREVENTION & SEDIMENT CONTROL -2006-" FROM THE VT AGENCY OF NATURAL RESOURCES FOR ADDITIONAL GUIDANCE.  
THIS WORK SHALL BE PERFORMED IN ACCORDANCE WITH SECTION 653 AND AS SHOWN IN THE PLANS FOR TEMPORARY EROSION MATTING (PAY ITEM 653.20) OR PERMANENT EROSION MATTING (PAY ITEM 653.21).

REVISIONS	
APRIL 16, 2007	JMF
JANUARY 13, 2009	WHF

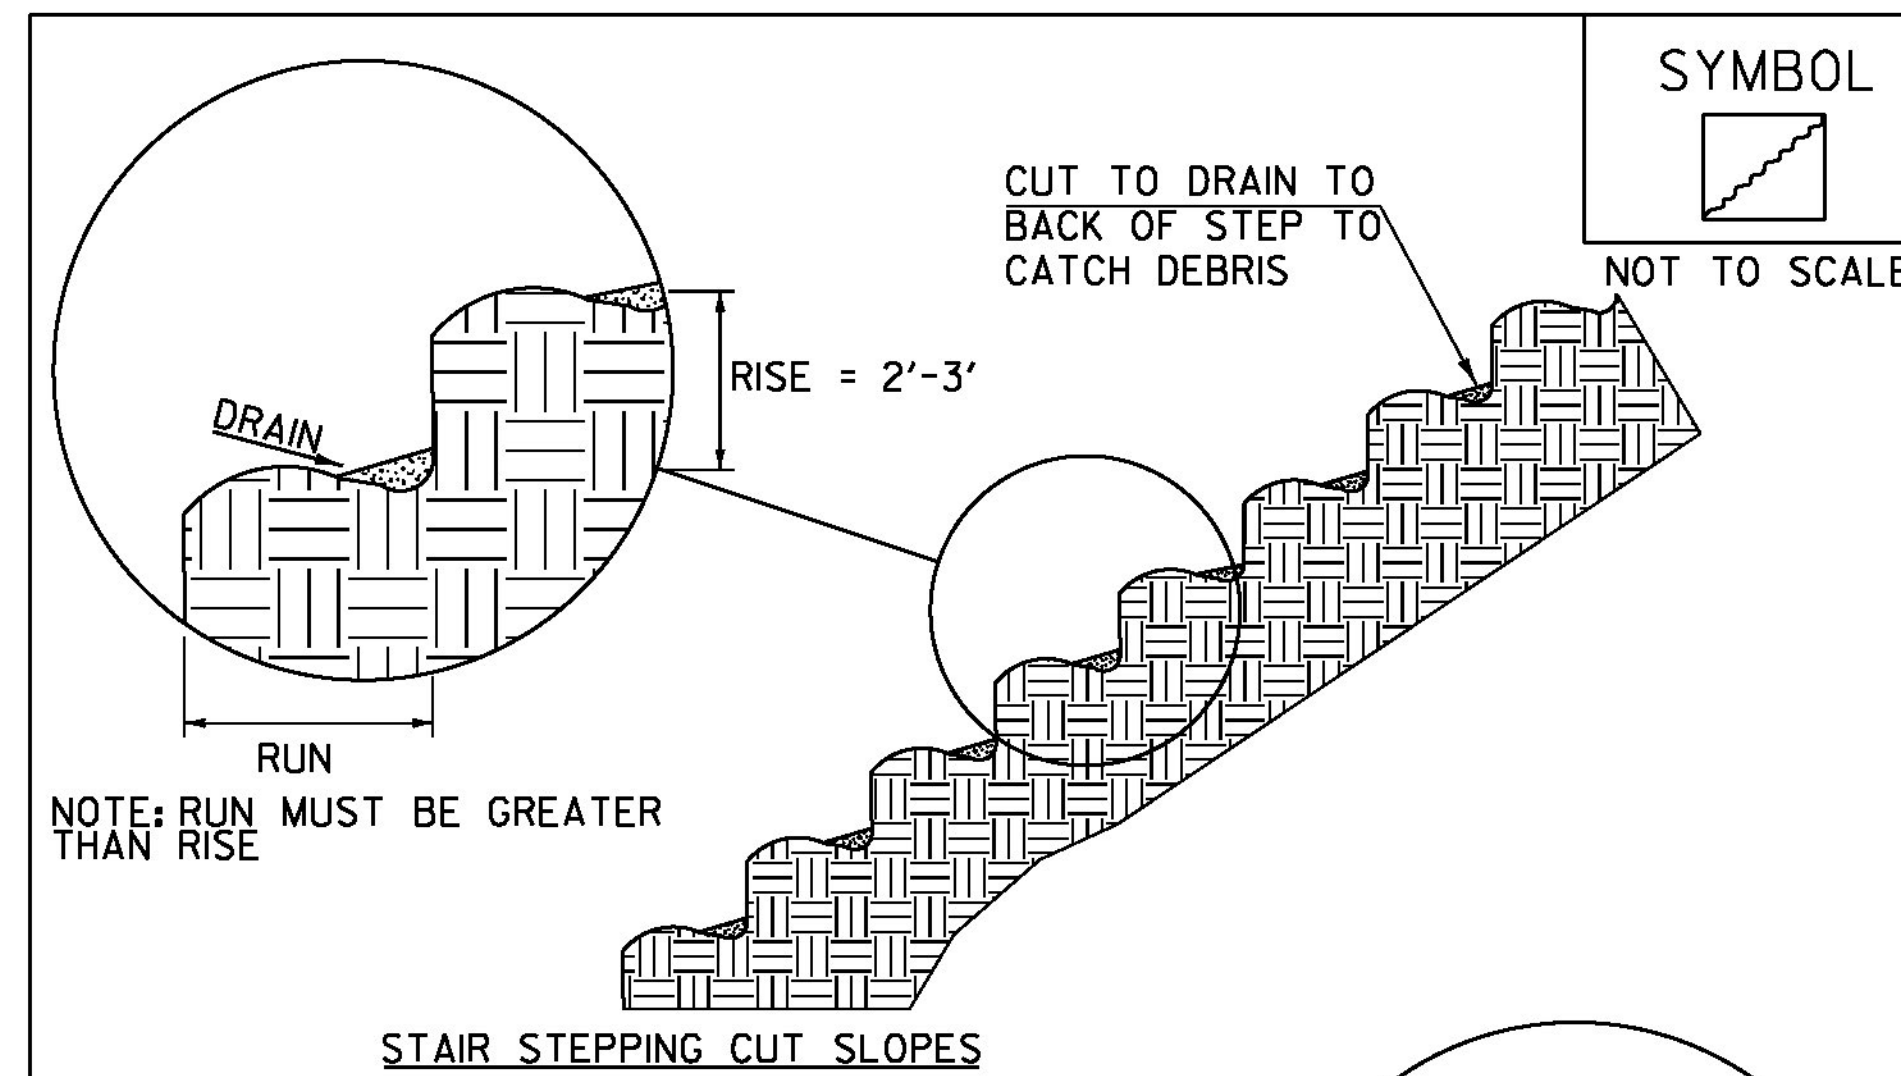

**STAIR STEPPING CUT SLOPES**

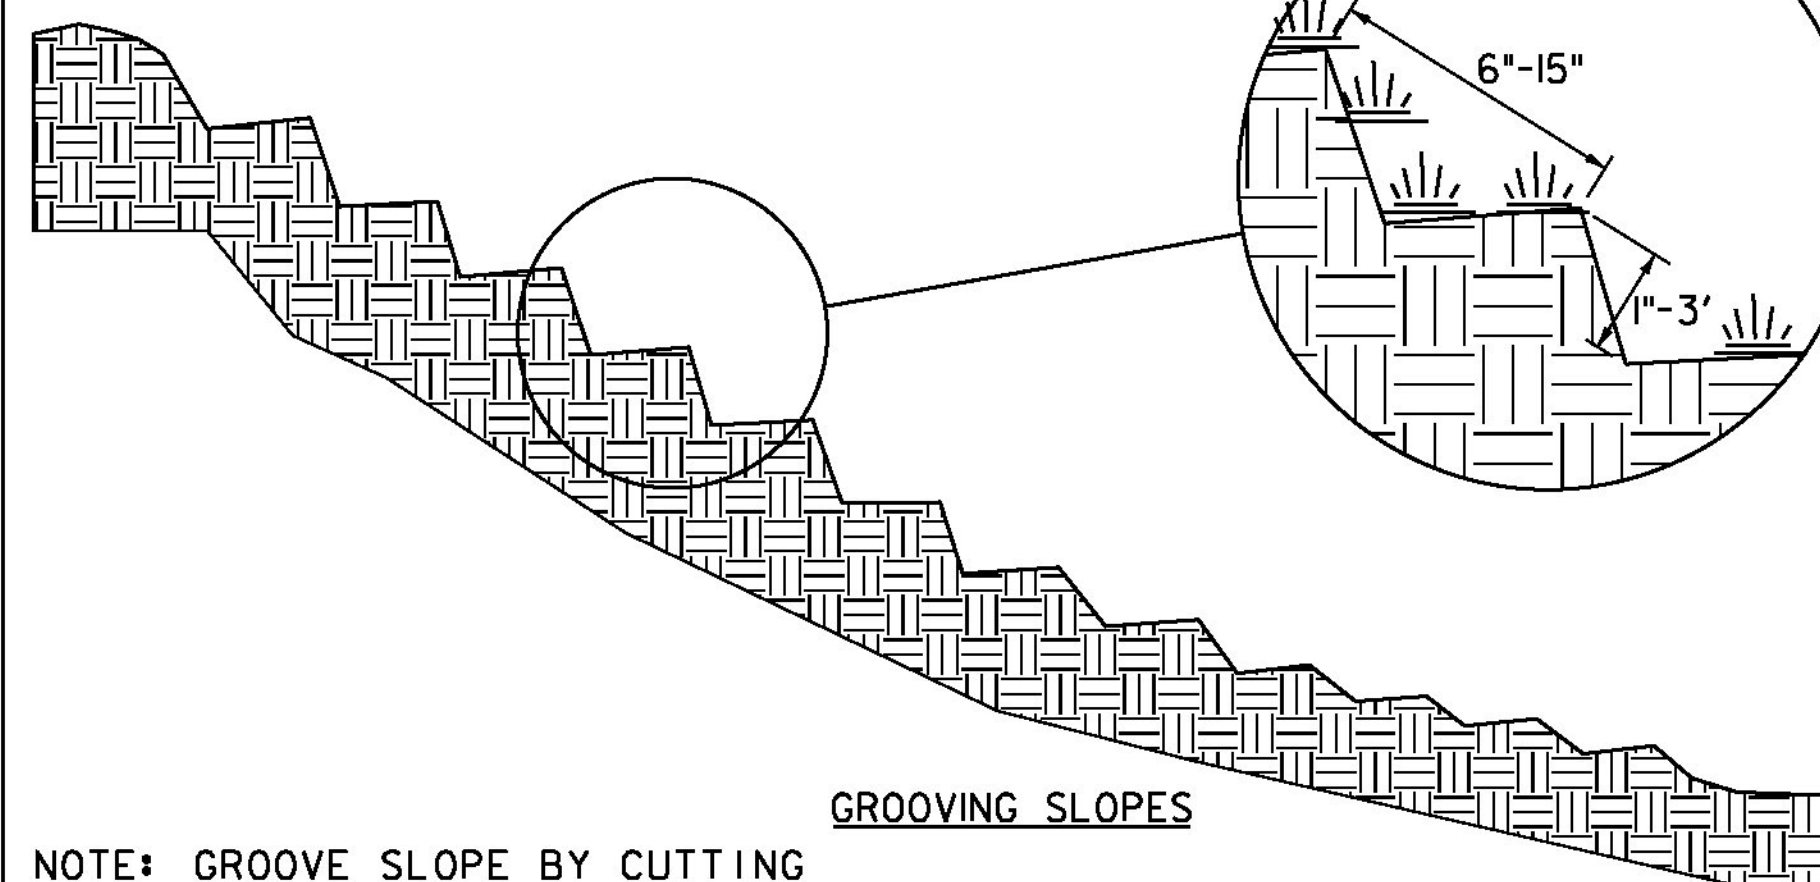

**GROOVING SLOPES**

NOTE: GROOVE SLOPE BY CUTTING FURROWS ALONG THE CONTOUR. IRREGULARITIES IN THE SOIL SURFACE CATCH RAINWATER AND RETAIN LIME, FERTILIZER AND SEED.

ADAPTED FROM DETAILS PROVIDED BY: NEW YORK STATE DEC  
ORIGINALLY DEVELOPED BY USDA-NRCS  
VERMONT DEPARTMENT OF ENVIRONMENTAL CONSERVATION

**SURFACE ROUGHENING**

NOTES:  
REFER TO "THE VERMONT STANDARDS & SPECIFICATIONS FOR EROSION PREVENTION & SEDIMENT CONTROL -2006-" FROM THE VT AGENCY OF NATURAL RESOURCES FOR ADDITIONAL GUIDANCE.

THIS WORK SHALL BE CONSIDERED INCIDENTAL TO THE CONTRACT

REVISIONS	
APRIL 1, 2008	WHF
JANUARY 13, 2009	WHF

VAOT RURAL AREA MIX					
% WEIGHT	LBS/AC		NAME	GERM %	PURITY %
	BROADCAST	HYDROSEED			
37.5%	22.5	45	CREeping RED FESCUE	85%	98%
37.5%	22.5	45	TALL FESCUE	90%	95%
5.0%	3	6	RED TOP	90%	95%
15.0%	9	18	BIRDSFOOT TREFOIL	85%	98%
5.0%	3	6	ANNUAL RYE GRASS	85%	95%
100%	60	120			

VAOT URBAN AREA MIX					
% WEIGHT	LBS/AC		NAME	GERM %	PURITY %
	BROADCAST	HYDROSEED			
42.5%	34	68	CREeping RED FESCUE	85%	98%
10.0%	8	16	PERENNIAL RYE GRASS	90%	95%
42.5%	34	68	KENTUCKY BLUE GRASS	85%	85%
5.0%	4	8	ANNUAL RYE GRASS	85%	95%
100%	80	160			

SOIL AMENDMENT GUIDANCE			
FERTILIZER		LIME	
BROADCAST	HYDROSEED	BROADCAST	HYDROSEED
10-20-10	FOLLOW	PELLETIZED	FOLLOW
500 LBS/AC	MANUFACTURER	2 TONS/AC	MANUFACTURER

**CONSTRUCTION GUIDANCE**

1. RURAL SEED MIX: USE AS INDICATED IN THE PLANS AND/OR FOR ALL ESTABLISHED UPLAND (NON WETLAND) AREAS DISTURBED BY THE CONTRACTOR.
2. URBAN SEED MIX: USE AS INDICATED IN THE PLANS AND/OR FOR ALL ESTABLISHED LAWN AREAS DISTURBED BY THE CONTRACTOR.
3. ALL SEED MIXTURES: SHALL NOT HAVE A WEED CONTENT EXCEEDING 0.40% BY WEIGHT AND SHALL BE FREE OF ALL NOXIOUS SEED.
4. FERTILIZER AND LIMESTONE: SHALL FOLLOW RATES SHOWN ON PLAN OR AS DIRECTED BY THE ENGINEER
5. HAY MULCH: TO BE PLACED ON EARTH SLOPES AT THE RATE OF 2 TONS/ACRE, ACHIEVE 90% GROUND COVER OR AS DIRECTED BY THE ENGINEER.
6. TOPSOIL: TO BE USED WITH SEED AS INDICATED ON THE PLANS, OR AS DIRECTED BY THE ENGINEER.
7. HYDROSEEDING: ALTHOUGH GUIDANCE IS GIVEN ABOVE THE SITE CONDITIONS AND THE TYPE OF HYDROSEED WILL ULTIMATELY DICTATE THE AMOUNTS AND TYPES OF SOIL AMENDMENTS TO BE APPLIED
8. TURF ESTABLISHMENT: PLACING SEED, FERTILIZER, LIME AND MULCH PRIOR TO SEPTEMBER 15 AND AFTER APRIL 15 CAN BETTER ENSURE A VIGOROUS GROWTH OF GRASS.

ADAPTED FROM VTRANS TECHNICAL LANDSCAPE MANUAL FOR ROADWAYS AND TRANSPORTATION FACILITIES

**TURF ESTABLISHMENT**

THIS WORK SHALL BE PERFORMED IN ACCORDANCE WITH SECTION 651 FOR SEED (PAY ITEM 651.15)


REVISIONS	
JUNE 23, 2009	WHF
JANUARY 15, 2010	WHF
FEBRUARY 16, 2011	WHF

PROJECT NAME: RICHFORD  
PROJECT NUMBER: BRF 0302(29)

FILE NAME: s12j158erodet.dgn PLOT DATE: 11-DEC-2014  
PROJECT LEADER: C. CARLSON DRAWN BY: R. PELLETT  
DESIGNED BY: H. SALLS CHECKED BY: H. SALLS  
EPSC DETAILS 2 SHEET 36 OF 36


**CONCRETE GENERAL NOTES**

1. ALL EXPOSED EDGES OF CONCRETE SHALL BE CHAMFERED 1" x 1"
2. REINFORCING STEEL SIZE AND SPACING SHOWN IN THE PLANS IS BASED ON 60 KSI STEEL, UNLESS NOTED OTHERWISE. WITH THE ENGINEER'S PERMISSION, BAR SIZE AND SPACING MAY BE MODIFIED ACCORDING TO THE LATEST AASHTO LRFD BRIDGE DESIGN SPECIFICATION AND STRUCTURES DESIGN MANUAL WHEN USING HIGHER STRENGTH STEEL.

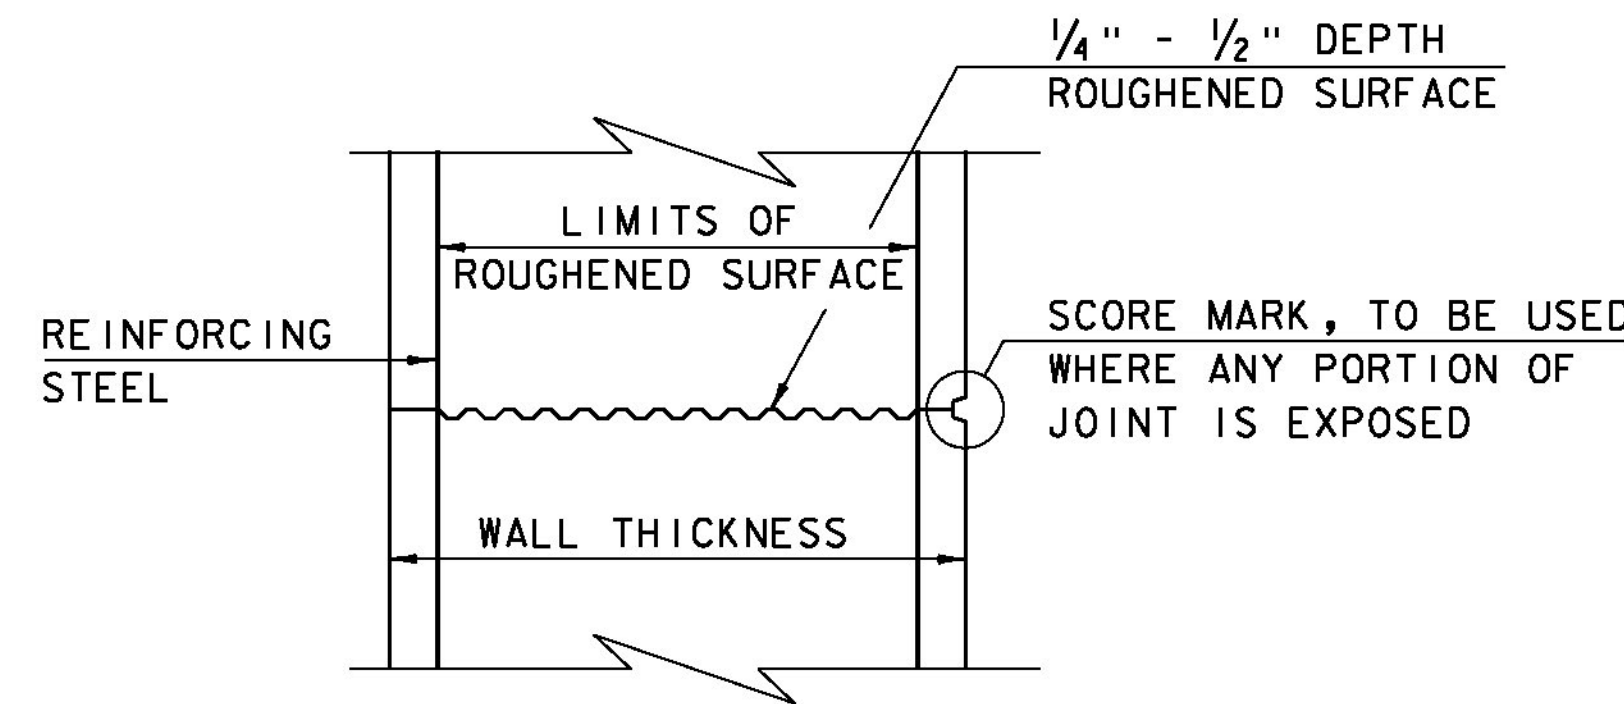


**TYPICAL HORIZONTAL CONSTRUCTION JOINT**  
(NOT TO SCALE)


1. THE SURFACE OF THE CONCRETE CONSTRUCTION JOINTS SHALL BE CLEANED AND FREE OF LAITANCE.
2. IMMEDIATELY BEFORE NEW CONCRETE IS PLACED, ALL CONSTRUCTION JOINTS SHALL BE WETTED AND STANDING WATER REMOVED.

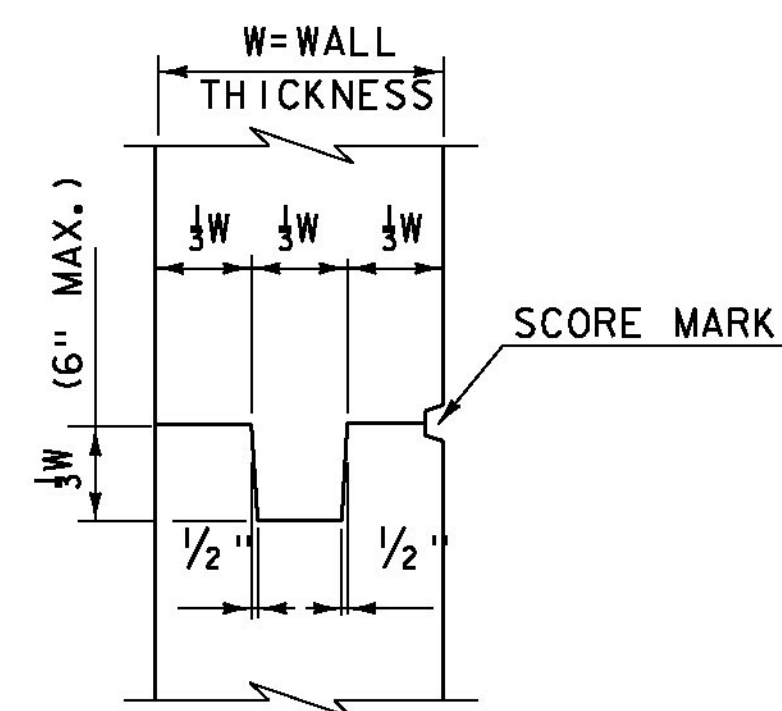


**TYPICAL CONCRETE CONSTRUCTION JOINT**  
(NOT TO SCALE)

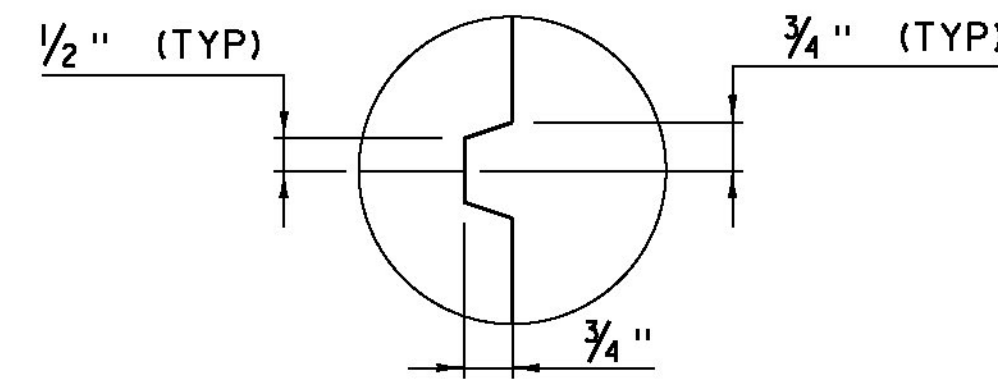


**SCORE MARK DETAIL**  
(NOT TO SCALE)

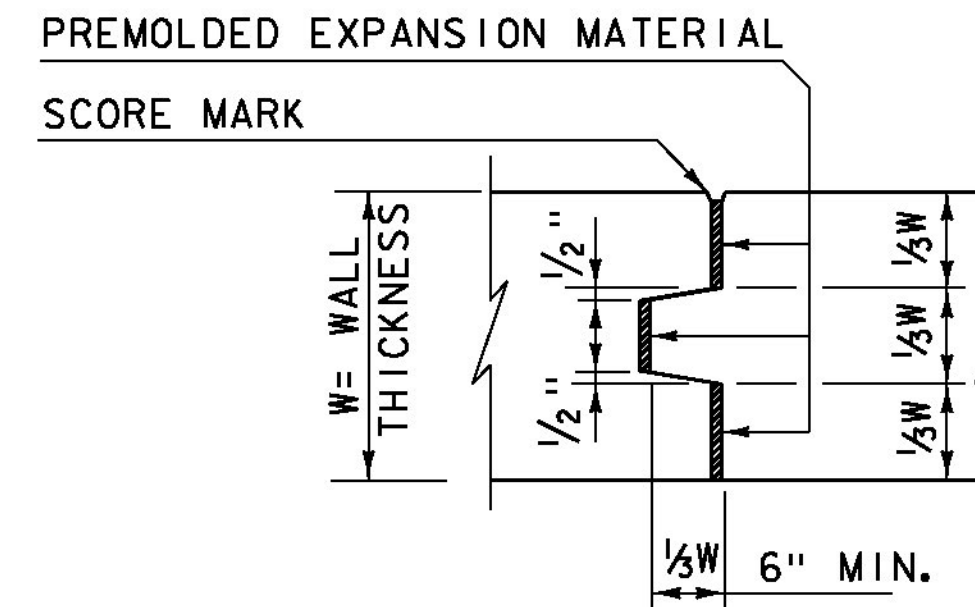

**TYPICAL CONCRETE EXPANSION JOINT**  
(NOT TO SCALE)

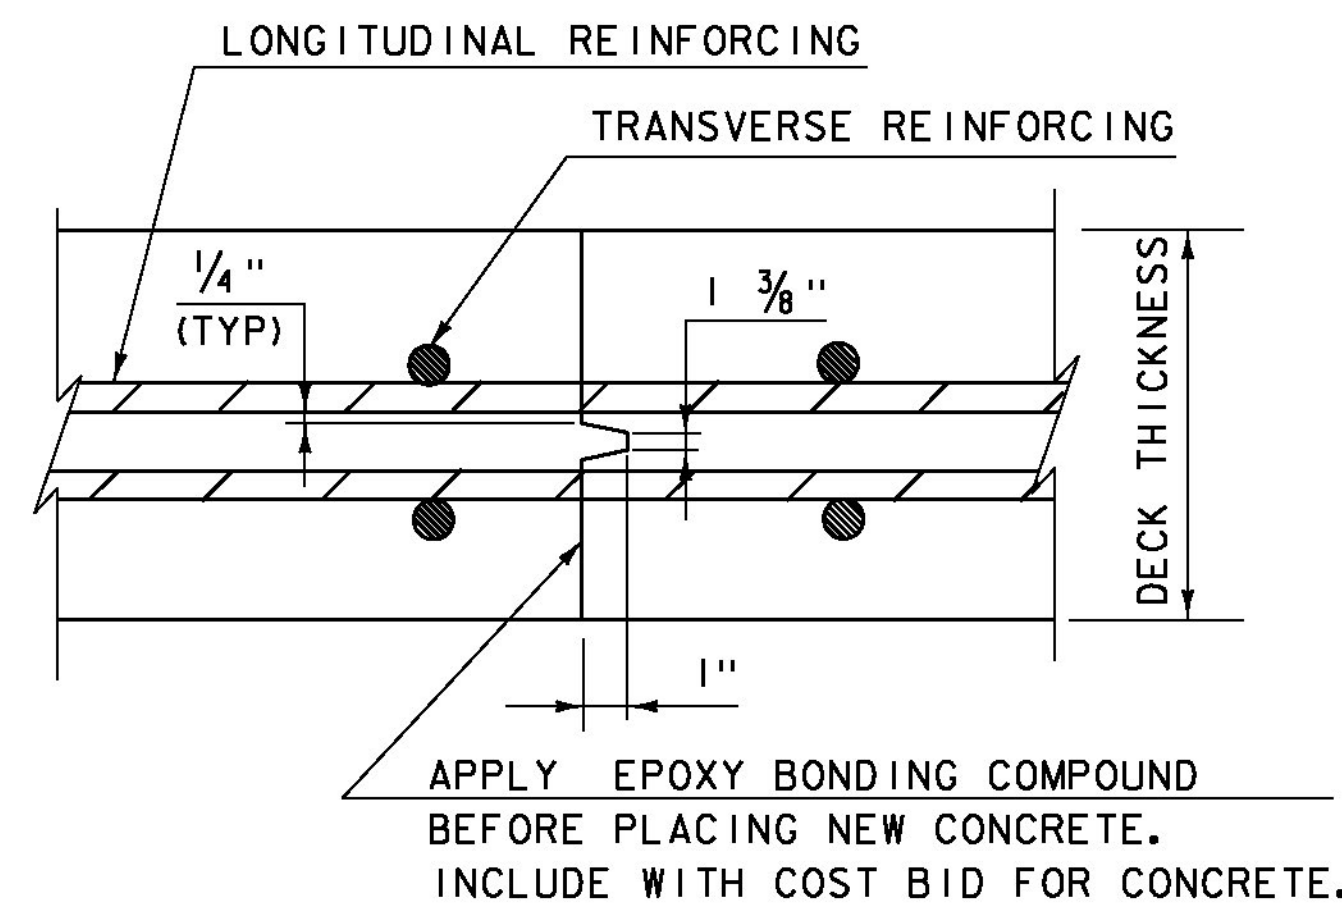


**TRANSVERSE BRIDGE SLAB CONSTRUCTION JOINT DETAILS**  
(NOT TO SCALE)

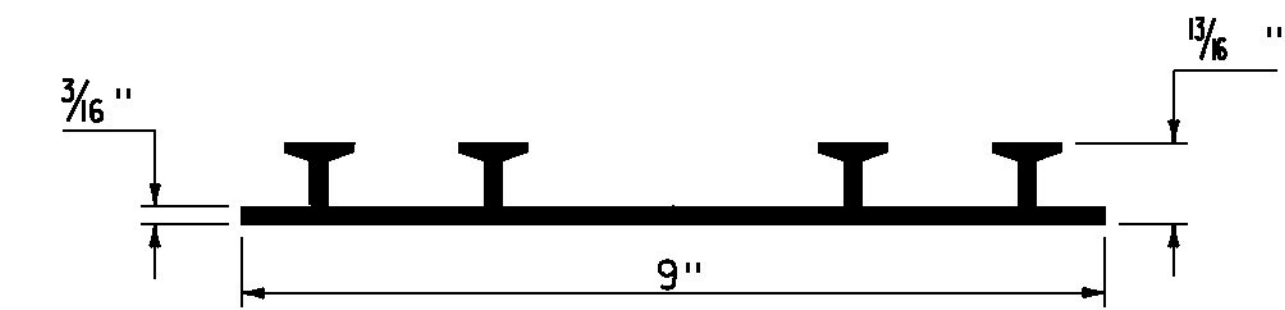

**P.V.C. WATERSTOP FOR CONSTRUCTION JOINTS**  
(NOT TO SCALE)

PAYMENT FOR THE P.V.C. WATERSTOP SHALL BE INCIDENTAL TO THE UNIT BID PRICE FOR THE ADJACENT CONCRETE.


OTHER CONFIGURATIONS OF WATERSTOP MAY BE USED UPON APPROVAL OF THE ENGINEER.

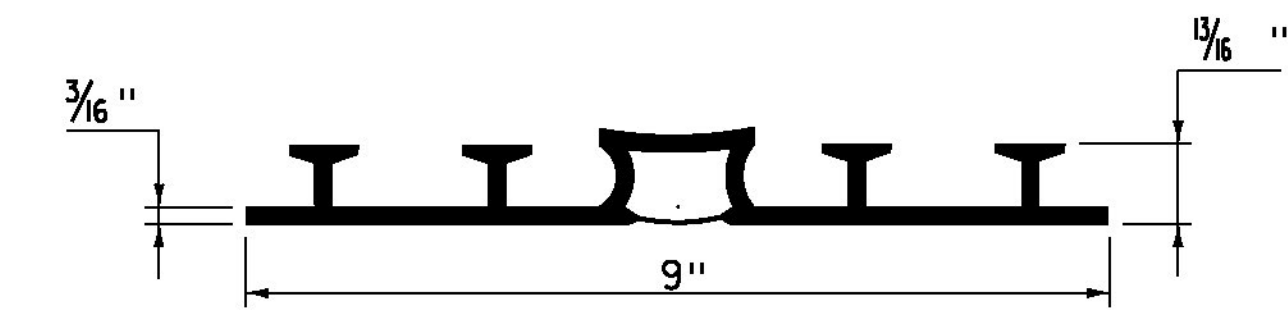

**P.V.C. WATERSTOP FOR EXPANSION JOINTS**  
(NOT TO SCALE)

PAYMENT FOR THE P.V.C. WATERSTOP SHALL BE INCIDENTAL TO THE UNIT BID PRICE FOR THE ADJACENT CONCRETE.

OTHER CONFIGURATIONS OF WATERSTOP MAY BE USED UPON APPROVAL OF THE ENGINEER.

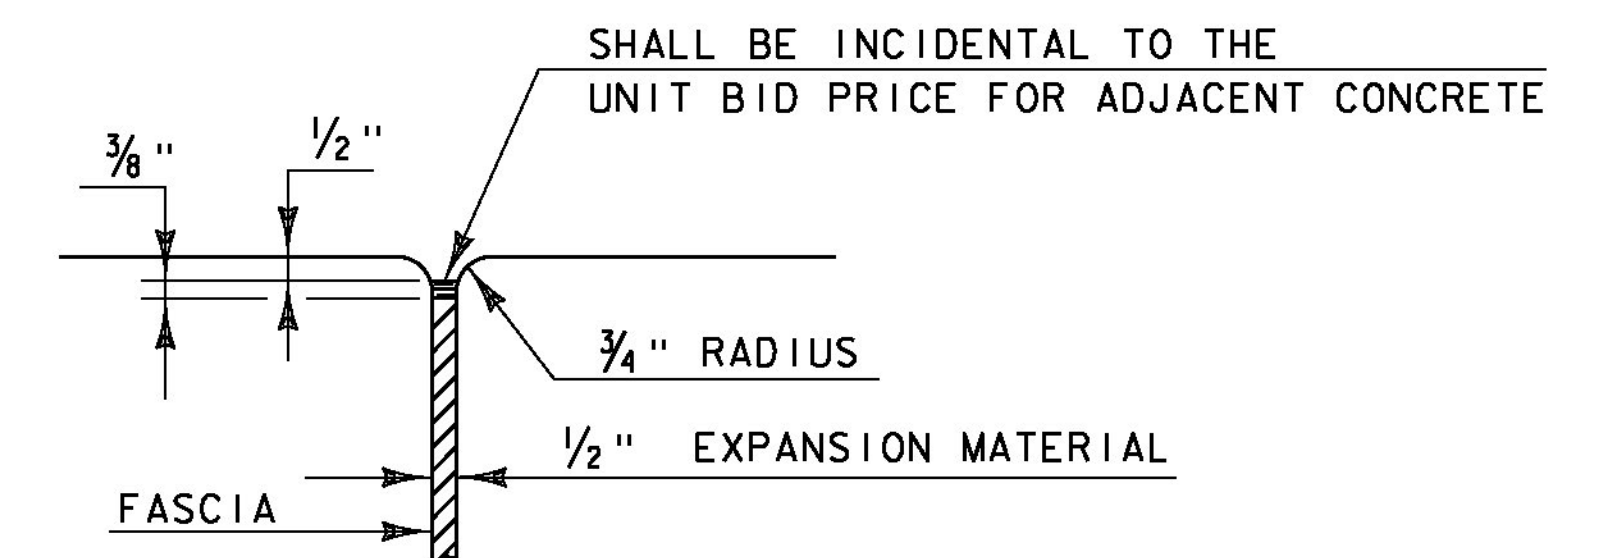


**JOINT BETWEEN FASCIA AND WINGWALL**  
(NOT TO SCALE)


**REVISIONS**

MAY 7, 2010	APPROVED FOR USE BY VAOT STRUCTURES SECTION
FEBRUARY 9, 2012	REBAR SUBSTITUTION ALLOWANCE ADDED TO CONCRETE GENERAL NOTES.


**CONCRETE  
DETAILS AND NOTES**

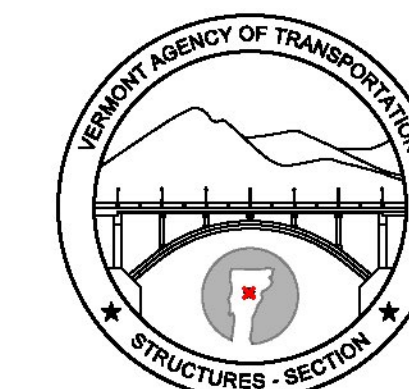

**STRUCTURES  
DETAIL  
SD-501.00**

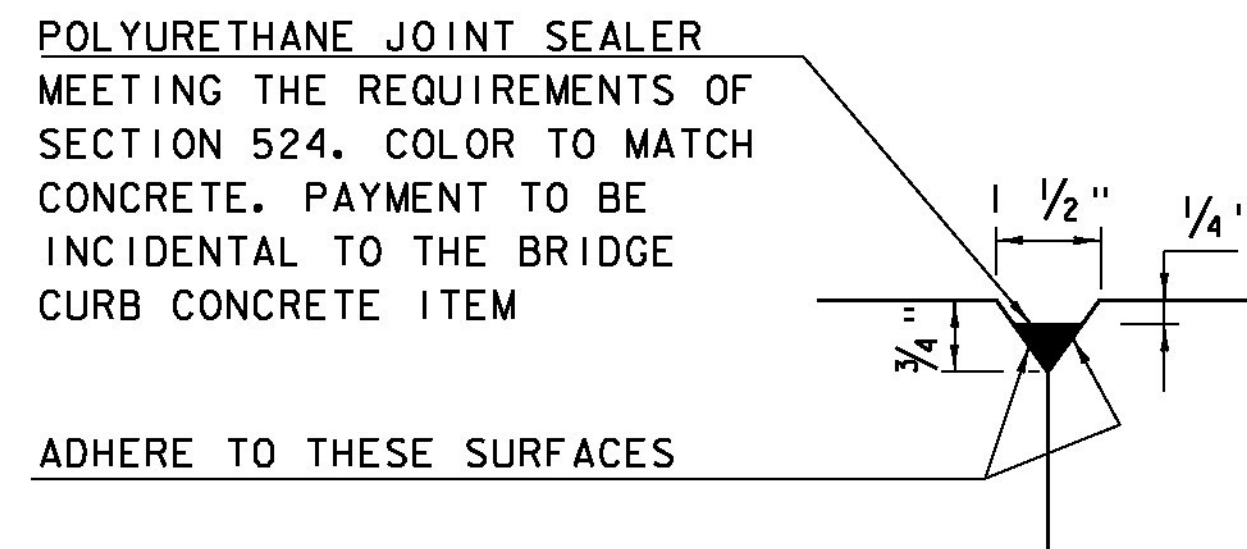


DETAIL "B"  
(NOT TO SCALE)

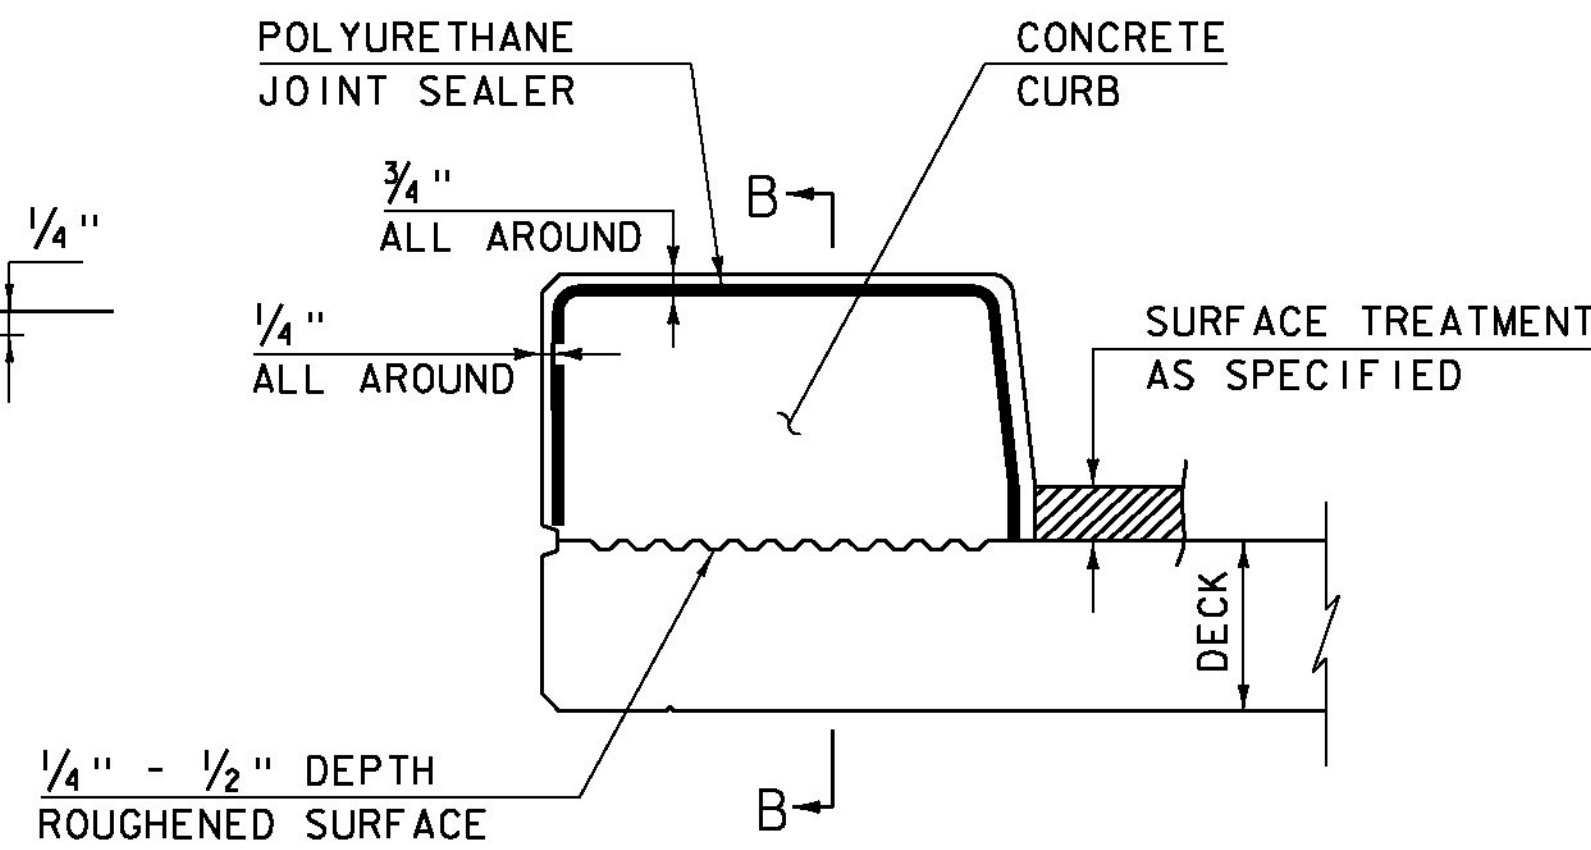


CONCRETE CURB JOINT SECTION  
(NOT TO SCALE)

- SEE TYPICAL HORIZONTAL CONSTRUCTION JOINT DETAIL FOR ADDITIONAL INFORMATION

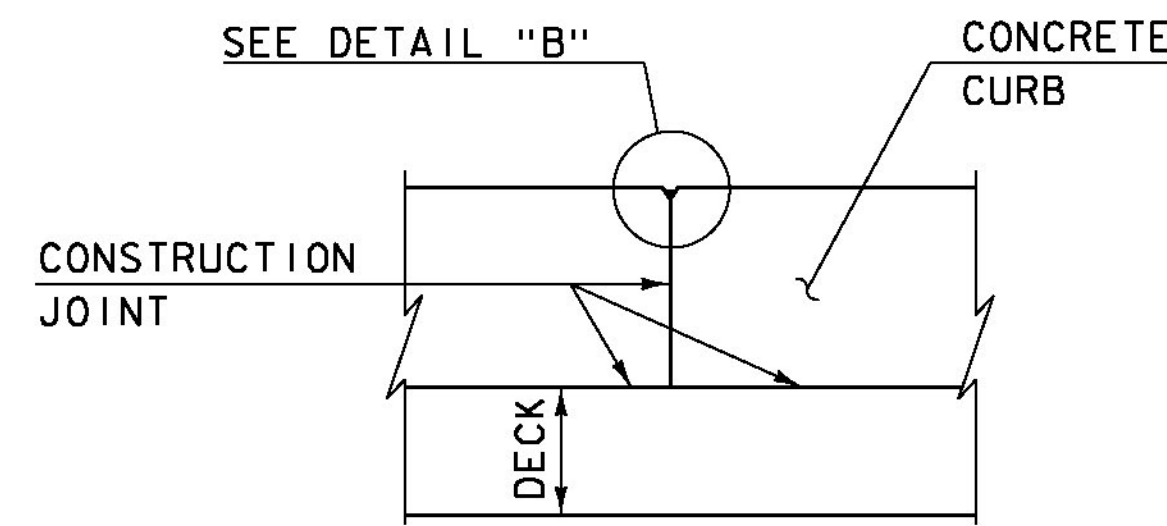


SECTION B - B  
(NOT TO SCALE)

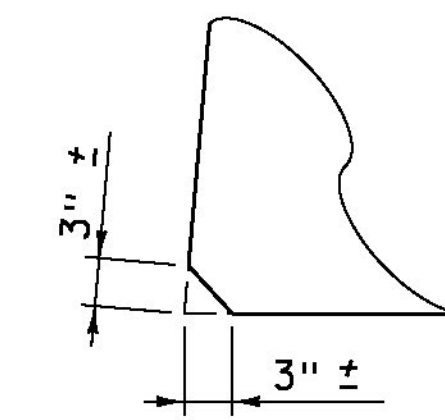


ACUTE ANGLE  
CLIP DETAIL  
(NOT TO SCALE)

### CONCRETE CURB JOINT NOTES



- CONCRETE CURBS MAY BE PLACED IN ONE CONTINUOUS OPERATION IF AN APPROVED SHRINKAGE REDUCING ADMIXTURE LISTED IN THE SPECIAL PROVISIONS IS USED WITH THE CONCRETE MIX DESIGN. PAYMENT FOR THE SHRINKAGE REDUCING ADMIXTURE WILL BE INCIDENTAL TO THE BRIDGE CURB CONCRETE ITEM.
- IF THE CONTRACTOR CHOOSES NOT TO USE AN APPROVED SHRINKAGE REDUCING ADMIXTURE, THE CURBS SHALL BE CONSTRUCTED WITH CONSTRUCTION JOINTS SPACED AT A MAXIMUM OF 15'-0" CENTER TO CENTER AND 2'-0" MINIMUM FROM THE CENTER OF NEAREST BRIDGE RAILING POST.
- ON MULTI-SPAN CONTINUOUS SUPERSTRUCTURES, REGARDLESS OF WHETHER APPROVED SHRINKAGE REDUCING ADMIXTURE IS USED, CURB JOINTS SHALL BE LOCATED OVER THE CENTERLINE OF PIERS AND 7'-0" EACH SIDE OF THE CENTERLINE OF EACH PIER.
- WHEN CURB JOINTS ARE USED THE CURBS SHALL BE PLACED IN ALTERNATE SECTIONS WITH A MINIMUM OF 48 HOUR DELAY BETWEEN ADJACENT PLACEMENTS.
- LONGITUDINAL REINFORCING SHALL BE CONTINUOUS THROUGH CURB CONSTRUCTION JOINTS. CURB STIRRUP BARS SHALL BE TURNED AS NECESSARY TO MAINTAIN COVER IN THE FLARED CURB ENDS.
- THE JOINT SPACING AND DETAILS SHOWN SHALL APPLY TO SIDEWALKS WHEN SHOWN IN THE PLANS.

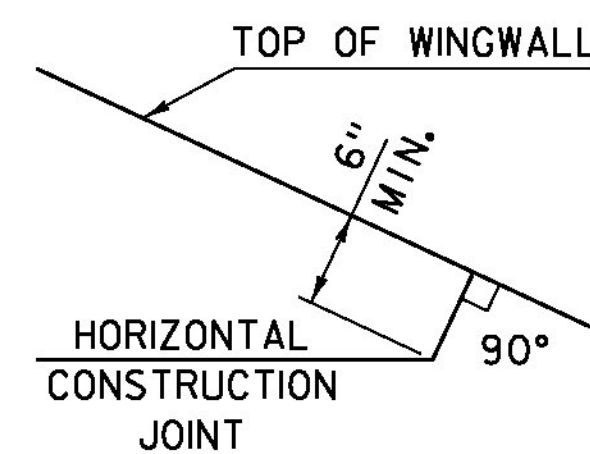

HORIZONTAL WINGWALL  
CONSTRUCTION JOINT  
(NOT TO SCALE)

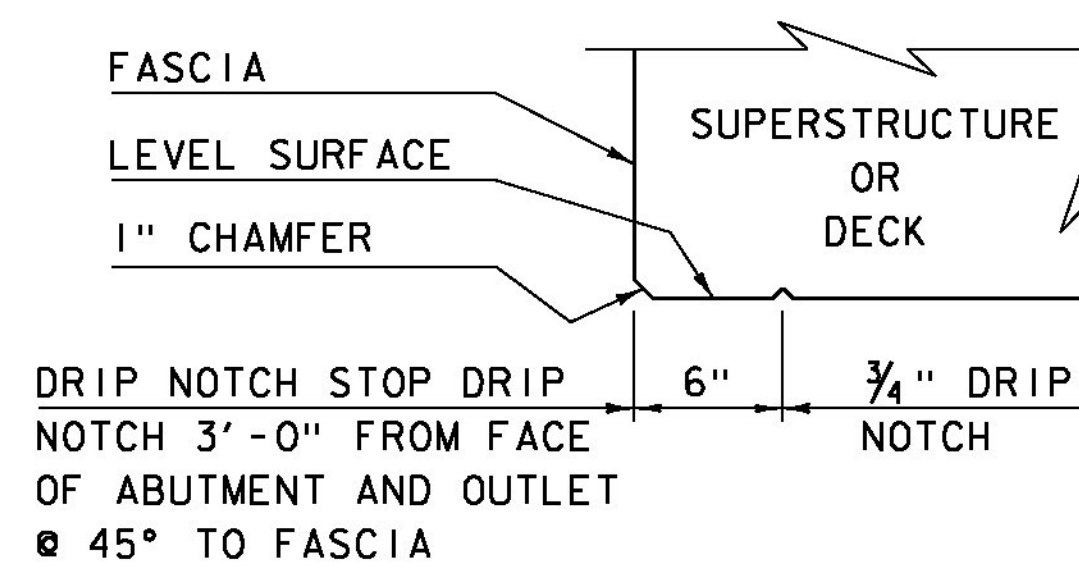

DRIP NOTCH DETAIL  
(NOT TO SCALE)

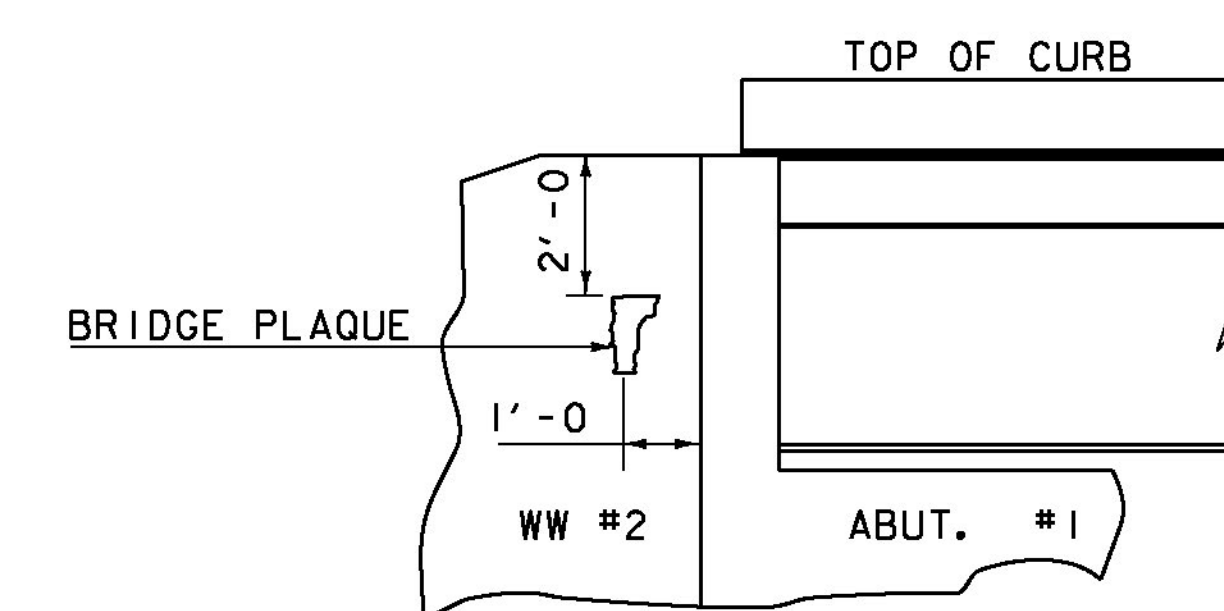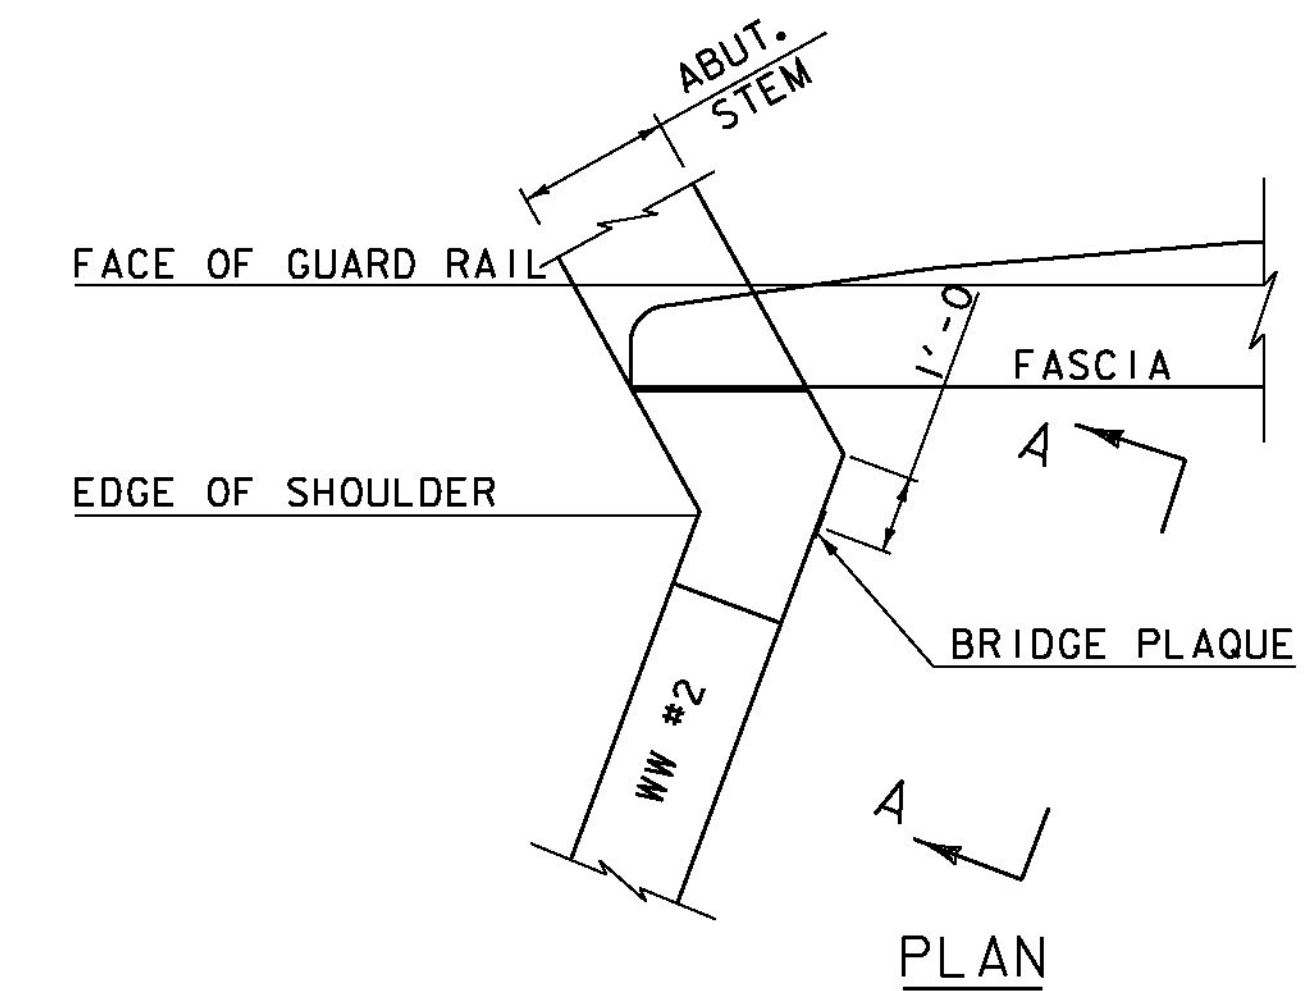

VIEW "A - A"

BRIDGE PLAQUE  
(NOT TO SCALE)


THE BRIDGE PLAQUE WILL BE SUPPLIED BY THE AGENCY OF TRANSPORTATION AND SHALL BE INSTALLED BY THE CONTRACTOR AT ABUTMENT #1 ON THE RIGHT SIDE AS SHOWN OR AS DIRECTED BY THE ENGINEER.

PAYMENT FOR INSTALLATION OF THE BRIDGE PLAQUE SHALL BE INCIDENTAL TO THE ADJACENT CONCRETE.


### REVISIONS

DATE	DESCRIPTION
MAY 7, 2010	APPROVED FOR USE BY VAOT STRUCTURES SECTION
JUNE 4, 2010	MODIFIED AND ADDED TWO DETAILS
OCTOBER 10, 2012	MODIFIED HORZ. JOINT WINGWALL ADD 6" MIN. DIMENSION


# CONCRETE DETAILS AND NOTES

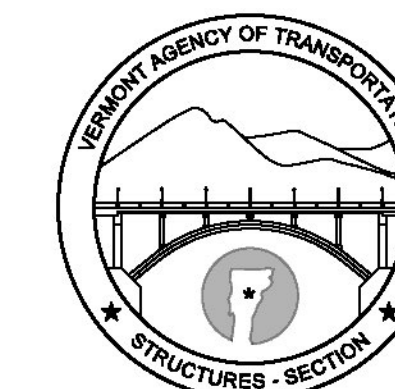


STRUCTURES  
DETAIL  
SD-502.00

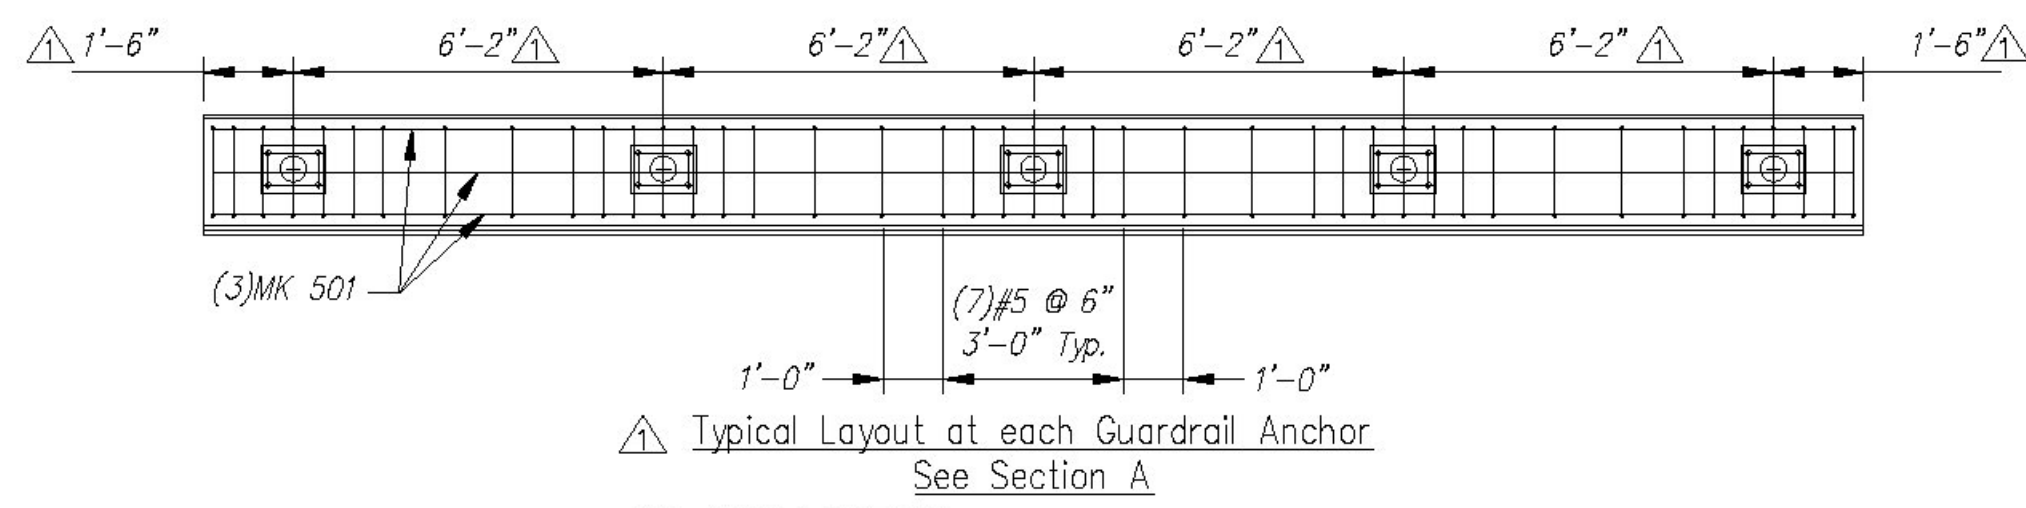


**PLAN VIEW HEADWALL REINFORCING DETAIL**  
Scale: 1/4" = 1'-0"

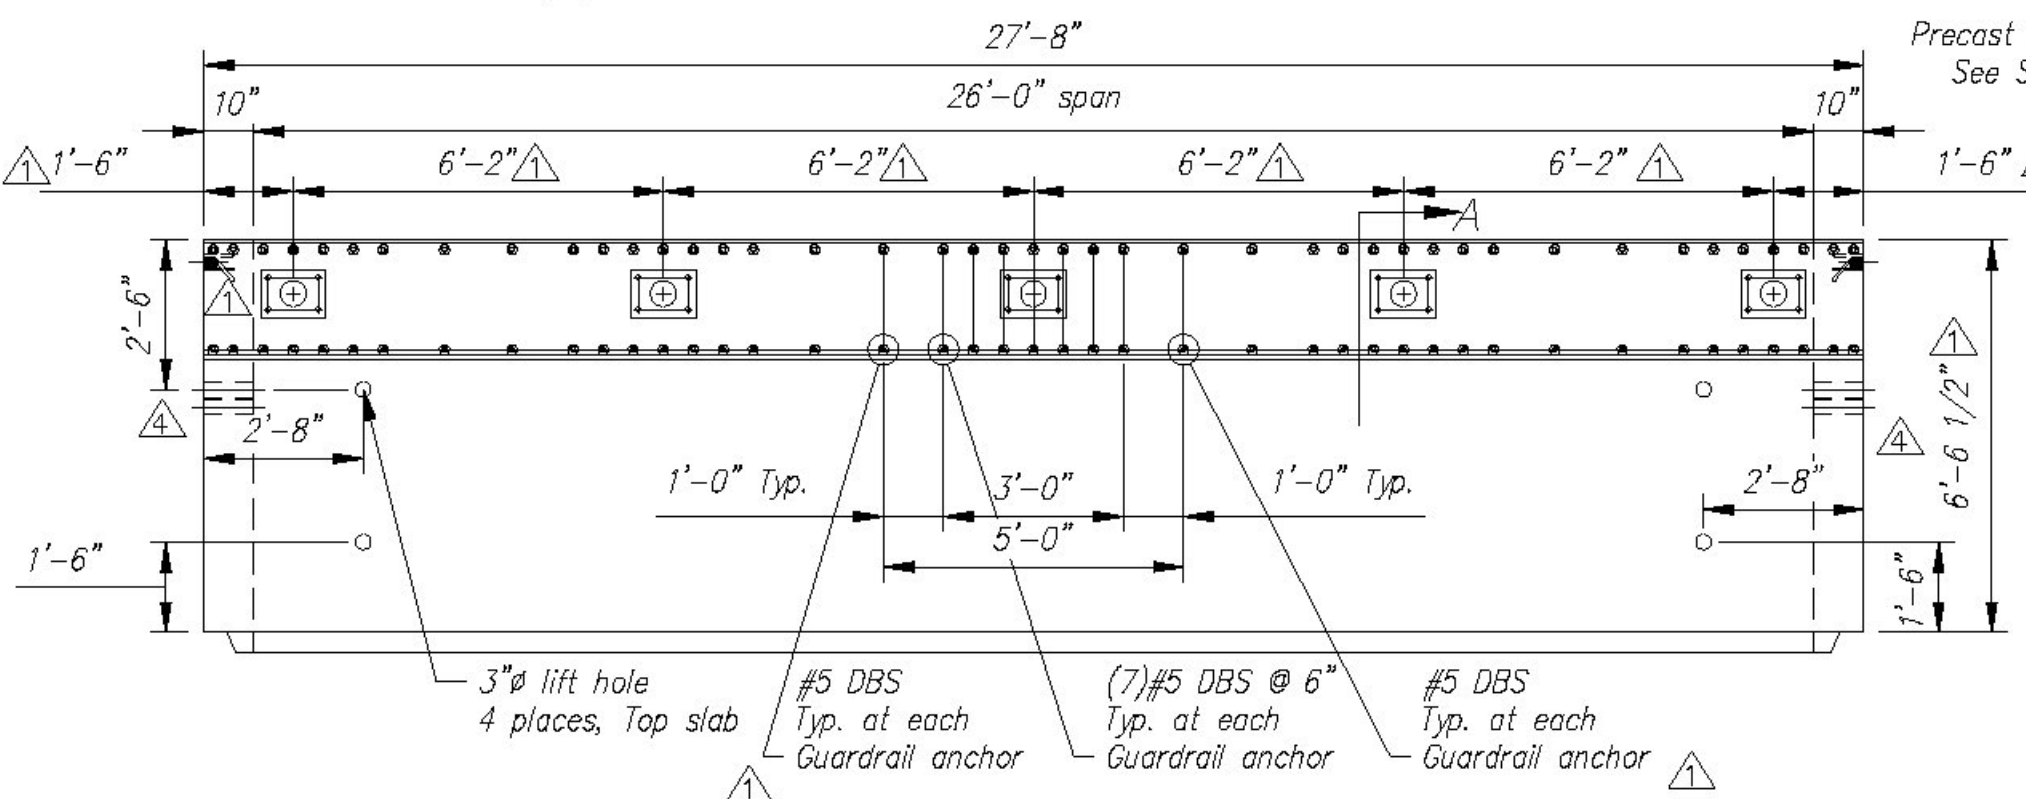


**PLAN VIEW**  
Scale: 1/4" = 1'-0"

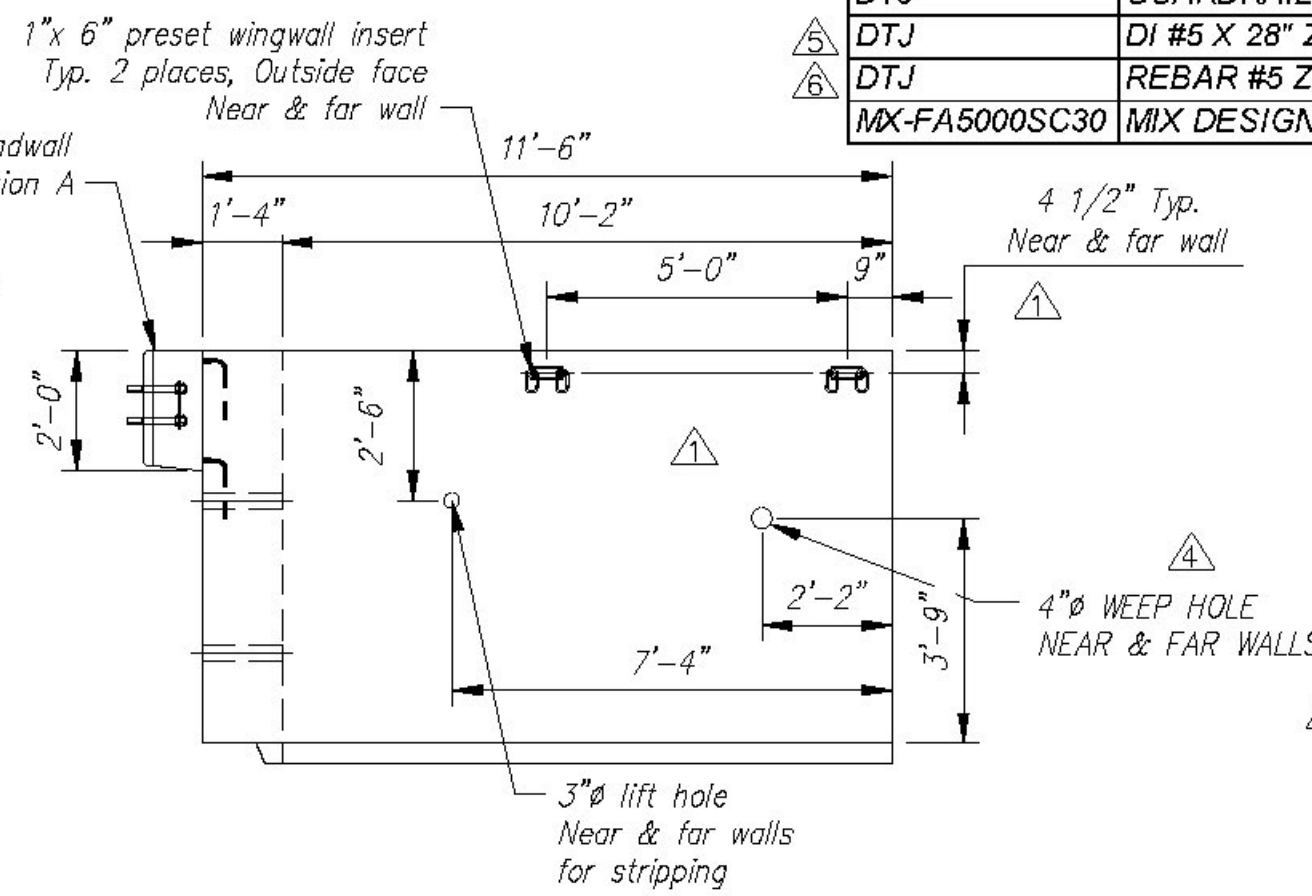


**R. SIDE ELEVATION**  
Scale: 1/4" = 1'-0"

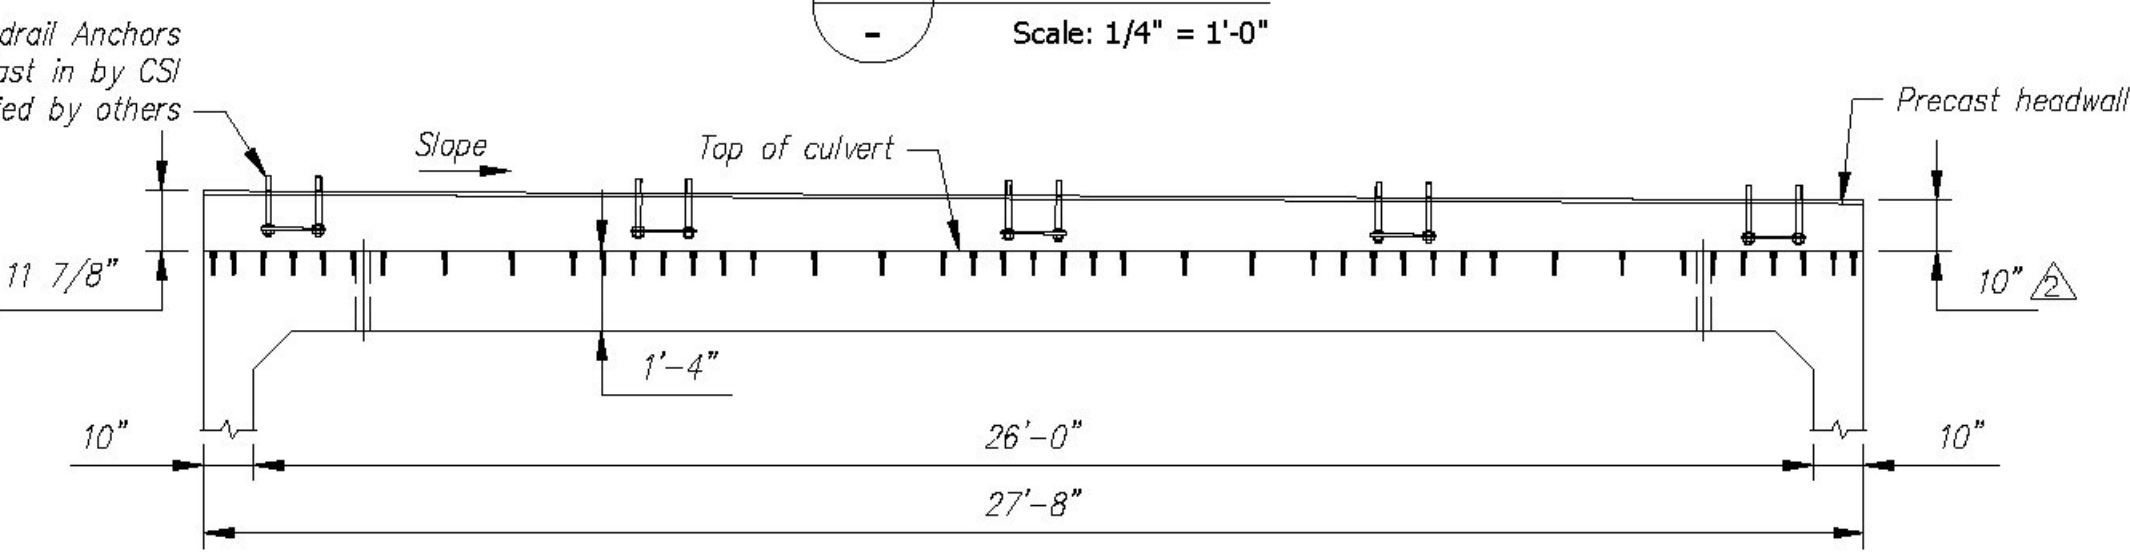


**PARTIAL ELEVATION**  
Scale: 1/4" = 1'-0"

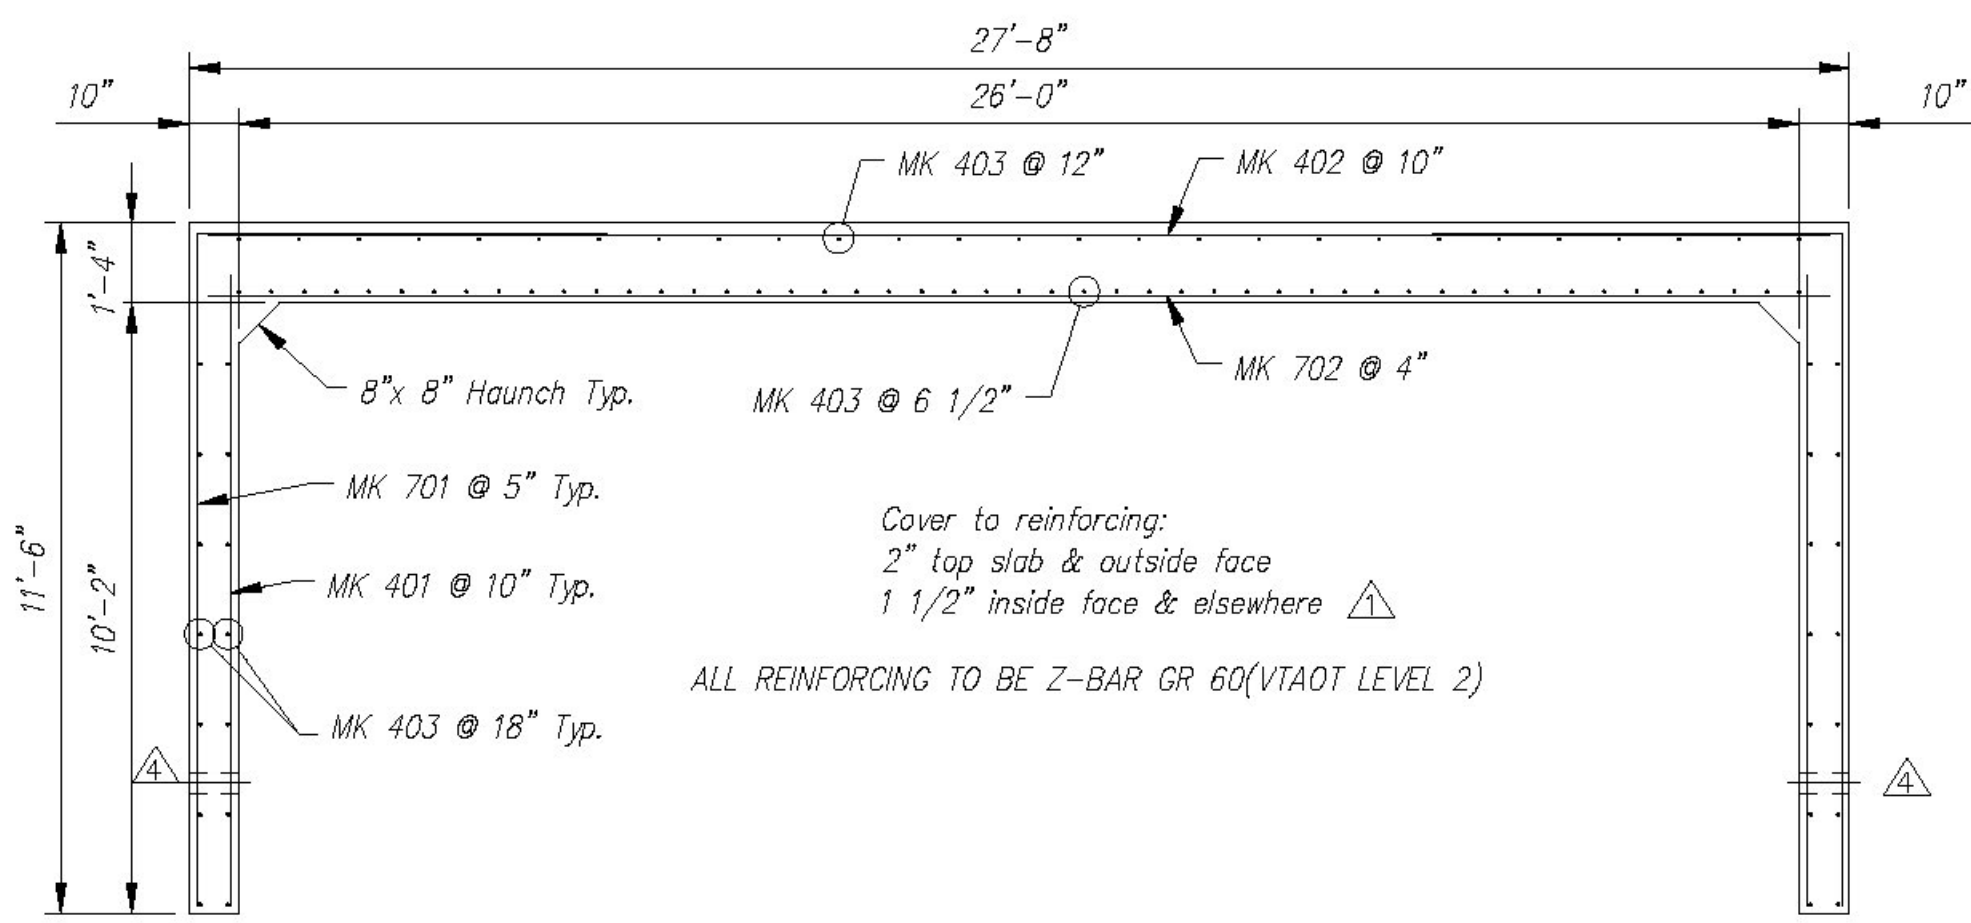


**REINFORCING DETAIL**  
Scale: N.T.S.

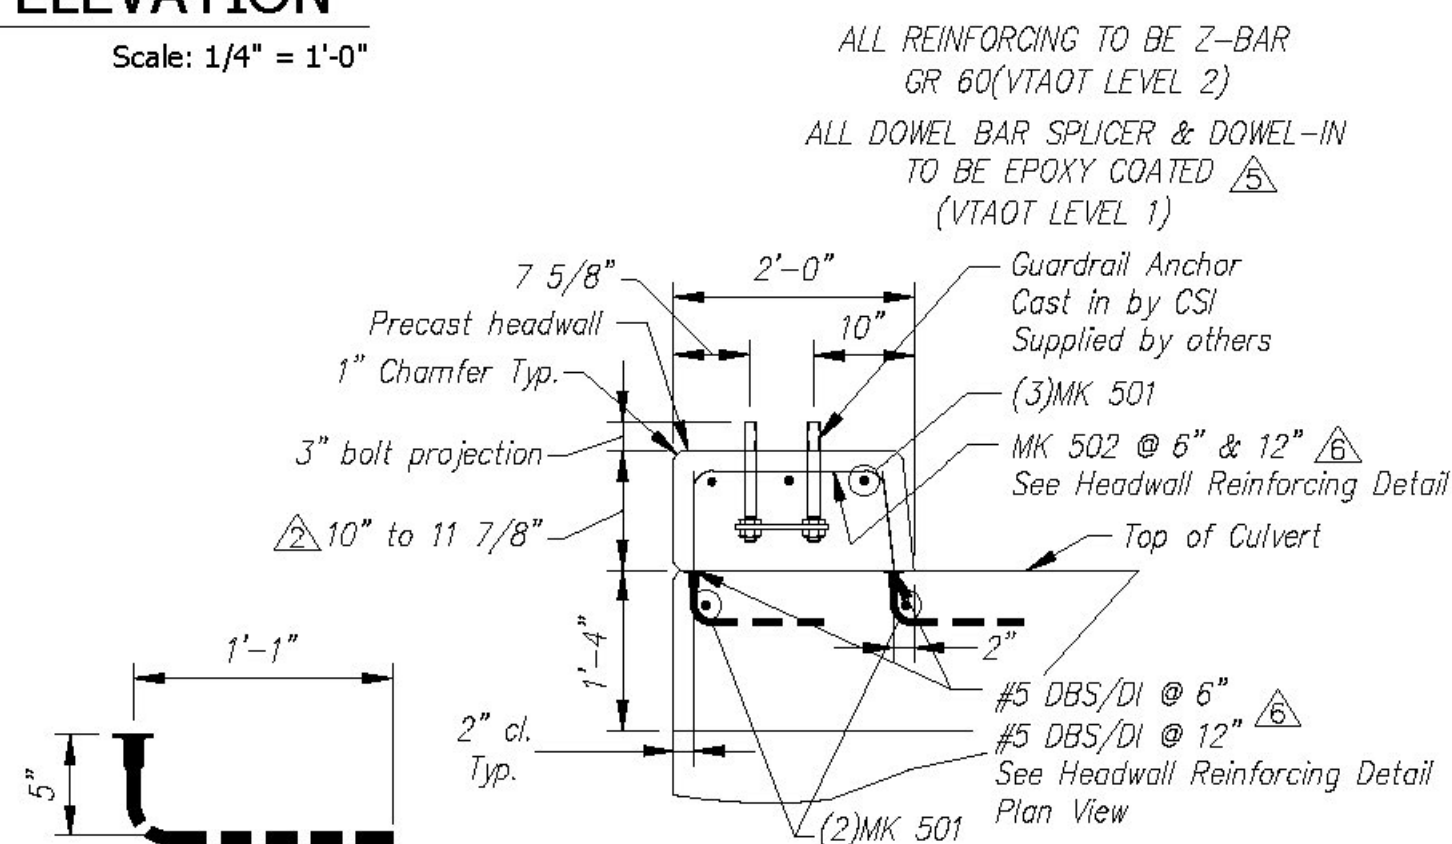

**SECTION A**  
Scale: N.T.S.

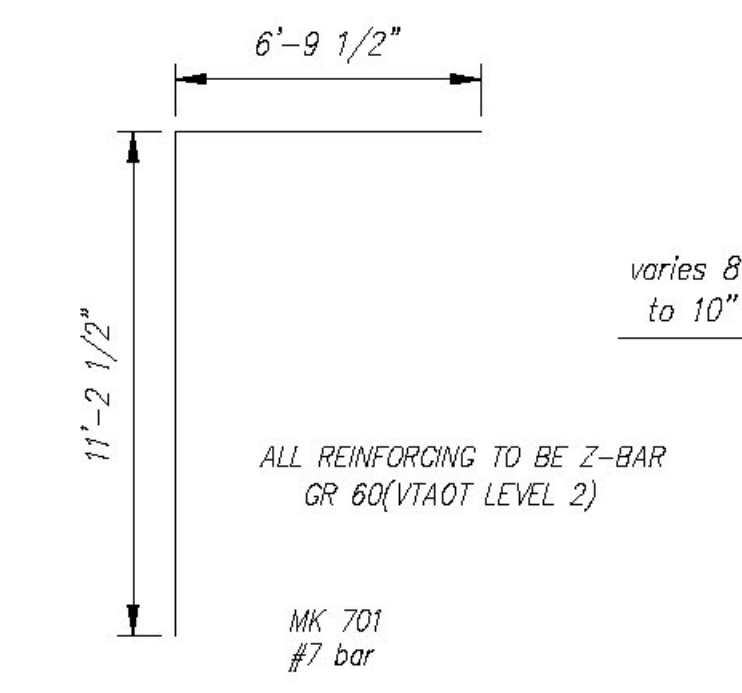

**BENDING SCHEDULE**  
Scale: N.T.S.

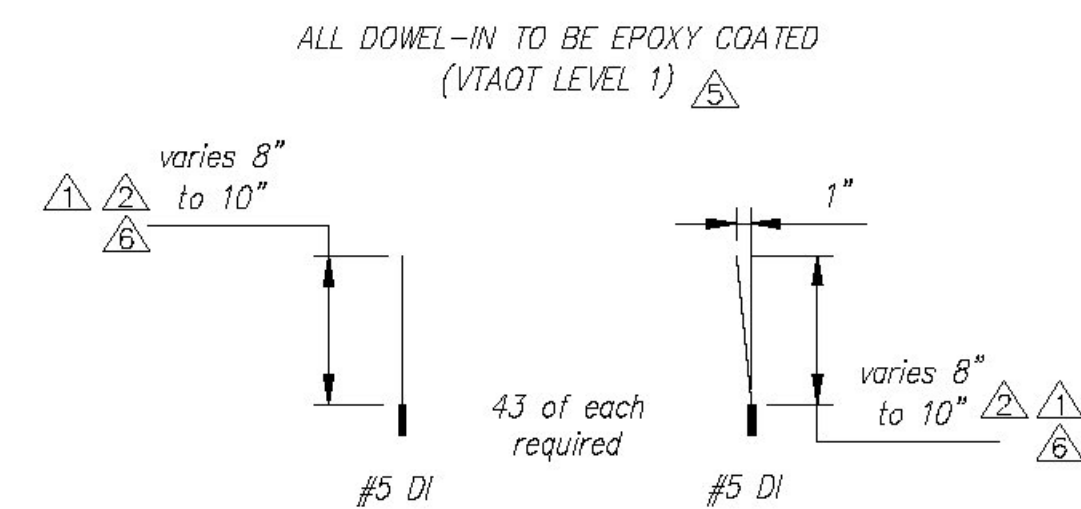

**HEADWALL BENDING SCHEDULE**  
Scale: N.T.S.

QUANTITY = 1  
WEIGHT = 31.19 TONS

C1 - BILL OF MATERIALS / EMBEDS				
CSI ID#	DESCRIPTION	QTY	UM	COMMENTS
DTJ	CERTI-VEX PENSEAL 244-40%	1.30	GA	
EM-0005A	1" X 6" PRESET WING INSERTS	4	EA	
EM-00033	3" FOAM CORE PVC	7	FT	
DTJ	DBSAE #5 Z-BAR GR 60 VTAOT LEVEL II	86	EA	DOWEL BAR SPLICER
DTJ	REBAR #4 Z-BAR GR 60 VTAOT LEVEL II	696	LB	
DTJ	REBAR #5 Z-BAR GR 60 VTAOT LEVEL II	57	LB	
DTJ	REBAR #7 Z-BAR GR 60 VTAOT LEVEL II	2281	LB	
MX-FA5000SC30	MIX DESIGN - FLY ASH 5000 SELF CONSOLIDATING	13.62	CY	
C1 HEADWALL - BILL OF MATERIALS / EMBEDS				
DTJ	GUARDRAIL ANCHOR	5	EA	SUPPLIED BY OTHERS
DTJ	DI #5 X 28" Z-BAR GR 60 VTAOT LEVEL II	86	EA	DOWEL IN
DTJ	REBAR #5 Z-BAR GR 60 VTAOT LEVEL II	228	LB	
MX-FA5000SC30	MIX DESIGN - FLY ASH 5000 SELF CONSOLIDATING	1.78	CY	

C1 Culvert Rebar Schedule		
MK	QTY	LENGTH
401 #4	16	10' - 6"
402 #4	8	27' - 0"
403 #4	104	6' - 4"
501 #5	2	27' - 4"
701 #7	32	18' - 0"
702 #7	20	27' - 0"

C1 HW Rebar Schedule		
MK	QTY	LENGTH
501 #5	3	27' - 4"
502 #5	43	3' - 2"

Rev.	Date	Description
10		
9		
8		
7		
6	21JUL2015	SHORTENED DI & ADDED REBAR TO HW TO EASE MFG
5	08JUL2015	ALL DBS/DI WERE Z-BAR, NOW EPOXY COATED
4	17JUN2015	REVISED PER CUSTOMER REVIEW
3	10JUN2015	ADJUSTED WATER REPELLENT
2	28MAY2015	10" WAS 9 1/2", HDWALL BEND SCHED - 8" WAS 7 1/2"
1	14MAY2015	REVISED PER CUSTOMER REVIEW, REVERSED GUARDRAIL ANCHOR SPACING, MOVED WINGWALL ANCHOR, ADDED NOTE
		DESCRIPTION
		REVISIONS
		By

Contractor is to verify that all information shown on drawings has been thoroughly checked, complies with the contract documents and is adequate to meet the field conditions. Some dimensions and details may differ from those shown on drawings. Approval of this drawing indicates that any deviation from the contract documents has been reviewed and found to be acceptable. Production will not commence until receipt of signed, approved shop drawings.

This drawing contains information proprietary to CONCRETE SYSTEMS, INC. It is disclosed with the understanding that it will be retained in confidence and not be used for any other project without the written authorization of CONCRETE SYSTEMS, INC. and that it will be returned to CONCRETE SYSTEMS, INC. upon request.

Vermont Agency of Transportation  
**RECEIVED**

CK'D BY CLB OK'D BY HIS  
July 22, 2015

RESUBMIT NO Approved  
BY C. CARLSON DATE 07/23/15

Following documents and/or sources:  
PROJECT, TOWN OF RICHFORD  
DATED 2011

**CSI**  
Concrete Systems Inc.  
9 Commercial St., Hudson, NH, 03051  
Phone 603-889-4163  
Fax 603-889-2417


STATE AGENCY  
**VTTrans**  
Drawn By: R. YEAGER Date: 16APR2015  
Reviewed By: Date:  
Approved By: C. VICK Date: 7/21/15

G.W. TATRO CONSTRUCTION, INC.  
VT/AOT BRIDGE REPLACEMENT - ROAD IMPROVEMENT  
RICHFORD, VT.  
Drawing No. C22312-C1  
REV 6  
Quantity: 1 Project No: BRFO30229 SHEET 1 OF 14


QUANTITY = 2  
WEIGHT = 30.78 TONS

C2 - BILL OF MATERIALS / EMBEDS				
CSI ID#	DESCRIPTION	QTY	UM	COMMENTS
EM-00033	3" FOAM CORE PVC	7	FT	
JS-00002	1"X1"CLOSED NEOP GASKET	49	FT	AROUND BELL
DTJ	REBAR #4 Z-BAR GR 60 VTAOT LEVEL II	824	LB	
DTJ	REBAR #7 Z-BAR GR 60 VTAOT LEVEL II	2667	LB	
MX-FA5000SC30	MIX DESIGN - FLY ASH 5000 SELF CONSOLIDATING	15.2	CY	

C2 Culvert Rebar Schedule		
MK	QTY	LENGTH
401 #4	20	10' - 6"
402 #4	10	27' - 0"
403 #4	104	7' - 3"
701 #7	38	18' - 0"
702 #7	23	27' - 0"

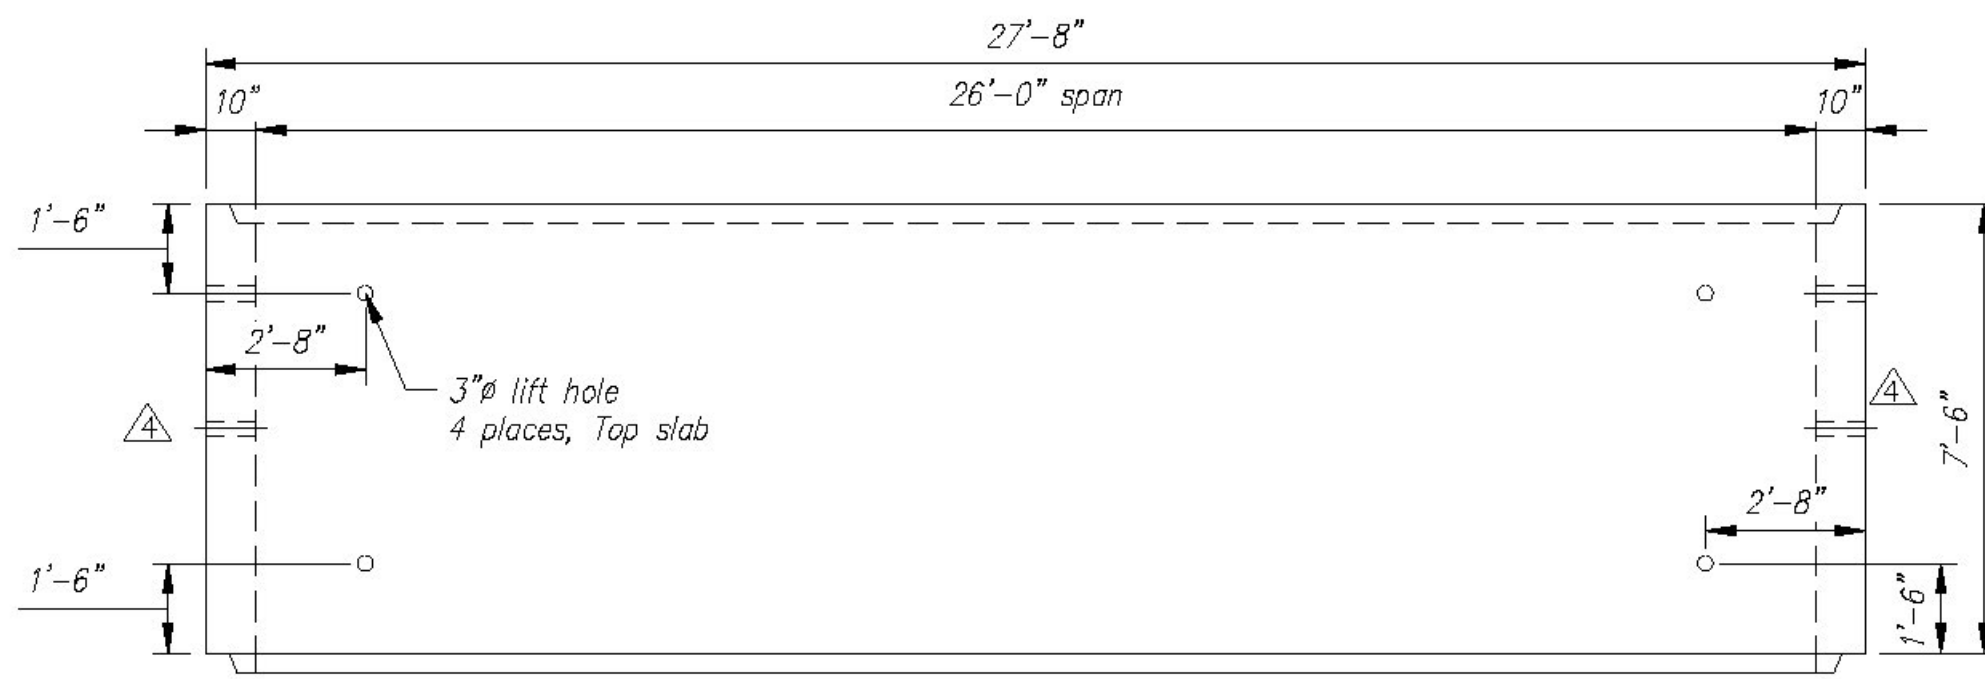


PLAN VIEW  
Scale: 1/4" = 1'-0"

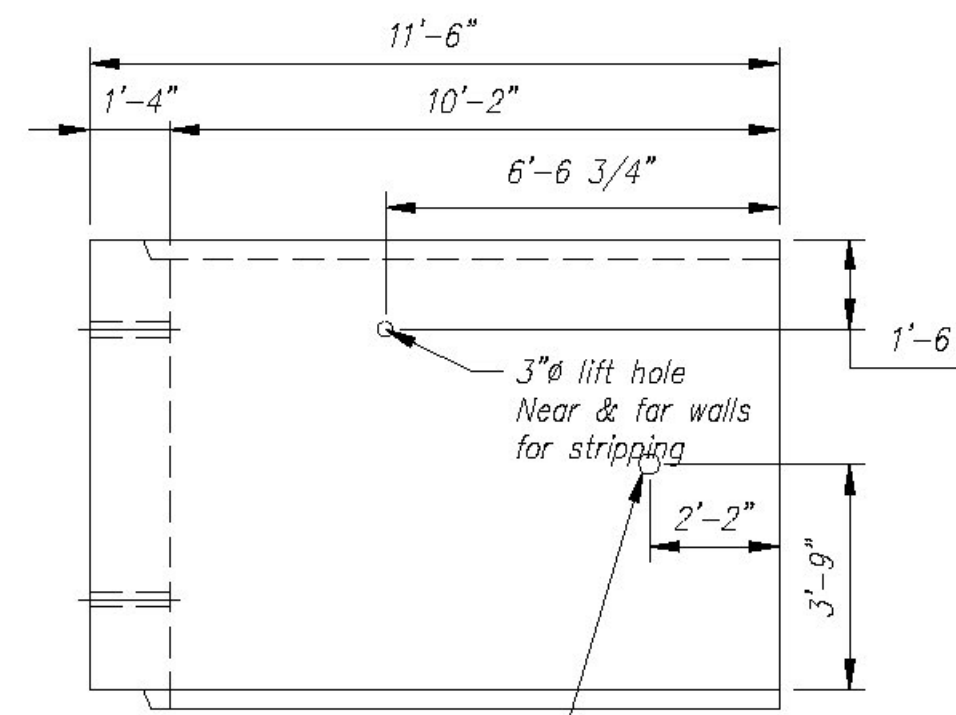


R. SIDE ELEVATION  
Scale: 1/4" = 1'-0"

△ Culvert piece length is 1/2" shorter on shop drawing than on layout drawing.  
Layout dimension includes joint gap.

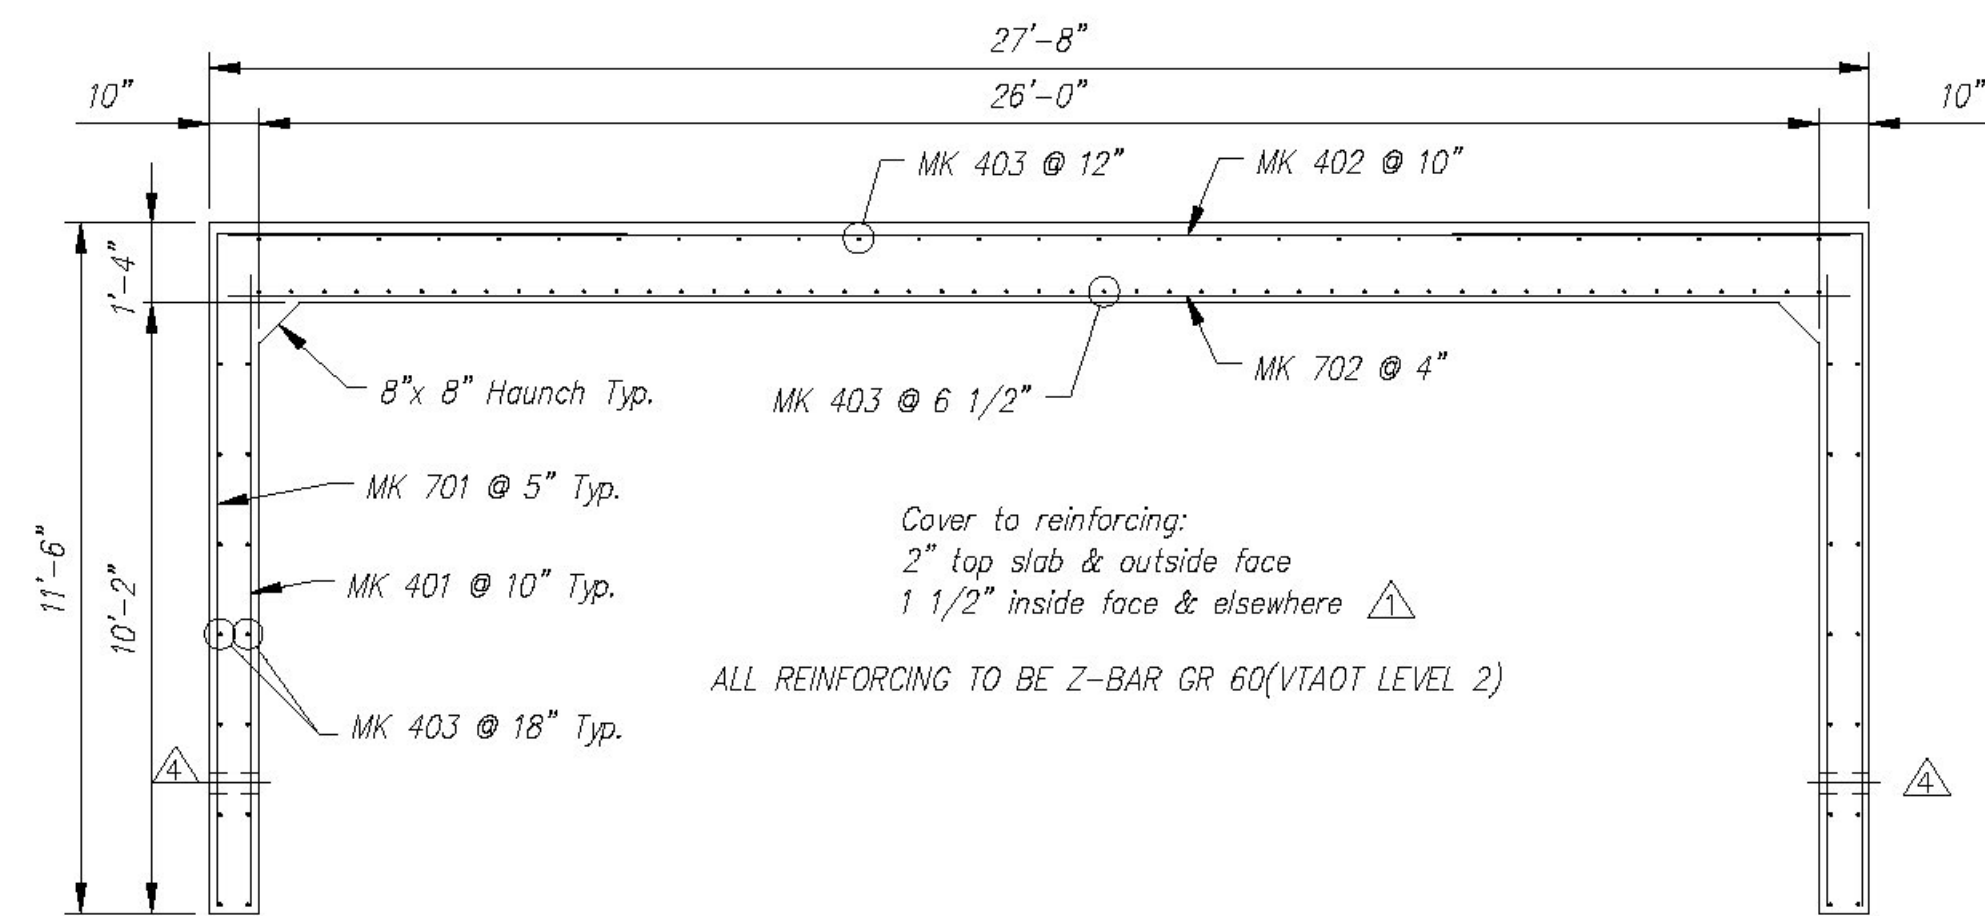

REINFORCING DETAIL  
Scale: N.T.S.

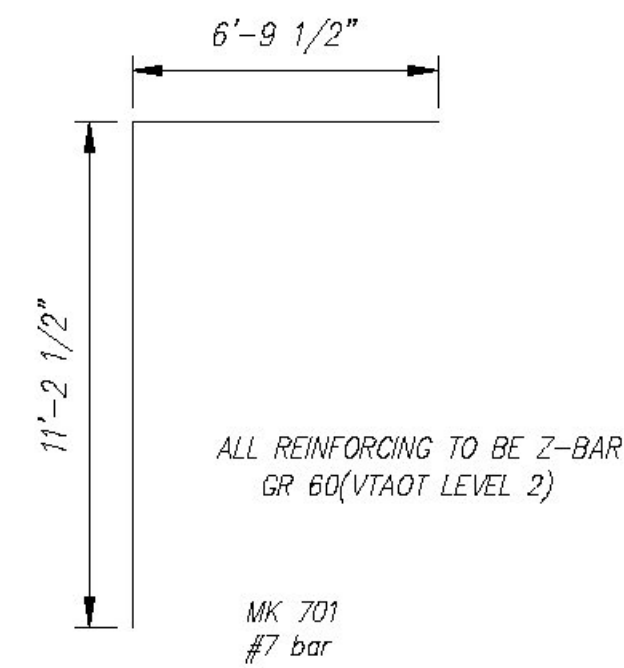

BENDING SCHEDULE  
Scale: N.T.S.

Vermont Agency of Transportation  
**RECEIVED**  
CK'D BY CLB OK'D BY HIS  
July 22, 2015  
RESUBMIT NO Approved  
BY C. CARLSON DATE 07/23/15

Rev.	Date	DESCRIPTION
1	14MAY2015	REVISED PER CUSTOMER REVIEW, ADDED NOTE
2	17JUN2015	REVISED PER CUSTOMER REVIEW
3		
4		
5		
6		
7		
8		
9		
10		

Contractor is to verify that all information shown on drawings has been thoroughly checked, complies with the contract documents and is adequate to meet the field conditions. Some dimensions and details may differ from those shown on drawings. Approval of this drawing indicates that any deviation from the contract documents has been reviewed and found to be acceptable. Production will not commence until receipt of signed, approved shop drawings.

This drawing contains information proprietary to CONCRETE SYSTEMS, INC. It is disclosed with the understanding that it will be retained in confidence and not be used for any other project without the written authorization of CONCRETE SYSTEMS, INC. and that it will be returned to CONCRETE SYSTEMS, INC. upon request.

This drawing is based upon information provided from the following documents and/or sources:  
 Engineer: STATE OF VT/AOT PROGRAM DEVELOPMENT  
 Project No: _____  
 Drawings: STATE OF VT/AOT PROPOSED IMPROVEMENT BRIDGE PROJECT, TOWN OF RICHFORD SHEETS 1,2,4,22,23,24 OF 36  
 Specifications: STANDARD SPECIFICATIONS FOR CONSTRUCTION DATED 2011  
 Other: _____

STATE AGENCY  
VTTrans

**Concrete Systems Inc.**  
9 Commercial St., Hudson, NH, 03051  
Phone 603-889-4163  
Fax 603-889-2417

Drawn By: R. YEAGER Date: 16APR2015  
 Reviewed By: B. KOLAWOLE Date: _____  
 Approved By: C. VICK Date: 17JUN2015

G.W. TATRO CONSTRUCTION, INC.  
VT/AOT BRIDGE REPLACEMENT- ROAD IMPROVEMENT  
RICHFORD, VT.


SHOP DRAWING C2  
C22312-C2

Quantity: 2 Project No: BRFO30229 SHEET 2 OF 14

REV 2




QUANTITY = 1  
WEIGHT = 15.73 TONS

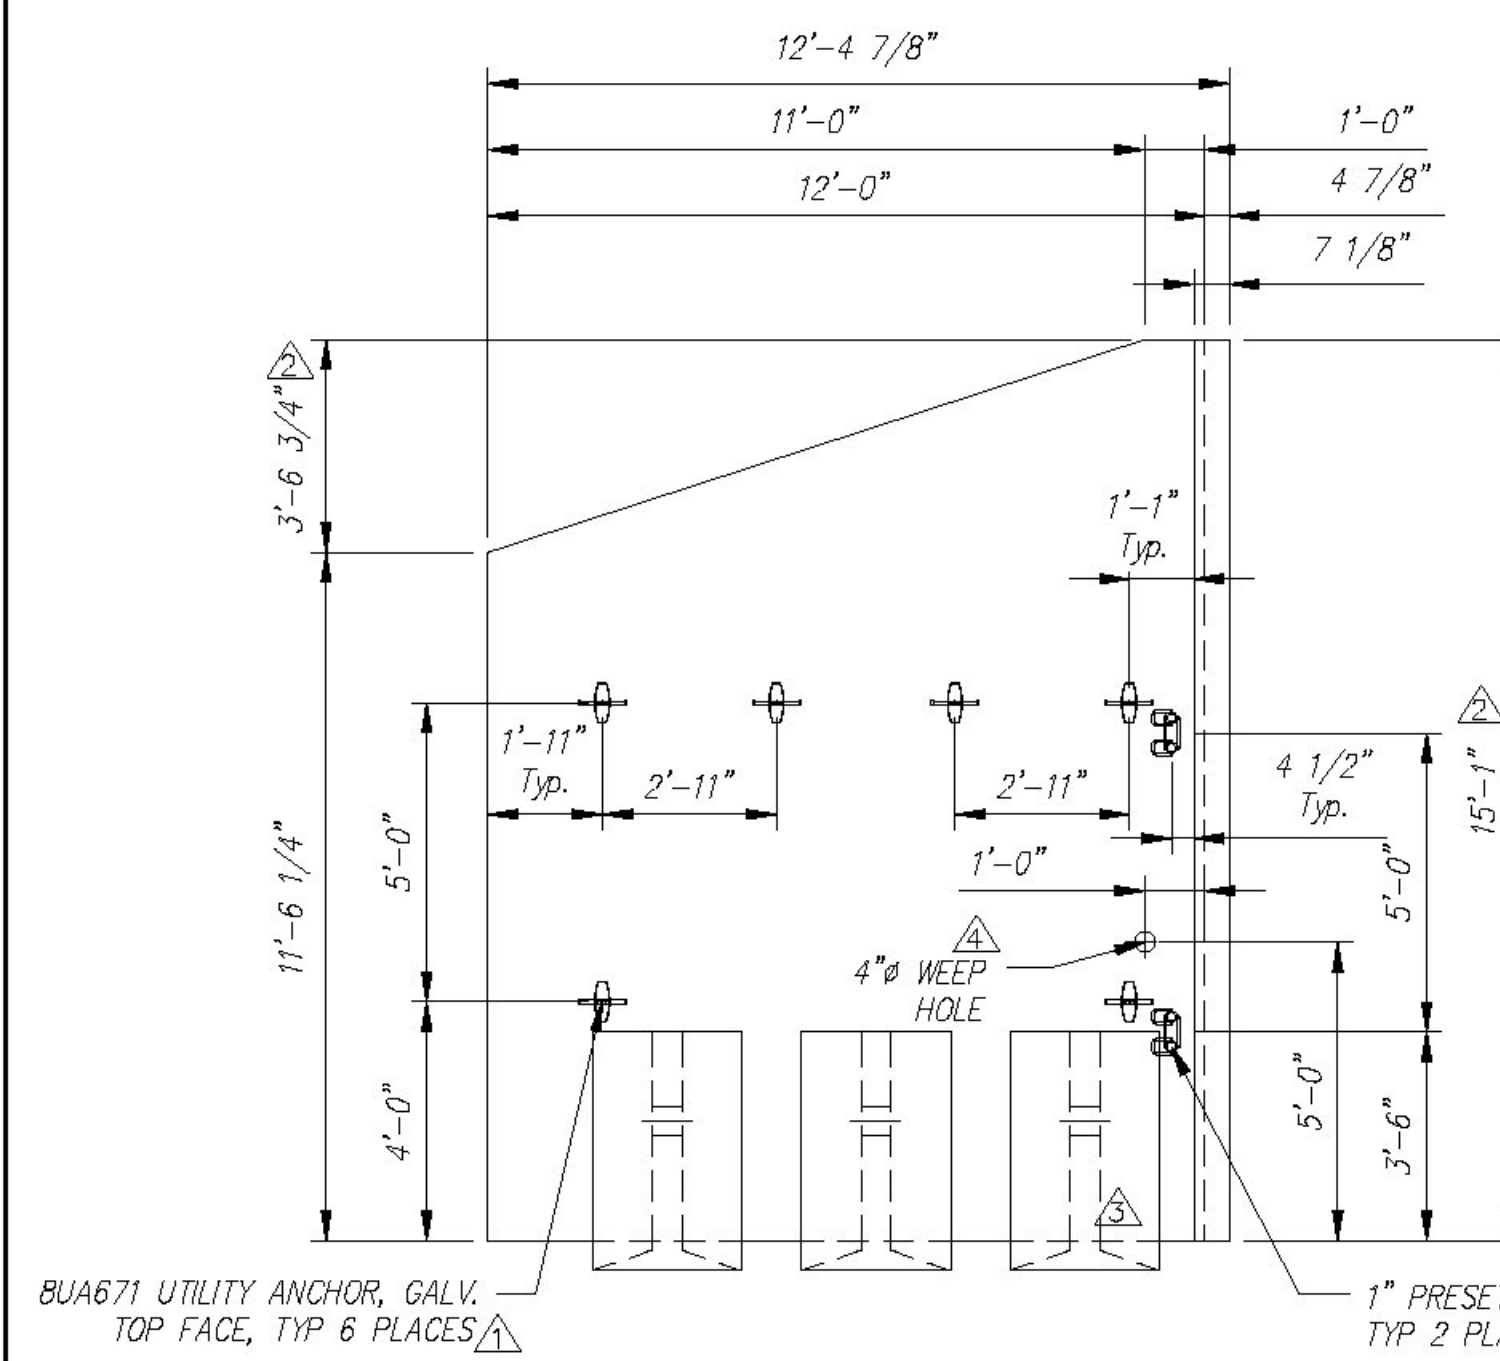


PLAN VIEW  
Scale: 1/4" = 1'-0"

ALL EXPOSED EDGES OF CONCRETE TO RECEIVE 1" CHAMFER

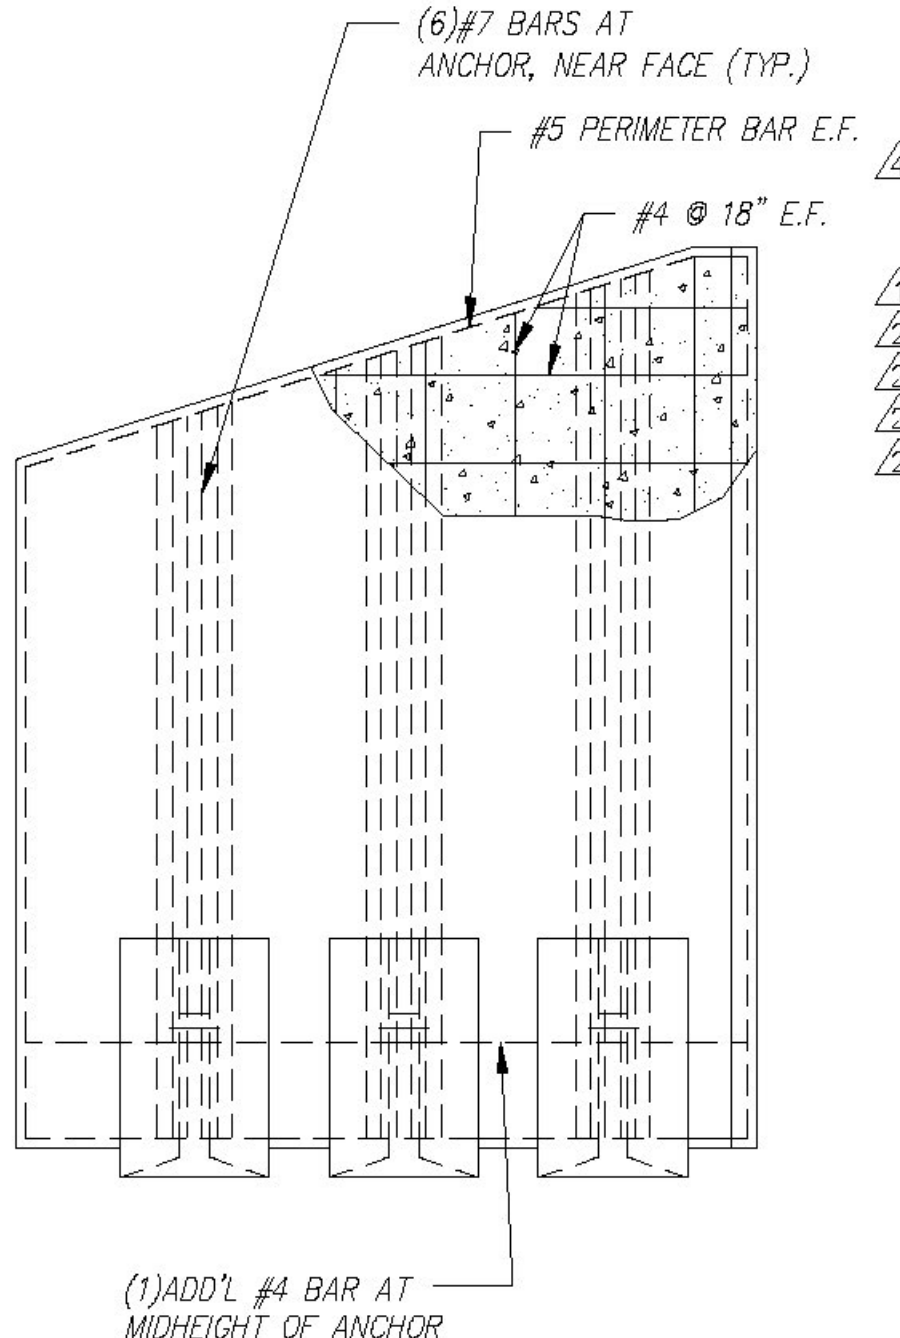


REINFORCING DETAIL  
Scale: 1/4" = 1'-0"

WW1 - BILL OF MATERIALS / EMBEDS				
CSI ID#	DESCRIPTION	QTY	UM	COMMENTS
CSANC-E	CONSPAN WINGWALL ANCHOR (E)	3	EA	
DTJ	CERTI-VEX PENSEAL 244-40%	1.20	GA	
EM-00034	4" FOAM CORE PVC	1	FT	
EM-0005A	1" X 6" PRESET WING INSERT	2	EA	
EM-00115	UTILITY ANCHOR #8UA671-GALVANIZED	6	EA	
DTJ	REBAR #4 Z-BAR GR 60 VTAOT LEVEL II	335	LB	
DTJ	REBAR #5 Z-BAR GR 60 VTAOT LEVEL II	106	LB	
DTJ	REBAR #7 Z-BAR GR 60 VTAOT LEVEL II	533	LB	
MX-FA5000SC30	MIX DESIGN - FLY ASH 5000 SELF CONSOLIDATING	6.06	CY	

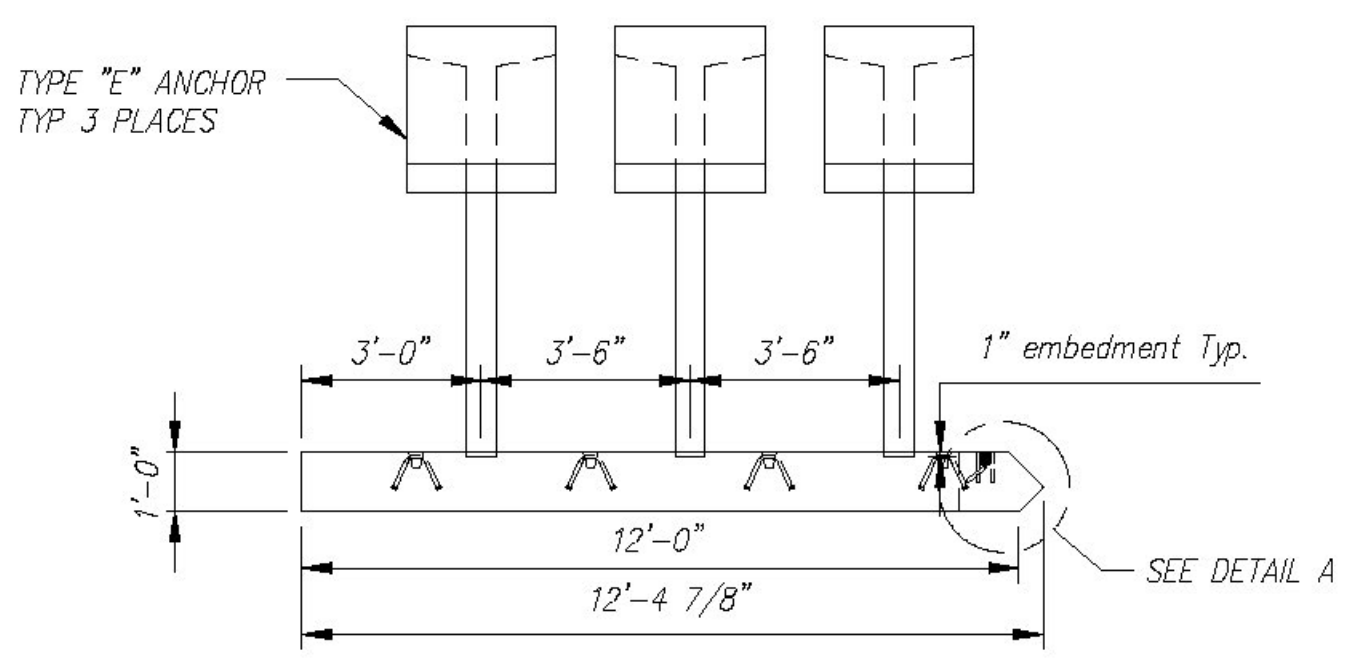

FRONT ELEVATION  
Scale: 1/4" = 1'-0"

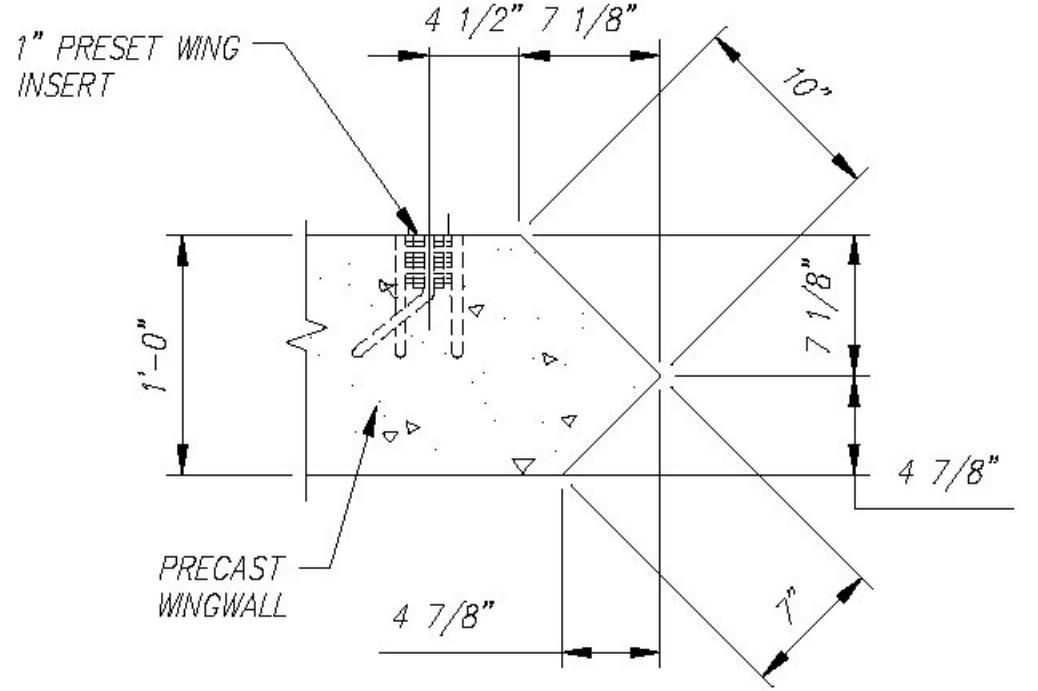

DETAIL A  
Scale: N.T.S.

Rev.	Date	Description
10		
9		
8		
7		
6		
5		
4	17JUN2015	REVISED PER CUSTOMER REVIEW
3	10JUN2015	MOVED WEEP HOLE TO 1'
2	28MAY2015	15'-1 WAS 14'-8", VARIOUS CHANGES
1	14MAY2015	REVISED PER CUSTOMER REVIEW

Contractor is to verify that all information shown on drawings has been thoroughly checked, complies with the contract documents and is adequate to meet the field conditions. Some dimensions and details may differ from those shown on drawings. Approval of this drawing indicates that any deviation from the contract documents has been reviewed and found to be acceptable. Production will not commence until receipt of signed, approved shop drawings.

This drawing contains information proprietary to CONCRETE SYSTEMS, INC. It is disclosed with the understanding that it will be retained in confidence and that no reproduction of this drawing is authorized without permission from CONCRETE SYSTEMS, INC. and that it will be returned to CONCRETE SYSTEMS, INC. upon request.

Vermont Agency of Transportation  
**RECEIVED**

CK'D BY CLB OK'D BY HIS  
July 22, 2015  
RESUBMIT NO Approved  
BY C. CARLSON DATE 07/23/15

This drawing is based upon information provided from the following documents and/or sources:  
Engineer: STATE OF VT/AOT PROGRAM DEVELOPMENT  
Project No: _____  
Drawings: STATE OF VT/AOT PROPOSED IMPROVEMENT BRIDGE PROJECT, TOWN OF RICHFORD SHEETS 1,2,4,22,23,24 OF 36  
Specifications: STANDARD SPECIFICATIONS FOR CONSTRUCTION DATED 2011  
Other: _____

STATE AGENCY  
VTTrans


**Concrete Systems Inc.**  
9 Commercial St., Hudson, NH, 03051  
Phone 603-889-4163  
Fax 603-889-2417

Drawn By: B. SKELTON/R.Y. Date: 17APR2015  
Reviewed By: B. KOLAWOLE Date: _____  
Approved By: C. VICK Date: 17JUN2015

G.W. TATRO CONSTRUCTION, INC.  
VT/AOT BRIDGE REPLACEMENT- ROAD IMPROVEMENT  
RICHFORD, VT.


SHOP DRAWING WW1  
C22312--WW1

Quantity: 1 Project No: BRFO30229 SHEET 4 OF 14

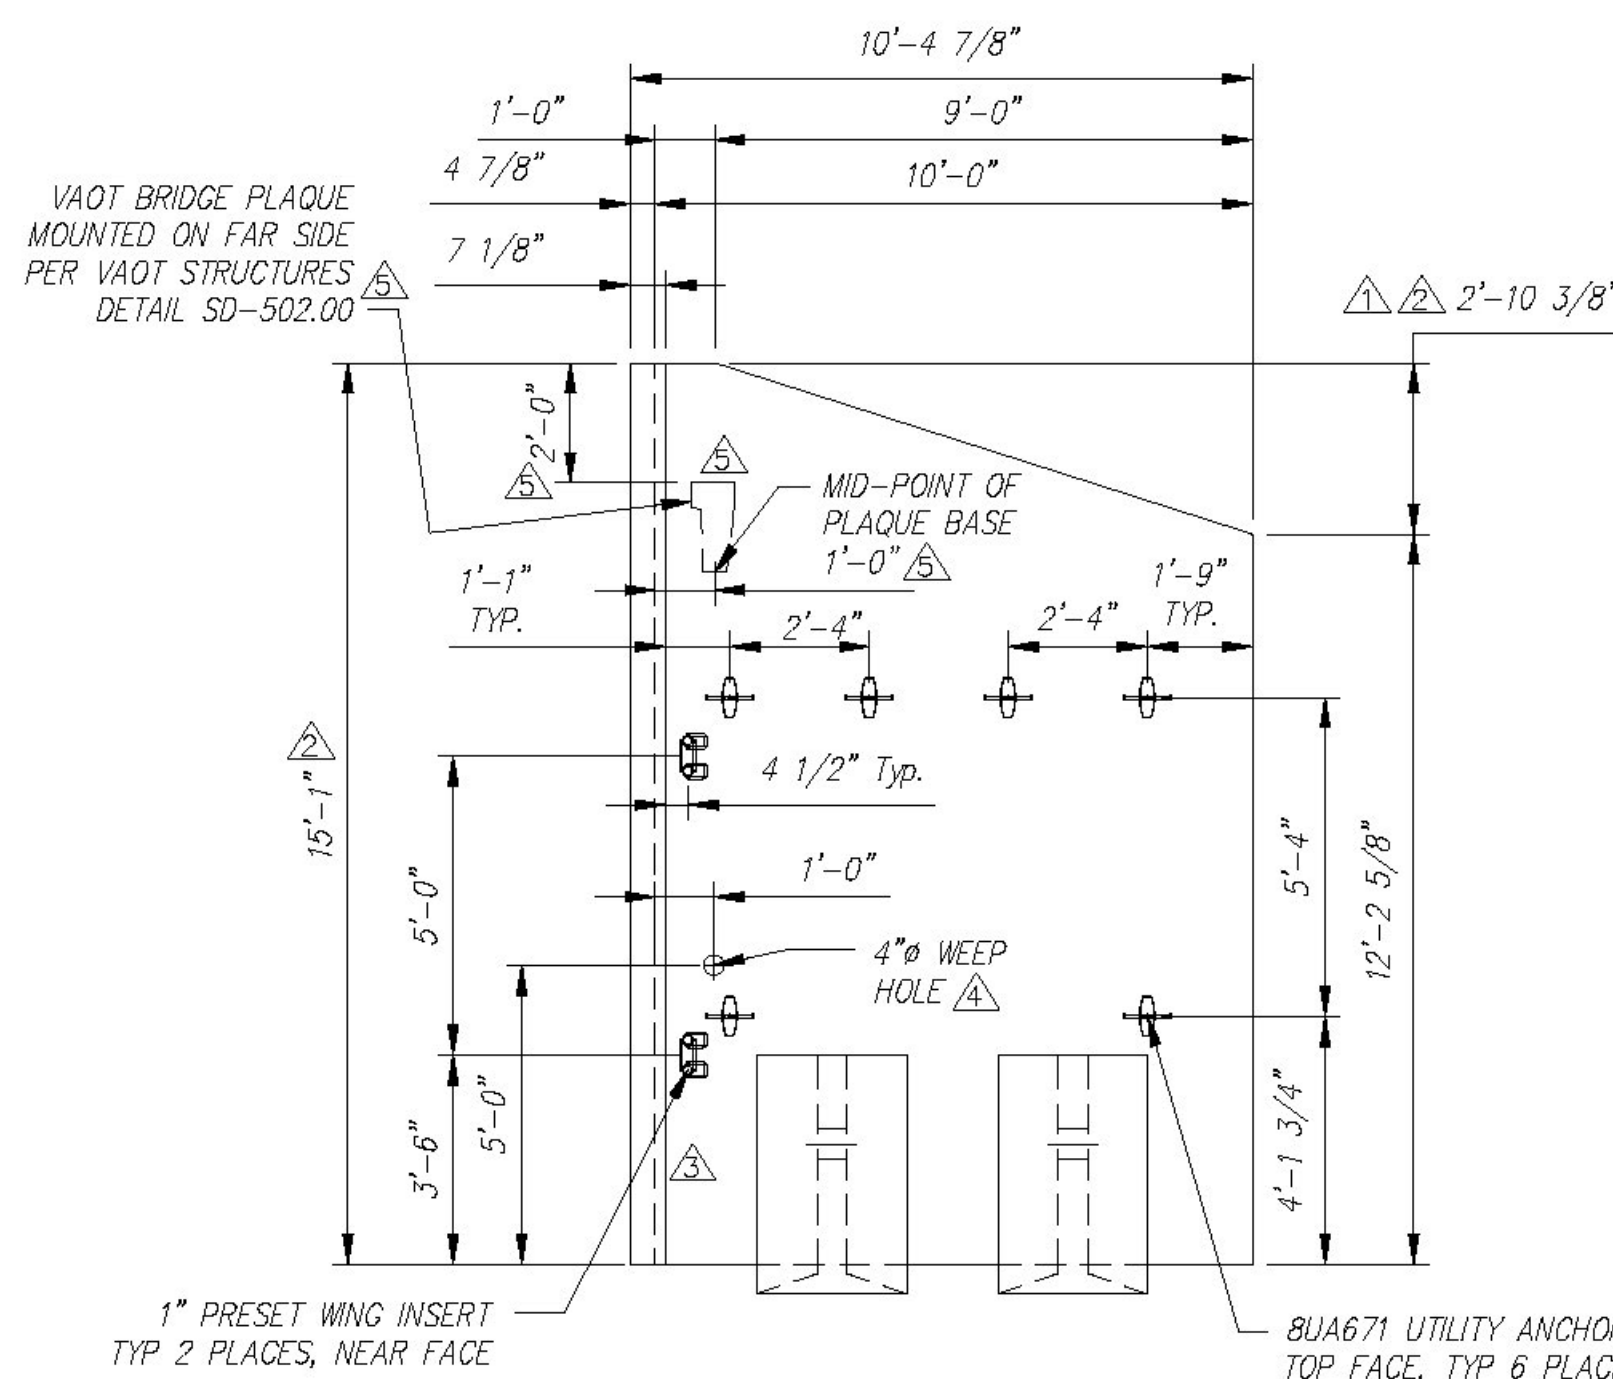


**PLAN VIEW**  
Scale: 1/4" = 1'-0"


ALL EXPOSED EDGES OF CONCRETE TO RECEIVE 1" CHAMFER

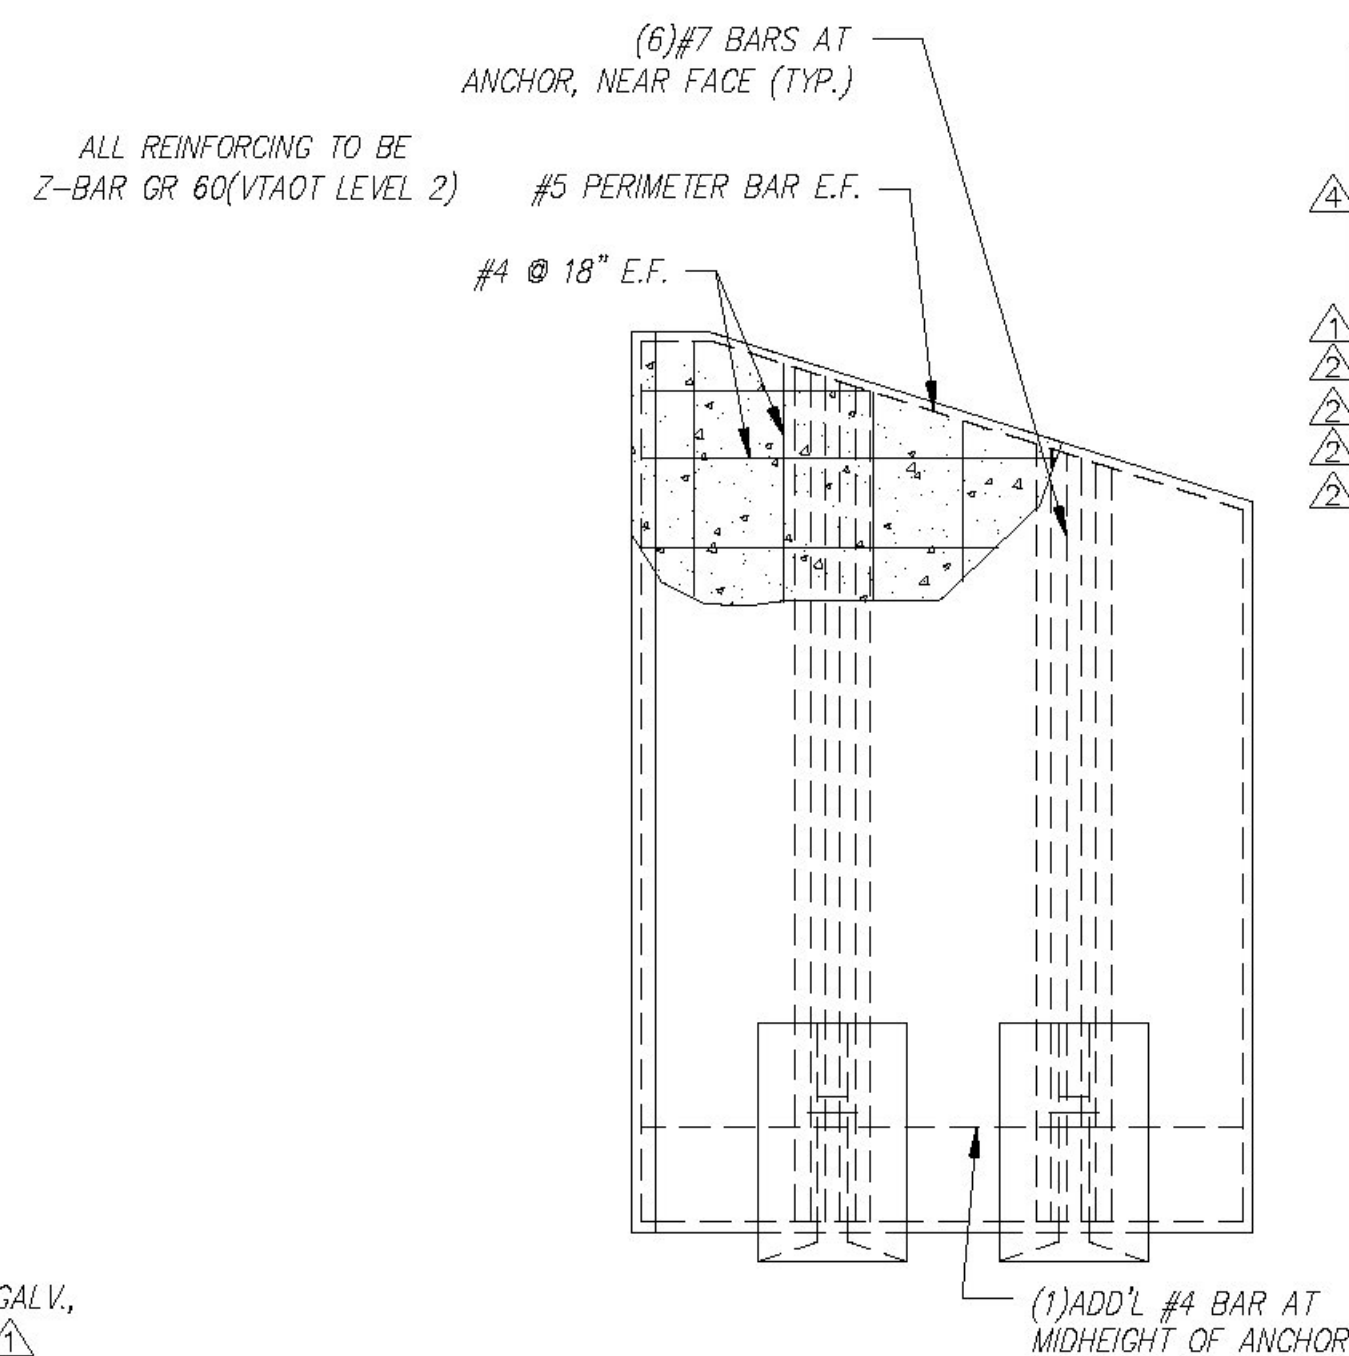

**REINFORCING DETAIL**  
Scale: 1/4" = 1'-0"

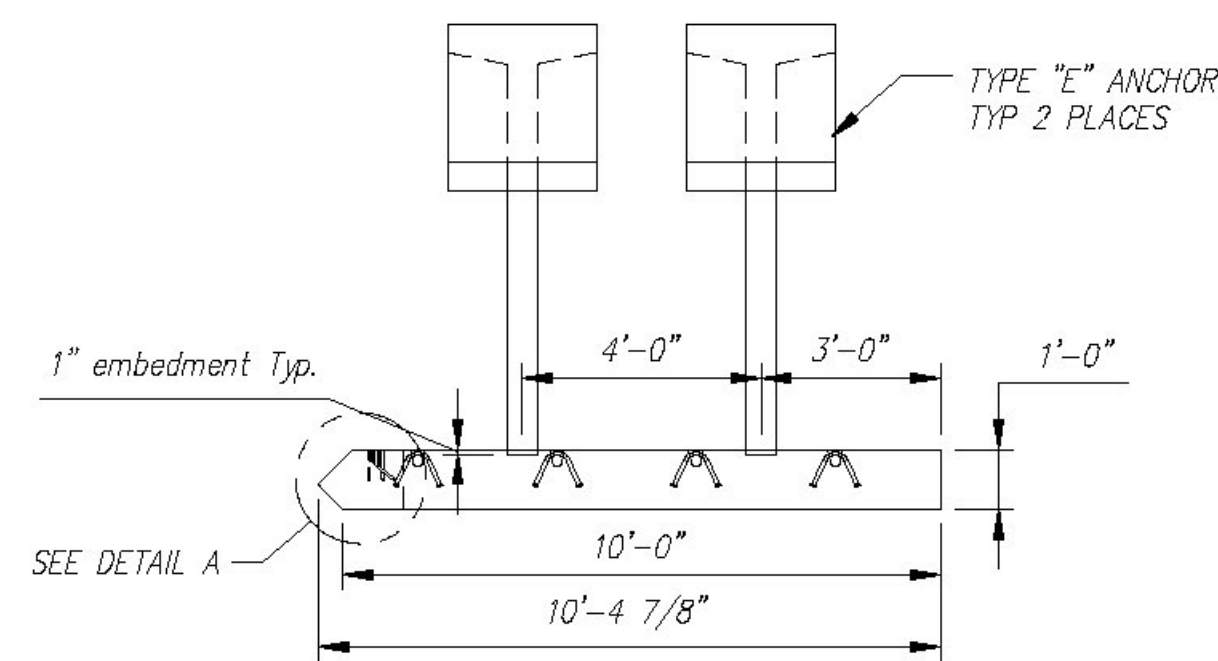

**FRONT ELEVATION**  
Scale: 1/4" = 1'-0"

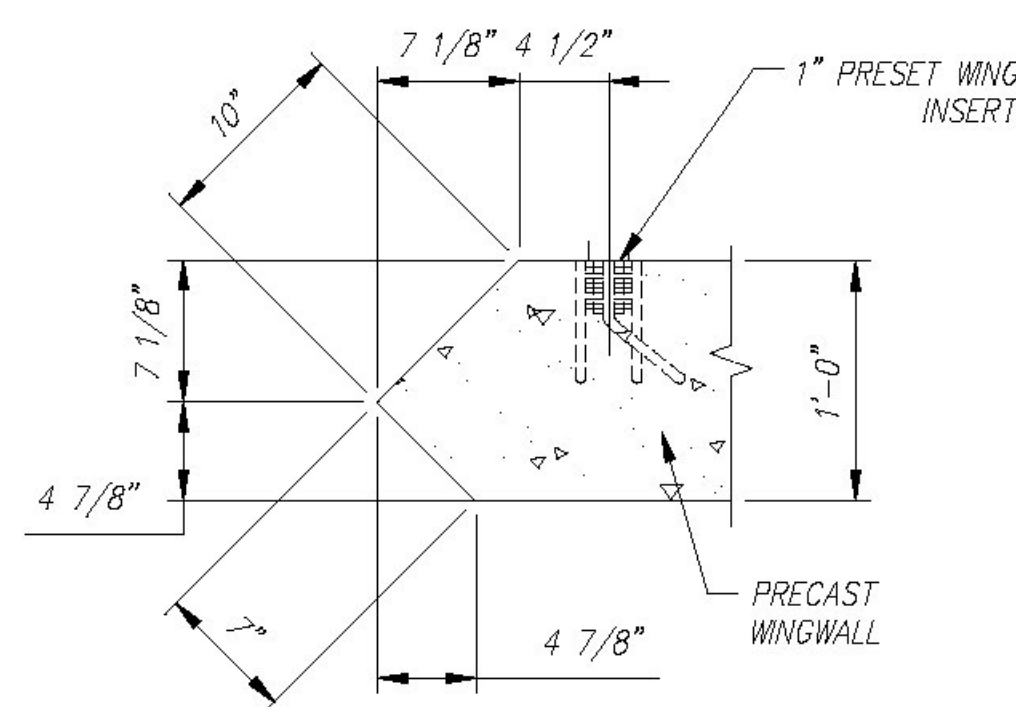

**DETAIL A**  
Scale: N.T.S.

QUANTITY = 1  
WEIGHT = 12.86 TONS

WW2 - BILL OF MATERIALS / EMBEDS				
CSI ID#	DESCRIPTION	QTY	UM	COMMENTS
CSANC-E	CON/SPAN WINGWALL ANCHOR (E)	2	EA	
DTJ	CERTI-VEX PENSEAL 244-40%	1.10	GA	
EM-00034	4" FOAM CORE PVC	1	FT	
EM-0005A	1" X 6" PRESET WING INSERT	2	EA	
EM-00115	UTILITY ANCHOR #8UA671-GALVANIZED	6	EA	
DTJ	REBAR #4 Z-BAR GR 60 VTAOT LEVEL II	286	LB	
DTJ	REBAR #5 Z-BAR GR 60 VTAOT LEVEL II	99	LB	
DTJ	REBAR #7 Z-BAR GR 60 VTAOT LEVEL II	350	LB	
MX-FA5000SC30	MIX DESIGN - FLY ASH 5000 SELF CONSOLIDATING	5.21	CY	

Rev.	Date	Description
10		
9		
8		
7		
6		
5	10JUL2015	ADDED VAOT BRIDGE PLAQUE
4	17JUN2015	REVISED PER CUSTOMER REVIEW
3	10JUN2015	MOVED WEEP HOLE TO 1"
2	28MAY2015	15'-1" WAS 14'-8", VARIOUS CHANGES
1	14MAY2015	REVISED PER CUSTOMER REVIEW
		DESCRIPTION
		REVISIONS
		By

Contractor is to verify that all information shown on drawings has been thoroughly checked, complies with the contract documents and is adequate to meet the field conditions. Some dimensions and details may differ from those shown on drawings. Approval of this drawing indicates that any deviation from the contract documents has been reviewed and found to be acceptable. Production will not commence until receipt of signed, approved shop drawings.

This drawing contains information proprietary to CONCRETE SYSTEMS, INC. It is to be used only for the project for which it was prepared. It is to be discarded without permission from CONCRETE SYSTEMS, INC. and that it will be returned to CONCRETE SYSTEMS, INC. upon request.

Vermont Agency of Transportation  
**RECEIVED**  
CK'D BY CLB OK'D BY HIS  
July 22, 2015  
RESUBMIT NO Approved  
BY C. CARLSON DATE 07/23/15

This drawing is based upon information provided from the following documents and/or sources:  
Engineer: STATE OF VT/AOT PROGRAM DEVELOPMENT  
Project No: _____  
Drawings: STATE OF VT/AOT PROPOSED IMPROVEMENT BRIDGE PROJECT, TOWN OF RICHFORD SHEETS 1,2,4,22,23,24 OF 36  
Specifications: STANDARD SPECIFICATIONS FOR CONSTRUCTION DATED 2011  
Other: _____

STATE AGENCY  
VTTrans  
**Concrete Systems Inc.**  
9 Commercial St., Hudson, NH, 03051  
Phone 603-889-4163  
Fax 603-889-2417


Drawn By: B. SKELTON/RV Date: 17APR2015  
Reviewed By: B. KOLAWOLE Date: _____  
Approved By: C. VICK Date: 7/10/15

G.W. TATRO CONSTRUCTION, INC.  
VT/AOT BRIDGE REPLACEMENT - ROAD IMPROVEMENT  
RICHFORD, VT.

SHOP DRAWING WW2  
C22312--WW2

Quantity: 1 Project No: BRFO30229 SHEET 5 OF 14


REV 5

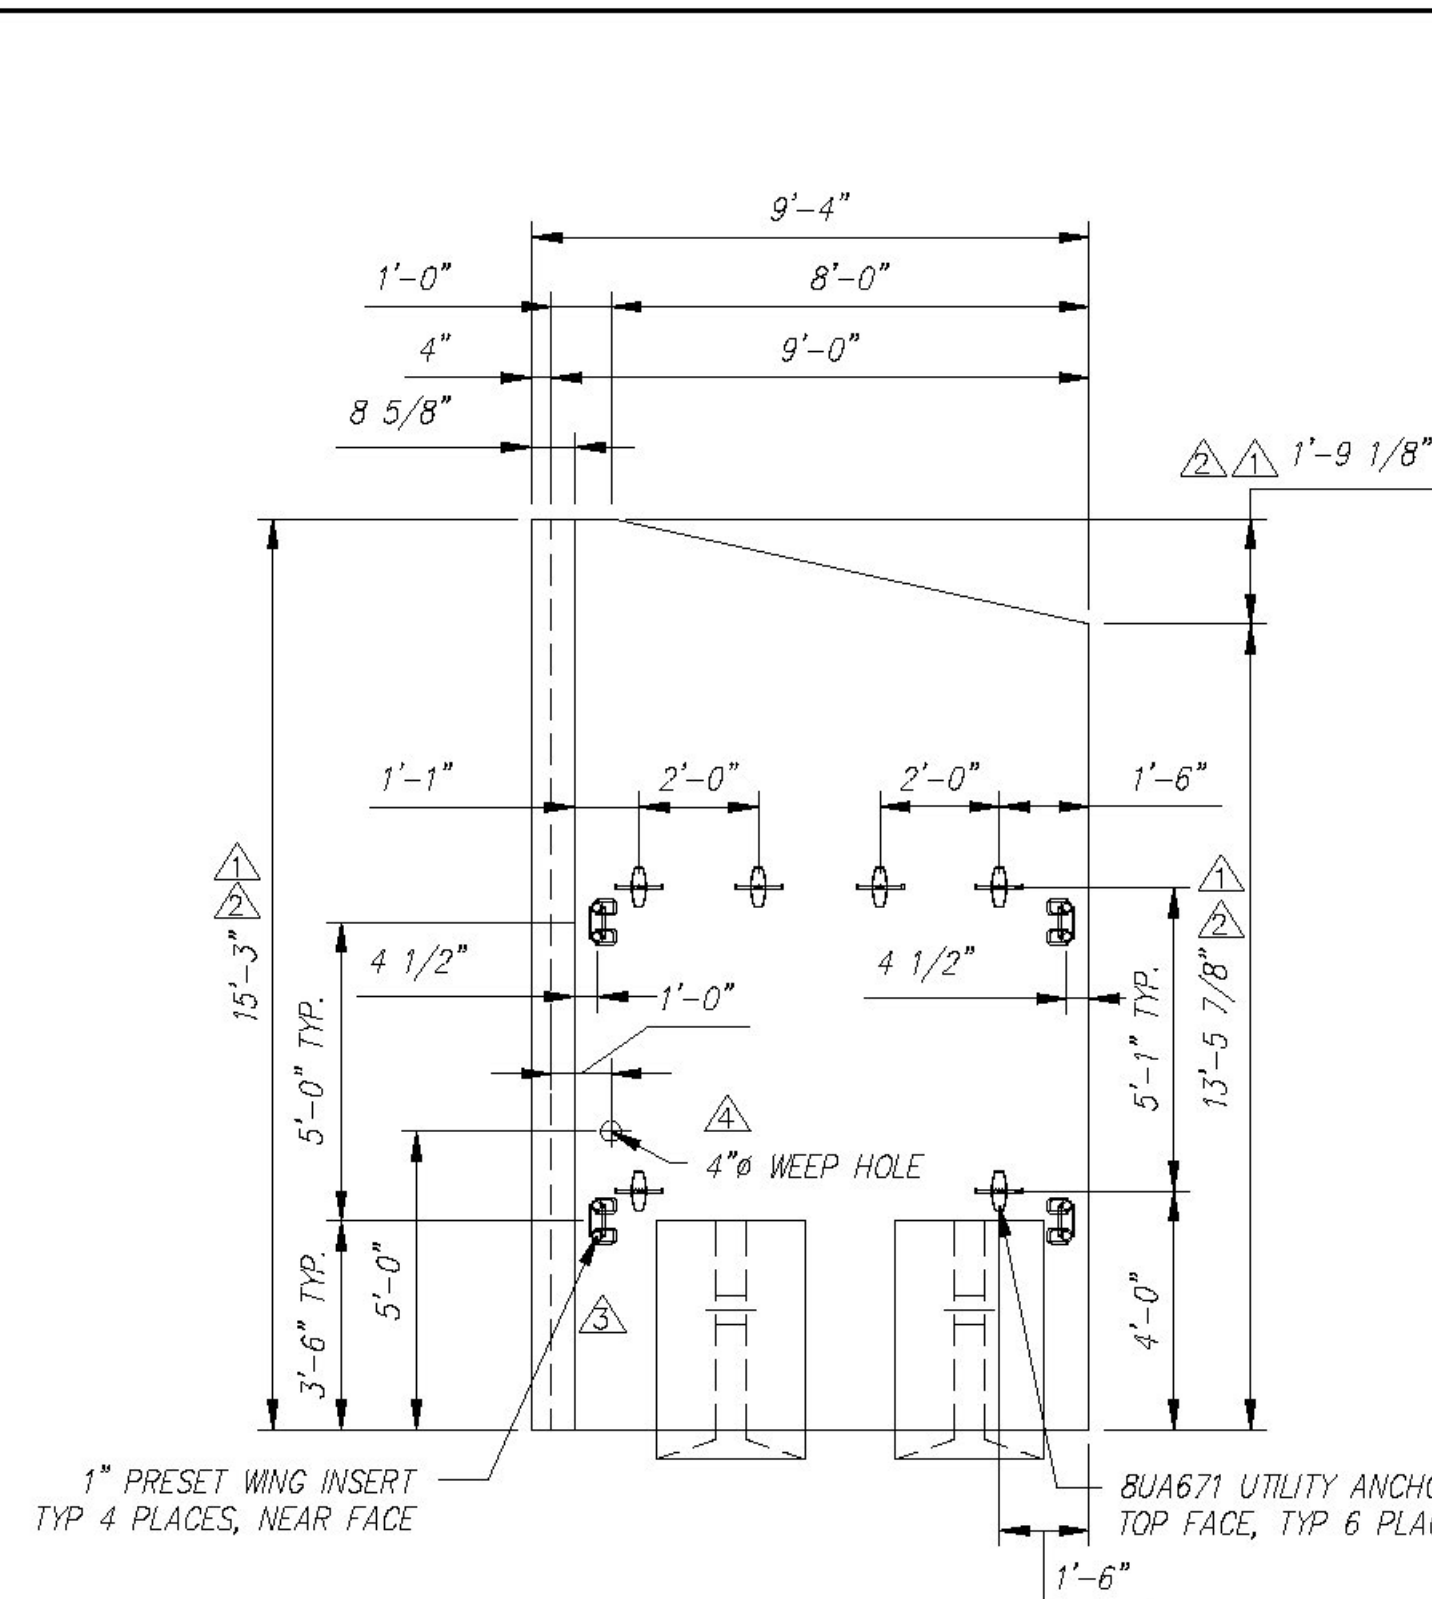

**PLAN VIEW**  
Scale: 1/4" = 1'-0"

ALL REINFORCING TO BE Z-BAR GR 60(VTAOT LEVEL 2)


ALL EXPOSED EDGES OF CONCRETE TO RECEIVE 1" CHAMFER

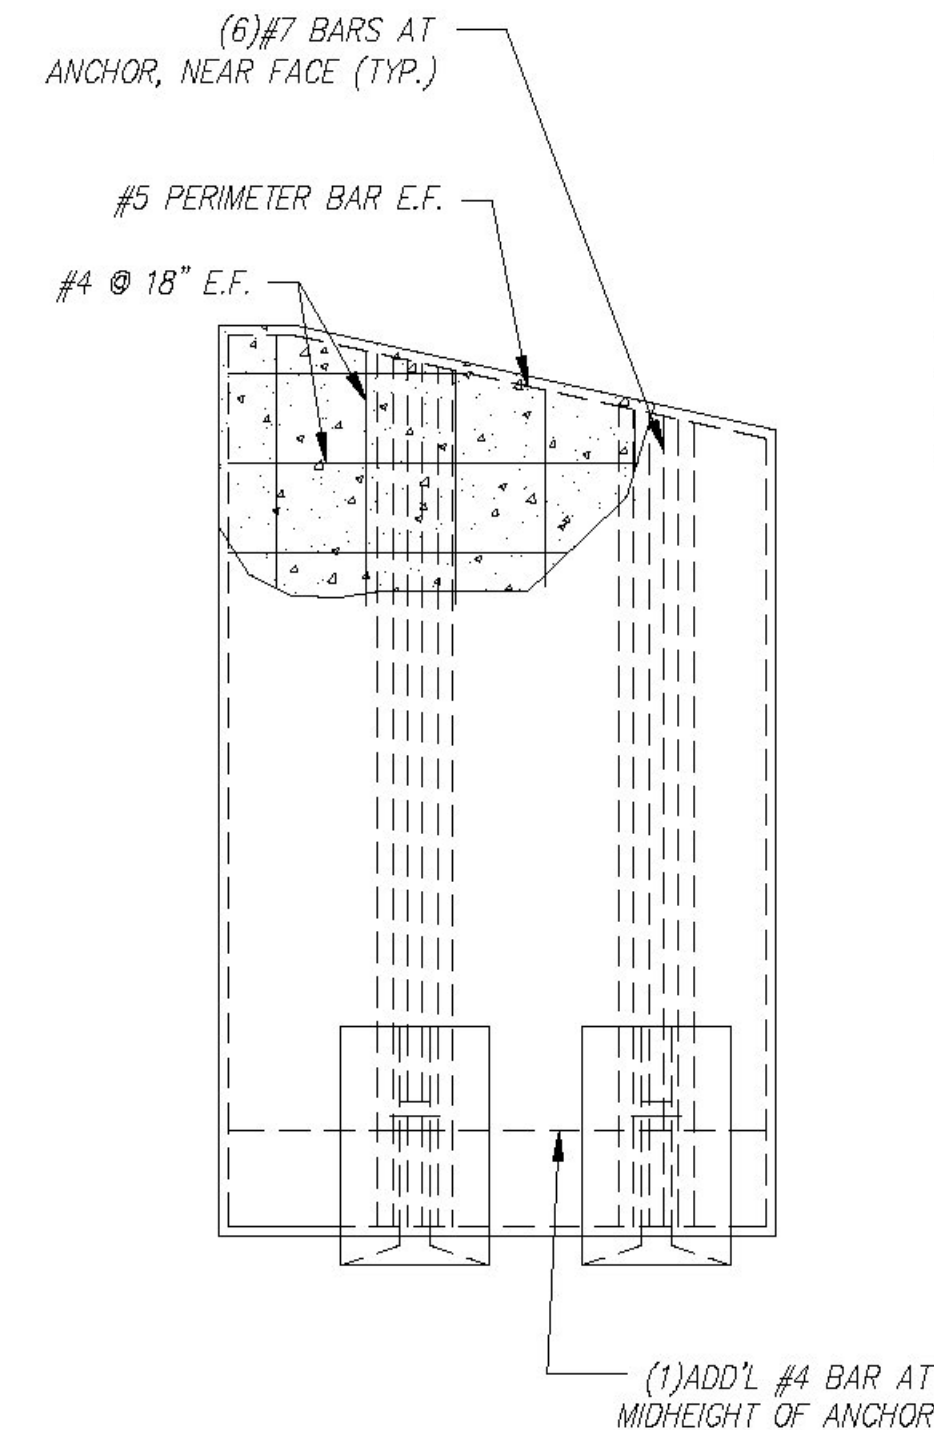


**REINFORCING DETAIL**  
Scale: 1/4" = 1'-0"

QUANTITY = 1  
WEIGHT = 12.21 TONS

WW3A - BILL OF MATERIALS / EMBEDS			
CSI ID#	DESCRIPTION	QTY	UM COMMENTS
CSANC-E	CON/SPAN WINGWALL ANCHOR (E)	2	EA
DTJ	CERTI-VEX PENSEAL 244-40%	1.00	GA
EM-00034	4" FOAM CORE PVC	1	FT
EM-0005A	1" X 6" PRESET WING INSERT	4	EA
EM-00115	UTILITY ANCHOR #8UA671-GALVANIZED	6	EA
DTJ	REBAR #4 Z-BAR GR 60 VTAOT LEVEL II	252	LB
DTJ	REBAR #5 Z-BAR GR 60 VTAOT LEVEL II	96	LB
DTJ	REBAR #7 Z-BAR GR 60 VTAOT LEVEL II	358	LB
MX-FA5000SC30	MIX DESIGN - FLY ASH 5000 SELF CONSOLIDATING	4.89	CY

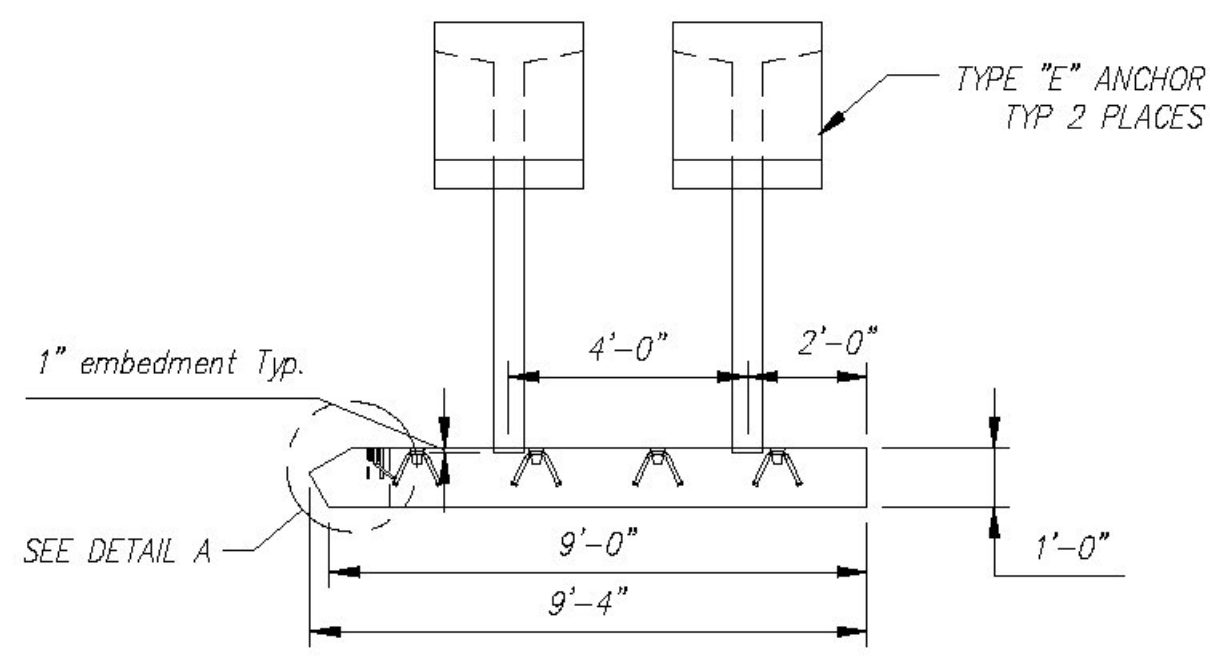

**FRONT ELEVATION**  
Scale: 1/4" = 1'-0"

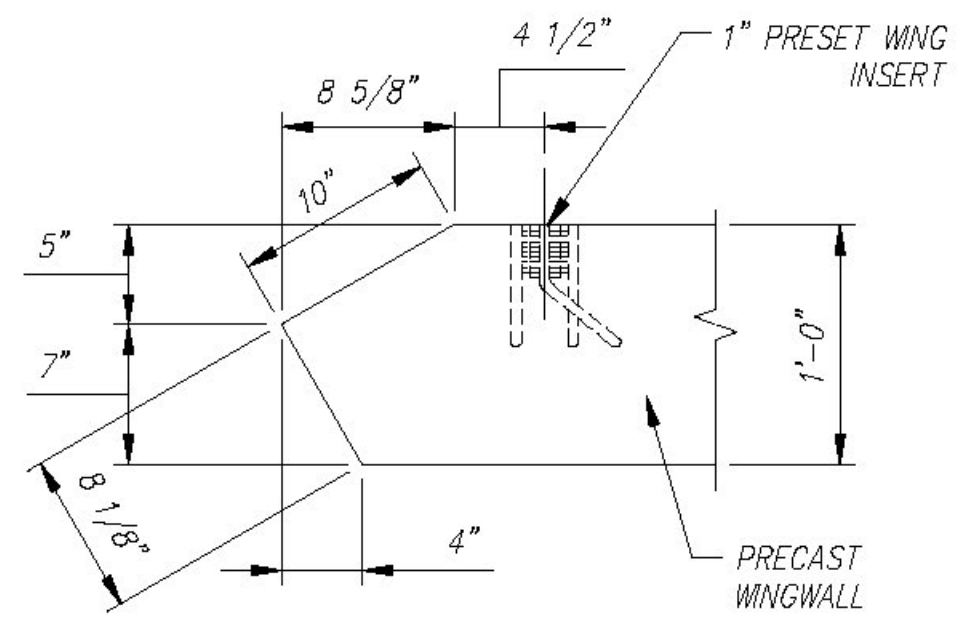

**DETAIL A**  
Scale: N.T.S.

Rev.	Date	Description
1	14MAY2015	REVISED PER CUSTOMER REVIEW
2	28MAY2015	15'-3" WAS 14'-10 3/8", 13'-5 7/8" WAS 13'-3 3/8", VARIOUS CHANGES
3	10JUN2015	MOVED WEEP HOLE TO 1'
4	17JUN2015	REVISED PER CUSTOMER REVIEW

Contractor is to verify that all information shown on drawings has been thoroughly checked, complies with the contract documents and is adequate to meet the field conditions. Some dimensions and details may differ from those shown on drawings. Approval of this drawing indicates that any deviation from the contract documents has been reviewed and found to be acceptable. Production will not commence until receipt of signed, approved shop drawings.

This drawing contains information proprietary to CONCRETE SYSTEMS, INC. It is to be used only for the project and site for which it was prepared. It is disclosed without permission from CONCRETE SYSTEMS, INC. and that it will be returned to CONCRETE SYSTEMS, INC. upon request.

Vermont Agency of Transportation  
**RECEIVED**  
CK'D BY CLB OK'D BY HIS  
July 22, 2015  
RESUBMIT NO Approved  
BY C. CARLSON DATE 07/23/15

This drawing is based upon information provided from the following documents and/or sources:  
 Engineer: STATE OF VT/AOT PROGRAM DEVELOPMENT  
 Project No: _____  
 Drawings: STATE OF VT/AOT PROPOSED IMPROVEMENT BRIDGE PROJECT, TOWN OF RICHFORD SHEETS 1,2,4,22,23,24 OF 36  
 Specifications: STANDARD SPECIFICATIONS FOR CONSTRUCTION DATED 2011  
 Other: _____

STATE AGENCY  
  
**Concrete Systems Inc.**  
 9 Commercial St., Hudson, NH, 03051  
 Phone 603-889-4163  
 Fax 603-889-2417

Drawn By: B. SKELTON/RY Date: 17APR2015  
 Reviewed By: B. KOLAWOLE Date: _____  
 Approved By: C. VICK Date: 17JUN2015


G.W. TATRO CONSTRUCTION, INC.  
 VT/AOT BRIDGE REPLACEMENT- ROAD IMPROVEMENT  
 RICHFORD, VT.

SHOP DRAWING WW3A  
 C22312--WW3A

Quantity: 1 Project No: BRFO30229 SHEET 6 OF 14


REV	DESCRIPTION
4	SHOP DRAWING WW3A



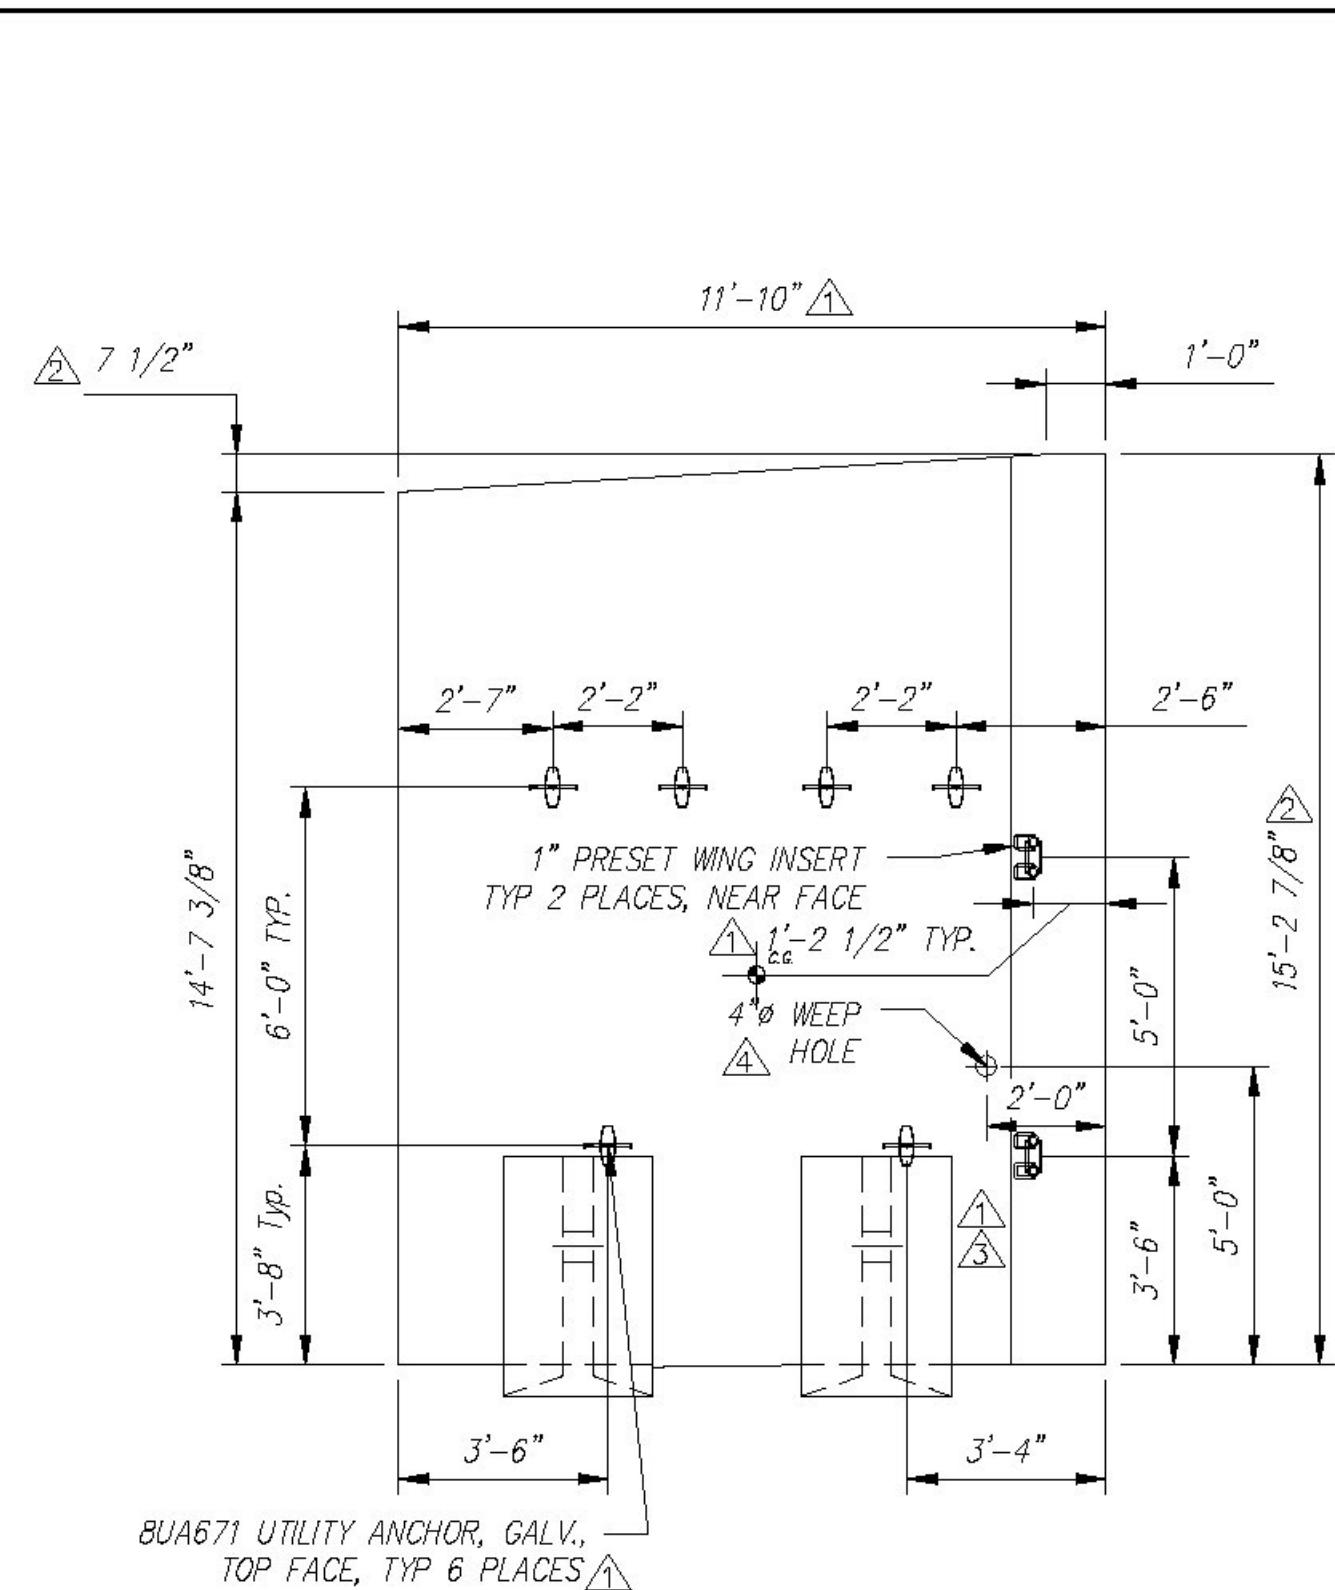

PLAN VIEW  
Scale: 1/4" = 1'-0"

ALL REINFORCING TO BE Z-BAR GR 60(VTAOT LEVEL 2)

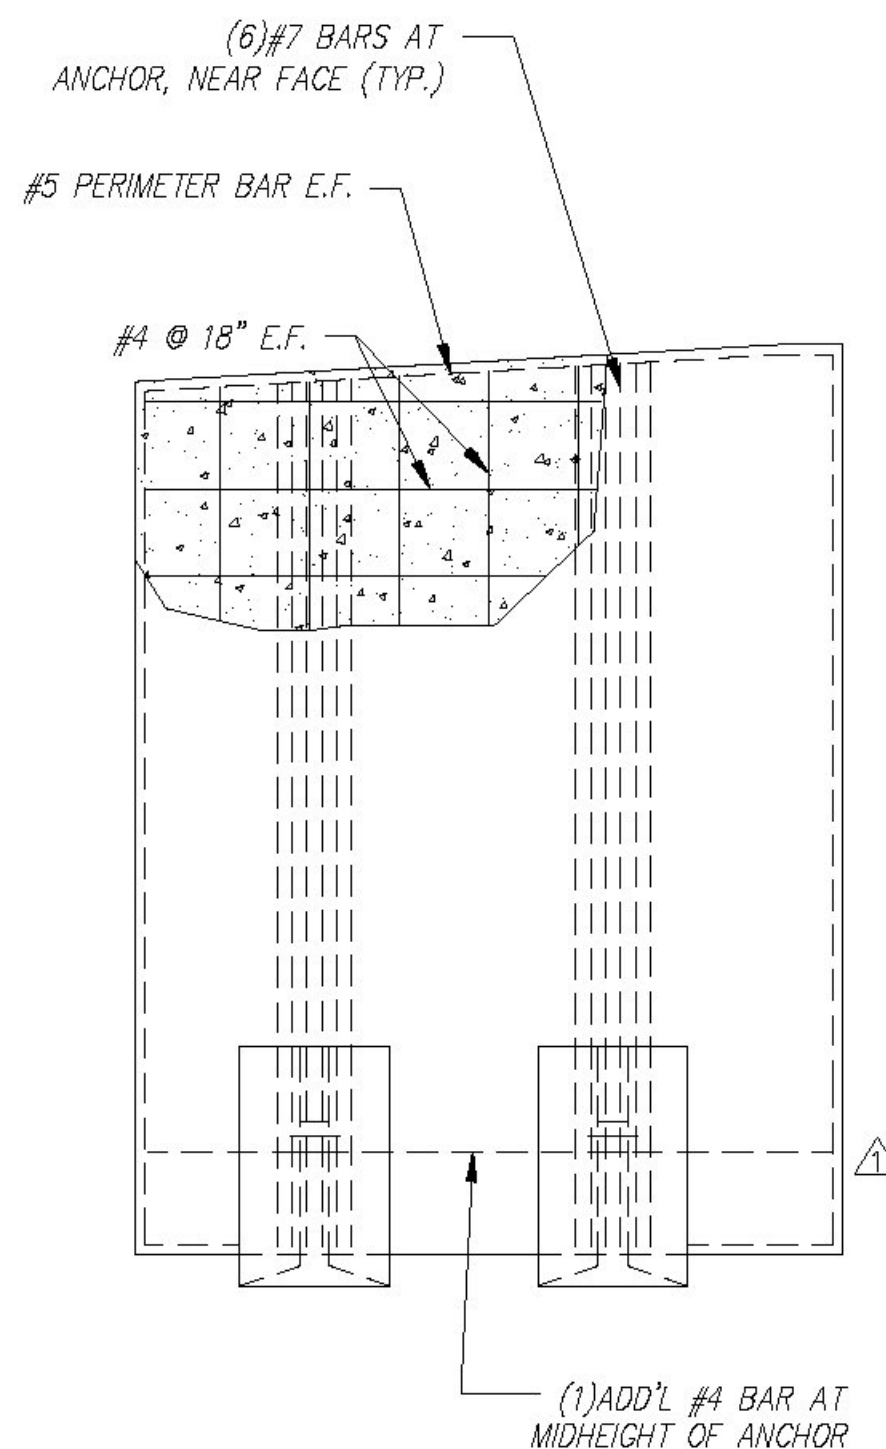


REINFORCING DETAIL  
Scale: 1/4" = 1'-0"

QUANTITY = 1  
WEIGHT = 16.47 TONS

WW4 - BILL OF MATERIALS / EMBEDS				
CSI ID#	DESCRIPTION	QTY	UM	COMMENTS
CSANC-E	CONSPAN WINGWALL ANCHOR (E)	2	EA	
DTJ	CERTI-VEX PENSEAL 244-40%	1.20	GA	
EM-00034	4" FOAM CORE PVC	1	FT	
EM-0005A	1" X 6" PRESET WING INSERT	2	EA	
EM-00115	UTILITY ANCHOR #8UA671-GALVANIZED	6	EA	
DTJ	REBAR #4 Z-BAR GR 60 VTAOT LEVEL II	305	LB	
DTJ	REBAR #5 Z-BAR GR 60 VTAOT LEVEL II	108	LB	
DTJ	REBAR #7 Z-BAR GR 60 VTAOT LEVEL II	356	LB	
MX-FA5000SC30	MIX DESIGN - FLY ASH 5000 SELF CONSOLIDATING	6.99	CY	

BUA671 UTILITY ANCHOR, GALV., TOP FACE, TYP 6 PLACES

ALL EXPOSED EDGES OF CONCRETE TO RECEIVE 1" CHAMFER

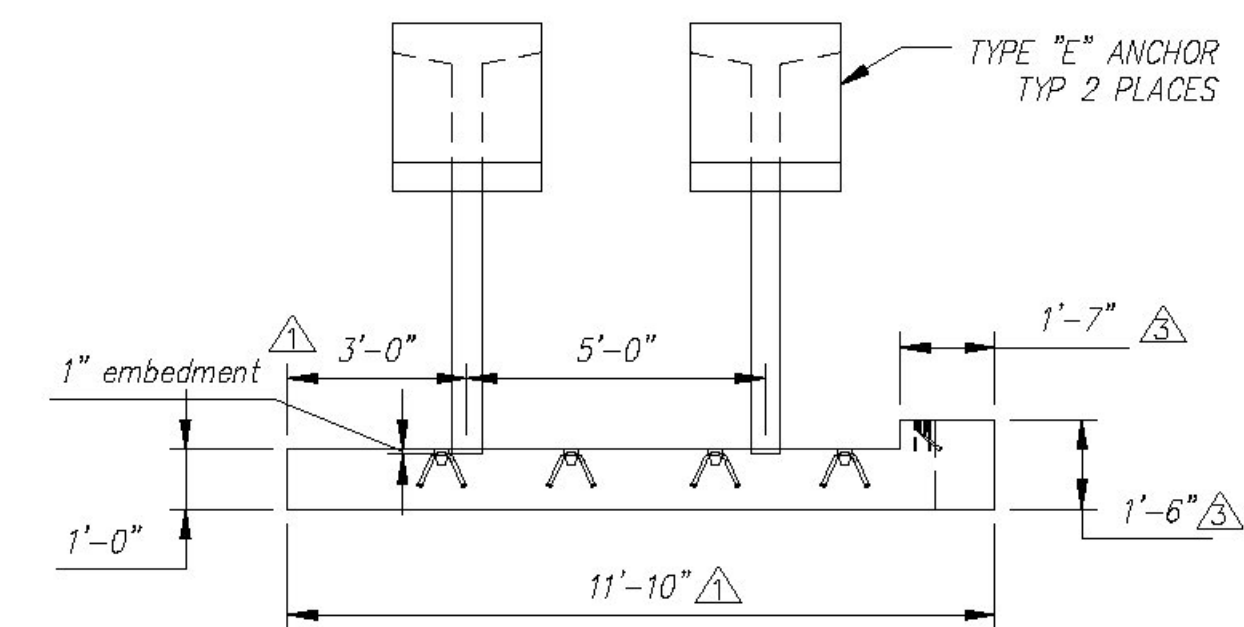

FRONT ELEVATION  
Scale: 1/4" = 1'-0"

Rev.	Date	DESCRIPTION	By
10			
9			
8			
7			
6			
5			
4	17JUN2015	REVISED PER CUSTOMER REVIEW	BSS
3	10JUN2015	ADDED 6" STANDOFF	RY
2	04JUN2015	REVISED PER CUSTOMER REVIEW	RY
1	14MAY2015	REVISED PER CUSTOMER REVIEW	RY

Contractor is to verify that all information shown on drawings has been thoroughly checked, complies with the contract documents and is adequate to meet the field conditions. Some dimensions and details may differ from those shown on drawings. Approval of this drawing indicates that any deviation from the contract documents has been reviewed and found to be acceptable. Production will not commence until receipt of signed, approved shop drawings.

This drawing contains information proprietary to CONCRETE SYSTEMS, INC. It is disclosed with the understanding that it will be retained in confidence and not be used for any other project without the written authorization of CONCRETE SYSTEMS, INC. and that it will be returned to CONCRETE SYSTEMS, INC. upon request.

Vermont Agency of Transportation  
**RECEIVED**

CK'D BY CLB OK'D BY HIS

July 22, 2015


RESUBMIT NO Approved  
BY C. CARLSON DATE 07/23/15

This drawing is based upon information provided from the following documents and/or sources:  
 Engineer: STATE OF VT/AOT PROGRAM DEVELOPMENT  
 Project No: ----  
 Drawings: STATE OF VT/AOT PROPOSED IMPROVEMENT BRIDGE PROJECT, TOWN OF RICHFORD SHEETS 1,2,4,22,23,24 OF 36  
 Specifications: STANDARD SPECIFICATIONS FOR CONSTRUCTION DATED 2011  
 Other: ----


**CSI**  
Concrete Systems Inc.  
9 Commercial St., Hudson, NH, 03051  
Phone 603-889-4163  
Fax 603-889-2417

STATE AGENCY  
**VTtrans**  
 Drawn By: B. SKELTON/RY Date: 17APR2015  
 Reviewed By: B. KOLAWOLE Date: ----  
 Approved By: C. VICK Date: 17JUN2015


G.W. TATRO CONSTRUCTION, INC.  
VT/AOT BRIDGE REPLACEMENT- ROAD IMPROVEMENT RICHFORD, VT.  
 Drawing No. SHOP DRAWING WW4  
 C22312--WW4  
 Quantity: 1 Project No: BRFO30229 SHEET 8 OF 14  
 REV 4

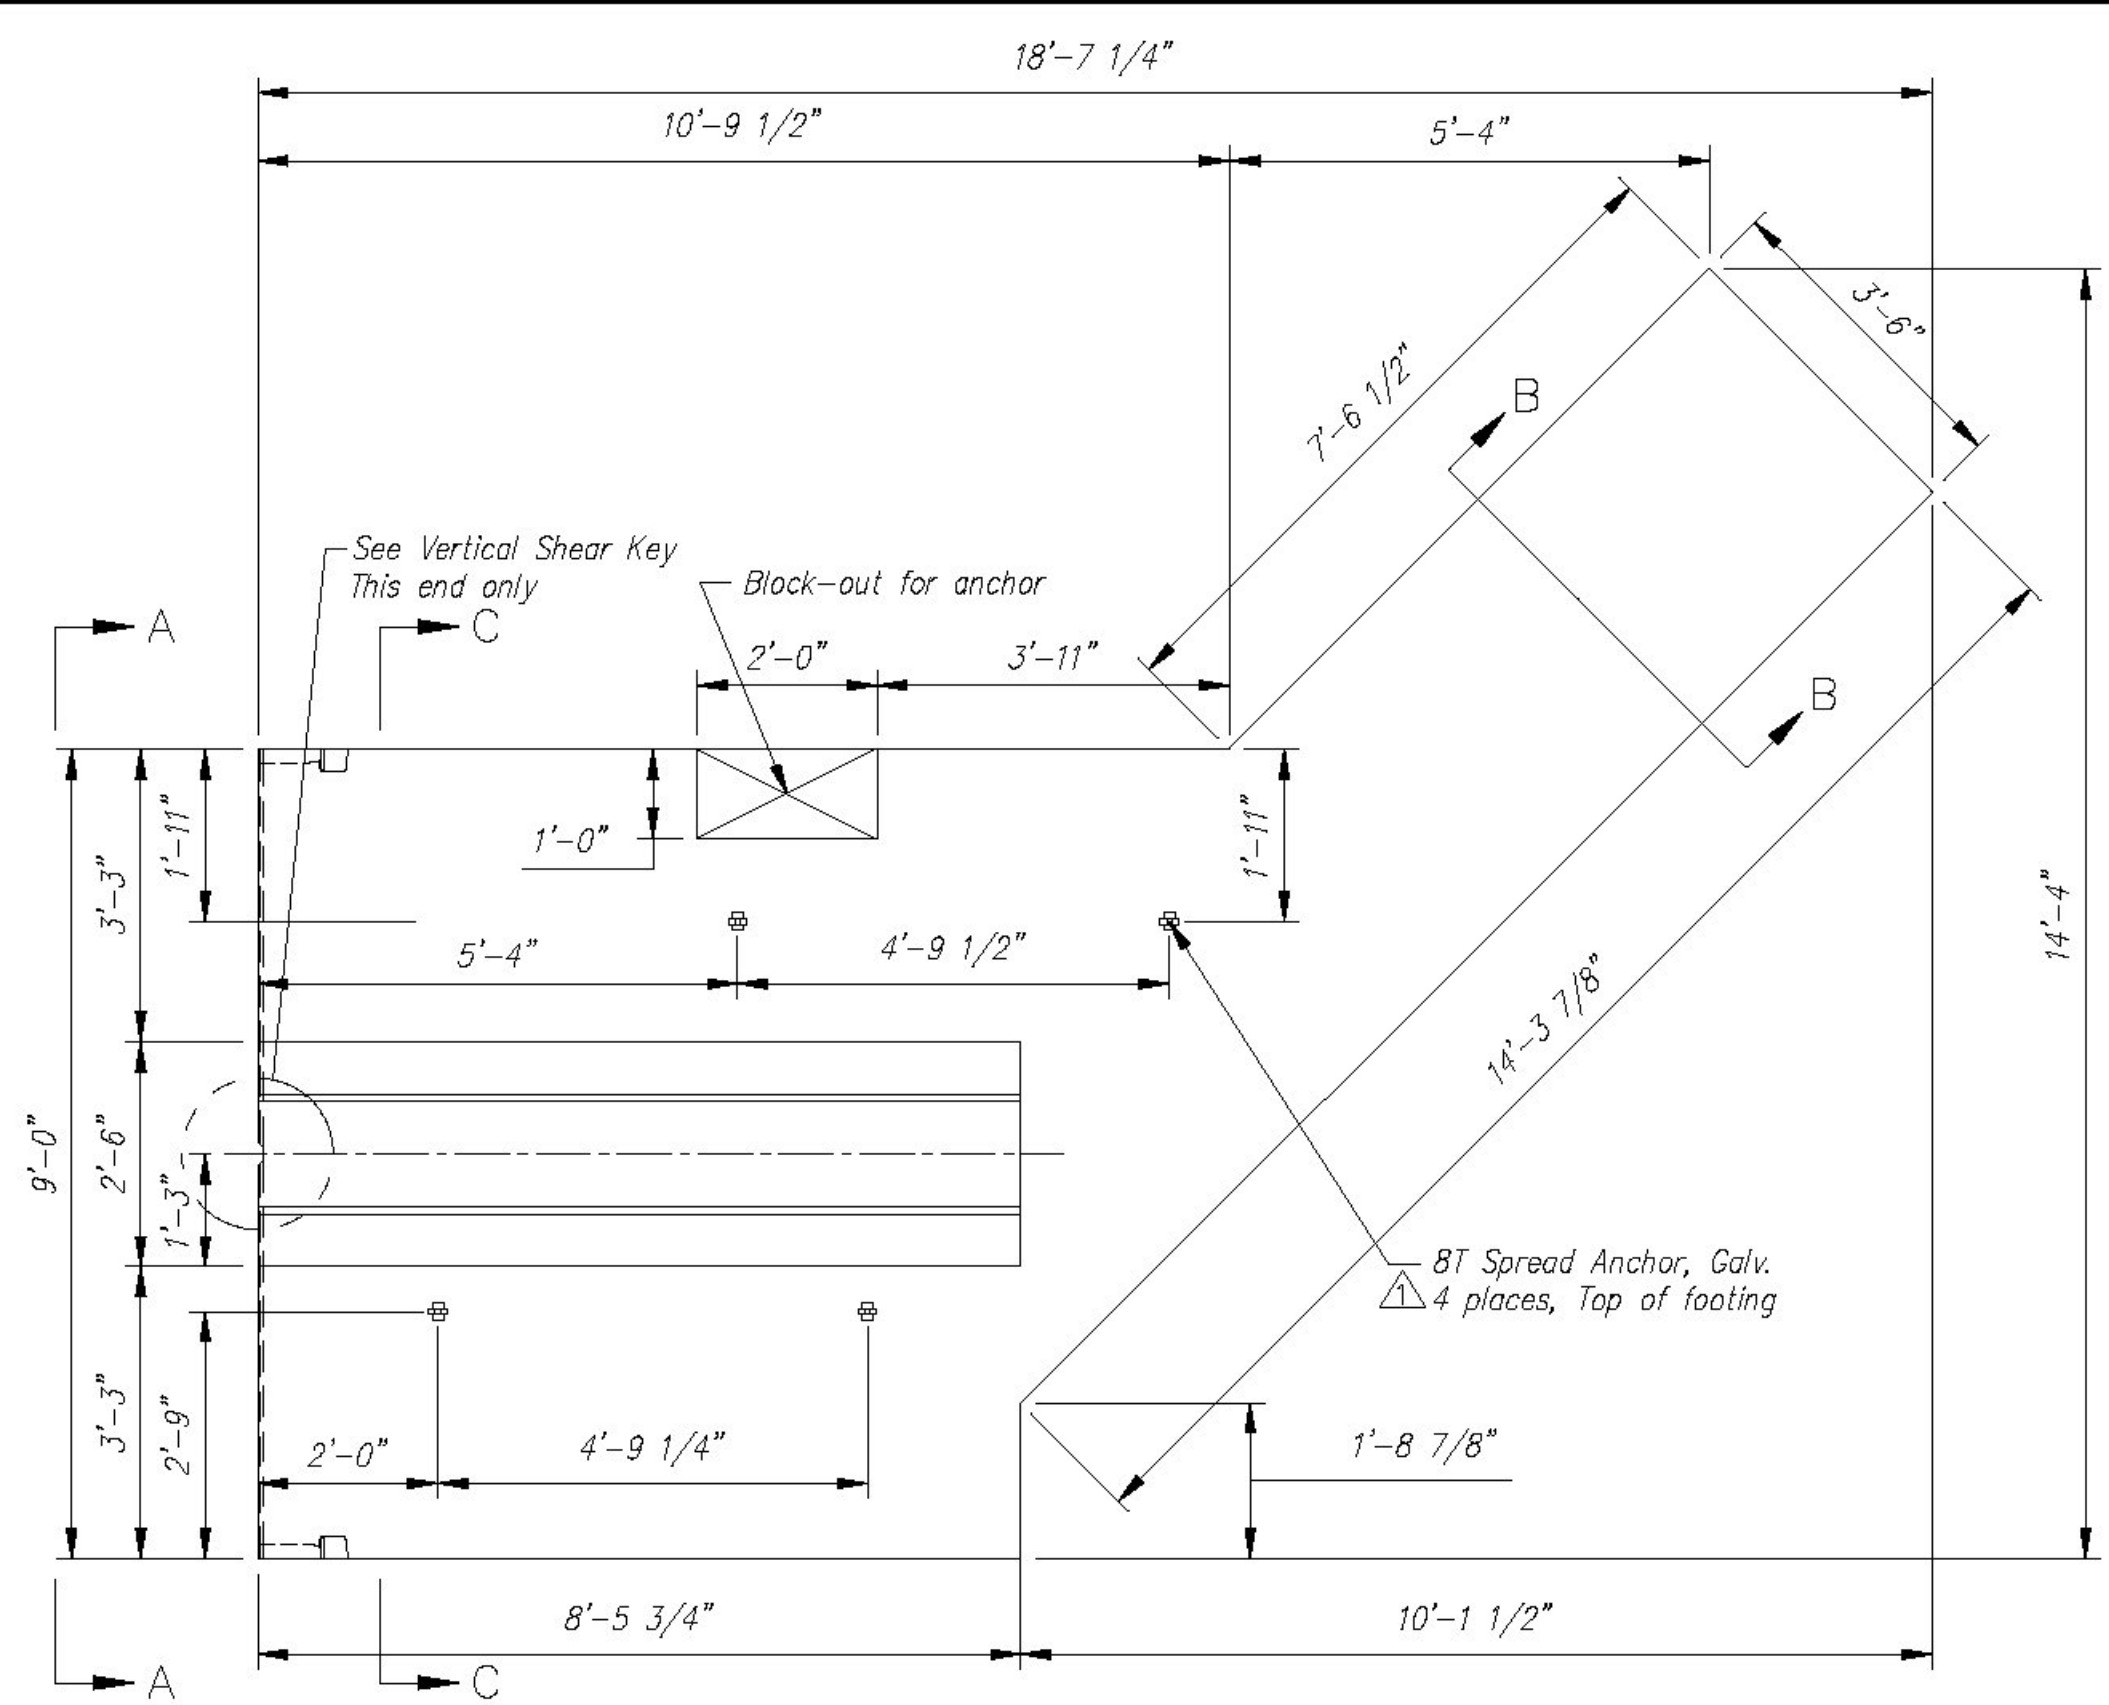


PLAN VIEW  
Scale: 3/8" = 1'-0"

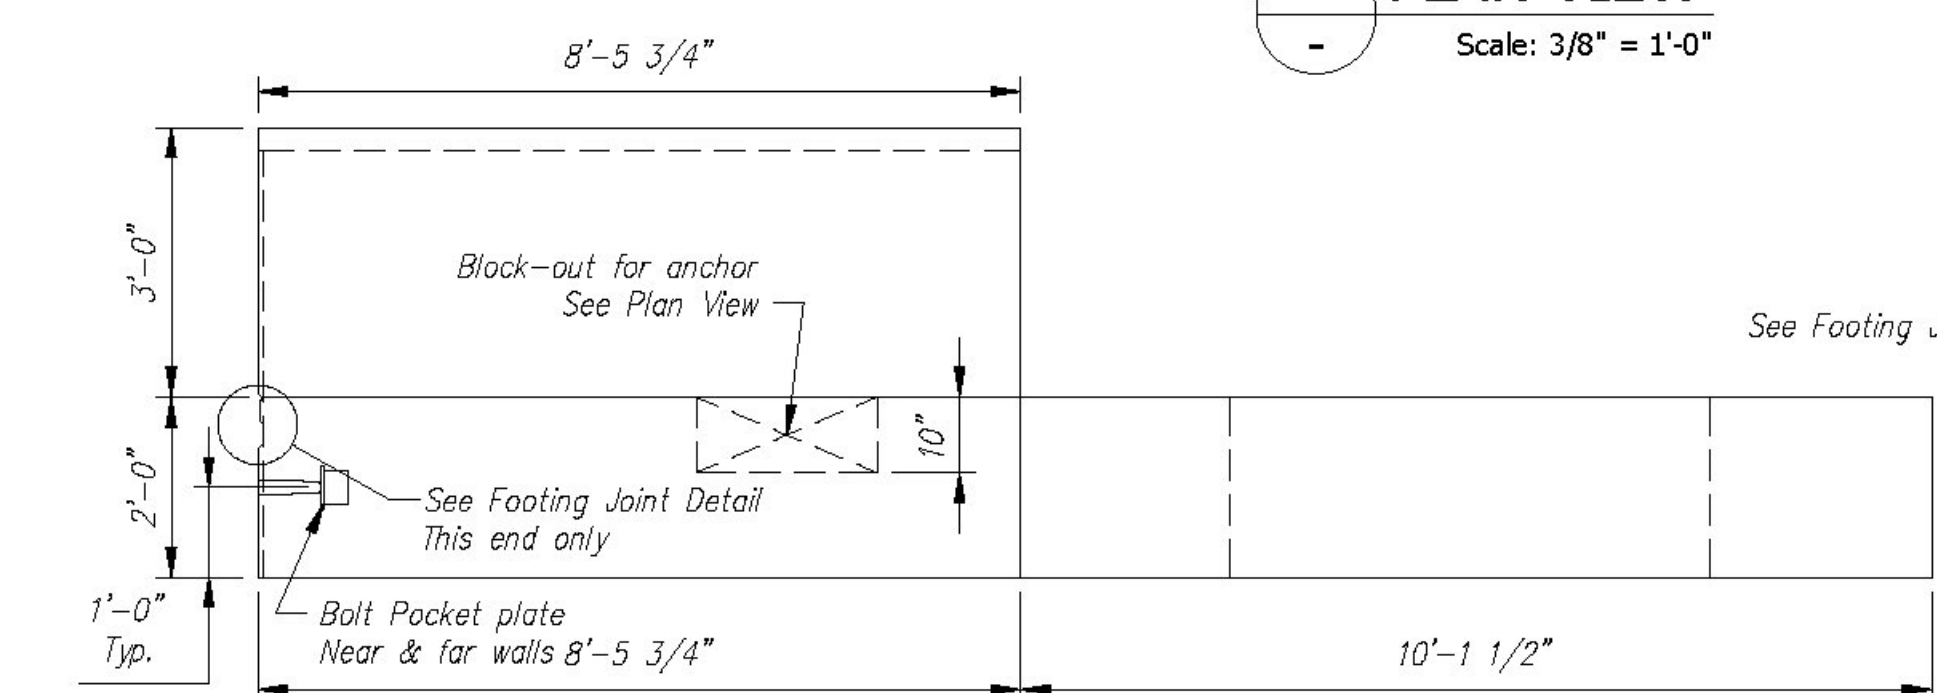


ELEVATION  
Scale: 3/8" = 1'-0"

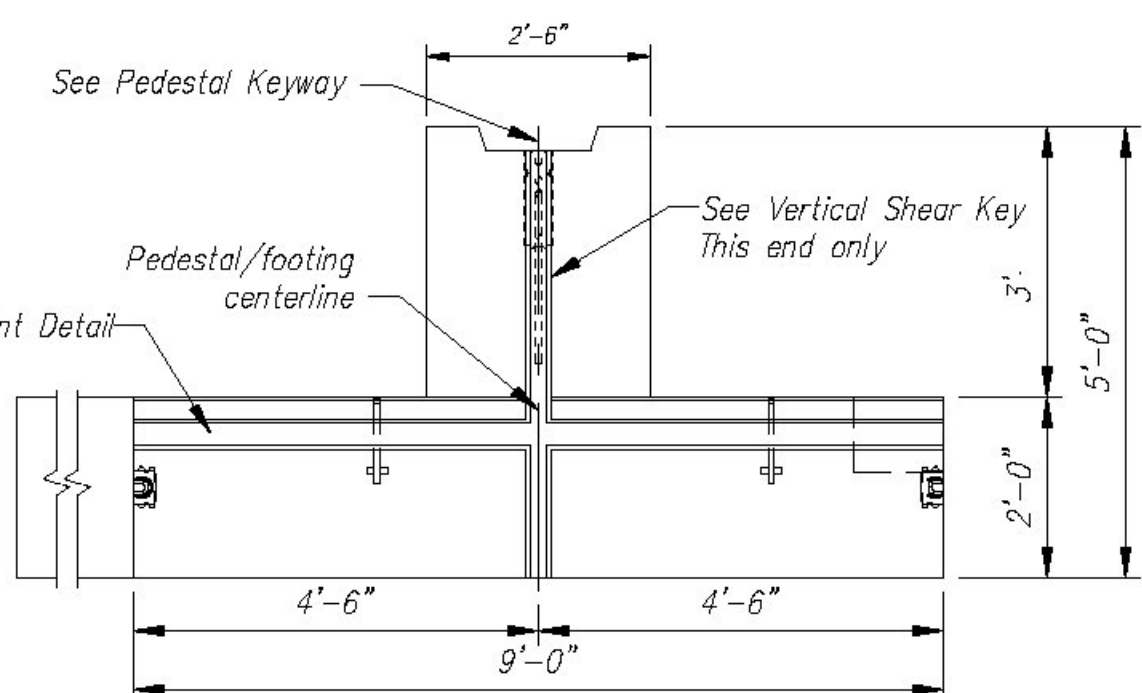


ELEVATION A-A  
Scale: 3/8" = 1'-0"

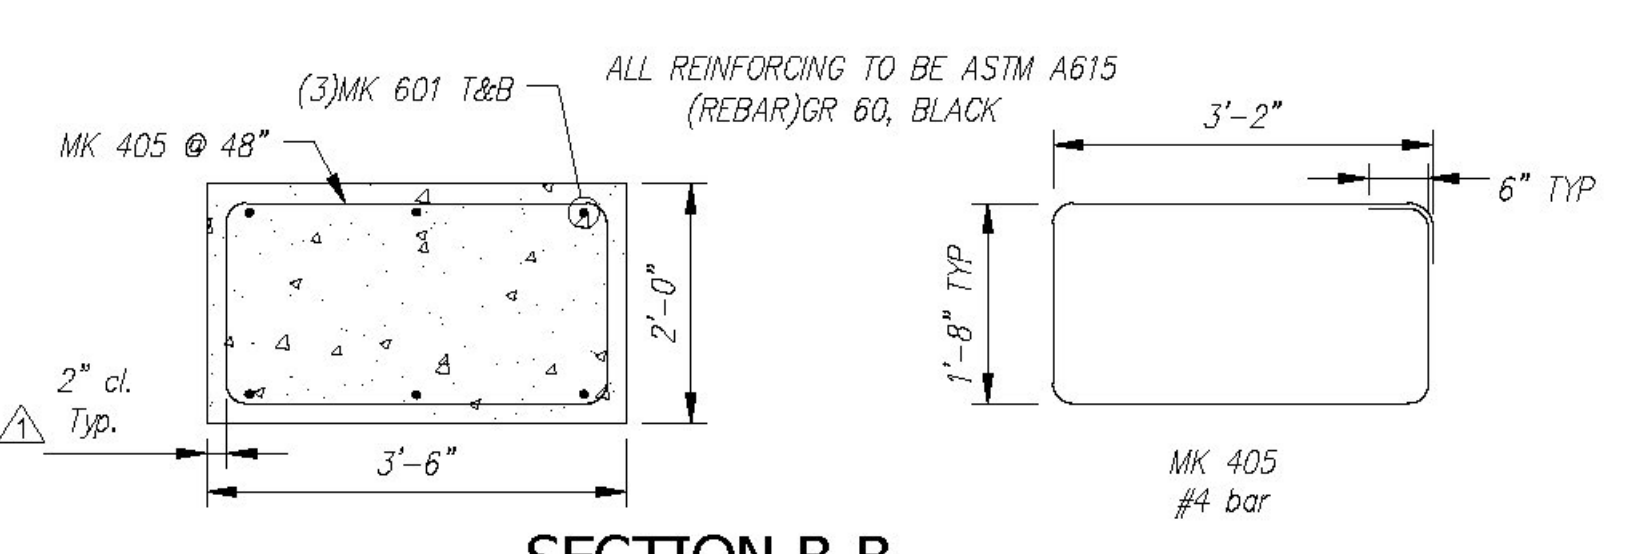


SECTION B-B  
REINFORCING DETAIL  
Scale: N.T.S.

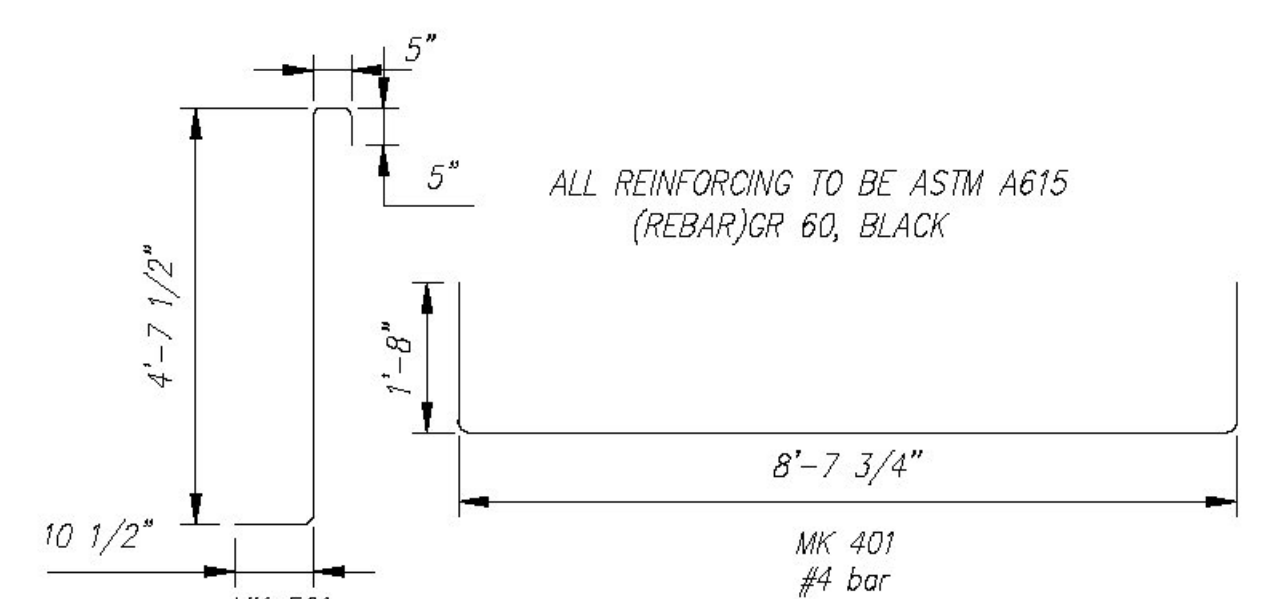


BENDING SCHEDULE  
Scale: N.T.S.

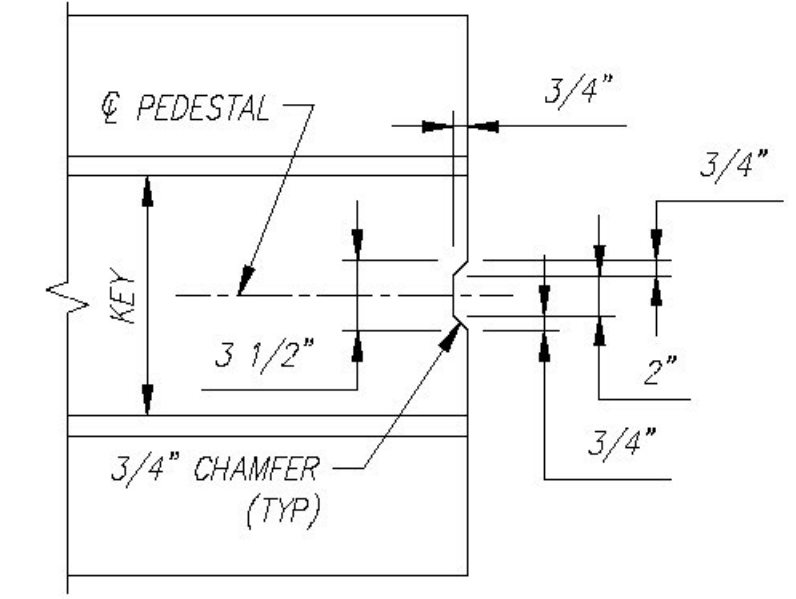


VERTICAL SHEAR KEY  
Scale: N.T.S.

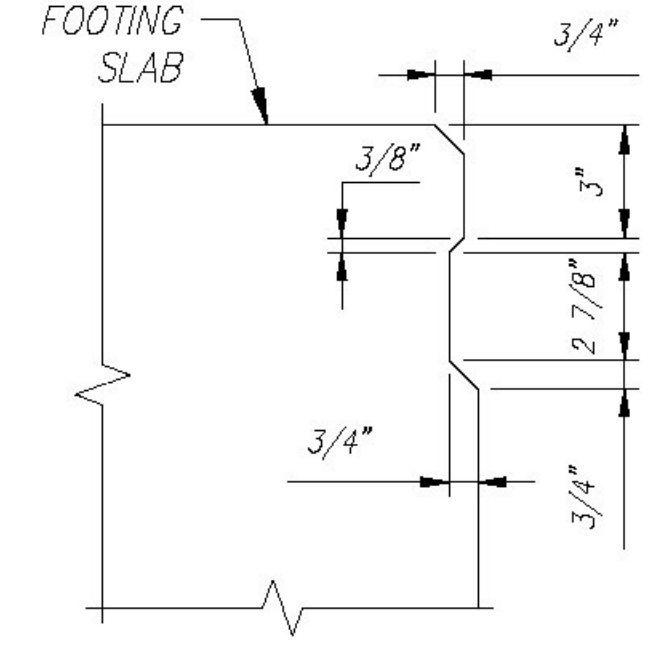

JOINT DETAIL  
Scale: N.T.S.

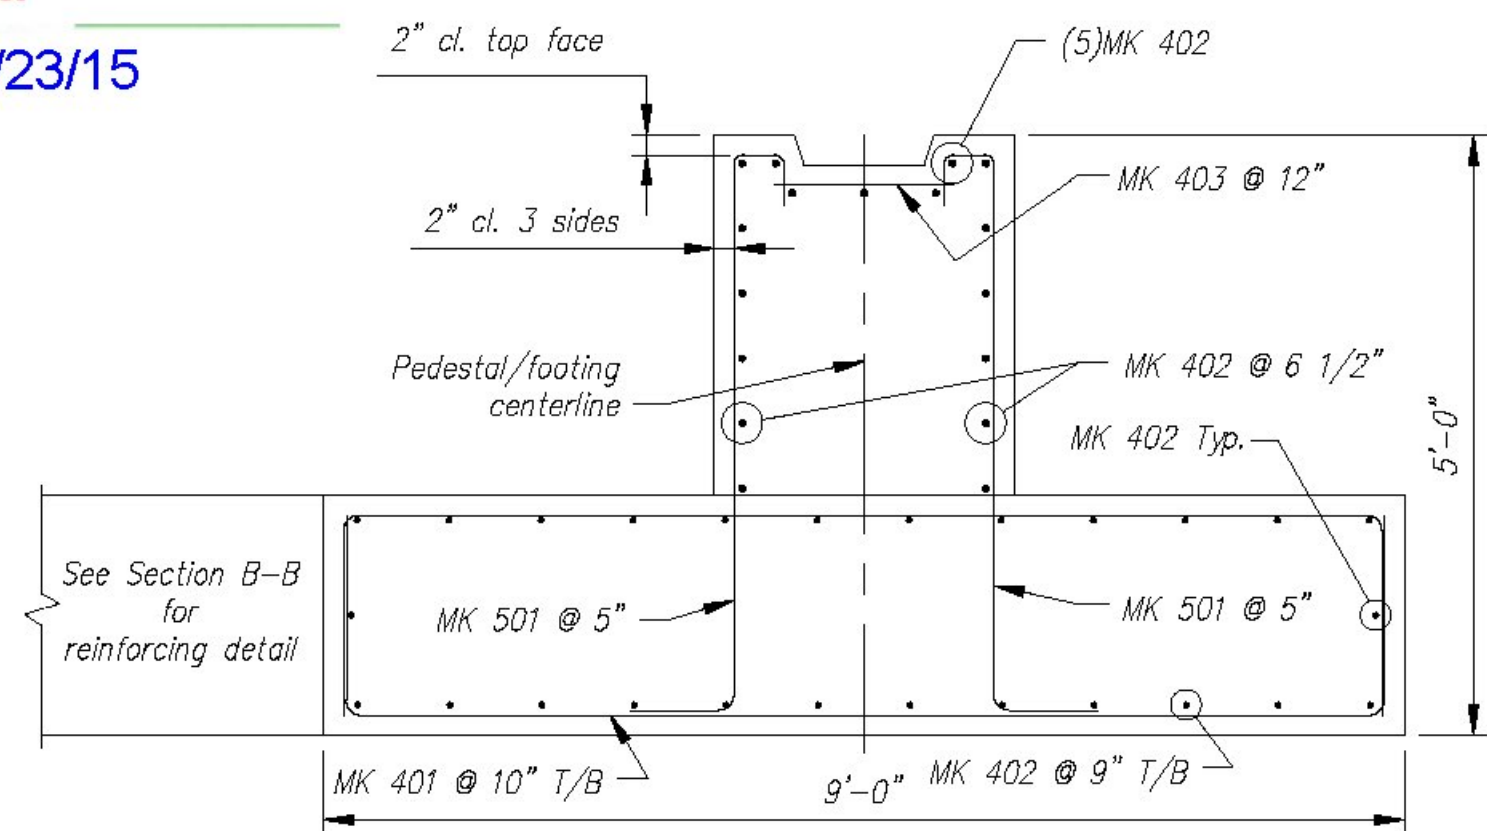

SECTION C-C  
REINFORCING DETAIL  
Scale: N.T.S.

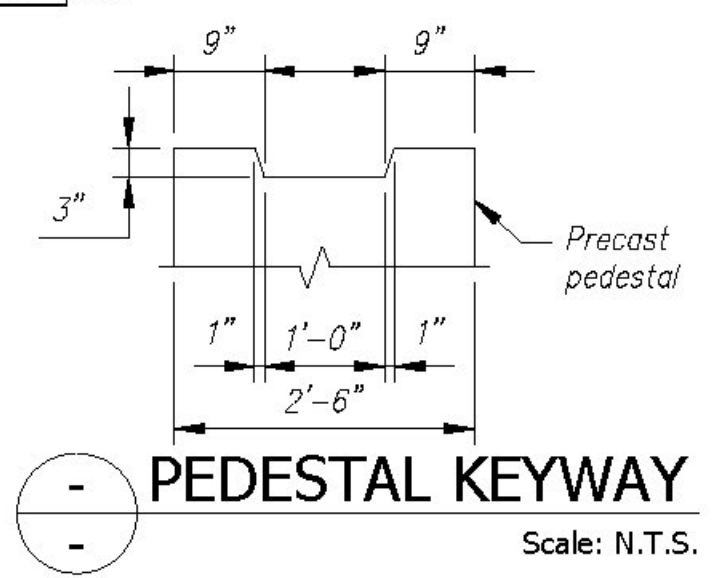

PEDESTAL KEYWAY  
Scale: N.T.S.

QUANTITY = 1  
WEIGHT = 23.02 TONS

FOOTING SLAB - F1 - BILL OF MATERIALS / EMBEDS			
GSI ID#	DESCRIPTION	QTY	UM / COMMENTS
EM-00078	8T SPREAD ANCHOR #FL119/P94	4	EA
EM-00125	BOLT POCKET PLATE (GALVANIZED)	2	EA
RM-00013	REBAR #4 BLACK- GR 60	424	LB
RM-00015	REBAR #5 BLACK-GR 60 40'	264	LB
RM-00017	REBAR #6 BLACK-GR 60 40'	128	LB
MX-FA5000SC30	MIX DESIGN - FLY ASH 5000 SELF CONSOLIDATING	9.11	CY
FOOTING PEDESTAL - F1 - BILL OF MATERIALS / EMBEDS			
GSI ID#	DESCRIPTION	QTY	UM / COMMENTS
RM-00013	REBAR #4 BLACK- GR 60	104	LB
MX-FA5000SC30	MIX DESIGN - FLY ASH 5000 SELF CONSOLIDATING	2.26	CY

Fig. Slab - F1 Rebar Schedule		
MK	QTY	LENGTH
401 #4	26	12'-0" MAX
402 #4	26	10'-9" MAX
405 #4	4	10'-8" MAX
501 #5	40	6'-4" MAX
601 #6	6	14'-3" MAX

Fig. Pedestal-F1 Rebar Schedule		
MK	QTY	LENGTH
402 #4	17	8'-3" MAX
403 #4	9	1'-8" MAX

Vermont Agency of Transportation  
**RECEIVED**  
CK'D BY CLB OK'D BY HIS  
July 22, 2015  
RESUBMIT NO Approved  
BY C. CARLSON DATE 07/23/15

REV.	DESCRIPTION	DATE
10		
9		
8		
7		
6		
5		
4		
3		
2		
1	REVISED PER CUSTOMER REVIEW, REVISED ANCHOR LOCATIONS	14MAY2015

Contractor is to verify that all information shown on drawings has been thoroughly checked, complies with the contract documents and is adequate to meet the field conditions. Some dimensions and details may differ from those shown on drawings. Approval of this drawing indicates that any deviation from the contract documents has been reviewed and found to be acceptable. Production will not commence until receipt of signed, approved shop drawings.

This drawing contains information proprietary to CONCRETE SYSTEMS, INC. It is to be used only for the project for which it was prepared. It is to be kept confidential and its use for any other project is unauthorized without permission from CONCRETE SYSTEMS, INC. and that it will be returned to CONCRETE SYSTEMS, INC. upon request.

This drawing is based upon information provided from the following documents and/or sources:  
 Engineer: STATE OF VT/AOT PROGRAM DEVELOPMENT  
 Project No: _____  
 Drawings: STATE OF VT/AOT PROPOSED IMPROVEMENT BRIDGE PROJECT, TOWN OF RICHFORD SHEETS 1,2,4,22,23,24 OF 36  
 Specifications: STANDARD SPECIFICATIONS FOR CONSTRUCTION DATED 2011  
 Other: _____

STATE AGENCY  
**VTTrans**

**Concrete Systems Inc.**  
 9 Commercial St., Hudson, NH, 03051  
 Phone 603-889-4163  
 Fax 603-889-2417

Drawn By R. YEAGER	Date 16APR2015
Reviewed By B. KOLAWOLE	Date 17JUN2015
Approved By C. VICK	Date 17JUN2015

G.W. TATRO CONSTRUCTION, INC.  
 VT/AOT BRIDGE REPLACEMENT - ROAD IMPROVEMENT  
 RICHFORD, VT.

SHOP DRAWING F1  
 C22312-F1

Quantity: 1	Project No: BRFO30229	REV 1
-------------	-----------------------	----------

SHEET 9 OF 14






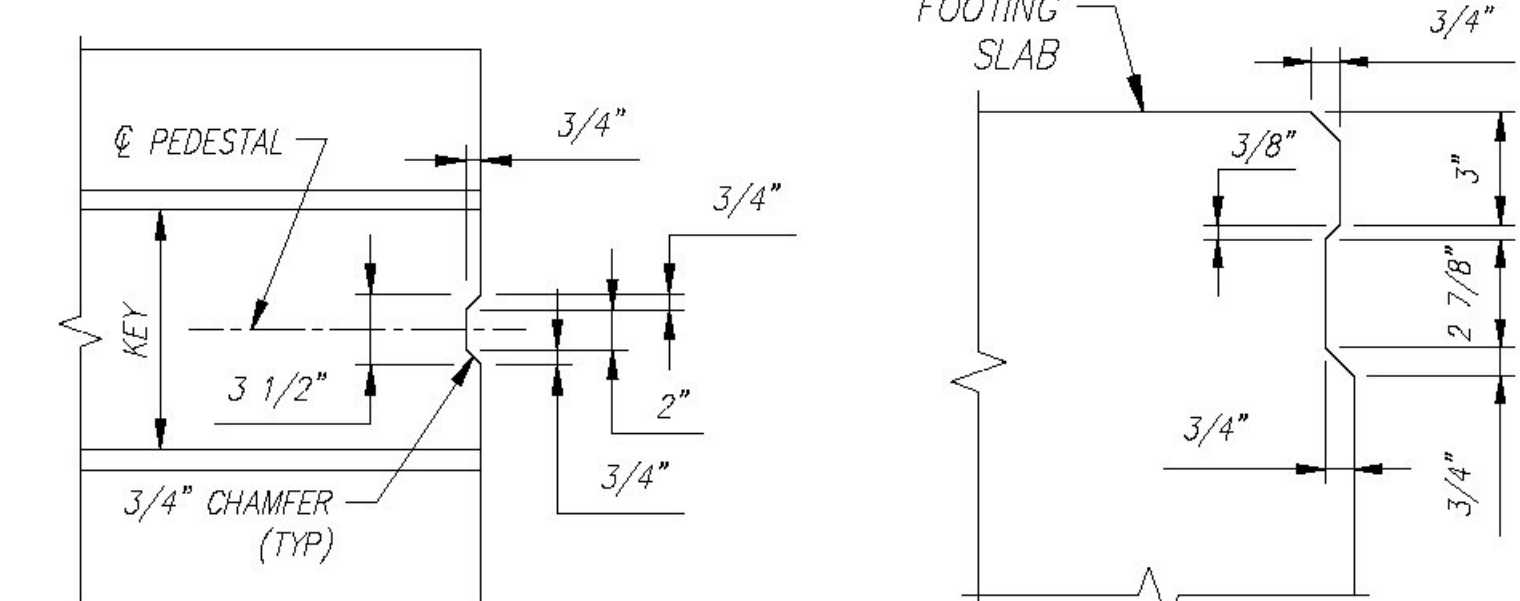
Fig. Slab - F2 Rebar Schedule			
MK	QTY	LENGTH	
401 #4	26	12'-0"	
402 #4	26	10'-9"	MAX
405 #4	4	10'-8"	
501 #5	40	6'-4"	
601 #6	6	12'-3"	MAX

Fig. Pedestal-F2 Rebar Schedule			
MK	QTY	LENGTH	
402 #4	17	8'-3"	
403 #4	9	1'-8"	

QUANTITY = 1  
WEIGHT = 21.97 TONS

FOOTING SLAB - F2 - BILL OF MATERIALS / EMBEDS			
CSI ID#	DESCRIPTION	QTY	UM COMMENTS
EM-00078	8T SPREAD ANCHOR #FL119/P94	4	EA
EM-00125	BOLT POCKET PLATE (GALVANIZED)	2	EA
RM-00013	REBAR #4 BLACK-GR 60	424	LB
RM-00015	REBAR #5 BLACK-GR 60 40'	264	LB
RM-00017	REBAR #6 BLACK-GR 60 40'	110	LB
MX-FA5000SC30	MIX DESIGN - FLY ASH 5000 SELF CONSOLIDATING	8.59	CY
FOOTING PEDESTAL - F2 - BILL OF MATERIALS / EMBEDS			
RM-00013	REBAR #4 BLACK-GR 60	104	LB
MX-FA5000SC30	MIX DESIGN - FLY ASH 5000 SELF CONSOLIDATING	2.26	CY

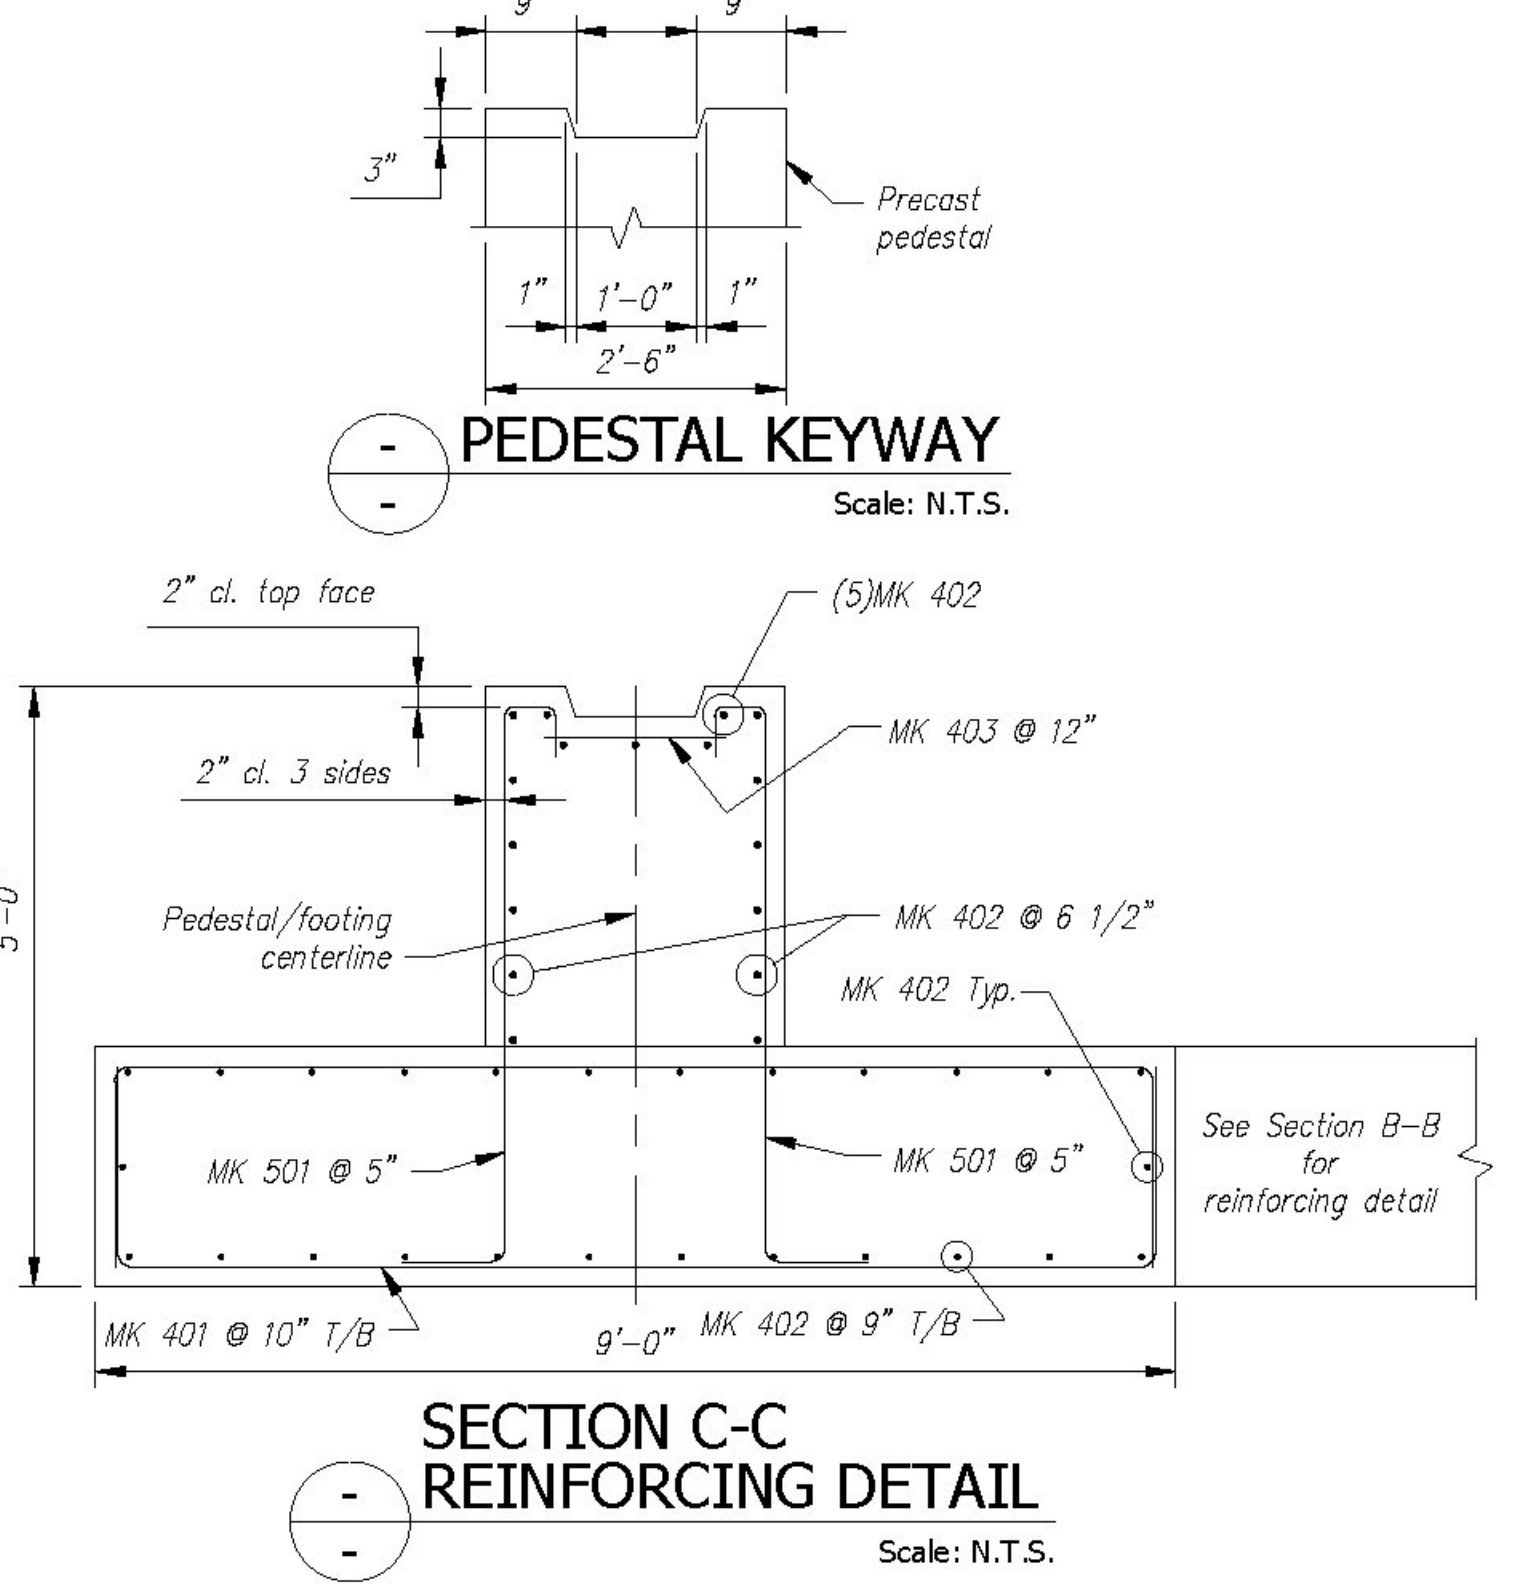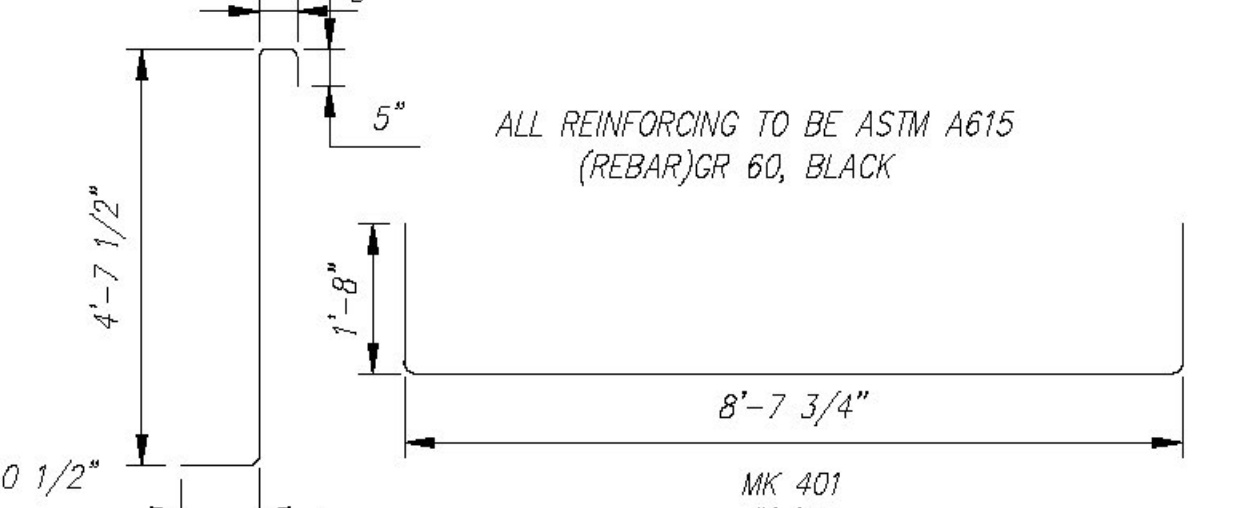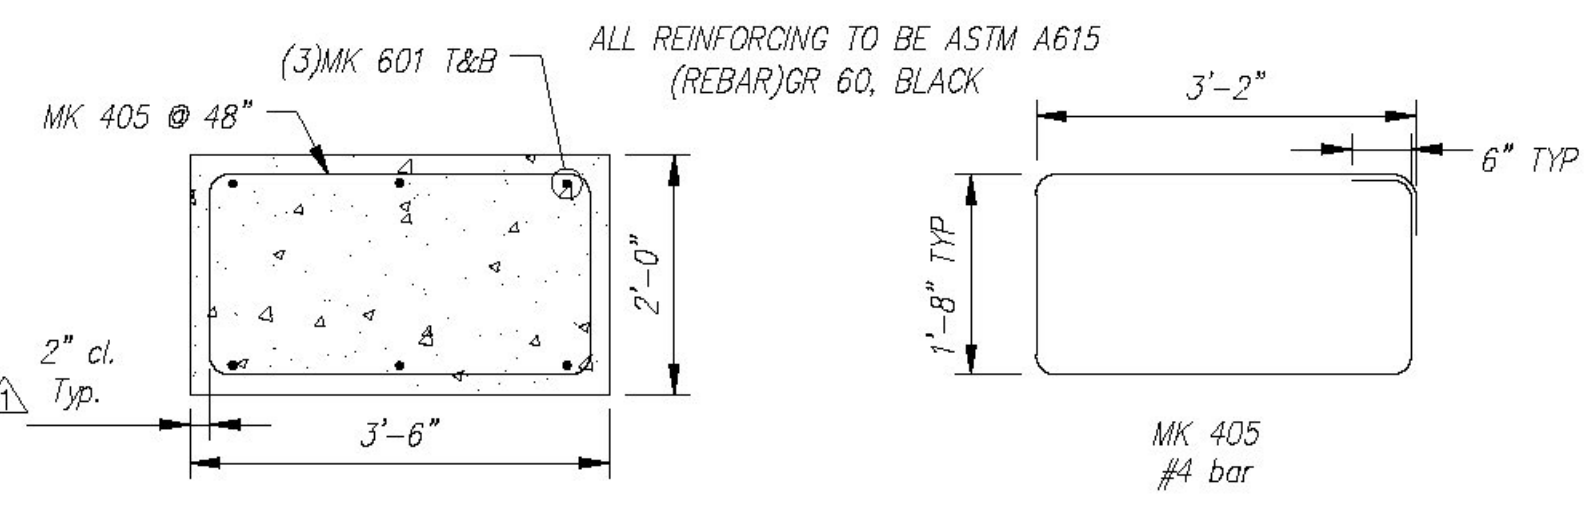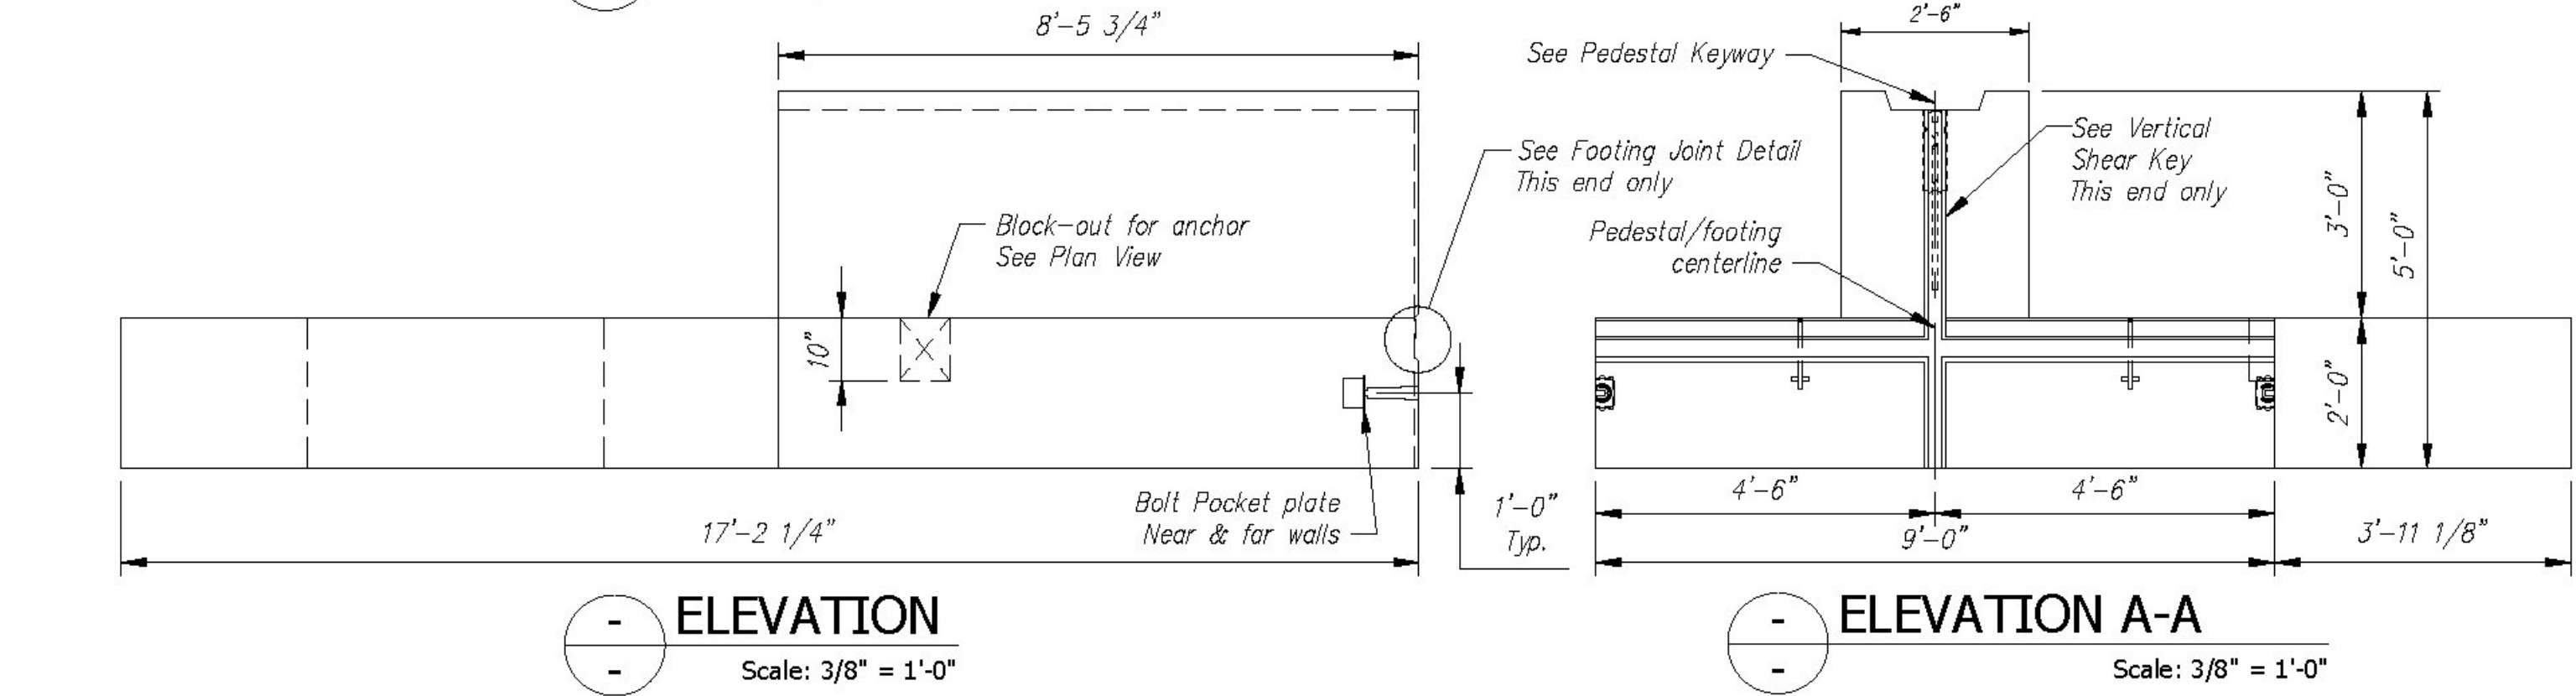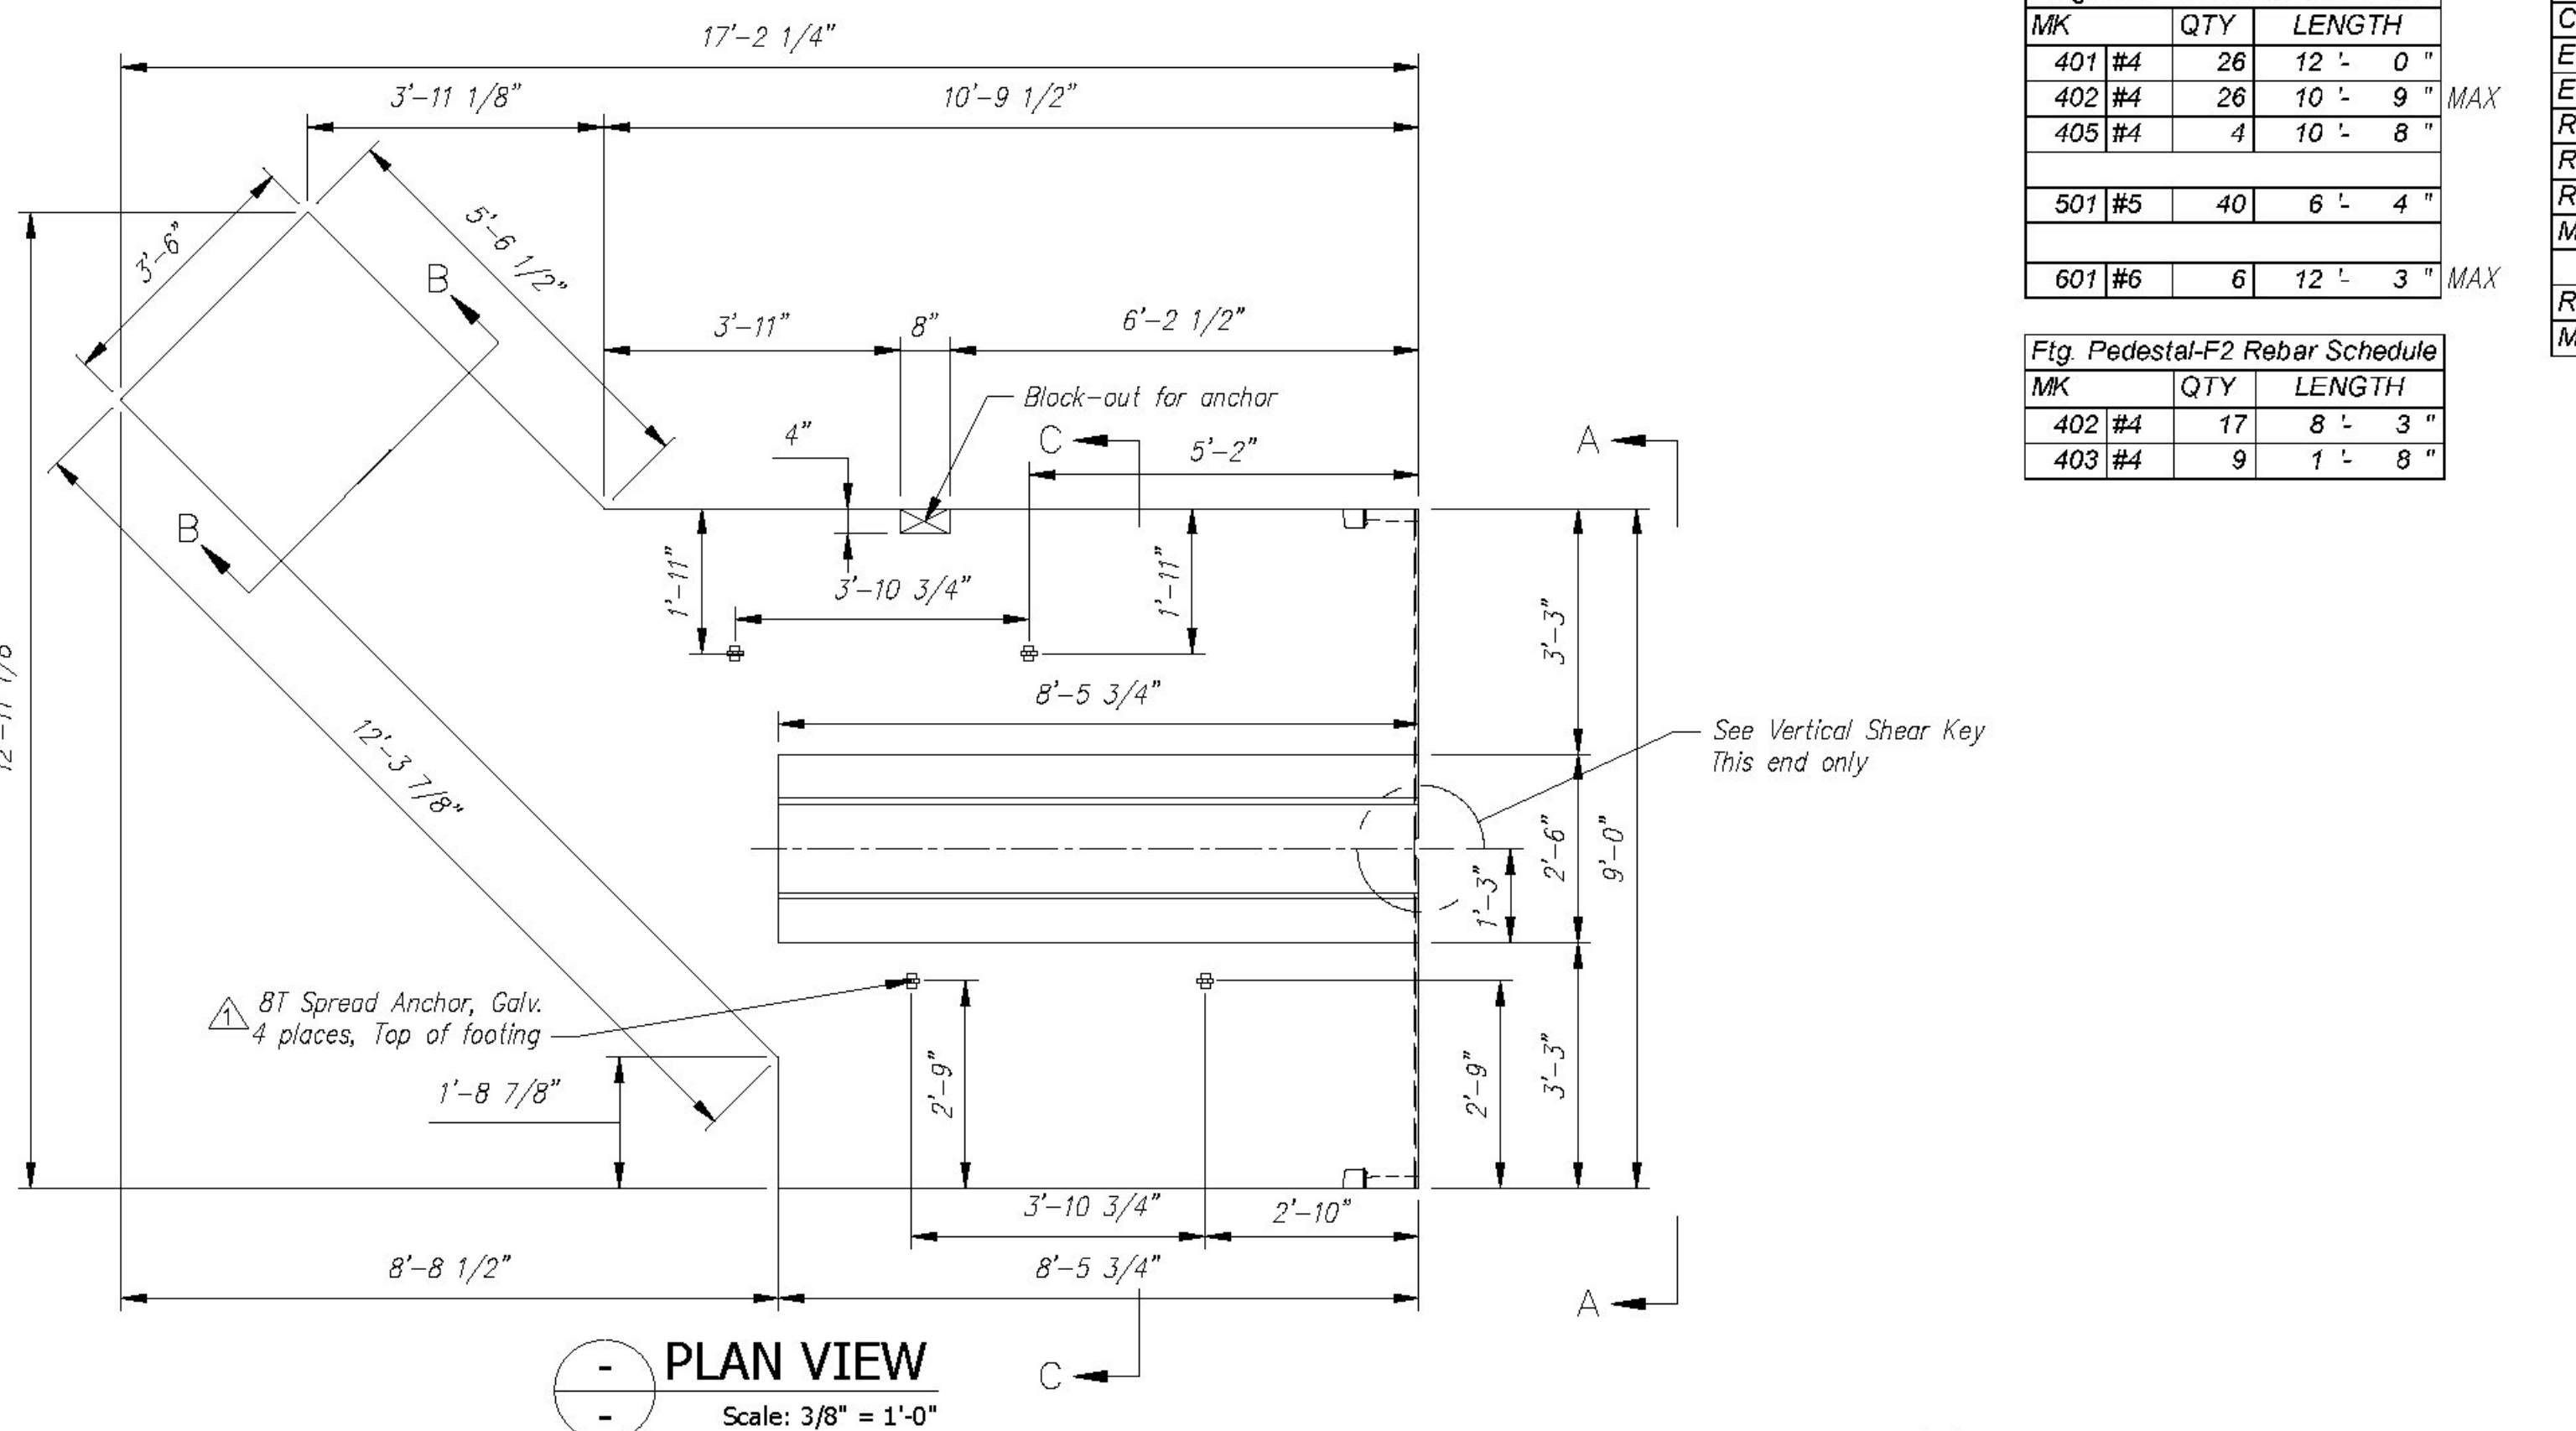

REV.	DESCRIPTION	DATE
10		
9		
8		
7		
6		
5		
4		
3		
2		
1	REVISED PER CUSTOMER REVIEW, REVISED ANCHOR LOCATIONS	14MAY2015

Contractor is to verify that all information shown on drawings has been thoroughly checked, complies with the contract documents and is adequate to meet the field conditions. Some dimensions and details may differ from those shown on drawings. Approval of this drawing indicates that any deviation from the contract documents has been reviewed and found to be acceptable. Production will not commence until receipt of signed, approved shop drawings.


This drawing contains information proprietary to CONCRETE SYSTEMS, INC. It is to be used only for the project for which it was prepared. It is to be returned to CONCRETE SYSTEMS, INC. upon request.

Vermont Agency of Transportation  
**RECEIVED**


CK'D BY CLB OK'D BY HIS  
July 22, 2015

RESUBMIT NO Approved  
BY C. CARLSON DATE 07/23/15


Following documents and/or sources:	STATE AGENCY VTTrans	G.W. TATRO CONSTRUCTION, INC. VT/AOT BRIDGE REPLACEMENT - ROAD IMPROVEMENT RICHFORD, VT.
PROJECT, TOWN OF RICHFORD	Concrete Systems Inc. 9 Commercial St., Hudson, NH, 03051 Phone 603-889-4163 Fax 603-889-2417	SHOP DRAWING F2 C22312-F2
DATED 2011	Drawn By: R. YEAGER Date: 16APR2015 Reviewed By: B. KOLAWOLE Date: 17JUN2015 Approved By: C. VICK	REV 1
	Quantity: 1 Project No: BRFO30229	SHEET 10 OF 14

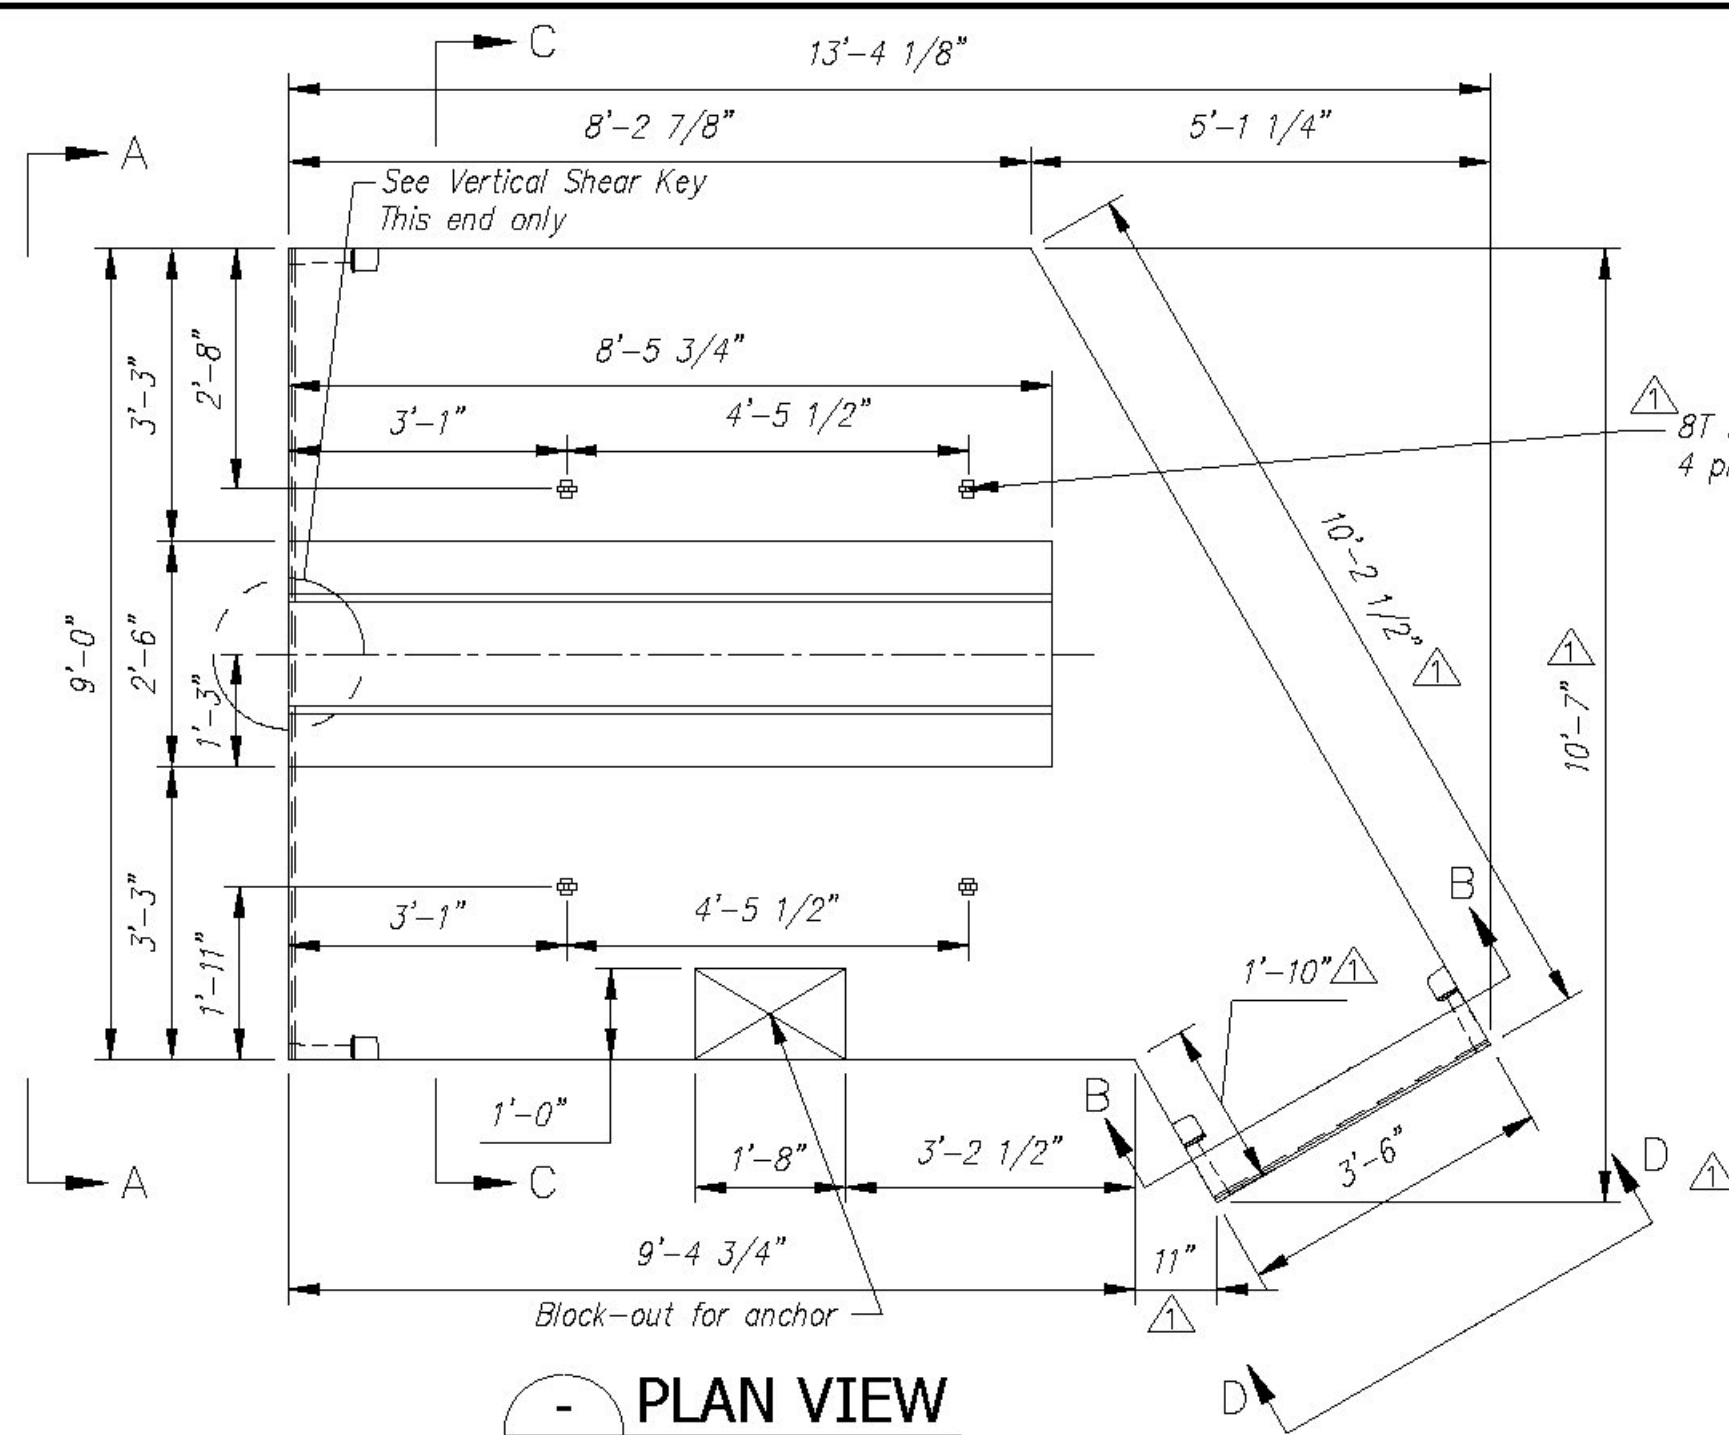


**PLAN VIEW**  
Scale: 3/8" = 1'-0"

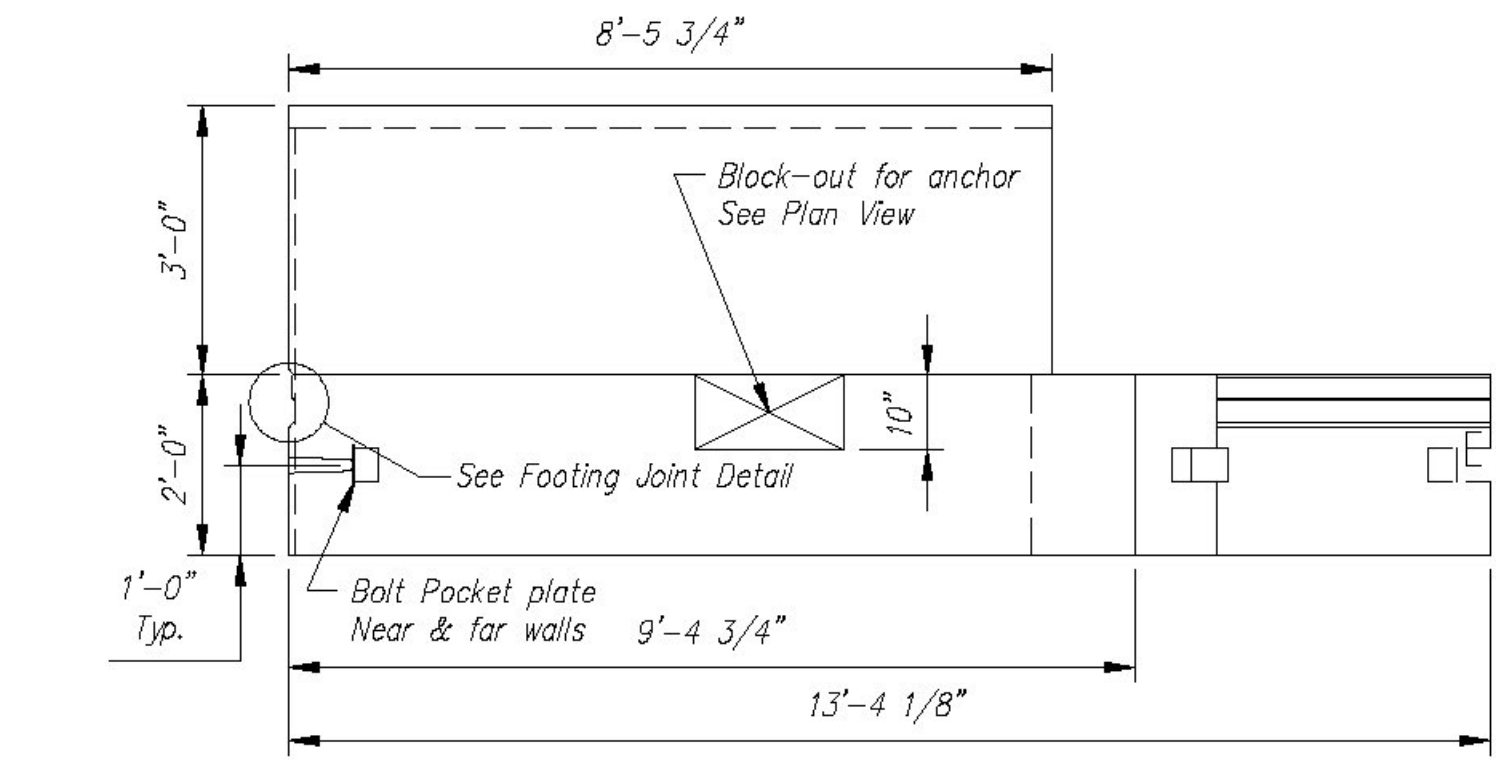


**ELEVATION**  
Scale: 3/8" = 1'-0"

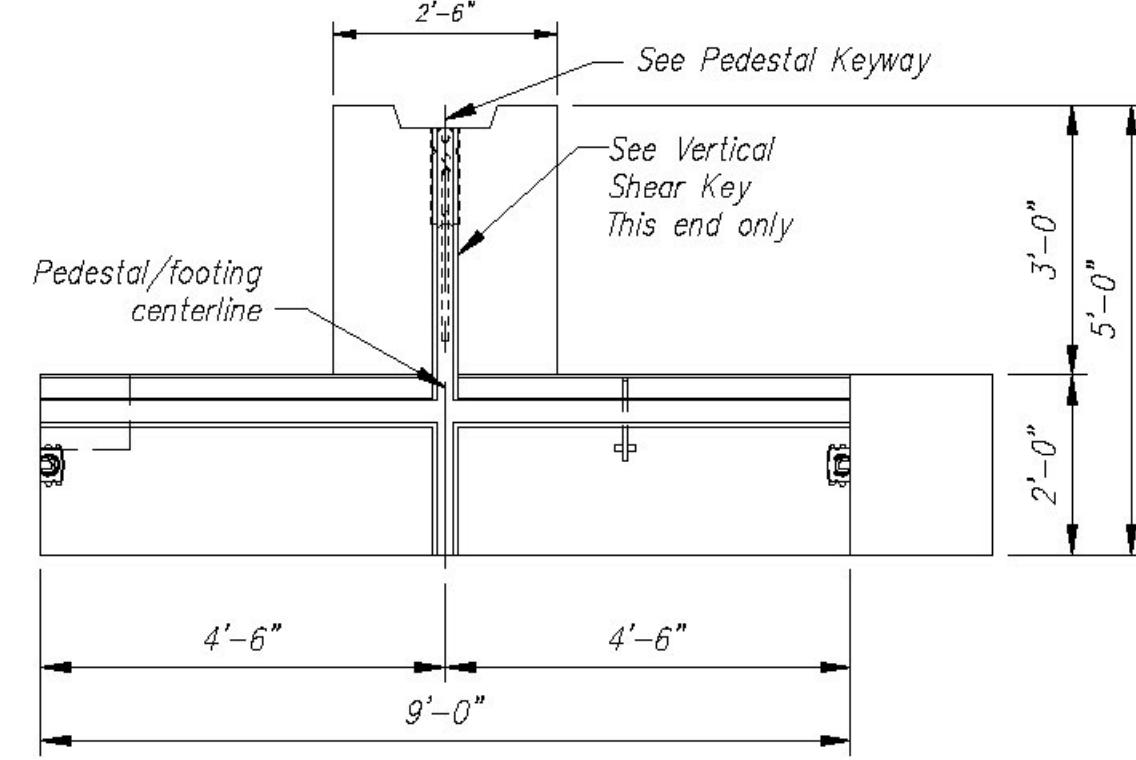


**ELEVATION A-A**  
Scale: 3/8" = 1'-0"

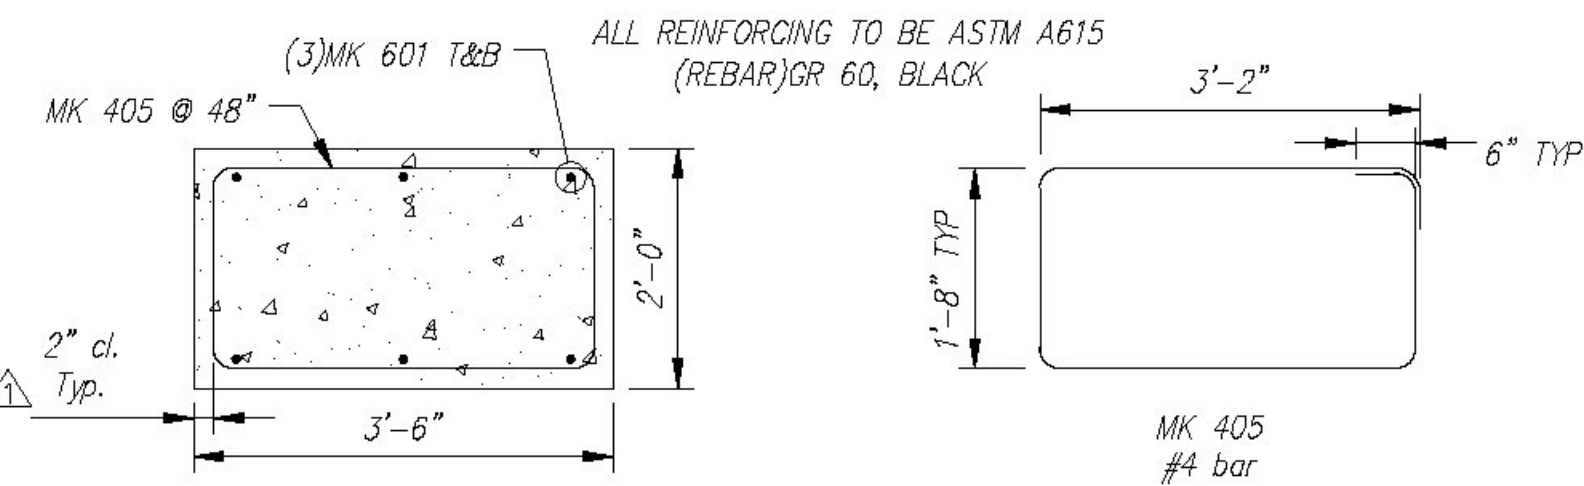


**SECTION B-B REINFORCING DETAIL**

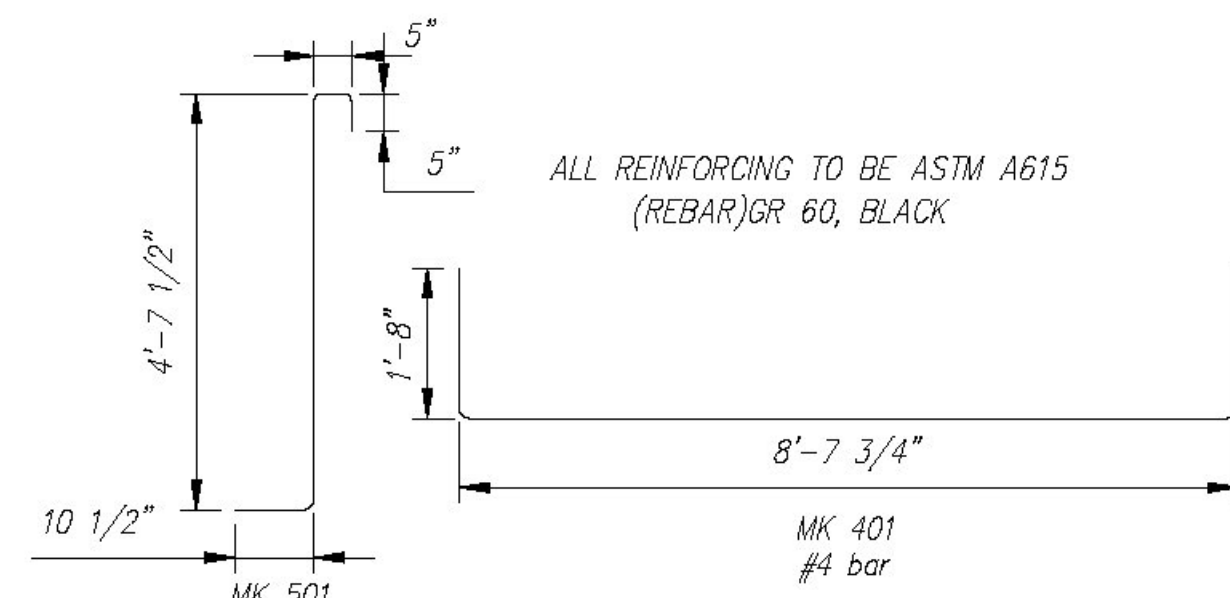

**BENDING SCHEDULE**  
Scale: N.T.S.

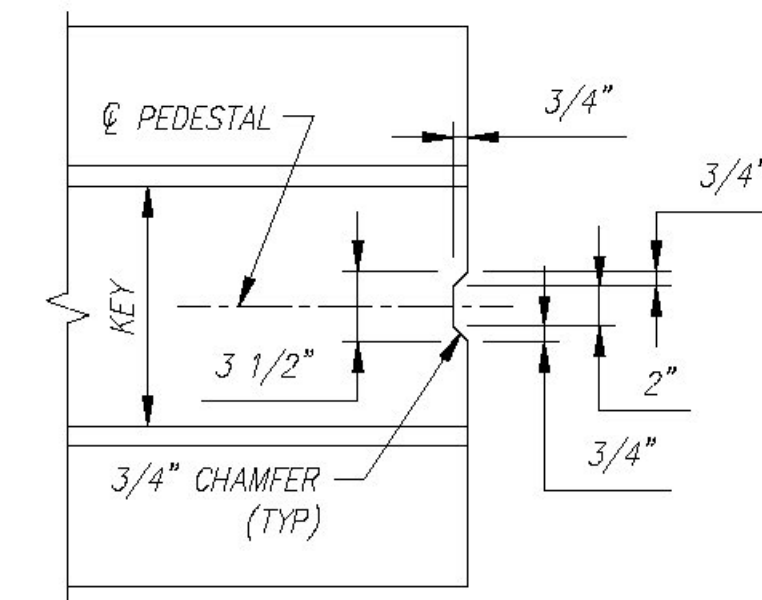

**VERTICAL SHEAR KEY**  
Scale: N.T.S.

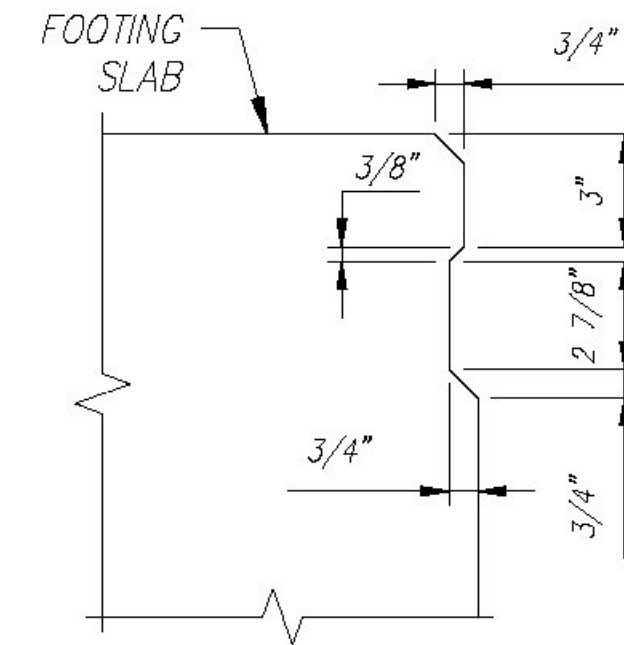

**JOINT DETAIL**  
Scale: N.T.S.

**Fig. Slab - F3A Rebar Schedule**

MK	QTY	LENGTH
401 #4	22	12' - 0"
402 #4	26	9' - 4"
405 #4	2	10' - 8"
501 #5	40	6' - 4"
601 #6	6	9' - 10"

**Fig. Pedestal-F3A Rebar Schedule**

MK	QTY	LENGTH
402 #4	17	8' - 3"
403 #4	9	1' - 8"

**FOOTING SLAB - F3A - BILL OF MATERIALS / EMBEDS**

CSI ID#	DESCRIPTION	QTY	UM	COMMENTS
EM-00078	8T SPREAD ANCHOR #FL119/P94	4	EA	
EM-00125	BOLT POCKET PLATE (GALVANIZED)	4	EA	
RM-00013	REBAR #4 BLACK-GR 60	353	LB	
RM-00015	REBAR #5 BLACK-GR 60 40'	264	LB	
RM-00017	REBAR #6 BLACK-GR 60 40'	69	LB	
MX-FA5000SC30	MIX DESIGN - FLY ASH 5000 SELF CONSOLIDATING	7.44	CY	

**FOOTING PEDESTAL - F3A - BILL OF MATERIALS / EMBEDS**

CSI ID#	DESCRIPTION	QTY	UM	COMMENTS
RM-00013	REBAR #4 BLACK-GR 60	104	LB	
MX-FA5000SC30	MIX DESIGN - FLY ASH 5000 SELF CONSOLIDATING	2.26	CY	

QUANTITY = 1  
WEIGHT = 19.85 TONS

REV.	DESCRIPTION	DATE
10		
9		
8		
7		
6		
5		
4		
3		
2		
1	REVISED PER CUSTOMER REVIEW, ADDED BOLT POCKETS, REVISED ANCHOR LOCATIONS	14MAY2015

Contractor is to verify that all information shown on drawings has been thoroughly checked, complies with the contract documents and is adequate to meet the field conditions. Some dimensions and details may differ from those shown on drawings. It is the responsibility of the contractor to verify the accuracy of the information provided in this drawing. The contractor shall be responsible for obtaining all necessary permits and approvals. Production will not commence until receipt of signed, approved shop drawings.

This drawing contains information proprietary to CONCRETE SYSTEMS, INC. This drawing is disclosed with the understanding that it will be retained in confidence and not be reproduced or transmitted in any form or by any means, electronic, mechanical, photocopying, recording, or by any information storage and retrieval system, without the prior written permission of CONCRETE SYSTEMS, INC. and that it will be returned to CONCRETE SYSTEMS, INC. upon request.

Vermont Agency of Transportation  
**RECEIVED**  
CK'D BY CLB OK'D BY HIS  
July 22, 2015  
RESUBMIT NO Approved  
BY C. CARLSON DATE 07/23/15

Following documents and/or sources:

STATE AGENCY  
VTTrans


G.W. TATRO CONSTRUCTION, INC.  
VT/AOT BRIDGE REPLACEMENT - ROAD IMPROVEMENT  
RICHFORD, VT.

Concrete Systems Inc.  
9 Commercial St., Hudson, NH, 03051  
Phone 603-889-4163  
Fax 603-889-2417


Drawn By: R. YEAGER Date: 16APR2015  
Reviewed By: B. KOLAWOLE Date: 17JUN2015  
Approved By: C. VICK

Quantity: 1 Project No: BRFO30229 SHEET 11 OF 14


SHOP DRAWING F3A  
C22312-F3A  
REV 1

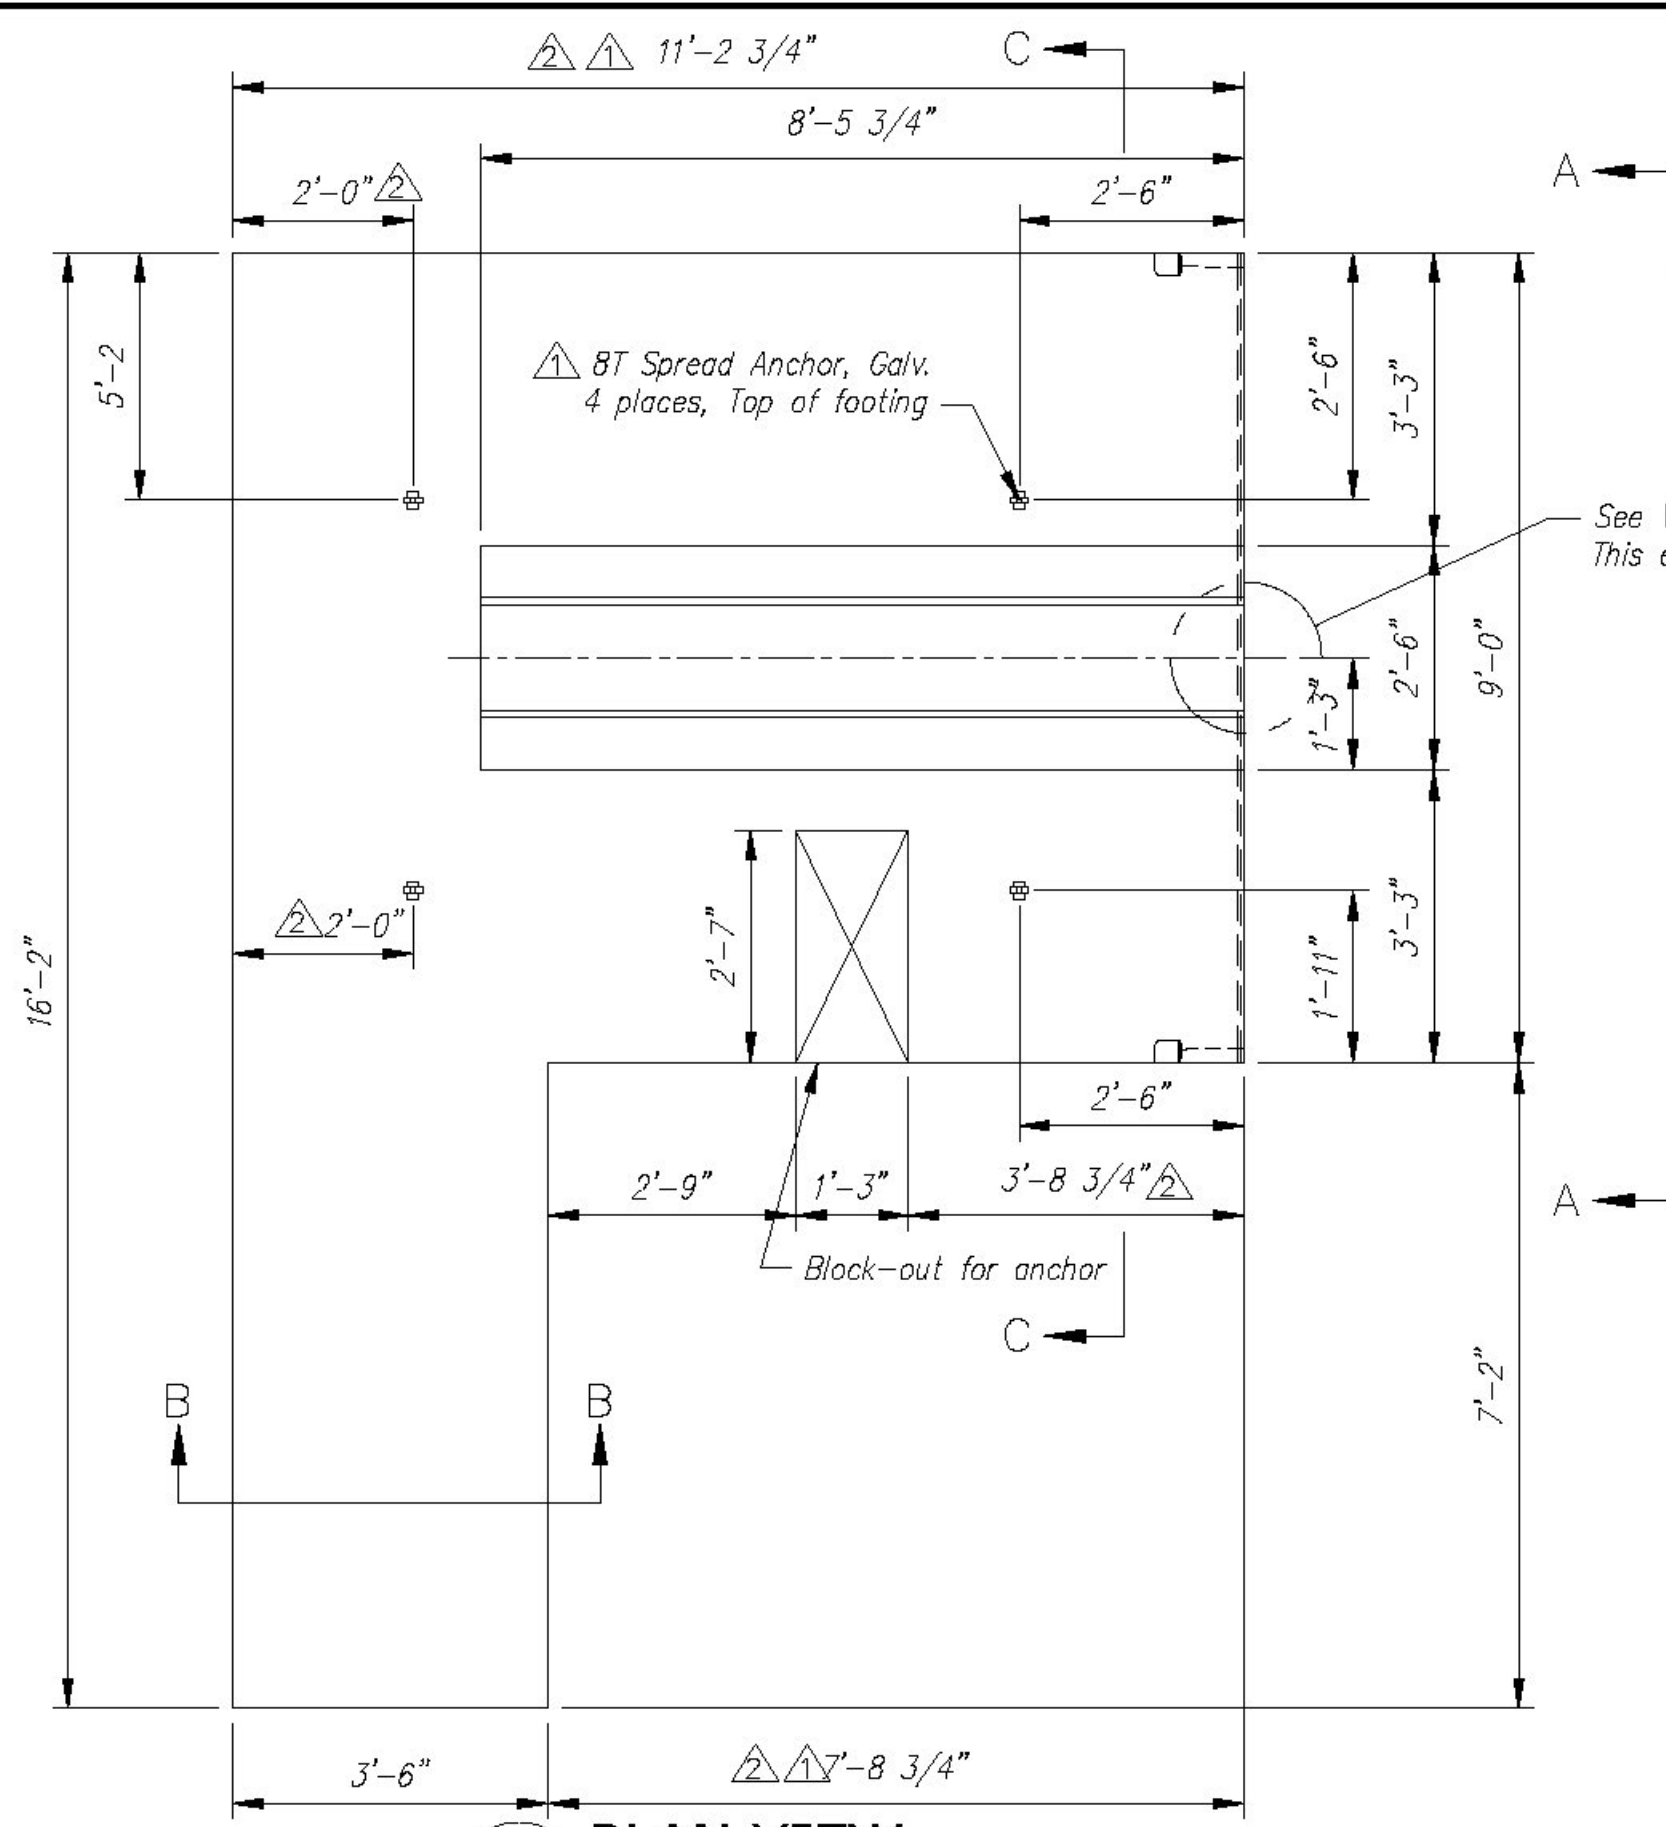


**PLAN VIEW**  
Scale: 3/8" = 1'-0"

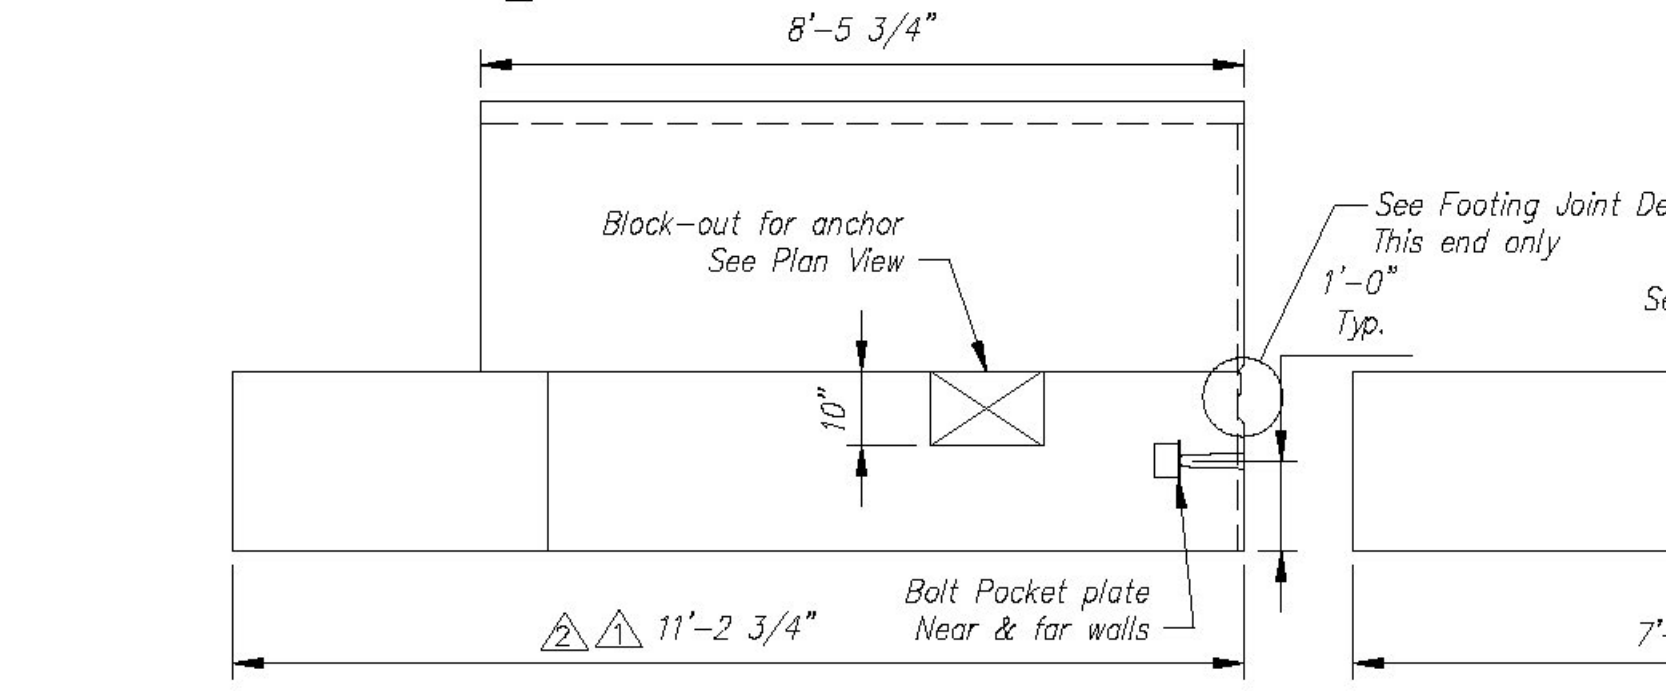


**ELEVATION**  
Scale: 3/8" = 1'-0"

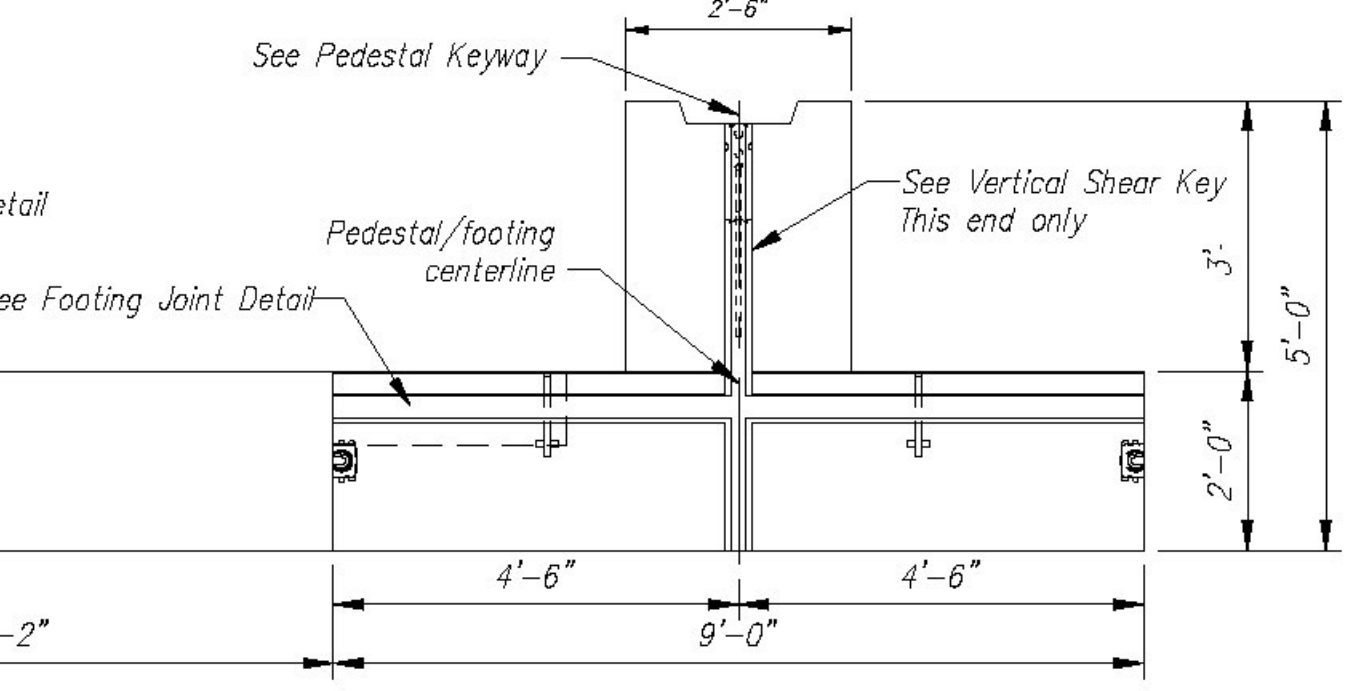


**ELEVATION A-A**  
Scale: 3/8" = 1'-0"

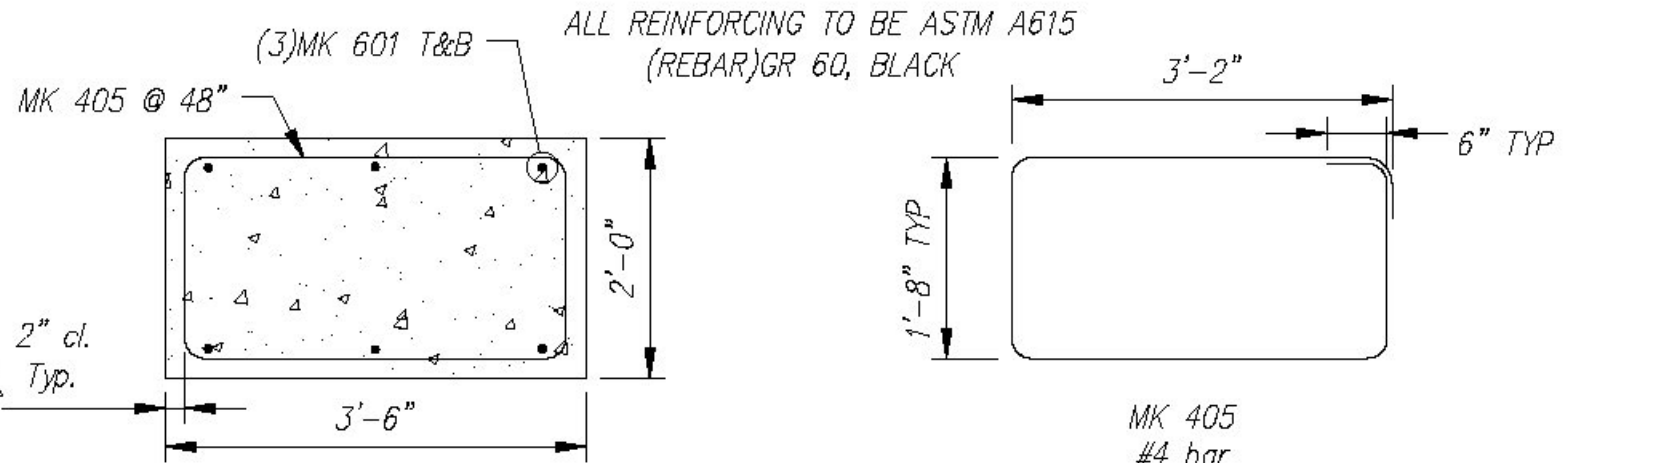


**SECTION B-B REINFORCING DETAIL**  
Scale: N.T.S.

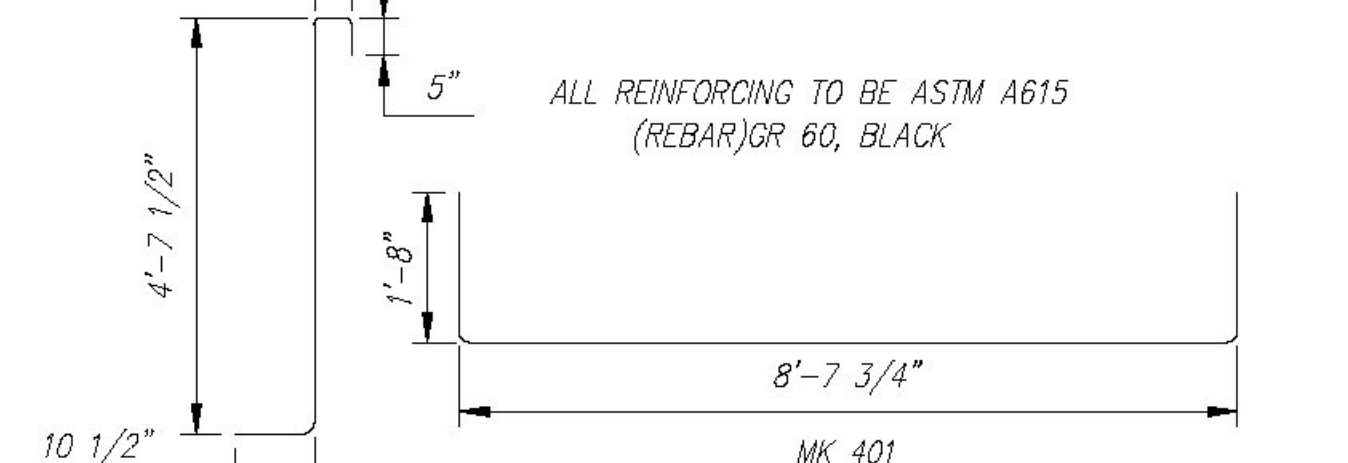


**BENDING SCHEDULE**  
Scale: N.T.S.

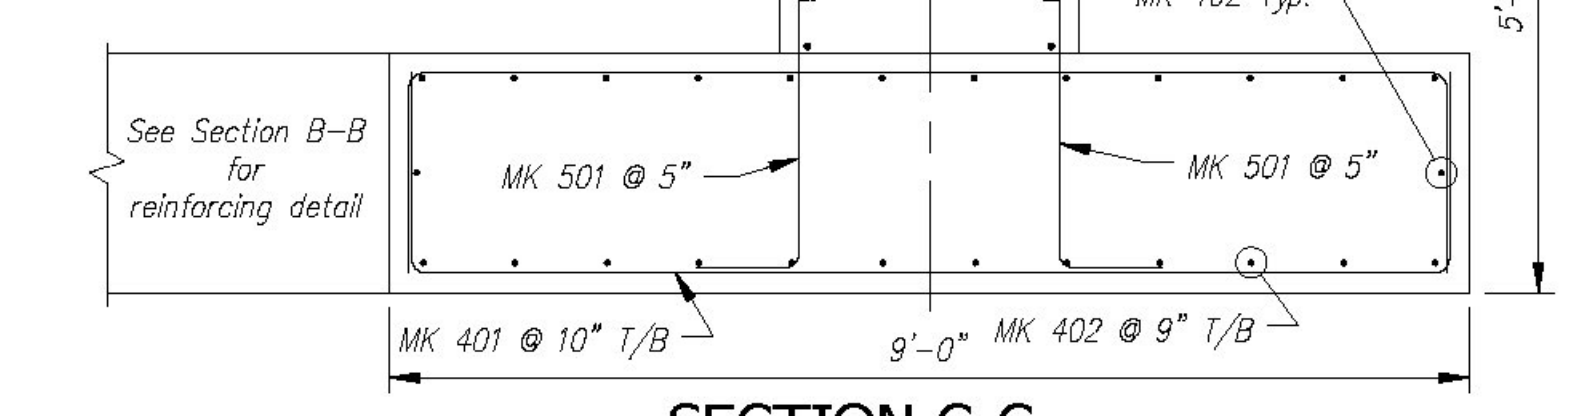

**SECTION C-C REINFORCING DETAIL**  
Scale: N.T.S.

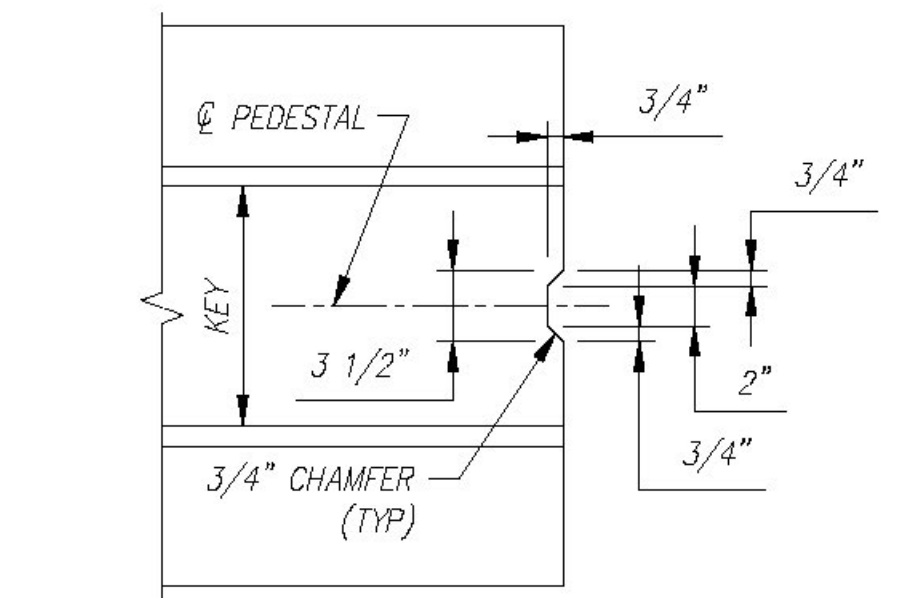

**VERTICAL SHEAR KEY**  
Scale: N.T.S.

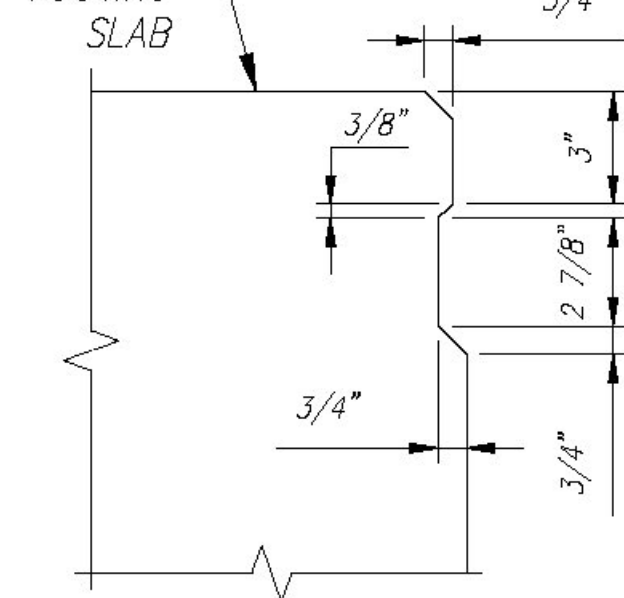

**JOINT DETAIL**  
Scale: N.T.S.

**Ftg. Slab - F4 Rebar Schedule**

MK	QTY	LENGTH
401 #4	28	12'-0"
402 #4	26	11'-0"
405 #4	3	10'-8"

**Ftg. Pedestal-F4 Rebar Schedule**

MK	QTY	LENGTH
402 #4	17	8'-3"
403 #4	9	1'-8"

**FOOTING SLAB - F4 - BILL OF MATERIALS / EMBEDS**

CSI ID#	DESCRIPTION	QTY	UM	COMMENTS
EM-00078	8T SPREAD ANCHOR #FL119/P94	4	EA	
EM-00125	BOLT POCKET PLATE (GALVANIZED)	2	EA	
RM-00013	REBAR #4 BLACK-GR 60	437	LB	
RM-00015	REBAR #5 BLACK-GR 60 40'	264	LB	
RM-00017	REBAR #6 BLACK-GR 60 40'	72	LB	
MX-FA5000SC30	MIX DESIGN - FLY ASH 5000 SELF CONSOLIDATING	9.34	CY	

**FOOTING PEDESTAL - F4 - BILL OF MATERIALS / EMBEDS**

CSI ID#	DESCRIPTION	QTY	UM	COMMENTS
RM-00013	REBAR #4 BLACK-GR 60	104	LB	
MX-FA5000SC30	MIX DESIGN - FLY ASH 5000 SELF CONSOLIDATING	2.26	CY	

QUANTITY = 1  
WEIGHT = 23.69 TONS

Vermont Agency of Transportation  
**RECEIVED**  
CK'D BY CLB OK'D BY HIS  
July 22, 2015  
RESUBMIT NO Approved  
BY C. CARLSON DATE 07/23/15

Rev.	Date	Description
10		
9		
8		
7		
6		
5		
4		
3	10JUN2015	ADDED 6" TO WIDTH, 11'-2.75 DIM WAS 10'-8.75
2	14MAY2015	REVISED PER CUSTOMER REVIEW, REVISED FOOTING DUE TO WINGWALL RELOCATION
1		

Contractor is to verify that all information shown on drawings has been thoroughly checked, complies with the contract documents and is adequate to meet the field conditions. Some dimensions and details may differ from those shown on drawings. It is the responsibility of the contractor to verify all dimensions and details. The contractor shall be responsible for any errors or omissions in the contract documents. Production will not commence until receipt of signed, approved shop drawings.

This drawing contains information proprietary to CONCRETE SYSTEMS, INC. This drawing is disclosed with the understanding that it will be retained in confidence and not be used for any other project without the written consent of CONCRETE SYSTEMS, INC. It is understood that no production of this drawing is authorized without permission from CONCRETE SYSTEMS, INC. and that it will be returned to CONCRETE SYSTEMS, INC. upon request.

This drawing is based upon information provided from the following documents and/or sources:  
 Engineer: STATE OF VT/AOT PROGRAM DEVELOPMENT  
 Project No: _____  
 Drawings: STATE OF VT/AOT PROPOSED IMPROVEMENT BRIDGE PROJECT, TOWN OF RICHFORD SHEETS 1,2,4,22,23,24 OF 36  
 Specifications: STANDARD SPECIFICATIONS FOR CONSTRUCTION DATED 2011  
 Other: _____

STATE AGENCY  
VTTrans

**CSI**  
Concrete Systems Inc.  
9 Commercial St., Hudson, NH, 03051  
Phone 603-889-4163  
Fax 603-889-2417

Drawn By: R. YEAGER Date: 16APR2015  
 Reviewed By: B. KOLAWOLE Date: _____  
 Approved By: C. VICK Date: 17JUN2015

G.W. TATRO CONSTRUCTION, INC.  
VT/AOT BRIDGE REPLACEMENT - ROAD IMPROVEMENT  
RICHFORD, VT.

SHOP DRAWING F4  
C22312-F4









Quantity: 1 Project No: BRFO30229 SHEET 12 OF 14

QUANTITY = 1  
WEIGHT = 22.66 TONS

FOOTING SLAB - F5 - BILL OF MATERIALS / EMBEDS			
CSI ID#	DESCRIPTION	QTY	UM COMMENTS
EM-00078	8T SPREAD ANCHOR #FL119/P94	4	EA
EM-00125	BOLT POCKET PLATE (GALVANIZED)	4	EA
RM-00013	REBAR #4 BLACK-GR 60	445	LB
RM-00015	REBAR #5 BLACK-GR 60 40'	383	LB
MX-FA5000SC30	MX DESIGN - FLY ASH 5000 SELF CONSOLIDATING	7.86	CY
FOOTING PEDESTAL - F5 - BILL OF MATERIALS / EMBEDS			
RM-00013	REBAR #4 BLACK-GR 60	147	LB
MX-FA5000SC30	MX DESIGN - FLY ASH 5000 SELF CONSOLIDATING	3.33	CY

Fig. Slab - F5 Rebar Schedule			
MK	QTY	LENGTH	
401 #4	30	12' - 0"	
402 #4	26	11' - 9"	
501 #5	58	6' - 4"	

Fig. Pedestal-F5 Rebar Schedule			
MK	QTY	LENGTH	
402 #4	17	11' - 9"	
403 #4	12	1' - 8"	

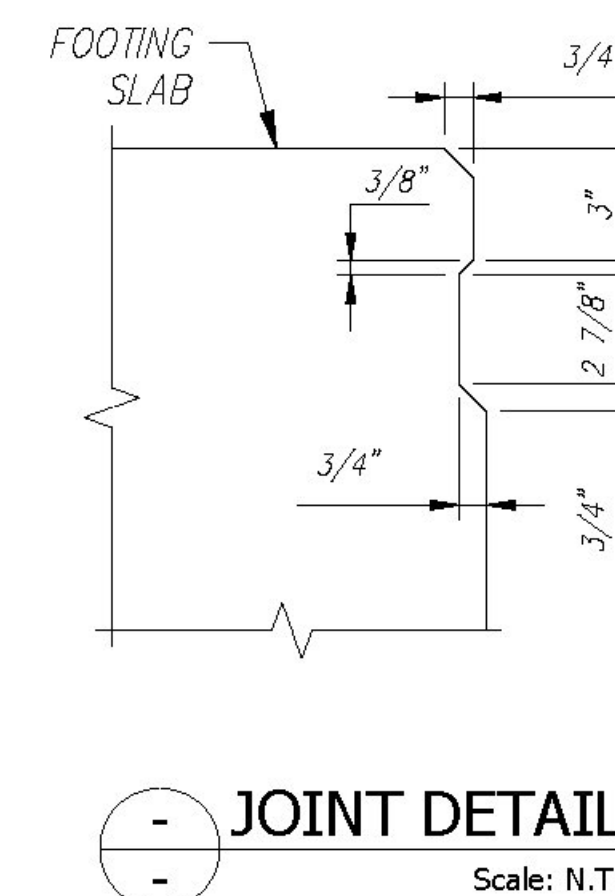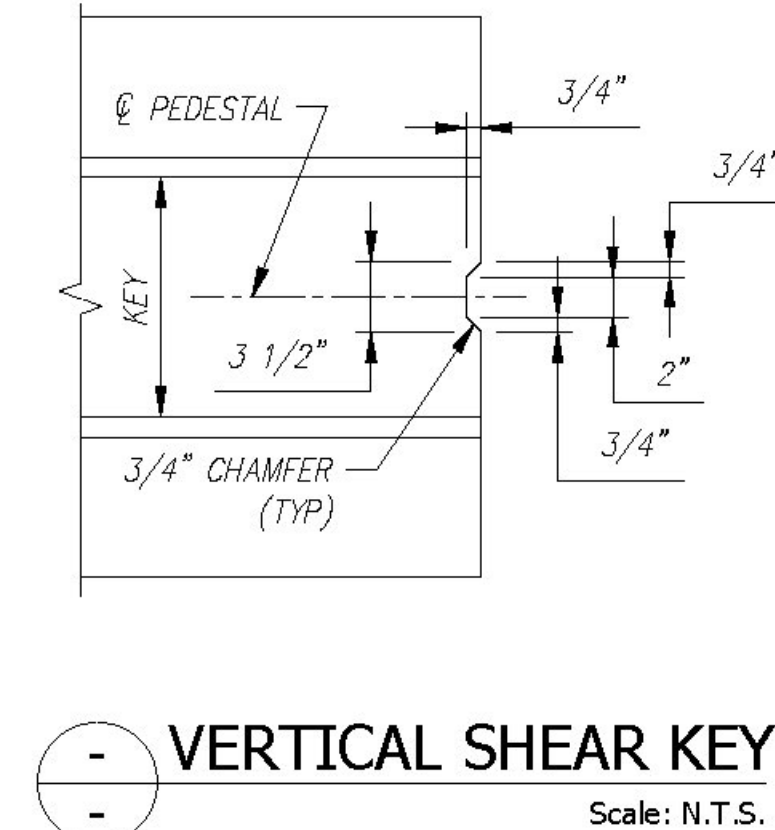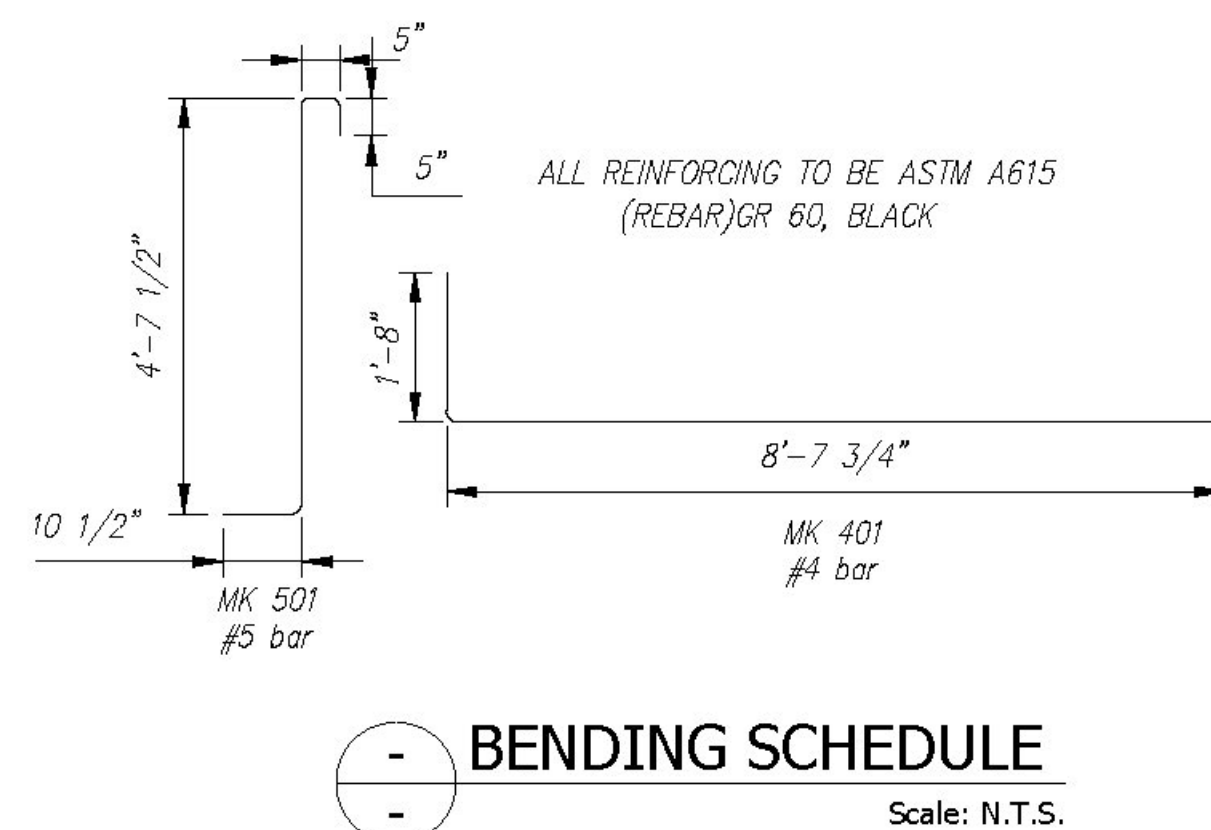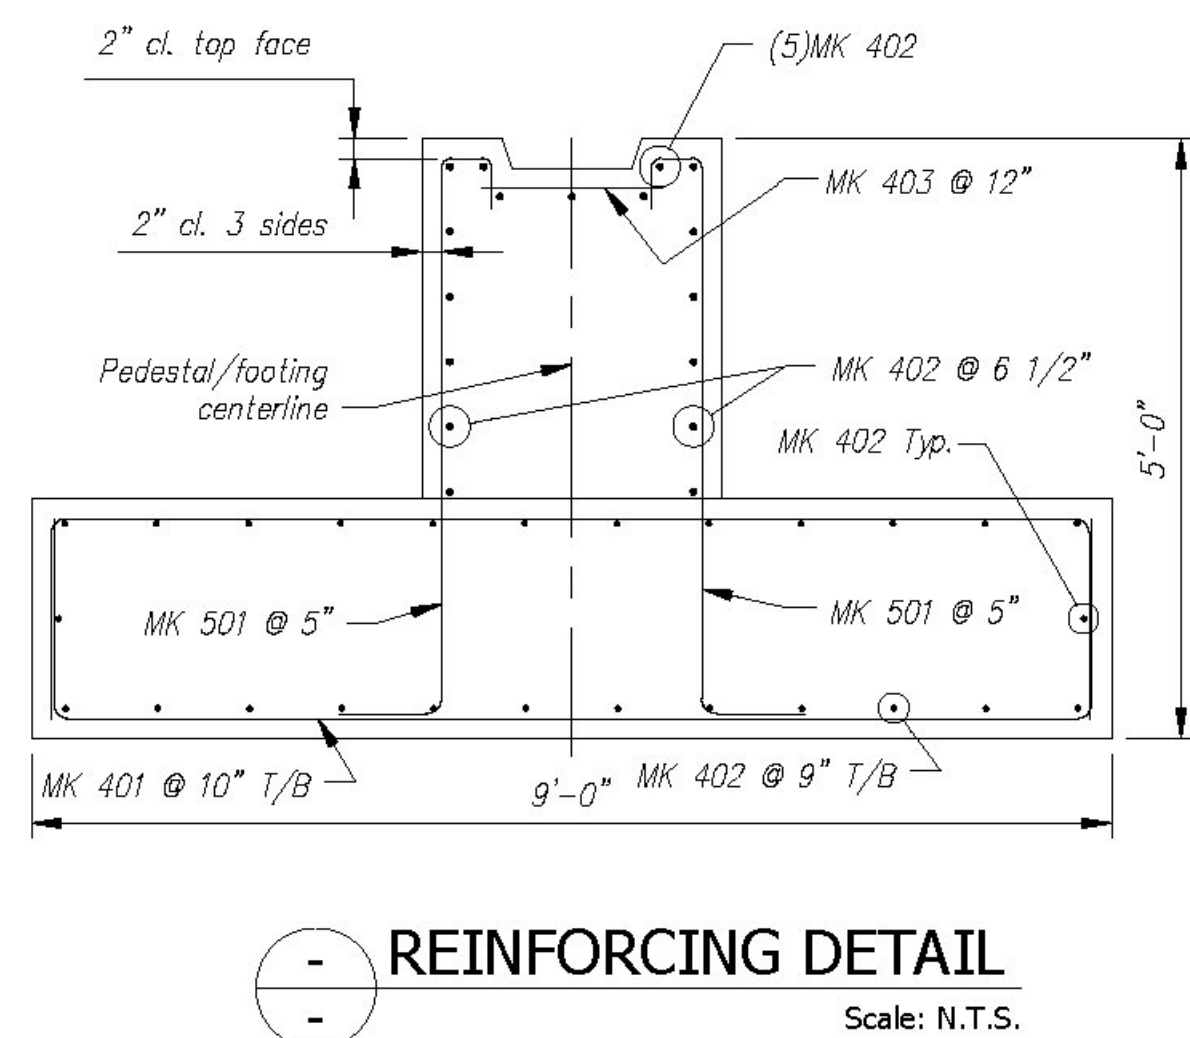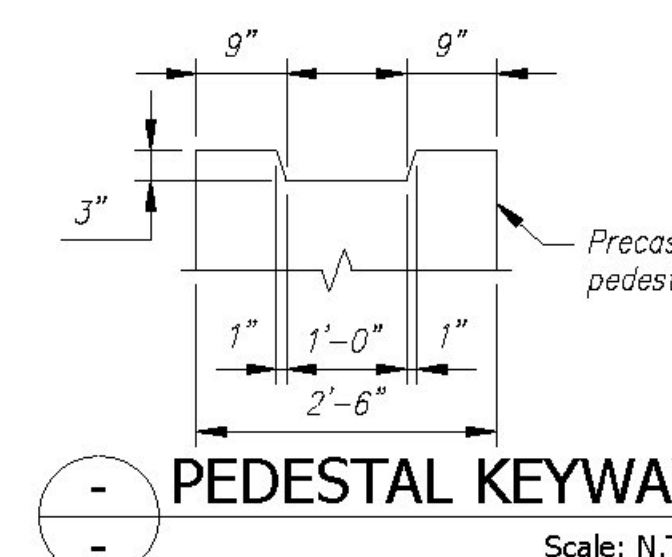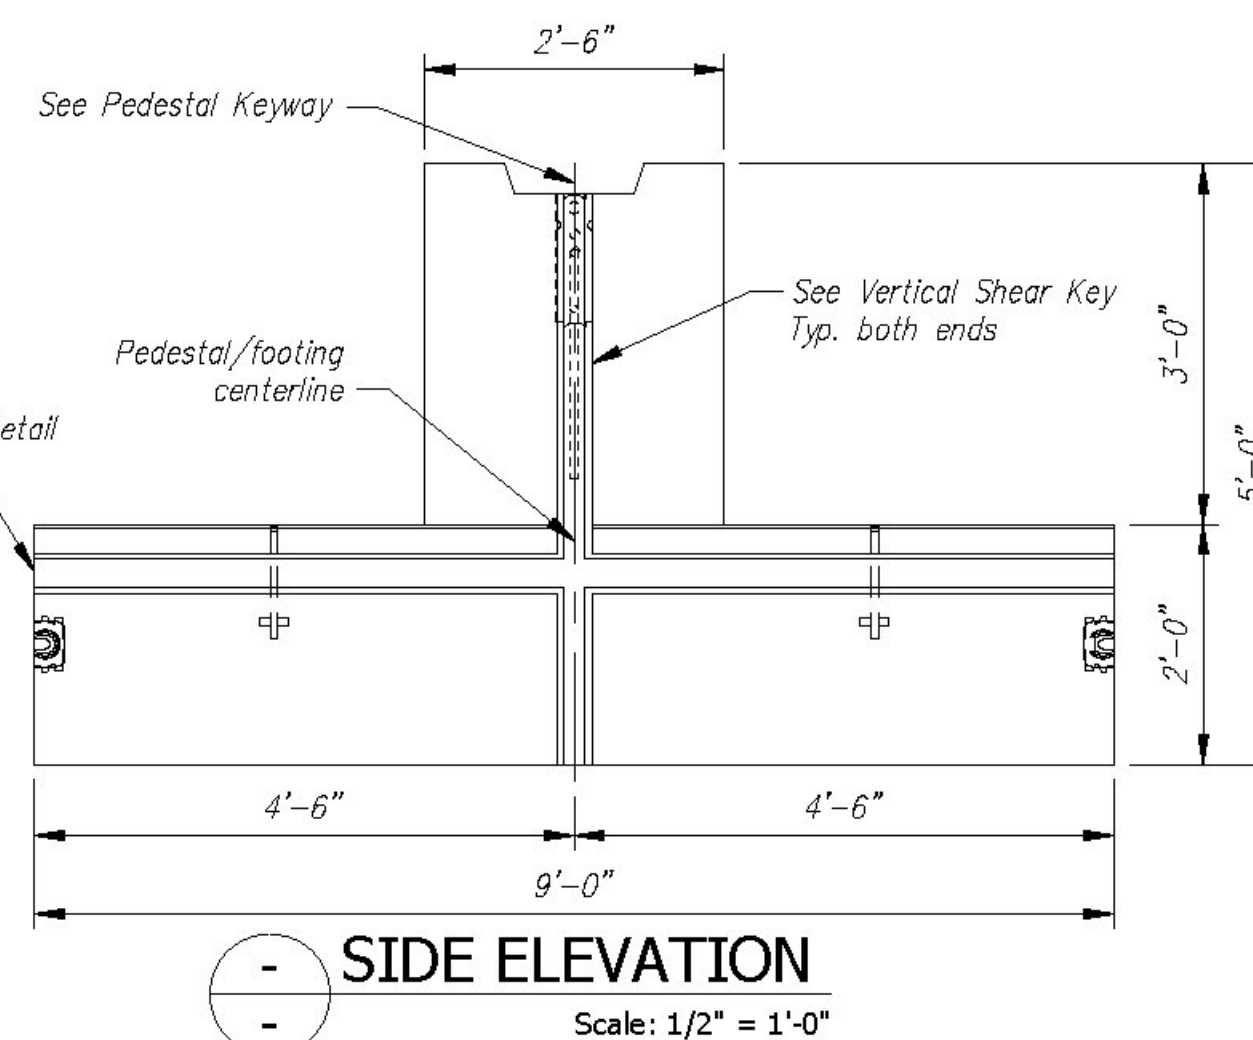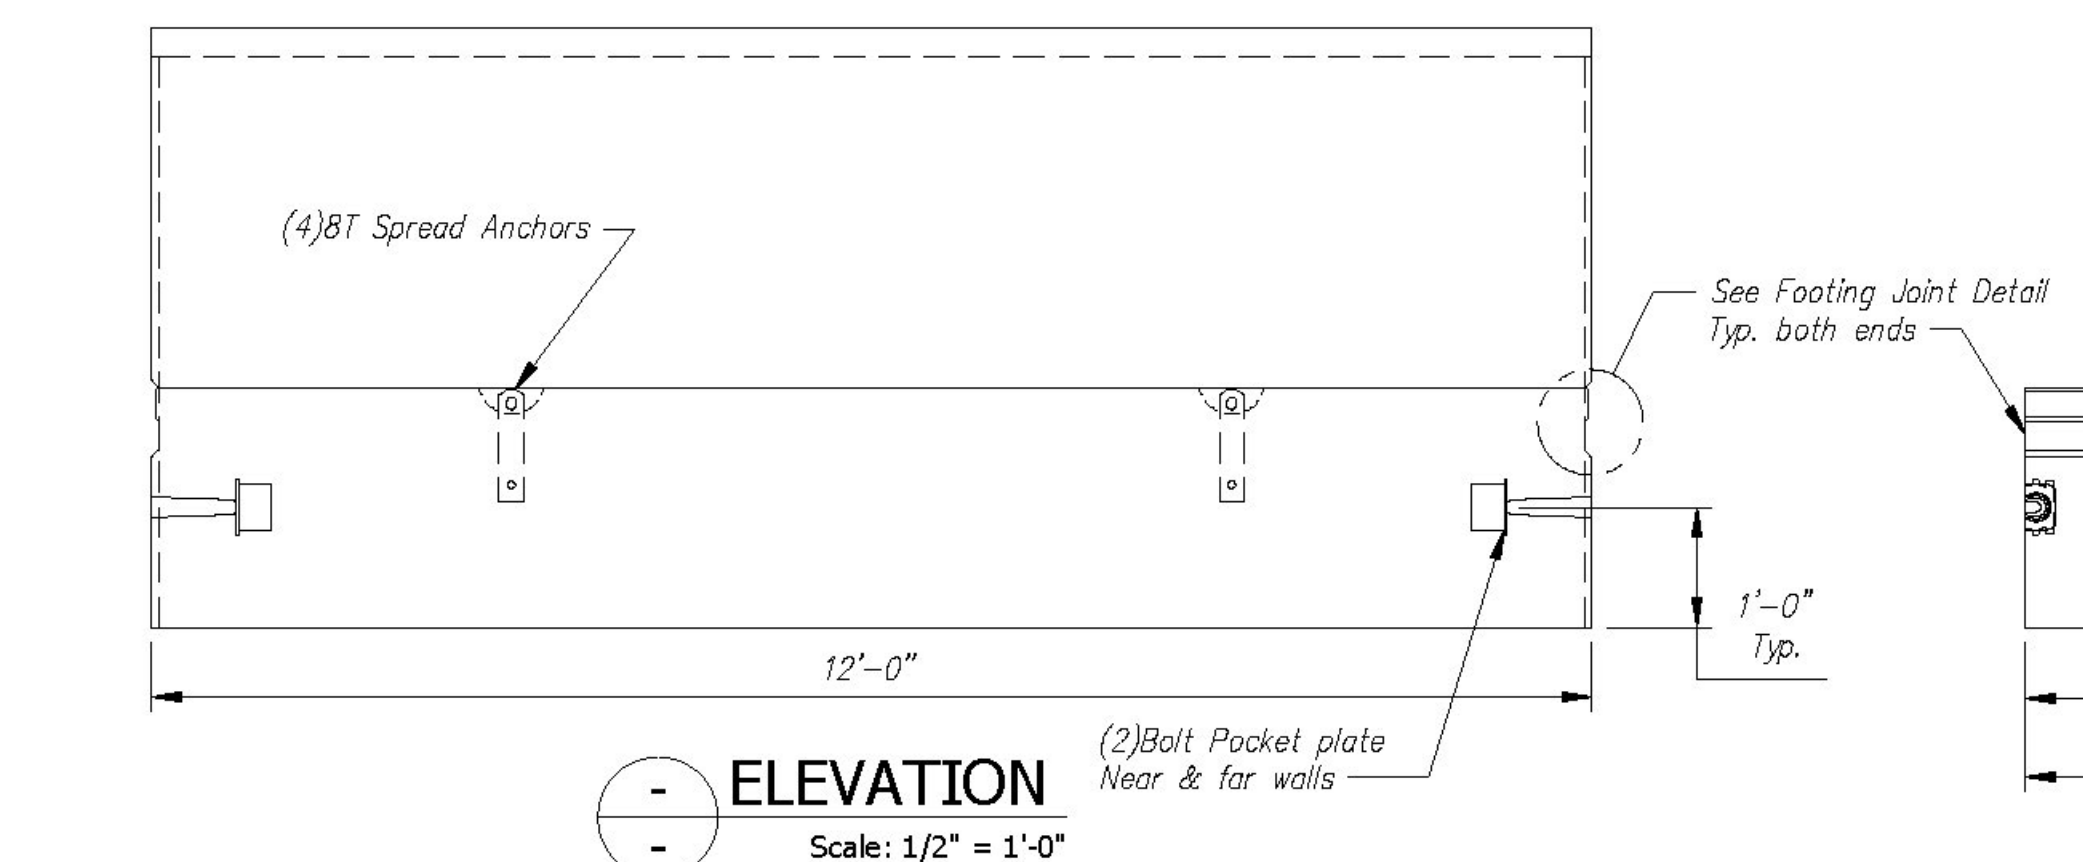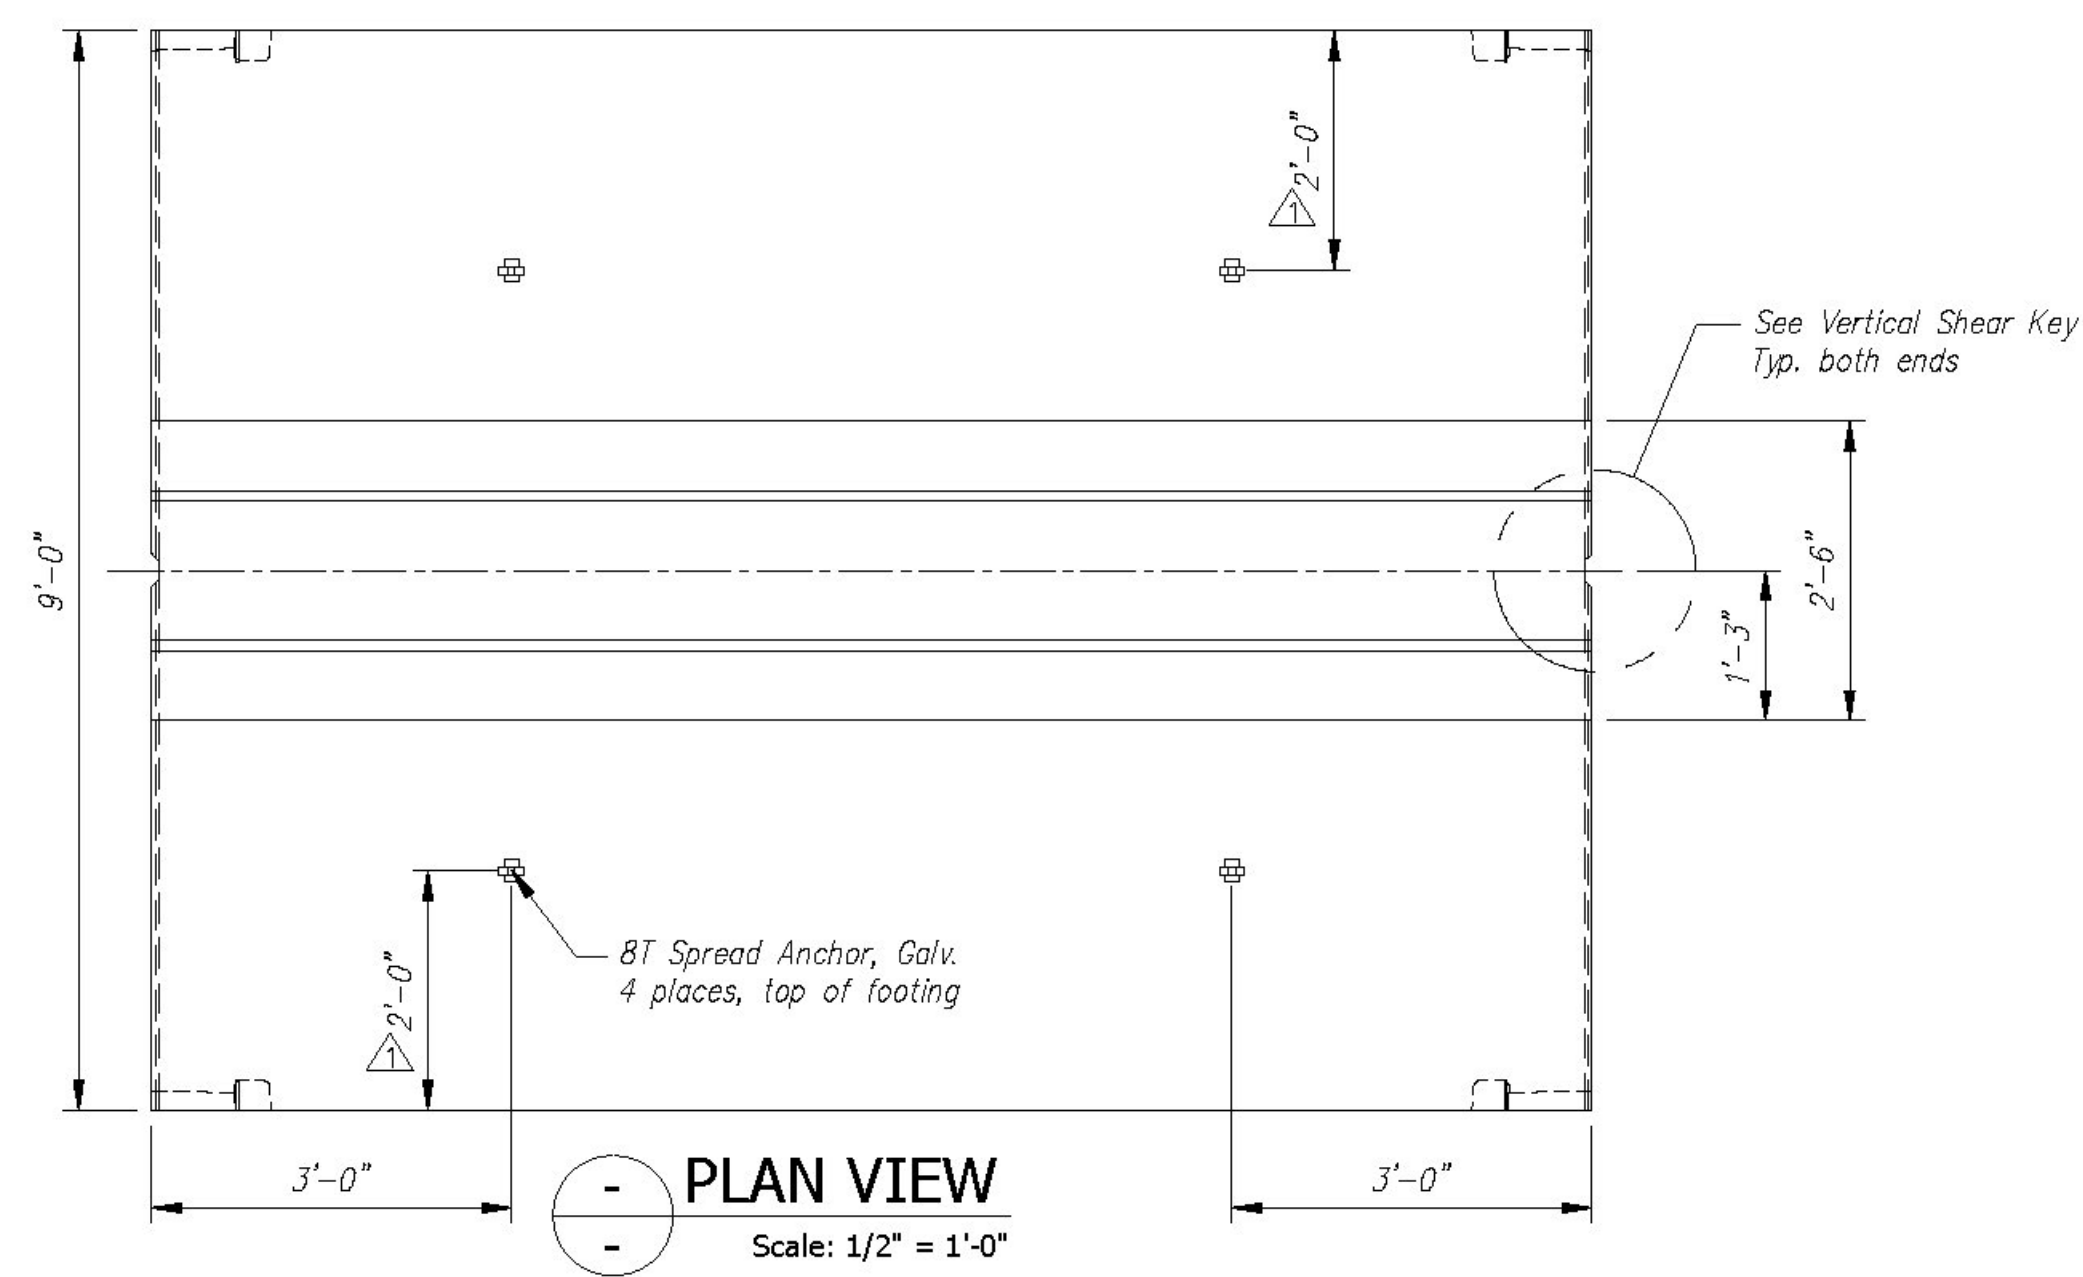

Vermont Agency of Transportation  
**RECEIVED**  
CK'D BY CLB OK'D BY HIS  
July 22, 2015  
RESUBMIT NO Approved  
BY C. CARLSON DATE 07/23/15

REV.	DATE	DESCRIPTION	BY
1	14MAY2015	REVISED PER CUSTOMER REVIEW, REVISED ANCHOR LOCATIONS	
2			
3			
4			
5			
6			
7			
8			
9			
10			

Contractor is to verify that all information shown on drawings has been thoroughly checked, complies with the contract documents and is adequate to meet the field conditions. Some dimensions and details may differ from those shown on drawings. The contractor shall be responsible for the design process. Approval of this drawing indicates that the contractor, from the contract documents has been reviewed and found to be acceptable. Production will not commence until receipt of signed, approved shop drawings.

This drawing contains information proprietary to CONCRETE SYSTEMS, INC. This drawing is disclosed with the understanding that it will be retained in confidence and not be reproduced or transmitted in any form or by any means, electronic, mechanical, photocopying, recording, or by any information storage and retrieval system, without the prior written permission of CONCRETE SYSTEMS, INC. and that it will be returned to CONCRETE SYSTEMS, INC. upon request.

This drawing is based upon information provided from the following documents and/or sources:  
 Engineer: STATE OF VT/AOT PROGRAM DEVELOPMENT  
 Project No: _____  
 Drawings: STATE OF VT/AOT PROPOSED IMPROVEMENT BRIDGE PROJECT, TOWN OF RICHFORD SHEETS 1,2,4,22,23,24 OF 36  
 Specifications: STANDARD SPECIFICATIONS FOR CONSTRUCTION DATED 2011  
 Other: _____

STATE AGENCY  
VTTrans

**CSI**  
Concrete Systems Inc.  
9 Commercial St., Hudson, NH, 03051  
Phone 603-889-4163  
Fax 603-889-2417


Drawn By: R. YEAGER Date: 16APR2015  
 Reviewed By: B. KOLAWOLE Date: _____  
 Approved By: C. VICK Date: 17JUN2015

G.W. TATRO CONSTRUCTION, INC.  
VT/AOT BRIDGE REPLACEMENT - ROAD IMPROVEMENT  
RICHFORD, VT.

SHOP DRAWING F5  
C22312-F5






Quantity: 2 Project No: BRFO30229 SHEET 1.3 OF 14

QUANTITY = 1  
WEIGHT = 6.30 TONS

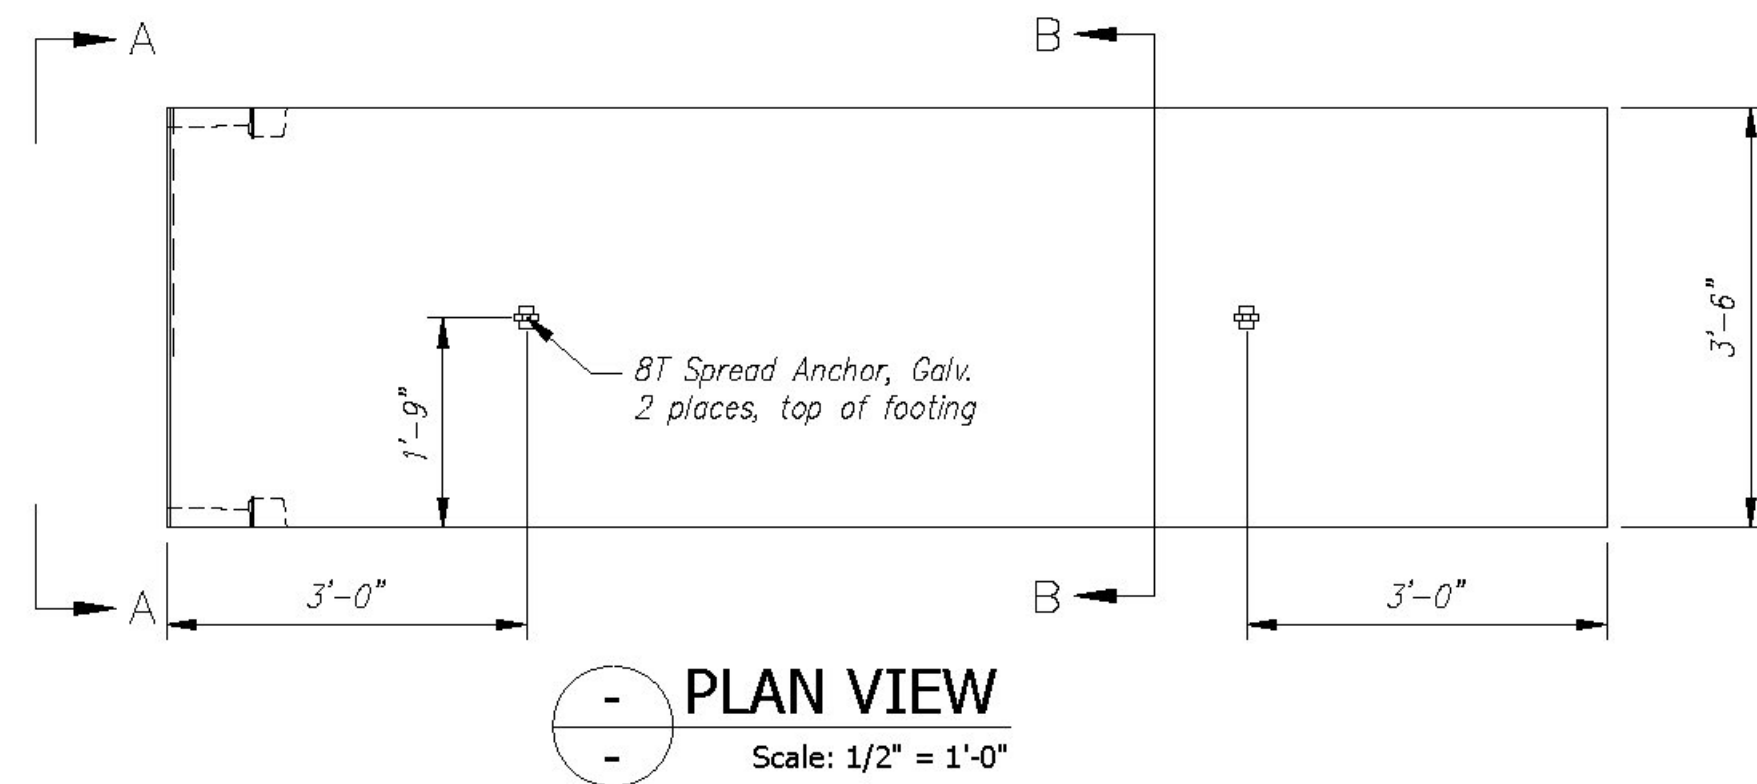

FOOTING SLAB - F3B - BILL OF MATERIALS / EMBEDS			
CSI ID#	DESCRIPTION	QTY	UM COMMENTS
EM-00078	8T SPREAD ANCHOR #FL119/P94	2	EA
EM-00125	BOLT POCKET PLATE (GALVANIZED)	2	EA
RM-00013	REBAR #4 BLACK- GR 60	29	LB
RM-00017	REBAR #6 BLACK-GR 60 40'	105	LB
MK-FA5000SC30	MIX DESIGN - FLY ASH 5000 SELF CONSOLIDATING	3.11	CY

Ftg. Slab - F3B Rebar Schedule		
MK	QTY	LENGTH
405 #4	4	10' - 8"
601 #6	6	11' - 8"

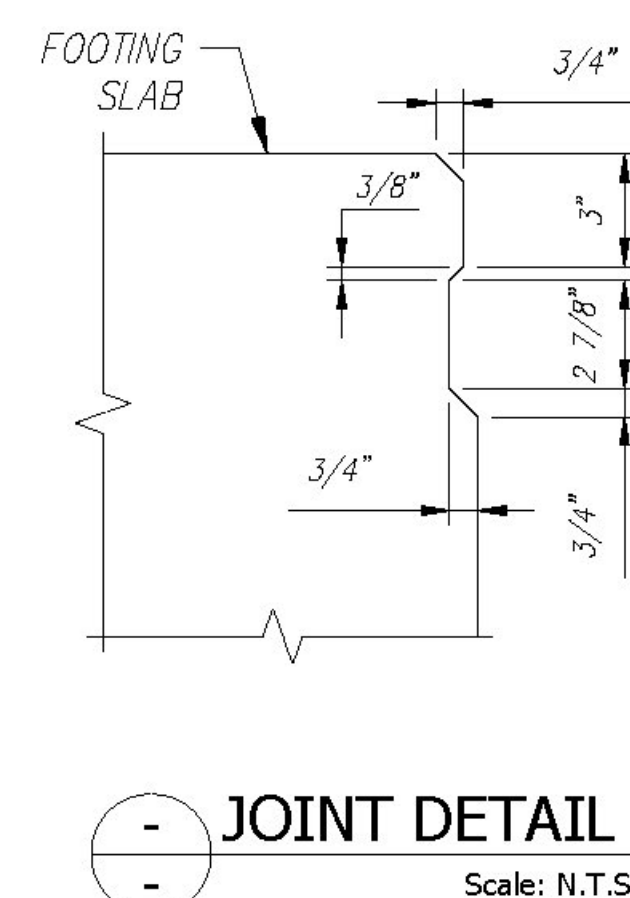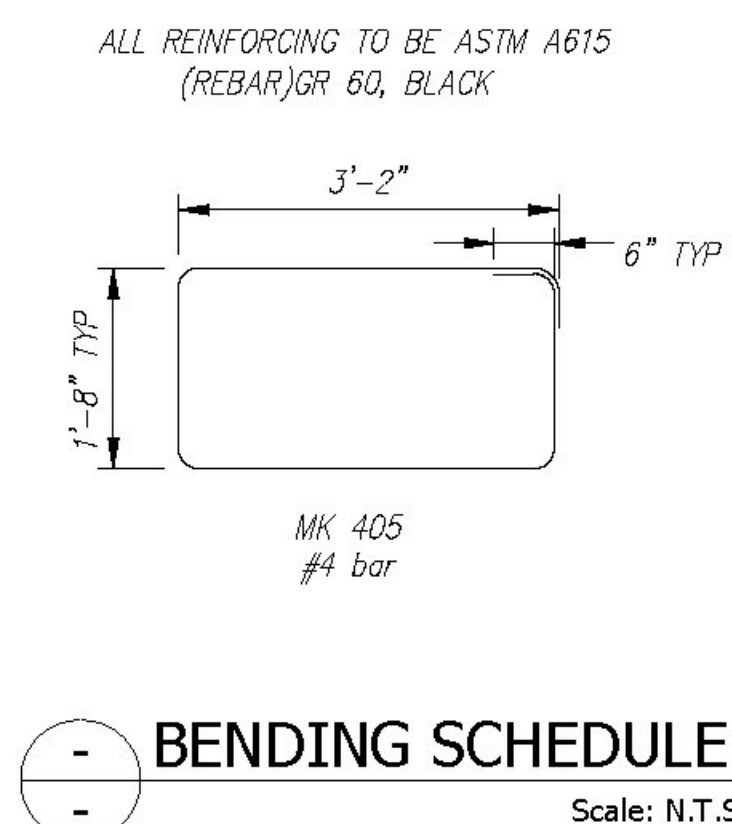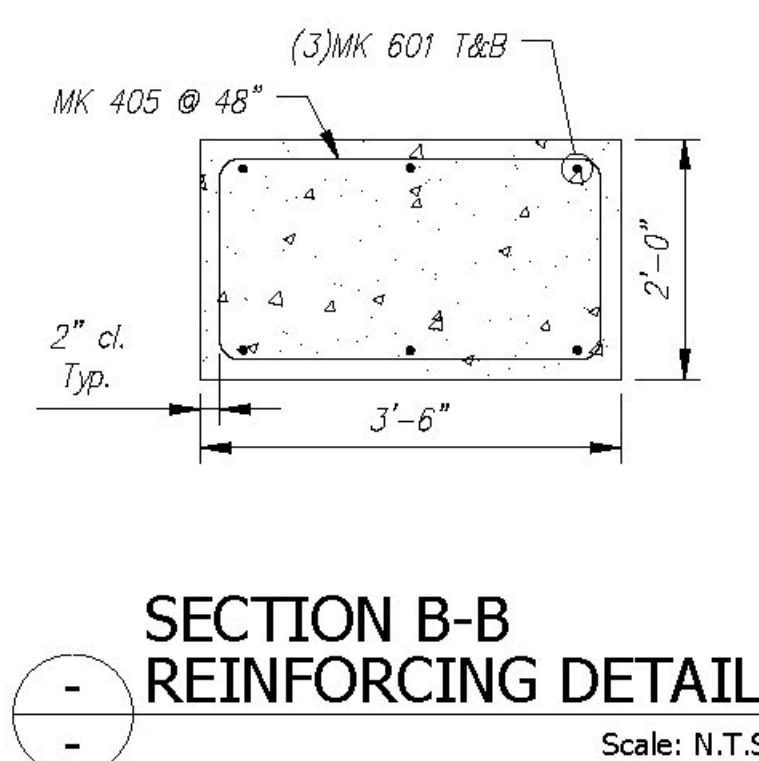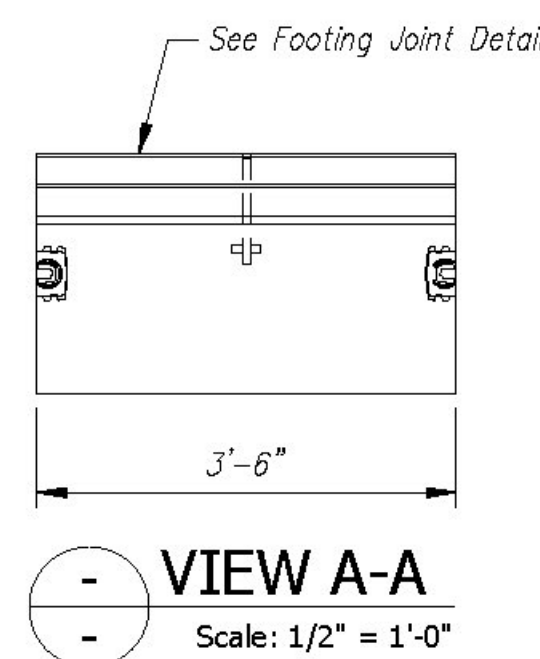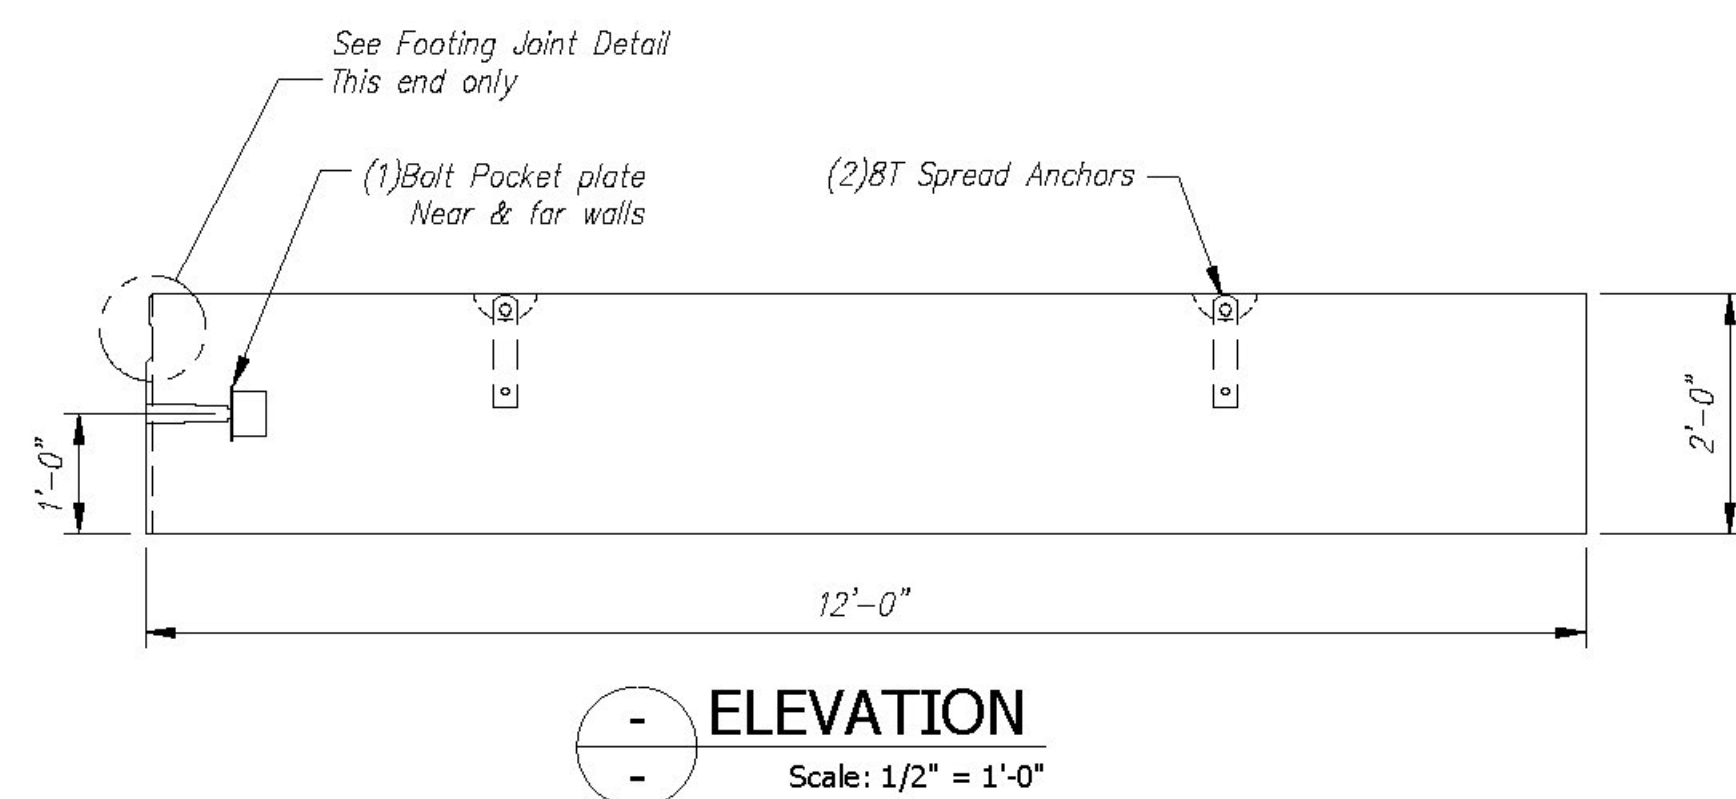

Vermont Agency of Transportation  
**RECEIVED**  
CK'D BY CLB OK'D BY HIS  
July 22, 2015  
RESUBMIT NO Approved  
BY C. CARLSON DATE 07/23/15

Rev.	Date	DESCRIPTION	RY	By
1	14MAY2015	REVISED PER CUSTOMER REVIEW, NEW FOOTING SECTION		
2				
3				
4				
5				
6				
7				
8				
9				
10				

Contractor is to verify that all information shown on drawings has been thoroughly checked, complies with the contract documents and is adequate to meet the field conditions. Some dimensions and details may differ from those shown on drawings. The contractor shall be responsible for the design process. Approval of this drawing indicates that the contractor, from the contract documents has been reviewed and found to be acceptable. Production will not commence until receipt of signed, approved shop drawings.

This drawing contains information proprietary to CONCRETE SYSTEMS, INC. This drawing is disclosed with the understanding that it will be retained in confidence and not be reproduced or transmitted in any form or by any means, electronic or mechanical, including photocopying, recording, or by any information storage and retrieval system, without the prior written permission of CONCRETE SYSTEMS, INC. and that it will be returned to CONCRETE SYSTEMS, INC. upon request.

This drawing is based upon information provided from the following documents and/or sources:  
 Engineer: STATE OF VT/AOT PROGRAM DEVELOPMENT  
 Project No: _____  
 Drawings: STATE OF VT/AOT PROPOSED IMPROVEMENT BRIDGE PROJECT, TOWN OF RICHFORD SHEETS 1,2,4,22,23,24 OF 36  
 Specifications: STANDARD SPECIFICATIONS FOR CONSTRUCTION DATED 2011  
 Other: _____

STATE AGENCY  
  
**Concrete Systems Inc.**  
 9 Commercial St., Hudson, NH, 03051  
 Phone 603-889-4163  
 Fax 603-889-2417


Drawn By: R. YEAGER Date: 14MAY2015  
 Reviewed By: _____ Date: _____  
 Approved By: C. VICK Date: 17JUN2015

G.W. TATRO CONSTRUCTION, INC.  
 VT/AOT BRIDGE REPLACEMENT - ROAD IMPROVEMENT  
 RICHFORD, VT.

Quantity: 1 Project No: BRFO30229 SHEET 14 OF 14

Drawing No. SHOP DRAWING F3B  
 C22312-F3B

REV 1

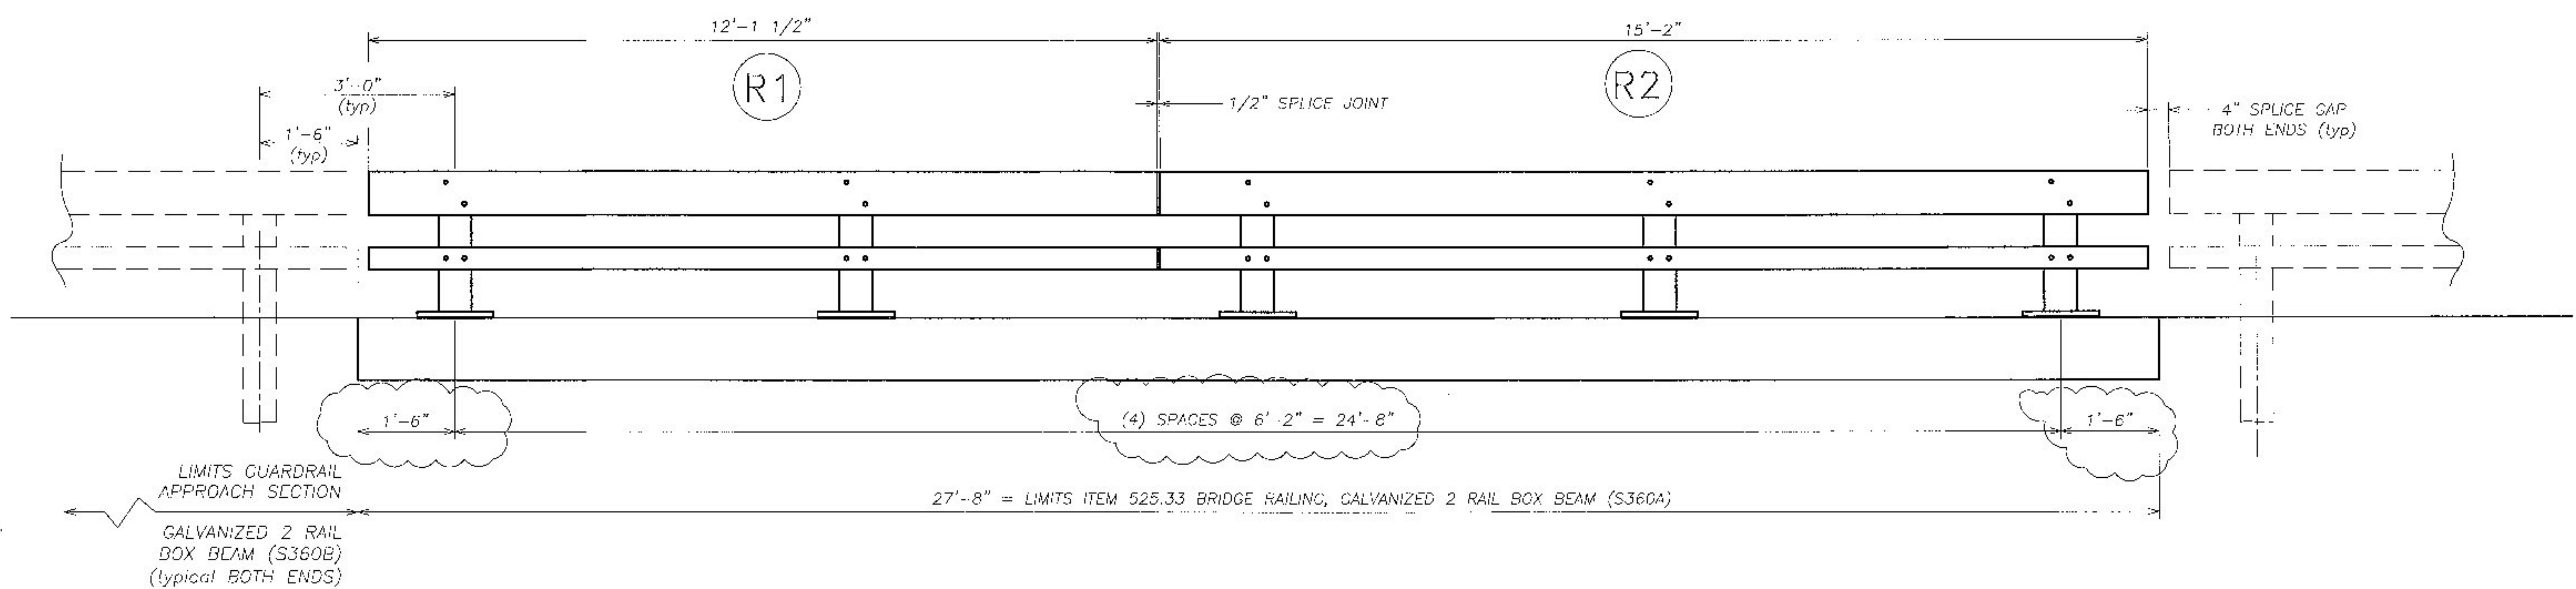

TYPICAL RAILING ELEVATION  
 LOOKING AT FACE OF RAILING FROM CENTERLINE OF ROAD  
 BOTH SIDES TYPICAL

**BILL OF MATERIAL**

ITEM 525.33 BRIDGE RAILING, GALVANIZED 2 RAIL BOX BEAM = 56 LF

Qty	mk	Description	Spec.
10		BRIDGE RAILING POST W6 x 25 x 2'-2.375" OAH WITH 1 x 10 x 14 BASE PLATE (GLV)	A709 gr 50
2		SPLICE TUBE (FOR 8X4 RAIL) HSS 7 x 3 x 3/8 x 1'-8.000" OAL w/ TAPPED HOLES & 2 WELDED NUTS (GLV)	A500 gr B
2		SPLICE TUBE (FOR 4X4 RAIL) HSS 3 x 3 x 5/16 x 1'-8.000" OAL w/ TAPPED HOLES & 2 WELDED NUTS (GLV)	A500 gr B
2	R1	UPPER RAIL TUBE HSS 8 x 4 x 5/16 x 12'-1.500" LG (GLV) one end holes, one end slots	A500 gr B
2	R2	UPPER RAIL TUBE HSS 8 x 4 x 5/16 x 15'-2.000" LG (GLV) one end holes, one end slots	A500 gr B
2	R1	LOWER RAIL TUBE HSS 4 x 4 x 1/4 x 12'-1.500" LG (GLV) one end holes, one end slots	A500 gr B
2	R2	LOWER RAIL TUBE HSS 4 x 4 x 1/4 x 15'-2.000" LG (GLV) one end holes, one end slots	A500 gr B
10		ANCHOR SPACER PLATE PL 0.375 x 13.000 x 9.375	A709 gr 36
40		ANCHOR STUD DBL END PART THREAD - 1" DIA x 12.000 w/ 2.250" THD EACH END (GLV)	A449
80		HEAVY HEX NUT 1" (GLV)	A563 DH
40		ROUND WASHER (SAE) - 1" DIA SMALL (GLV)	F436
40		JAM NUT 1" (GALV)	A563 DH
40		ROUND HEAD POST BOLT slot or wrench head - no shoulder 3/4" DIA x 6" LG. FULL BODY (GLV)	A449 / A325
40		LOCK NUT 3/4" (GLV)	A563 DH
40		ROUND WASHER (SAE) 3/4" (GLV)	F436
16		HEX HEAD BOLT 5/8" DIA x 1.75" LG. (GLV)	A325
16		ROUND WASHER (SAE) 5/8" (GLV)	F436
10		BEARING PAD 0.125" THICK x 10.000 x 14.000 (NEOPRENE 80 duro +/-10)	aashto M251

No.	Remarks	Date
B	changes to match precast drawings	06-19-15
A	changes to match precast drawings	05-14-15
0	initial submittal	04-28-15

Vermont Agency of Transportation

**RECEIVED**

CK'D BY FDB OK'D BY HIS

June 23, 2015

RESUBMIT No Approved

BY Carolyn Carlson DATE 06/23/15

**HIGHWAY SAFETY CORP**

GLASTONBURY, CT  
860-633-9445

ITEM 525.33 BRIDGE RAILING, GALVANIZED 2 RAIL BOX BEAM (S-360A)

BRF 0302 (28)  
TH 3 - BRIDGE NO. 6  
TOWN OF RICHFORD, FRANKLIN COUNTY VT

GENERAL CONTRACTOR




LAFAYETTE

DATE 04-27-15


CERTIFIED FABRICATOR

NSC JOB NO. 2039



SHEET NO. 1 of 3

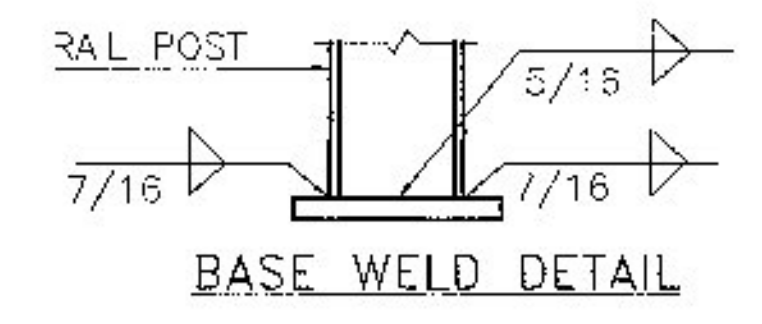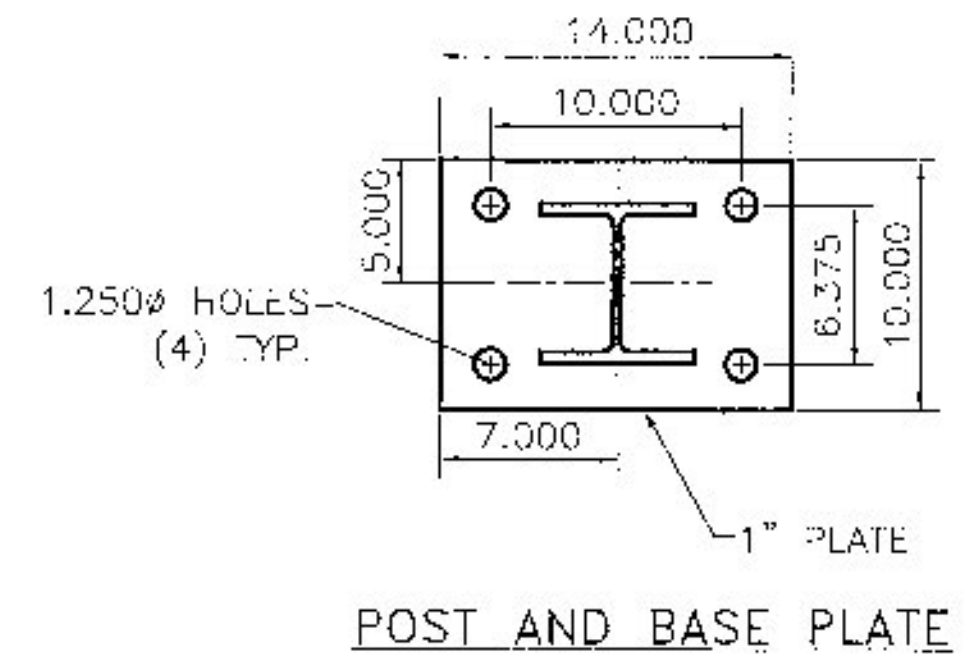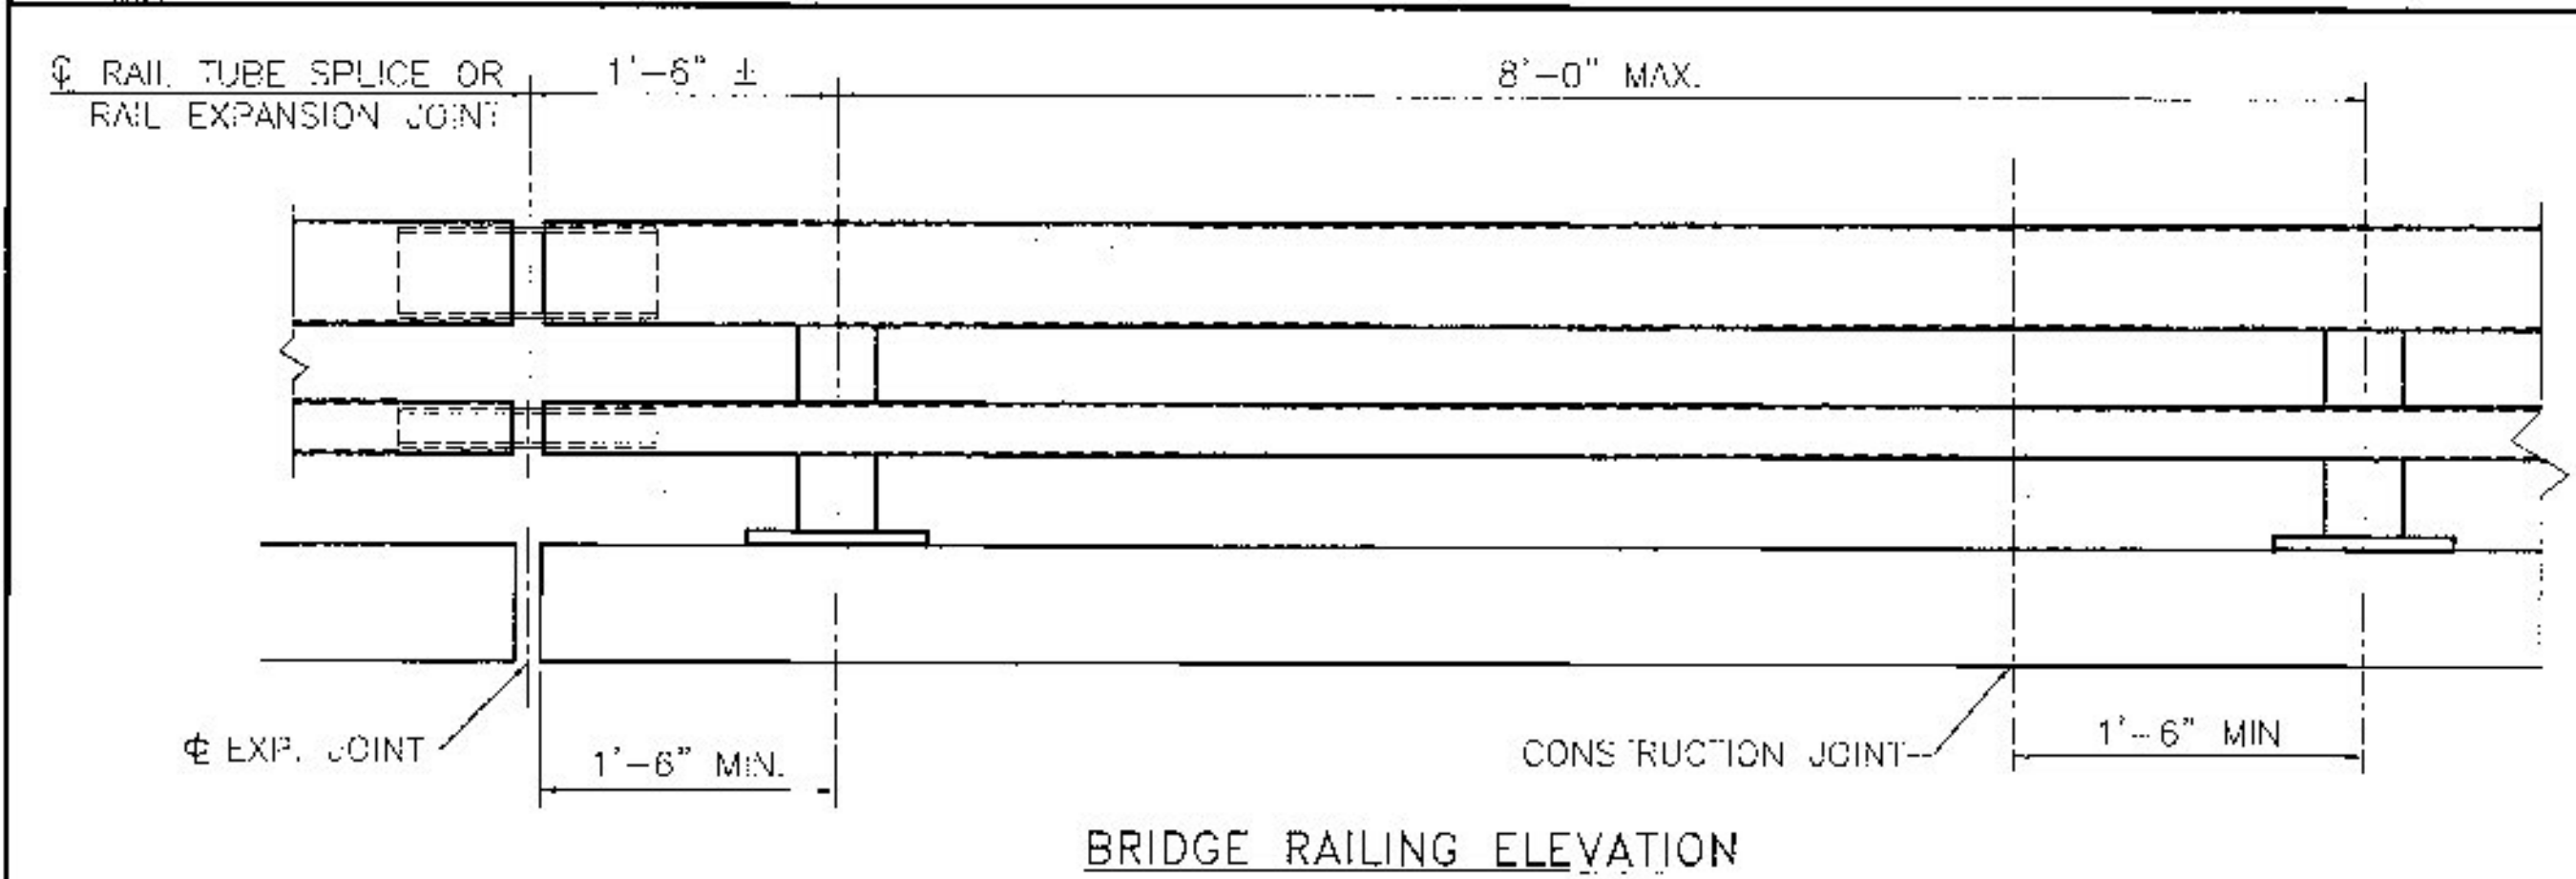








- NOTES:**
1. ALL WORK AND MATERIALS SHALL CONFORM TO SECTION 525.
  2. PRIOR TO GALVANIZING, ALL EXPOSED CUT OR SHEARED EDGES SHALL BE ROUNDED TO A 1/16" RADIUS AND BE FREE OF BURRS.
  3. ALL POSTS SHALL BE SET NORMAL TO GRADE.
  4. SECTIONS OF RAIL TUBE SHALL BE ATTACHED TO A MINIMUM OF TWO (2) RAIL POSTS AND PREFERABLY TO AT LEAST FOUR (4) POSTS.
  5. RAIL TUBE EXPANSION JOINT SHALL BE PROVIDED IN ANY RAIL BAY SPANNING THE END OF AN INTEGRAL ABUTMENT BRIDGE AND AT ALL SLIPERS/STRUCTURAL EXPANSION JOINTS. EXPANSION JOINT WIDTH SHALL BE 4" AT 45° AND WILL BE ADJUSTED IN THE FIELD BY THE ENGINEER FOR OTHER TEMPERATURES.
  6. HOLES IN RAILS FOR RAIL TUBE ATTACHMENT SHALL BE FIELD-DRILLED. HOLES SHALL BE COATED WITH AN APPROVED ZINC-RICH PAINT PRIOR TO INSTALLATION.
  7. RAIL POST ANCHORING NUTS SHALL BE TIGHTENED TO A SNUG FIT AND GIVEN AN ADDITIONAL ONE-FIFTH TURN.
  8. RAIL TUBES SHALL BE ATTACHED USING 3/4" FULL DIAMETER BODY ASTM A449 ROUND HEAD BOLTS INSERTED THROUGH THE FACE OF THE TUBE. HOLES IN POSTS SHALL BE 1/16" LARGER THAN THE BOLT SIZE.
  9. ANY BENDING OR CURVING OF RAIL SHALL BE DONE IN A FABRICATION PLANT IN ACCORDANCE WITH SUBMITTED PROCEDURES.
  10. THE MINIMUM DISTANCE FROM A POST TO AN EXPANSION JOINT SHALL BE SUCH TO MAINTAIN MINIMUM EDGE DISTANCE OF 5" FROM ANY ANCHOR STUD TO THE END OF THE SLAB, OR TO THE EXPANSION JOINT RECESS POUR, IF ONE IS USED.
  11. A DELINEATOR (SEE VDOT STANDARD DRAWING C-1 FOR DETAILS) SHALL BE INSTALLED AT NEAREST POST TO 30 FT SPACING. WHITE IS TO BE INSTALLED ON THE DRIVER'S RIGHT, FOR ONE WAY BRIDGES, YELLOW IS TO BE INSTALLED ON THE DRIVER'S LEFT. PAYMENT SHALL BE INCIDENTAL TO OTHER ITEMS.
  12. THIS RAILING MEETS THE REQUIREMENTS FOR A TL-4 SERVICE LEVEL.

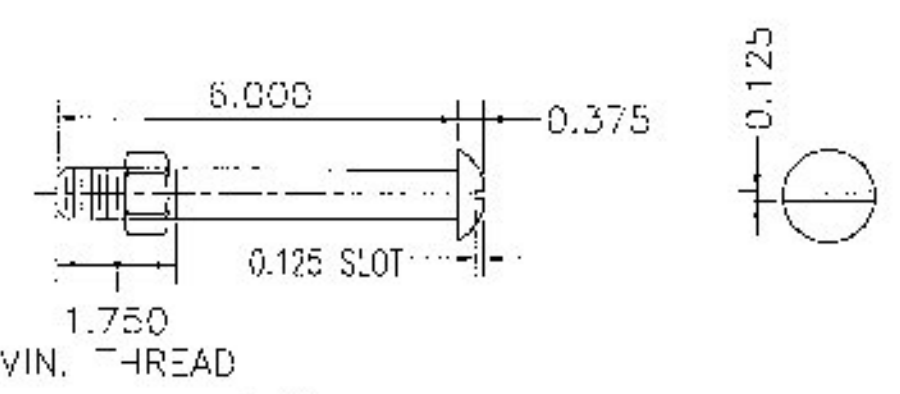

(WITH WASHER AND PREVAILING TORQUE TYPE LOCK NUT)  
(SEE NOTE #8)  
ONLY FULL DIAMETER BODY BOLTS WILL BE ALLOWED.

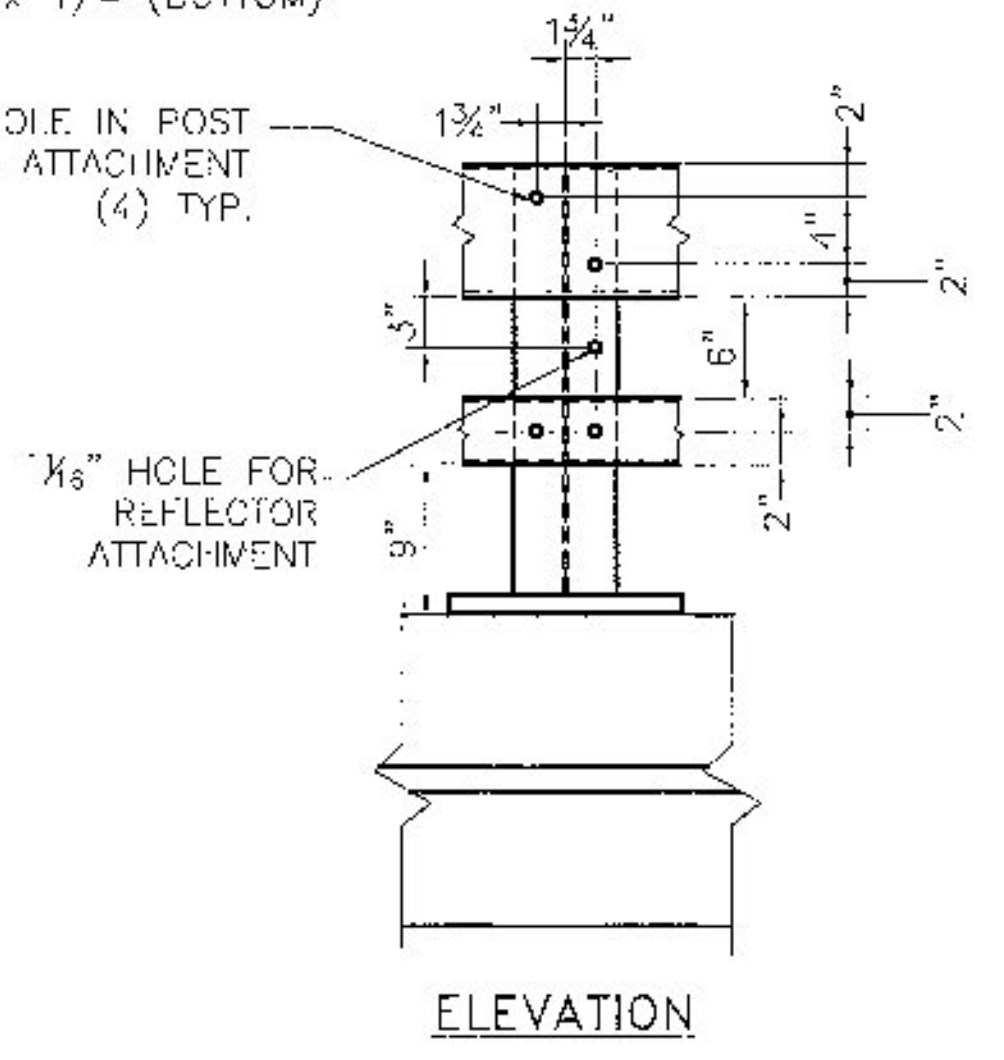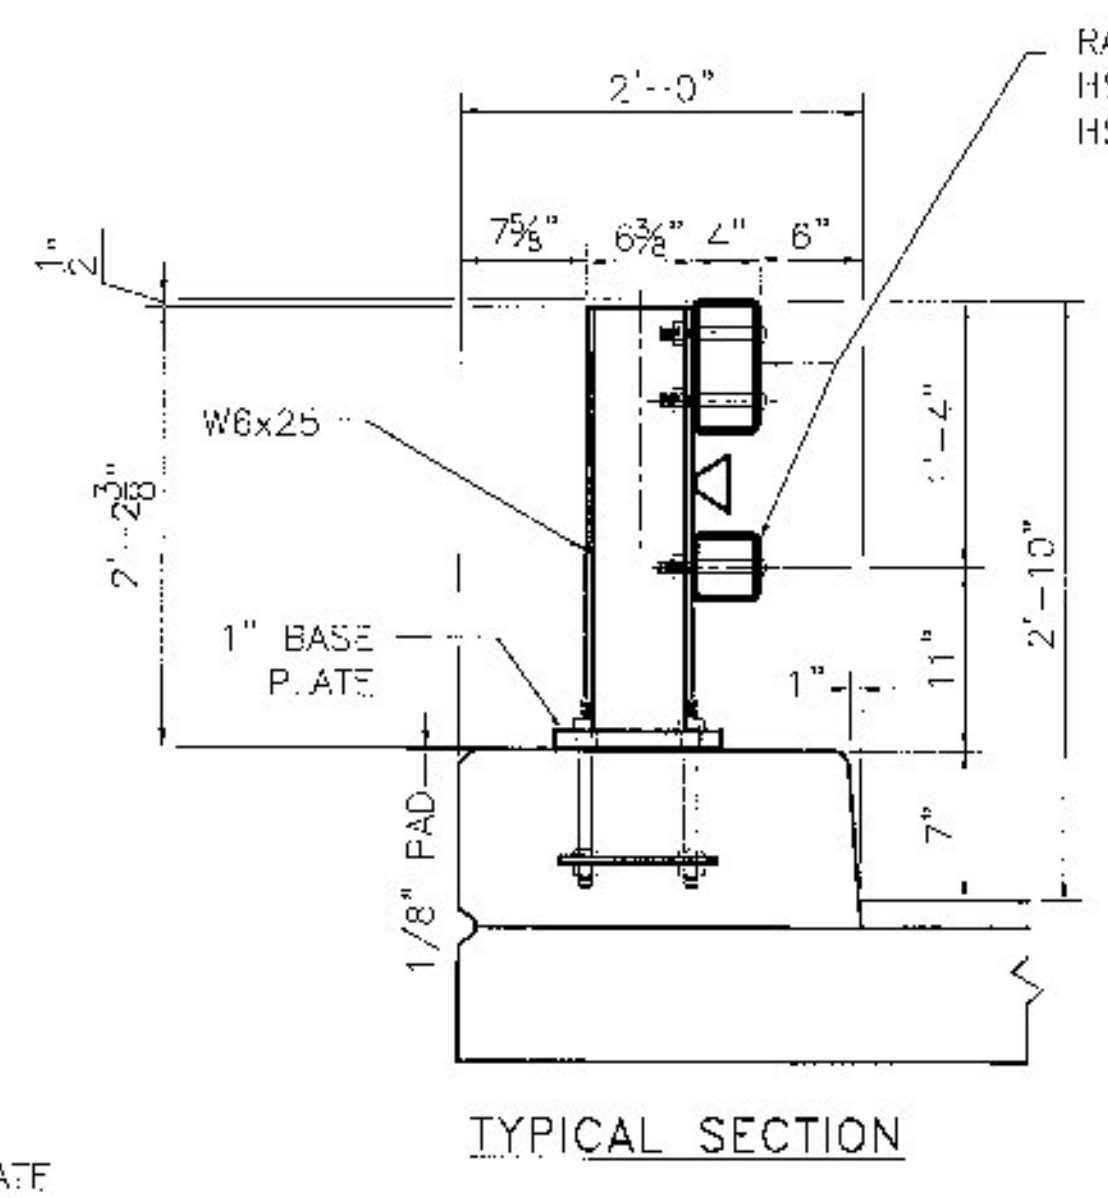

- MATERIALS**
- RAIL TUBES.....ASTM A500 GRADE B OR ASTM A501
  - RAIL POSTS AND BASE PLATES.....ASTM A709/A709M, GRADE 50
  - ALL OTHER SHAPES AND PLATES.....ASTM A709/A709M, GRADE 50
  - ANCHOR STUDS.....ASTM A449
  - ALL OTHER BOLTS (UNLESS NOTED).....AASHTO M164, TYPE 1
  - NUTS FOR AASHTO M164 BOLTS AND FOR ANCHOR STUDS SHALL COMPLY WITH AASHTO M291 (ASTM A563).
  - WASHERS SHALL COMPLY WITH AASHTO M293 (ASTM F436) SPECIFICATIONS.
  - 1/8" PAD SHALL COMPLY WITH STANDARD SPECIFICATION SUBSECTION 731.01 OR 731.02.
  - RAIL POSTS AND BASE PLATES SHALL BE TESTED FOR IMPACT PROPERTIES IN ACCORDANCE WITH ASTM A370 C-APPY IMPACT TESTING USING TYPE A SPECIMEN.

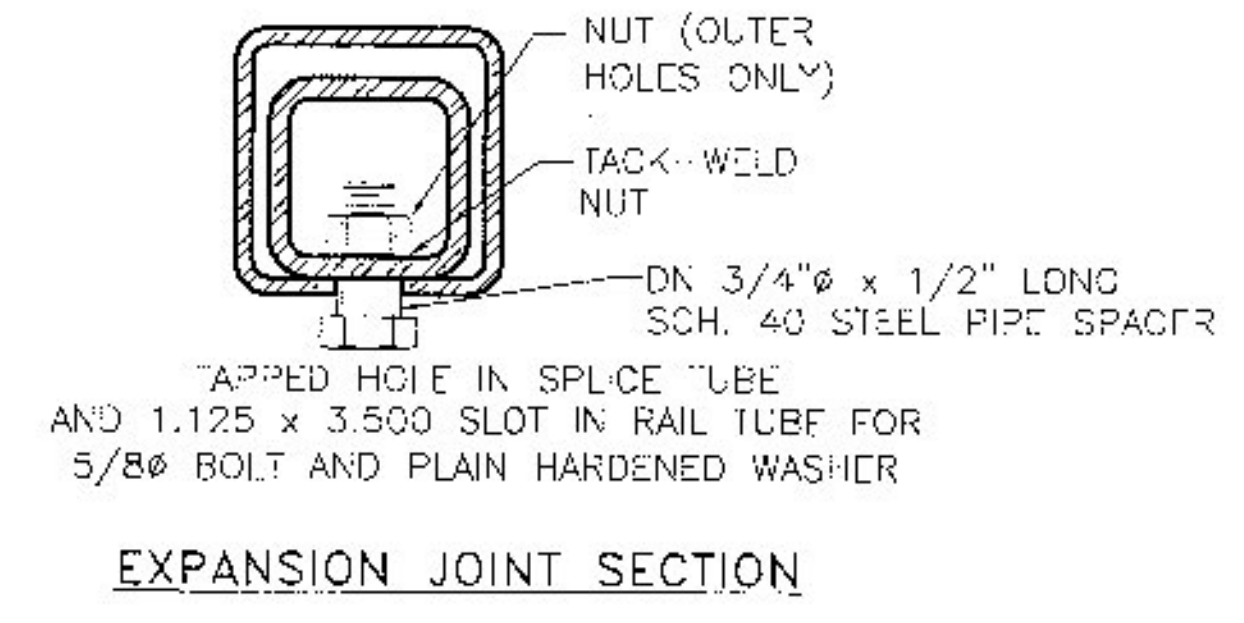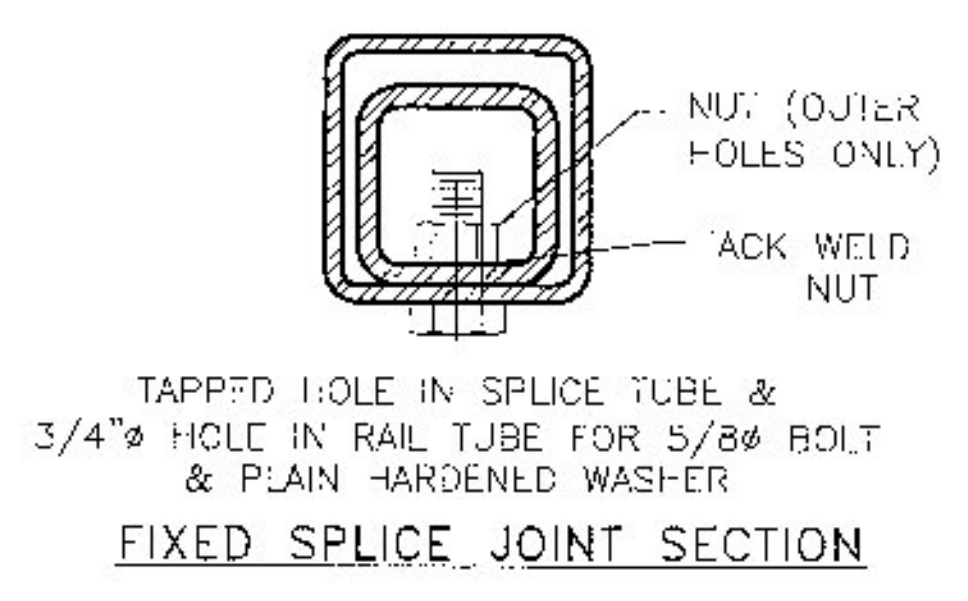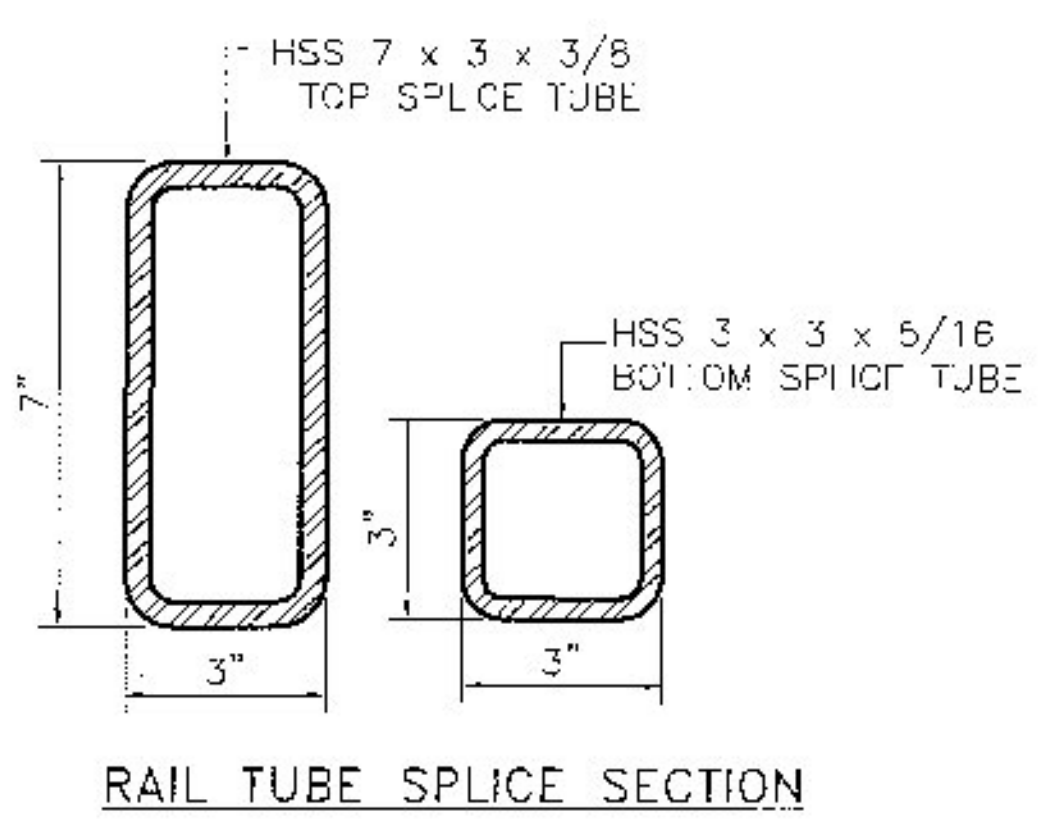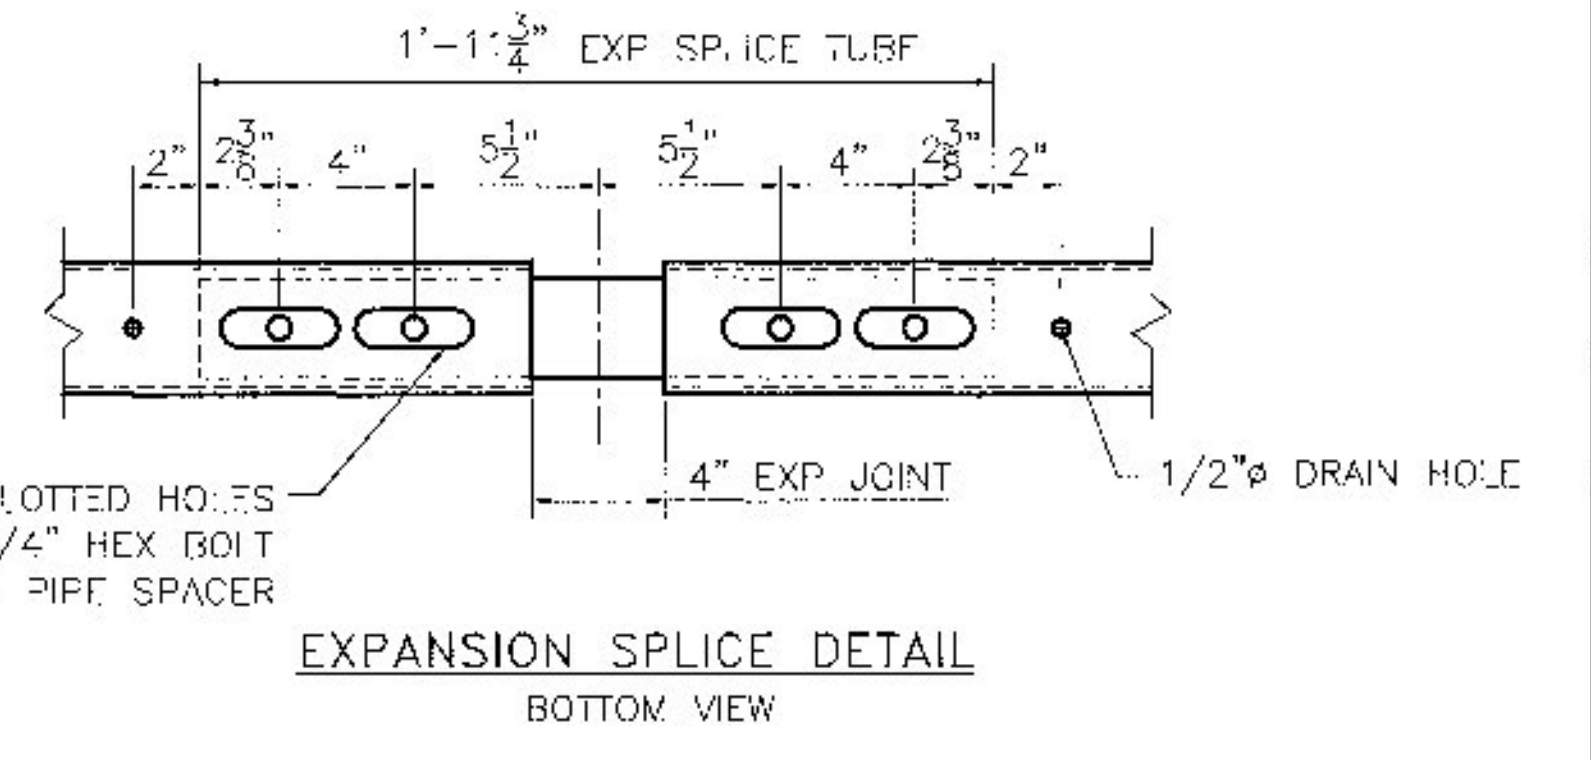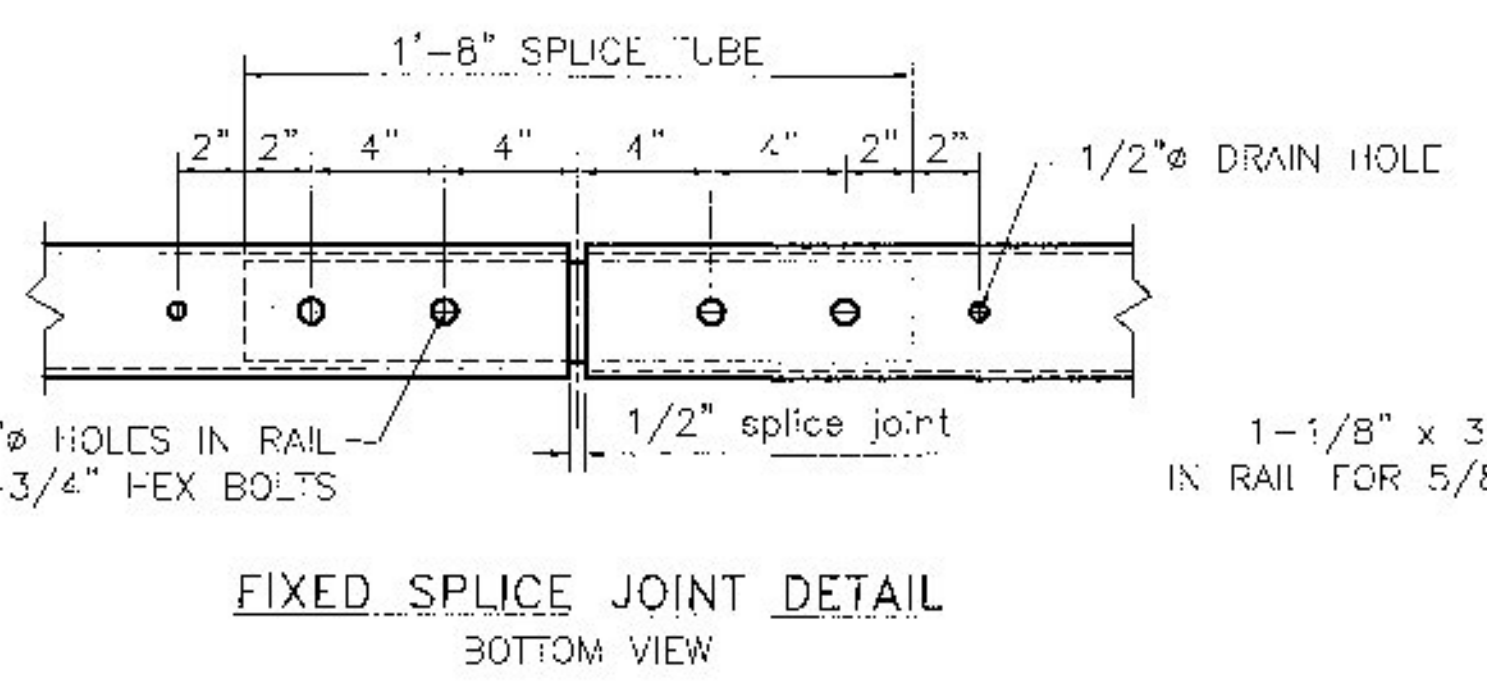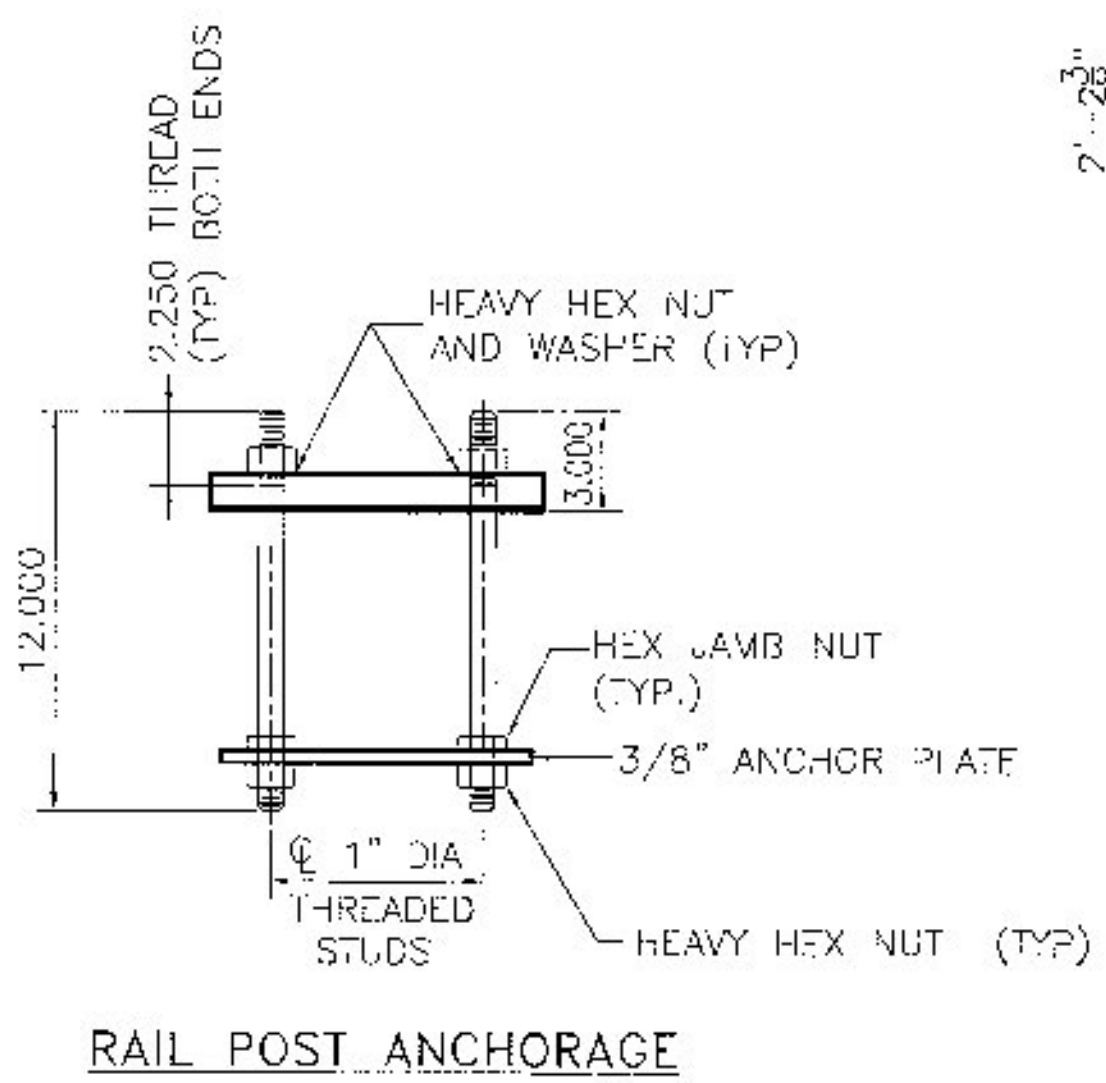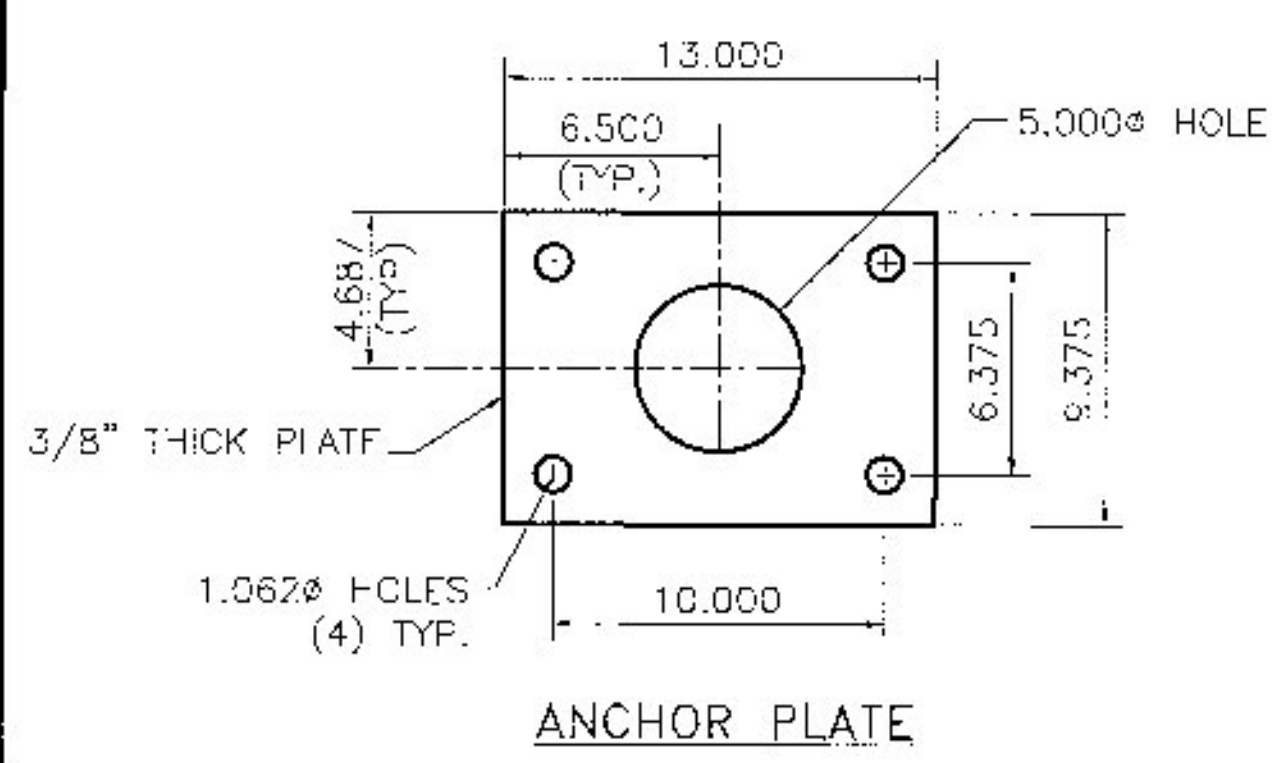

Vermont Agency of Transportation

RECEIVED

CK'D BY FDB OK'D BY HIS

June 23, 2015

RESUBMIT No Approved

BY Carolyn Carlson DATE 06/23/15

HIGHWAY SAFETY CORP

GLASTONBURY, CT  
860-633-9415

ITEM 525.33 BRIDGE RAILING, GALVANIZED 2 RAIL BOX BEAM (S-360A)



BRF 0302 (29)  
TH 3 - BRIDGE NO. 6  
TOWN OF RICHFORD, FRANKLIN COUNTY VT

GENERAL CONTRACTOR

LAFAYETTE

SCALE 2 of 3

DATE 04-27-15

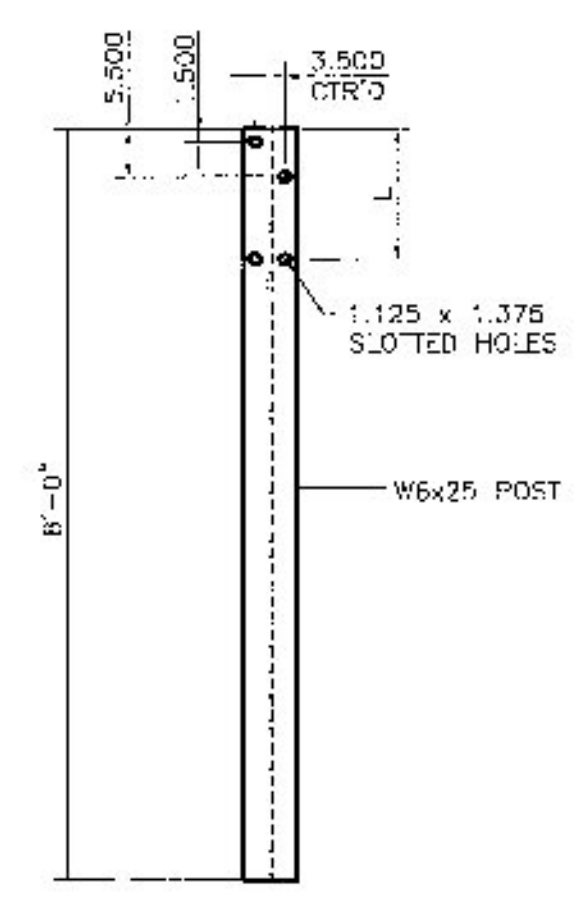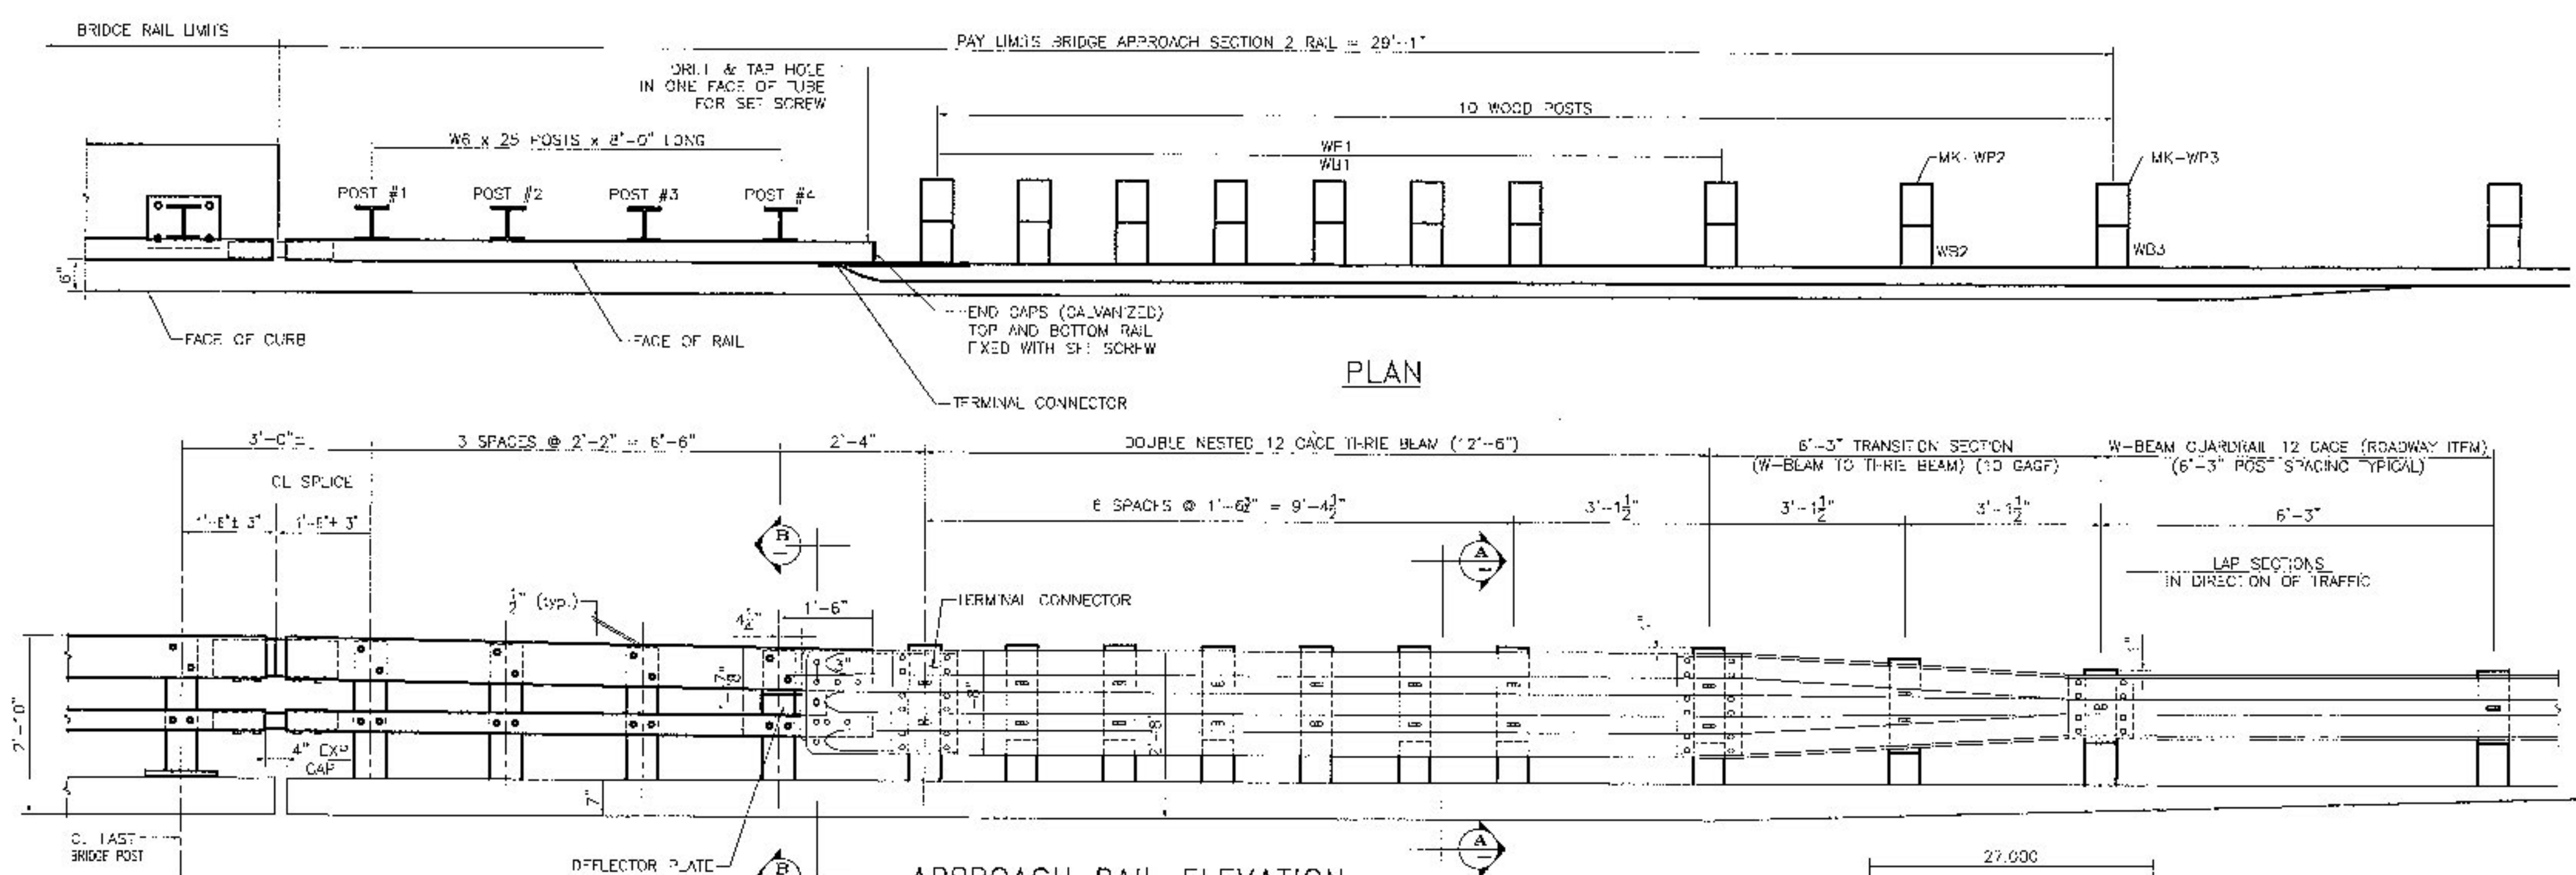


STEEL POST

STEEL POST CHART

No.	L
#1	1'-3.250"
#2	1'-3.000"
#3	1'-2.667"
#4	1'-2.375"

- NOTES:
1. PAYMENT FOR GUARDRAIL APPROACH SECTION - GALVANIZED 2 RAIL, SHALL INCLUDE THE TERMINAL CONNECTOR, THE CONNECTION PLATE, THE DEFLECTOR PLATE, RAIL, POSTS, BLOCKS AND ATTACHMENT HARDWARE.
  2. ALL APPROACH RAIL SPLICES SHALL BE LAPPED IN THE DIRECTION OF TRAFFIC FLOW.
  3. TUBE AND STEEL POST MATERIALS, DIMENSION SIZES AND NOTES SHALL BE THE SAME AS THOSE OF THE BRIDGE RAIL UNLESS OTHERWISE NOTED.
  4. APPROACH RAIL BOLTS SHALL BE ASTM A327 GRADE A AND NUTS SHALL BE ASTM A291 (ASTM A63 GRADE A OR BETTER (GALVANIZED)), WASHERS SHALL BE ASTM F844.
  5. W6x25 TOP SPLICE BAR TO FIT 30x3. USE COMPLETE PENETRATION WELD (9-L2).

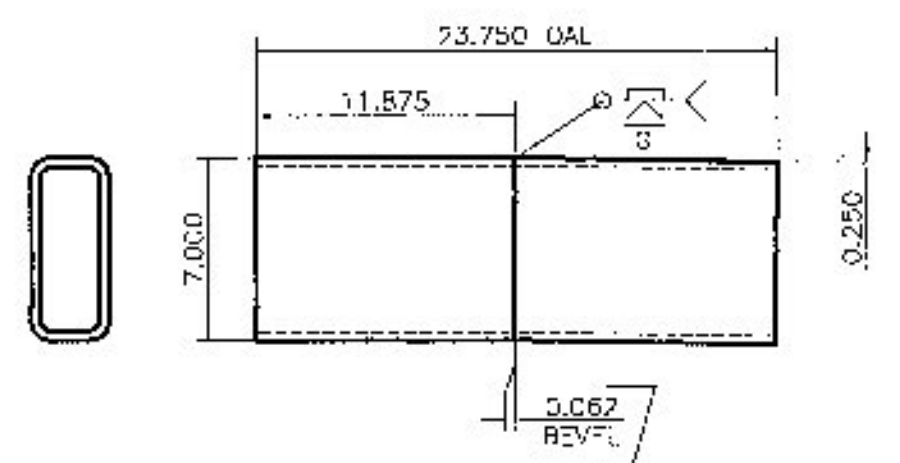

ANGLED SPLICE DETAIL


HSS 7 x 3 x 3/8 - FOR UPPER RAIL. SEE BRIDGE RAIL SHEET FOR DETAIL ON LOWER RAIL SPLICE TUBE.

APPROACH RAIL ELEVATION  
LEADING END (RIGHT) IS SHOWN  
DEPARTURE END (LEFT) SIMILAR BUT OPPOSITE HAND

BILL OF MATERIAL



ITEM 621.72 GUARDRAIL APPROACH SECTION, GALVANIZED 2 RAIL BOX BEAM = 4 UNITS

Qty	mk	Description	Spec.
4	01	W6x25 APPROACH POST - #1 x 8'-0" OAL (GALV)	A709 gr 50
4	02	W6x25 APPROACH POST - #2 x 8'-0" OAL (GALV)	A709 gr 50
4	03	W6x25 APPROACH POST - #3 x 8'-0" OAL (GALV)	A709 gr 50
4	04	W6x25 APPROACH POST - #4 x 8'-0" OAL (GALV)	A709 gr 50
4		UPPER RAIL APPROACH TUBE HSS 8 x 4 x 5/16 x 9'-4.000" w/ 3.500 SLOTS FOR 4" EXP GAP (GALV)	A500 gr B
4		LOWER RAIL APPROACH TUBE HSS 4 x 4 x 5/16 x 9'-4.000" w/ 3.500 SLOTS FOR 4" EXP GAP (GALV)	A500 gr B
4		CONNECTION PLATE PL 0.375" x 20.000" x 27.000" (GALV)	A709 gr 36
2		DEFLECTOR PLATE (RIGHT) PL 0.375 x 4.000 x 13.375 (GALV)	A709 gr 36
2		DEFLECTOR PLATE (LEFT) PL 0.375 x 4.000 x 13.375 (GALV)	A709 gr 36
4		END CAP FOR 8x4 TUBE 0.187 THICK PLATE 8.000 x 4.000 w/ WELDED TABS (GALV)	A709 gr 36
4		END CAP FOR 4x4 TUBE 0.187 THICK PLATE 4.000 x 4.000 w/ WELDED TABS (GALV)	A709 gr 36
4		(ANGLED) SPLICE TUBE (EXPANSION) FOR 8x4 UPPER RAIL HSS 7 x 3 x 3/8 x 1'-11.750" OAL (GALV)	A500 gr B
4		SPLICE TUBE (EXPANSION) FOR 4x4 LOWER RAIL HSS 3 x 3 x 5/16 x 1'-11.750" OAL (GALV)	A500 gr B
32		WOOD POST (WP1) 6 x 8 x 7'-0"	TIMBER
32		WOOD BLOCKOUT (WB1) 6 x 8 x 1'-6"	TIMBER
4		WOOD POST (WP2) 6 x 8 x 7'-0"	TIMBER
4		WOOD BLOCKOUT (WB2) 6 x 8 x 1'-6"	TIMBER
4		WOOD POST (WP3) 6 x 8 x 7'-0"	TIMBER
4		WOOD BLOCKOUT (WB3) 6 x 8 x 1'-2"	TIMBER
4		THREE FLAT LIP BRIDGE SHOE (MODIFIED) 10 GA. GALV	ashto M180 B2
4		THREE TRANSITION PANEL 6'-3" / 3'-1 1/2" 10 GA. GALV.	ashto M180 B2
8		THREE PANEL 12'-6" / 1'-6 3/4" 12 GA. GALV.	ashto M180 A2
92		ROUND HEAD POST BOLT slot or wrench head - no shoulder 3/4" DIA x 6" LG. (GLV) w/ LOCK NUT & FLAT WASHER	A449
4		ROUND HEAD POST BOLT slot or wrench head - no shoulder 3/4" DIA x 2" LG. (GLV) w/ HEX NUT	A449
8		ROUND HEAD POST BOLT - oval shoulder 5/8" DIA x 1'-8" LG. (GALV) w/ DBL RECESS NUT, FLAT WASHER	A307
68		ROUND HEAD POST BOLT - oval shoulder 5/8" DIA x 1'-6" LG. (GALV) w/ DBL RECESS NUT, FLAT WASHER	A307
32		HEX HEAD BOLT 5/8 x 1-3/4" (GALV) w/ FLAT WASHER	A325
128		PANEL SPLICE BOLT 5/8 x 1-1/4" (GALV) w/ DOUBLE RECESSED NUT	A307
76		RECTANGULAR PLATE WASHER 0.187 x 1.760 x 3.000 (GALV)	A709 gr 36
32		SPACER PIPE - GALVANIZED 3/4" SCH. 40 x 1/2" LONG (GLV)	A53 gr B

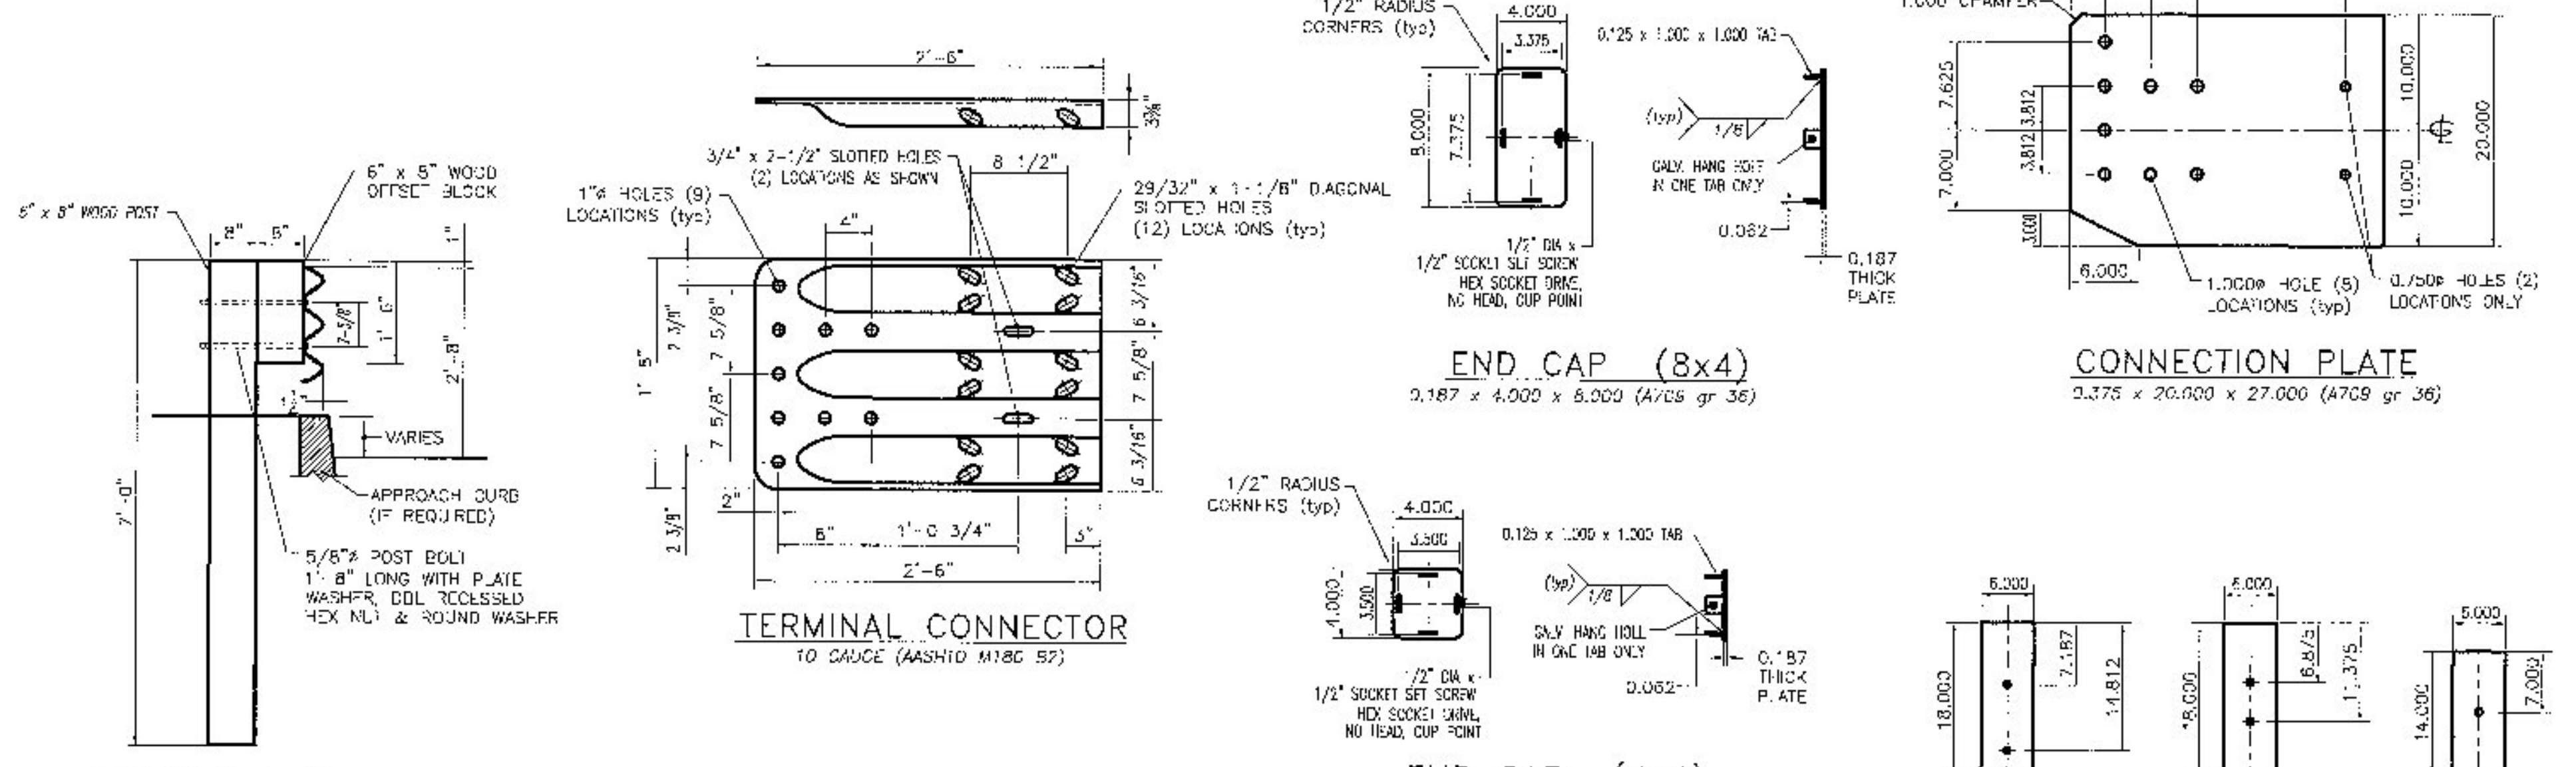


SECTION A-A

SECTION B-B

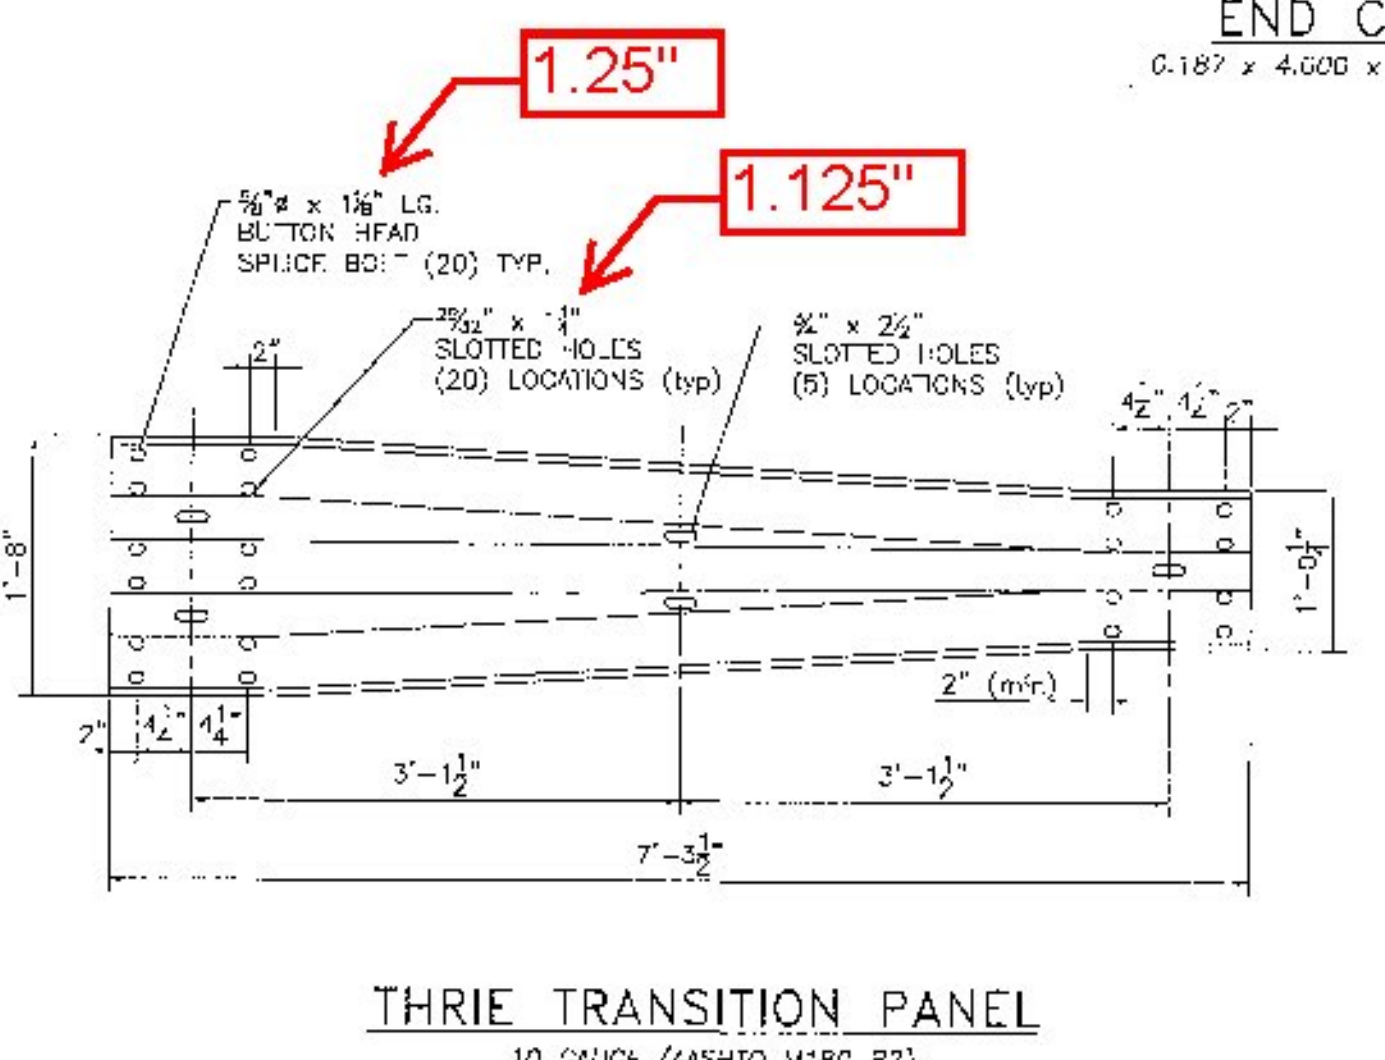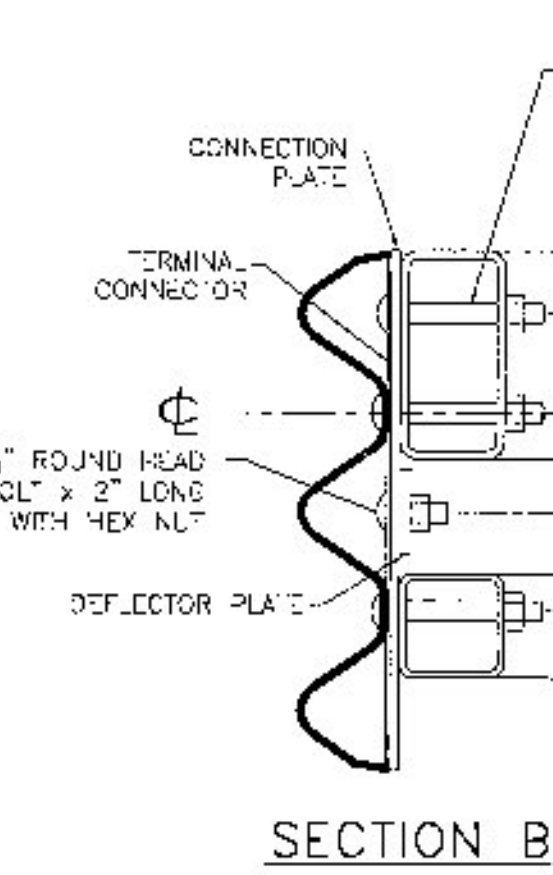

THREE TRANSITION PANEL  
10 GAUGE (AASHTO M180 B2)

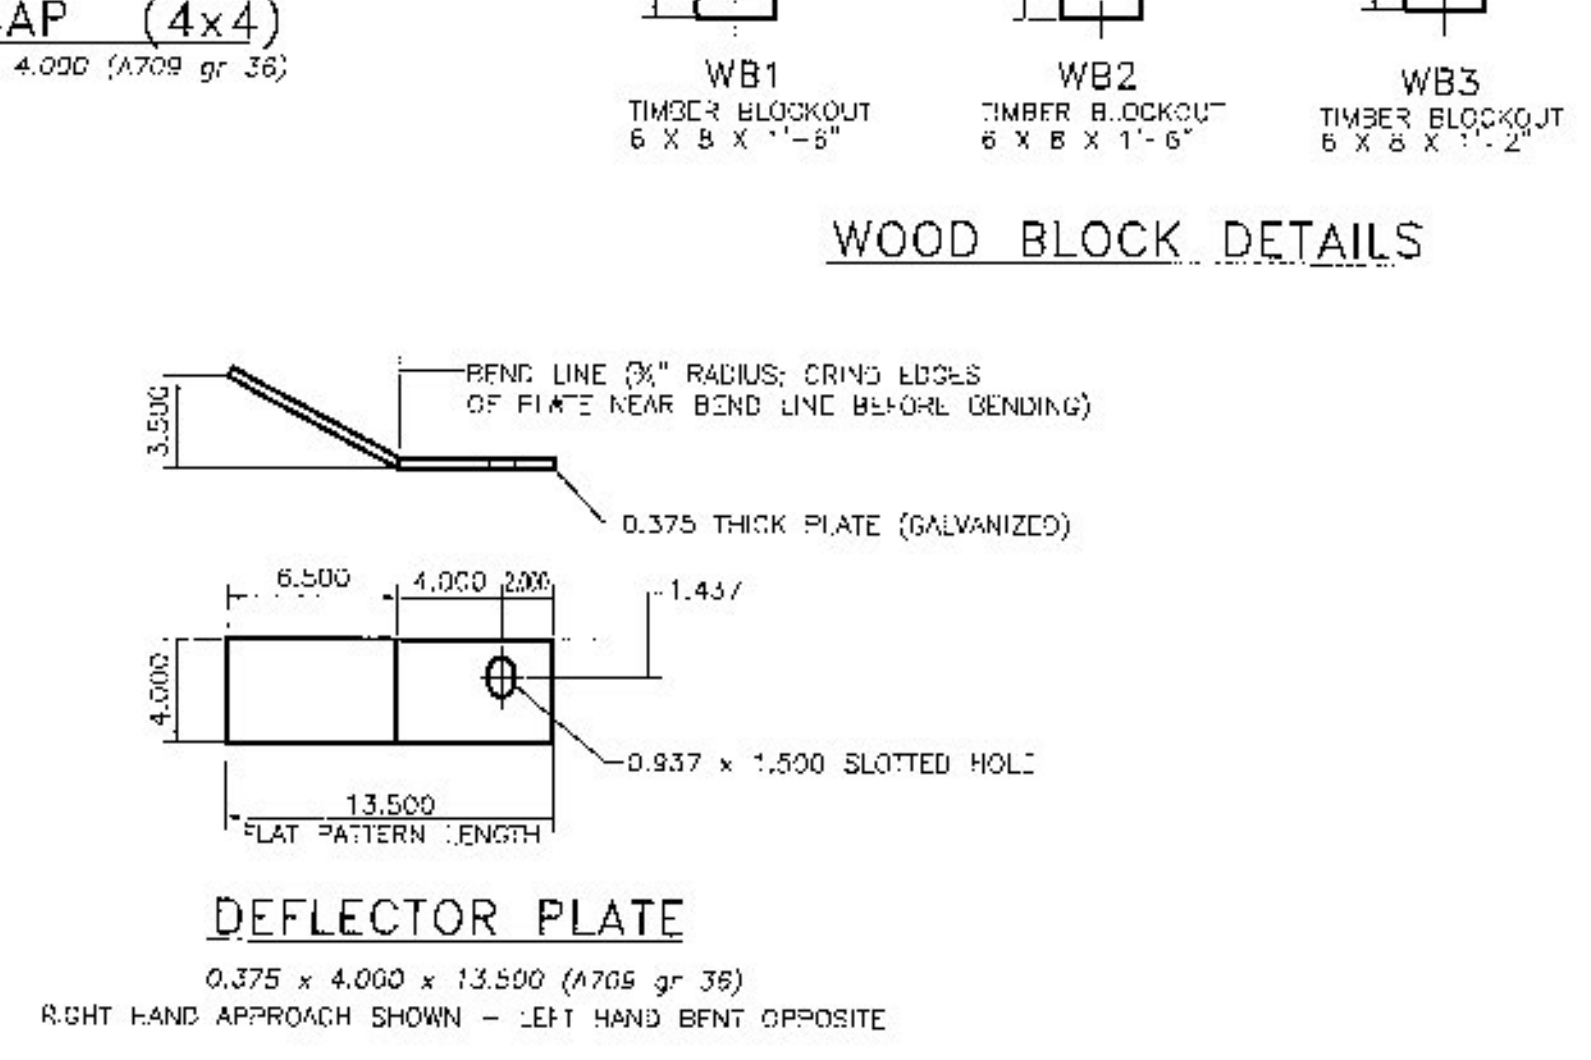

WOOD BLOCK DETAILS

DEFLECTOR PLATE  
0.375 x 4.000 x 13.500 (A709 gr 36)  
RIGHT HAND APPROACH SHOWN - LEFT HAND BENT OPPOSITE

Vermont Agency of Transportation

**RECEIVED**

CK'D BY FDB OK'D BY HIS

June 23, 2015

RESUBMIT No Approved AsNoted

BY Carolyn Carlson DATE 06/23/15

**HIGHWAY SAFETY CORP**

GLASTONBURY, CT  
860-633-9445

ITEM 621.72 GUARDRAIL APPROACH, GALVANIZED 2 RAIL BOX BEAM (S-3609)

BRF 0302 (29)  
TH 3 - BRIDGE NO. 6  
TOWN OF RICHFORD, FRANKLIN COUNTY VT












CERTIFIED FABRICATOR

2039

3 of 3

LAFAYETTE





04-27-15

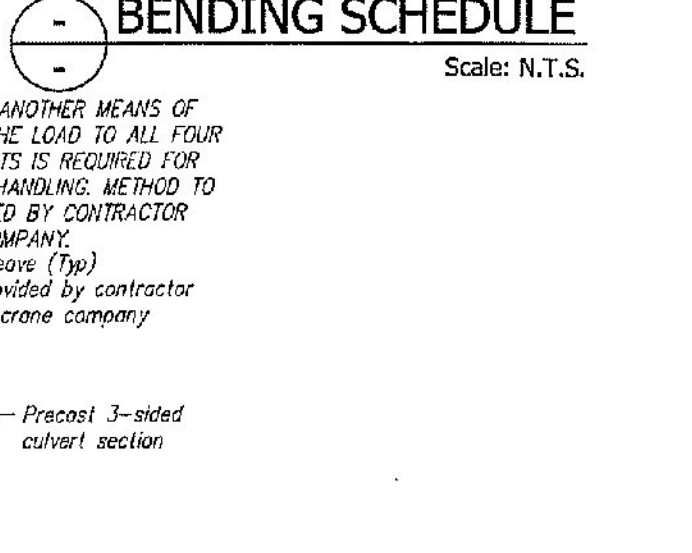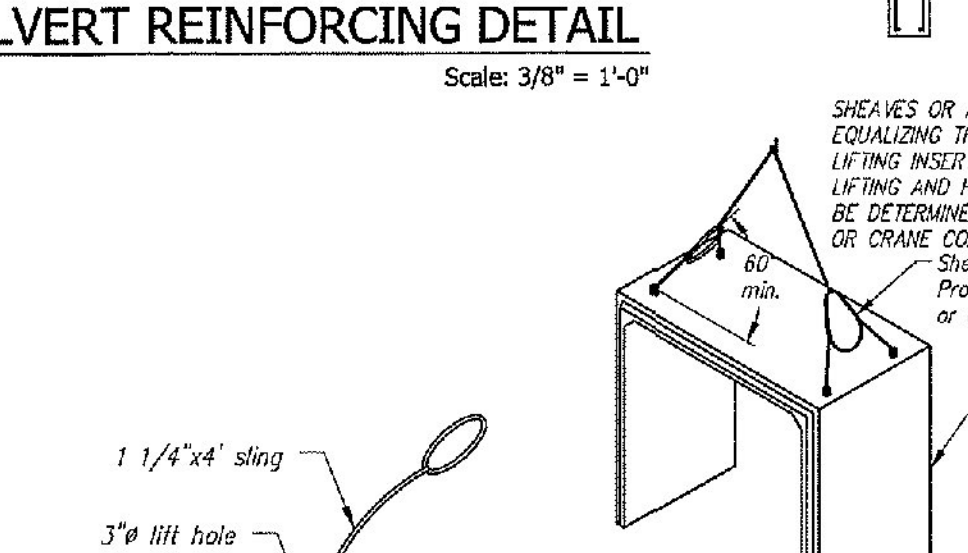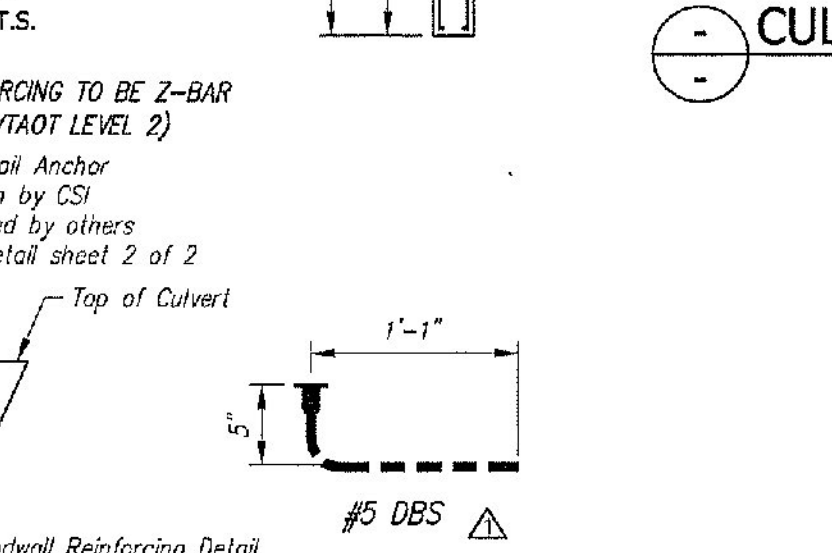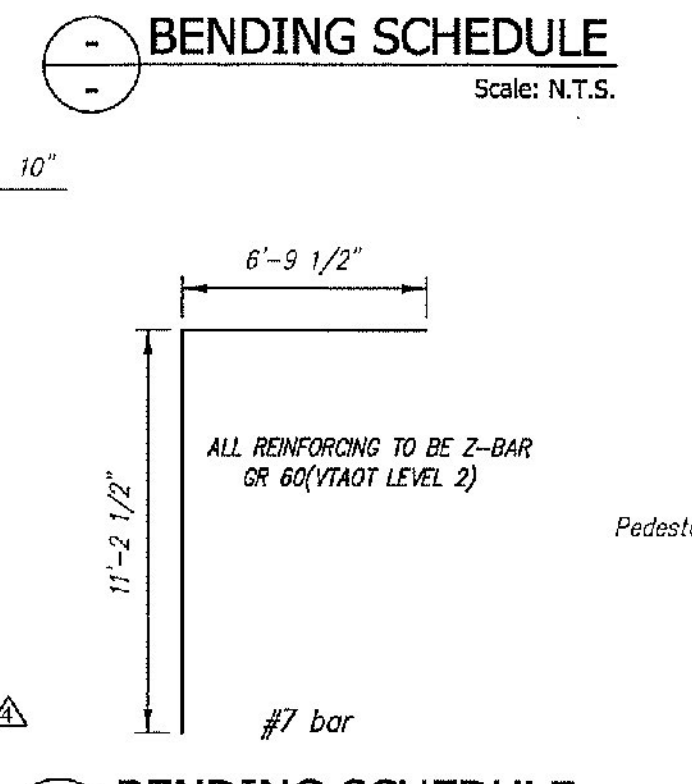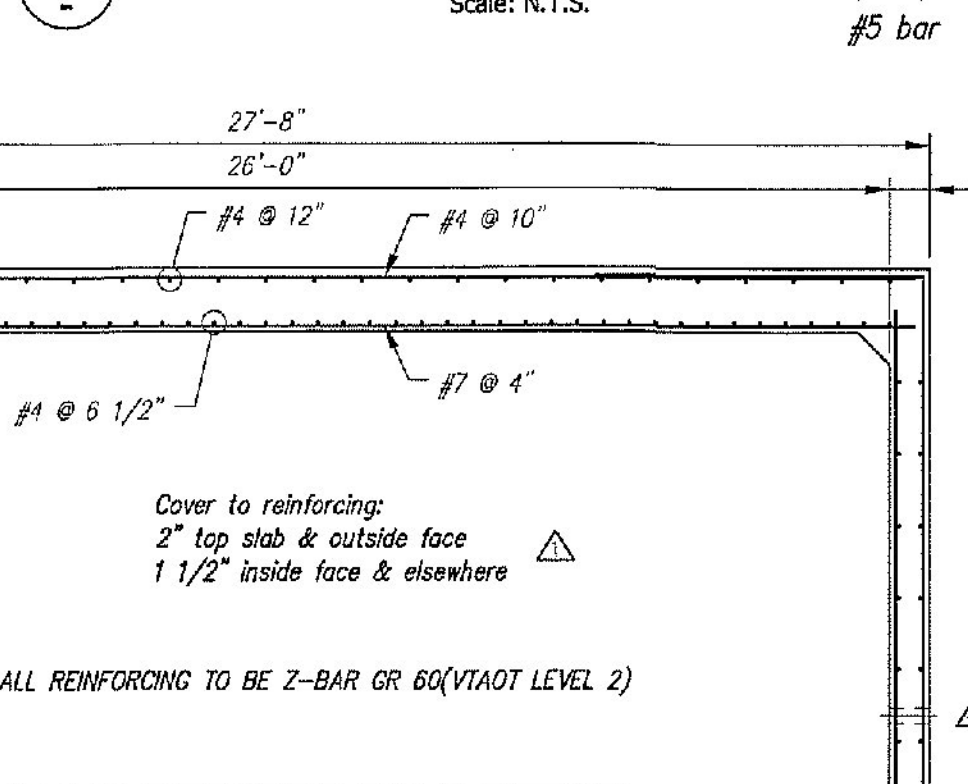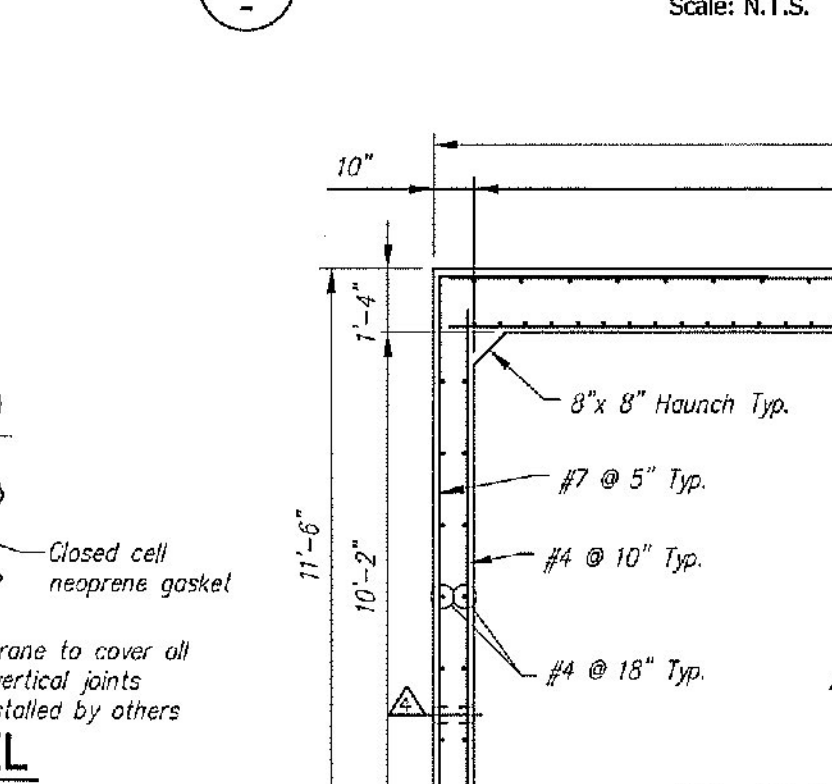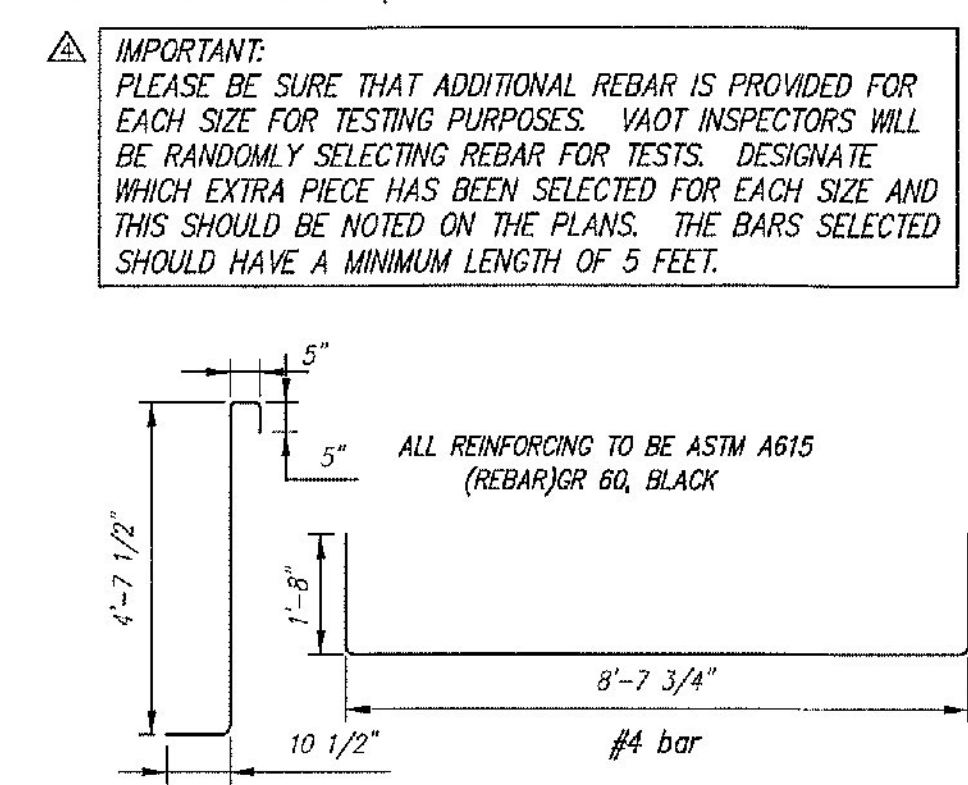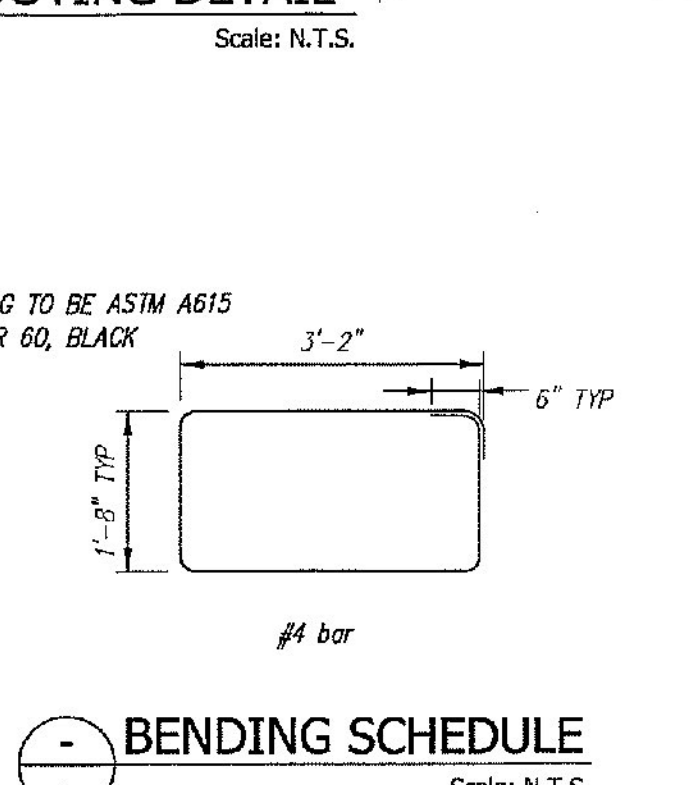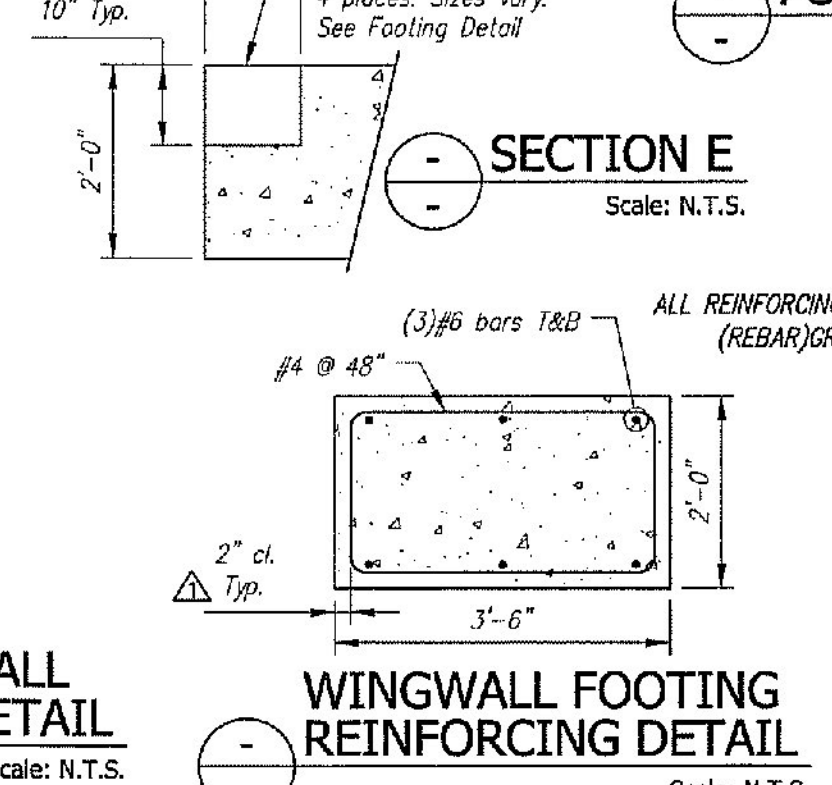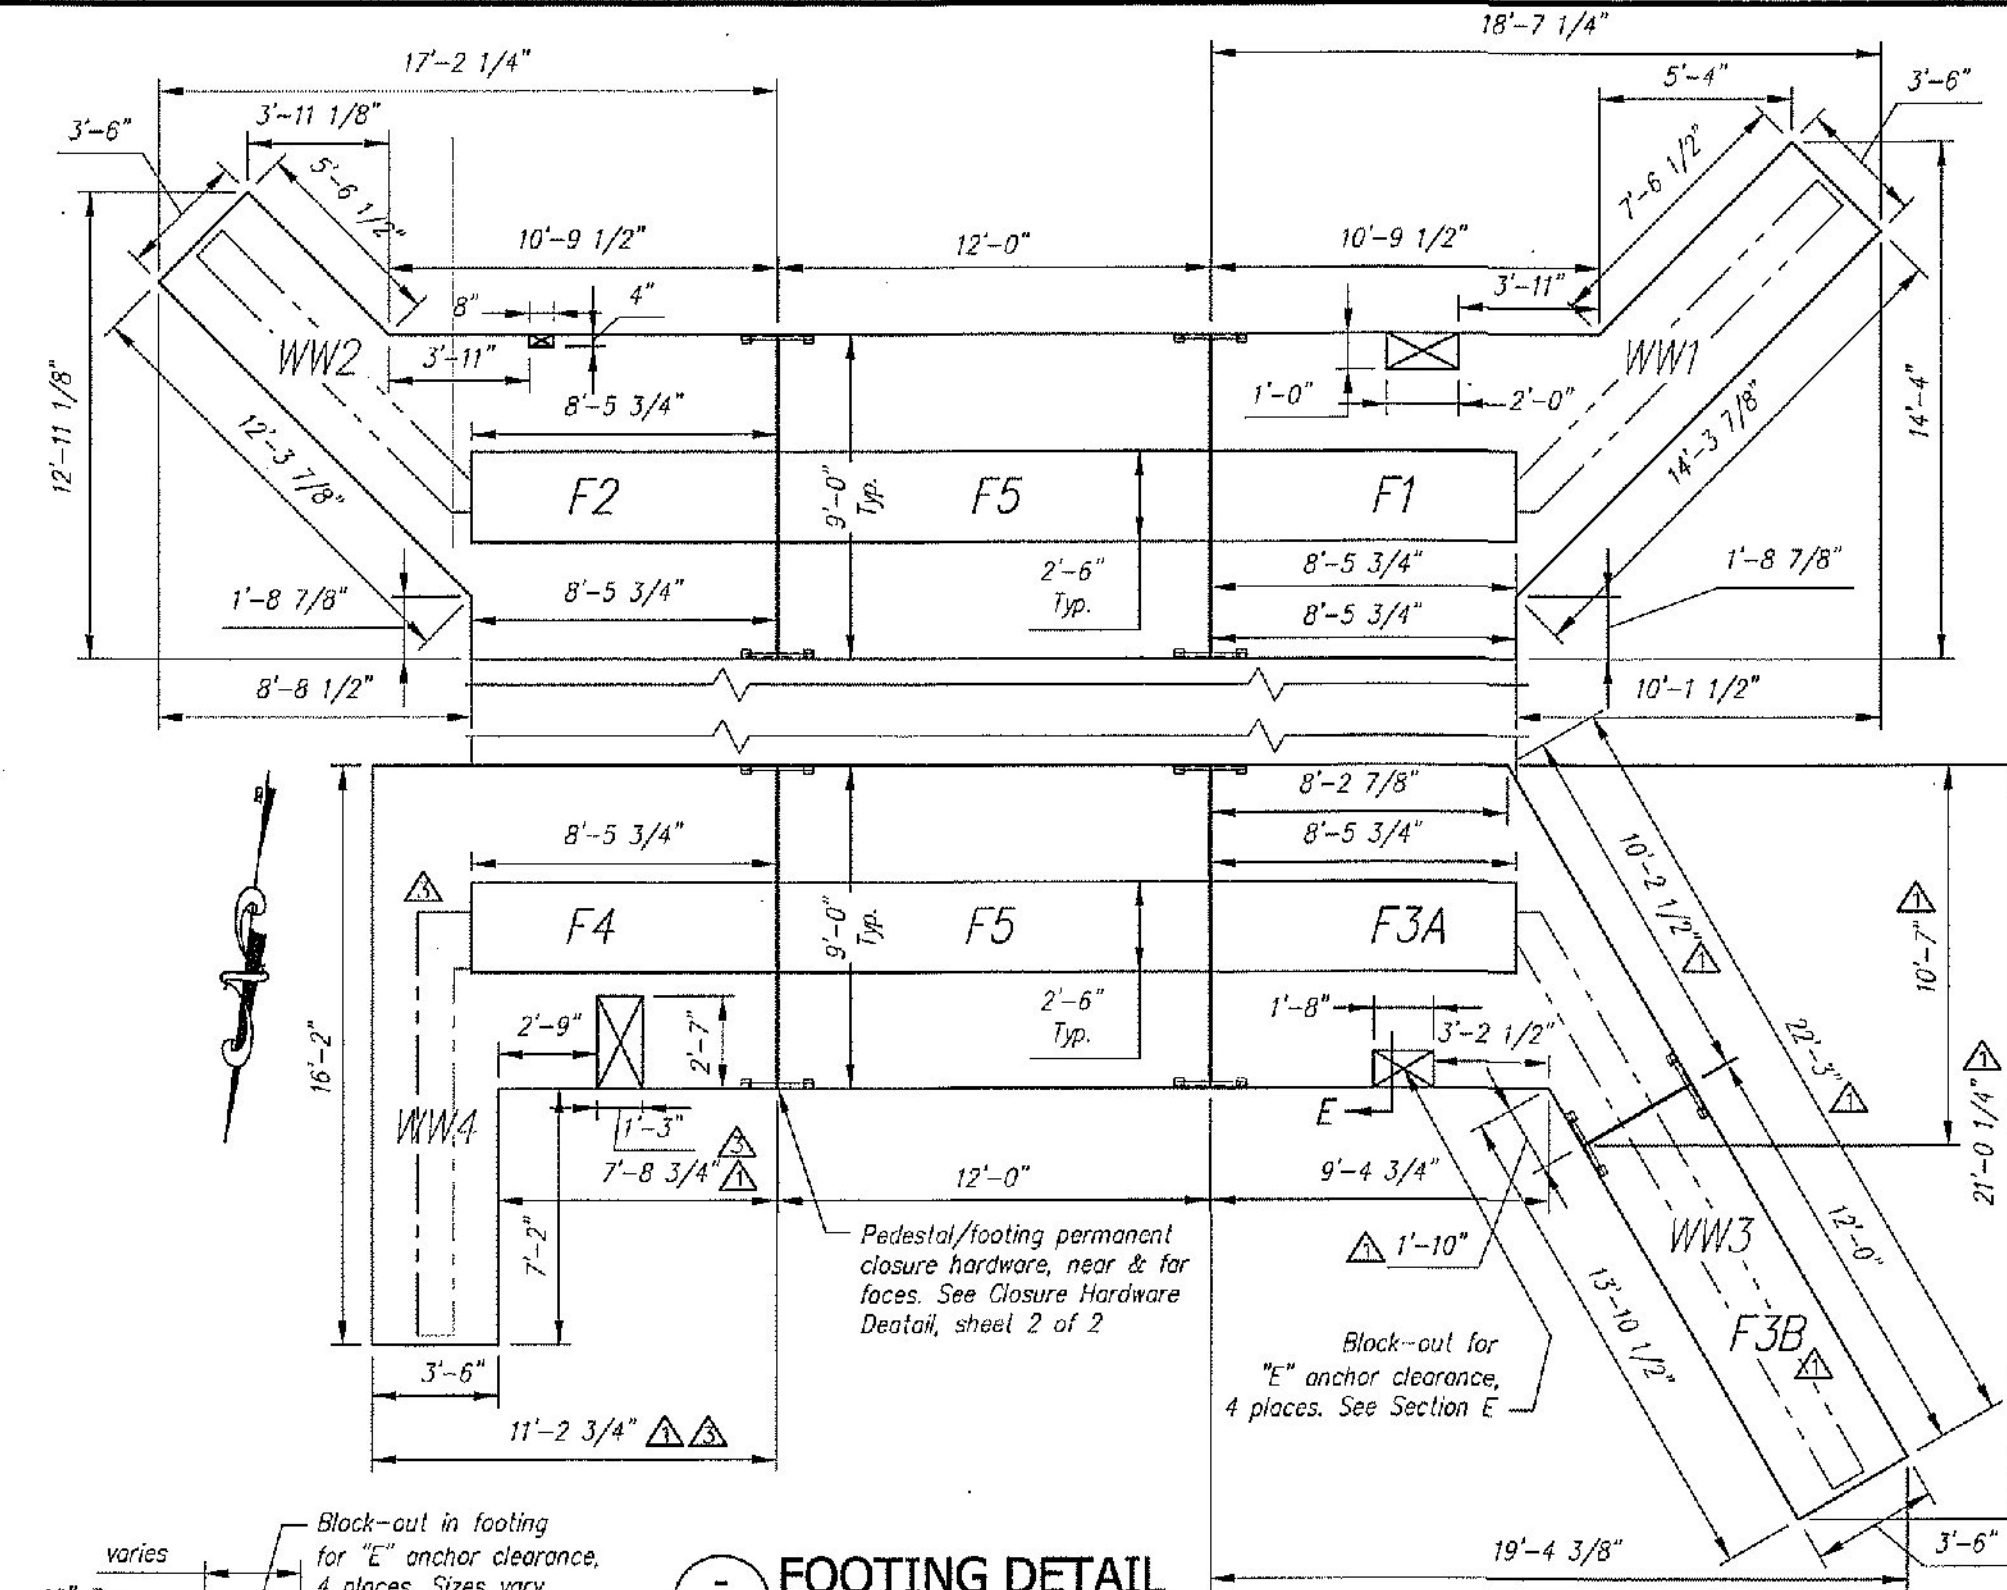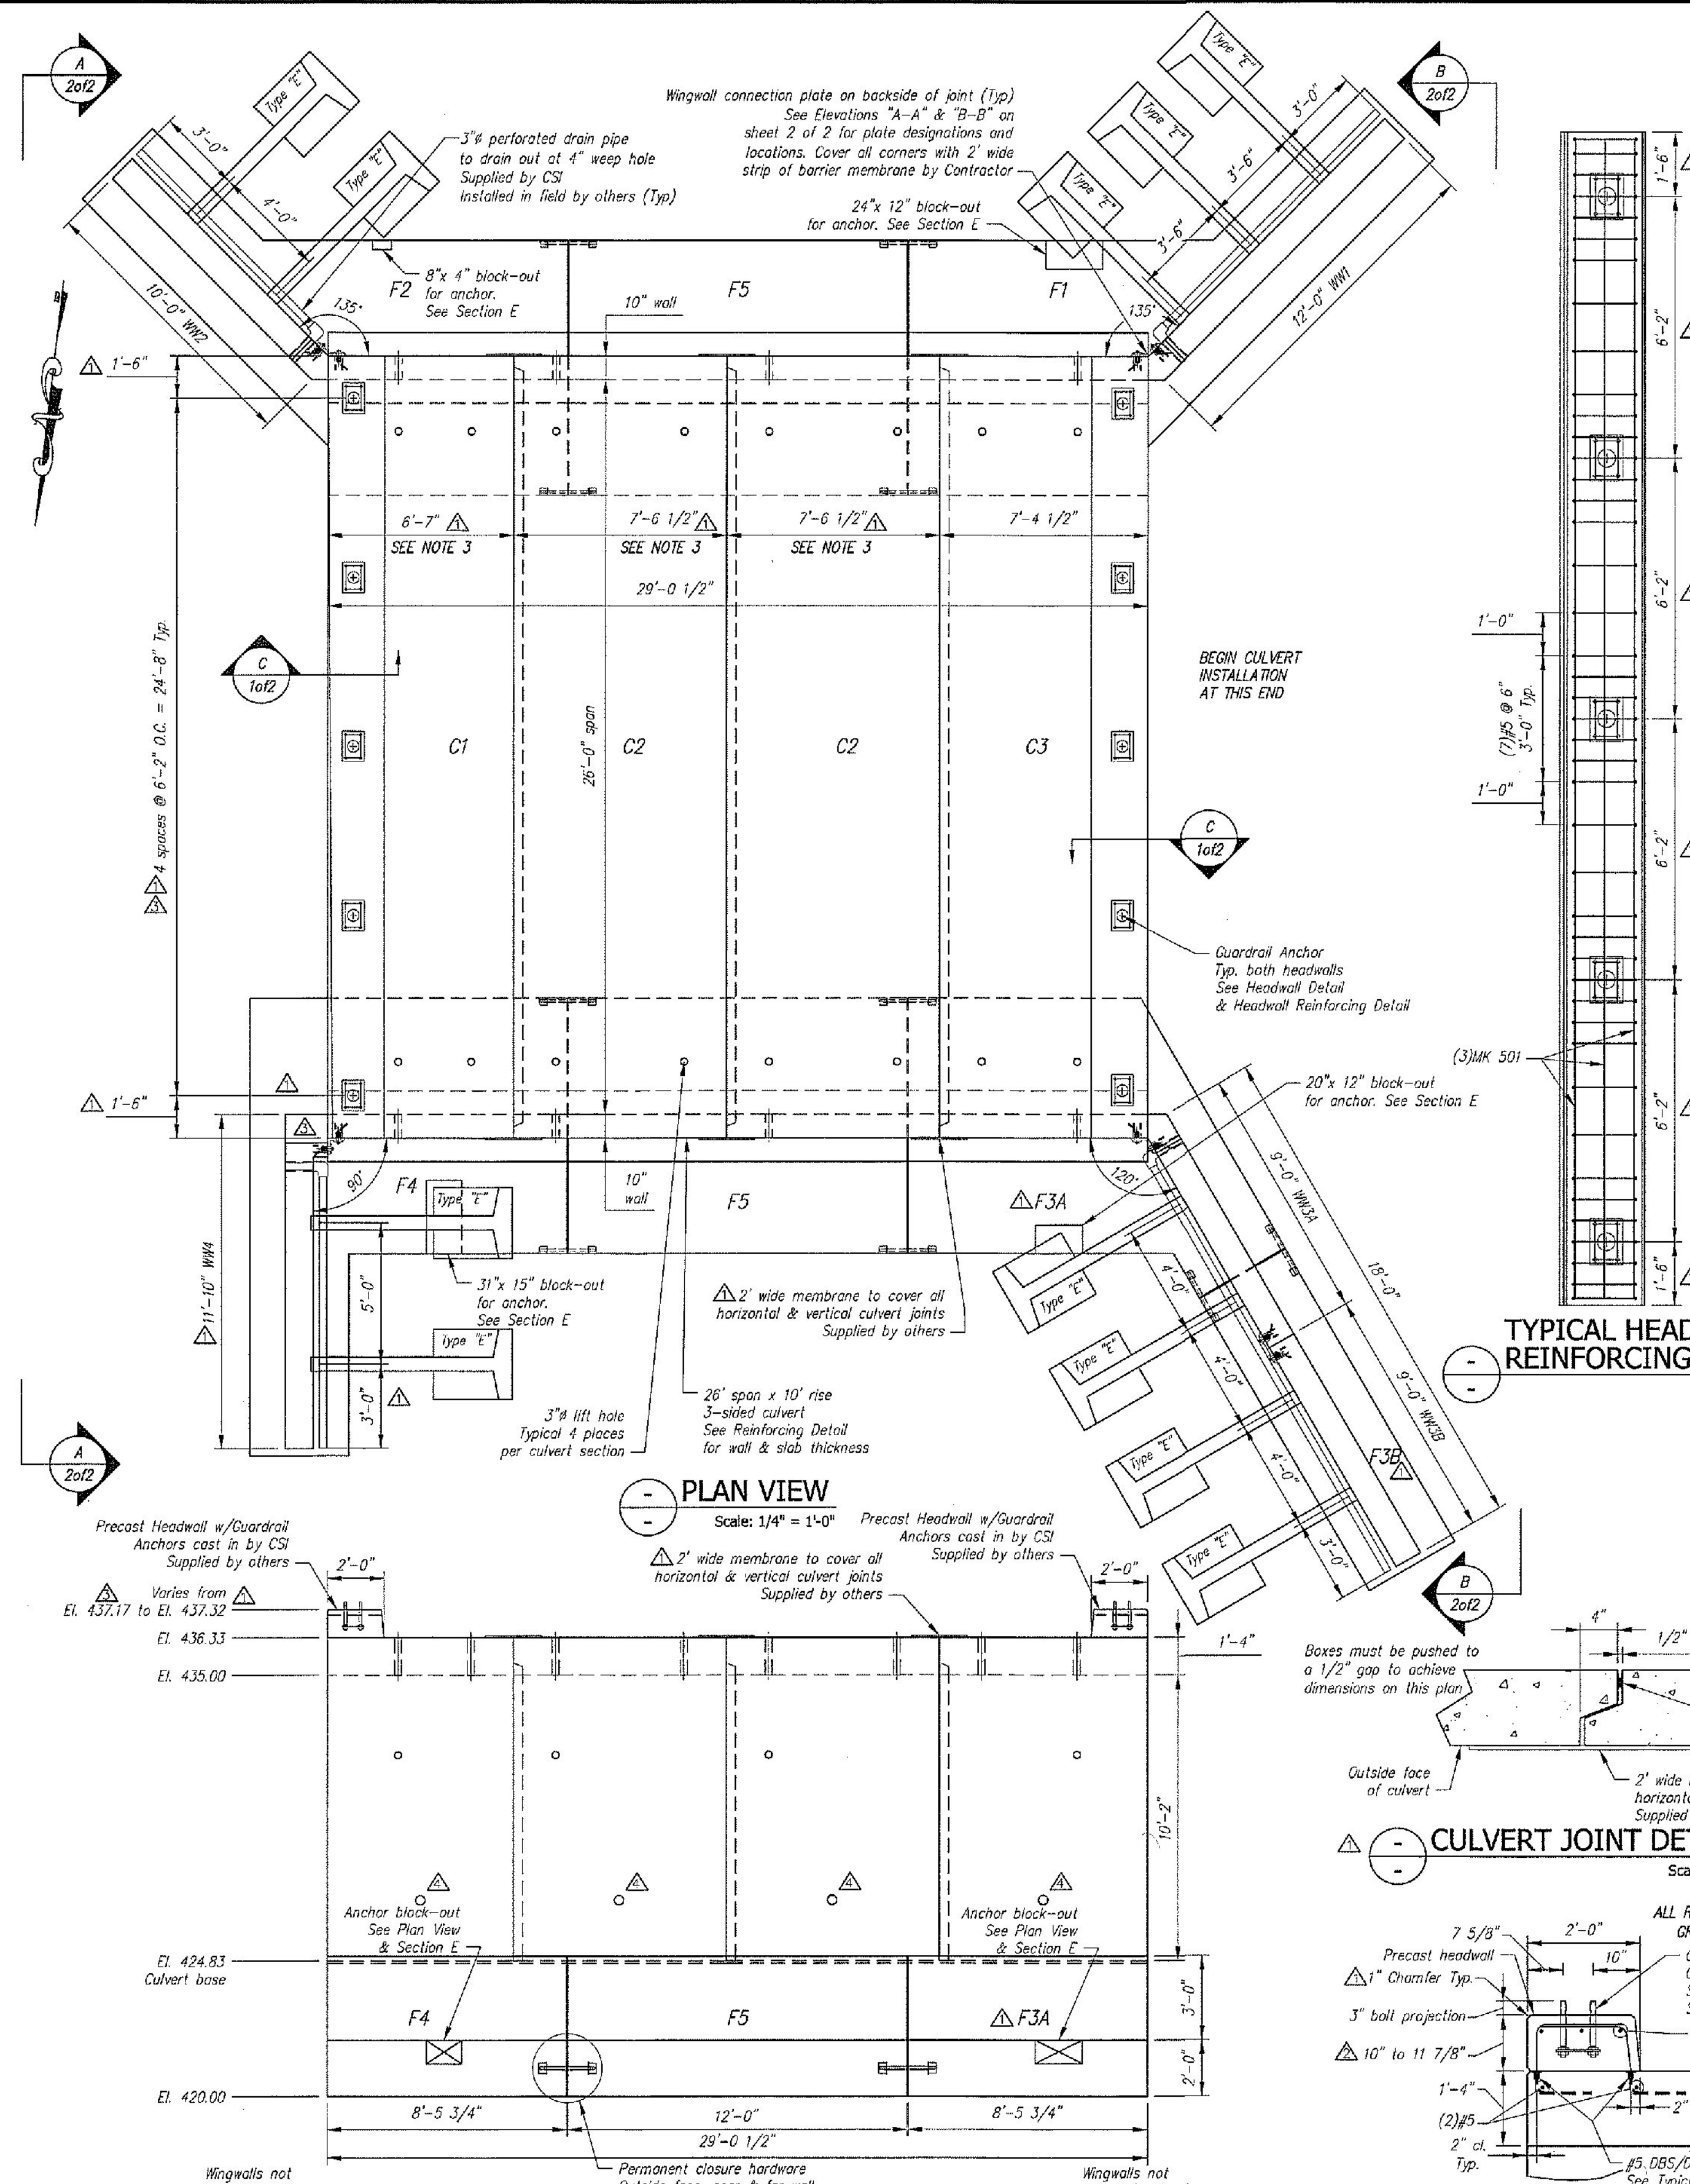


**GENERAL NOTES:**

- Reference Standards:
  - AASHTO "LRFD Bridge Design Specifications" ASTM C1577
- Design Parameters:
  - Live load: HL-93
  - Earth Cover: 0.5' to 1.0'
  - Concrete: Design strength  $f_c = 5000$  psi
  - Unit weight = 150 pcf
  - Reinforcing: Pedestal/Footing - ASTM A615 (rebar) GR 60, plain (VTAOT Level 1)
  - Culvert/Headwall/Wingwall - Z-Bar(rebar), GR 60 (VTAOT Level II)
  - Soil: Minimum lateral pressure coefficient .25
  - Maximum lateral pressure coefficient .50
  - Cover to reinforcing: 2" Top of top slab & outside faces of walls
  - 1 1/2" elsewhere u.n.a.
- Dimensions include a joint gap. Actual culvert piece length is 1/2" shorter (i.e. C2 = 7'-6").
- DBS are Dowel Bar Splicers and DI are Dowel Ins. Both are supplied by CSI. DI's are to be installed and cut/bent in the field by others as required.
- Headwall design taken from contract drawing S-360A.
- Water repellent by CSI on all exposed faces of culvert to 1' in, headwalls and wingwalls. Water repellent to be Certi-Vex Penesol 244-40% (Silane-Siloxane in accordance with Virans 540.04).
- Provide engineer a minimum fourteen (14) days notice prior to the start of fabrication and a detailed casting schedule.

MARK	QTY	LENGTH	YDS	WEIGHT
C1	1	6.54	15.40	31.19 TONS
C2	2	7.50	15.20	30.78 TONS
C3	1	7.38	16.50	33.41 TONS
WW1	1	12.00	7.77	15.73 TONS
WW2	1	10.00	6.35	12.86 TONS
WW3A	1	9.00	6.03	12.21 TONS
WW3B	1	9.00	5.31	10.75 TONS
WW4	1	11.83	8.13	16.46 TONS
F1	1	18.58	11.37	23.02 TONS
F2	1	17.17	10.85	21.97 TONS
F3A	1	13.33	9.80	19.85 TONS
F3B	1	12.00	3.11	6.30 TONS
F4	1	16.17	11.70	23.69 TONS
F5	2	12.00	11.19	22.66 TONS

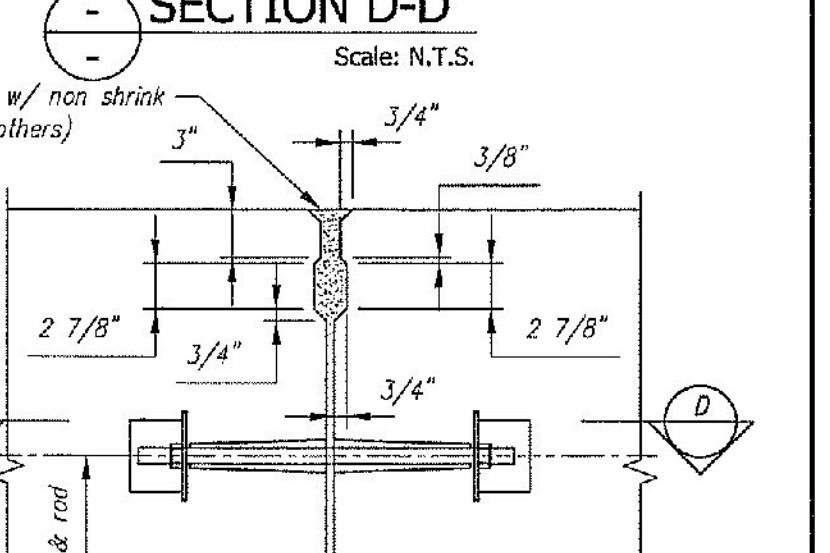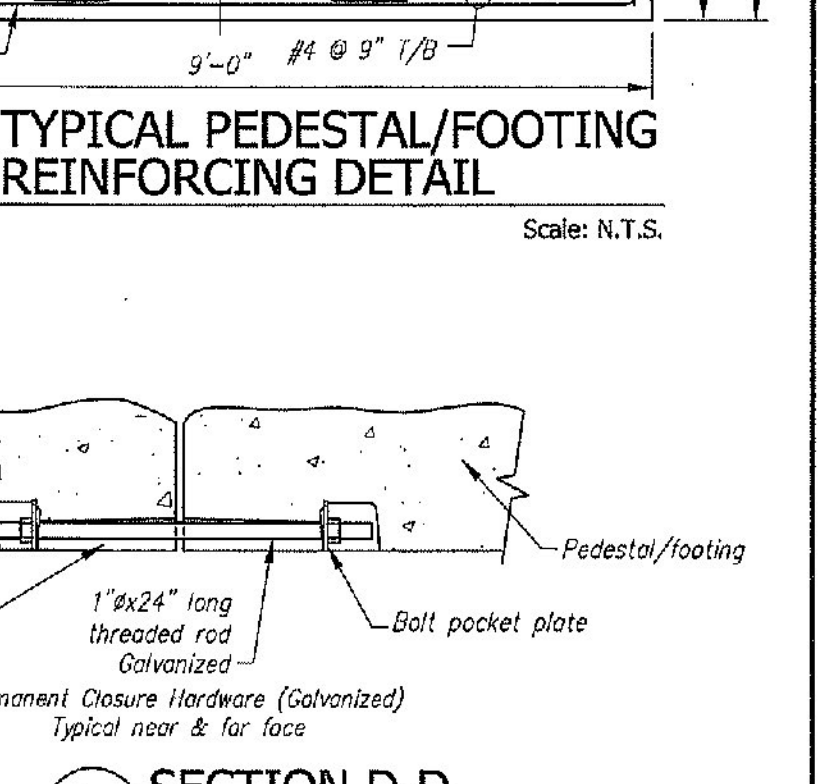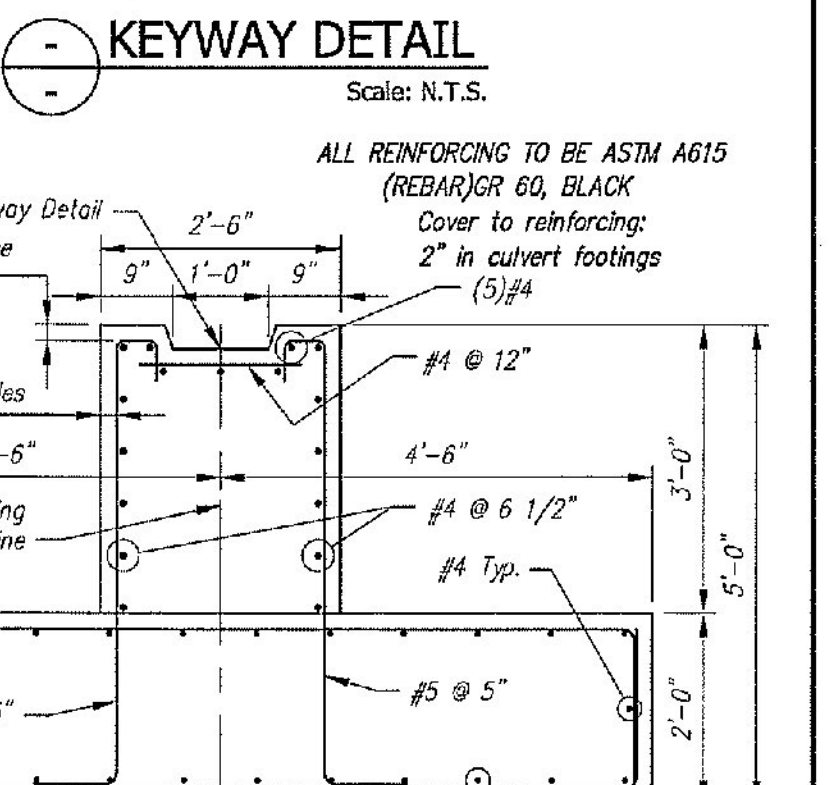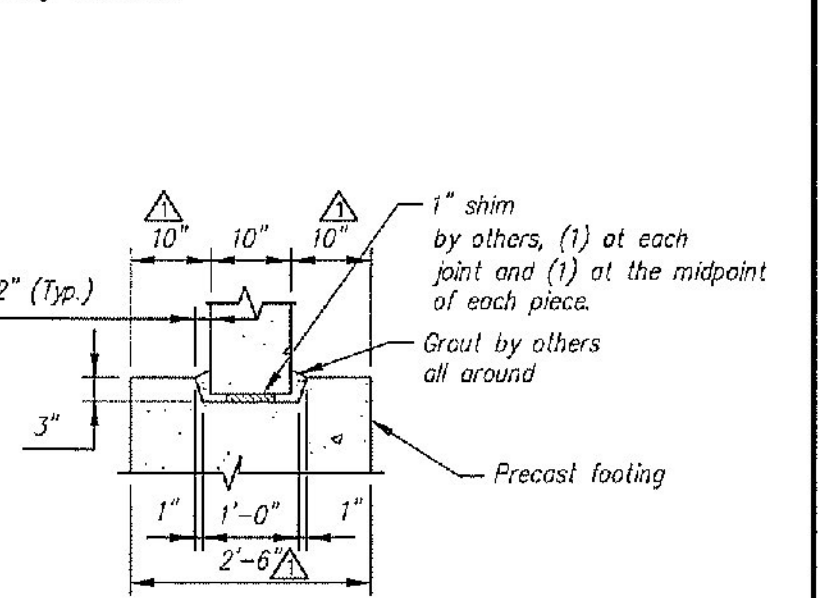

Contractor is to verify that all information shown on drawings has been thoroughly checked, complies with the contract documents and is adequate to meet the field conditions. Some dimensions and details may differ slightly from contract drawings to accommodate the manufacturing or design process. Approval of this drawing indicates that any deviation from the contract documents has been reviewed and found to be acceptable. Production will not commence until receipt of signed, approved shop drawings.

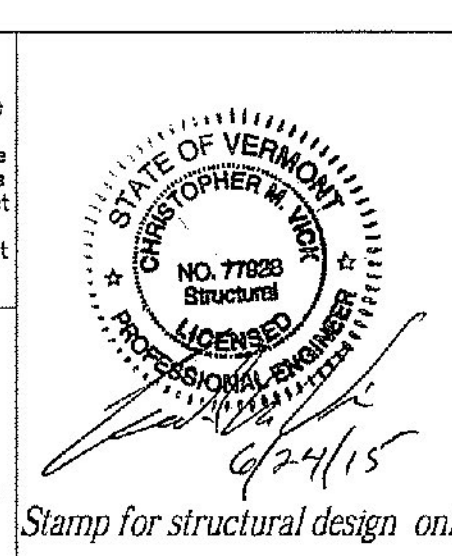

Rev.	Date	DESCRIPTION	By
7			
6			
5			
4	17JUN2015	REVISED PER CUSTOMER REVIEW	BSS
3	04JUN2015	REVISED PER CUSTOMER REVIEW	RY
2	28MAY2015	REVISED PER CUSTOMER REVIEW, SECTION C-10" DIM WAS 9 1/2", EXTENDED WINGWALLS EVEN WITH HDWALL	RY
1	14MAY2015	REVISED PER CUSTOMER REVIEW, MOVED WW4, ADDED F3A & F3B, REVISED GUARDRAIL ANCHORS	RY



**Vermont Agency of Transportation**

This drawing is provided for informational purposes only. It is not to be used for construction without the following documents and/or sources:

Engineer: STRATEGIC VTAOT PROGRAM DEVELOPMENT  
 Project: VTAOT PROJECT DEVELOPMENT  
 Drawing: CK'D BY FDB, OK'D BY HIS  
 SHEETS 1, 2, 4, 22, 23, 24 OF 25  
 June 29, 2015

Specifications: STANDARD CONSTRUCTION DATED 2011

Other Sources: RESUBMIT No Approved  
 BY Carolyn Carlson DATE 06/29/15

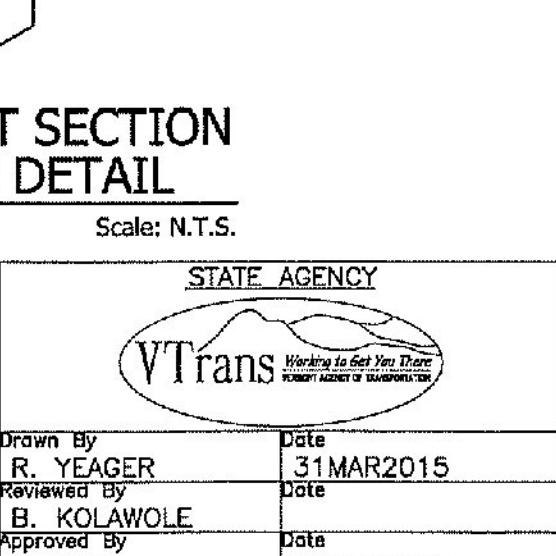
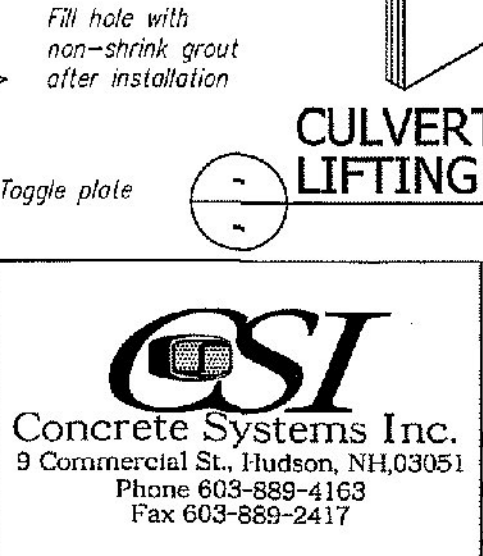


G.W. TATRO CONSTRUCTION, INC.  
 VT/AOT BRIDGE REPLACEMENT - ROAD IMPROVEMENT  
 RICHFORD, VT.

26' SPAN X 10' RISE 3-SIDED CULVERT


Drawing No. C22312-L01A

Quantity: 1 Project No: BRFO30229 SHEET 1 OF 2

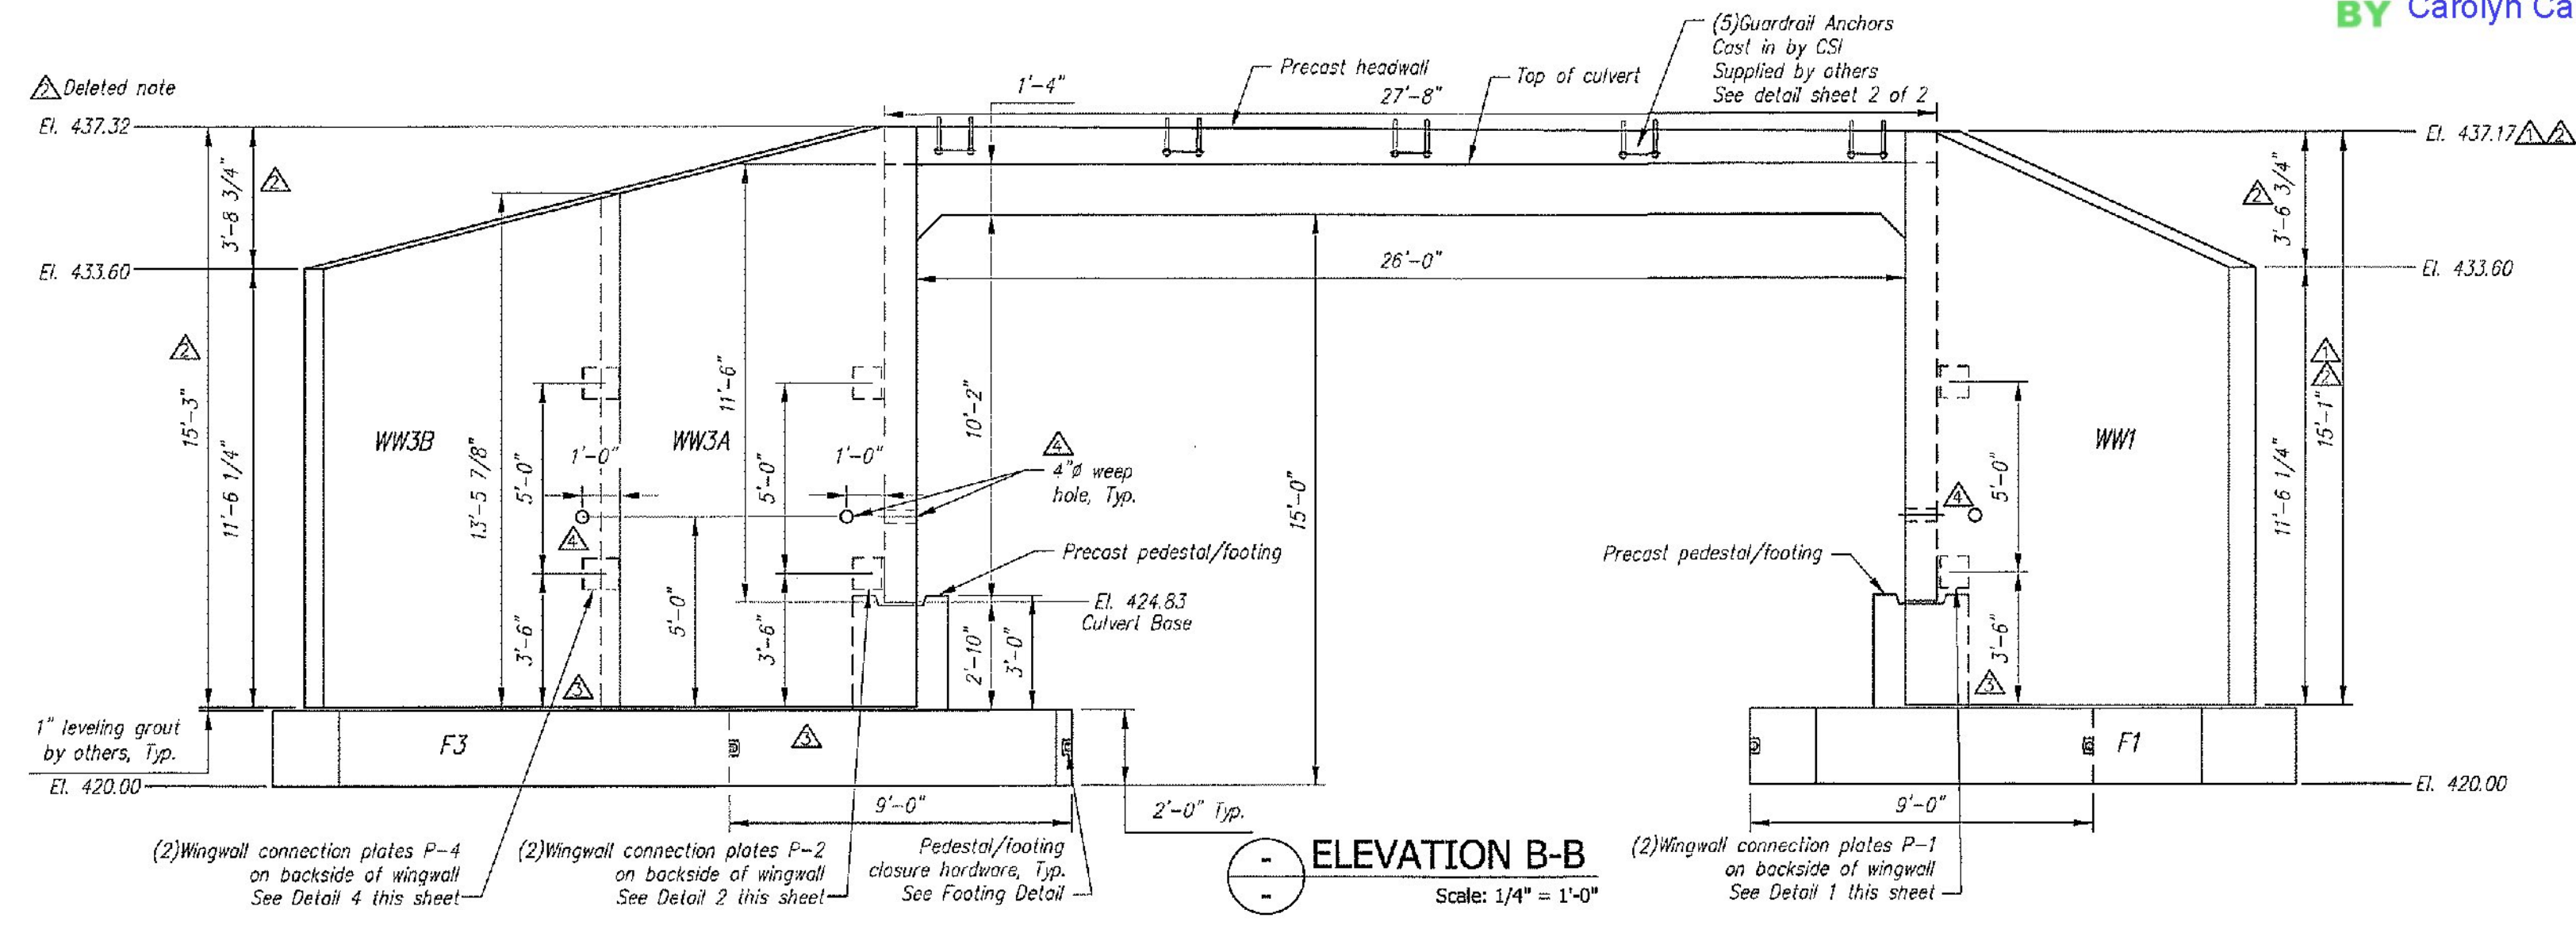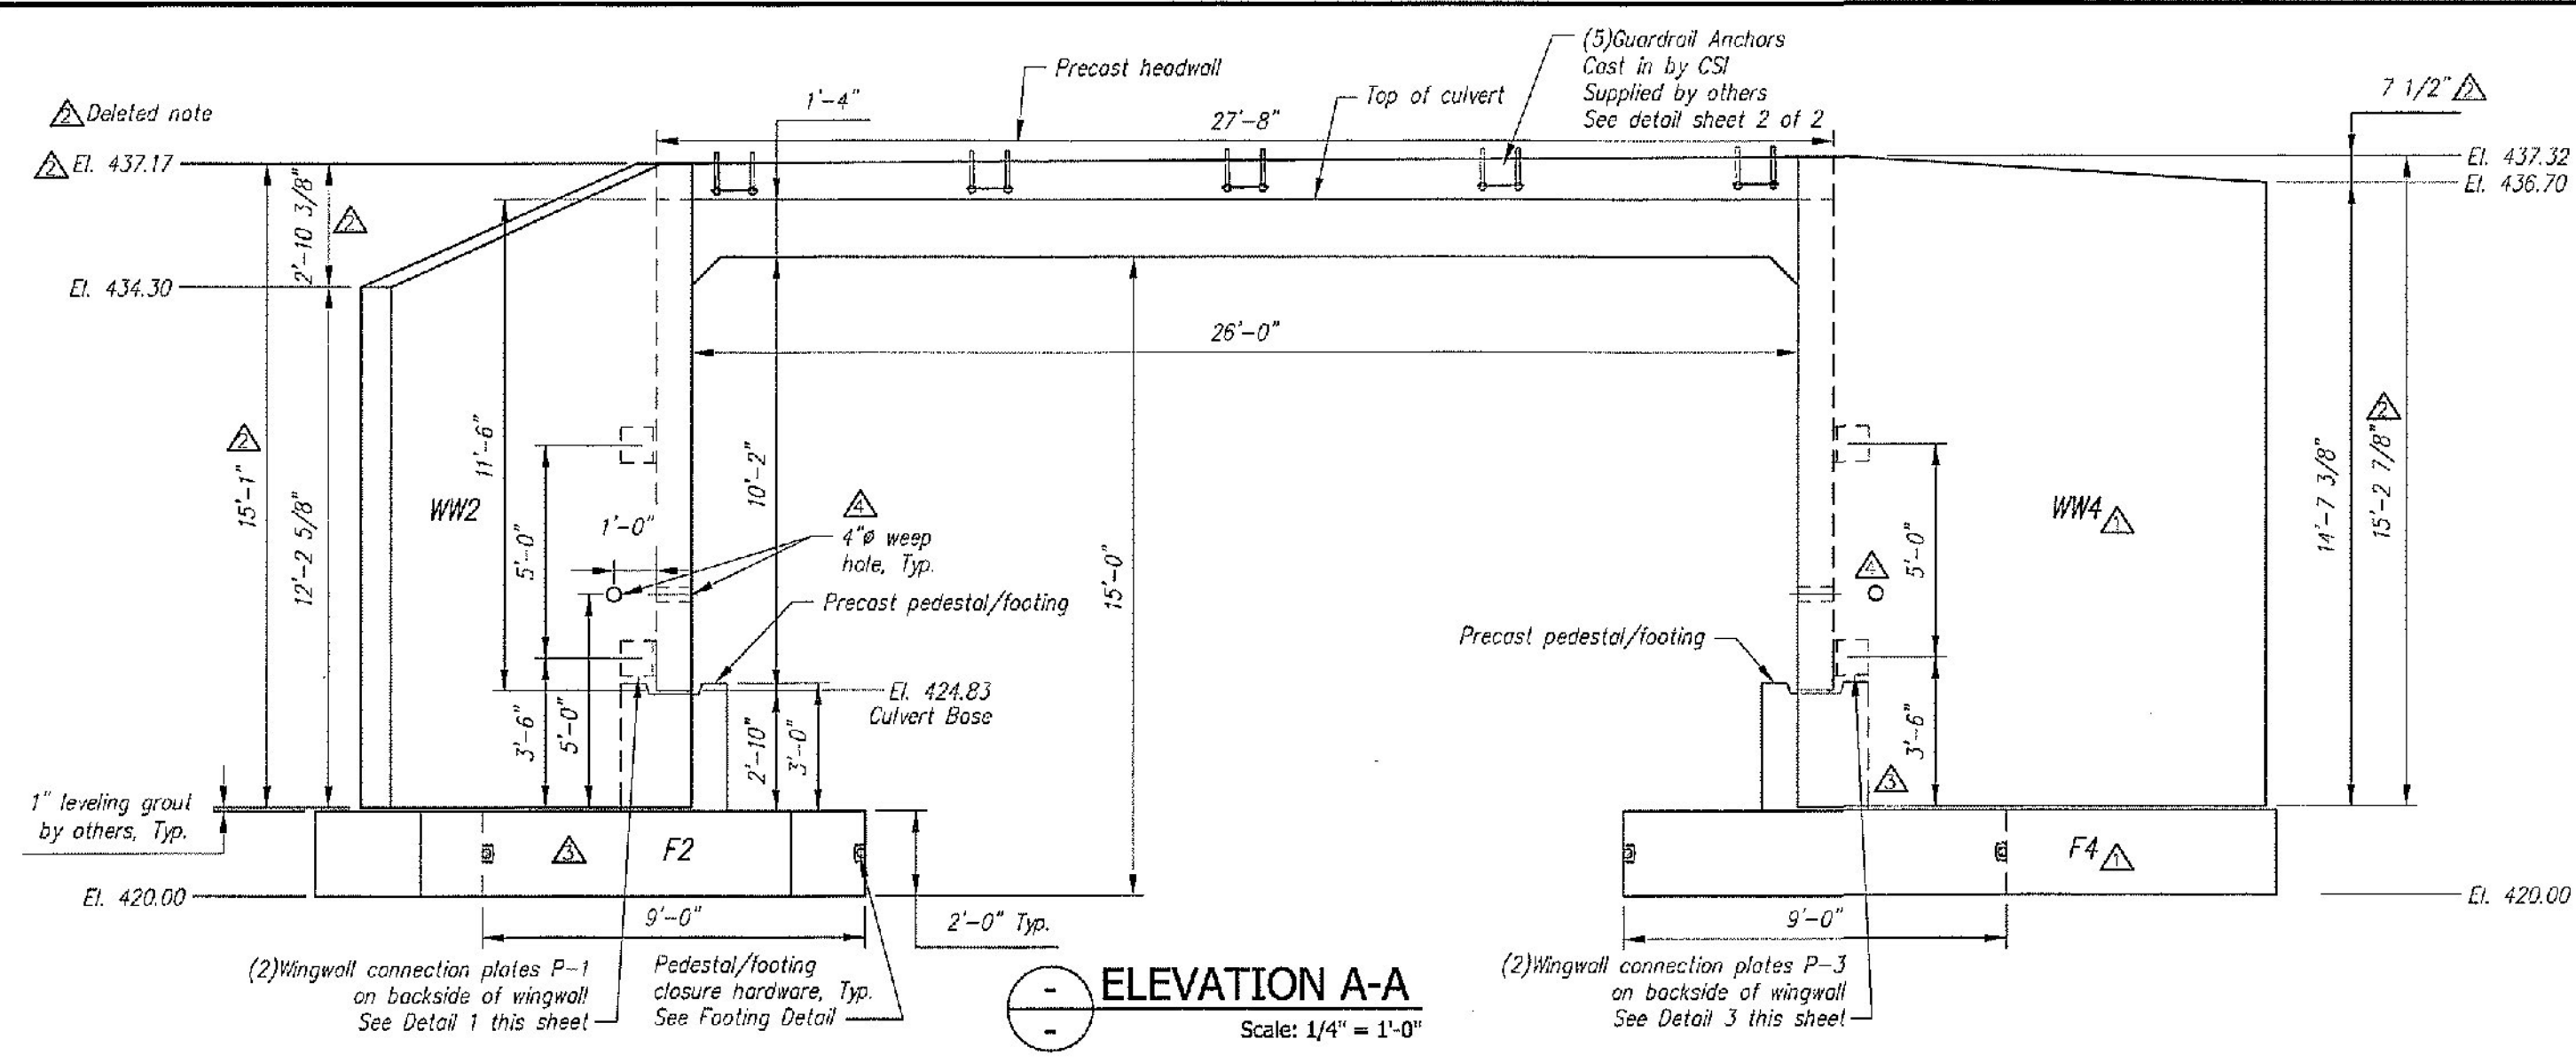

**WINGWALL GENERAL NOTES:**  
 1. Reference standard: AASHTO LRFD Specifications  
 2. Design Parameters:  
 Normal Bearing Resistance: 10 ksf (Footing width > 6 ft.)  
 Earth Cover: 1.0 ft.  
 Concrete: Design strength  $f'_c = 5000$  psi  
 Unit weight = 150 pcf  
 Reinforcing: Z-BAR(rebar), OR 60(VIAOT Level II)  
 Soil: Unit weight = 125 pcf  
 Minimum lateral pressure coefficient .25  
 Maximum lateral pressure coefficient .50  
 Cover to reinforcing: 2" c.n.s.  
 3. The wingwalls have been designed for general site conditions. The project engineer shall be responsible for the structure's suitability to the existing site conditions and for the hydraulic evaluation, including scour and confirmation of soil conditions.  
 4. Prior to construction, contractor must verify all elevations shown through the engineer.




Vermont Agency of Transportation  
**RECEIVED**  
 CK'D BY FDB OK'D BY HIS  
 June 29, 2015  
 RESUBMIT No Approved  
 BY Carolyn Carlson DATE 06/29/15

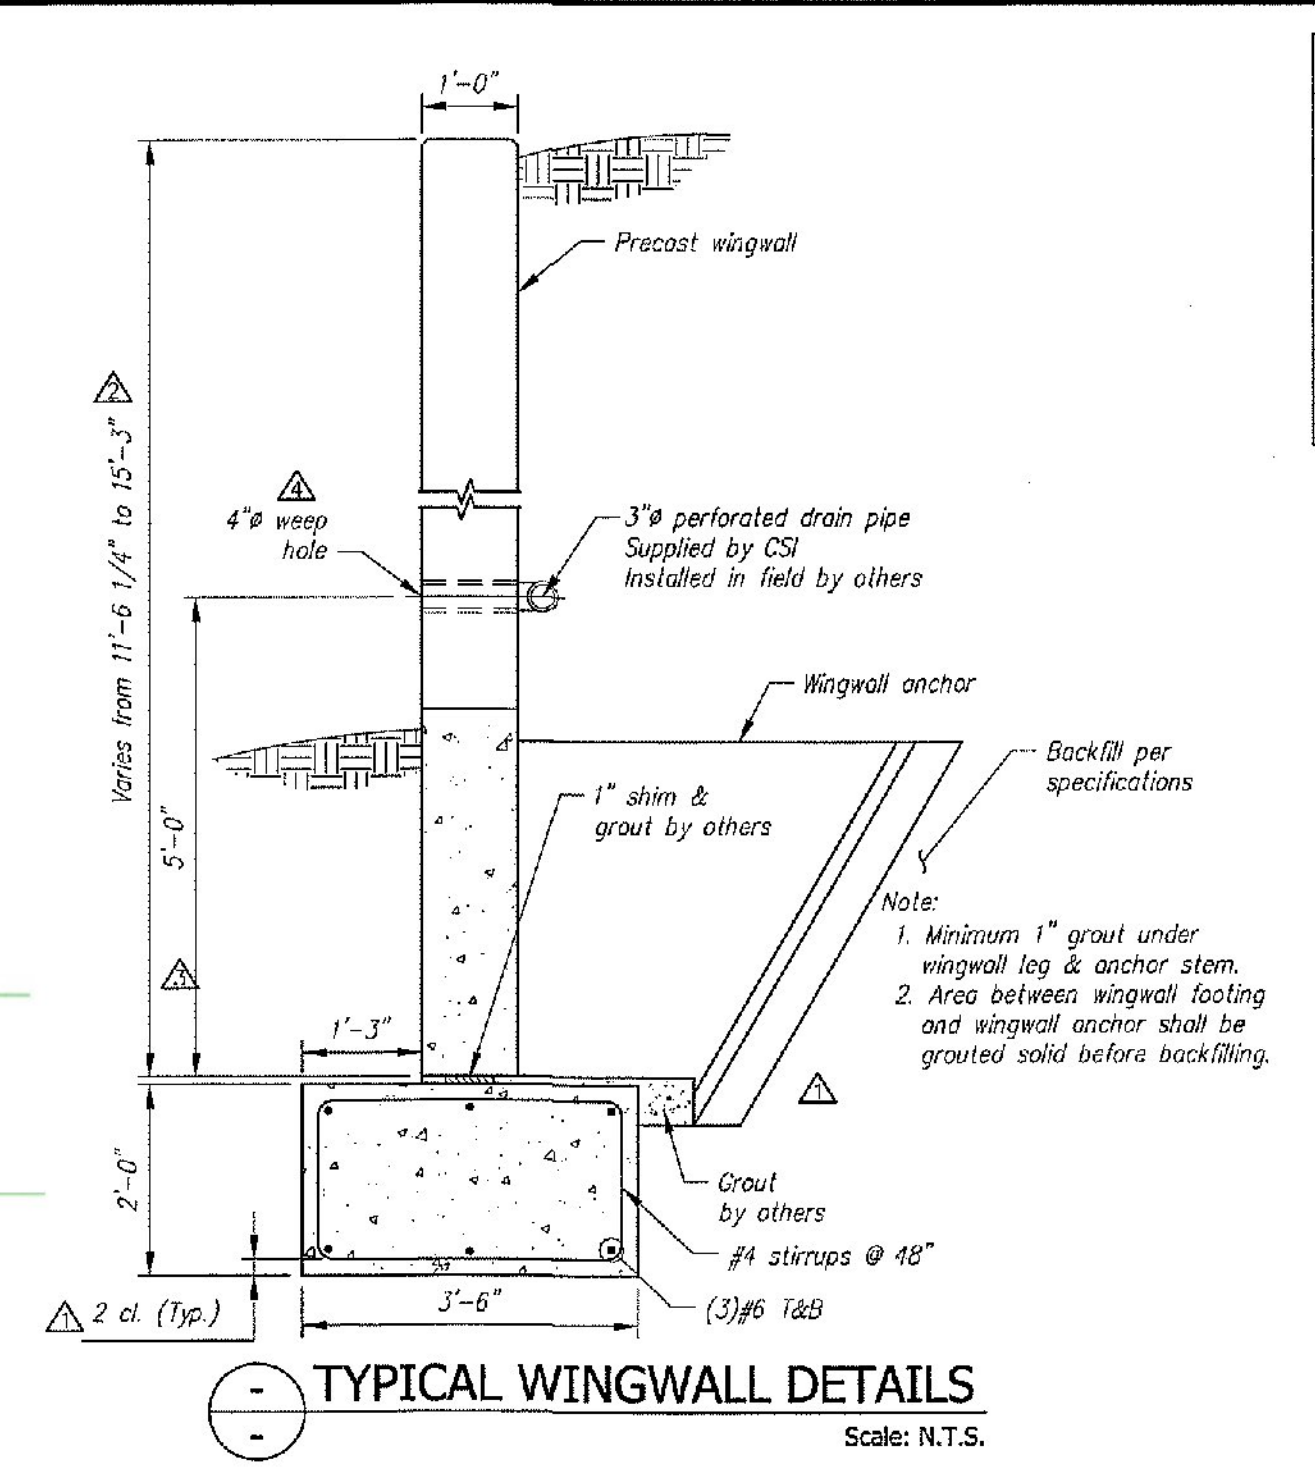

**BACKFILL DESCRIPTION**


Group Classification	A-1		A-3		A-2	
	A-1-a	A-1-b	A-3-a	A-3-b	A-2-a	A-2-b
Sieve Analysis, Percent Passing						
No. 10	50 max.	50 max.	51 min.	35 max.	35 max.	35 max.
No. 40	30 max.	50 max.	10 min.			
No. 200	15 max.	23 max.	10 max.			
Characteristics of Fraction Passing No. 40						
Liquid Limit	6 max.	N.P.	40 max.	41 min.	40 max.	41 min.
Plasticity Index	6 max.	N.P.	10 max.	10 min.	11 min.	11 min.
Usual Types of Significant Constituent Materials	Gravel & Sand	Excelsior to Good	Clay	Silty or Clayey Gravel and Sand	Sand	Excelsior to Good
General Rating as Subgrade						

**NOTES:**  
 1. BACKFILL OPERATIONS WITHIN THE C.B.Z. SHALL BE PERFORMED IN LIFTS OF 6" OR LESS (LOOSE DEPTH).  
 2. MAXIMUM DRY DENSITY SHALL BE DETERMINED BY AASHTO T-99 OR OTHER APPROVED METHODS.  
 3. BACKFILL SHALL BE COMPACTED IN LAYERS UNTIL THE DENSITY IS NOT LESS THAN 95% OF THE MAXIMUM DRY DENSITY.

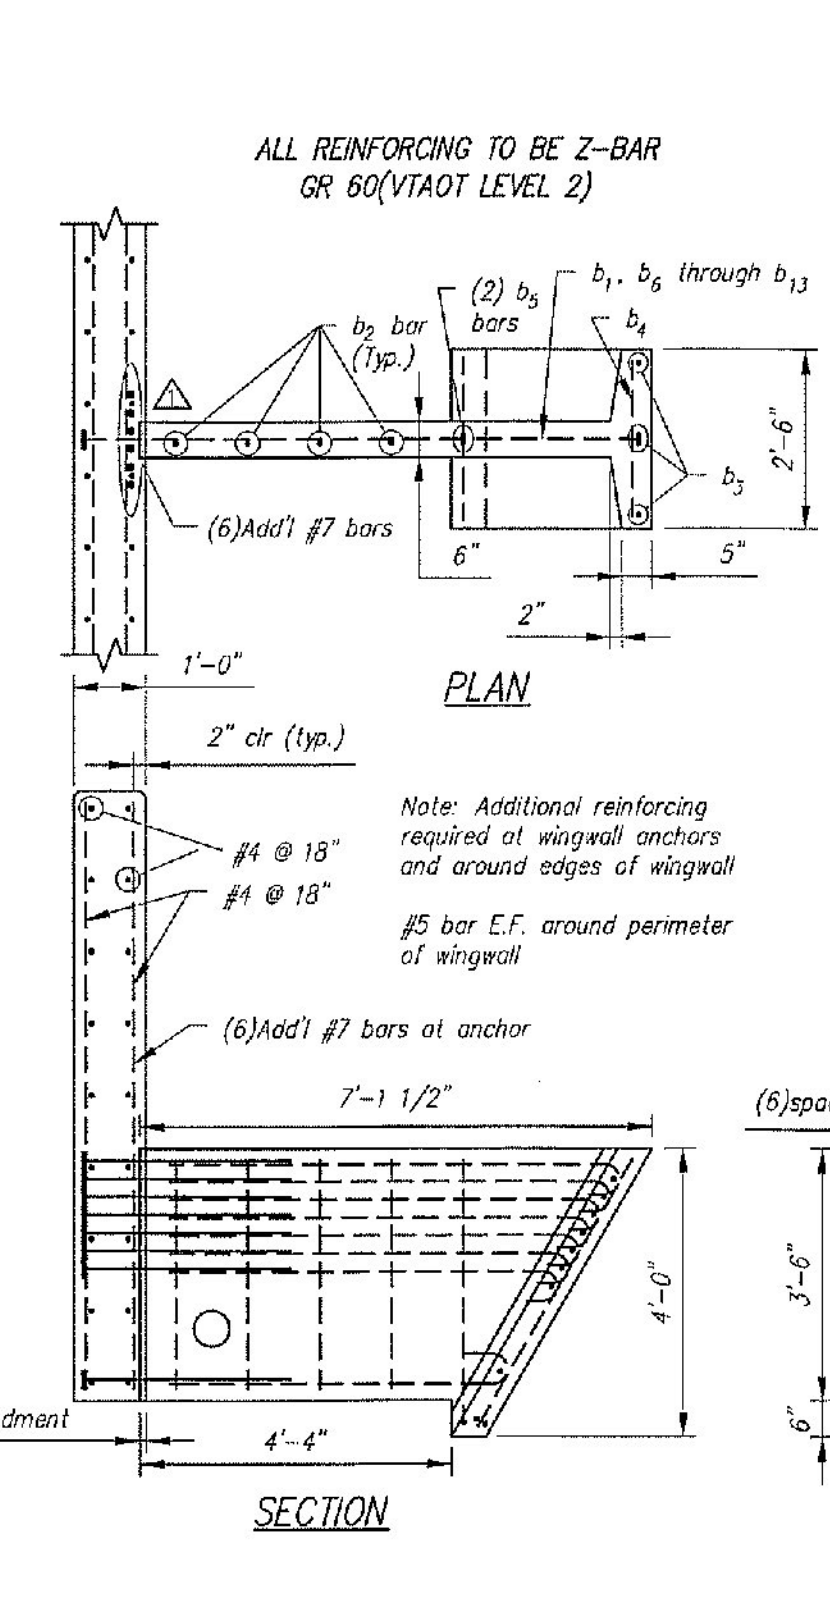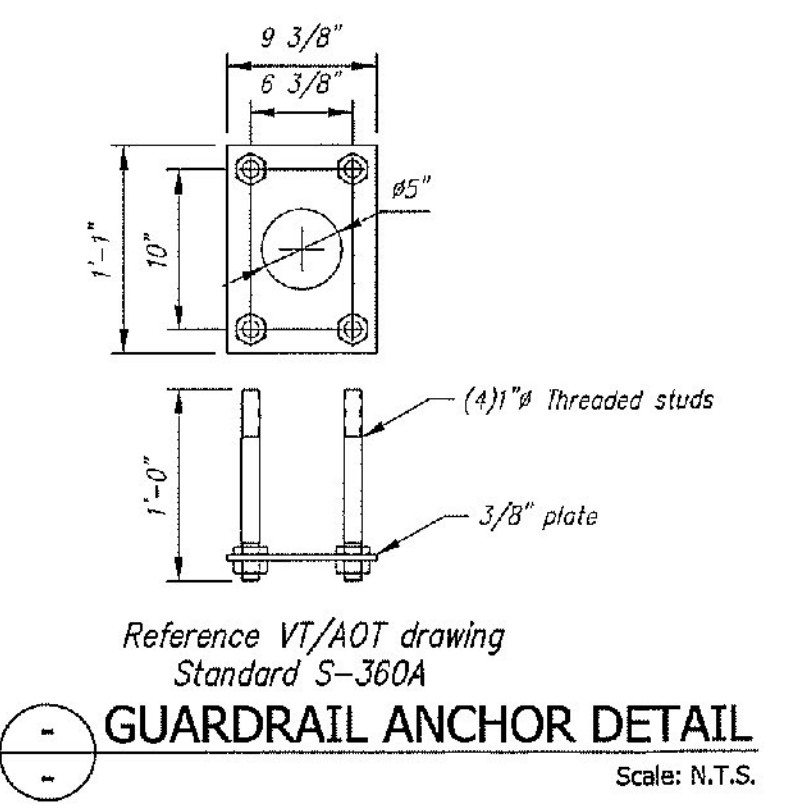
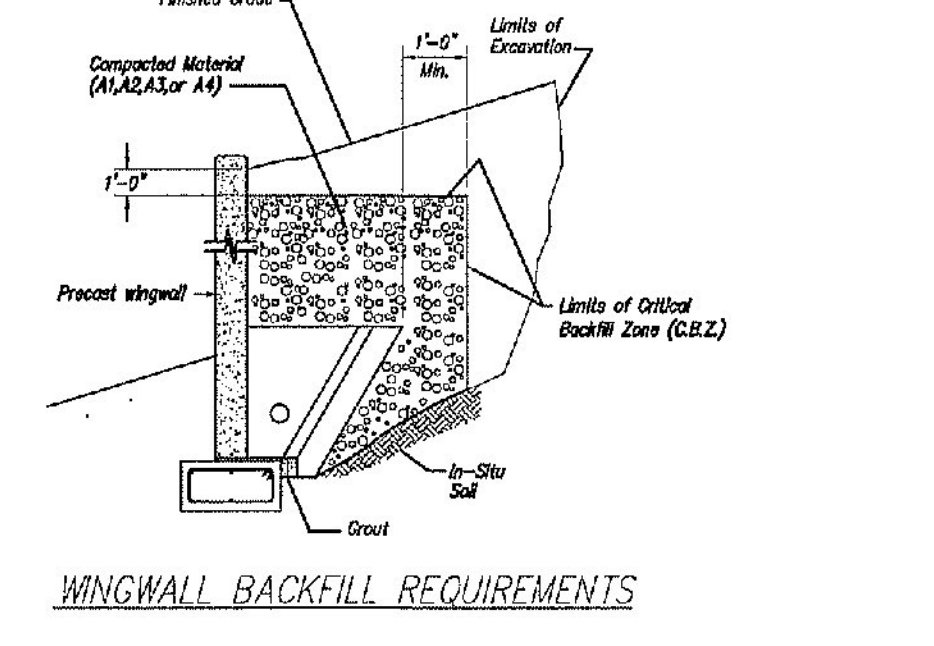


**BAR LIST**


MARK	QTY.	SIZE	a	TYPE	LENGTH
b ₁	8	#5	3'-0"	3	
b ₂	4	#5	Str.	3'-2"	
b ₃	4	#5	Str.	4'-3"	
b ₄	11	#5	Str.	2'-2"	
b ₅	2	#5	3'-8"	2	
b ₆	1	#5	4'-9"	1	
b ₇	1	#5	5'-4"	1	
b ₈	1	#5	5'-6"	1	
b ₉	1	#5	5'-8"	1	
b ₁₀	1	#5	5'-10"	1	
b ₁₁	1	#5	6'-0"	1	
b ₁₂	1	#5	6'-1"	1	
b ₁₃	1	#5	6'-3"	1	

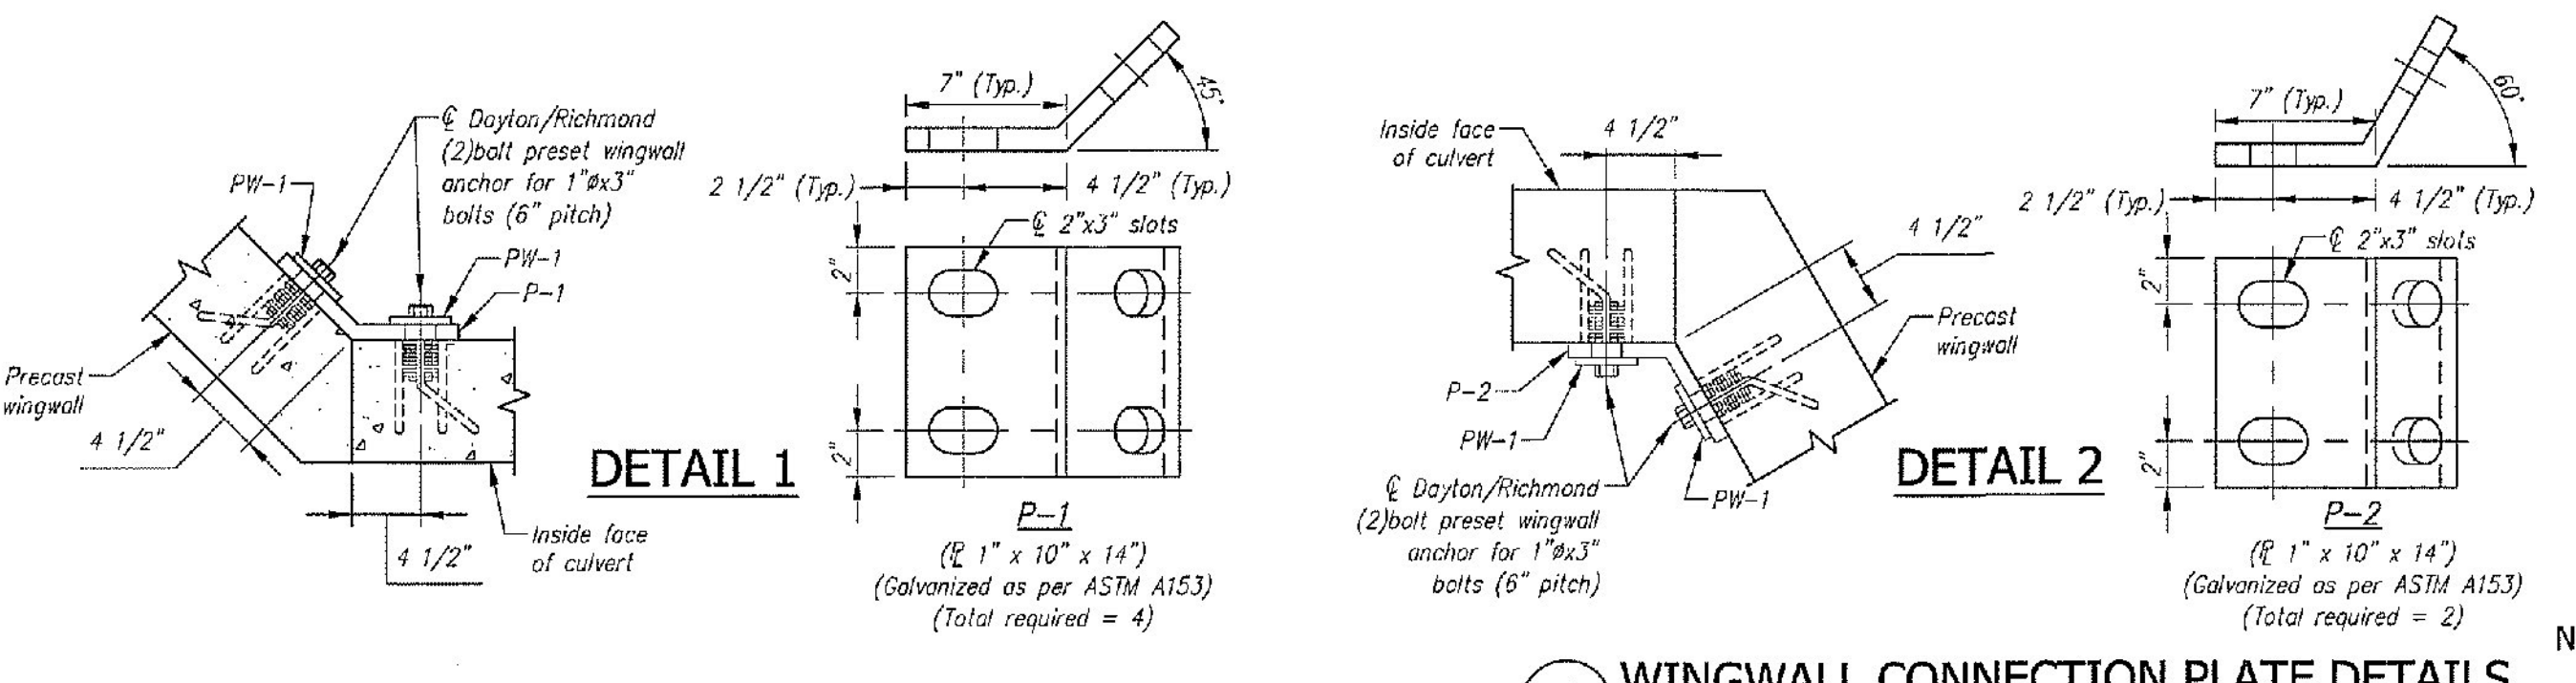

Note: All wingwall joints are covered with 2' wide strip of barrier membrane by others. See note, Sheet 1, Plan View.

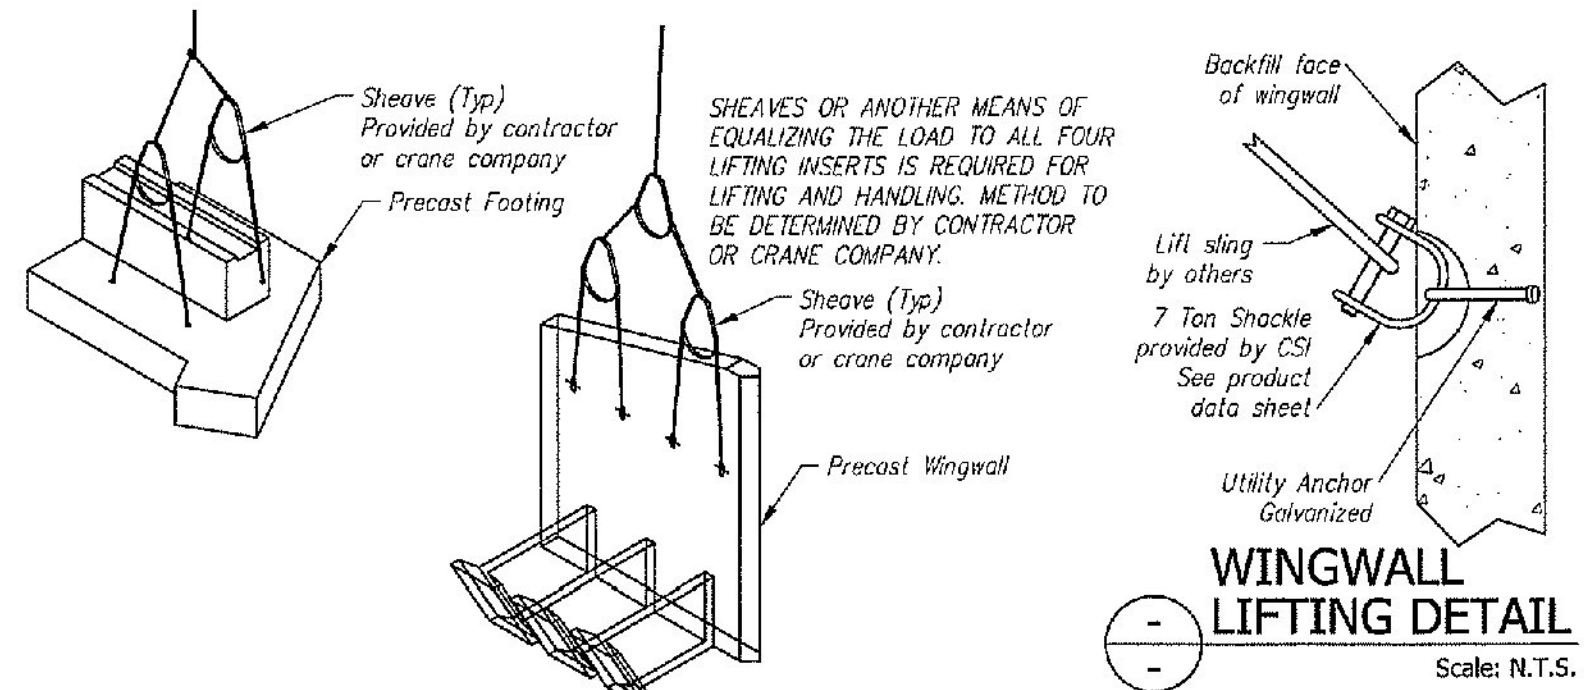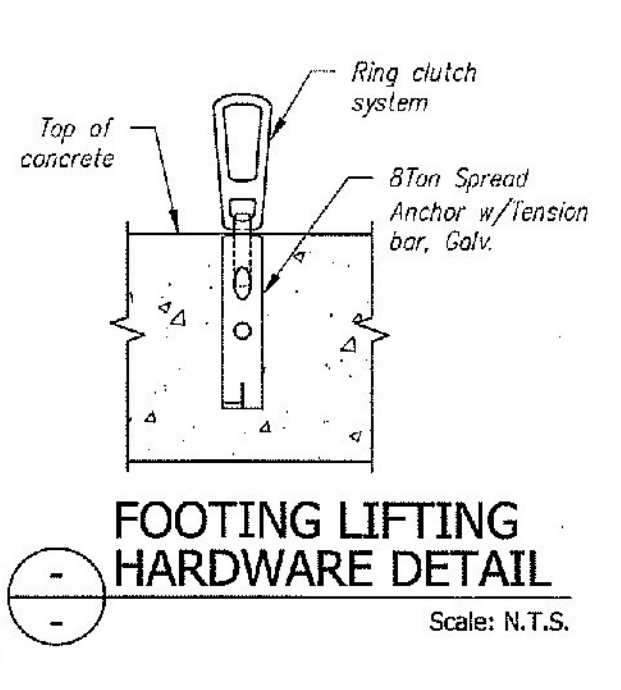

Contractor is to verify that all information shown on drawings has been thoroughly checked, complies with the contract documents and is adequate to meet the field conditions. Some dimensions and details may differ slightly from contract drawings to accommodate the manufacturing or design process. Approval of this drawing indicates that any deviation from the contract documents has been reviewed and found to be acceptable. Production will not commence until receipt of signed, approved shop drawings.

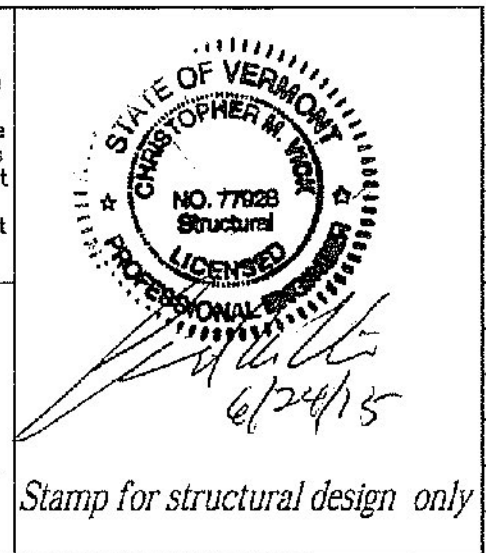

**REVISIONS**

Rev.	Date	DESCRIPTION	By
7			
6			
5			
4	17JUN2015	REVISED PER CUSTOMER REVIEW	BSS
3	04JUN2015	REVISED PER CUSTOMER REVIEW	RY
2	28MAY2015	EL A-A & B-B: 437.17 WAS 437.13, EXTENDED WINGWALLS EVEN WITH HEADWALL	RY
1	14MAY2015	REVISED PER CUSTOMER REVIEW, SEE SHEET 1	RY

This drawing is based upon information provided from the following documents and/or sources:  
 Engineer: STATE OF VT/AOT PROGRAM DEVELOPMENT  
 Project No: -----  
 Drawings: STATE OF VT/AOT PROPOSED IMPROVEMENT BRIDGE PROJECT, TOWN OF RICHFORD SHEETS 1,2,4,22,23,24 OF 36  
 Specifications: STANDARD SPECIFICATIONS FOR CONSTRUCTION DATED 2011  
 Other Sources: -----

**CSI**  
 Concrete Systems Inc.  
 9 Commercial St., Hudson, NH, 03051  
 Phone 603-889-4165  
 Fax 603-889-2417

**STATE AGENCY**  
**VTrans**  
 Drawn by: R. YEAGER  
 Checked by: B. KOLAWOLE  
 Approved by: C. VICK  
 Date: 31 MAR 2015  
 Date: 17 JUN 2015

G.W. TATRO CONSTRUCTION, INC.  
 VT/AOT BRIDGE REPLACEMENT— ROAD IMPROVEMENT  
 RICHFORD, VT.  
 26' SPAN X 10' RISE 3-SIDED CULVERT  
 C22312-101B  
 Drawing No. C22312-101B  
 Quantity: 1  
 Project No: BRFO30229  
 SHEET 2 OF 2