



# STATE OF VERMONT AGENCY OF TRANSPORTATION

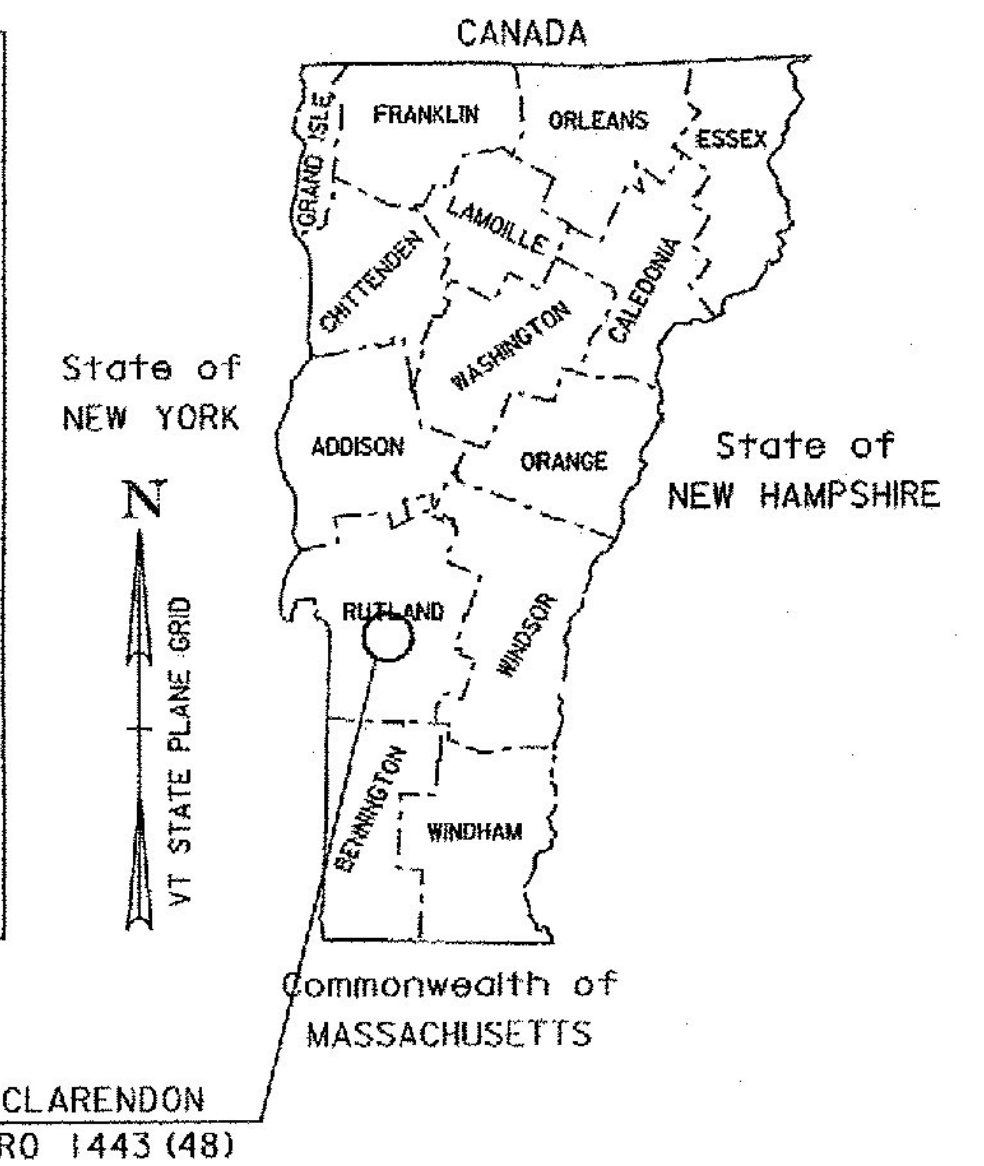


## PROPOSED IMPROVEMENT BRIDGE PROJECT

TOWN OF CLARENDON  
COUNTY OF RUTLAND

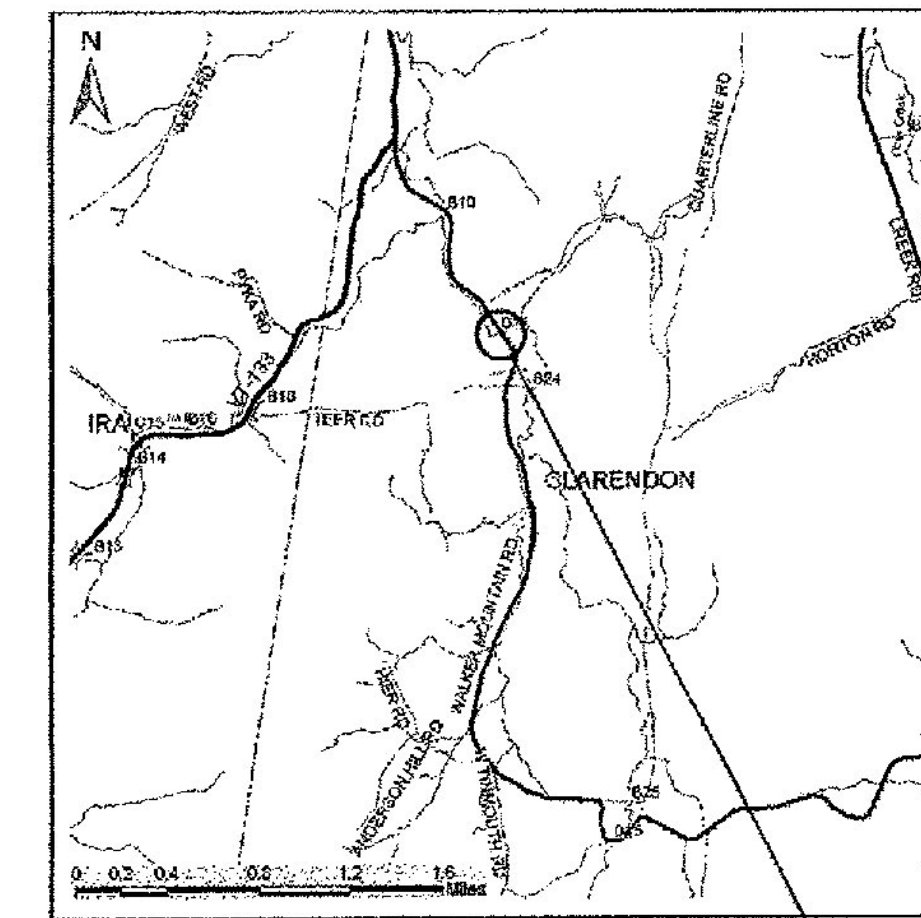

RECORD PLANS	
CONTRACTOR:	J. A. McDONALD INC. - LYNDON CENTER, VT
RESIDENT ENGINEER:	CHRISTOPHER D. WILLIAMS
CONSTRUCTION BEGAN:	JUNE 27, 2016
CONSTRUCTION COMPLETE:	AUGUST 18, 2016
RECORD PLANS BY:	CHRISTOPHER D. WILLIAMS & JESSE IVES
I HEREBY CERTIFY THAT ALL THE CONSTRUCTION REQUIRED BY THIS SET OF DRAWINGS HAS BEEN ACCOMPLISHED AS INDICATED HEREIN.	
BY	RESIDENT ENGINEER
DATE 4/6/2017	
NOTE: Any further information concerning final quantities, amounts or other details relative to this project may be found at Central Files in the electronic archives.	

ROUTE NO : TH 3 (CLASS 2), RURAL COLLECTOR BRIDGE NO : 11  
 PROJECT LOCATION : 1.05 MILES SOUTH OF THE INTERSECTION OF TH 3 AND VT RT 133  
 PROJECT DESCRIPTION : REPLACEMENT OF BRIDGE 11 WITH A NEW PRECAST CONCRETE STRUCTURE WITH RELATED APPROACH AND CHANNEL WORK.  
 LENGTH OF STRUCTURE : 76.70 FEET.  
 LENGTH OF ROADWAY : 98.30 FEET.  
 LENGTH OF PROJECT : 175.00 FEET.

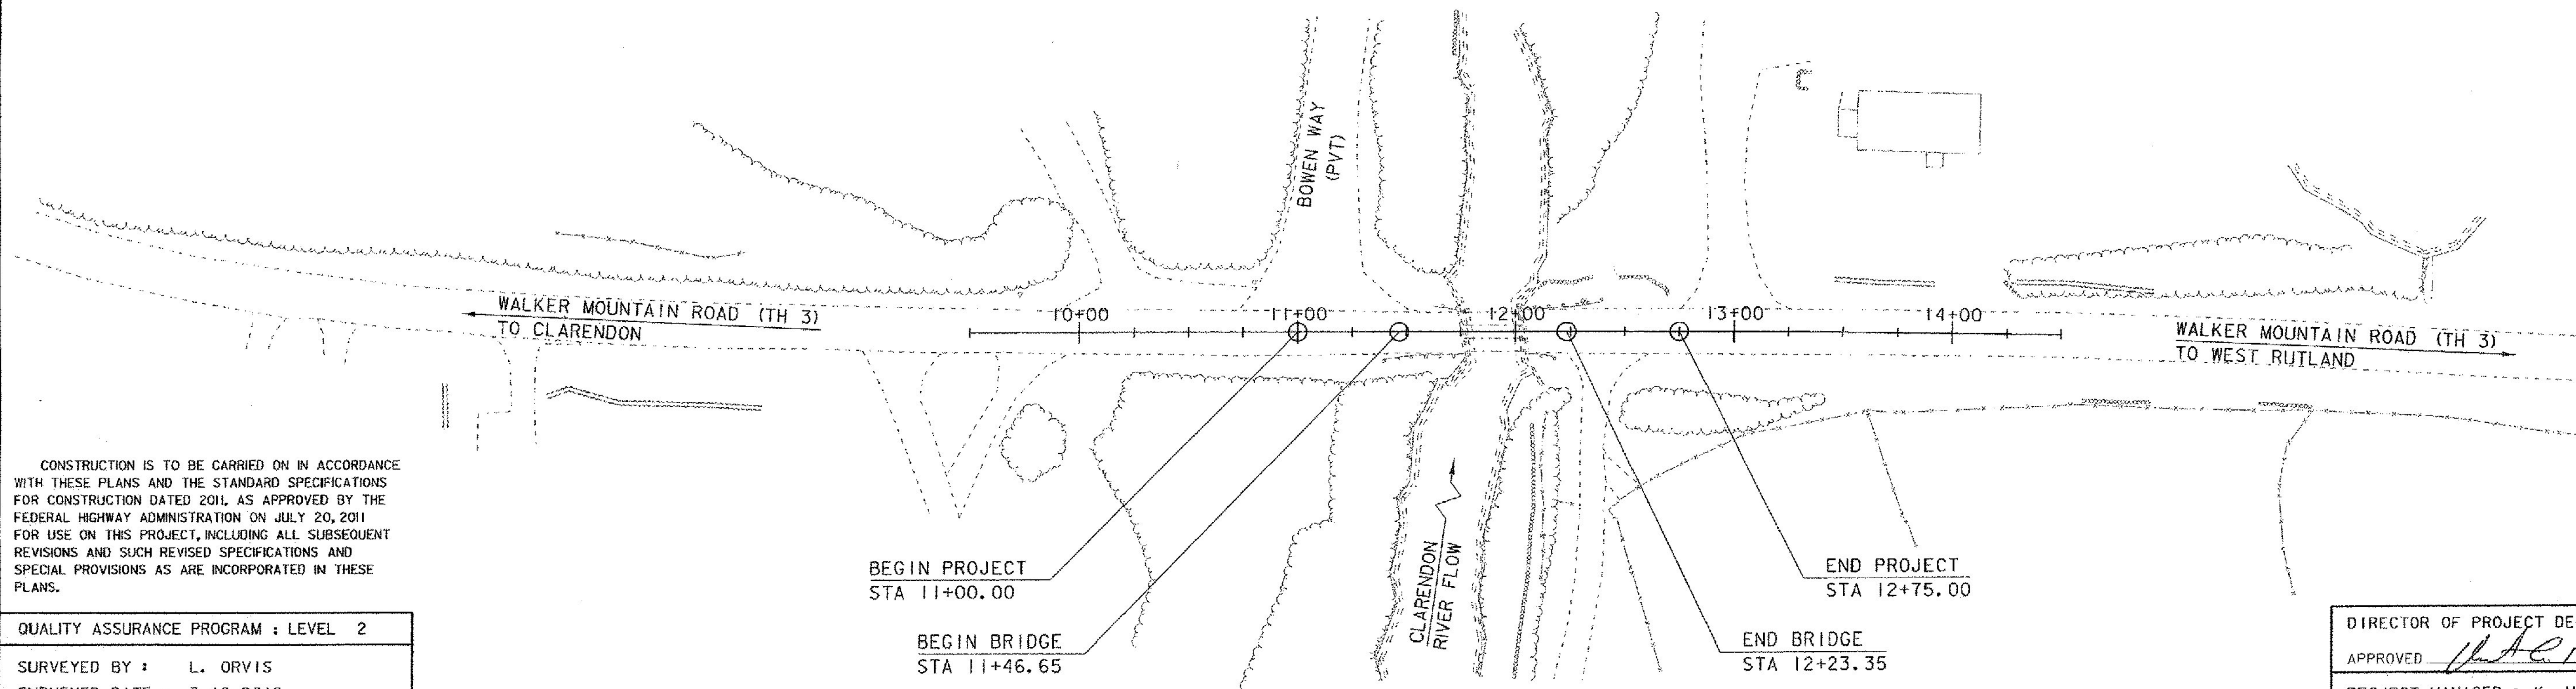

CONSTRUCTION IS TO BE CARRIED ON IN ACCORDANCE WITH THESE PLANS AND THE STANDARD SPECIFICATIONS FOR CONSTRUCTION DATED 2011, AS APPROVED BY THE FEDERAL HIGHWAY ADMINISTRATION ON JULY 20, 2011 FOR USE ON THIS PROJECT, INCLUDING ALL SUBSEQUENT REVISIONS AND SUCH REVISED SPECIFICATIONS AND SPECIAL PROVISIONS AS ARE INCORPORATED IN THESE PLANS.

QUALITY ASSURANCE PROGRAM : LEVEL 2	
SURVEYED BY :	L. ORVIS
SURVEYED DATE :	3-18-2012
DATUM	
VERTICAL	NAVD 88
HORIZONTAL	NAD 83 (92)



DIRECTOR OF PROJECT DELIVERY	
APPROVED	DATE 9/10/2015
PROJECT MANAGER : K. M. HIGGINS, P. E.	
PROJECT NAME : CLARENDON	
PROJECT NUMBER : BRO 1443 (48)	
SHEET 1 OF 59 SHEETS	