


BRIDGE TYPICAL SECTION NEXT BEAM ALTERNATE
SCALE 3/8" = 1'-0"

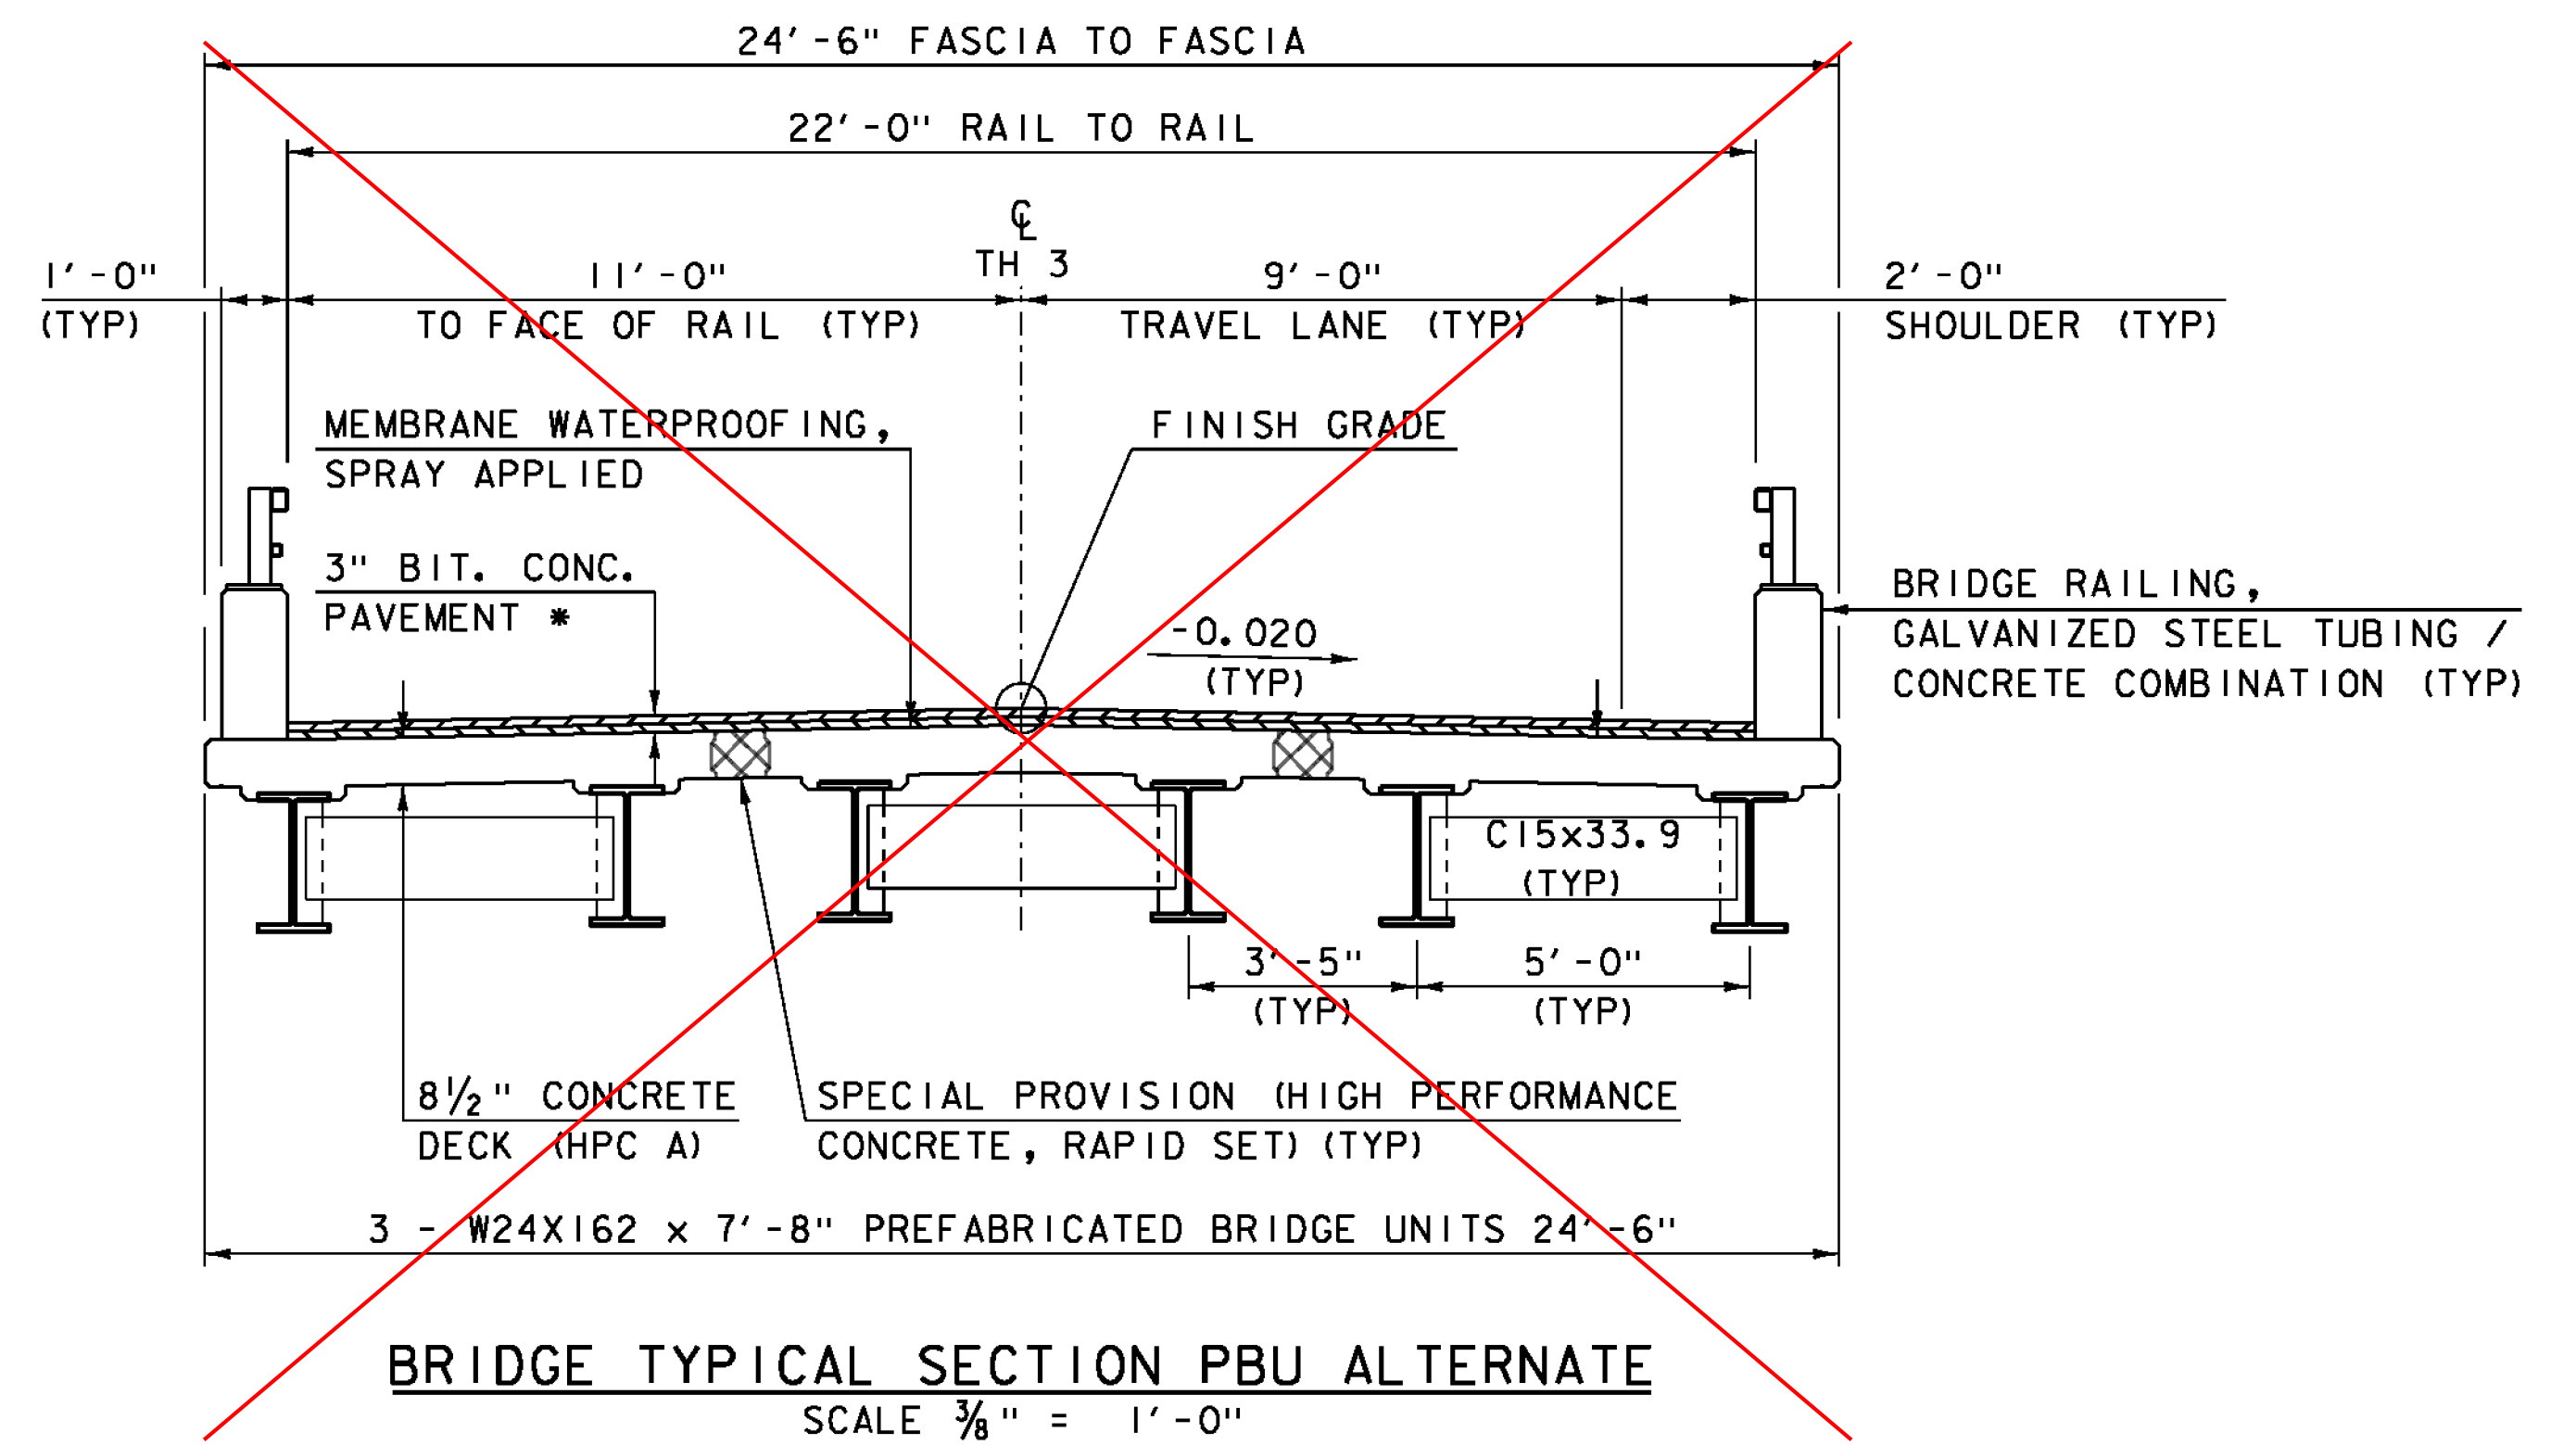


BRIDGE TYPICAL SECTION PBU ALTERNATE
SCALE 3/8" = 1'-0"

* 1 1/2" BITUMINOUS CONCRETE PAVEMENT TYPE III OR IVS OVER
1 1/2" BITUMINOUS CONCRETE PAVEMENT TYPE III OR IVS

MATERIAL TOLERANCES
(IF USED ON PROJECT)

SURFACE	
- PAVEMENT (TOTAL THICKNESS)	+/- 1/4"
- AGGREGATE SURFACE COURSE	+/- 1/2"
SUBBASE	+/- 1"
SAND BORROW	+/- 1"

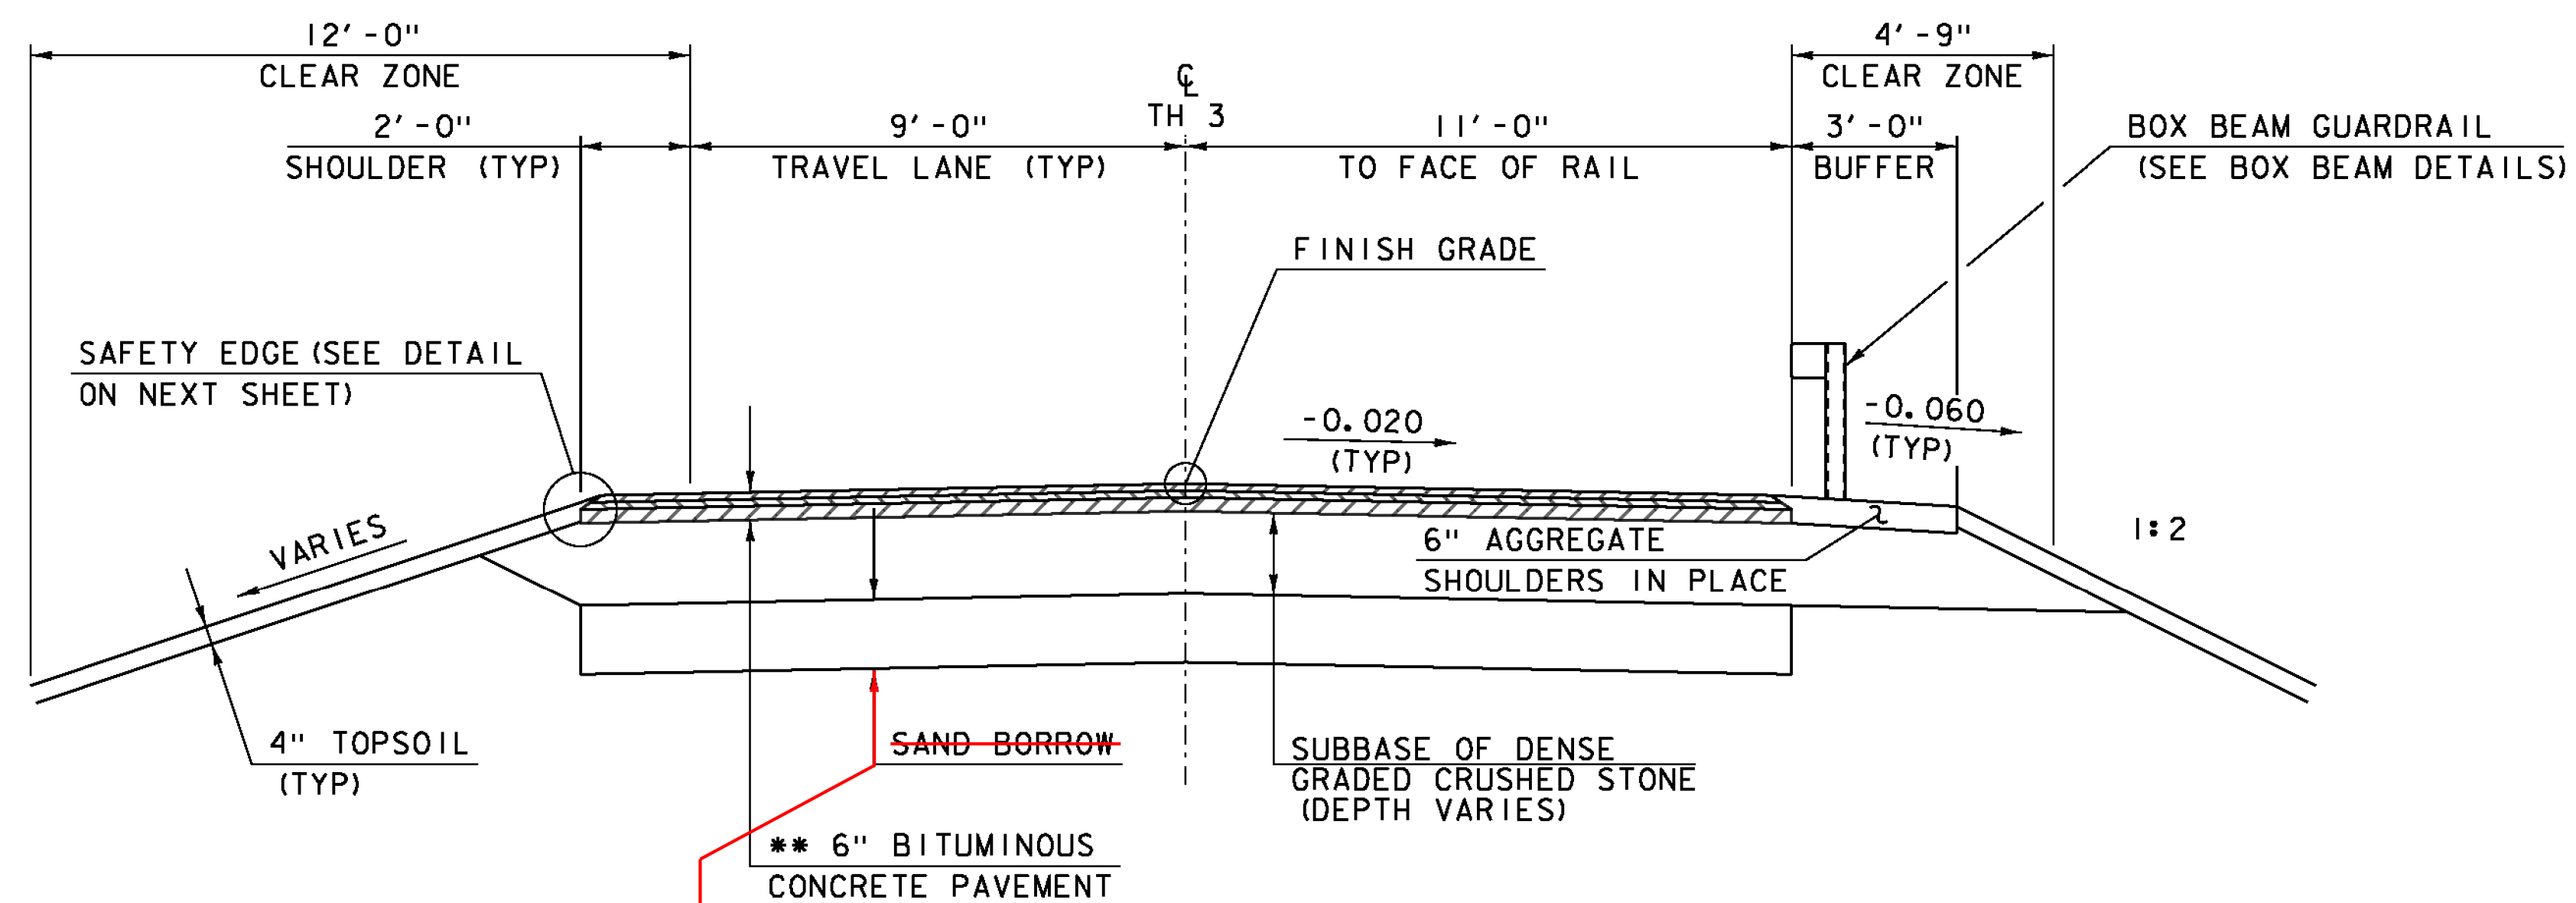

ROADWAY TYPICAL SECTION
SCALE 3/8" = 1'-0"

** 1 1/2" BITUMINOUS CONCRETE PAVEMENT TYPE III OR IVS OVER
1 1/2" BITUMINOUS CONCRETE PAVEMENT TYPE III OR IVS OVER
3" BITUMINOUS CONCRETE PAVEMENT TYPE I OR IIS

1'-6" SUBBASE OF DENSE GRADED CRUSHED STONE
1'-3" SAND BORROW

SUBBASE OF DENSE
GRADED CRUSHED STONE

PROJECT NAME: CLARENDON
PROJECT NUMBER: BRO 1443(48)

FILE NAME: s12j160typical.dgn
PROJECT LEADER: K. HIGGINS
DESIGNED BY: J. GRIGAS
TYPICAL SECTIONS 1

PLOT DATE: 08-OCT-2015
DRAWN BY: J. GRIGAS
CHECKED BY: G. LAROCHE
SHEET 9 OF 59