



**MAINLINE PROFILE**

HORIZONTAL SCALE 1" = 20'-0"  
 VERTICAL SCALE 1" = 10'-0"

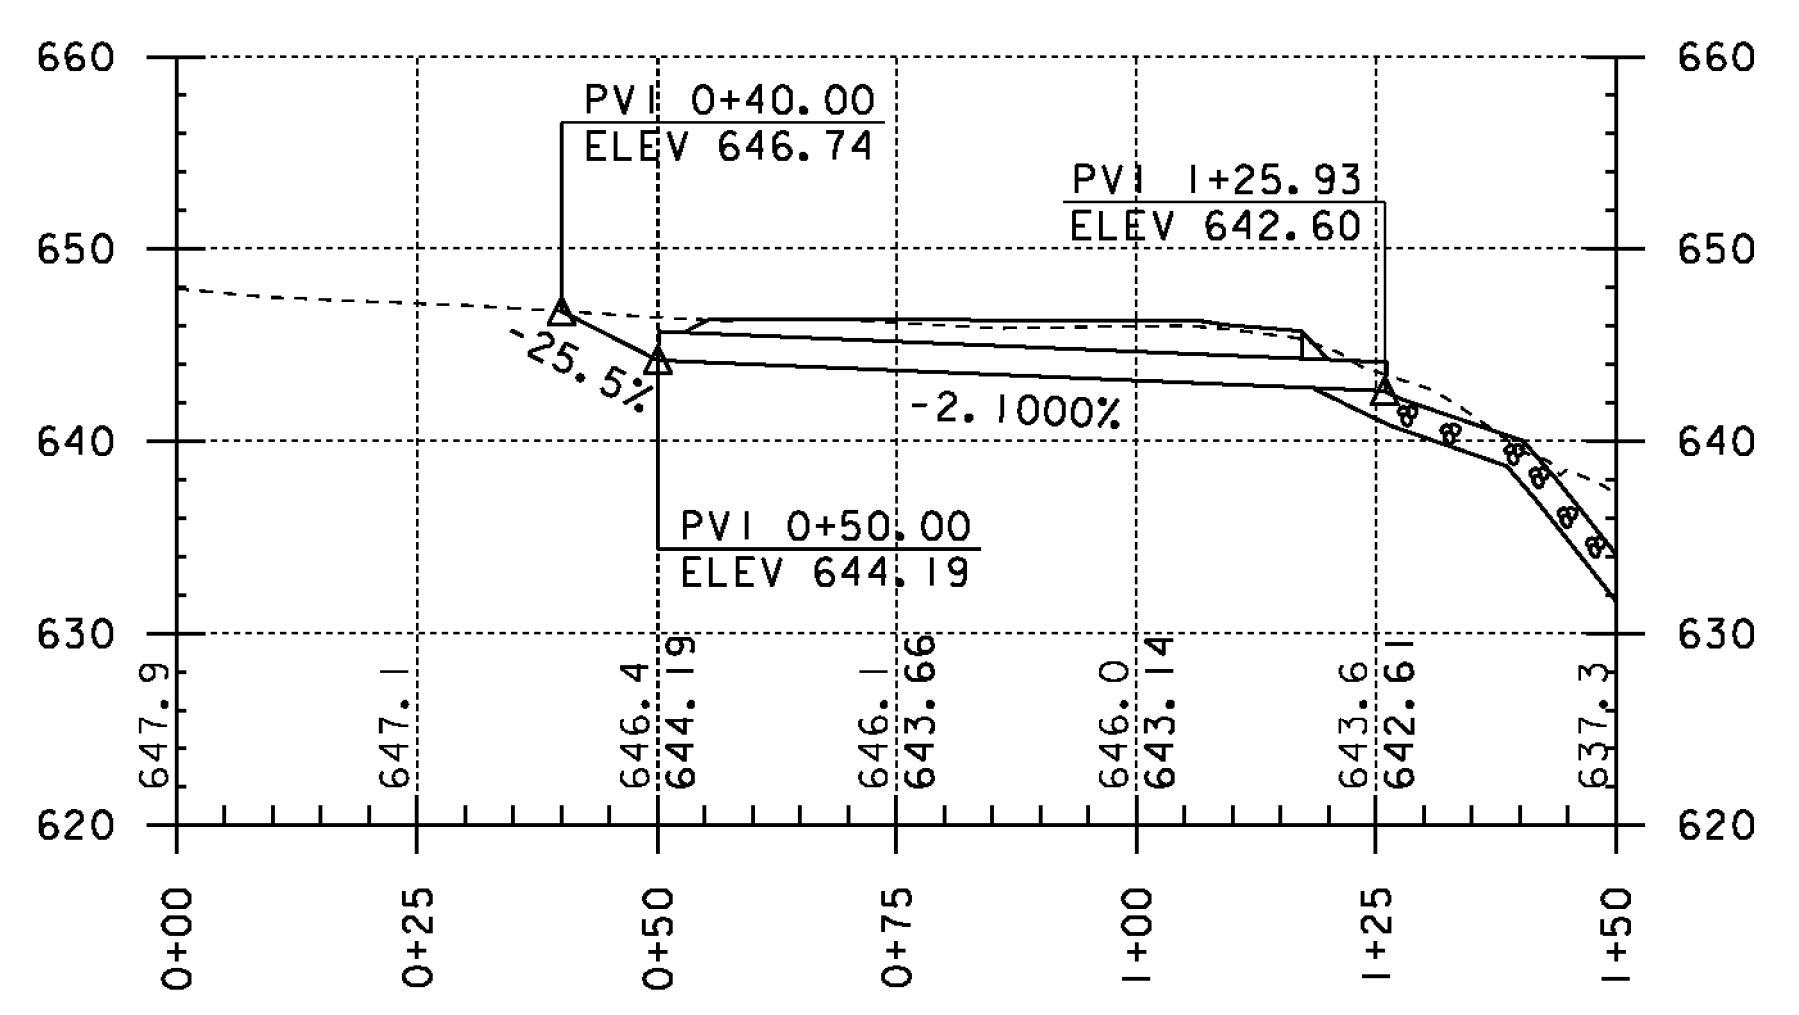

**OPTION PIPE PROFILE**

HORIZONTAL SCALE 1" = 20'-0"  
 VERTICAL SCALE 1" = 10'-0"

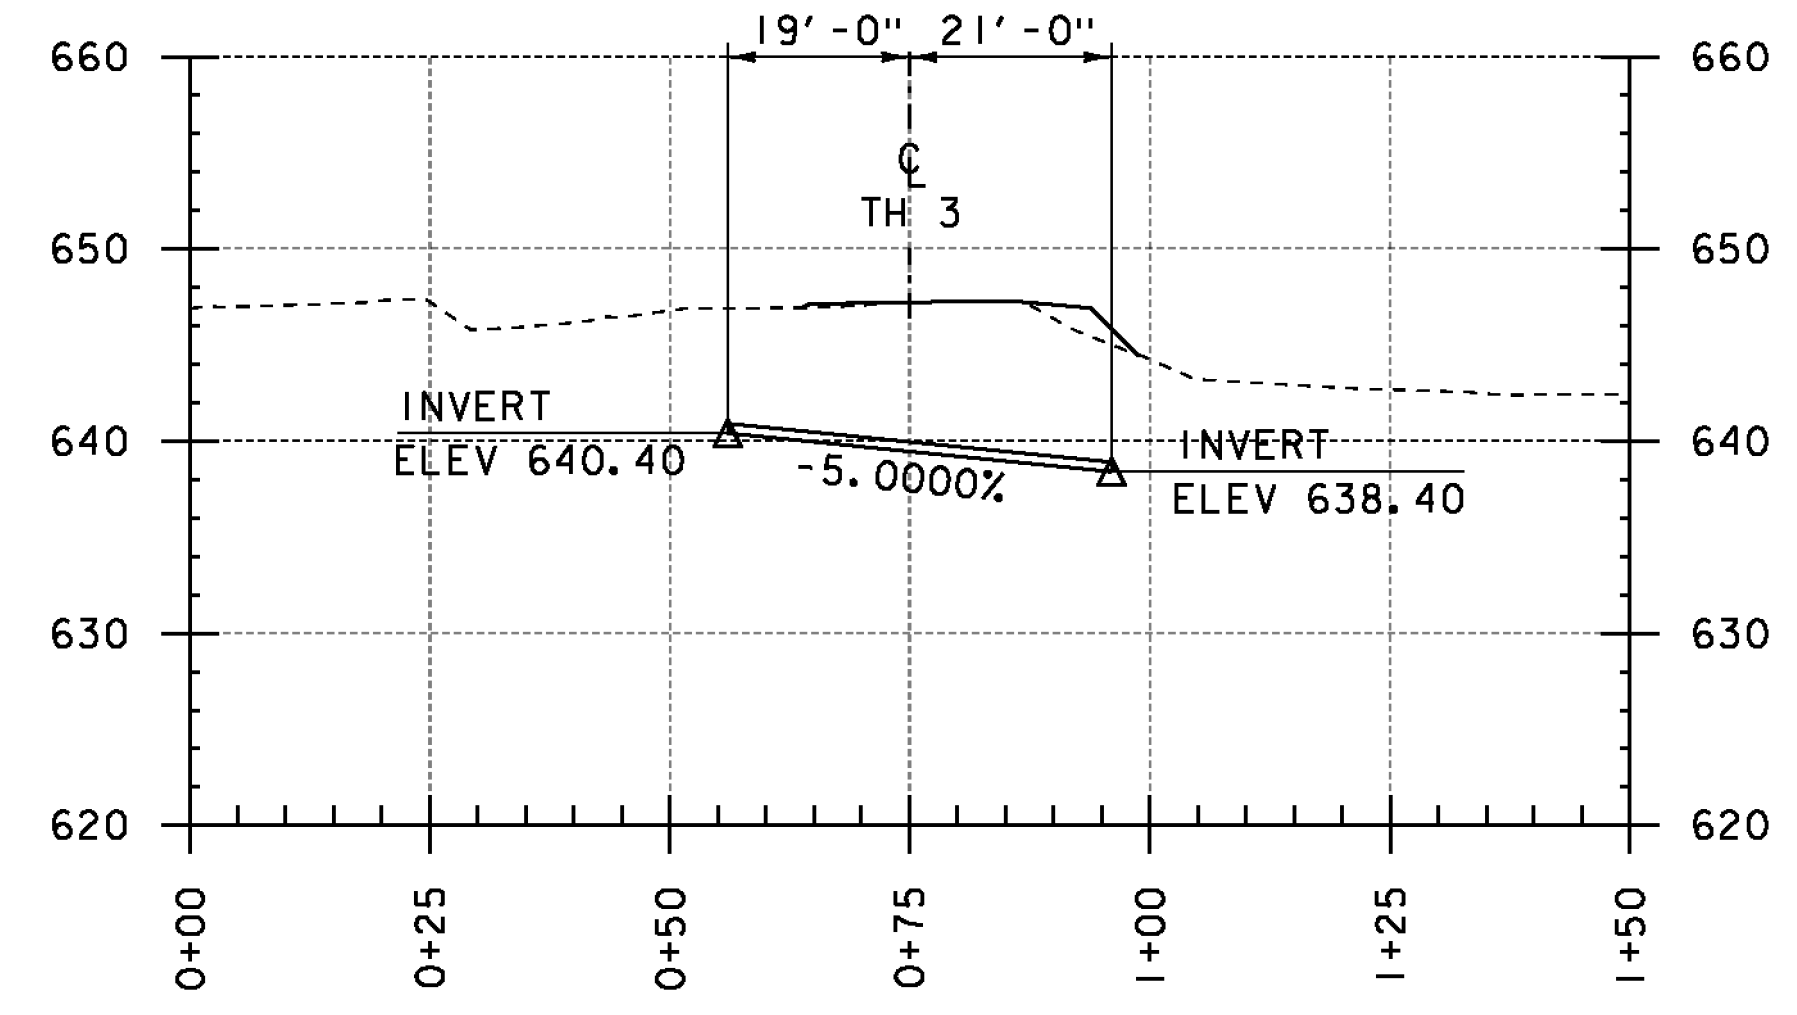

**UTILITY SLEEVE PROFILE (STA 10+60)**

HORIZONTAL SCALE 1" = 20'-0"  
 VERTICAL SCALE 1" = 10'-0"

THE GRADES SHOWN TO THE NEAREST TENTH ARE THE ORIGINAL GROUND ELEVATIONS ALONG THE PROPOSED ALIGNMENT.

THE GRADES SHOWN TO THE NEAREST HUNDREDTH ARE THE FINISH GRADES ALONG THE PROPOSED ALIGNMENT.

PROJECT NAME: CLARENDON	PLOT DATE: 10-SEP-2015
PROJECT NUMBER: BRO 1443(48)	DRAWN BY: J. GRIGAS
FILE NAME: s12j160profile.dgn	CHECKED BY: G. LAROCHE
PROJECT LEADER: K. HIGGINS	SHEET 15 OF 59
DESIGNED BY: J. GRIGAS	
MAINLINE PROFILE	