

REMOVING SIGNS

STA 12+31.00 LT



~~4 INCH WHITE LINE~~

~~STA 10+25.00 - 13+50.00 LT/RT~~

4 INCH YELLOW LINE (DOUBLE)

STA 10+25.00 - 13+50.00 CL

STA 12+31.00 LT

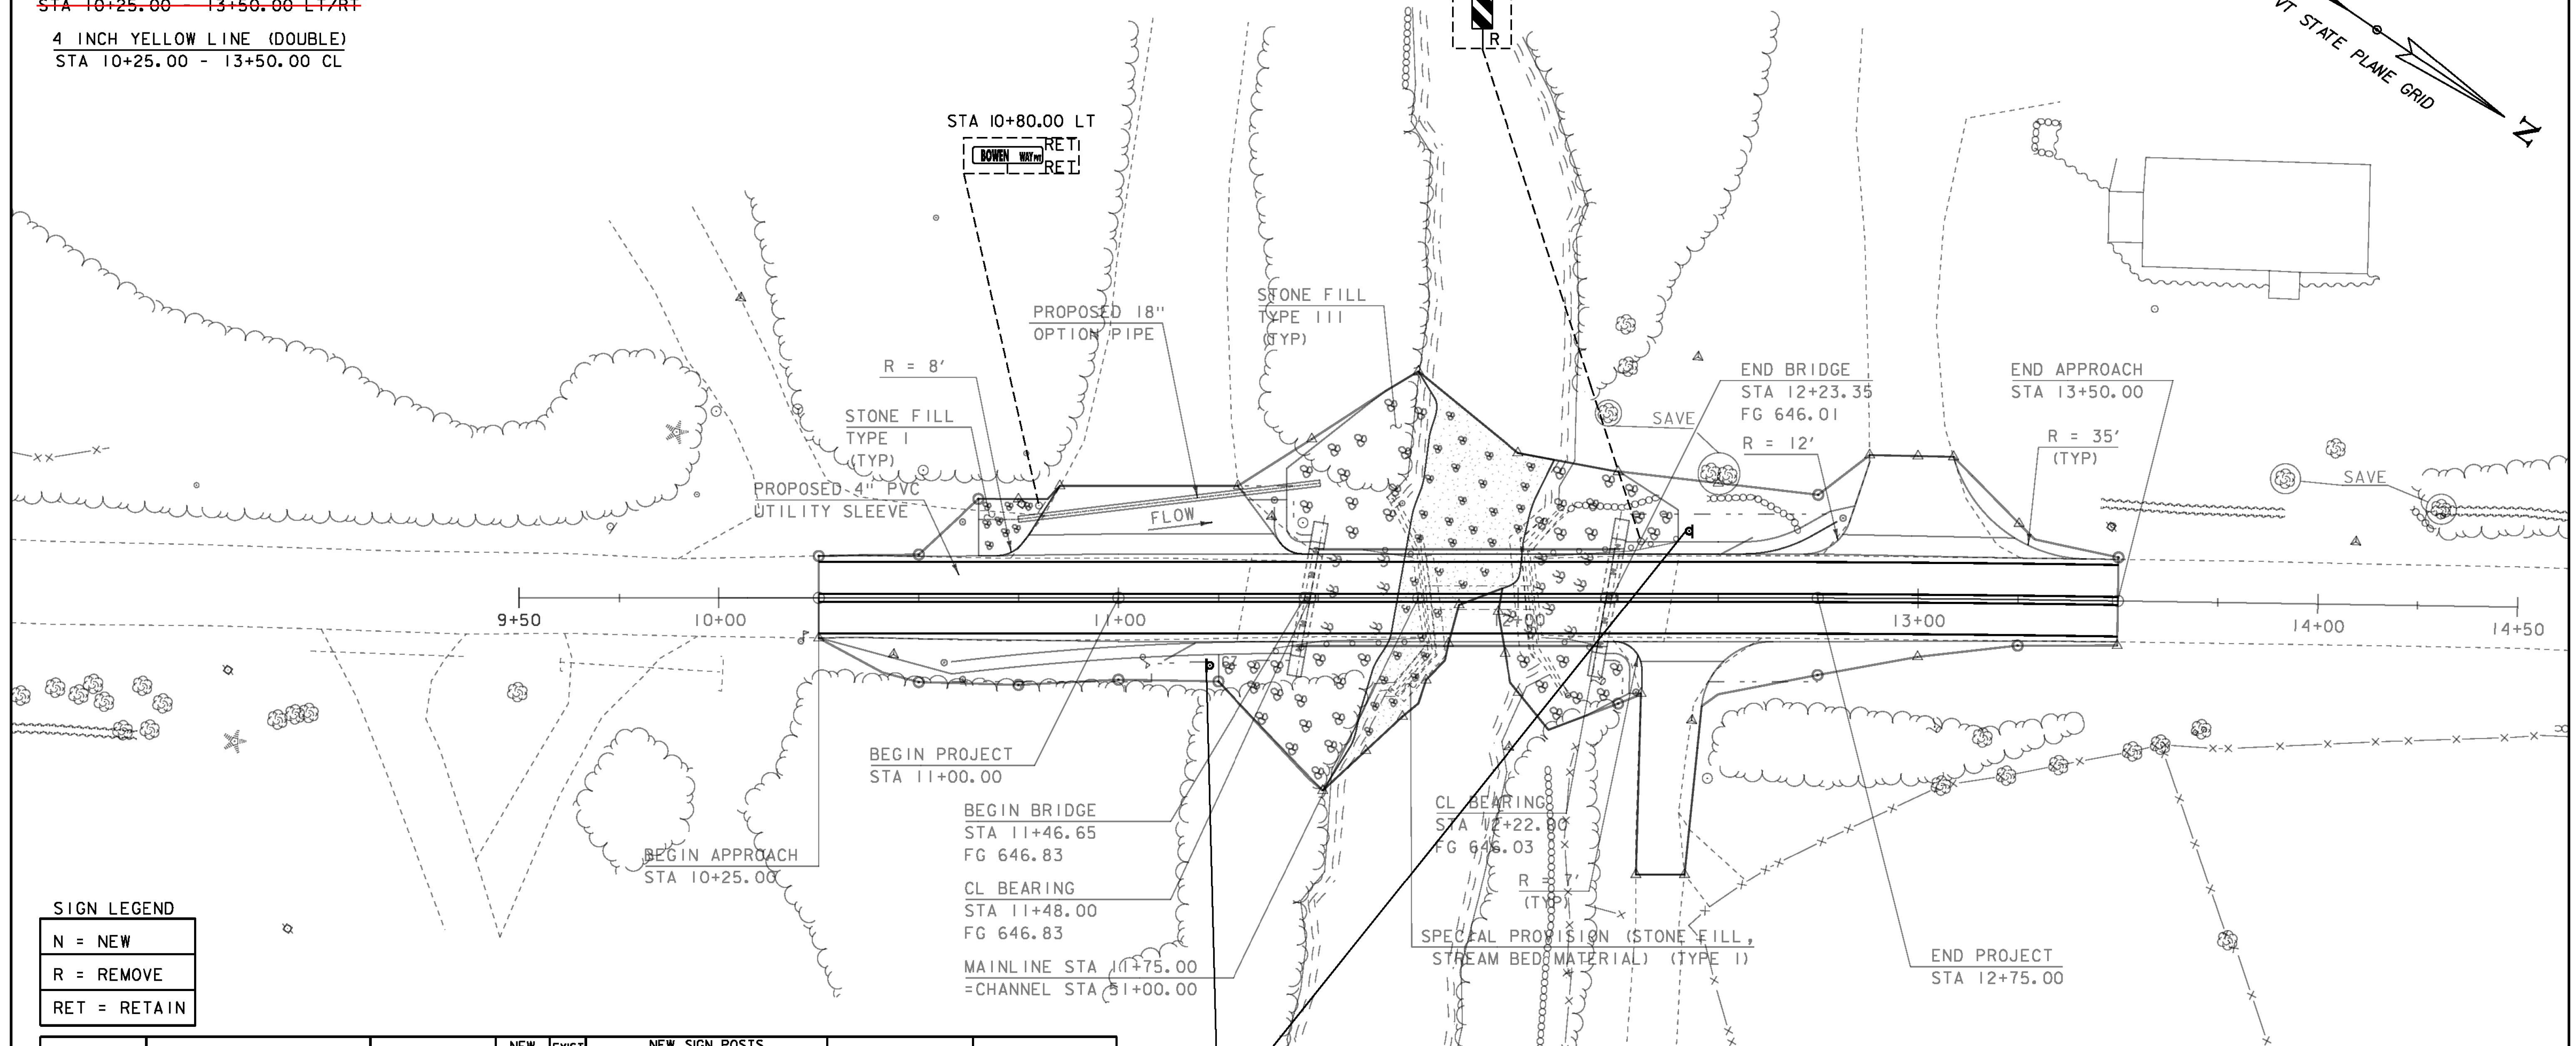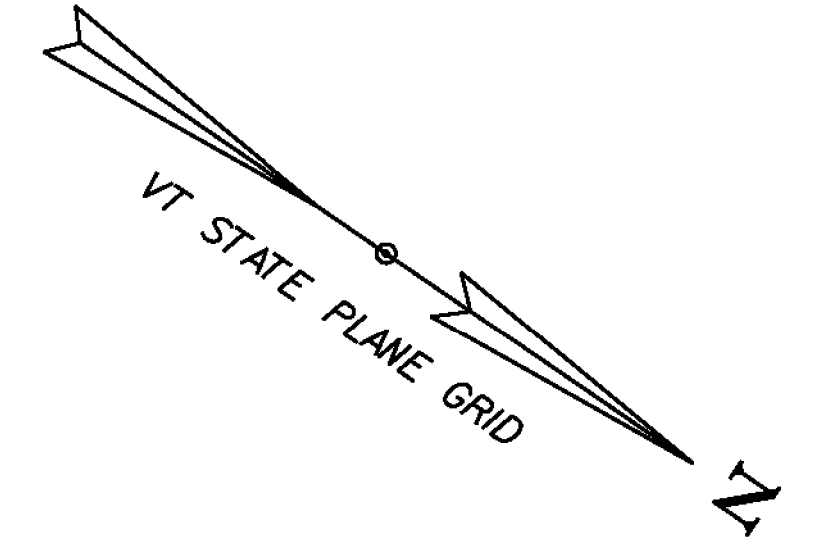

SIGN LEGEND

N = NEW
R = REMOVE
RET = RETAIN

MILEMARKER, STATION, OR SIGN NUMBER	SIGN LEGEND	SIGN DIMENSIONS		NEW SIGN "A"	EXIST POST RETAIN	NO. OF POSTS	NEW SIGN POSTS SQUARE STEEL (in)					REMARKS	SIGN DETAIL								
		WIDTH (in)	HEIGHT (in)				SQUARE STEEL (in)			ANCHOR ROD DIA	SHEATH DIA		SHEATH THICK	DETAIL ON SHEET NUMBER	STD. SHEET NUMBER						
							1.75	2.0	2.5												
11+23 RT	 BRIDGE 11	30	30	6.25		1		15			X		VW-133	E-154							
		6	8	0.33									VD-701	T-42							
12+43 LT	 BRIDGE 11	30	30	6.25		1		15			X		VW-133	E-154							
		6	8	0.33									VD-701	T-42							
FINAL POST LENGTHS ARE TO BE DETERMINED IN THE FIELD. POST SIZES ARE COMPUTED BASED ON INFORMATION FURNISHED ON THE STANDARD SHEETS AND THE VTRANS "SIGN POST DESIGN GUIDELINE."		<table border="1"> <tr> <td>FT</td> <td>FT</td> <td>EA</td> </tr> <tr> <td>30</td> <td></td> <td></td> </tr> </table>		FT	FT	EA	30			<table border="1"> <tr> <td>TOTALS</td> <td>SF</td> <td>EA</td> <td>FT</td> </tr> <tr> <td>13,16</td> <td></td> <td></td> <td>30</td> </tr> </table>		TOTALS	SF	EA	FT	13,16			30	SHS = STANDARD HIGHWAY SIGNS (MUTCD)	
FT	FT	EA																			
30																					
TOTALS	SF	EA	FT																		
13,16			30																		

SIGN & PAVEMENT MARKINGS

SCALE 1" = 20' - 0"  
 20 0 20

NOTE:  
 ADJUST NEW CENTERLINE AND EDGE LINES TO MATCH EXISTING LINES AT BEGIN/END APPROACH

PROJECT NAME: CLARENDON	PLOT DATE: 08-OCT-2015
PROJECT NUMBER: BRO 1443(48)	DRAWN BY: S. COLEY
FILE NAME: s12j160s1gn	CHECKED BY: J. GRIGAS
PROJECT LEADER: K. HIGGINS	SHEET 17 OF 59
DESIGNED BY: S. COLEY	
SIGN AND PAVEMENT MARKINGS	