
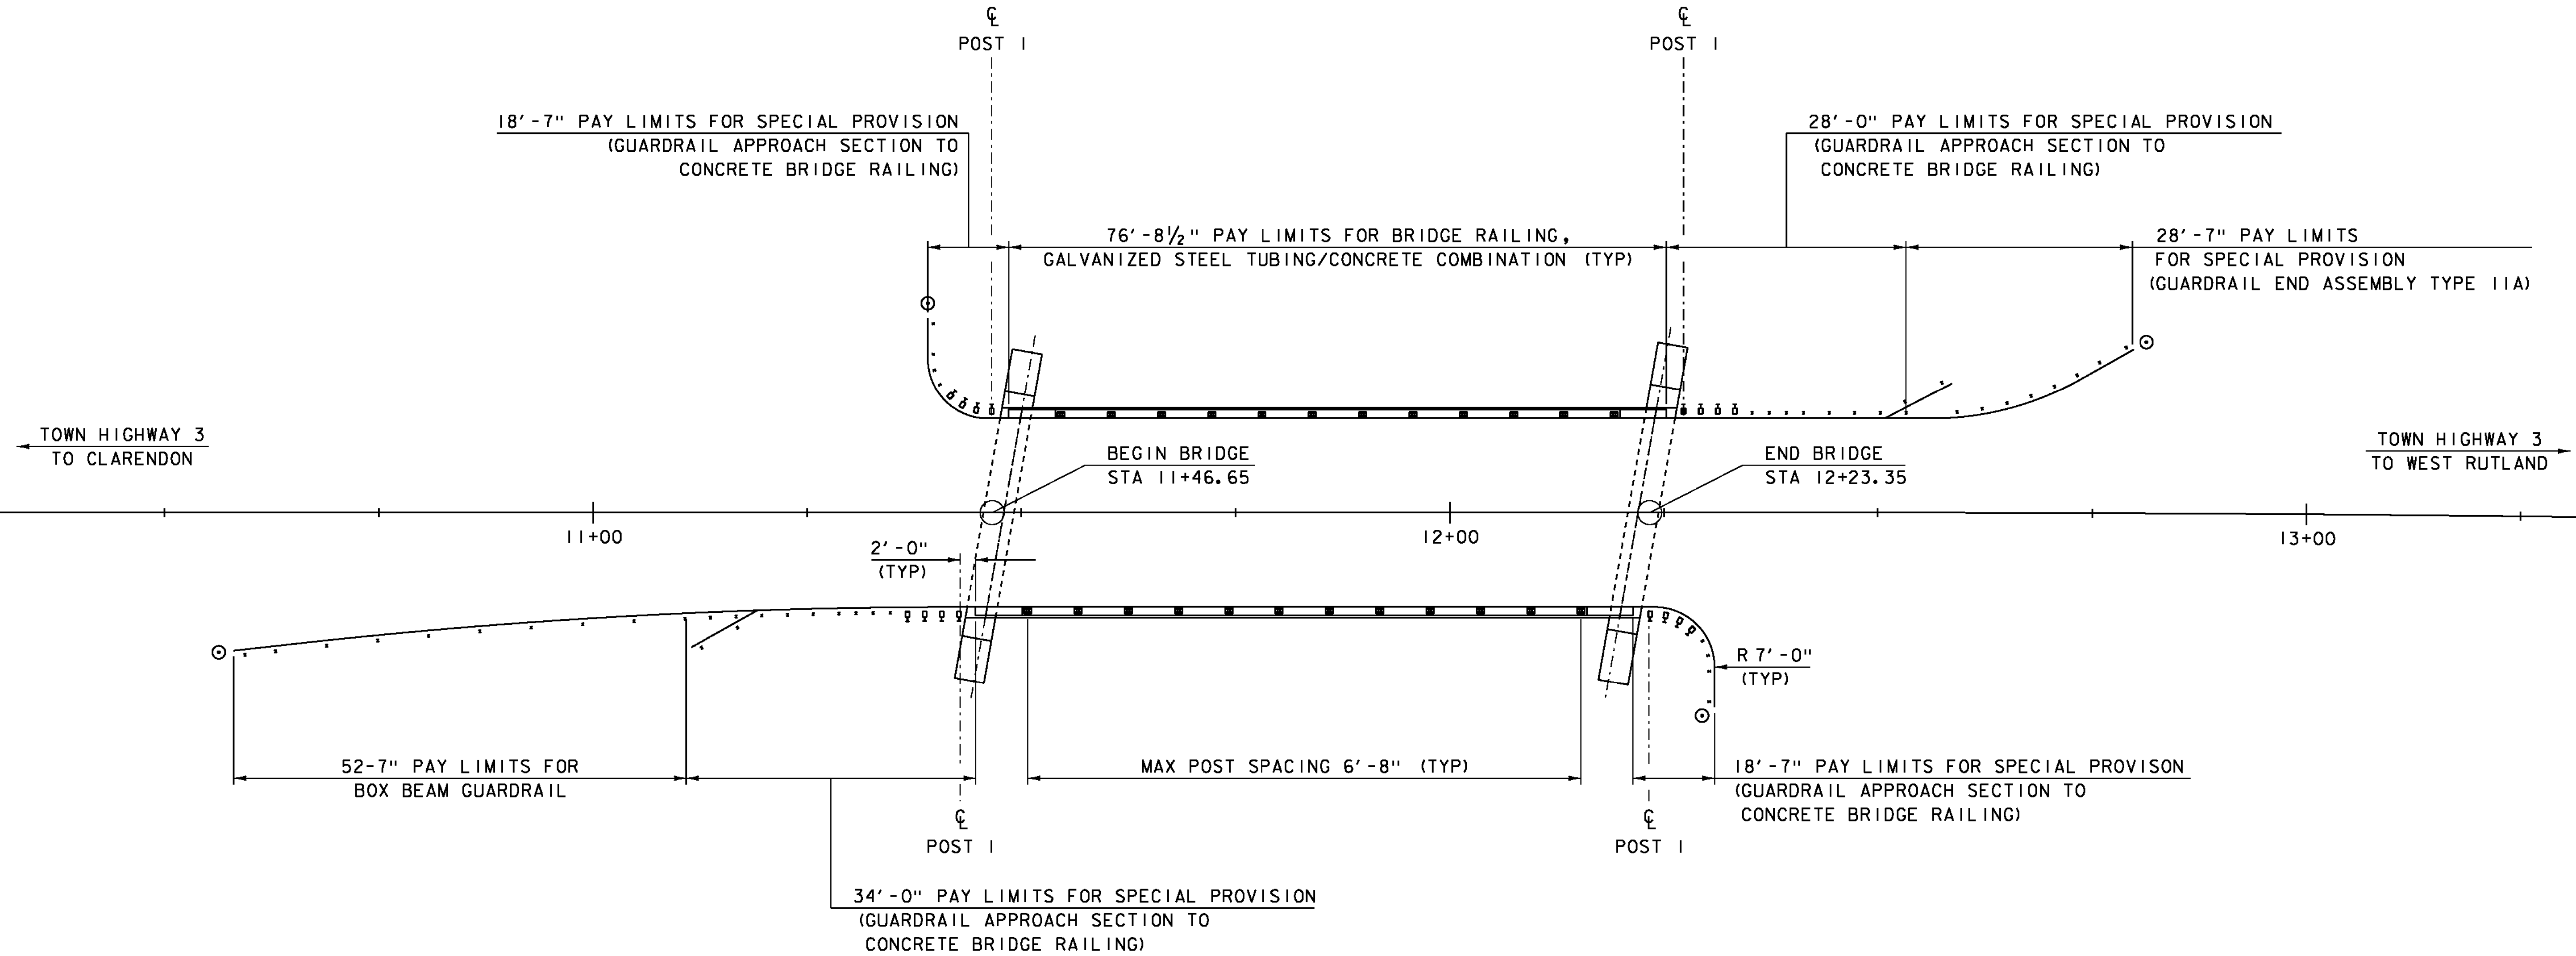


BOX BEAM GUARDRAIL
 STA 10+58.25 - 11+10.89 RT
SPECIAL PROVISION (GUARDRAIL APPROACH SECTION TO CONCRETE BRIDGE RAILING)
 STA 11+10.89 - 11+44.88 RT
 STA 11+33.59 - 11+48.75 LT
 STA 12+21.25 - 12+30.73 RT
 STA 12+25.12 - 12+56.13 LT

DELINEATOR W/ STEEL POST
 STA 10+56.34 RT
 STA 11+39.10 LT
~~GUIDE POST (WOOD)~~ DELINEATOR W/STEEL POST
 STA 12+30.90 RT
 STA 12+81.21 LT

CLARENDON RIVER
 FLOW

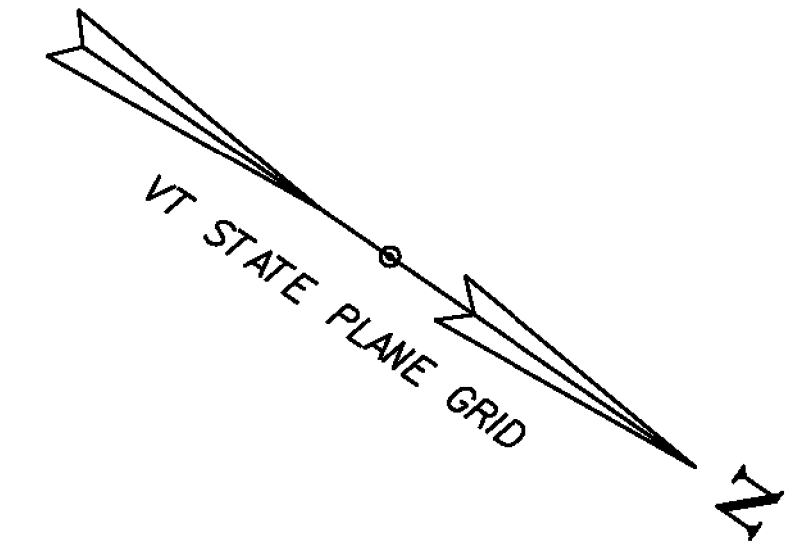

RAIL LAYOUT SHEET
 SCALE 1" = 10'-0"

NOTES:

1. ALL DIMENSIONS ARE ALONG THE FACE OF RAIL.
2. SEE STANDARDS G-4, S-352B, S-352C, T-40 AND THE FOLLOWING PLAN SHEETS FOR ADDITIONAL DETAILS.

PROJECT NAME: CLARENDON	PLOT DATE: 10-SEP-2015
PROJECT NUMBER: BRO 1443(48)	DRAWN BY: J. GRIGAS
FILE NAME: s12j160bdr_rail.dgn	CHECKED BY: G. LAROCHE
PROJECT LEADER: K. HIGGINGS	SHEET 18 OF 59
DESIGNED BY: J. GRIGAS	
RAIL LAYOUT SHEET	