


APPROACH RAIL PLAN @ WW2

NOT TO SCALE

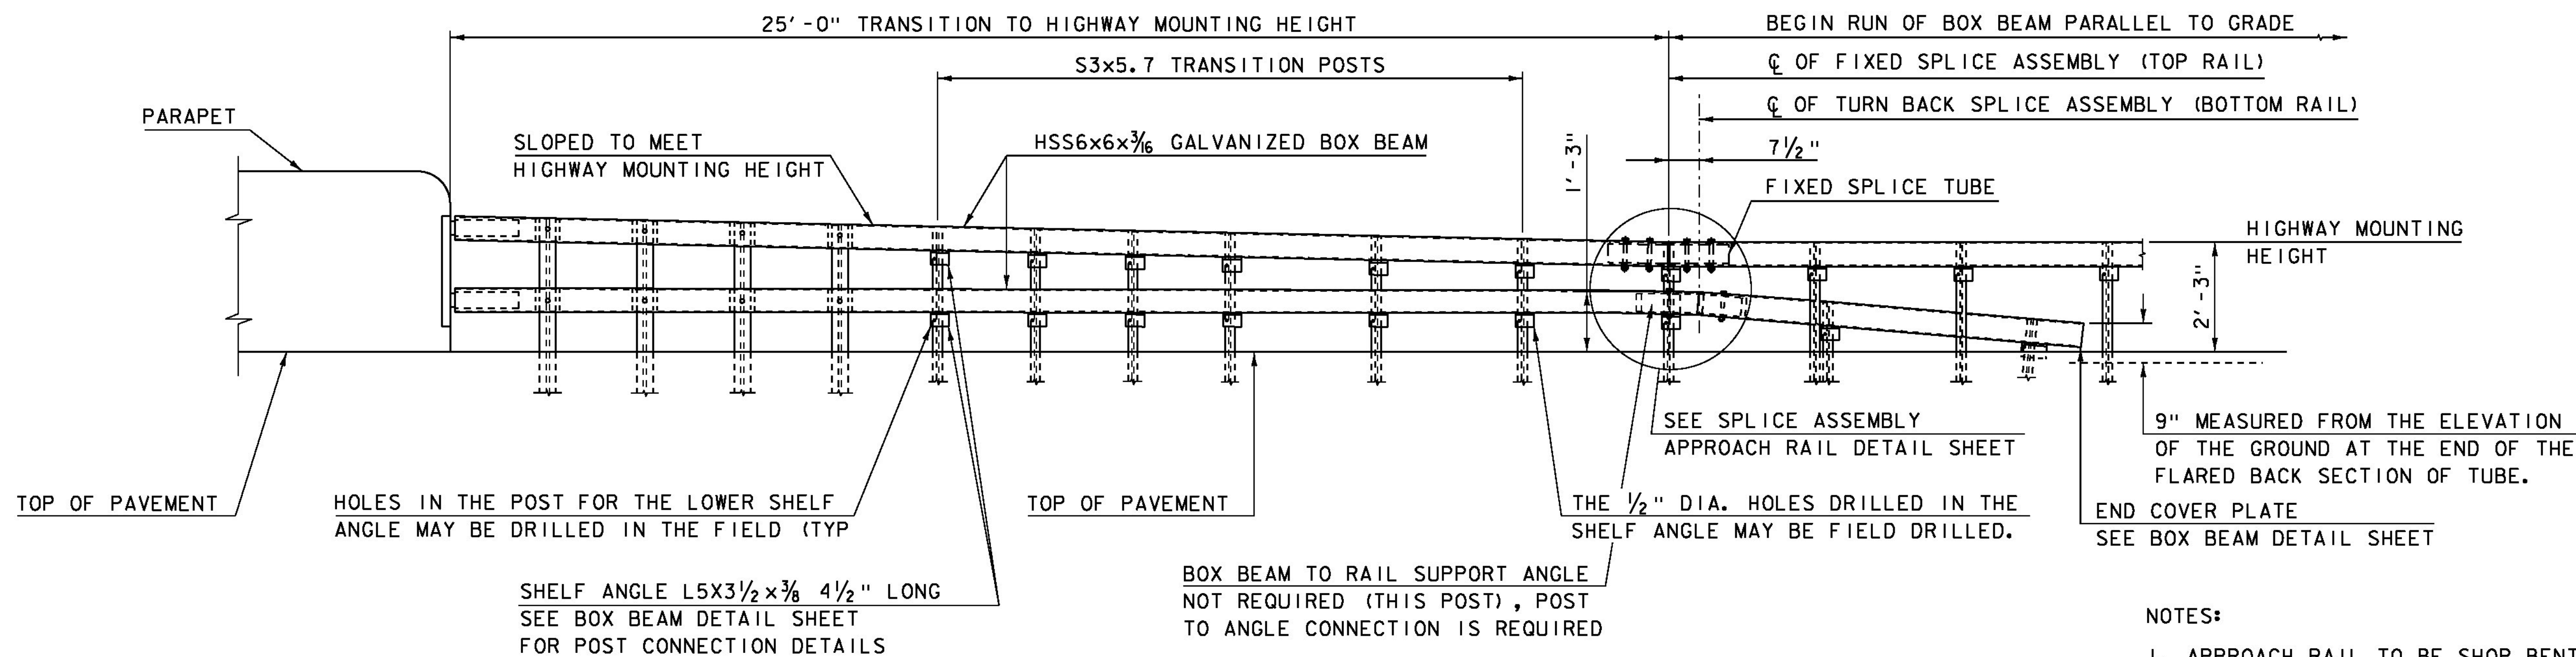

APPROACH RAIL ELEVATION @ WW2

NOT TO SCALE

NOTES:

1. APPROACH RAIL TO BE SHOP BENT.
2. ANY HOLES THAT ARE FIELD DRILLED SHALL HAVE THEIR GALVANIZING REPAIRED PER SUBSECTION 726.08 OF THE STANDARD SPECIFICATIONS.
3. SEE BOX BEAM DETAIL SHEET FOR FURTHER DETAILS.
4. RAILS SHOWN STRAIGHT FOR CLARITY

PROJECT NAME:	CLARENDON
PROJECT NUMBER:	BRO 1443(48)
FILE NAME:	st2j160ralldet.dgn
PROJECT LEADER:	K. HIGGINS
DESIGNED BY:	J. GRIGAS
APPROACH RAIL WW2	
PLOT DATE:	10-SEP-2015
DRAWN BY:	S. COLEY
CHECKED BY:	G. LAROCHE
SHEET	21 OF 59