


L	75'-0 1/4"
W1	8'-5"
W2	7'-8"
W3	8'-0 1/2"
S1	5'-0"
S2	3'-5"
D	15'-0"
D1	7'-0"
D2	7'-10 1/2"
D3	6'-1 1/2"

SKEW	A1	100°
	A2	80°

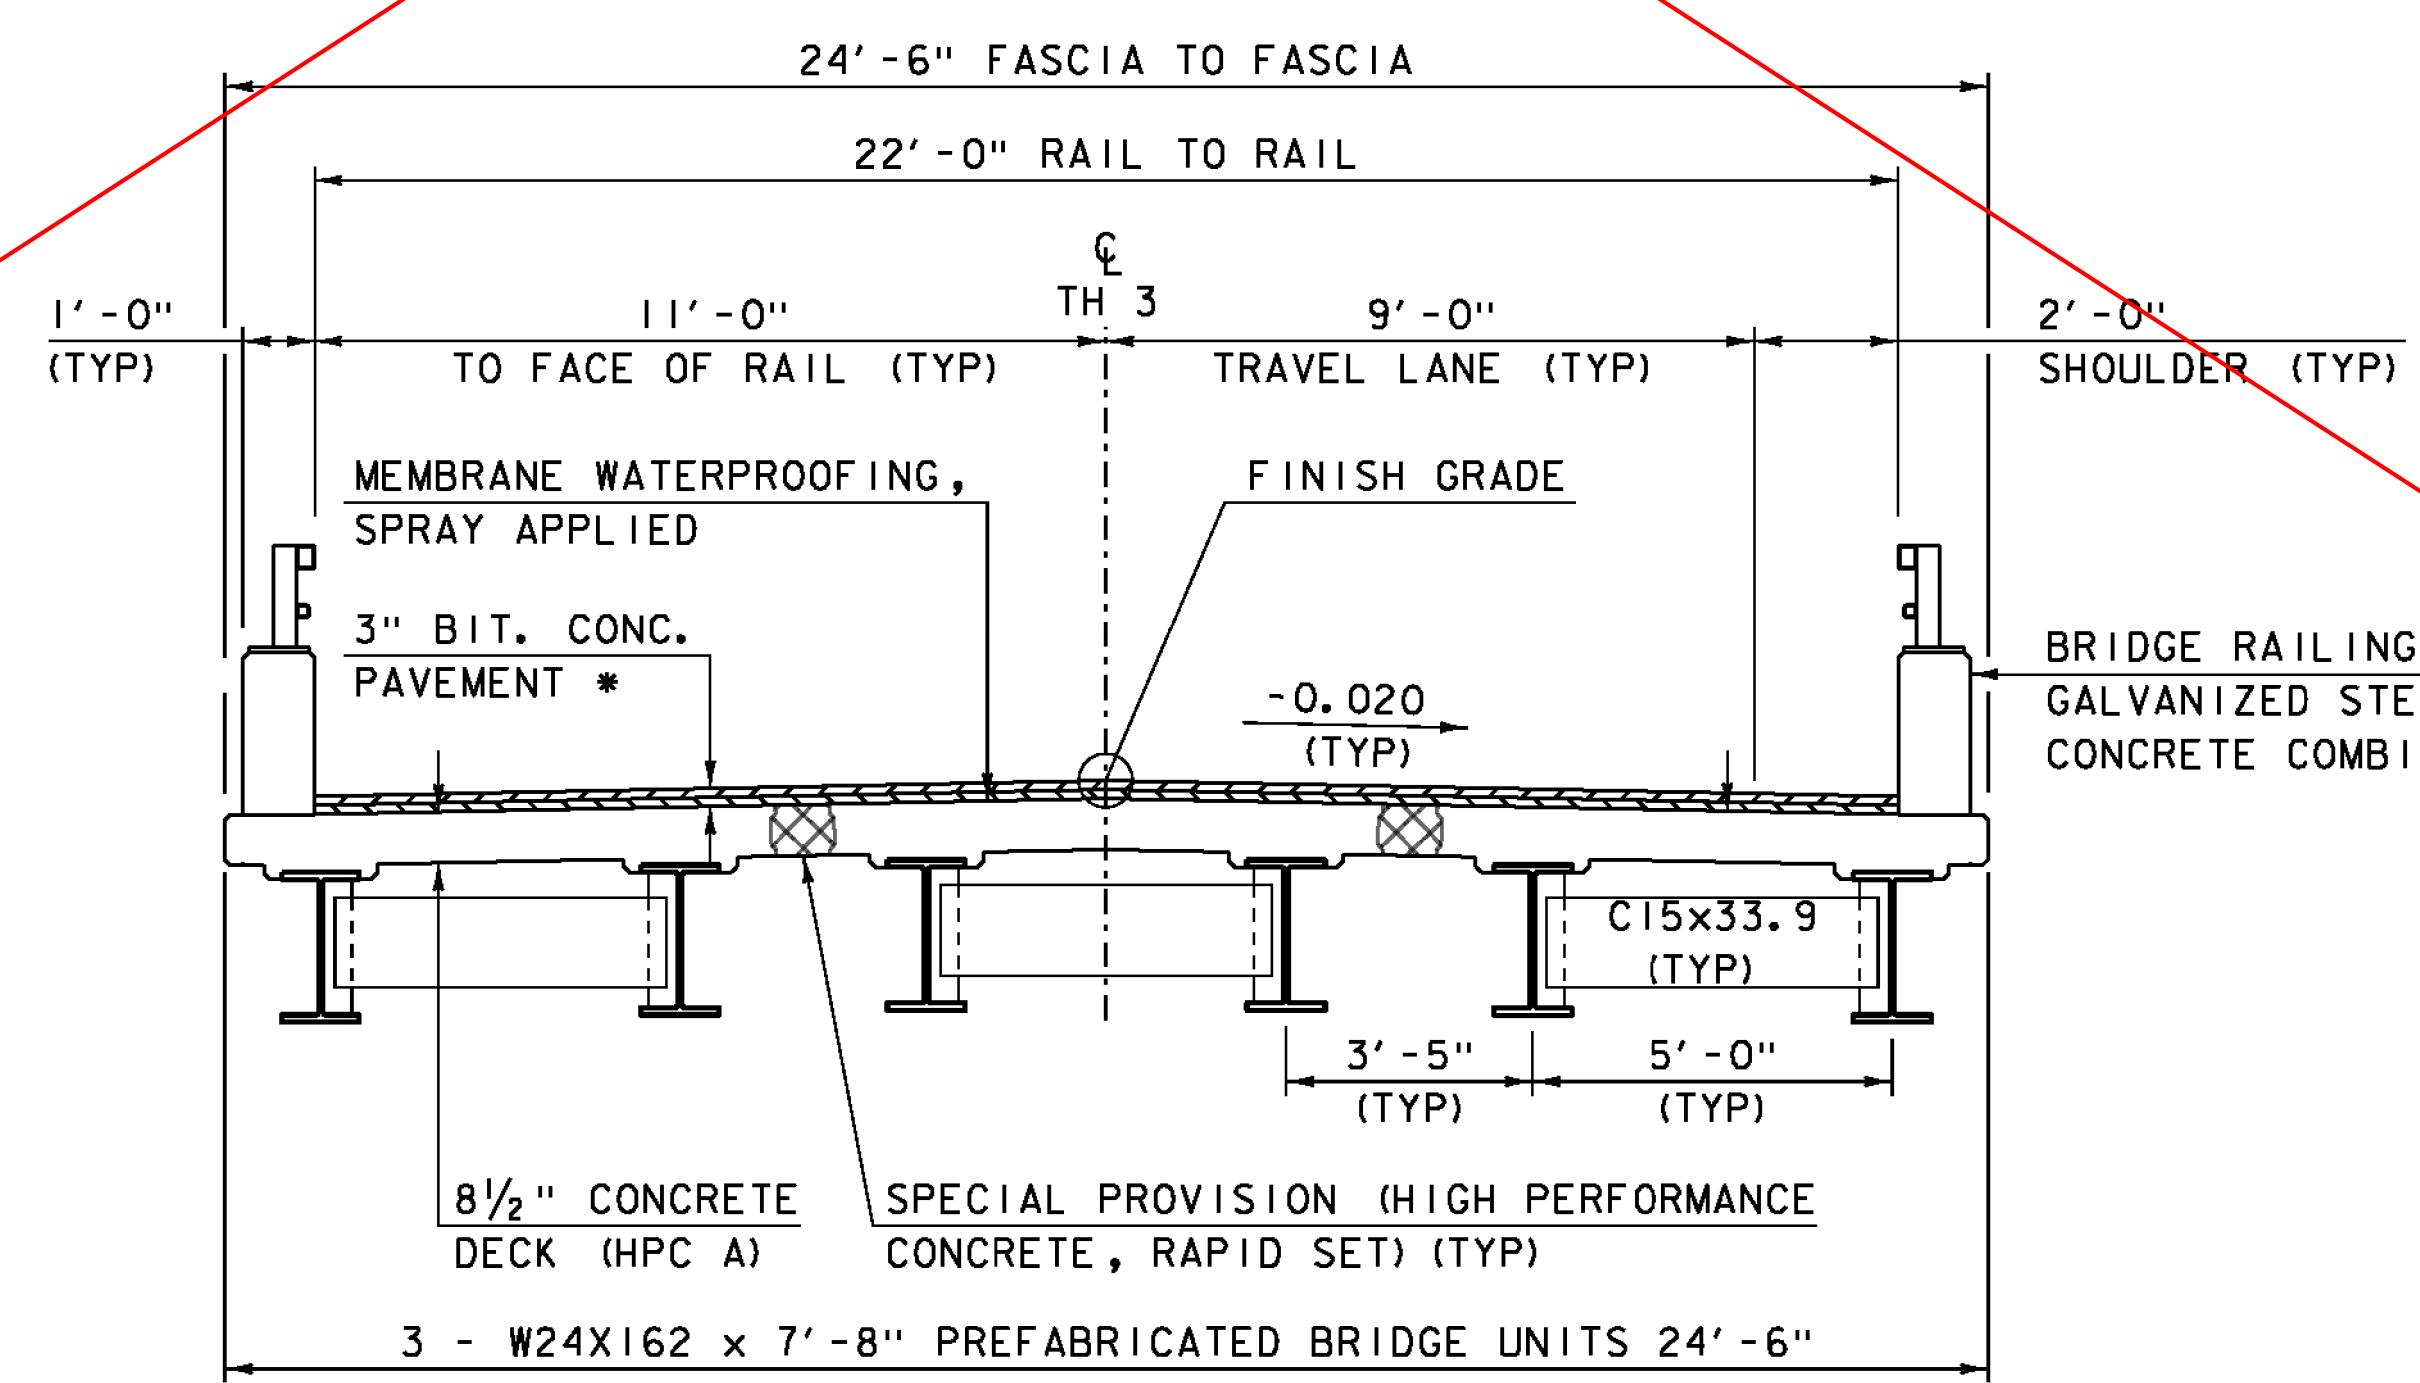

- SPECIAL PROVISION (HIGH PERFORMANCE CONCRETE, RAPID SET)
- SPECIAL PROVISION (BITUMINOUS CONCRETE PAVEMENT, SMALL QUANTITY) \*

NOTE:  
\*BITUMINOUS CONCRETE PAVEMENT IN DECK PLAN VIEW IS OMITTED FOR CLARITY

PROJECT NAME:	CLARENDON
PROJECT NUMBER:	BRO 1443(48)
FILE NAME:	s12j160sup2
PROJECT LEADER:	K. HIGGINS
DESIGNED BY:	J. GRIGAS
PBU FRAMING PLAN	
PLOT DATE:	08-OCT-2015
DRAWN BY:	T. MATTHEWS
CHECKED BY:	G. LAROCHE
SHEET	37 OF 59