


ABUTMENT REINFORCING PLAN  
SCALE 1/2" = 1'-0"

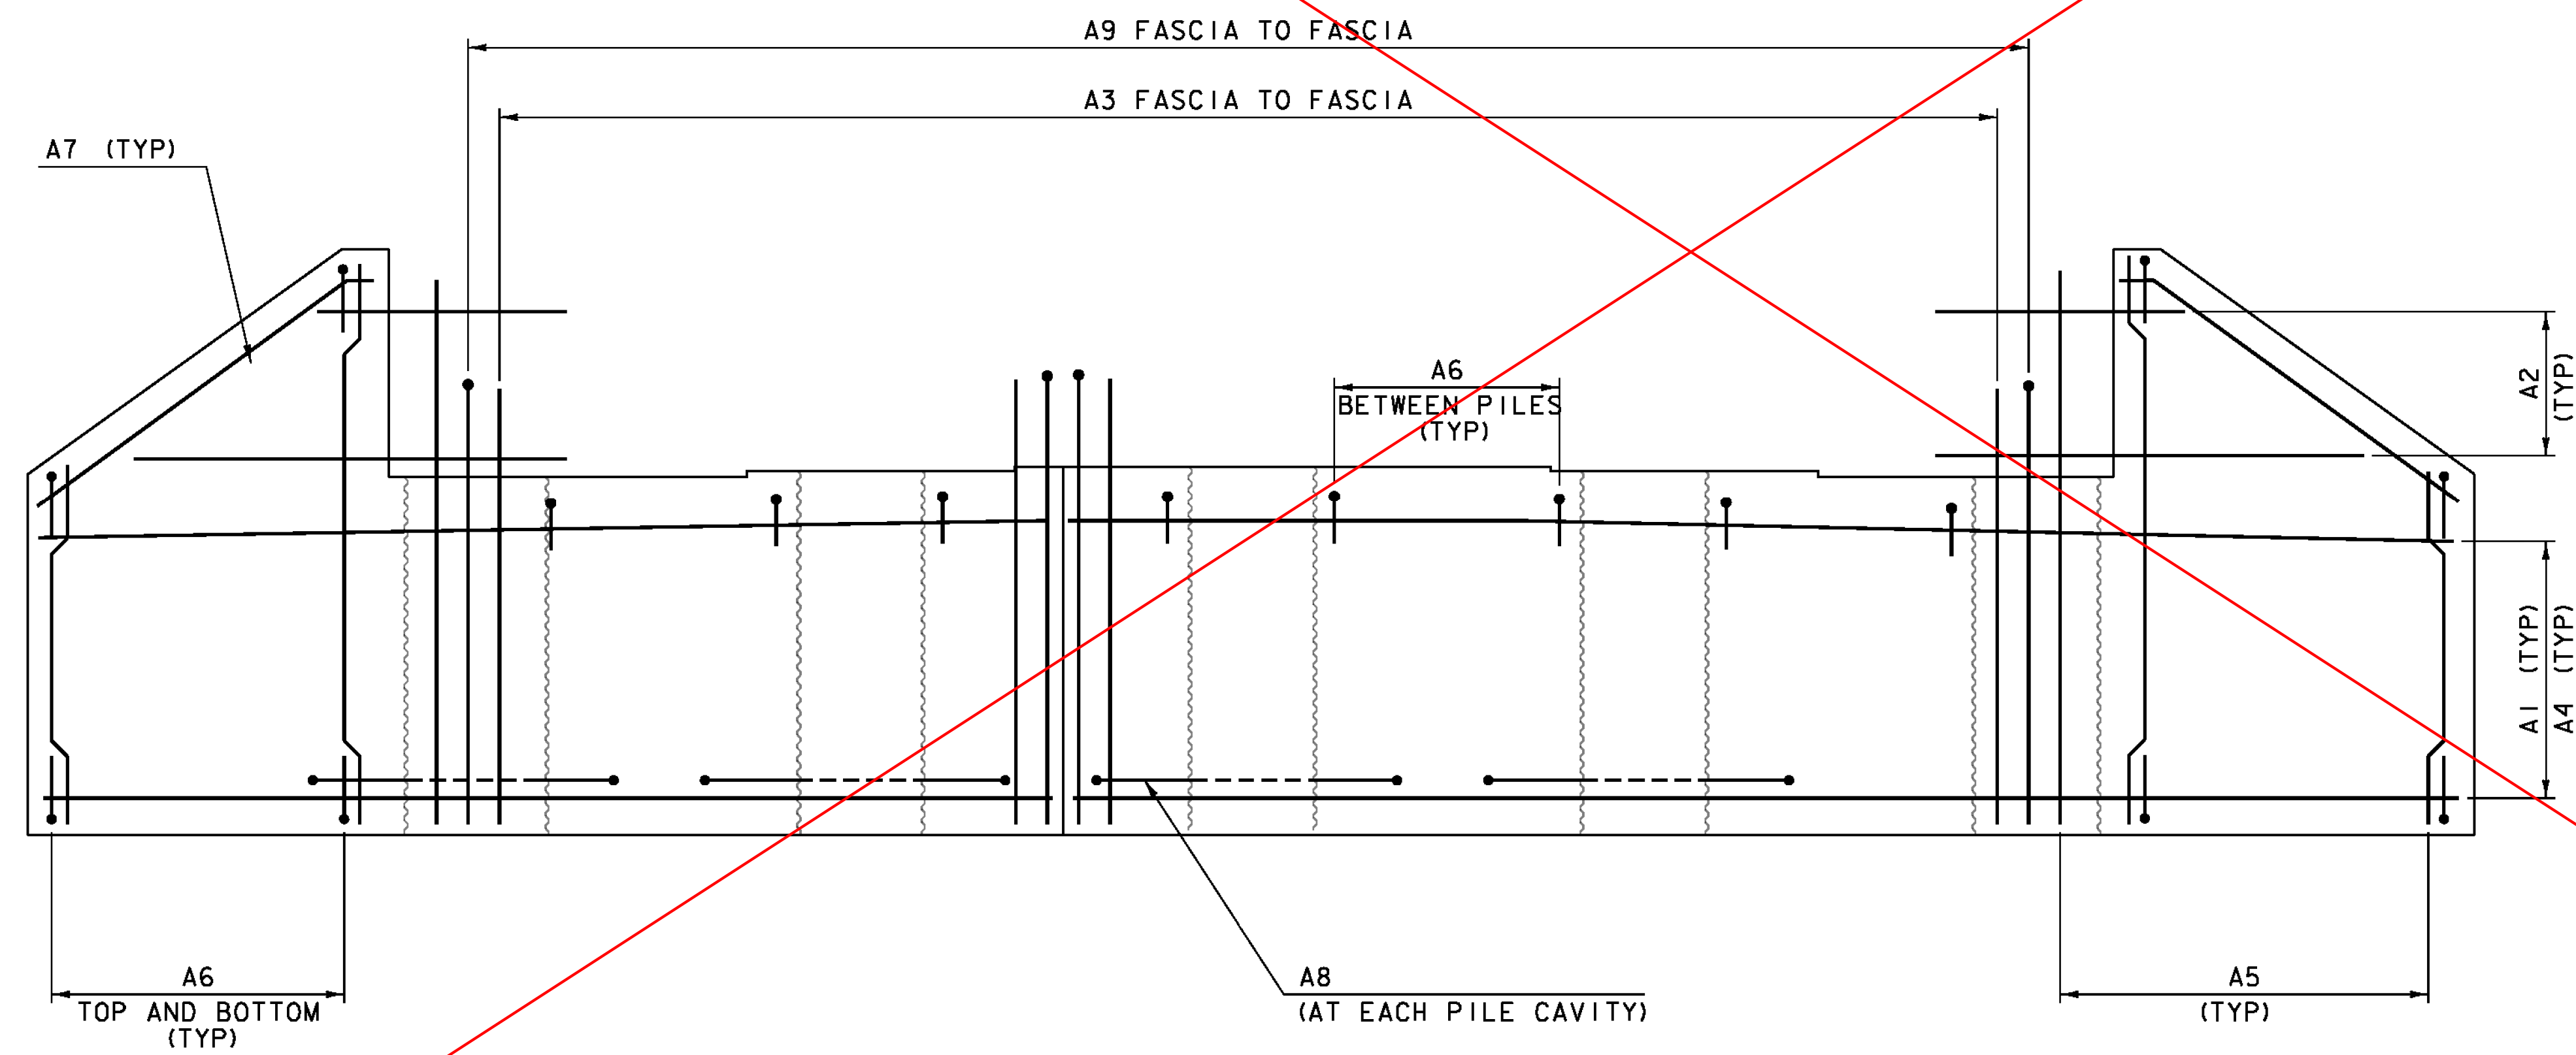

ABUTMENT REINFORCING ELEVATION  
SCALE 1/2" = 1'-0"

ABUTMENT REINFORCING

BAR	SIZE	SPACING	FACE	TYPE
A1	5	10"	NF	STR
A2	5	10"	EF	STR
A3	5	10"	NF	STR
A4	8	12"	FF	STR
A5	5	10"	EF	STR
A6	5	10"	---	S10
A7	5	AS SHOWN	EF	19
A8	6	AS SHOWN	EF	14
A9	9	12"	FF	1

NOTES:

1. ABUTMENT 1 SHOWN, ABUTMENT 2 SIMILAR.
2. EXTEND A2 AND A7 BARS 1'-11" OUT OF WING WALL. CUT TO FIT AT CONFLICTS.
3. SEE ABUTMENT TYPICALS FOR MORE INFORMATION.

NOTE:

NF = NEAR FACE  
 FF = FAR FACE  
 EF = EACH FACE  
 3" CLEAR, UNLESS OTHERWISE SPECIFIED ON THE PLANS.  
 2'-7" BAR LAP UNLESS OTHERWISE SPECIFIED ON THE PLANS.

PROJECT NAME: CLARENDON	PLOT DATE: 10-SEP-2015
PROJECT NUMBER: BRO 1443(48)	DRAWN BY: J. GRIGAS
FILE NAME: s12j160sub2.dgn	CHECKED BY: G. LAROCHE
PROJECT LEADER: K. HIGGINS	SHEET 42 OF 59
DESIGNED BY: J. GRIGAS	
PBU ABUTMENT REINFORCING	