


### TH 3 BANKING DIAGRAM

HORIZONTAL SCALE: 1" = 20'-0"  
 VERTICAL SCALE: NOT TO SCALE

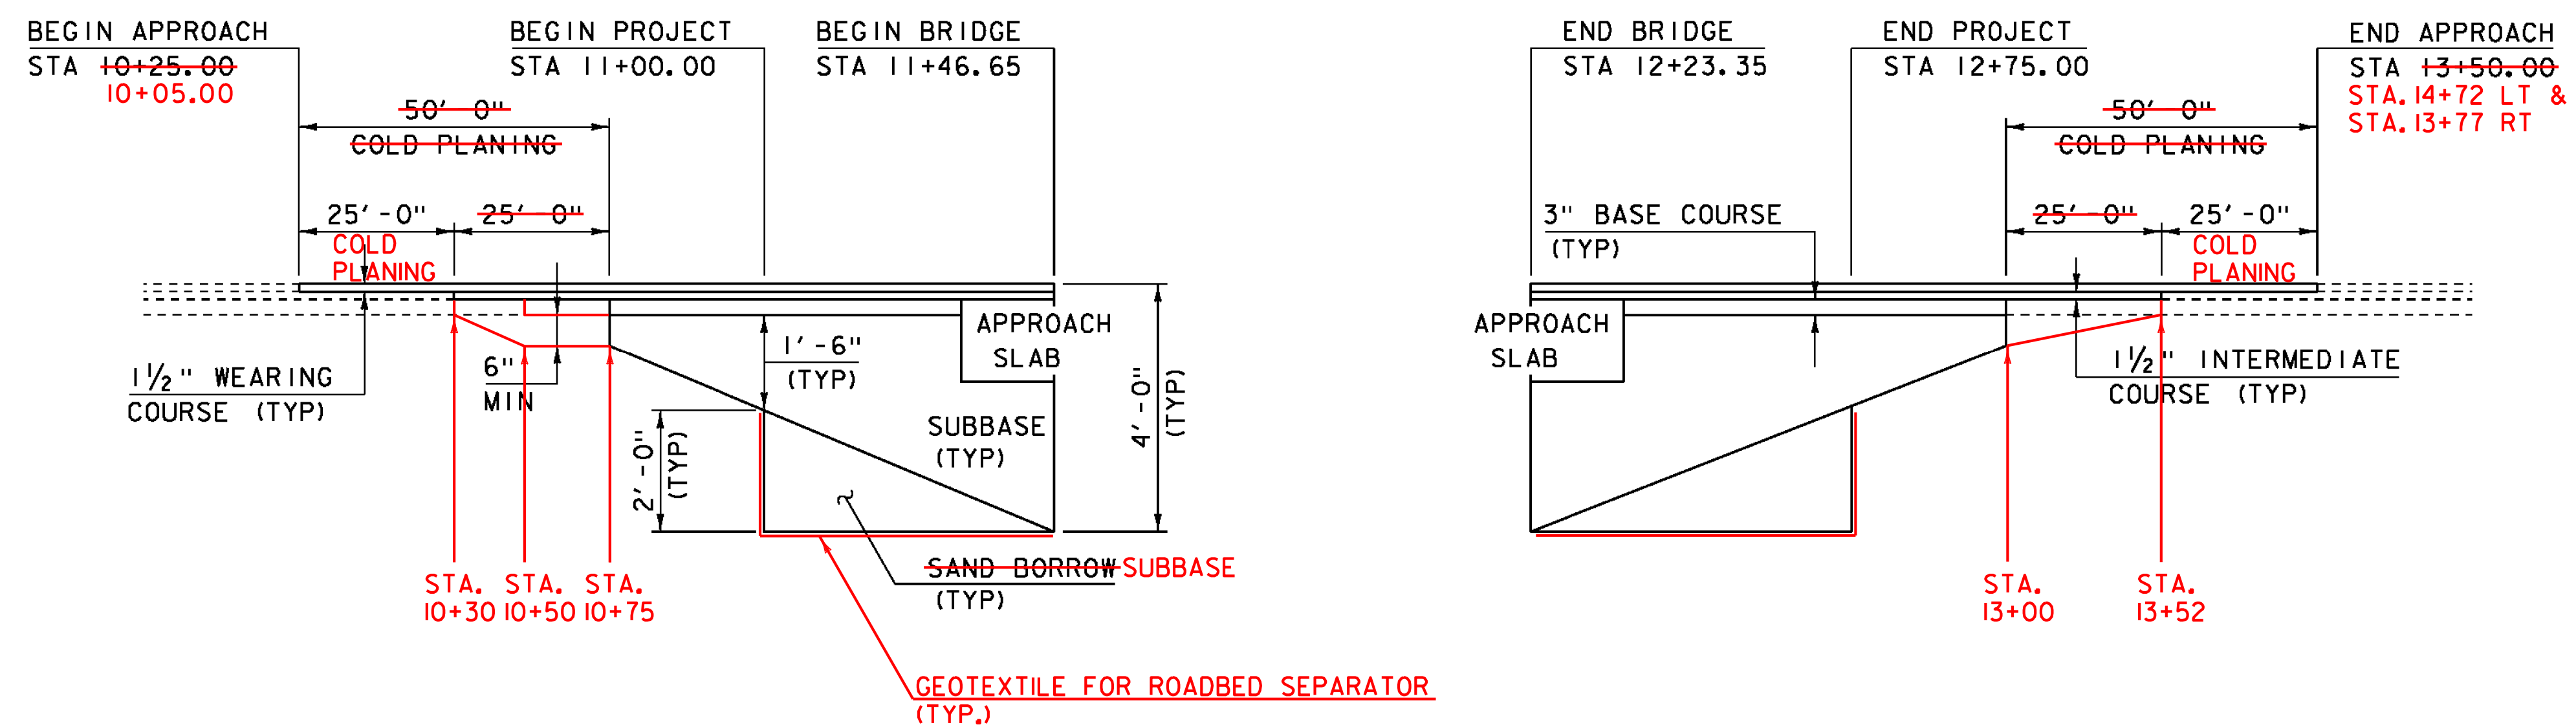

### TH 3 MATERIAL TRANSITION DETAIL

HORIZONTAL SCALE: 1" = 20'-0"  
 VERTICAL SCALE: 1" = 2'-0"

PROJECT NAME:	CLARENDON
PROJECT NUMBER:	BRO 1443(48)
FILE NAME:	s12j160profile.dgn
PROJECT LEADER:	K. HIGGINS
DESIGNED BY:	J. GRIGAS
BANKING DIAGRAM AND MATERIAL TRANSITION SHEET	49 OF 59
PLOT DATE:	10-SEP-2015
DRAWN BY:	J. GRIGAS
CHECKED BY:	G. LAROCHE